

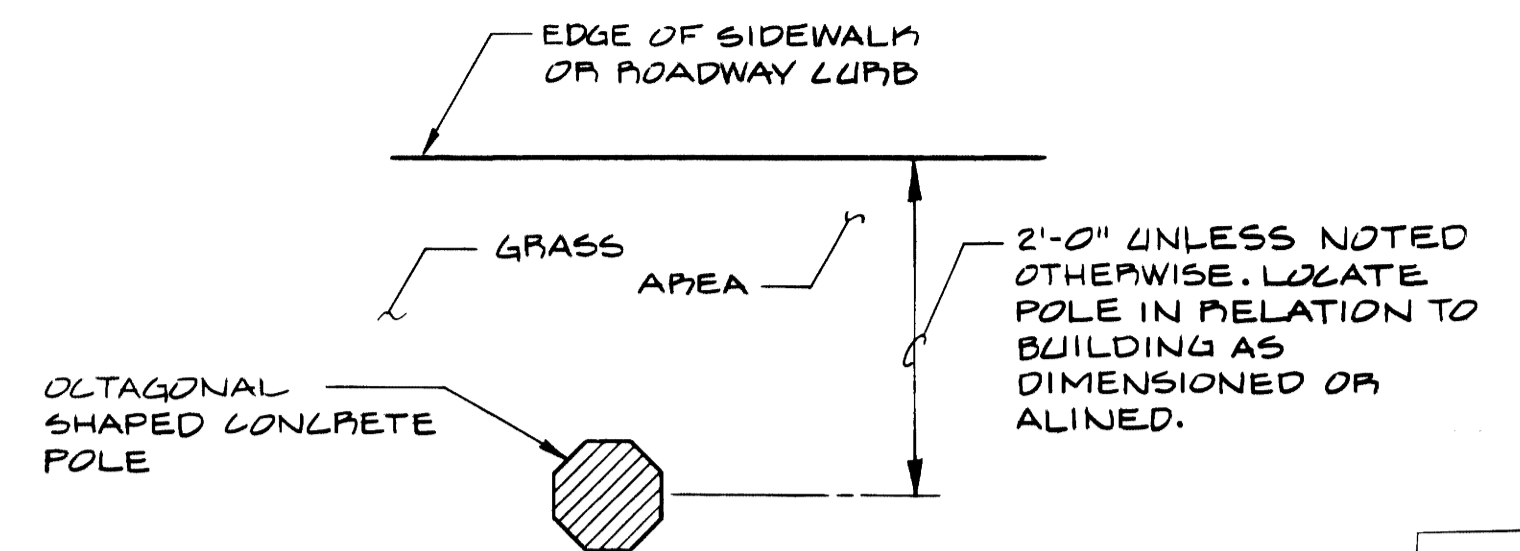


CAUTION: EXISTING BURIED UTILITIES ARE LOCATED IN THIS CONSTRUCTION AREA. THE CONTRACTOR SHALL USE CARE IN EXCAVATING TO INSURE THAT EXISTING UTILITY SYSTEMS ARE NOT DAMAGED OR DISRUPTED. IT IS THE RESPONSIBILITY OF THIS CONTRACTOR TO LOCATE ALL BURIED UTILITIES. PLANS, INDICATING THE APPROXIMATE LOCATION OF EXISTING UTILITIES ARE AVAILABLE FOR THE CONTRACTOR'S INSPECTION. THESE PLANS MAY BE REVIEWED AT THE UNIVERSITY OF KENTUCKY DESIGN AND CONSTRUCTION DIVISION OFFICE.

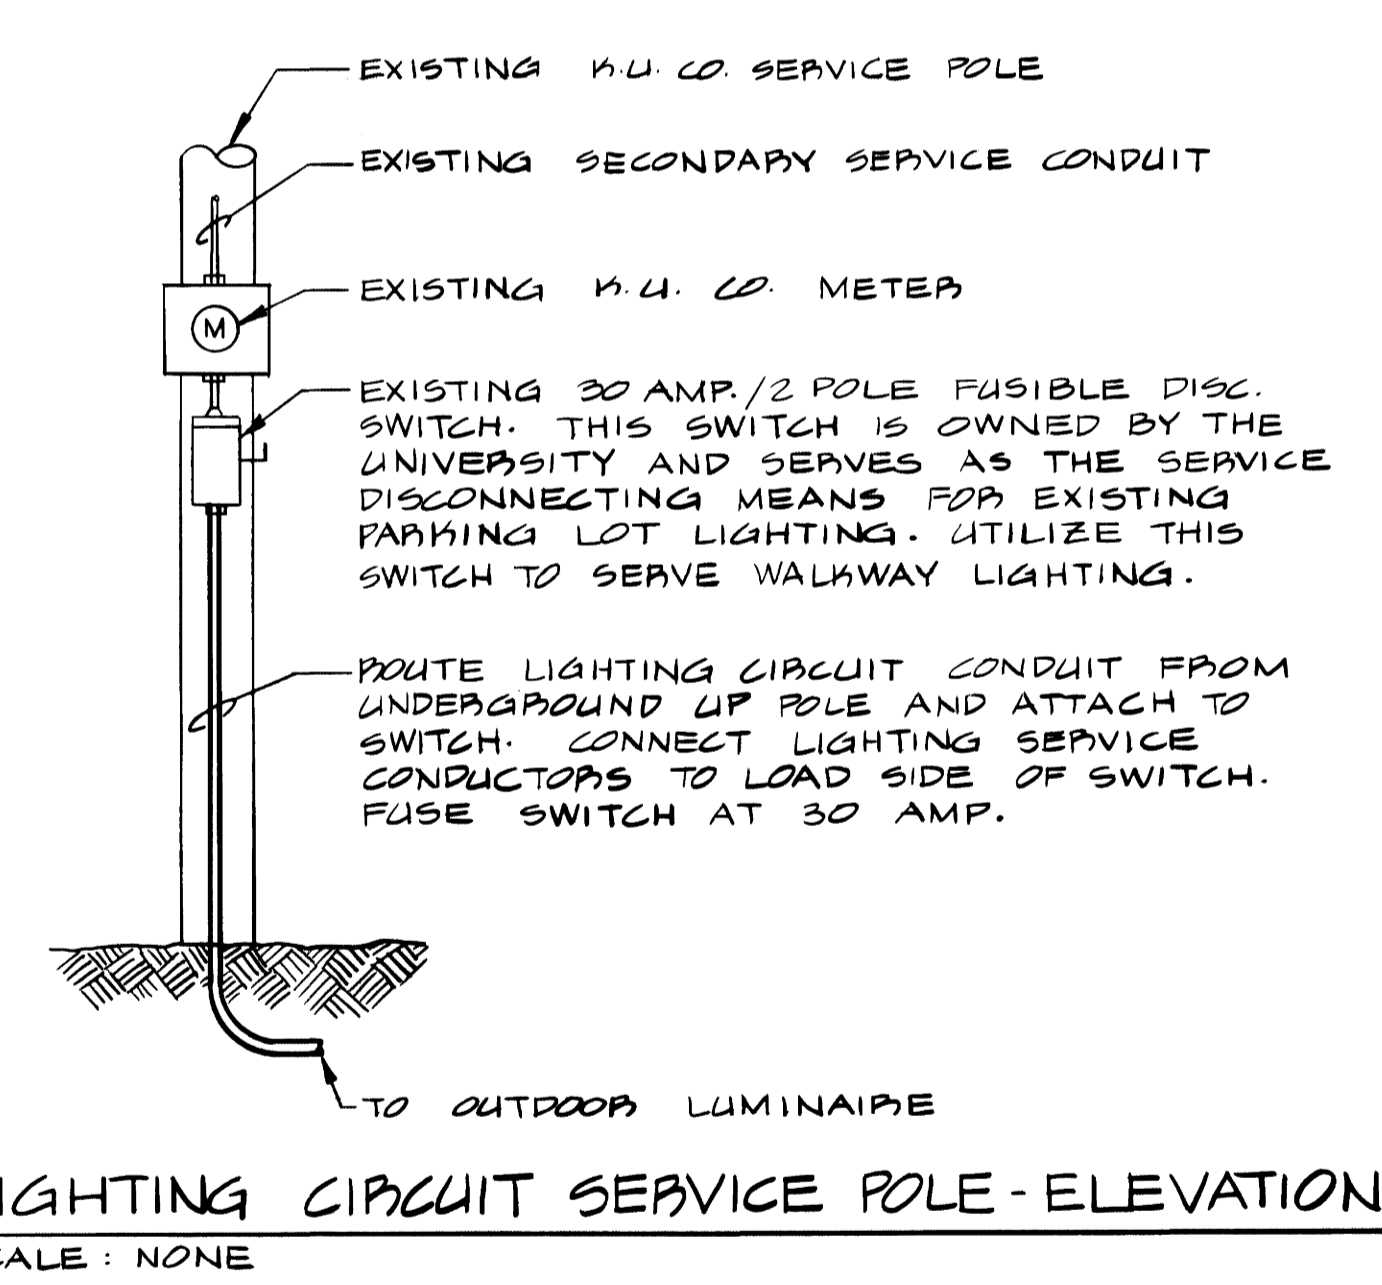


LUMINAIRE / POLE TYPES
 Ⓛ & Ⓧ - POLE LOCATION PLAN
 SCALE: NONE

- NOTES:**
1. EXISTING LANTERN STYLE POLE TOP LUMINAIRE AND METAL POLE. DISCONNECT AND REMOVE LUMINAIRE AND POLE. TURN OVER LUMINAIRE AND POLE TO THE UNIVERSITY. REMOVE CONCRETE POLE FOUNDATION AND FINISH GRADE TO MATCH EXISTING. WITH THE ASSISTANCE OF THE UNIVERSITY LOCATE CIRCUIT SERVING THIS LUMINAIRE. IF CIRCUIT DOES NOT SERVE LOADS TO REMAIN - DISCONNECT AND REMOVE INTERIOR WIRE AND CONDUIT. ABANDON IN PLACE BURIED WIRE AND CONDUIT.
 2. PUSH CONDUIT UNDER ASPHALT ROADWAY IF POSSIBLE.
 3. ROUTE LIGHTING CIRCUITS IN SUCH A MANNER AS NOT TO DISTURB OR DAMAGE TREES OR SHRUBS.
 4. PUSH CONDUIT UNDER PAVEMENT AT SIDEWALK CROSSINGS.
 5. THE UNIVERSITY WILL TRIM AND REMOVE FOLIAGE ALONG WALKWAY TO ALLOW INSTALLATION OF OUTDOOR LUMINAIRE.
 6. EXISTING WOOD POLE WITH ROADWAY TYPE LUMINAIRE OWNED BY THE UNIVERSITY.
 7. EXISTING ROADWAY TYPE LUMINAIRE OWNED BY THE UNIVERSITY AND ATTACHED TO K.U. CO. SERVICE POLE.
 8. EXISTING LIGHTING CIRCUIT ROUTED OVERHEAD.
 9. PROVIDE A.W.G. SIZE # 10 CONDUCTORS BETWEEN LIGHTING CIRCUIT IN POLE BASE AND LUMINAIRE FOR ALL POLES INDICATED ON THIS SHEET.
 10. CONTRACTOR SHALL VERIFY LIGHTING CIRCUIT VOLTAGE AND PROVIDE OUTDOOR LUMINAIRE BALLAST ACCORDINGLY.

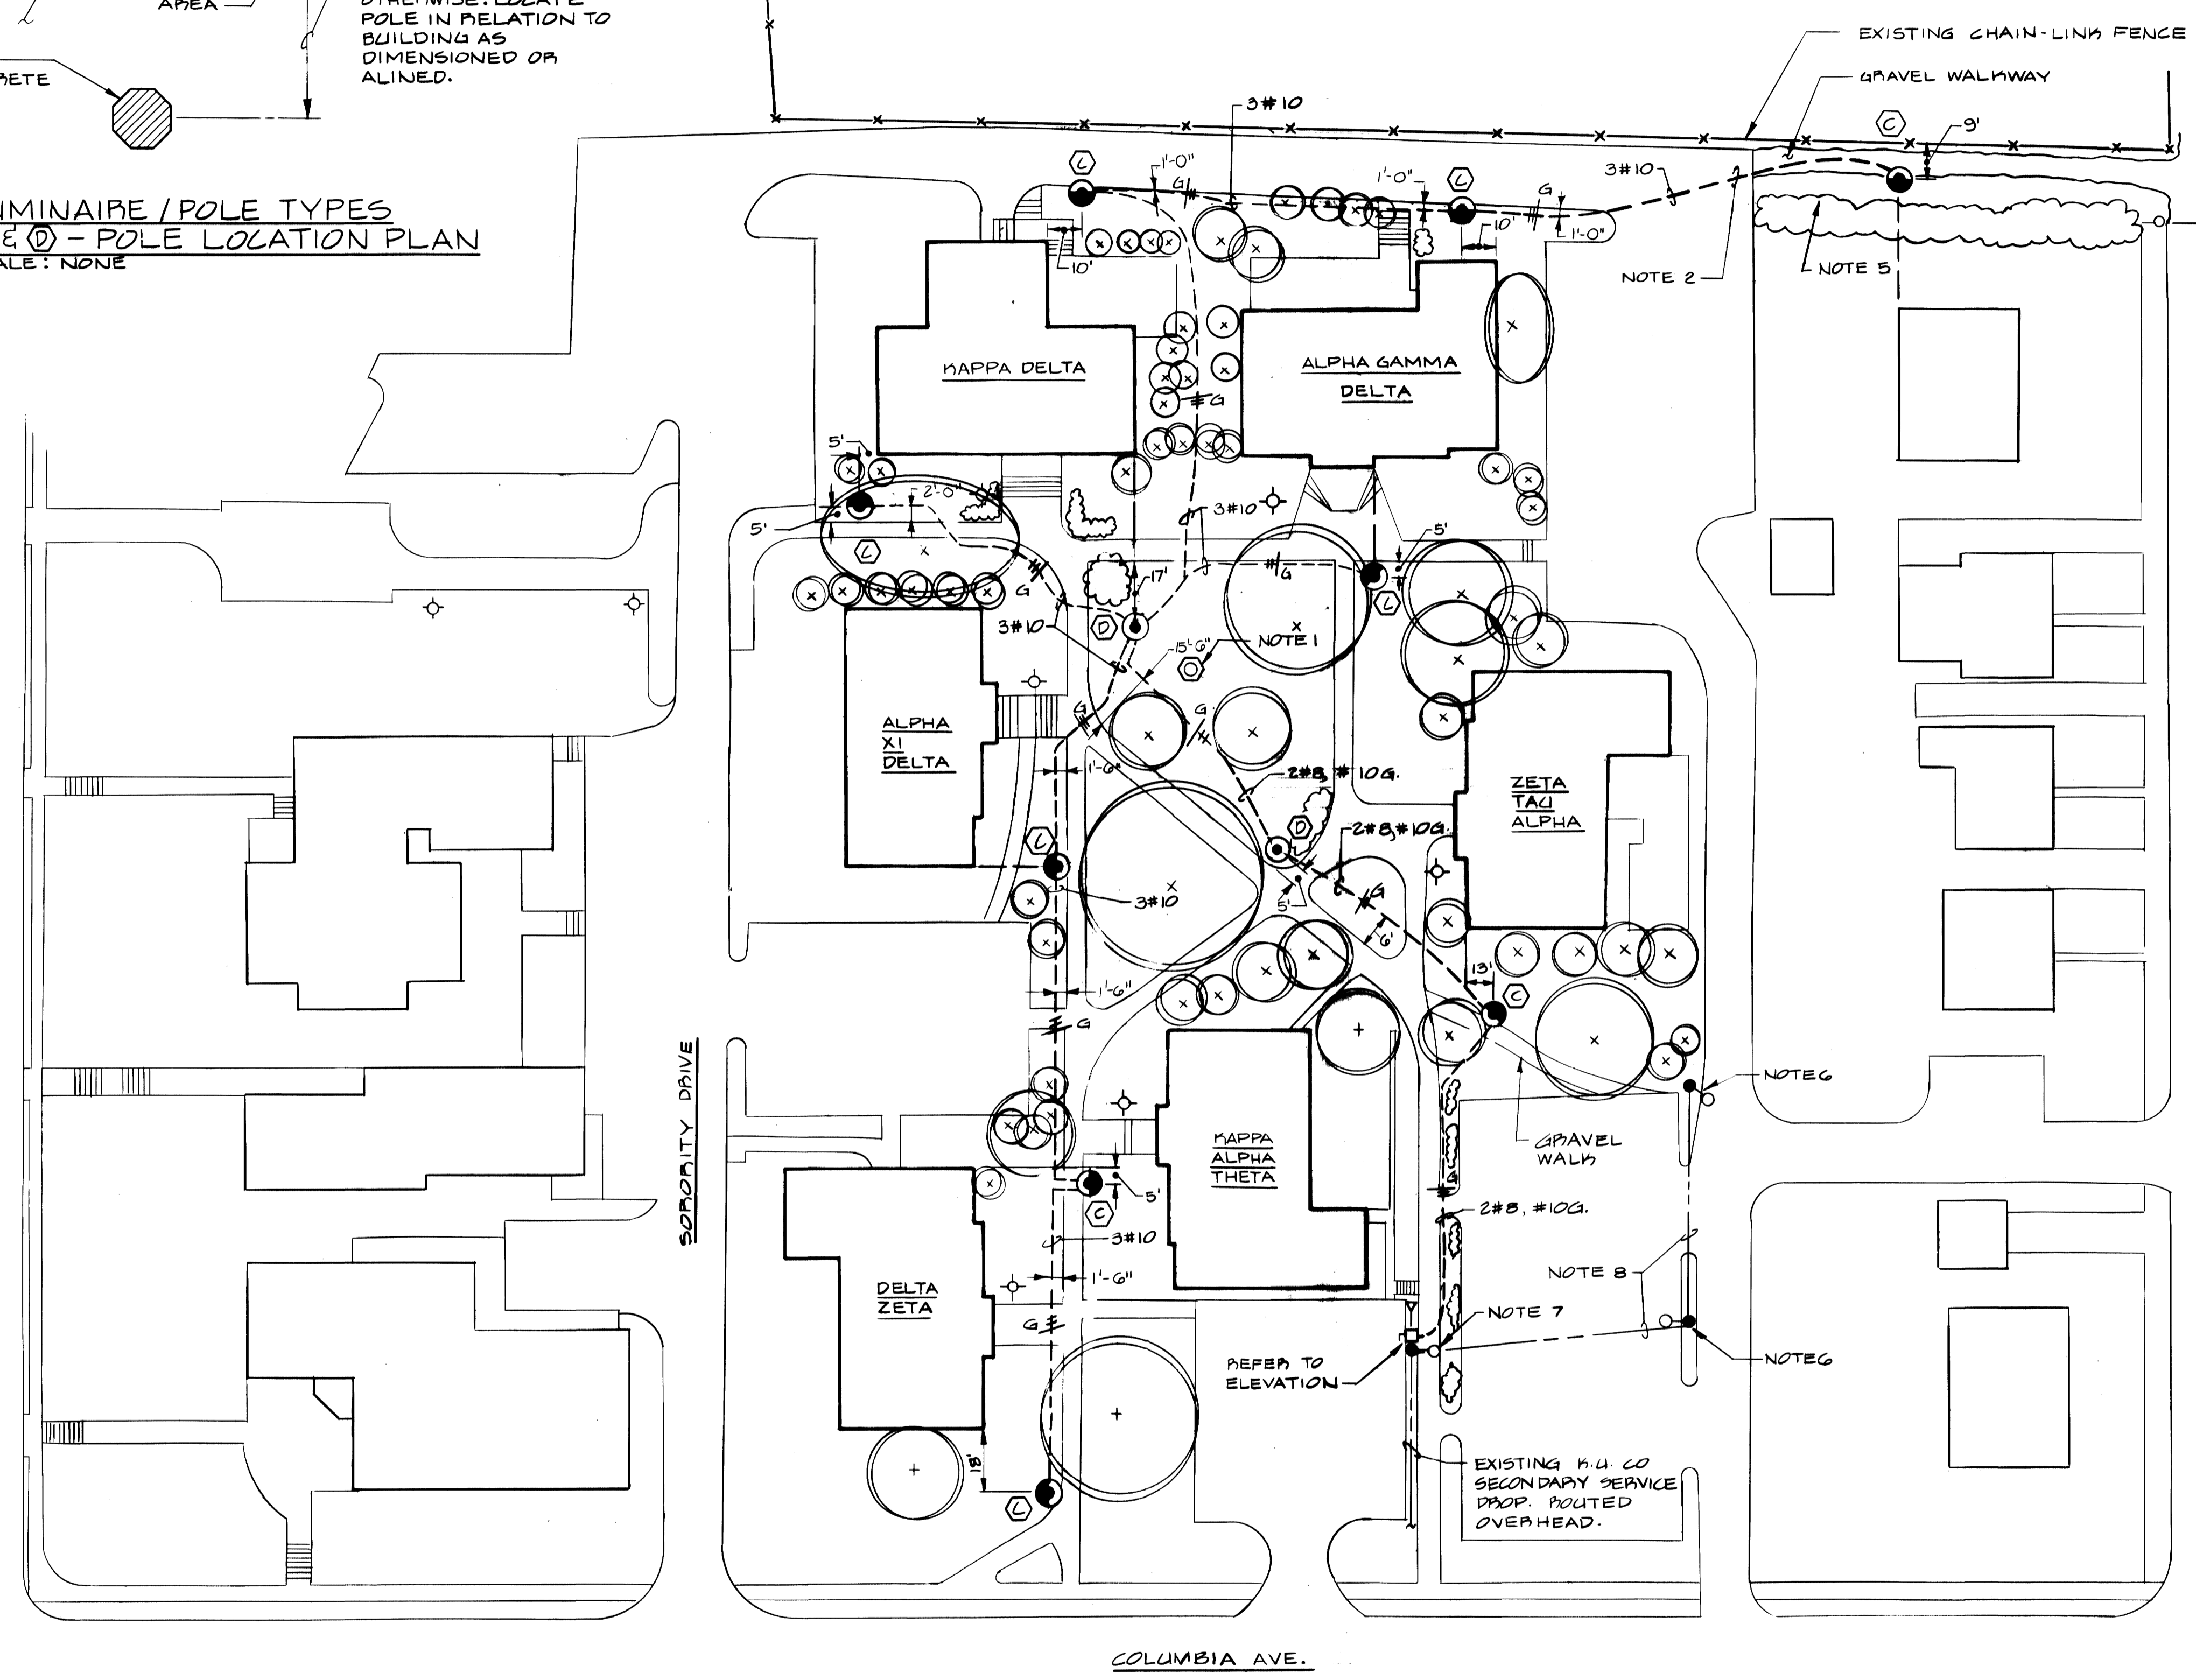

SORORITY ROW
SITE LIGHTING PLAN
 SCALE: 1" = 30'

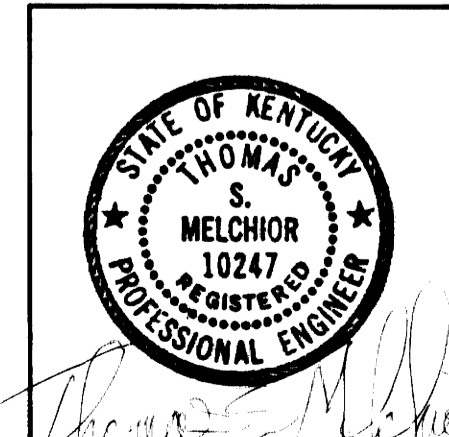

REVISED TO AS-BUILT, OCT. 1987

| | |
|-----------------|----------------------|
| PROJECT NO. 355 | DATE OCT. 1985 |
| FILE NO. | DR. BY C.E.J. & P.J. |
| REVISION | CHK. BY J.B. |
| DRAWING NO. | |

University of Kentucky
 Lexington, Kentucky

E-2

Biagi, Chance, Cummins, London, Titzer, Inc.
 Consulting Engineers

approved by *[Signature]* 10/30/85
 design and construction division