


FP-3	
2-BP	
2-FW	
1-GRID	
FP-3	

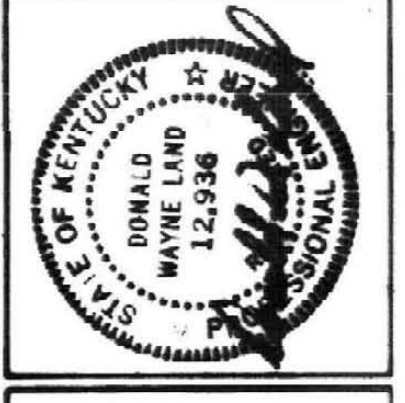

Hellmuth, Obata, & Kassabaum, Inc.
M-E-P Engineering
 100 North Broadway, St. Louis, Mo. 63102
 Ph: 314-471-8000

OMNI/CMW Joint Venture Architects
 In Association with Hellmuth, Obata, & Kassabaum
 2365 Harbortown Road, Lexington, KY 40504 Ph: 606-223-3045
 326 S. Broadway, Lexington, KY 40502 Ph: 606-254-6623

SECOND LEVEL PLAN
HOSPITAL EXPANSION & RENOVATION
A. B. CHANDLER MEDICAL CENTER
 PROJECT NO. 304.1
 100 PACKAGE 02

University of Kentucky
 Design & Construction
 Approval
[Signature]
 Director

Date: 11/8
 Drawn by:
 Check by:
 Revisions:

FP-3
 HOSPITAL ADDRESS

ALBERT B. CHANDLER MEDICAL CENTER UNIVERSITY OF KENTUCKY HOSPITAL EXPANSION & RENOVATION

KEY PLAN

RECORD DRAWINGS DATE: 10-22-93
 These record drawings have been prepared, in part, on the basis of information compiled and furnished by others. The Engineer will not be responsible for any errors or omissions which have been incorporated into this document as a result.
 STAGOS & FISHER CONSULTING ENGINEERS, INC.