


NOTE:  
 1. INSTALL TOP OF ALL  
 RECTANGULAR DUCTWORK  
 5' FROM 2ND FLR SLAB  
 UNLESS OTHERWISE  
 INDICATED.

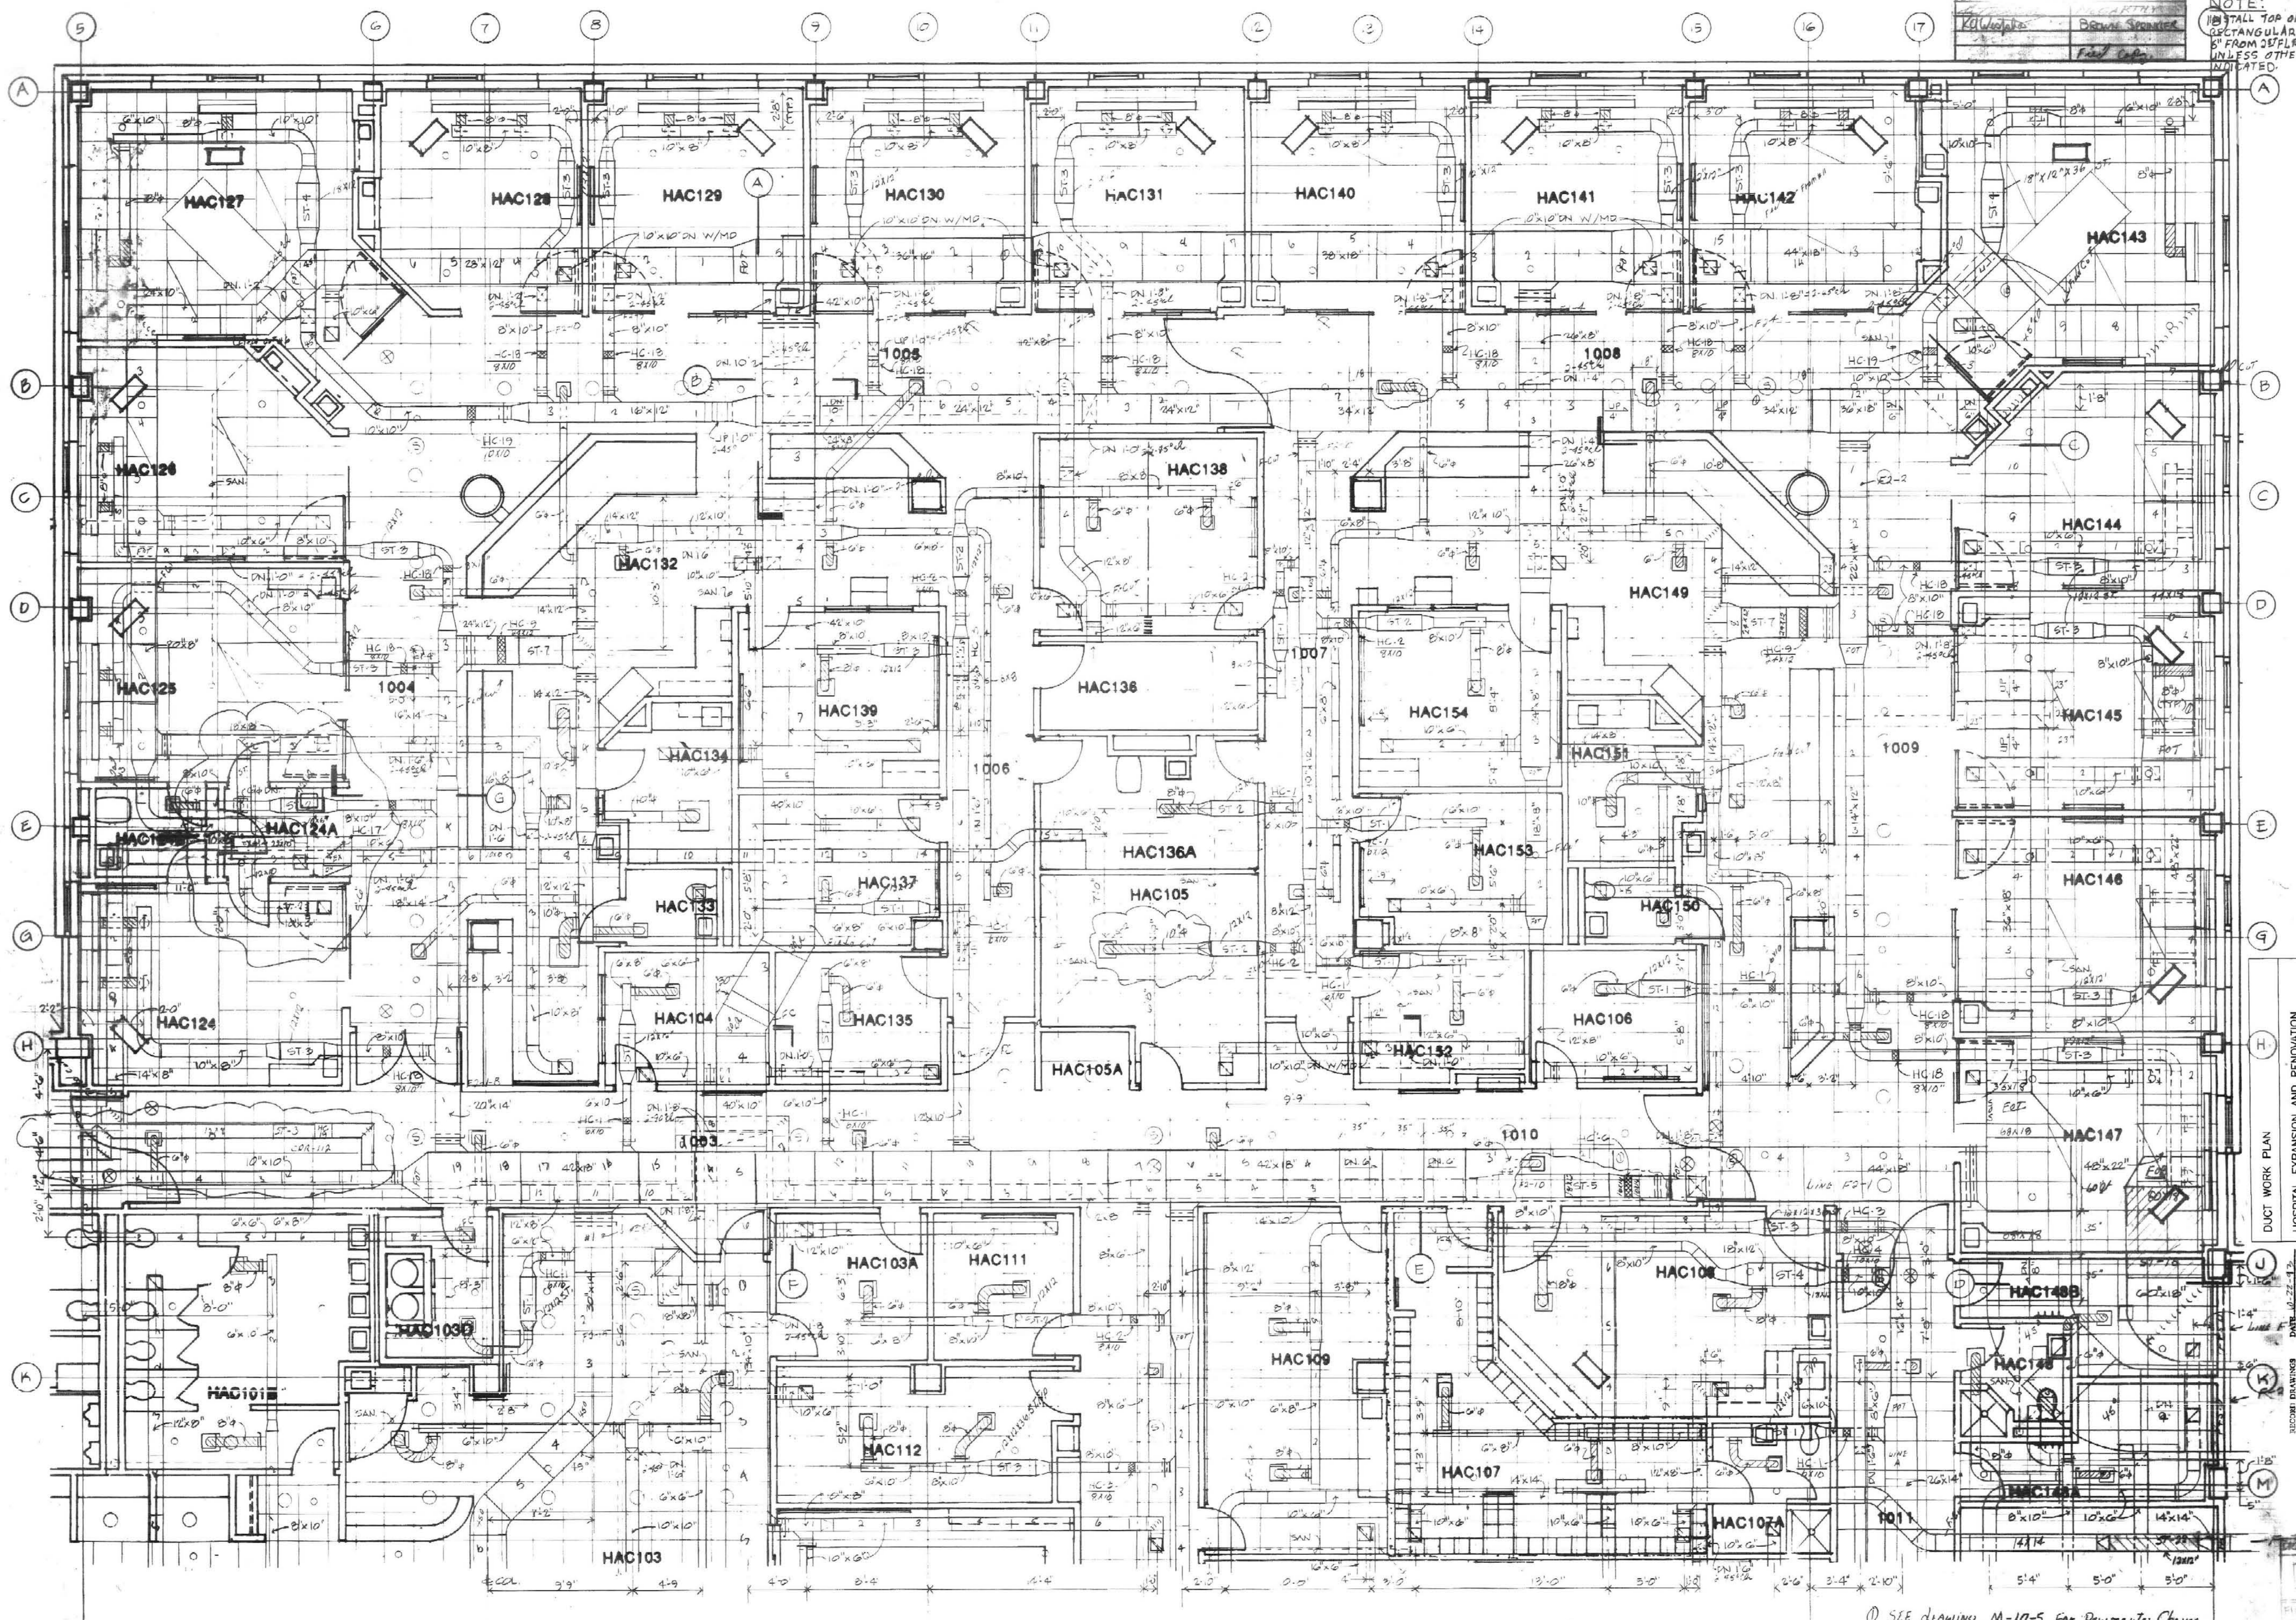

DUCT WORK PLAN  
 HOSPITAL EXPANSION AND RENOVATION  
 A. B. CHANDLER MEDICAL CENTER  
 PROJECT NO. 304-1  
 PID PACKAGE #2

RECORD DRAWING DATE 10-22-13  
 These record drawings have been prepared in full on the basis of the contract documents and the information furnished by the contractor. The contractor is responsible for any errors or omissions which may have been incorporated into the drawings as a result.  
 STOKES & FISHER CONSULTING ENGINEERS, INC.  
 03-10-144

SEE DRAWING M-10-5 FOR REVISIONS  
 FIRST FLOOR - EAST HALF  
 1/4" = 1'-0"

D-6  
 FIRST FLOOR  
 EAST HALF