



SECTION M
1/2" = 1'-0"


SECTION N
1/2" = 1'-0"

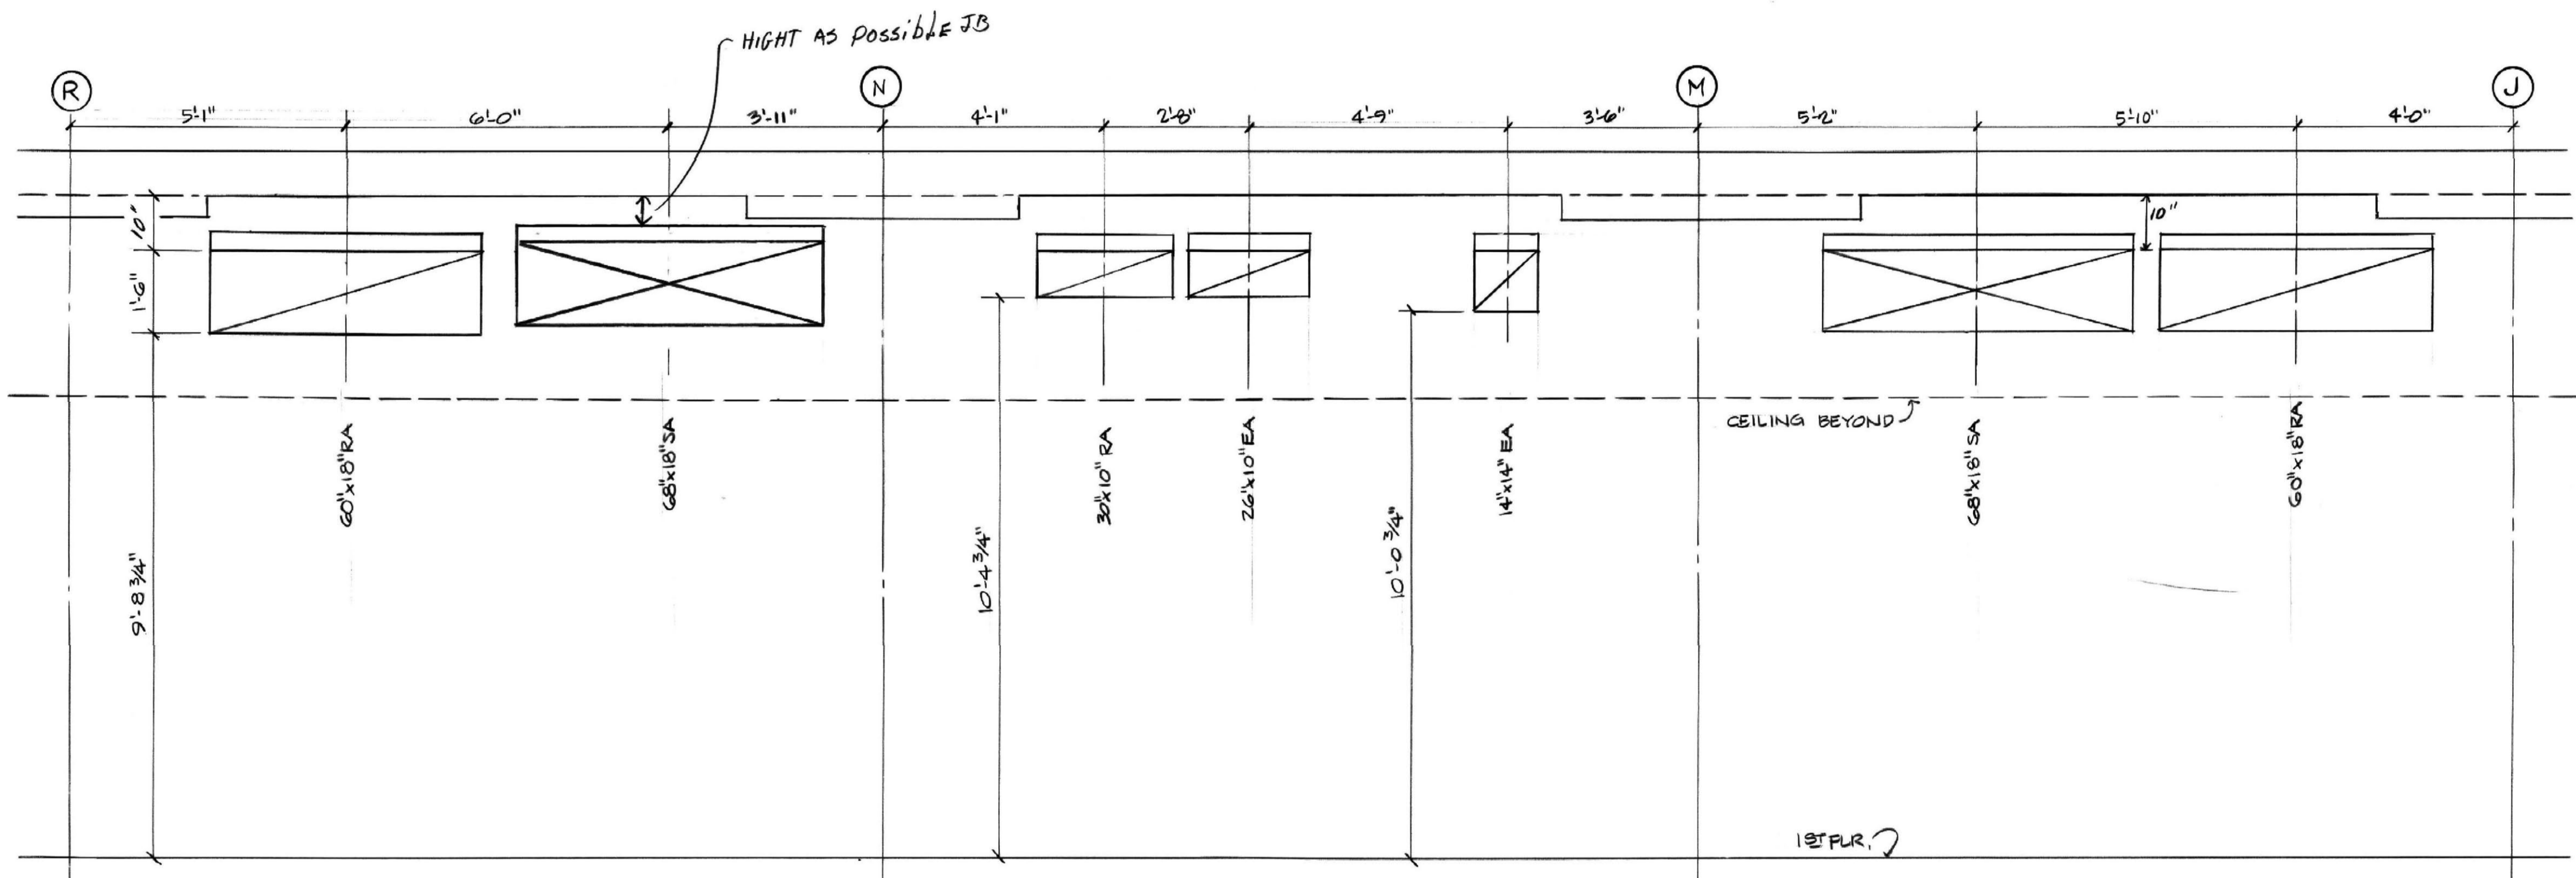

SECTION P
1/2" = 1'-0"

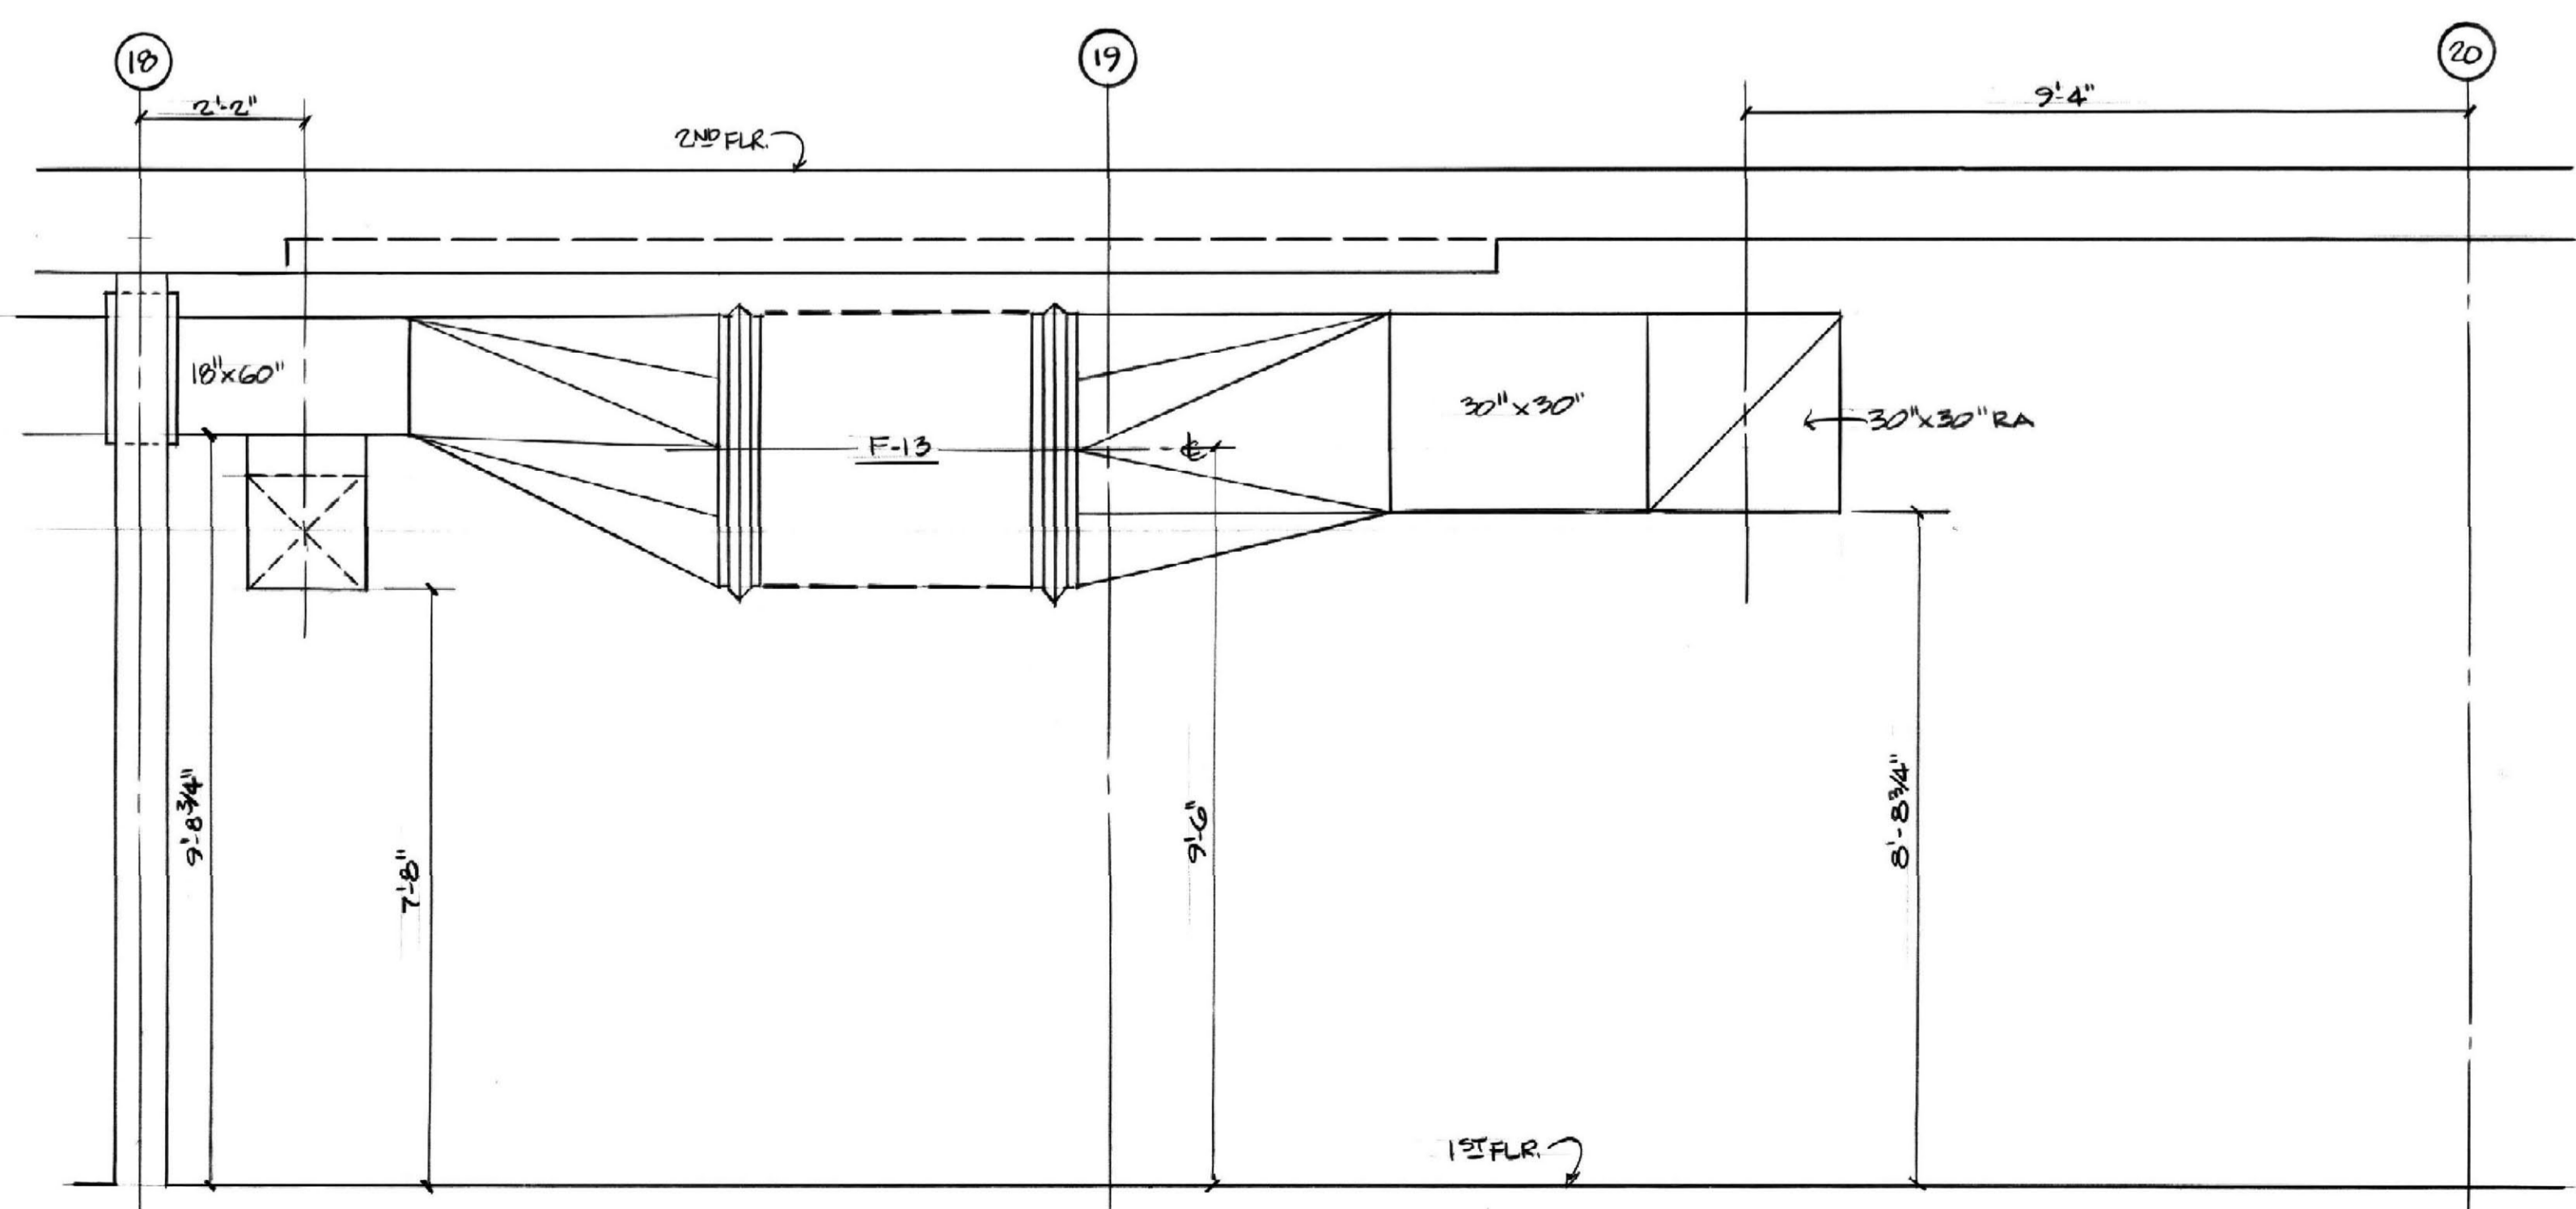

SECTION Q
1/2" = 1'-0"

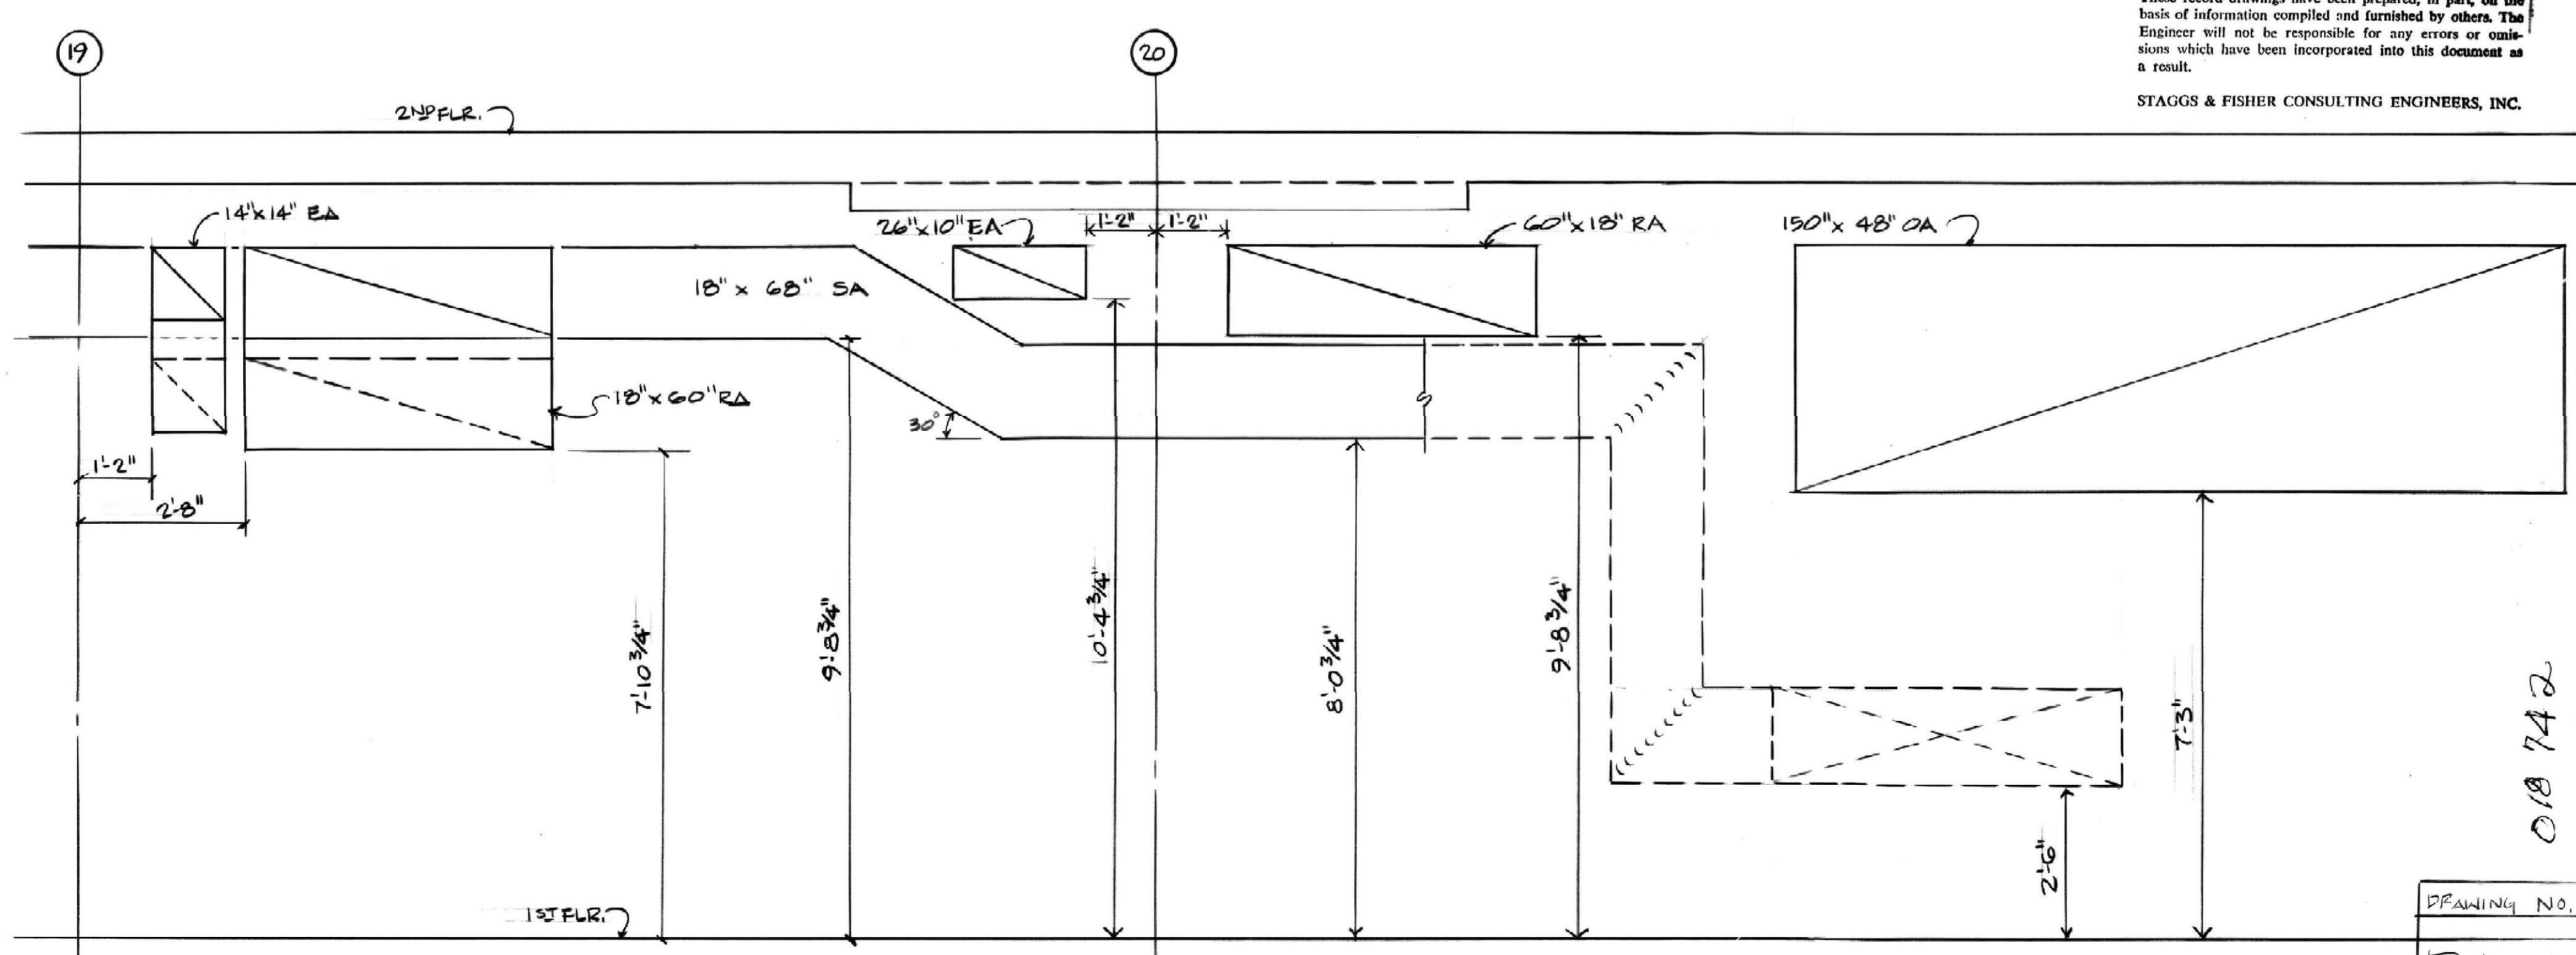

SECTION R
1/2" = 1'-0"

SECTIONS - FIRST FLOOR

DUCT WORK SECTION
HOSPITAL EXPANSION AND RENOVATION
A. B. CHANDLER MEDICAL CENTER
PROJECT NO. 304.1
PID PACKAGE #2

RECORD DRAWINGS DATE 12-22-99
These record drawings have been prepared, in part, on the basis of information compiled and furnished by others. The Engineer will not be responsible for any errors or omissions which have been incorporated into this document as a result.
STAGOS & FISHER CONSULTING ENGINEERS, INC.

DRAWING NO.	D-16-K
FIRST FLORP	
SECTIONS	

018 742