
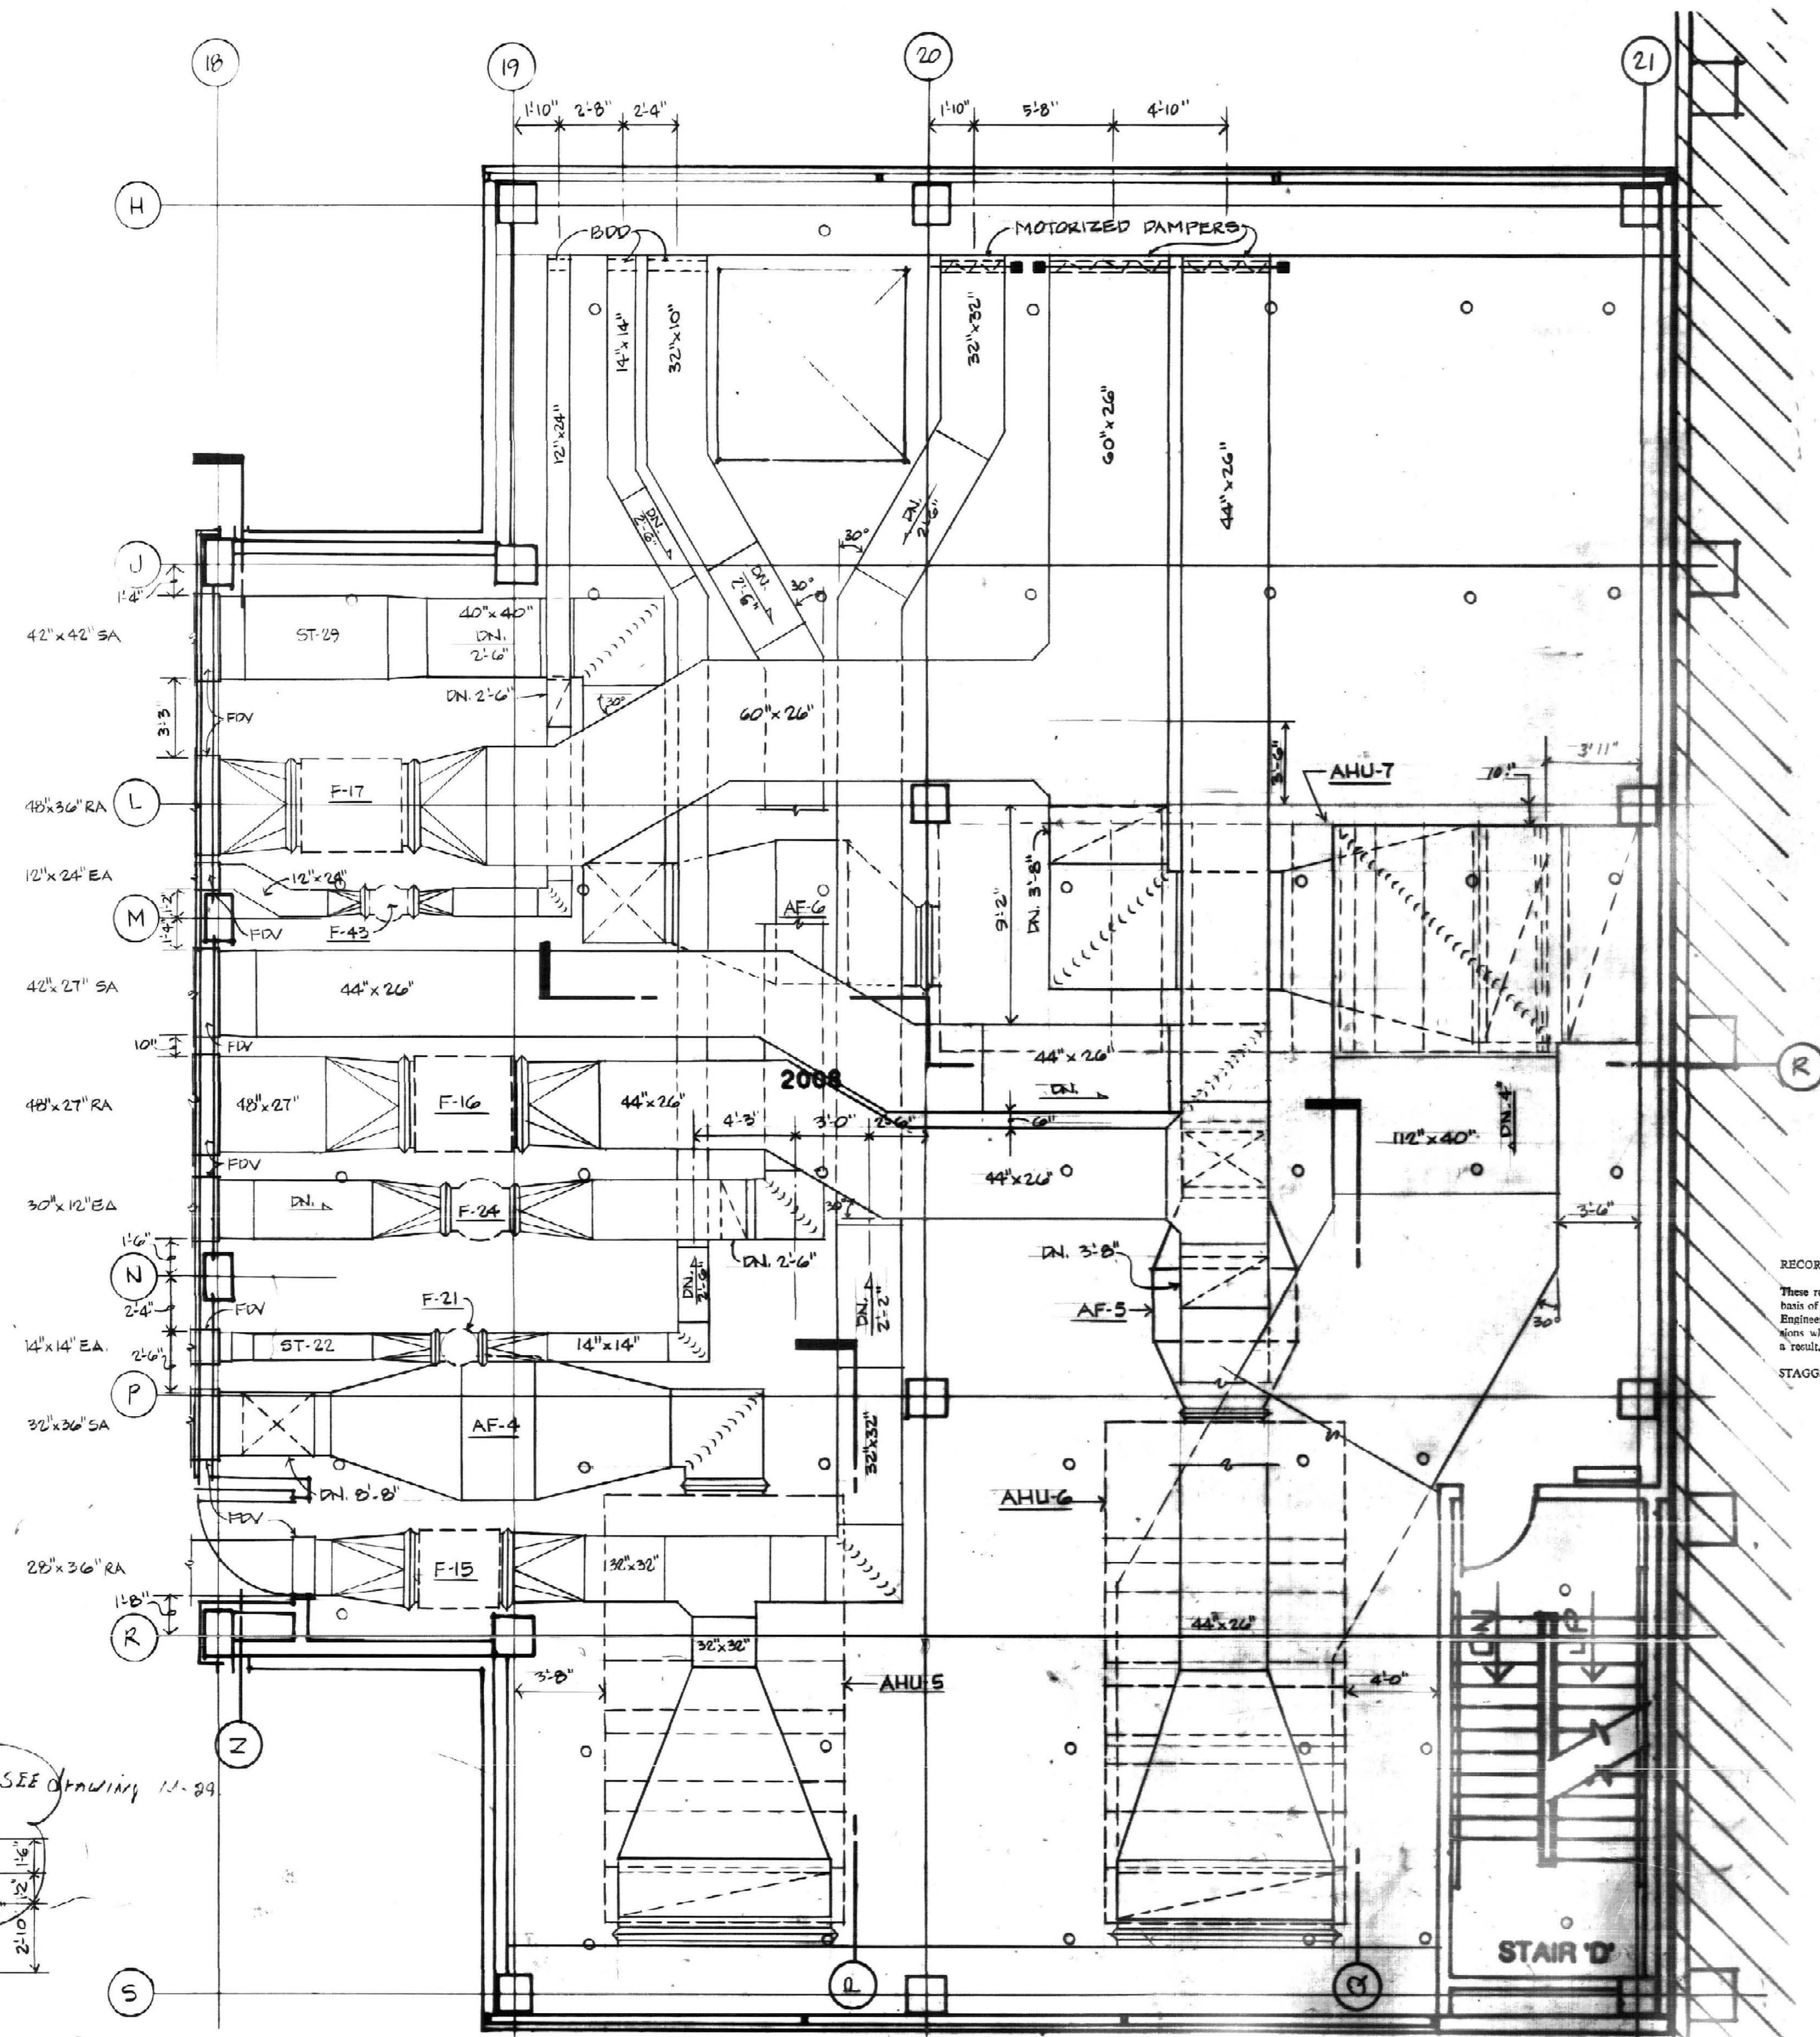


SIGN-OFF BY CONTRACTORS	
SIGNATURE	COMPANY
<i>[Signature]</i>	<i>[Company]</i>
<i>[Signature]</i>	<i>[Company]</i>
<i>[Signature]</i>	<i>[Company]</i>
<i>[Signature]</i>	<i>[Company]</i>

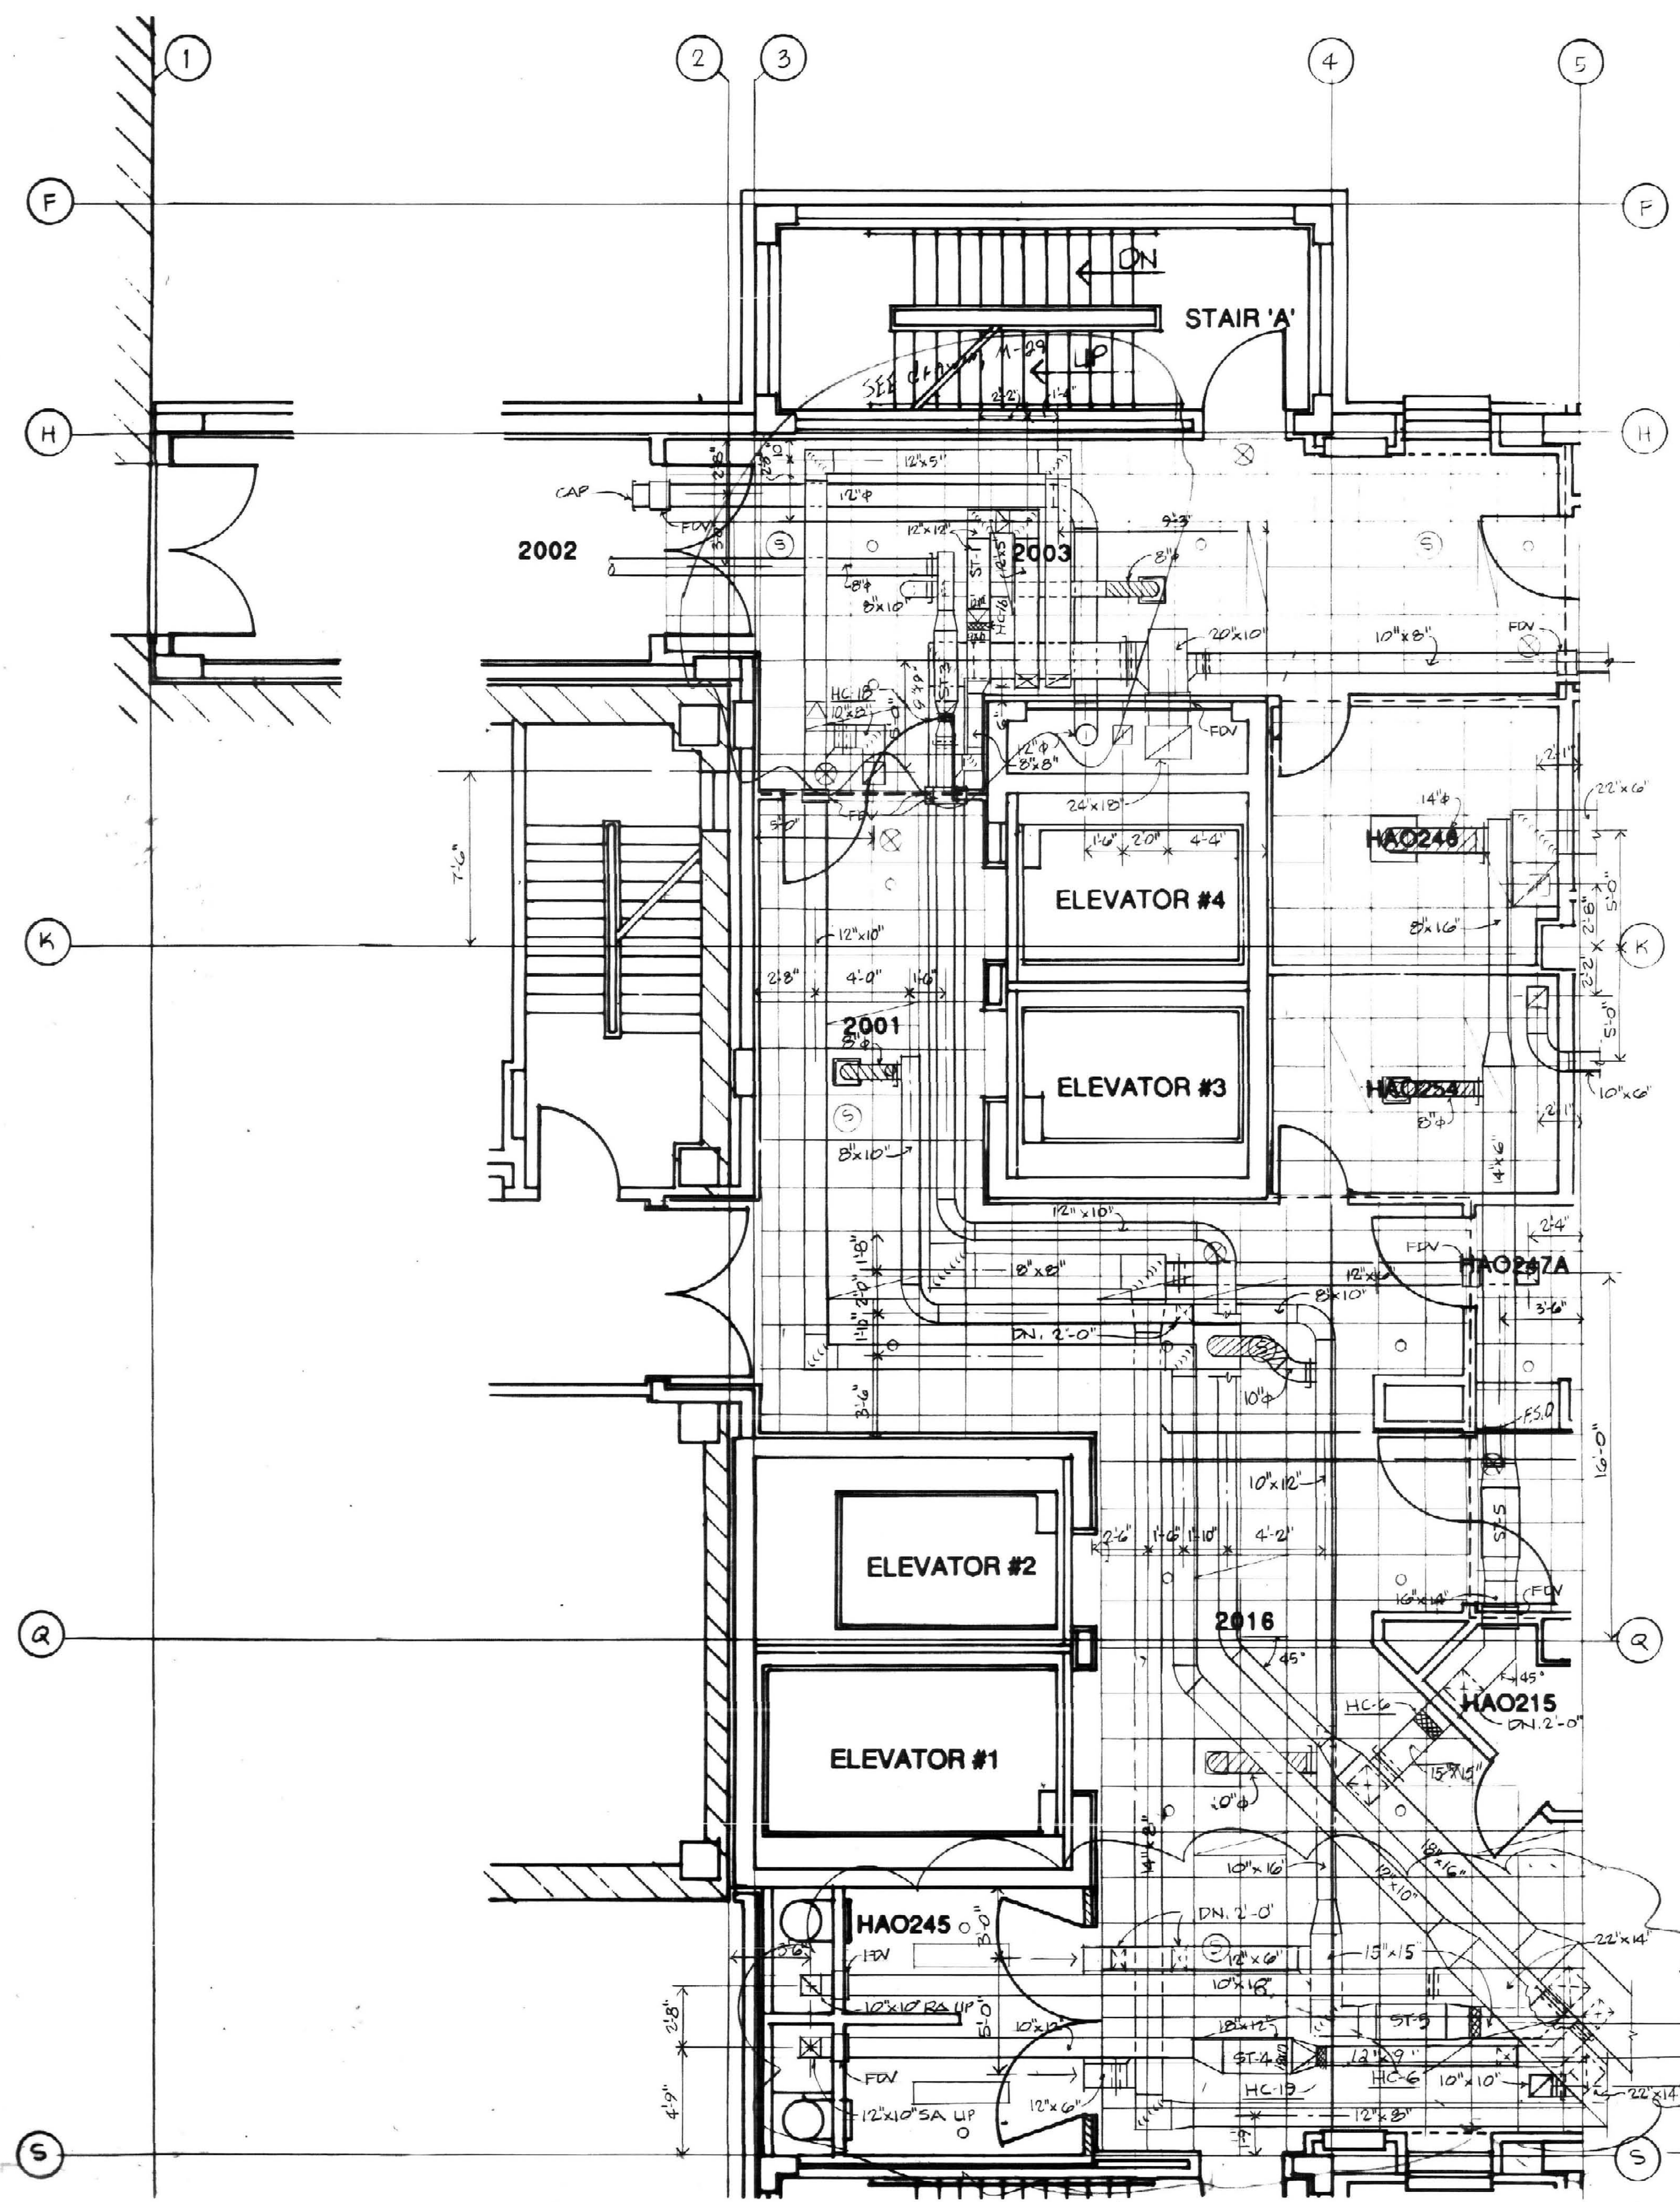

RECORD DRAWINGS DATE: 12-22-93
 These record drawings have been prepared, in part, on the basis of information compiled and furnished by others. The Engineer will not be responsible for any errors or omissions which have been incorporated into this document as a result.
 STAGGS & FISHER CONSULTING ENGINEERS, INC.

DUCT WORK PLAN
 HOSPITAL EXPANSION AND RENOVATION
 A. B. CHANDLER MEDICAL CENTER
 PROJECT NO. 304.1
 PID PACKAGE #2 010743

DRAWING NO. D-7
 SECOND FLOR
 PART 3
 ROOM/AREA

SCALE: 1/8" = 1'-0"