


★ = INCREASE IN DUCT SIZE Eq. TO VERIFY
 CONCENT. COIL SIZE ON THIS DRAWING

SIGN-OFF BY CONTRACTORS	
SIGNATURE	COMPANY
THOMAS S. LEE	ARROW ELECTRIC CO.
DATE	12-27-87

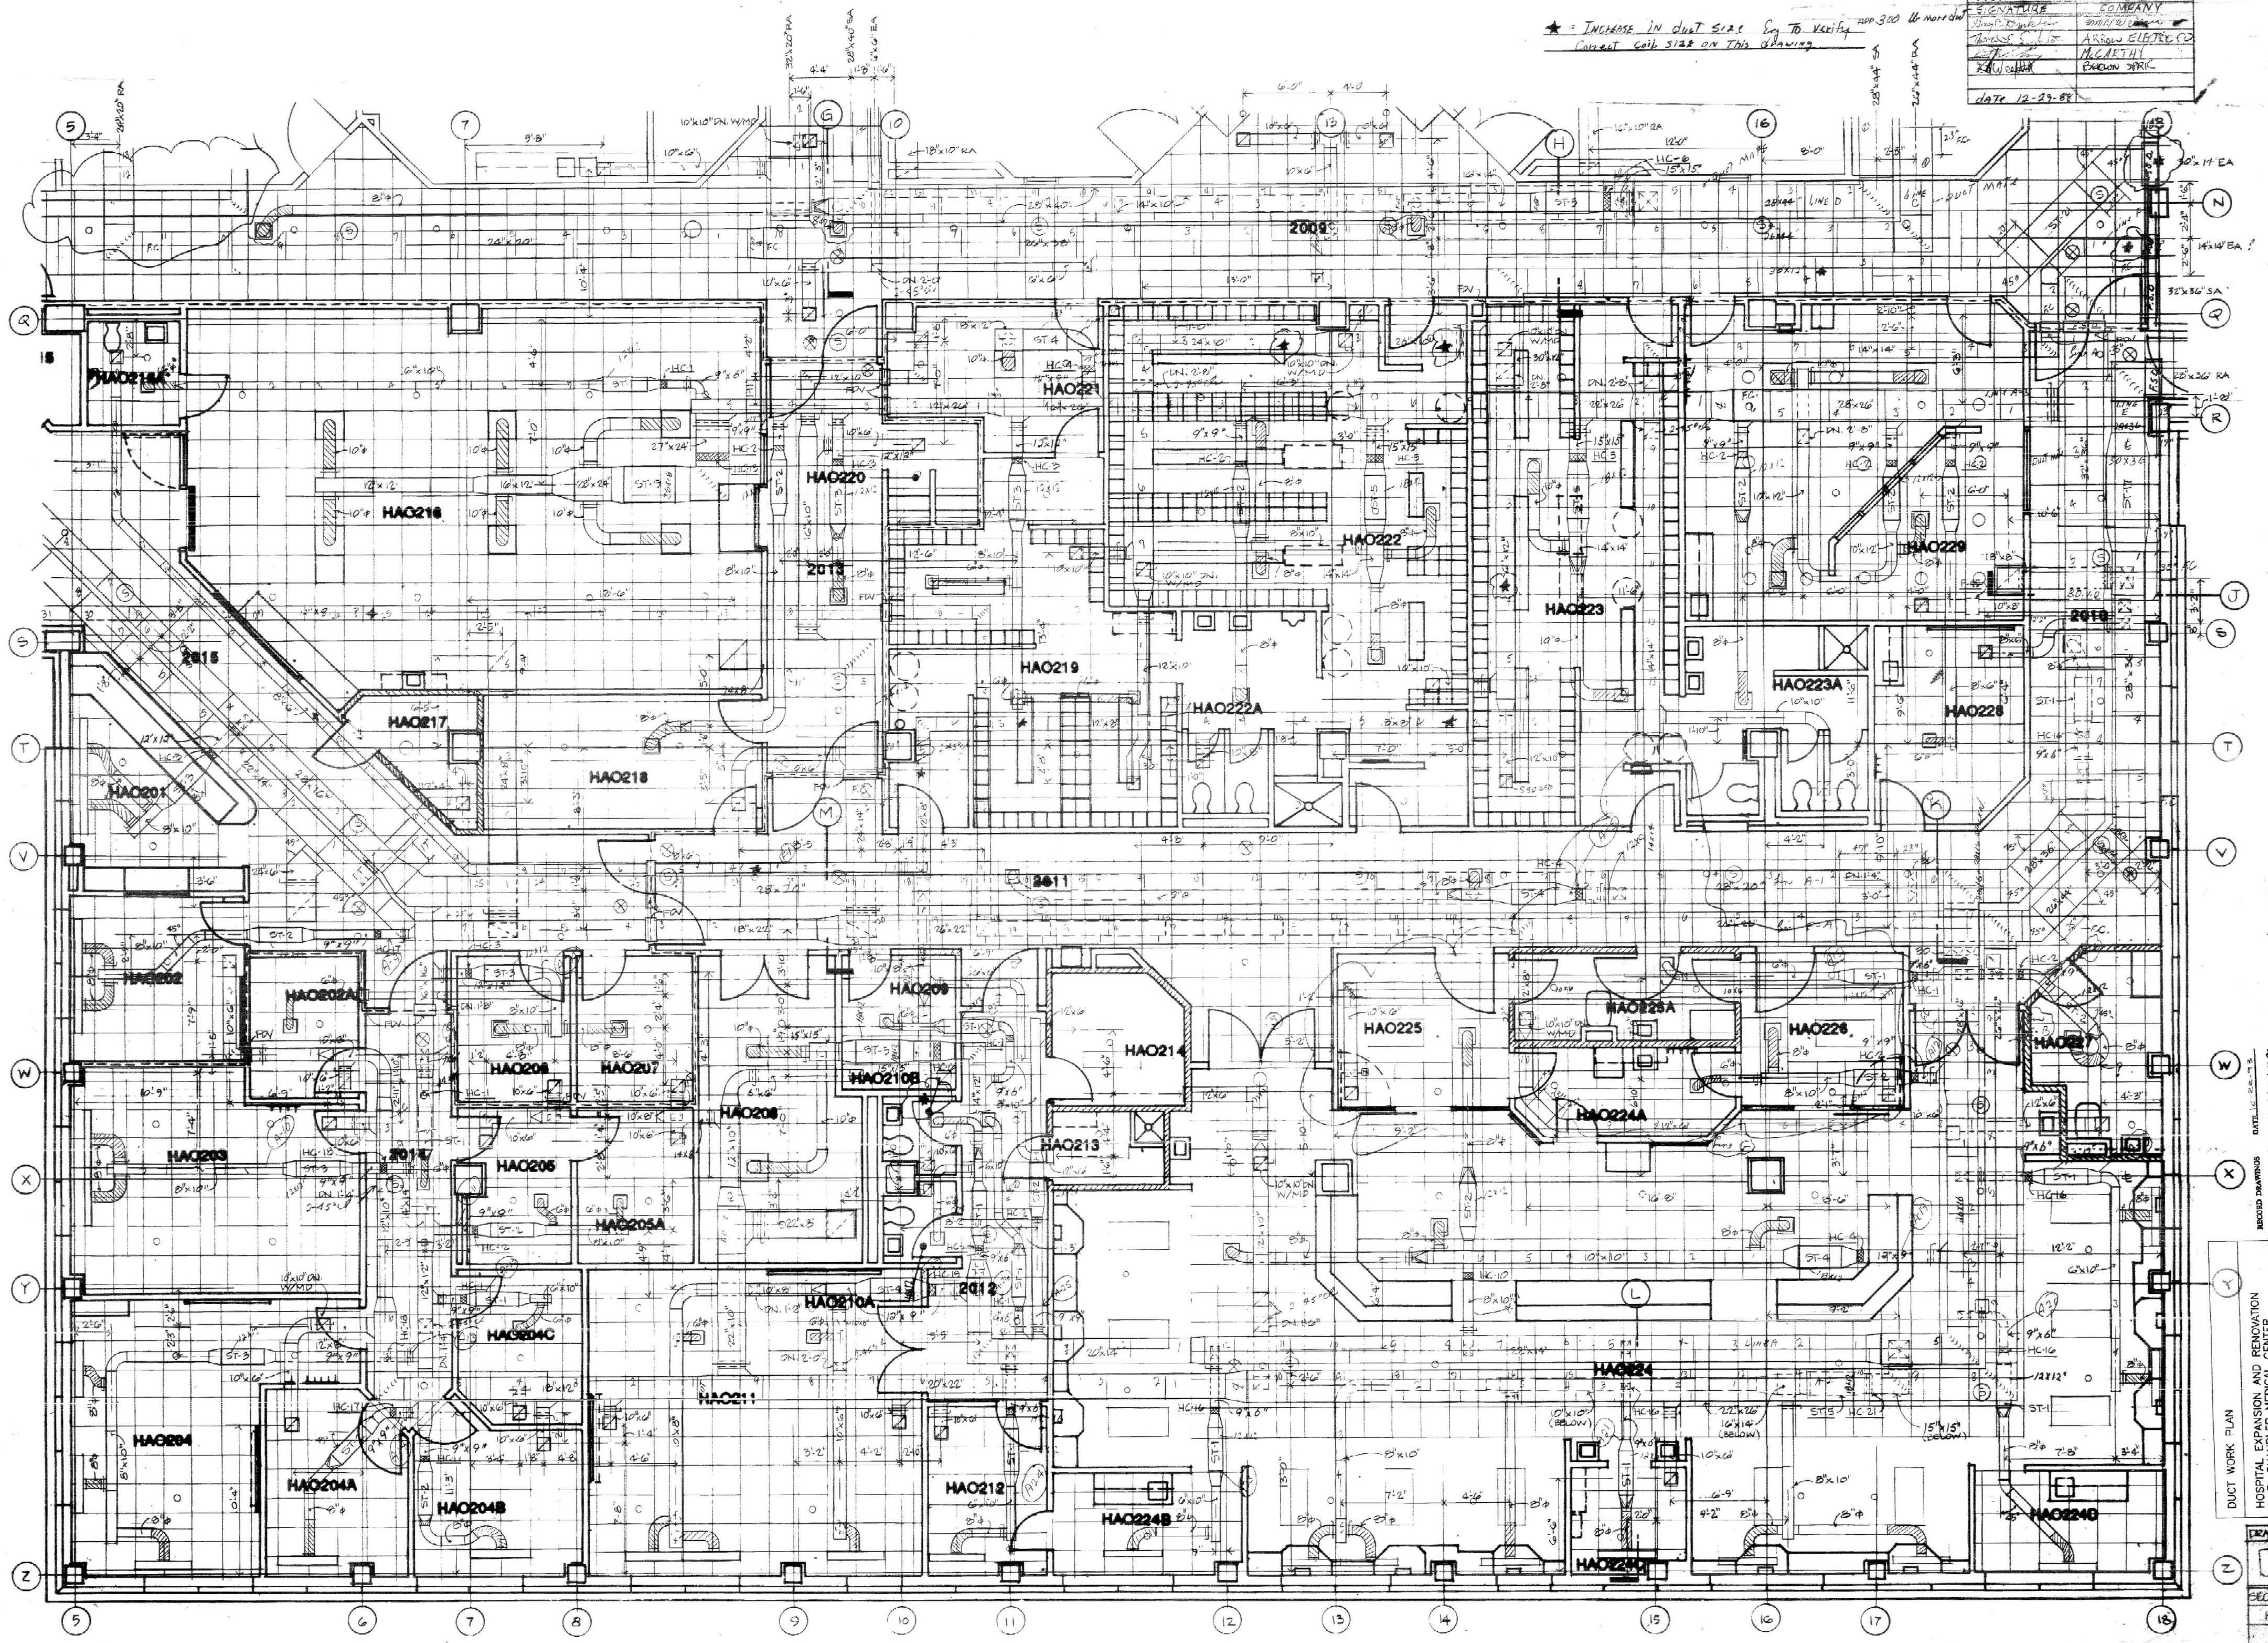

RECORD DRAWINGS DATE: 12-27-87
 THESE RECORD DRAWINGS HAVE BEEN REVISIONED, IN PART, ON THE BASIS OF FABRICATION CHECKS AND FIELD CONDITIONS. ANY CHANGES TO THESE RECORD DRAWINGS SHALL BE INDICATED BY A REVISION TO THESE RECORD DRAWINGS. THESE RECORD DRAWINGS SHALL BE USED IN CONJUNCTION WITH THE CONTRACT DOCUMENTS.
 STAGGS & FISHER CONSULTING ENGINEERS, INC.
 1000 W. 10TH ST., SUITE 100
 DENVER, CO 80202
 PROJECT NO. 304-1
 PID PACKAGE #2
 DRAWING NO. D-8
 SECOND FLOOR
 WEST