


SIGN-OFF BY CONTRACTORS	
SIGNATURE	COMPANY
<i>[Signature]</i>	MELKIN
<i>[Signature]</i>	ARROW ELECTRIC CO.
<i>[Signature]</i>	ROBINS TRIMMER
<i>[Signature]</i>	R.R.P. WALLACE

★ Trade 055 ON Change # 41

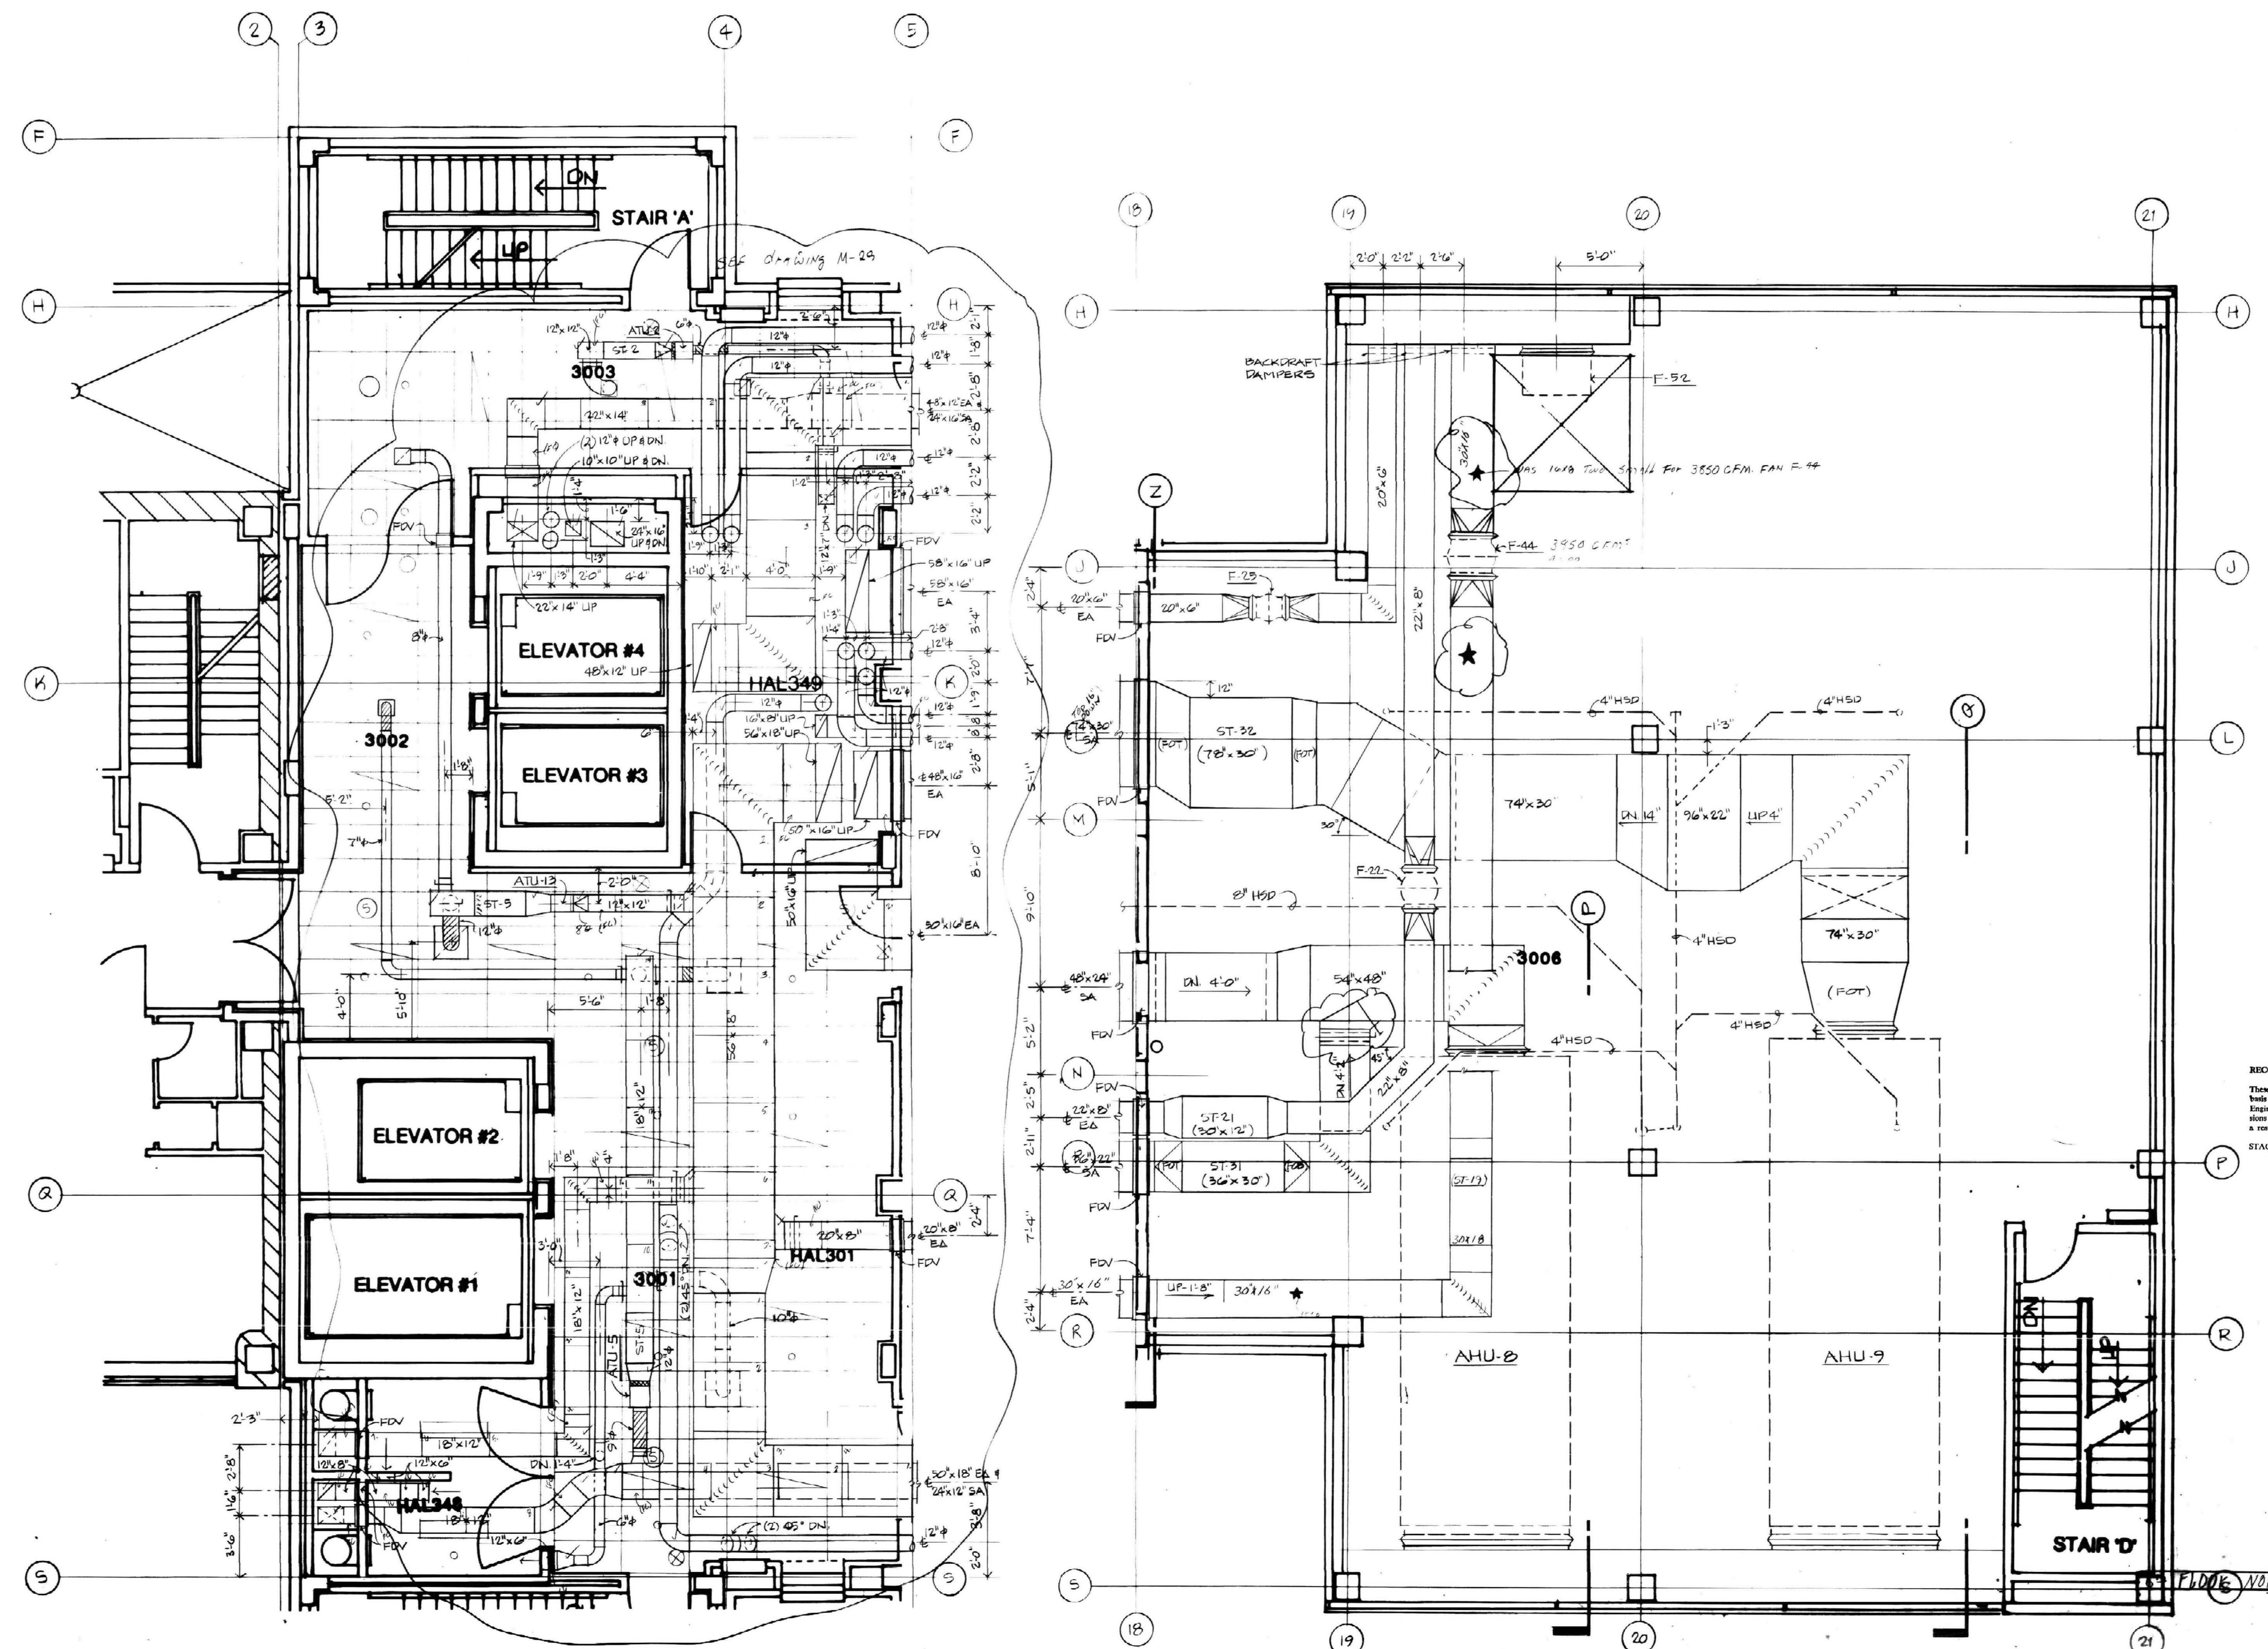

RECORD DRAWINGS DATE 8-22-13

These record drawings have been prepared, in part, on the basis of information compiled and furnished by others. The Engineer will not be responsible for any errors or omissions which have been incorporated into this document as a result.

STAGGS & FISHER CONSULTING ENGINEERS, INC.

DUCT WORK PLAN  
 HOSPITAL EXPANSION AND RENOVATION  
 A. B. CHANDLER MEDICAL CENTER  
 PROJECT NO. 304.1  
 PID PACKAGE #2

DRAWING NO.  
 D-10  
 SIXTH FLOOR  
 PART I  
 NORTH/SOUTH

FLOOR NORTH + SOUTH