


NOTE

FC = Field C.U.T.
A.D. = Acc. door
Acc. door both sides of Corridor

DATE	11-27-14
BY	W. J. ...
CHECKED	...
PROJECT NO.	304.1
PID PACKAGE	#2

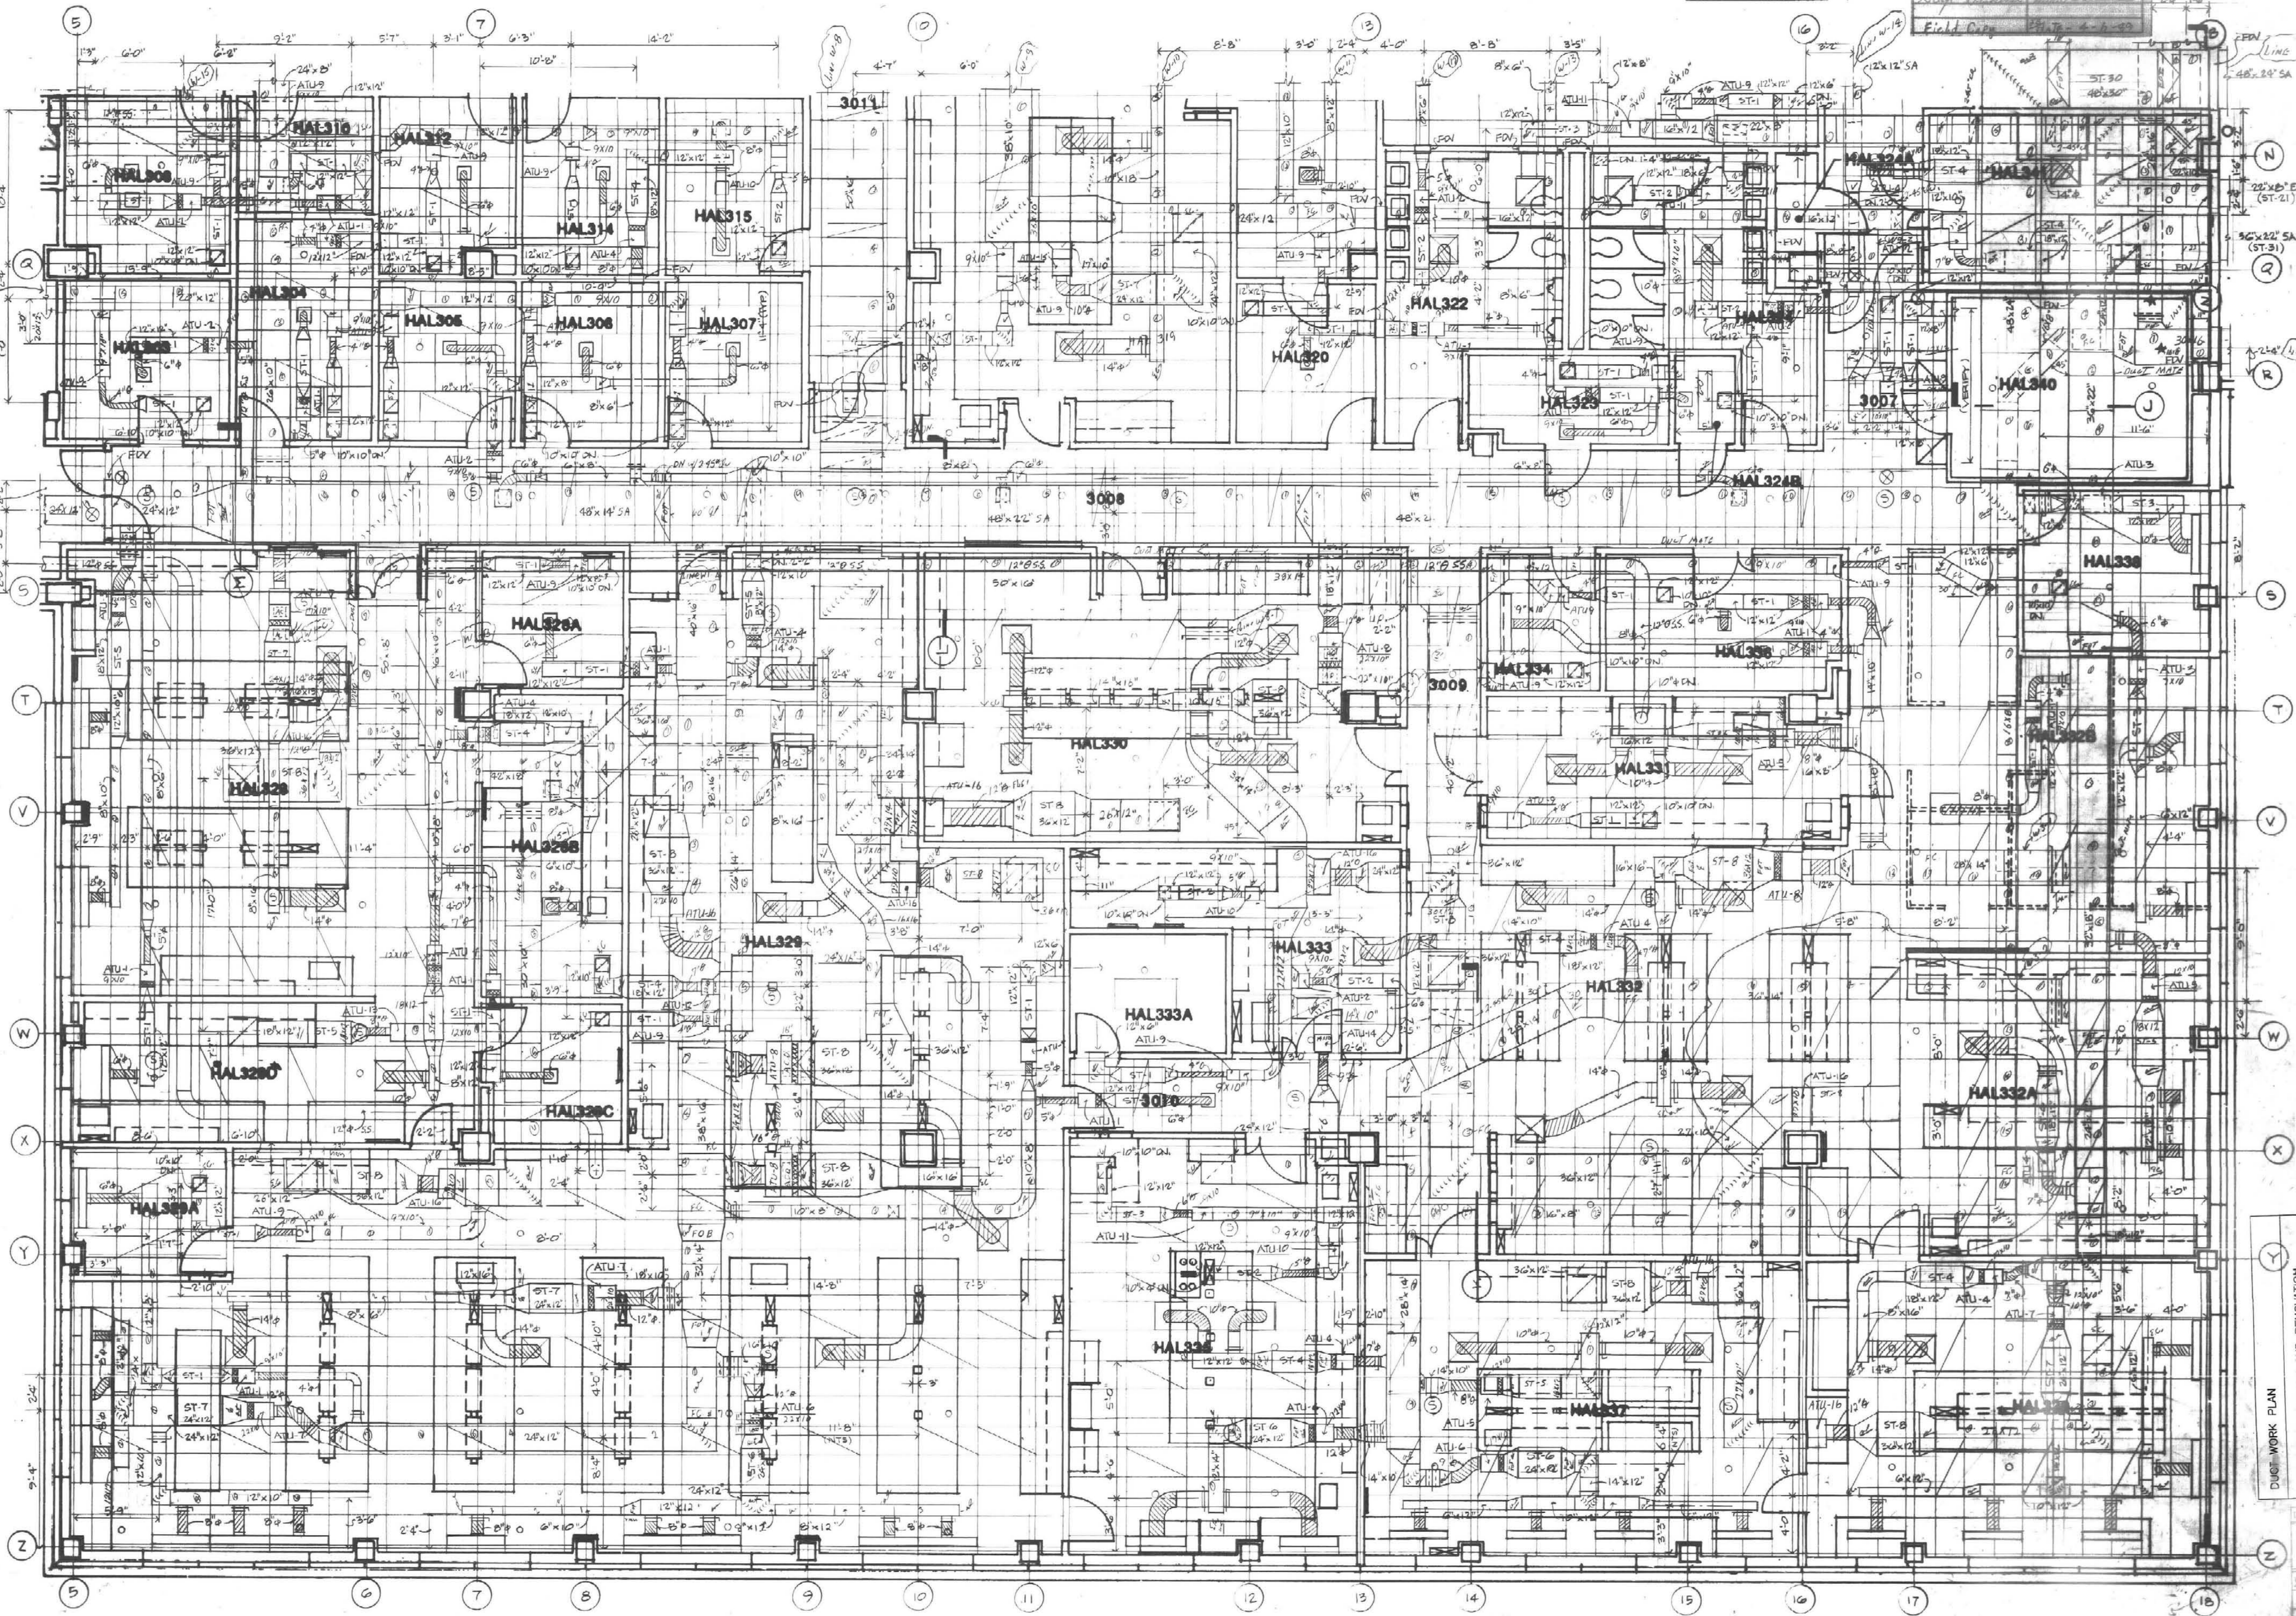

RECORD DRAWING DATE: 11-27-14
 These record drawings have been prepared, in part, on the basis of information furnished by others. The Engineer will not be responsible for any errors or omissions in this information nor for any consequences that may result therefrom.

PROJECT NO. 304.1
 PID PACKAGE #2
 HOSPITAL EXPANSION AND RENOVATION
 A. B. CHANDLER MEDICAL CENTER

DATE: 11-27-14
 PART II
 WEST