


NOTES
 1. FC = FIELD CUT TO LENGTH
 2. AD = AIR DUCT
 3. ALL CURTS & STY ARE DOOR PATH 51005
 4. ALL DOORS ON EAST OR R.A. ARE NOTED
 5. BRANCH LINE

Field Copy	ARROW P/LOC
	MINI/LOC
	DATE 6-28-89
	AS BUILT 18

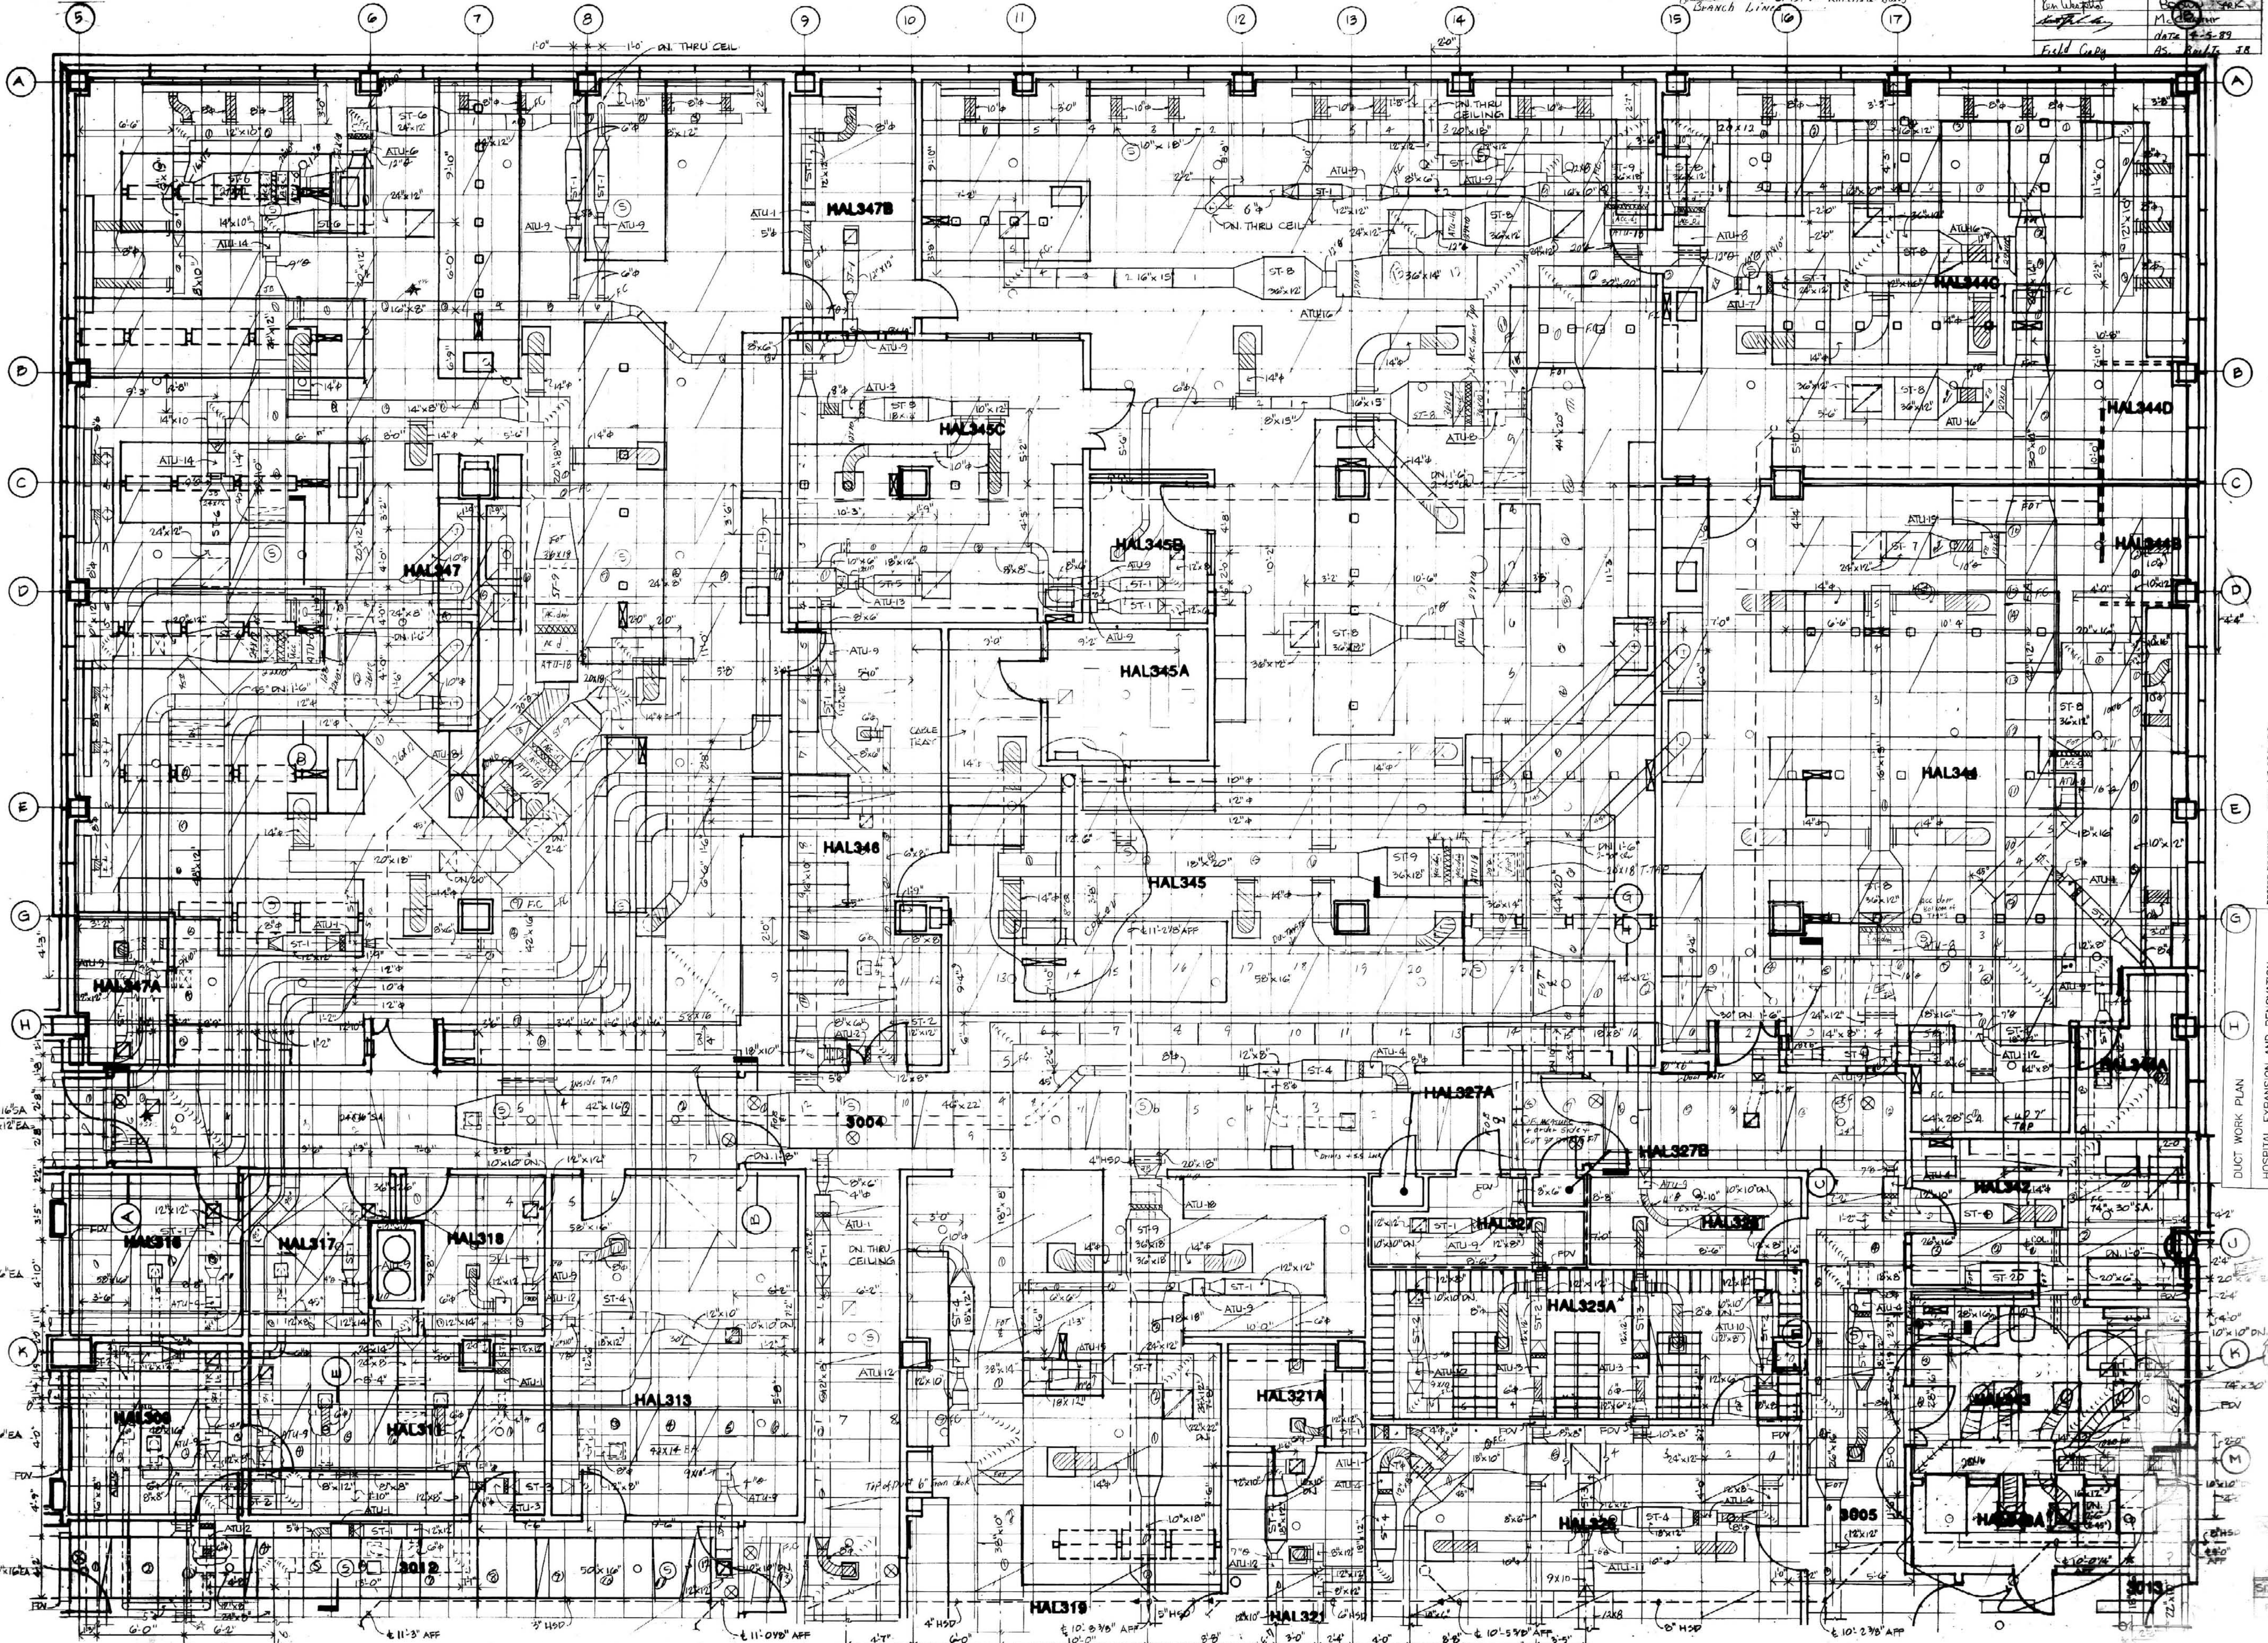

RECORD DRAWINGS DATE 12-22-73
 THESE DRAWINGS HAVE BEEN PREPARED BY THE ARCHITECT AND SHALL BE USED BY THE CONTRACTOR AS A GUIDE ONLY. THE CONTRACTOR SHALL BE RESPONSIBLE FOR ANY ERRORS OR OMISSIONS.
 STANCO & FISHER CONSULTING ENGINEERS, INC.
 11-1-89
 DUCT WORK PLAN
 HOSPITAL EXPANSION AND RENOVATION
 A. B. CHANDLER MEDICAL CENTER
 PROJECT NO. 304.1
 P/D PACKAGE #2