

RV PARKING
N.T.S.


NOTE:
RV PARKING STRIPE TO BE PAINTED FIRST THEN TYPICAL STALL PARKING TO BE PAINTED OVER RV STRIPES.

RV PARKING
99 SPACES

RECORD DRAWINGS

THESE RECORD DRAWINGS HAVE BEEN PREPARED BASED ON INFORMATION COMPILED AND FURNISHED BY OTHERS. THE ENGINEER HAS NOT VERIFIED THE ACCURACY AND/OR COMPLETENESS OF THIS INFORMATION AND SHALL NOT BE RESPONSIBLE FOR ANY ERRORS OR OMISSIONS WHICH MAY BE INCORPORATED HEREIN AS A RESULT.

DESIGNER	TFH	DATE	BY	REVISION
DRAWN	DJS			
CHECKED	?			
APPROVED	RLP			

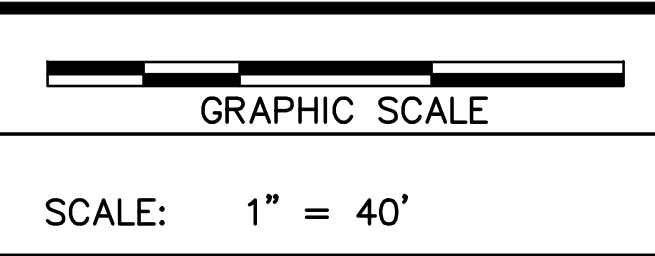

ALL RIGHTS RESERVED
THIS DOCUMENT IS THE PROPERTY OF BELL ENGINEERING AND SHALL NOT BE REPRODUCED IN WHOLE OR IN PART OR USED FOR CONSTRUCTION OF OTHER THAN THIS SPECIFIC PROJECT WITHOUT THE WRITTEN PERMISSION OF BELL ENGINEERING. FACSIMILES OF LICENSED PROFESSIONAL ENGINEER AND/OR LAND SURVEYOR SEALS, IF AFFIXED TO THIS DOCUMENT, SHALL BE CONSIDERED LEGITIMATE ONLY IF SIGNED AND DATED BY THE REGISTRANT.

Lexington, KY (859) 278-5412
Hopkinsville, KY (270) 886-5466

2422.0 SOUTH CAMPUS PARKING LOT EXPANSION
CAPITAL PROJECT MANAGEMENT DIVISION
UNIVERSITY OF KENTUCKY
LEXINGTON, KENTUCKY

RV PARKING LAYOUT PLAN

DIVISION	CIVIL
CONTRACT NO.	600-048
DATE	MAY, 2015
SHEET NO.	C3.2