

ROBOTICS FACILITY


PROJECT NO. 431.0

UNIVERSITY OF KENTUCKY

LEXINGTON, KENTUCKY

SHERMAN / CARTER / BARNHART SUITE 1900 LEXINGTON FINANCIAL CENTER 250 WEST MAIN STREET LEXINGTON, KENTUCKY 40507	ARCHITECT
MASON & HANGER ENGINEERING, INC 1500 WEST MAIN STREET LEXINGTON, KENTUCKY 40507	STRUCTURAL ENGINEER CIVIL ENGINEER
BELCAN CORPORATION 10200 ANDERSON WAY CINCINNATI, OHIO 45242	MECHANICAL ENGINEER ELECTRICAL ENGINEER
JAMES B. EVANS & ASSOCIATES 828 NORTH BROADWAY LEXINGTON, KENTUCKY 40507	LANDSCAPE ARCHITECT

AS BUILT

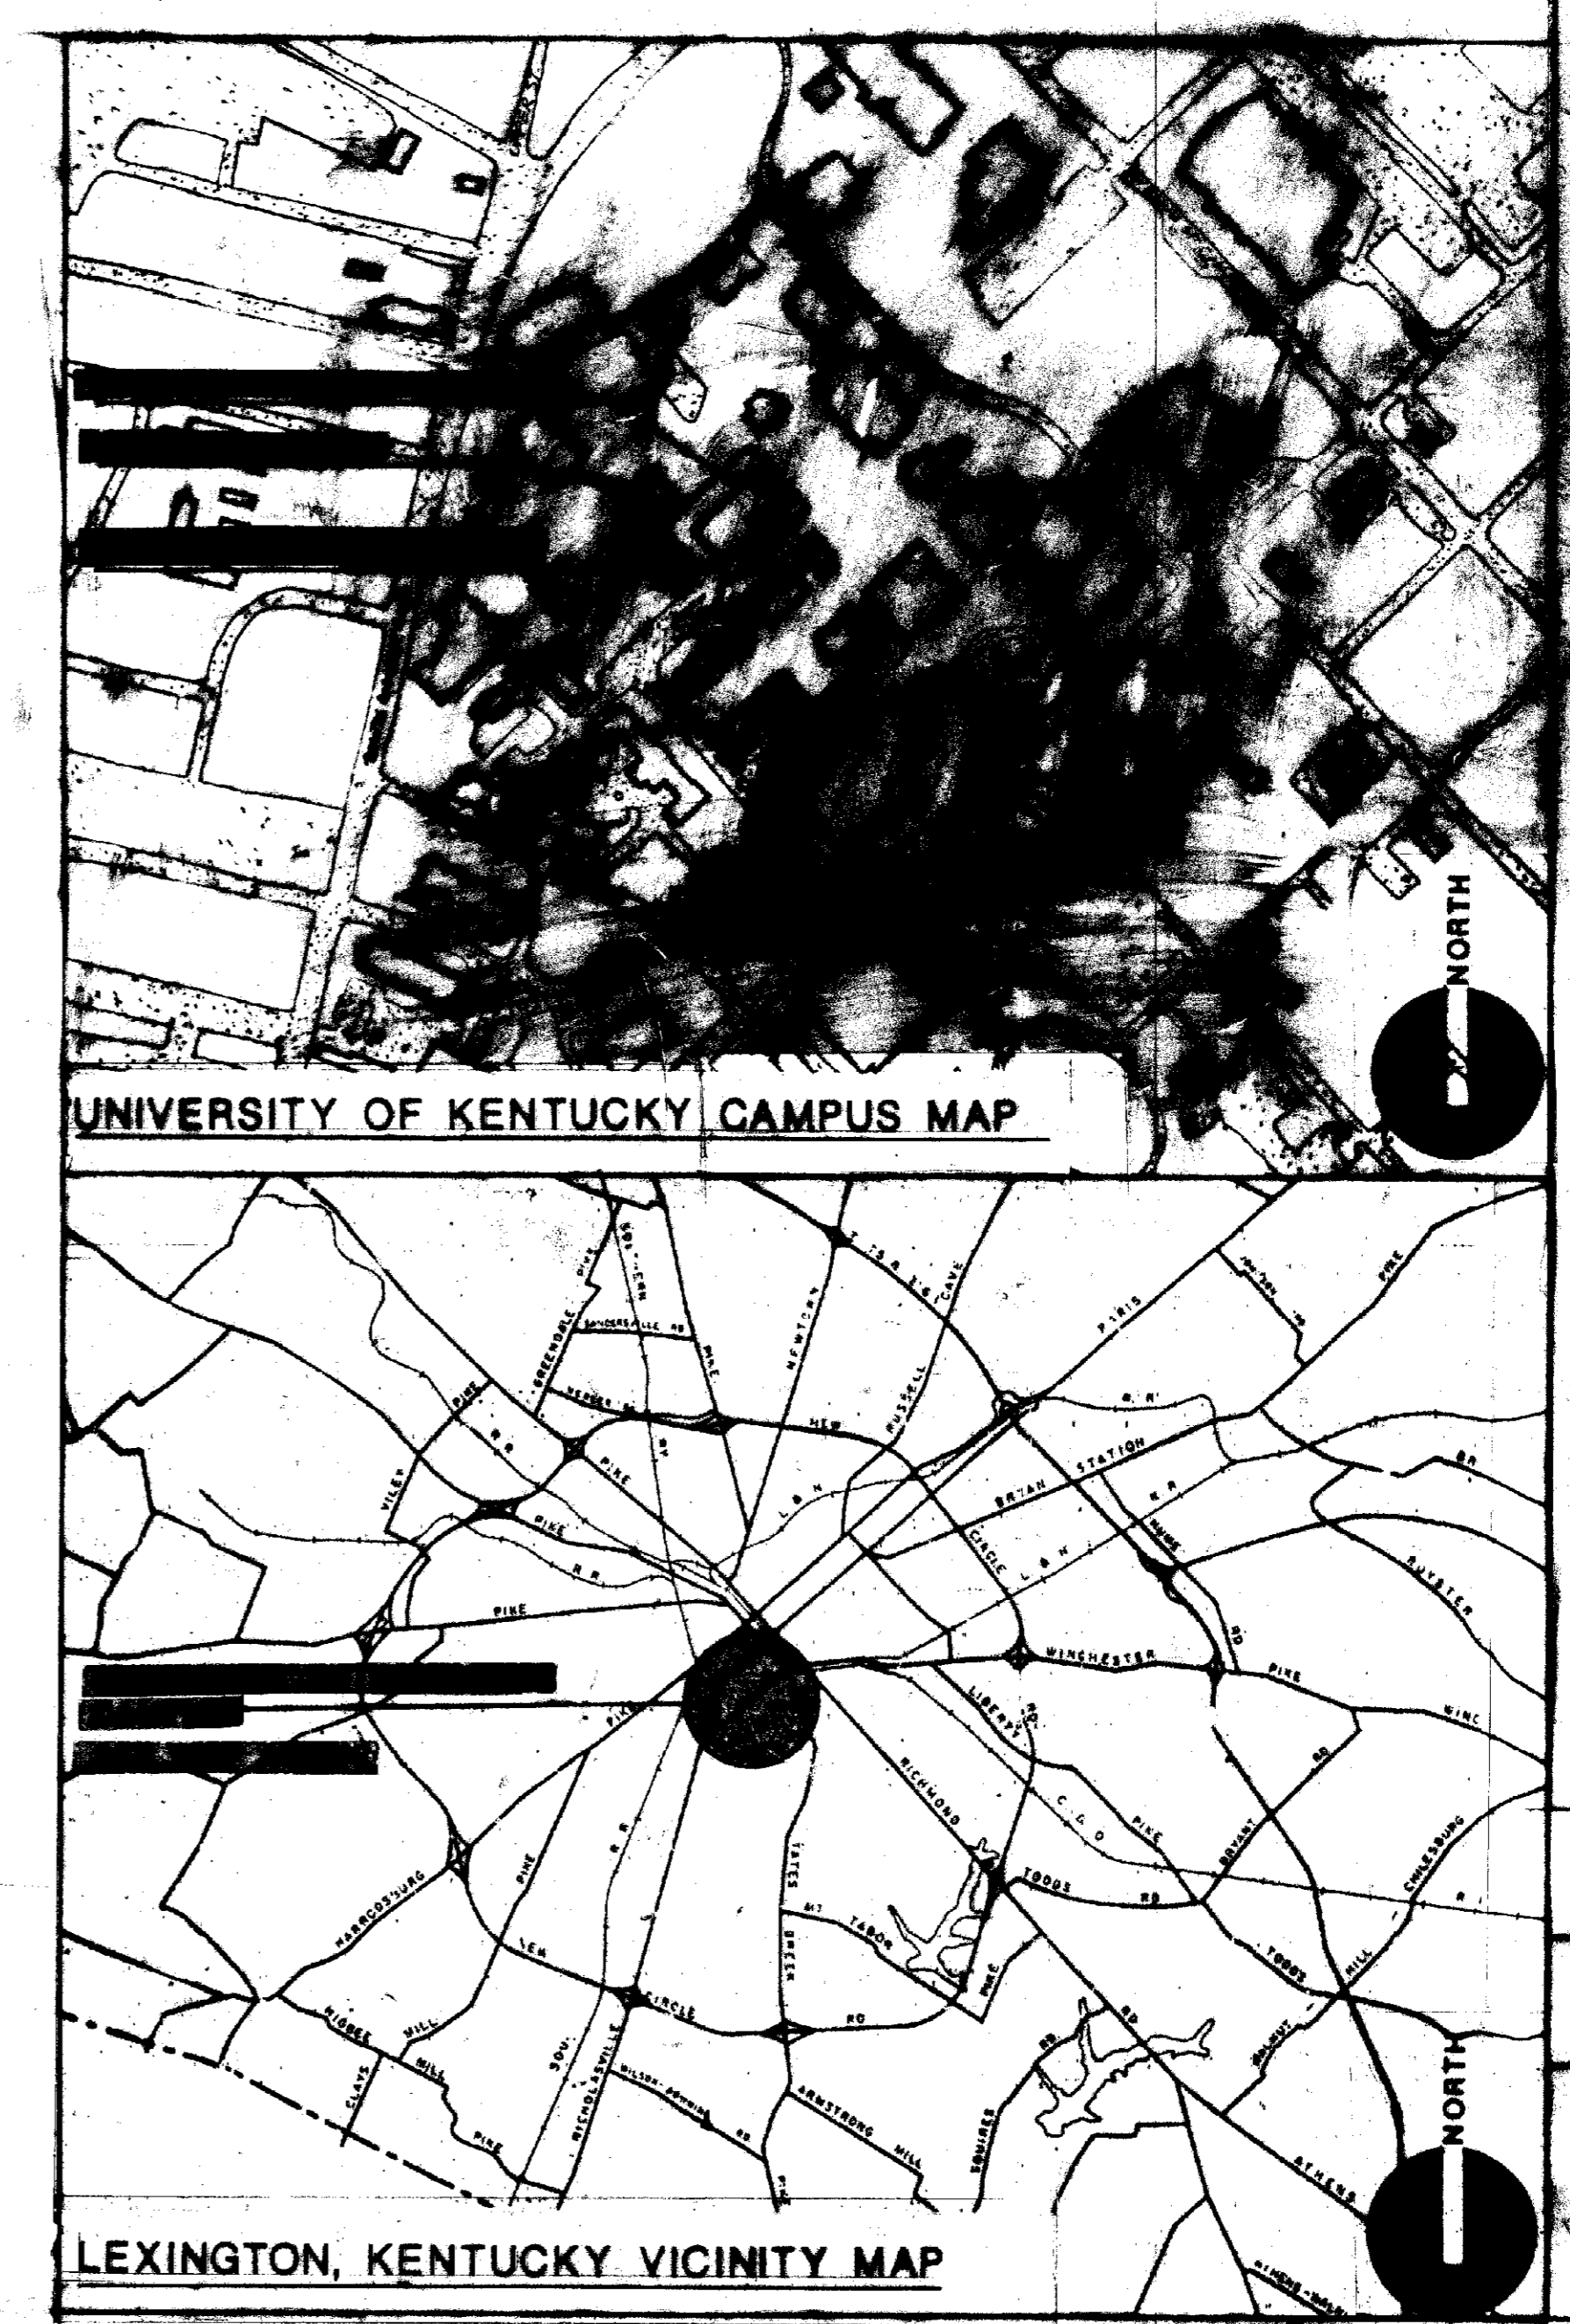

BUILDING FINISHES	
KENTUCKY BUILDING CODE	
COMPLIANCE WITH	
USE OF	
TECHNICAL SPECIFICATIONS	
GRAND TOTAL	575 SQ. FEET
BUILDING FINISHES	
• SMOKE	
• SPRINKLER	
• EMERGENCY LIGHTING WITH	
EMERGENCY GENERATOR	
• OCCUPANCY	575
FINISH "R" VALUES	
Built-up Roof	24.14
Terrace Roof	17.2
Masonry Walls (Type A & B)	11.2
Metal Panel Walls	13.08
Curtainwall A & B	13.64
Spandrels	1.8
Vision Glass	1.8
DATE	
PROJECT	
SET NO.	

Sheet
C-1
041882

CIVIL

- C-1 SYMBOLS & LEGEND
- C-2 TOPOGRAPHIC SURVEY
- C-3 DEMOLITION PLAN
- C-4 LAYOUT PLAN
- C-5 GRADING PLAN
- C-6 BUILDING CROSS-SECTIONS
- C-7 SECTIONS & DETAILS
- C-8 SECTIONS & DETAILS
- C-9 EXTERIOR UTILITY PLAN
- C-10 SANITARY & STORM PROFILES
- C-11 CHILLED WATER DETAILS
- C-12 STEAM DETAILS
- C-13 CHILLED WATER & STEAM DETAILS
- C-14 POWER & COMMUNICATION
- C-15 POWER & COMMUNICATION
- C-16 COMMUNICATION DETAILS
- C-17 BORING LAYOUT
- C-18 LOGS OF BORINGS
- C-19 LOGS OF BORINGS
- C-20 LOGS OF BORINGS
- C-21 LOGS OF BORING

LANDSCAPING

- L-1 LANDSCAPING PLAN
- L-2 LANDSCAPING PLAN

STRUCTURAL

- S-1 FOUNDATION PLAN
- S-1A BASEMENT FLOOR PLAN
- S-2 FIRST FLOOR FRAMING PLAN
- S-3 SECOND FLOOR FRAMING PLAN
- S-4 THIRD FLOOR FRAMING PLAN
- S-5 FOURTH FLOOR FRAMING PLAN
- S-6 FIFTH FLOOR FRAMING PLAN
- S-7 ROOF FRAMING PLAN
- S-8 FOUNDATION & COLUMN SCHEDULE
- S-9 BEAM SCHEDULE
- S-10 BEAM SCHEDULE
- S-11 GIRDER SCHEDULE
- S-12 FOUNDATION DETAILS
- S-13 FOUNDATION DETAILS
- S-14 FOUNDATION DETAILS
- S-15 FOUNDATION DETAILS
- S-16 SECTIONS & DETAILS
- S-17 SECTIONS & DETAILS
- S-18 SECTIONS & DETAILS
- S-19 SECTIONS & DETAILS
- S-20 SECTIONS & DETAILS
- S-21 SECTIONS & DETAILS
- S-22 SECTIONS & DETAILS
- S-23 SECTIONS & DETAILS

ARCHITECTURAL

- A-1 BASEMENT FLOOR PLAN
- A-2 FIRST FLOOR PLAN
- A-3 SECOND FLOOR PLAN
- A-4 THIRD FLOOR PLAN
- A-5 FOURTH FLOOR PLAN
- A-6 FIFTH FLOOR PLAN
- A-7 PENTHOUSE & ROOF PLANS
- A-7A SECTION & DETAILS
- A-8 BUILDING SECTION
- A-9 BUILDING SECTION
- A-10 BUILDING SECTION
- A-11 BUILDING SECTIONS
- A-12 BUILDING SECTION
- A-13 SOUTH ELEVATION
- A-14 WEST ELEVATION
- A-15 NORTH ELEVATION
- A-16 EAST ELEVATION
- A-17 WALL SECTIONS & DETAILS
- A-18 WALL SECTIONS & DETAILS
- A-19 WALL SECTIONS & DETAILS
- A-20 WALL SECTIONS & DETAILS
- A-21 WALL SECTION & DETAILS
- A-21A DETAILS
- A-22 DOCK SECTION & DETAILS
- A-23 PARTITION SCHEDULE & DETAILS
- A-24 ENLARGED STAIR PLANS & DETAILS
- A-25 ENLARGED PLANS & DETAILS
- A-26 ENLARGED PLANS & DETAILS
- A-27 TOILET ELEVATIONS & ENLARGED PLAN
- A-28 ENLARGED PLANS & DETAILS
- A-29 DETAILS
- A-30 CASEWORK ELEVATIONS & DETAILS
- A-31 ROOM FINISH SCHEDULE
- A-32 ROOM FINISH SCHEDULE
- A-33 DOOR & FRAME SCHEDULE
- A-34 DOOR & FRAME ELEVATIONS & DETAILS
- A-34A DETAILS
- A-35 WINDOW ELEVATIONS & DETAILS
- A-36 WINDOW ELEVATIONS & DETAILS
- A-37 SECTIONS & DETAILS
- A-38 PEDWAY & DETAILS
- A-39 SECTIONS & DETAILS
- A-40 BASEMENT REFL. CEIL. PLAN
- A-41 FIRST FLOOR REFL. CEIL. PLAN
- A-42 SECOND FLOOR REFL. CEIL. PLAN
- A-43 THIRD FLOOR REFL. CEIL. PLAN
- A-44 FOURTH FLOOR REFL. CEIL. PLAN
- A-45 FIFTH FLOOR REFL. CEIL. PLAN

MECHANICAL

- M-1 LEGEND
- M-2 BASEMENT HVAC PLAN
- M-3 FIRST FLOOR HVAC PLAN
- M-4 SECOND FLOOR HVAC PLAN
- M-5 THIRD FLOOR HVAC PLAN
- M-6 FOURTH FLOOR HVAC PLAN
- M-7 FIFTH FLOOR HVAC PLAN
- M-8 PENTHOUSE/ROOF HVAC PLAN
- M-9 PART. PLANS HVAC & PIPING
- M-10 PART. PLANS HVAC & PIPING
- M-11 MECHANICAL DETAILS
- M-12 MECHANICAL DETAILS
- M-13 TEMPERATURE CONTROLS
- M-14 BASEMENT PLUMB. & PIPING PLAN
- M-15 FIRST FLOOR PLUMB. & PIPING PLAN
- M-16 SECOND FLOOR PLUMB. & PIPING PLAN
- M-17 THIRD FLOOR PLUMB. & PIPING PLAN
- M-18 FOURTH FLOOR PLUMB. & PIPING PLAN
- M-19 FIFTH FLOOR PLUMB. & PIPING PLAN
- M-20 PENTHOUSE/ROOF PLUMB. & PIPING PLAN
- M-21 SANITARY ISOMETRIC
- M-22 DOMESTIC WATER ISOMETRIC
- M-23 DETAIL
- M-24 BASEMENT FIRE PROTECTION
- M-25 FIRST FLOOR FIRE PROTECTION
- M-26 SECOND FLOOR FIRE PROTECTION
- M-27 THIRD FLOOR FIRE PROTECTION
- M-28 FOURTH FLOOR FIRE PROTECTION
- M-29 FIFTH FLOOR FIRE PROTECTION
- M-30 PENTHOUSE/ROOF FIRE PROTECTION
- M-31 SCHEDULES
- M-32 SCHEDULES
- M-33 SCHEDULES
- M-34 SCHEDULES
- M-35 SCHEDULES

ELECTRICAL

- E-1 BASEMENT FLOOR LIGHTING PLAN
- E-2 BASEMENT FLOOR POWER PLAN
- E-3 FIRST FLOOR LIGHTING PLAN
- E-4 FIRST FLOOR POWER PLAN
- E-5 SECOND FLOOR LIGHTING PLAN
- E-6 SECOND FLOOR POWER PLAN
- E-7 THIRD FLOOR LIGHTING PLAN
- E-8 THIRD FLOOR POWER PLAN
- E-9 FOURTH FLOOR LIGHTING PLAN
- E-10 FOURTH FLOOR POWER PLAN
- E-11 FIFTH FLOOR LIGHTING PLAN
- E-12 FIFTH FLOOR POWER PLAN
- E-13 PENTHOUSE LIGHTING PLAN
- E-14 PENTHOUSE POWER PLAN
- E-15 ELECTRICAL CLOSETS PLAN
- E-16 I.T.V. ROOM'S PLAN
- E-17 ELECTRICAL DETAILS
- E-18 GROUND RISER DIAGRAM
- E-19 FIRE ALARM RISER DIAGRAM
- E-20 ELECTRICAL DETAILS
- E-21 ELECTRICAL DRAWING NOTES
- E-22 LUMINAIRE SCHEDULE & SYMBOLS
- E-23 SINGLE LINE DIAGRAM
- E-24 M.C.C. RISERS & DIAGRAMS
- E-25 M.C.C. RISERS & DIAGRAMS
- E-26 PANEL SCHEDULES
- E-27 PANEL SCHEDULES
- E-28 PANEL SCHEDULES
- E-29 TELEPHONE RENOVATION, ANDERSON HALL
- E-30 PANEL SCHEDULES
- E-18A LIGHTNING PROTECTION
- E-18B LIGHTNING PROTECTION
- E-31 RELOC SYSTEM 820 LEGEND
- E-5R RELOC 2ND FLOOR
- E-7R RELOC 3RD FLOOR
- E-9R RELOC 4TH FLOOR
- E-11R RELOC 5TH FLOOR
- 1251 I FIRE ALARM
- 1251 A FIRE ALARM
- 1251 B FIRE ALARM
- 1251 C FIRE ALARM
- 1251 D FIRE ALARM
- 1251 E FIRE ALARM
- 1251 F FIRE ALARM
- 1251 G FIRE ALARM
- 1251 H FIRE ALARM

ROBOTICS FACILITY
LEXINGTON CAMPUS
UNIVERSITY OF KENTUCKY
LEXINGTON, KENTUCKY

University of Kentucky
Lexington, Kentucky

INDEX TO DRAWINGS
Sherman Carter Barnhart
PARTNERS IN ARCHITECTURE
LEXINGTON FINANCIAL CENTER - SUITE 1900 - 250 W. MAIN - LEXINGTON, KY 40507 - 606-254-1351

JOB NO. 1700
DATE 10-4-87
DRAWN
CHECKED
FILE NO. 431.0

REVISIONS

SHEET
T2

AS BUILT
3-1-91

SYMBOLS & LEGEND

CIVIL/STRUCTURAL

EXISTING	NEW		EXISTING	NEW	
		BUILDING			HIGH PRESSURE STEAM
		WATER			PUMP DISCHARGE RETURN
		FIRE HYDRANT			CHILLED WATER SUPPLY
		VALVE			CHILLED WATER RETURN
		FIRE WATER			GAS
		DOMESTIC WATER			GATE, FLANGED
		SANITARY SEWER			AIR ELIMINATOR
		STORM DRAIN			ANCHOR
		MANHOLE			EXPANSION LOOP
		CLEANOUT			FIRE DEPARTMENT CONNECTION
	T.E. 1016	TOP ELEVATION			CAP
	INV 1016	INVERT ELEVATION			ELBOW
	578.3	SPOT ELEVATION			ELBOW, TURNED UP
		BENCH MARK			ELBOW, TURNED DOWN
		CONTROL MONUMENT			REDUCER, CONCENTRIC
		CONSTRUCTION BARRICADE			TEE
		TEMPORARY CONSTRUCTION BARRICADE			UNDERGROUND COMMUNICATIONS DUCT
		TREE			UNDERGROUND TELEPHONE CONDUIT
		DROP INLET			UNDERGROUND ELECTRICAL PRIMARY
		POLE LIGHT			UNDERGROUND ELECTRICAL
		BRICK OR EXISTING MASONRY			UTILITY MARKER
		CONCRETE			SWITCH/FUSE
		CAPILLARY WATER BARRIER (DRAINAGE FILL)			CIRCUIT BREAKER
		EARTH			DRIVEN GROUND ROD
		ROCK			ELECTRICAL MANHOLE NUMBER U-81

ABBREVIATIONS

'	INCH	HORIZ.	HORIZONTAL
#	NUMBER, POUND	IN.	INCH
AT	AT	JT.	JOINT
ALUM. ARCH.	ALUMINUM ARCHITECTURAL	L	ANGLE LONG
BLDG. BM.	BUILDING BEAM	LG.	LONG
B.O.FTG.	BOTTOM OF FOOTING	MAT'L MIN.	MATERIAL MINIMUM
BRG.	BEARING	NO.	NUMBER
B.S.	BRICK SEAT	PL	PLATE
CL.	CENTERLINE	R.	RADIUS
CLR., CL.	CLEAR COLUMN	RAD.	RADIUS
COL.	COLUMNS	REINF.	REINFORCING
COL'S	COLUMNS	SCHED. SHT.	SCHEDULE SHEET
CONC.	CONCRETE	SIM.	SIMILAR
CONT. CONST.	CONTINUOUS CONSTRUCTION	SPA.	SPACE(S)
DIA.	DIAMETER	SQ.	SQUARE
DIM.	DIMENSION	STL.	STEEL
E.A.	EACH	T.C.	TOP OF CONCRETE
E.A.F.	EACH FACE	TEMP.	TEMPERATURE
ELEV.	ELEVATION	TYP.	TYPICAL
ELEV.	ELEVATION	W.W.F.	WELD WIRE FABRIC WITH
EXIST.	EXISTING		
EXP.	EXPANSION		
EXPL.	EXPLOSION		
F.F.	BOTTOM OF FOOTING ELEVATION		
FIN.	FINISH		
F.L.	FLOOR		
FLEX.	FLEXIBLE		
FT.	FEET		
FTG.	FOOTING		
F.V.	FIELD VERIFY		

ABBREVIATIONS & SYMBOLS SHOWN ARE STANDARDS AND INCLUDE THOSE USED ON THIS PROJECT. NOT ALL ABBREVIATIONS & SYMBOLS SHOWN ARE USED ON THIS PROJECT.

GENERAL NOTES

THE CONTRACT DRAWINGS SHOW THE APPROXIMATE LOCATION OF EXISTING AND NEW SUBSURFACE UTILITY LINES. THESE LINES HAVE BEEN IDENTIFIED AND LOCATED AS ACCURATELY AS POSSIBLE USING AVAILABLE INFORMATION; THE CONTRACTOR IS RESPONSIBLE FOR VERIFYING ALL ACTUAL LOCATIONS. IF ANY CHARTED, UNCHARTED OR MISLOCATED UTILITY SERVICE IS INTERRUPTED FOR ANY REASON, THE CONTRACTOR WILL WORK CONTINUOUSLY TO RESTORE SERVICE TO THE SATISFACTION OF THE OWNER AT NO ADDITIONAL COST TO THE OWNER.

SHOULD THE UTILITIES REQUIRE RELOCATION OR REROUTING NOT SHOWN OR INDICATED TO BE RELOCATED OR REROUTED, CONTACT AND COOPERATE WITH THE OWNER TO MAKE THE REQUIRED ADJUSTMENTS AT AN EQUITABLE CHANGE IN THE CONTRACT PRICE.

UTILITY MARKERS: THE CONTRACTOR SHALL FURNISH AND INSTALL UTILITY MARKERS FOR ALL BURIED PIPE LINES AND DUCT BANKS AT EACH BUILDING ENTRANCE, AT EACH BEND, AND AT EACH ROAD CROSSING. THE MARKERS SHALL BE FABRICATED AND INSTALLED AS SHOWN ON SHEET C-12. THE EXACT WORDING ON THE BRASS PLATE SHALL BE COORDINATED WITH THE ENGINEER BEFORE FABRICATION.

CONTRACTOR SHALL MAINTAIN FIRE TRUCK ACCESS WEST OF MOVEY HALL TO THE JOURNALISM, OLD MINING LAB, AND THE QUADRANGLE BUILDINGS AT ALL TIMES.

RECORD PRINTS
THESE ARE RECORDS OF DRAWINGS BASED UPON MARKET SURVEYS, PLANS AND OTHER DATA FURNISHED TO THE ENGINEER AND WHICH THE ENGINEER CONSIDERS SIGNIFICANT

ROBOTICS FACILITY
LEXINGTON CAMPUS
UNIVERSITY OF KENTUCKY
LEXINGTON, KENTUCKY

University of Kentucky
Lexington, Kentucky

10-19-87

SYMBOLS & LEGEND

Sherman Carter Barnhart
PARTNERS IN ARCHITECTURE
SUITE 1000 • 750 WEST MAIN STREET • LEXINGTON, KY 40501 • 506-754-1331

JOB NO. 2046
DATE 10-19-87
DRAWN DAH
CHECKED TOA
FILE NO. 431.0



REVISIONS

SHEET

C-1

MASON & HANGER ENGINEERING INC.
ARCHITECT - ENGINEERS
LEXINGTON, KENTUCKY

Storm M.H. #1 T/R-360.75 Inv. 8"-358.2 Inv. 12"-358.0 Inv. 15"-352.4	Storm M.H. #2 T/R-364.56 Inv. 12"-363.8 Inv. 24"-351.1	Storm M.H. #3 T/R-366.91 Inv. 24"-359.4	Storm M.H. #4 T/R-368.39 Inv. 12"-358.9 Inv. 24"-355.1 Inv. 24"-352.3	Storm M.H. #5 T/R-360.61 Inv. 24"-349.2 Inv. 8"-357.8	Storm M.H. #6 T/R-363.03 Inv. 24"-349.8	Storm M.H. #7 T/R-365.38 Inv. 8"-360.8
San. M.H. #1 T/R-363.38 Inv. 8"-356.4	San. M.H. #2 T/R-364.76 Inv. 8"-354.9	San. M.H. #3 T/R-360.64 Inv. 8"-350.5	San. M.H. #4 T/R-364.98 Inv. 8"-359.2	San. M.H. #5 T/R-364.92 Inv. 8"-349.5	San. M.H. #6 T/R-363.67 Inv. 8"-351.2	

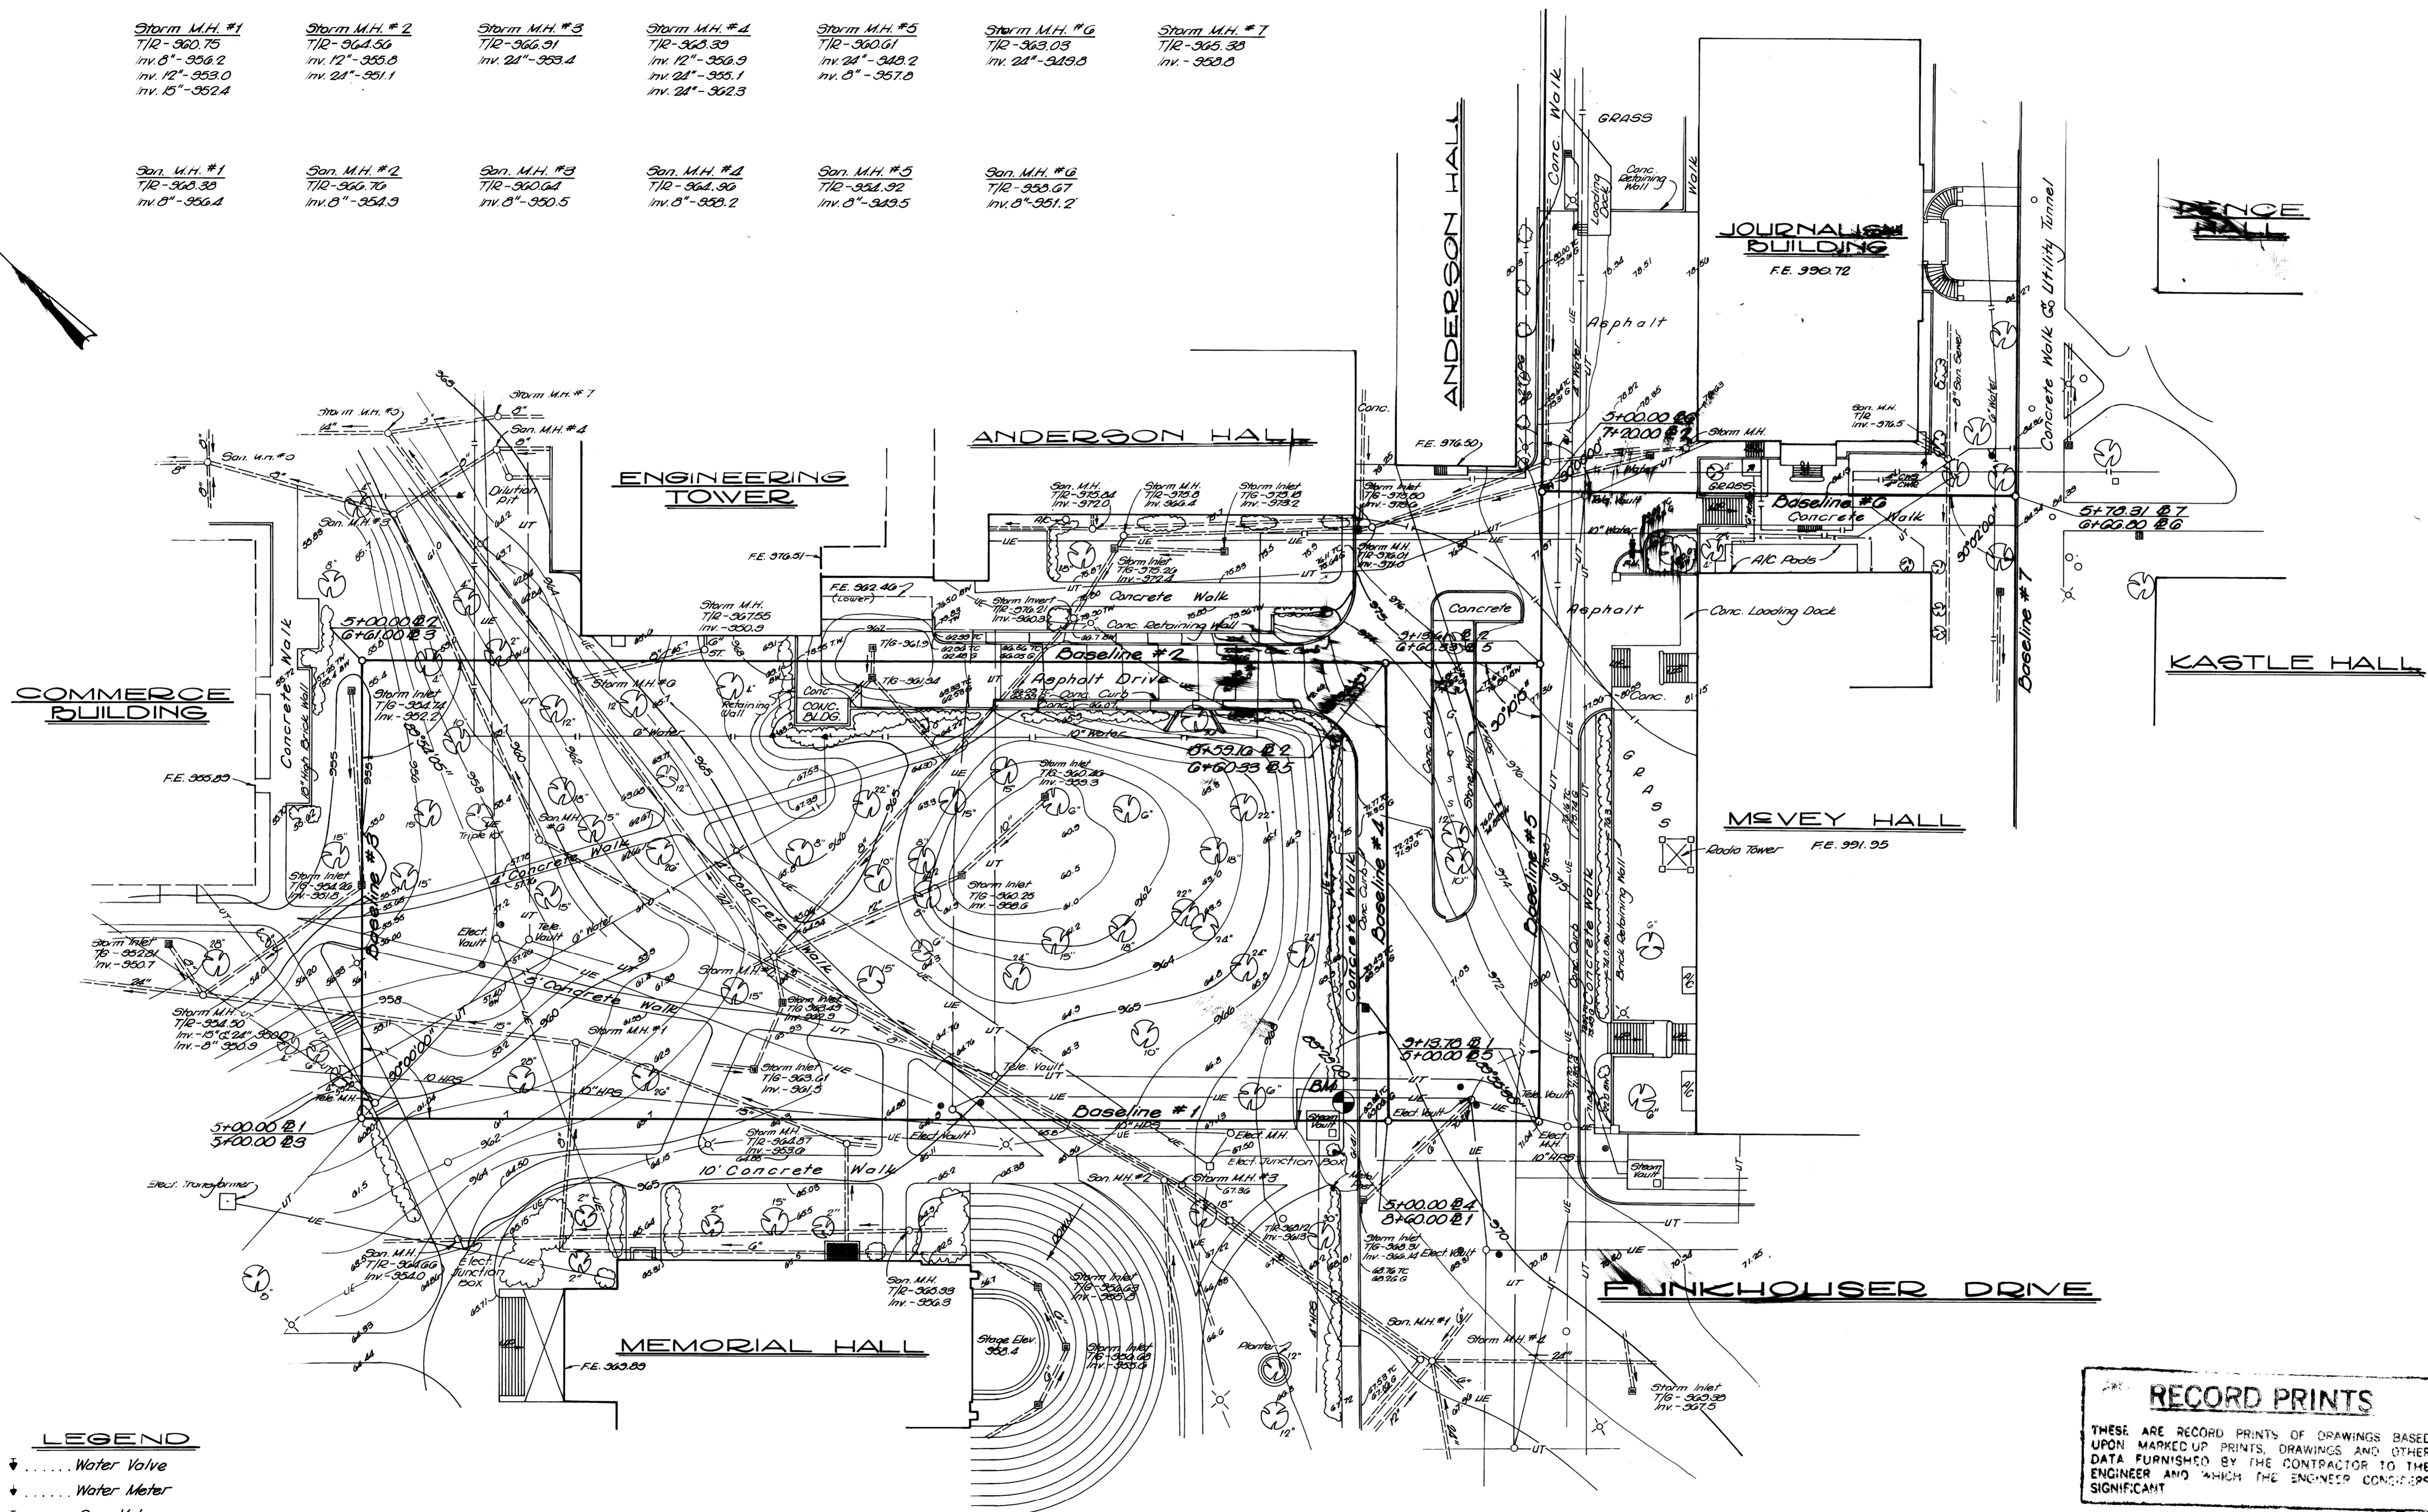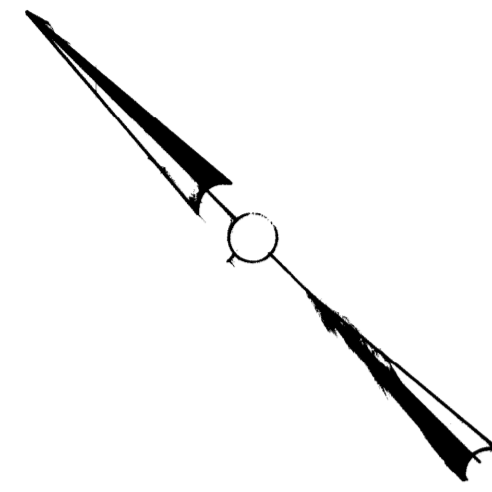

- LEGEND**
- ⊕ Water Valve
 - ⊕ Water Meter
 - ⊕ Gas Valve
 - ⊕ Gas Meter
 - ⊕ Light Pole
 - ⊕ Fire Hydrant
 - ⊕ Storm Water Inlet
 - ⊕ Vault Vents

BM - Chisled Square N.E. Corner of
Steam Vault Elev. 971.28'

Elevation Datum is Based on a U.S.C. & G.S.
Standard Benchmark, located in front of
The U.K. Administration Building and Having
an Elevation of 975.008

RECORD PRINTS
THESE ARE RECORD PRINTS OF DRAWINGS BASED
UPON MARKED UP PRINTS, DRAWINGS AND OTHER
DATA FURNISHED BY THE CONTRACTOR TO THE
ENGINEER AND WHICH THE ENGINEER CONSIDERS
SIGNIFICANT



TOPOGRAPHIC SURVEY
BY:
WITT & ASSOCIATES, INC. - LEXINGTON, KY.
AUGUST 1987 1" = 30'

ROBOTICS FACILITY
LEXINGTON CAMPUS
UNIVERSITY OF KENTUCKY
LEXINGTON, KENTUCKY


University of Kentucky
Lexington, Kentucky
10.19.87
Wesley B. Witt
REGISTERED LAND SURVEYOR

Sherman Carter Barnhart
PARTNERS IN ARCHITECTURE
SUITE 1900 • 750 WEST MAIN STREET • LEXINGTON, KY 40507 • 606-254-1951

JOB NO.	8708
DATE	
DRAWN	
CHECKED	CEB
FILE NO.	431.0

REVISIONS

SHEET	

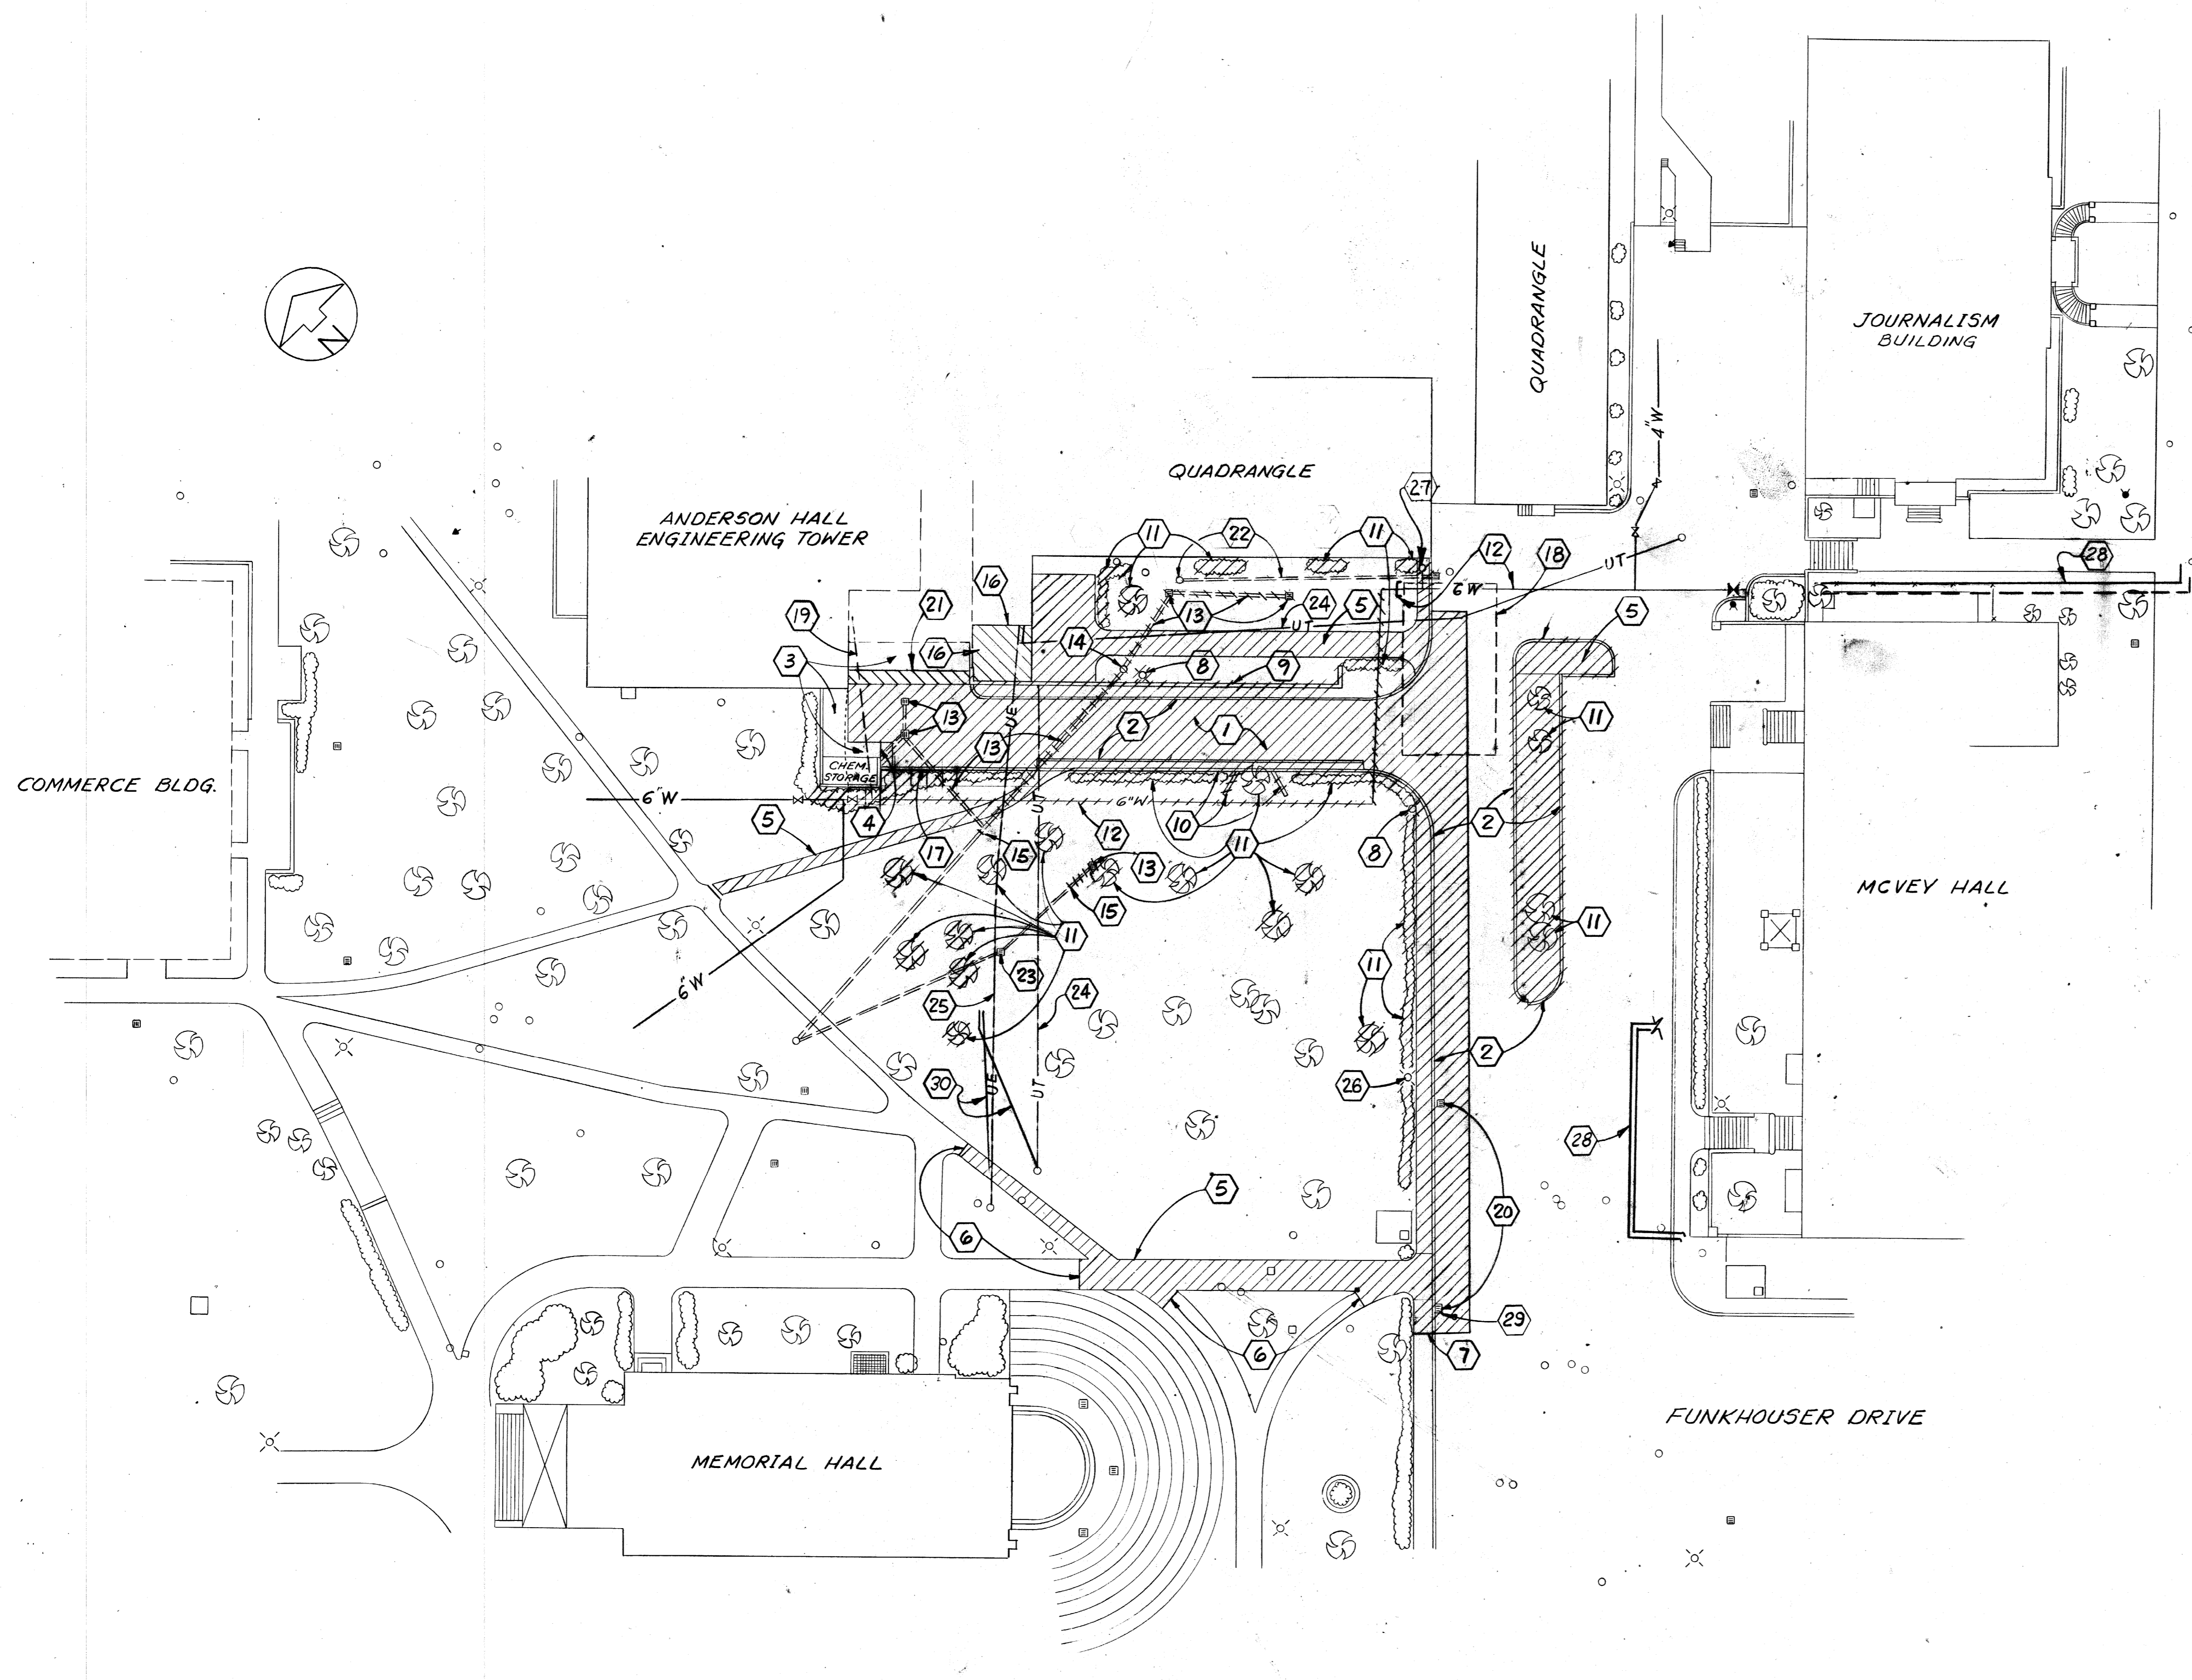

- DEMOLITION NOTES**
1. REMOVE BITUMINOUS ASPHALT PAVEMENT AND BASE.
 2. REMOVE CURB AND GUTTER.
 3. EXISTING CONCRETE SLAB TO REMAIN.
 4. SAWCUT CONCRETE PAVEMENT FLUSH WITH FACE OF CHEMICAL STORAGE BUILDING AND REMOVE THIS SECTION OF CONCRETE SLAB AND ONE GUARD POST.
 5. REMOVE CONCRETE SIDEWALK.
 6. SAWCUT EXISTING CONCRETE SIDEWALK, FULL DEPTH, OR REMOVE BACK TO FIRST EXPANSION JOINT.
 7. SAWCUT EXISTING CONCRETE SIDEWALK AND CURB.
 8. REMOVE CONCRETE LIGHTPOLE AND FOUNDATION. TURN LIGHT POLE OVER TO OWNER.
 9. REMOVE RETAINING WALL AND FOUNDATION.
 10. REMOVE CONCRETE WALL AND FOUNDATION.
 11. REMOVE TREES AND SHRUBS AS SHOWN.
 12. CAP EXISTING 6 INCH WATER LINE WEST OF WATER METER SERVICE LINE TO QUADRANGLE. BETWEEN THIS POINT AND EXISTING VALVE SOUTH OF CHEMICAL STORAGE BUILDING, REMOVE EXISTING WATER LINE AS REQUIRED FOR NEW CONSTRUCTION.
 13. REMOVE STORM SEWER AND INLETS AS REQUIRED FOR BUILDING CONSTRUCTION.
 14. REMOVE STORM SEWER MANHOLE.
 15. SAWCUT EXISTING STORM SEWER, PLUG END WITH 2 FEET OF CONCRETE AND ABANDON.
 16. REMOVE EXISTING CONCRETE SLAB AND WALLS, SEE STRUCTURAL DRAWINGS FOR DIMENSIONS.
 17. REMOVE GROUNDING MAT FOR ENGINEERING TOWER, AFTER NEW MAT HAS BEEN INSTALLED. SEE SHEET C-9.
 18. POSSIBLE BELOW GRADE AUTO SHOP FOUNDATION, REMOVE IF ENCOUNTERED.
 19. ABANDONED 6 INCH WATER LINE, REMOVE IF ENCOUNTERED.
 20. REMOVE CURB BOX INLET, LEAVE PIPE UNDAMAGED FOR FUTURE CONNECTION. SEE SHEET C-4 FOR CONTINUATION.
 21. SAWCUT AND REMOVE 5 FT. OF CONCRETE SLAB. FINISHED EDGE TO ALIGN WITH CONCRETE OVERHANG ABOVE.
 22. MANHOLE AND STORM SEWER TO REMAIN.
 23. REMOVE EXISTING CATCH BASIN A MINIMUM 1'-FOOT BELOW GRADE. SEAL STORM SEWER AS IN 15. COVER WITH EARTH.
 24. EXISTING TELEPHONE - MAINTAIN DUCTBANK UNTIL NEW DUCTBANK IS INSTALLED WITH CABLE. COORDINATE WITH OWNER AND ABANDON DUCTBANK WHEN ALL RELOCATION OF CABLES HAS BEEN COMPLETED. CABLE WILL BE CHANGED OUT AS SOON AS POSSIBLE AFTER NEW CONDUIT IS INSTALLED. NO CABLE WILL BE CHANGED OUT BETWEEN CHRISTMAS AND NEW YEARS.
 25. EXISTING PRIMARY 12.47 KV ELECTRIC DUCTBANK - MAINTAIN DUCTBANK UNTIL NEW DUCTBANK IS INSTALLED AND ANDERSON HALL ENERGIZED FROM NEW INSTALLATION. COORDINATE OUTAGES, ETC., WITH OWNER AND ABANDON DUCTBANK WHEN NEW IS COMPLETELY INSTALLED AND ENERGIZED.
 26. REMOVE EXISTING POLE LIGHT AND FOUNDATION. TURN LIGHT POLE OVER TO OWNER. VERIFY CIRCUITRY; AND IF CIRCUIT EXTENDS BEYOND THIS POINT, REFEED FROM SOURCE BY SAME SIZE WIRE AND CONDUIT.
 27. EXISTING WATER METER MANHOLE TO REMAIN.
 28. FOR DEMOLITION ASSOCIATED WITH CHILLED WATER OR STEAM PIPELINE CONSTRUCTION, SEE SHEETS C-11 THRU C-13.
 29. EXISTING STEAM VENT, LEAVE UNDISTURBED FOR FUTURE CONNECTION.
 30. FOR DEMOLITION ASSOCIATED WITH ELECTRIC POWER AND COMMUNICATION DUCTBANK CONSTRUCTION, SEE SHEETS C-14 THRU C-16.

DEMOLITION PLAN
SCALE: 1"=30'

RECORD PRINTS
THESE ARE RECORD PRINTS OF DRAWINGS BASED UPON MARKED UP PRINTS, DRAWINGS AND OTHER DATA FURNISHED BY THE CONTRACTOR TO THE ENGINEER AND WHICH THE ENGINEER CONSIDERS SIGNIFICANT



ROBOTICS FACILITY
LEXINGTON CAMPUS
UNIVERSITY OF KENTUCKY
LEXINGTON, KENTUCKY


University of Kentucky
Lexington, Kentucky
10-19-87
W. MASON & HANGER
ARCHITECT • ENGINEERS

DEMOLITION PLAN
Sherman Carter Barnhart
PARTNERS IN ARCHITECTURE
SUITE 1000 • 250 WEST MAIN STREET • LEXINGTON, KY 40501 • 502.254.1350

JOB NO. 2046
DATE 10-19-87
DRAWN PG
CHECKED TOA
FILE NO. 431.0



REVISIONS

SHEET
C-3

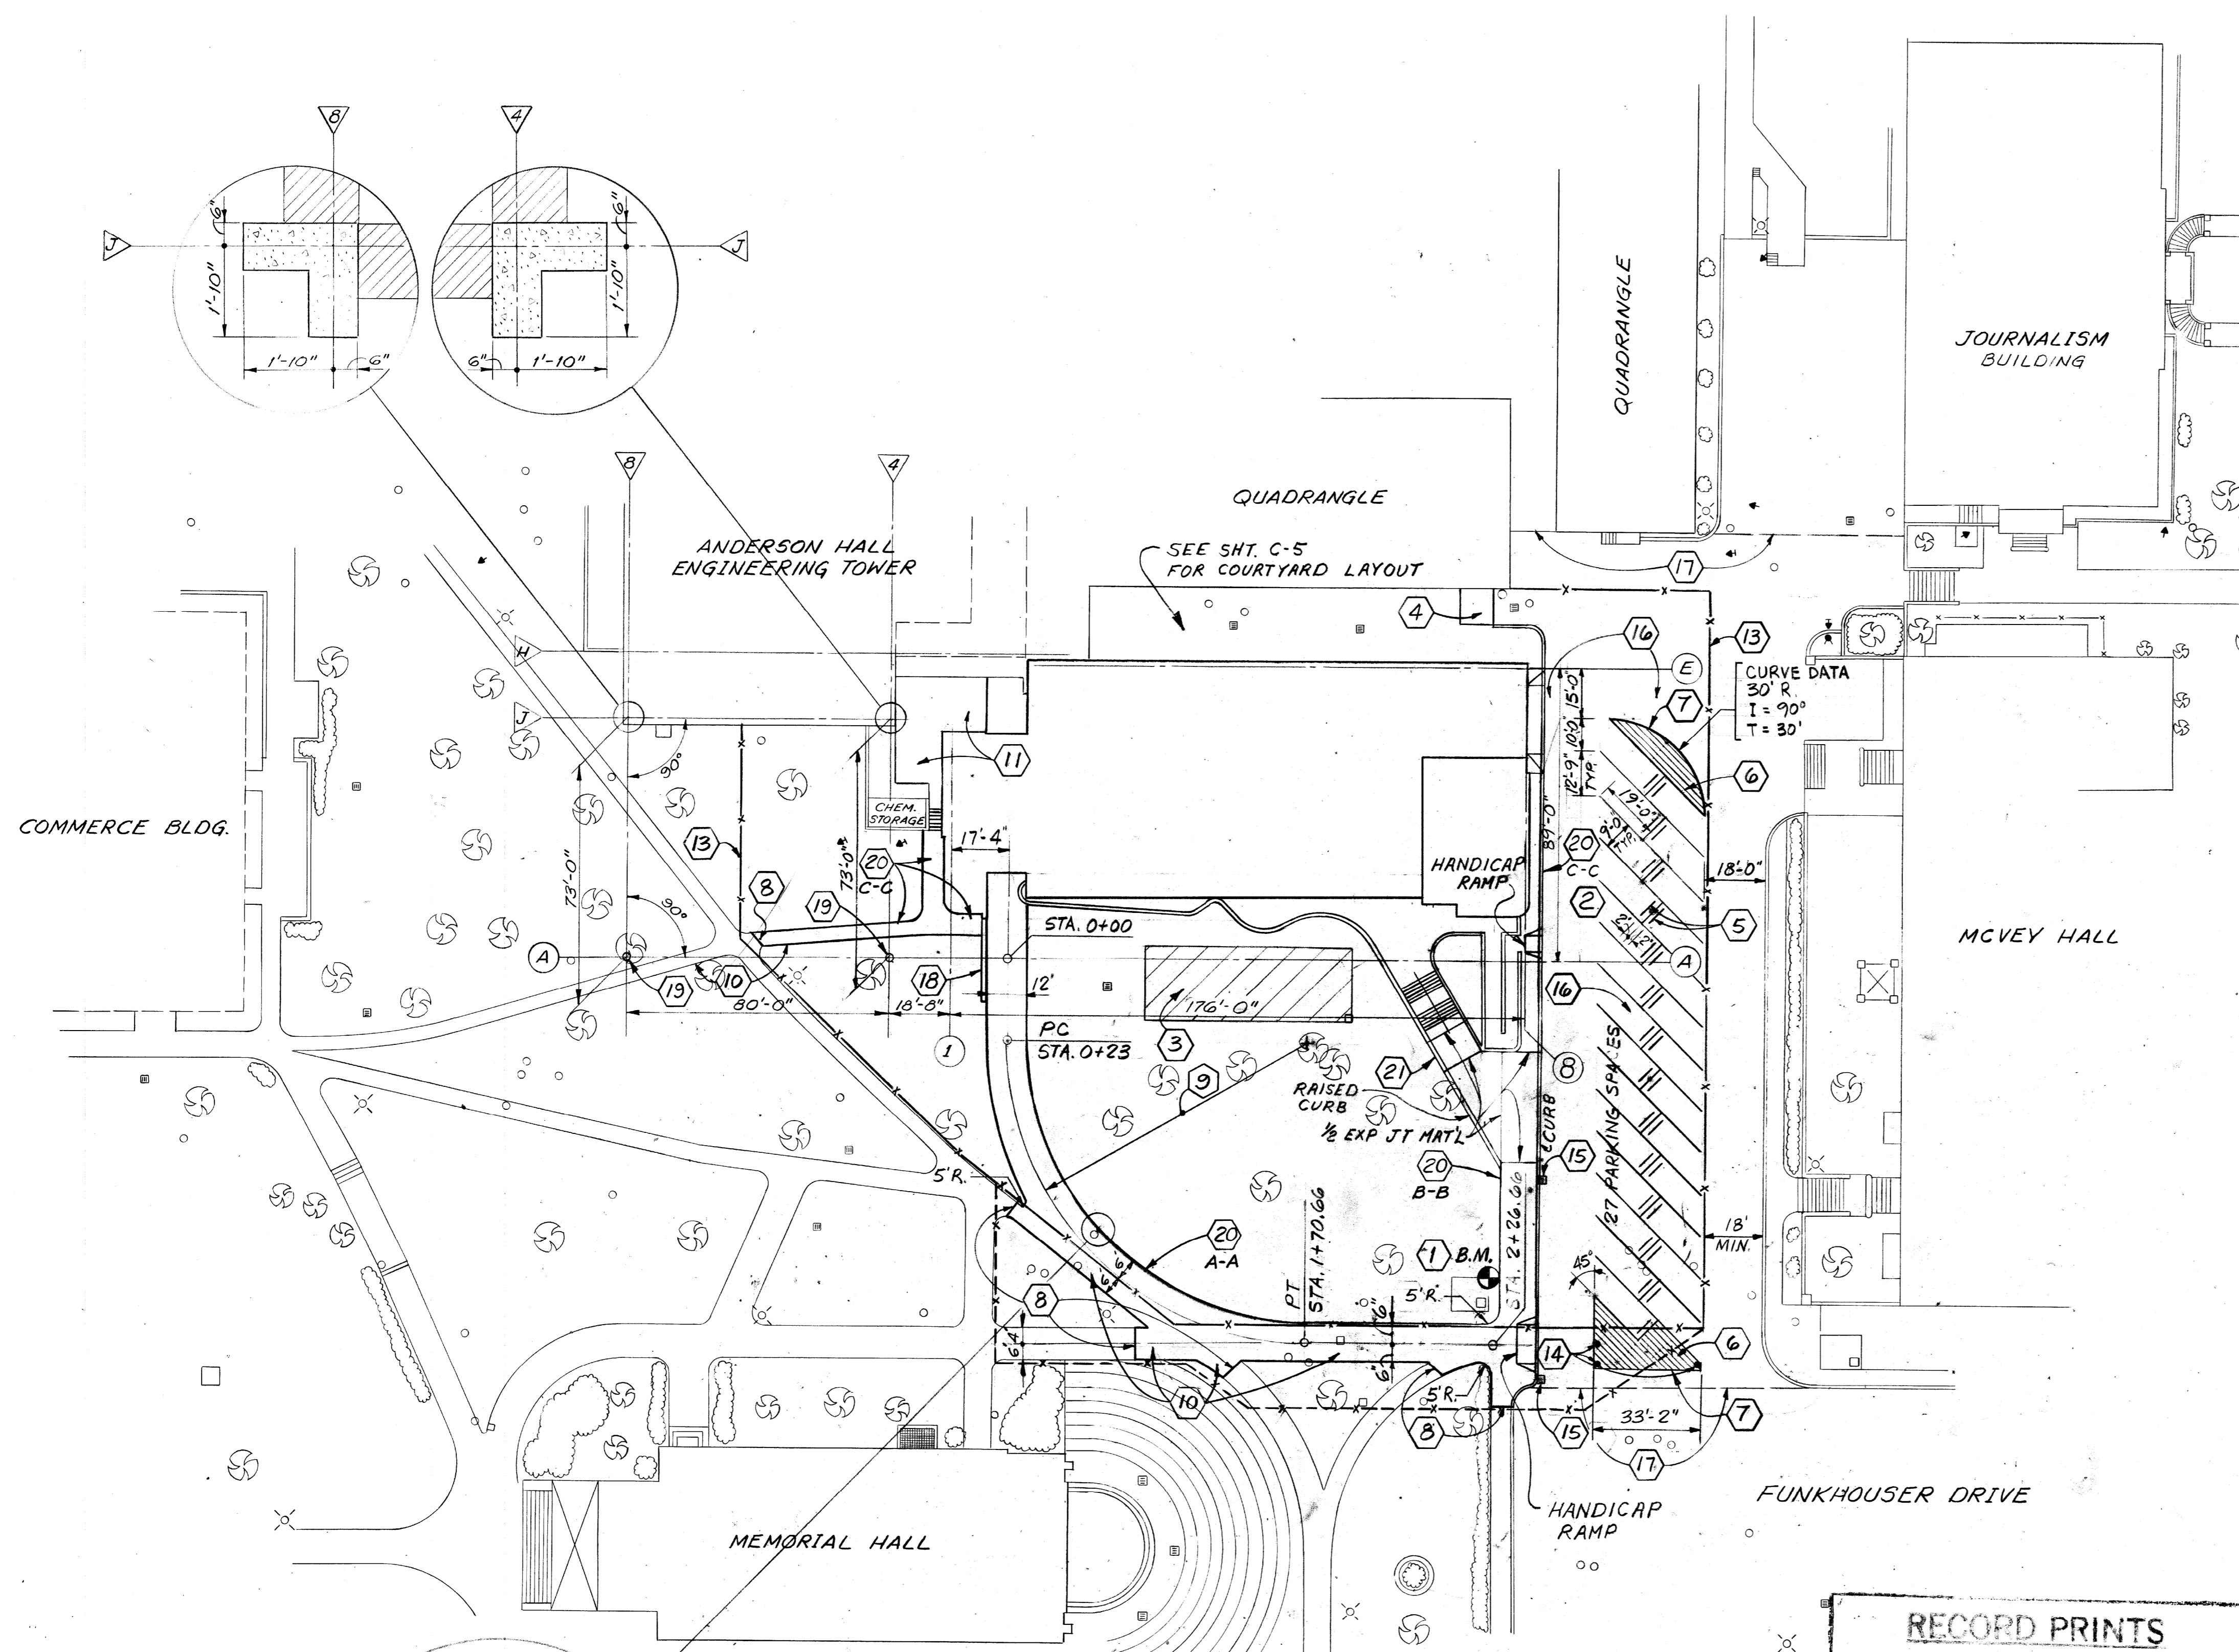

- SITE CONSTRUCTION NOTES**
1. B.M. - CHISLED SQUARE N.E. CORNER OF STEAM VAULT. ELEVATION = 971.28
 2. STAGING AND STORAGE AREA SHALL BE IN THAT AREA OF EXISTING PAVEMENT EAST OF THE NEW BUILDING AND WITHIN THE CONSTRUCTION BARRICADE FENCE. IF ASTECC FACILITY IS BUILT, THEN THE STAGING AND STORAGE AREA SHALL BE REMOVED.
 3. TOPSOIL STOCKPILE FROM SITE DEVELOPMENT OPERATION. FINAL LOCATION OF STOCKPILE IS TO BE COORDINATED WITH THE DESIGN AND CONSTRUCTION DIVISION, CONSTRUCTION ADMINISTRATOR. IT IS THE RESPONSIBILITY OF THE CONTRACTOR TO INSTALL AND MAINTAIN EROSION CONTROL.
 4. DUMPSTER PAD - SEE SHEET A-2.
 5. FOR WHEEL STOP DETAIL SEE SHEET C-8.
 6. FOUR (4) INCH WIDE YELLOW PAINT STRIPES, TO BE EIGHTEEN (18) INCHES ON CENTERS.
 7. EDGE OF PAINT STRIP.
 8. PLACE ONE-HALF (1/2) INCH EXPANSION JOINT BETWEEN EXISTING SIDEWALK AND NEW CONSTRUCTION.
 9. RADIUS OF CURVE TO CENTERLINE OF DRIVE = 90 FEET. MODIFY RADIUS OR END STATIONS AS REQUIRED TO MATCH EXISTING SIDEWALK.
 10. ALIGN NEW CONSTRUCTION WITH EXISTING SIDEWALK EDGE.
 11. SIX (6) INCH CONCRETE SLAB WITH 6 x 6 - W2.9 x W2.9 WNF ON 6" SUBBASE. PROVIDE 1/2 INCH EXPANSION JOINT AROUND ALL OUTSIDE EDGES. ELEVATION OF NEW CONSTRUCTION AT OUTSIDE EDGES SHALL MATCH EXISTING, SLOPE TO DRAIN.
 12. LOCATION OF SURFACE INLET AND PIPING TO BE SUCH THAT INSTALLATION WILL CAUSE MINIMUM DISTURBANCE TO THE EXISTING TREE - SEE SHEET C-7 FOR SURFACE INLET DETAILS.
 13. CONSTRUCTION BARRICADE FENCE, SEE SPECIAL CONDITIONS.
 14. EXISTING GUARD POST TO REMAIN IN PLACE.
 15. SURFACE INLET (DETAIL SHEET C-7) TO CONNECT TO EXISTING STORM DRAIN AT LOCATION OF REMOVED SURFACE INLET WITH EIGHT (8) INCH DUCTILE IRON PIPE. SEE DEMOLITION PLAN FOR LOCATION OF EXISTING SURFACE INLET TO BE REMOVED. RECONNECT STEAM VENT AS REQUIRED TO NEW SURFACE INLET.
 16. FOR UNPAVED AREA, CONSTRUCT AGGREGATE BASE AND BITUMINOUS BASE COARSE AS SHOWN ON DETAIL SHEET C-7. FOR ALL DISTURBED PAVED AREAS PROVIDE A MINIMUM AGGREGATE BASE AND BITUMINOUS BASE COARSE AS SHOWN IN DETAIL ON SHEET C-7. IN BOTH OF THE ABOVE DESCRIBED CASES, THE TOP OUTSIDE EDGE OF THE BITUMINOUS BASE COARSE IS TO MATCH THE SURFACE OF THE ADJACENT PAVEMENT.
 17. LIMITS OF PAVEMENT TO RECEIVE NEW SURFACE COARSE. SEE NOTE 16. ELEVATION OF NEW SURFACE COARSE TO MATCH EXISTING SURFACE. ADJUST ALL MANHOLE COVERS AND SURFACE INLETS TO BE FLUSH WITH NEW SURFACE COARSE ELEVATION AS REQUIRED.
 18. SEE SHEET C-7 FOR RETAINING WALL DETAILS.
 19. EXISTING CONCRETE MARKERS.
 20. SIDEWALKS. SEE SHEET C-7 FOR DETAILS.
 21. TURN DOWN WEST EDGE OF SIDEWALK TO FORM VERTICAL WALL IN ACCORDANCE WITH DETAIL "A". VERTICAL WALL SHALL EXTEND 20 FEET SOUTHWEST FROM END OF RETAINING WALL, WITH 1/2" EXPANSION JOINT IN BETWEEN. HEIGHT OF WALL SHALL VARY LINEARLY FROM 2'-6" ADJACENT TO RETAINING WALL DOWN TO 6" AT OPPOSITE END.

RECORD PRINTS
 THESE ARE RECORD PRINTS OF DRAWINGS BASED UPON MARKED UP PRINTS, DRAWINGS AND OTHER DATA FURNISHED BY THE CONTRACTOR TO THE ENGINEER AND WHICH THE ENGINEER CONSIDERS SIGNIFICANT

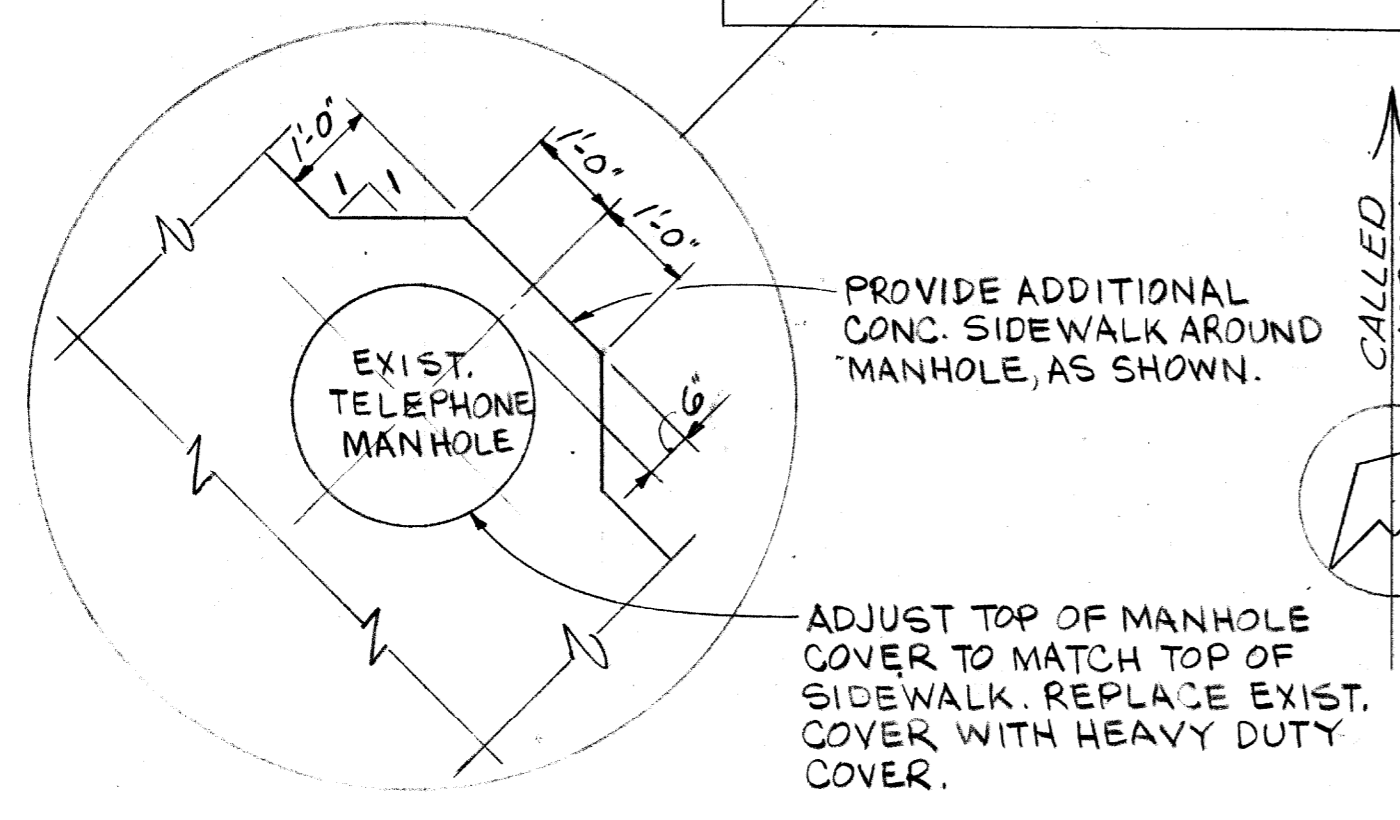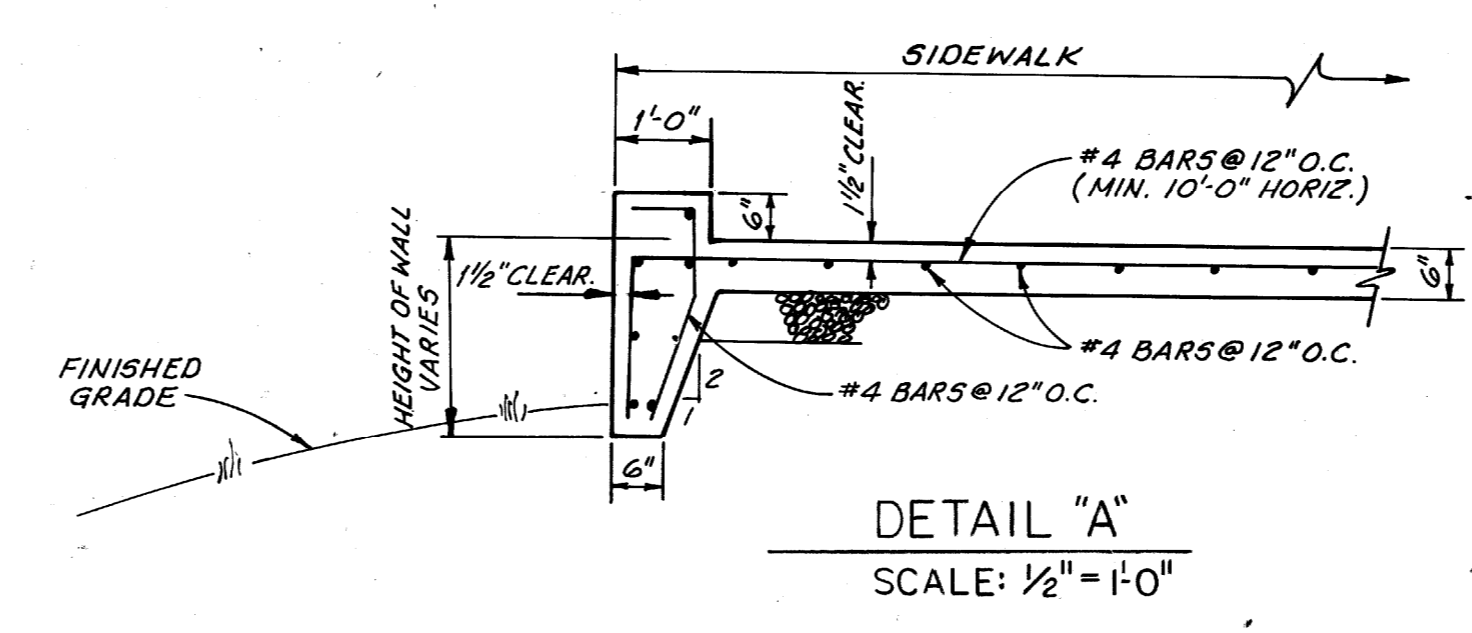

LAYOUT PLAN
 SCALE: 1"=30'

DETAIL "A"
 SCALE: 1/2"=1'-0"

ROBOTICS FACILITY
 LEXINGTON CAMPUS
 UNIVERSITY OF KENTUCKY
 LEXINGTON, KENTUCKY

University of Kentucky
 Lexington, Kentucky


LAYOUT PLAN

Sherman Carter Barnhart
 PARTNERS IN ARCHITECTURE


JOB NO 2046
 DATE 10-19-87
 DRAWN PG
 CHECKED TOA
 FILE NO. 4310

REVISIONS


C-4

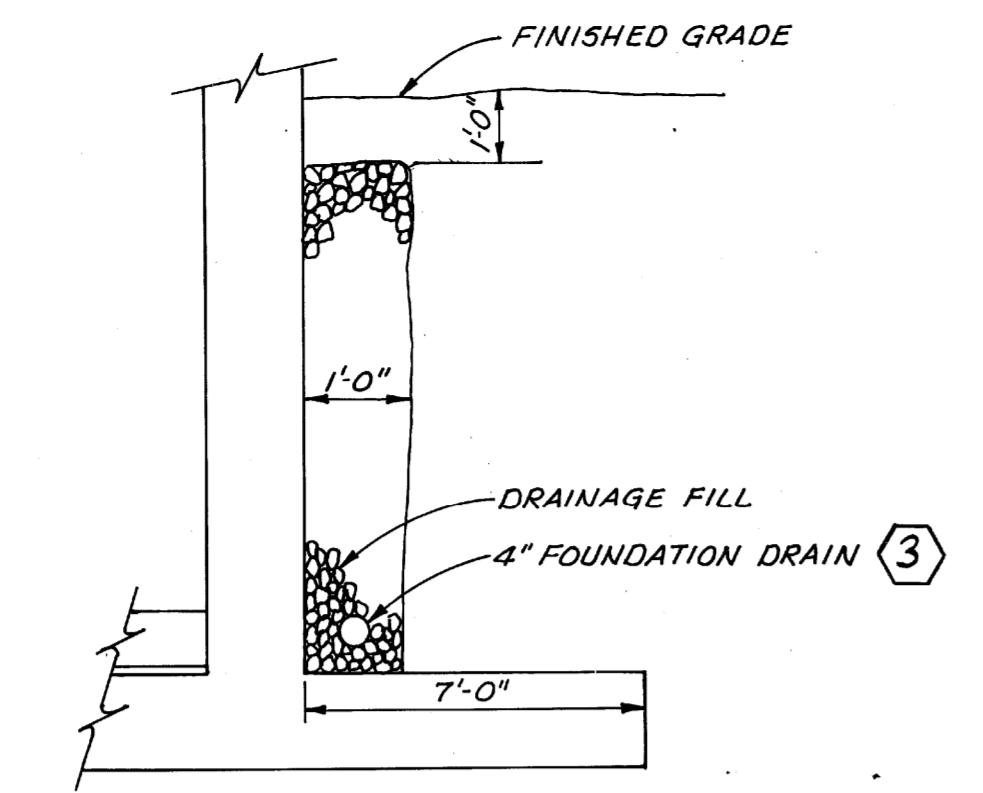

SECTION THRU FOUNDATION DRAIN
NO SCALE

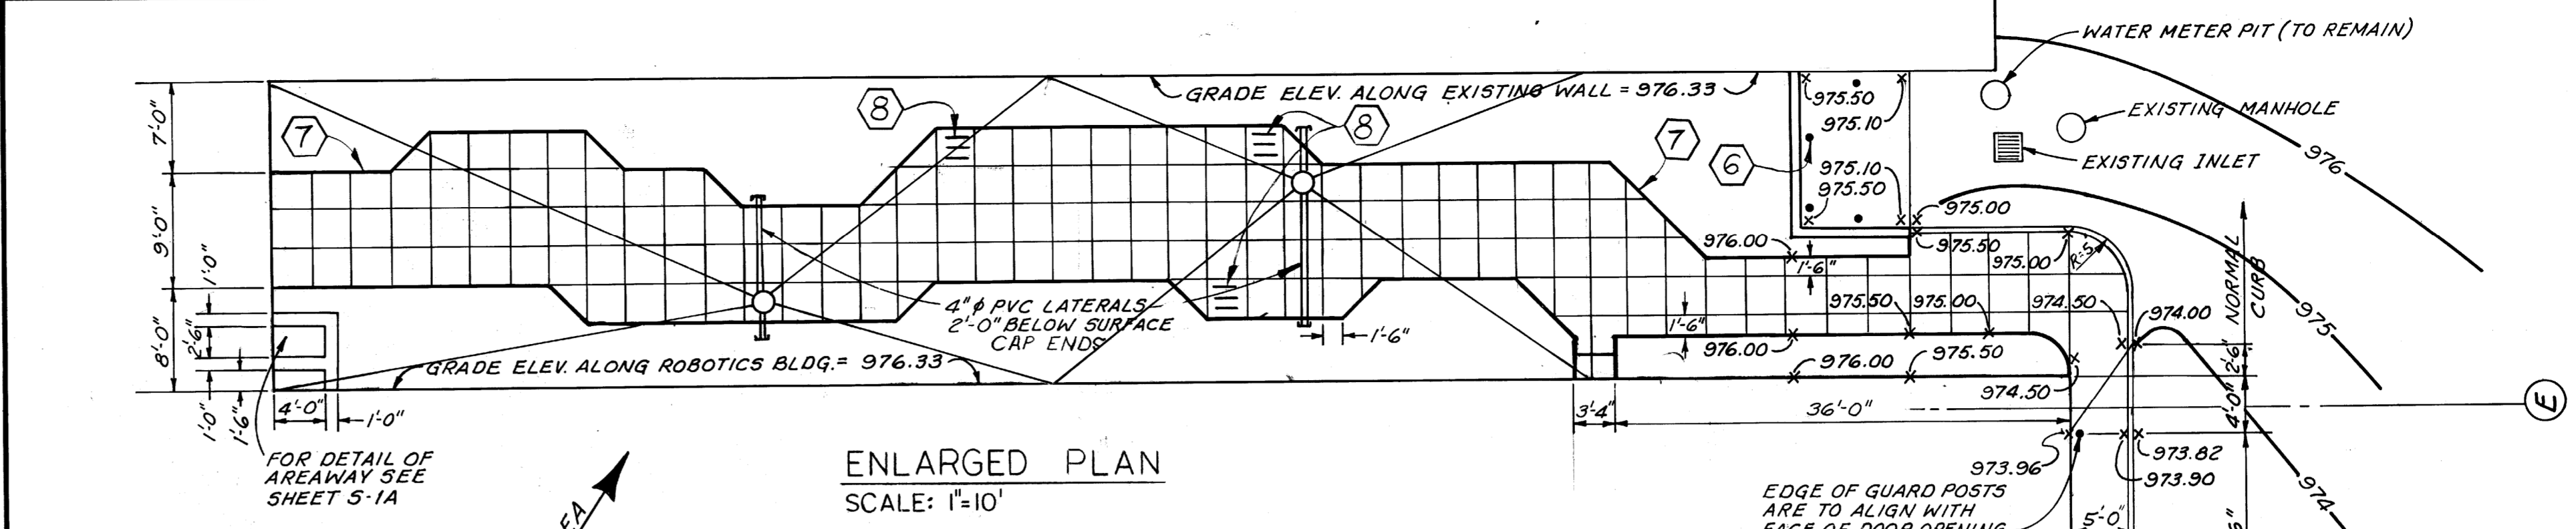

ENLARGED PLAN
SCALE: 1"=10'

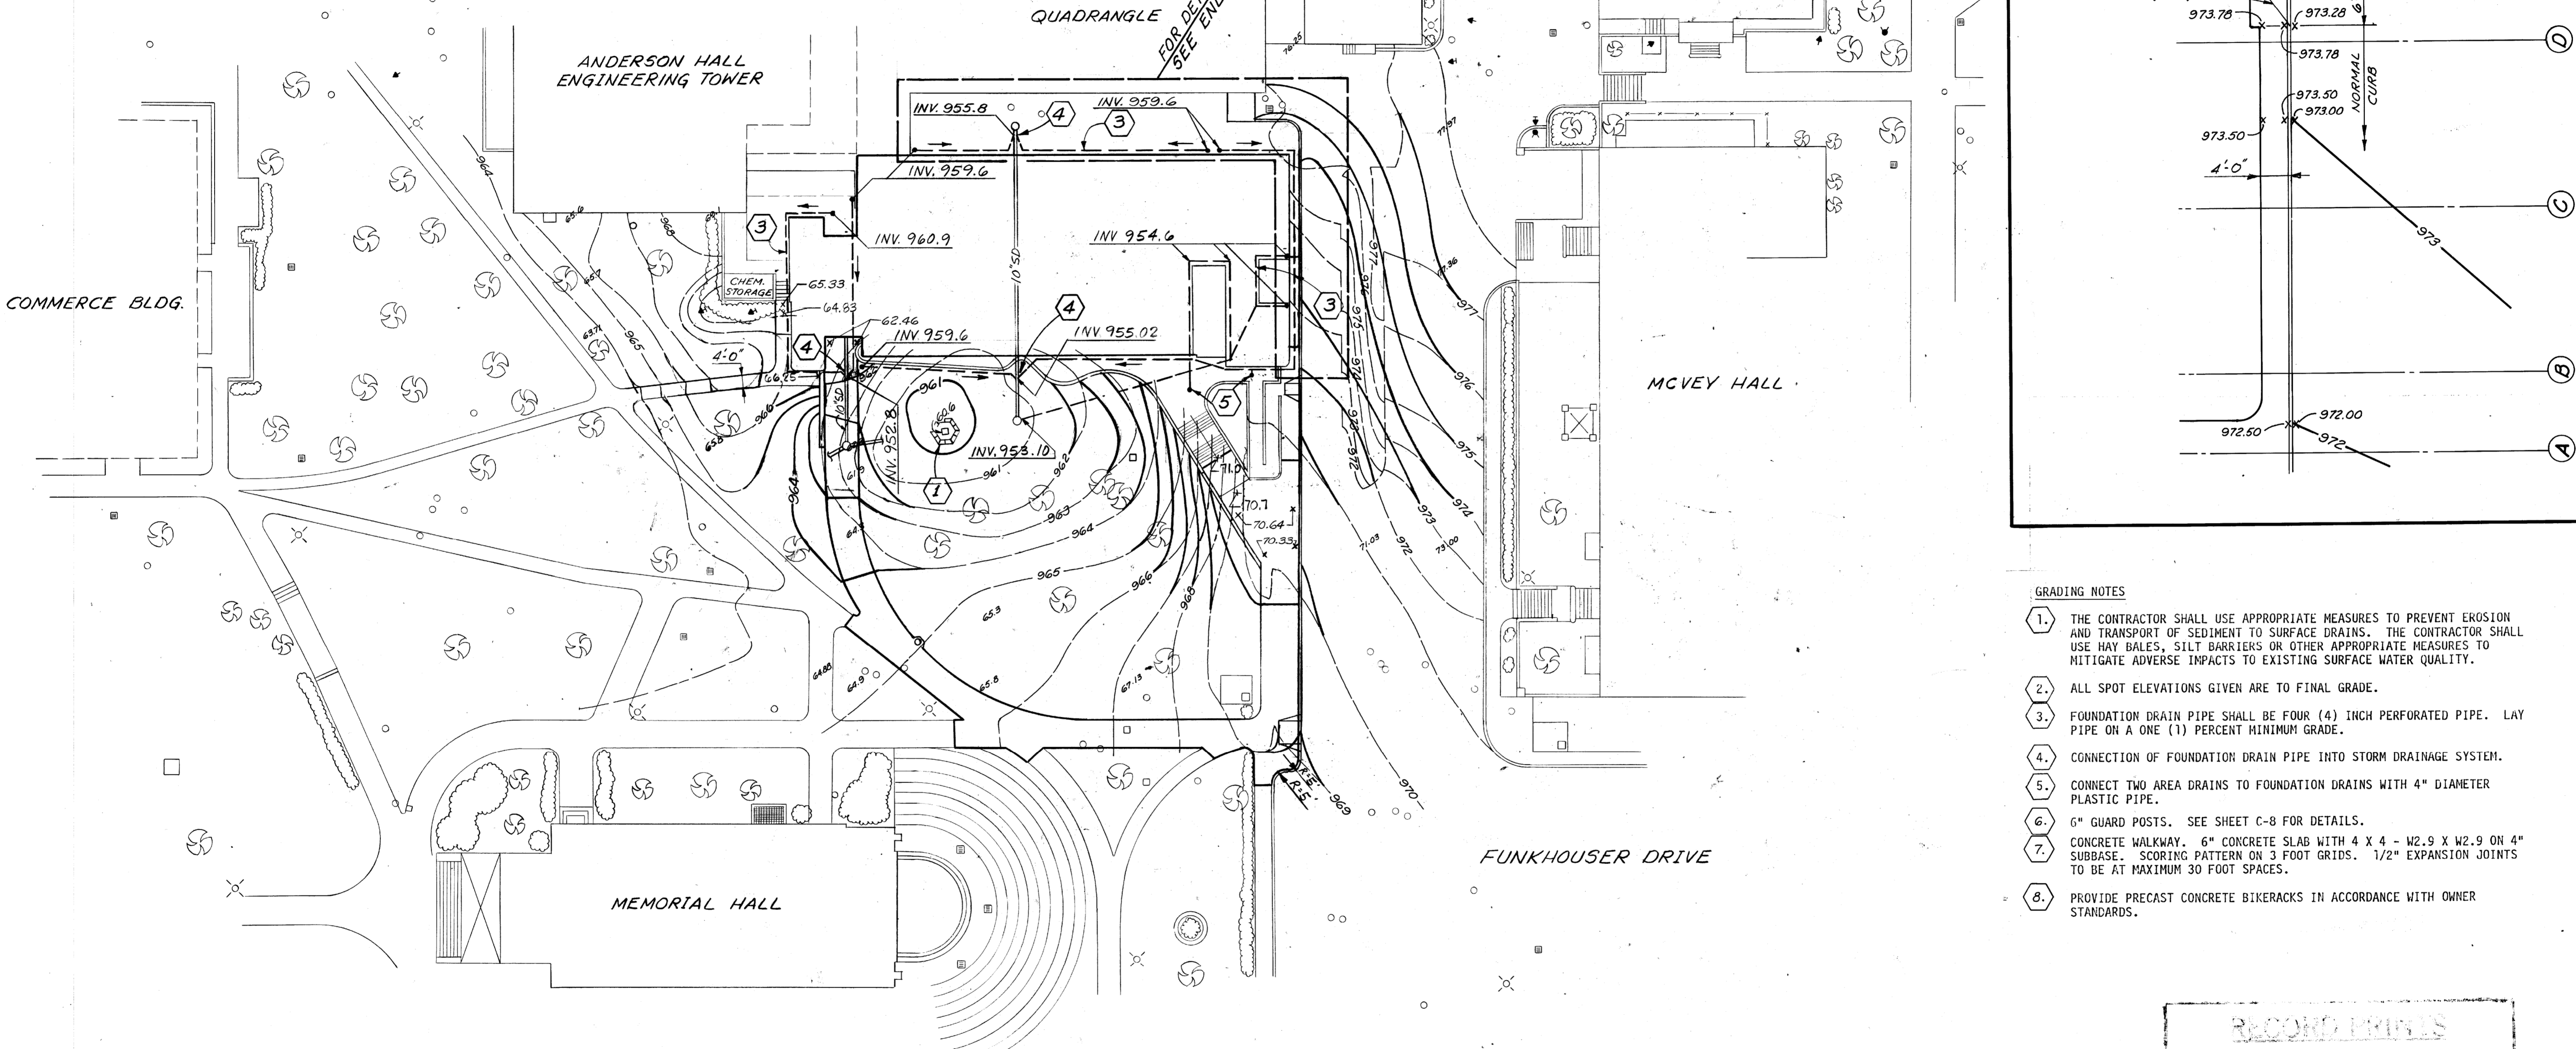

GRADING PLAN & FOUNDATION DRAIN PLAN
SCALE: 1"=30'

GRADING NOTES

1. THE CONTRACTOR SHALL USE APPROPRIATE MEASURES TO PREVENT EROSION AND TRANSPORT OF SEDIMENT TO SURFACE DRAINS. THE CONTRACTOR SHALL USE HAY BALES, SILT BARRIERS OR OTHER APPROPRIATE MEASURES TO MITIGATE ADVERSE IMPACTS TO EXISTING SURFACE WATER QUALITY.
2. ALL SPOT ELEVATIONS GIVEN ARE TO FINAL GRADE.
3. FOUNDATION DRAIN PIPE SHALL BE FOUR (4) INCH PERFORATED PIPE. LAY PIPE ON A ONE (1) PERCENT MINIMUM GRADE.
4. CONNECTION OF FOUNDATION DRAIN PIPE INTO STORM DRAINAGE SYSTEM.
5. CONNECT TWO AREA DRAINS TO FOUNDATION DRAINS WITH 4" DIAMETER PLASTIC PIPE.
6. 6" GUARD POSTS. SEE SHEET C-8 FOR DETAILS.
7. CONCRETE WALKWAY. 6" CONCRETE SLAB WITH 4 X 4 - W2.9 X W2.9 ON 4" SUBBASE. SCORING PATTERN ON 3 FOOT GRIDS. 1/2" EXPANSION JOINTS TO BE AT MAXIMUM 30 FOOT SPACES.
8. PROVIDE PRECAST CONCRETE BIKERACKS IN ACCORDANCE WITH OWNER STANDARDS.

RECORD PRINTS
THESE ARE RECORD PRINTS OF DRAWINGS BASED UPON MARKED UP PRINTS, DRAWINGS AND OTHER DATA FURNISHED BY THE CONTRACTOR TO THE ENGINEER AND WHICH THE ENGINEER CONSIDERS SIGNIFICANT.

ROBOTICS FACILITY
LEXINGTON CAMPUS
UNIVERSITY OF KENTUCKY
LEXINGTON, KENTUCKY

University of Kentucky
Lexington, Kentucky

10.19.87
CIN
WALTER BUNNY
DIRECTOR, DESIGN AND CONSTRUCTION DIVISION

GRADING PLAN

Stelman Carter Barnhart
PARTNERS IN ARCHITECTURE
SHEET 1000 - 250 WEST MAIN STREET - LEXINGTON, KY 40502 - 502-254-1514

JOB NO. 2046
DATE 10-19-87
DRAWN PG
CHECKED TOA
FILE NO. 431.0


NO.	REVISIONS

SHEET

C-5

MASON J. HANGER ENGINEERING INC.
ARCHITECT • ENGINEERS
LEXINGTON, KENTUCKY

Sheet # 004839
A-1

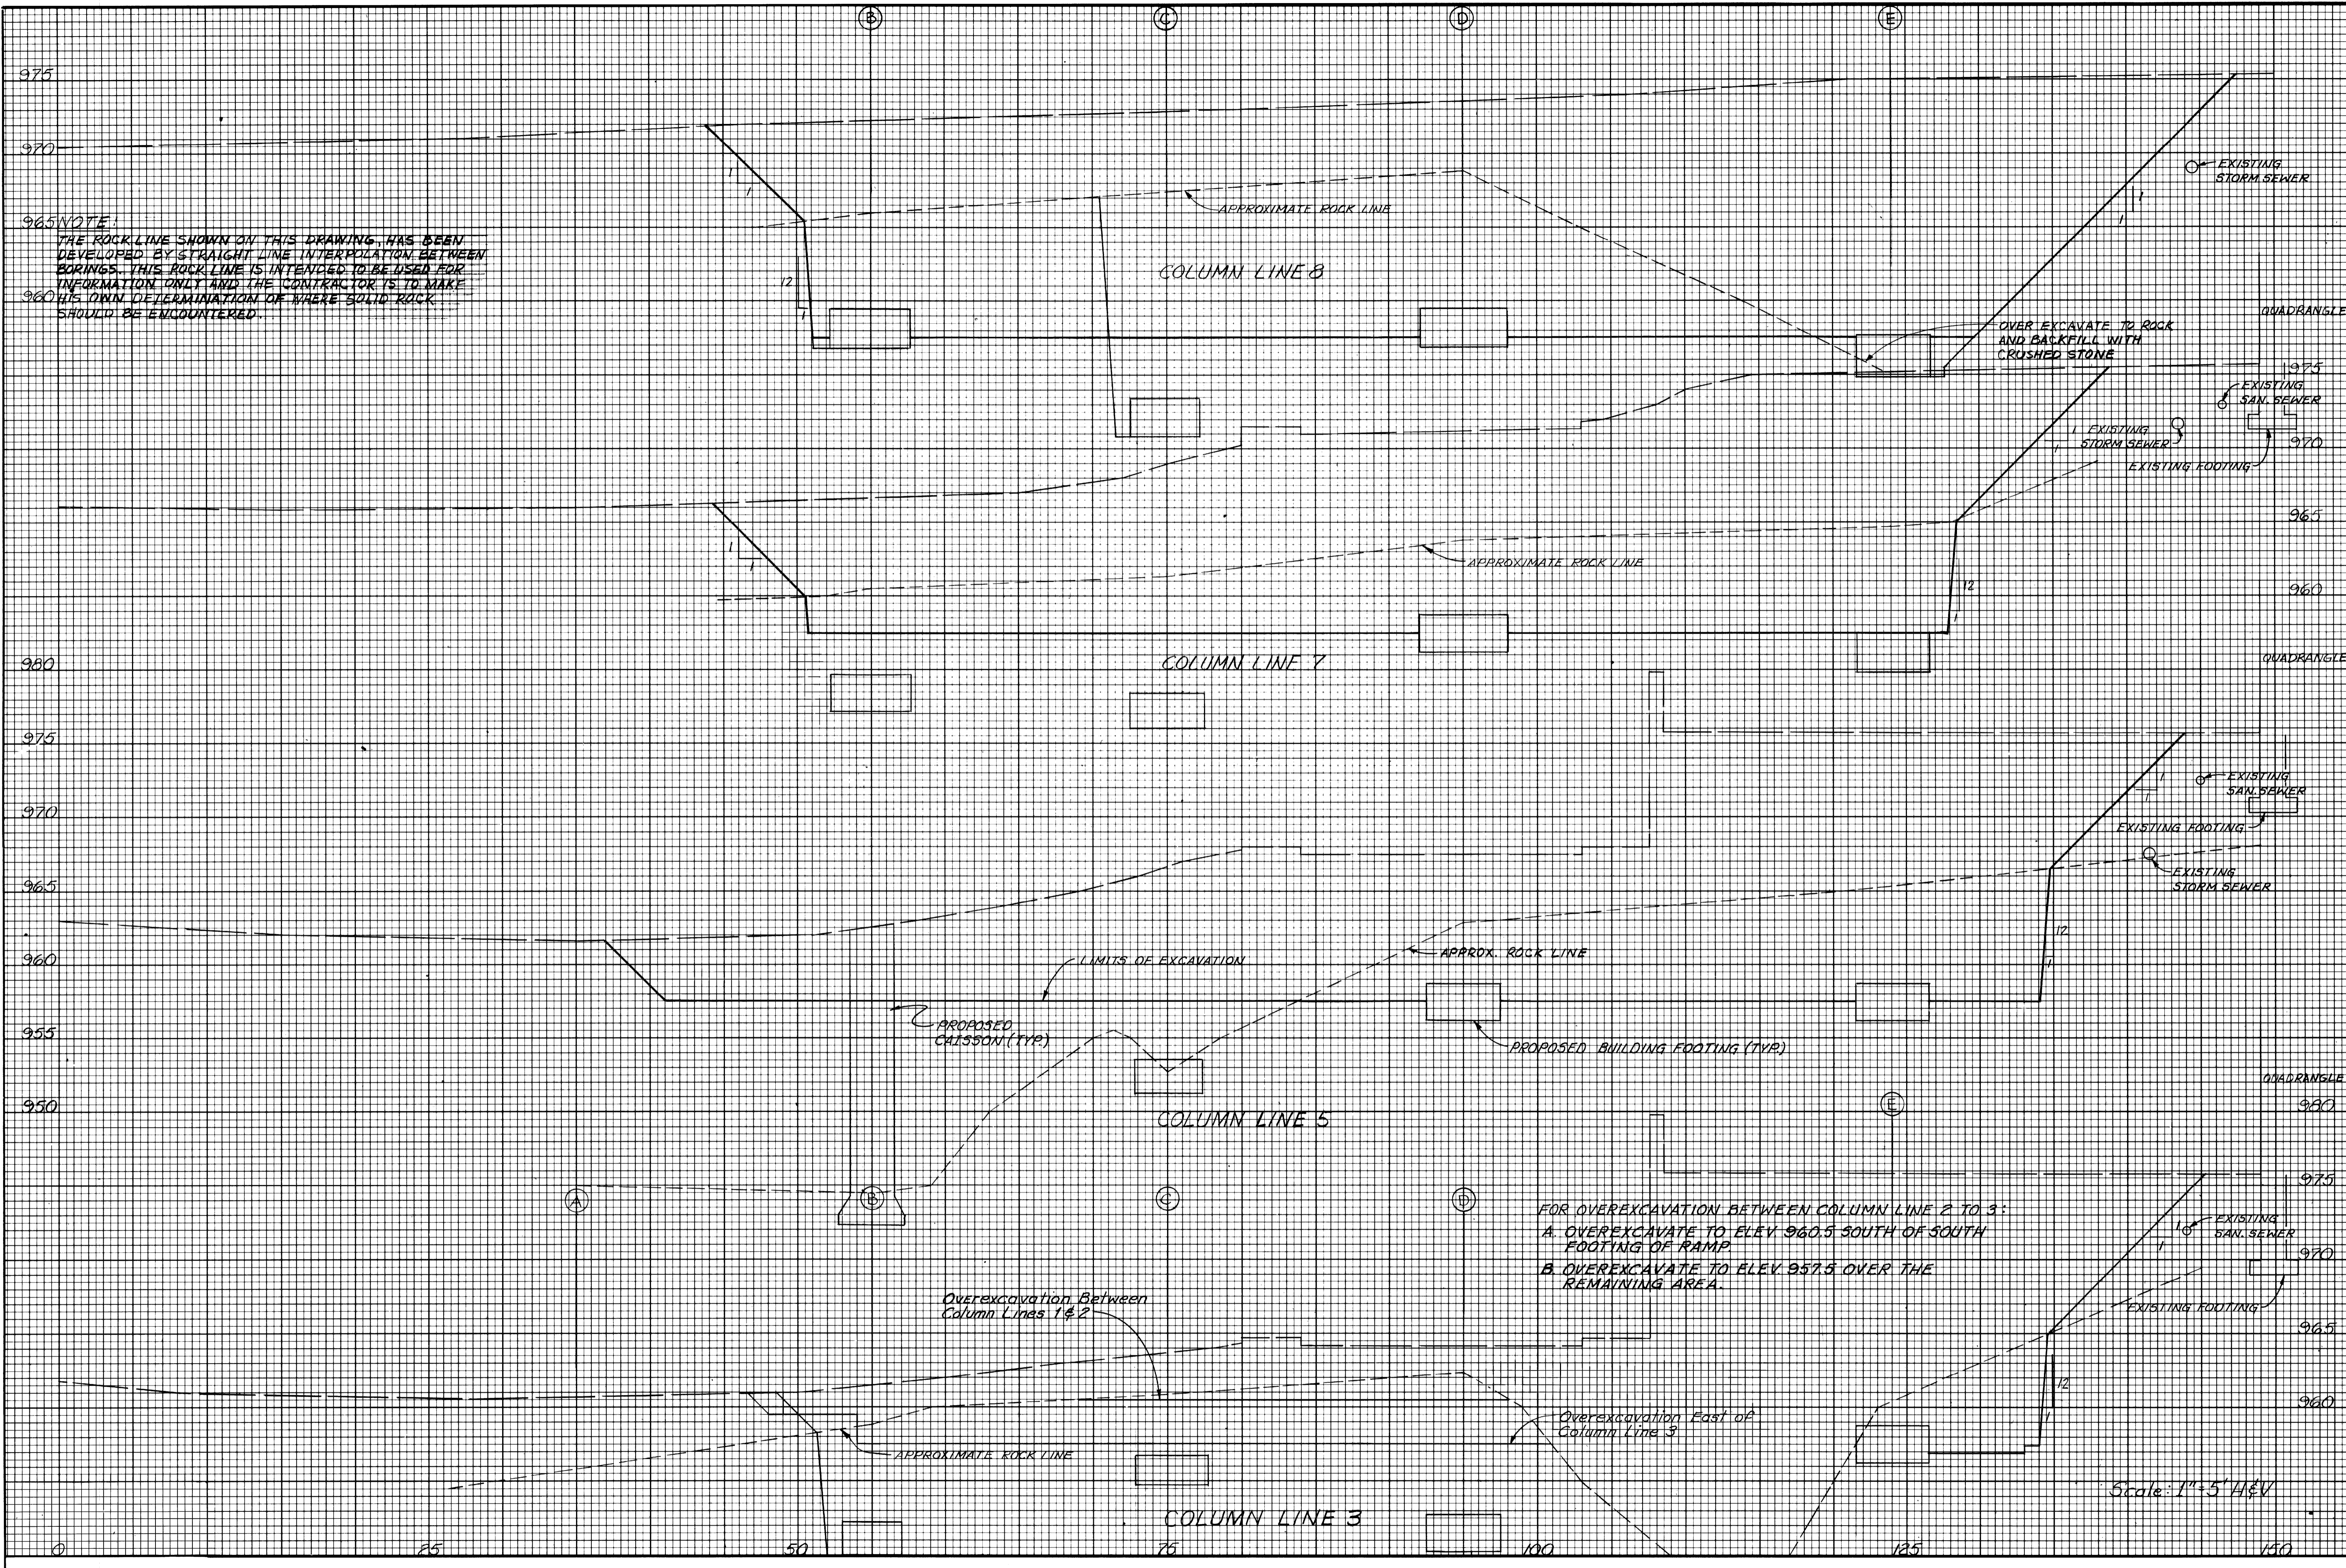

965 NOTE:
 THE ROCK LINE SHOWN ON THIS DRAWING, HAS BEEN DEVELOPED BY STRAIGHT LINE INTERPOLATION BETWEEN BORINGS. THIS ROCK LINE IS INTENDED TO BE USED FOR INFORMATION ONLY AND THE CONTRACTOR IS TO MAKE HIS OWN DETERMINATION OF WHERE SOLID ROCK SHOULD BE ENCOUNTERED.

FOR OVEREXCAVATION BETWEEN COLUMN LINE 2 TO 3:
 A. OVEREXCAVATE TO ELEV. 960.5 SOUTH OF SOUTH FOOTING OF RAMP
 B. OVEREXCAVATE TO ELEV. 957.5 OVER THE REMAINING AREA.

Overexcavation Between Column Lines 1 & 2

Overexcavation East of Column Line 3

Scale: 1" = 5' H&V

RECORD PRINTS
 THESE ARE RECORD PRINTS OF DRAWINGS BASED UPON WORKED UP DETAILS, DRAWINGS AND OTHER DATA SUBMITTED BY THE CONTRACTOR TO THE ENGINEER AND SHALL BE THE ENGINEER'S RESPONSIBILITY.

MASON & HANGER ENGINEERING INC.
 ARCHITECT • ENGINEERS
 LEXINGTON, KENTUCKY

ROBOTICS FACILITY
 LEXINGTON CAMPUS
 UNIVERSITY OF KENTUCKY
 LEXINGTON, KENTUCKY


University of Kentucky
 Lexington, Kentucky
 10-19-87
 W. B. BUNN

BUILDING CROSS-SECTIONS
 Sherman Carter Barnhart
 PARTNERS IN ARCHITECTURE
 SUITE 100 • 750 WEST MAIN STREET • LEXINGTON, KY 40502 • 502-254-1101


JOB NO. 2046
 DATE 10-19-87
 DRAWN BT
 CHECKED TOA
 FILE NO. 431.0

REVISIONS

SHEET
C-6
 82 A-1
 004840

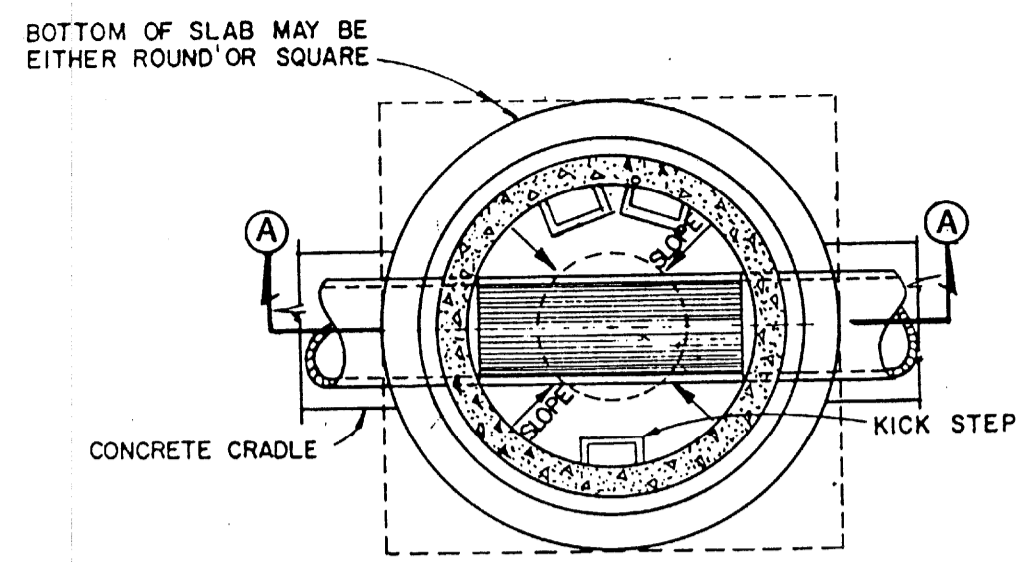


SECTION B-B

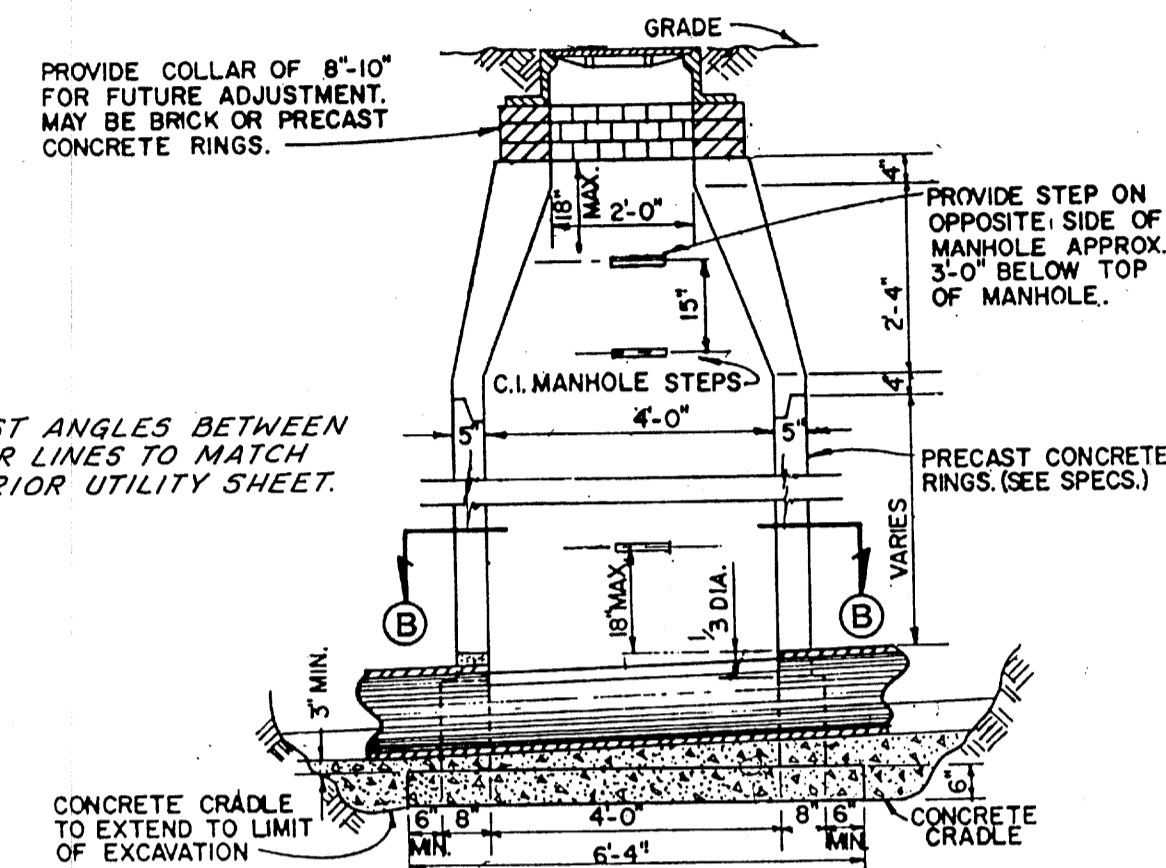

SECTION A-A

STANDARD MANHOLE

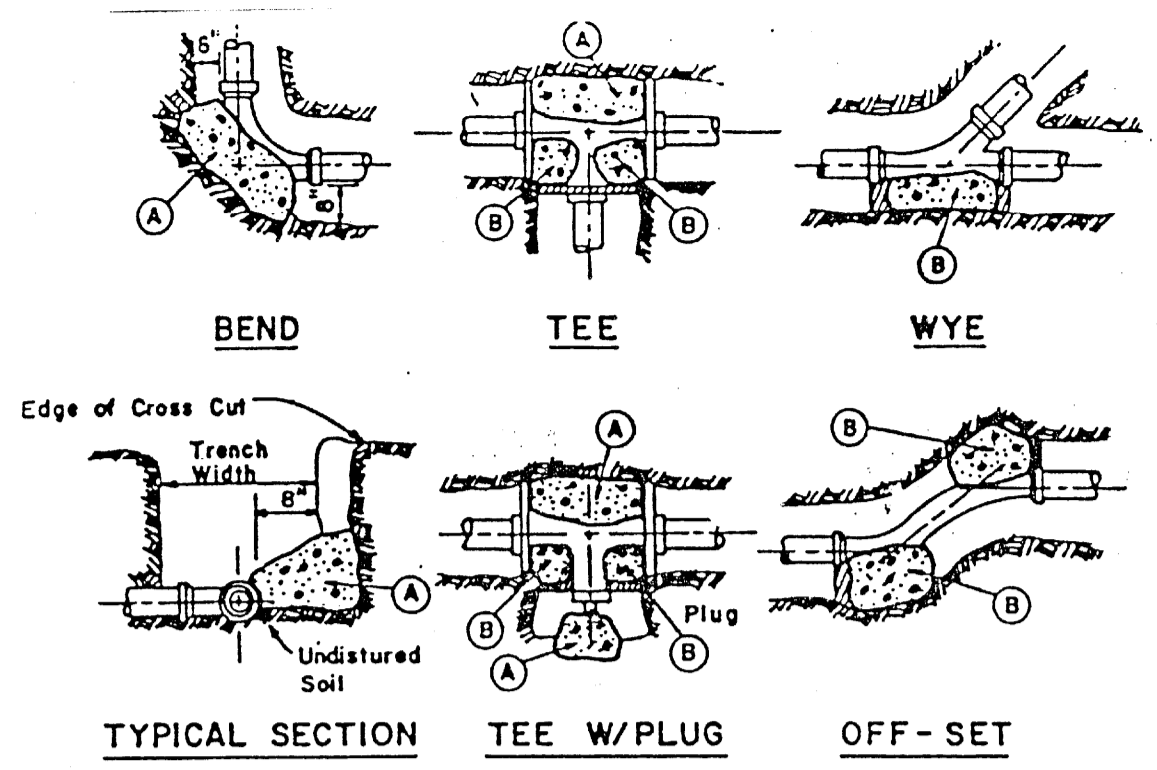


- Notes:
1. Pour thrust blocks against undisturbed material. Where trench wall has been disturbed, excavate loose material and extend thrust blocks to undisturbed material.
 2. On bends and tees, extend thrust blocks full length.
 3. Place board in front of all plugs before pouring thrust blocks.
 4. In backfilling, any muck encountered shall be removed and replaced with acceptable material.
 5. No coupling or joints shall be covered with concrete.
 6. Sizes are based on 150 p.s.i. internal pressure and 2000 lbs./sq. ft. soil bearing.
 7. Concrete shall be class "B".

SQUARE FEET OF CONCRETE THRUST BLOCKING BEARING ON UNDISTURBED MATERIAL


PIPE SIZE	4"	6"	8"	10"	12"	14"	16"	20"
MARK (A)	1.5	3	6	9	12	16	20	22
MARK (B)	1	2	4	5	8	10	12	15

THRUST BLOCK DETAILS

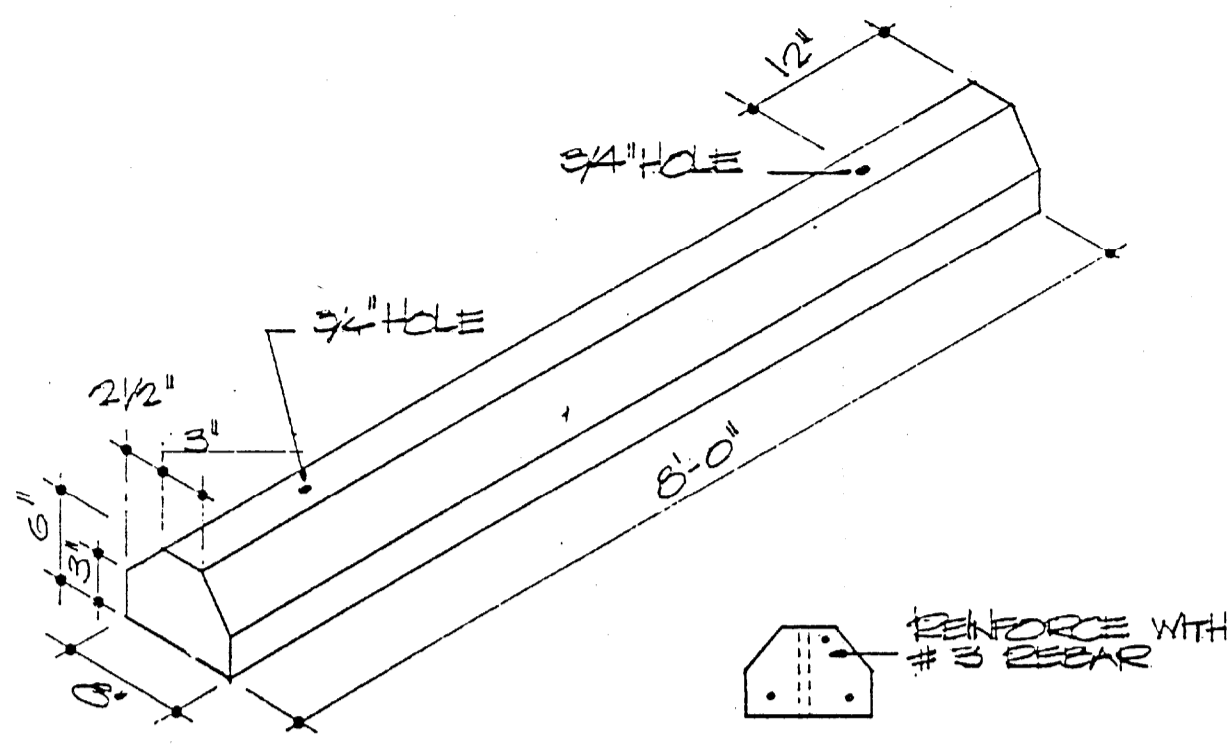


2'-4'-6'-8' STANDARD LENGTHS
 3'-5'-7' SPECIAL ORDER LENGTHS
 CONCRETE 3000 PSI. AT 28 DAYS
 WEIGHT: 38 LBS. PER LINEAR FOOT
 3/4" x 12" PINS TO FASTEN TO PAVEMENT


WHEEL STOP BLOCK

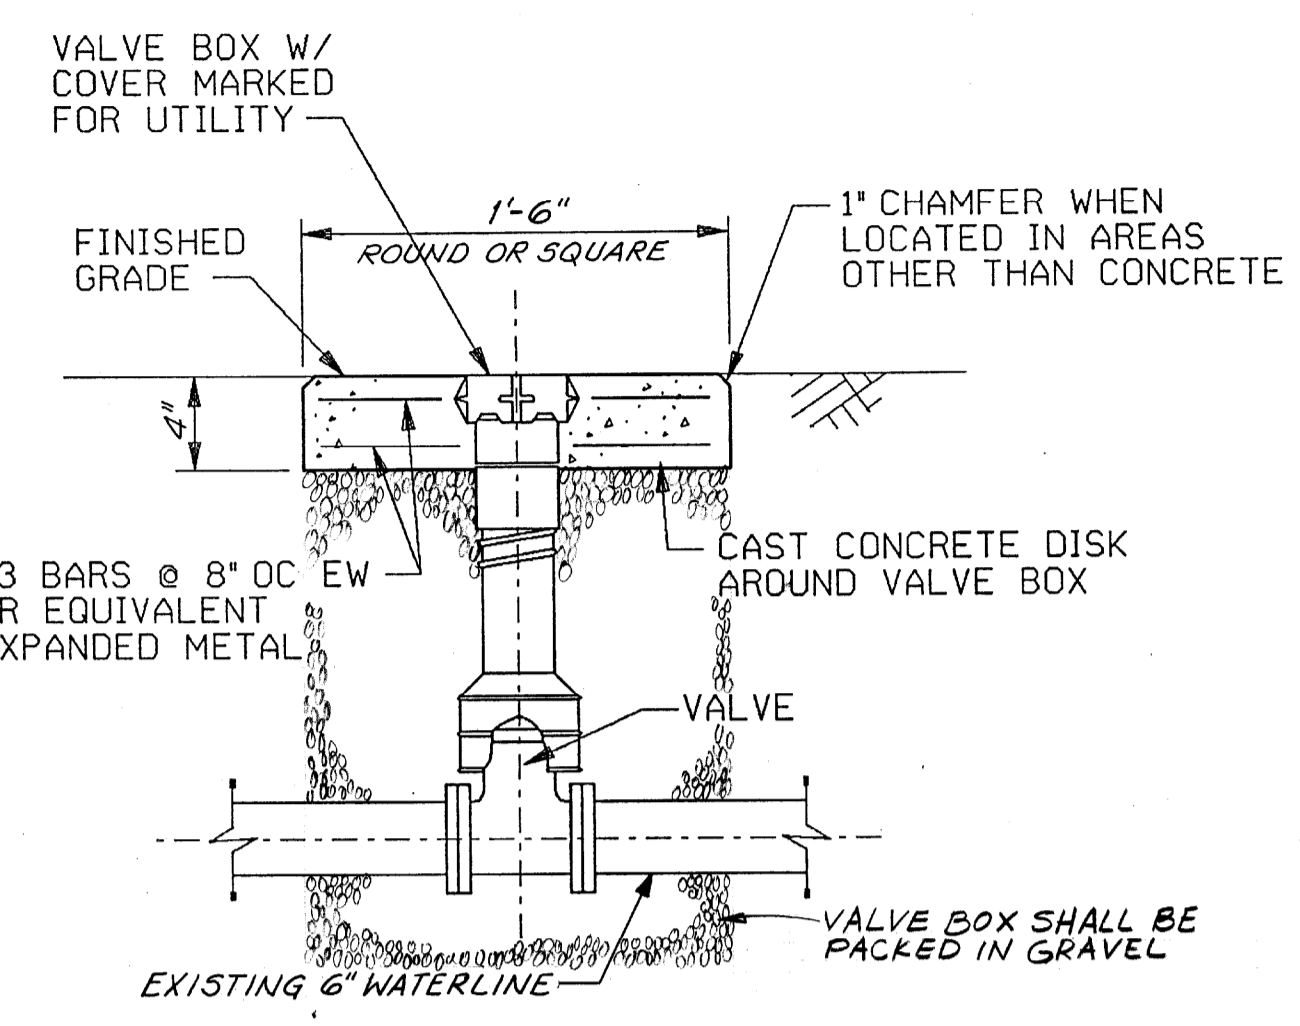

VALVE BOX & VALVE SETTING


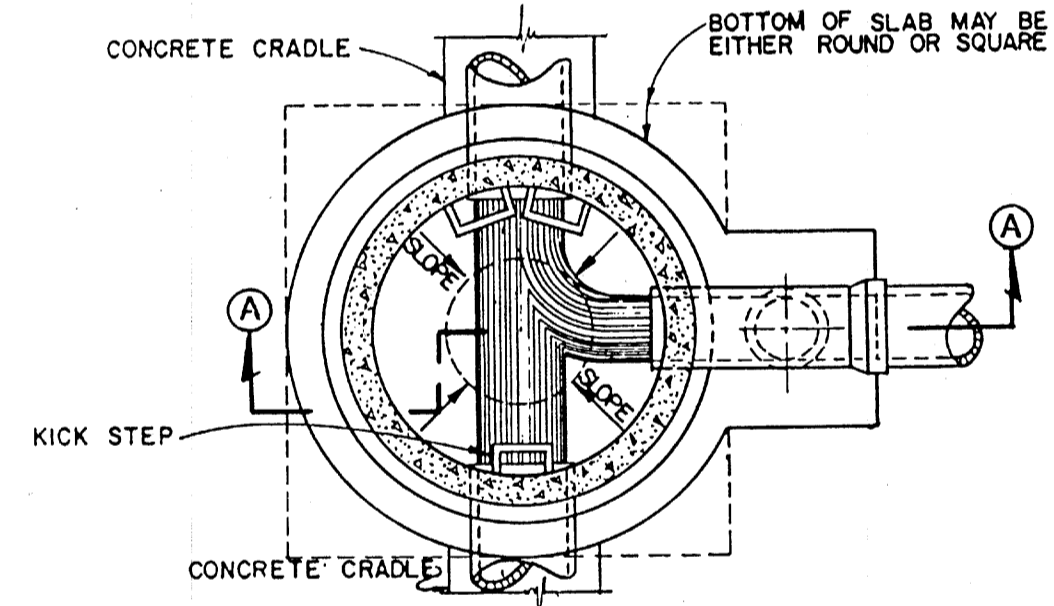


SECTION B-B

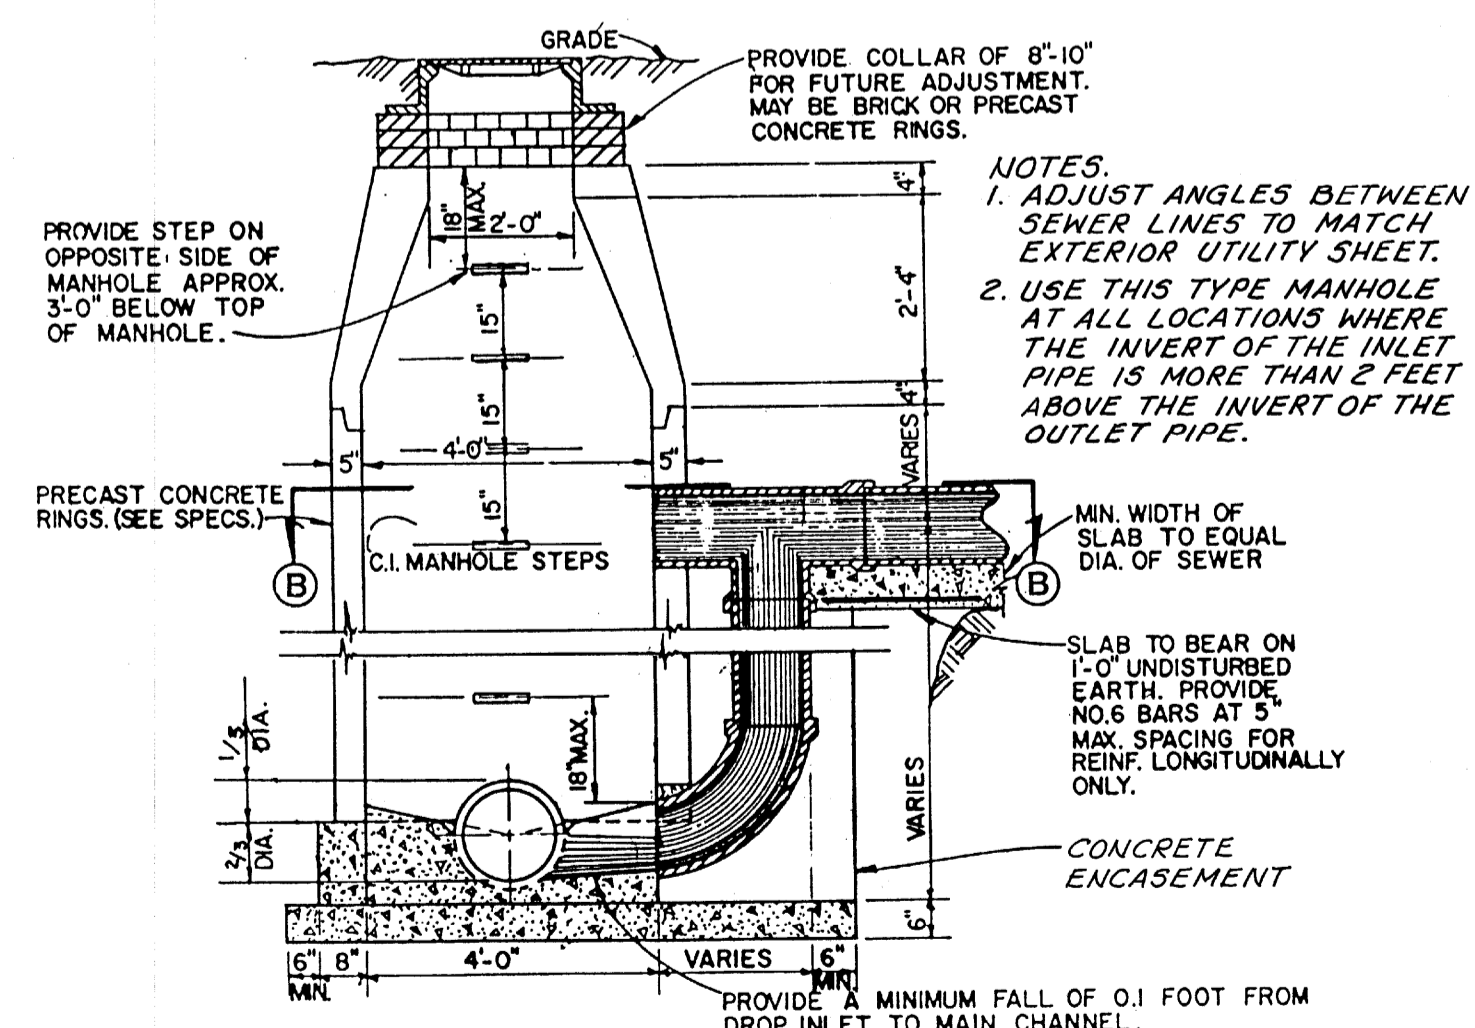


SECTION A-A

DROP MANHOLE

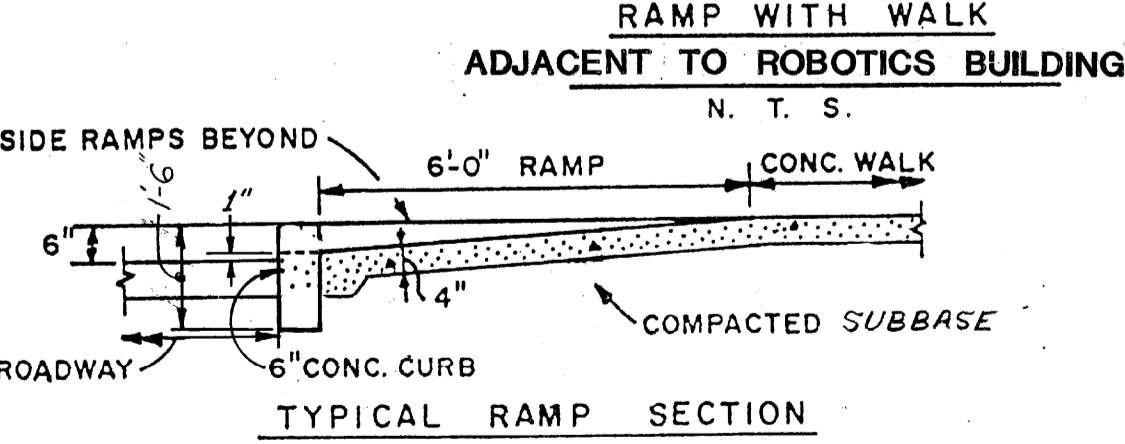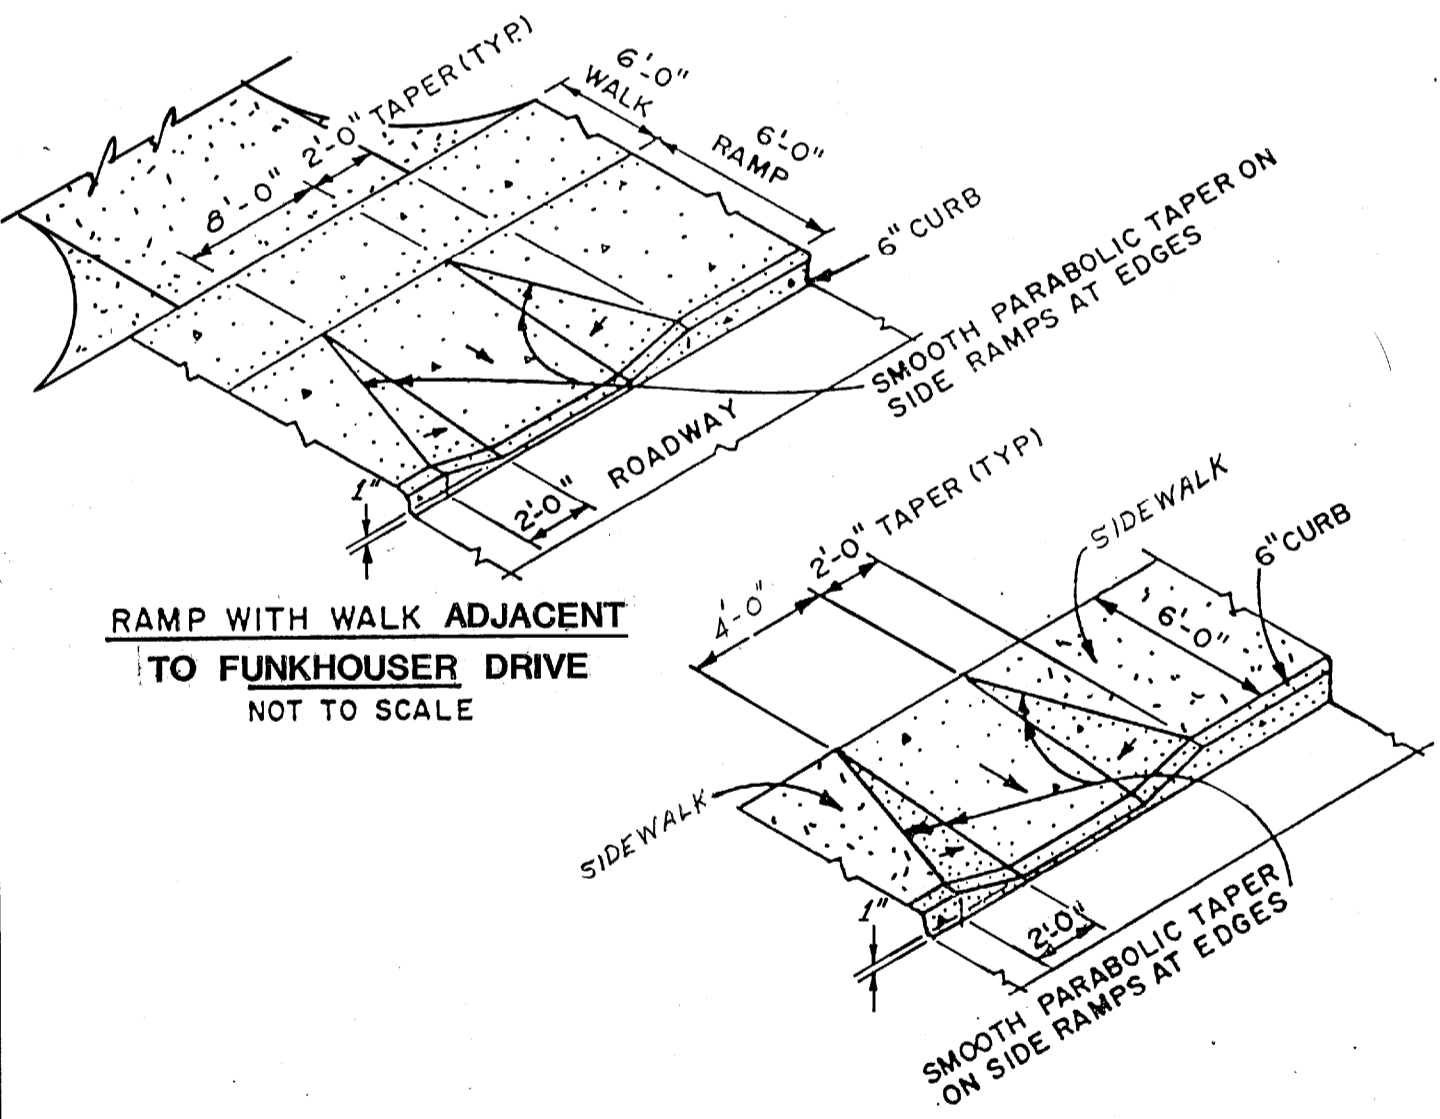


TYPICAL RAMP SECTION

CONCRETE PAVED HANDICAPPED RAMP DETAIL

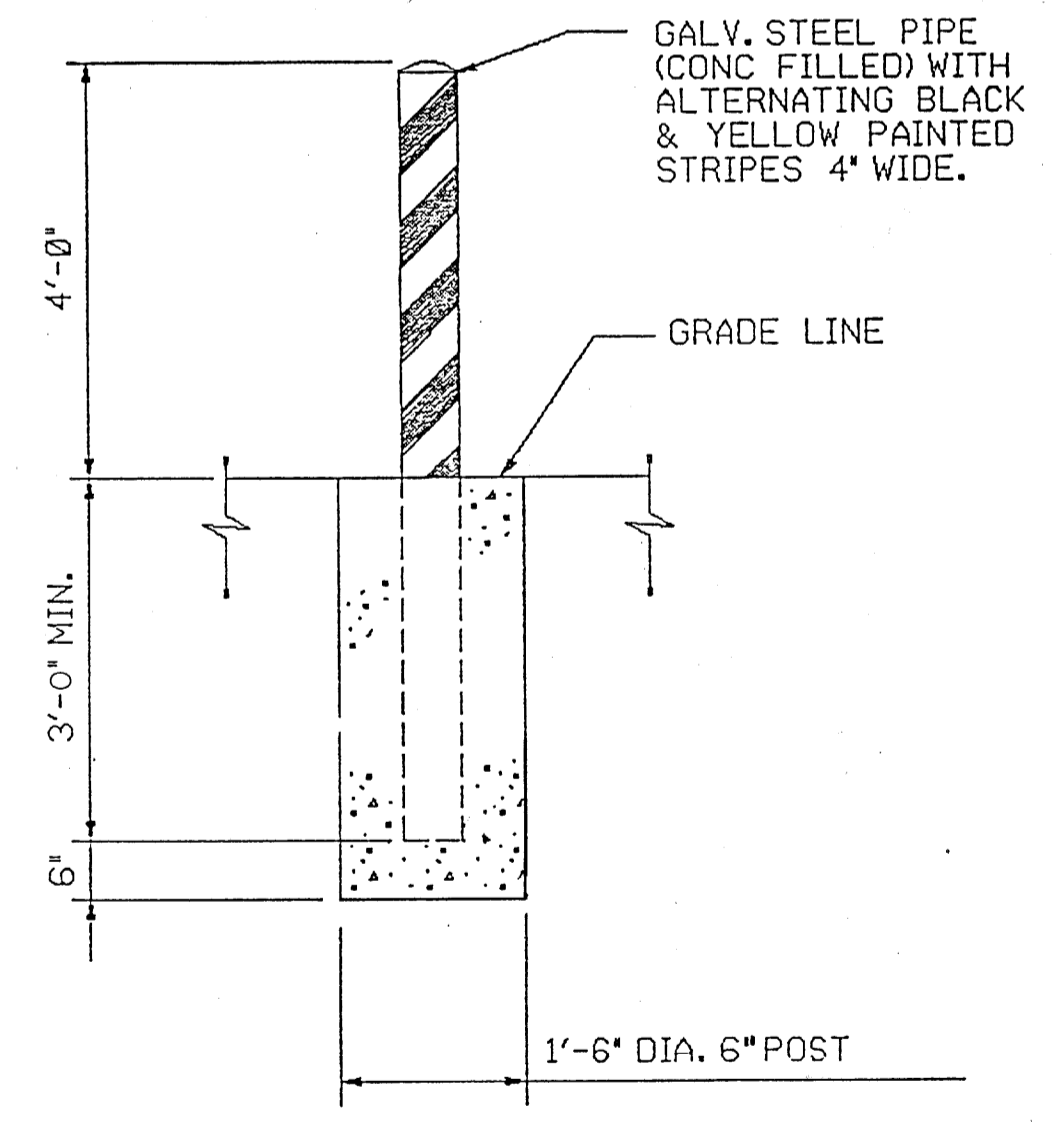

GUARD POST DETAIL

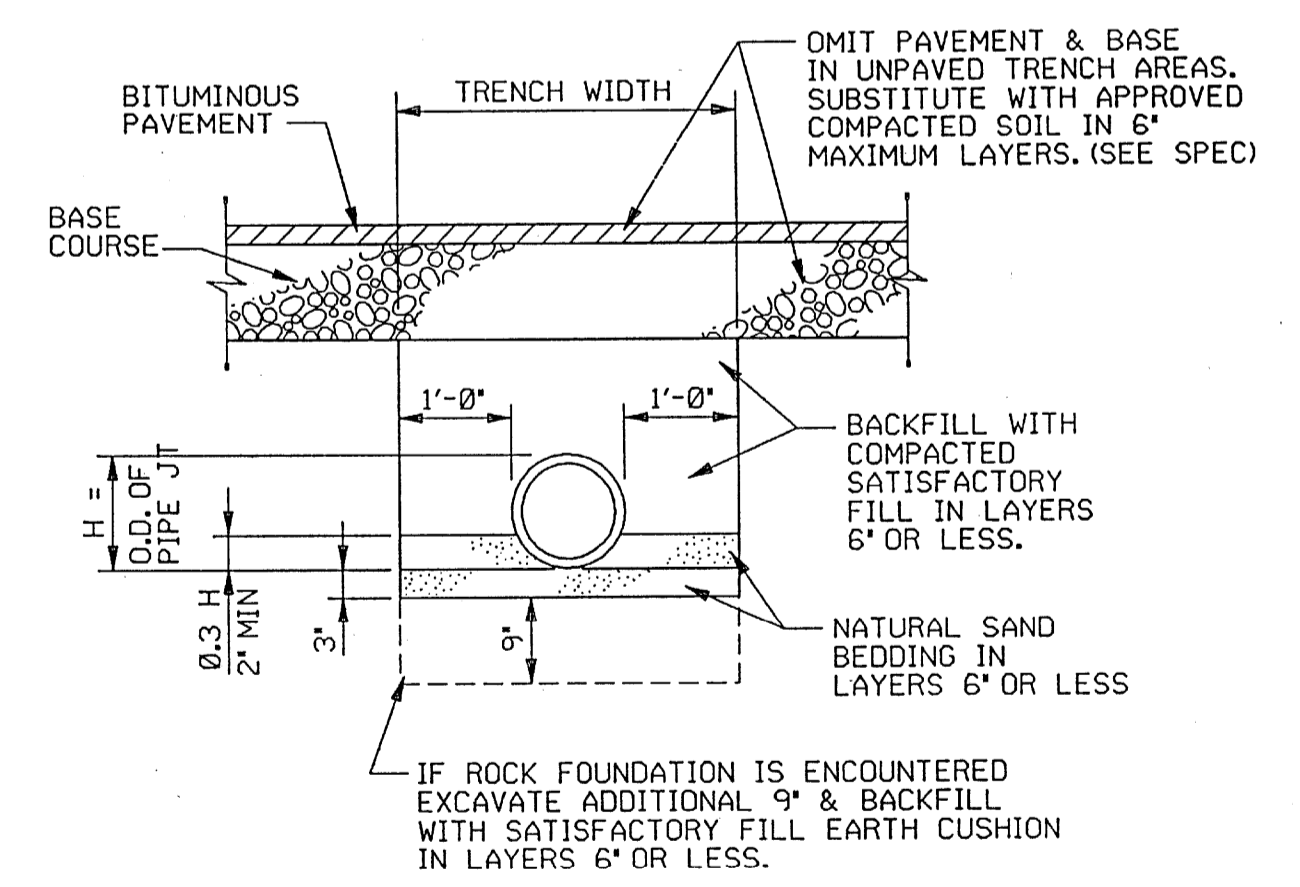

DOMESTIC AND FIRE WATER STORM AND SANITARY SEWER TRENCH AND BEDDING DETAIL

RECORD PRINTS
 THESE ARE RECORD PRINTS. THEY ARE NOT TO BE USED FOR CONSTRUCTION. ANY CHANGES TO THE ORIGINAL DESIGN SHALL BE MADE BY THE ENGINEER AND MUST BE INDICATED BY SIGNATURES.

ROBOTICS FACILITY
 LEXINGTON CAMPUS
 UNIVERSITY OF KENTUCKY
 LEXINGTON, KENTUCKY

University of Kentucky
 Lexington, Kentucky

10.19.87

SECTIONS AND DETAILS


Sherman Carter Barnhart
 PARTNERS IN ARCHITECTURE

JOB NO 2046
 DATE 10-19-87
 DRAWN BT
 CHECKED TOA
 FILE NO. 431.0

REVISIONS

SHEET

E
D
C
B
A

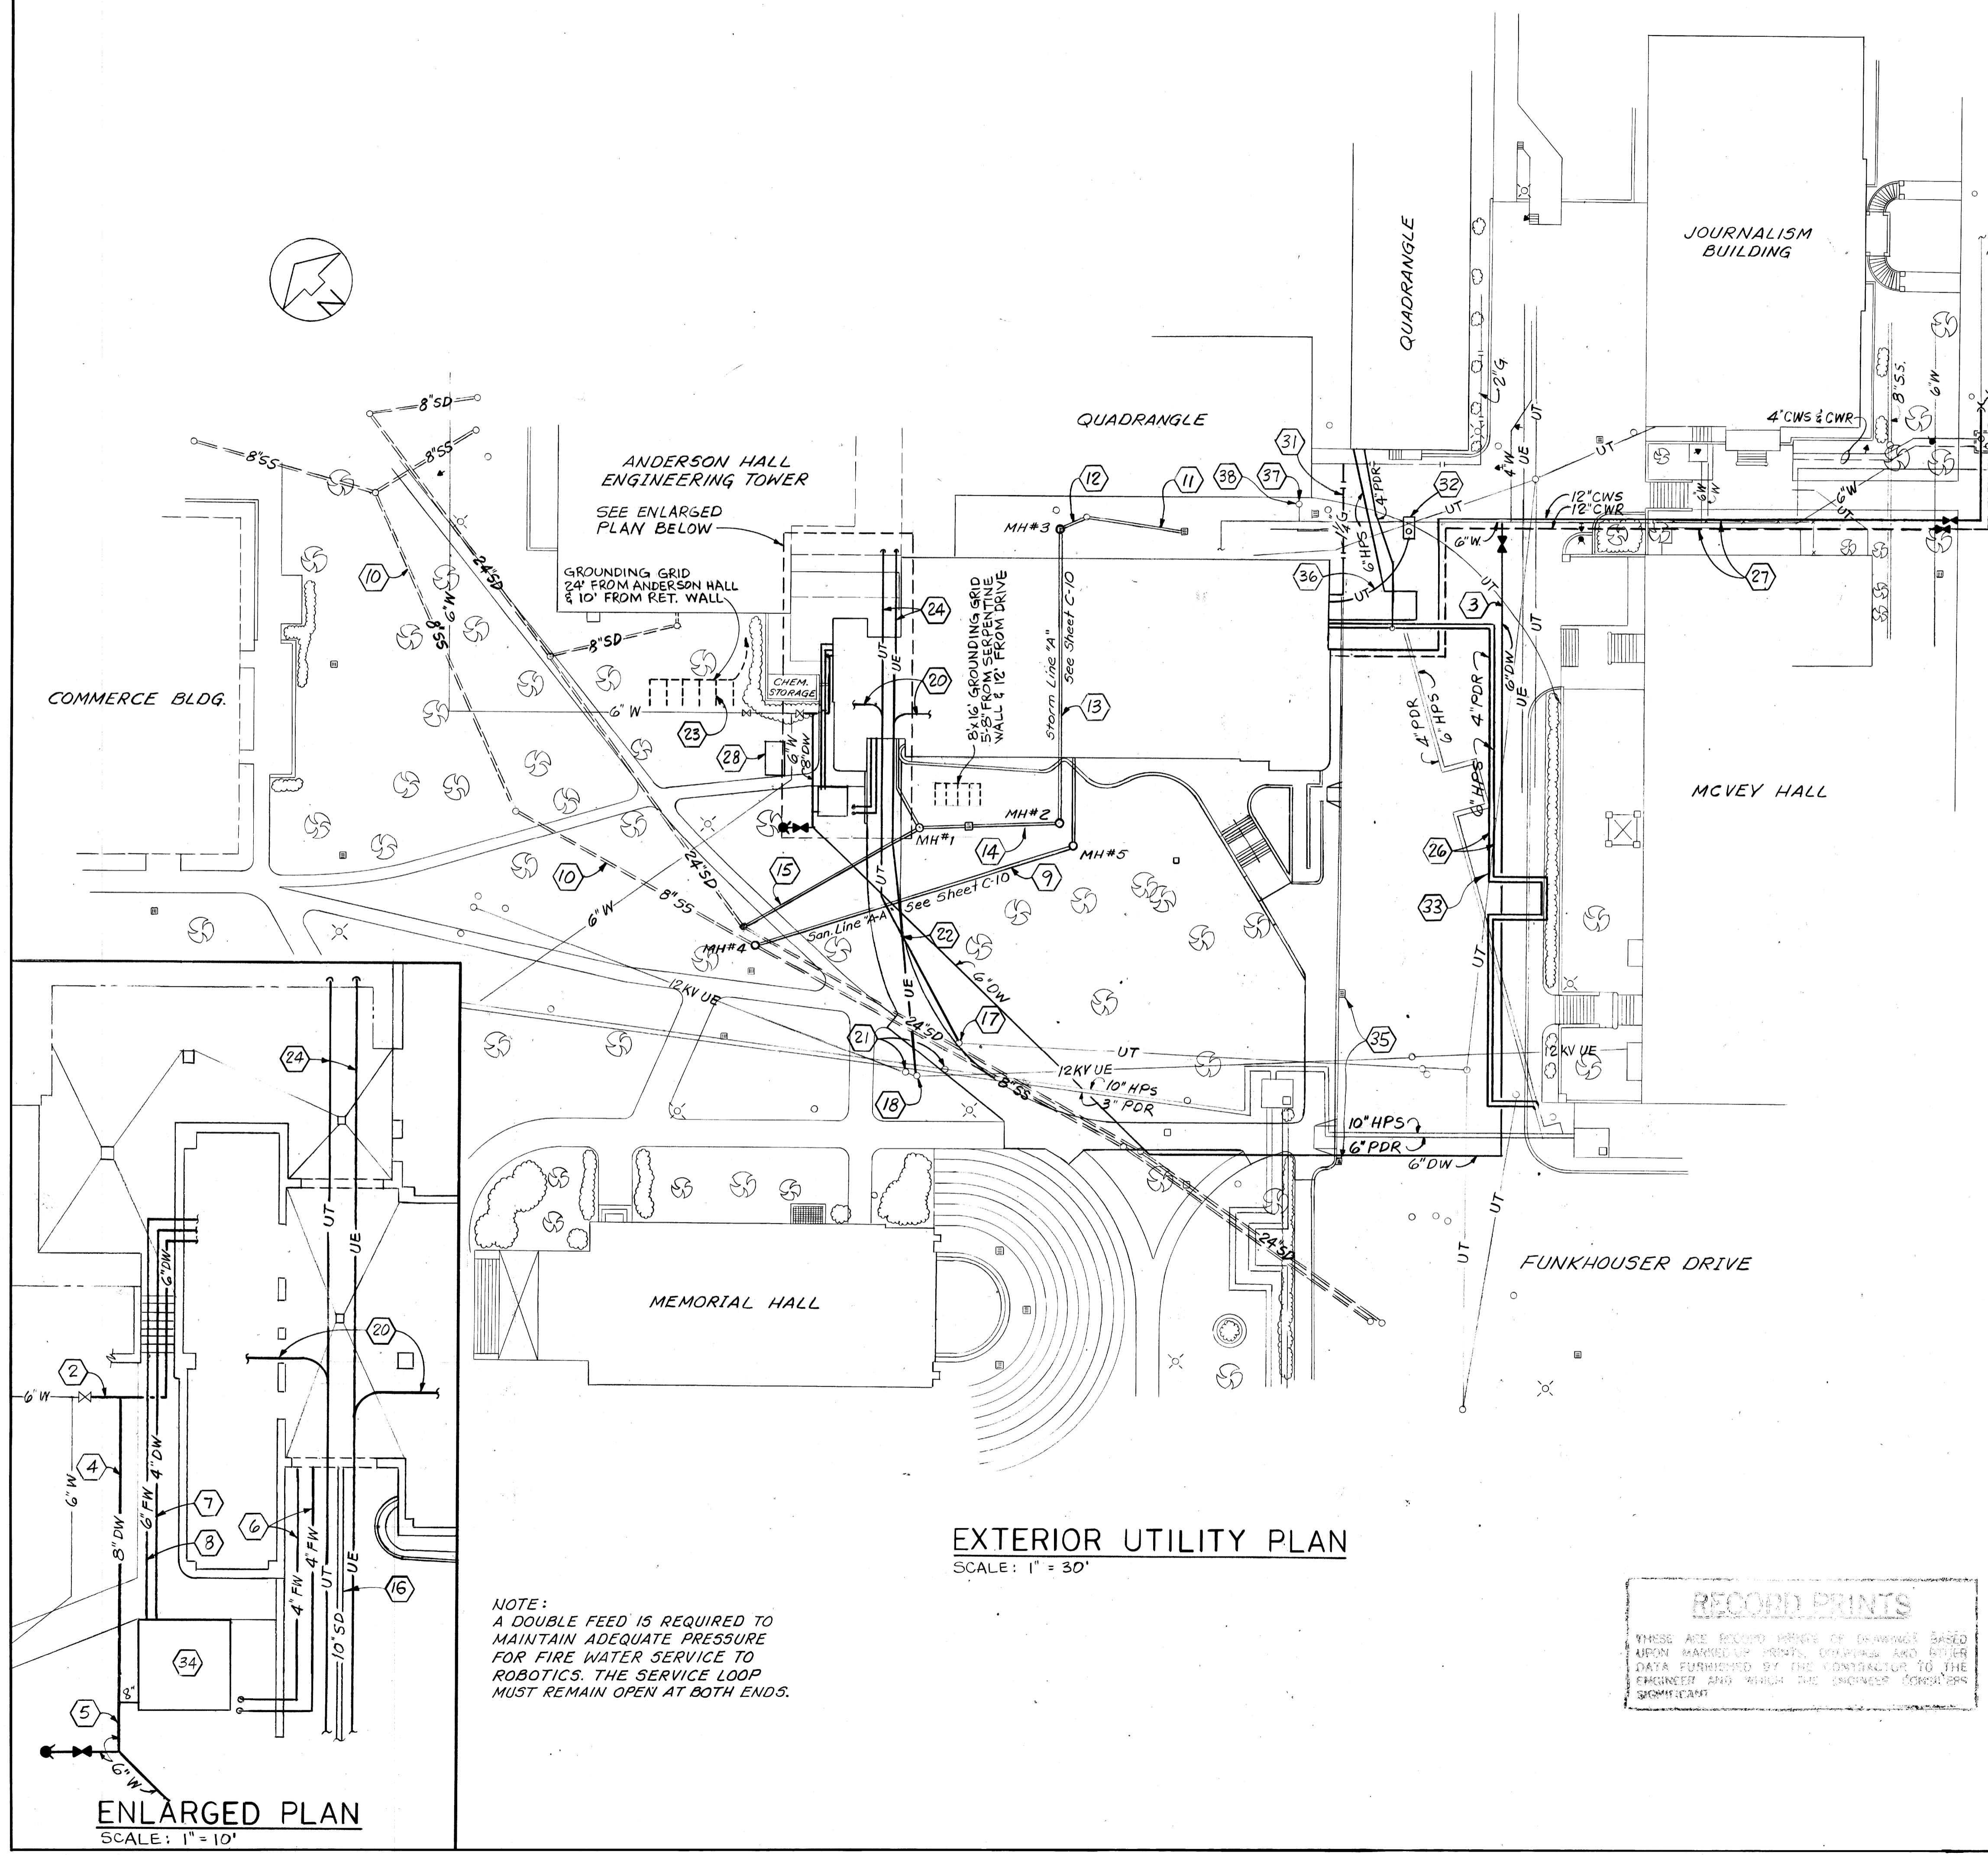

- UTILITY CONSTRUCTION NOTES
- OMIT 1. CAP EXISTING 6 INCH WATER LINE WEST OF SERVICE LINE TO QUADRANGLE.
 - OMIT 2. EXTEND 6 INCH DUCTILE IRON WATER LINE FROM EXISTING LINE TO INSIDE FACE OF ROBOTICS FACILITY AND STUB UP THROUGH THE FLOOR. SEE SHEET M-9 FOR CONTINUATION.
 - 3. EXTEND 6 INCH DUCTILE IRON WATER LINE FROM 6\"/>
 - 4. EXTEND 8 INCH DUCTILE IRON WATER LINE FROM EXISTING 6 INCH LINE TO METER VAULT. SEE SHEET C-7 FOR PIT DETAILS.
 - 5. EXTEND 6 INCH DUCTILE IRON WATER LINE TO FIRE HYDRANT, SEE SHEET C-7 FOR FIRE HYDRANT DETAIL.
 - 6. EXTEND TWO 4 INCH DUCTILE IRON FIRE MAINS FROM SIAMSESE CONNECTIONS IN METER VAULT TO OUTSIDE FACE OF ROBOTICS BUILDING. SEE SHEET M-24 FOR CONTINUATIONS.
 - 7. EXTEND 4 INCH DUCTILE IRON DOMESTIC WATER LINE FROM METER PIT AND STUB UP INSIDE ROBOTICS. SEE SHEET M-9 FOR CONTINUATION.
 - 8. EXTEND 6 INCH DUCTILE IRON FIRE MAIN FROM METER PIT AND STUB UP INSIDE ROBOTICS. SEE SHEET M-9 FOR CONTINUATION.
 - 9. EXTEND SANITARY SEWER FROM ROBOTICS THROUGH TWO MANHOLES AND CONNECT TO EXISTING SANITARY SEWER. SEE SHEET M-14 FOR CONTINUATION OF SEWER UNDER ROBOTICS. SEE SHEET C-8 FOR MANHOLE DETAILS.
 - 10. CONTRACTOR SHALL VERIFY THAT EXISTING SANITARY SEWER, FROM POINT OF CONNECTION, FOR AN APPROXIMATE DISTANCE OF 230 FEET DOWNSTREAM TO THE SECOND EXISTING MANHOLE, IS IN SATISFACTORY WORKING ORDER.
 - 11. CONNECT SURFACE INLET TO EXISTING MANHOLE WITH 8 INCH DUCTILE IRON STORM SEWER. SEE SHEET C-7 FOR DETAILS OF SURFACE INLET.
 - 12. CONNECT EXISTING MANHOLE TO NEW MANHOLE WITH 10 INCH DUCTILE IRON STORM SEWER.
 - 13. EXTEND 10 INCH STORM SEWER FROM MANHOLE NORTH OF ROBOTICS, UNDER BUILDING FOOTING TO MANHOLE SOUTH OF ROBOTICS.
 - 14. CONTINUE 10 INCH STORM SEWER SURFACE INLET AND ON TO MANHOLE.
 - 15. EXTEND 12 INCH DUCTILE IRON STORM SEWER FROM MANHOLE #1 TO EXISTING STORM SEWER MANHOLE AS INDICATED.
 - 16. EXTEND 10\"/>
 - 17. EXISTING TELEPHONE MANHOLE U-81.
 - 18. EXISTING ELECTRIC MANHOLE E-110.
 - OMIT 19. RELOCATE EXISTING 6\"/>
 - 20. SEE PARTIAL BASEMENT FLOOR PLAN, SHEET C-14. FOR CONDUIT STUB UP LOCATIONS INSIDE BUILDING.
 - 21. EXISTING AIR VENTS, MANHOLE E-110.
 - 22. MAINTAIN 12 INCH EARTH SEPARATION BETWEEN TELEPHONE AND ELECTRIC LINES.
 - 23. NEW GROUNDING GRID. SEE DETAIL SHEET C-15.
 - 24. TELEPHONE AND ELECTRIC DUCT BANKS TO ANDERSON HALLS MECHANICAL ROOM, SEE SHEET C-14-16 FOR DETAILS.
 - OMIT 25. EXISTING WATER METER PIT. REPLACE EXISTING COVER WITH HEAVY DUTY COVER, ADJUST ELEVATION TO MATCH NEW GRADE.
 - 26. HIGH PRESSURE STEAM AND PUMP DISCHARGE RETURN, SEE SHEETS C-11 THRU 13 FOR DETAILS.
 - 27. CHILLED WATER SUPPLY AND RETURN LINES, SEE SHEETS C-11 THRU 13 FOR DETAILS.
 - 28. UNDERGROUND FUEL OIL STORAGE TANK, LOCATED 15'-0\"/>
 - OMIT 29. SURFACE INLET, T/R ELEVATION 961.6, INVERT ELEVATION 962.0. SEE SHEET C-7 FOR CONSTRUCTION DETAILS.
 - OMIT 30. CONNECT SURFACE INLET TO EXISTING MANHOLE WITH 8 INCH DUCTILE IRON STORM SEWER. OUTFLOW INVERT ELEVATION AT MANHOLE 961.76. EXISTING MANHOLE INVERT ELEVATION IS 950.0.
 - 31. EXTEND 1-1/4 INCH STEEL GAS LINE FROM EXISTING 2 INCH LOW PRESSURE GAS MAIN INTO ROBOTICS BUILDING AS SHOWN. SEE SHEET M-10 FOR CONTINUATION INSIDE BUILDING.
 - 32. NEW TELEPHONE MANHOLE. SEE SHEET C-16 FOR DETAILS.
 - 33. MAINTAIN MAXIMUM SEPARATION BETWEEN NEW STEAM LINES AND EXISTING UNDERGROUND TELEPHONE LINES.
 - 34. WATER METER VAULT. SEE SHEET C-7 FOR VAULT AND VAULT PIPING DETAILS.
 - 35. SURFACE INLETS, SEE NOTE 15 ON SHEET C-4.
 - 36. PROVIDE DUCT BANK FROM NEW TELEPHONE MANHOLE TO ROOM B-02 IN BSMT OF ROBOTICS FACILITY. SEE DWG C-16 FOR DUCT BANK DETAILS. ENTER ROOM B-02 THROUGH THE EAST WALL, 8 FT. SOUTH OF COL. LINE E AT EL. 969.5.
 - 37. REPLACE EXIST PIT TOP SLAB WITH 8\"/>
 - 38. EXIST. WATER METER PIT. CONNECT EXIST. WATER LINE DIRECTLY TO EXIST. METER. PROVIDE REDUCER, COUPLINGS & DUCTILE IRON OR COPPER PIPE AS REQUIRED FOR CONNECTION. ABANDON LINE WEST OF CONNECTION.

EXTERIOR UTILITY PLAN
SCALE: 1" = 30'

NOTE:
A DOUBLE FEED IS REQUIRED TO MAINTAIN ADEQUATE PRESSURE FOR FIRE WATER SERVICE TO ROBOTICS. THE SERVICE LOOP MUST REMAIN OPEN AT BOTH ENDS.

RECORD PRINTS
THESE ARE RECORD PRINTS OF DRAWINGS BASED UPON MARKED UP PRINTS, CHANGES AND FIELD DATA FURNISHED BY THE CONTRACTOR TO THE ENGINEER AND WHICH THE ENGINEER CONSIDERS SUFFICIENT.

ENLARGED PLAN
SCALE: 1" = 10'


ROBOTICS FACILITY
LEXINGTON CAMPUS
UNIVERSITY OF KENTUCKY
LEXINGTON, KENTUCKY

University of Kentucky
Lexington, Kentucky
10-19-87
10-19-87


EXTERIOR UTILITY PLAN
Sherman Carter Barnhart
PARTNERS IN ARCHITECTURE
SUIT 1800 • 2401 WEST MAIN STREET • LEXINGTON, KY 40503 • 606-254-1500

JOB NO 2046
DATE 10-19-87
DRAWN PG
CHECKED TOA
FILE NO. 431.0


REVISIONS
SHEET
C-9
MASON & HANGER ENGINEERING INC.
ARCHITECT • ENGINEERS
LEXINGTON, KENTUCKY

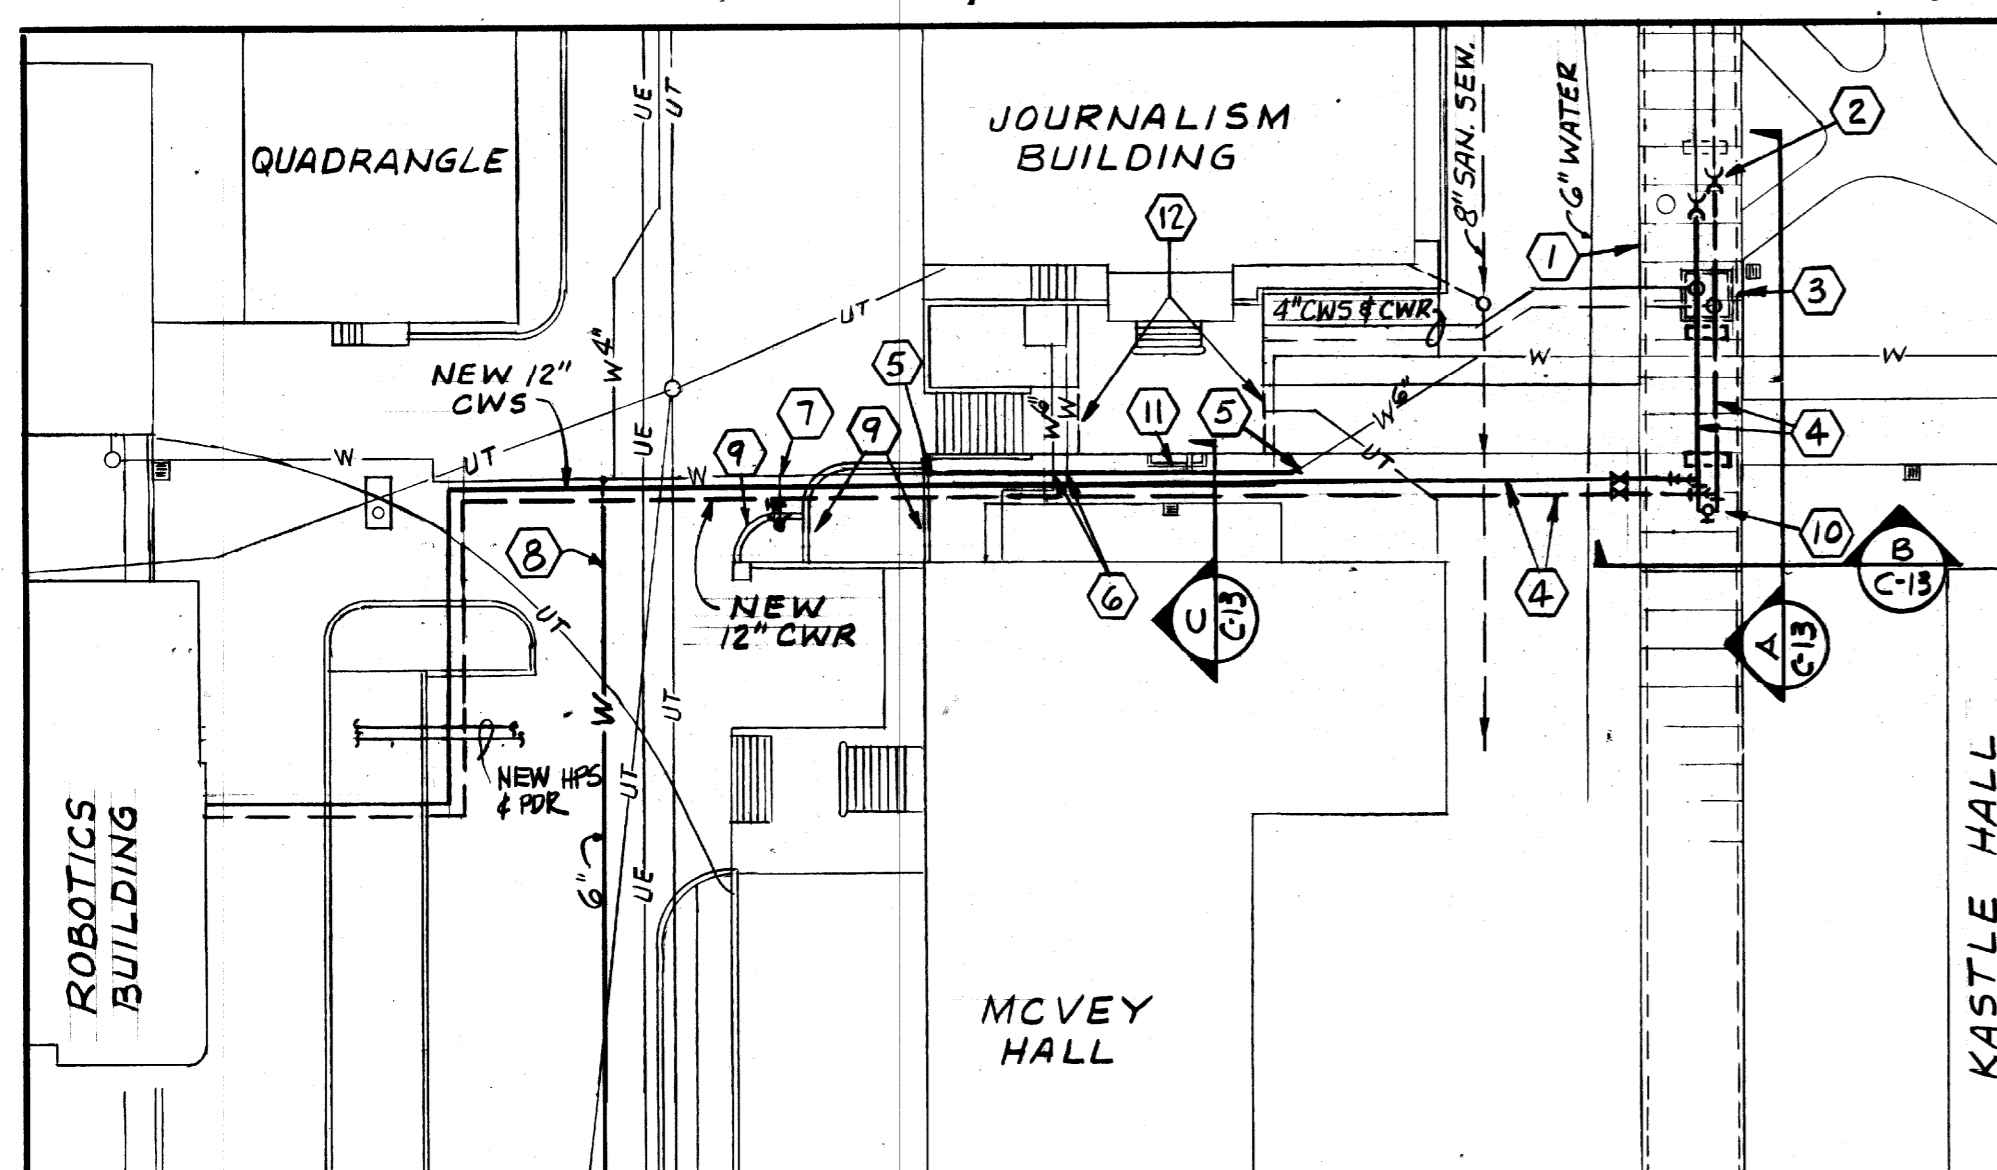

CWS & CWR PLAN
SCALE: 1" = 30'-0"

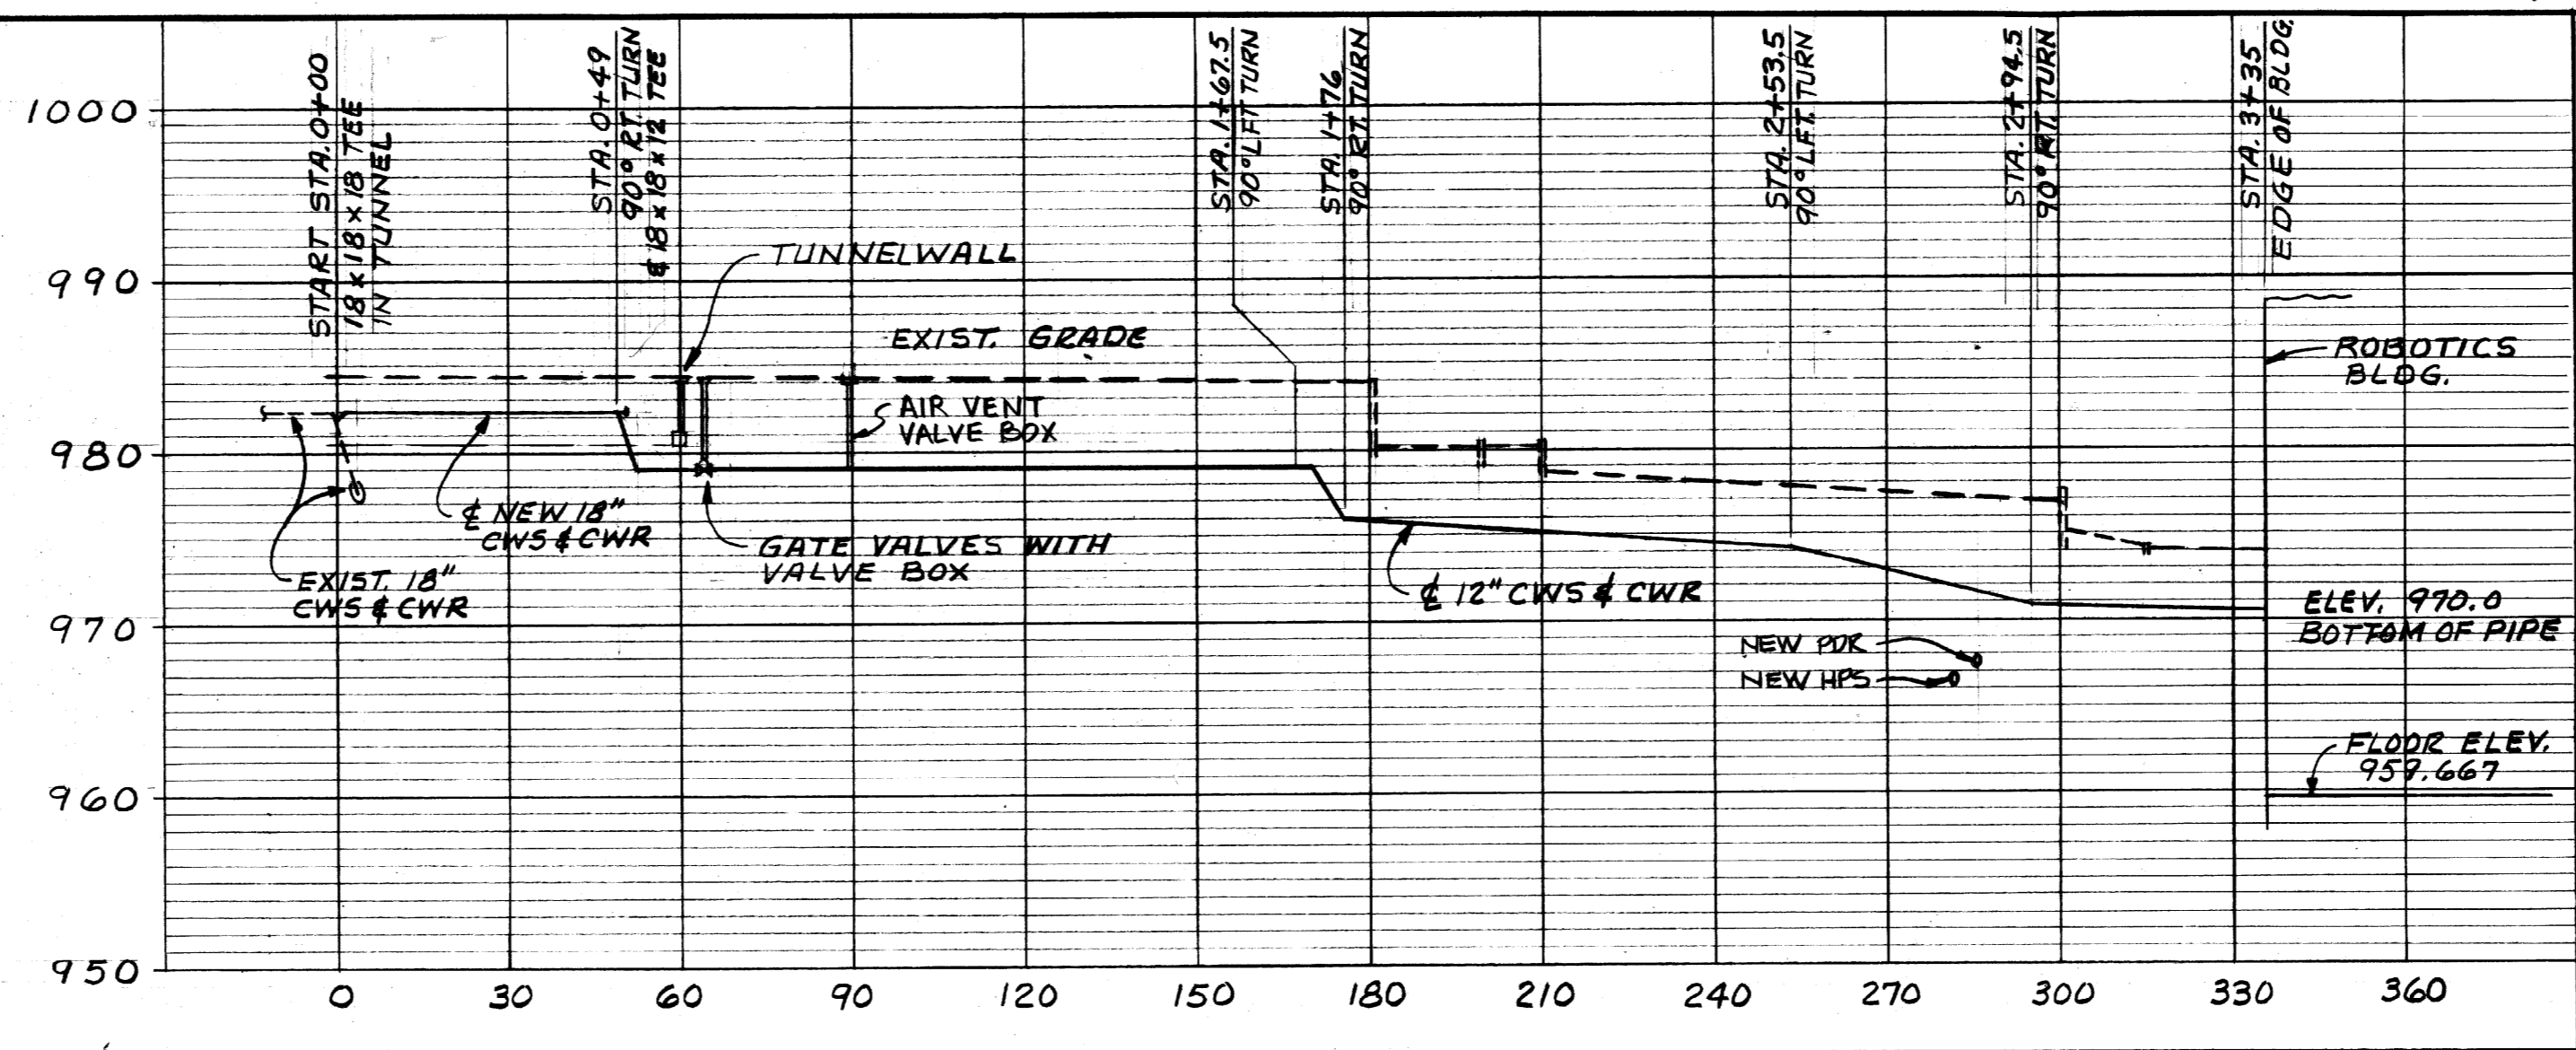


CWS & CWR PROFILE
SCALE: 1" = 10' VERT.
1" = 30' HORIZ.

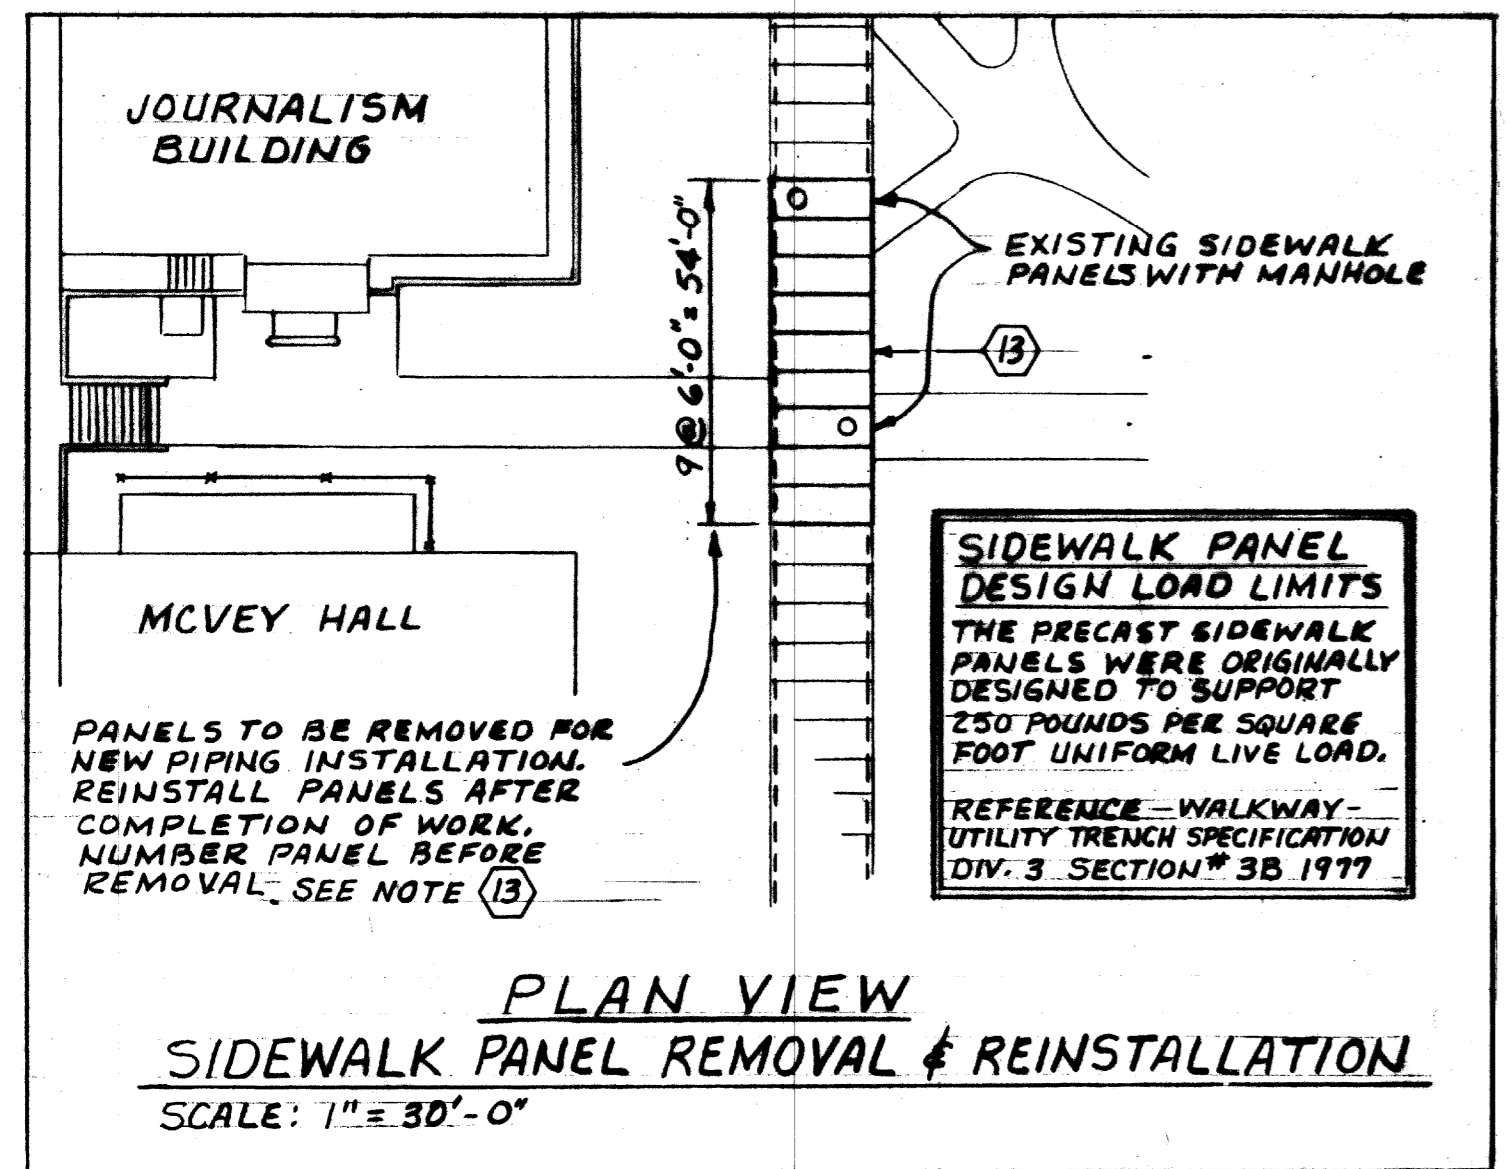


PLAN VIEW SIDEWALK PANEL REMOVAL & REINSTALLATION
SCALE: 1" = 30'-0"

SIDEWALK PANEL DESIGN LOAD LIMITS
THE PRECAST SIDEWALK PANELS WERE ORIGINALLY DESIGNED TO SUPPORT 250 POUNDS PER SQUARE FOOT UNIFORM LIVE LOAD.
REFERENCE - WALKWAY - UTILITY TRENCH SPECIFICATION DIV. 3 SECTION # 3B 1977


PANELS TO BE REMOVED FOR NEW PIPING INSTALLATION. REINSTALL PANELS AFTER COMPLETION OF WORK. NUMBER PANEL BEFORE REMOVAL. SEE NOTE (13)

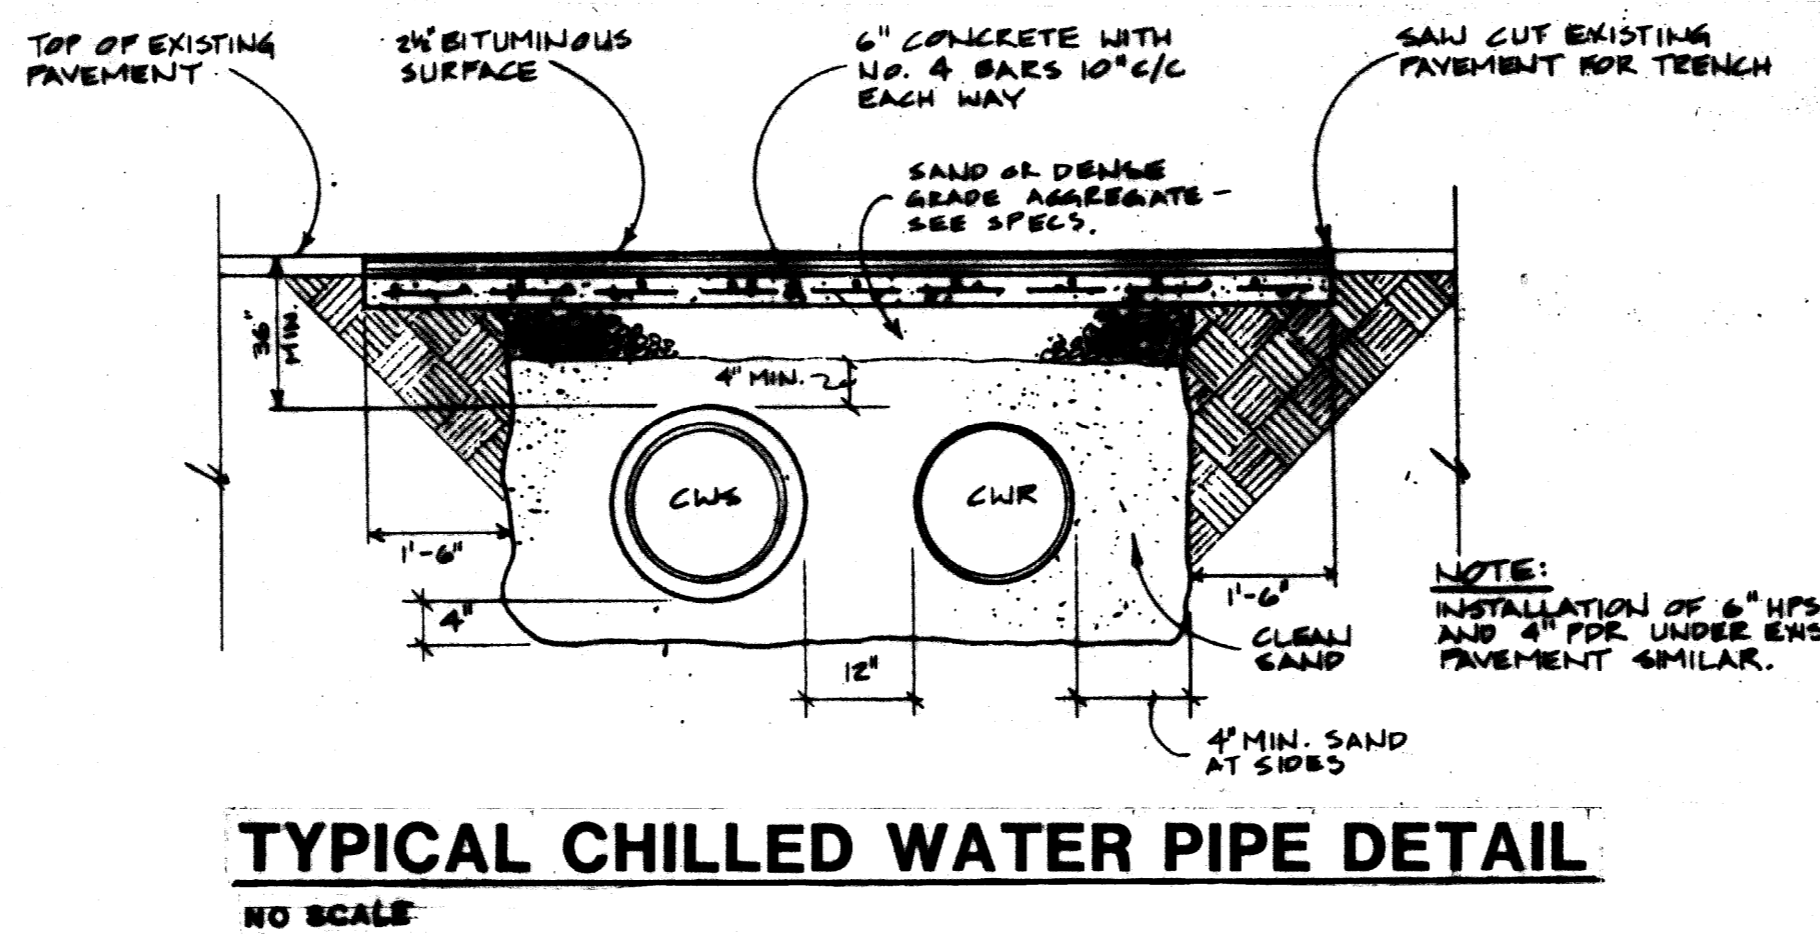


TYPICAL CHILLED WATER PIPE DETAIL
NO SCALE

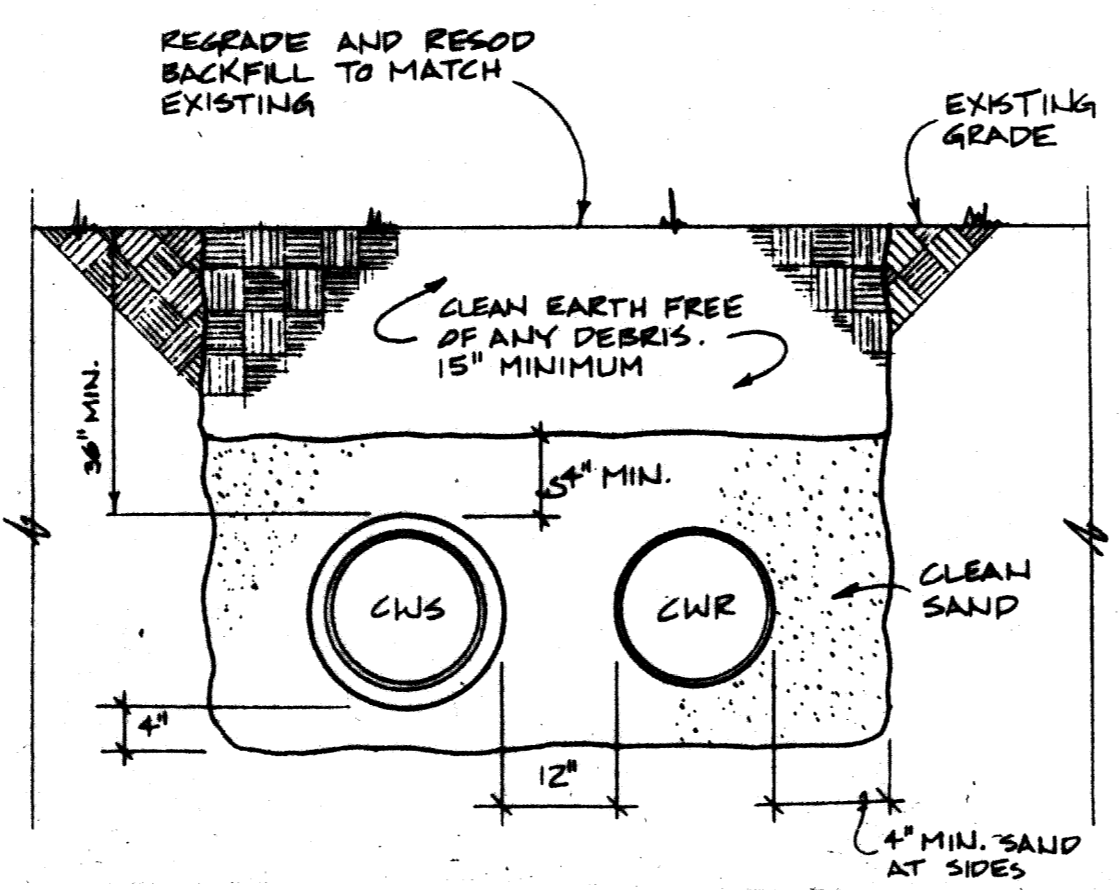

TYPICAL CHILLED WATER PIPE DETAIL
NO SCALE

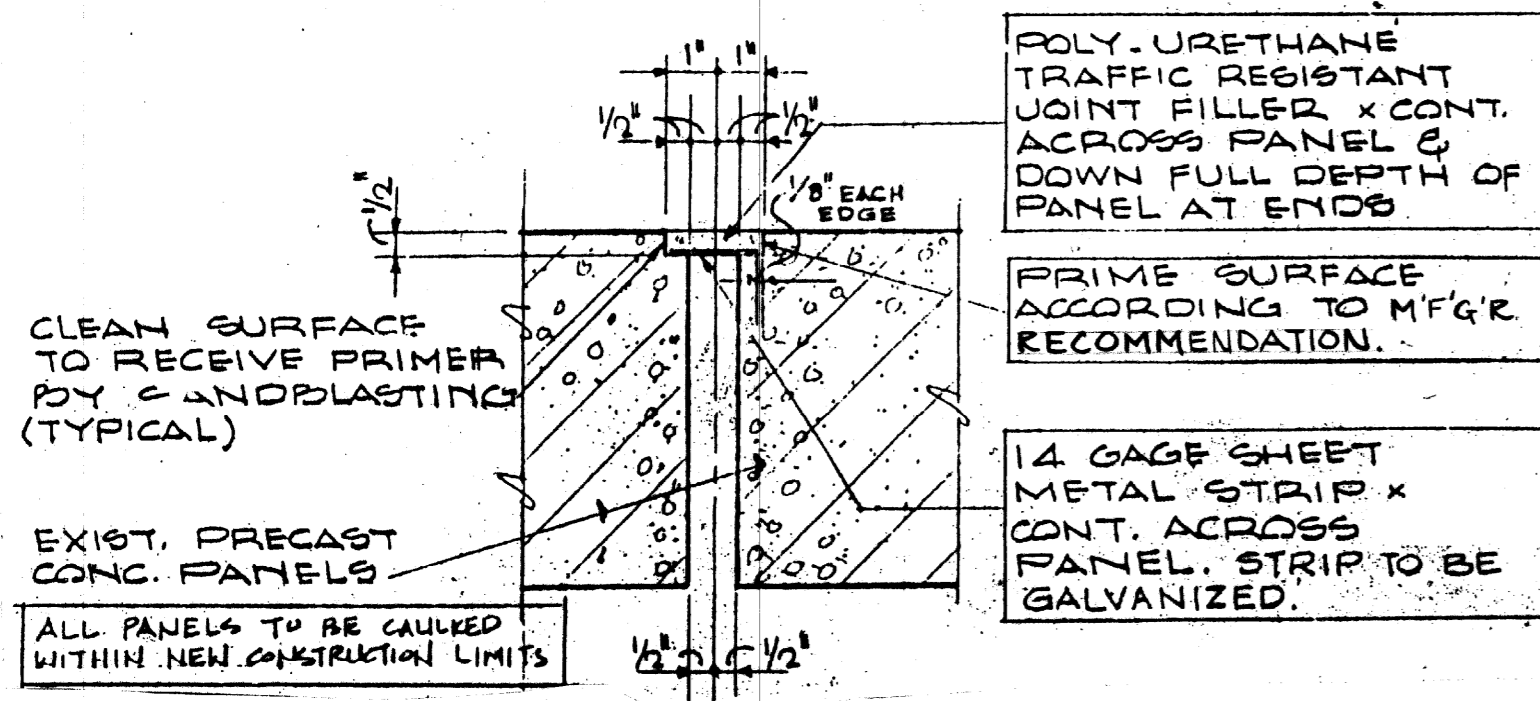


TYPICAL DETAIL FOR CAULKING OF PRECAST SIDEWALK PANELS
NO SCALE

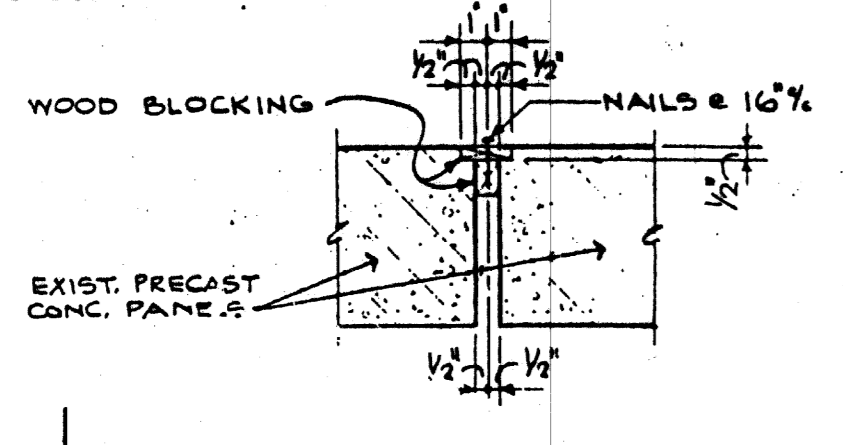

DETAIL SHOWS TEMPORARY CLOSING OF JOINTS BETWEEN PRECAST CONCRETE PANELS UNTIL WEATHER CONDITIONS ALLOW POLYURETHANE TRAFFIC RESISTANT JOINT FILLER TO BE INSTALLED.

TEMPORARY JOINT DETAIL
NO SCALE

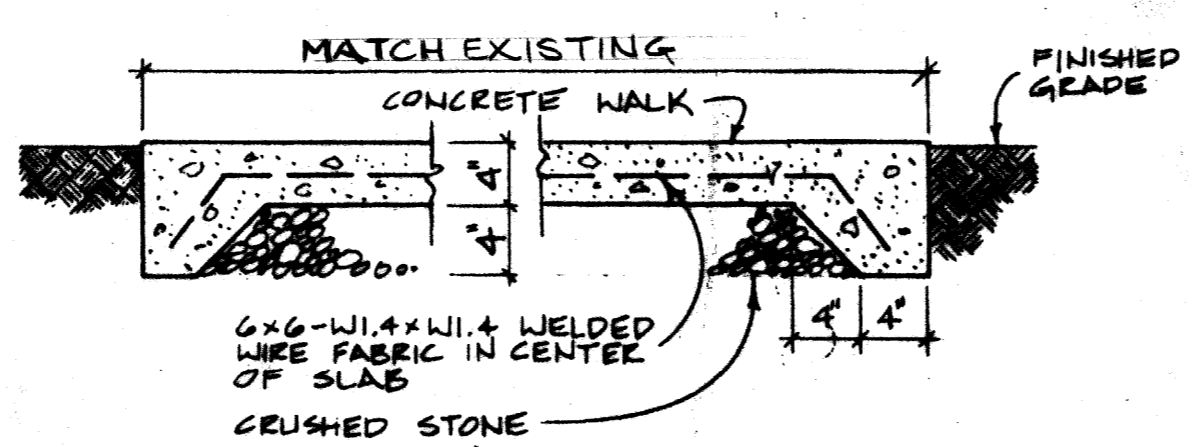


TYPICAL SIDEWALK DETAIL
NO SCALE

NOTES:

- (1) REMOVE, STORE, AND REPLACE SIDEWALK PANELS, AS DETAILED.
- (2) REMOVE EXISTING 10 INCH CWS AND CWR LINES, DISCONNECTING 4 INCH CWS AND CWR TO JOURNALISM BUILDING. REPLACE EXISTING 18 X 18 X 10 INCH TEES AND SPOOL PIECE WITH NEW 18 X 18 X 18 TEES, 18 INCH SPOOL PIECE AND 18" PIPE AS DETAILED IN SECTION - B.
- (3) RECONNECT 4 INCH CWS AND CWR LINE TO JOURNALISM BUILDING.
- (4) EXTEND NEW 18 INCH CWS AND CWR LINES IN TUNNEL AND NEW 12 INCH CWS AND CWR LINES FROM NEW 18 INCH LINES TO ROBOTICS BUILDING. SEE SECTIONS - A & B.
- (5) PROVIDE NEW 6 INCH WATER LINE TO RELOCATE THIS UTILITY TO POSITION SHOWN IN SECTION - C. INSTALL NEW PORTION TO THE FULL EXTENT POSSIBLE BEFORE MAKING FINAL CONNECTIONS TO THE EXISTING LINE TO KEEP THE SERVICE INTERRUPTION TO A MINIMUM. REMOVE OLD PIPE BETWEEN NEW CONNECTION POINTS.
- (6) RECONNECT EXISTING BRANCH LINES TO JOURNALISM BUILDING AND MCVEY HALL AS REQUIRED KEEPING SERVICE INTERRUPTION TO A MINIMUM.
- (7) RELOCATED EXISTING FIRE HYDRANT, VALVE AND VALVE BOX AS REQUIRED TO CLEAR NEW 12 INCH CWS AND CWR LINES. REPLACE EXISTING PLANTER CURB AROUND FIRE HYDRANT AS REQUIRED TO ACCOMMODATE NEW HYDRANT AND VALVE LOCATION.
- (8) CONNECT NEW 6 INCH WATER LINE FROM THE ROBOTICS BUILDING TO THE EXISTING 6 INCH WATER MAIN.
- (9) REPLACE PLASTER RETAINING WALLS, CURBS AND ANY OTHER DAMAGED SURFACES CAUSED BY CONSTRUCTION.
- (10) TERMINATE 18 INCH LINES WITH BLIND FLANGES. PROVIDE 1 INCH CROSS OVER CIRCULATION LINE WITH GLOBE VALVE FOR FREEZE PROTECTION.
- (11) REMOVE EXISTING AREAWAY AND REPLACE WITH NEW 70 INCH LONG BY 18 INCH WIDE (INSIDE DIMENSIONS) AREAWAY. MAINTAIN BOTTOM DRAIN IF IT EXISTS AND MODIFY AS NECESSARY. SEE SECTION - C.
- (12) JOURNALISM BUILDING MECHANICAL ROOM EXTENDS BELOW SIDEWALK. ROOF SLAB WILL NOT SUPPORT HEAVY EQUIPMENT LOADS. THE CONTRACTOR SHALL KEEP THIS AREA FREE OF ALL EQUIPMENT LOADS.
- (13) SIDEWALK PANELS TO BE REMOVED SHALL BE HANDLED WITH CARE TO ELIMINATE BREAKAGE OR OTHER DAMAGE. PANELS SHALL BE LIFTED BY SUPPORTING EACH END USING FABRIC SLINGS OR A SUITABLE CRADLE. REMOVED PANELS SHALL BE CAREFULLY STACKED USING WOOD BLOCKING NEAR EACH END AND STACKING NO MORE THAN THREE PANELS HIGH. PANELS REST ON NEOPRENE PADS ON THE TUNNEL WALLS. PADS MAY NEED REPLACING IF DAMAGE OF ANY NATURE OCCURS DURING PANEL REMOVAL.

RECORD PRINTS

THESE ARE RECORD PRINTS OF DRAWINGS BASED UPON MARKED UP PRINTS, DRAWINGS AND OTHER DATA FURNISHED BY THE CONTRACTOR TO THE ENGINEER AND WHICH THE ENGINEER CONSIDERS SIGNIFICANT

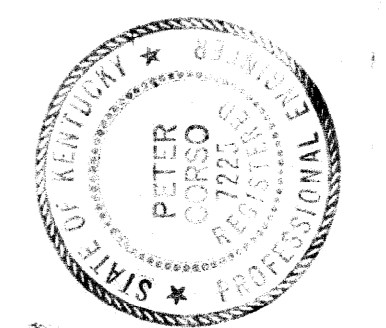

ROBOTICS FACILITY
LEXINGTON CAMPUS
UNIVERSITY OF KENTUCKY
LEXINGTON, KENTUCKY

University of Kentucky
Lexington, Kentucky
S. Carter Barnhart
Professional Engineer
No. 19147


CHILLED WATER DETAILS
S. Carter Barnhart
PARTNERS IN ARCHITECTURE
SUIT. 1000 - 500 WEST MAIN STREET - LEXINGTON, KY 40502-1000

JOB NO. 2046
DATE 10-19-87
DRAWN FDK
CHECKED R
FILE NO. 4310


REVISIONS

SHEET
C-11

MASON & HANGER ENGINEERING INC.
ARCHITECT • ENGINEERS
LEXINGTON, KENTUCKY

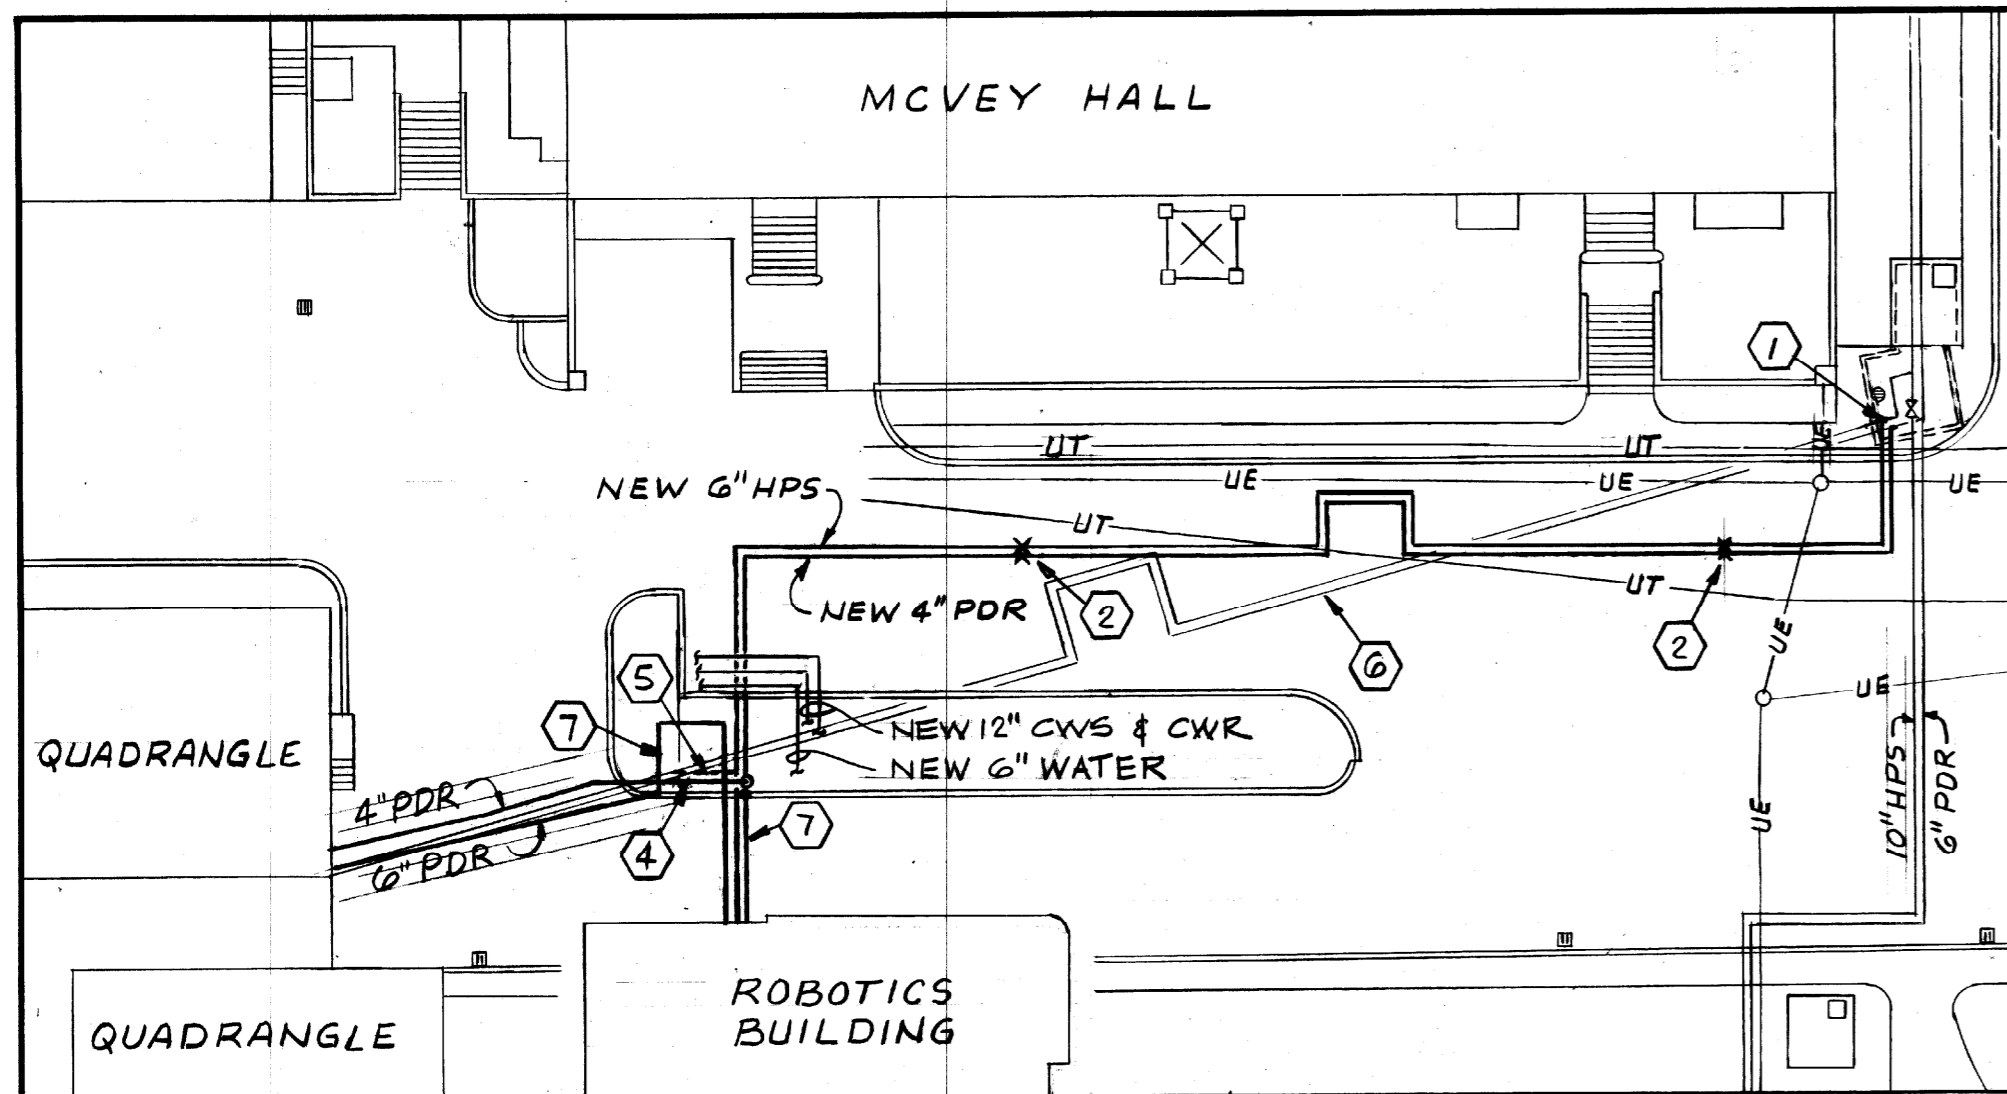


STEAM & PDR PLAN
SCALE: 1" = 30'

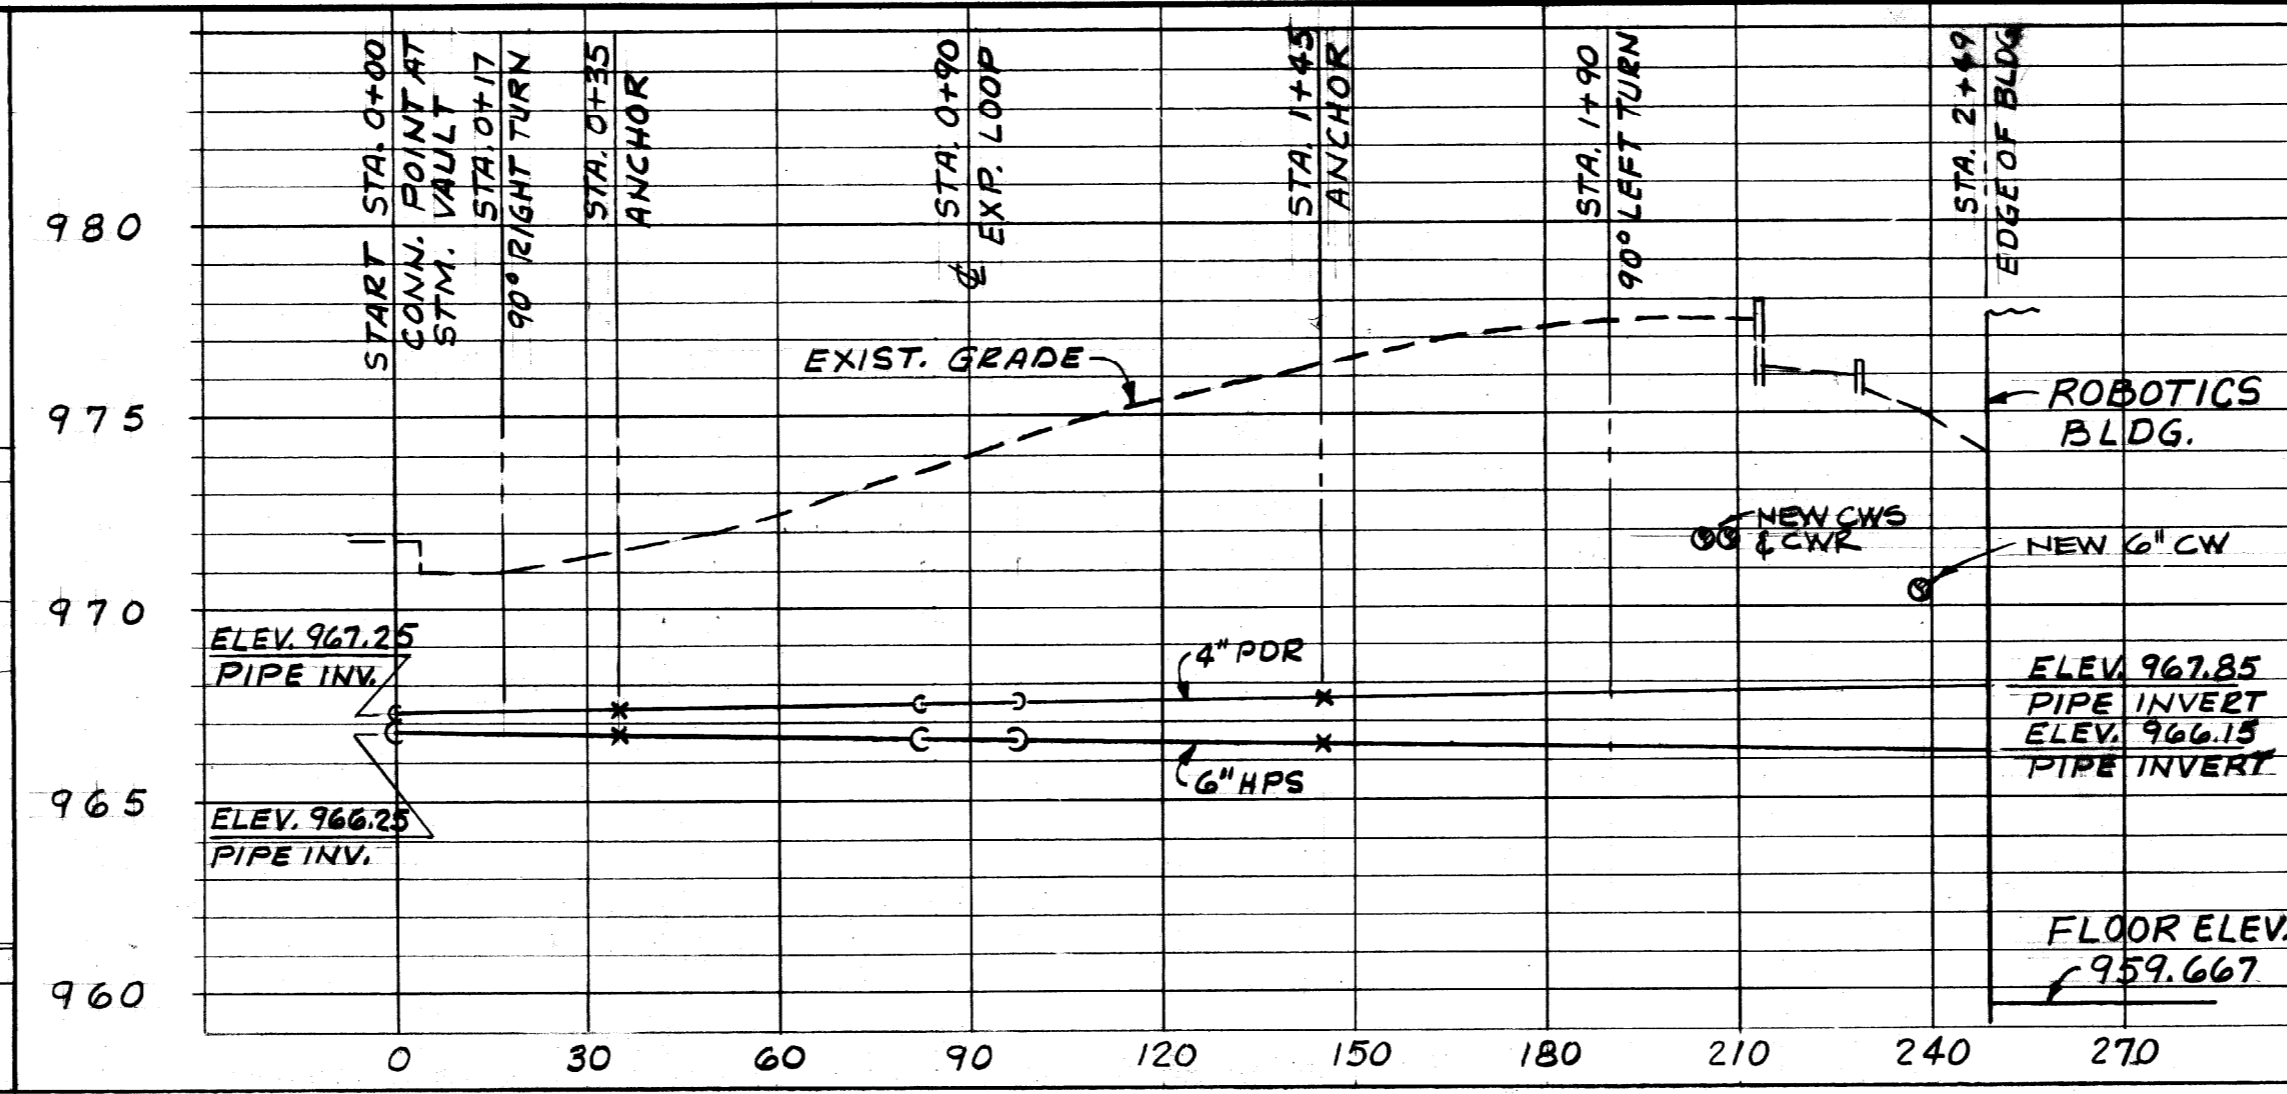


STEAM & PDR PROFILE
SCALE: 1" = 5' VERT.
1" = 30' HORIZ.

NOTE: DATA IS BASED ON ASSUMED CONNECTION POINT LOCATION & ELEVATION. ADJUST STATIONING & ELEVATION TO SUIT ACTUAL FIELD CONDITIONS.


- NOTES:
- CONNECT TO EXISTING 6 INCH HPS AND 4 INCH PDR FROM STEAM VAULT. ADJUST ELEVATION AND LOCATION AS REQUIRED AND RUN NEW 6 INCH HPS AND 4 INCH PDR AS SHOWN. REMOVE PORTIONS OF EXISTING 6 INCH HPS AND 4 INCH PDR ONLY AS REQUIRED TO MAKE NEW CONNECTIONS AND ACCOMMODATE THE NEW INSTALLATION. REMAINDER MAY BE ABANDONED.
 - ANCHOR POINTS.
 - REMOVE EXISTING SADDLES AS REQUIRED TO INSTALL EXPANSION LOOP. REPLACE SADDLES TO MATCH EXISTING AT COMPLETION OF WORK.
 - PROVIDE A NEW 4 INCH PDR CONNECTION FROM THE EXISTING 4 INCH PDR COMING FROM THE QUADRANGLE, TO THE NEW 4 INCH PDR. PROVIDE A TEE WITH BLIND FLANGE AT CONNECTION POINT TO NEW 4 INCH PDR FOR CONNECTING TO THE NEW 4 INCH PDR FROM THE ROBOTICS BUILDING.
 - PROVIDE A TEMPORARY 6 INCH CONNECTION FROM THE EXISTING 6 INCH HPS SERVING THE QUADRANGLE, TO THE NEW 6 INCH HPS. THIS TEMPORARY CONNECTION WILL PROVIDE STEAM TO THE QUADRANGLE DURING ROBOTICS BUILDING CONSTRUCTION.
 - ABANDON EXISTING 6 INCH HPS AND 4 INCH PDR BETWEEN NEW CONNECTIONS.
 - WHEN ROBOTICS BUILDING CONSTRUCTION PERMITS, EXTEND NEW 6 INCH HPS INTO BUILDING AND RUN A NEW 6 INCH HPS FROM A 6 INCH HPS LINE CONNECTION POINT INSIDE THE BUILDING TO THE NEW 6 INCH HPS SERVING THE QUADRANGLE, PROVIDING AN EXPANSION LOOP AS SHOWN. REMOVE TEMPORARY 6 INCH HPS CONNECTING LINE IF IN PLACE.

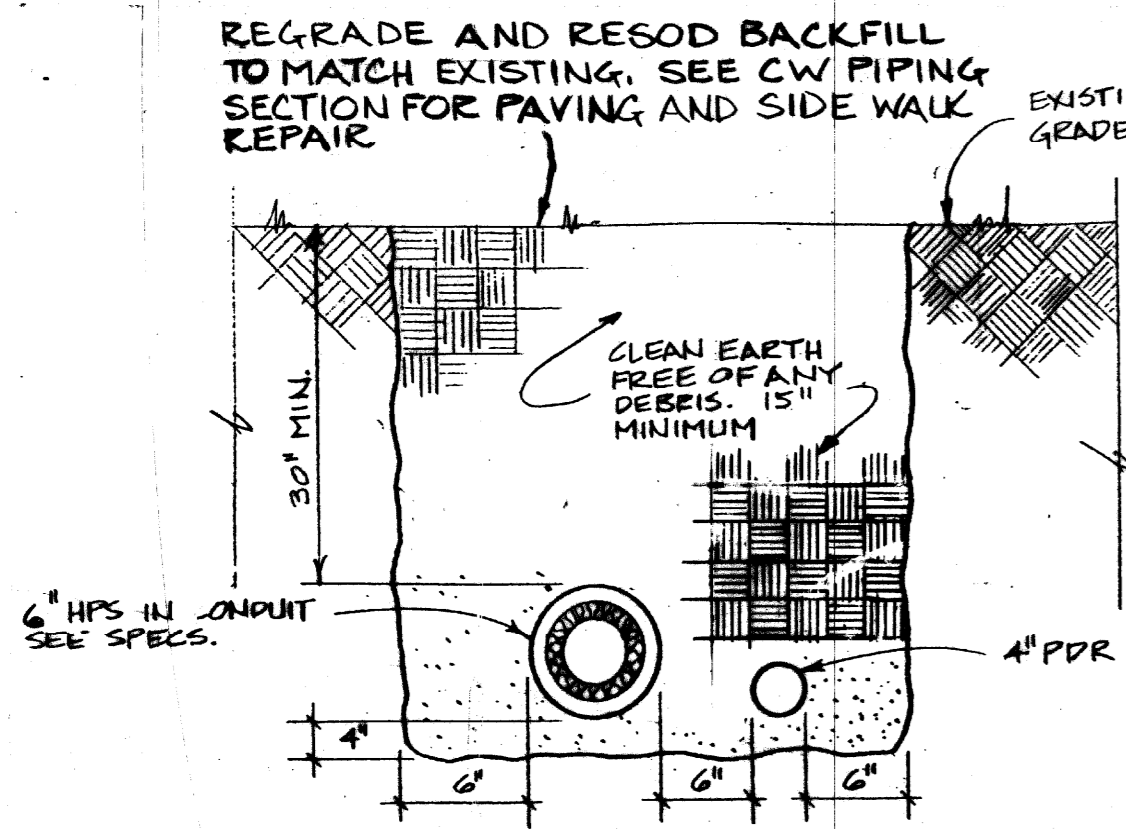


STEAM & PDR DETAIL
NO SCALE

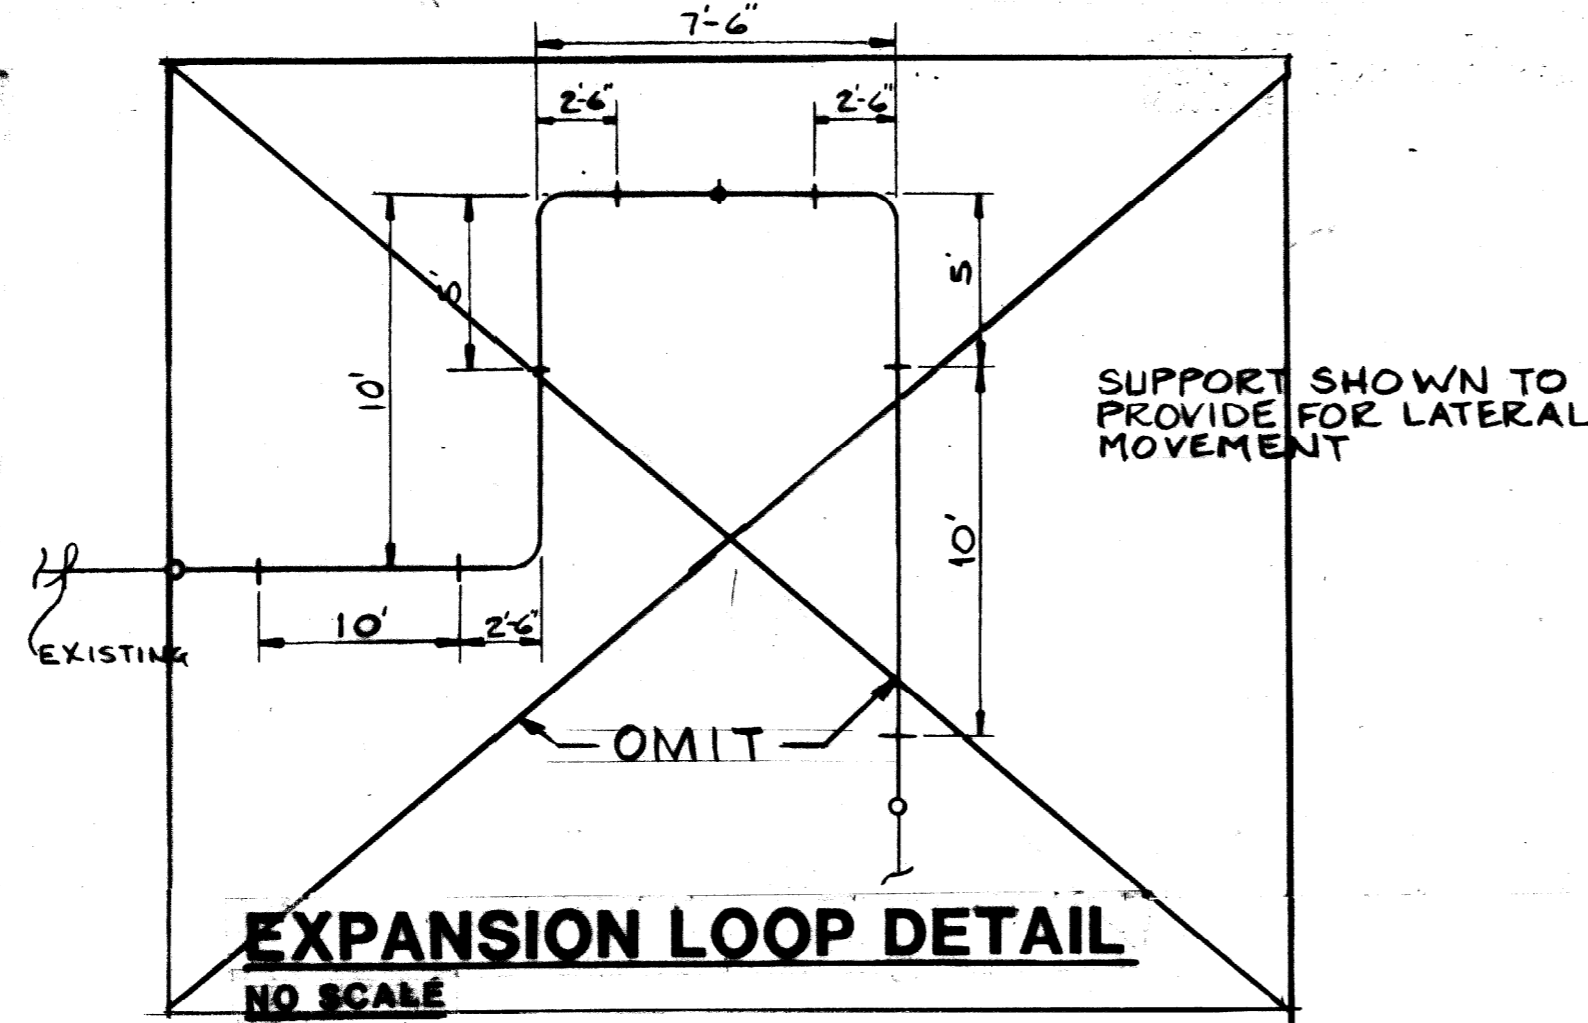


EXPANSION LOOP DETAIL
NO SCALE

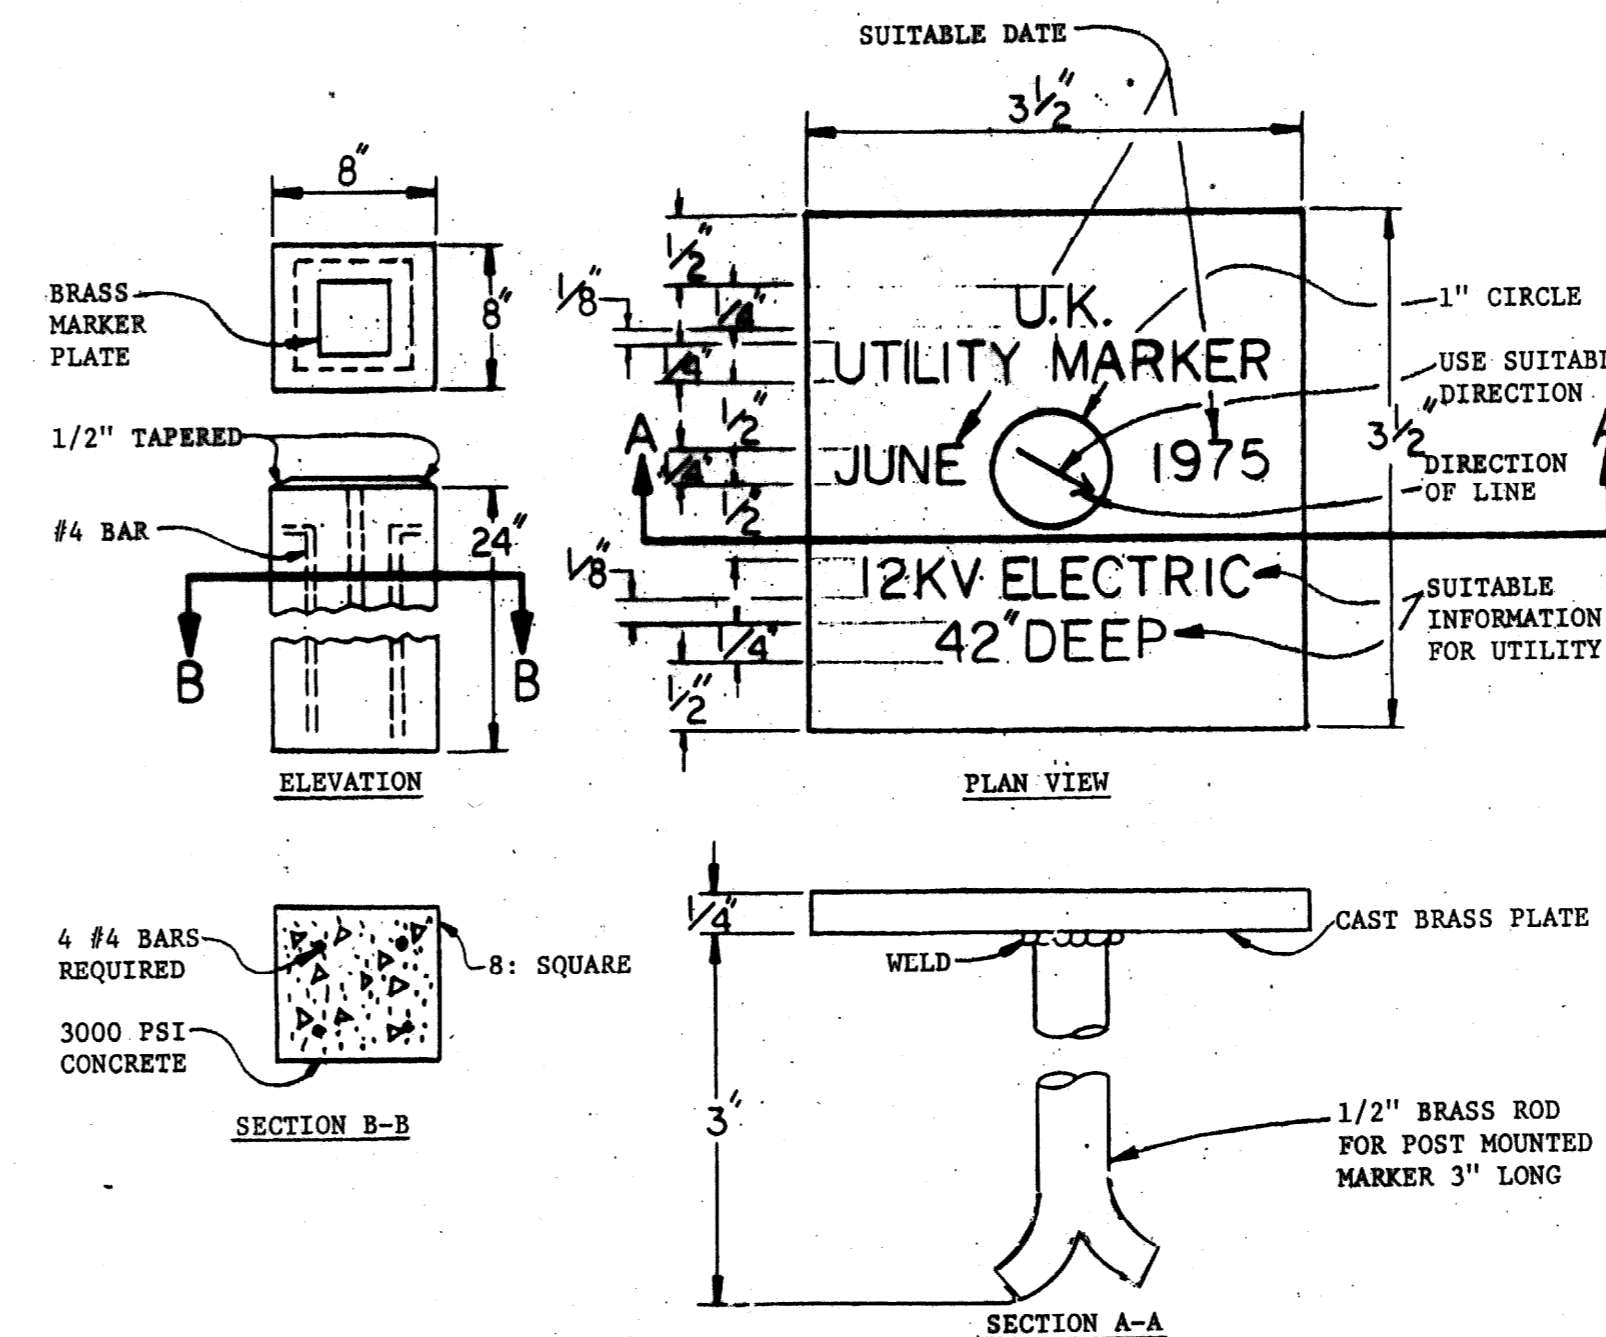


UTILITY MARKER DETAIL
NO SCALE

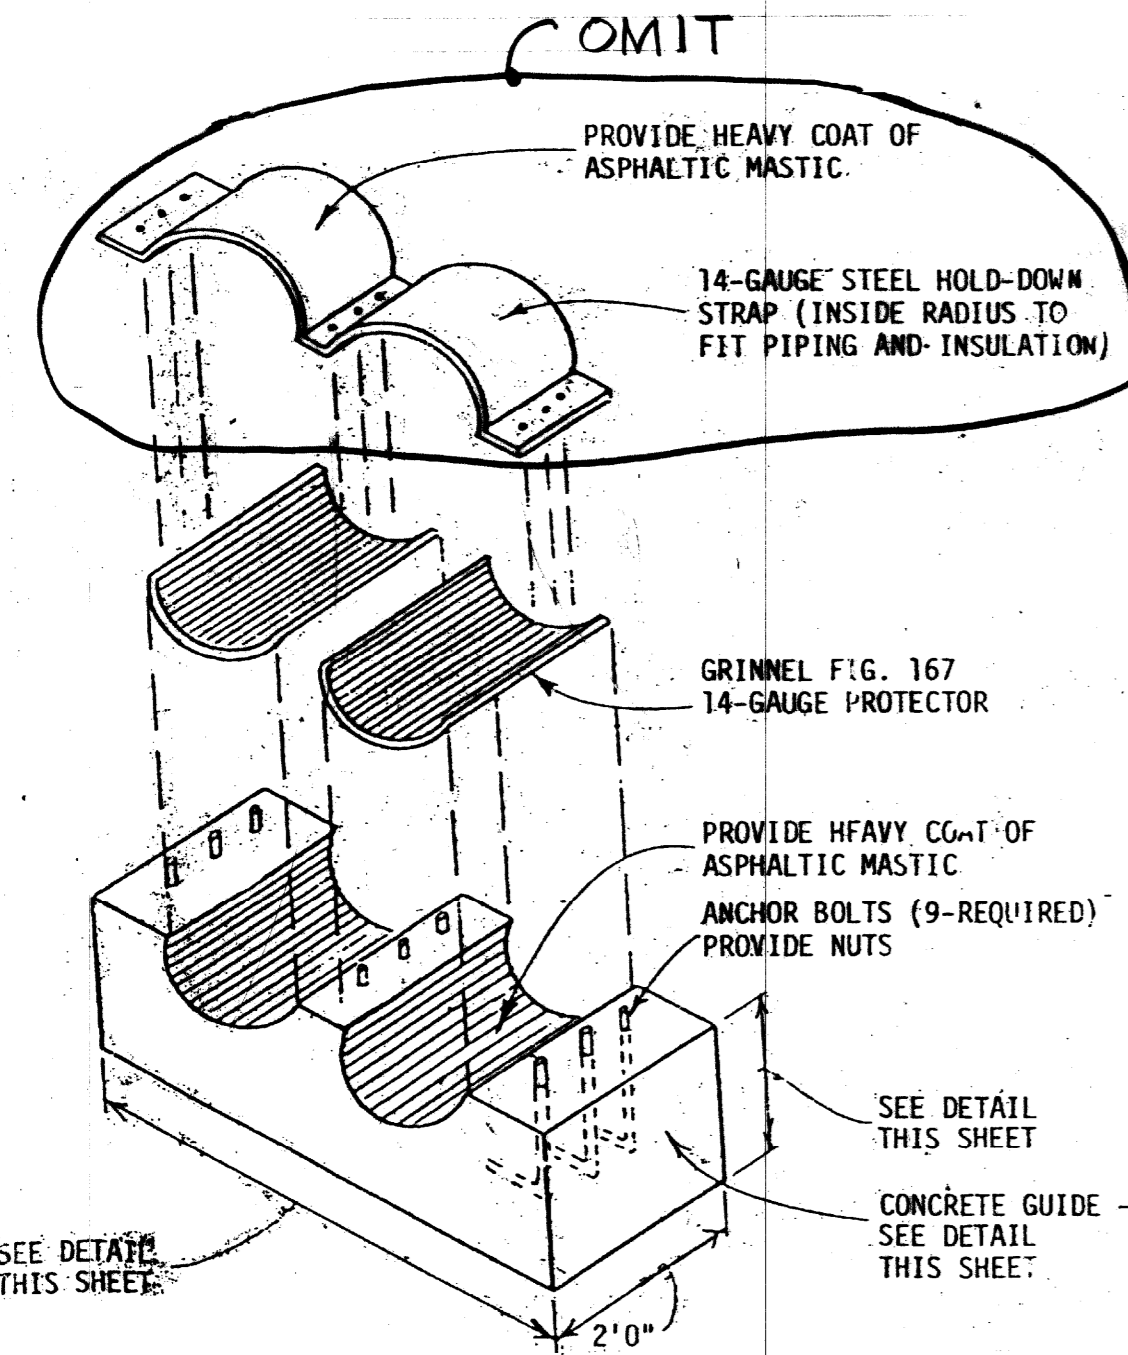

TYPICAL PIPE GUIDE DETAIL
NO SCALE

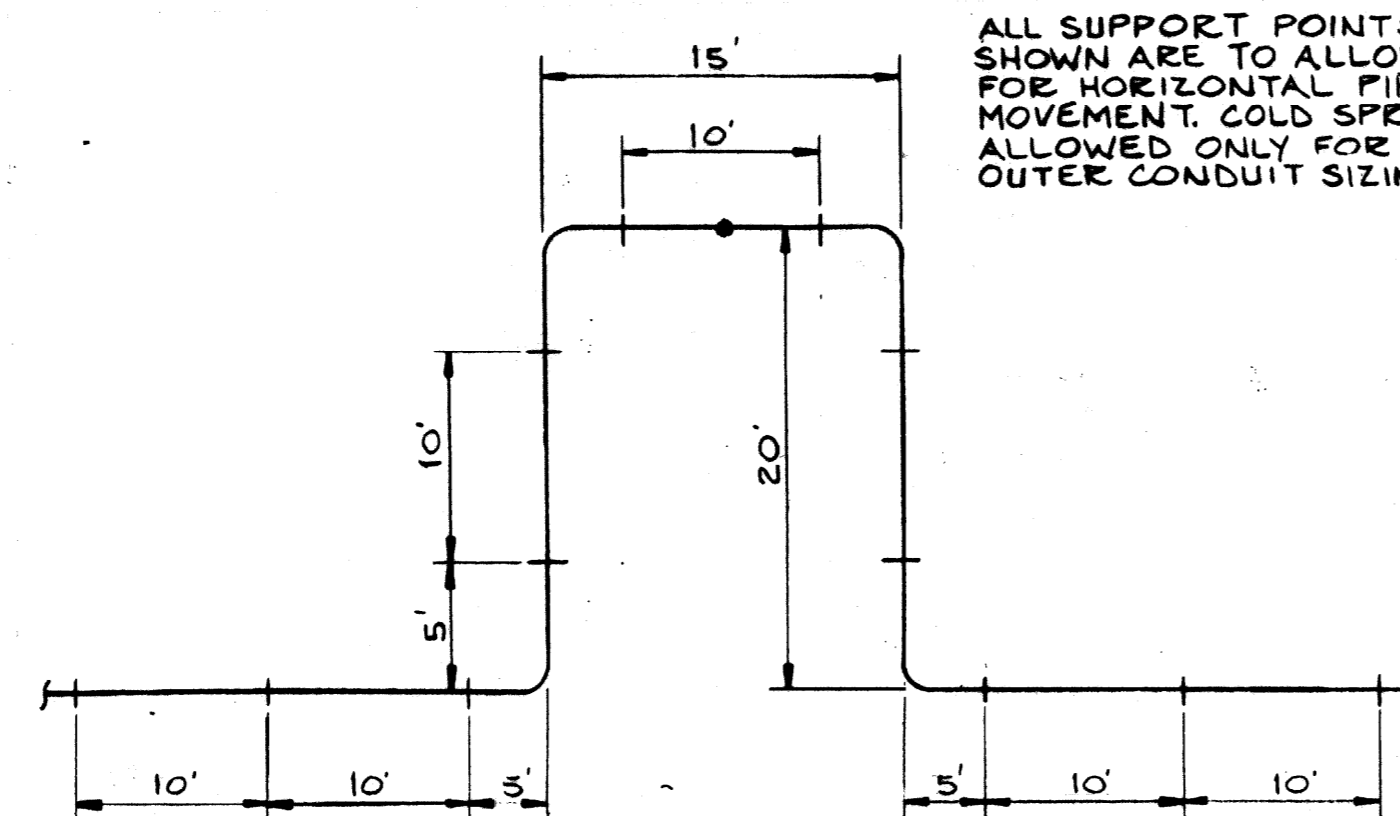

EXPANSION LOOP DETAIL
NO SCALE

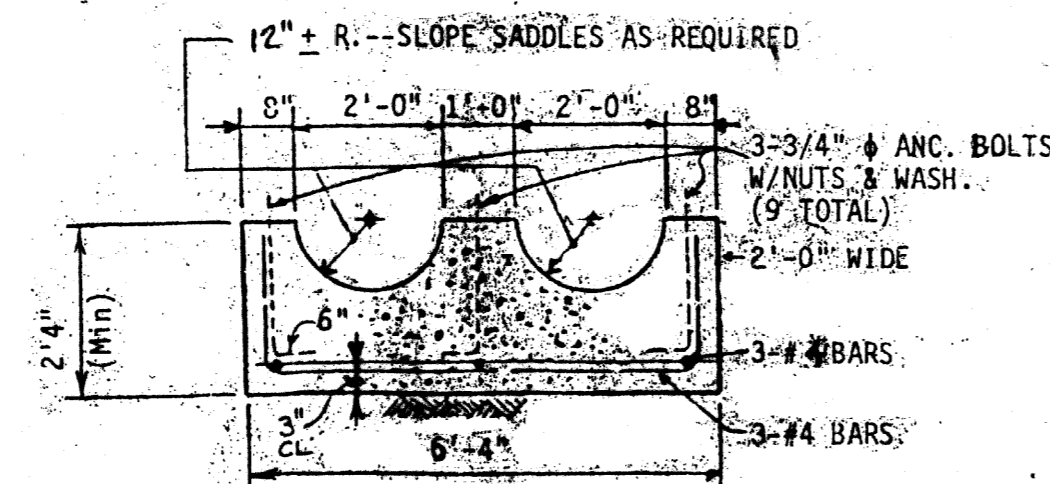


12\"/>

RECORD PRINTS

THESE ARE RECORD PRINTS OF DRAWINGS BASED UPON MARKED UP PRINTS, DRAWINGS AND OTHER DATA FURNISHED BY THE CONTRACTOR TO THE ENGINEER AND WHICH THE ENGINEER CONSIDERS SIGNIFICANT

MASON & HANGER ENGINEERING INC.
ARCHITECT • ENGINEERS
LEXINGTON, KENTUCKY

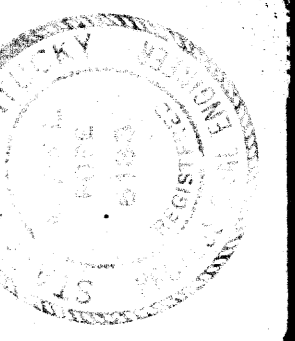

ROBOTICS FACILITY
LEXINGTON CAMPUS
UNIVERSITY OF KENTUCKY
LEXINGTON, KENTUCKY

University of Kentucky
Lexington Kentucky

STEAM DETAILS

Sterman Carter Barnhart
PARTNERS IN ARCHITECTURE
100 WEST MAIN STREET - LEXINGTON, KY 40502 - 258-9440


JOB NO. 2046
DATE 10-19-87
DRAWN FDK
CHECKED
FILE NO. 4310

REVISIONS


NO.	DESCRIPTION

SHEET


C-12

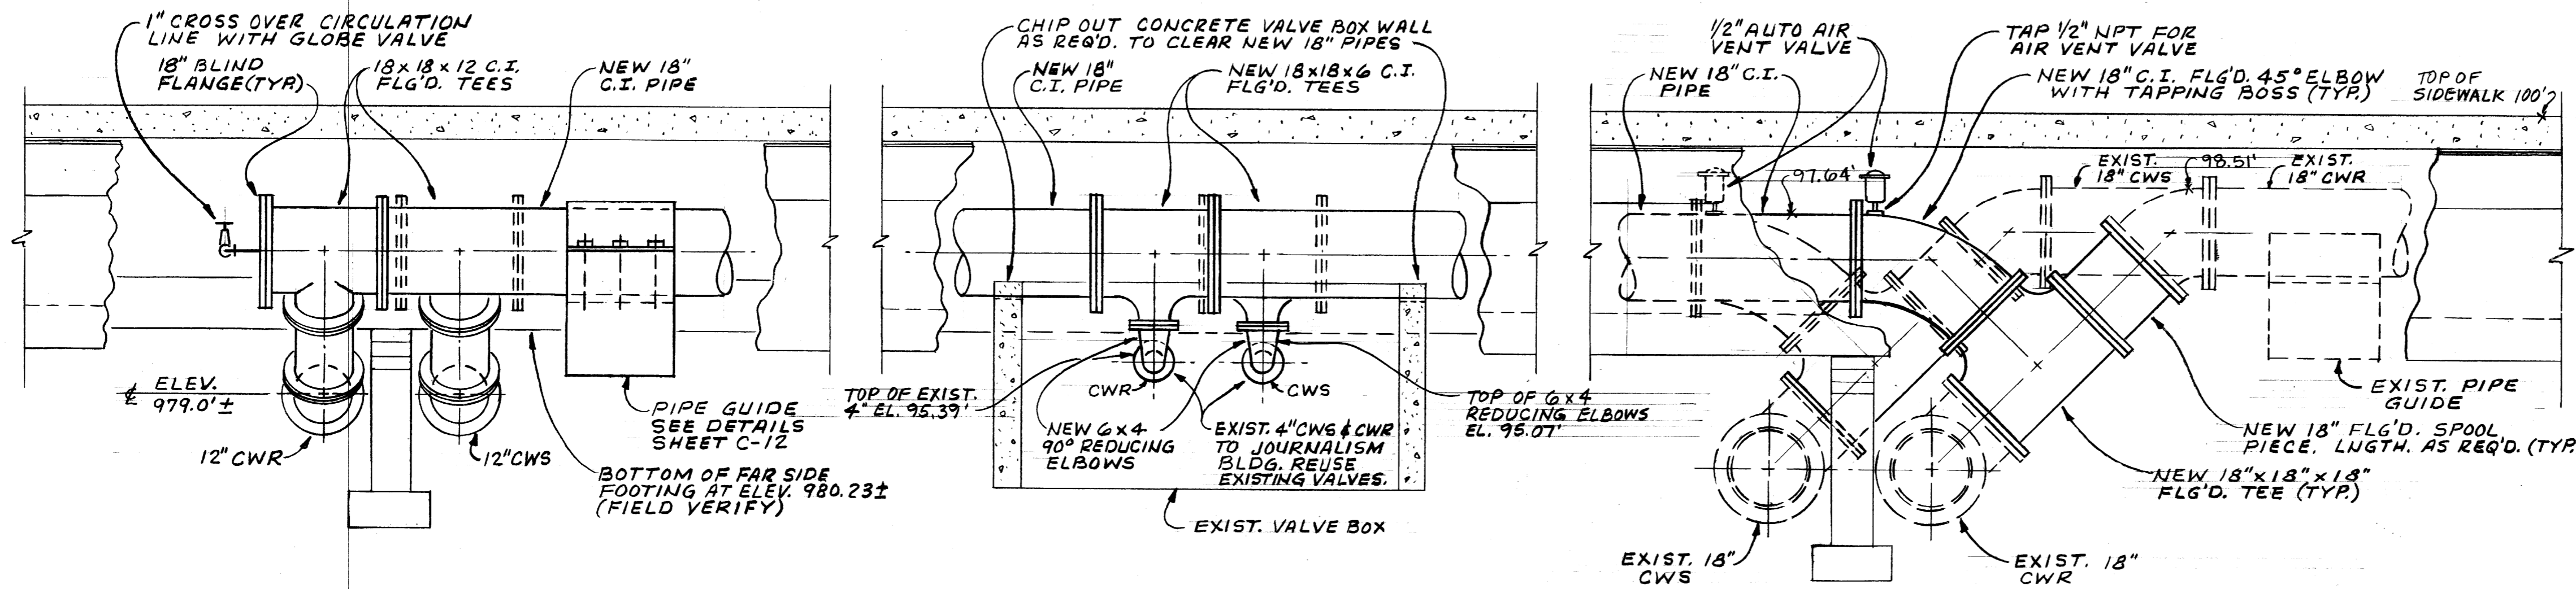

SECTION A-C-11
SCALE: 1/2" = 1'-0"

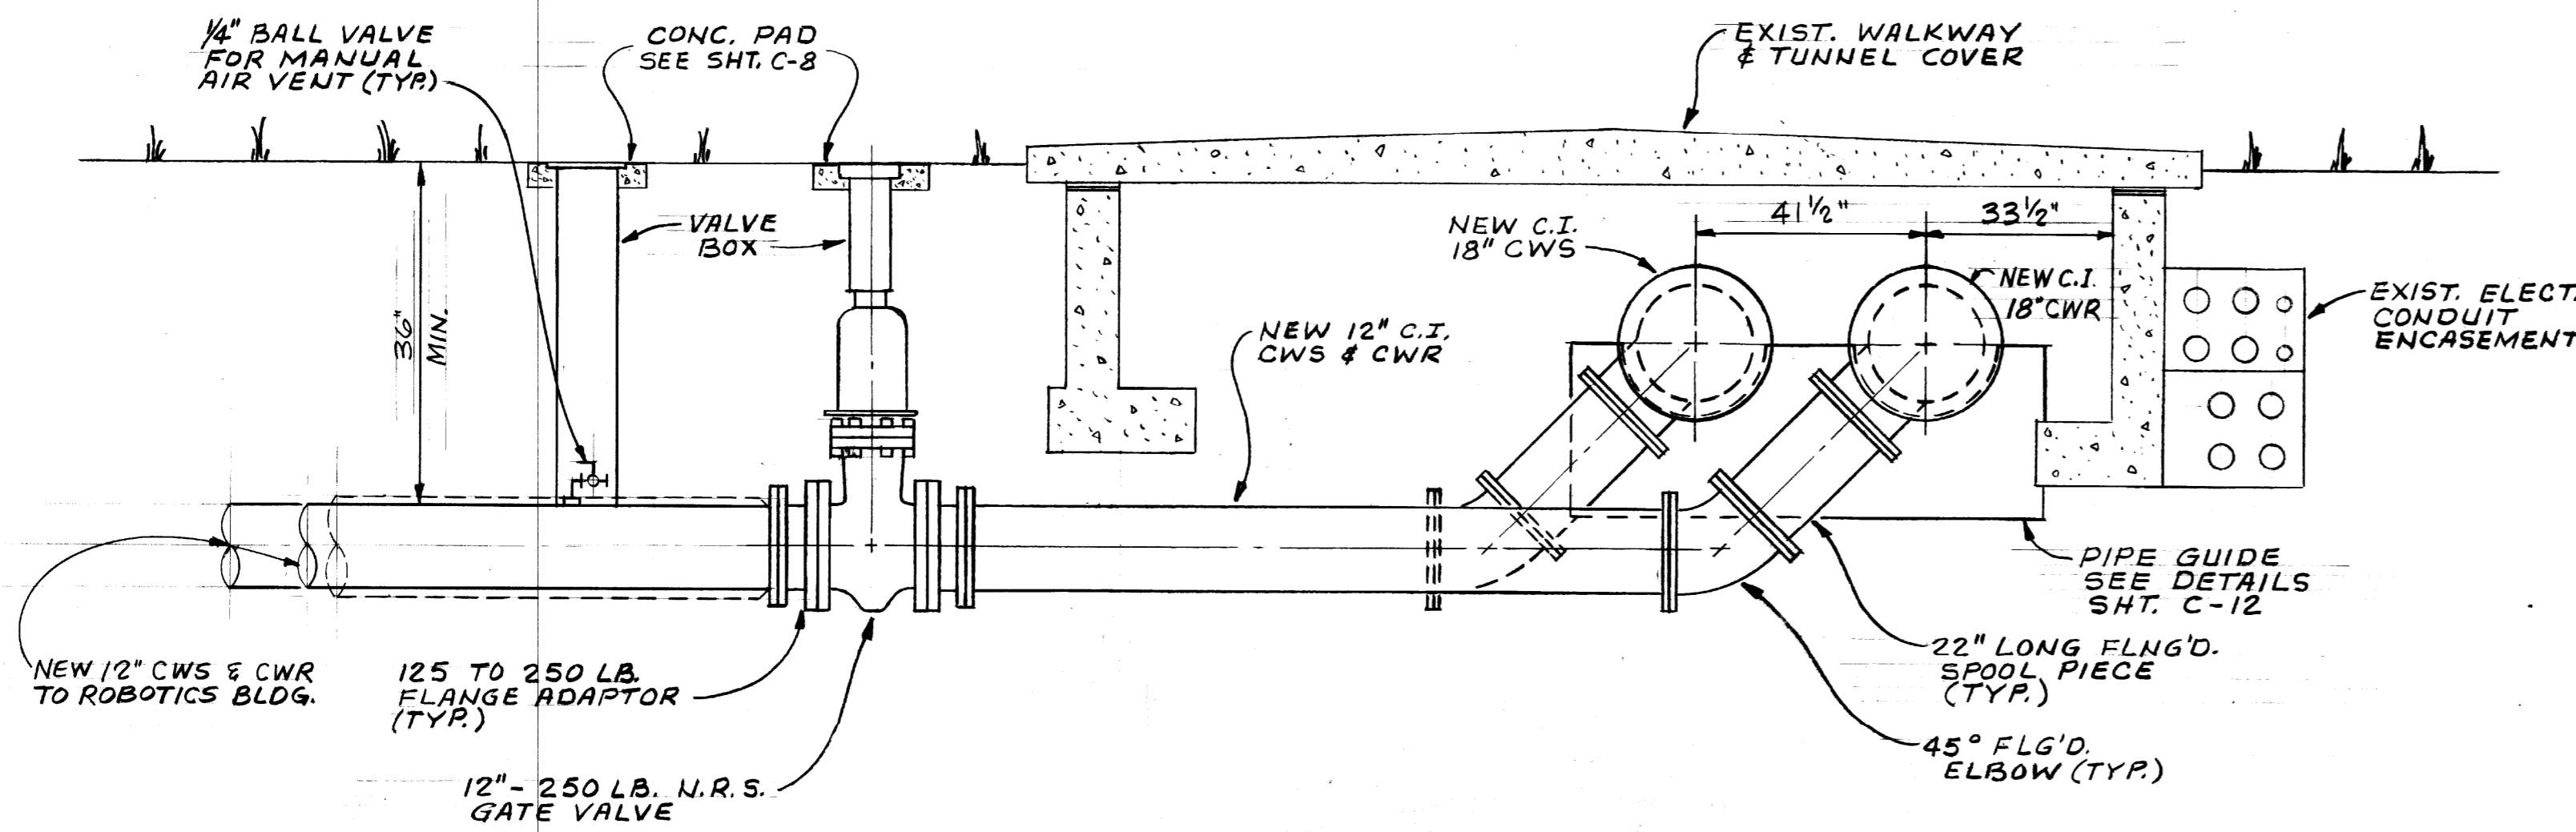

SECTION B-C-11
SCALE: 1/2" = 1'-0"

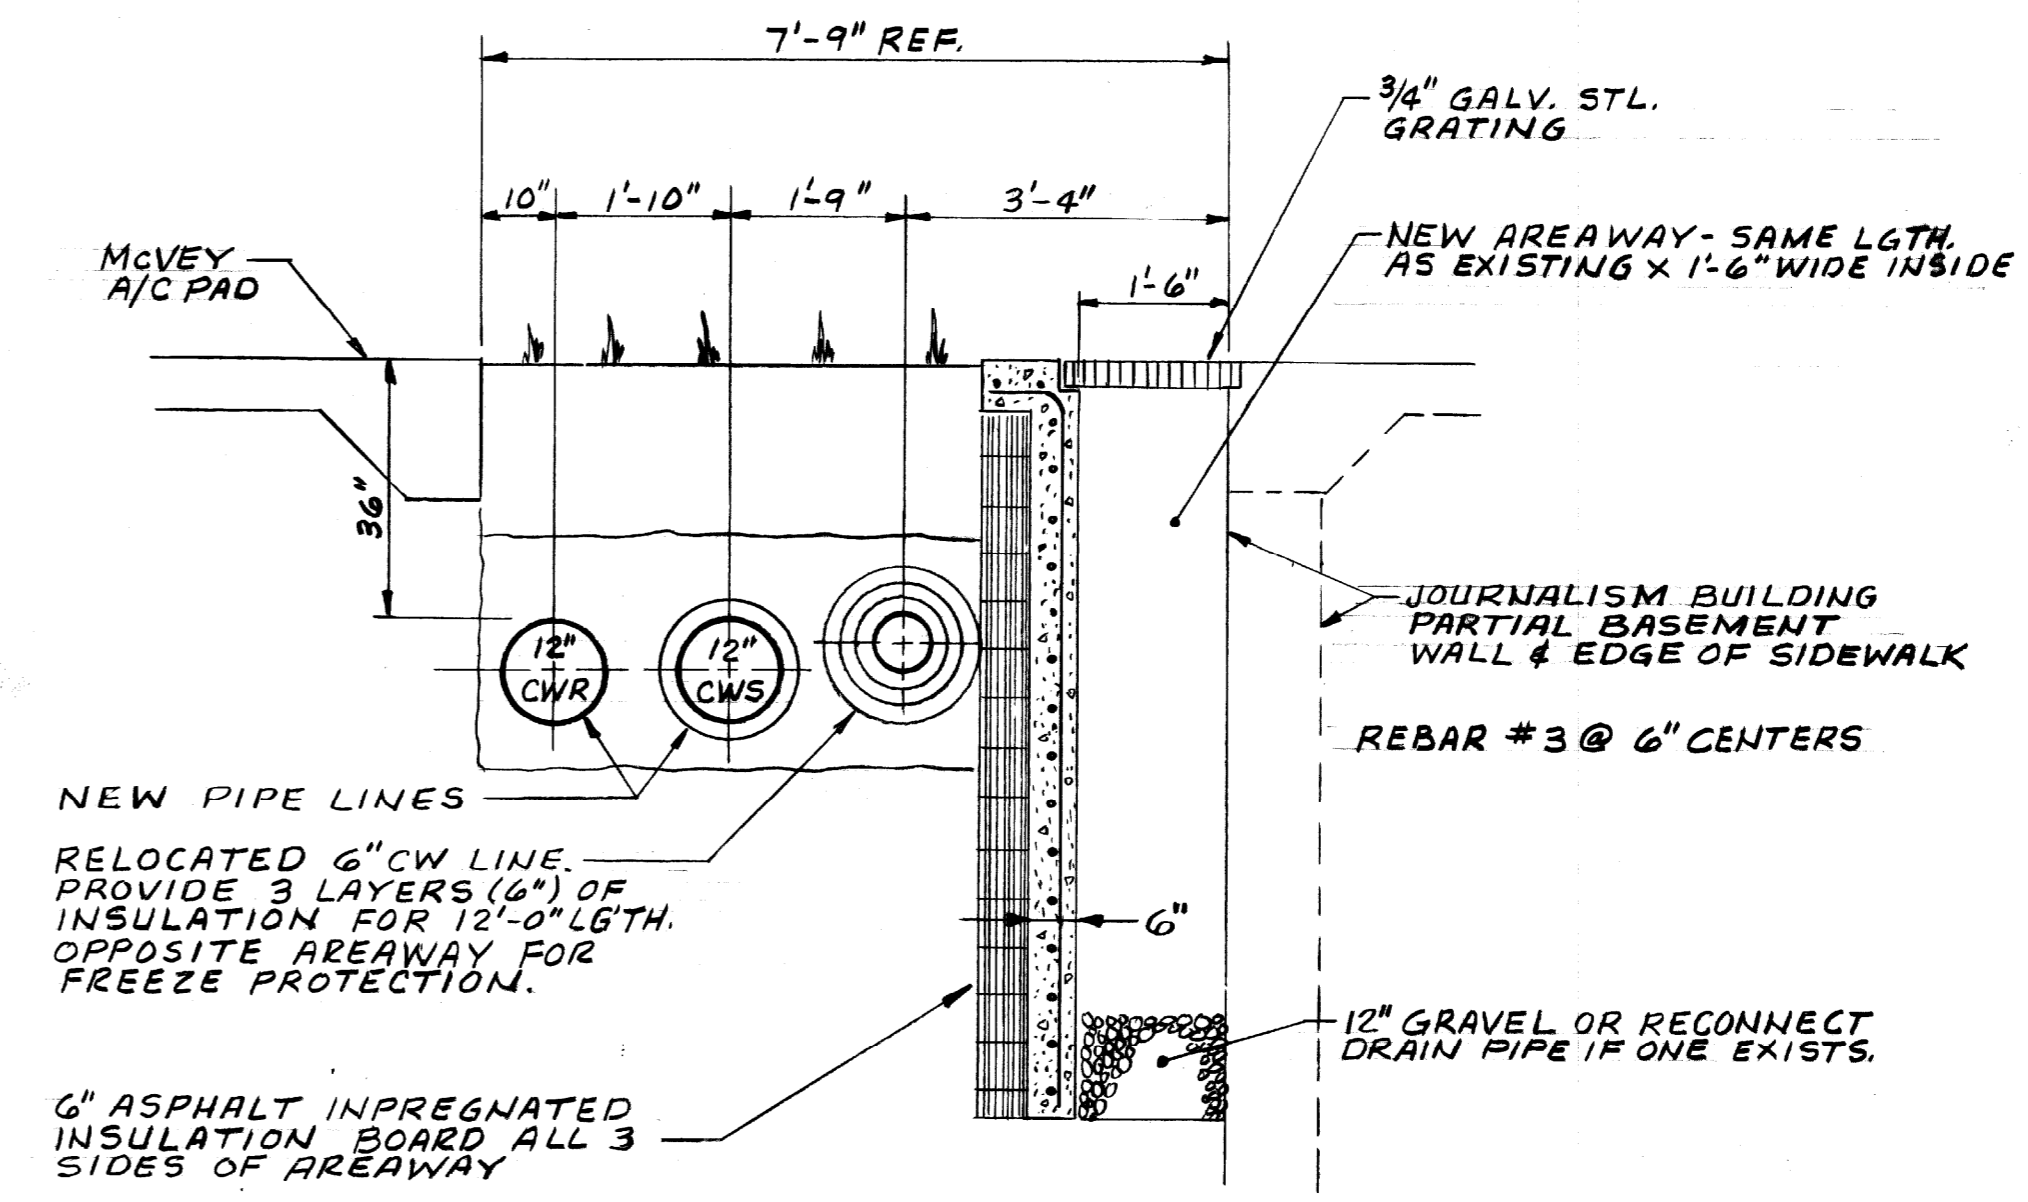

SECTION C-C-11
SCALE: 1/2" = 1'-0"

NOTE:
BOTH THE CWS AND THE CWR LINES LOCATED WITHIN THE PIPING TUNNEL SHALL BE INSULATED. CWS LINE ONLY SHALL BE INSULATED OUTSIDE OF THE TUNNEL WHERE BURIED.

RECORD PRINTS
THESE ARE RECORD PRINTS OF DRAWINGS BASED UPON MARKED UP PRINTS, DRAWINGS AND OTHER DATA FURNISHED BY THE CONTRACTOR TO THE ENGINEER AND WHICH THE ENGINEER CONSIDERS SIGNIFICANT

MASON & HANGER ENGINEERING INC.
ARCHITECT • ENGINEERS
LEXINGTON, KENTUCKY

ROBOTICS FACILITY
LEXINGTON CAMPUS
UNIVERSITY OF KENTUCKY
LEXINGTON, KENTUCKY

University of Kentucky
Lexington, Kentucky

William E. Hanger
M.E. 10000

CHILLED WATER & STEAM DETAILS


Sherman Carter Barnhart
PARTNERS IN ARCHITECTURE
SUIT. 1900 • 250 WEST MAIN STREET • LEXINGTON, KY 40502 • 806.254.1555

JOB NO. 2000
DATE 10-13-01
DRAWN G
CHECKED R
FILE NO. 437.0

REVISIONS






Sheet # 82
A-1
00847

C-13

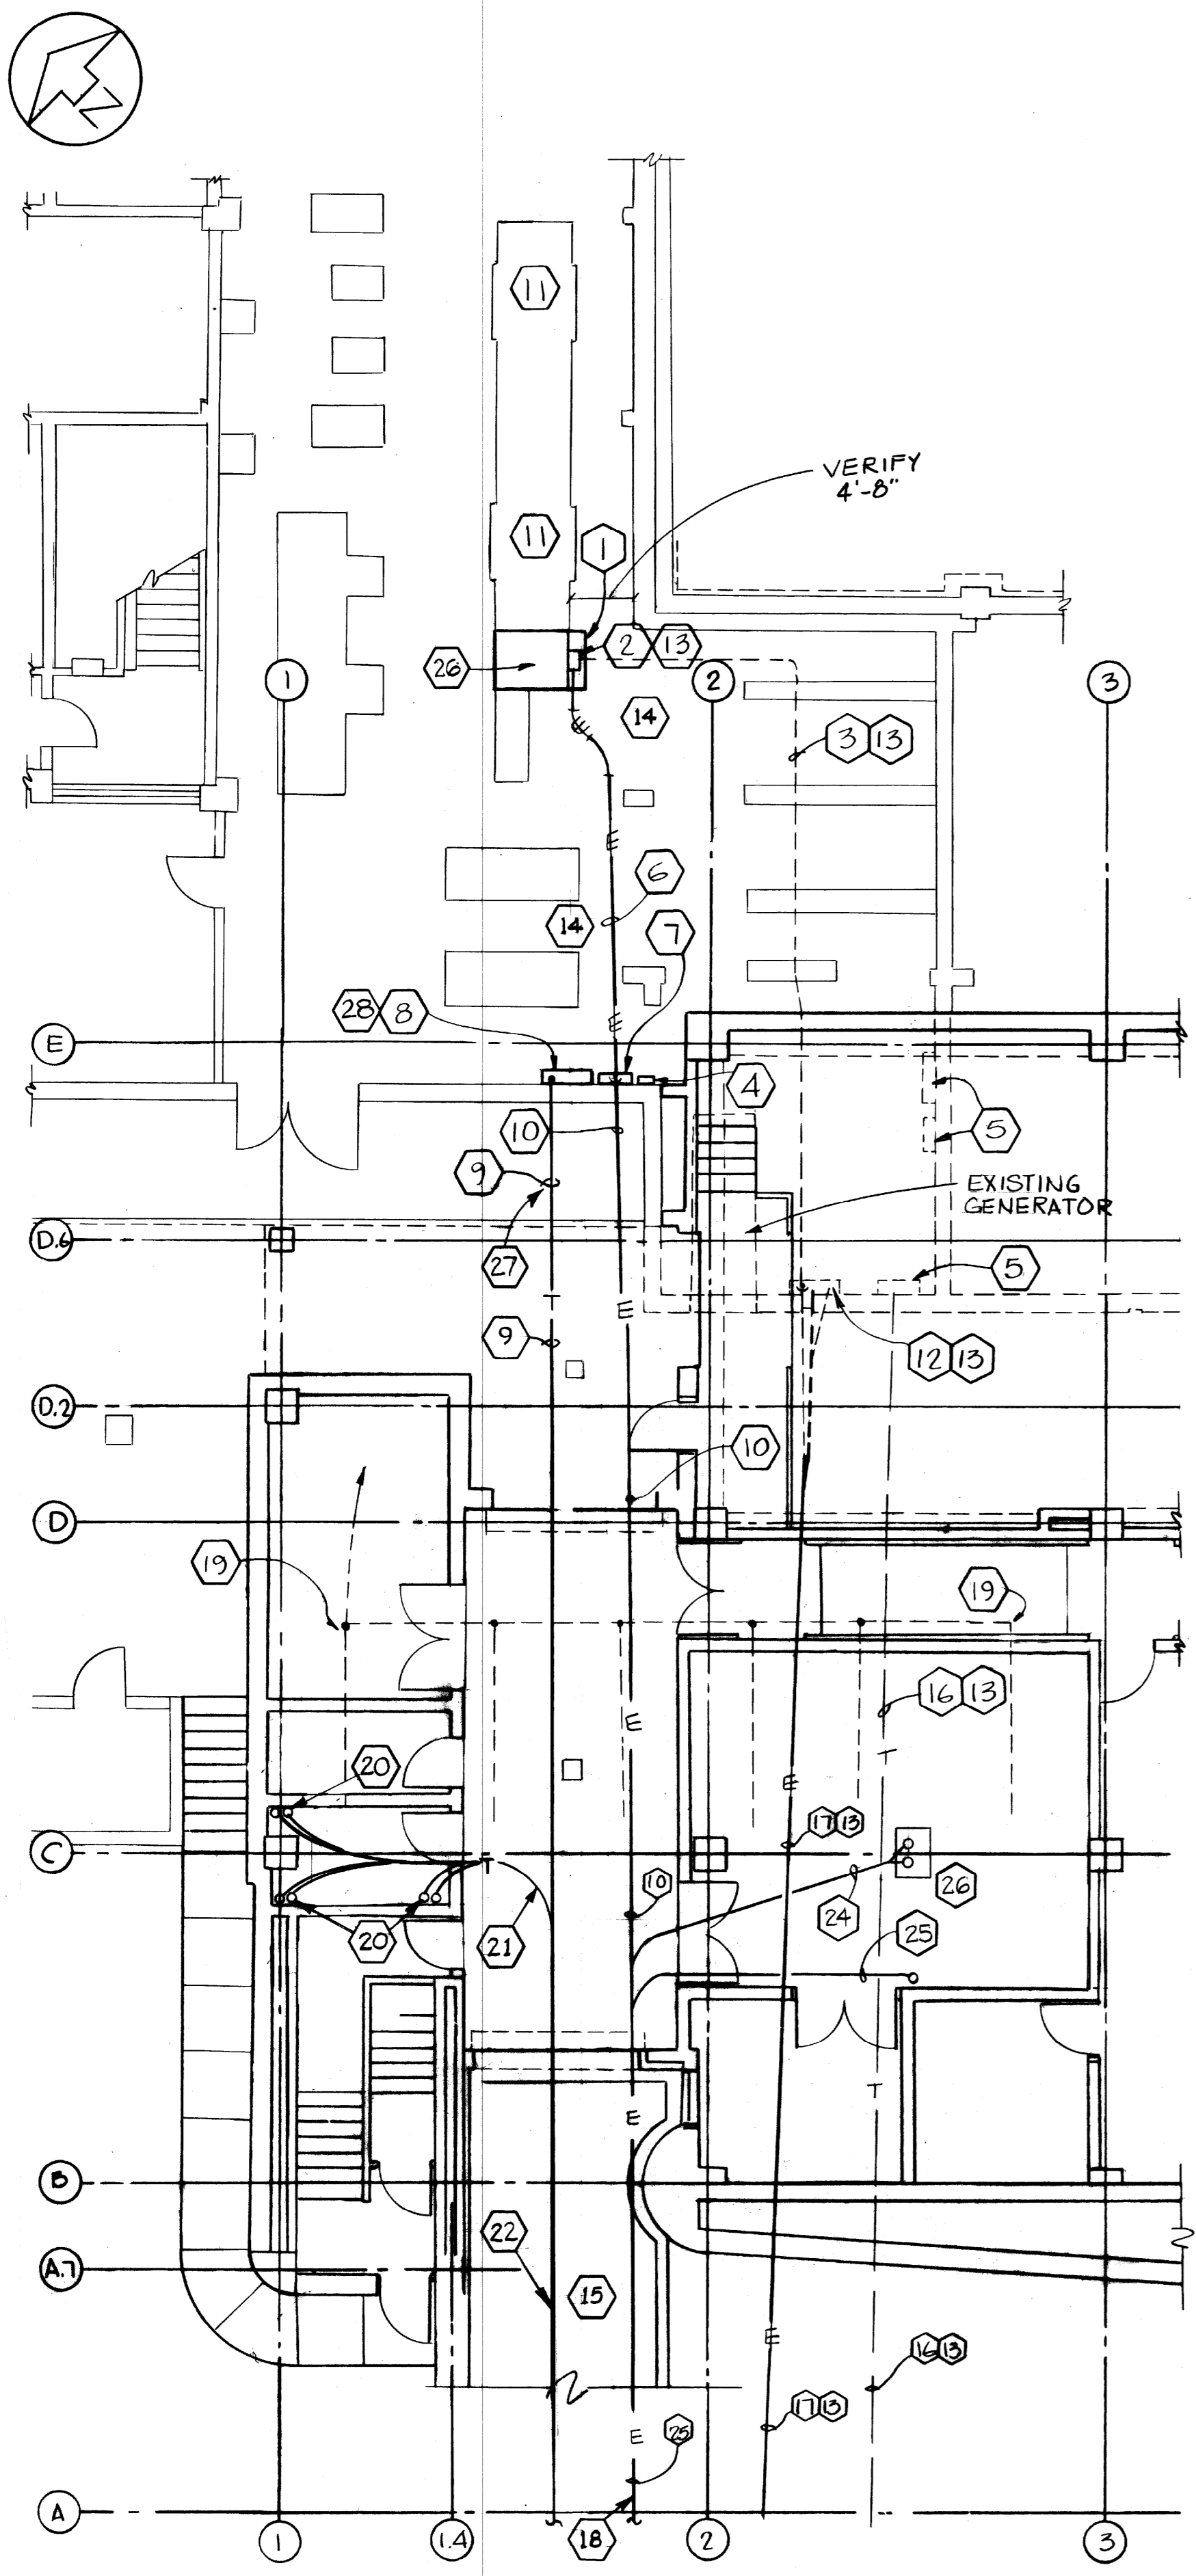

PARTIAL BASEMENT FLOOR PLAN
SCALE: 1/8" = 1'-0"

- NOTES - ELECTRICAL**
- 1 NEW WIREWAY 8" x 30" x 92".
 - 2 EXISTING 8" x 12" x 72" WIREWAY.
 - 3 EXISTING H.V. LINE IN 5" C NEAR CEILING
 - 4 EXISTING SWITCH.
 - 5 EXISTING TELEPHONE PANELS.
 - 6 NEW 5" RMC A 8' A.F.F. ADJ. TO ROOF LEADER LINE. LABEL 12 KV
 - 7 NEW J-BOX 24" 36" x 8".
 - 8 NEW TELEPHONE J BOX 36" x 48" x 10" WITH PLYWOOD BACK.
 - 9 NEW TELEPHONE CONDUITS, (4) 4" PVC ENCASED.
 - 10 NEW ELECTRIC DUCTBANK: 1 - 5" PVC WITH 3 - 4/0 15 KV & 4/0 THW COPPER CONDUCTORS, 1 - 5" PVC SPARE ENCASED IN CONCRETE.
 - 11 EXISTING ELECTRIC SWITCHGEAR, DOUBLE ENDED SUBSTATION.
 - 12 EXISTING 24" x 36" x 6" J-BOX.
 - 13 REMOVE COMPLETELY.
 - 14 RELOCATE ANY LIGHT FIXTURES, CONDUITS, ETC. TO INSTALL NEW.
 - 15 MAINTAIN 12" SEPARATION BETWEEN TELEPHONE AND ELECTRIC CONDUITS (6" BETWEEN BANKS.)
 - 16 EXISTING TELEPHONE DUCTBANK.
 - 17 EXISTING 12 KV ELECTRIC DUCTBANK.
 - 18 TO MANHOLE E-110, FOR CONTINUATION, SEE DRAWING C-9.
 - 19 EXISTING GROUND GRID (3/0 CU. ATTACHED TO 10 FT. GROUND RODS, 6 FT ON CENTERS): RELOCATE AS SHOWN ON SITE PLAN.
 - 20 NEW (2) 4" CONDUIT (12" A.F.F.) TURNED UP INTO COMM. ROOM.
 - 21 NEW (5) 4" PVC (1) 4" FIBER OPTIC PVC ENCASED, TELEPHONE.
 - 22 NEW (9) 4" PVC (1) 4" FIBER OPTIC PVC ENCASED, TELEPHONE.
 - 23 NEW ELECTRICAL DUCTBANK: 2 - 5" PVC WITH 3 - 4/0 15 KV & 4/0 THW COPPER CONDUCTORS, 2 - 5" PVC & 1 - 2" PVC SPARE ENCASED IN CONCRETE, SEE DETAIL THIS SHEET.
 - 24 NEW ELECTRICAL DUCTBANK: 1 - 5" PVC WITH 3 - 4/0 15 KV & 1 - 4/0 THW COPPER CONDUCTORS, 1 - 5" PVC SPARE ENCASED IN CONCRETE.
 - 25 2" RIGID STEEL CONDUIT STUBBED UP 6" ALONG WALL.
 - 26 TERMINATE 15 KV CABLE AT SWITCH ENCLOSURE USING 15 KV CLASS HEAT SHRINKABLE TERMINATOR KITS EQUAL TO RAYCHEM HVT-150.
 - 27 EXISTING CONCRETE RAMP, DEMOLISH & REPAIR.
 - 28 PROVIDE 1-TRIAx, HONEYWELL - AK3605 WITH 1 - INTERCOM (DELTA 2000 SYSTEM) FROM THE EXISTING DELTA 2000 PANEL IN ANDERSON HALL TO THE NEW DELTA 2000 PANEL IN ROBOTICS. ROUTE CABLES FROM THE EXISTING DELTA 2000 PANEL ON THE EAST WALL OF THE MECHANICAL ROOM IN EXISTING CONDUIT TO TELEPHONE RM 89 APPROX. 100 FT. FROM TELEPHONE RM 89 ROUTE IN CONDUIT, PROVIDED BY INTERIOR ELECTRICAL, TO DUCT BANK ENTRANCE (SEE ITEM 8). ROUTE IN DUCT BANK TO MANHOLE U-81, THRU MANHOLE TO ROBOTICS DUCT BANK AND INTO ROBOTICS COMMUNICATION ROOM.

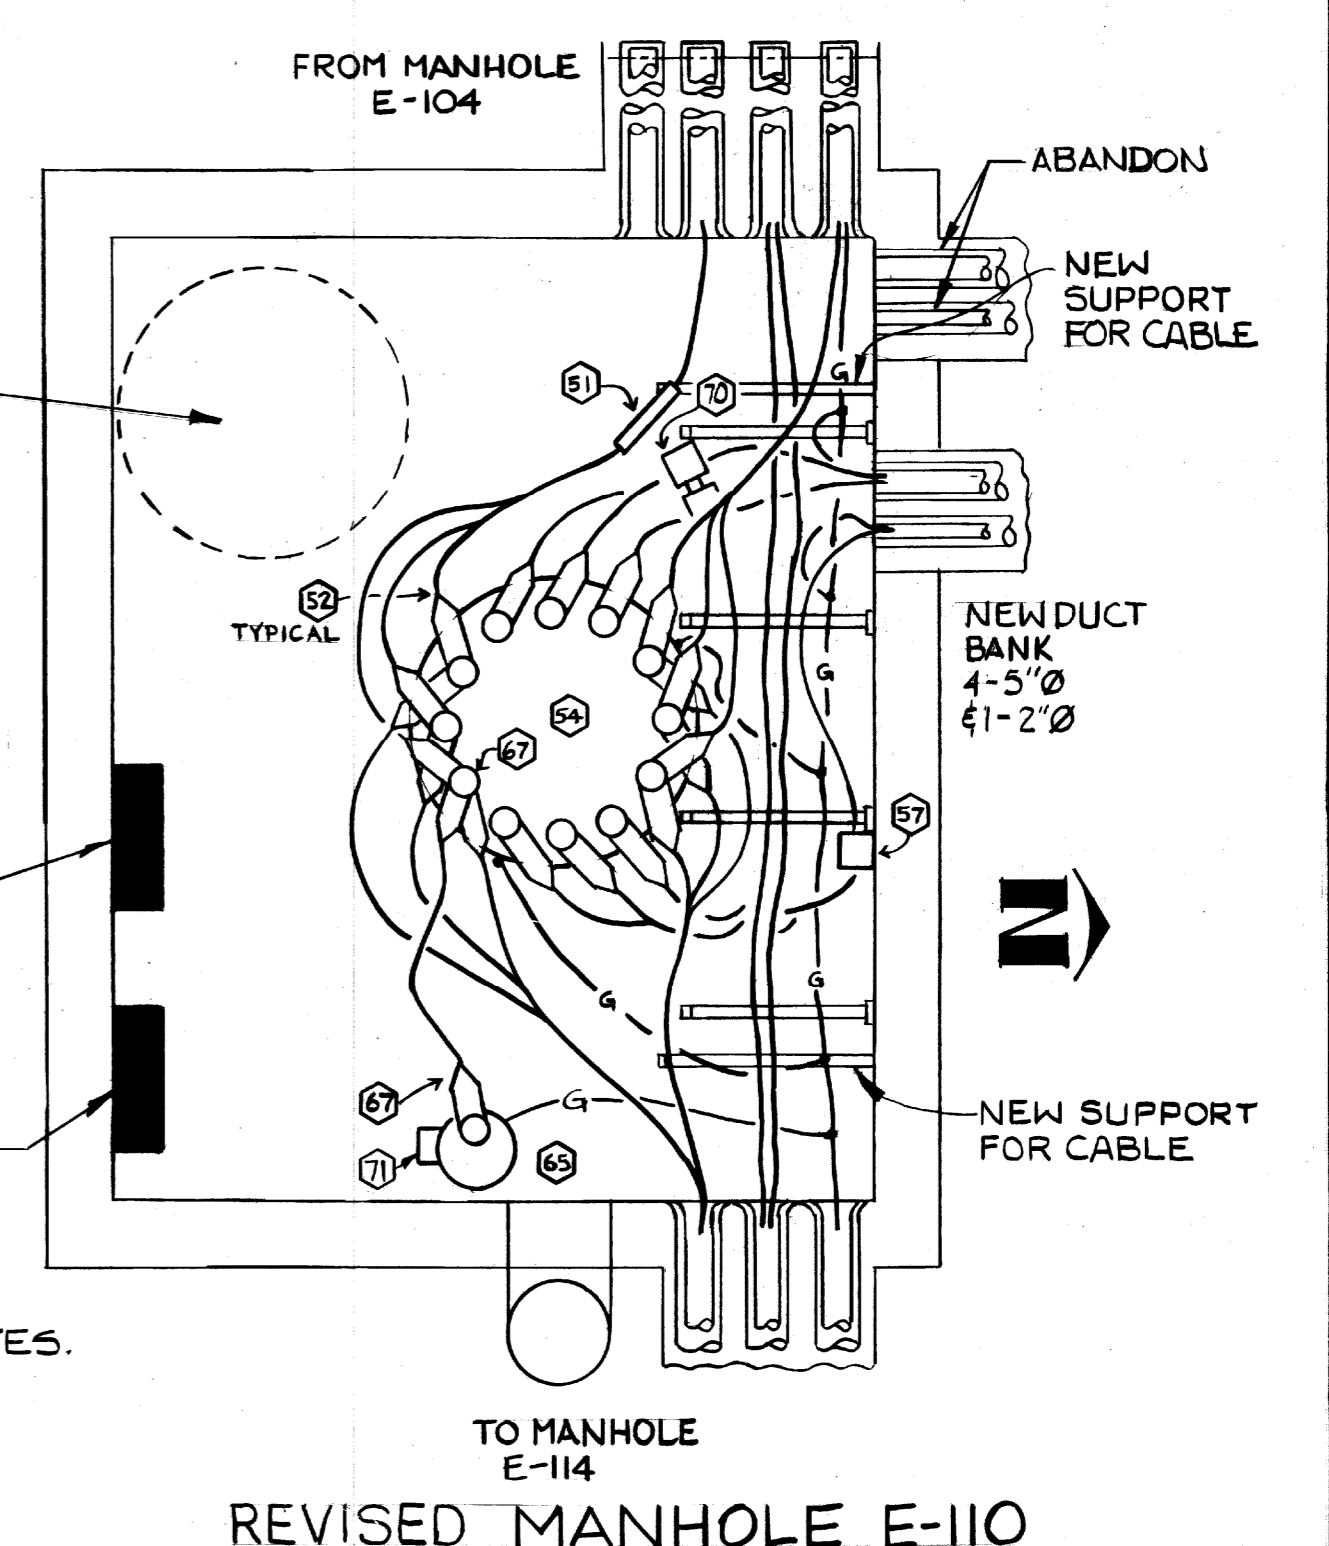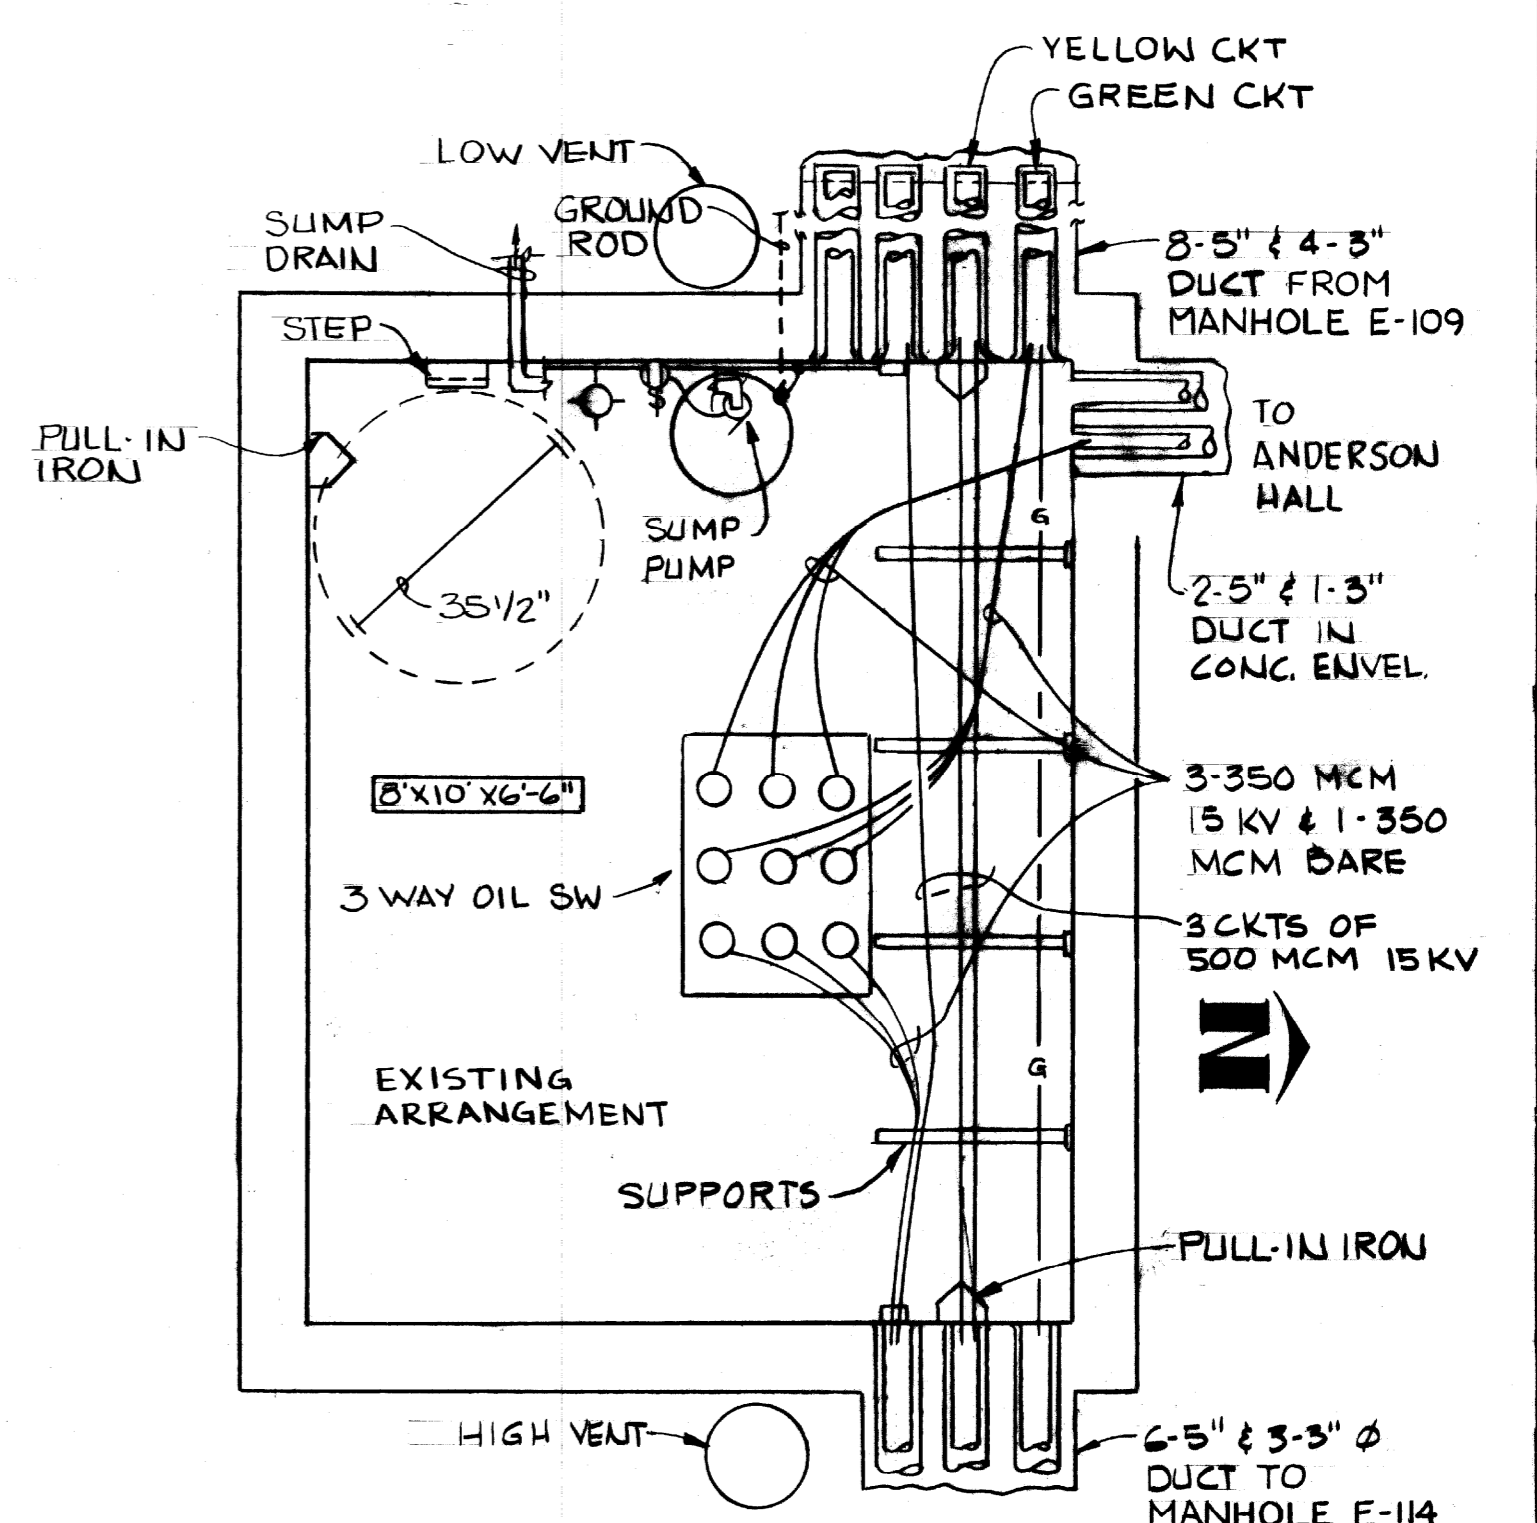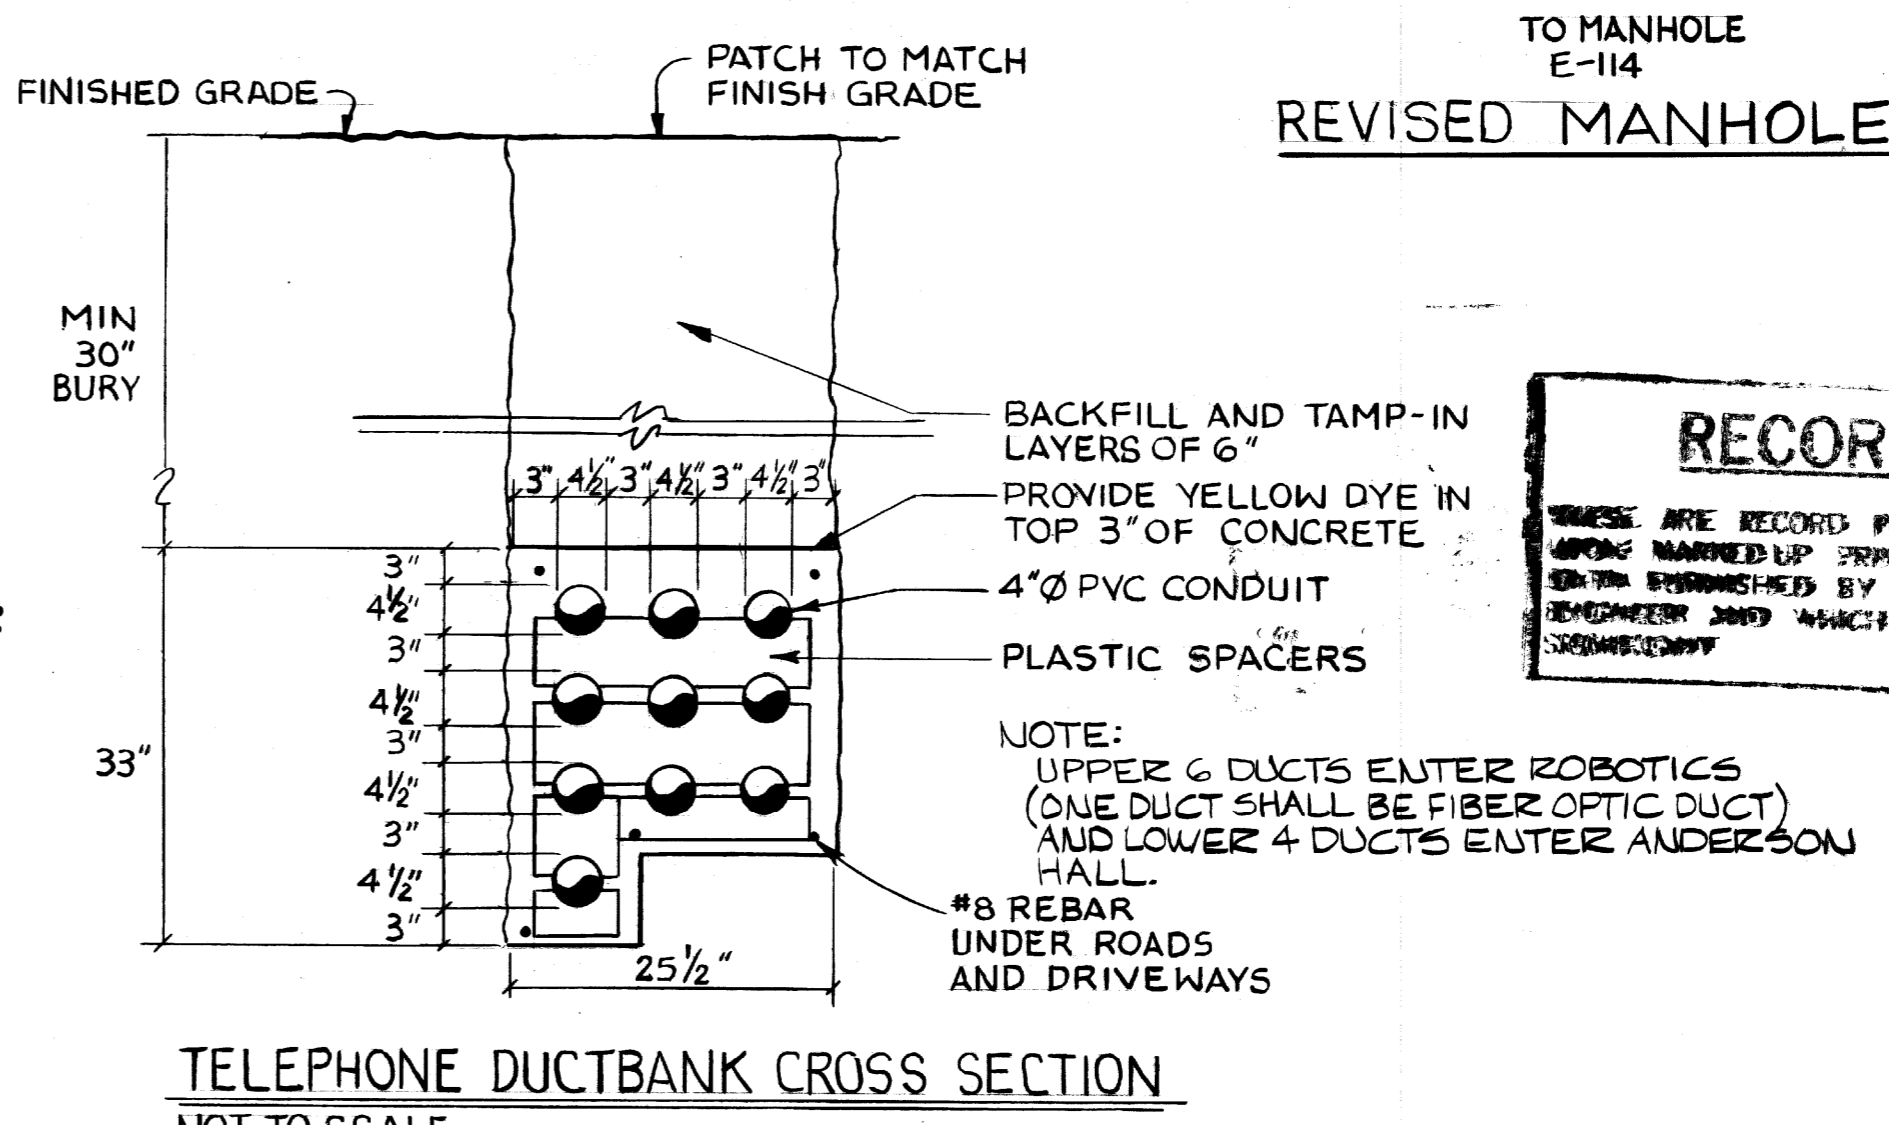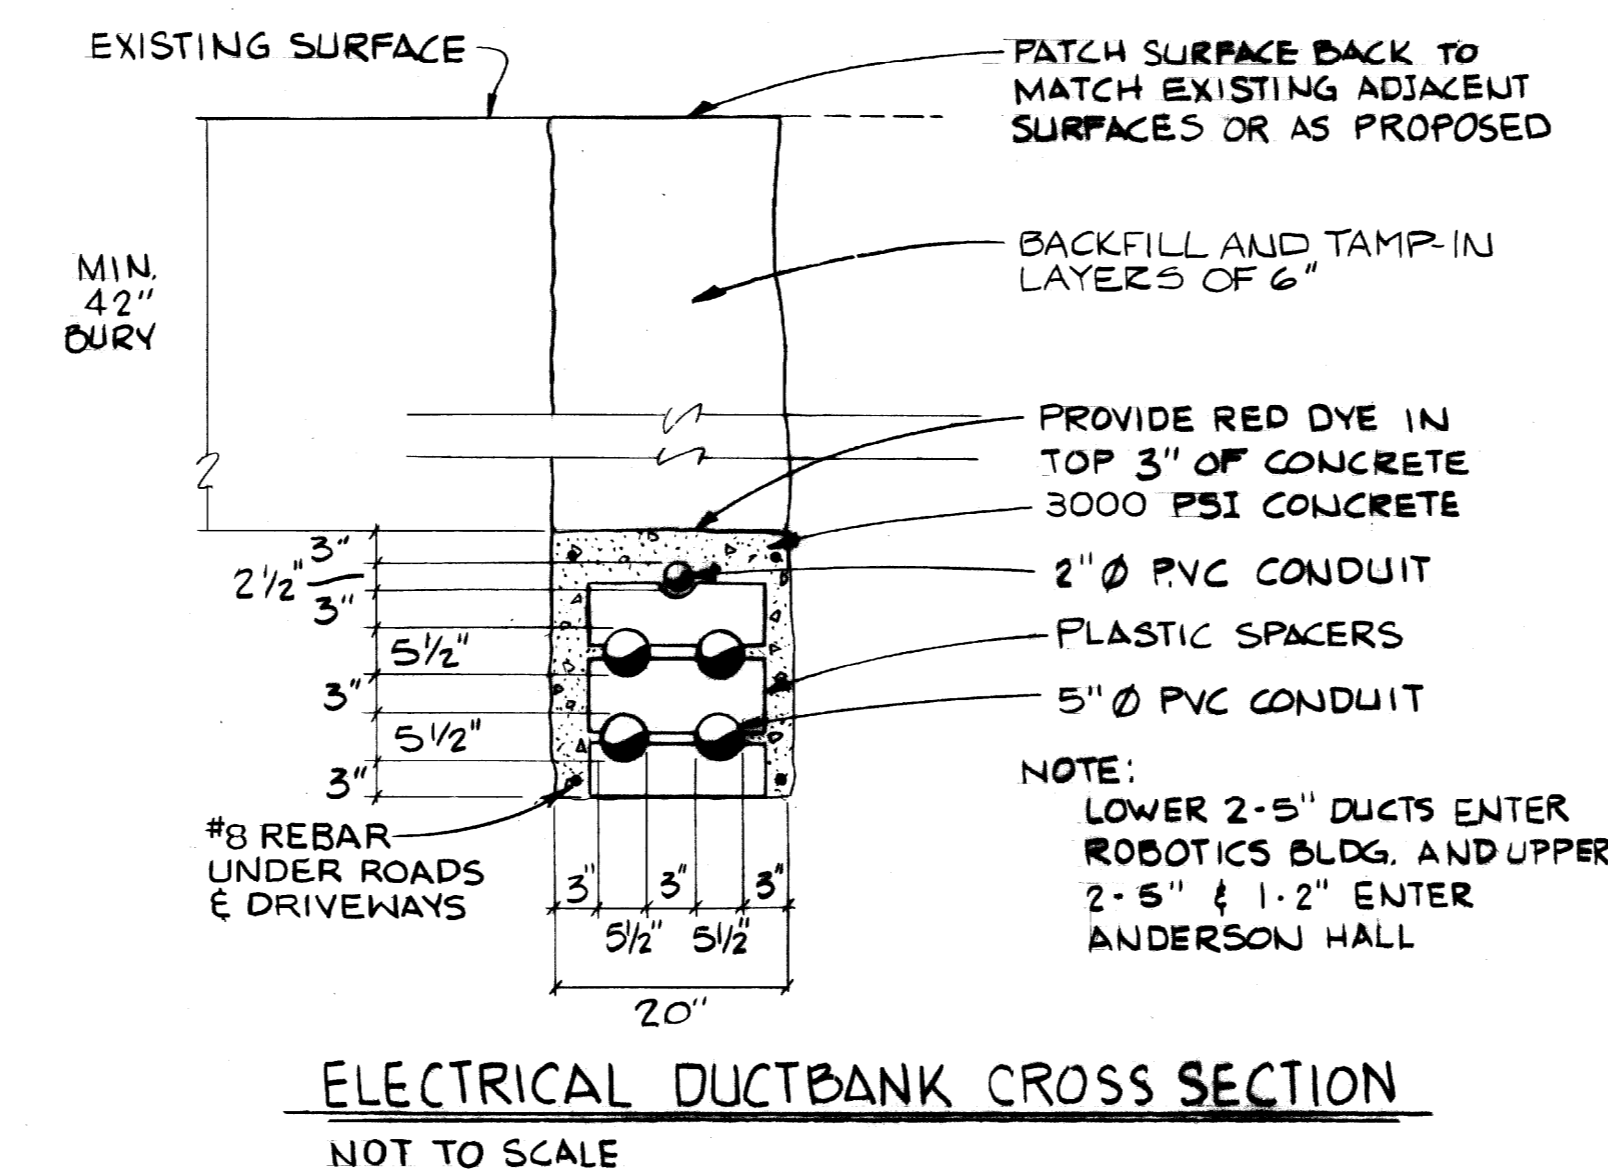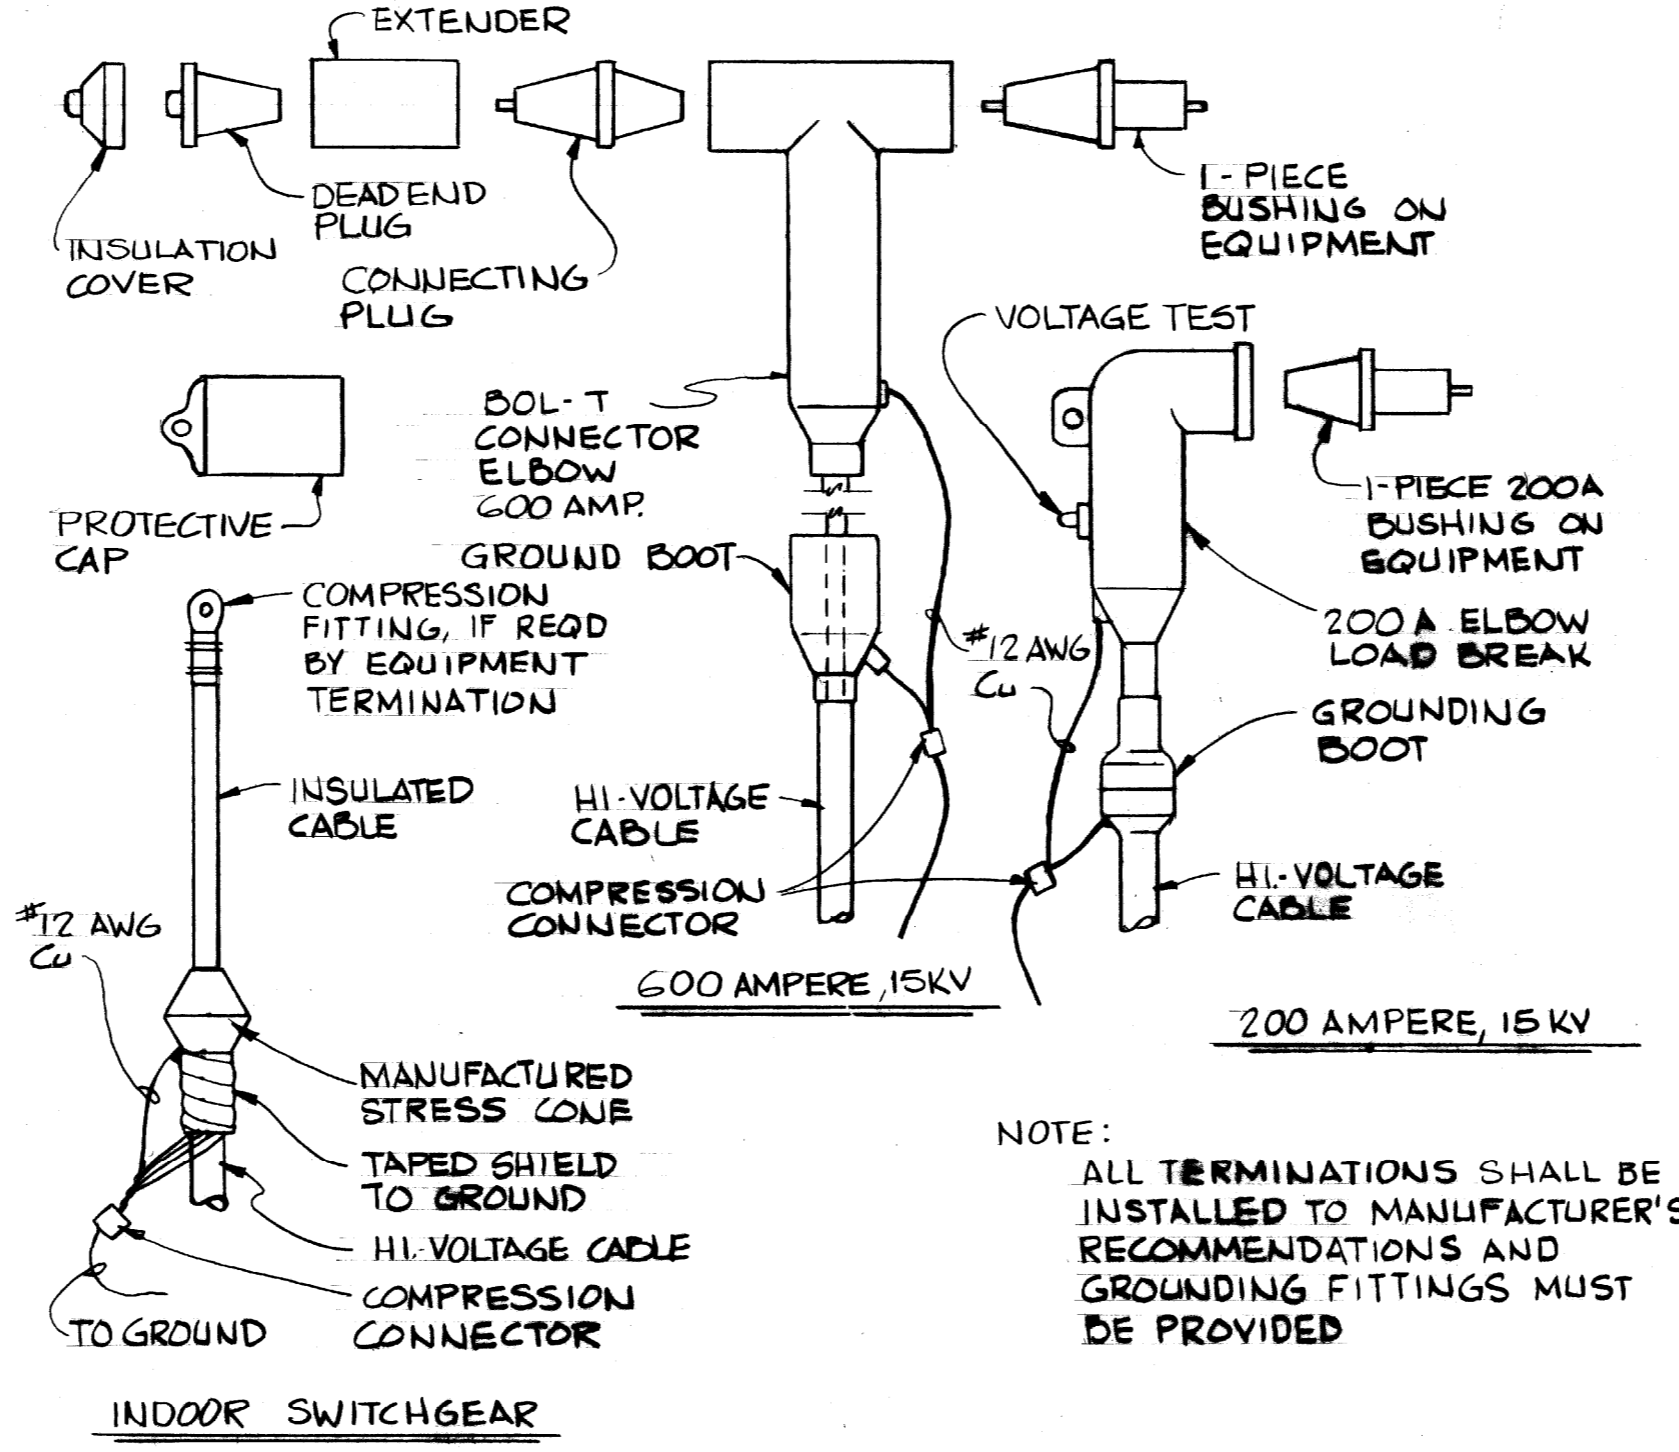

RECORD PRINTS

THESE ARE RECORD PRINTS OF DRAWINGS BASED UPON MARKED UP PRINTS. DRAWINGS AND OTHER DATA FURNISHED BY THE CONTRACTOR TO THE ENGINEER SHALL BE THE BASIS FOR WHICH THE ENGINEER CONSIDERS HIS RESPONSIBILITY.

ROBOTICS FACILITY
LEXINGTON CAMPUS
UNIVERSITY OF KENTUCKY
LEXINGTON, KENTUCKY

University of Kentucky
Lexington, Kentucky

Sherman Carter Barnhart
PARTNERS IN ARCHITECTURE


POWER AND COMMUNICATION

JOB NO 2046
DATE 10-19-83
DRAWN J.W.
CHECKED L.D.C.
FILE NO 481.0

REVISIONS


SHEET

C-14

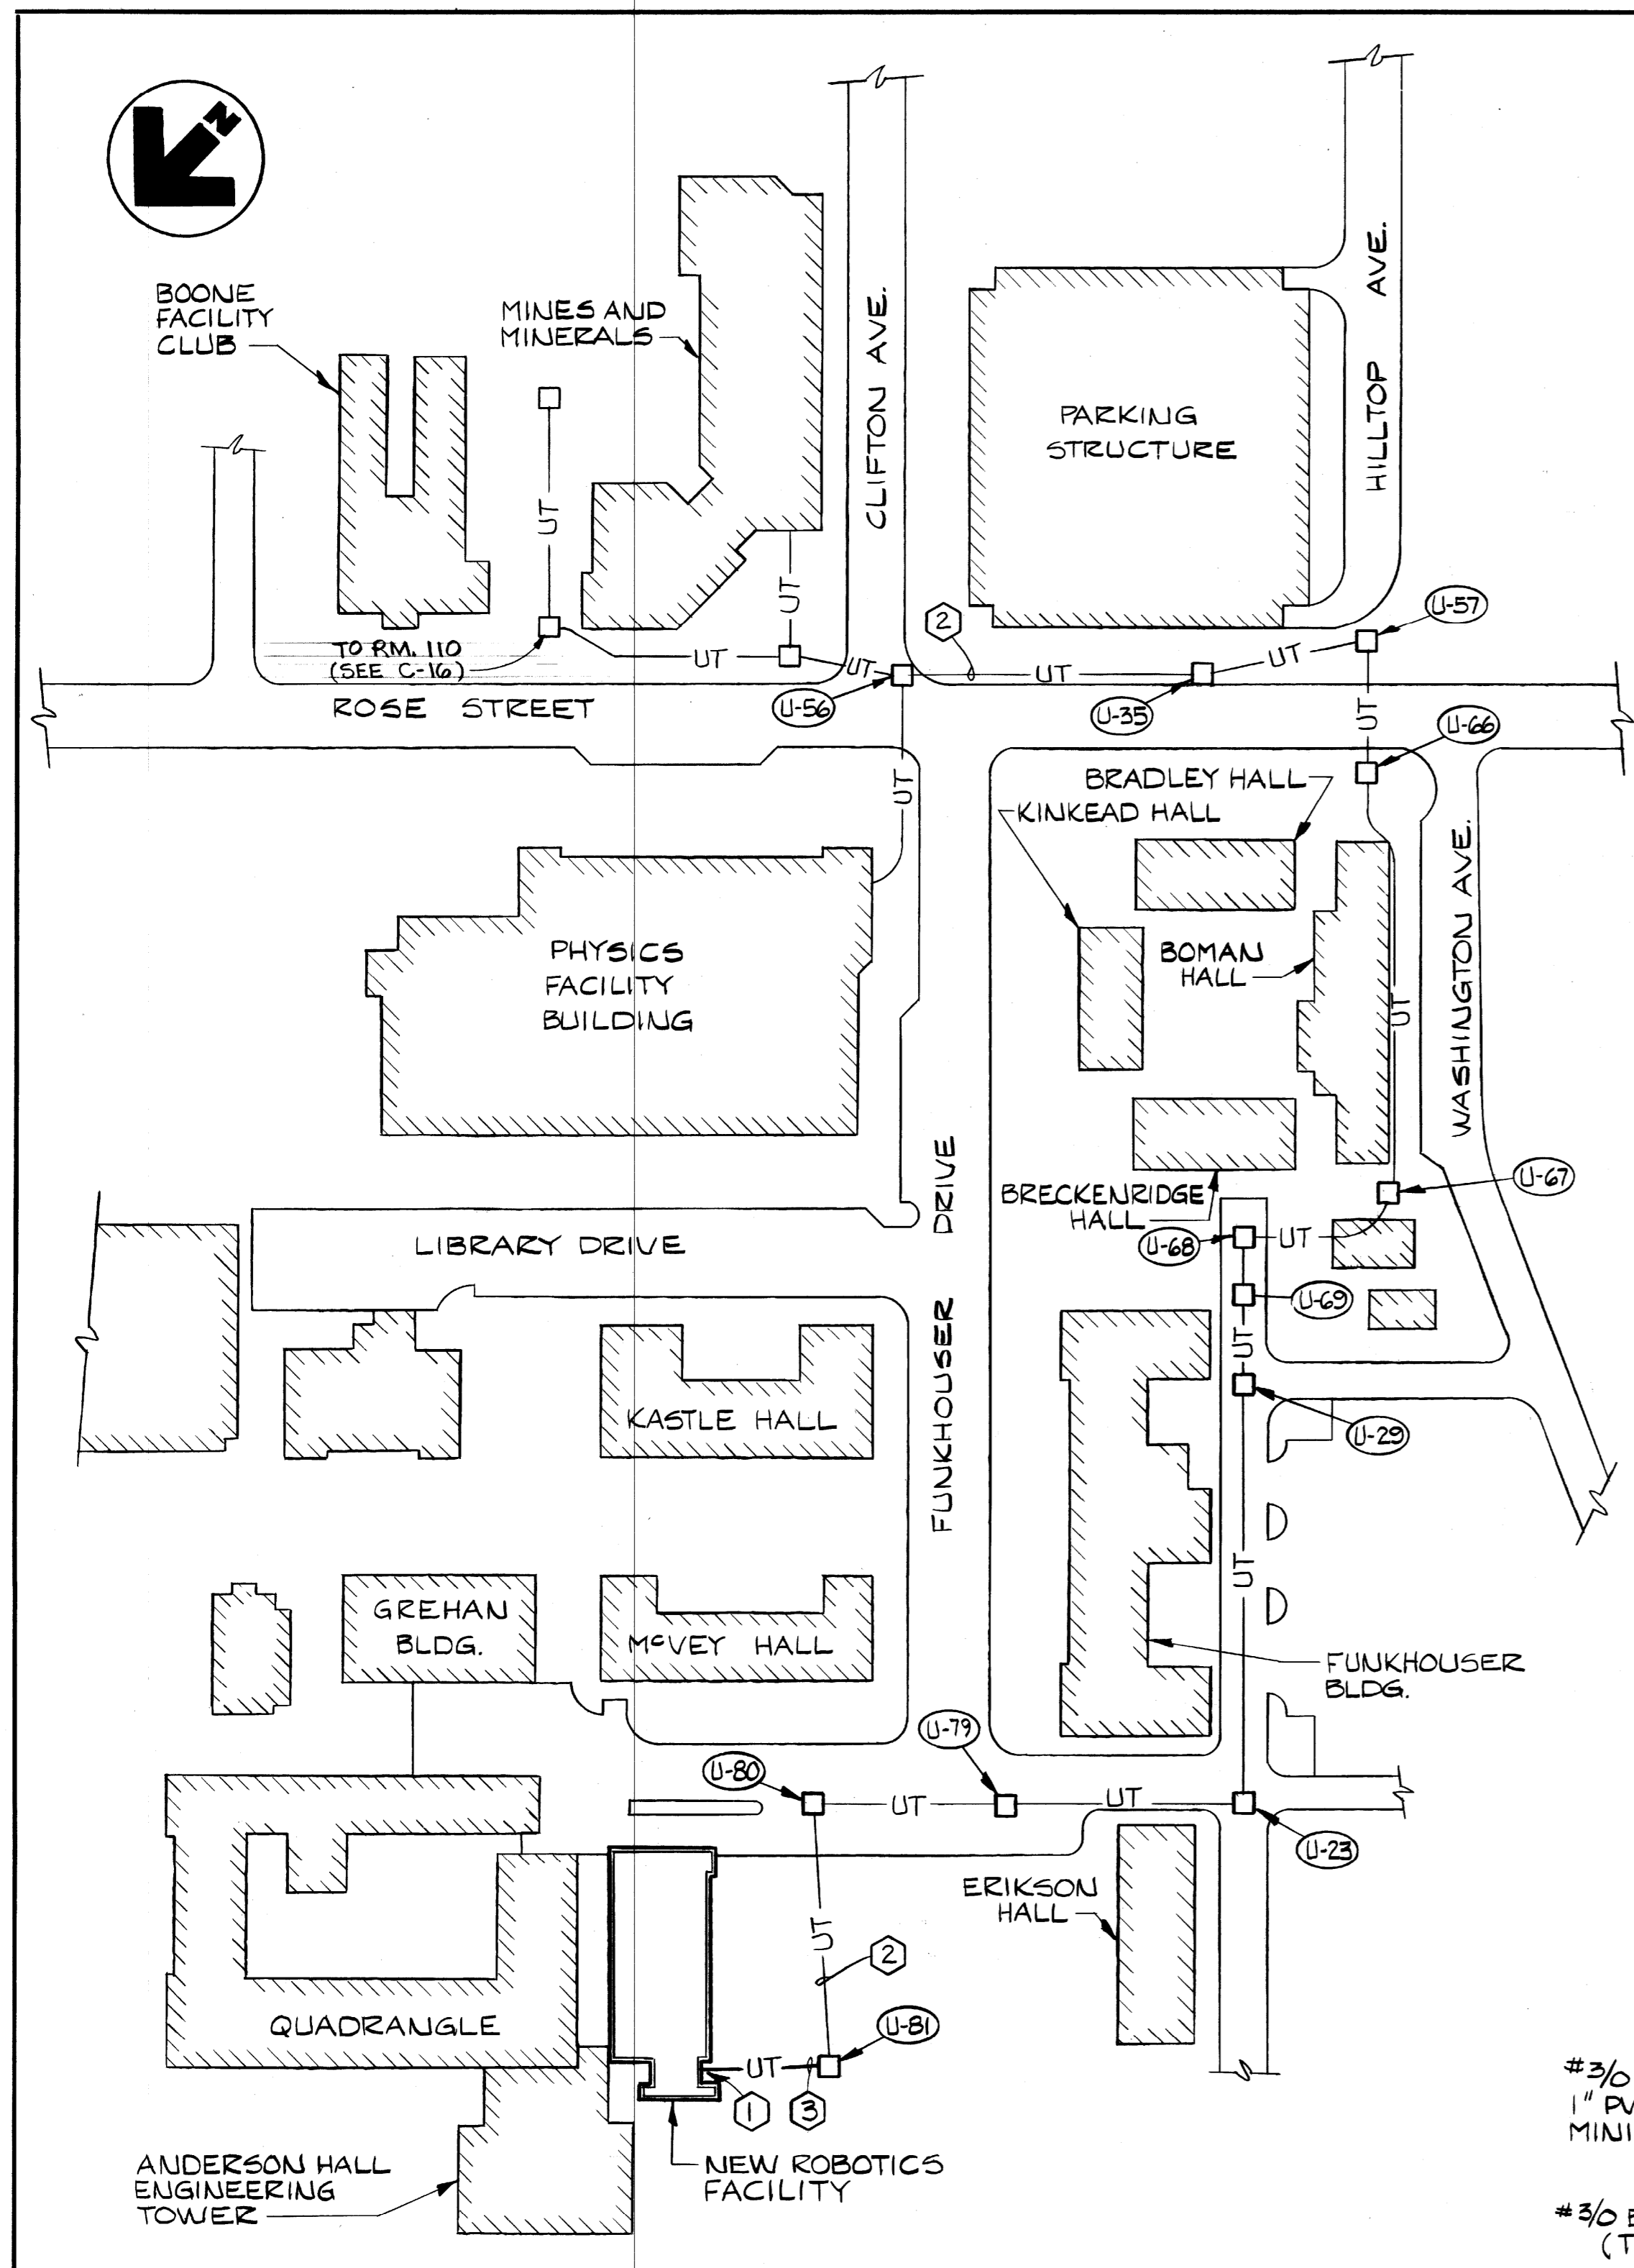


PARTIAL SITE PLAN-U. of K. CAMPUS
NO SCALE

- ① SEE SHEET C-9 FOR LOCATION OF DUCTBANK BETWEEN MANHOLE U-81 AND THE ROBOTICS FACILITY.
- ② A NEW 7-PAIR FMS CABLE TO BE INSTALLED IN EXISTING SPARE DUCTBANK FROM EXISTING 560 PANEL IN MINES AND MINERALS TO MANHOLE U-81.
- ③ A NEW 9-WAY, 4 INCH DUCTBANK WILL PROVIDE 3 - 4 DUCTS INTO ANDERSON HALL AND 6 - 4 INCH DUCTS INTO ROBOTICS. ONE OF THE 4 INCH DUCTS WILL CARRY THE 7-PAIR FMS CABLE FROM U-81 TO ROBOTICS COMMUNICATIONS ROOM

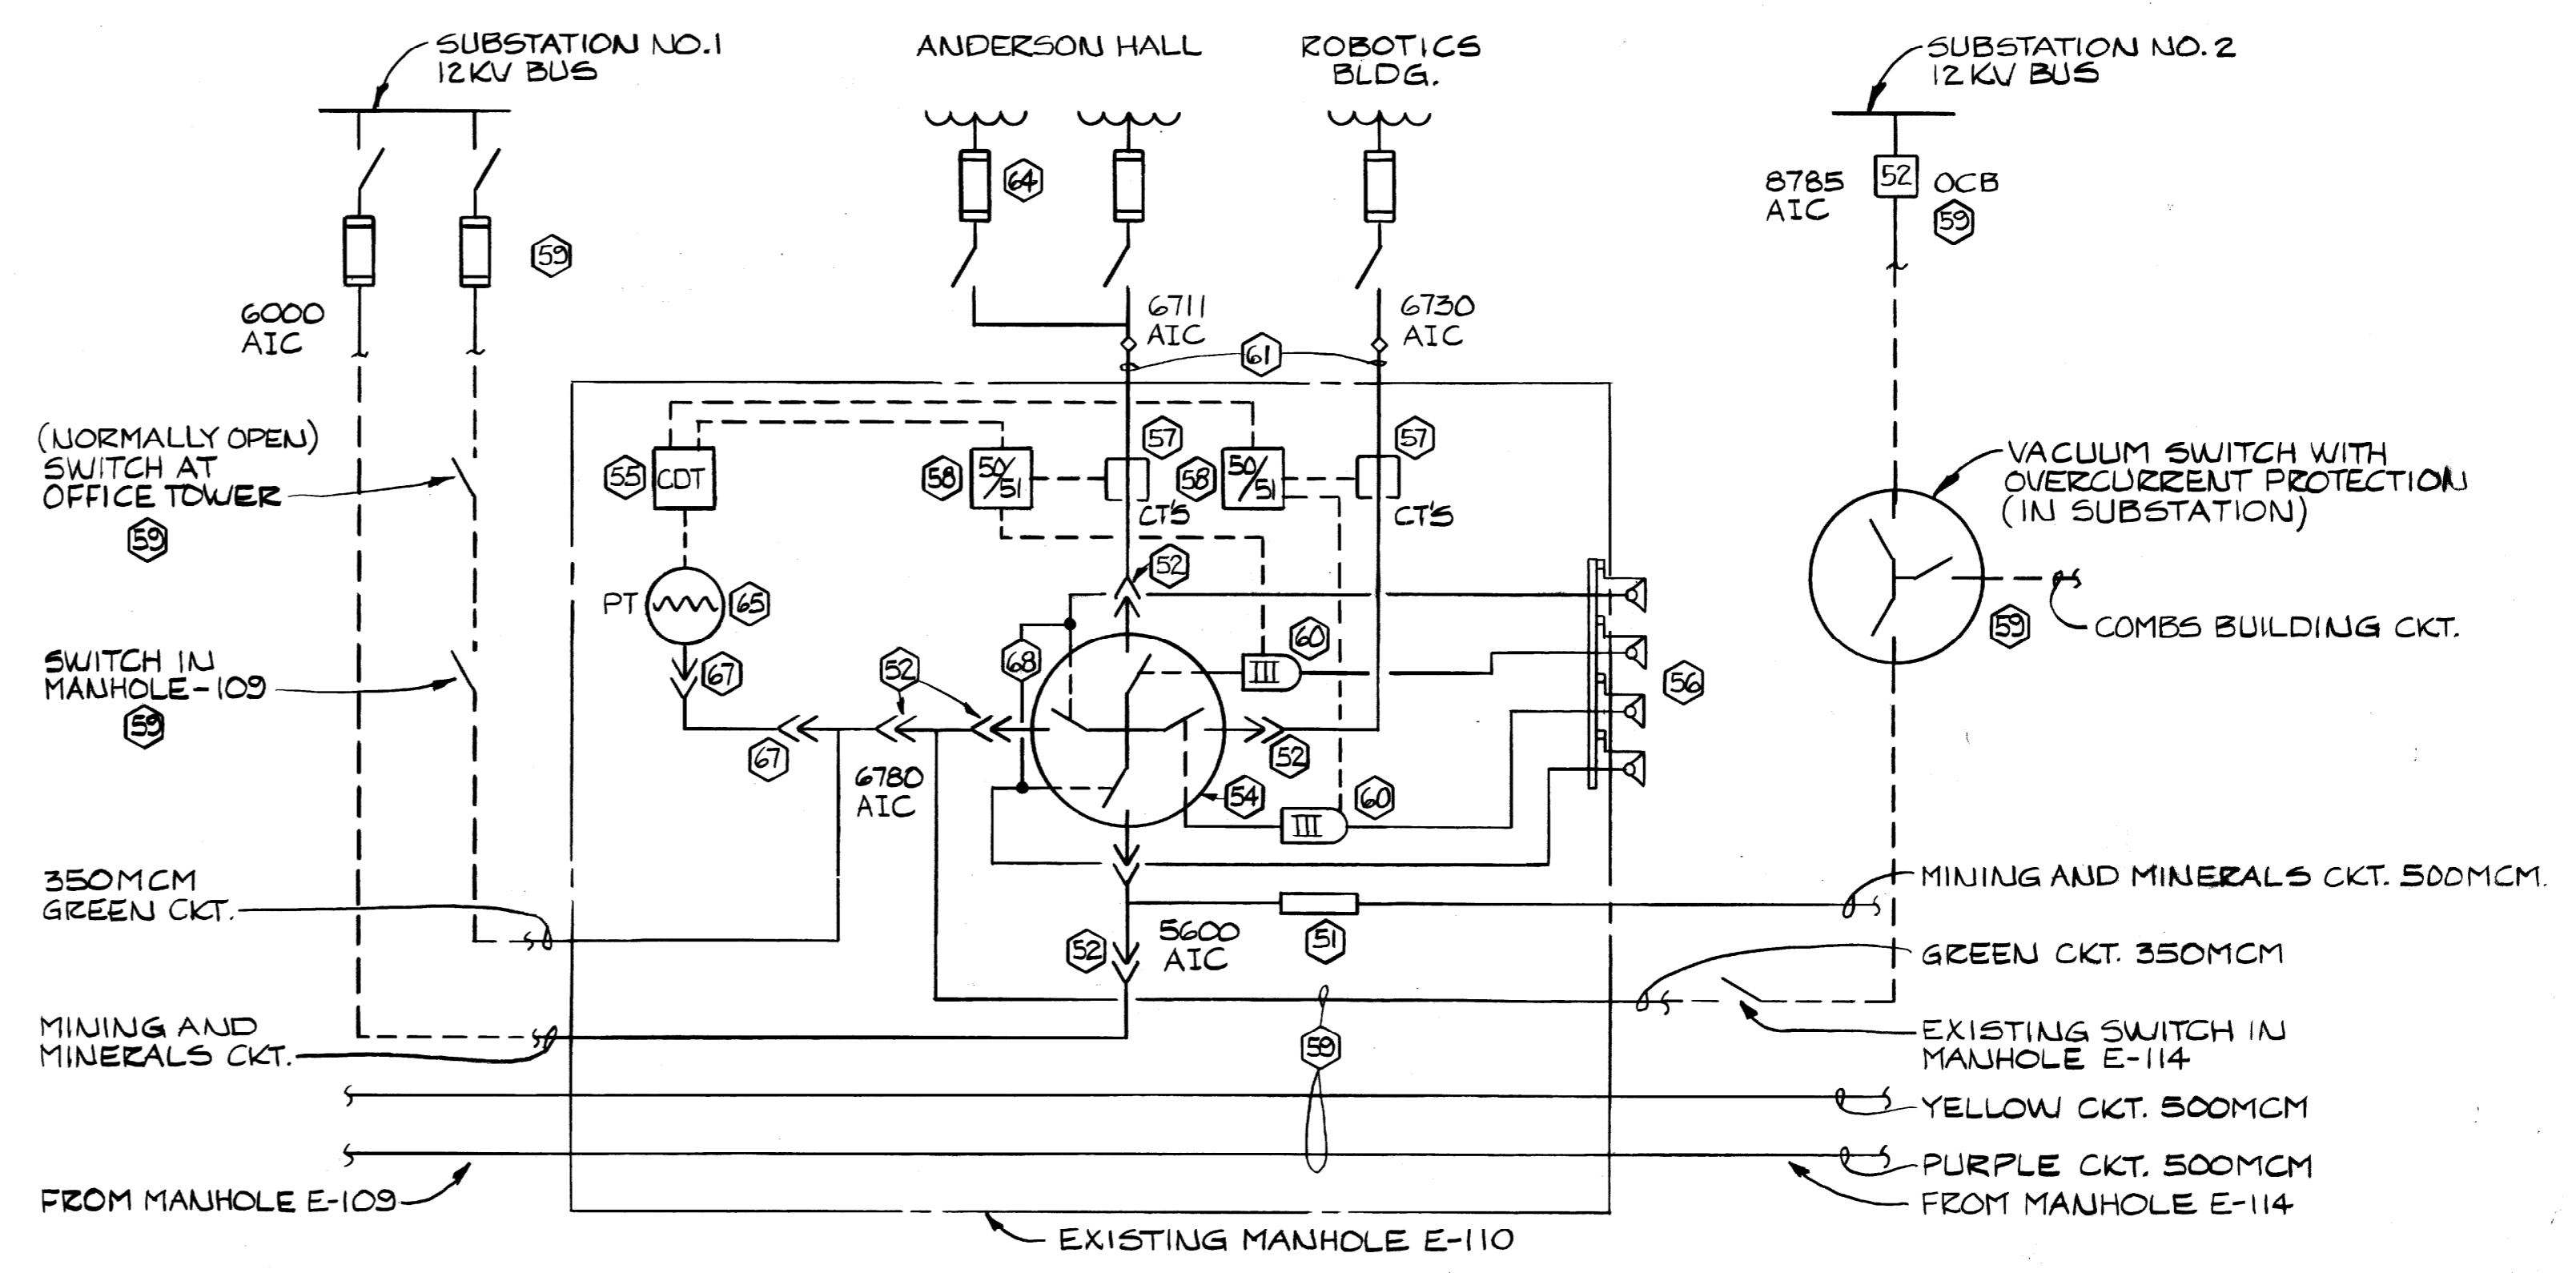


15KV SWITCH SCHEMATIC
NO SCALE

- NOTES - HIGH VOLTAGE VACUUM SWITCH SHEETS C14 & C15
- ⑤1 NEW 15 KV IN-LINE SPLICE.
 - ⑤2 NEW 600 AMPERE ELBOW TERMINATION
 - ⑤3 OMITTED
 - ⑤4 NEW HIGH VOLTAGE VACUUM SWITCH.
 - ⑤5 NEW CAPACITOR DISCHARGE & TRIP DEVICE
 - ⑤6 NEW REMOTE MANUAL OPERATORS GROUPED AT MANHOLE ENTRANCE. OPERATORS TO BE PROVIDED WITH 5 FOOT CABLE SLACK AND TO BE MOUNTED ON PORTABLE SWITCH STAND.
 - ⑤7 NEW 400:5 CURRENT TRANSFORMERS. MOUNTED ON WALL.
 - ⑤8 NEW RELAY PACKAGE.
 - ⑤9 EXISTING.
 - ⑥0 SPRING LOADED SWITCH OPERATOR.
 - ⑥1 NEW 3 #4/0 CU., 15 KV AND 1 #4/0 CU THW.
 - ⑥2 OMITTED
 - ⑥3 OMITTED
 - ⑥4 EXISTING DOUBLE ENDED SUBSTATION.
 - ⑥5 POTENTIAL TRANSFORMER.
 - ⑥6 OMITTED
 - ⑥7 200 AMP LOAD BREAK ELBOW W/ADAPTER AT SWITCH.
 - ⑥8 MECHANICAL INTERLOCK BETWEEN SWITCH LEGS.
 - ⑥9 SEE SPECIFICATIONS FOR INSTALLATION & OUTAGE SEQUENCE.
 - ⑦0 NEW 400:5 CURRENT TRANSFORMERS. SEE DETAIL BELOW.
 - ⑦1 CONTROL WIRING (NOT SHOWN) TO BE INSTALLED IN RIGID STEEL CONDUIT. ALL CONNECTIONS TO BE INSULATED.

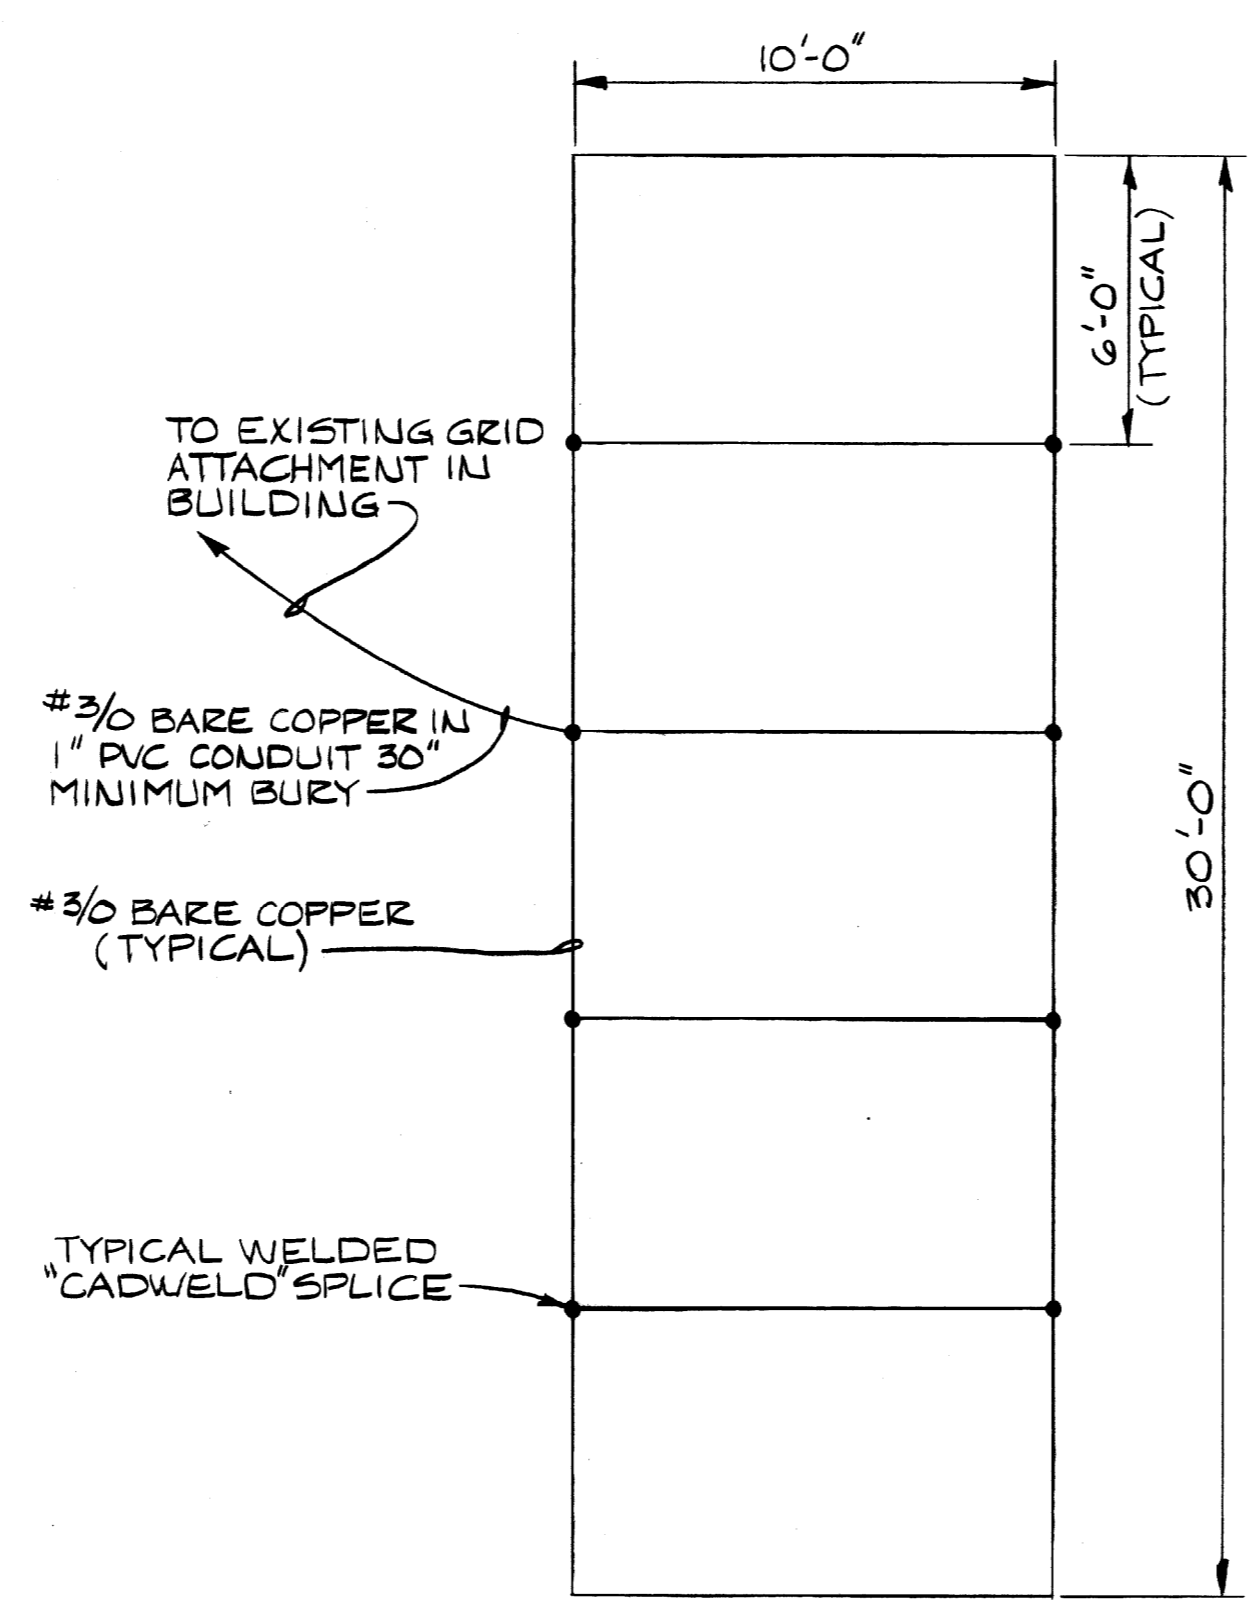

NOTE:
GRID IS TO BE BURIED 30" BELOW FINAL GRADE.

GROUND GRID DETAIL
NO SCALE

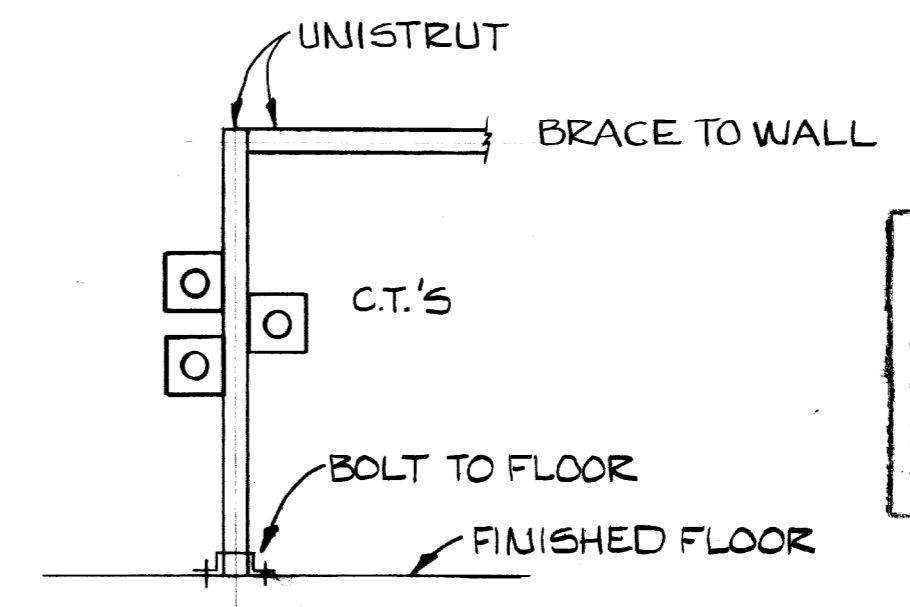

C.T. MOUNTING DETAIL
NO SCALE

RECORD PRINTS
THESE ARE RECORD PRINTS OF DRAWINGS BASED UPON MARKED UP PRINTS, DRAWINGS AND OTHER DATA FURNISHED BY THE CONTRACTOR TO THE ENGINEER AND WHICH THE ENGINEER CONSIDERS SIGNIFICANT



ROBOTICS FACILITY
LEXINGTON CAMPUS
UNIVERSITY OF KENTUCKY
LEXINGTON, KENTUCKY

University of Kentucky
Lexington, Kentucky
10-19-87
Wendy Banning

POWER AND COMMUNICATION
Sherman Carter Barnhart
PARTNERS IN ARCHITECTURE
SUITE 1800 • 250 WEST MAIN STREET • LEXINGTON, KY 40501 • 606.254.1353


JOB NO. 2046
DATE 10-19-87
DRAWN T.M.G.
CHECKED L.D.C.
FILE NO. 431.0

REVISIONS


SHEET

C-15


NOTE: CONTRACTOR SHALL COORDINATE INSTALLATION OF MANHOLE WITH RELOCATION OF EXISTING WATER LINE.

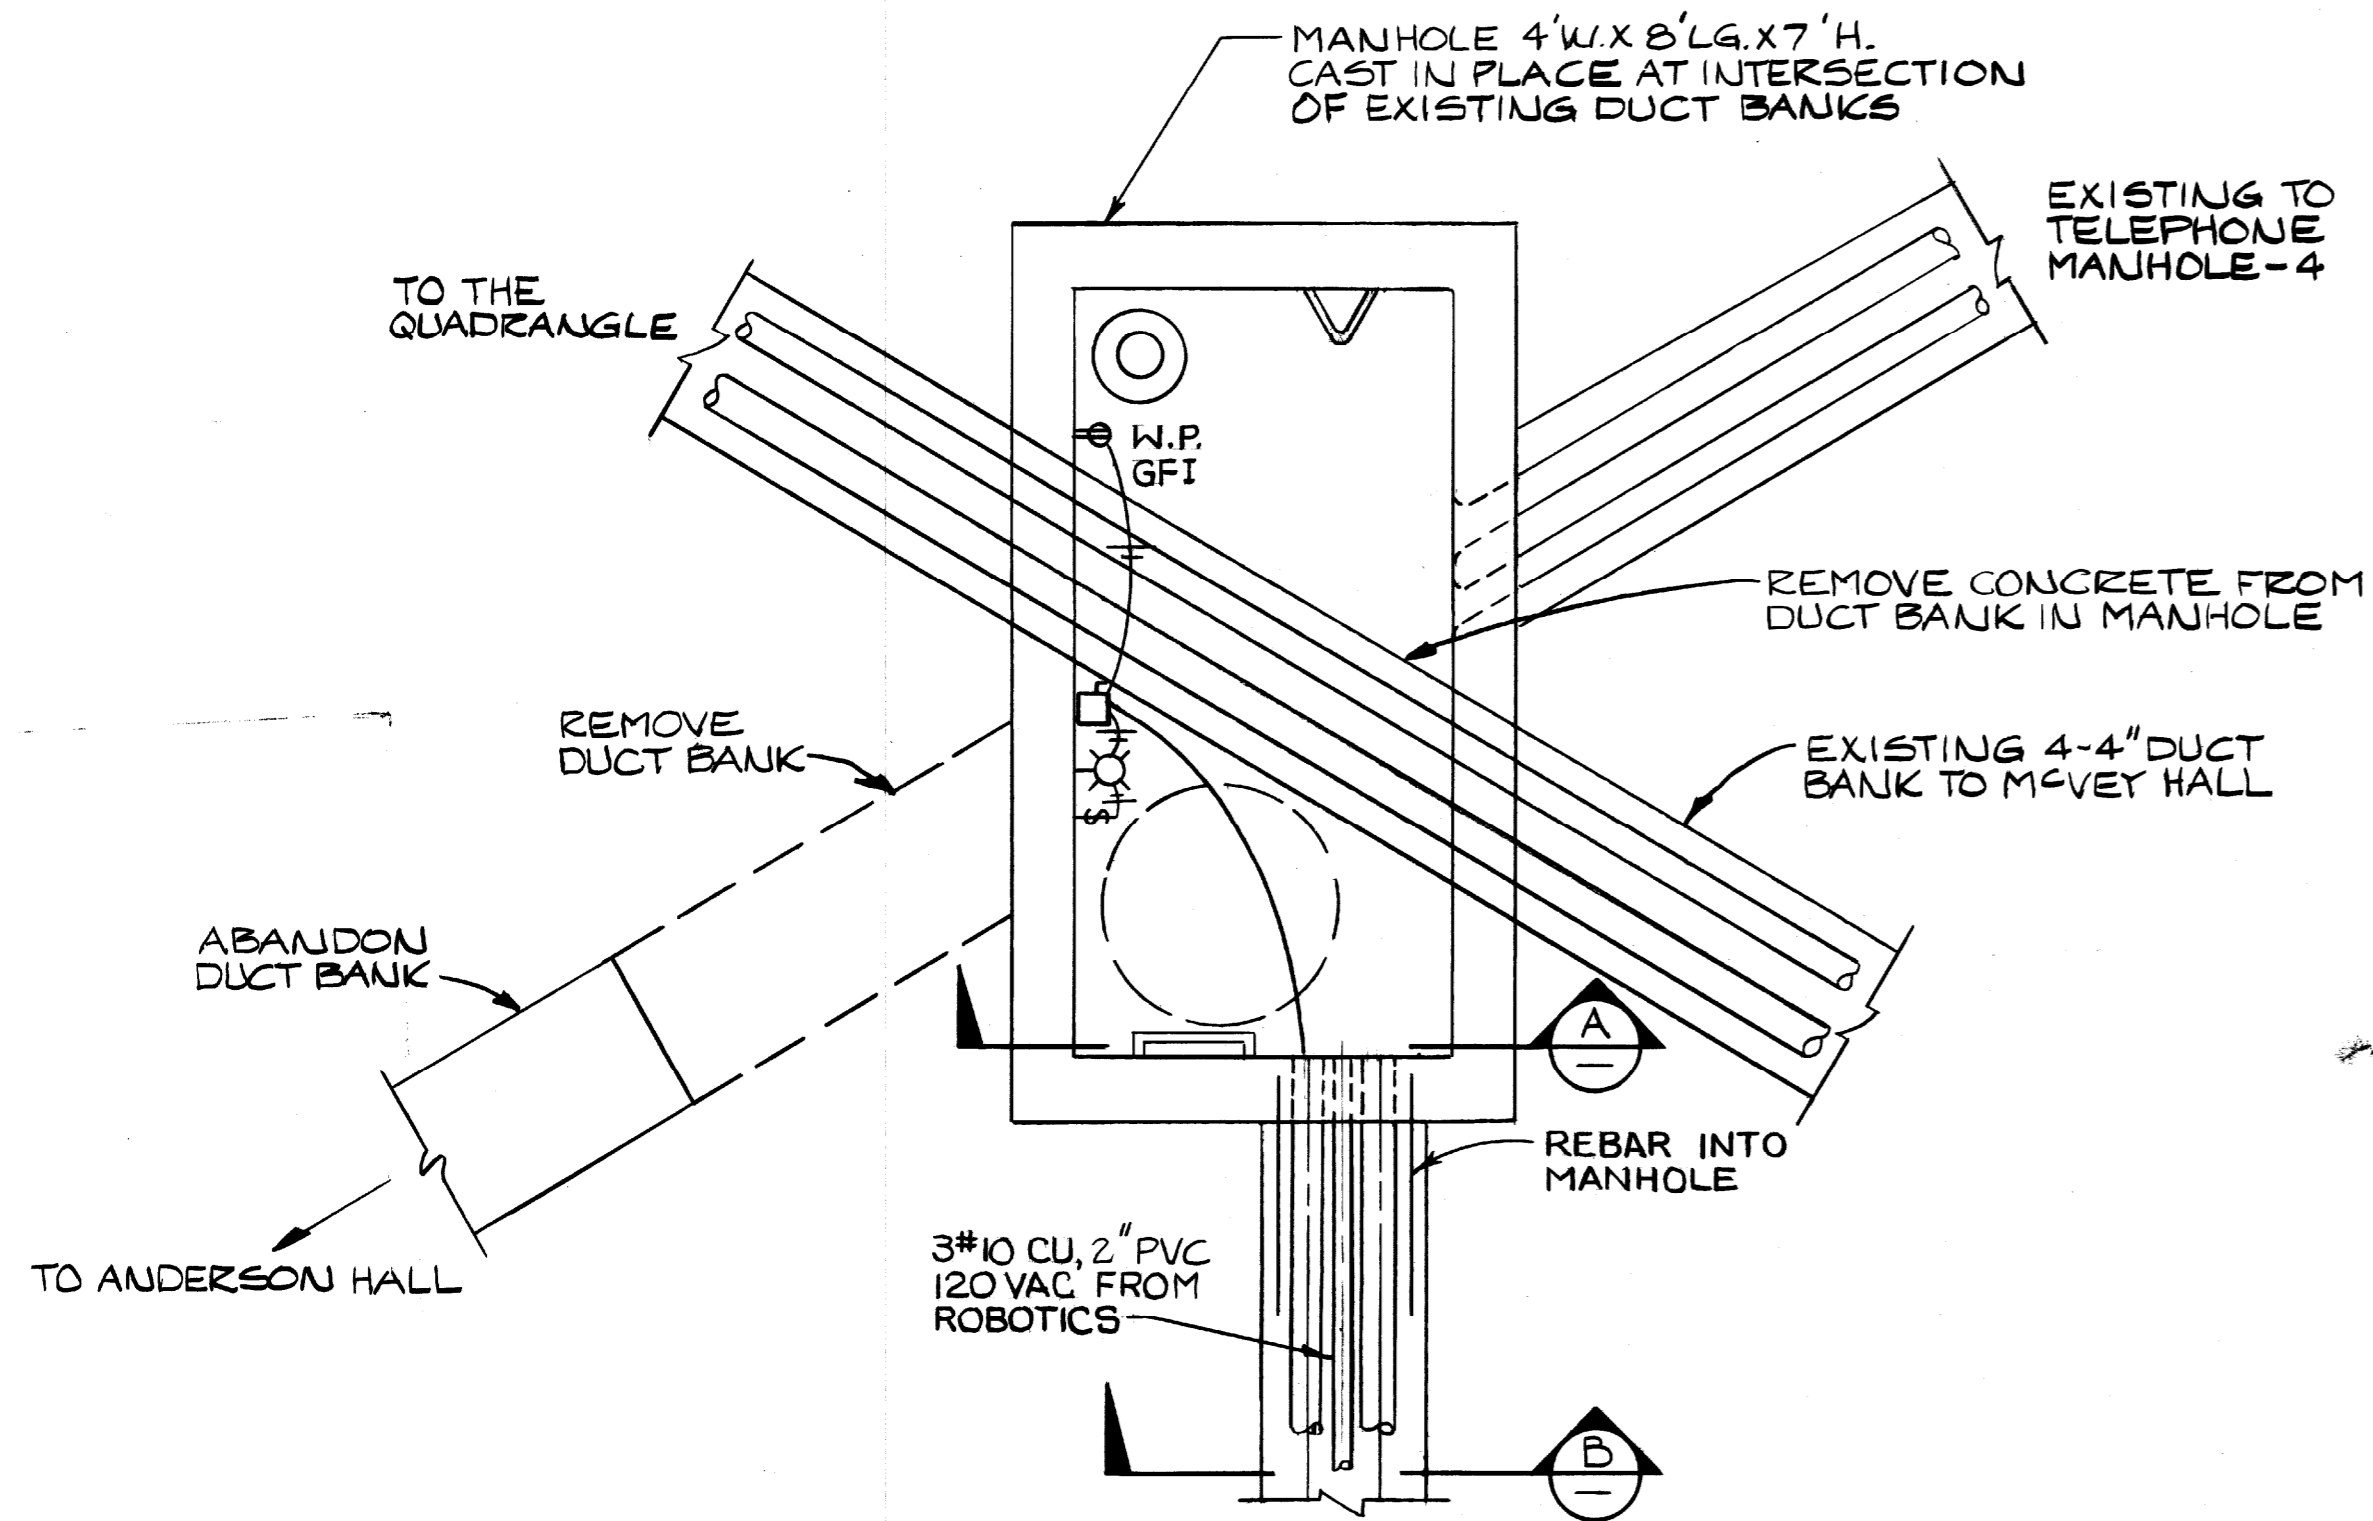


NEW TELEPHONE MANHOLE DETAIL
SCALE: 1/2" = 1'-0"

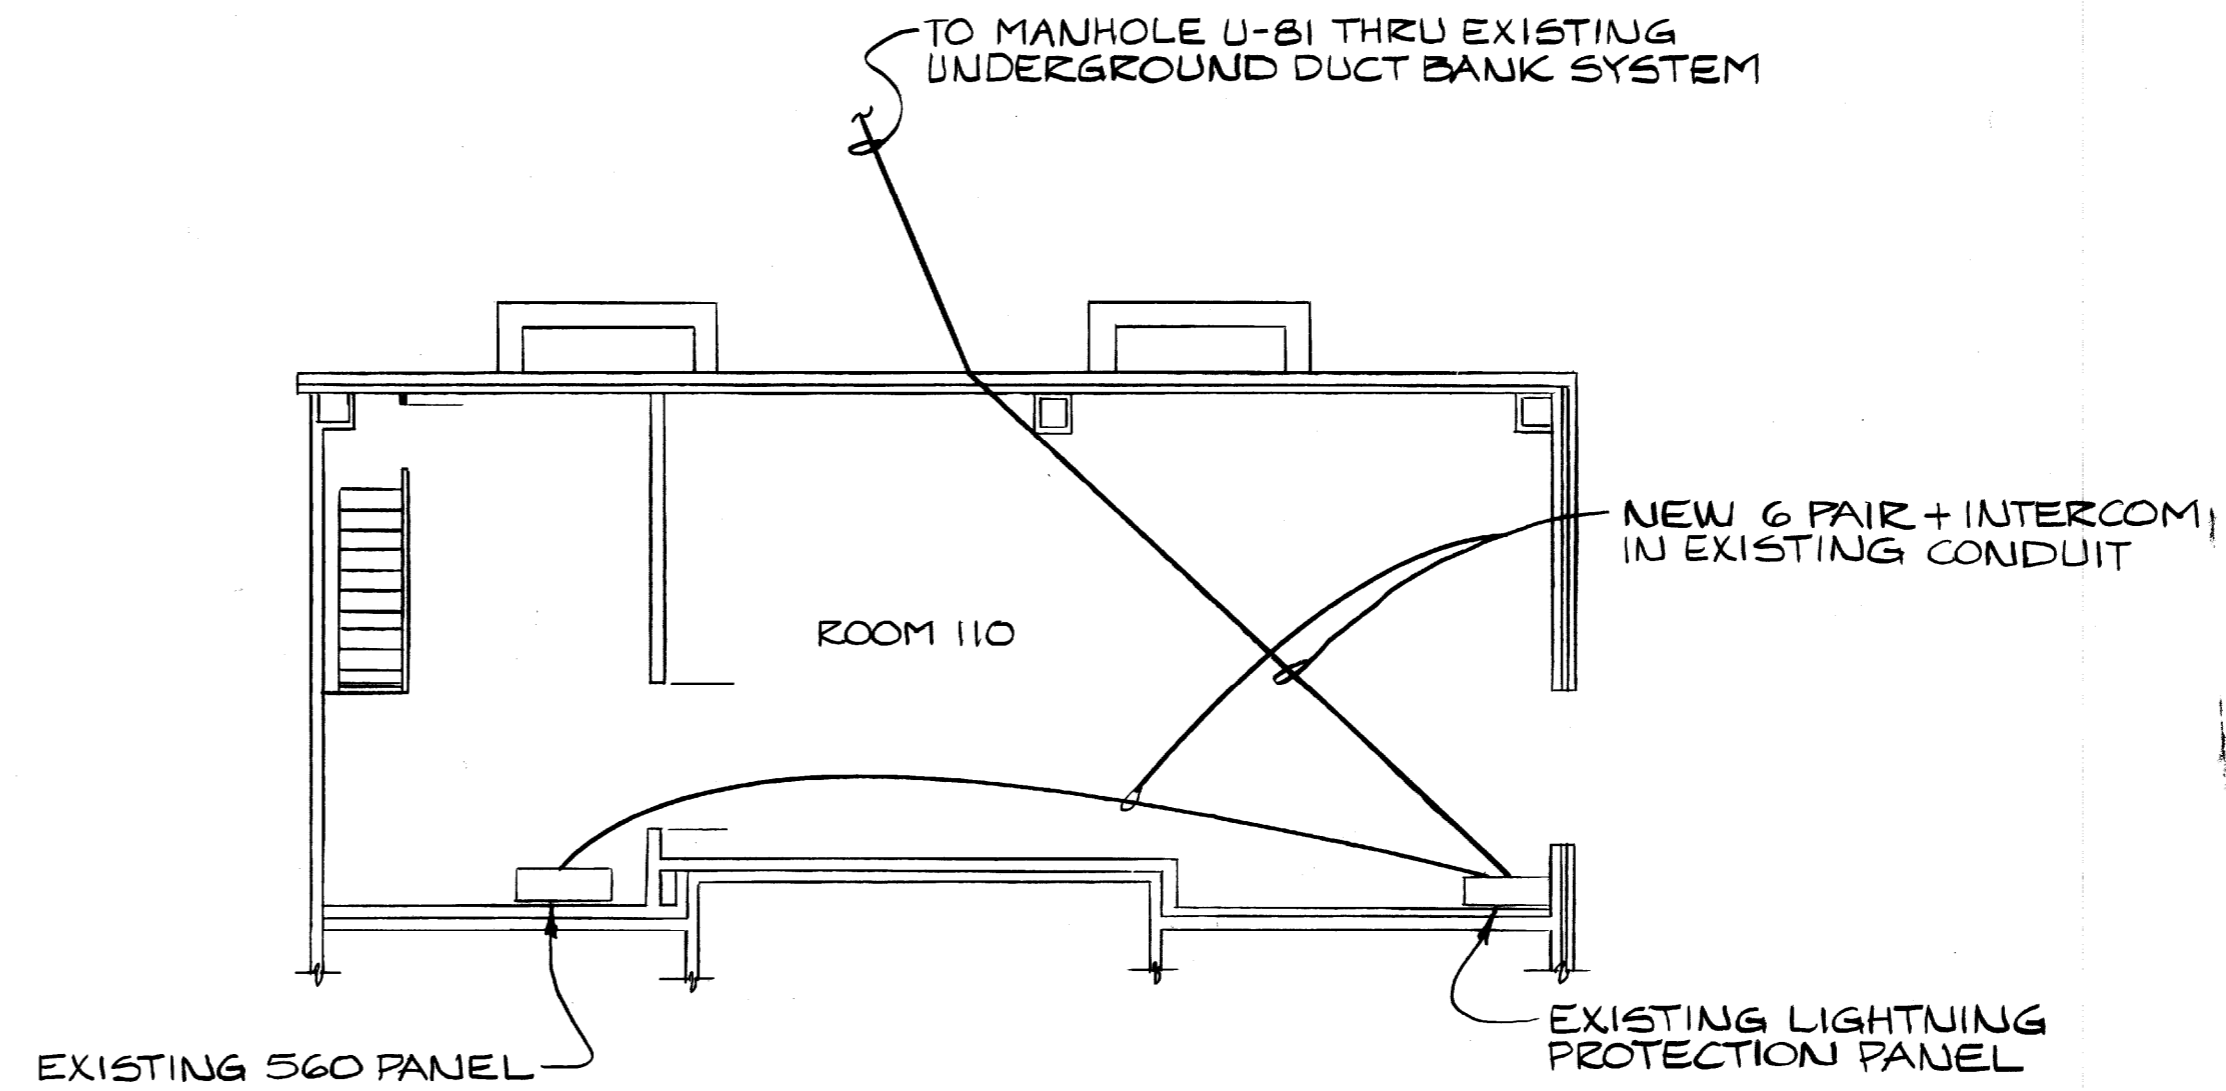

MINES AND MINERALS PARTIAL PLAN
SCALE: 1/8" = 1'-0"

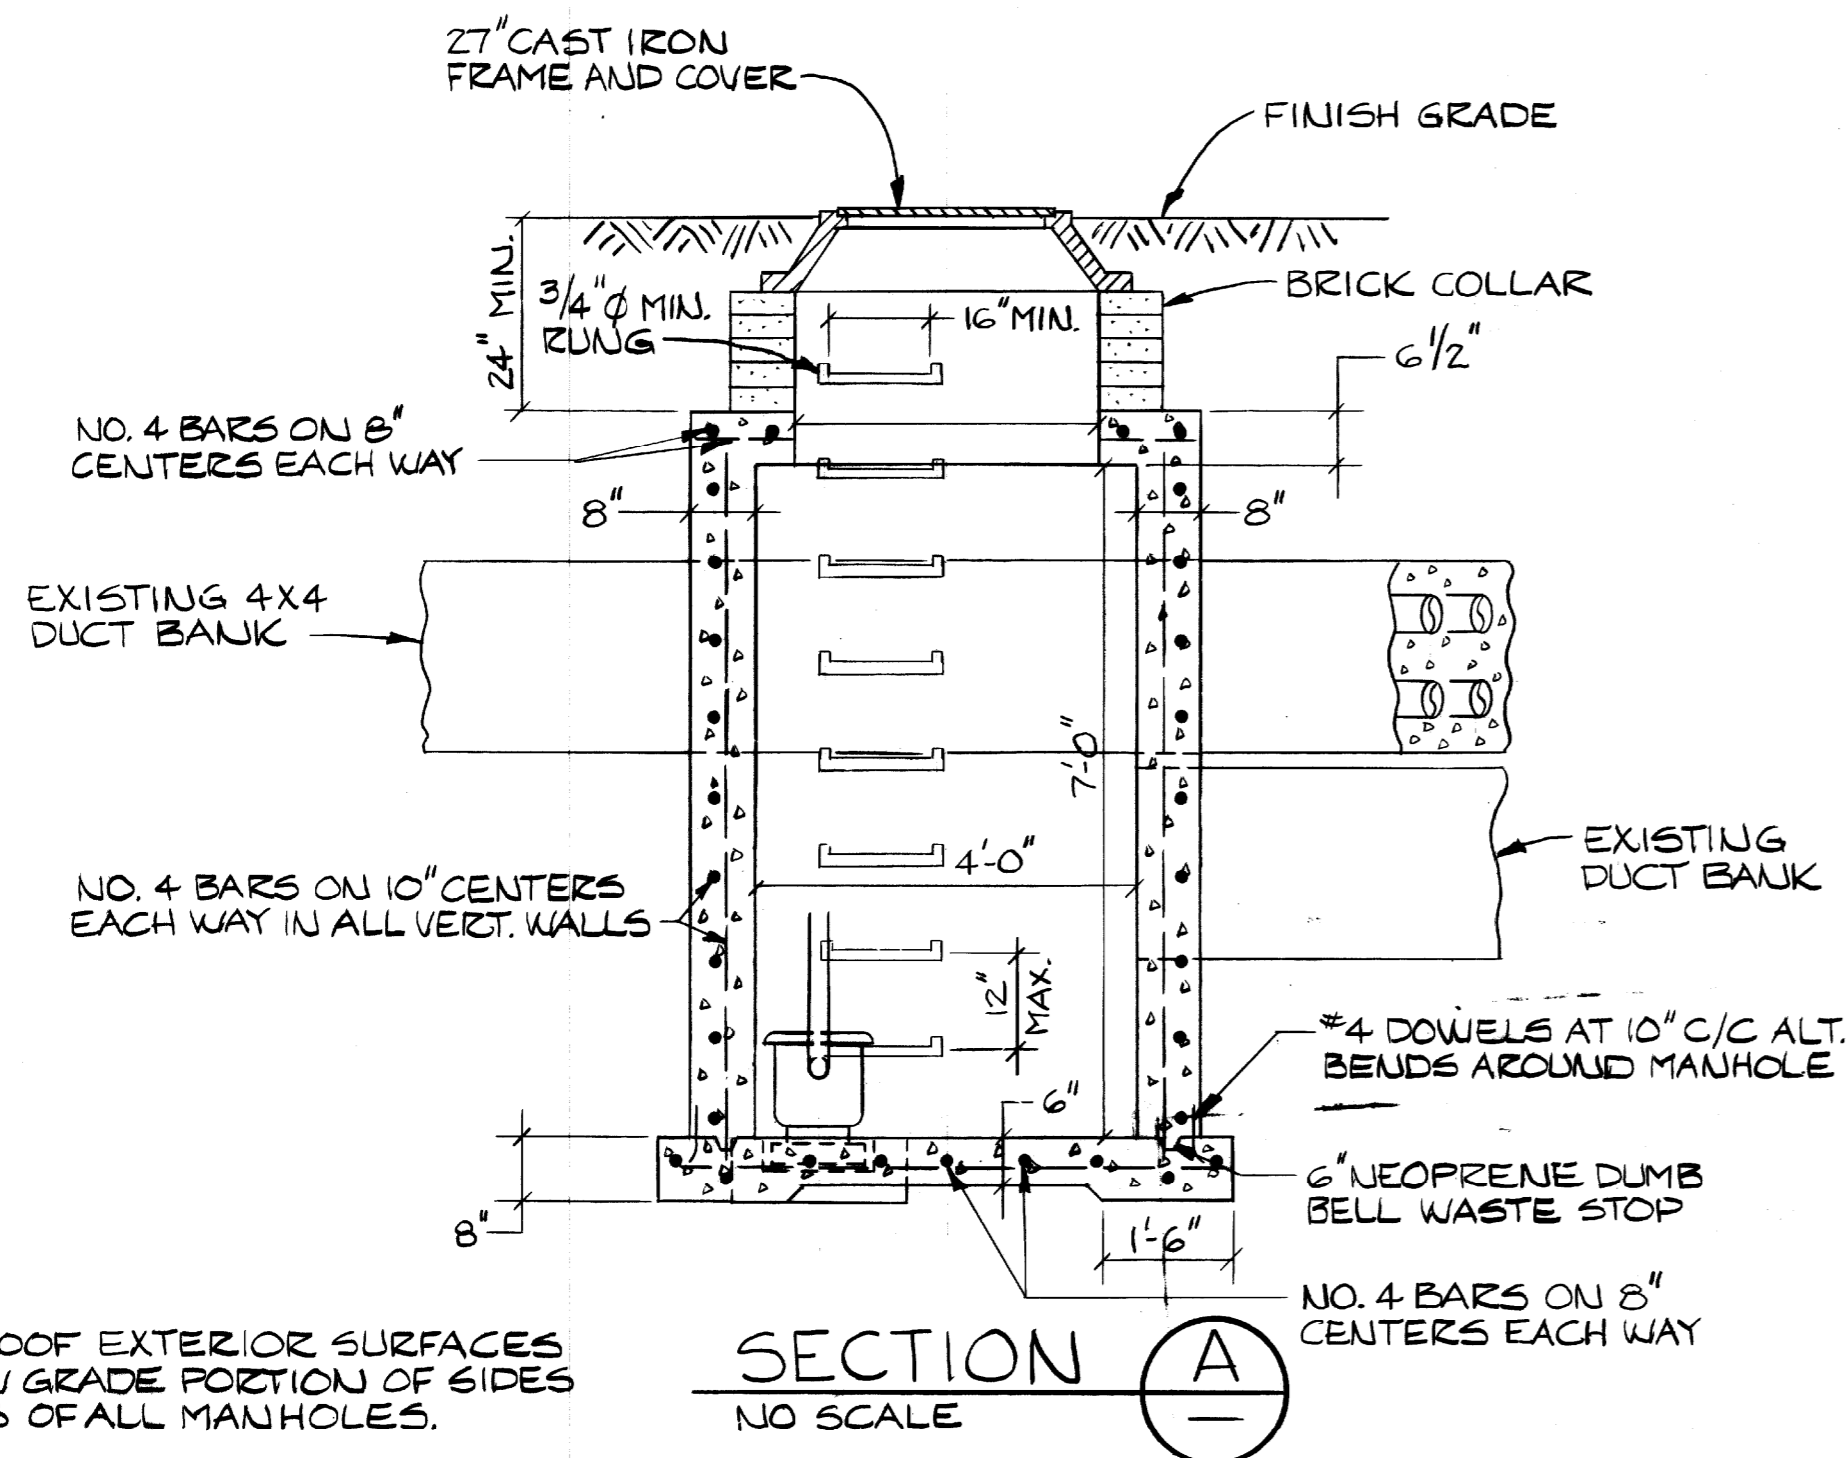

SECTION A
NO SCALE

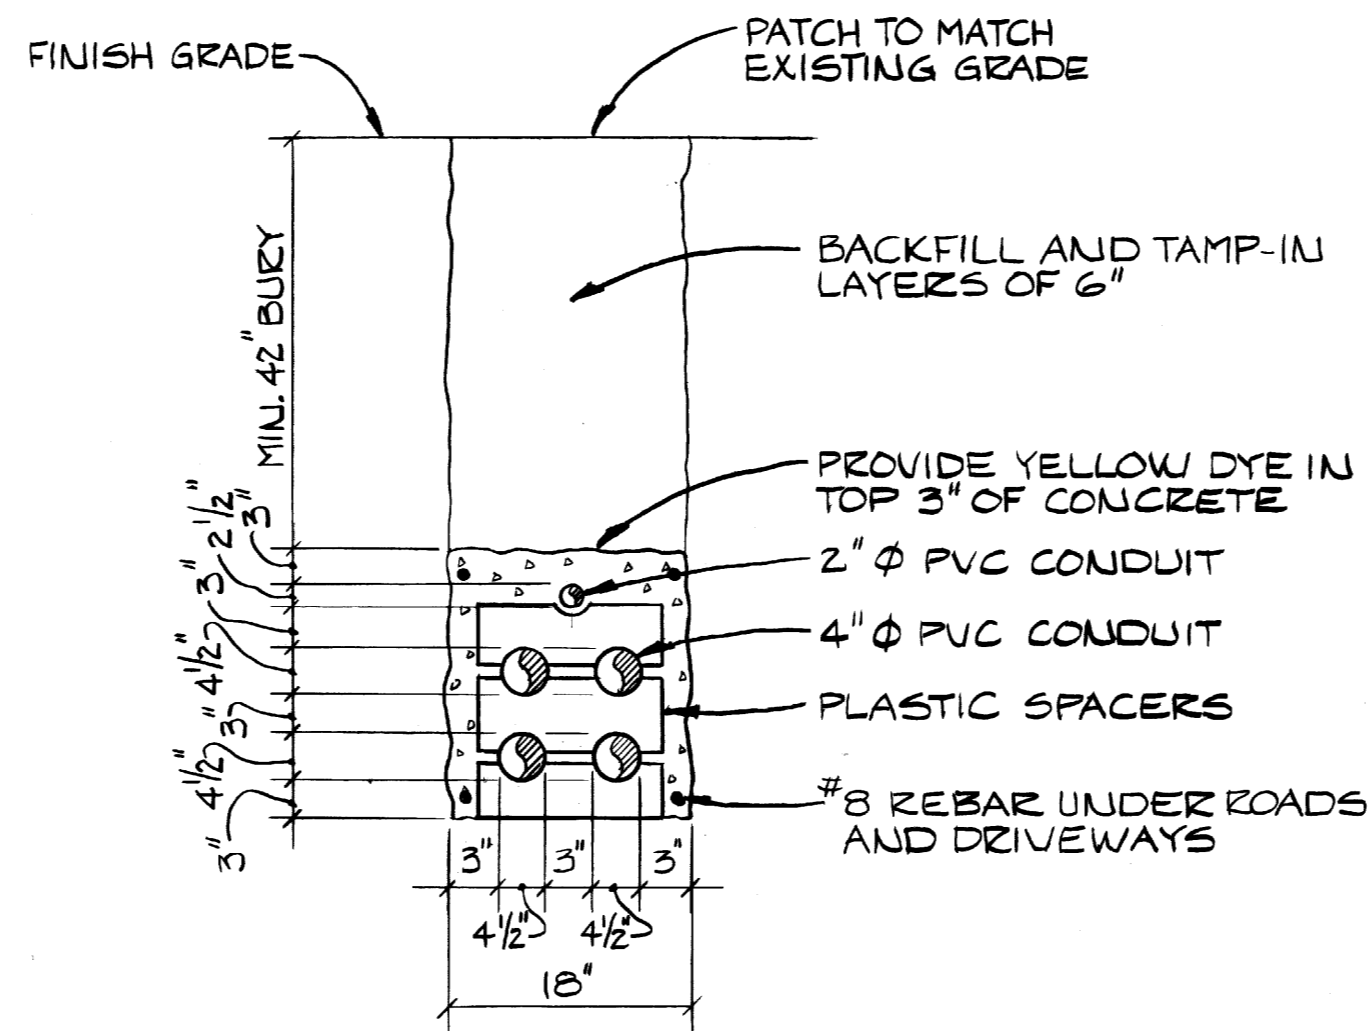

SECTION B
NO SCALE

NOTE:
WATERPROOF EXTERIOR SURFACES
OF BELOW GRADE PORTION OF SIDES
AND TOPS OF ALL MANHOLES.

RECORD PRINTS
THESE ARE RECORD PRINTS OF DRAWINGS BASED
UPON MARKED UP PRINTS, DRAWINGS AND OTHER
DATA FURNISHED BY THE CONTRACTOR TO THE
ENGINEER AND WHICH THE ENGINEER CONSIDERS
SIGNIFICANT

ROBOTICS FACILITY
LEXINGTON CAMPUS
UNIVERSITY OF KENTUCKY
LEXINGTON, KENTUCKY

University of Kentucky
Lexington, Kentucky

COMMUNICATION DETAILS



Sherman Carter Barnhart
PARTNERS IN ARCHITECTURE
SHELBY COUNTY, KENTUCKY

JOB NO. 2046
DATE 10-19-87
DRAWN T.M.G.
CHECKED L.D.C.
FILE NO. 431.0

REVISIONS

DATE: 10-19-87
SHEET: A-1
C-16

MASON & HANGER ENGINEERING INC.
ARCHITECT • ENGINEERS
LEXINGTON, KENTUCKY

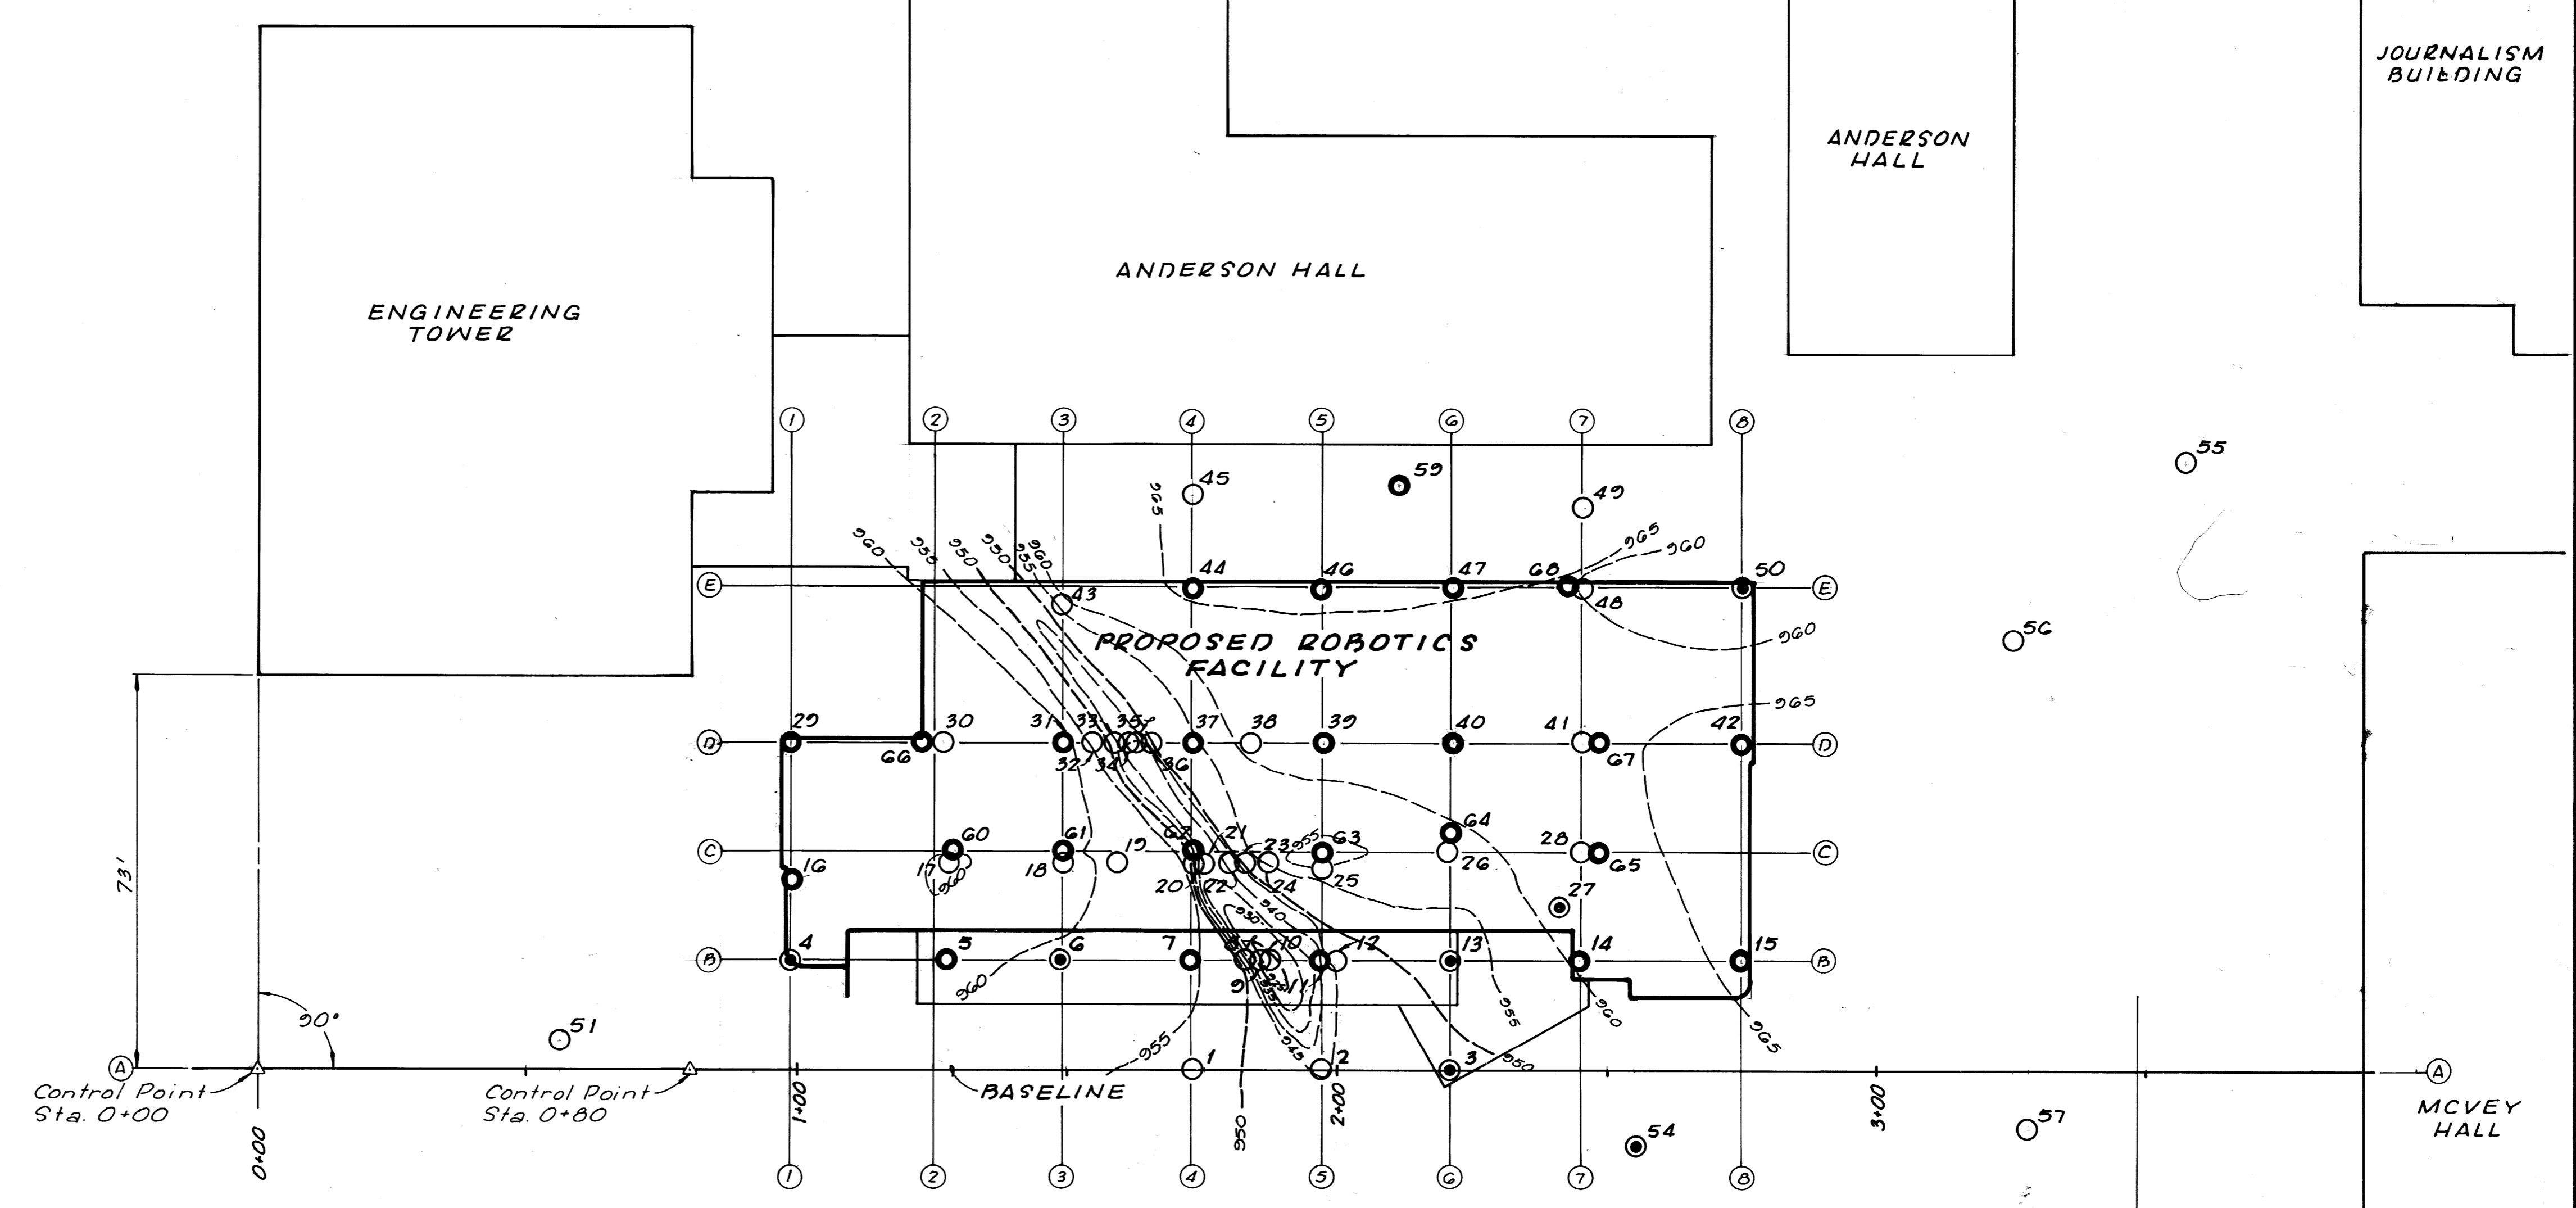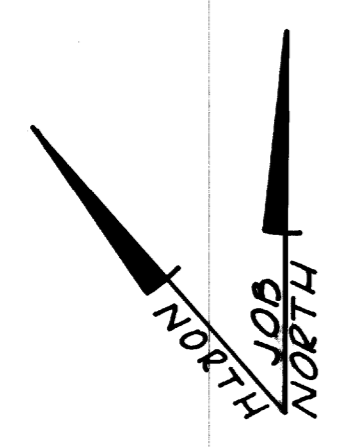


BORING LOCATIONS

Boring No.	Surface Elev.(Ft.)	Station	Offset (Ft.)*	Column Location
1	961.0	1+73	0	
2	961.2	1+97	0	
3	963.2	2+21	0	A-6
4	966.5	0+99	20	B-1
5	963.3	1+28	20	B-2, (3' East)
6	961.3	1+49	20	B-3
7	961.0	1+73	20	B-4
8	961.6	1+83	20	
9	961.7	1+86	20	
10	961.6	1+88	20	
11	961.7	1+97	20	B-5
12	961.7	2+00	20	
13	963.3	2+21	20	B-6
14	967.0	2+45	20	B-7
15	972.1	2+75	20	B-8
16	966.7	0+99	35	C-1, (5' South)
17	963.7	1+28	38	C-2, (2' South, 3' East)
18	964.1	1+49	38	C-3, (2' South)
19	964.3	1+59	38	
20	964.5	1+73	38	C-4, (2' South)
21	964.5	1+75	38	
22	964.8	1+80	38	
23	964.9	1+83	38	
24	965.0	1+87	38	
25	965.4	1+97	37	C-5, (3' South)
26	966.0	2+20	40	C-6, (1' West)
27	968.0	2+41	30	
28	971.0	2+45	40	C-7
29	962.1	0+99	60	D-1
30	962.7	1+27	60	D-2, (2' East)
31	964.4	1+49	60	D-3
32	964.7	1+54	60	
33	965.0	1+58	60	
34	965.3	1+61	60	
35	965.6	1+62	60	
36	965.8	1+65	60	
37	966.0	1+73	60	D-4
38	967.0	1+84	60	
39	967.9	1+97	60	D-5
40	969.7	2+21	60	D-6
41	971.6	2+45	60	D-7
42	973.8	2+75	60	D-8
43	976.2	1+49	86	E-3, (3' South)
44	976.0	1+73	89	E-4
45	975.9	1+73	106	
46	975.8	1+97	89	E-5
47	975.5	2+21	89	E-6
48	975.7	2+45	89	E-7
49	975.6	2+45	104	

Boring No.	Surface Elev.(Ft.)	Station	Offset (Ft.)*	Column Location
50	975.4	2+75	89	E-8
51	966.0	0+56	5	
52	965.1	1+36	81 Rt.	
53	968.2	2+54	59 Rt.	
54	969.2	2+55	14 Rt.	
55	978.8	3+57	112	
56	977.7	3+25	79	
57	973.9	3+28	11 Rt.	
58	971.3	3+21	73 Rt.	
59	975.6	2+11	108	
60	963.4	1+28	40	C-2, (3' East)
61	964.0	1+49	40	C-3
62	965.5	1+73	40	C-4
63	967.4	1+97	40	C-5
64	969.7	2+21	44	C-6, (4' North)
65	971.4	2+48	40	C-7, (3' East)
66	962.5	1+23	60	D-2, (2' West)
67	971.8	2+49	60	D-7, (4' East)
68	975.7	2+43	89	E-7, (2' West)

* Offsets are to the left unless noted otherwise.

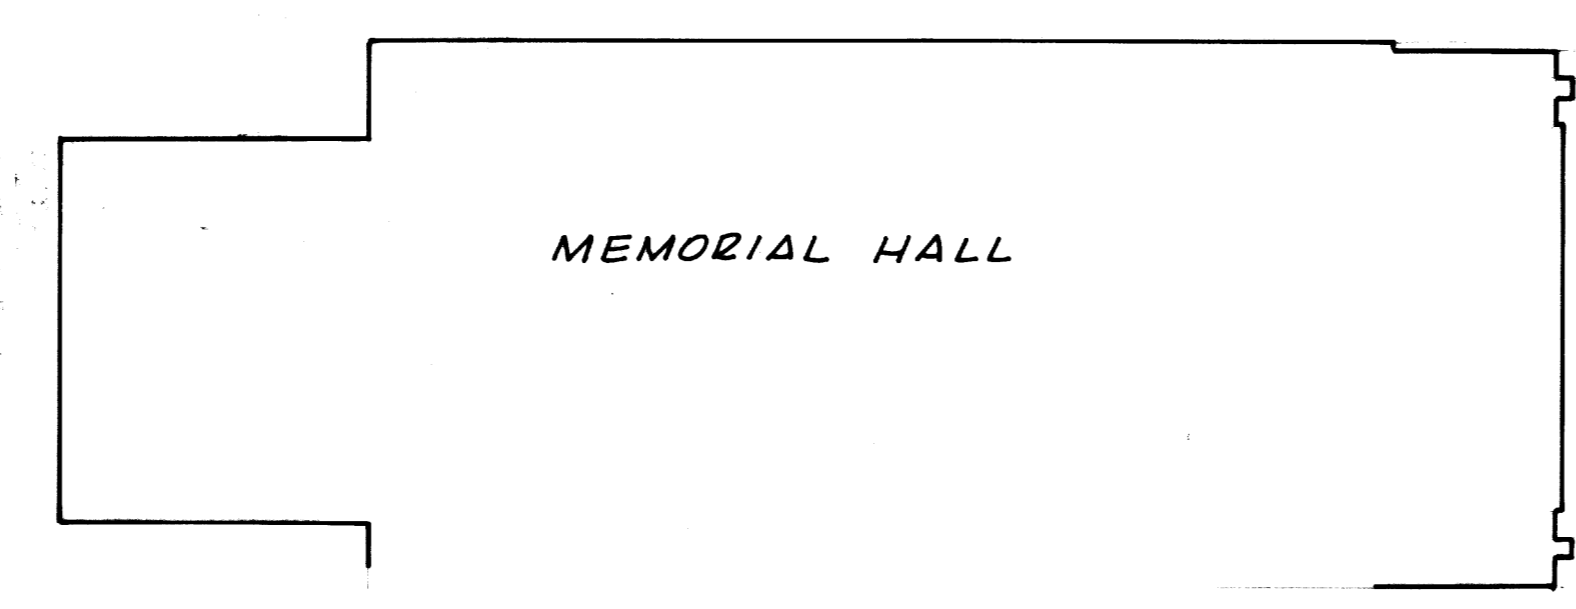

NOTES:

- 1) THE ROCK CONTOURS SHOWN ON THIS SHEET ARE THE RESULT OF STRAIGHT LINE INTERPOLATION BETWEEN ROCK CONTACT POINTS AT EACH BORING LOCATION. THESE CONTOURS ARE PRESENTED FOR ILLUSTRATION PURPOSES ONLY AND SHOULD NOT BE USED BY THE CONTRACTOR FOR CONSTRUCTION OF THE PROJECT. ACTUAL ROCK CONTOURS BETWEEN BORINGS ARE UNKNOWN AND MAY DIFFER FROM THOSE SHOWN.
- 2) LAYOUT OF THE ROBOTICS FACILITY AND LOCATION OF ADJACENT STRUCTURES WERE SCALED FROM A DRAWING PROVIDED BY SHERMAN/CARTER/BARNHART ARCHITECTS ENTITLED "SITE DEVELOPMENT PLAN" - SHEET SD.1 OF PHASE "A" SUBMITTAL DATED JULY 10, 1987.
- 3) ELEVATION BENCHMARK: TOP OF 12-INCH DIAMETER CONCRETE POST 39.2 FEET FROM SW CORNER OF STEAM GALLERY ADJACENT TO MCVEY HALL AND 68.0 FEET FROM NW CORNER OF STEAM GALLERY NEAR MEMORIAL HALL. (BENCHMARK OBTAINED FROM UNIVERSITY OF KENTUCKY, DESIGN AND CONSTRUCTION BRANCH) ELEV. 974.51 FT.

LEGEND

- Rock Sounding.
- Soil Boring with Undisturbed (Shelby) Tube Samples and Rock Core.
- ⊙ Rock Core Boring.
- Rock Contours (See Note 1)
- Δ Survey Monument.

BENCHMARK ELEV. 974.51.
(See note 3)

← FUNKHOUSER DRIVE →

RECORD PRINTS

THESE ARE RECORD PRINTS OF DRAWINGS BASED UPON MARKED UP PRINTS, DRAWINGS AND OTHER DATA FURNISHED BY THE CONTRACTOR TO THE ENGINEER AND WHICH THE ENGINEER CONSIDERS SIGNIFICANT.

BORING LAYOUT

ROBOTICS FACILITY - UNIVERSITY OF KENTUCKY

FULLER, MOSSBARGER, SCOTT AND MAY
CIVIL ENGINEERS, INC.
1409 FORBES ROAD
LEXINGTON, KENTUCKY 40505

DRAWN BY S.F.S.	DATE Aug., 1987	REVISION	SHEET
CHECKED BY K.O.H.	PROJECT NO. 87178		1 of 5
CHECKED BY W.A.M.	SCALE 1" = 20'		



ROBOTICS FACILITY
LEXINGTON CAMPUS
UNIVERSITY OF KENTUCKY
LEXINGTON, KENTUCKY

University of Kentucky
Lexington, Kentucky


APPROVED BY
W. B. BARNHART
DIRECTOR - DESIGN AND CONSTRUCTION BRANCH
DATE 8-19-87

Sherman Carter Barnhart
PARTNERS IN ARCHITECTURE
SUITE 1800 • 250 WEST MAIN STREET • LEXINGTON, KY 40507 • 806/254-1851

JOB NO.	8706
DATE	
DRAWN	
CHECKED	CEB
FILE NO.	431.0

REVISIONS	

SHEET
A-1

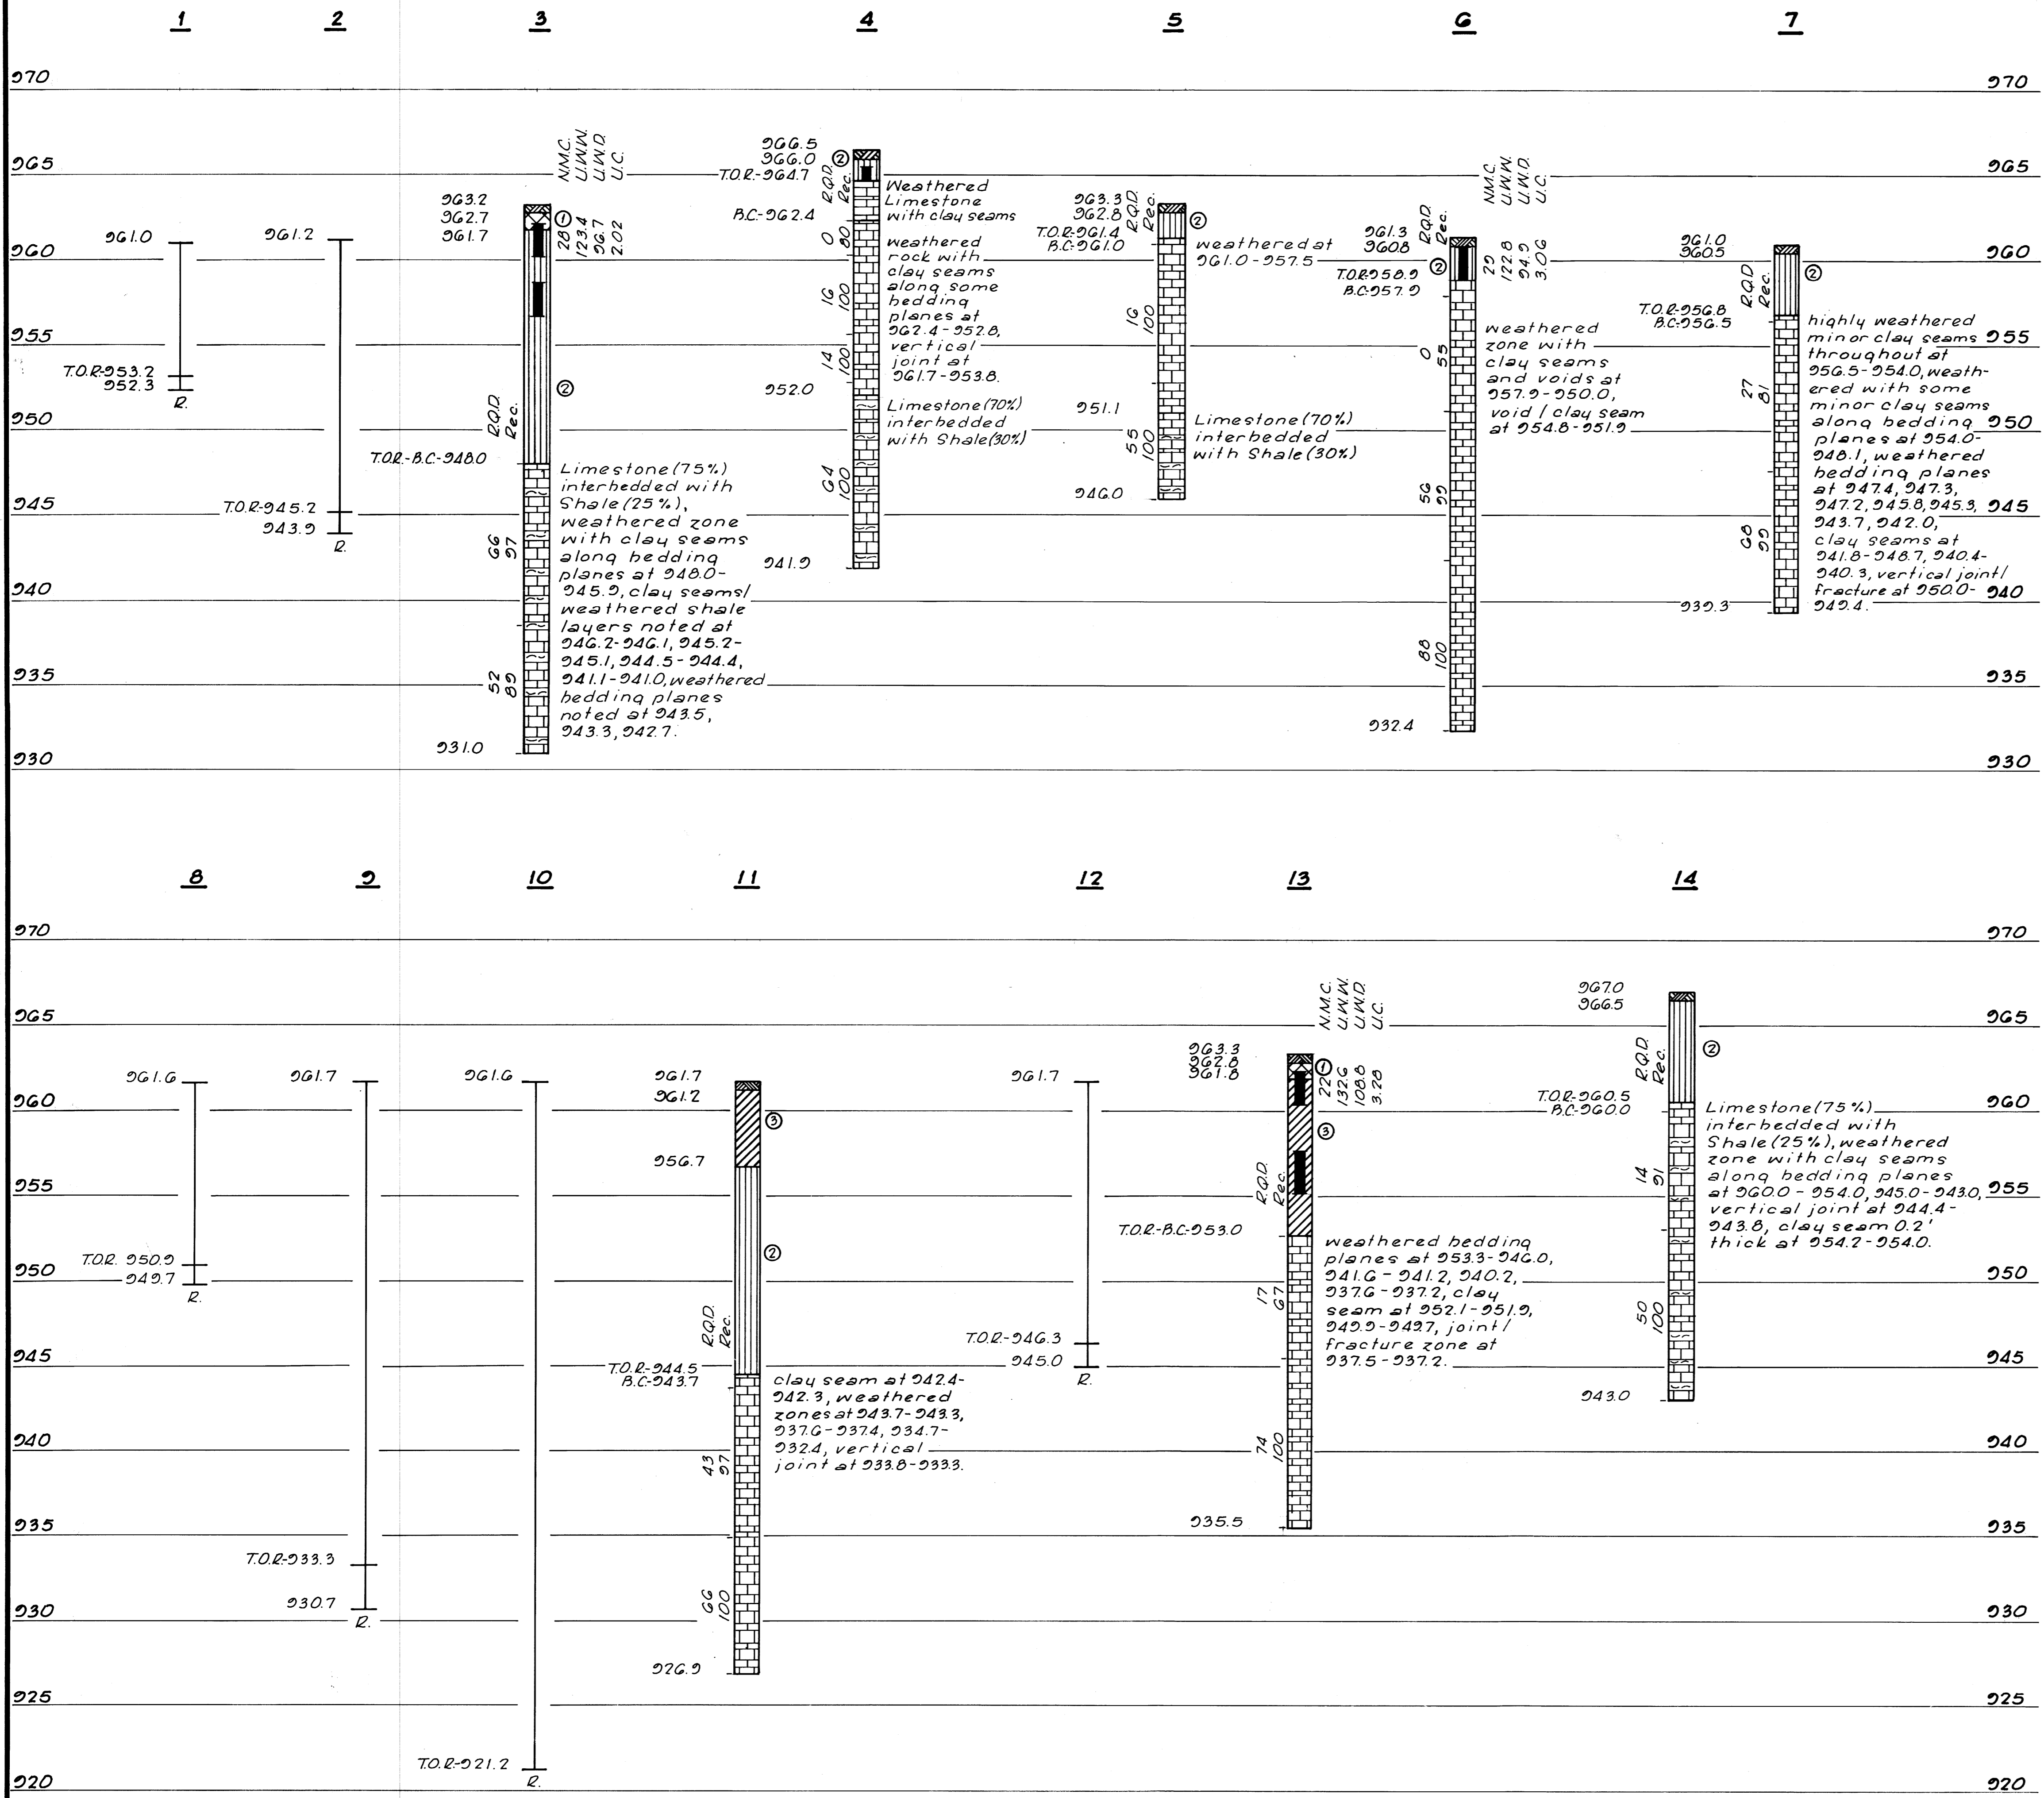

LEGEND

- Topsoil
- Bituminous Pavement.
- Fill Material: silt, dark brown with construction debris.
- Silt, dark brown, dry to moist, stiff.
- Fat Clay with Sand, light to dark reddish brown, moist, medium to stiff.
- Limestone interbedded with Shale; Limestone, gray, fine to coarse crystalline grained with shale partings and stringers, fossiliferous, moderately hard to hard; Shale, gray, calcareous, moderately to hard.
- Limestone, gray, weathers brown, fine to coarse crystalline grained with shale partings and stringers, moderately hard to hard.
- Undisturbed Thin-walled (Shelby) Tube Sample Interval.
- N.M.C. Natural Moisture Content (%).
- U.W.W. Unit Weight, Wet (lbs./cu.ft.).
- U.W.D. Unit Weight Dry (lbs./cu.ft.).
- U.C. Unconfined Compressive Strength (tons/sq.ft.).
- R. Refusal
- T.O.R. Top of Rock (Indicates the beginning of rock-like resistance to the advancement of the augers. This may indicate the beginning of weathered bedrock, boulders or rock remnants. An exact determination cannot be made without performing rock coring.)
- B.C. Begin Rock Core.
- Rec. Core Recovery (%).
- R.Q.D. Rock Quality Designation (%).

NOTE: The boring logs and related information shown on this drawing depict approximate subsurface conditions only at the specific boring locations noted and at the time of drilling. Soil conditions at other locations may differ from conditions occurring at the boring locations. Also, the passage of time may result in a change in the soil at the boring locations. Any correlations shown between borings are generally based on straight line interpolation. Actual conditions between borings are unknown and may differ from those shown.

RECORD PRINTS
 THESE ARE RECORD PRINTS OF DRAWINGS BASED UPON MARKED UP PRINTS, DRAWINGS AND OTHER DATA FURNISHED BY THE CONTRACTOR TO THE ENGINEER AND WHICH THE ENGINEER CONSIDERS SIGNIFICANT

SOIL SUMMARY

SAMPLE NO.	Composite	
	3	2
STATION		
OFFSET		
DEPTH		
Composition of Total Sample		
GRAVEL (-3" + No. 4)	6	3
SAND (-No. 4 + No. 200)	16	9
SILT (-No. 200 + 0.005 mm)	21	56
CLAY (-0.005 mm)	57	32
LIQUID LIMIT	60	49
PLASTIC LIMIT	25	30
PLASTICITY INDEX	44	19
ACTIVITY INDEX	0.8	1.1
SPECIFIC GRAVITY	2.80	2.60
AASHTO CLASSIFICATION	A-7-0(36)	A-7-5(20)
UNIFIED CLASSIFICATION	CH	ML
CALIF. BEARING RATIO		
MAXIMUM DRY DENSITY (pcf)	98.0	
OPTIMUM MOISTURE (%)	24.0	

LOGS OF BORINGS

ROBOTICS FACILITY - UNIVERSITY OF KENTUCKY

FULLER, MOSSBARGER, SCOTT AND MAY CIVIL ENGINEERS, INC.
 1409 FORBES ROAD
 LEXINGTON, KENTUCKY 40505

STATE OF KENTUCKY REGISTERED PROFESSIONAL ENGINEER
 JEFFREY A. HAY 13486

DRAWN BY S.F.S. DATE Aug., 1987 REVISION SHEET
 CHECKED BY J.A.H. PROJECT NO. 87178
 CHECKED BY W.A.M. SCALE As Noted 2 of 5

LOGS OF BORINGS
 SCALE: 1"=5' (vert. only)

ROBOTICS FACILITY
 LEXINGTON CAMPUS
UNIVERSITY OF KENTUCKY
 LEXINGTON, KENTUCKY

University of Kentucky
 Lexington, Kentucky

Wendell S. Smith
 DIRECTOR - DESIGN AND CONSTRUCTION

10/14/87


Sherman Carter Barnhart
 PARTNERS IN ARCHITECTURE

SUITE 1800 • 250 WEST MAIN STREET • LEXINGTON, KY 40507 • 606/254-1851

JOB NO. 8706
 DATE
 DRAWN
 CHECKED CEB
 FILE NO. 431.0

REVISIONS

SHEET

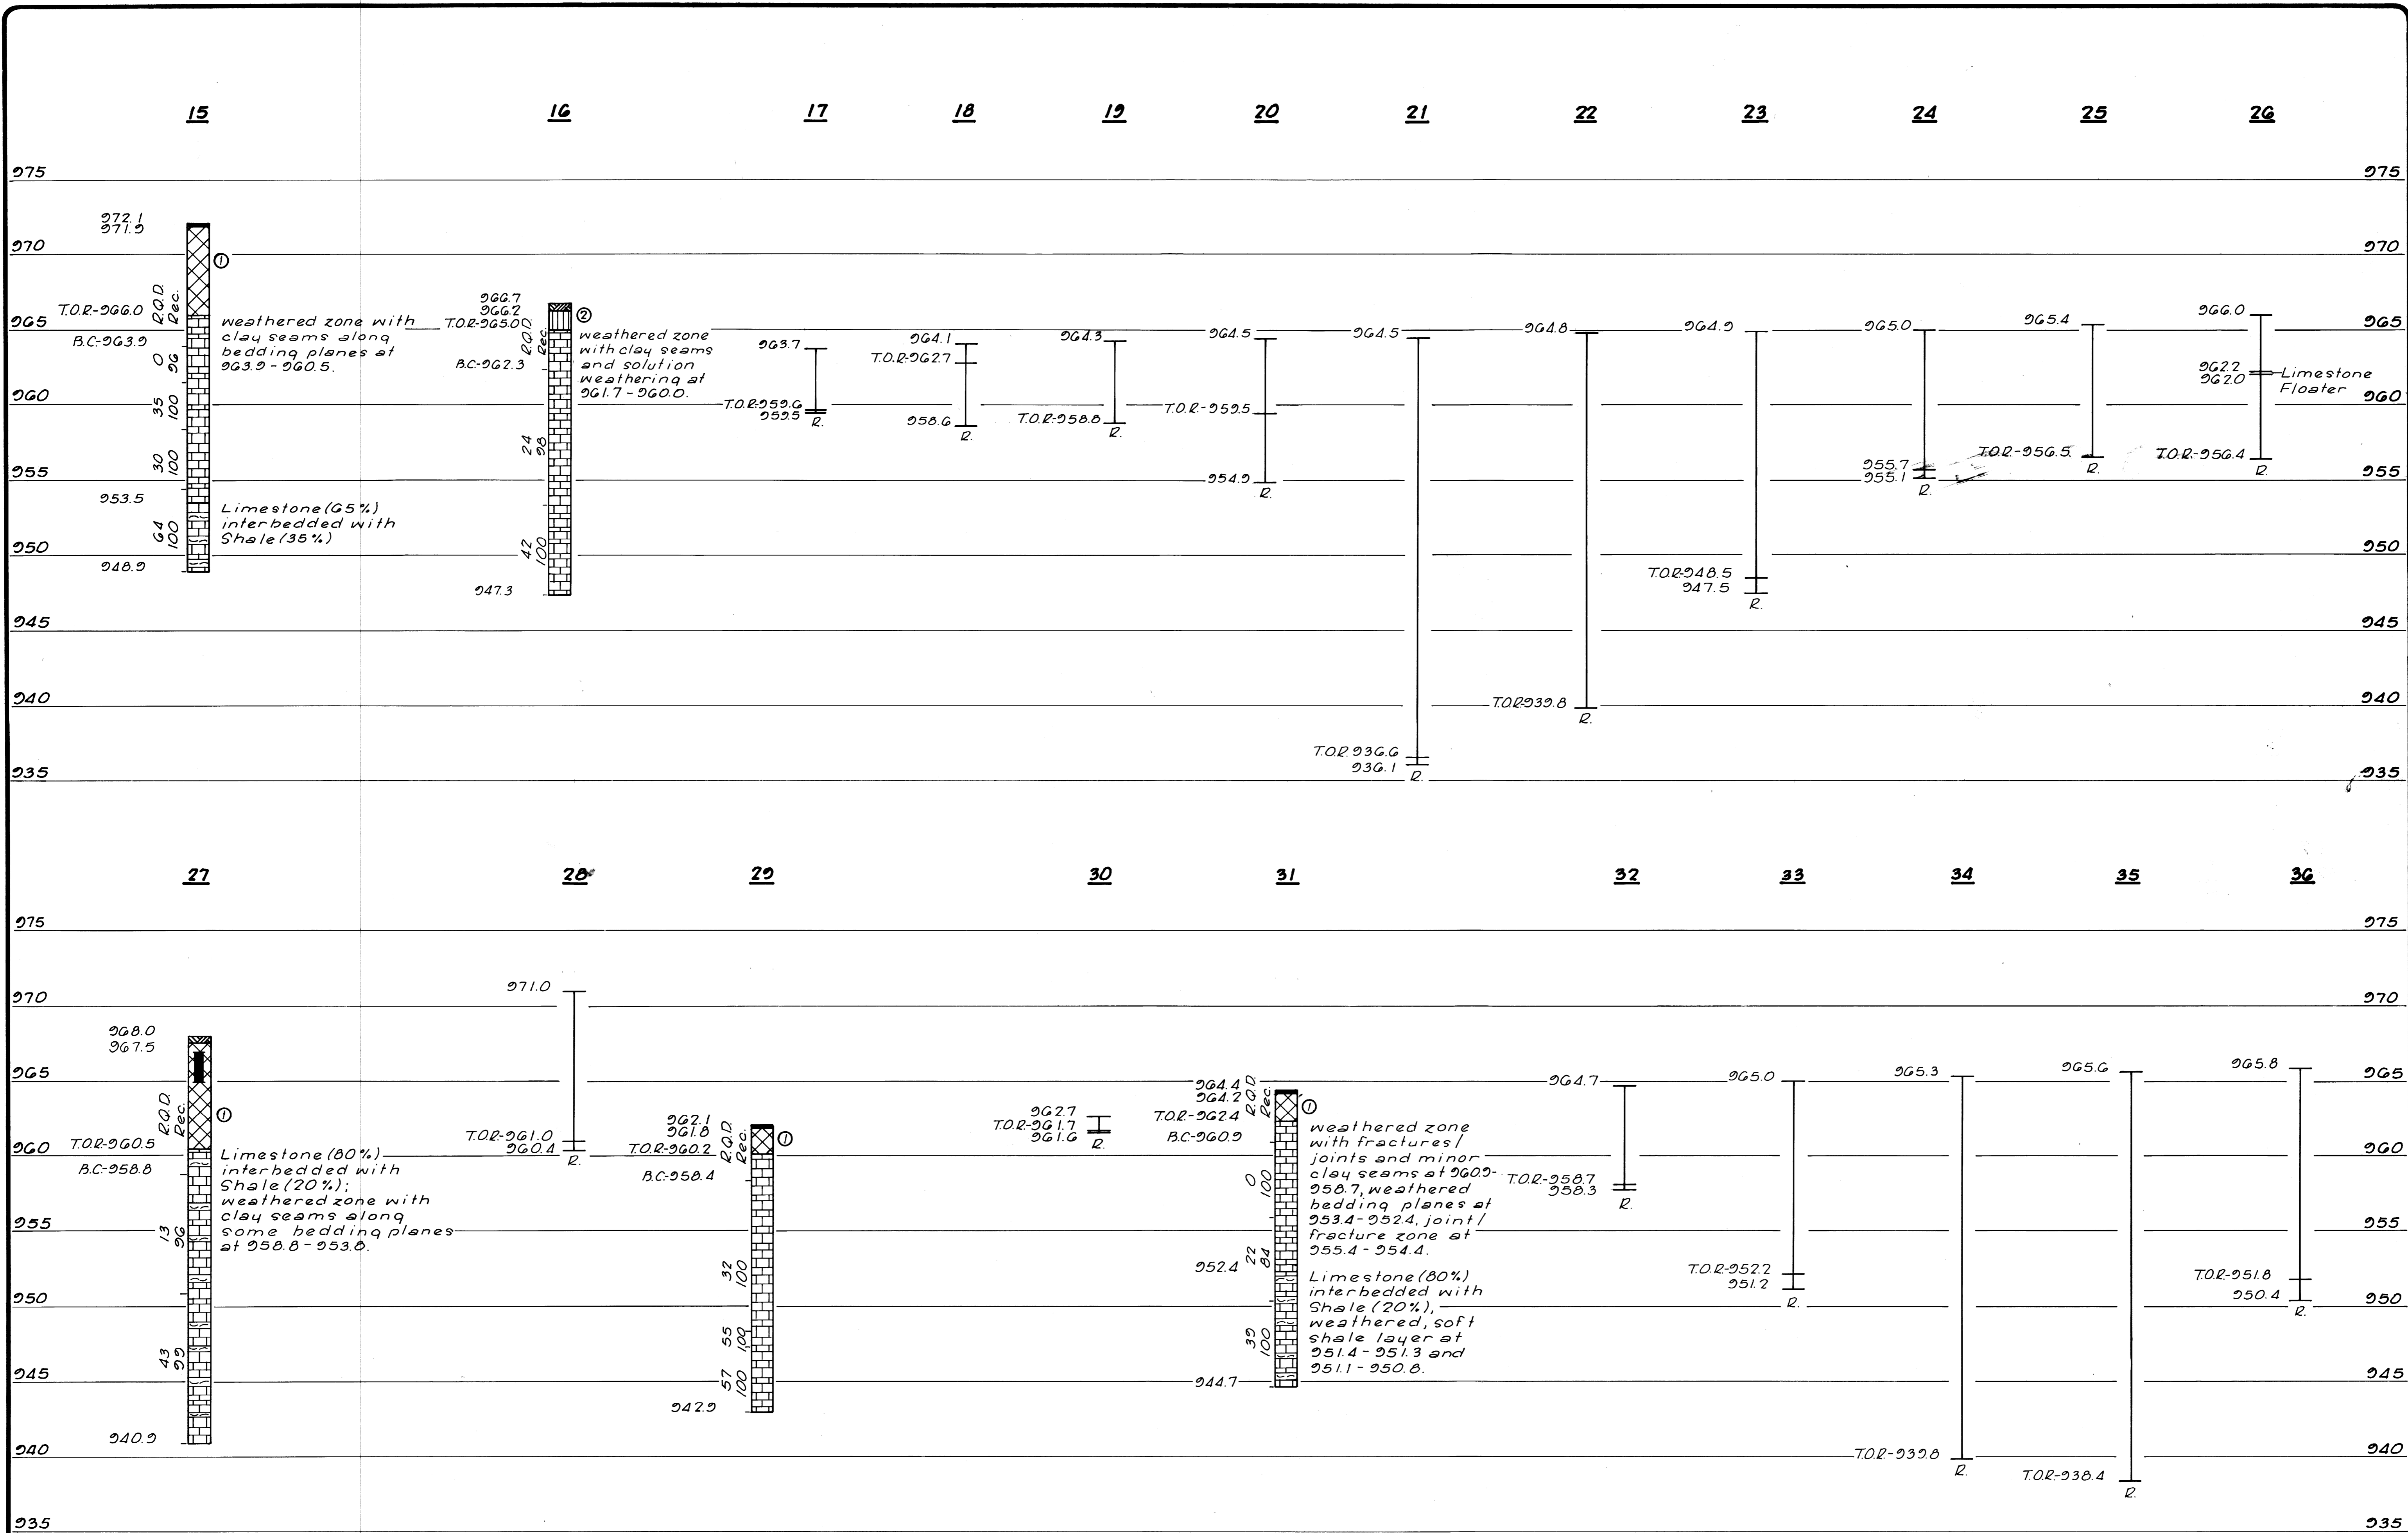

NOTE: The boring logs and related information shown on this drawing depict approximate subsurface conditions only at the specific boring locations noted and at the time of drilling. Soil conditions at other locations may differ from conditions occurring at the boring locations. Also, the passage of time may result in a change in the soil at the boring locations. Any correlations shown between borings are generally based on straight line interpolation. Actual conditions between borings are unknown and may differ from those shown.

LOGS OF BORINGS (CONT'D)

SCALE: 1"=5' (vert. only)

NOTE: See Sheet 2 of 5 for Legend and Soil Summary.

RECORD PRINTS

THESE ARE RECORD PRINTS OF DRAWINGS BASED UPON MARKED UP PRINTS, DRAWINGS AND OTHER DATA FURNISHED BY THE CONTRACTOR TO THE ENGINEER AND WHICH THE ENGINEER CONSIDERS SIGNIFICANT

LOGS OF BORINGS

ROBOTICS FACILITY - UNIVERSITY OF KENTUCKY

FULLER, MOSSBARGER, SCOTT AND MAY
CIVIL ENGINEERS, INC.
 1409 FORBES ROAD
 LEXINGTON, KENTUCKY 40505

DRAWN BY S.F.S.	DATE Aug, 1987	REVISION	SHEET
CHECKED BY J.A.H.	PROJECT NO. 87178		
CHECKED BY W.A.M.	SCALE 4s Noted		3 of 5

ROBOTICS FACILITY
 LEXINGTON CAMPUS
 UNIVERSITY OF KENTUCKY
 LEXINGTON, KENTUCKY

University of Kentucky
 Lexington, Kentucky


Sherman Carter Barnhart
 PARTNERS IN ARCHITECTURE
 SUITE 1900 • 250 WEST MAIN STREET • LEXINGTON, KY 40507 • 805-254-1351

JOB NO. 8706
 DATE
 DRAWN
 CHECKED CEB
 FILE NO. 431.0

REVISIONS

SHEET

C-10

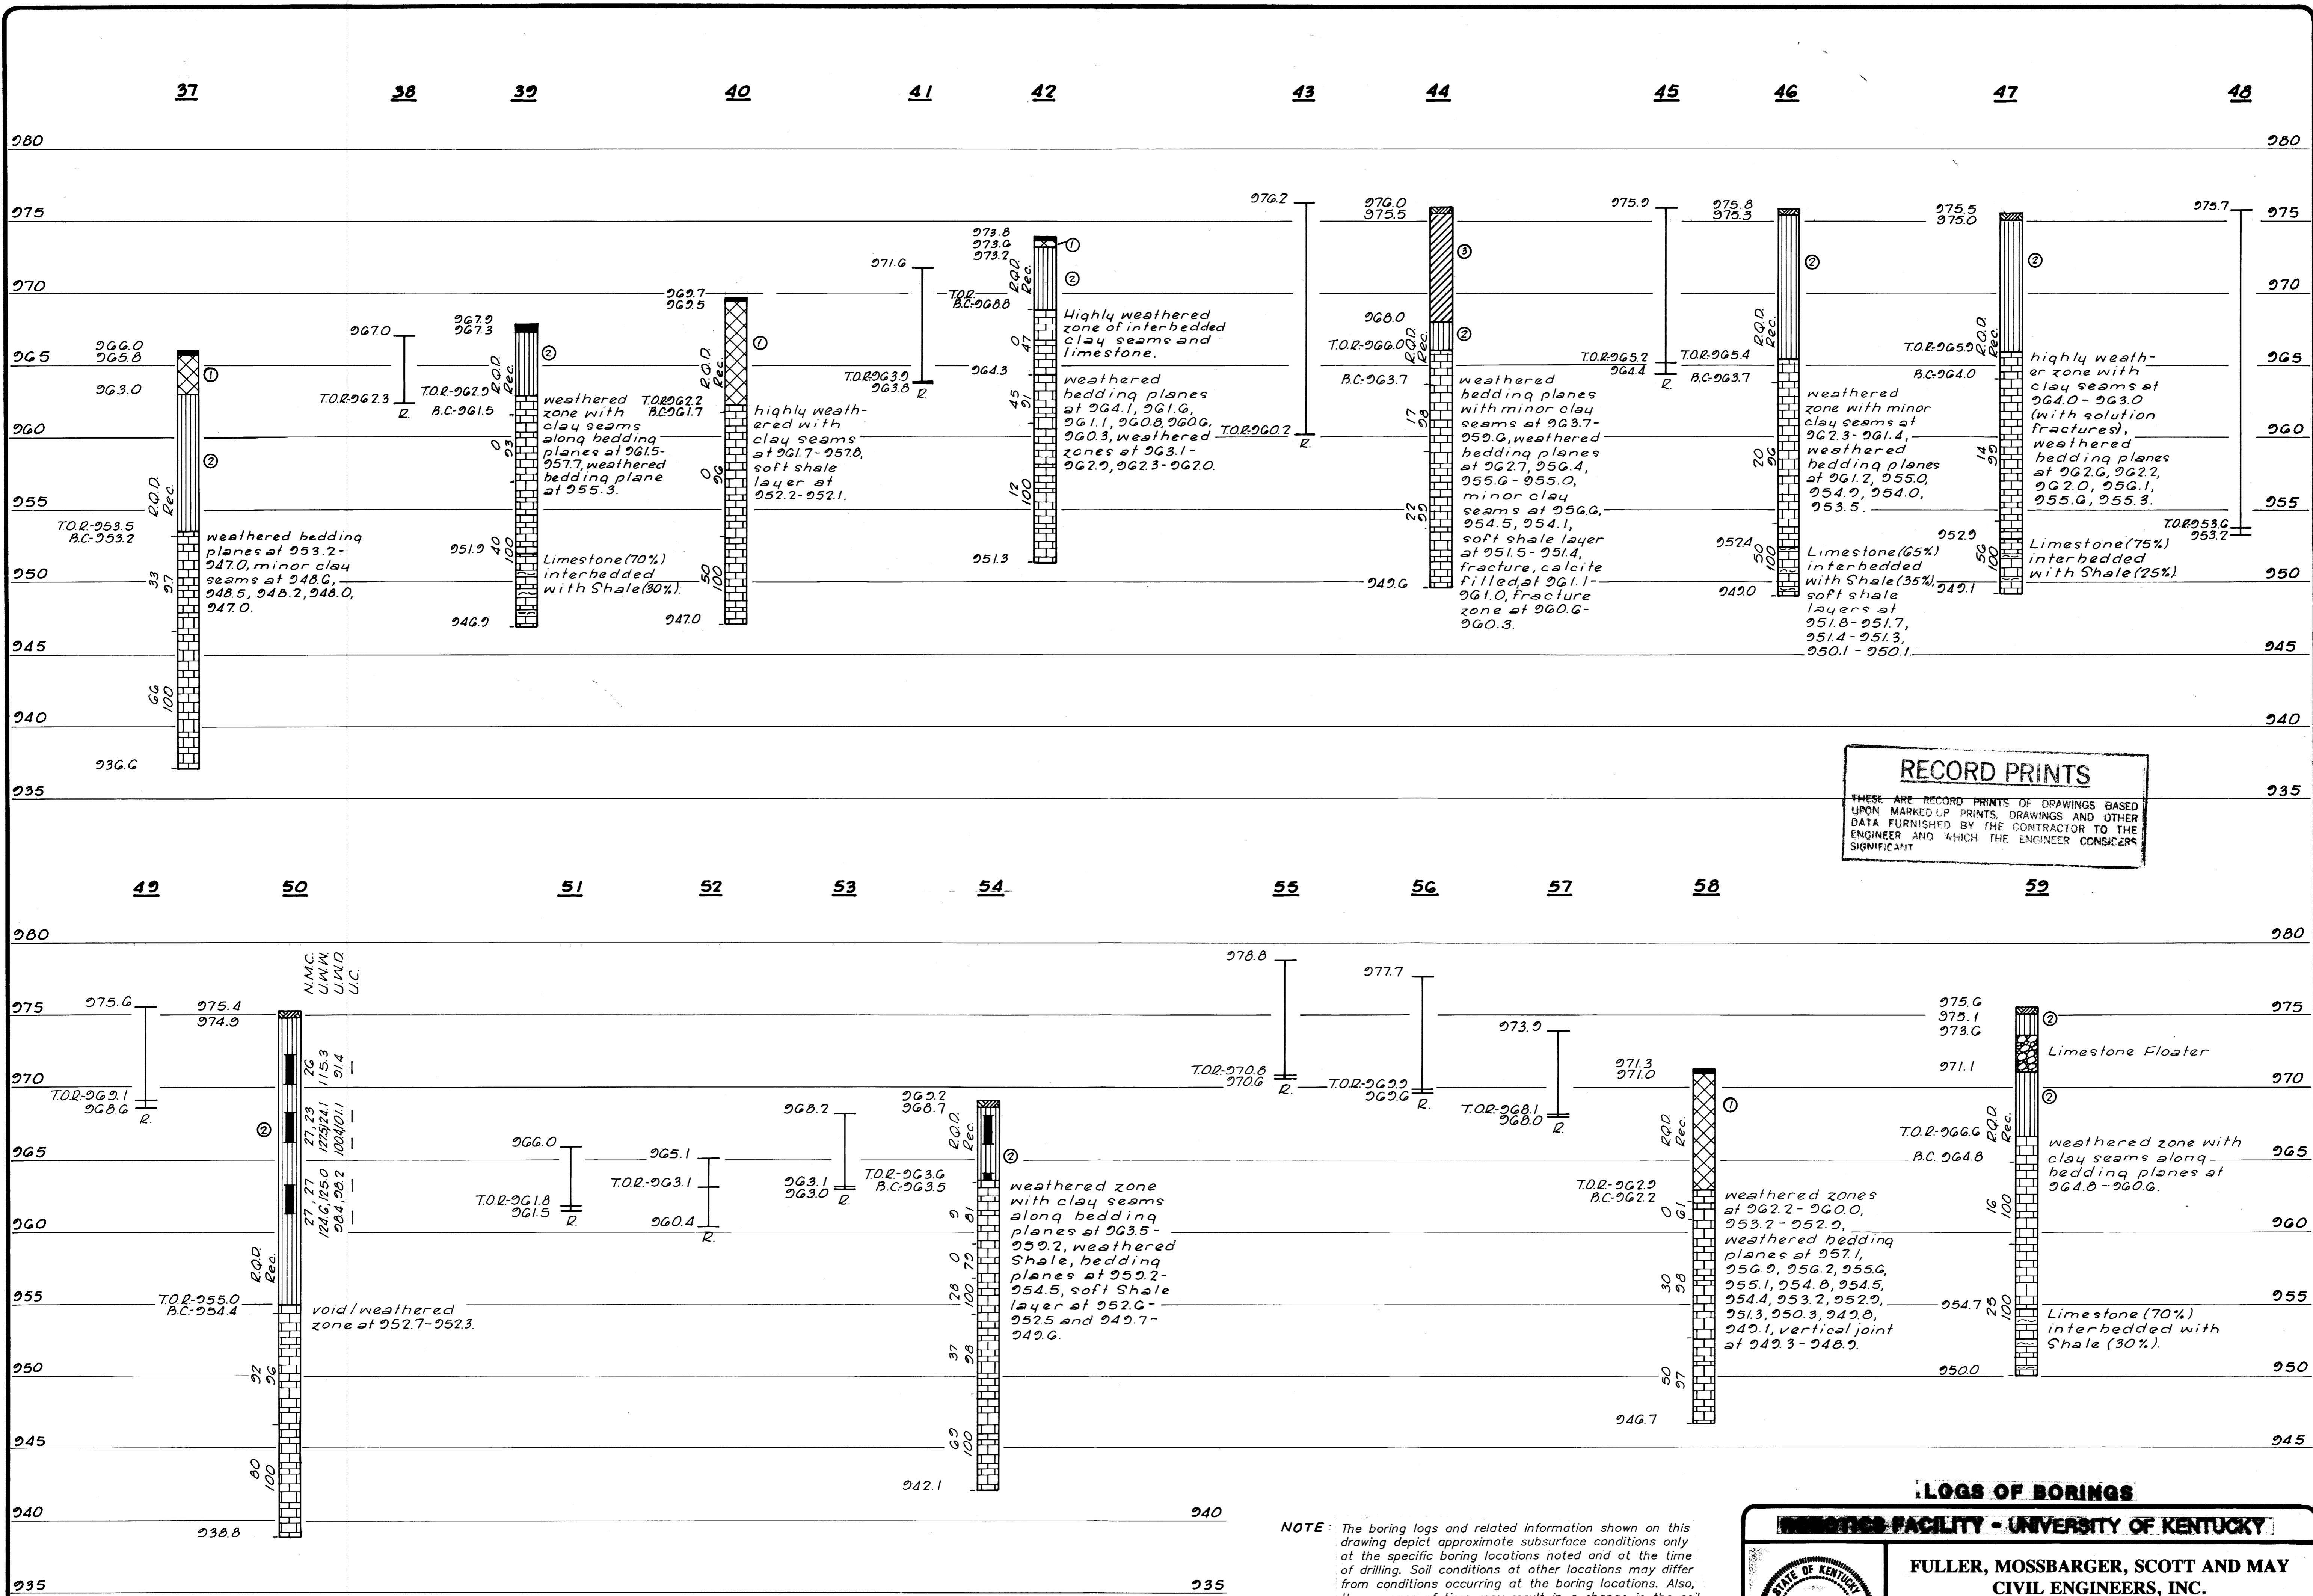

RECORD PRINTS
 THESE ARE RECORD PRINTS OF DRAWINGS BASED UPON MARKED UP PRINTS, DRAWINGS AND OTHER DATA FURNISHED BY THE CONTRACTOR TO THE ENGINEER AND WHICH THE ENGINEER CONSIDERS SIGNIFICANT

LOGS OF BORINGS (CONT'D)
 SCALE: 1"=5' (vert. only)
 NOTE: See Sheet 2 of 5 for Legend and Soil Summary.

NOTE: The boring logs and related information shown on this drawing depict approximate subsurface conditions only at the specific boring locations noted and at the time of drilling. Soil conditions at other locations may differ from conditions occurring at the boring locations. Also, the passage of time may result in a change in the soil at the boring locations. Any correlations shown between borings are generally based on straight line interpolation. Actual conditions between borings are unknown and may differ from those shown.

LOGS OF BORINGS
ROBOTICS FACILITY - UNIVERSITY OF KENTUCKY

JEFFREY A. HAY
 REGISTERED PROFESSIONAL ENGINEER
 STATE OF KENTUCKY
 13498

FULLER, MOSSBARGER, SCOTT AND MAY
 CIVIL ENGINEERS, INC.
 1409 FORBES ROAD
 LEXINGTON, KENTUCKY 40505

DRAWN BY S.F.S.	DATE Aug, 1987	REVISION	SHEET
CHECKED BY J.A.L.	PROJECT NO. 87178		4 of 5
CHECKED BY W.A.M.	SCALE As Noted		

ROBOTICS FACILITY
 LEXINGTON CAMPUS
 UNIVERSITY OF KENTUCKY
 LEXINGTON, KENTUCKY


University of Kentucky
 Lexington, Kentucky

Sherman Carter Barnhart
 PARTNERS IN ARCHITECTURE
 SUITE 1900 • 250 WEST MAIN STREET • LEXINGTON, KY 40507 • 800-254-1551

JOB NO. 8708
 DATE
 DRAWN
 CHECKED CEB
 FILE NO. 431.0

REVISIONS

SHEET
C-20

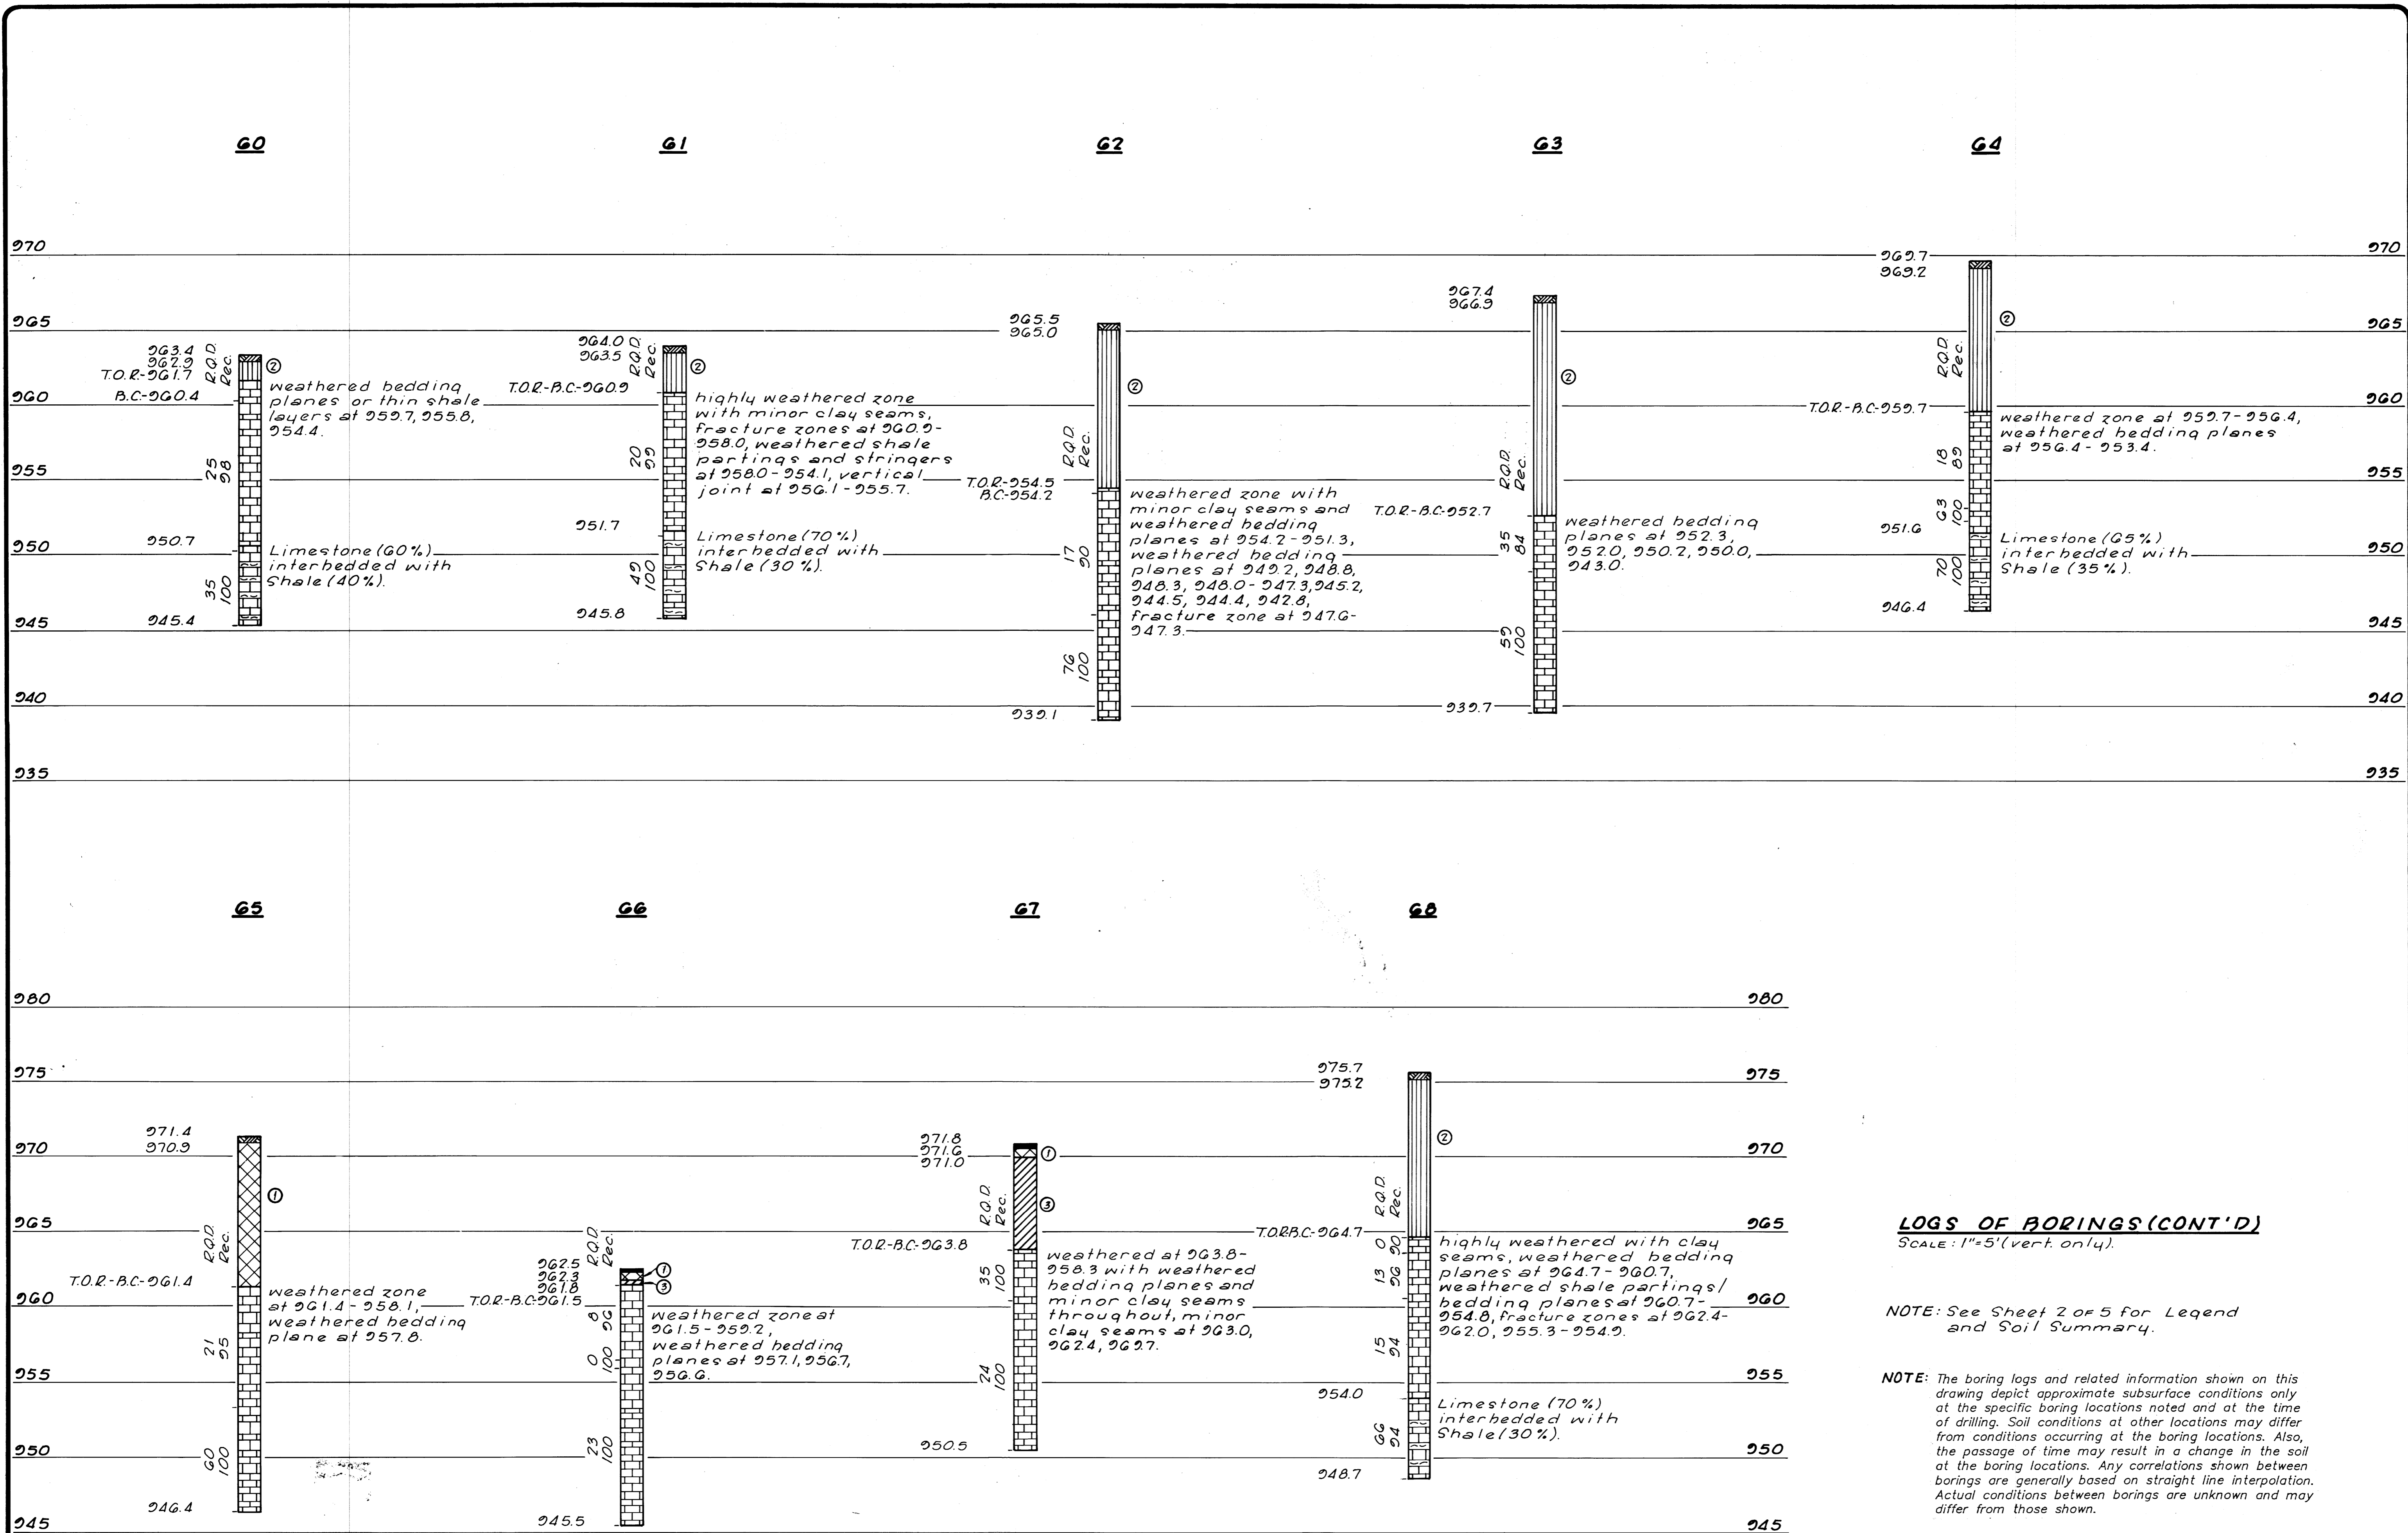

LOGS OF BORINGS (CONT'D)
 SCALE: 1"=5'(vert. only).


NOTE: See Sheet 2 of 5 for Legend and Soil Summary.

NOTE: The boring logs and related information shown on this drawing depict approximate subsurface conditions only at the specific boring locations noted and at the time of drilling. Soil conditions at other locations may differ from conditions occurring at the boring locations. Also, the passage of time may result in a change in the soil at the boring locations. Any correlations shown between borings are generally based on straight line interpolation. Actual conditions between borings are unknown and may differ from those shown.

LOGS OF BORINGS

ROBOTICS FACILITY - UNIVERSITY OF KENTUCKY

**FULLER, MOSSBARGER, SCOTT AND MAY
 CIVIL ENGINEERS, INC.**
 1409 FORBES ROAD
 LEXINGTON, KENTUCKY 40505

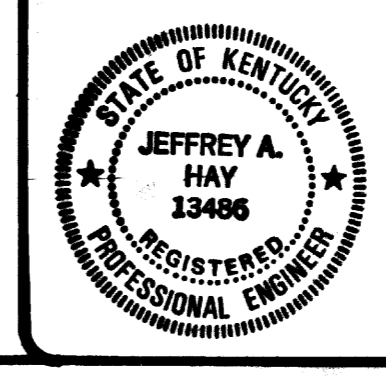

DRAWN BY S.F.S.	DATE Aug., 1987	REVISION	SHEET
CHECKED BY J.A.H.	PROJECT NO. 8717B		5 of 5
CHECKED BY W.A.M.	SCALE As Noted		

RECORD PRINTS
 THESE ARE RECORD PRINTS OF DRAWINGS MADE UPON MARKED UP PRINTS. DRAWINGS AND THEIR DATA FURNISHED BY THE CONTRACTOR TO THE ENGINEER AND WHICH THE ENGINEER HAS REVIEWED FOR SIGNIFICANT.

ROBOTICS FACILITY
 LEXINGTON CAMPUS
UNIVERSITY OF KENTUCKY
 LEXINGTON, KENTUCKY

University of Kentucky
 Lexington, Kentucky

Approved by: *Wendy Swann*
 Director, design and construction services


Sherman Carter Barnhart
 PARTNERS IN ARCHITECTURE
 SUITE 1900 • 250 WEST MAIN STREET • LEXINGTON, KY 40507 • 800-254-1951

JOB NO.	8708
DATE	
DRAWN	
CHECKED	CEB
FILE NO.	431.0

REVISIONS	

SHEET

C-21

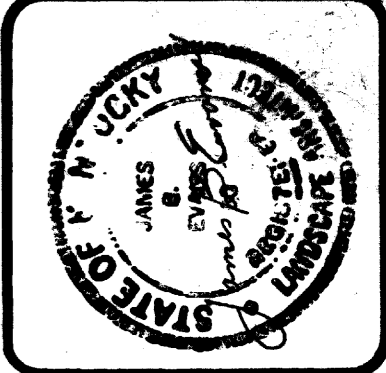

ROBOTICS FACILITY
 LEXINGTON CAMPUS
 UNIVERSITY OF KENTUCKY
 LEXINGTON, KENTUCKY

University of Kentucky
 Lexington, Kentucky
 10-19-87
 Approved by: *[Signature]*
 Director, Design and Construction Division


LANDSCAPE PLANTING PLAN
Sherman Carter Barnhart
 PARTNERS IN ARCHITECTURE
 LEXINGTON FINANCIAL CENTER - SUITE 1900 - 250 W. MAIN - LEXINGTON, KY 40507 - 606-254-1351

JOB NO.
 DATE **OCT. 1, 1987**
 DRAWN **REB**
 CHECKED **JOE**
 COPYRIGHT © 1987
 SHERMAN/CARTER/
 BARNHART


REVISIONS
 48 BUILT REVISIONS
 12 MARCH 1991 ELM

SHEET
 A-1

82
 A-1

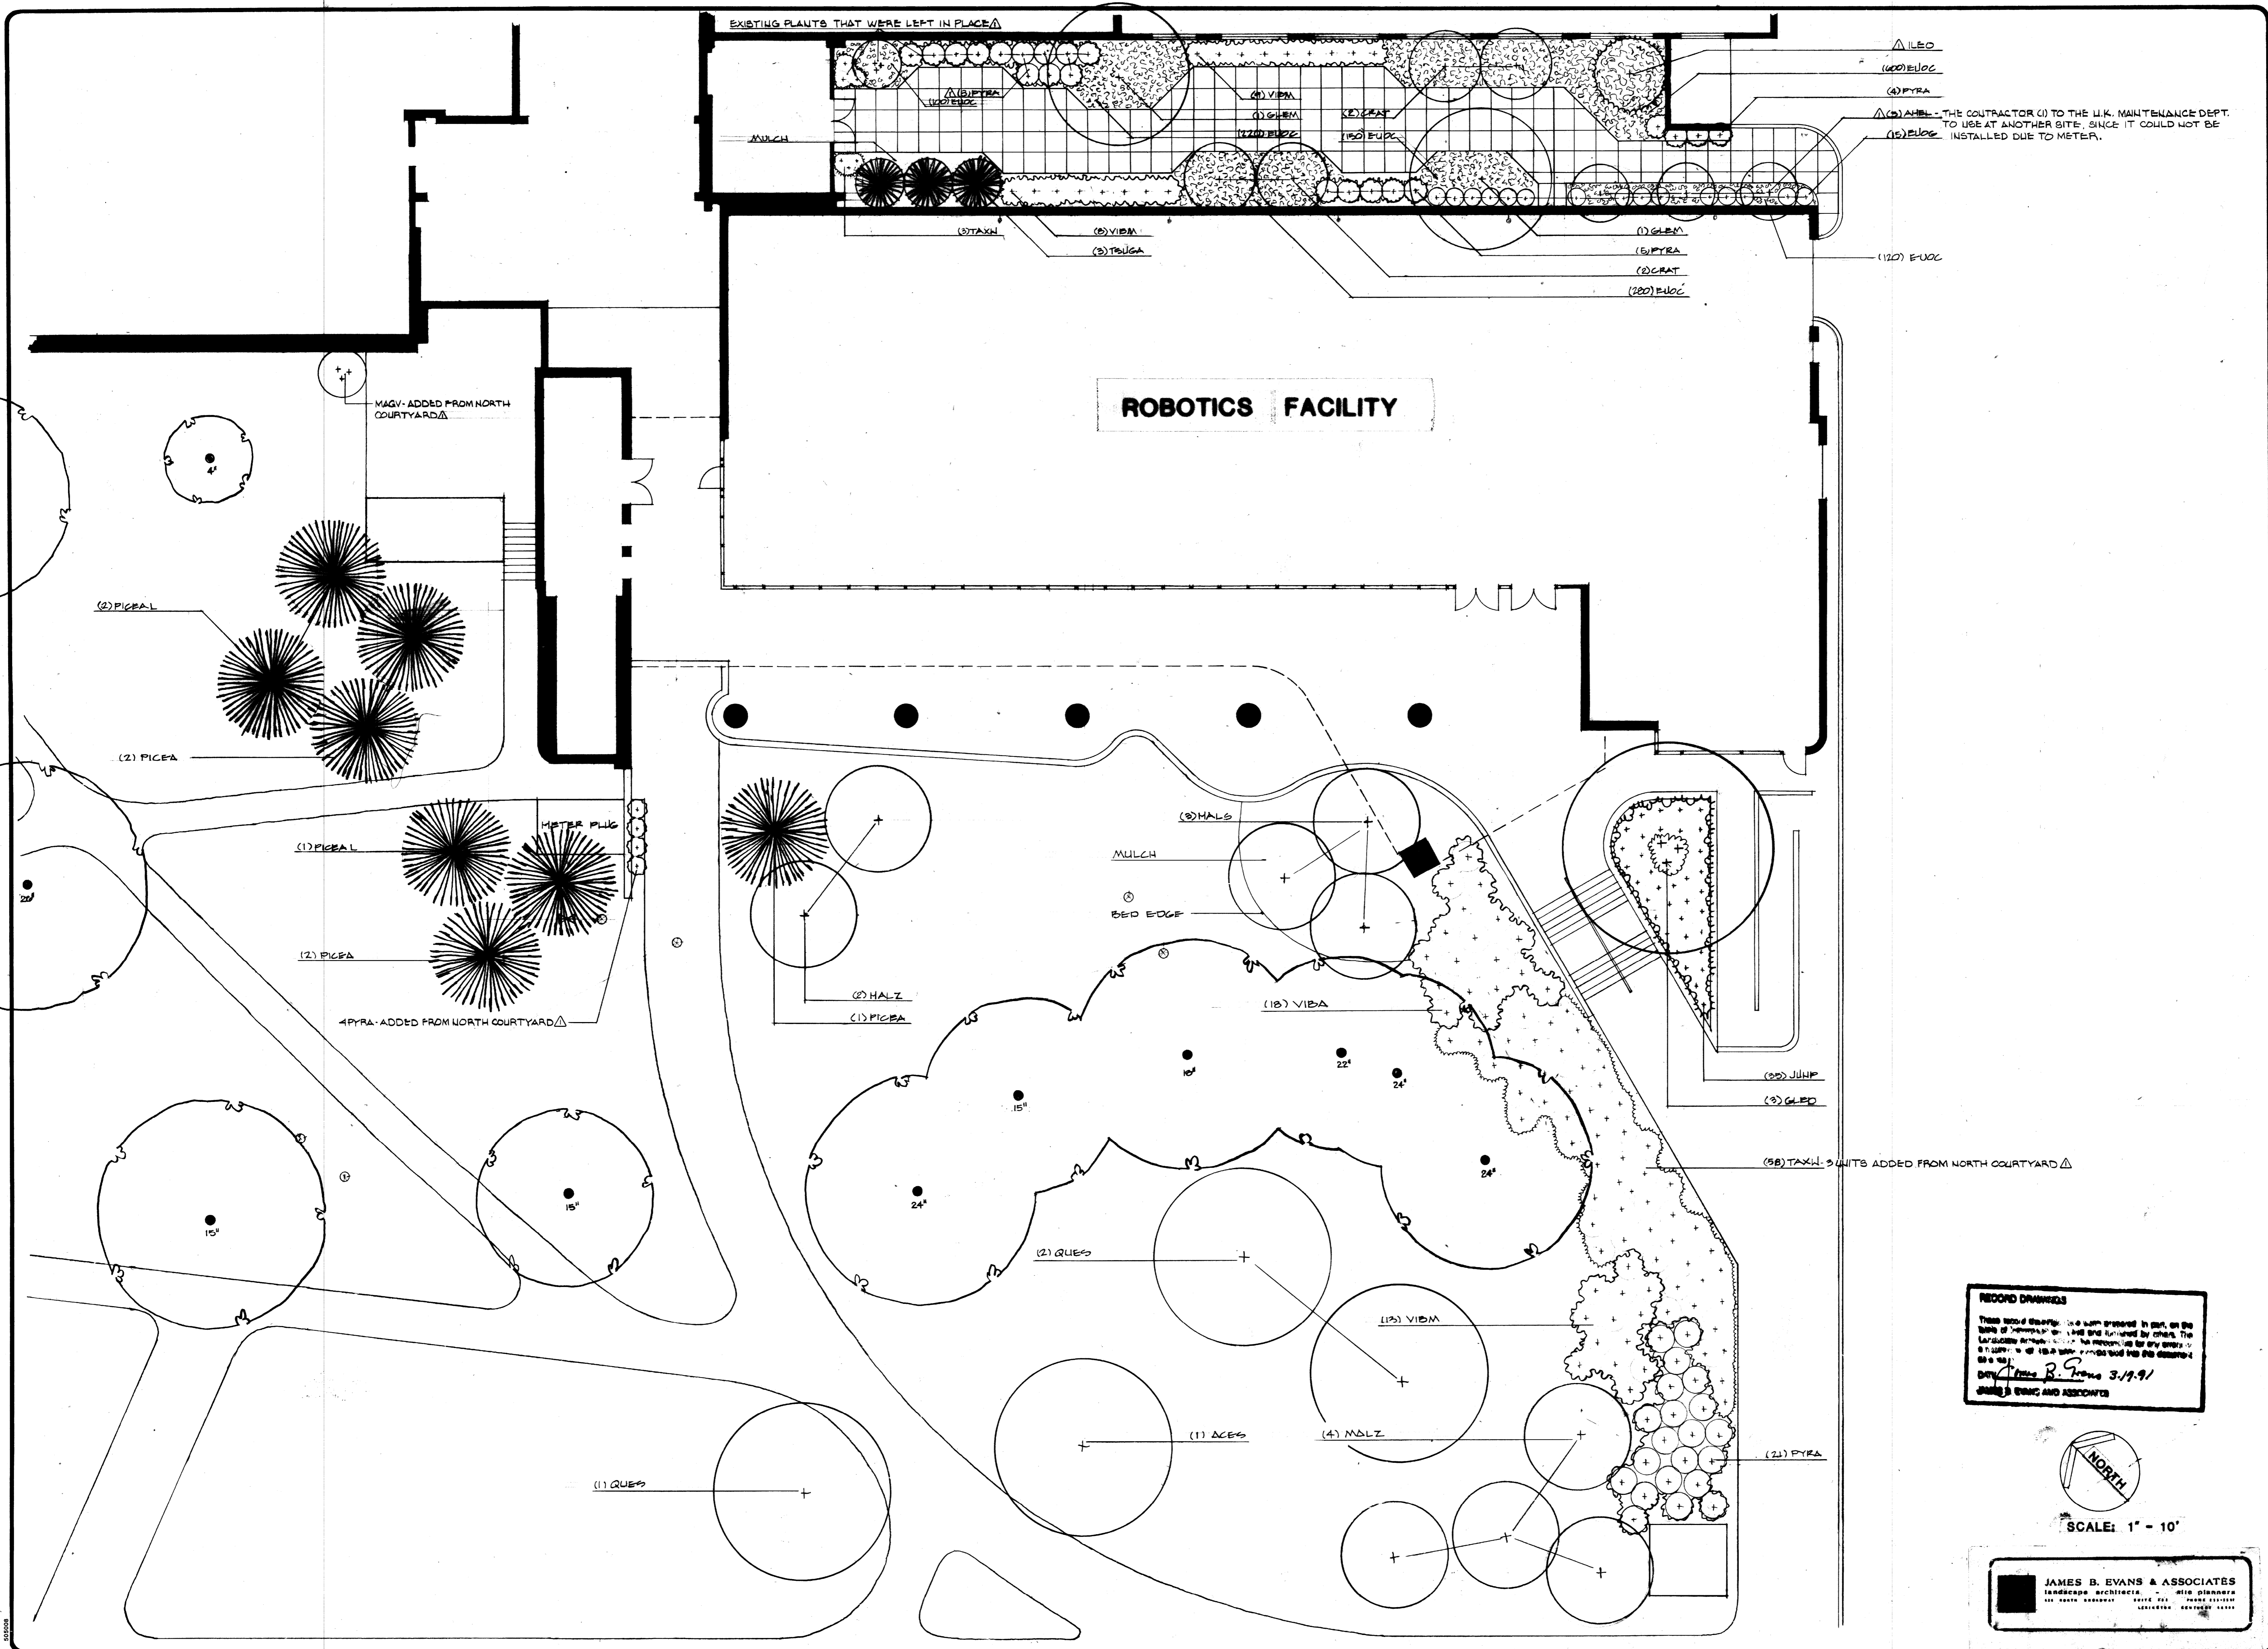

RECORD DRAWING
 These record drawings have been prepared in part, on the basis of information provided and furnished by others. The Landscape Architect assumes no responsibility for any errors or omissions in this plan, which are intended to be correct as shown.

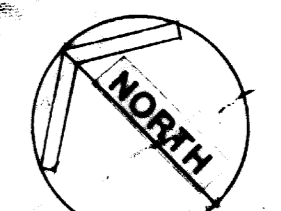


SCALE: 1" = 10'


JAMES B. EVANS & ASSOCIATES
 landscape architects site planners
 100 EAST LAMAR STREET, SUITE 200
 LEXINGTON, KENTUCKY 40502

PLANTING NOTES


- PLANTS LABELED NIC ARE NOT IN CONTRACT AND NOT A PART OF THIS PHASE OF WORK.
- THE CONTRACTOR SHALL SOD ANY AREAS DISTURBED BY CONSTRUCTION OPERATIONS. NO SEEDING SHALL BE PERFORMED ON THIS PROJECT. EXISTING SOD SHALL BE REMOVED FROM BENEATH ALL NEW SOD. NEW SOD SHALL BE "CUT-IN" TO THE EDGE OF EXISTING SOD SO BOTH SURFACES ARE AT THE SAME ELEVATION AND PRESENT A SMOOTH UNIFORM SURFACE.
- REQUIREMENTS FOR THE MEASUREMENT, BRANCHING, GRADING, QUALITY, BALLING AND BURLAPPING OF PLANTS IN THE PLANT LIST GENERALLY FOLLOWS OR EXCEEDS A CODE OF STANDARDS CURRENTLY RECOMMENDED BY THE AMERICAN ASSOCIATION OF NURSERMEN, INC. IN THE AMERICAN STANDARD FOR NURSERY STOCKS. SEE THE PLANT LIST FOR MORE RESTRICTIVE REQUIREMENTS.
- ALL PLANTS SHALL HAVE A WELL FORMED HEAD WITH MINIMUM CALIPER, HEIGHT AND SPREAD OF THE SIDE BRANCHES AS SHOWN ON THE PLANT LIST. TRUNKS SHALL BE UNDAUNAGED AND SHAPE SHALL BE TYPICAL OF THE SPECIES.
- MEASUREMENT OF CONIFER HEIGHT SHALL INCLUDE NOT MORE THAN FIFTY (50) PER CENT OF THIS YEARS VERTICAL GROWTH (TOP CANDLE).
- THE LANDSCAPE CONTRACTOR IS HEREBY NOTIFIED OF THE EXISTENCE OF UNDERGROUND UTILITIES WITHIN LIMITS OF THE PROJECT AREA. THE CONTRACTOR SHOULD VERIFY THE EXACT LOCATION OF ALL UTILITY LINES PRIOR TO COMMENCEMENT OF DIGGING OPERATIONS.
- THE LANDSCAPE CONTRACTOR WILL BE RESPONSIBLE FOR STAKING AND LAYOUT OF PLANTINGS ON THIS PROJECT. THE ARCHITECT OR OWNER SHALL BE ADVISED WHEN STAKES ARE READY FOR INSPECTION ON VARIOUS PLANTING AREAS. ALL LAYOUT WORK SHALL BE INSPECTED AND APPROVED BY THE ARCHITECT OR OWNER PRIOR TO OPENING ANY PLANTING PITS.
- IT IS THE RESPONSIBILITY OF THE LANDSCAPE CONTRACTOR TO VERIFY THAT EACH EXCAVATED TREE OR SHRUB PIT WILL PERCOLATE (DRAIN) PRIOR TO ADDING TOPSOIL AND INSTALLING TREES OR SHRUBS. THE CONTRACTOR SHALL FILL THE BOTTOM OF SELECTED HOLES WITH SIX (6) INCHES OF WATER. THIS WATER SHOULD PERCOLATE OUT WITHIN A TWENTY-FOUR (24) HOUR PERIOD. THE OWNER OR ARCHITECT SHALL VERIFY ACCURACY AND EFFECT OF PERCOLATION TESTING. IF THE SOIL AT A GIVEN AREA DOES NOT DRAIN PROPERLY, A P.V.C. DRAIN OR GRAVEL SUMP SHALL BE INSTALLED OR THE PLANTINGS RELOCATED.
- SHOULD THE LANDSCAPE CONTRACTOR ENCOUNTER UNSATISFACTORY SURFACE OR SUBSURFACE DRAINAGE CONDITIONS, SOIL DEPTH, LATENT SOILS, HARD PAN, STEAM OR OTHER UTILITY LINES OR OTHER CONDITIONS THAT WILL JEOPARDIZE THE HEALTH AND VIGOR OF THE PLANTS, HE MUST ADVISE THE ARCHITECT IN WRITING OF THE CONDITIONS PRIOR TO INSTALLING THE PLANTS. OTHERWISE THE LANDSCAPE CONTRACTOR WARRANTS THAT THE PLANTING AREAS ARE SUITABLE FOR PROPER GROWTH AND DEVELOPMENT OF THE PLANTS TO BE INSTALLED.
- PLANTING PITS FOR TREES AND SHRUBS SHALL BE DUG A FULL TWELVE (12) INCHES WIDER THAN THE BALL AROUND THE ENTIRE PLANT AND SIX (6) INCHES DEEPER THAN THE BALL. NEW TOPSOIL AS SHALL BE FURNISHED BY THE CONTRACTOR SHALL BE MIXED WITH PEAT MOSS AT A RATE OF 5:1 VOLUME FOR BACKFILL. ANY HEAVY CLAY OR OTHER SOIL UNSUITABLE FOR PLANTING ENCOUNTERED IN THE BOTTOM OF THE HOLES SHALL BE REMOVED FROM THE SITE. IF THE CONTRACTOR ENCOUNTERS SOILS THAT ARE SUITABLE FOR BACKFILL, HE SHALL ADVISE THE ARCHITECT PRIOR TO BACKFILLING. A WRITTEN CHANGE ORDER WITH A CREDIT TO THE OWNER MAY BE PREPARED TO ALLOW THE CONTRACTOR TO USE EXISTING SOILS AS BACKFILL.
- BARK MULCH SHALL BE APPLIED TO ALL SHRUB BEDS BY THE CONTRACTOR. BEDS SHALL BE TREATED WITH PREEMERGENT HERBICIDE BY THE CONTRACTOR BEFORE MULCH IS APPLIED. BARK MULCH SHALL BE ONE AND ONE-HALF INCHES DEEP. A SAMPLE OF MULCH SHALL BE PRESENTED TO THE LANDSCAPE ARCHITECT FOR APPROVAL.
- ALL TREES ARE TO BE STAKED AND WRAPPED IMMEDIATELY AFTER PLANTING AS DETAILED.
- THE CONTRACTOR SHALL BE RESPONSIBLE FOR ALL REQUIRED MAINTENANCE UNTIL ALL PLANTINGS ARE FORMALLY ACCEPTED. ALL PLANTS SHALL BE WATERED AT TIME OF INSTALLATION AND AS OFTEN THEREAFTER AS NECESSARY TO MAINTAIN THEM IN A HEALTHY VIGOROUS CONDITION.
- THE OWNER SHALL BE RESPONSIBLE FOR LANDSCAPE MAINTENANCE AFTER THE PLANTINGS ARE FORMALLY ACCEPTED DURING THE ONE (1) YEAR GUARANTEE PERIOD.
- THE LANDSCAPE CONTRACTOR SHALL BE RESPONSIBLE FOR CLEANING UP THE SITE AT THE COMPLETION OF THE PROJECT AND SHALL MAINTAIN THE SITE IN A REASONABLY NEAT AND CLEAN STATE THROUGHOUT THE INSTALLATION PROCESS. STREETS AND PAVED AREAS SHALL BE CLEANED REGULARLY TO REMOVE CONSTRUCTION MATERIALS AND OTHER DEBRIS RESULTING FROM WORK OF THIS PROJECT.
- PLANTS SHALL BE GUARANTEED FOR THE DURATION OF ONE (1) FULL YEAR AFTER THE FORMAL ACCEPTANCE OF THE PLANTING BY THE OWNER AND SHALL BE ALIVE AND IN SATISFACTORY GROWTH AT THE END OF THE GUARANTEE PERIOD. ANY PLANT NOT IN A HEALTHY AND VIGOROUS STATE AT THE END OF THE GUARANTEE PERIOD SHALL BE REPLACED AT NO COST TO THE OWNER. PLANTS SEVERELY DAMAGED BY VANDALS ARE NOT SUBJECT TO REPLACEMENT BY THIS CONTRACTOR.
- REPLACEMENTS OF DEAD OR UNSATISFACTORY MATERIAL SHALL BE MADE AS SPECIFIED IN THE PLANT LIST. THE OWNER OR LANDSCAPE ARCHITECT SHALL INSPECT REPLACED PLANTS WHEN ALL REPLACEMENTS HAVE BEEN MADE. REPLACEMENTS ARE TO BE ALIVE AND IN A HEALTHY CONDITION WHEN THE REPLACEMENTS ARE COMPLETE BUT THEY SHALL NOT BE SUBJECT TO A ONE (1) YEAR GUARANTEE.
- SHOULD THE CONTRACTOR NOT MAKE REPLACEMENTS IN A SATISFACTORY AND TIMELY FASHION IN ACCORD WITH THE PLANTING NOTES, THE OWNER, AFTER PROPER NOTIFICATION TO THE CONTRACTOR, MAY UTILIZE THE FUNDS OF THE RETAINAGE TO HAVE THE REPLACEMENTS MADE IN ACCORD WITH THE SPECIFICATIONS BY ANOTHER CONTRACTOR.
- NO EXCAVATION OR PLANTING PIT SHALL BE LEFT UNATTENDED OR OPEN OVERNIGHT.

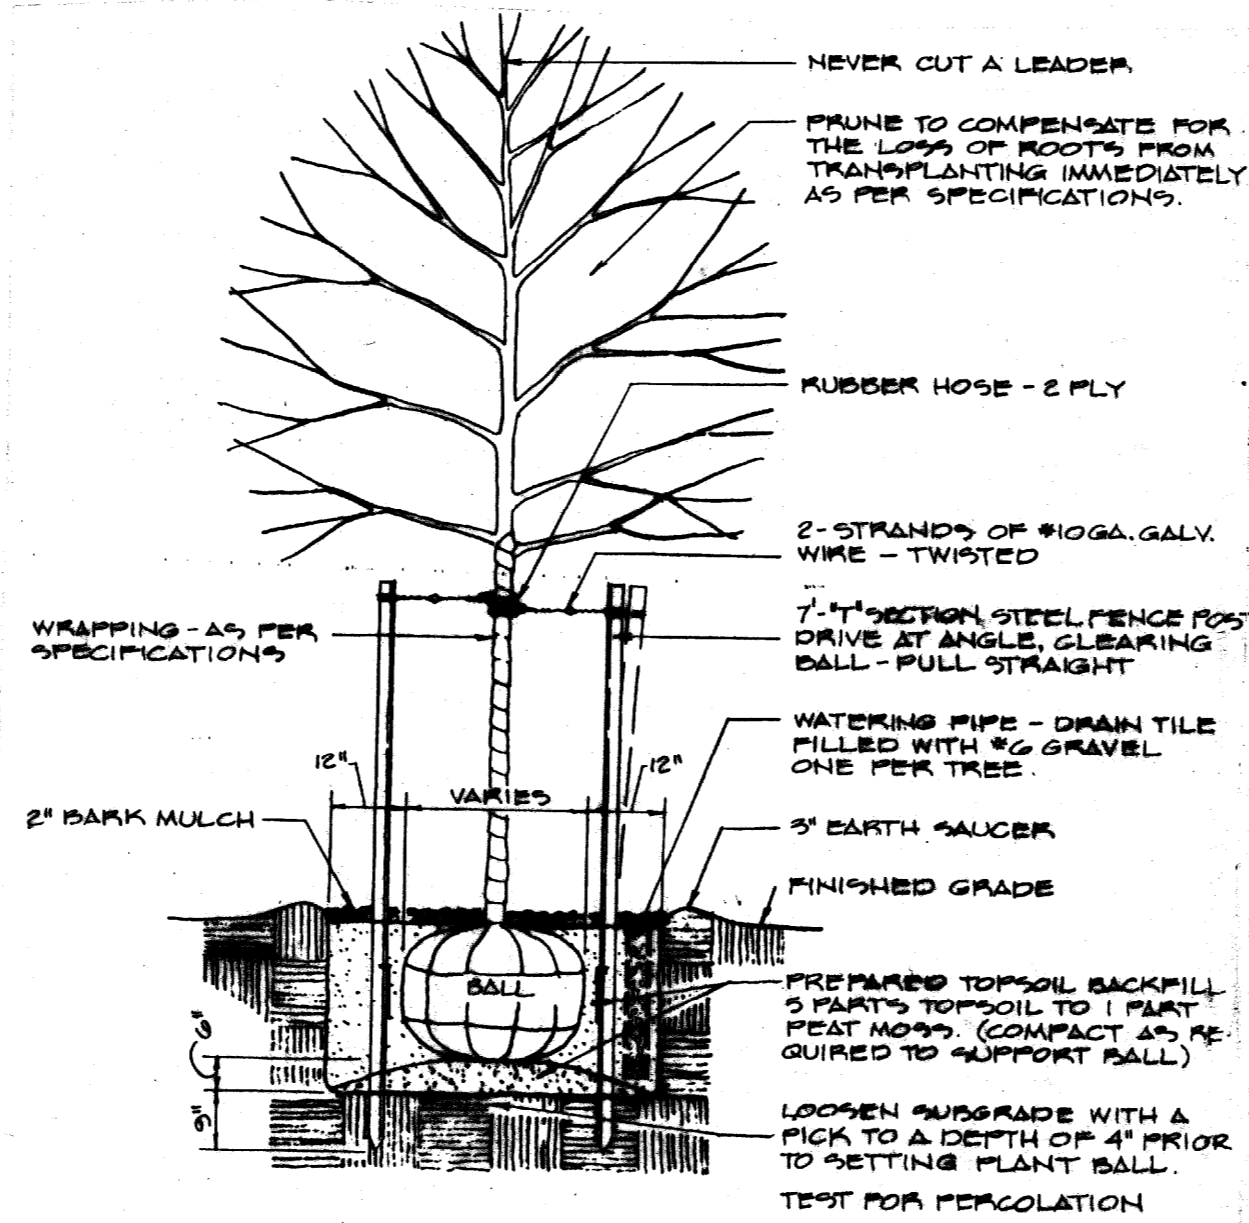


A PLANTING & DOUBLE STAKING DETAIL
SCALE: 3/8" = 1'-0"

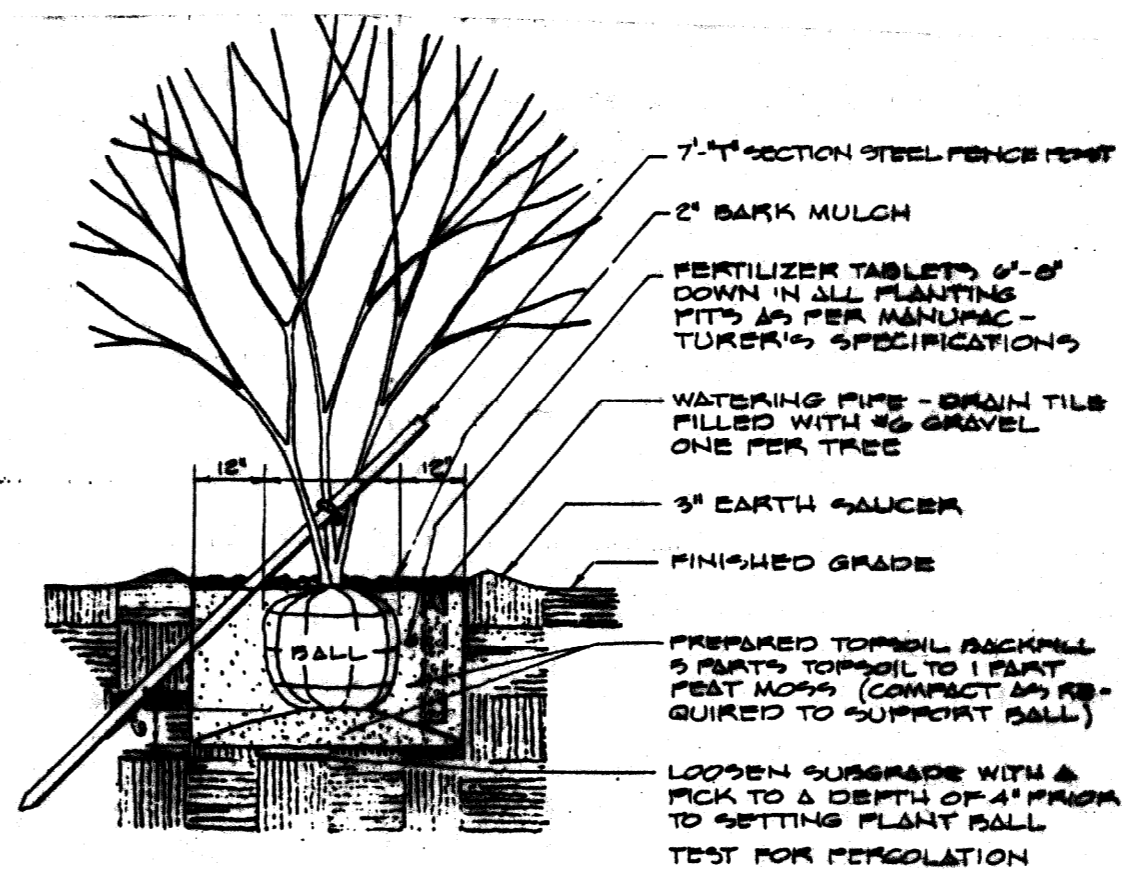


B PLANTING AND SINGLE STAKING SECTION
SCALE: 3/8" = 1'-0"

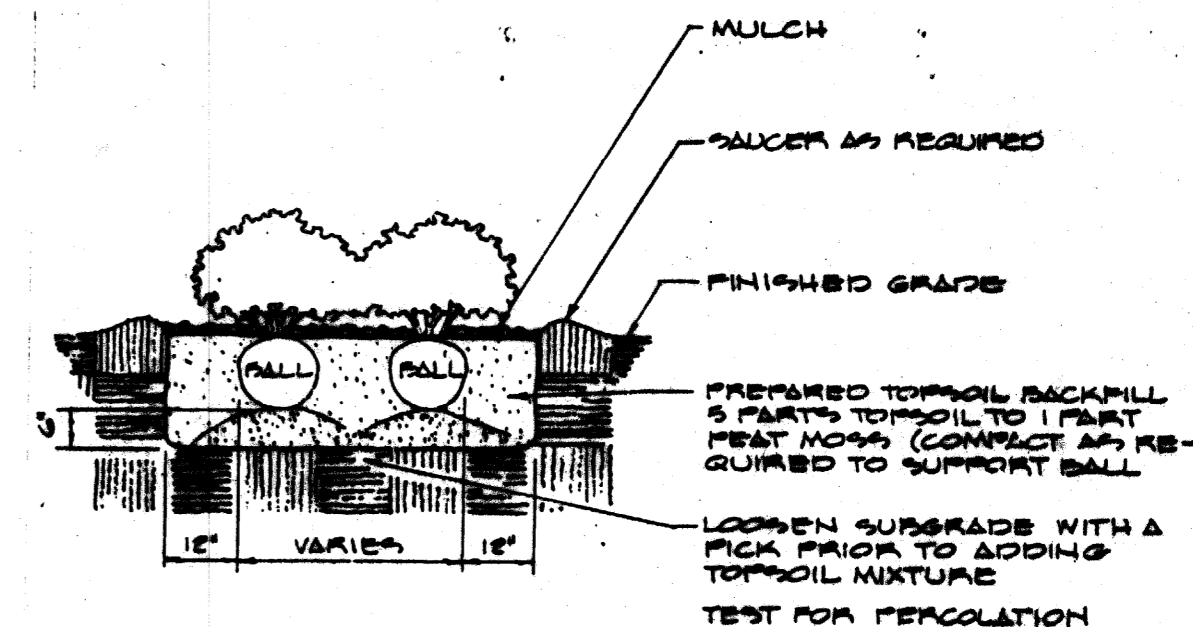

C SHRUB PLANTING SECTION
SCALE: 3/8" = 1'-0"

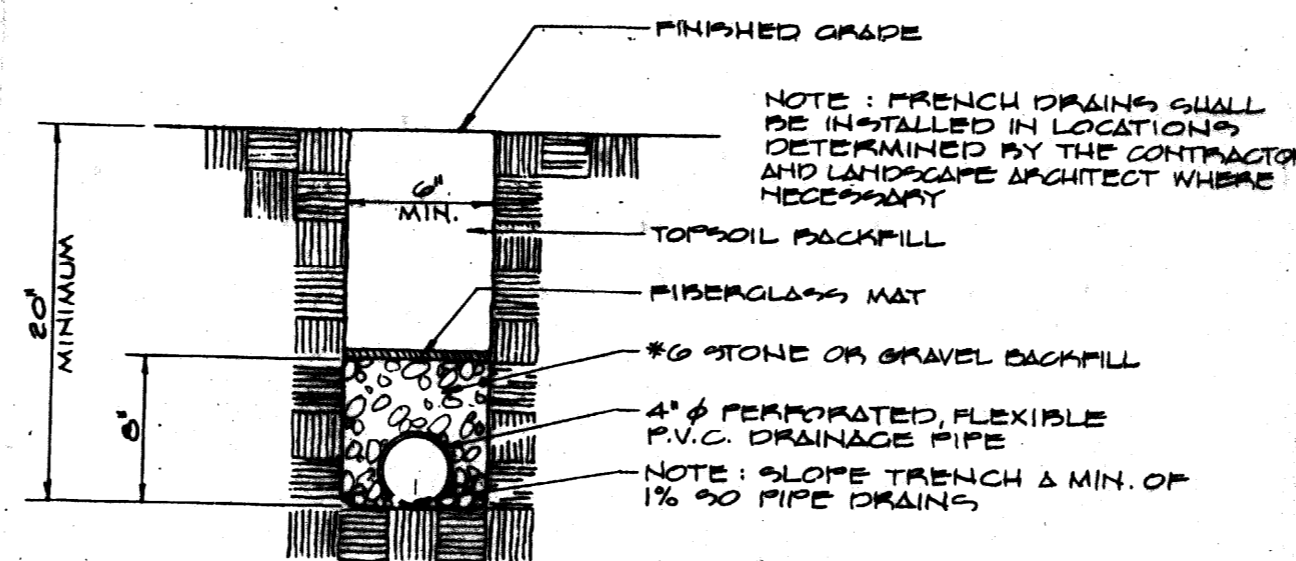

D FRENCH DRAIN DETAIL (10\"/>

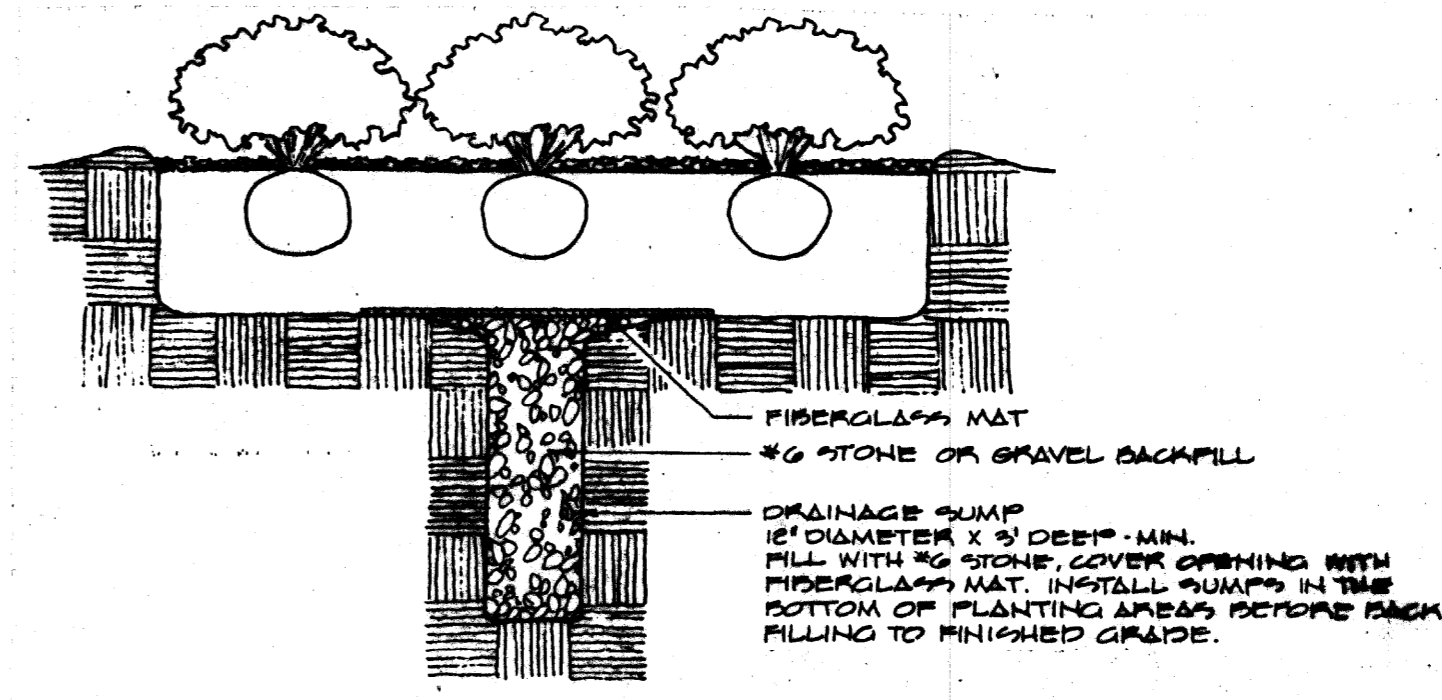

E DRAINAGE SUMP DETAIL (20\"/>

PLANT LIST

ABBREV.	BOTANICAL NAME	COMMON NAME	MINIMUM					COMMENTS
			CALIPER	SPREAD	HEIGHT	BALL DIA.	NO. CANE	
Aces	Acer saccharum 'Green Mountain'	Green Mountain Sugar Maple	3"	5'	14-16'	32"	1	
Gled	Gleditsia tri. in. 'Moraine'	Moraine Honeylocust	2"	4'	12-14'	24"	1	
Glem	Gleditsia tri. in. 'Moraine'	Moraine Honeylocust	3 1/2"	6'	14-16'	34"	1	
Ques	Quercus shumardii	Shumard Oak	3"	5'	12-14'	32"	1	
Crat	Crataegus phaenopyrum	Washington Hawthorn	1 1/2" / cane	4'	7-8'	28"	3-4	
FLER	FLER OPAGA	AMERICAN HOLLY						Branched to Ground
Magv	Magnolia virginiana	Sweetbay Magnolia	1 1/2" / cane	4'	7-8'	28"	3-5	
Malz	Malus sargentii	Sargent's Crabapple	2 1/2"	4'	5'	28"	1	
Malz	Malus zumi 'Calocarpa'	Zumi Crabapple	2 1/2"	4'	6'	28"	1	
AMEL	Amelanchier laevis	Allegheny Serviceberry	1 1/2" / cane		6-9'	26"	3-5	
Picea	Picea abies	Norway Spruce	4"	4'	7-8'	24"	1	Medium Shear
Picea L	Picea canadensis	Norway Spruce	5"	5'	8-10'	27"	1	Medium Shear
Tsuga	Tsuga canadensis	Canadian Hemlock	4"	4'	7-8'	24"	1	Medium Shear
Euog	Euonymus fortunei 'Green Lane'	Green Lane Euonymus		15-18"	18"	9"	7-10	
Junp	Juniperus chinensis var. sargentii	Sargent's Juniper (Green)		18"		3 gal.	7-10	
Pyra	Pyracantha coccinea 'Kasan'	Kasan Firethorn		24-30"		7 gal.	7-10	
Taxu	Taxus x media 'wardii'	Wards Yew		21"	15"	10"	5-7	Medium Shear
Viba	Viburnum x rhytidophylloides 'Allegheny'	Allegheny Viburnum		24"	36"	12"	7-10	
Vibm	Viburnum plicatum tomentosum 'Mariesii'	Marie's Viburnum		24"	36"	12"	7-10	
Euoc	Euonymus fortunei var 'Coloratus'	Coloratus Wintercreeper				2" pots	3-4 runners	4-6" long

RECORD DRAWING
These record drawings have been prepared to comply with the terms of the contract and shall be maintained by the owner. The contractor shall be responsible for the accuracy of the information shown on these drawings and shall be held responsible for any errors or omissions. The contractor shall be held responsible for any damage to the drawings caused by the contractor or its subcontractors. The contractor shall be held responsible for any damage to the drawings caused by the contractor or its subcontractors. The contractor shall be held responsible for any damage to the drawings caused by the contractor or its subcontractors.

JAMES B. EVANS & ASSOCIATES
landscape architects - site planners
111 SOUTH MAIN STREET, SUITE 200, LEXINGTON, KY 40507
PHONE: 254-1234 FAX: 254-5678



ROBOTICS FACILITY
LEXINGTON CAMPUS
UNIVERSITY OF KENTUCKY
LEXINGTON, KENTUCKY

University of Kentucky
Lexington, Kentucky
10-19-97
design and construction division


PLANTING DETAILS
Sherman Carter Barnhart
PARTNERS IN ARCHITECTURE
LEXINGTON FINANCIAL CENTER • SUITE 1900 • 250 W. MAIN • LEXINGTON, KY 40507 • 606-254-1351

JOB NO.
DATE **OCT. 1, 1997**
DRAWN **EKS**
CHECKED **JBE**
DATE **NOV 18, 1997**
COPYRIGHT ©
SHERMAN CARTER/
BARNHART

REVISIONS
AS BUILT REVISIONS
18 MARCH 1991 ELM

Document #
004857

SHEET
L-2
A-1

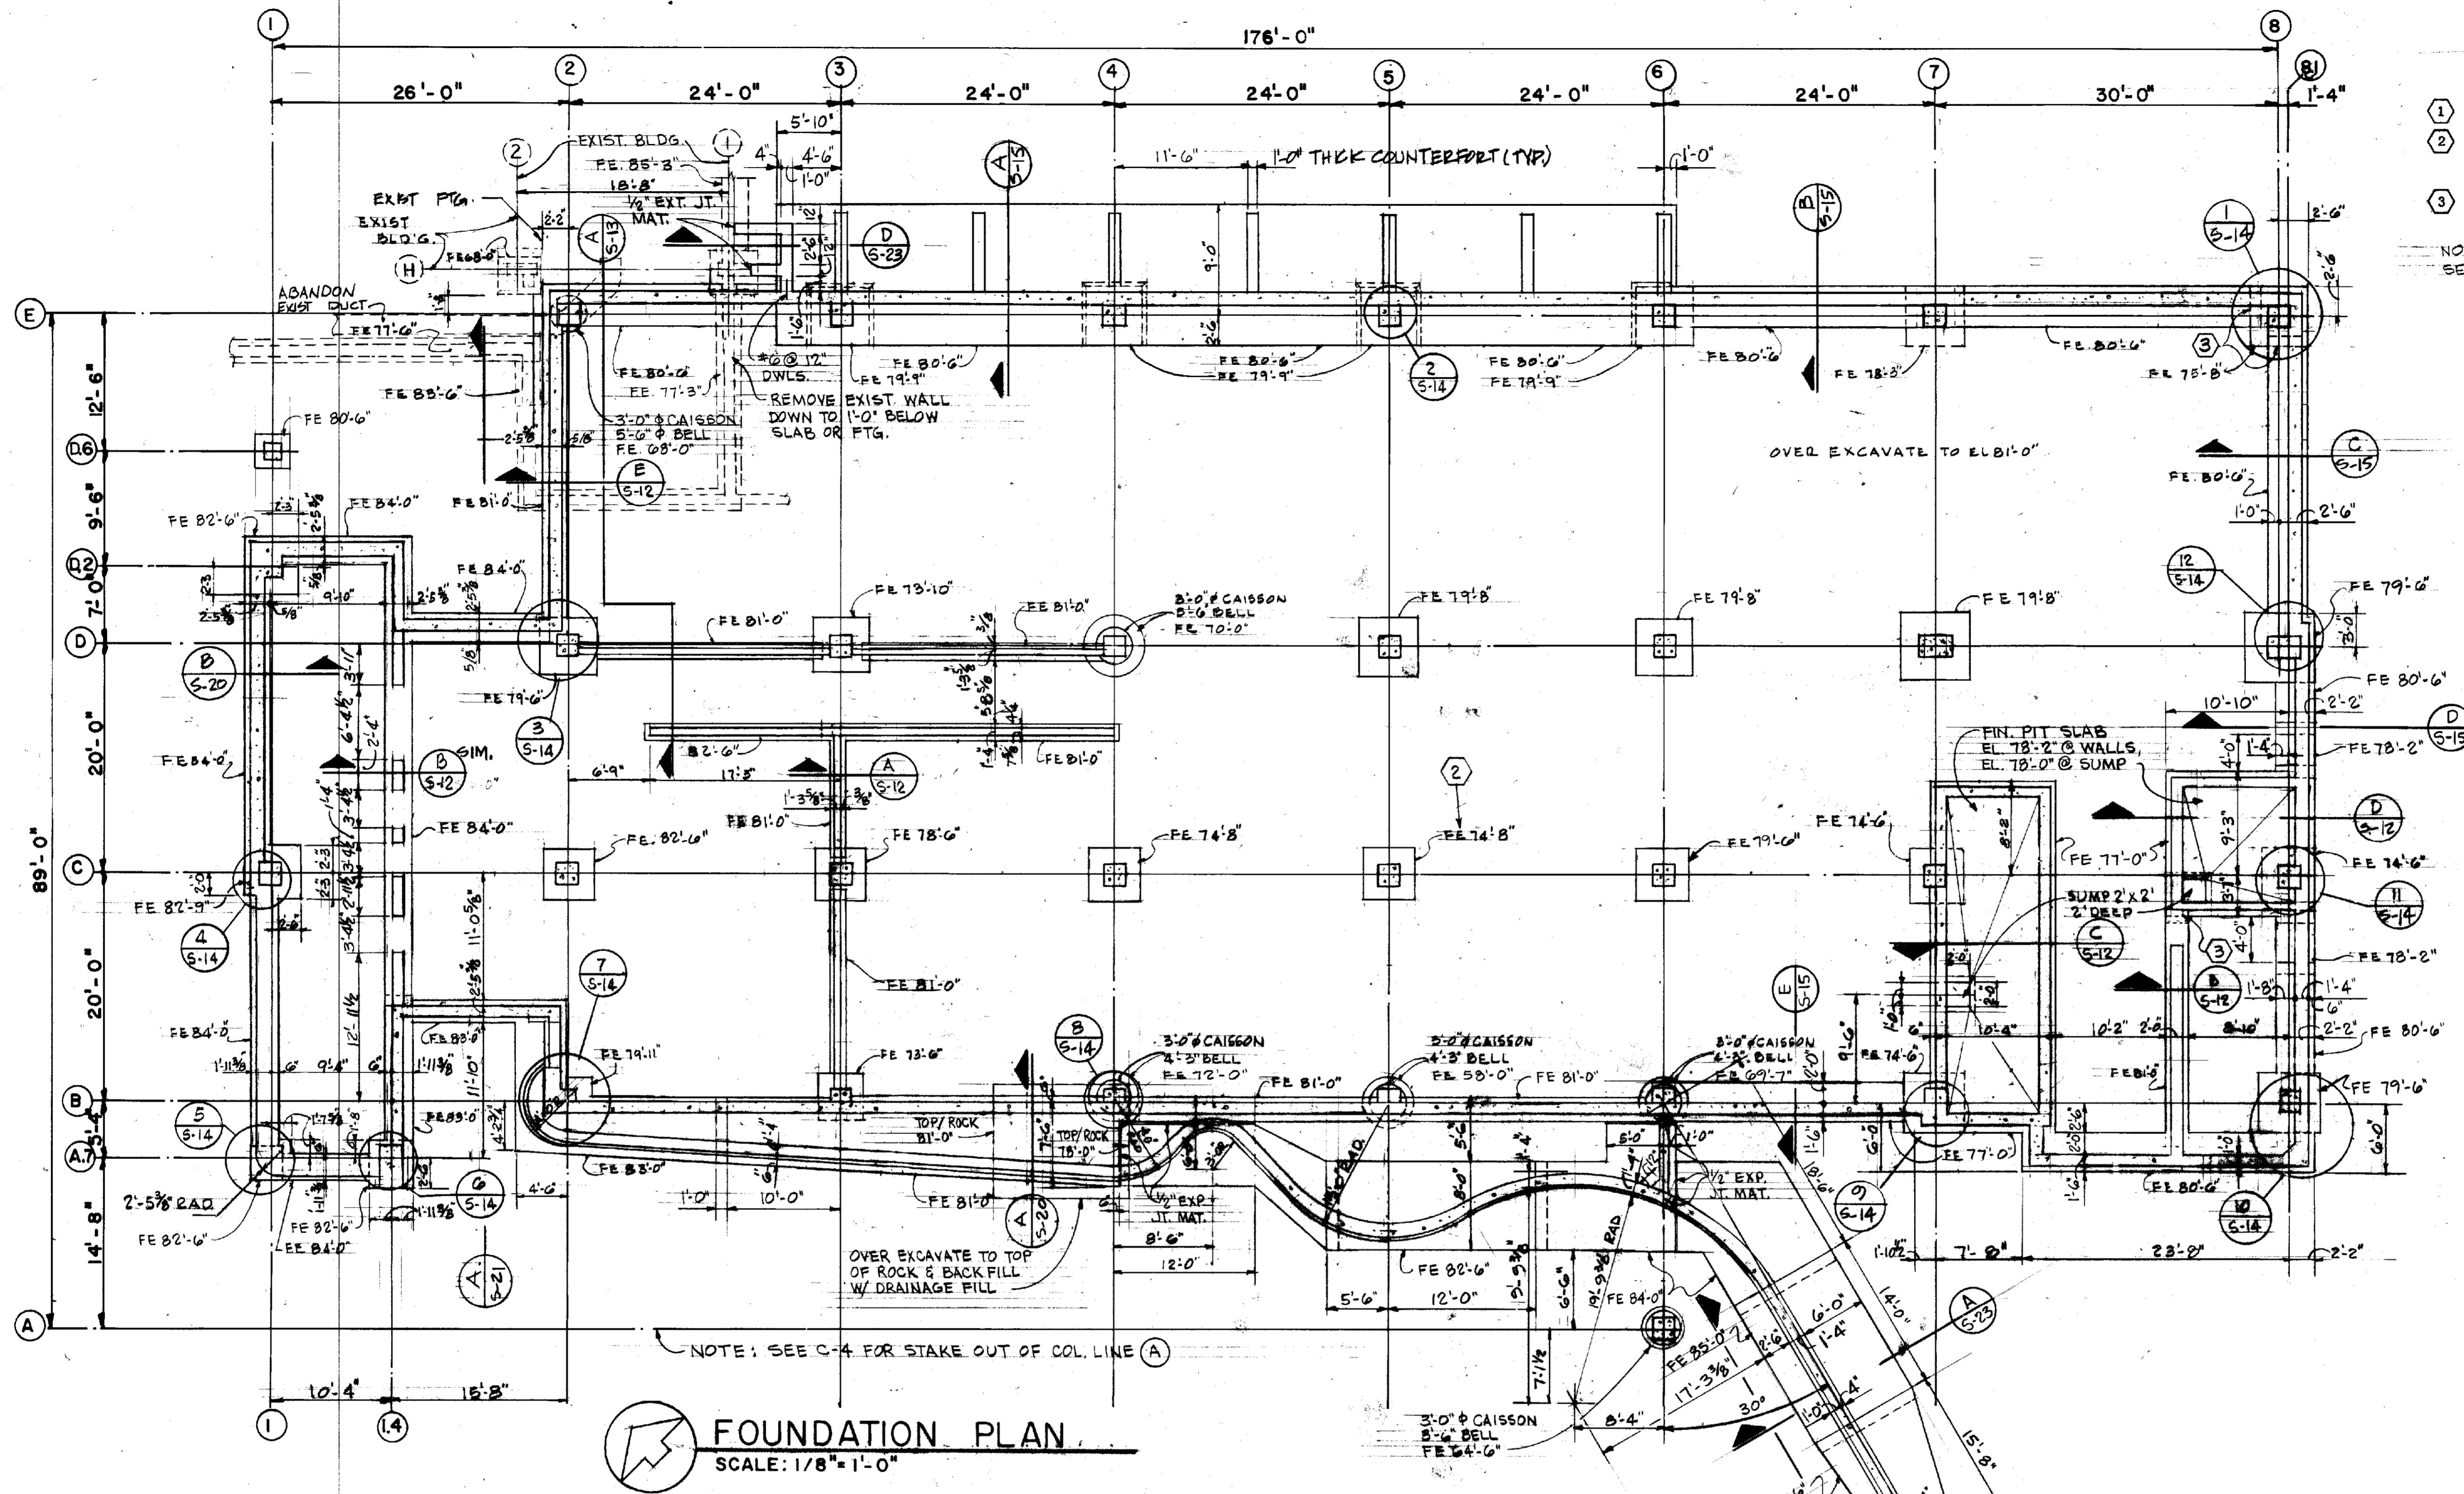

- NOTES**
- 1 SEE SHEET S-1 FOR GENERAL NOTES
 - 2 F.E. DENOTES THE BOTTOM OF FOOTING OR BOTTOM OF CAISSON ELEVATION.
 - 3 TURN WALL FOOTING DOWN TO THE TOP OF COLUMN FOOTING.
- NOTE:
SEE D.C.R. #2, 1/11/88

FOUNDATION PLAN
SCALE: 1/8" = 1'-0"

GENERAL NOTES:

CODES USED IN DESIGN:
 KENTUCKY BUILDING CODE (KBC) (1965 EDITION)
 A.C.I. BUILDING CODE REQUIREMENTS FOR REINFORCED CONCRETE (ACI 318-83 WITH 1986 SUPPLEMENT)
 AISC MANUAL OF STEEL CONSTRUCTION (1980 - 8TH EDITION)

DESIGN STRESSES

CONCRETE: ULTIMATE COMPRESSIVE STRENGTH (MINIMUM) AT 28 DAYS AS FOLLOWS:
 BUILDING CONCRETE 4000 PSI
 EXTERIOR WALKS DRIVE CURBS, YARLTS, PITS, UNDERGROUND CONDUITS, ETC. 3000 PSI

REINFORCING STEEL: GRADE 60 DEFORMED BARS WITH STRESSES GOVERNED BY ACI

STRUCTURAL STEEL:
 STRUCTURAL STEEL SHALL BE ASTM A-36 WITH DESIGN STRESSES GOVERNED BY AISC UNLESS OTHERWISE NOTED.

CONNECTIONS FOR STEEL MEMBERS:
 CONNECTIONS SHALL BE WITH ASTM A-307 BOLTS FOR BOLTED CONNECTIONS UNLESS OTHERWISE NOTED. AND E-70XX ELECTRODES FOR WELDED CONNECTIONS. CONNECTION DETAILS NOT SHOWN SHALL BE SELECTED TO SUPPORT ONE-HALF THE TOTAL UNIFORM LOAD CAPACITY OF THE BEAM. HOLES ARE NOT PERMITTED IN TENSION FLANGE UNLESS SPECIFICALLY NOTED.

FORM DECKING:
 2 INCH x 20 GAUGE GALVANIZED STEEL DECK SHALL HAVE A MINIMUM YIELD STRENGTH OF 33,000 PSI. FORMS ARE TO HAVE THE MINIMUM SECTION PROPERTIES: t = 0.0358 INCHES; I = 0.43 IN⁴/FT.; S = 0.369 IN³/FT.

MISCELLANEOUS FASTENERS:
 HEADED STUD-TYPE SHEAR CONNECTORS SHALL BE ASTM A 108 GRADE 1015 OR 1020.
 ANCHOR BOLTS SHALL BE ASTM A 307.

FOUNDATIONS

FOOTINGS OR CAISSONS FOR BUILDING COLUMN LOADS WERE DESIGNED TO BEAR ON SOLID ROCK WITH A MINIMUM BEARING VALUE OF 60,000 PSF.

WALL FOOTINGS ON ROCK WERE DESIGNED FOR AN ALLOWABLE BEARING VALUE OF 60,000 PSF MINIMUM.

WALL FOOTINGS BEARING ON SOIL WERE DESIGNED FOR AN ALLOWABLE BEARING PRESSURE OF 3,000 PSI MINIMUM.

DESIGN FROST DEPTH = 24 INCHES.

DESIGN LOADS

DEAD LOADS:
 WEIGHTS OF MATERIALS AND CONSTRUCTION: PER KBC APPENDIX B.

LIVE LOADS:
 ROOF LIVE LOADS: 20 PSF FOR SNOW.
 PONDING WATER: DESIGNED FOR THE MAXIMUM POSSIBLE WATER DEPTHS.

FLOOR LIVE LOADS:

STAIRS AND EXITS: 100 PSF OR 300 LBS. @ TREAD
 SCHOOL CORRIDORS: 80 PSF PLUS 20 PSF FOR FUTURE PARTITIONS = 100 PSF OR 1000 LB ON A 2.5 FT. SQUARE AREA
 COMPUTER ROOMS: 80 PSF PLUS 20 PSF FOR FUTURE PARTITIONS = 100 PSF OR 1000 LB ON A 2.5 FT. SQUARE AREA

ELEVATOR MACHINE ROOM: 125 PSF
 MACHINE BAY,
 LOADING DOCK,
 MECHANICAL ROOM:
 YARDS AND TERRACES
 USE 125 PSF OR 5 TON FORK TRUCK
 100 PSF OR 800 LBS ON A 2.5 FT. SQUARE AREA.

EQUIPMENT:
 ELEVATORS: USE MANUFACTURER'S CATALOG DATA.
 ELEVATOR SHAFT HOISTWAY BEAM = 6000 LBS.
 HOISTWAY: USE MANUFACTURER'S DATA (TWO-5 TON CAPACITY HOISTS).
 ROBOTICS EQUIPMENT, ROBOTS, ETC.: FROM MANUFACTURER'S CATALOG DATA
 USE THE FOLLOWING: HIGH BAY = 7000 LBS.
 MED LABS = 1000 LBS.
 SMALL LABS = 500 LBS.

WALKS AND DRIVES FOR TRUCKS:
 USE 250 PSF OR:
 P = 8000 LBS ON A 2.5 FT. SQUARE AREA
 HS 20 TRUCK OR 5 TON FORK TRUCK AS APPLICABLE

WIND: PER KENTUCKY BUILDING CODE FOR 75 MPH
EARTHQUAKE: PER KENTUCKY BUILDING CODE FOR ZONE 1

FUTURE FLOORS: THE PRIMARY STRUCTURAL FRAME, COLUMNS AND FOUNDATIONS WERE DESIGNED TO ALLOW THE ADDITION OF TWO FLOORS IN THE FUTURE SIMILAR TO THE FIFTH FLOOR.

ADMINISTRATIVE CONTROLS WILL BE REQUIRED TO INSURE THAT FLOOR DESIGN LIVE LOADS ARE NOT EXCEEDED IN PRACTICE. AN IMPORTANT EXAMPLE IS THAT THE UNIVERSITY MUST INSTALL ADEQUATE SIGNS OR WARNINGS TO PREVENT A LOADED FORK TRUCK FROM EXITING THE FREIGHT ELEVATOR ON FLOORS 2, 3 & 4 AND 5. CONTINUED ON SHEET S-1A

RECORD PRINTS

THESE ARE RECORD PRINTS OF DRAWINGS BASED UPON MARKED UP PRINTS, DRAWINGS AND OTHER DATA FURNISHED BY THE CONTRACTOR TO THE ENGINEER AND WHICH THE ENGINEER CONSIDERS SIGNIFICANT

82/81

ROBOTICS FACILITY
LEXINGTON CAMPUS
UNIVERSITY OF KENTUCKY
LEXINGTON, KENTUCKY

University of Kentucky
Lexington, Kentucky

FOUNDATION PLAN


Shelley Carter Barnhart
PARTNERS IN ARCHITECTURE
SUITE 1000 • 250 WEST MAIN STREET • LEXINGTON, KY 40502

JOB NO: 2046
 DATE: 10-19-87
 DRAWN: V.T.J.
 CHECKED: P.H.
 FILE NO: 401.0

REVISIONS

MASON & HANGER ENGINEERING INC.
ARCHITECT • ENGINEERS
LEXINGTON, KENTUCKY

Cub # 510 Document # 04838
82 P-1

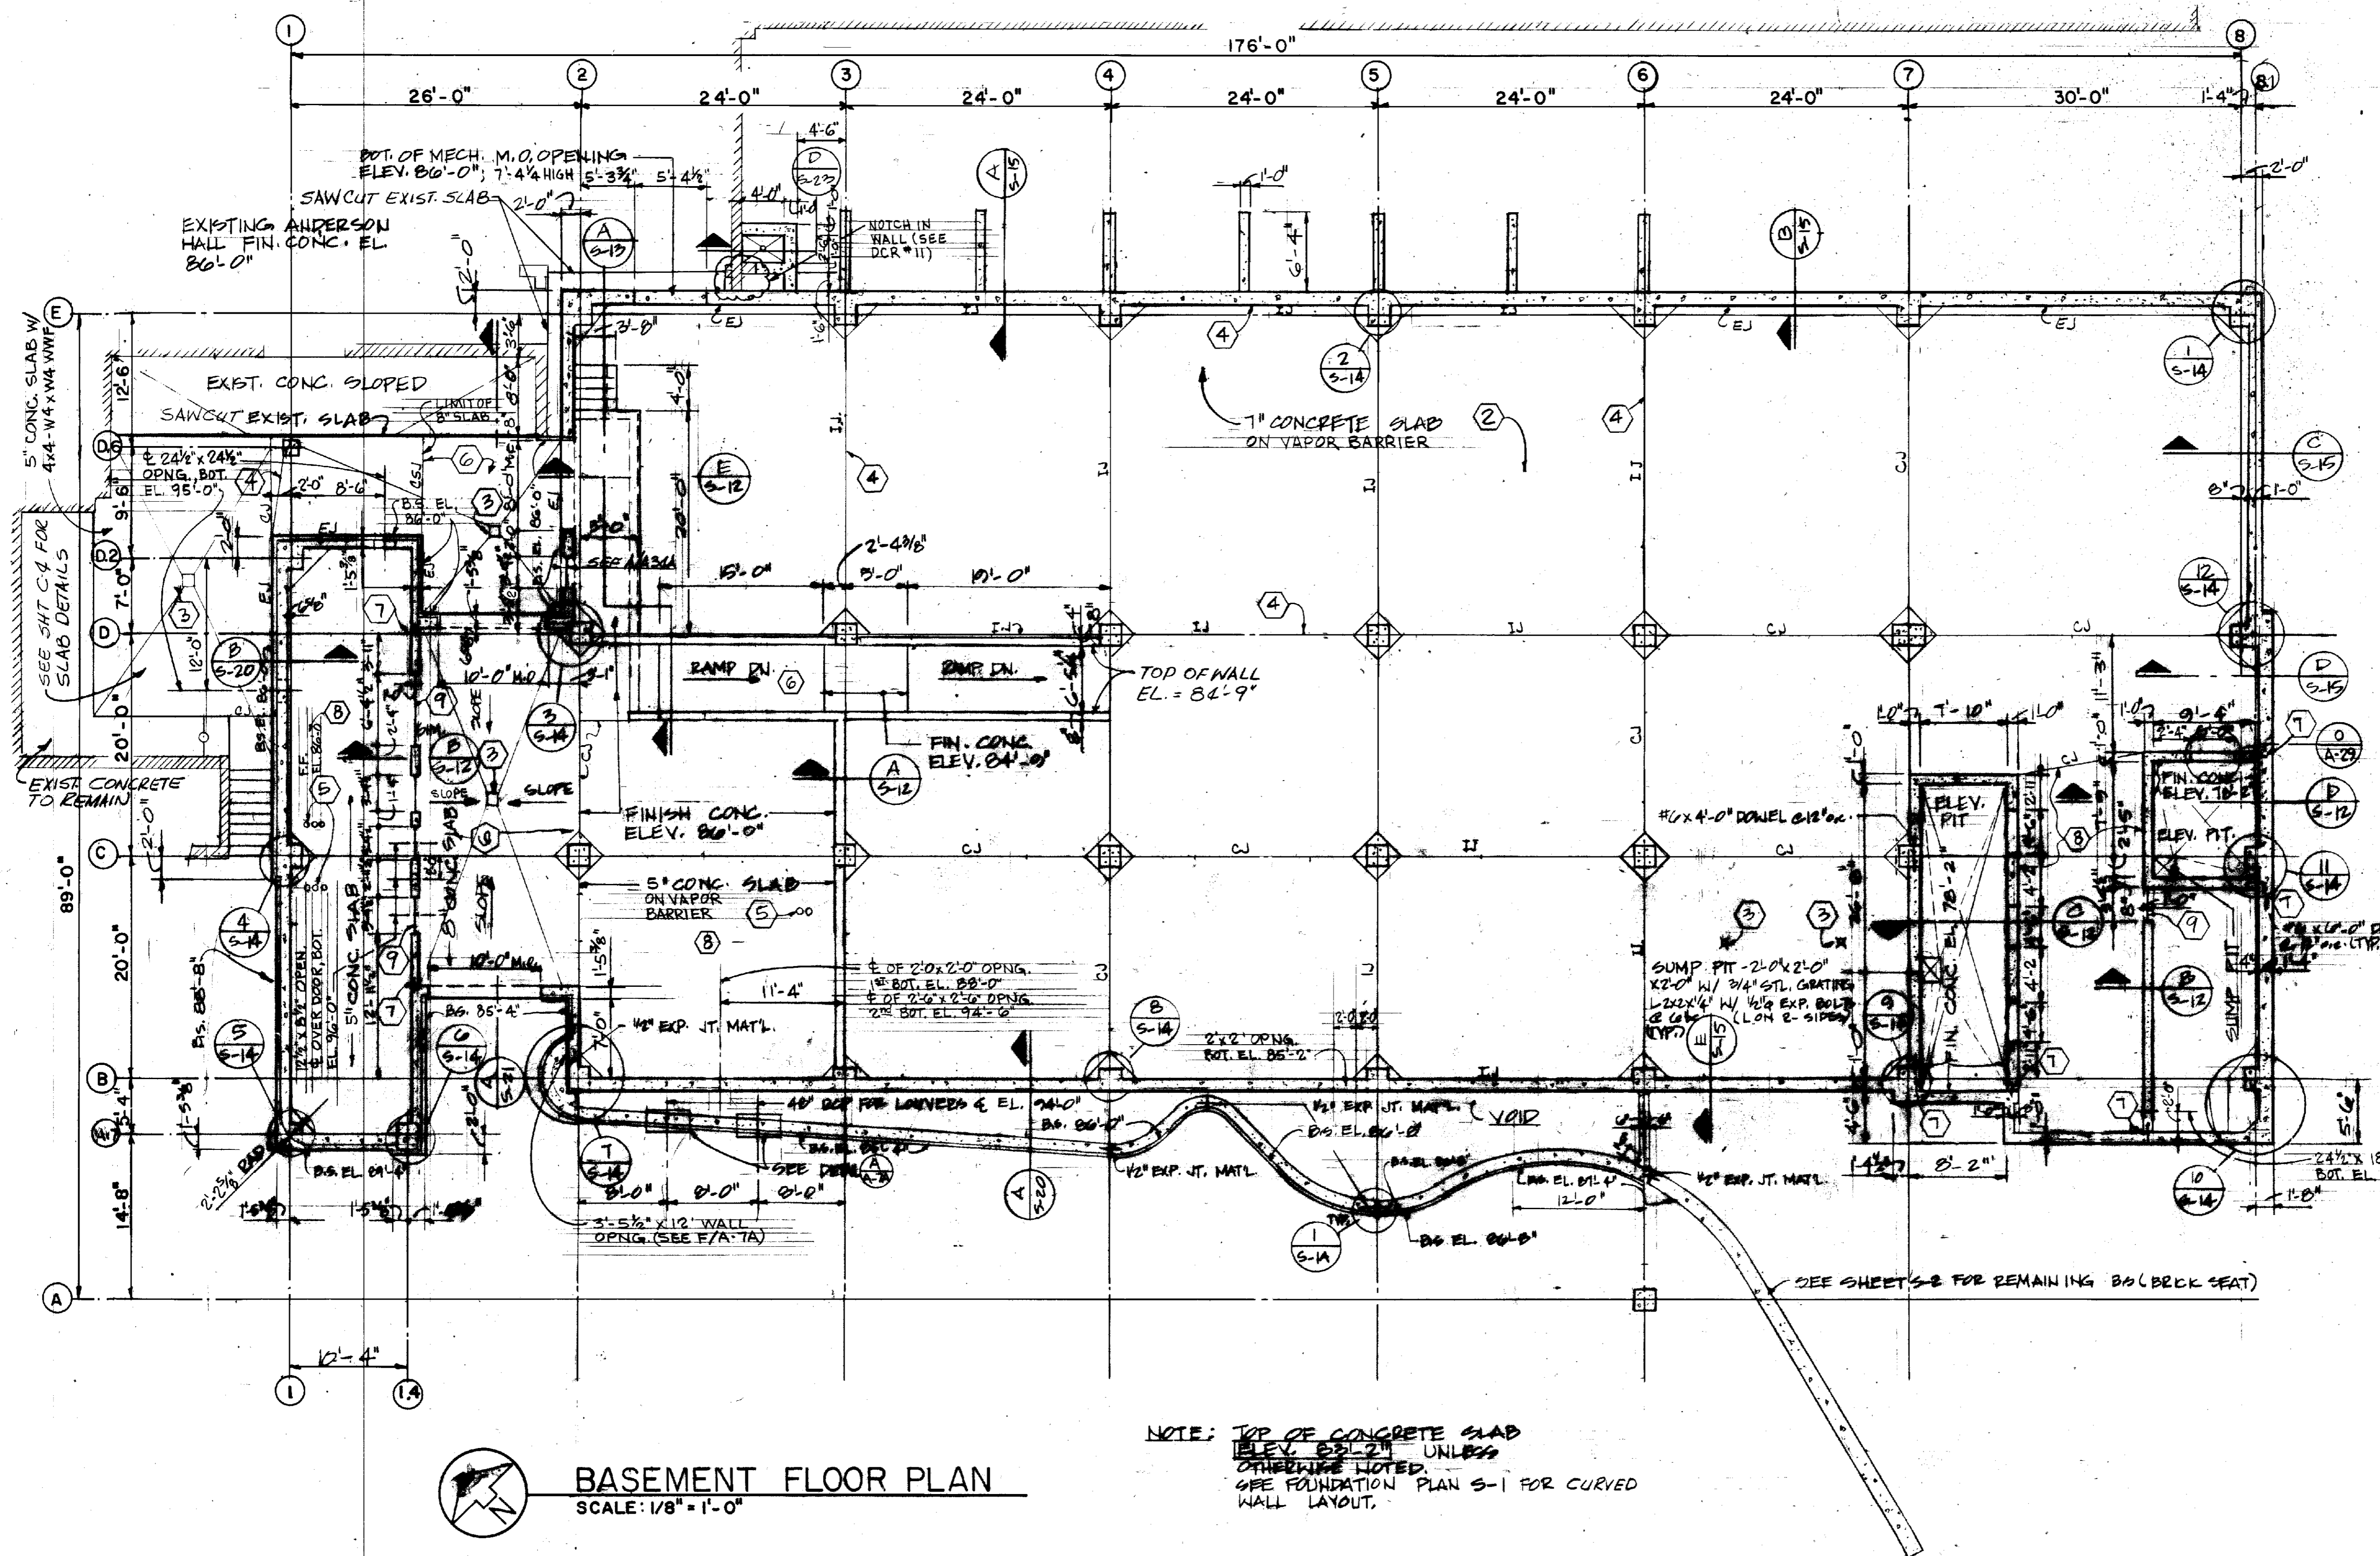

- 5-1A NOTES**
- ① SEE SHEET S-1 FOR GENERAL NOTES.
 - ② 7 INCH SLAB ON GRADE. REINFORCE WITH ONE LAYER OF 4 X 4 - W2.9 X W2.9 W/MF 2" FROM TOP OF SLAB.
 - ③ AREA DRAINS. SEE MECHANICAL.
 - ④ SEE SHEET S-12 FOR SLAB JOINT DETAILS.
 - ⑤ ELECTRIC CONDUIT. SEE SHEET C-14.
 - ⑥ 8 INCH SLAB ON GRADE. REINFORCE WITH ONE LAYER 4 X 4 - W4.0 X W4.0 W/MF 2 INCHES FROM TOP OF SLAB.
 - ⑦ #6 X 2'-0" DOWELS @ 12" O.C.
 - ⑧ 5 INCH SLAB ON GRADE. REINFORCE WITH ONE LAYER 6 X 6 - W2.9 X W2.9 W/MF 2 INCHES FROM TOP OF SLAB.
 - ⑨ UNLESS OTHERWISE INDICATED LOCATE JOINT IN FLOOR SLAB UNDER THE DOOR.
- NOTE:
SEE DCR #6, 2/26/88

NOTE: BASEMENT - INTERIOR BASEMENT WALL & FLOOR SLAB TO BE IN PLACE PRIOR TO BACKFILL OF PERIMETER WALLS

BASEMENT FLOOR PLAN
SCALE: 1/8" = 1'-0"

NOTE: TOP OF CONCRETE SLAB ELEV. 83'-2" UNLESS OTHERWISE NOTED. SEE FOUNDATION PLAN S-1 FOR CURVED WALL LAYOUT.

CONCRETE WORK

BEAMS AND GIRDERS IN SCHEDULES ARE ORIENTED SUCH THAT THE MEMBER MARK ON THE FLOOR PLAN IS ON THE LEFT END OF THE MEMBER.

ANY CONCRETE WITH REINFORCEMENT NOT DETAILED SHALL BE PROVIDED WITH #4 @ 12" EACH WAY, EACH FACE.

PROVIDE 2 NO. 5 BARS E.F. DIAGONAL (45 DEGREES) EXTENDING 2'-6" EACH DIRECTION, AT EACH CORNER OF OPENINGS LARGER THAN 2'-0" IN ANY DIRECTION. (UNLESS NOTED OTHERWISE).

CHAMFER ALL EXPOSED EDGES 3/4" UNLESS NOTED OTHERWISE.

LAP SPLICES SHALL BE IN ACCORDANCE WITH ACI 318-83 UNLESS OTHERWISE NOTED. STAGGER SPLICES IN FLOOR SLABS SO THAT NOT MORE THAN HALF THE BARS ARE SPLICED ALONG ANY ONE PLANE.

CONSTRUCTION JOINT LOCATION OTHER THAN THOSE SHOWN SHALL BE APPROVED BY THE ARCHITECT/ENGINEER.

ALL MECHANICAL AND PLUMBING PENETRATIONS NOT INDICATED SHALL BE SLEEVED THROUGH CONCRETE.

DO NOT BACKFILL AGAINST BASEMENT WALLS UNTIL THE FIRST FLOOR SLAB IS IN PLACE.

COORDINATION WITH EQUIPMENT FURNISHED

WHERE THE CONTRACTORS PROPOSED EQUIPMENT REQUIRES MODIFICATION TO THE STRUCTURE THE ARCHITECT/ENGINEER SHALL BE SO ADVISED TO DETERMINE WHETHER THE MODIFICATIONS CAN REASONABLY BE MADE.

THE CONSTRUCTION OF THE MACHINE ROOM FLOOR OVER ELEVATOR MOISTWAYS SHALL BE COORDINATED WITH THE INSTALLATION OF ELEVATOR MACHINERY.


BUILDING ELEVATIONS

BUILDING ELEVATION 100'-0" EQUALS SITE ELEVATION 976.50. SEE SITE SURVEY FOR DATUM BENCHMARK.

CONCRETE WORK (CONT.)

ALL SLAB ON GRADE JOINTS SHALL BE 30" FELT JOINTS, UNLESS NOTED OTHERWISE.


ALL JOINTS AROUND COLUMNS (BETWEEN AFTER POUR AND SLAB) SHALL BE 1/2" EXPANSION JOINT MATERIAL WITH SEALER, EXCEPT WHERE CORK IS REQUIRED TO MAKE THE ISOLATION JOINT (1J) CONTINUOUS.

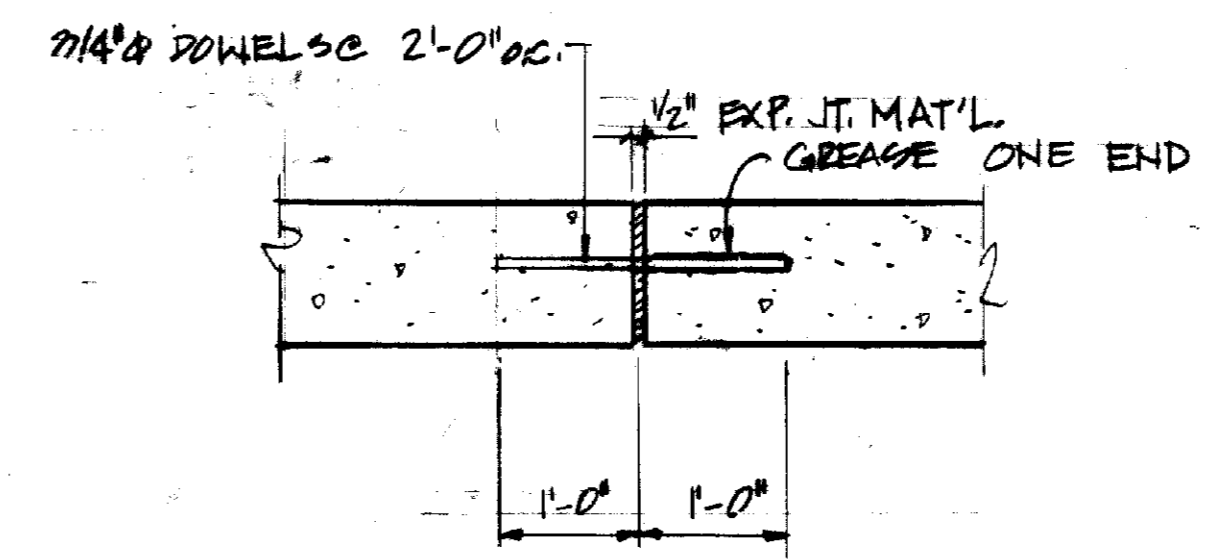

DETAIL
S-1A SCALE: 3/4" = 1'-0"

RECORD PRINTS

THESE ARE RECORD PRINTS OF DRAWINGS BASED UPON MARKED UP PRINTS, DRAWINGS AND OTHER DATA FURNISHED BY THE CONTRACTOR TO THE ENGINEER AND WHICH THE ENGINEER CONSIDERS SIGNIFICANT.

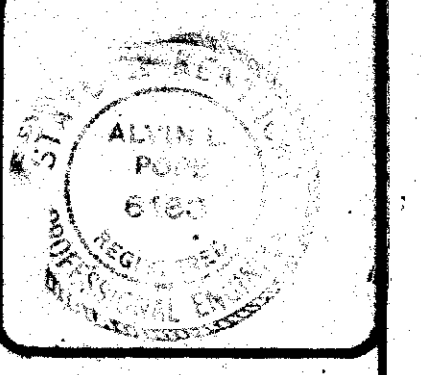

ROBOTICS FACILITY
LEXINGTON CAMPUS
UNIVERSITY OF KENTUCKY
LEXINGTON, KENTUCKY


University of Kentucky
Lexington, Kentucky

Basement Floor Plan
Sherman Carter Barnhart
PARTNERS IN ARCHITECTURE
SHERMAN CARTER BARNHART ARCHITECTS, LEXINGTON, KY 40504

JOB NO. 206
DATE 10-19-87
DRAWN M.A.A.
CHECKED ALP/BN
FILE NO. 431.0





REVISIONS

SHEET
S-1A

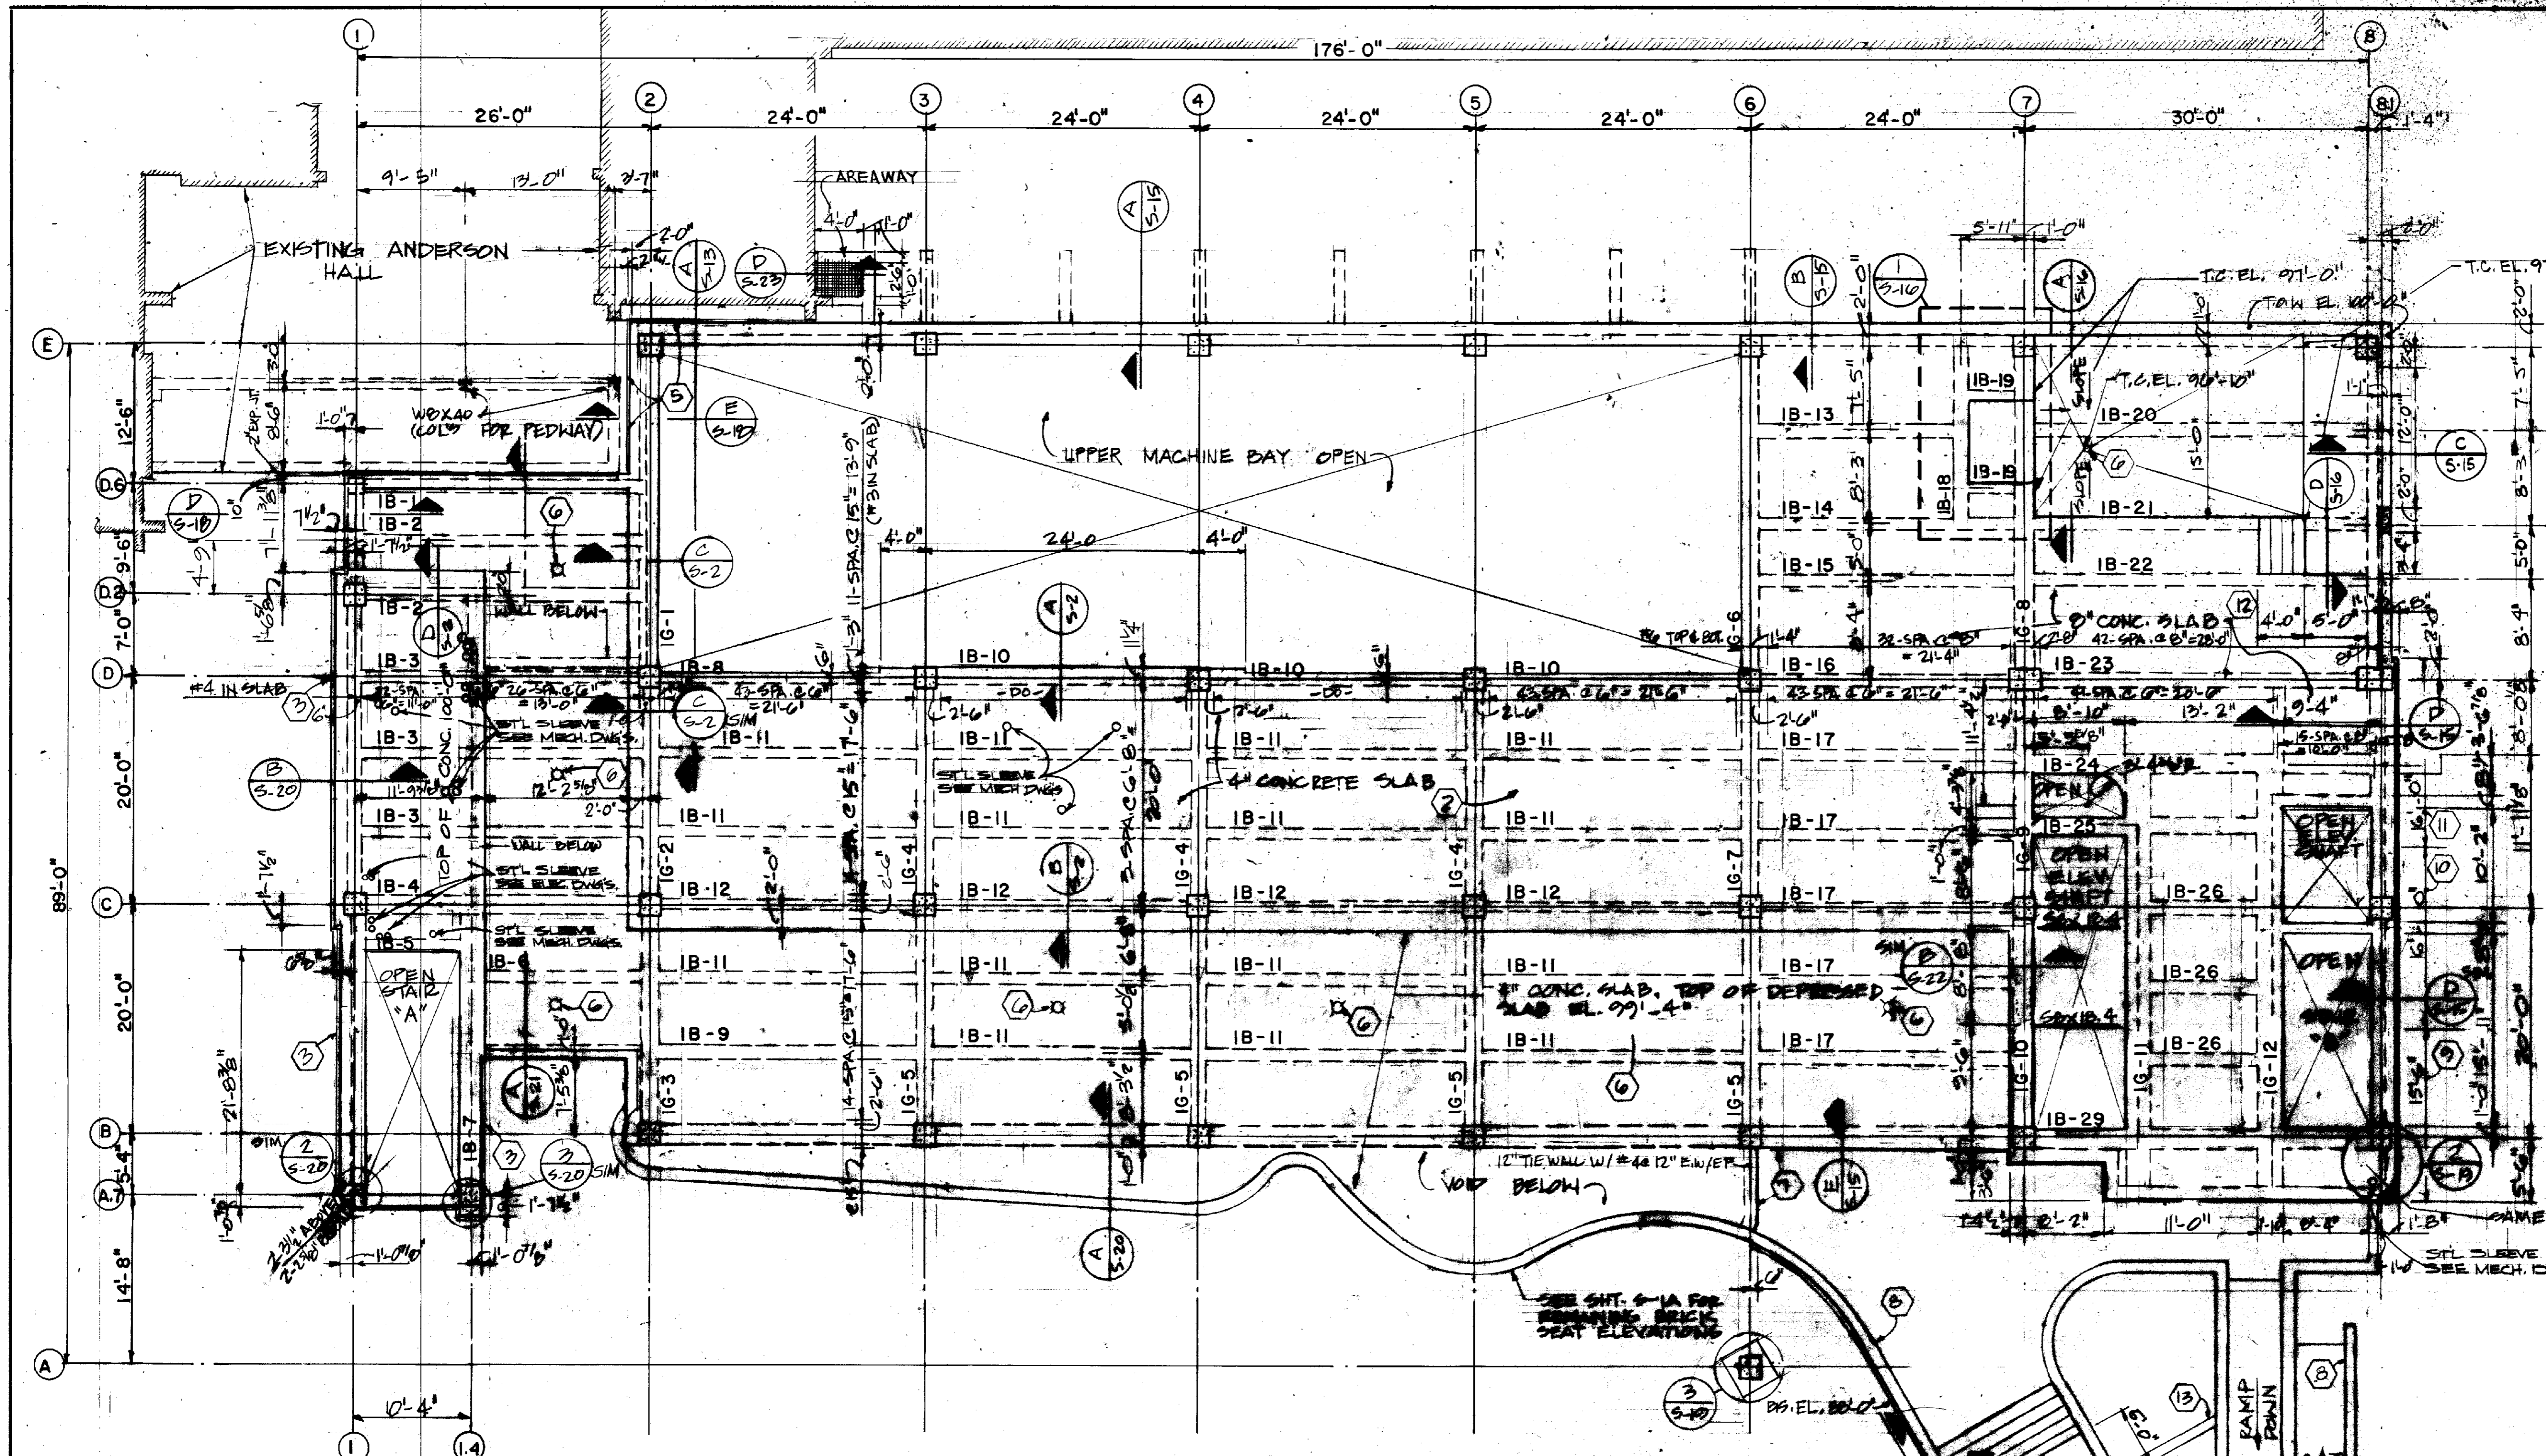


- 5-2 NOTES
- 1 SEE SHEET S-1 FOR GENERAL NOTES
 - 2 SLAB REINFORCING IS #4 @ 6 NORTH-SOUTH IN CENTER OF SLAB. EAST-WEST TEMPERATURE STEEL IS #3 @ 15 ABOVE THE MAIN REINF. PROVIDE ADDITIONAL #4 AT BUILDING PERIMETER AS INDICATED.
 - 3 SHELF ANGLE 4 X 4 X 5/16. SUPPORT WITH CAST IN DUCTILE IRON WEDGE INSERTS WITH 3/4 # ASKEW HEAD BOLT MITER ANGLES AT CORNERS.
 - 4 ROOF DRAIN. SEE MECHANICAL.
 - 5 LIMITS OF REMOVAL OF EXISTING BUILDING. SAW CUT AND NEATLY BREAK EXISTING SLAB.
 - 6 FLOOR DRAIN. SEE MECHANICAL.
 - 7 1/2" EXPANSION JOINT WITH SEALER
 - 8 FOR DETAILS OF STEPS & RAMPS SEE SHEET A-37
 - 9 BRICK LEDGE, ELEVATION = 96'-0"
 - 10 BRICK LEDGE, ELEVATION = 96'-8"
 - 11 BRICK LEDGE, ELEVATION = 97'-4"
 - 12 8 INCH CONCRETE SLAB WITH #6@8" TOP AND BOTTOM NORTH-SOUTH. EAST-WEST TEMPERATURE STEEL IS #3@12" TOP AND BOTTOM.
 - 13 TIE WALL IS 12 INCHES THICK WITH #4@12" EW. BOTTOM ELEVATION = 92'-6". TOP ELEVATION = 100'-0". HOOK HORIZONTAL BARS INTO SUPPORTING WALL AT BOTH ENDS.
- NOTE:
SEE DCR #6, 2/26/88

FIRST FLOOR FRAMING PLAN
SCALE: 1/8" = 1'-0"

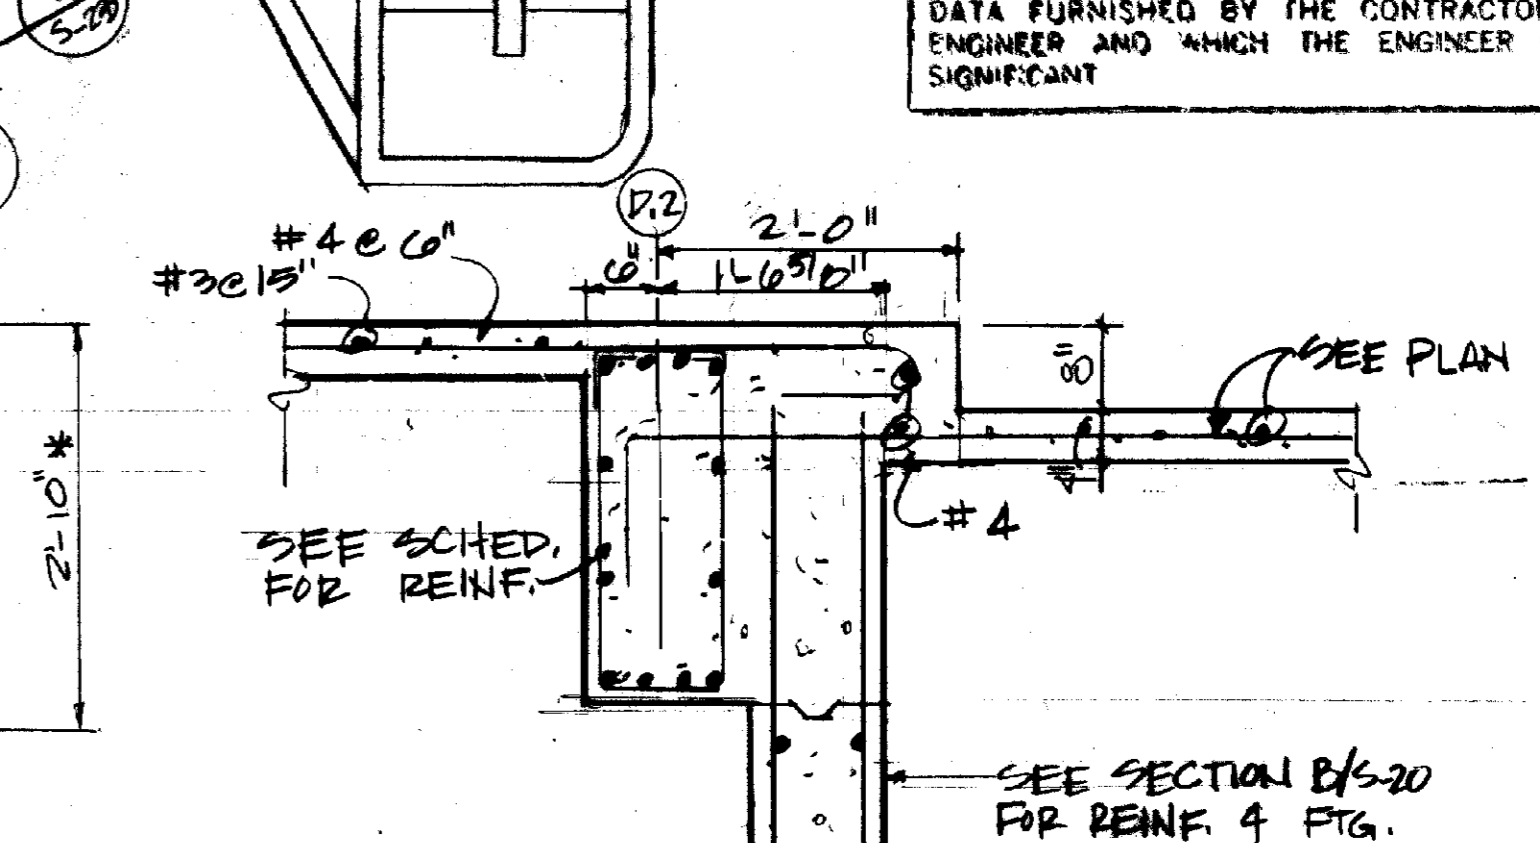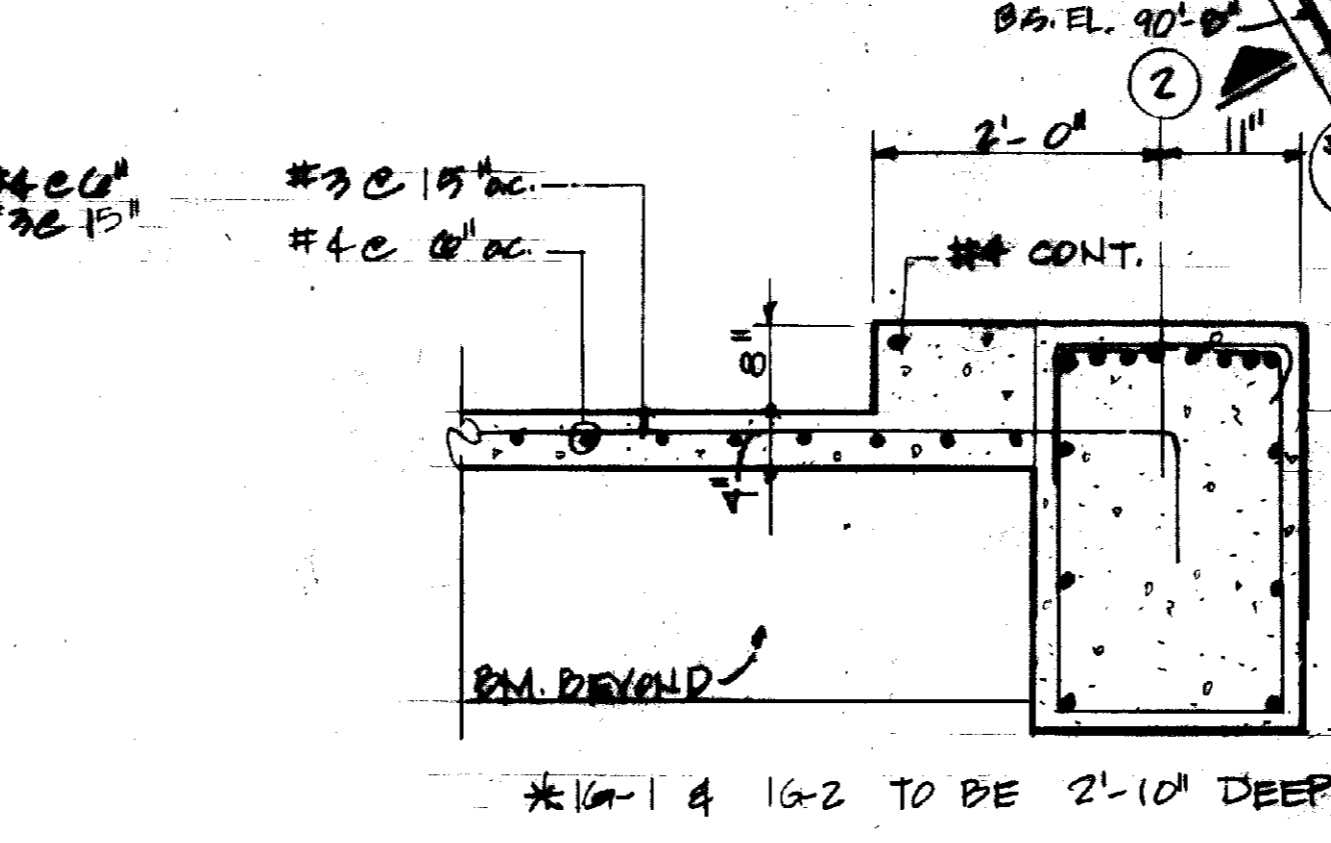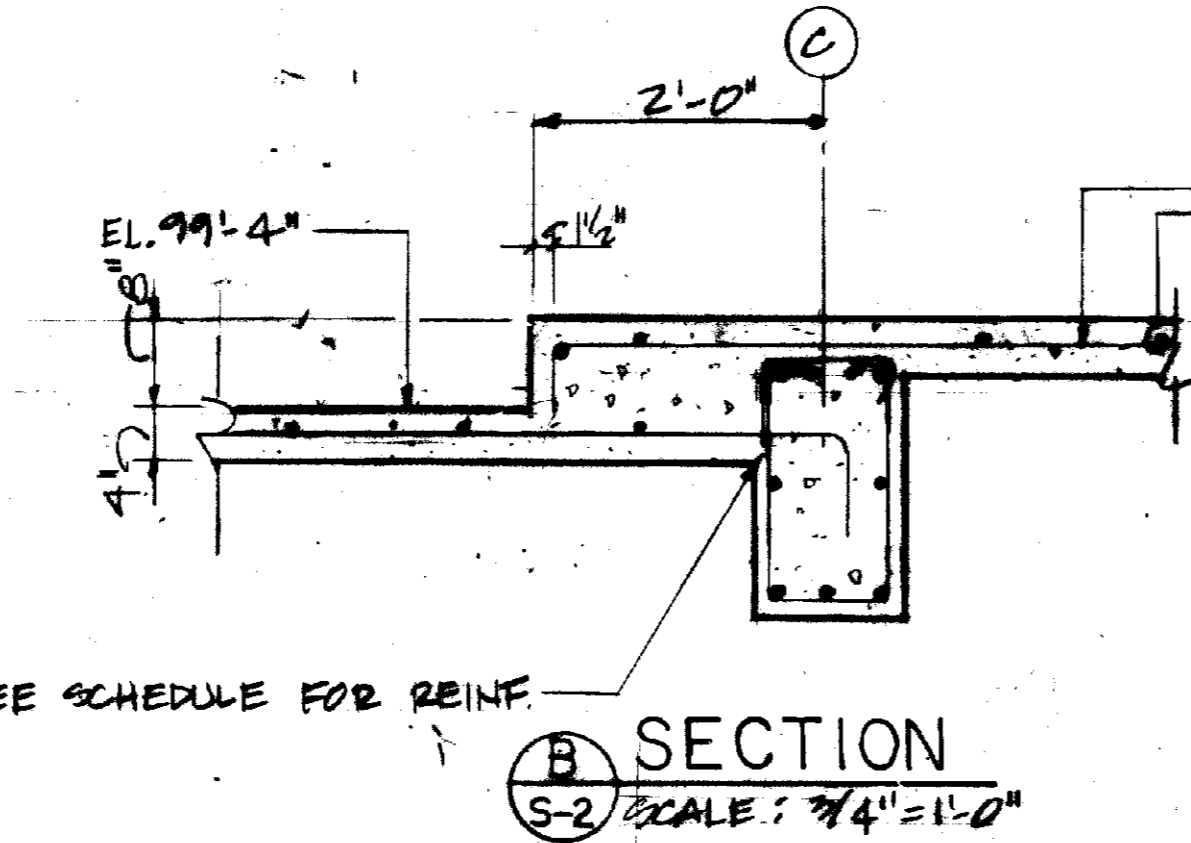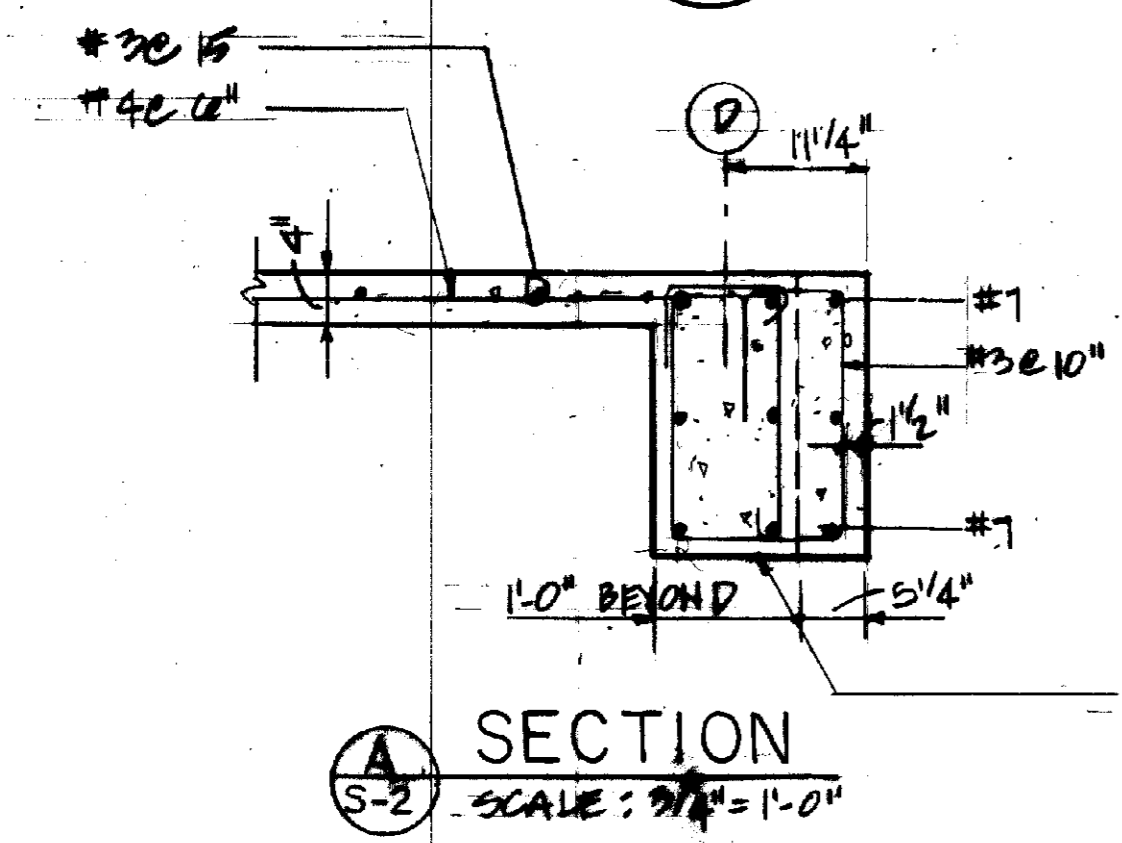

RECORD PRINTS
THESE ARE RECORD PRINTS OF DRAWINGS BASED UPON MARKED UP PRINTS, DRAWINGS AND OTHER DATA FURNISHED BY THE CONTRACTOR TO THE ENGINEER AND WHICH THE ENGINEER CONSIDERS SIGNIFICANT

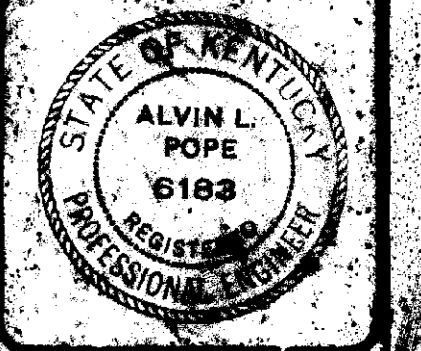

ROBOTICS FACILITY
LEXINGTON CAMPUS
UNIVERSITY OF KENTUCKY
LEXINGTON, KENTUCKY

University of Kentucky
Lexington, Kentucky


First Floor Framing
Sherman-Carter
PARTNERS IN ARCHITECTURE

JOB NO. 2046
DATE: 10-19-81
DRAWN: M.A.A.
CHECKED: A.L.P.
FILE NO. 431.0

NO.	REVISIONS

SHEET: 9-2

MASON & HANGER ENGINEERING INC.
ARCHITECT • ENGINEERS
LEXINGTON, KENTUCKY

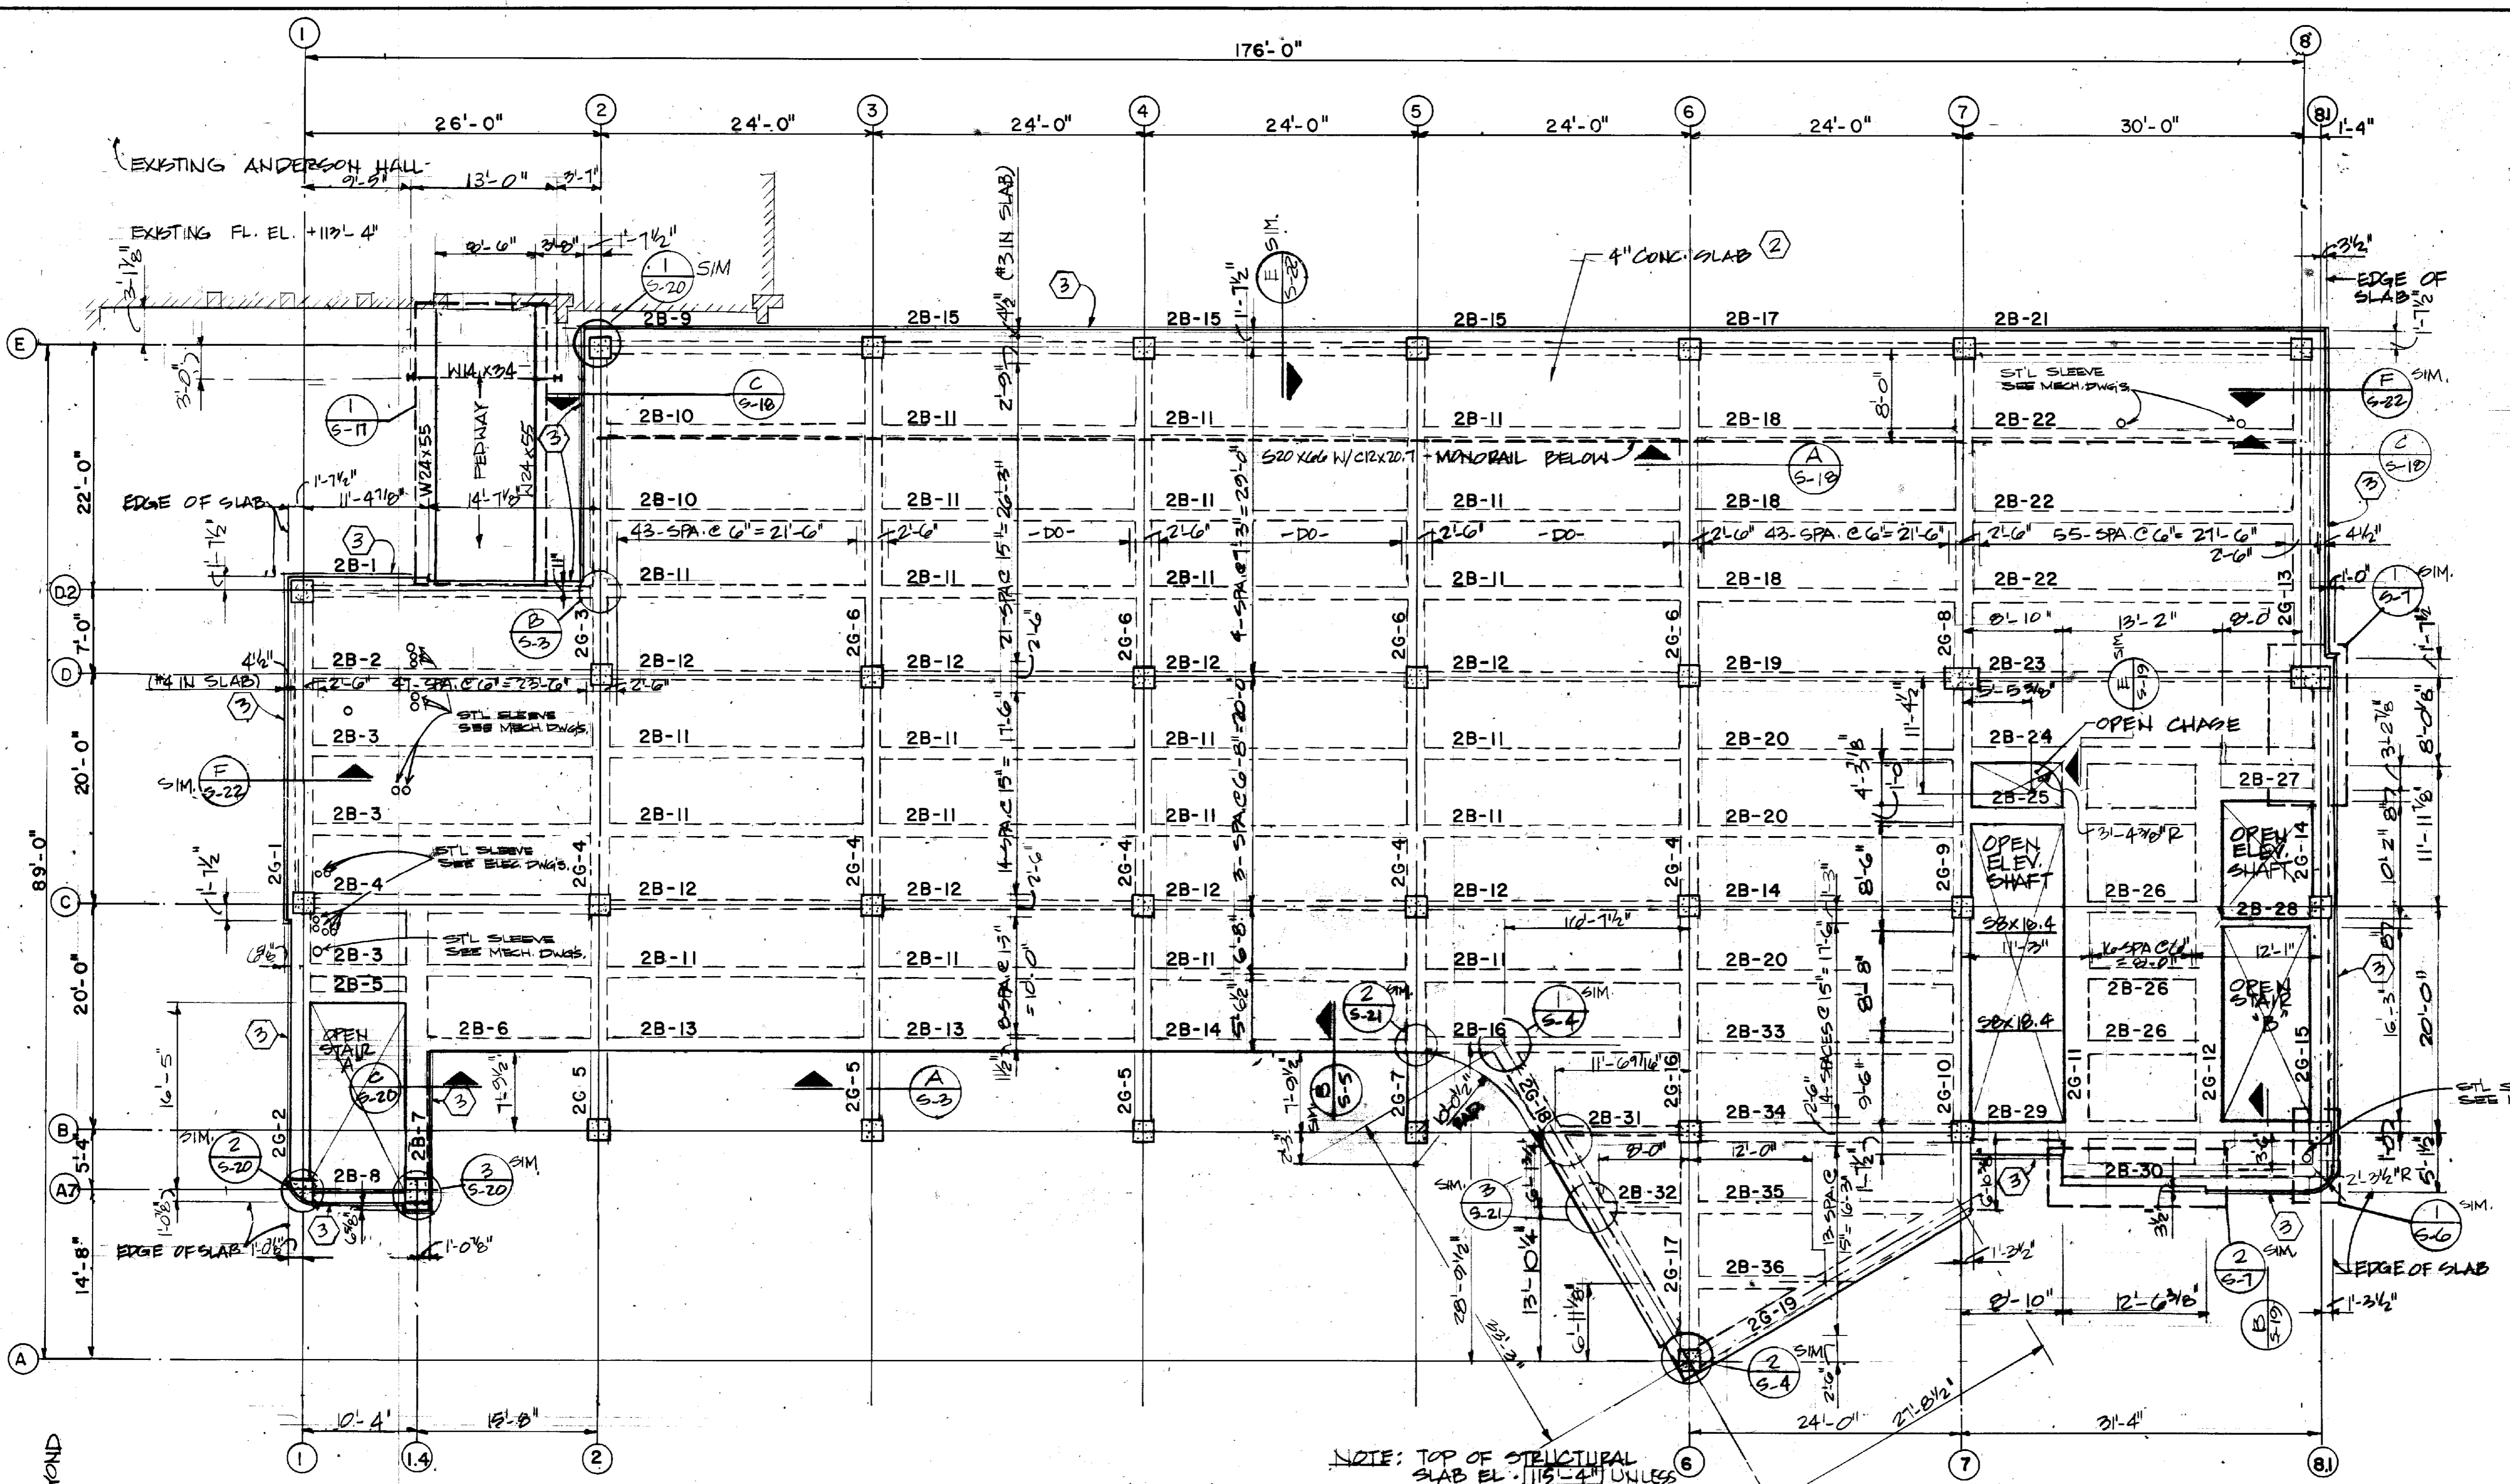


5-3 NOTES


- SEE SHEET S-1 FOR GENERAL NOTES.
- SLAB REINFORCING IS #4 @ 6" NORTH-SOUTH IN CENTER OF SLAB. EAST-WEST TEMPERATURE STEEL IS #3 @ 15" ABOVE THE MAIN REINF. PROVIDE ADDITIONAL REBAR AT BUILDING PERIMETER AS INDICATED.
- SHELF ANGLE 4 X 4 X 5/16. SUPPORT WITH CAST IN DUCTILE IRON WEDGE INSERTS WITH 3/4" ASKEW HEAD BOLT MITER ANGLES AT CORNERS.

NOTE:
ADD SHELF ANGLE @ EL. 114'-2" ALONG COL. LINE D.2 BETWEEN COL. LINE E.2 TO CARRY THE INSET 4" CONC. BLK. ON EACH SIDE OF THE MASONRY WALL.

SECOND FLOOR FRAMING PLAN
SCALE: 1/8" = 1'-0"

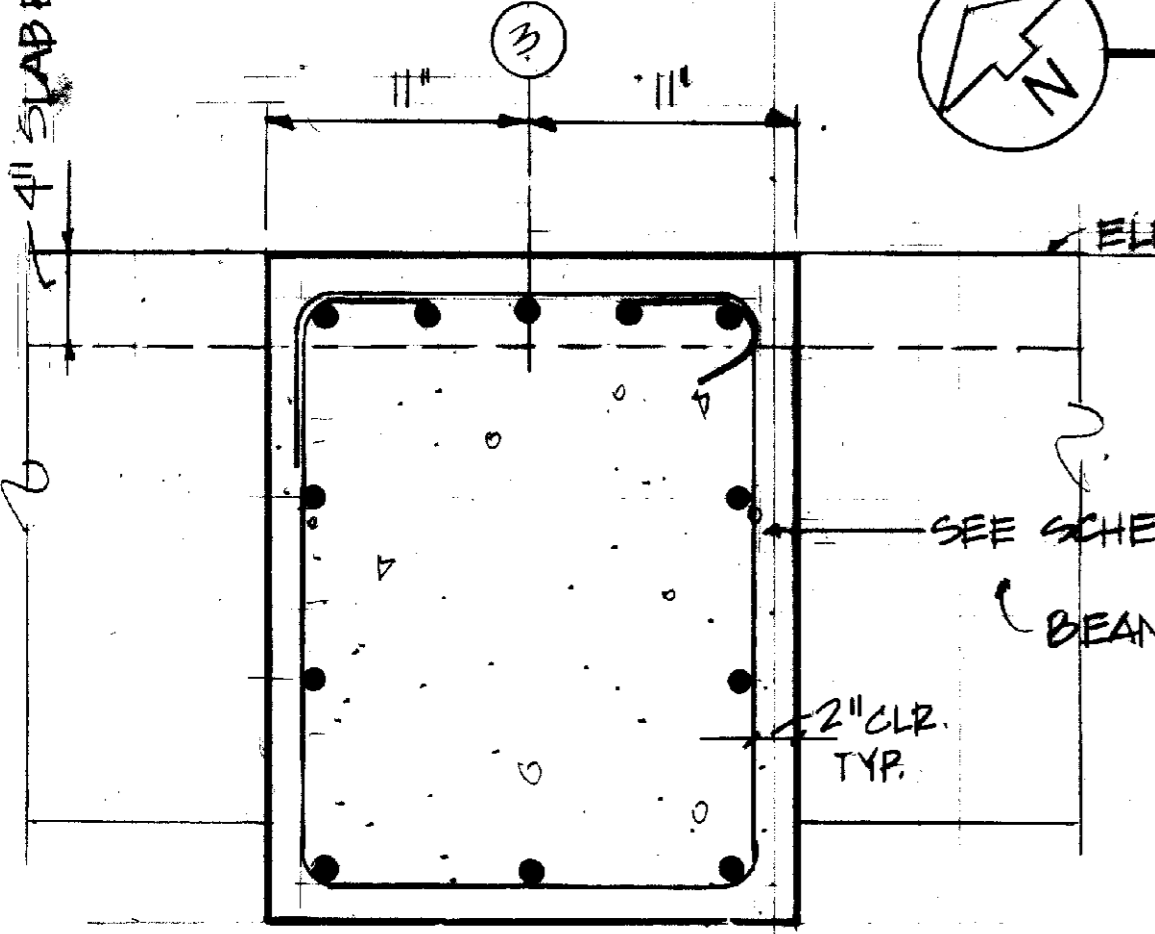


SECTION A-5-3
SCALE: 1/2" = 1'-0"

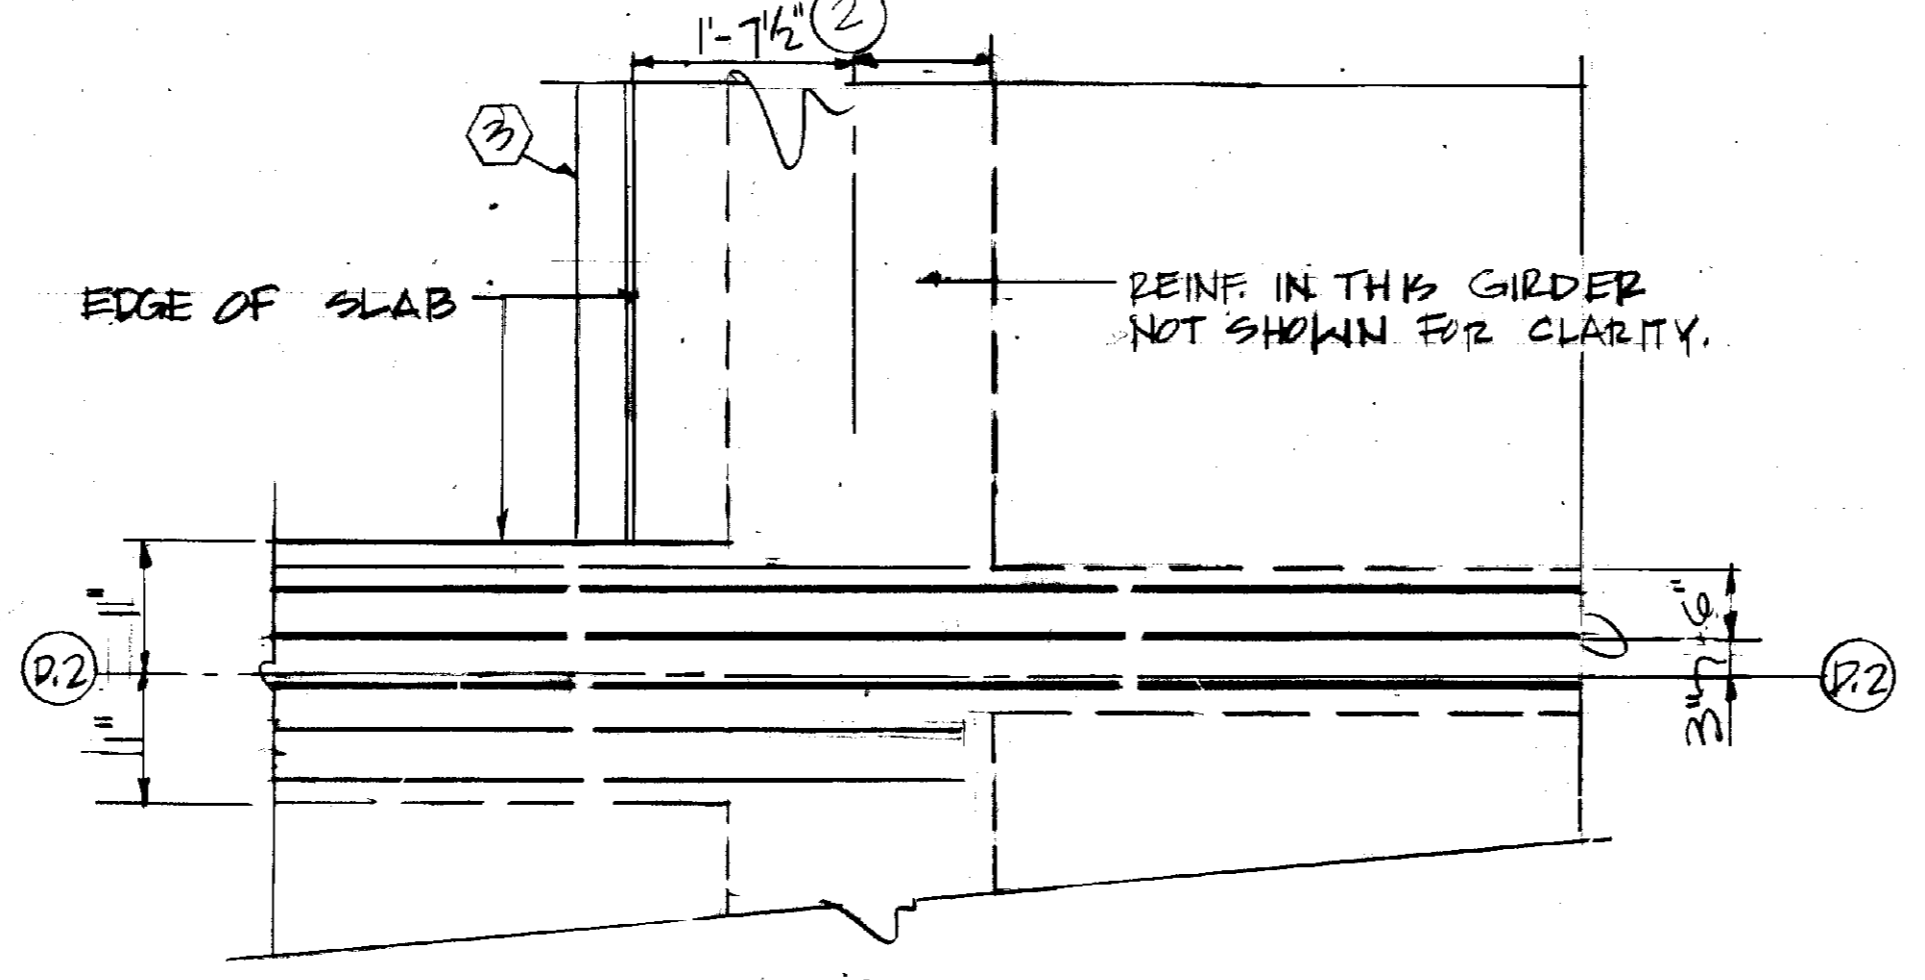

DETAIL B-5-3
SCALE: 3/4" = 1'-0"

RECORD PRINTS

THESE ARE RECORD PRINTS OF DRAWINGS BASED UPON MARKED UP PRINTS, DRAWINGS AND OTHER DATA FURNISHED BY THE CONTRACTOR TO THE ENGINEER AND WHICH THE ENGINEER CONSIDERS SIGNIFICANT.

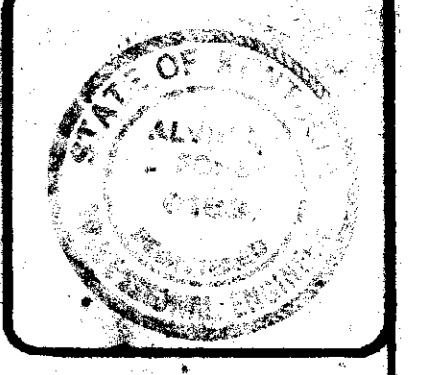

ROBOTICS FACILITY
LEXINGTON CAMPUS
UNIVERSITY OF KENTUCKY
LEXINGTON, KENTUCKY

University of Kentucky
Lexington, Kentucky

Shelley Carter-Barnhart
10.19.07


SECOND FLOOR FRAMING PLAN

Shelley Carter-Barnhart
PARTNERS IN ARCHITECTURE

JOB NO. 2046
DATE 10-19-07
DRAWN M.A.A.
CHECKED A.L.P.
FILE NO. 421.0

REVISIONS




SHEET
S-3

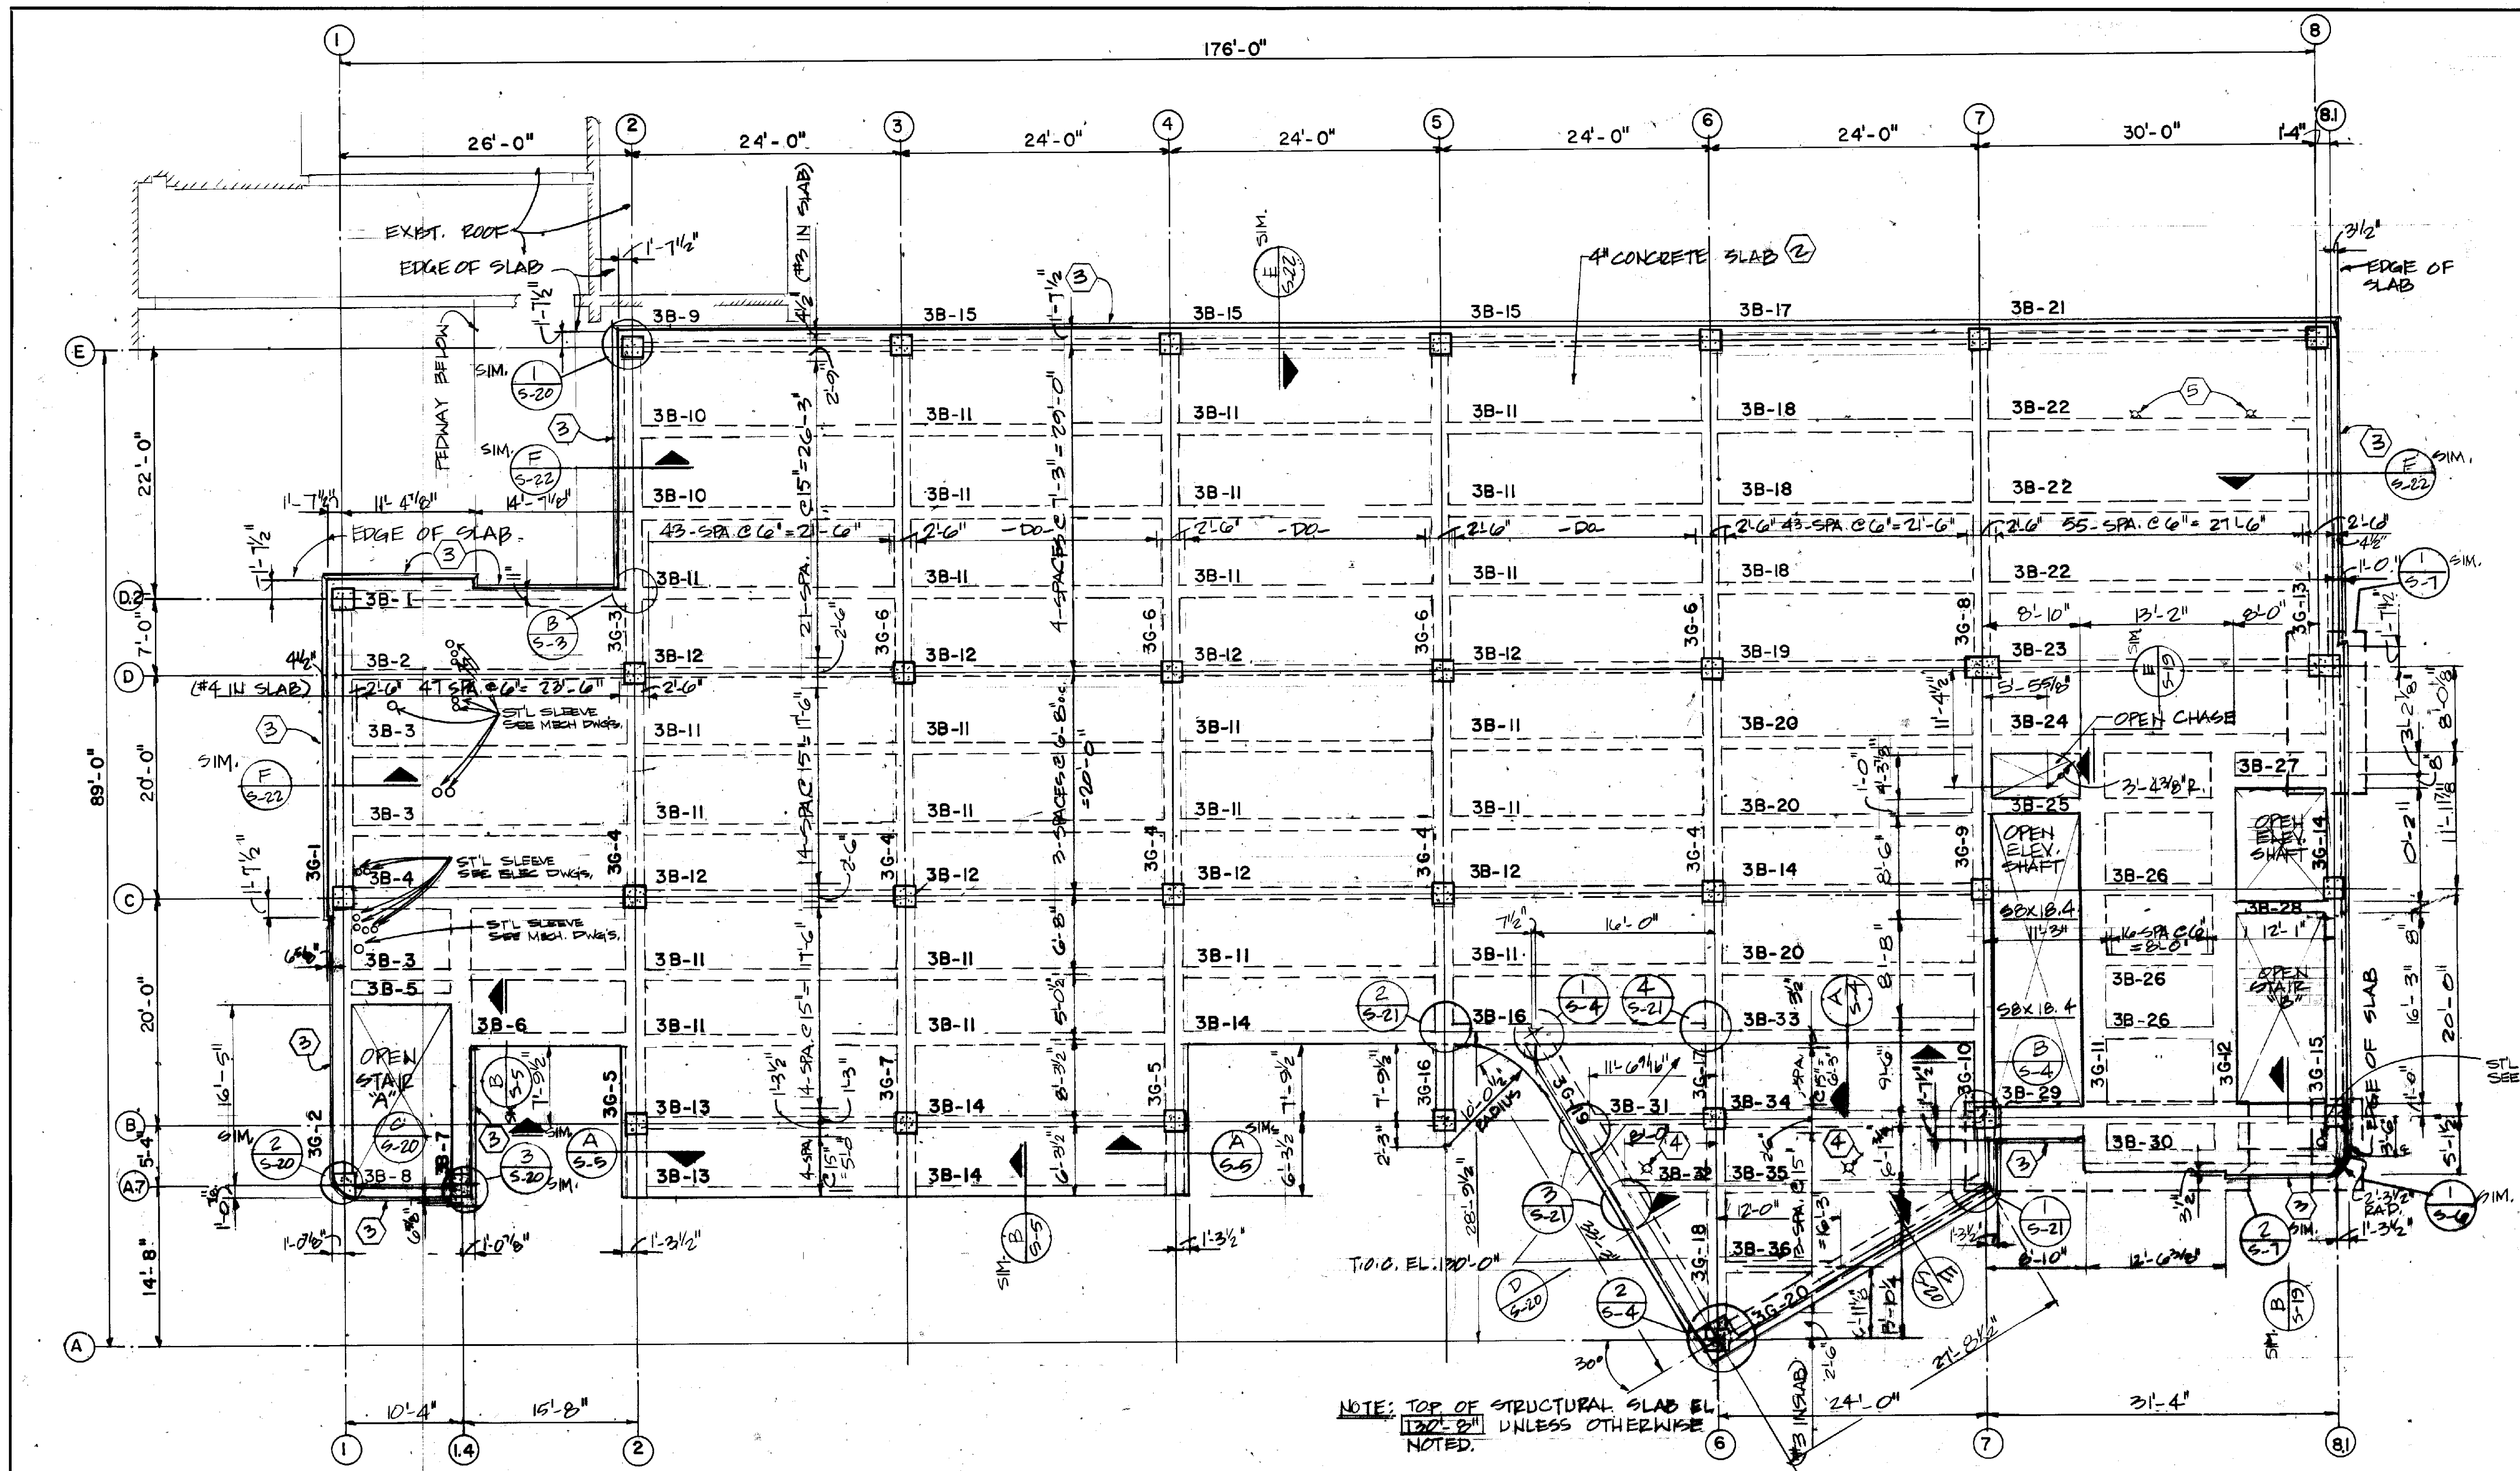

- 5-4 NOTES
- 1 SEE SHEET S-1 FOR GENERAL NOTES.
 - 2 SLAB REINFORCING IS #4 @6" NORTH-SOUTH IN CENTER OF SLAB. EAST-WEST TEMPERATURE STEEL IS #3 @ 15" ABOVE THE MAIN REINF. PROVIDE ADDITIONAL REBAR AT BUILDING PERIMETER AS INDICATED.
 - 3 SHELF ANGLE 4 X 4 X 5/16. SUPPORT WITH CAST IN DUCTILE IRON WEDGE INSERTS WITH 3/4" ASKED HEAD BOLT MITER ANGLES AT CORNERS.
 - 4 ROOF DRAIN FLUSH WITH TOP OF STRUCTURAL SLAB. SEE MECHANICAL.
 - 5 FLOOR DRAIN, DEPRESS 1/2 INCH BELOW FINISHED FLOOR AND TRANSITION SLAB ELEVATION IN A 3 FOOT DIAMETER CIRCLE. SEE MECHANICAL.

THIRD FLOOR FRAMING PLAN

SCALE: 1/8" = 1'-0"

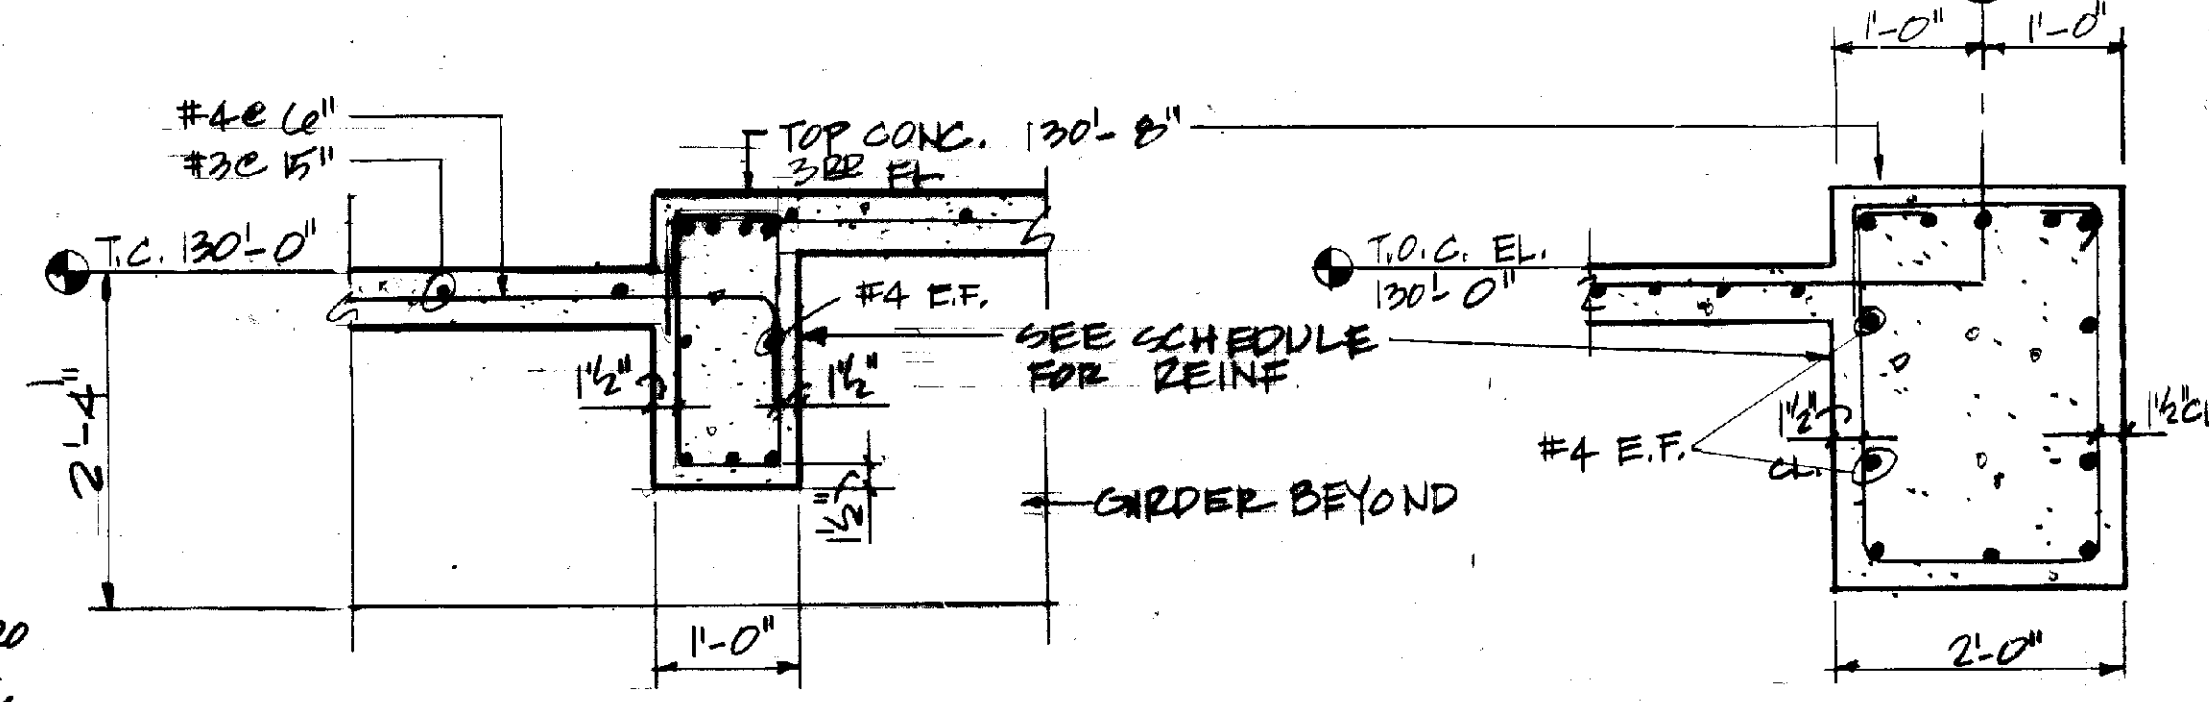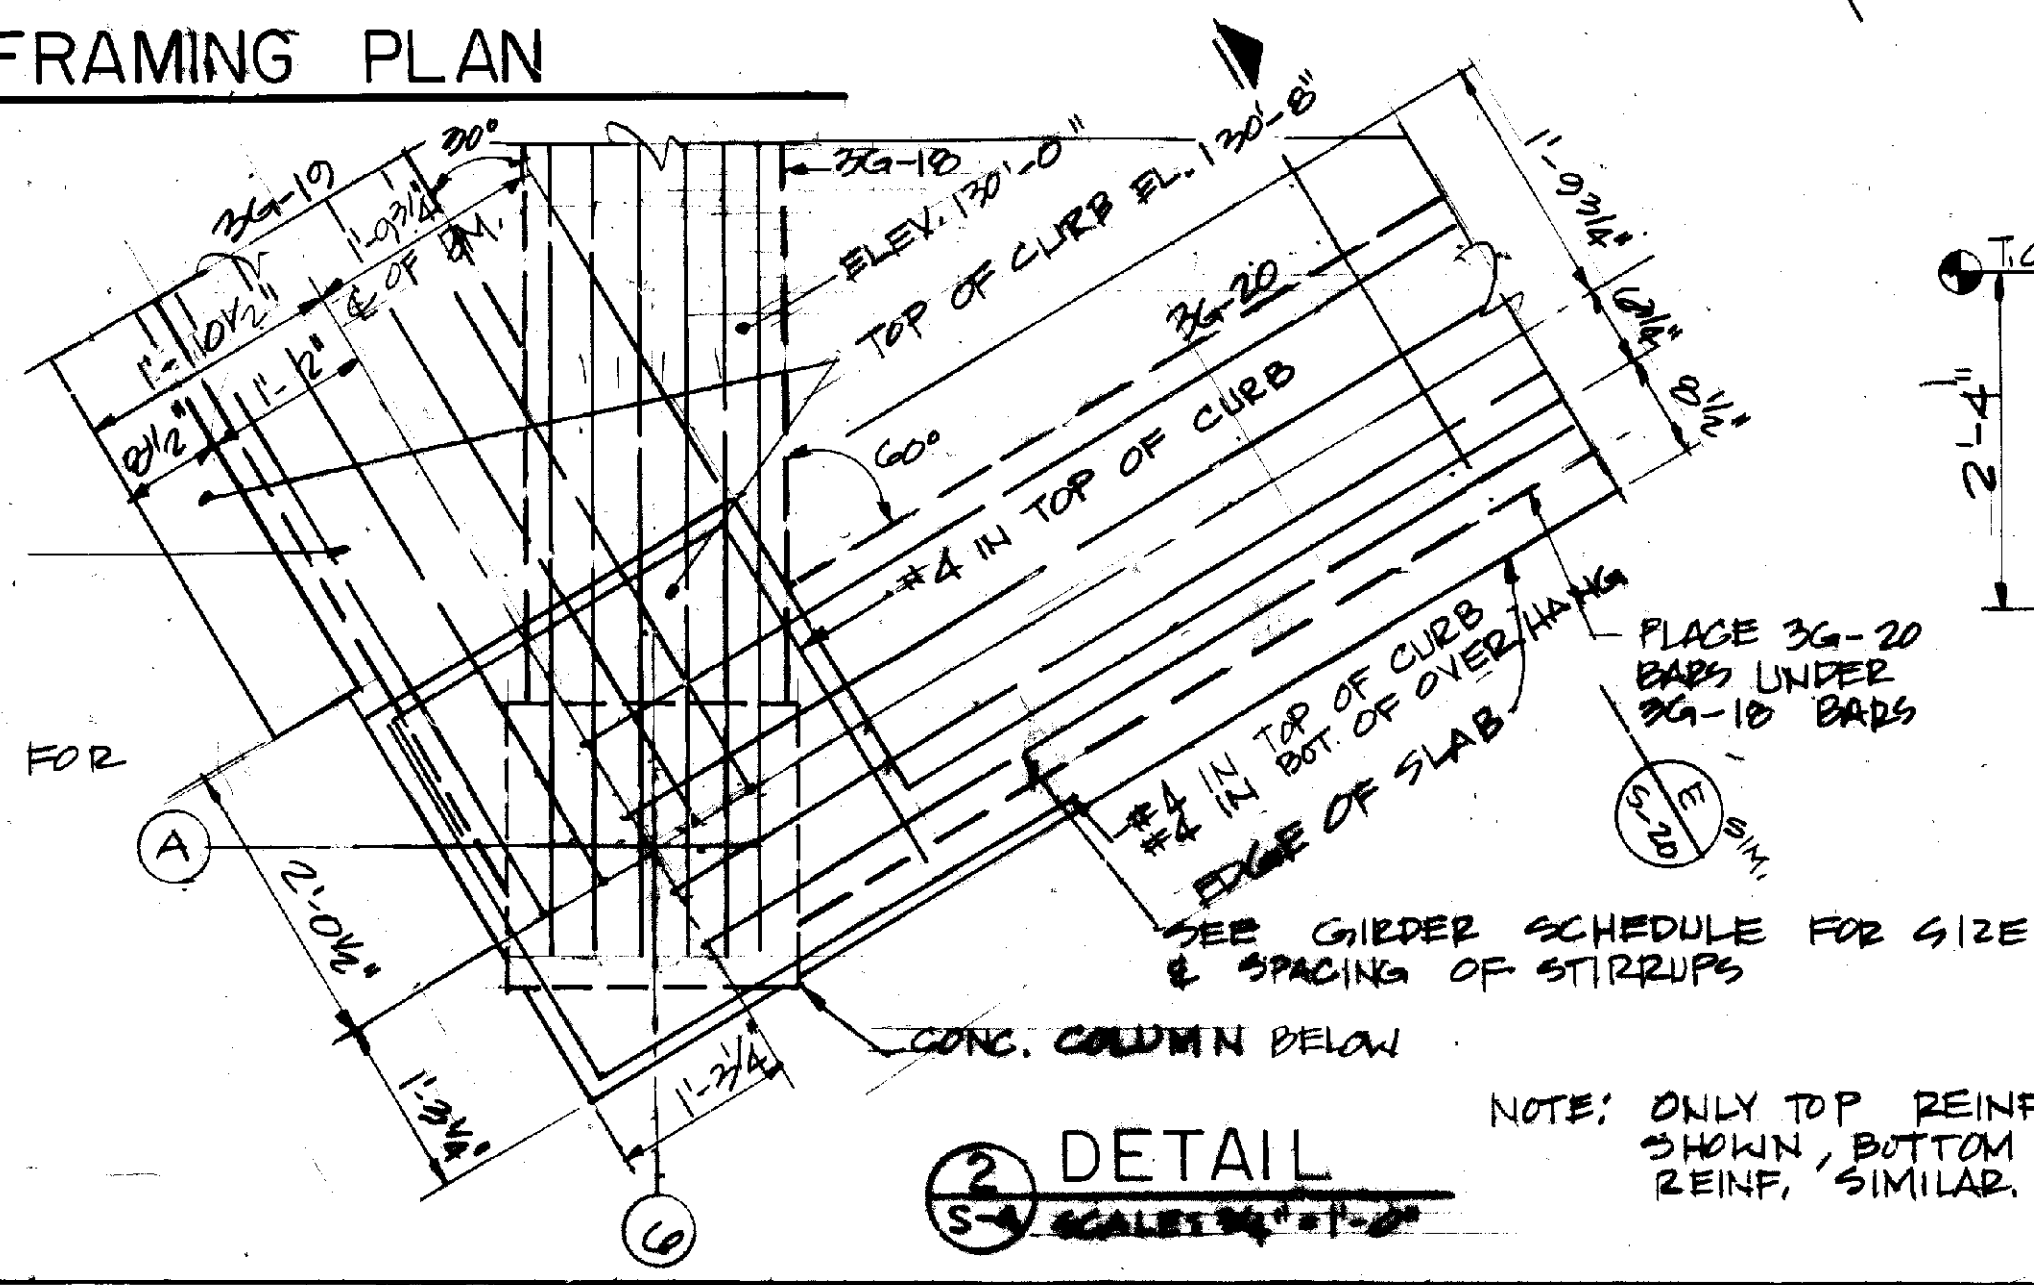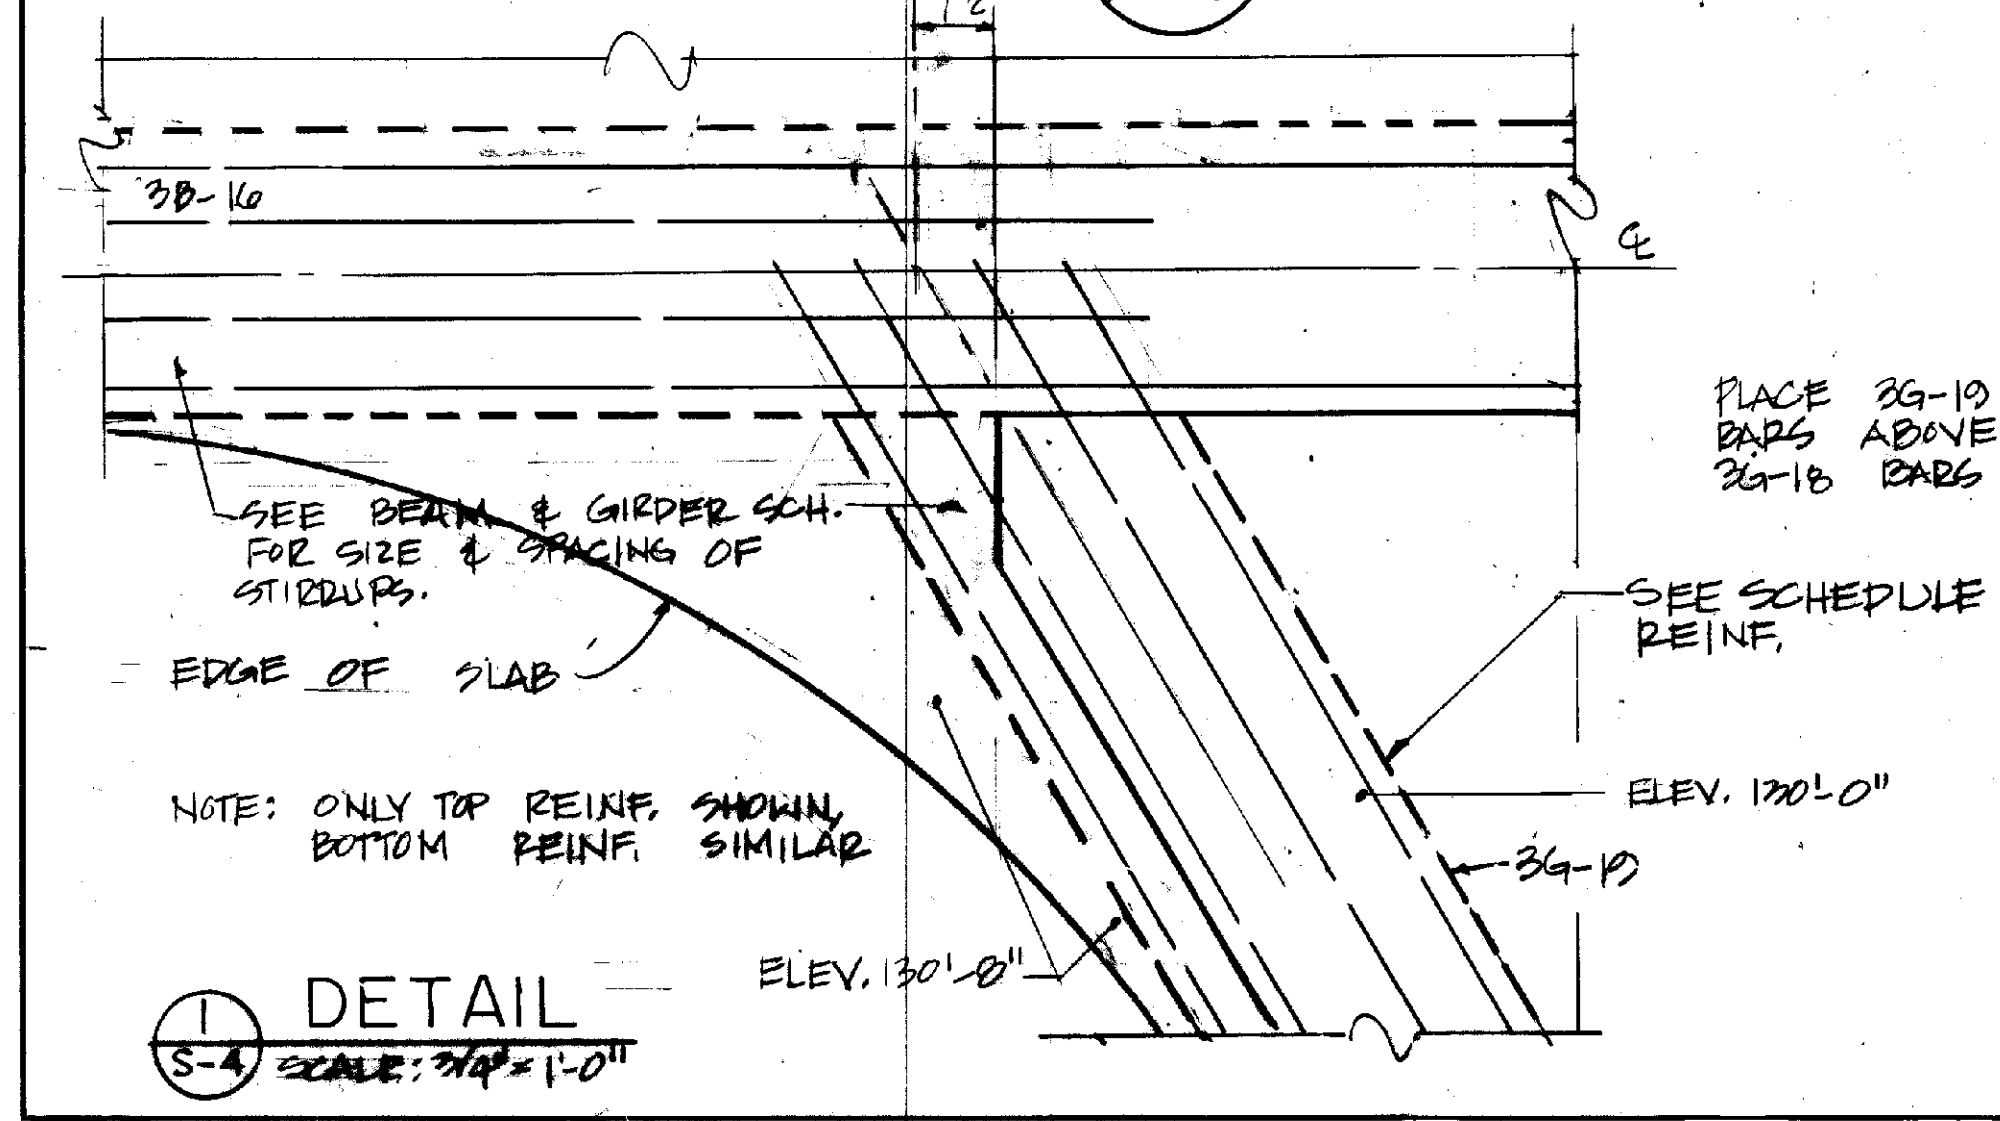


SECTION A-S-4
SCALE: 3/4" = 1'-0"

SECTION B-S-4
SCALE: 3/4" = 1'-0"

RECORD PRINTS

THESE ARE RECORD PRINTS OF DRAWINGS BASED UPON MARKED UP PRINTS, DRAWINGS AND OTHER DATA FURNISHED BY THE CONTRACTOR TO THE ENGINEER AND WHICH THE ENGINEER CONSIDERS SIGNIFICANT.

MASON & HANGER ENGINEERING INC.
ARCHITECT • ENGINEERS
LEXINGTON, KENTUCKY

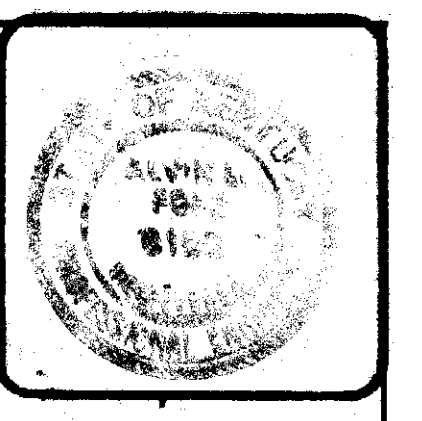

ROBOTICS FACILITY
LEXINGTON CAMPUS
UNIVERSITY OF KENTUCKY
LEXINGTON, KENTUCKY

University of Kentucky
Lexington, Kentucky

Sherman Carter Barnhart
PARTNERS IN ARCHITECTURE
SOUTH BLDG. • 250 WEST MAIN STREET • LEXINGTON, KY. 40508 • 606-254-1331

THIRD FLOOR FRAMING PLAN


Sherman Carter Barnhart
PARTNERS IN ARCHITECTURE
SOUTH BLDG. • 250 WEST MAIN STREET • LEXINGTON, KY. 40508 • 606-254-1331

JOB NO. 2046
DATE 10-19-87
DRAWN M.A.A.
CHECKED A.L.P.
FILE NO. 4710

NO.	REVISIONS

SHEET


1

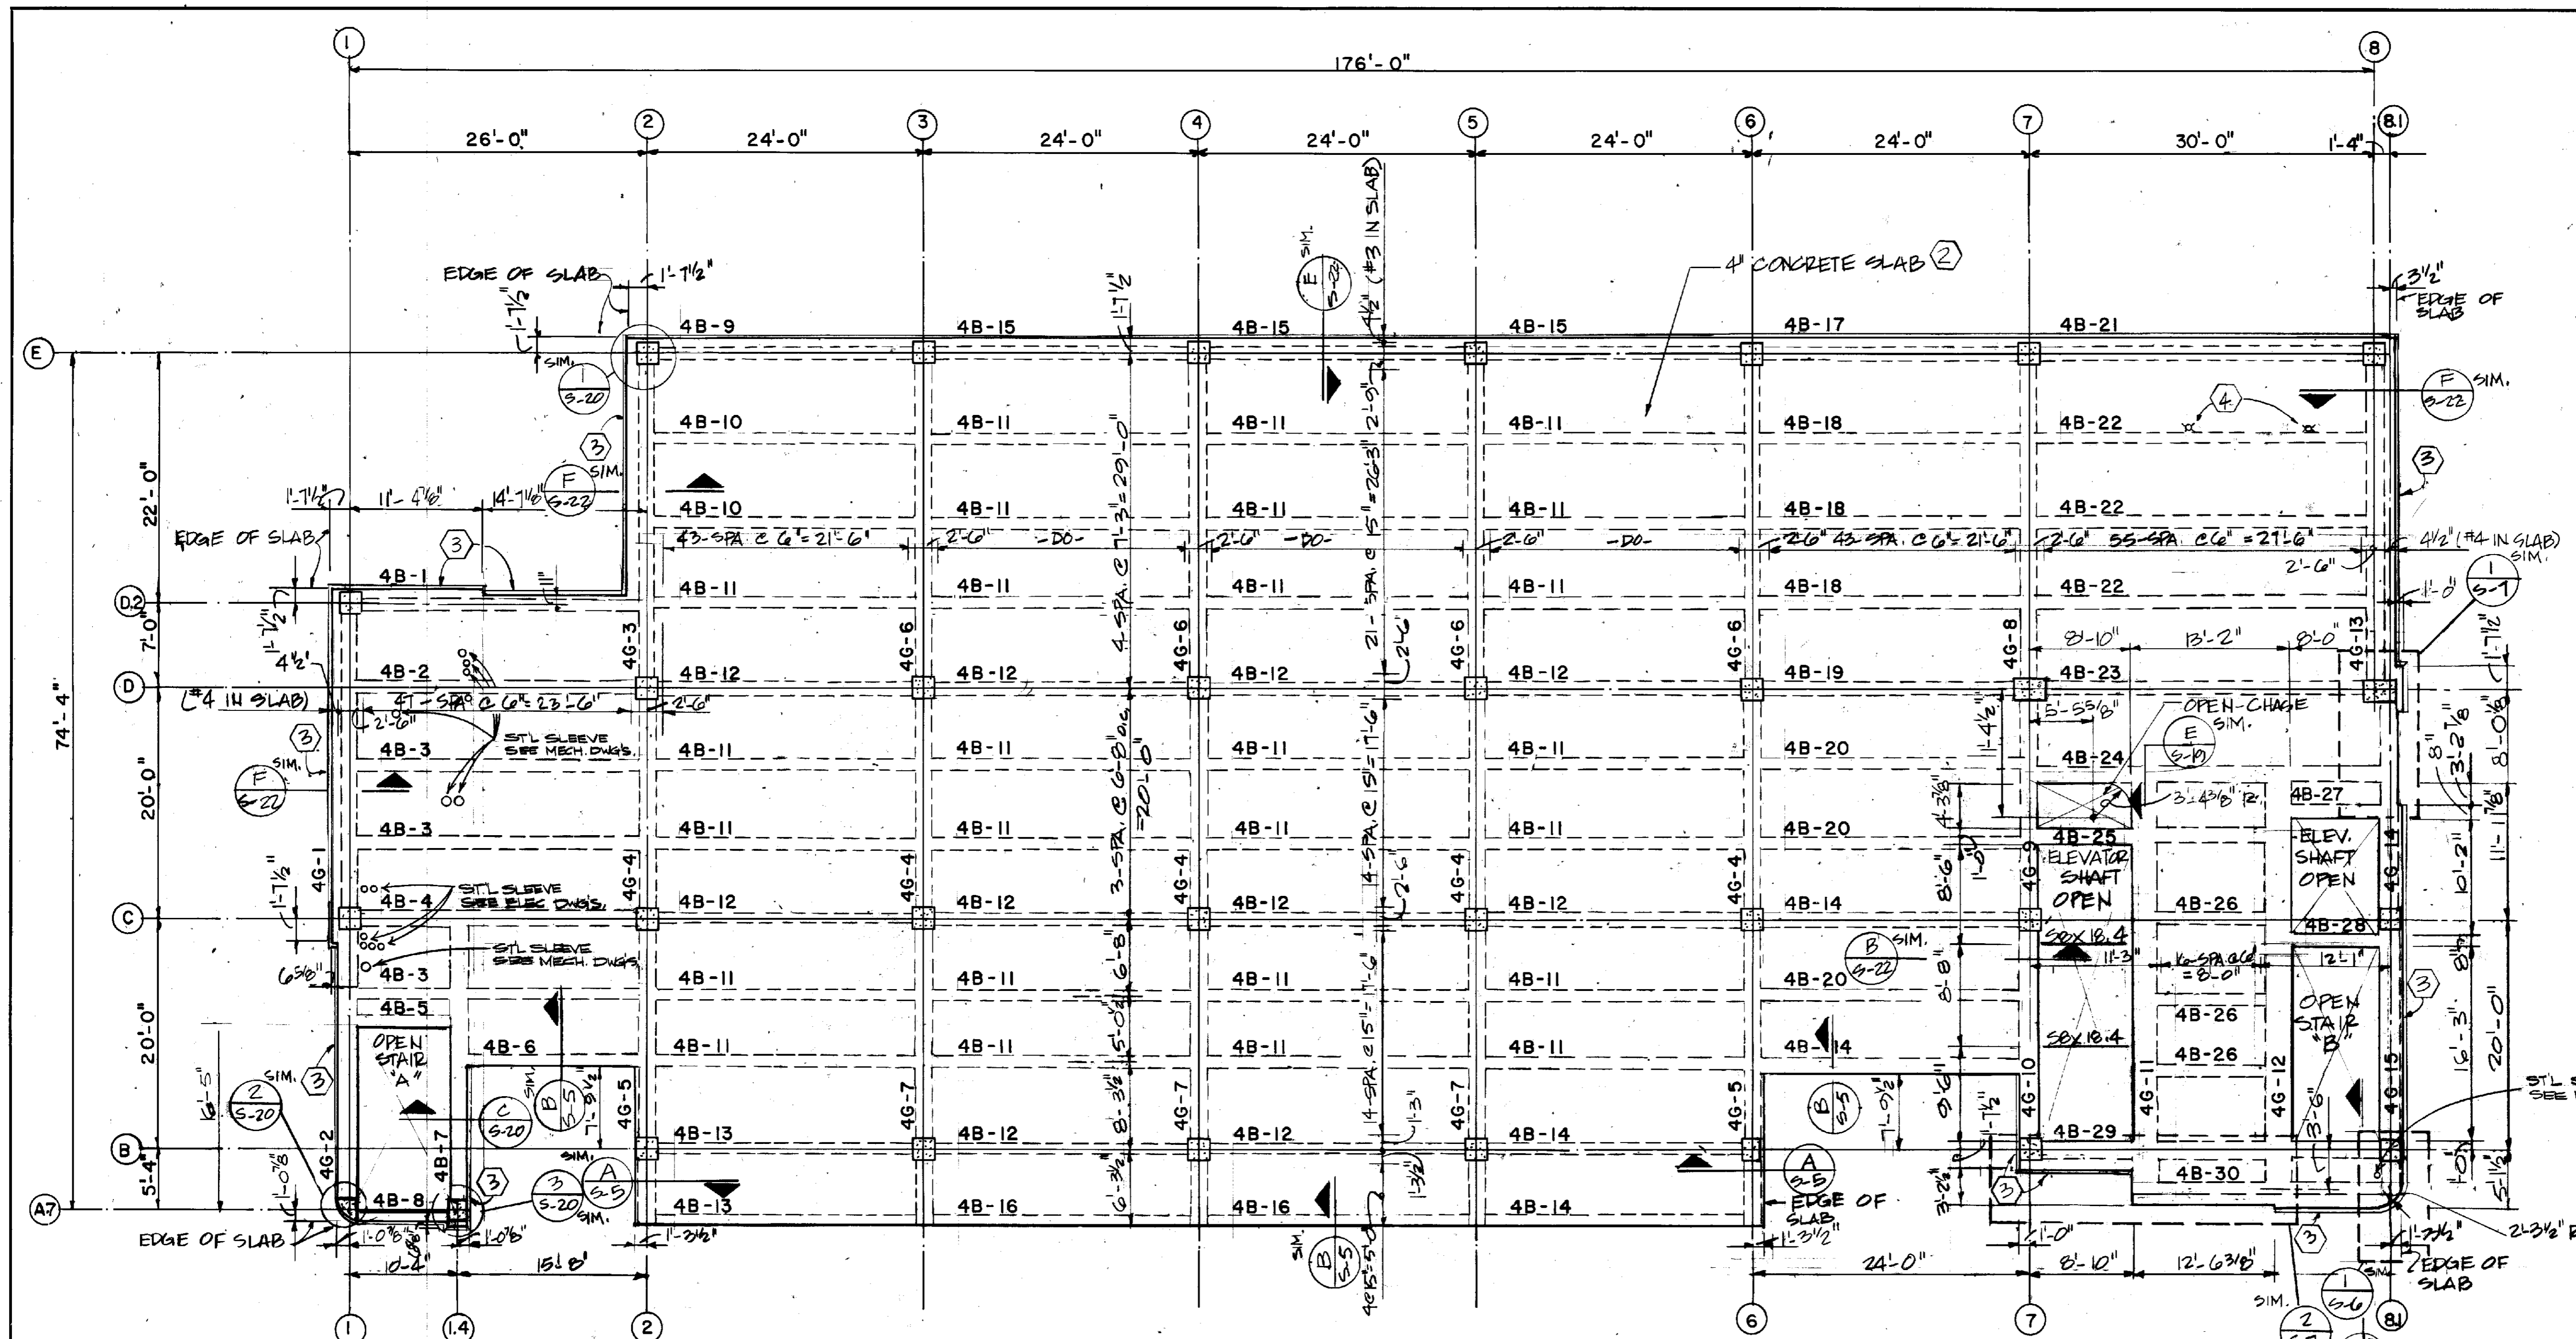

- S-5 NOTES
- ① SEE SHEET S-1 FOR GENERAL NOTES.
 - ② SLAB REINFORCING IS #4 @6" NORTH-SOUTH IN CENTER OF SLAB. EAST-WEST TEMPERATURE STEEL IS #3 @ 15" ABOVE THE MAIN REINF. PROVIDE ADDITIONAL REBAR AT BUILDING PERIMETER AS INDICATED.
 - ③ SHELF ANGLE 4 X 4 X 5/16. SUPPORT WITH CAST IN DUCTILE IRON WEDGE INSERTS WITH 3/4" ASKEW HEAD BOLT MITER ANGLES AT CORNERS.
 - ④ FLOOR DRAIN. DEPRESS 1/2 INCH BELOW FINISHED FLOOR AND TRANSITION SLAB ELEVATION IN A 3 FOOT DIAMETER CIRCLE. SEE MECHANICAL.

NOTE: TOP OF STRUCTURAL SLAB EL. 146'-0" UNLESS OTHERWISE NOTED

FOURTH FLOOR FRAMING PLAN
SCALE: 1/8" = 1'-0"

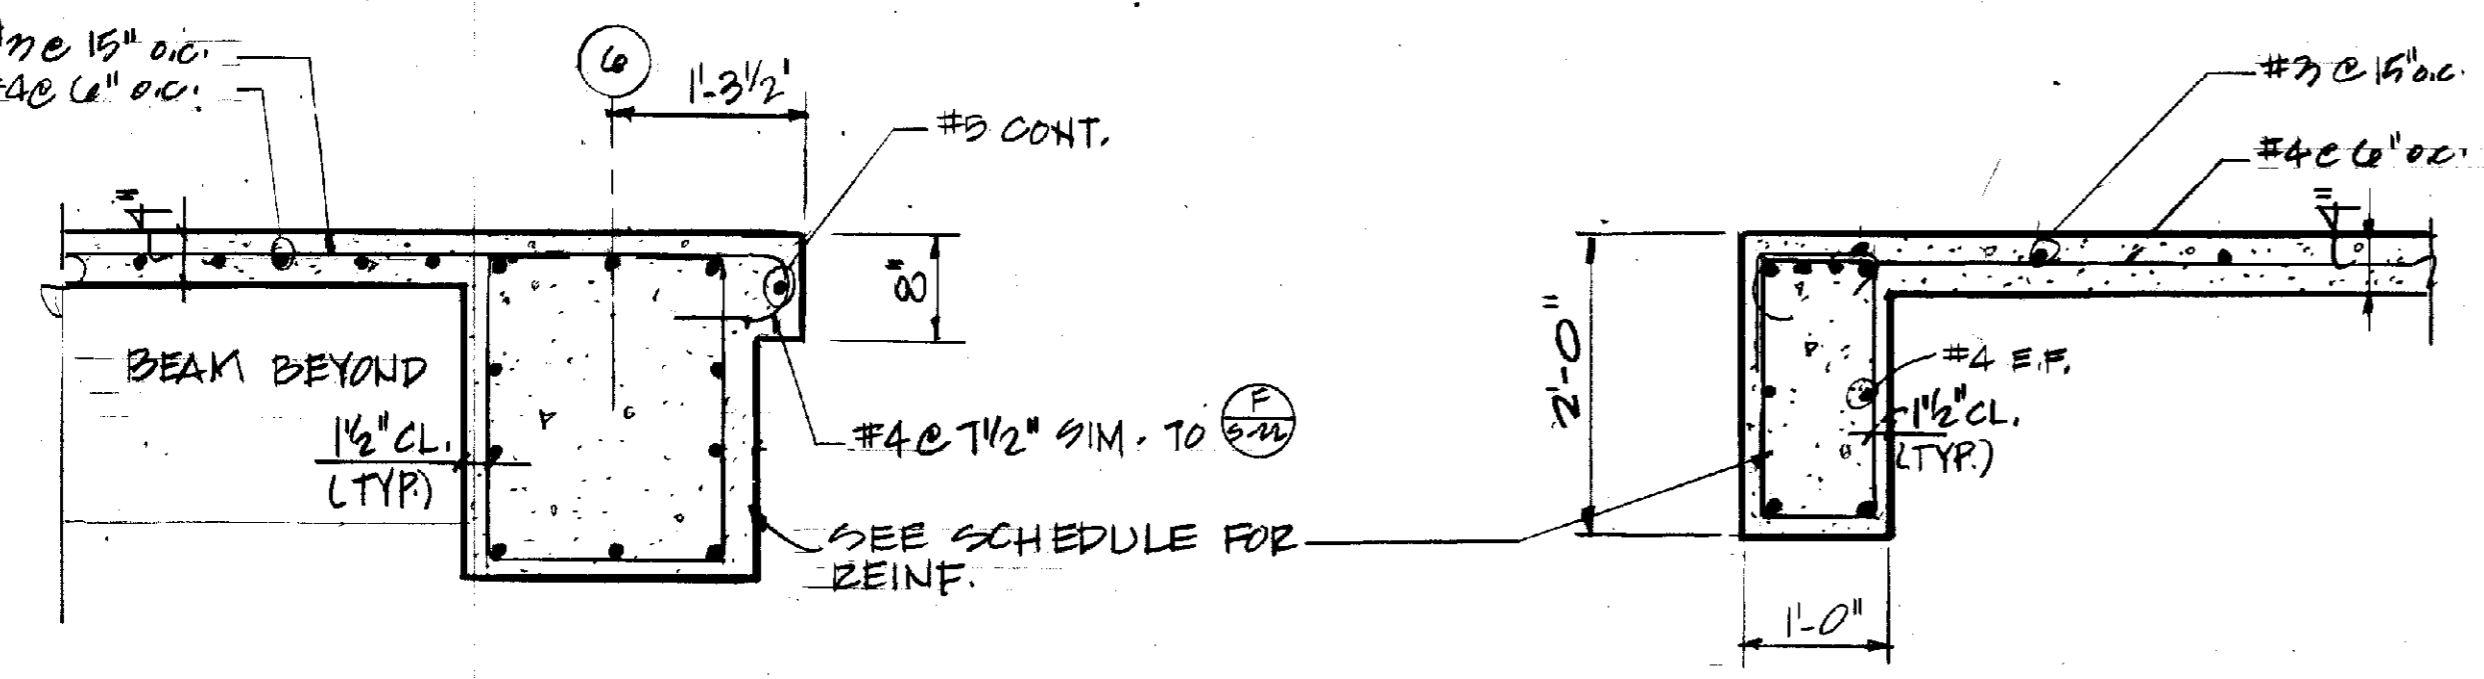

A SECTION
SCALE: 3/4" = 1'-0"

B SECTION
SCALE: 3/4" = 1'-0"

RECORD PRINTS
THESE ARE RECORD PRINTS OF DRAWINGS BASED UPON MARKED UP PRINTS, DRAWINGS AND OTHER DATA FURNISHED BY THE CONTRACTOR TO THE ENGINEER AND WHICH THE ENGINEER CONSIDERS SIGNIFICANT

FOURTH FLOOR FRAMING PLAN

Sherman-Carter-Barnhart
PARTNERS IN ARCHITECTURE
SUITE 1800 - 750 WEST MAIN STREET - LEXINGTON, KY 40502 - 502-243-1232

JOB NO. 2046
DATE: 10-10-81
DRAWN: M.A.A.
CHECKED: A.L.P.
FILE NO. 431.0

REVISIONS

SHEET

S-5

MASON & HANGER ENGINEERING INC.
ARCHITECT • ENGINEERS
LEXINGTON, KENTUCKY

ROBOTICS FACILITY
LEXINGTON CAMPUS
UNIVERSITY OF KENTUCKY
LEXINGTON, KENTUCKY

University of Kentucky
Lexington, Kentucky

Sherman-Carter-Barnhart
PARTNERS IN ARCHITECTURE
SUITE 1800 - 750 WEST MAIN STREET - LEXINGTON, KY 40502 - 502-243-1232


JOB NO. 2046
DATE: 10-10-81
DRAWN: M.A.A.
CHECKED: A.L.P.
FILE NO. 431.0

REVISIONS

SHEET


S-5

MASON & HANGER ENGINEERING INC.
ARCHITECT • ENGINEERS
LEXINGTON, KENTUCKY

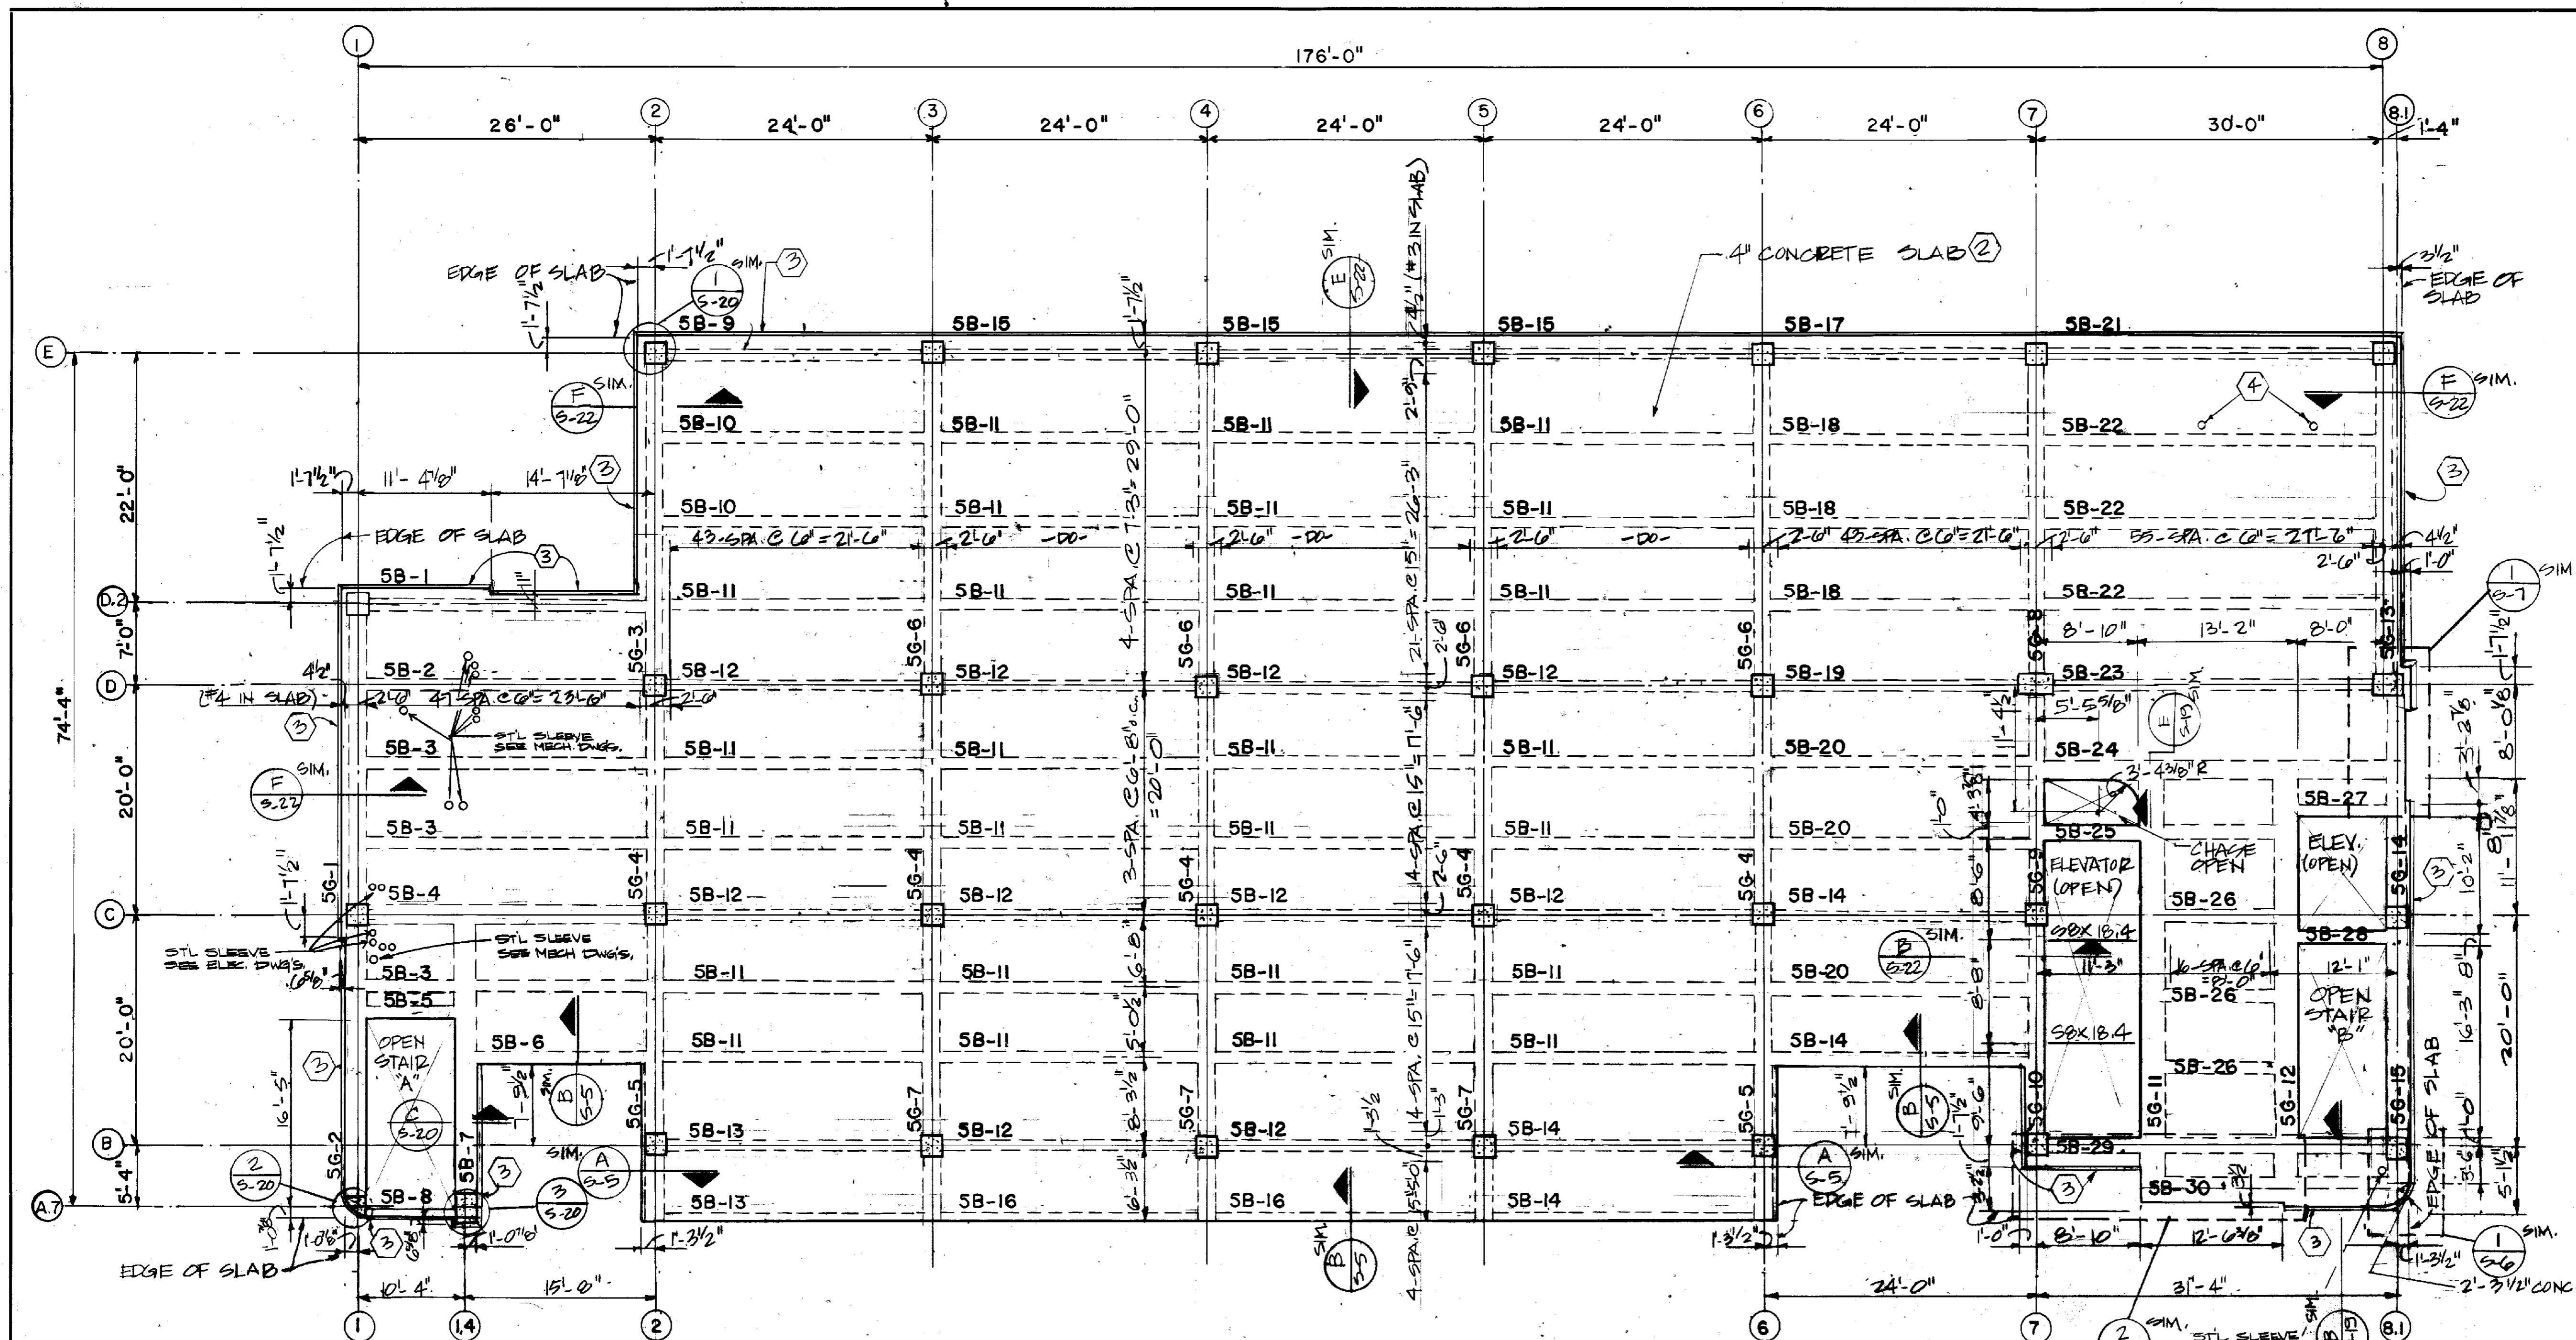

- 5-6 NOTES
- 1 SEE SHEET S-1 FOR GENERAL NOTES.
 - 2 SLAB REINFORCING IS #4 @6" NORTH-SOUTH IN CENTER OF SLAB. EAST-WEST TEMPERATURE STEEL IS #3 @ 15" ABOVE THE MAIN REINF. PROVIDE ADDITIONAL REBAR AT BUILDING PERIMETER AS INDICATED.
 - 3 SHELF ANGLE 4 X 4 X 5/16. SUPPORT WITH CAST IN DUCTILE IRON WEDGE INSERTS WITH 3/4" Ø ASKED HEAD BOLT MITER ANGLES AT CORNERS.
 - 4 FLOOR DRAIN. DEPRESS 1/2 INCH BELOW FINISHED FLOOR AND TRANSITION ON SLAB ELEVATION IN A 3 FOOT DIAMETER CIRCLE. SEE MECHANICAL.

FIFTH FLOOR FRAMING PLAN
SCALE: 1/8" = 1'-0"

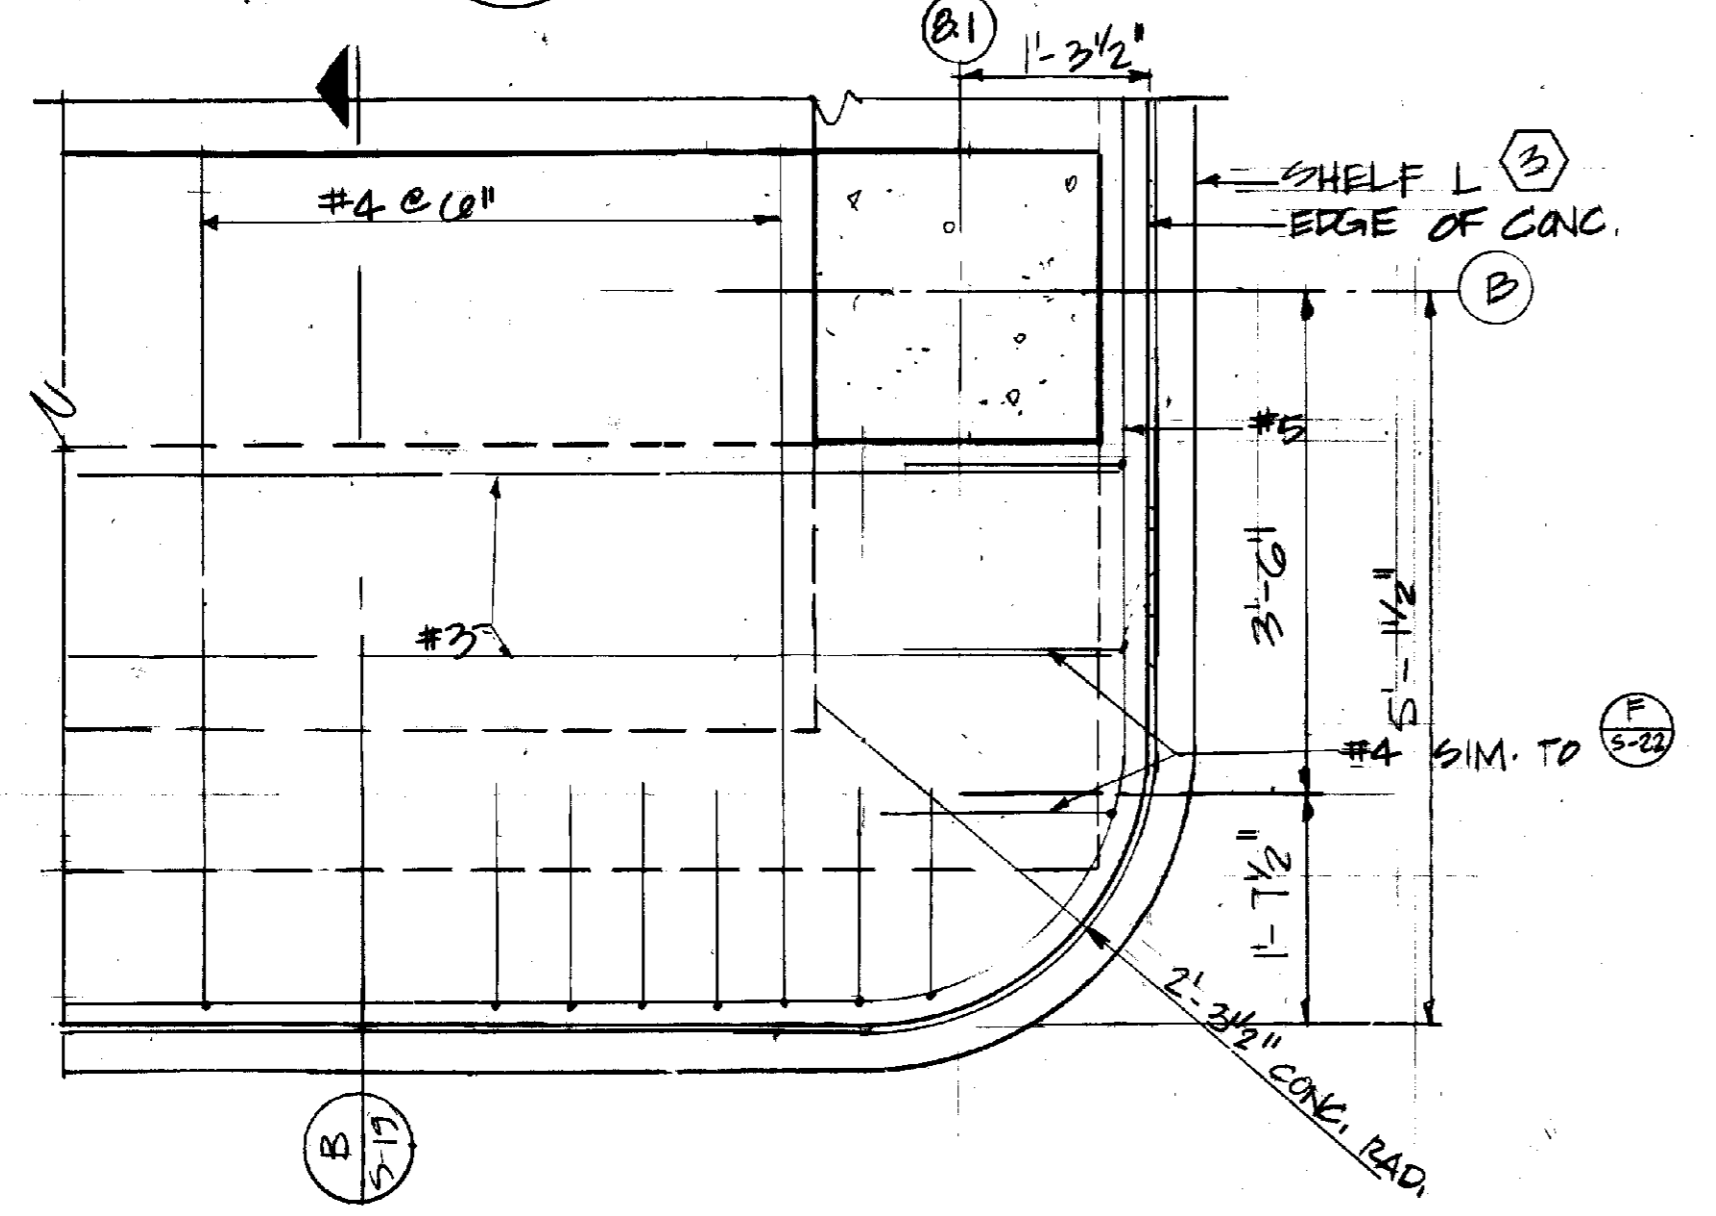

1 DETAIL
5-6 SCALE: 3/4" = 1'-0"



ROBOTICS FACILITY
LEXINGTON CAMPUS
UNIVERSITY OF KENTUCKY
LEXINGTON, KENTUCKY

University of Kentucky
Lexington, Kentucky
Shelton Carter Barnhart
ARCHITECT


FIFTH FLOOR FRAMING PLAN
Shelton Carter Barnhart
PARTNERS IN ARCHITECTURE
SUITE 100 • 250 WEST MAIN STREET • LEXINGTON, KY 40502-1000

JOB NO.	2046
DATE	10-19-01
DRAWN	M.A.A.
CHECKED	A.L.P.
FILE NO.	431.0



NO.	REVISIONS

RECORD PRINTS
THESE ARE RECORD PRINTS OF DRAWINGS BASED UPON MARKED UP PRINTS, DRAWINGS AND OTHER DATA FURNISHED BY THE CONTRACTOR TO THE ENGINEER AND WHICH THE ENGINEER CONSIDERS SIGNIFICANT.

MASON & HANGER ENGINEERING INC.
ARCHITECT • ENGINEERS
LEXINGTON, KENTUCKY

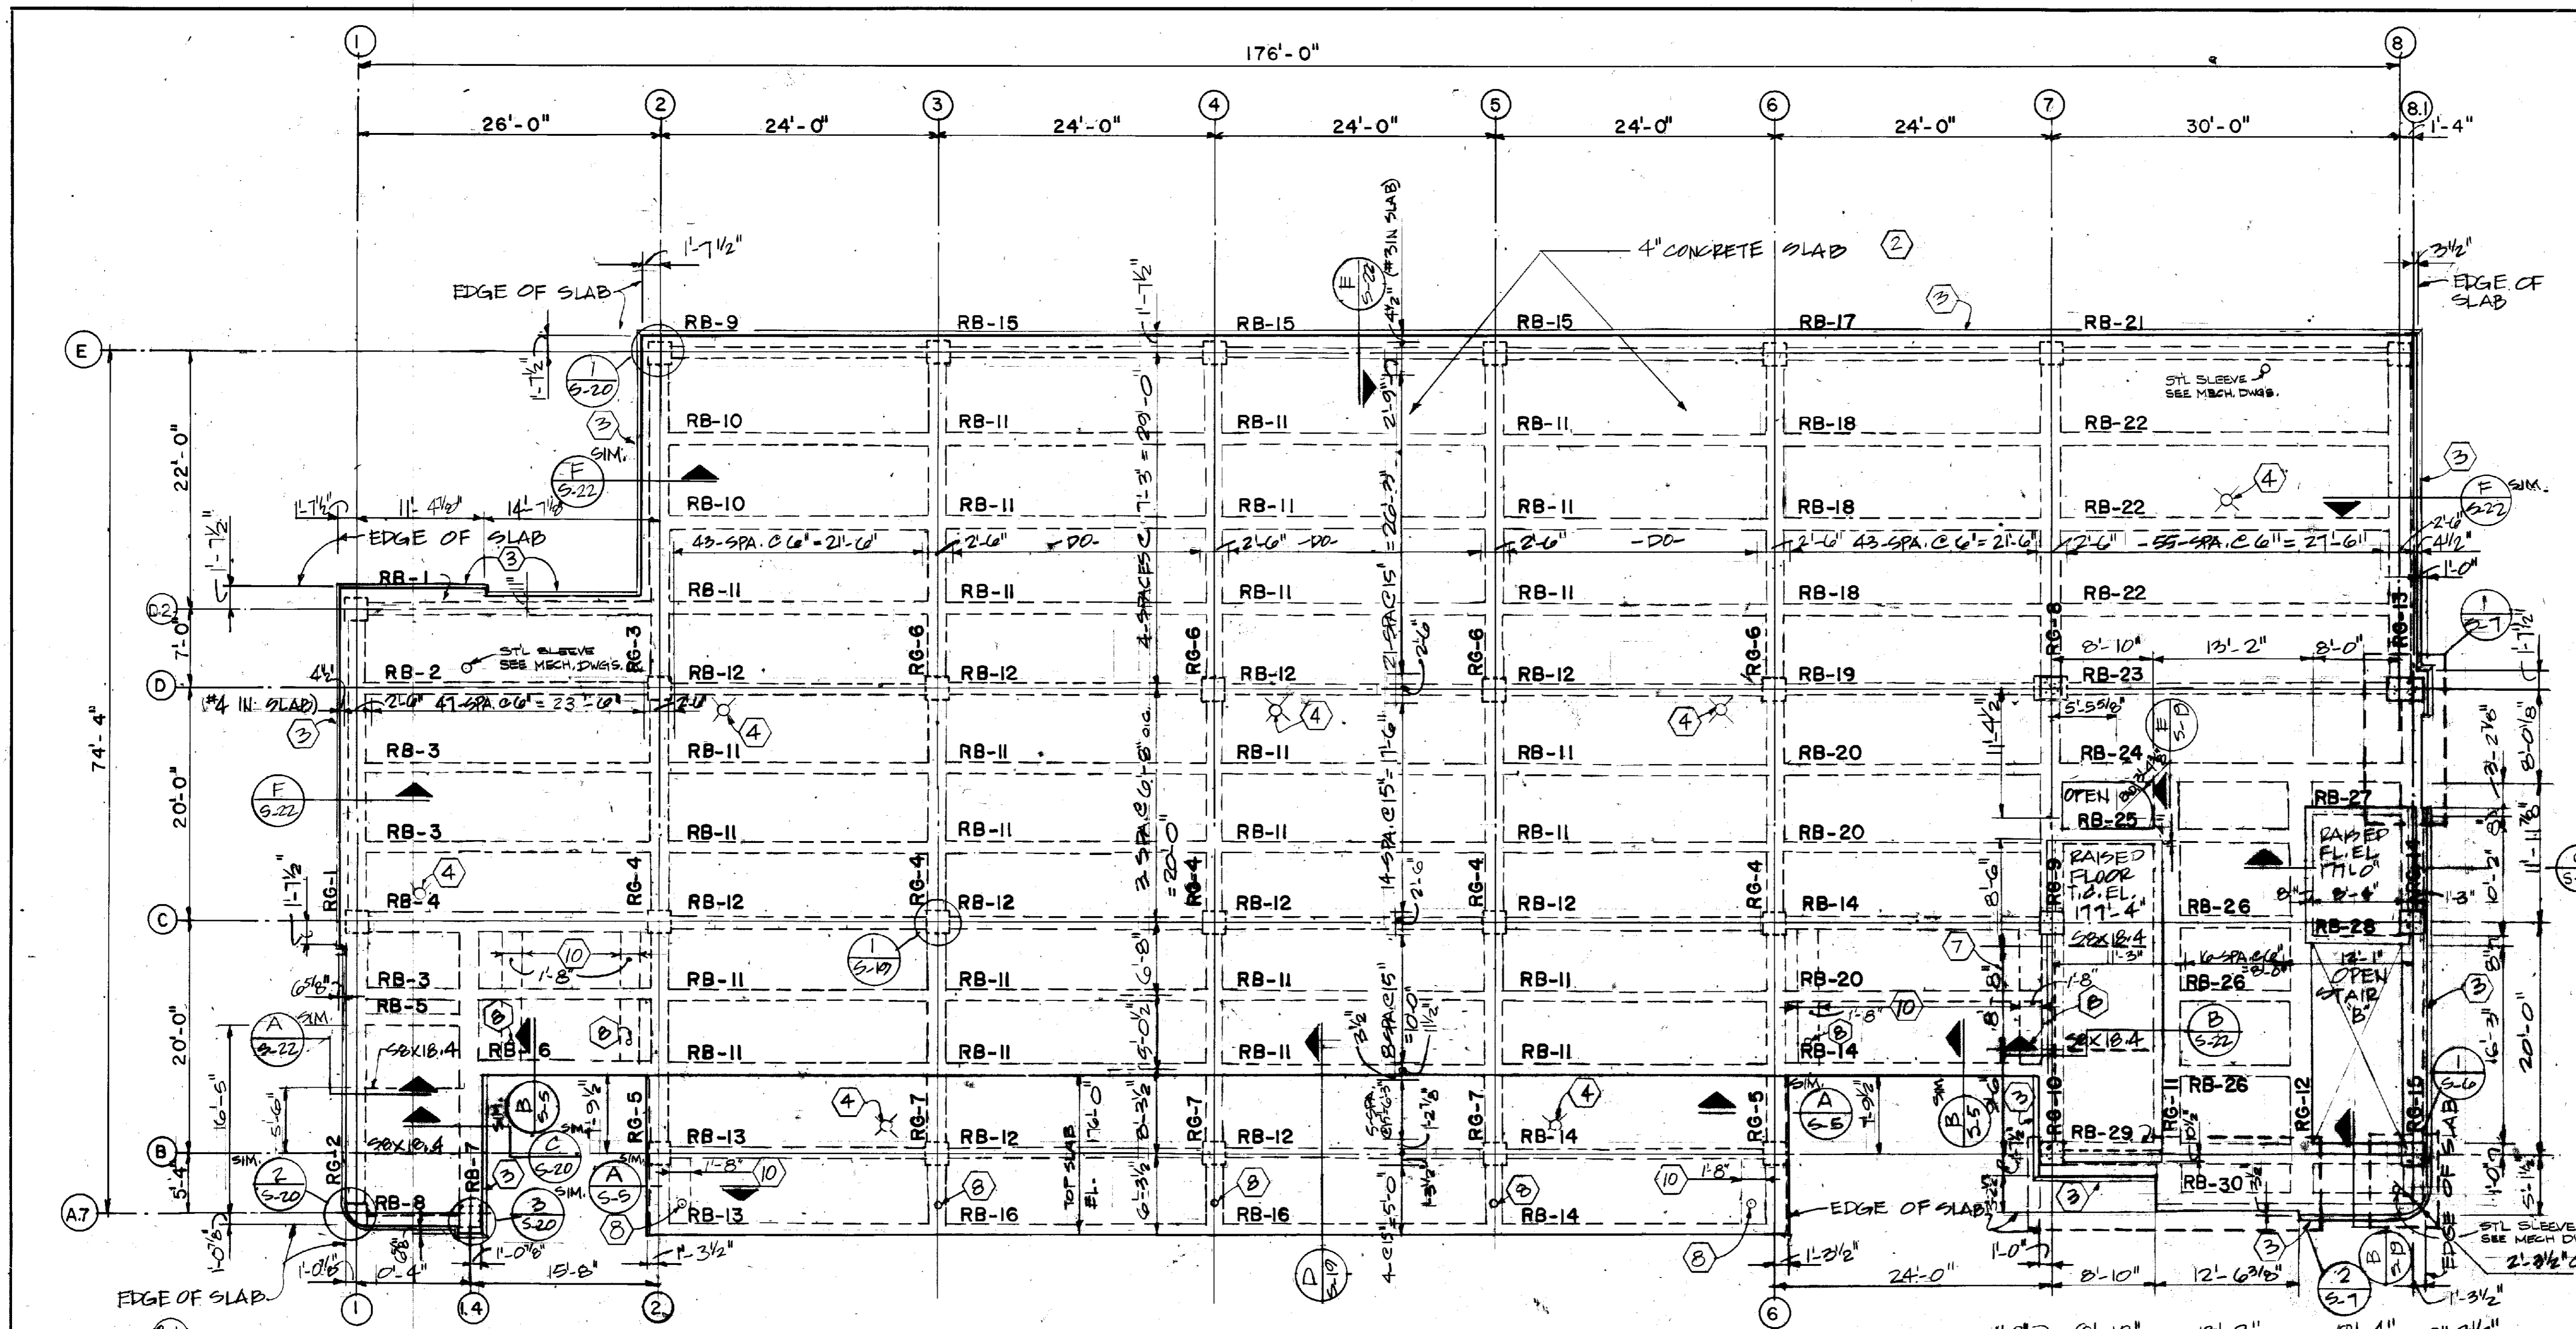


- 5-7 NOTES
- 1 SEE SHEET S-1 FOR GENERAL NOTES.
 - 2 SLAB REINFORCING IS #4 @6" NORTH-SOUTH IN CENTER OF SLAB. EAST-WEST TEMPERATURE STEEL IS #3 @ 16" ABOVE THE MAIN REINF. PROVIDE ADDITIONAL REBAR AT BUILDING PERIMETER AS INDICATED.
 - 3 SHELF ANGLE 4 X 4 X 5/16. SUPPORT WITH CAST IN DUCTILE IRON WEDGE INSERTS WITH 3/4" ASKED HEAD BOLT MITER ANGLES AT CORNERS.
 - 4 ROOF DRAIN FLUSH WITH TOP OF STRUCTURE SLAB. SEE MECHANICAL.
 - 5 HOIST BEAM 23'2" LONG. PROVIDE L3 X 3 X 1/4 TROLLEY STOP ON BOTH SIDES OF BEAM AT BOTH ENDS.
 - 6 TO FACILITATE ADDING 2 MORE STORIES TO THE BUILDING IN THE FUTURE, AT EACH COLUMN PROVIDE THREADED DOWELS AND STRAIGHT REBAR COUPLERS FOR EACH COLUMN REBAR. INCREASE DOWEL BAR SIZE AS REQUIRED TO DEVELOP 125% OF A CLASS A TENSION SPLICE AT THE ROOT OF THE THREADS AND POSITION THE DOWELS SO THAT FUTURE COLUMN REBARS CAN ALIGN WITH THE REBARS AT THE TOP OF THE PRESENT COLUMNS.
 - 7 COORDINATE WITH ELEVATOR EQUIPMENT FURNISHED.
 - 8 WINDOW WASHING ANCHORS. SEE ARCHITECTURAL.
 - 9 THICKEN SLAB TO 12 INCHES WITH #4@12 IN BOTTOM.
 - 10 12 INCH DEEP BEAM WITH #5 TOP AND BOTTOM. #3 STIRRUPS @ 12. CENTER BEAM UNDER WINDOW WASHING ANCHOR.

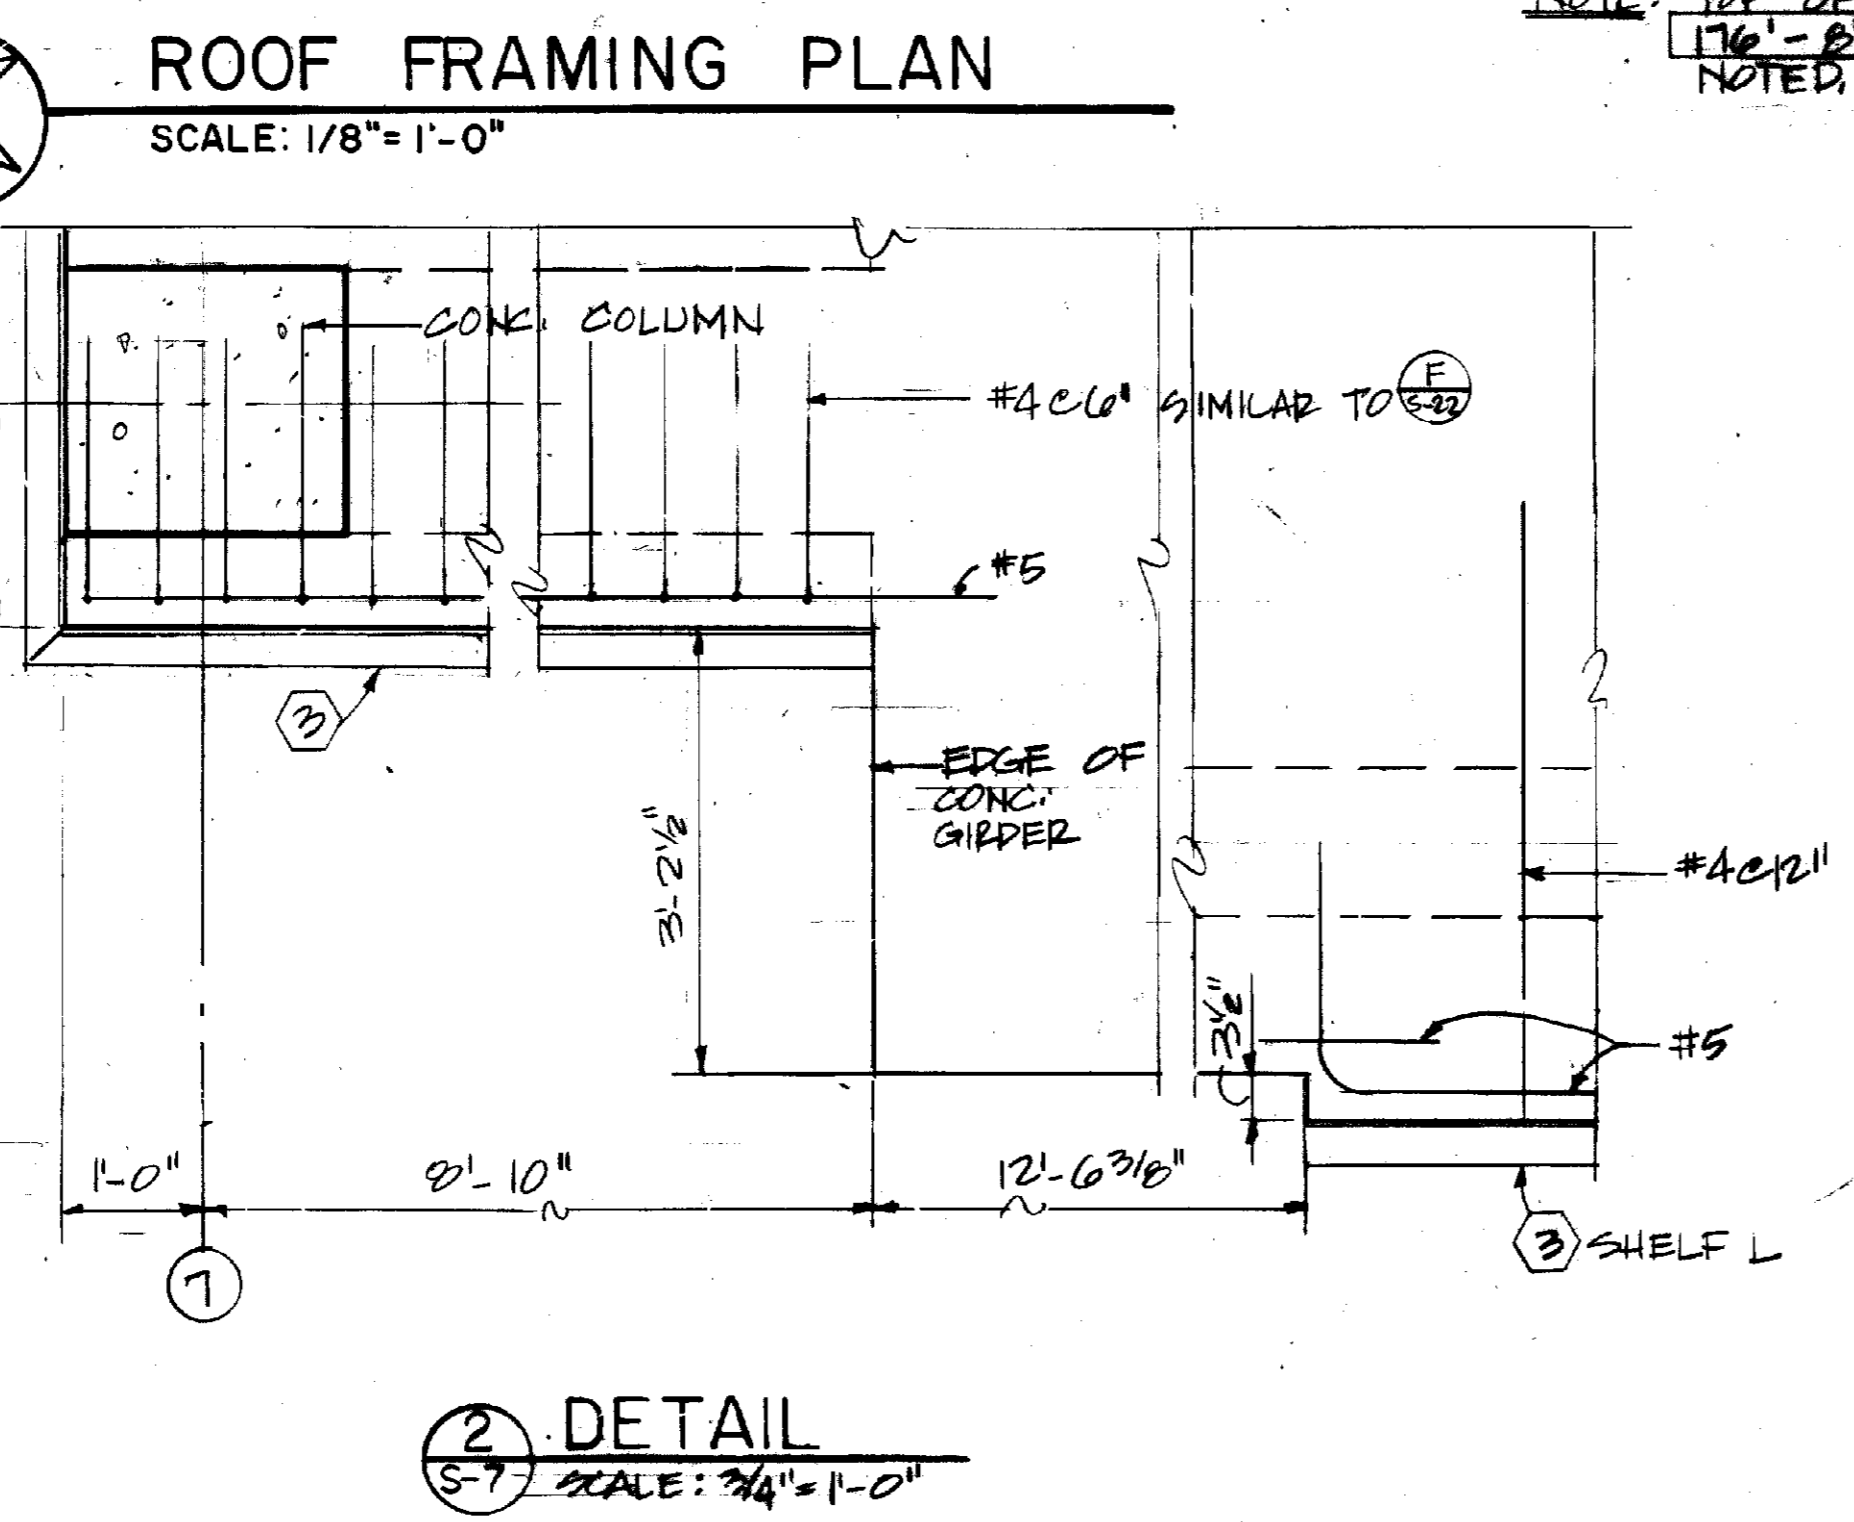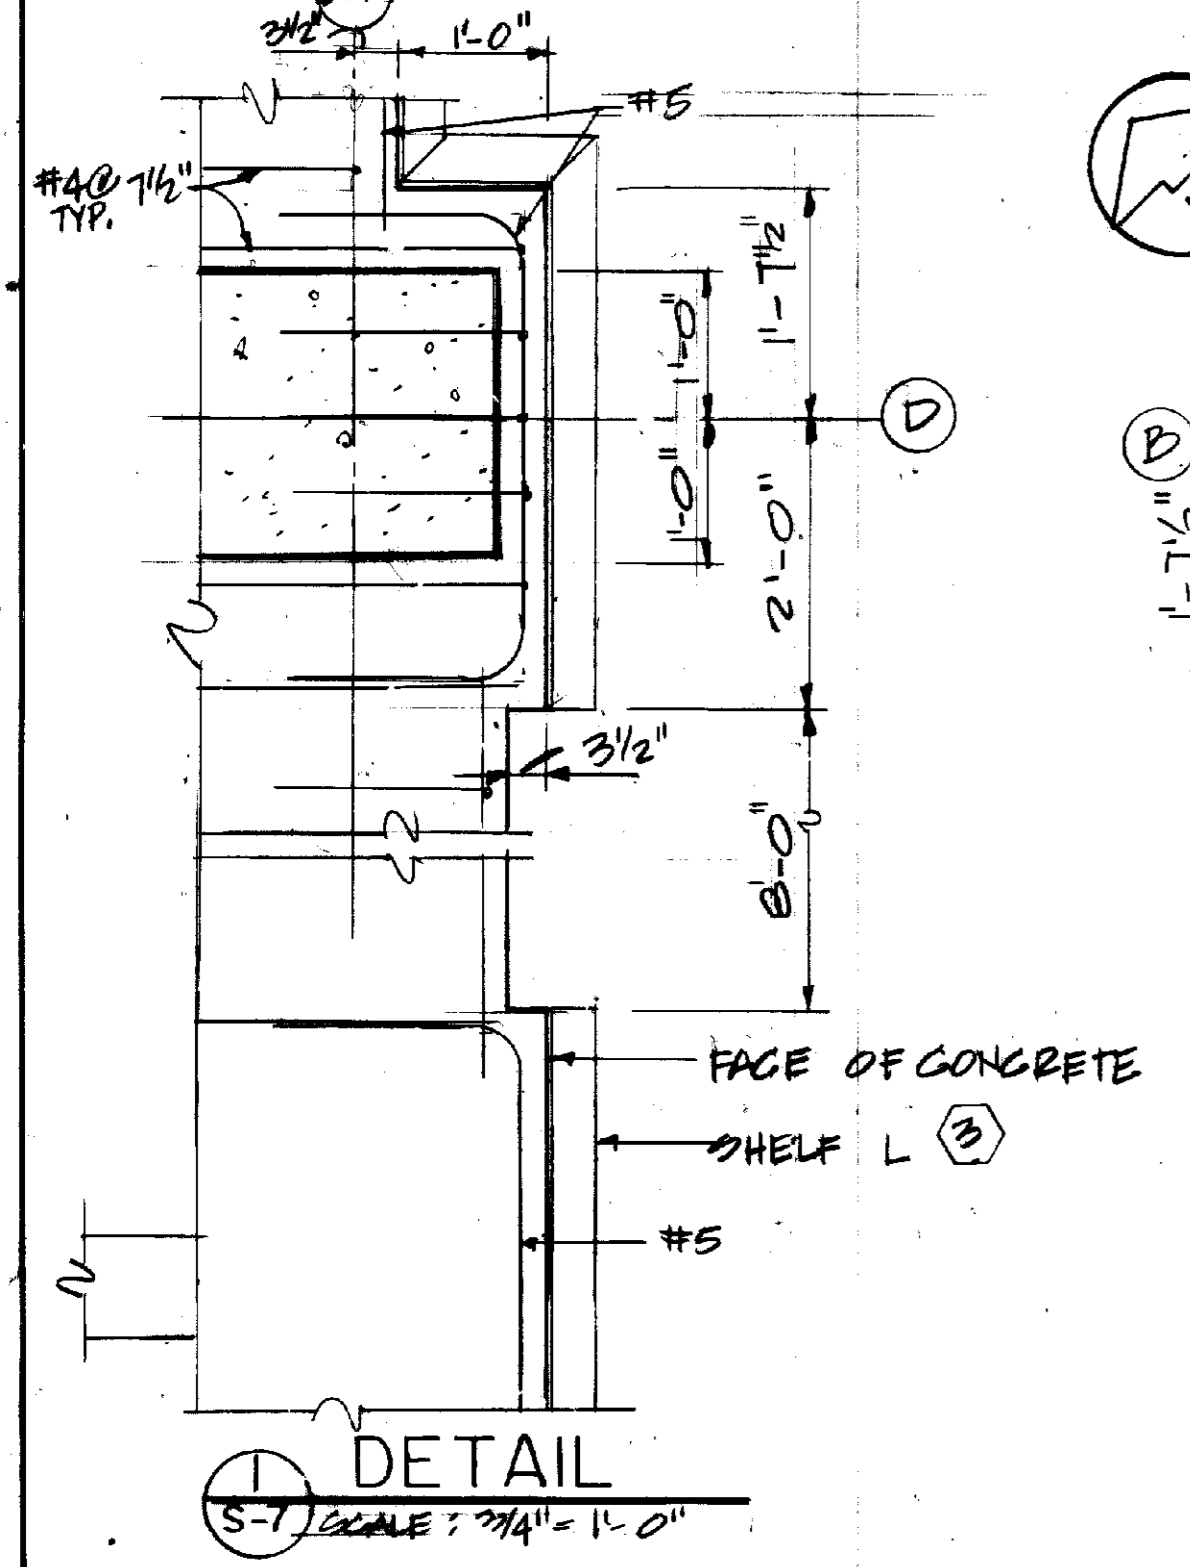


NOTE: TOP OF STRUCTURAL SLAB EL. 176'-0" UNLESS OTHERWISE NOTED.

NOTE: TOP OF PENTHOUSE ROOF STRUCTURAL SLAB ELEV. 192'-0" UNLESS OTHERWISE NOTED.

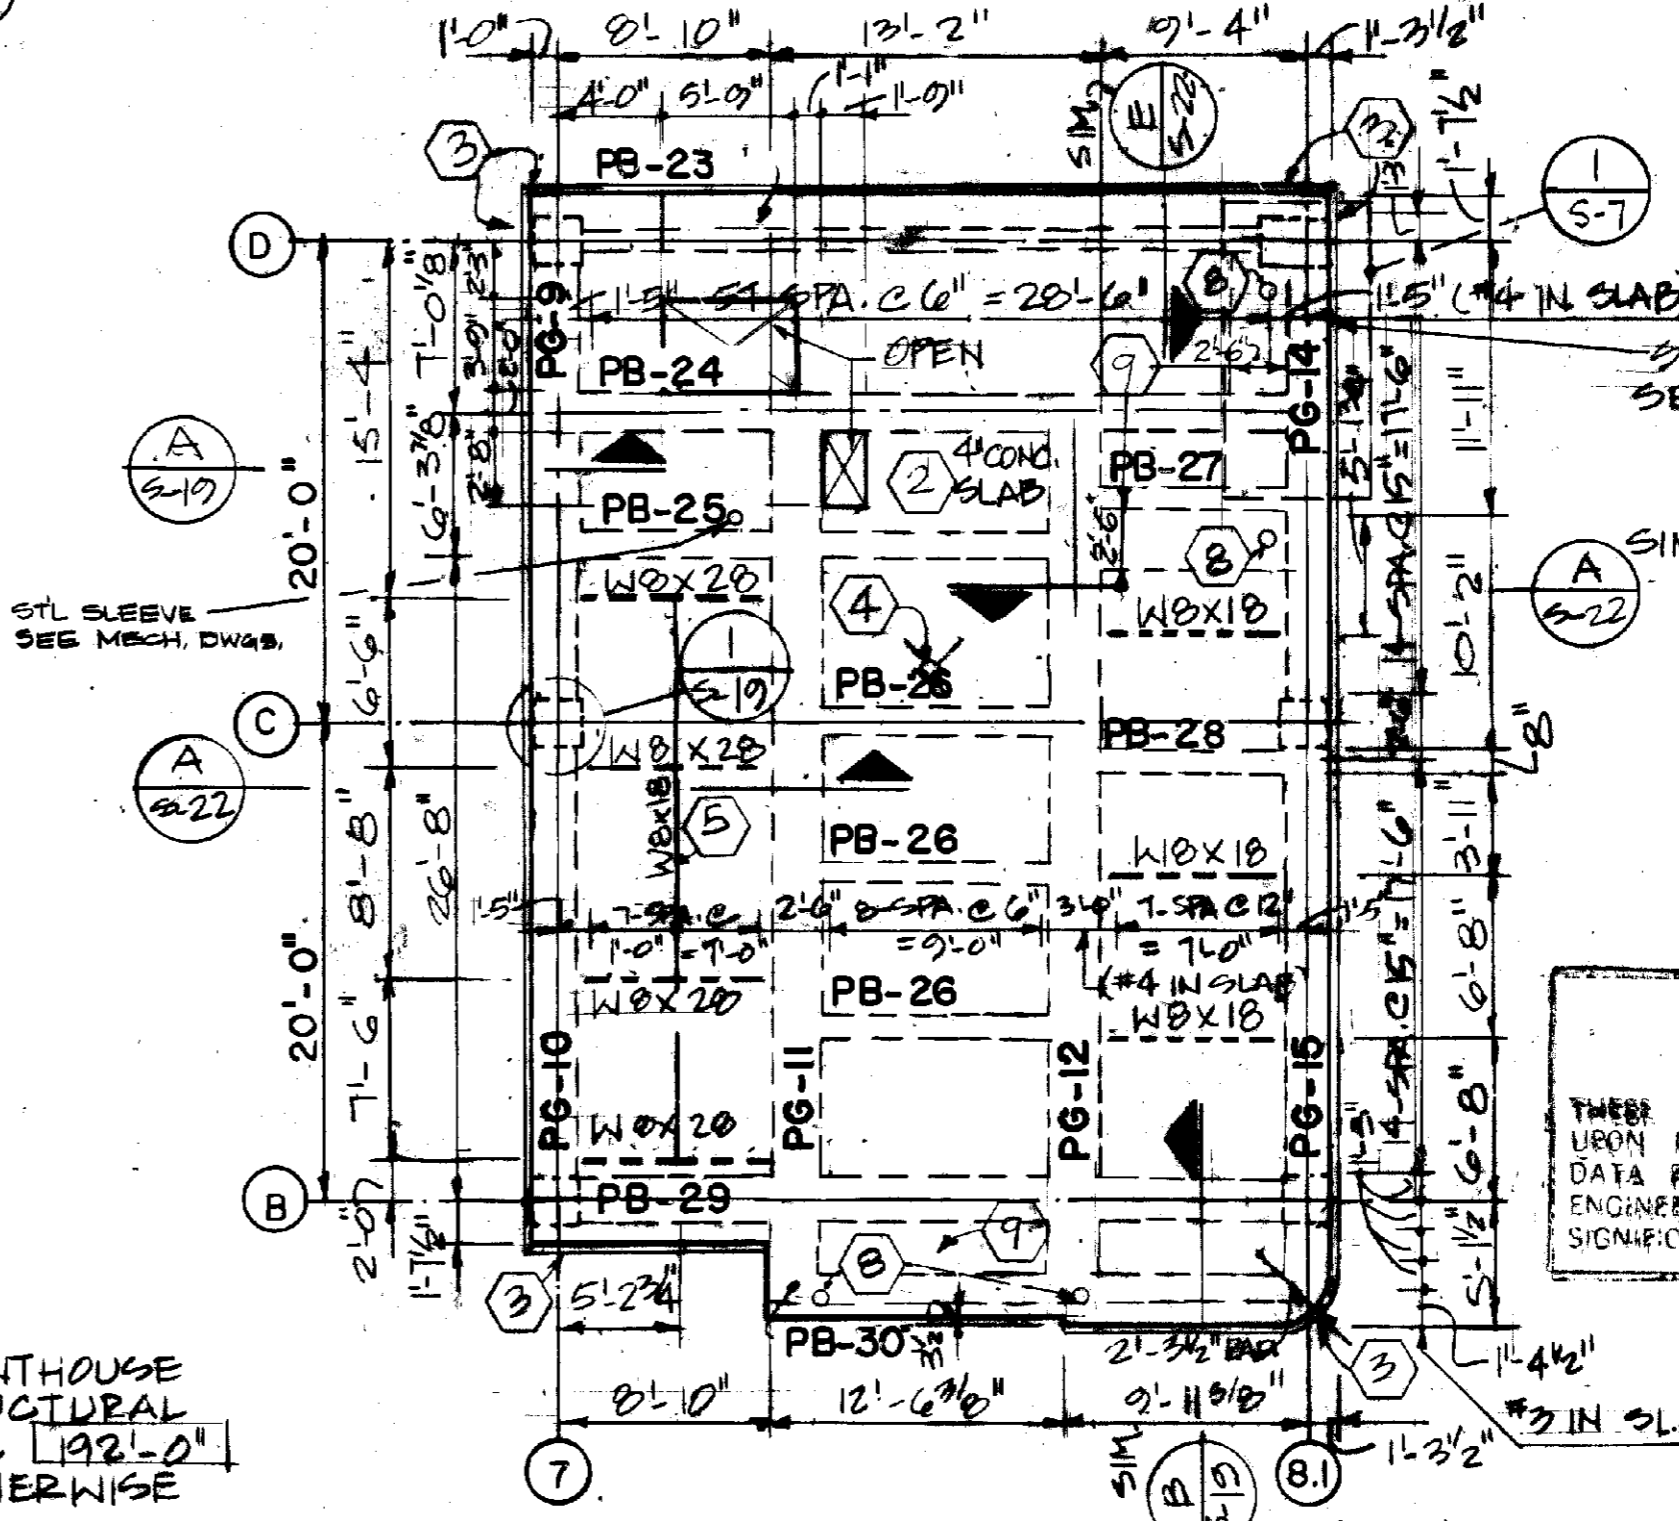

PENTHOUSE ROOF FRAMING PLAN
SCALE: 1/8" = 1'-0"

RECORD PRINTS
THESE ARE RECORD PRINTS OF DRAWINGS BASED UPON MARKED UP PRINTS, DRAWINGS AND OTHER DATA FURNISHED BY THE CONTRACTOR TO THE ENGINEER AND WHICH THE ENGINEER CONSIDERS SIGNIFICANT.

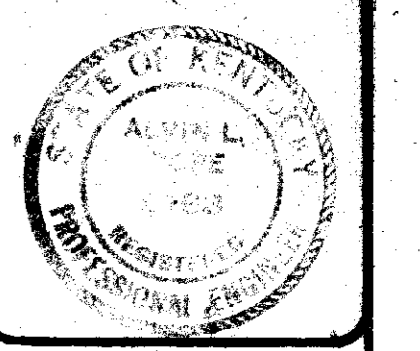

ROBOTICS FACILITY
LEXINGTON CAMPUS
UNIVERSITY OF KENTUCKY
LEXINGTON, KENTUCKY

University of Kentucky
Lexington, Kentucky

ROOF FRAMING PLAN

Sherman Carter Barnhart
PARTNERS IN ARCHITECTURE


JOB NO. 2046
DATE 10-19-87
DRAWN M.A.A.
CHECKED A.L.P.
FILE NO. 431.0

NO.	REVISIONS


SHEET
S-7

MASON & HANGER ENGINEERING INC.
ARCHITECT • ENGINEERS
LEXINGTON, KENTUCKY

FOUNDATION & COLUMN SCHEDULE

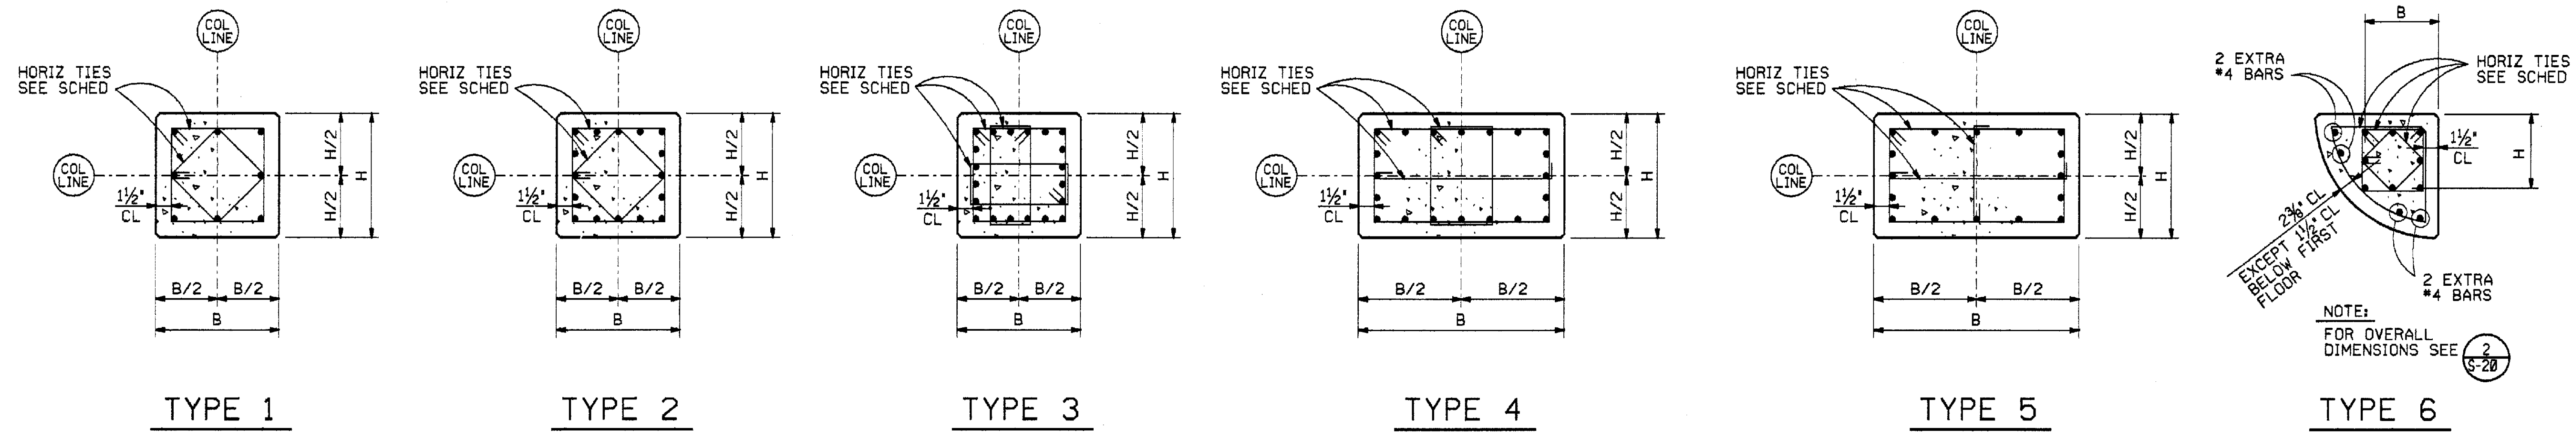

LOCATION		A-6	A.7-1	A.7-1.4	B-2	B-3	B-4	B-5	B-6	B-7	B-8.1	C-1	C-2	C-3	C-4 C-5	C-6	C-7	C-8.1	D-2	D-3	D-4	D-5 D-6	D-7	D-8.1	D.2-1	D.6-1	E-2	E-3	E-4 E-5 E-6	E-7	E-8		
ROOF	EL TOP OF COLUMN	138'-0"	176'-0"	176'-0"	176'-0"	176'-0"	176'-0"	176'-0"	176'-0"	192'-0"	192'-0"	176'-0"	176'-0"	176'-0"	176'-0"	192'-0"	192'-0"	176'-0"	176'-0"	176'-0"	176'-0"	192'-0"	192'-0"	176'-0"	176'-0"	99'-4"	176'-0"	176'-0"	176'-0"	176'-0"	176'-0"		
	EL TOP OF PENTHSE ROOF									192'-0"	192'-0"					192'-0"	192'-0"																
FIFTH FLOOR	SIZE (B X H)	15' X 15'	24' X 24'	24' X 24'		VERTICAL REINFORCING	8 #8	8 #8	FOURTH FLOOR	SIZE (B X H)	15' X 15'	24' X 24'	24' X 24'		VERTICAL REINFORCING	8 #8	8 #8	THIRD FLOOR	SIZE (B X H)	15' X 15'	24' X 24'	24' X 24'		VERTICAL REINFORCING	8 #8	8 #8	SECOND FLOOR	SIZE (B X H)	24' X 24'	15' X 15'	24' X 24'	24' X 24'		VERTICAL REINFORCING	8 #8	8 #10	8 #8	8 #8	FIRST FLOOR	SIZE (B X H)	24' X 24'	15' X 15'	24' X 24'	24' X 24'		VERTICAL REINFORCING	8 #8	8 #11	8 #8	8 #10	8 #10	BASEMENT	SIZE (B X H)	24' X 24'	15' X 15'	24' X 24'	24' X 24'		VERTICAL REINFORCING	8 #8	8 #11	8 #8	8 #10	8 #10	CAISSON	SIZE (DIAMETER)	3'-6"																															
	VERTICAL REINFORCING	8 #10																															
FOOTING	DIMENSION 'A'	3'-7"	3'-10 1/4"	4'-0"	4'-0"					5'-3"	5'-3"	4'-6"	4'-6"	4'-6"	4'-6"	4'-6"	4'-6"	4'-6"	4'-9"	4'-9"	5'-0"	5'-0"	5'-0"	5'-0"	5'-0"	5'-0"	5'-0"	5'-0"	5'-0"	5'-0"	5'-0"	5'-0"	
	DIMENSION 'B'	3'-7"	3'-7"	4'-0"	4'-0"					5'-3"	5'-3"	4'-6"	4'-6"	4'-6"	4'-6"	4'-6"	4'-6"	4'-6"	4'-9"	4'-9"	5'-0"	5'-0"	5'-0"	5'-0"	5'-0"	5'-0"	5'-0"	5'-0"	5'-0"	5'-0"	5'-0"	5'-0"	
DETAIL	13	13	13	13	13	13	13	13	13	13	13	13	13	13	13	13	13	13	13	13	13	13	13	13	13	13	13	13	13	13	13	13	13
	14	14	14	14	14	14	14	14	14	14	14	14	14	14	14	14	14	14	14	14	14	14	14	14	14	14	14	14	14	14	14	14	14

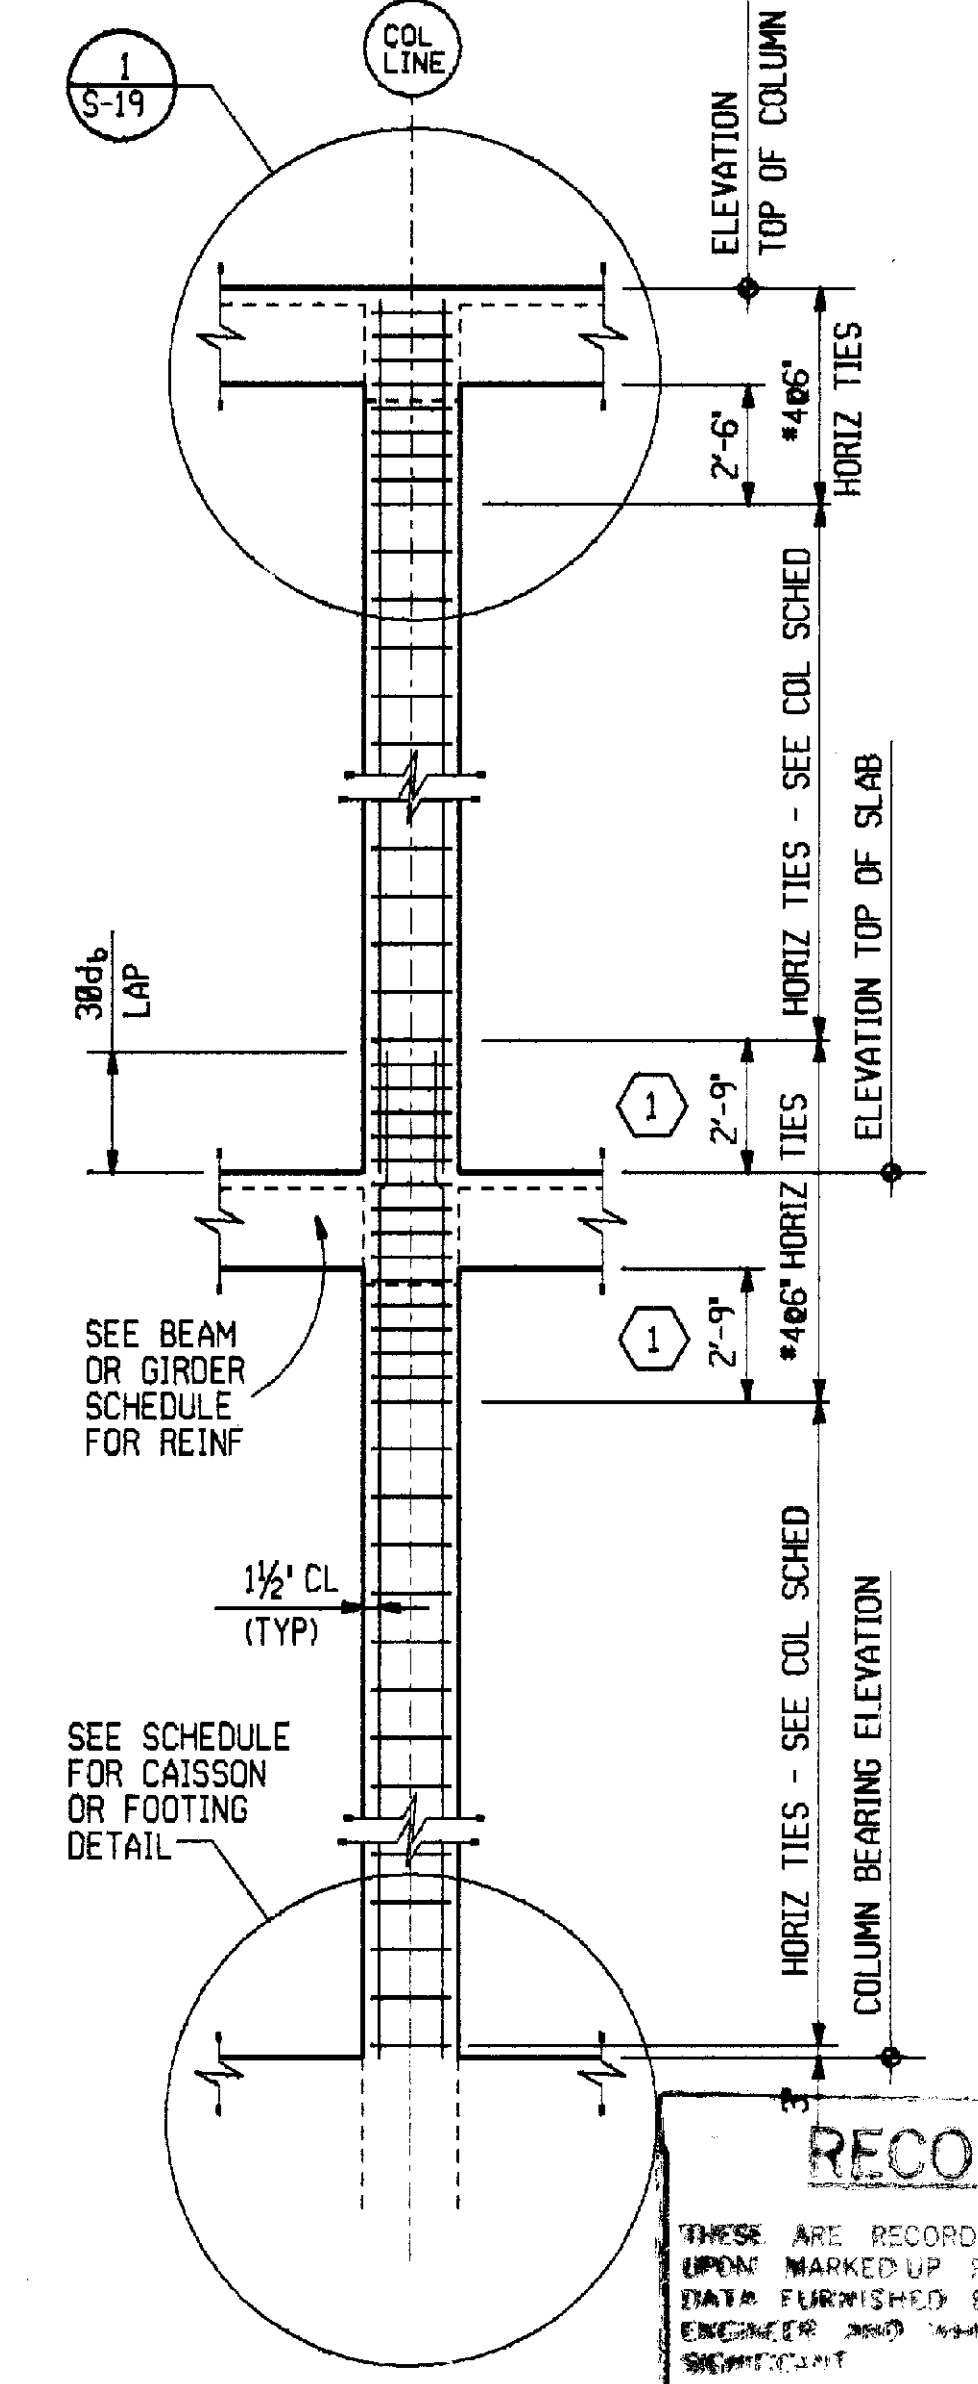

TYPICAL COLUMN REINFORCEMENT

NO SCALE

1 THIS DIMENSION SHALL BE:
 5'-0" FOR B-2 & THIRD FLOORS
 5'-0" FOR B-3 & THIRD FLOORS
 5'-0" FOR B-4 & THIRD FLOORS
 7'-6" FOR B-5 & FOURTH FLOORS

MASON & HANGER ENGINEERING INC.
 ARCHITECT - ENGINEERS
 LEXINGTON, KENTUCKY

ROBOTICS FACILITY
 LEXINGTON CAMPUS
 UNIVERSITY OF KENTUCKY
 LEXINGTON, KENTUCKY

University of Kentucky
 Lexington, Kentucky

FOUNDATION & COLUMN SCHEDULE

Sherman Carter Barnhart
 PARTNERS IN ARCHITECTURE
 SUITE 1000 • 750 WEST MAIN STREET • LEXINGTON, KY 40507 • 606-254-1351







JOB NO. 2046
 DATE 10-19-87
 DRAWN DAH
 CHECKED JEB
 FILE NO. 431.0

RECORD PRINTS


THESE ARE RECORD PRINTS OF DRAWINGS & UPON MARKED UP PRINTS. DRAWINGS AND DATA FURNISHED BY THE DESIGNATOR TO THE ENGINEER AND WHICH THE ENGINEER CONSIDERS NECESSARY FOR THE PROJECT.

SHEET **S-8**


BEAM SCHEDULE

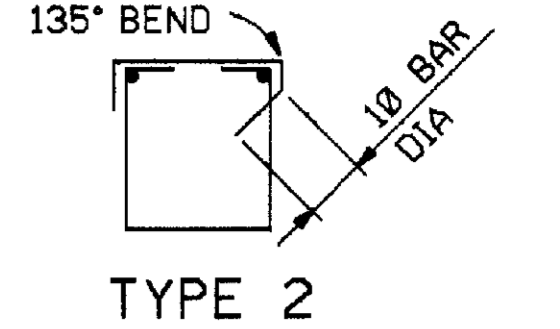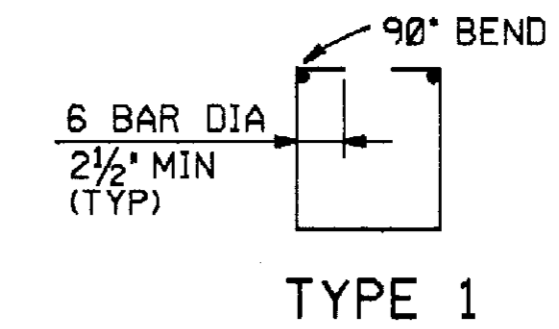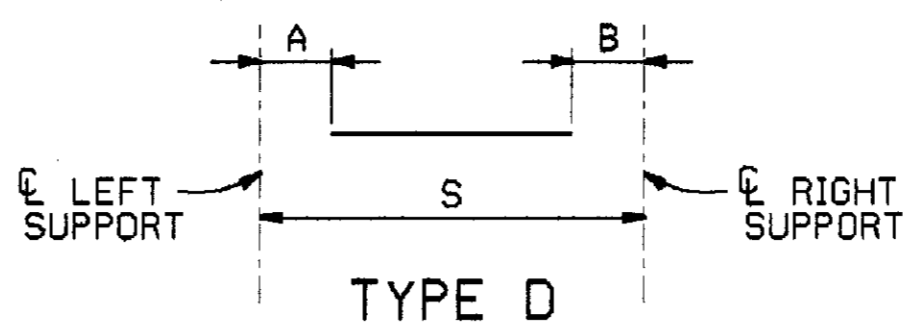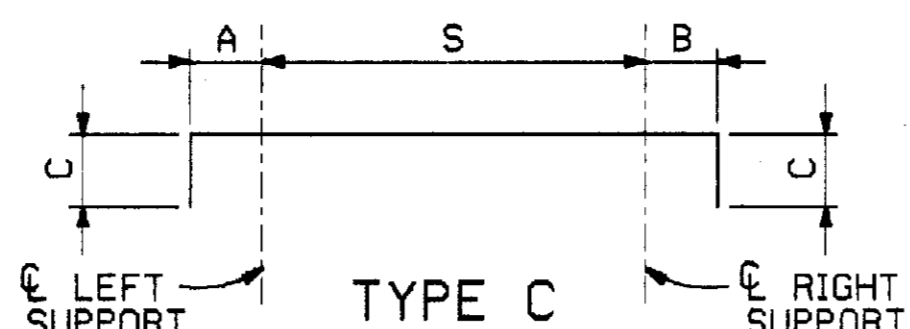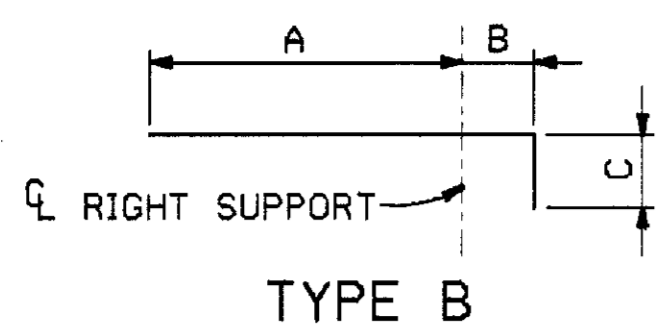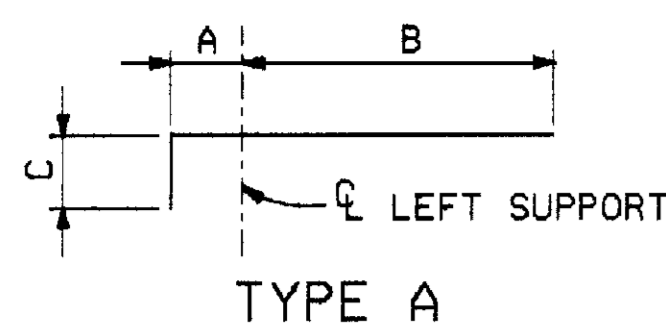


MARK	SIZE		NO. & SIZE	TOP	BEND	TYPE	BAR TYPE DIMENSIONS				SECTION	STIRRUPS					REMARKS	MARK	SIZE		NO. & SIZE	TOP	BEND	TYPE	BAR TYPE DIMENSIONS				SECTION	STIRRUPS					REMARKS
	B	H					FT-IN	FT-IN	FT-IN	FT-IN		S	NO. & SIZE	SPACING FROM FACE OF SUPPORT	END	TYPE			NO. & SIZE	SPACING FROM FACE OF SUPPORT					END	TYPE	NO. & SIZE	SPACING FROM FACE OF SUPPORT		END	TYPE				
1B-1	12	24	4 #7	X	C	0-9	0-9	0	26-0	28#4	14	RIGHT	2	(A)	1B-9	12	24	2 #5	X	A	0-8	16-0	0	24-0	42#3	1 12	8	RIGHT	2	(S-21)					
			4 #7	X	C	0-9	0-9	0	26-0						2B-9			2 #7	X	B	9-10	9-10	0		1 12	8	LEFT	2							
															3B-9			2 #7	X	B	6-0	6-0	0												
2B-1	22	28	3 #7	X	A	0-9	7-4	0	26-0	28#4	14	RIGHT	2	(B)	4B-9			2 #8	X	D	0-5	0-5													
3B-1			3 #4	X	C	0-7	0-7	0							5B-9			2 #5	X	A	0-8	5-4													
			3 #10	X	B	9-10	9-10	0							3B-13																				
			4 #8	X	A	0-7	26-0	0							4B-13																				
4B-1	12	24	2 #6	X	A	0-8	16-0	0	26-0	28#3	14	RIGHT	2		5B-13																				
5B-1			2 #6	X	A	0-8	5-4	0							4B-13																				
RB-1			4 #8	X	B	9-10	9-10	0							5B-13																				
			3 #7	X	D	0-5	0-5								RB-13																				
1B-2	12	24	3 #7	X	C	0-9	0-9	0	26-0	28#4	14	RIGHT	1		1B-10	12	24	2 #7	X	B	9-10	9-10	0	24-0	42#3	1 12	8	RIGHT	2						
			3 #7	X	C	0-9	0-9	0	26-0									2 #7	X	B	6-0	6-0	0		1 12	8	LEFT	2							
2B-2	12	24	2 #6	X	A	0-8	5-4	0	26-0	44#3	1 12	9	RIGHT	1	2B-10	12	24	2 #5	X	A	0-8	16-0	0	24-0	26#3	13	RIGHT	1							
3B-2			2 #8	X	B	9-10	9-10	0							3B-10			2 #7	X	B	9-10	9-10	0		1 12	13	LEFT	1							
4B-2			2 #8	X	B	6-0	6-0	0							4B-10			2 #7	X	B	6-0	6-0	0												
5B-2			2 #6	X	A	0-8	16-0	0							5B-10			2 #8	X	D	0-5	0-5													
RB-2			2 #8	X	D	0-5	0-5								RB-10			2 #5	X	A	0-8	5-4													
1B-3	12	24	3 #7	X	A	1-0	18-2	0	26-0	28#4	14	RIGHT	1		1B-11	12	24	2 #7	X	B	9-10	9-10	0	24-0	26#3	13	RIGHT	1							
OR			2 #8	X	B	9-10	9-10	0							2B-11			2 #7	X	B	6-0	6-0	0												
			2 #8	X	B	6-0	6-0	0							3B-11			2 #5	X	D	8-0	8-0													
			3 #8	X	D	0-5	0-5								4B-11			2 #8	X	D	0-5	0-5													
2B-3	12	24	2 #6	X	A	0-8	16-0	0	26-0	28#3	14	RIGHT	1		5B-11																				
3B-3			2 #6	X	A	0-8	5-4	0							RB-11																				
4B-3			2 #8	X	B	9-10	9-10	0																											
5B-3			2 #8	X	B	6-0	6-0	0																											
RB-3			2 #8	X	D	0-5	0-5																												
1B-4	22	28	6 #8	X	A	0-8	8-0	0	26-0	44#3	1 12	9	RIGHT	1	1B-12	12	24	2 #7	X	B	9-10	9-10	0	24-0	42#3	1 12	8	RIGHT	1						
2B-4			2 #7	X	D	6-0	9-0								2B-12			2 #7	X	B	6-0	6-0	0		1 12	8	LEFT	1							
3B-4			4 #8	X	B	11-0	11-0	0							3B-12			2 #5	X	D	8-0	8-0													
4B-4			6 #8	X	D	0-5	0-5								4B-12			2 #8	X	D	0-5	0-5													
5B-4															5B-12																				
RB-4															RB-12																				
1B-5	12	22	2 #5	X	C	0-8	0-8	0	10-4	0				1B-13	16	28	4 #7	X	C	0-9	0-9	0	18-1	14#4	7	RIGHT	1	(1)							
2B-5			2 #5	X	C	0-8	0-8	0							4B-13			4 #7	X	C	0-9	0-9	0												
3B-5															1B-14	16	34	5 #8	X	X	A	0-9	34-0	1-4	24-0	36#4	1 12	5	RIGHT	2					
4B-5																		5 #8	X	C	0-9	0-9	0		1 12	5	LEFT	2							
5B-5															2B-14	12	24	3 #6	X	B	5-4	0-7	0	24-0	42#3	1 12	8	RIGHT	2						
RB-5															3B-14			2 #5	X	D	8-0	3-6			1 12	8	LEFT	2							
															4B-14			2 #8	X	D	0-5	0-5													
1B-6	12	24	4 #7	X	A	0-9	25-6	0	15-8	28#4	1 13	RIGHT	1		5B-14																				
			2 #8	X	D	0-5	0-5								RB-14			1																	
2B-6	12	24	2 #7	X	A	0-9	5-4	0	15-8	28#3	1 13	RIGHT	2		1B-15	16	28	5 #8	X	X	A	0-9	34-0	1-4	24-0	36#4	1 12	5	RIGHT	2					
3B-6			2 #7	X	A	0-9	25-6	0										5 #8	X	C	0-9	0-9	0		1 12	5	LEFT	2							
4B-6			2 #7	X	B	6-0	6-0	0							2B-15	12	24	2 #7	X	B	9-10	9-10	0	24-0	42#3	1 12	8	RIGHT	2						
5B-6			2 #8	X	D	0-5	0-5								3B-15			2 #7	X	B	6-0	6-0	0		1 12	8	LEFT	2							
RB-6															4B-15			2 #5	X	D	8-0	8-0													
															5B-15			2 #8	X	D	0-5	0-5													
1B-7	24	24	3 #6	X	X	C	0-5	0-5	1-0	25-4	28#3	1 13	RIGHT	2	1B-16	16	28	3 #10	X	B	16-2	15-0	0	24-0	21#4	10	RIGHT	1							
2B-7			7 #8	X	X	C	0-5	0-5	1-0									4 #11	X	C	0	1-6	0												
3B-7															2B-16	24	28	4 #6	X	A	0-6	8-0	0	24-0	30#4	1 9 3	2	RIGHT	2	(2)					
4B-7																		2 #6	X	A	0-6	18-0	0		1 9 3	2	LEFT	2							
5B-7																		4 #6	X	B	8-0	0-6	0												
RB-7																		6 #9	X	C	0	0	0												
1B-8	12	24	2 #5	X	D	8-0	8-0		24-0	42#3	1 12	8	RIGHT	2	3B-16	24	32																		

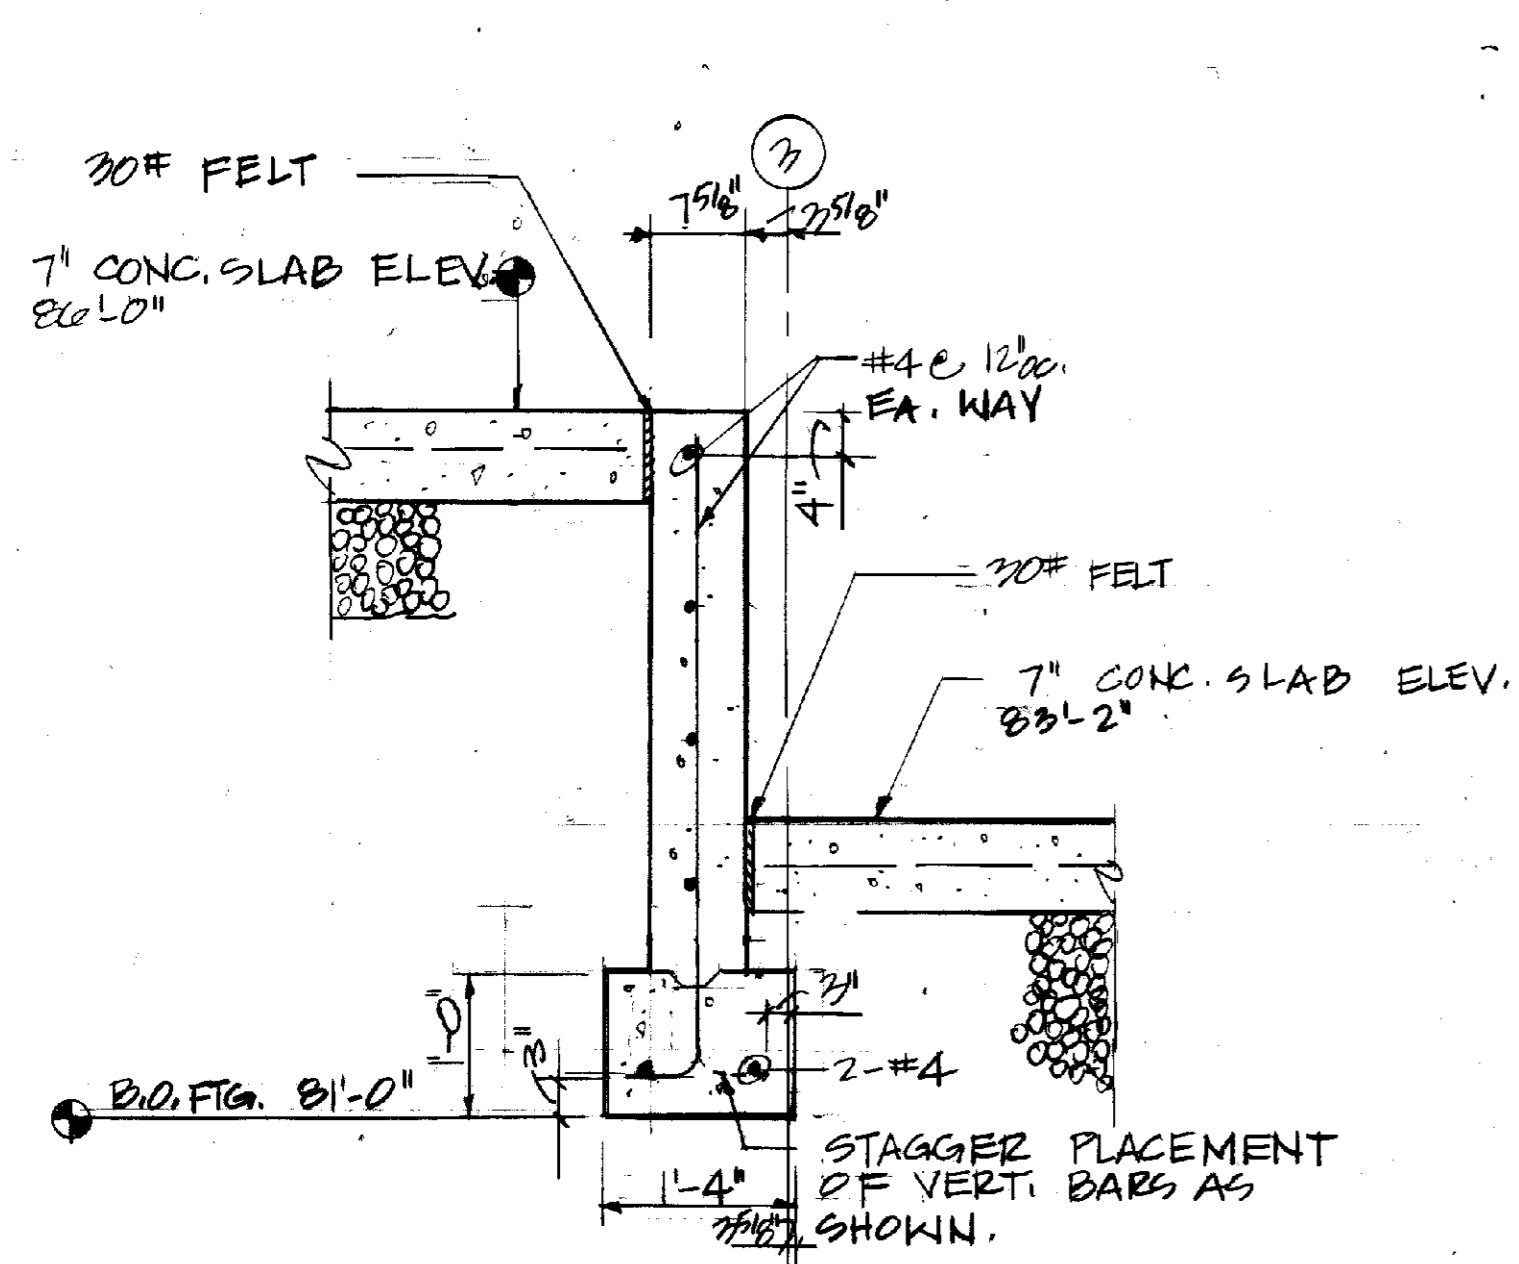


A SECTION
S-12 SCALE: 3/4" = 1'-0"

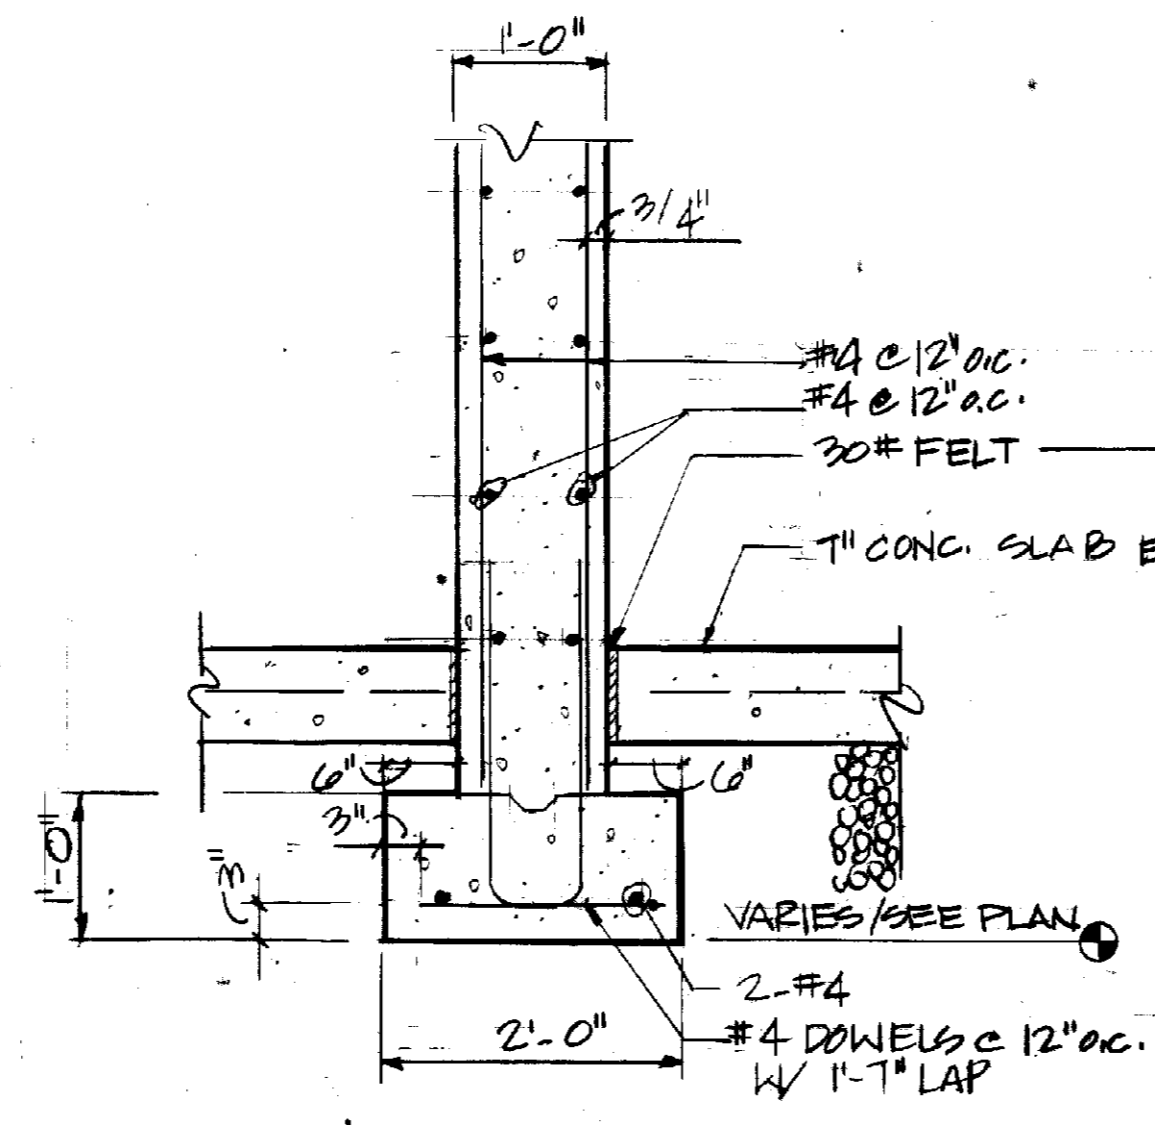


B SECTION
S-12 SCALE: 3/4" = 1'-0"

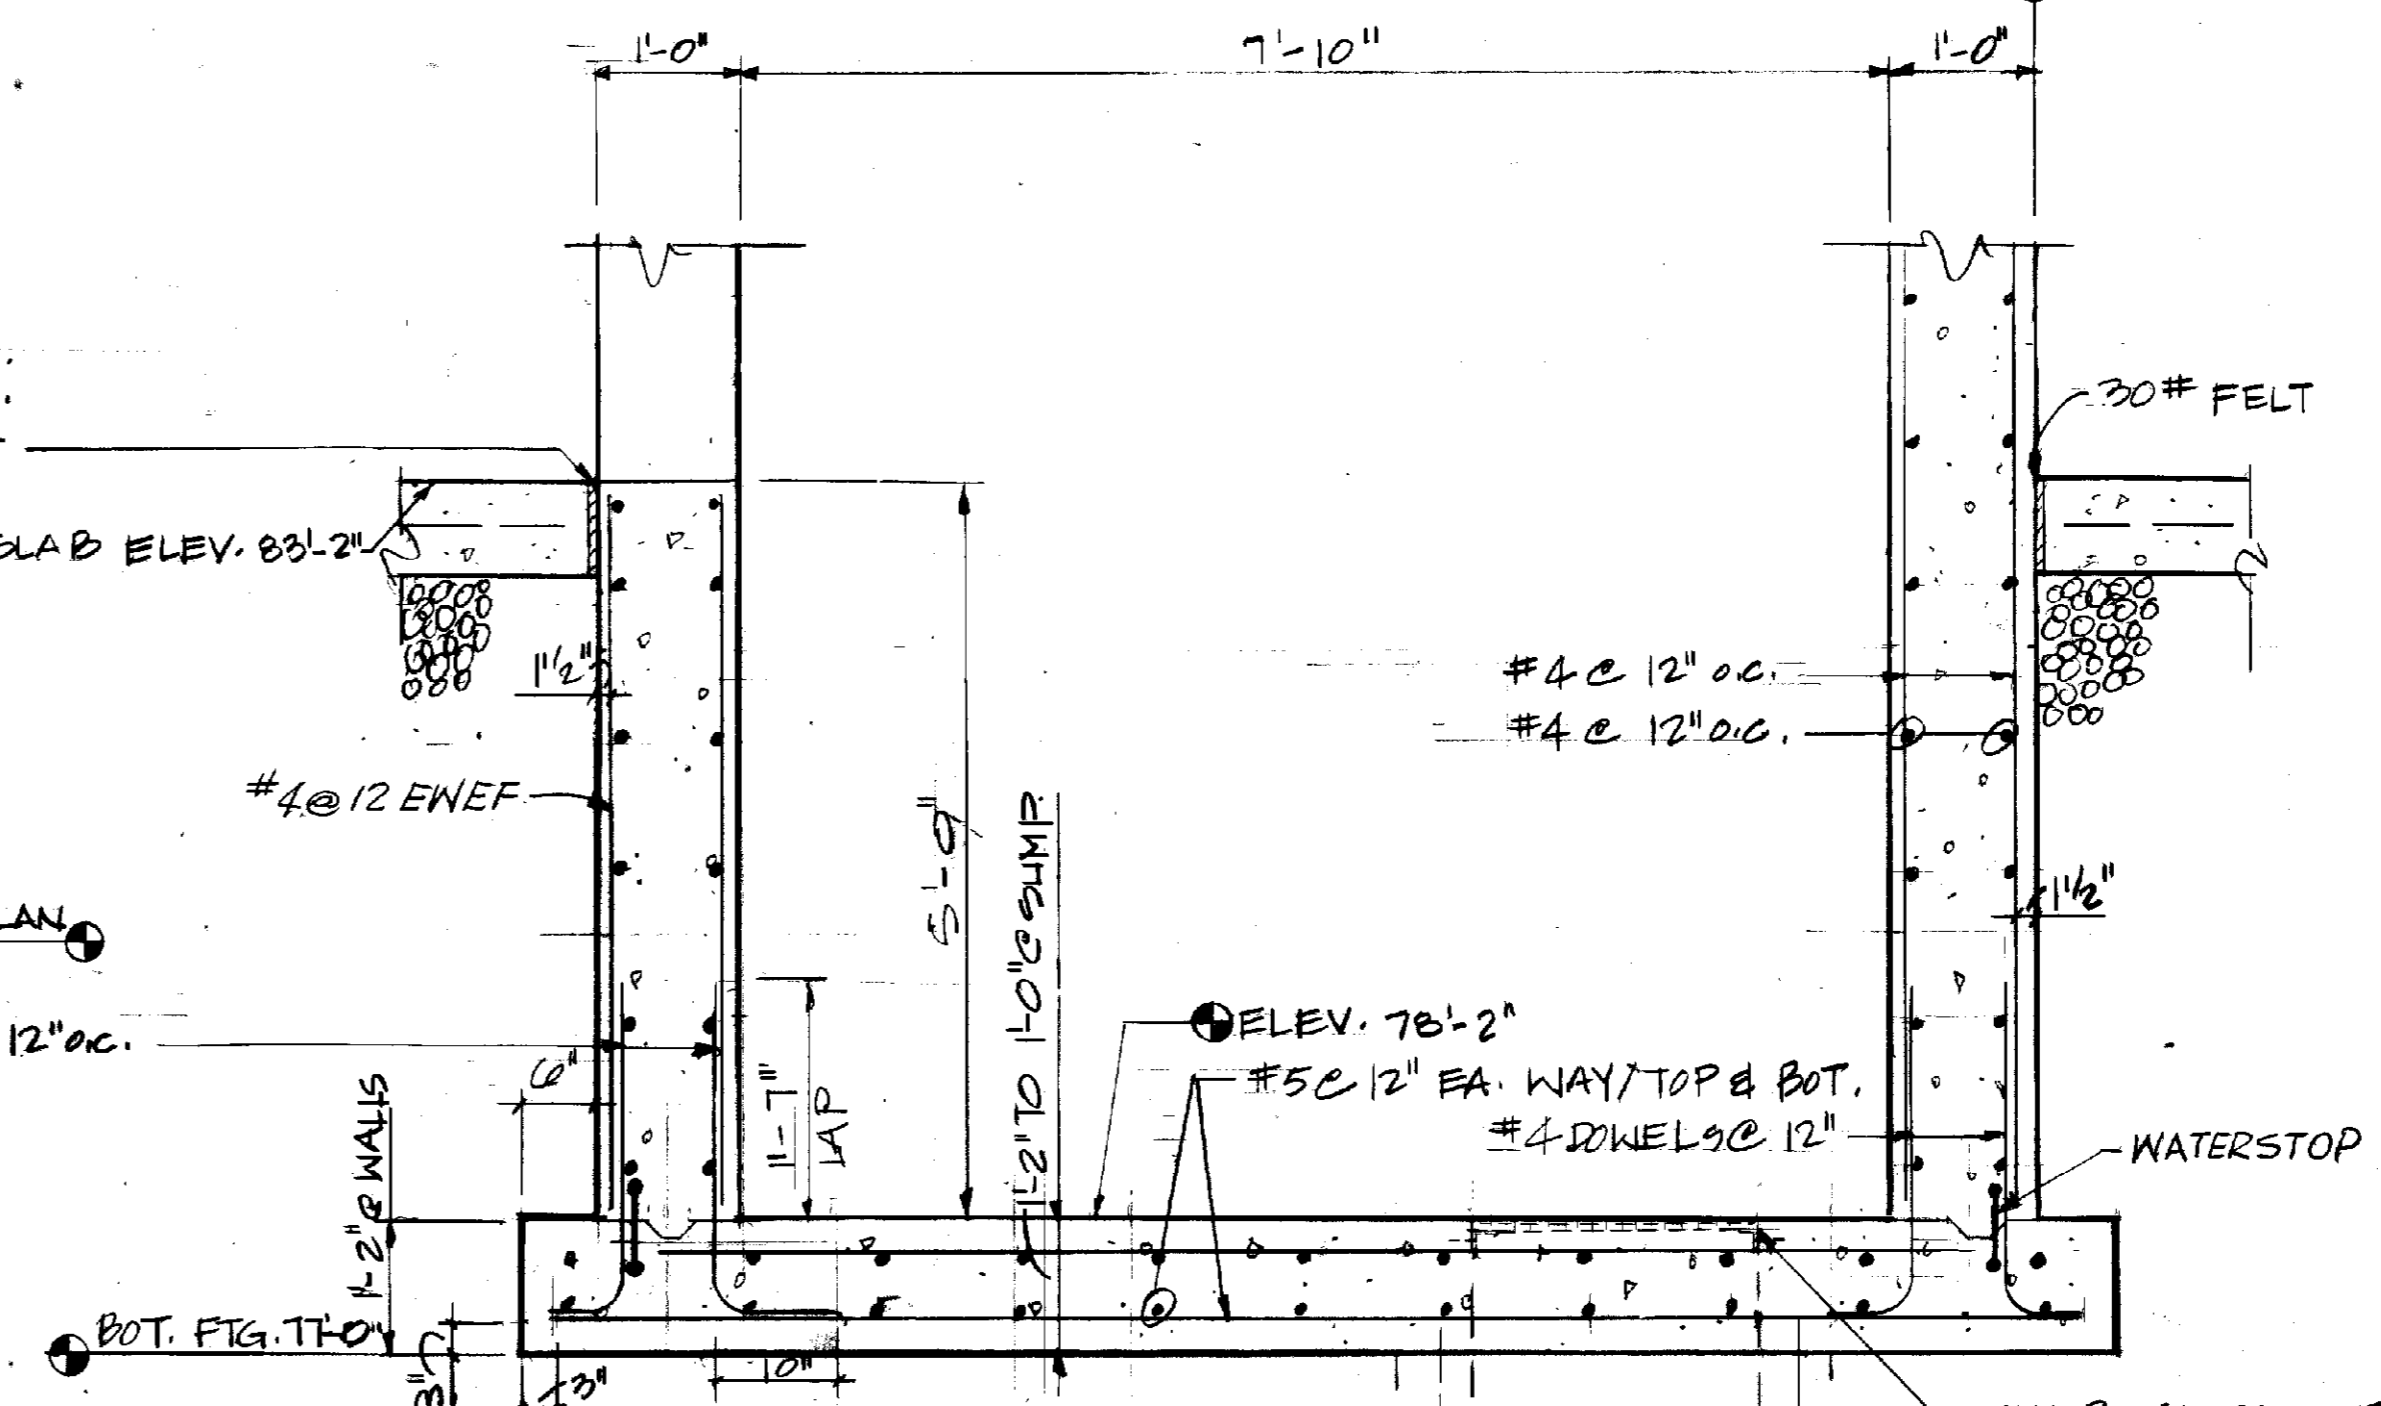


C SECTION
S-12 SCALE: 3/4" = 1'-0"

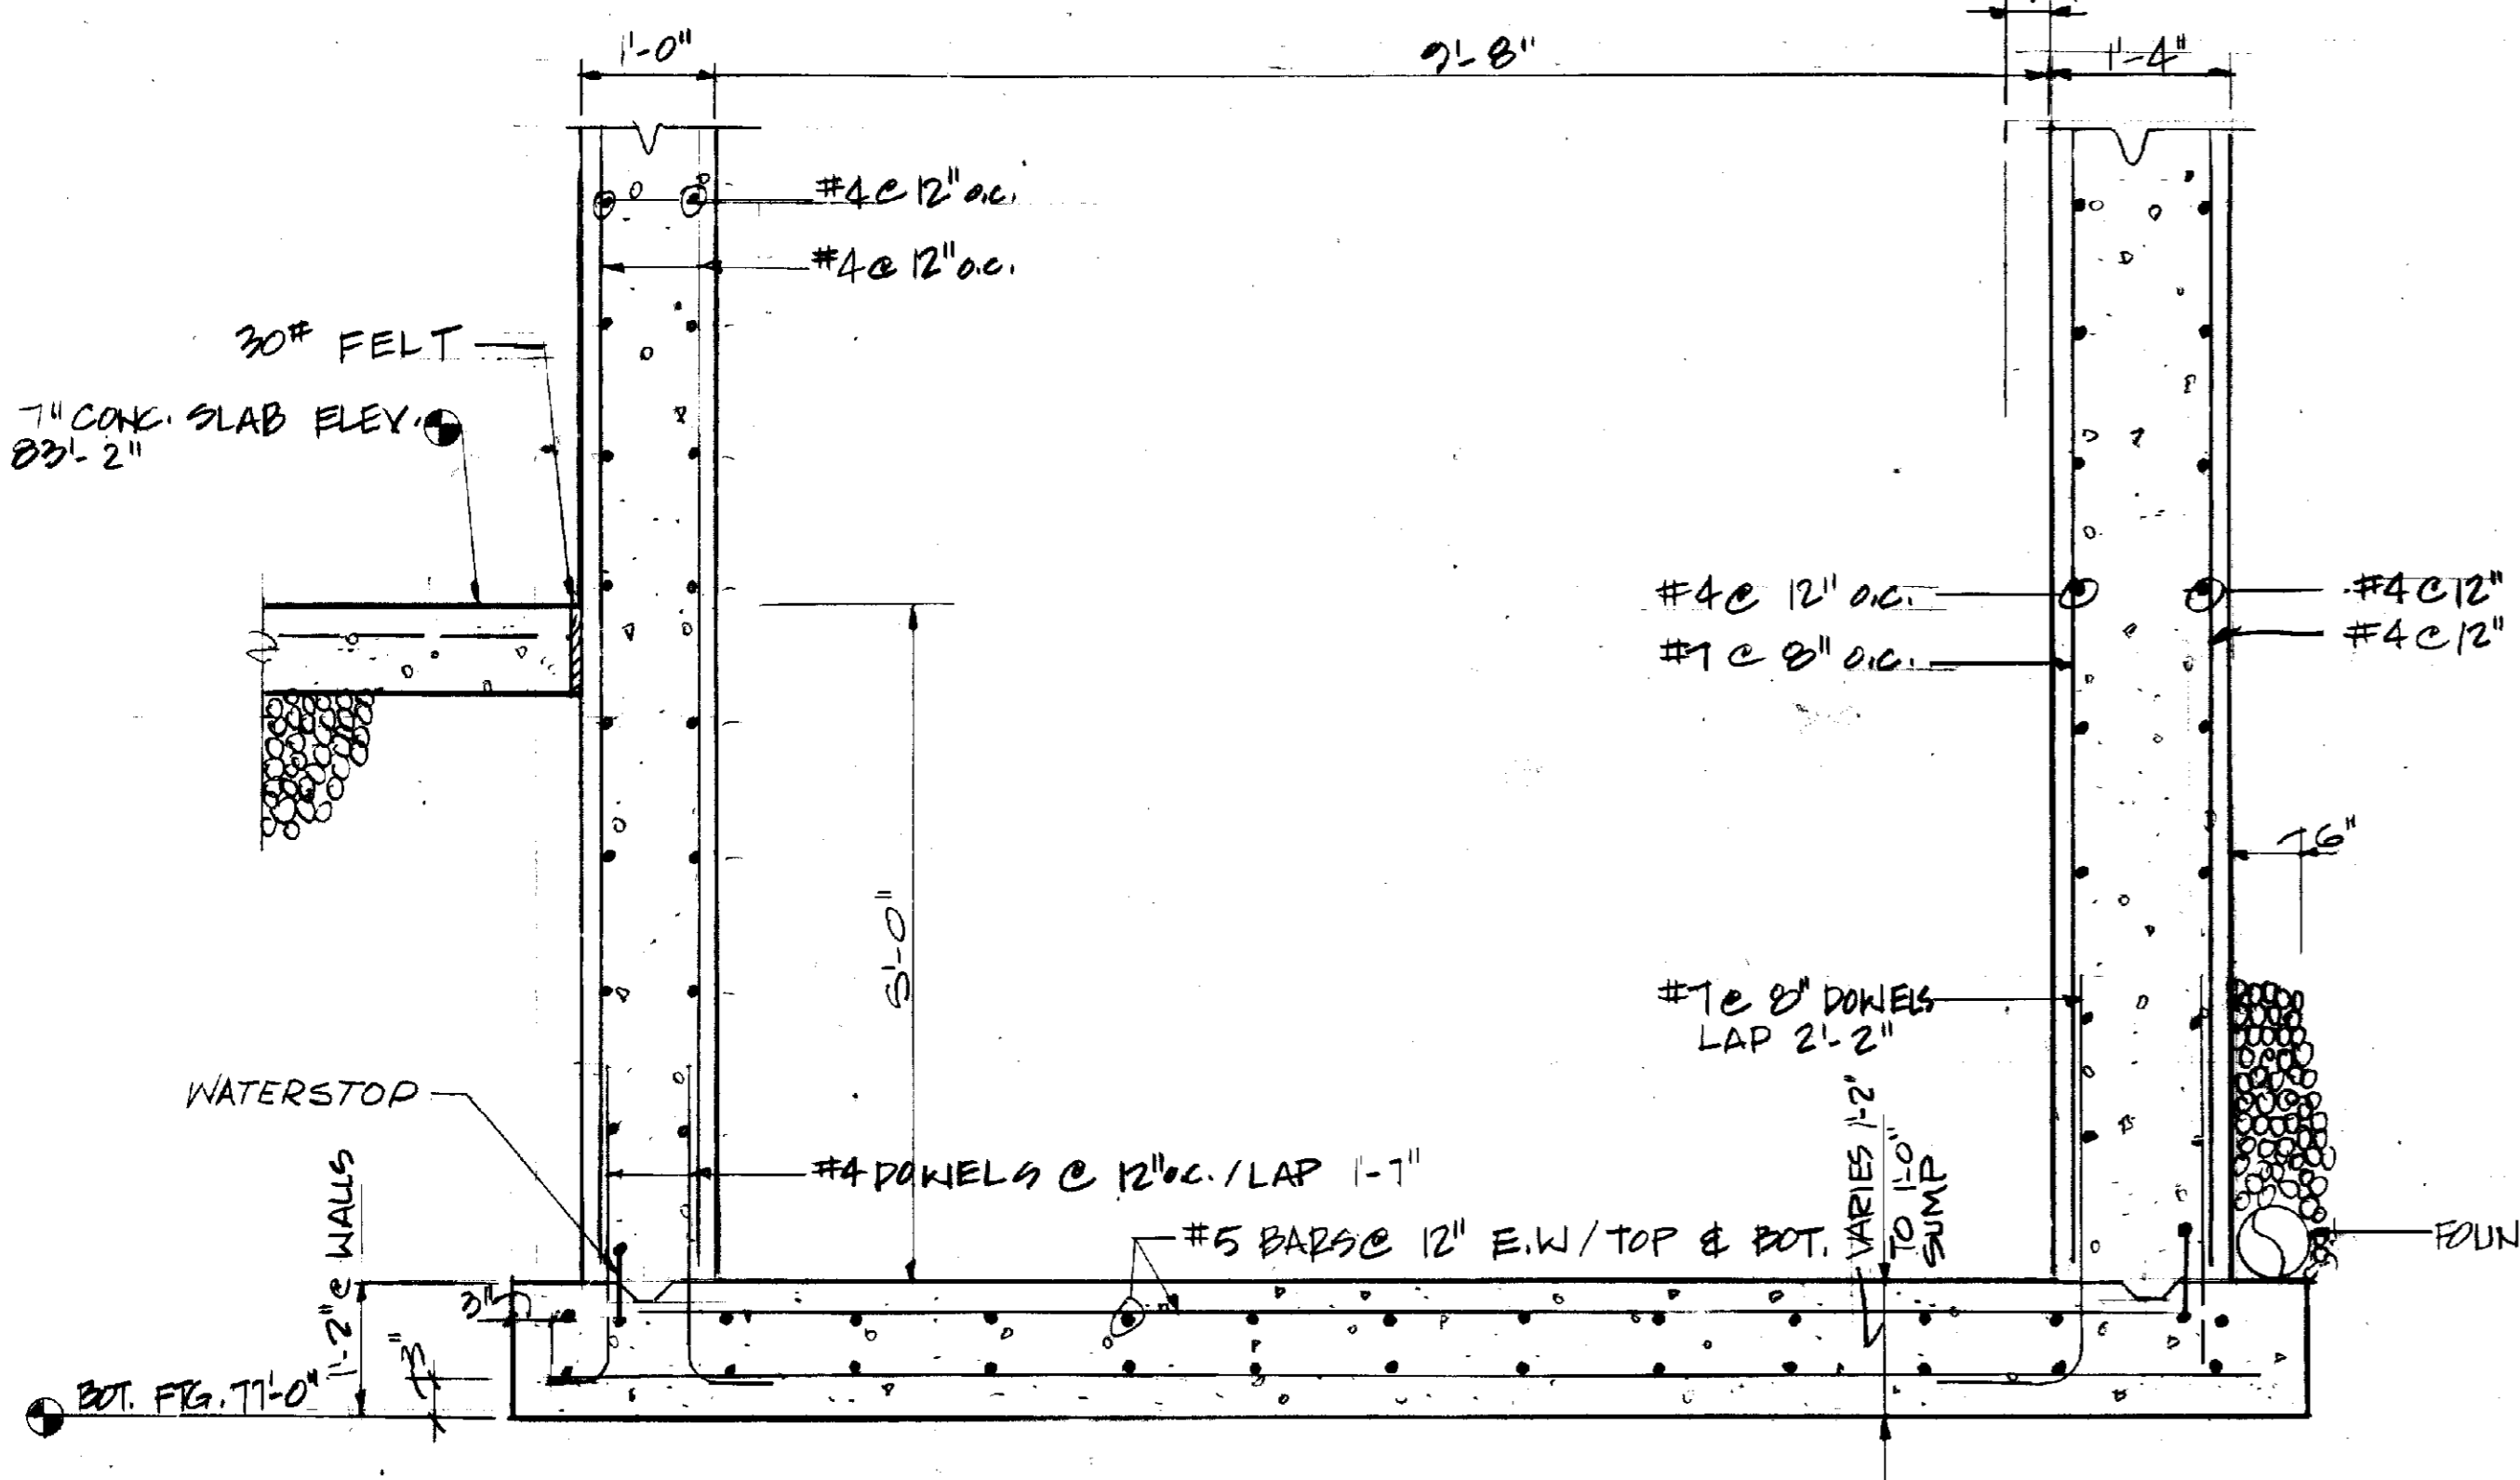


D SECTION
S-12 SCALE: 3/4" = 1'-0"

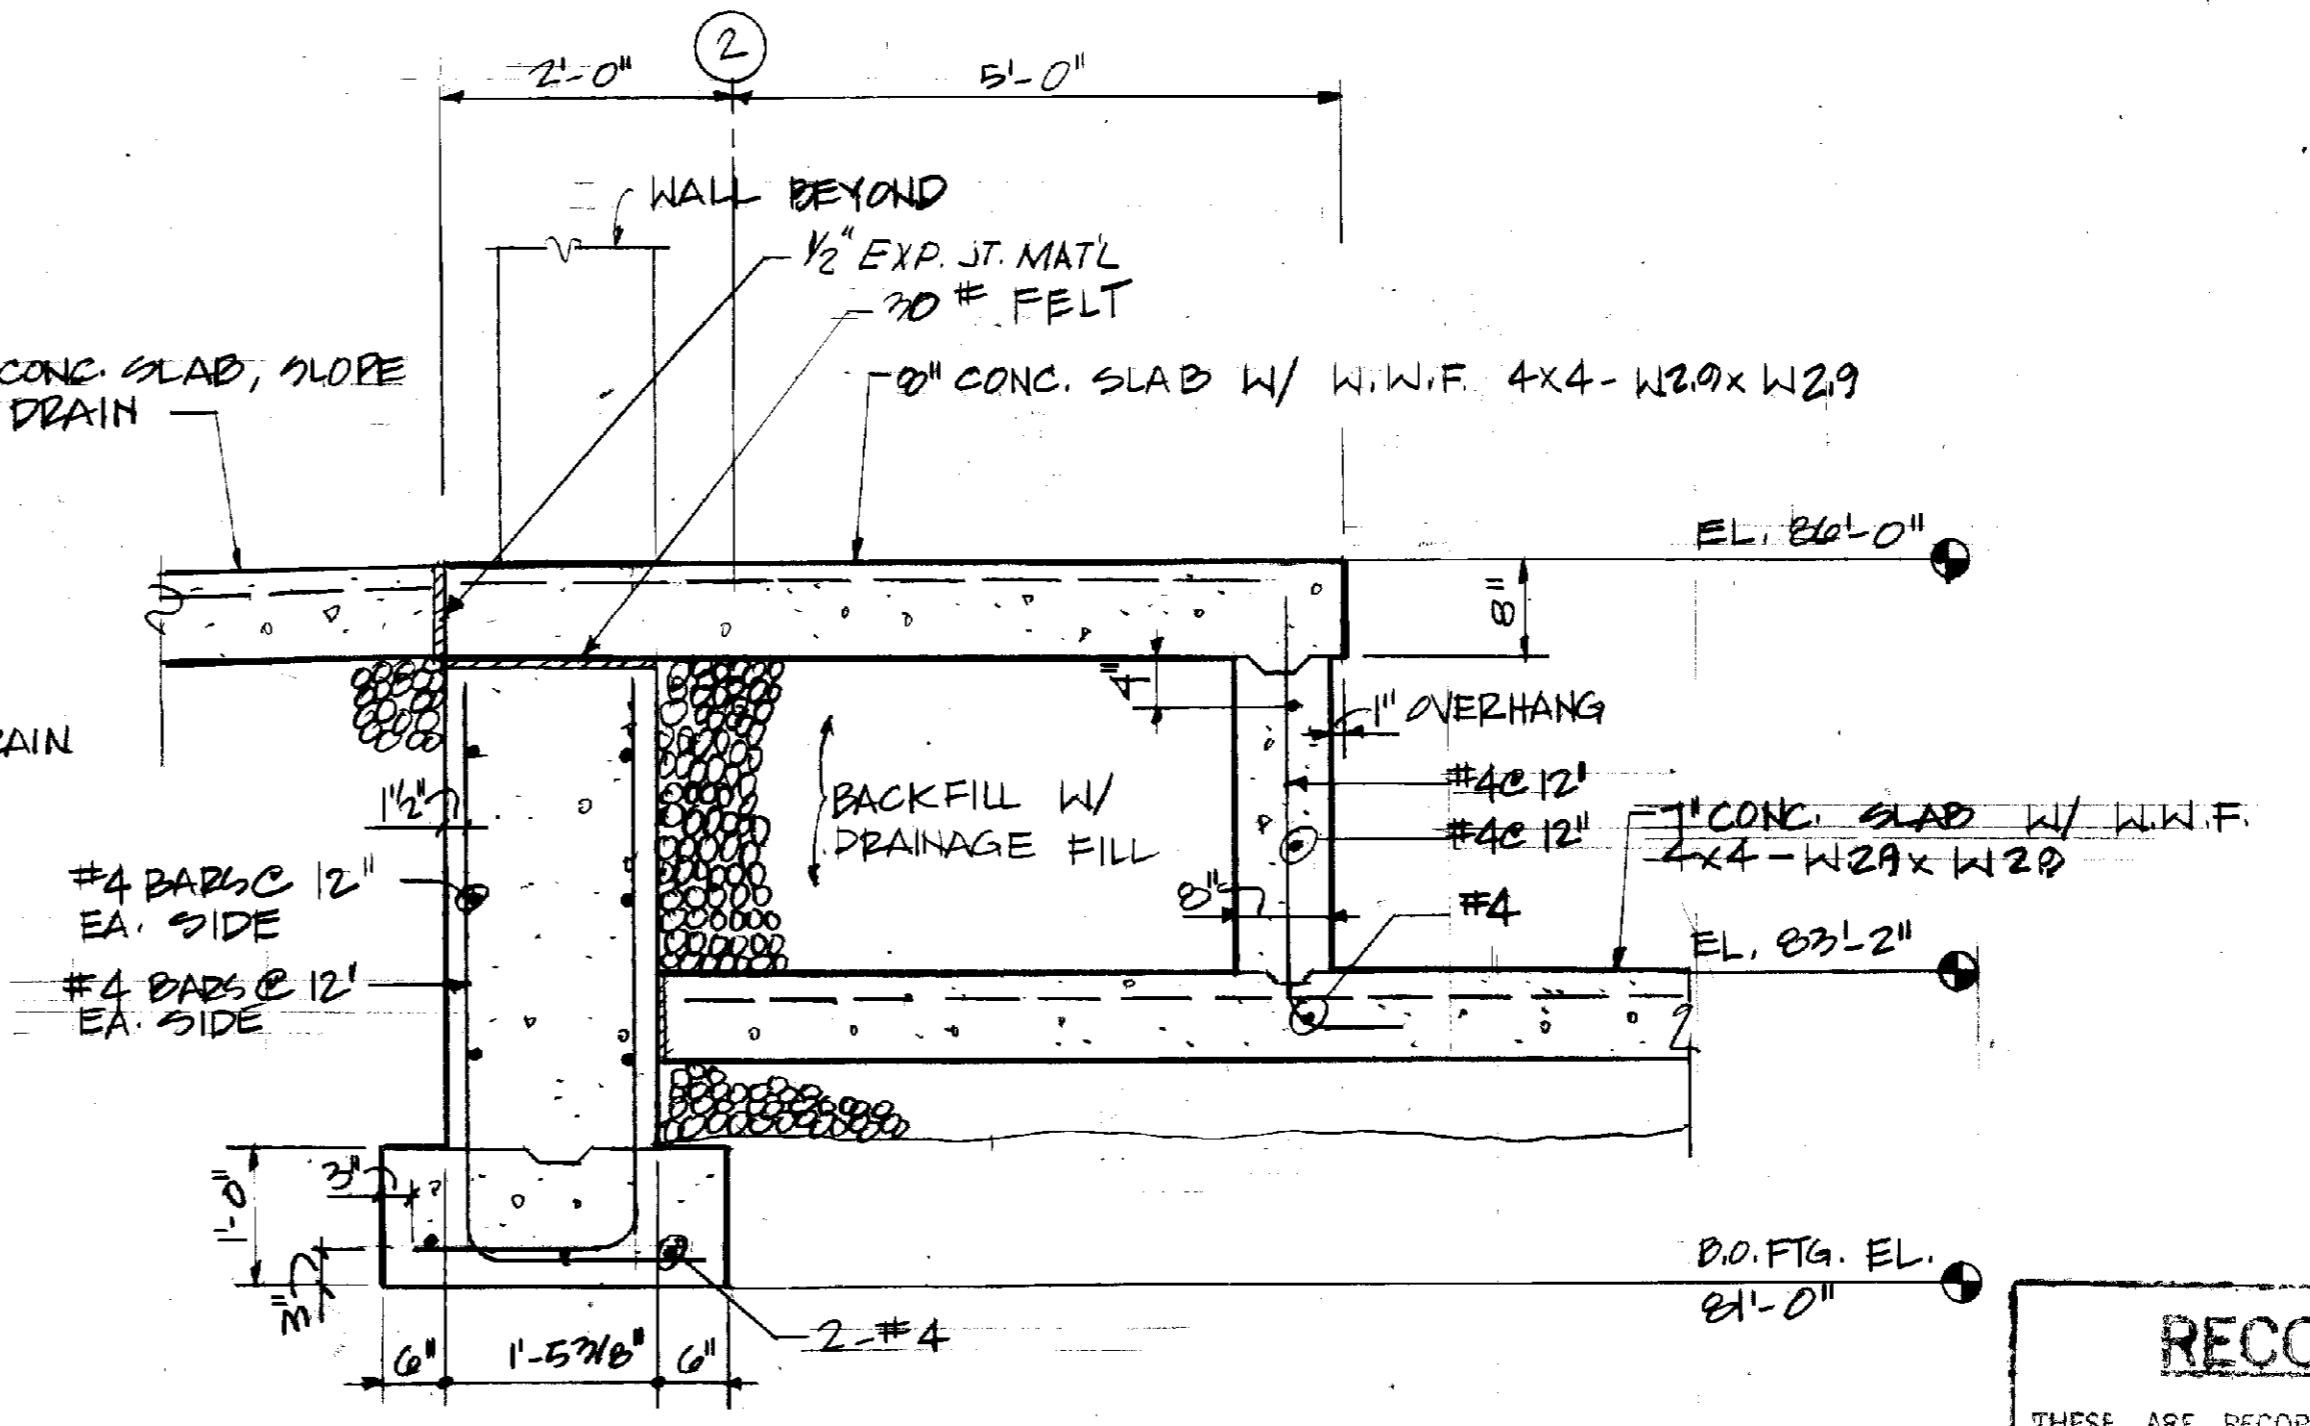


E SECTION
S-12 SCALE: 3/4" = 1'-0"

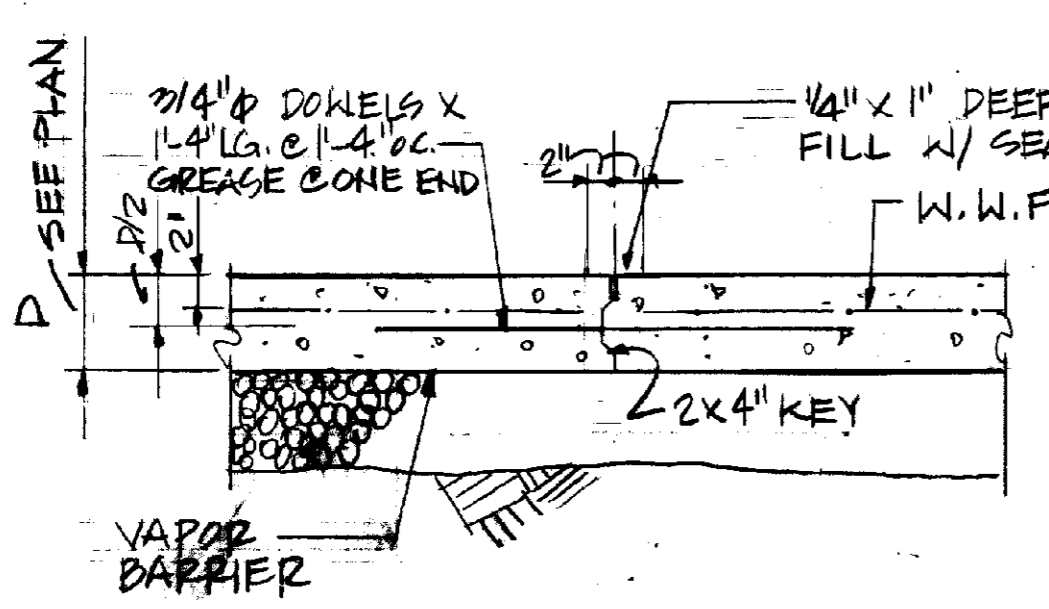


CONSTRUCTION JOINT (CSJ)

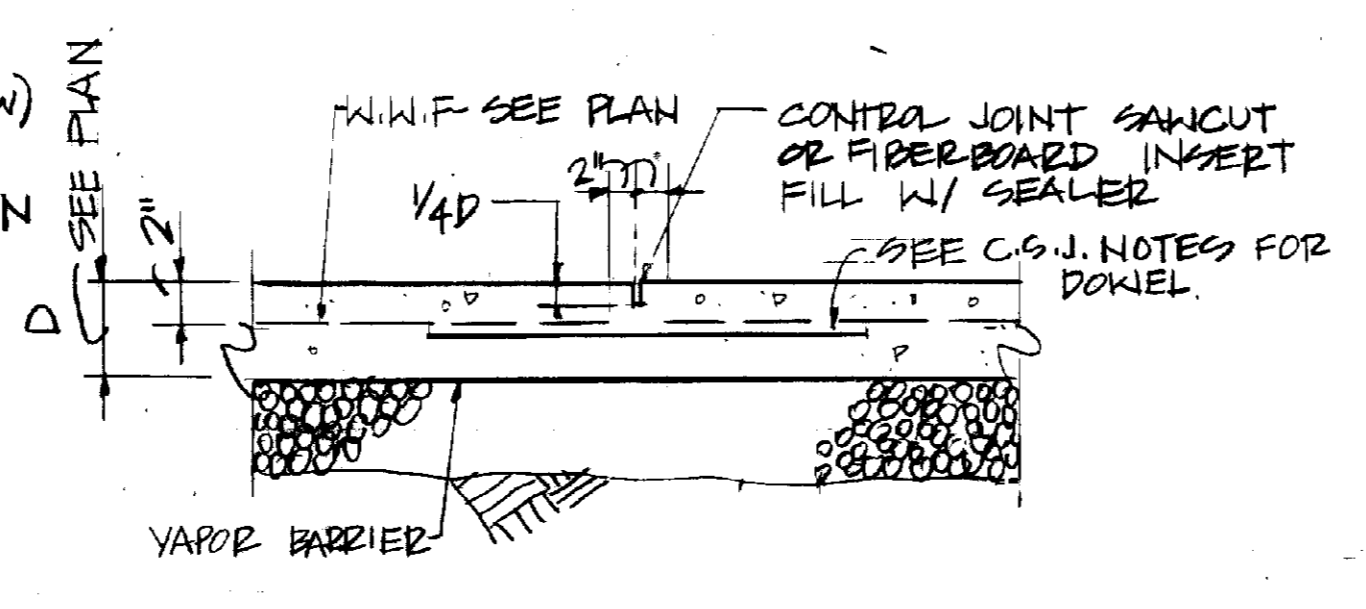

CONTROL JOINT (CJ)

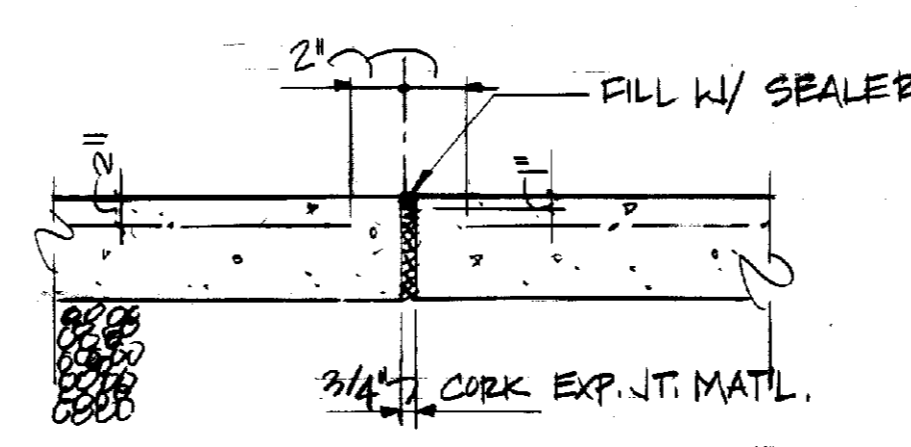

ISOLATION JOINT (IJ)

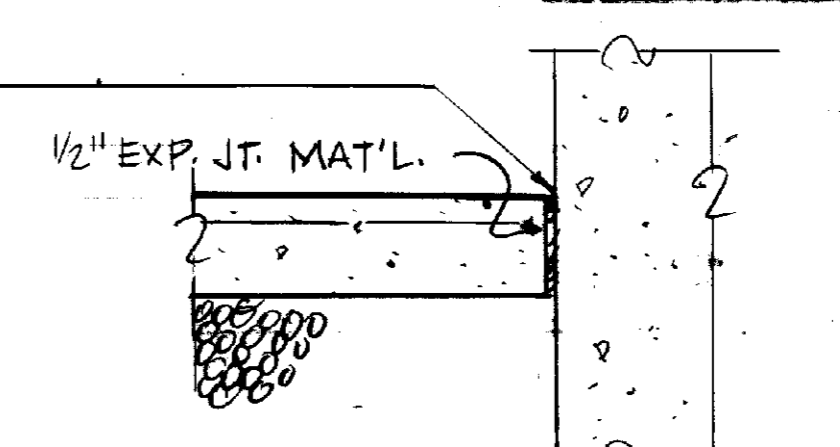

EXPANSION JOINT (EJ)

TYPICAL SLAB DETAILS
NO SCALE

SUMP PIT 2'-0" x 2'-0" x 2'-0" W/ 6" WALLS & #4 BARS @ 12" O.C.
SEE ARCH. FOR LOCATION. PROVIDE WATERSTOPS AT CONSTRUCTION JOINTS.

ON 2 SIDES OF SUMP PIT USE 1/2" x 2" x 1/4" CONT. W/ 1/2" EXP. BOLTS @ 6" O.C. COVER W/ 3/4" STL. GRATING. TYP AT ELEVATOR PIT SUMPS.

RECORD PRINTS
THESE ARE RECORD PRINTS OF DRAWINGS BASED UPON MARKED UP PRINTS, DRAWINGS AND OTHER DATA FURNISHED BY THE CONTRACTOR TO THE ENGINEER AND WHICH THE ENGINEER CONSIDERS SIGNIFICANT.

SIMILAR TO EXPANSION JOINT EXCEPT THAT MATERIAL SHALL CONFORM TO ASTM D-250.

FELT JOINTS

MASON & HANGER ENGINEERING INC.
ARCHITECT • ENGINEERS
LEXINGTON, KENTUCKY

ROBOTICS FACILITY
LEXINGTON CAMPUS
UNIVERSITY OF KENTUCKY
LEXINGTON, KENTUCKY


University of Kentucky
Lexington, Kentucky

FOUNDATION DETAILS
Sherman Carter Barnhart
PARTNERS IN ARCHITECTURE
SHELBY HILL, 2500 WELLS MANOR SQUARE, LEANING TOWER, JEFFERSON, KY 40303

JOB NO. 2046
DATE 10-19-87
DRAWN M.A.A.
CHECKED A.L.P.
FILE NO. 431.0

REVISIONS

SHEET
S-12

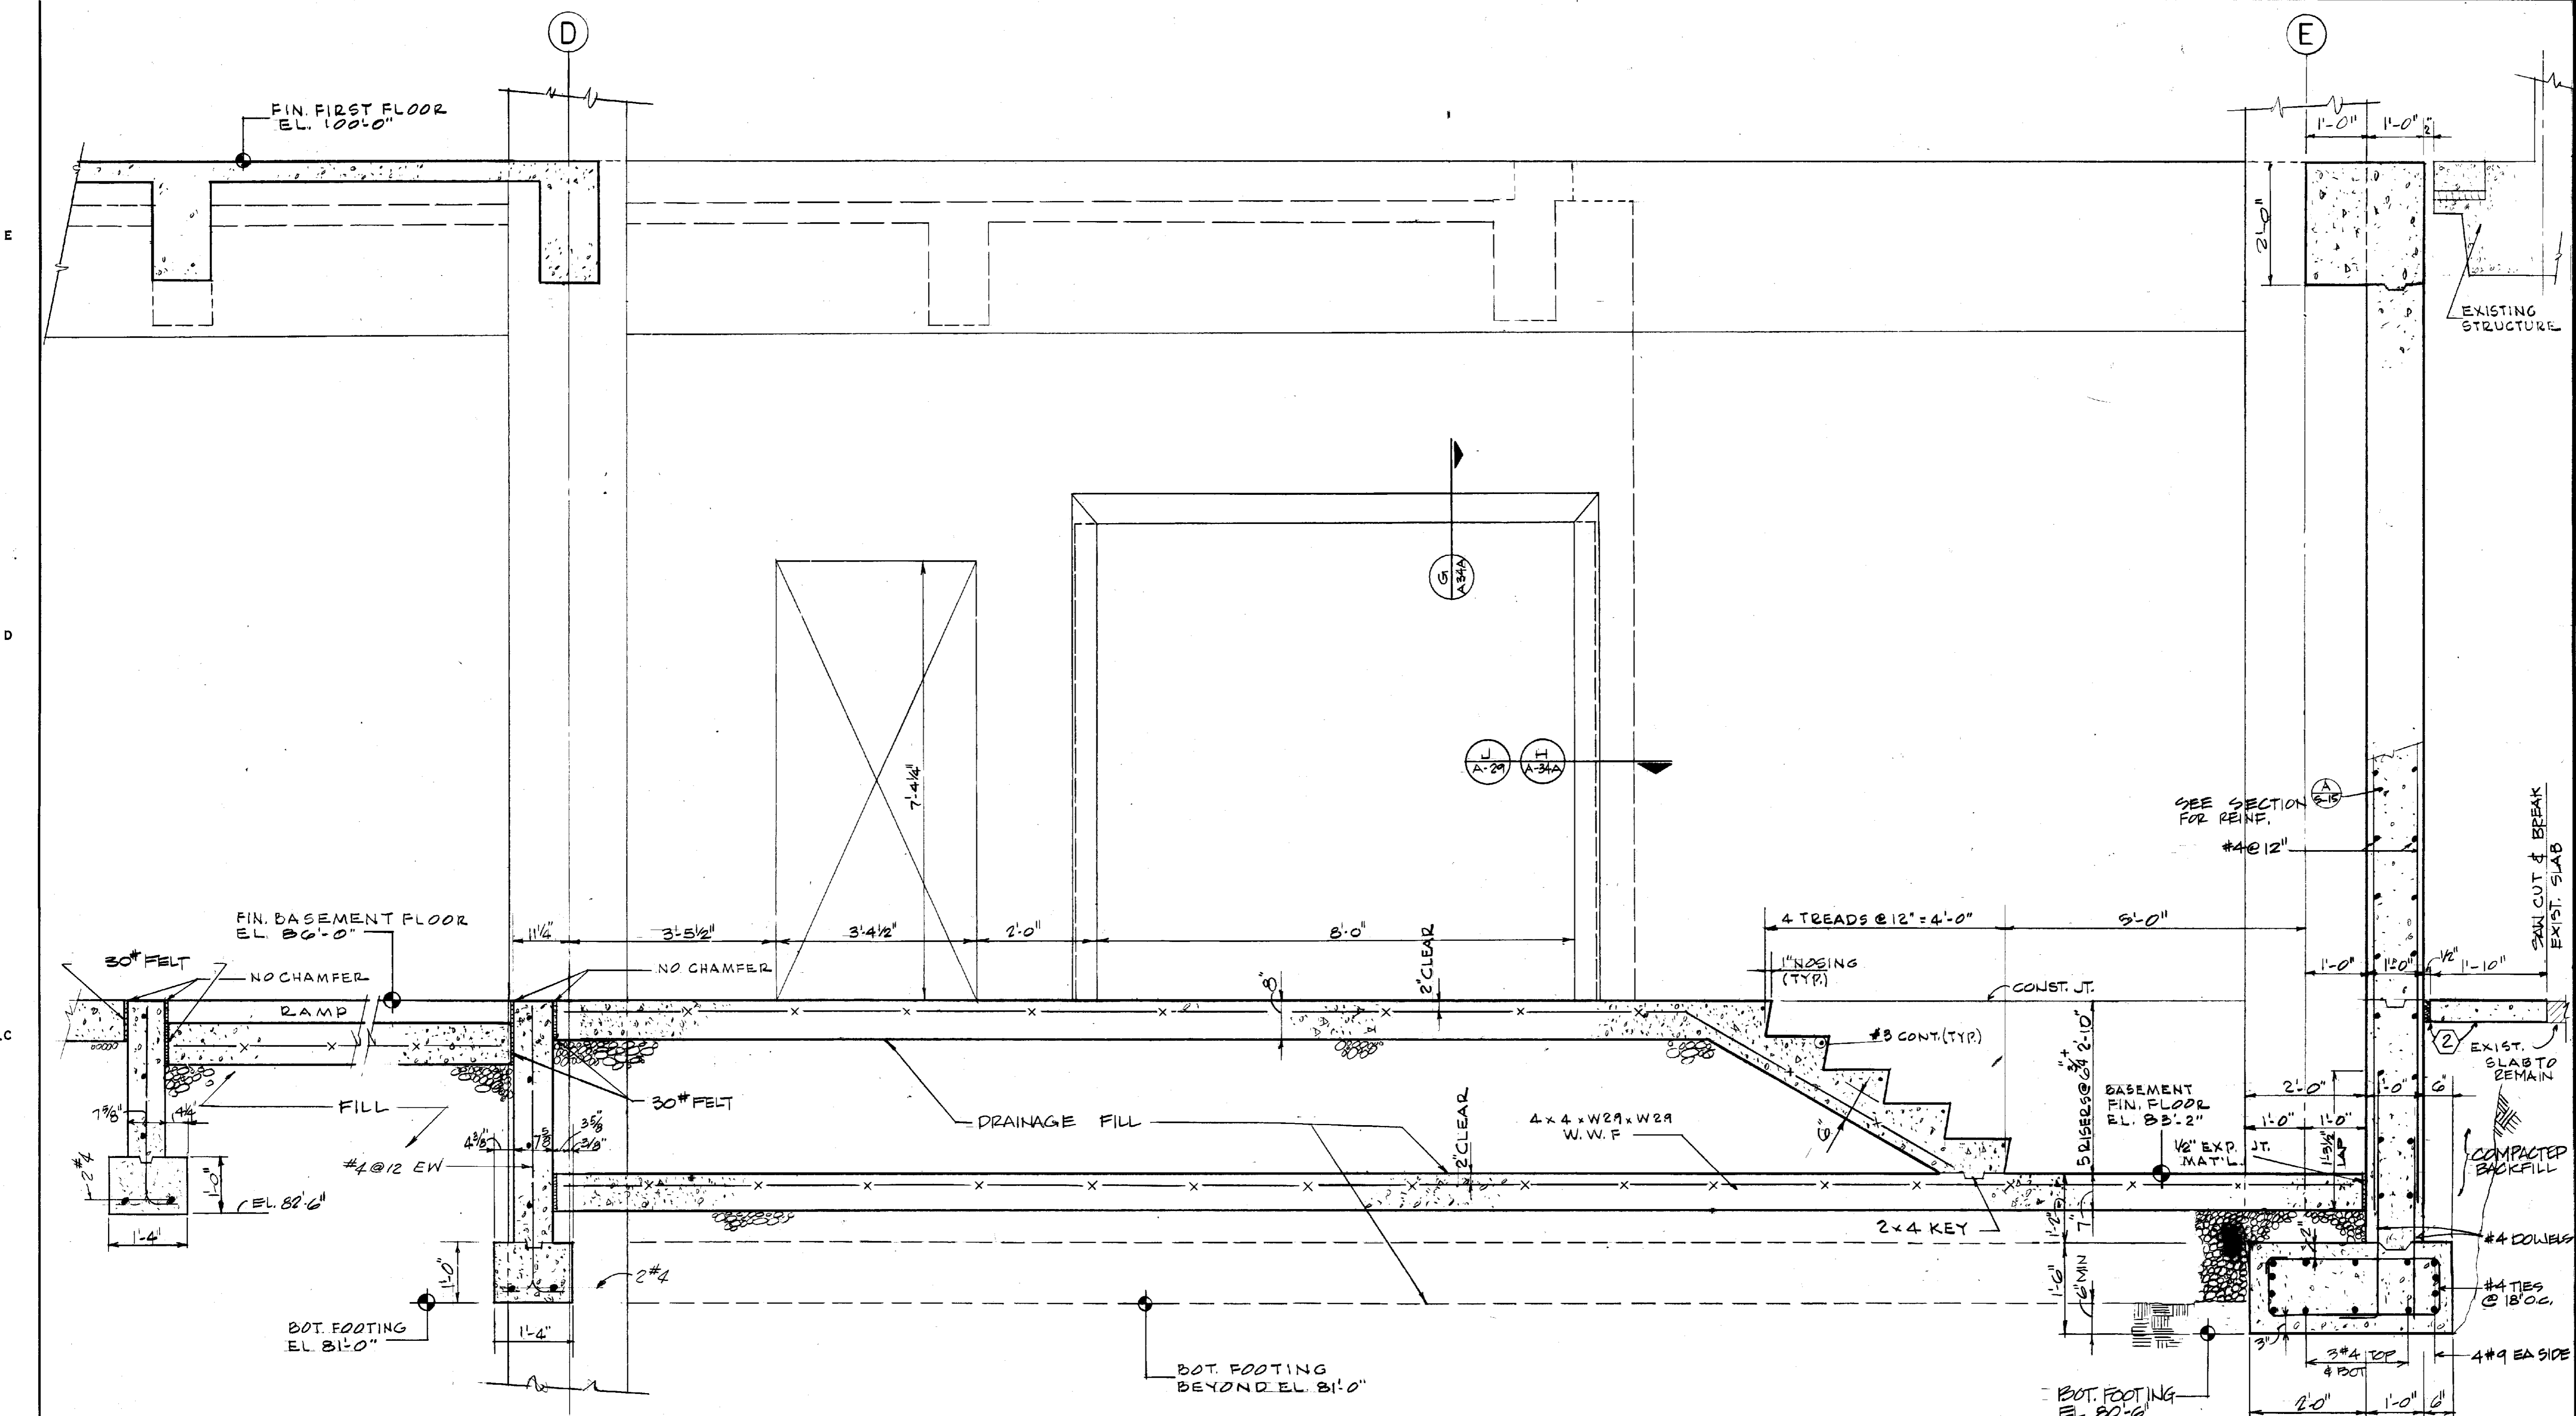

A SECTION
S-13 SCALE: 3/4" = 1'-0"

- ① SEE SHEET S-1 FOR GENERAL NOTES.
- ② AT EXISTING MECHANICAL ROOM SAW CUT AND REMOVE EXISTING SLAB AS INDICATED. CAREFULLY EXCAVATE FOR THE ROBOTICS WALL C-CONSTRUCTION. AFTER THE ROBOTICS WALL HAS BEEN POURED AND CURED, PLACE COMPACTED BACKFILL AND REPLACEMENT SLAB WITH 1/2 INCH EXPANSION JOINT MATERIAL AND ~~ONE~~ SEALER AT THE ROBOTICS WALL.

RECORD PRINTS
THESE ARE RECORD PRINTS OF DRAWINGS BASED UPON MARKED UP PRINTS, DRAWINGS AND OTHER DATA FURNISHED BY THE CONTRACTOR TO THE ENGINEER AND WHICH THE ENGINEER CONSIDERS SIGNIFICANT



ROBOTICS FACILITY
LEXINGTON CAMPUS
UNIVERSITY OF KENTUCKY
LEXINGTON, KENTUCKY


University of Kentucky
Lexington, Kentucky
Sherman Carter Barnhart
Director - Design and Construction Division
19.872

FOUNDATION DETAILS
SHERMAN CARTER BARNHART
PARTNERS IN ARCHITECTURE
SHELLEY, MOORE & JEAR, WEST MAIN STREET - LEXINGTON, KY 40502 - 586-2410


JOB NO.	2046
DATE	10-19-81
DRAWN	V.T.J.
CHECKED	A.L.P.
FILE NO.	431.0

REVISIONS


SHEET
9-13

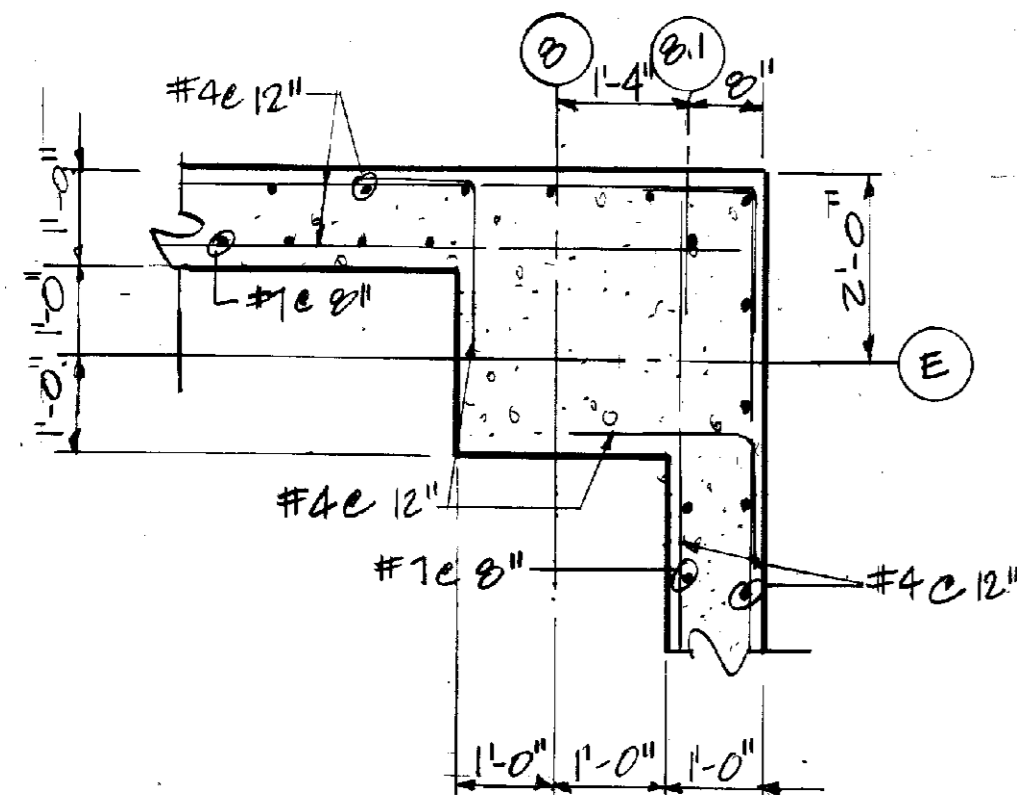


1 DETAIL
S-14 SCALE: 1/2" = 1'-0"

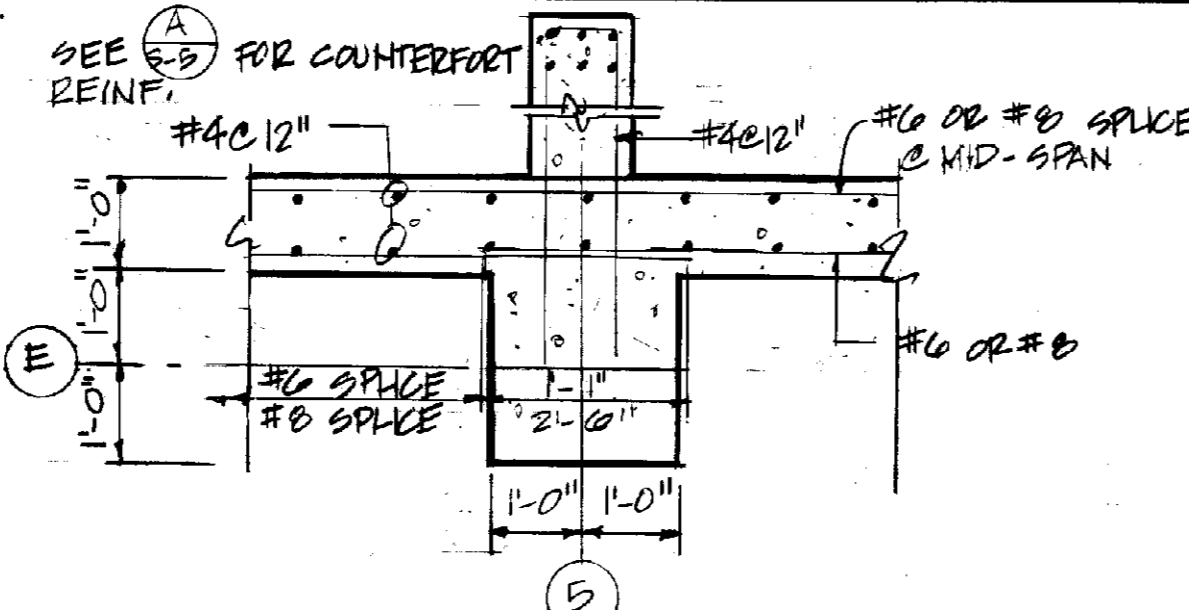


2 DETAIL
S-14 SCALE: 1/2" = 1'-0"

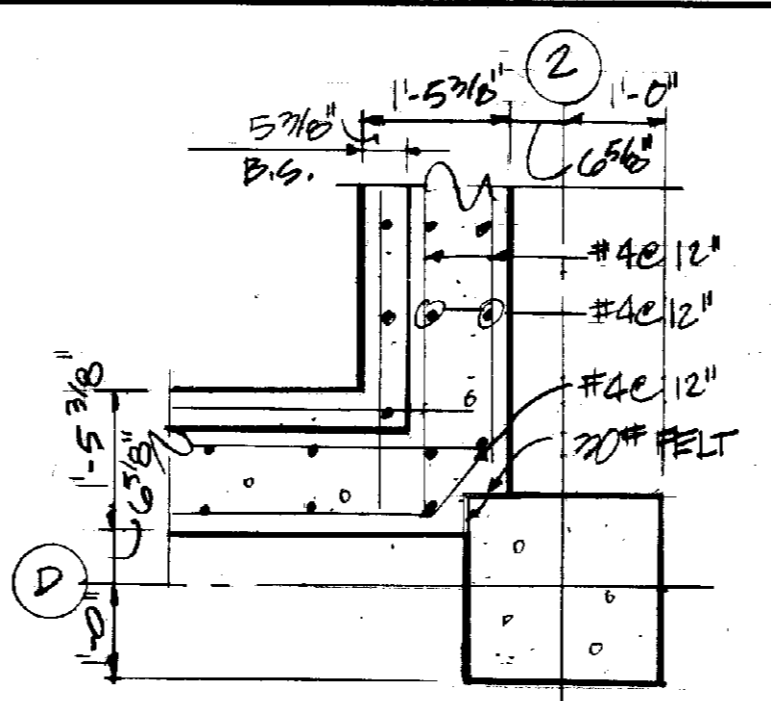


3 DETAIL
S-14 SCALE: 1/2" = 1'-0"

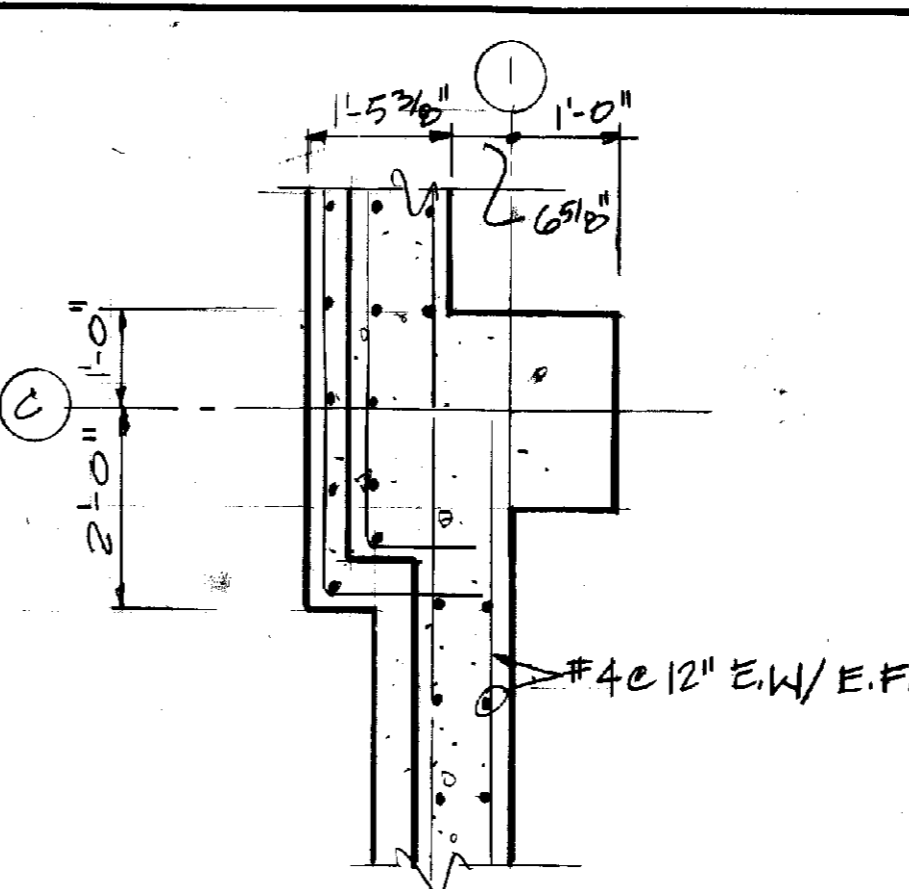


4 DETAIL
S-14 SCALE: 1/2" = 1'-0"

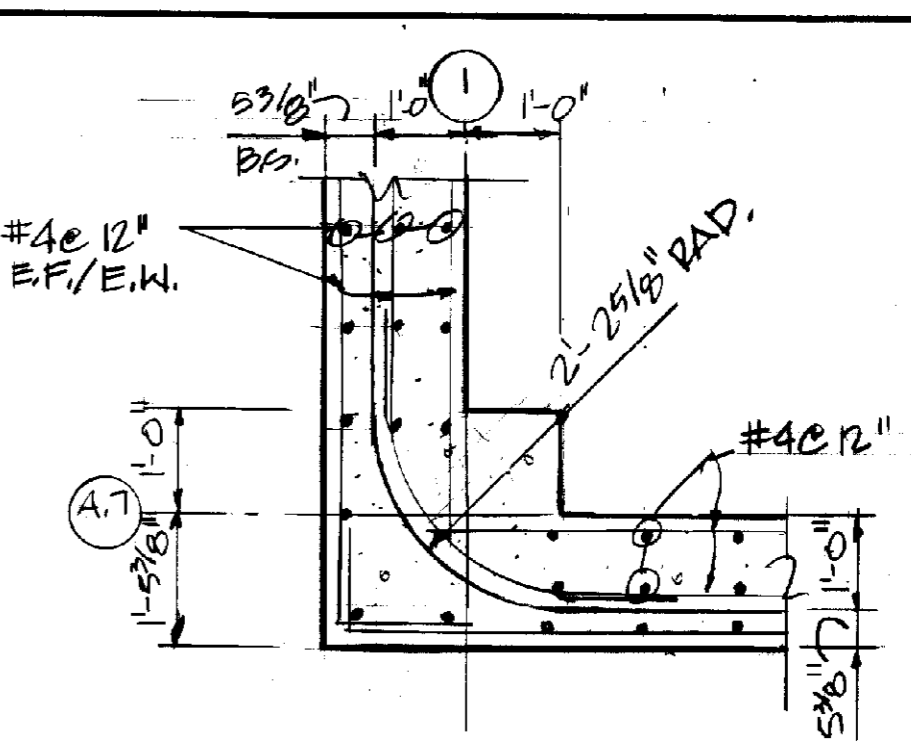


5 DETAIL
S-14 SCALE: 1/2" = 1'-0"

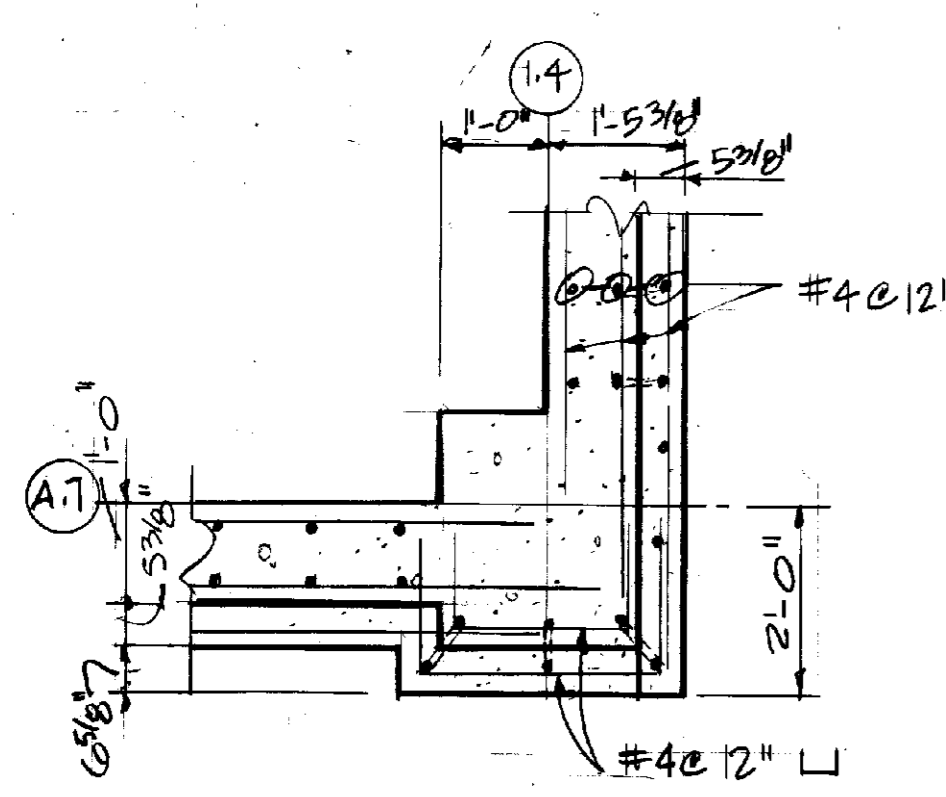


6 DETAIL
S-14 SCALE: 1/2" = 1'-0"

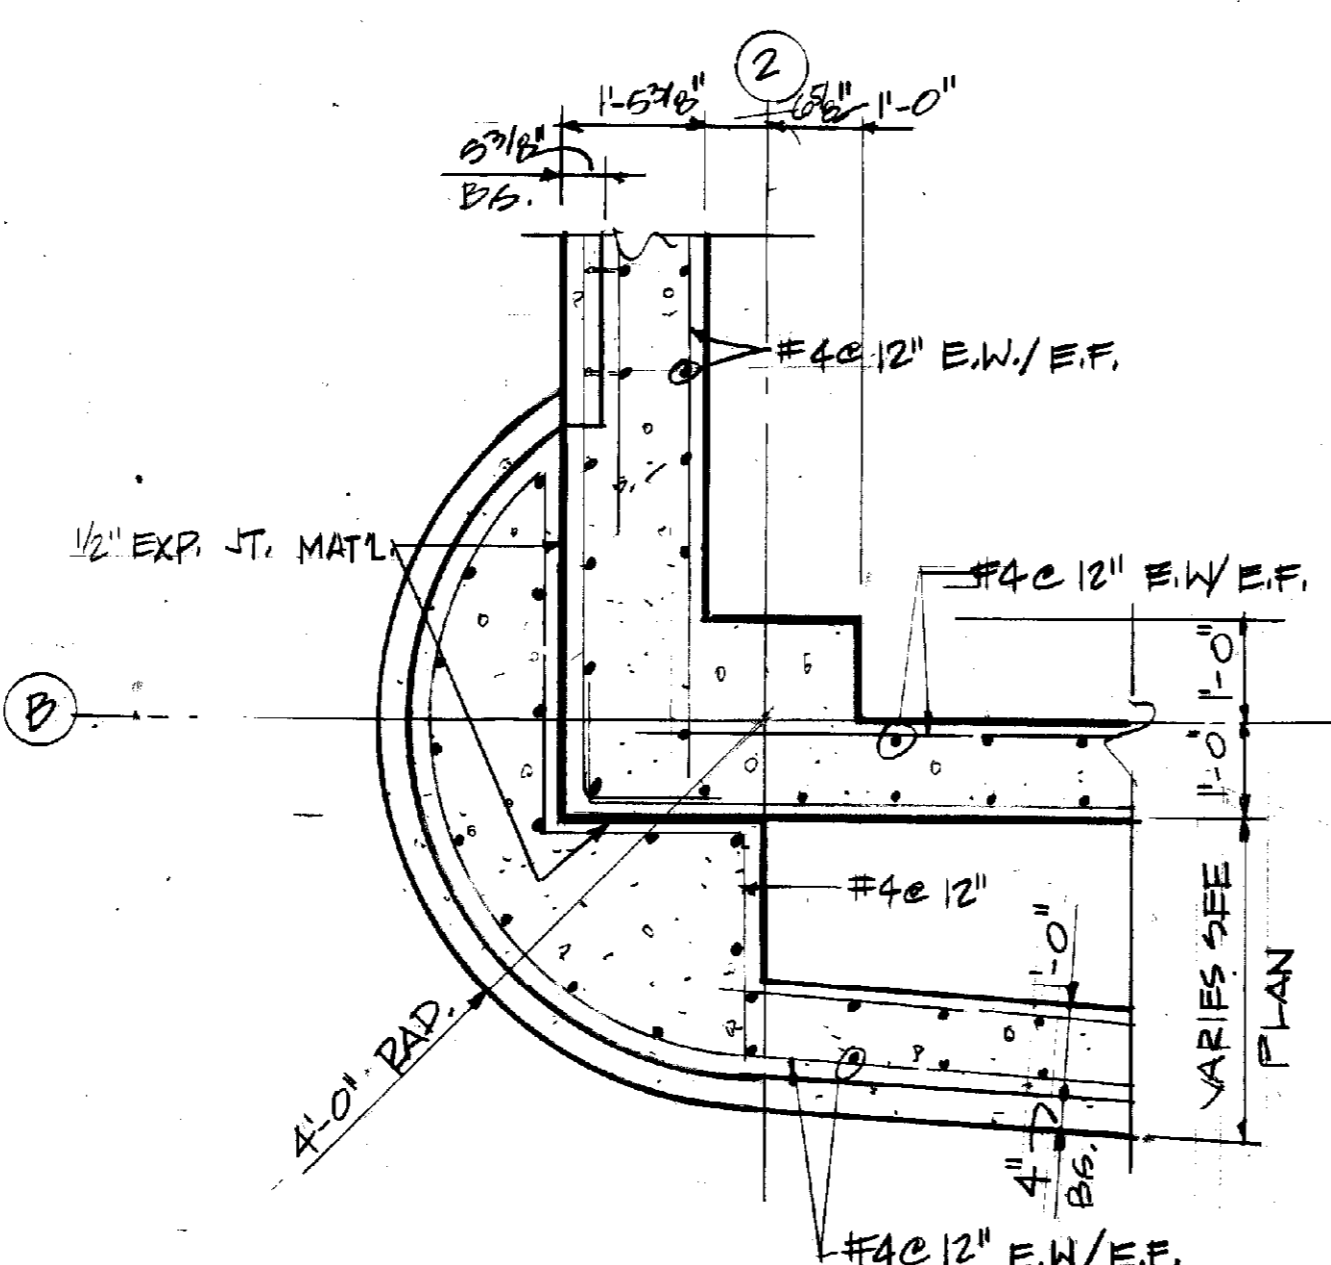


7 DETAIL
S-14 SCALE: 1/2" = 1'-0"

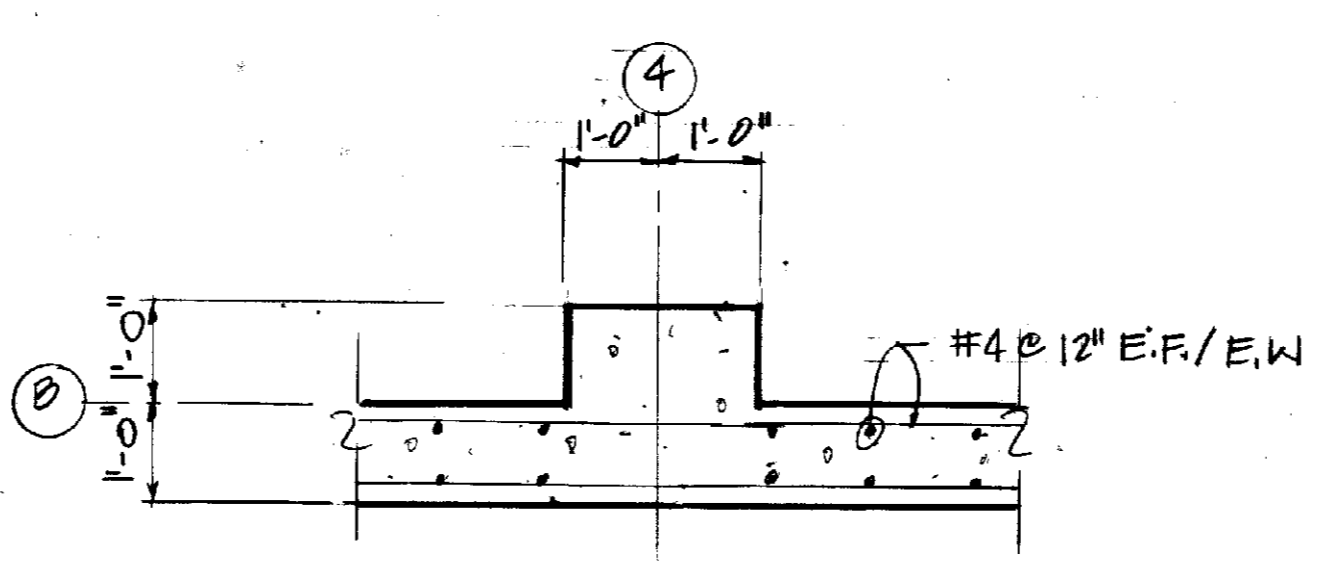


8 DETAIL
S-14 SCALE: 1/2" = 1'-0"

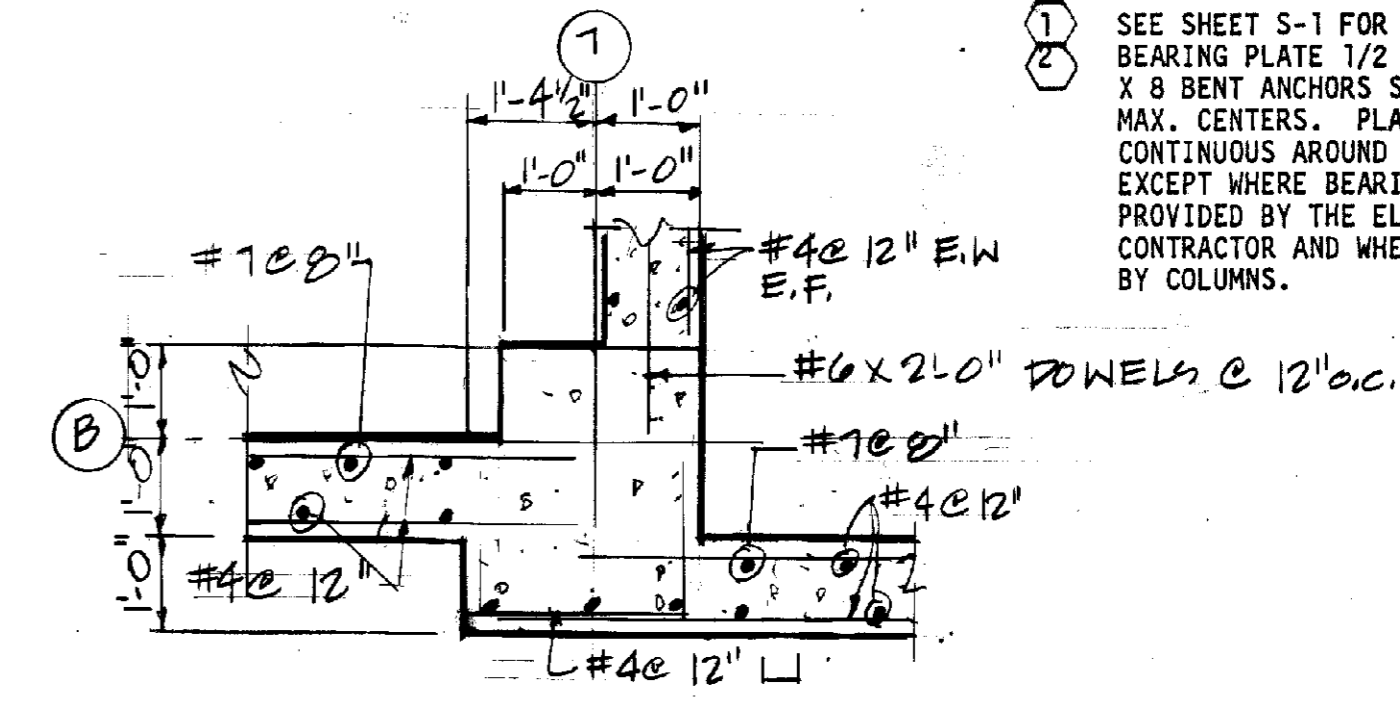


9 DETAIL
S-14 SCALE: 1/2" = 1'-0"

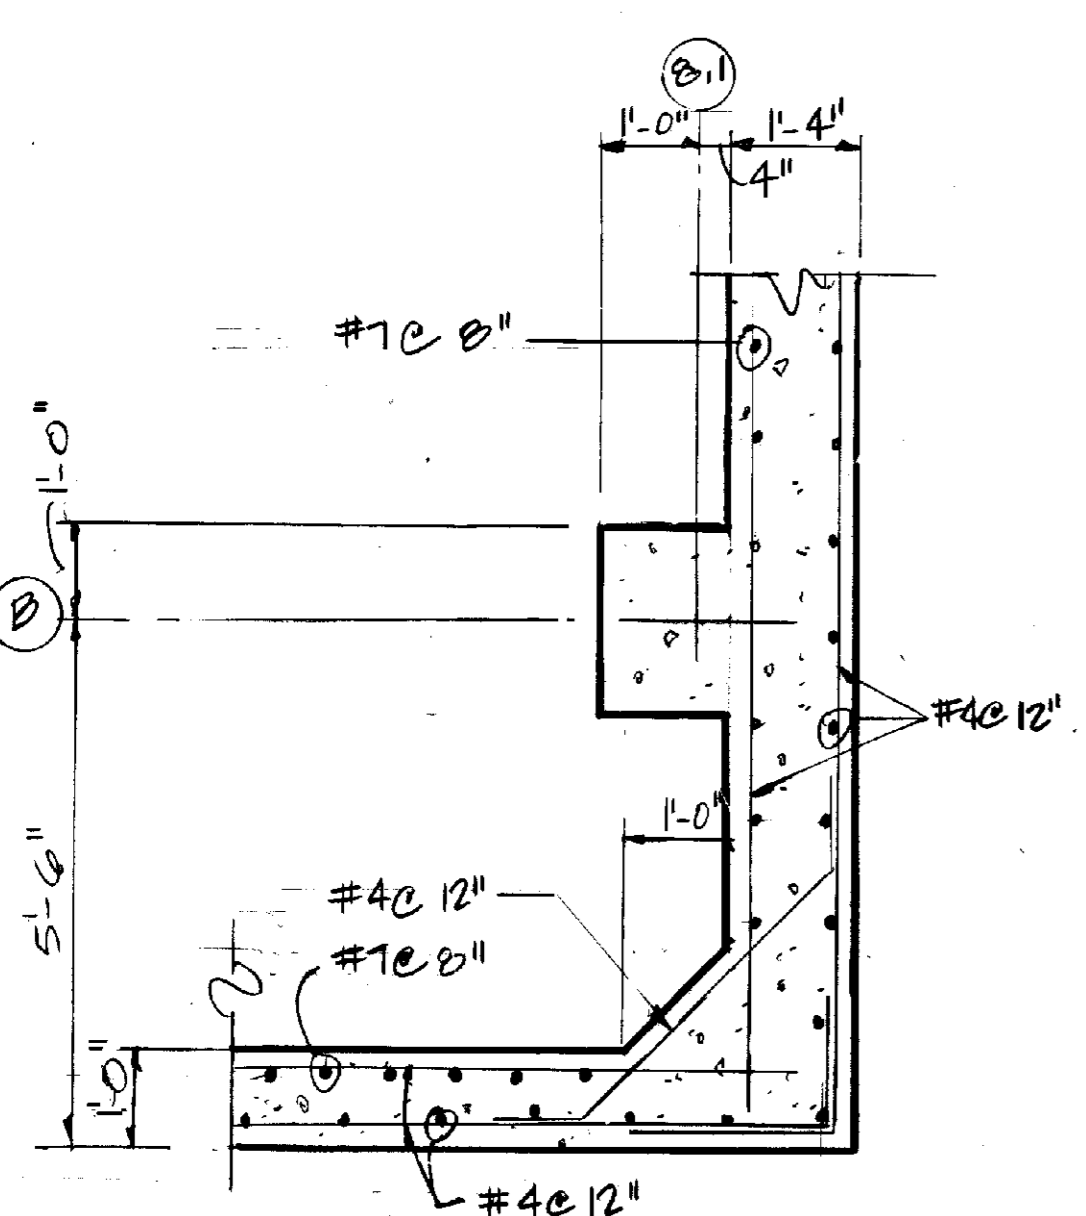

10 DETAIL
S-14 SCALE: 1/2" = 1'-0"

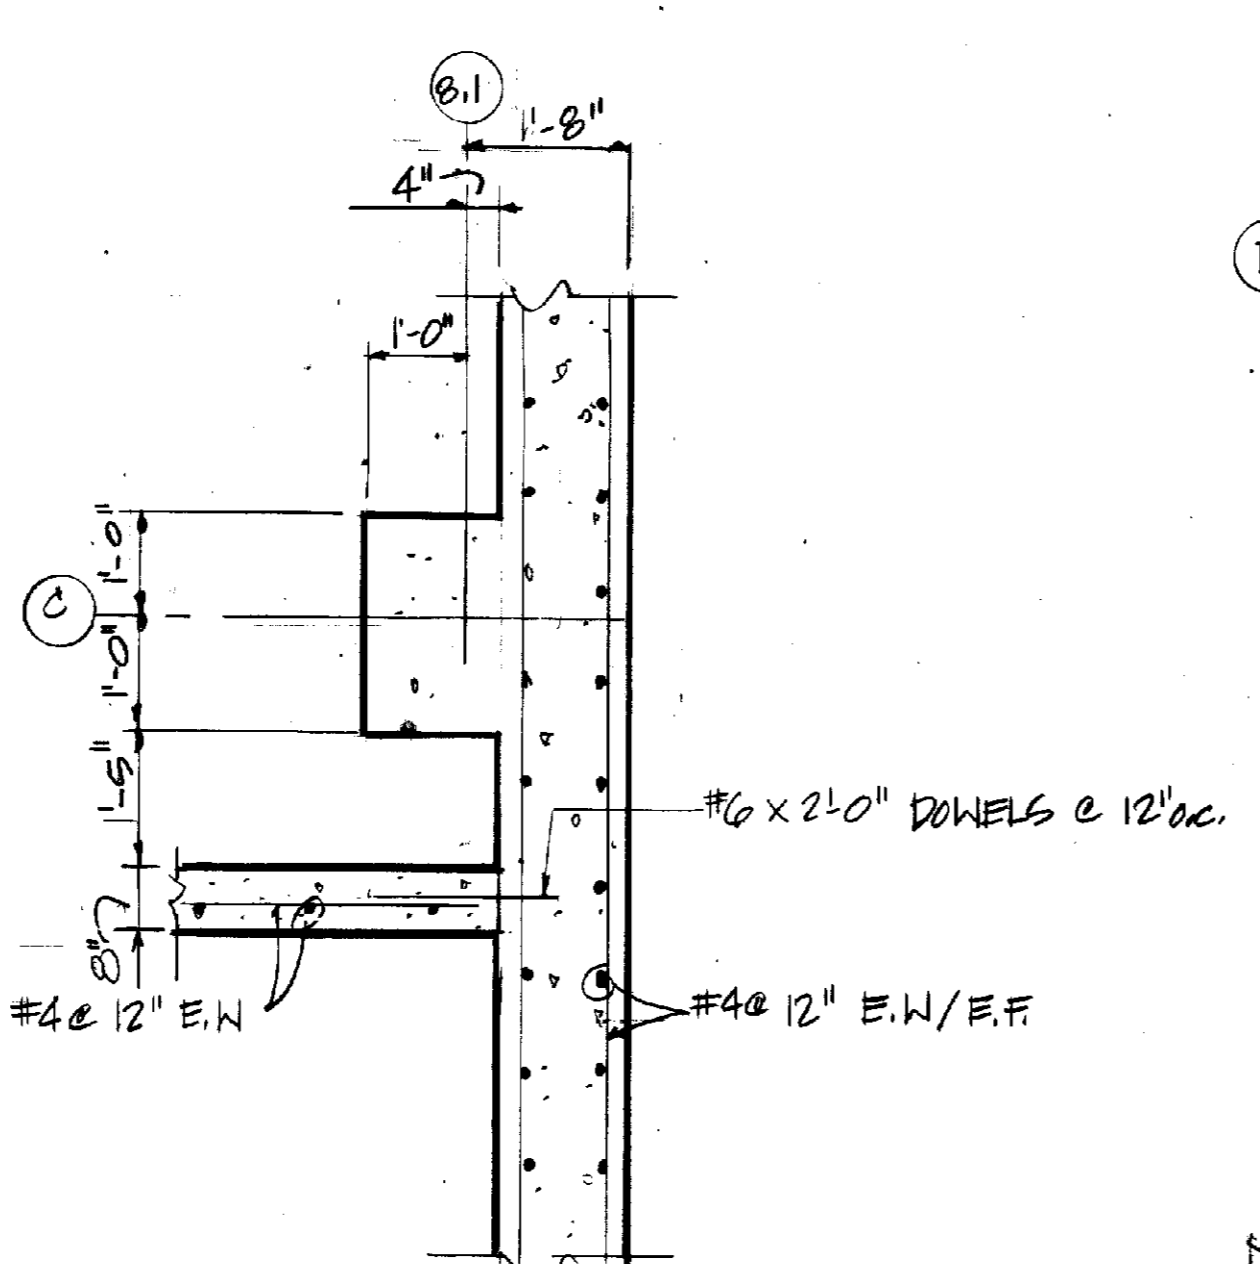


11 DETAIL
S-14 SCALE: 1/2" = 1'-0"

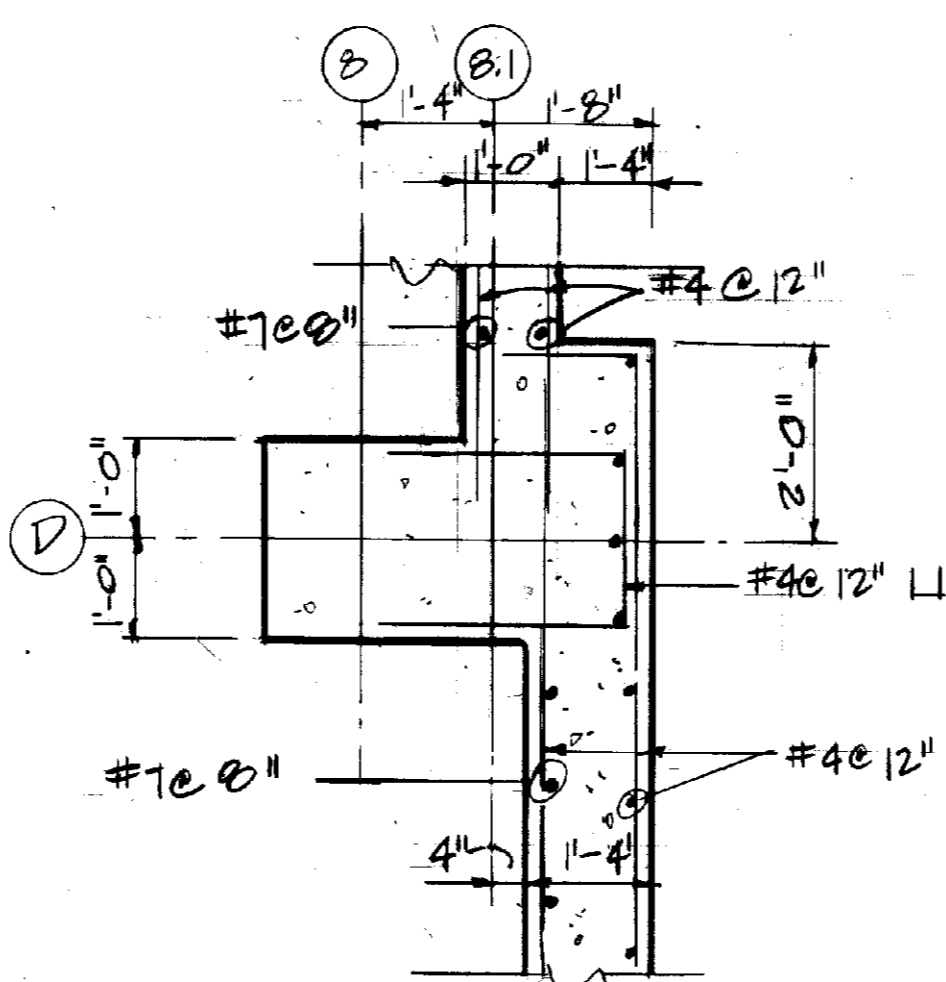


12 DETAIL
S-14 SCALE: 1/2" = 1'-0"

NOTE:
SEE COLUMN SCHEDULE FOR COLUMN REINF. NOT SHOWN IN DETAILS 1 THRU 12.

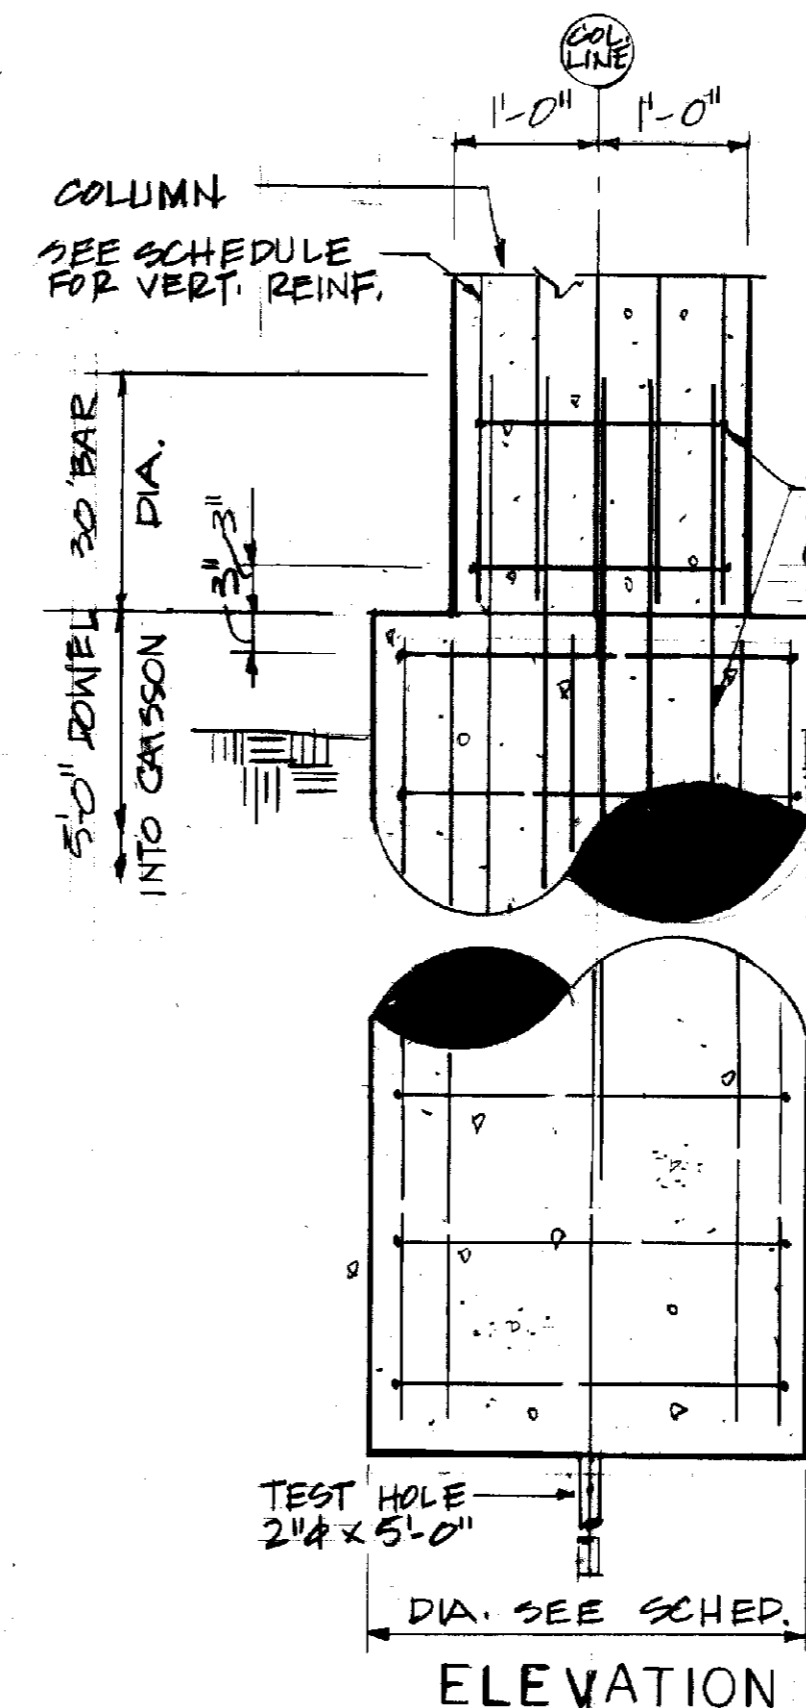

13 TYPICAL CAISSON DETAIL
S-14 SCALE: 3/4" = 1'-0"

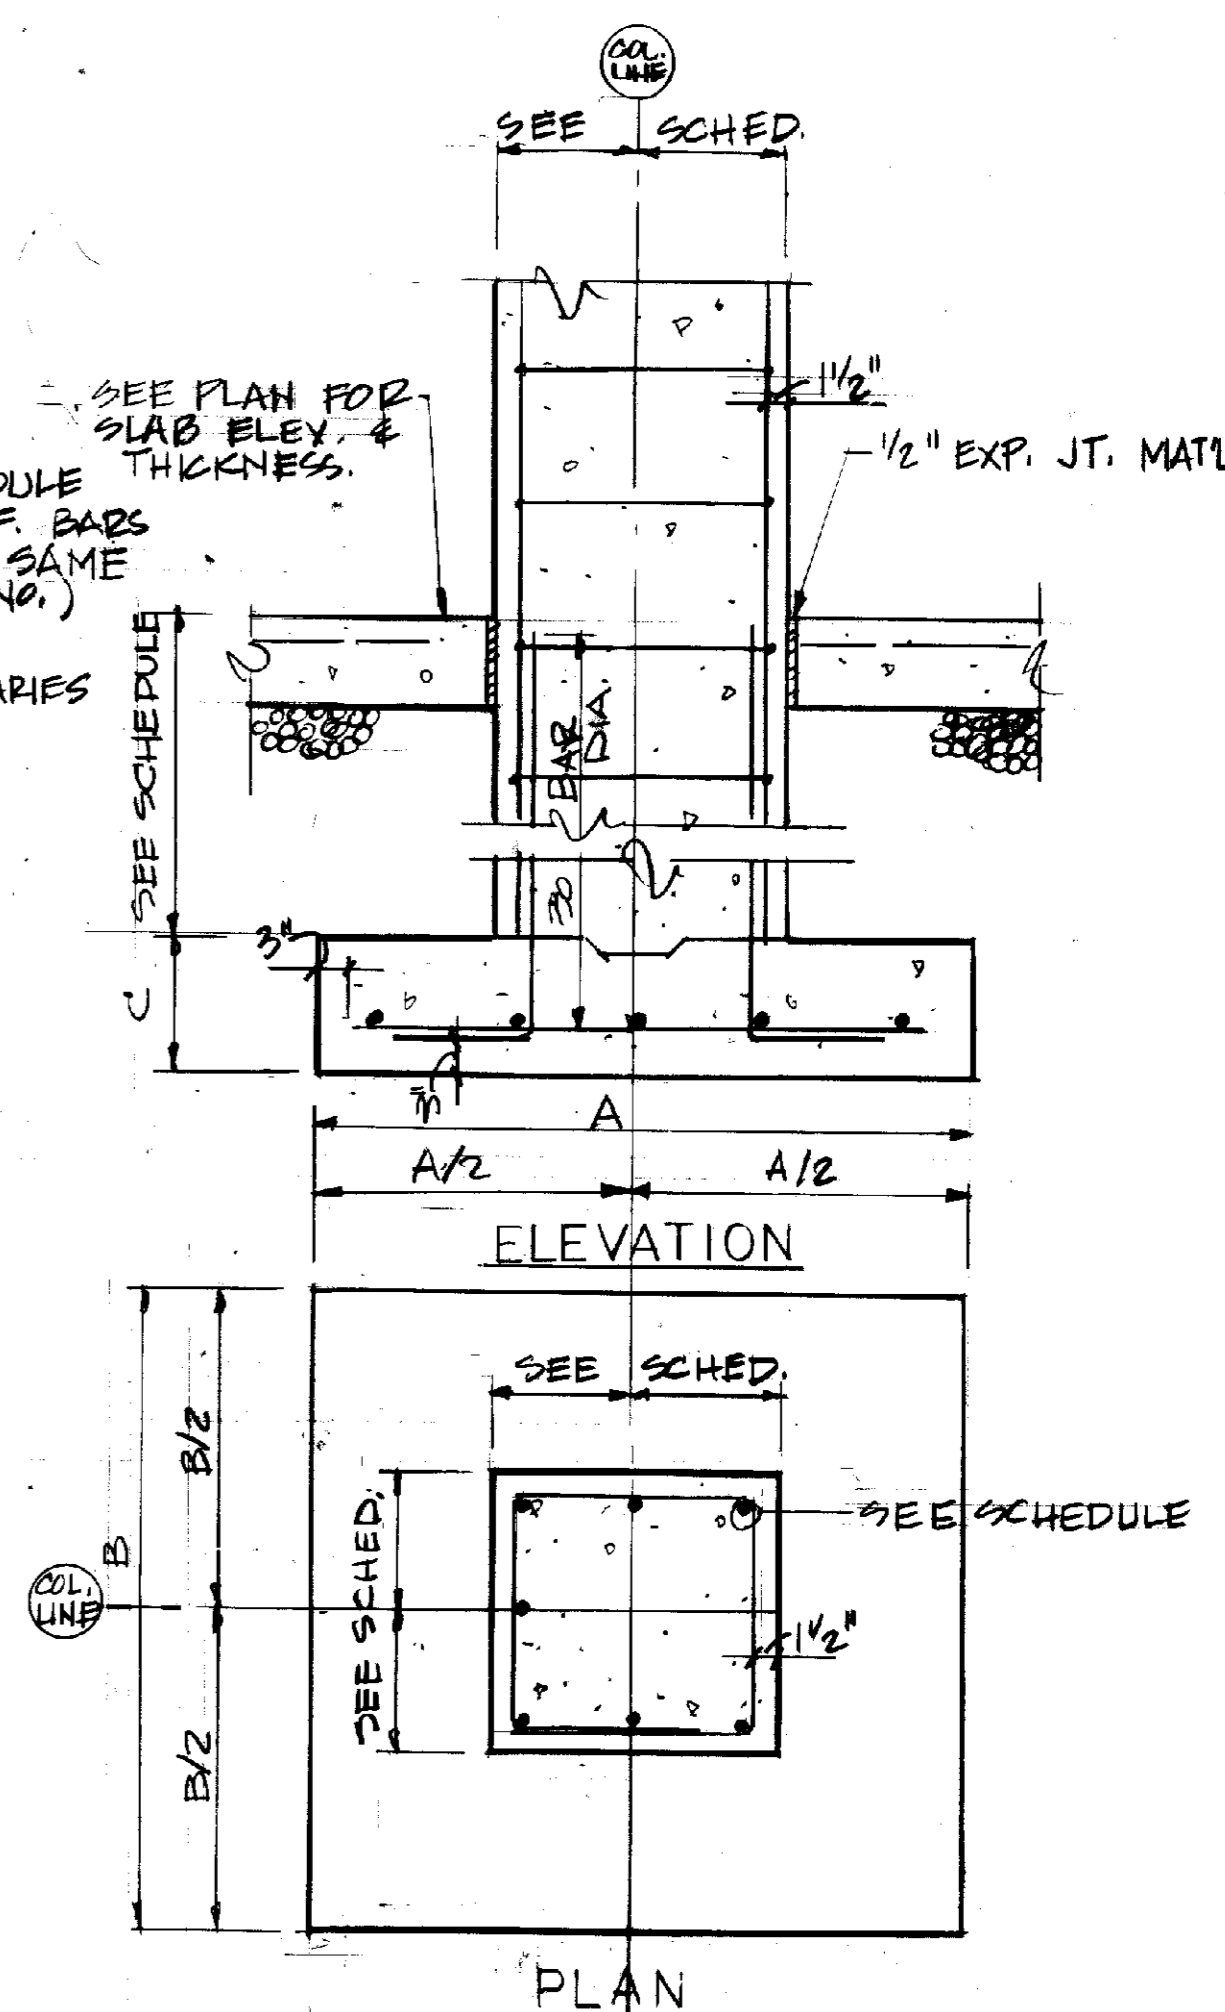

14 TYPICAL PIER & FOOTING
S-14 SCALE: 3/4" = 1'-0"

S-14
SEE SHEET S-1 FOR GENERAL NOTES BEARING PLATE 1/2 X 6 WITH 5/8 X 8 BENT ANCHORS SPACED AT 1'-6" MAX. CENTERS. PLATES ARE CONTINUOUS AROUND THE HOISTWAY EXCEPT WHERE BEARING PLATES ARE PROVIDED BY THE ELEVATOR CONTRACTOR AND WHERE INTERRUPTED BY COLUMNS.

RECORD PRINTS
THESE ARE RECORD PRINTS OF DRAWINGS BASED UPON MARKED UP PRINTS, DRAWINGS AND OTHER DATA FURNISHED BY THE CONTRACTOR TO THE ENGINEER AND WHICH THE ENGINEER CONSIDERS SIGNIFICANT.

ROBOTICS FACILITY
LEXINGTON CAMPUS
UNIVERSITY OF KENTUCKY
LEXINGTON, KENTUCKY

University of Kentucky
Lexington, Kentucky


FOUNDATION DETAILS
Sherman Carter Barnhart
PARTNERS IN ARCHITECTURE

JOB NO. 2046
DATE 10-19-87
DRAWN M.A.A.
CHECKED PFH
FILE NO. 4310

NO.	REVISIONS

SHEET
S-14

MASON & HANGER ENGINEERING INC.
ARCHITECT • ENGINEERS
LEXINGTON, KENTUCKY

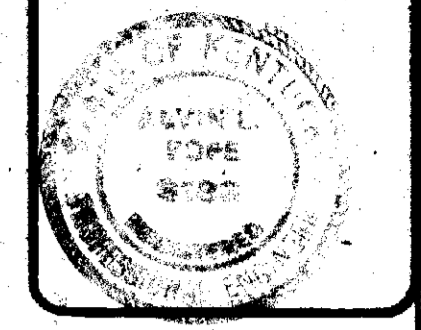

ROBOTICS FACILITY
LEXINGTON CAMPUS
UNIVERSITY OF KENTUCKY
LEXINGTON, KENTUCKY

University of Kentucky
Lexington, Kentucky
SHERMAN CARTER BARNHART ARCHITECTS
PARTNERS IN ARCHITECTURE
SUITE 1000 • 500 WEST MAIN STREET • LEXINGTON, KY 40502 • 502.254.2500


FOUNDATION DETAILS
Sherman Carter Barnhart
PARTNERS IN ARCHITECTURE

JOB NO 2046
DATE 10-19-87
DRAWN M.A.A.
CHECKED A.L.P./P.H.
FILE NO 431.0


NO.	REVISIONS

SHEET
S-15


- NOTES
- SEE SHEET S-1 FOR GENERAL NOTES.
 - DRAINAGE FILL BEHIND THE WALL SHALL BE 1'-0" MINIMUM THICK EXTENDING FROM THE FOUNDATION DRAIN TO ONE FOOT BELOW FINISHED GRADE.

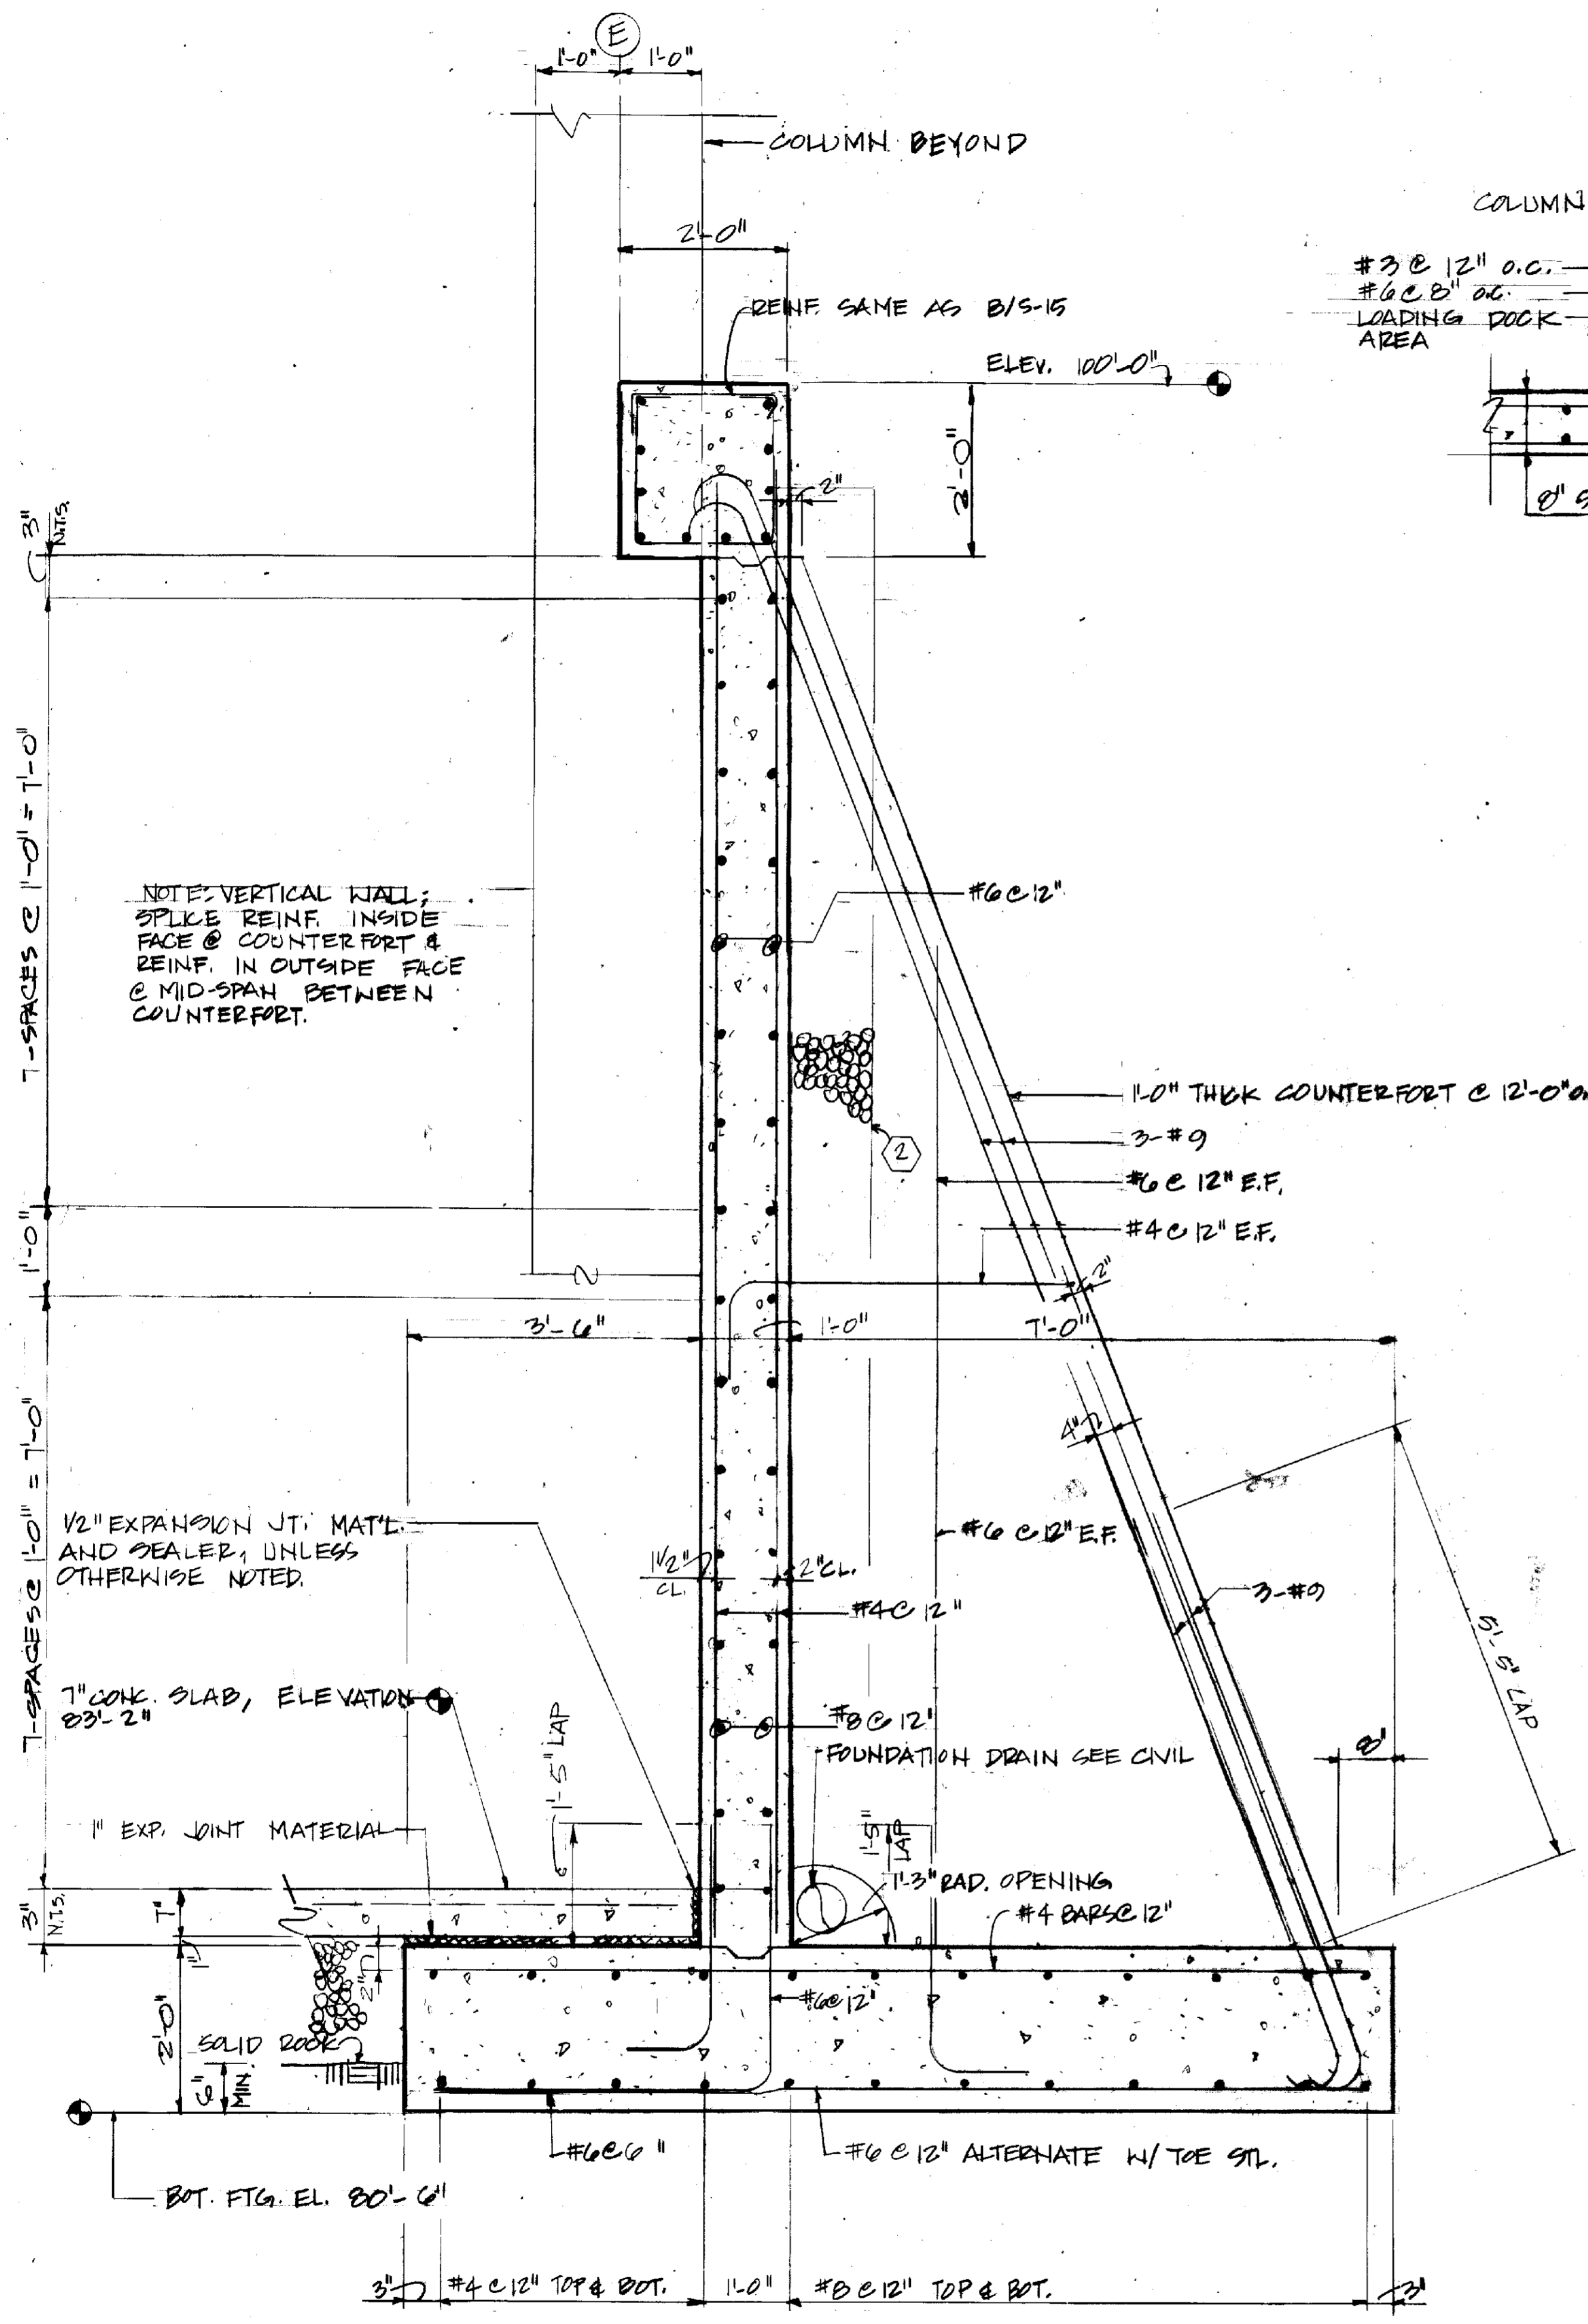


A SECTION
S-15 SCALE: 3/4"=1'-0"

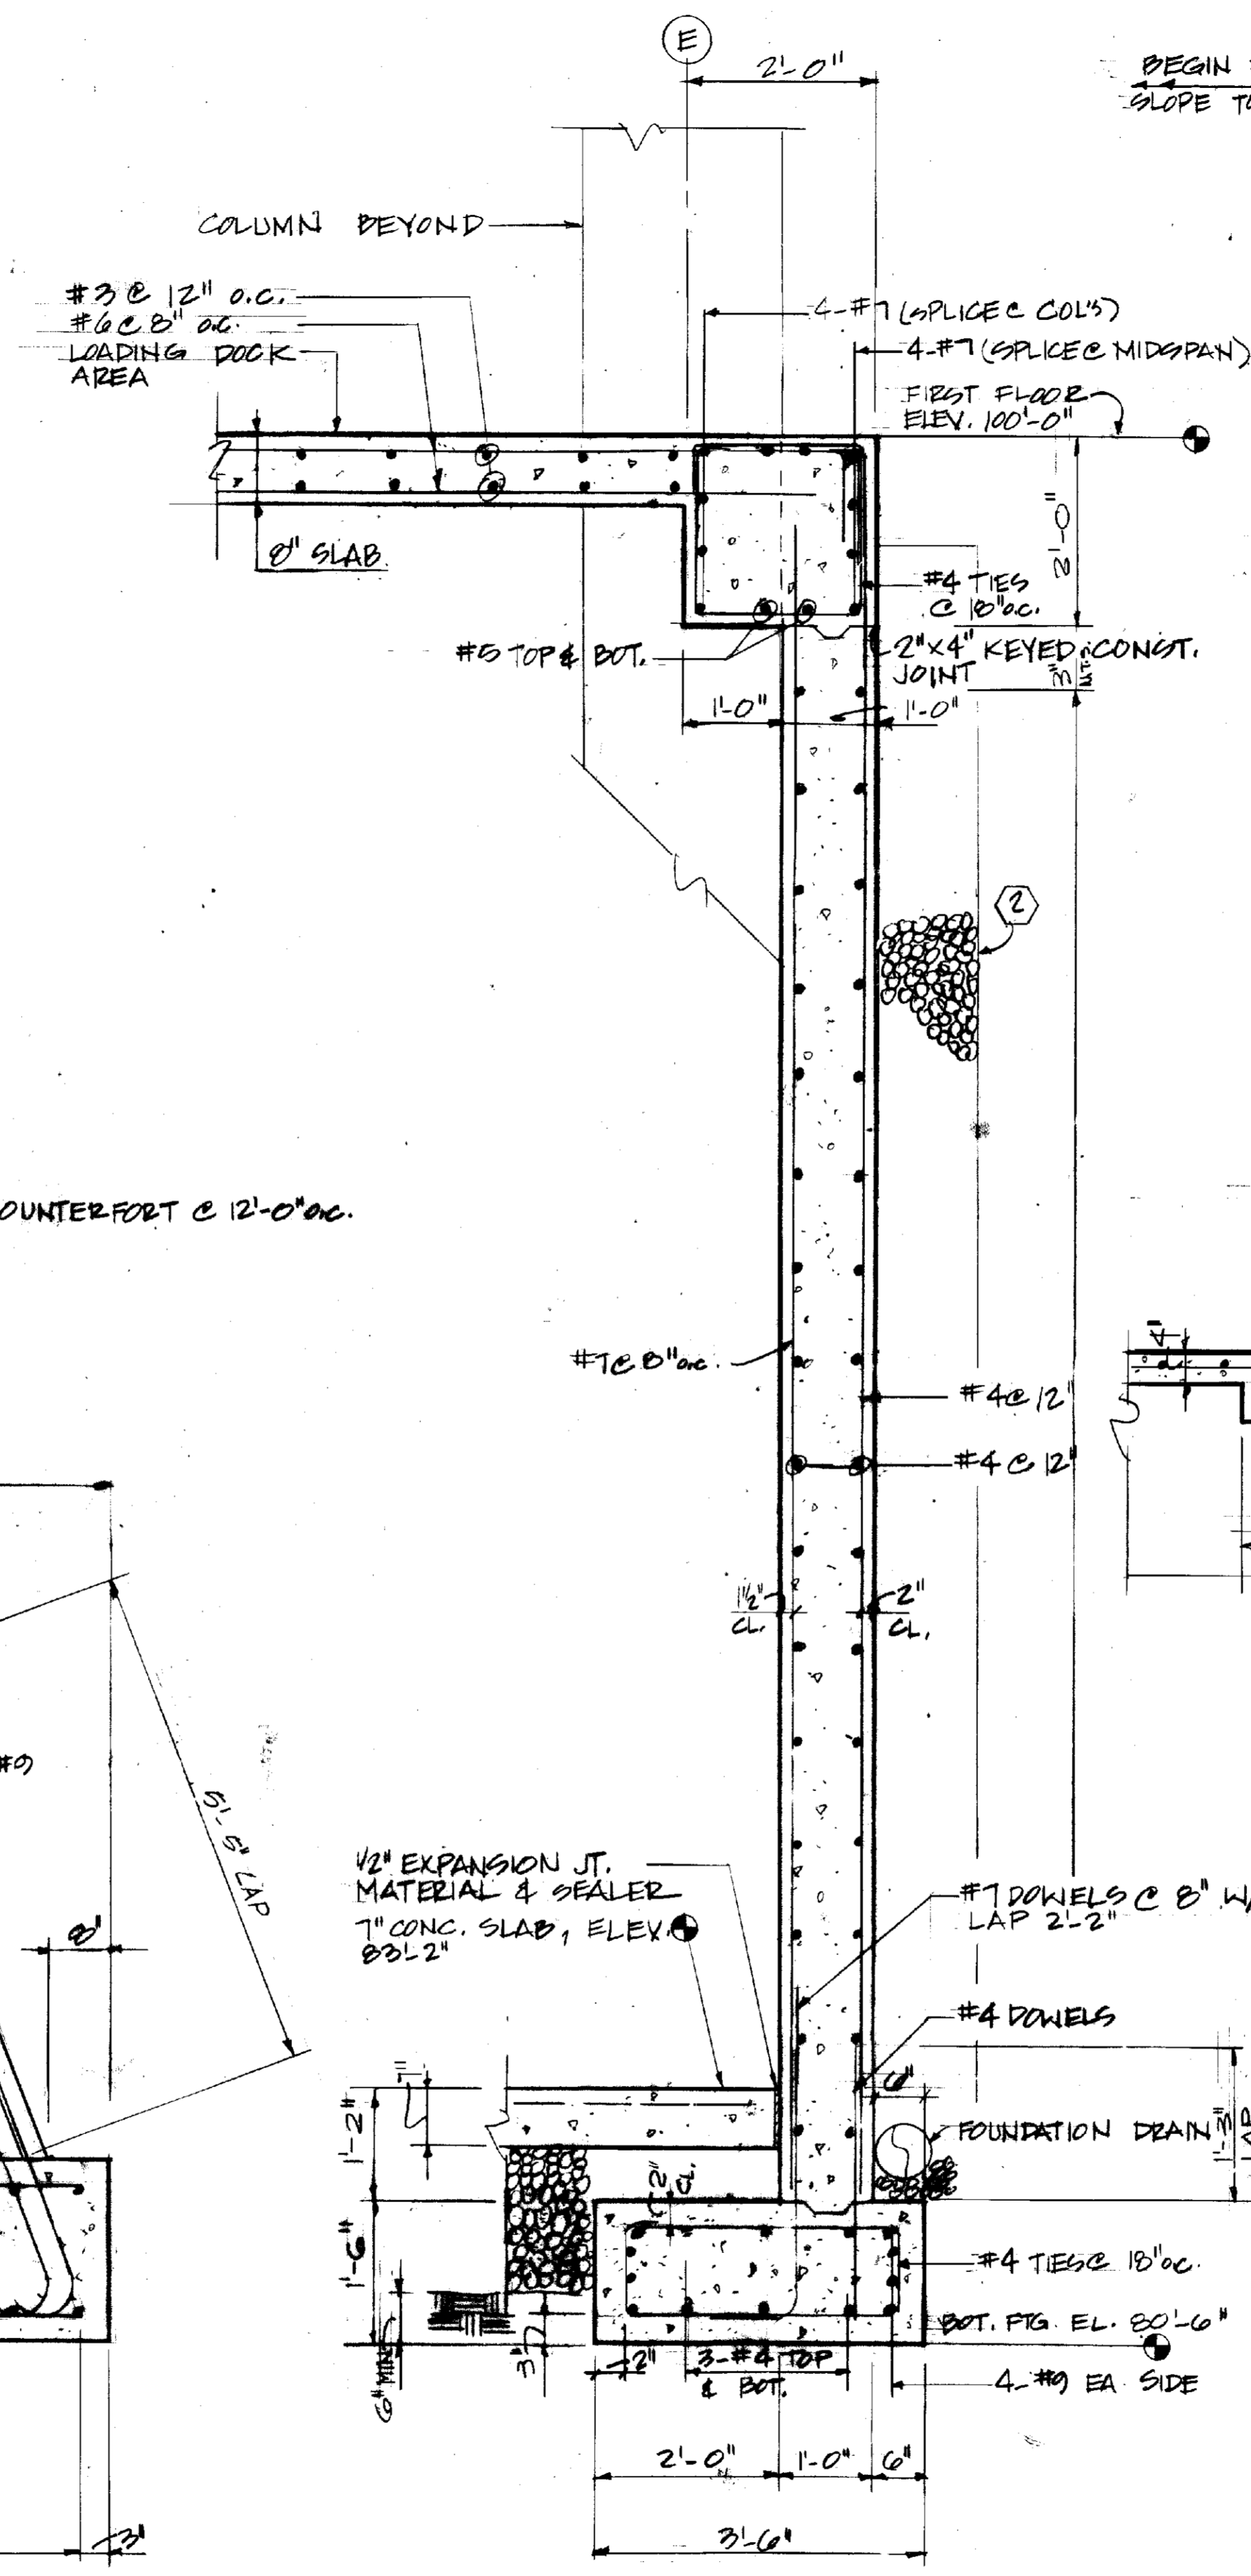


B SECTION
S-15 SCALE: 3/4"=1'-0"

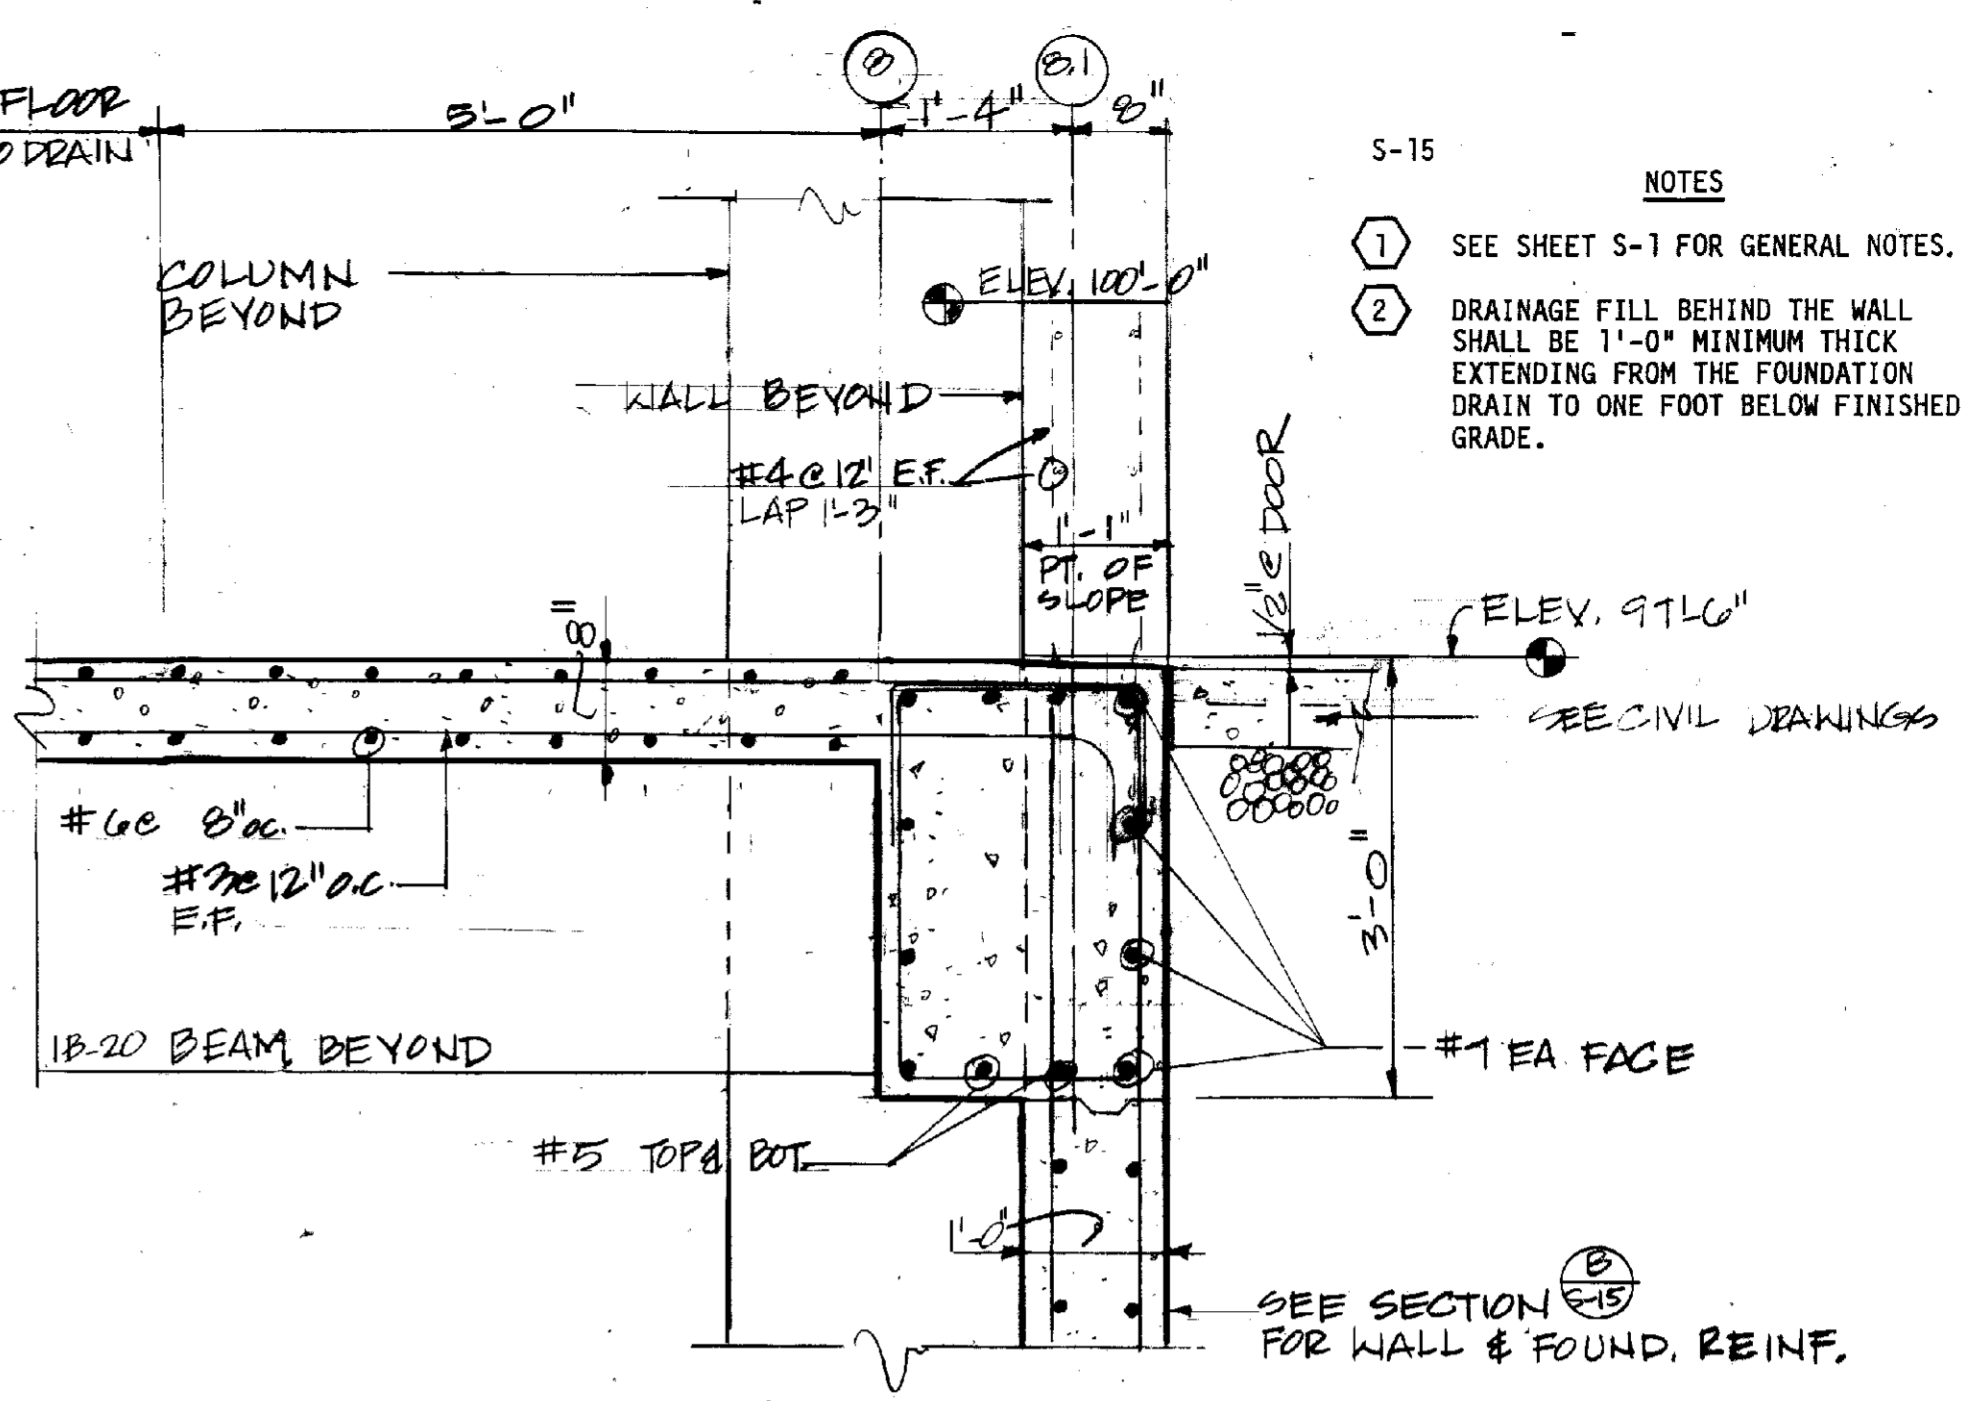

C SECTION
S-15 SCALE: 3/4"=1'-0"

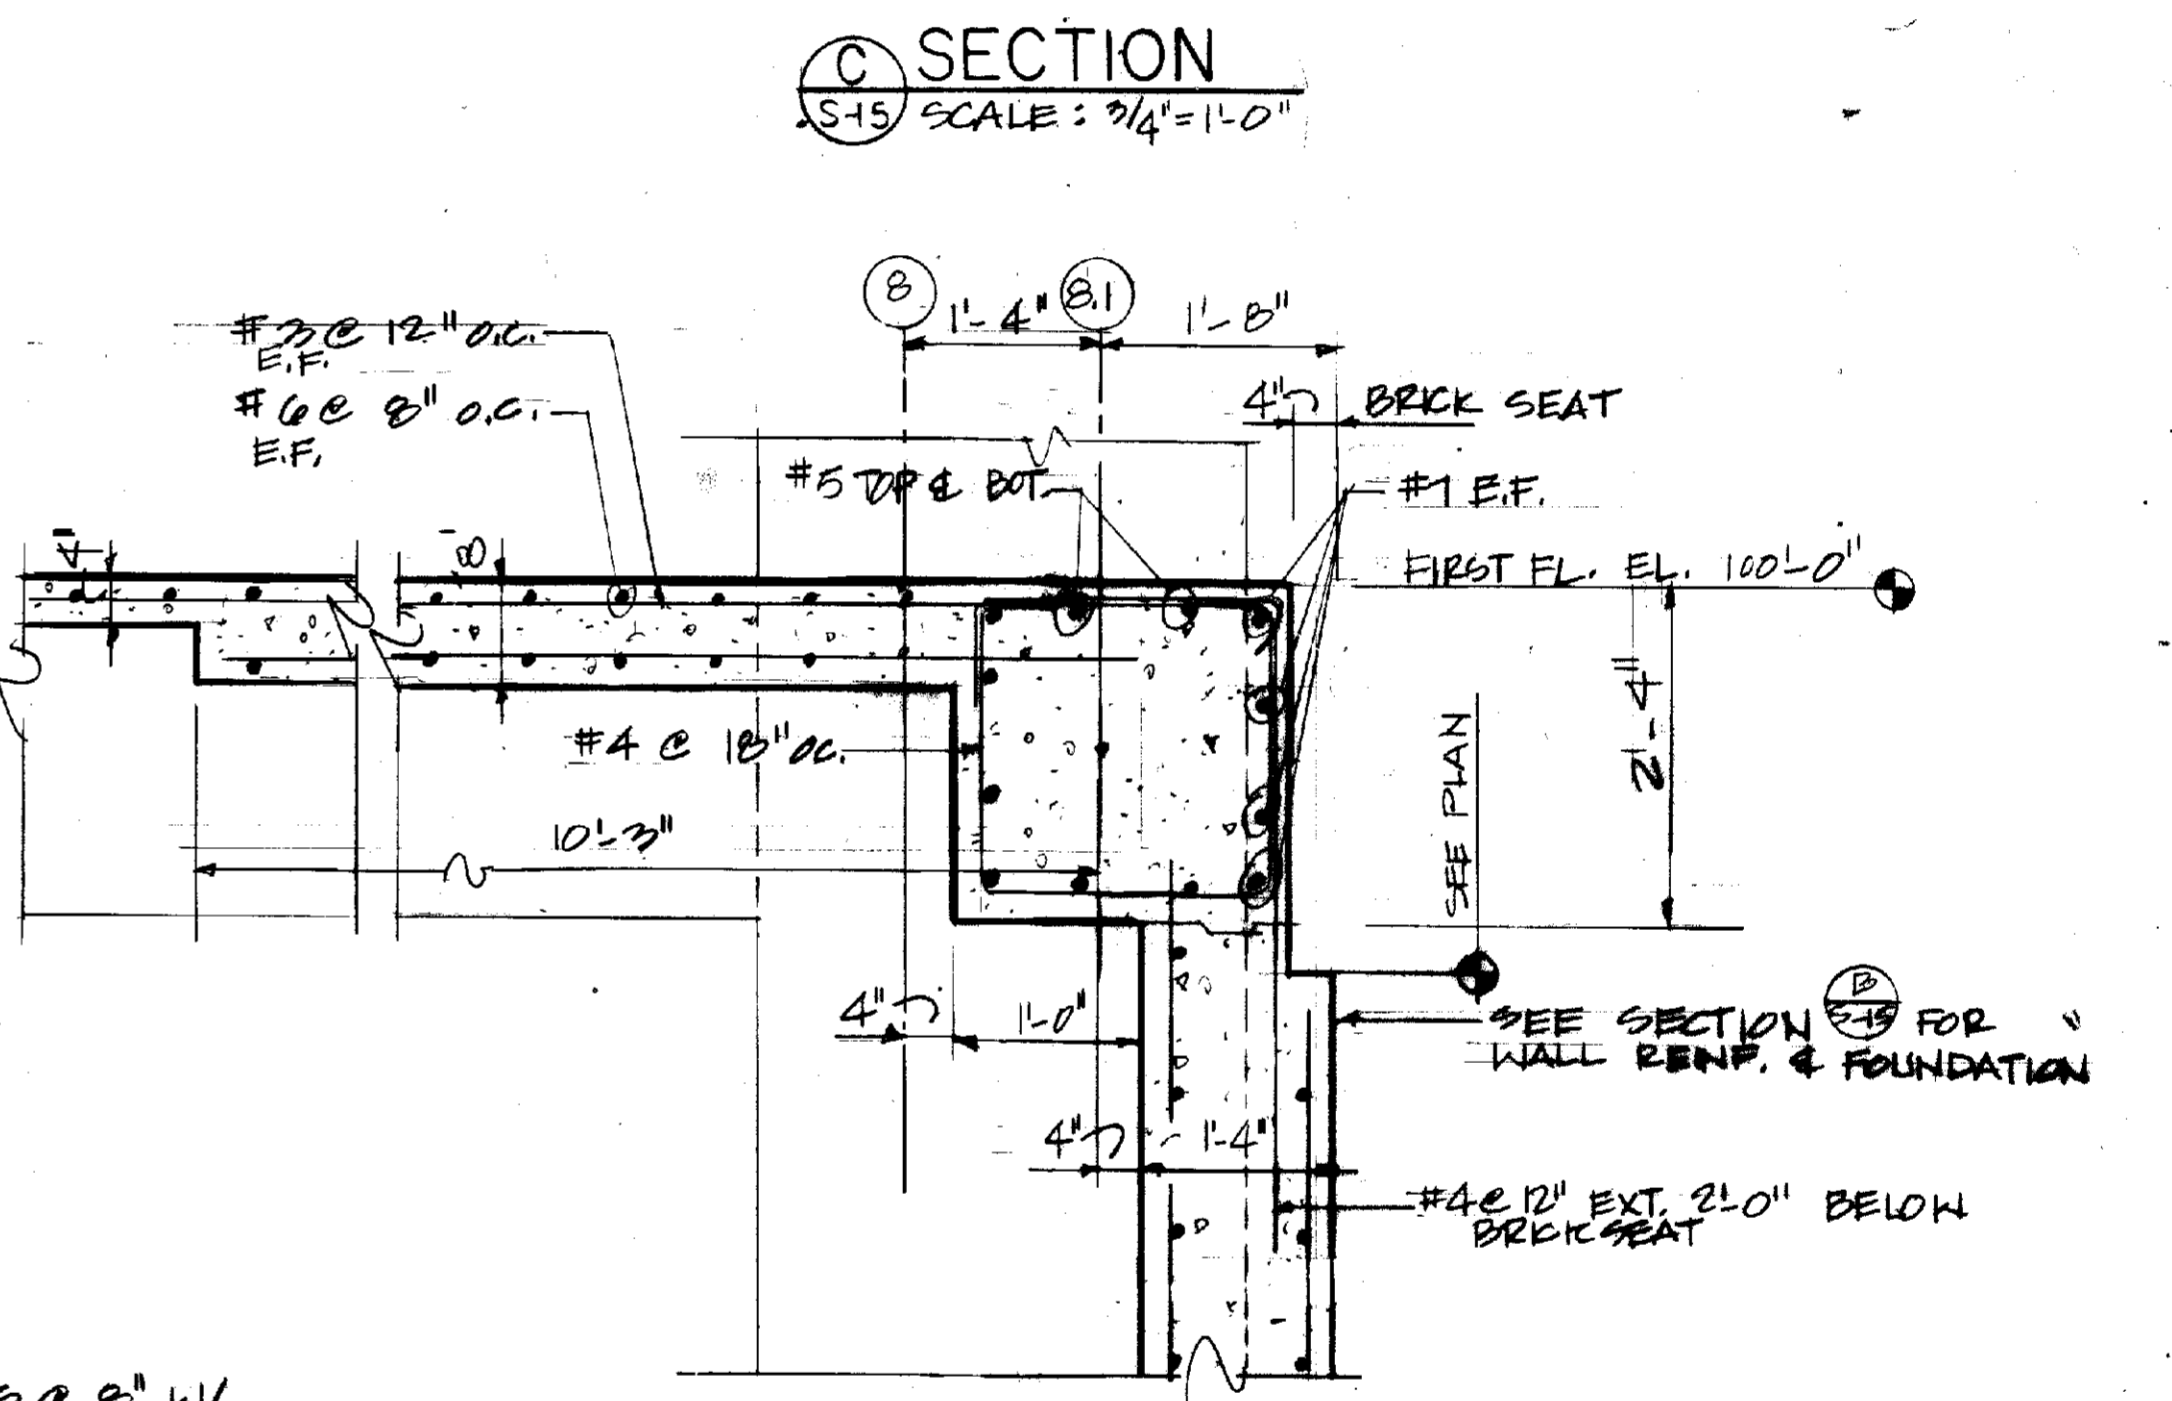


D SECTION
S-15 SCALE: 3/4"=1'-0"

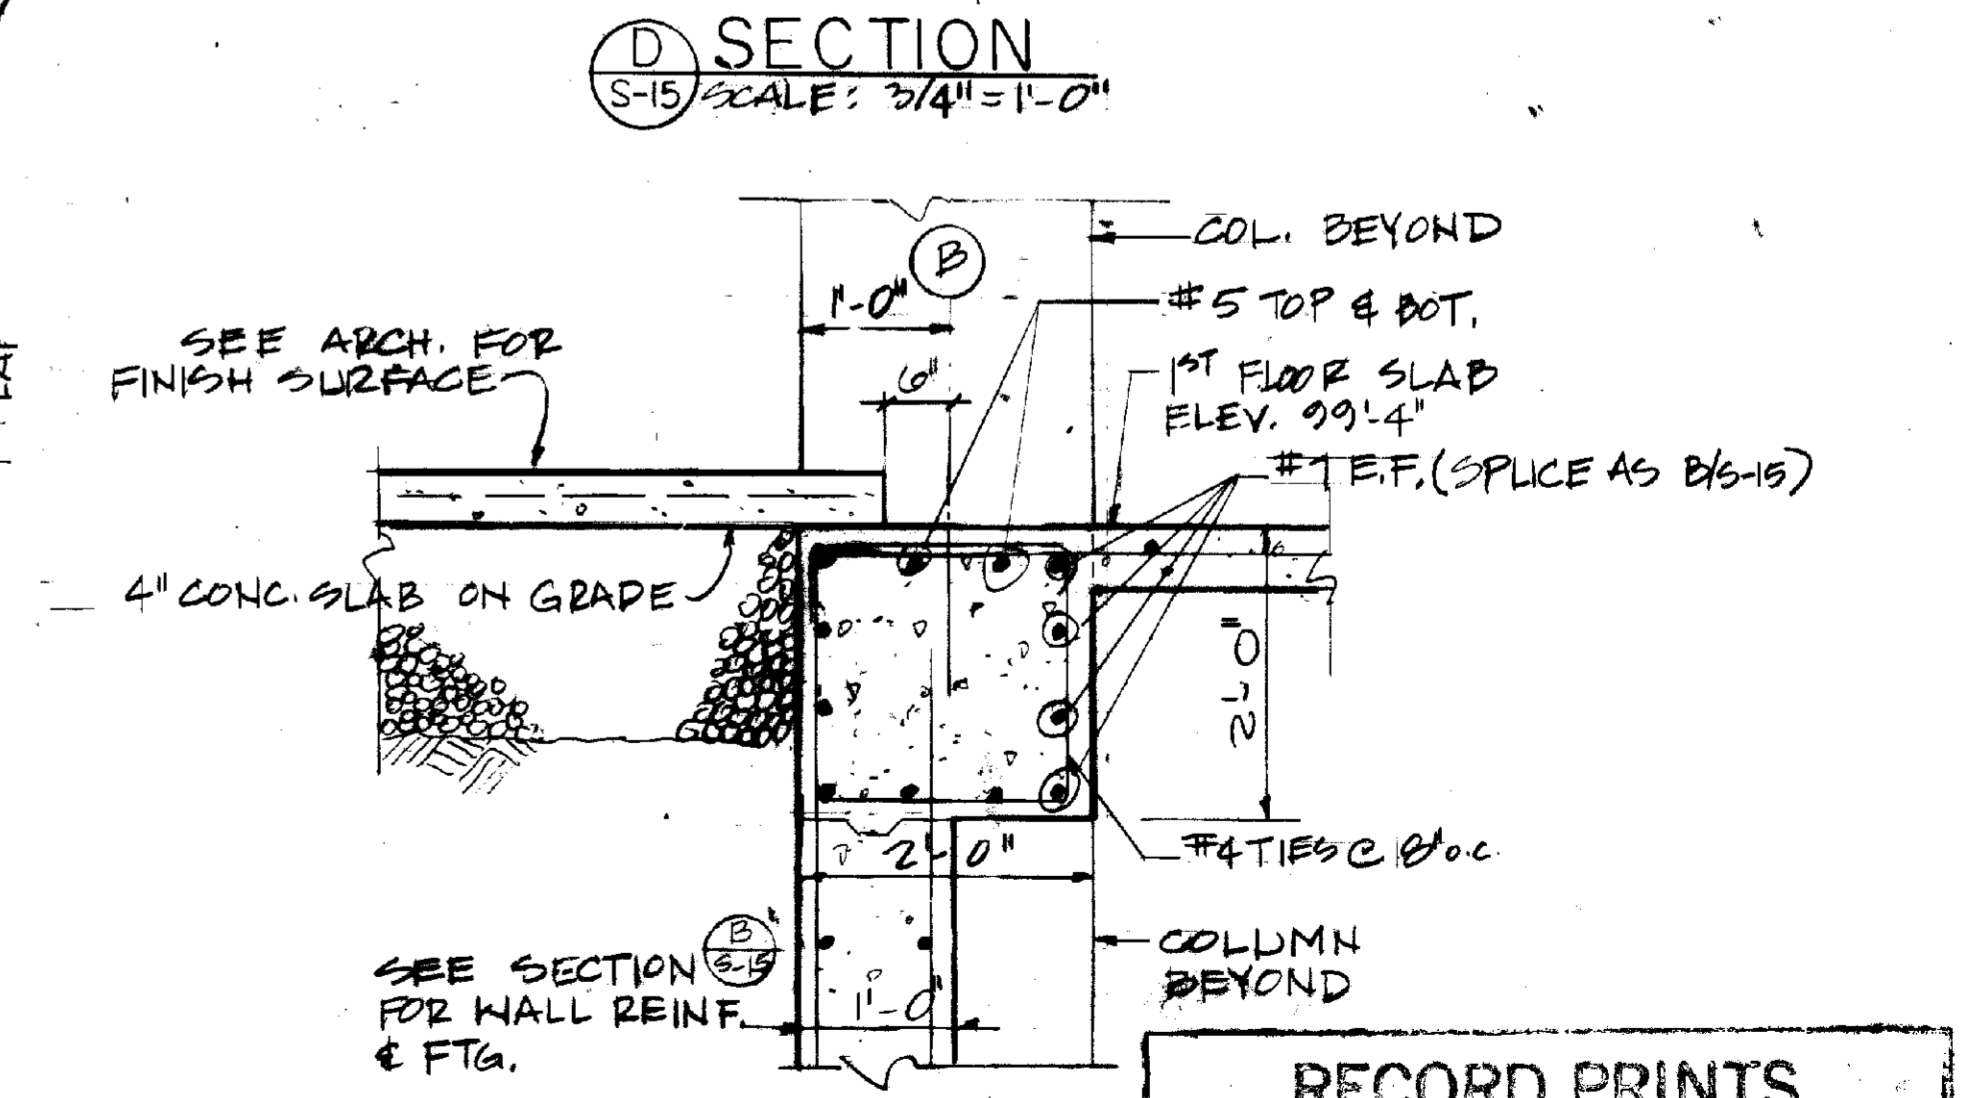


E SECTION
S-15 SCALE: 3/4"=1'-0"

RECORD PRINTS
THESE ARE RECORD PRINTS OF DRAWINGS BASED UPON MARKED UP PRINTS, DRAWINGS AND NOTES DATA FURNISHED BY THE CONTRACTOR TO THE ENGINEER AND WHICH THE ENGINEER CONSIDERS SIGNIFICANT.


MASON & HANGER ENGINEERING INC.
ARCHITECT • ENGINEERS
LEXINGTON, KENTUCKY

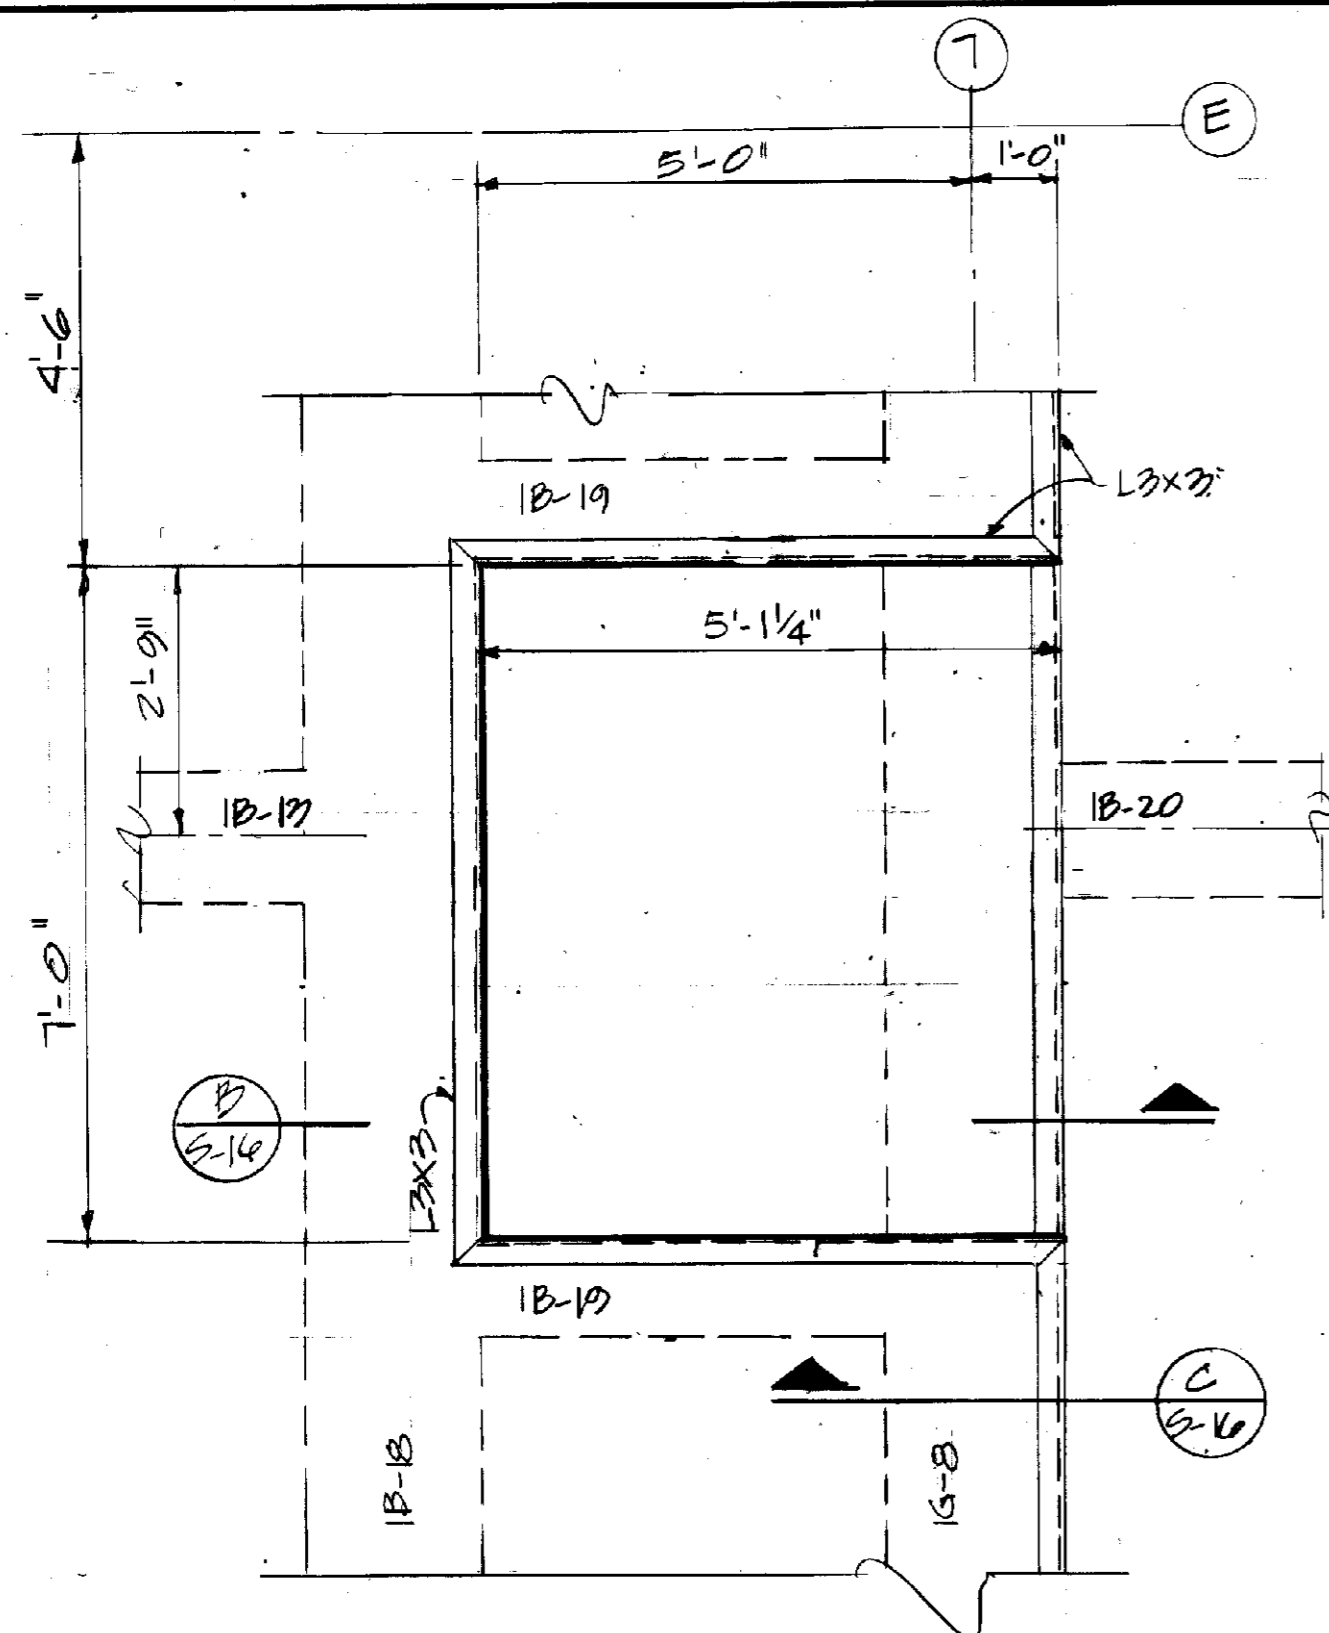


LOADING DOCK PLAN
S-16 SCALE: 1/2" = 1'-0"

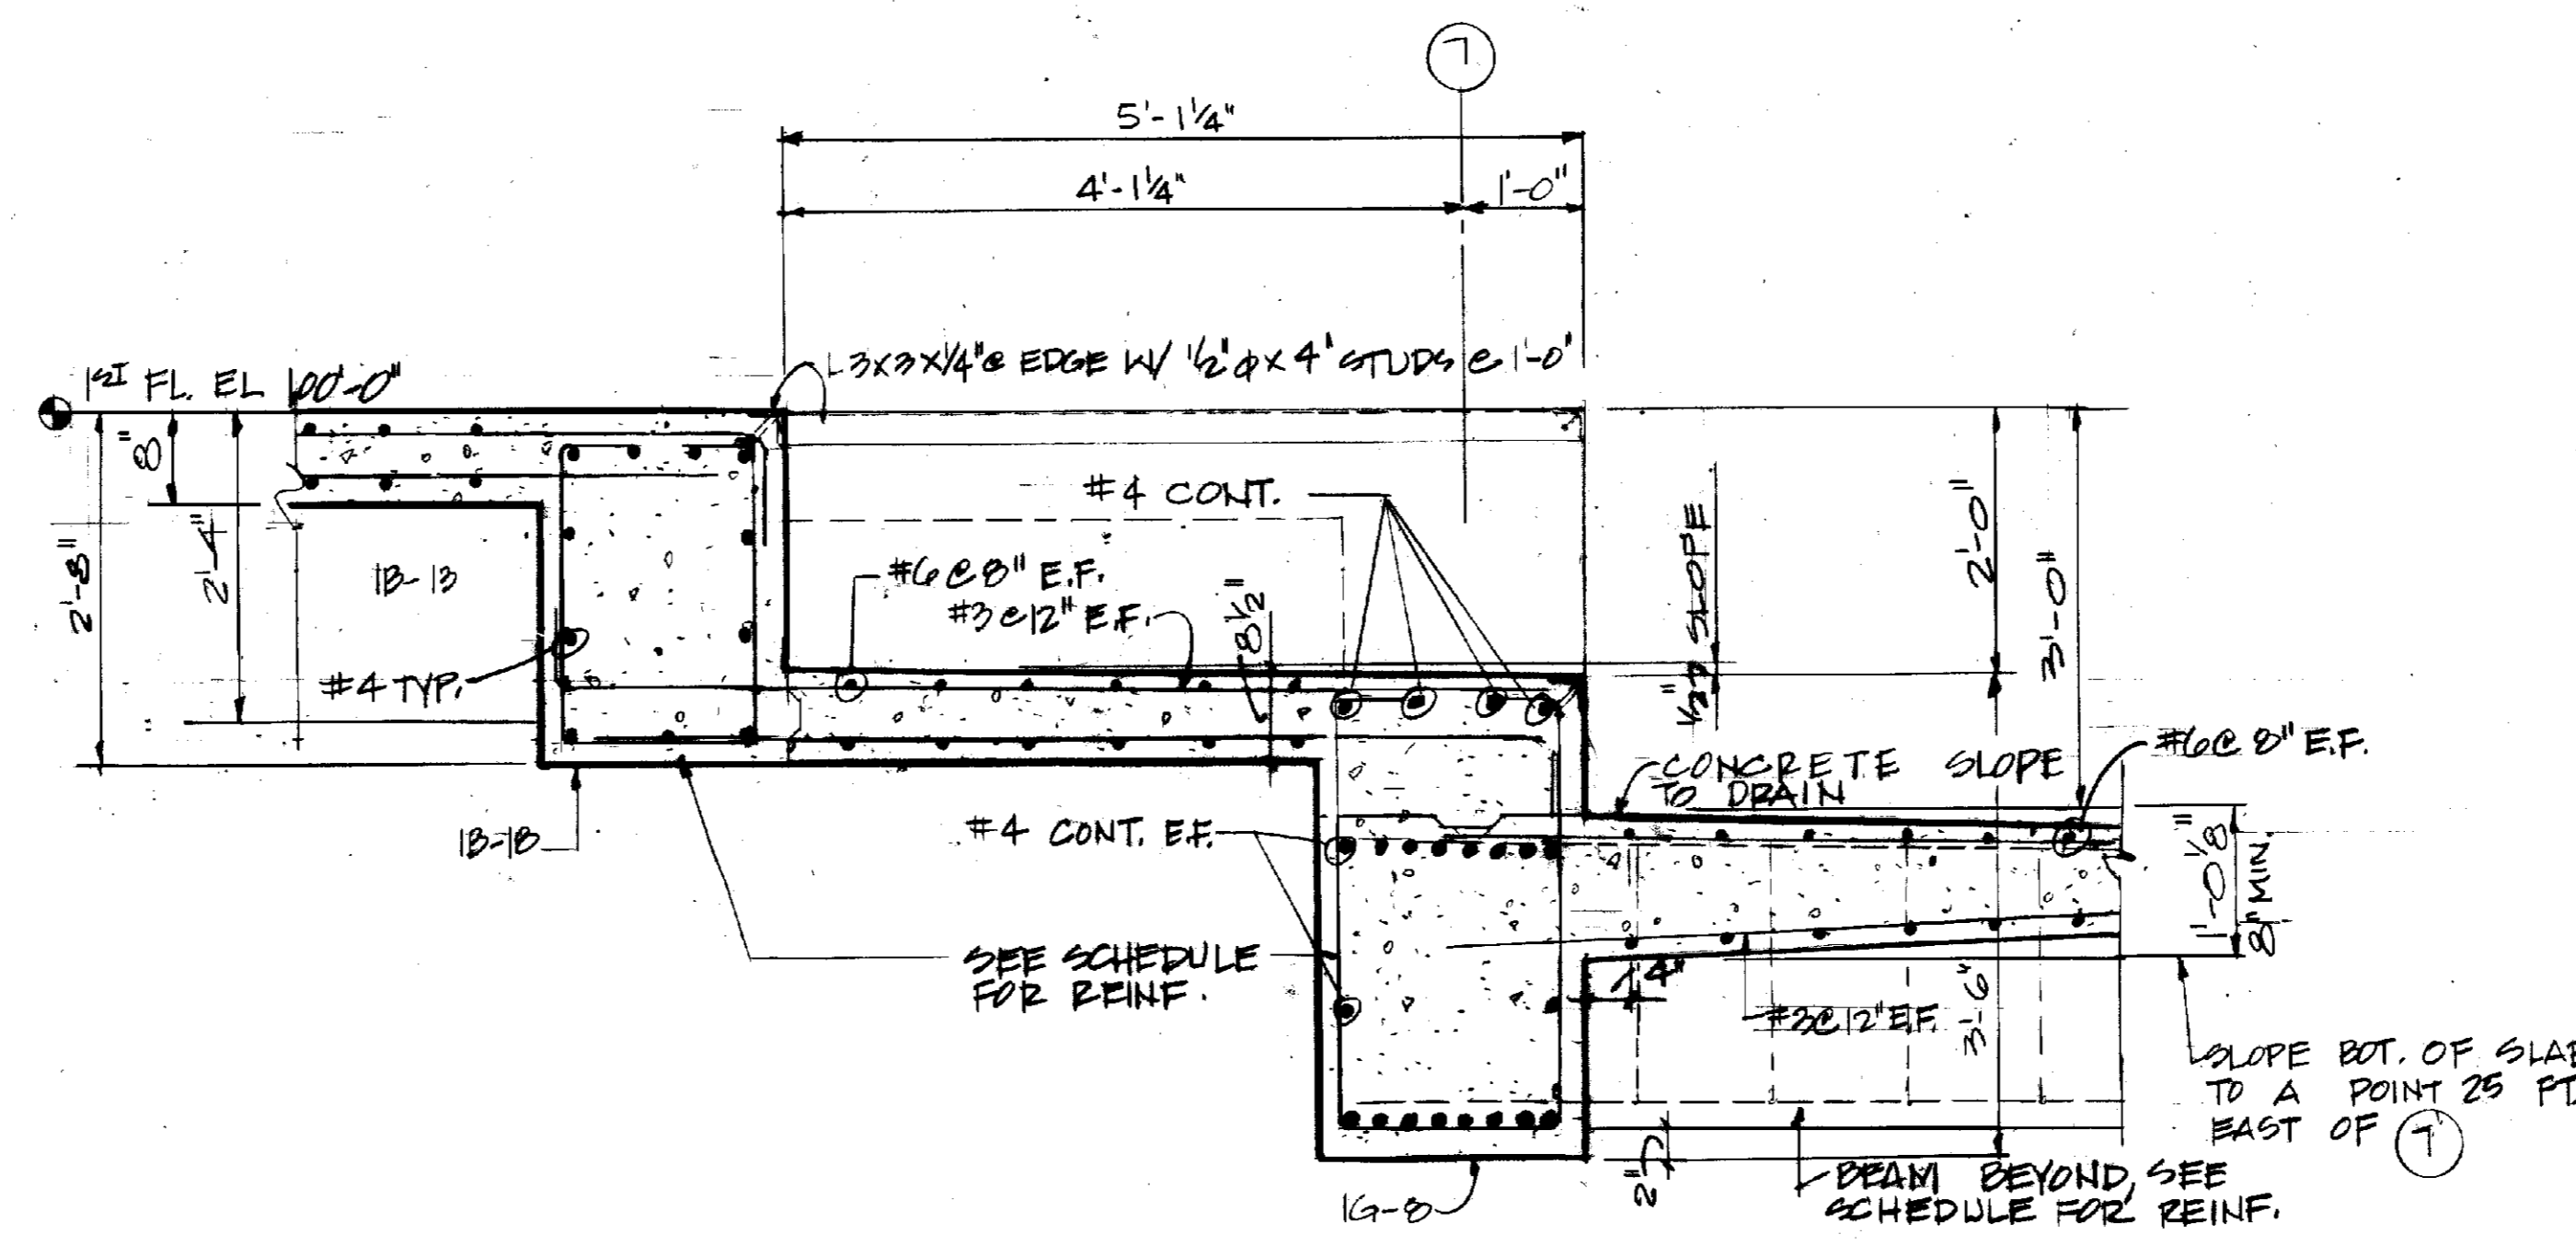


SECTION B
S-16 SCALE: 3/4" = 1'-0"

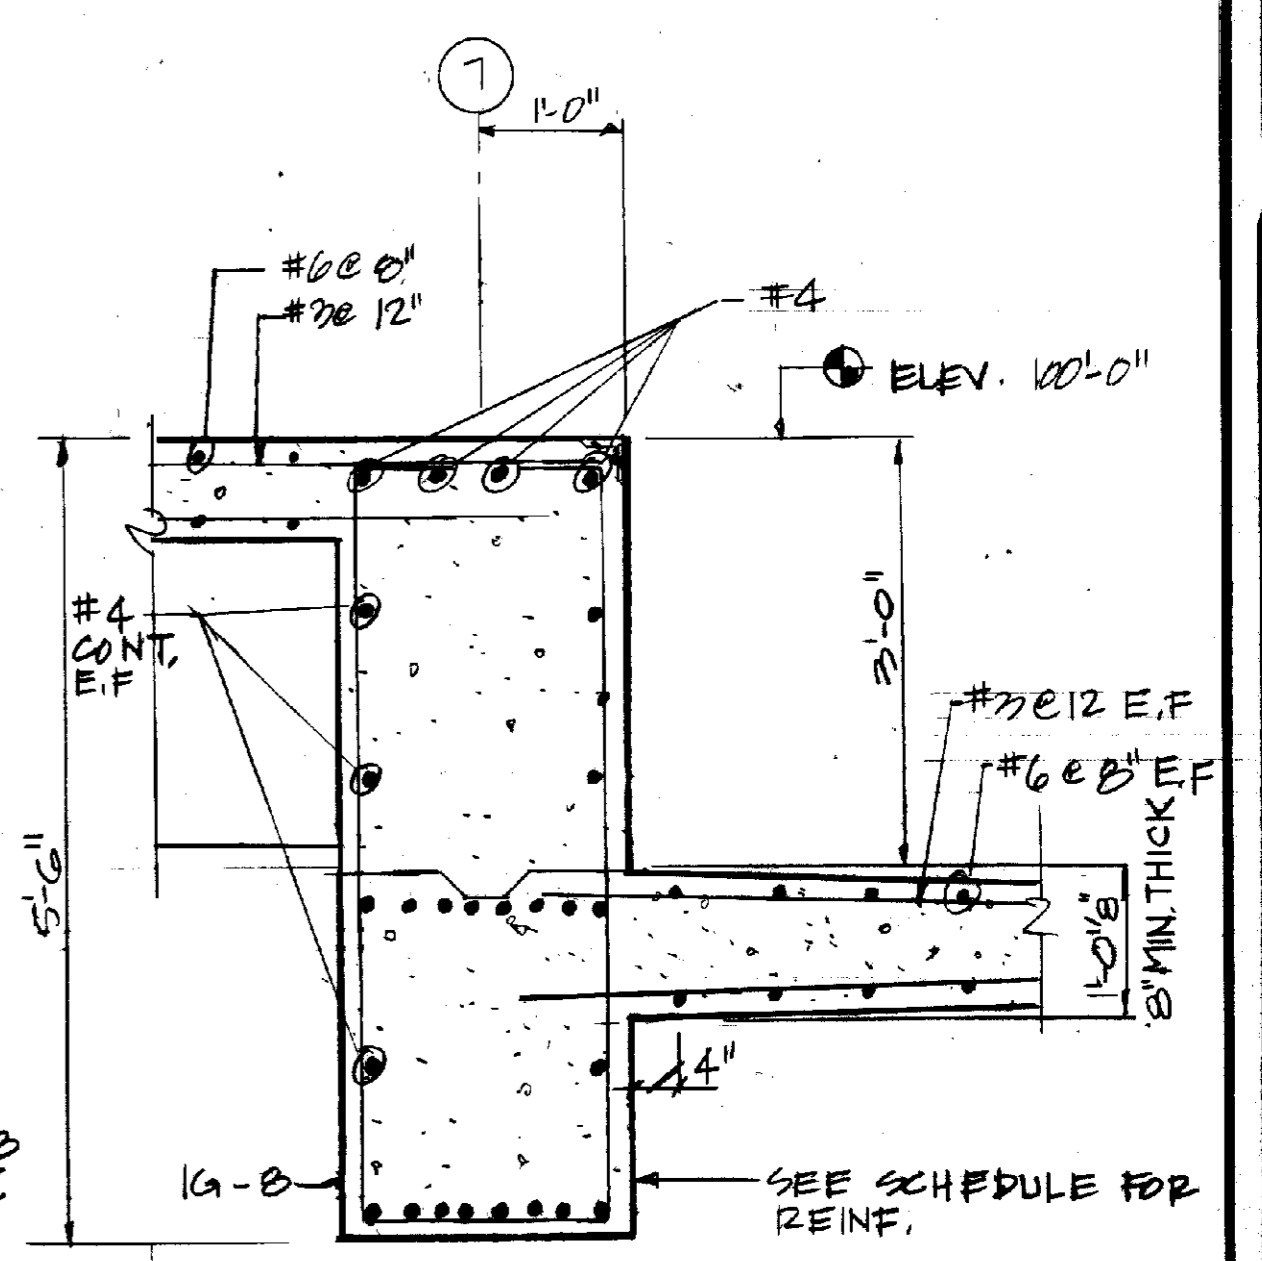

SECTION C
S-16 SCALE: 3/4" = 1'-0"

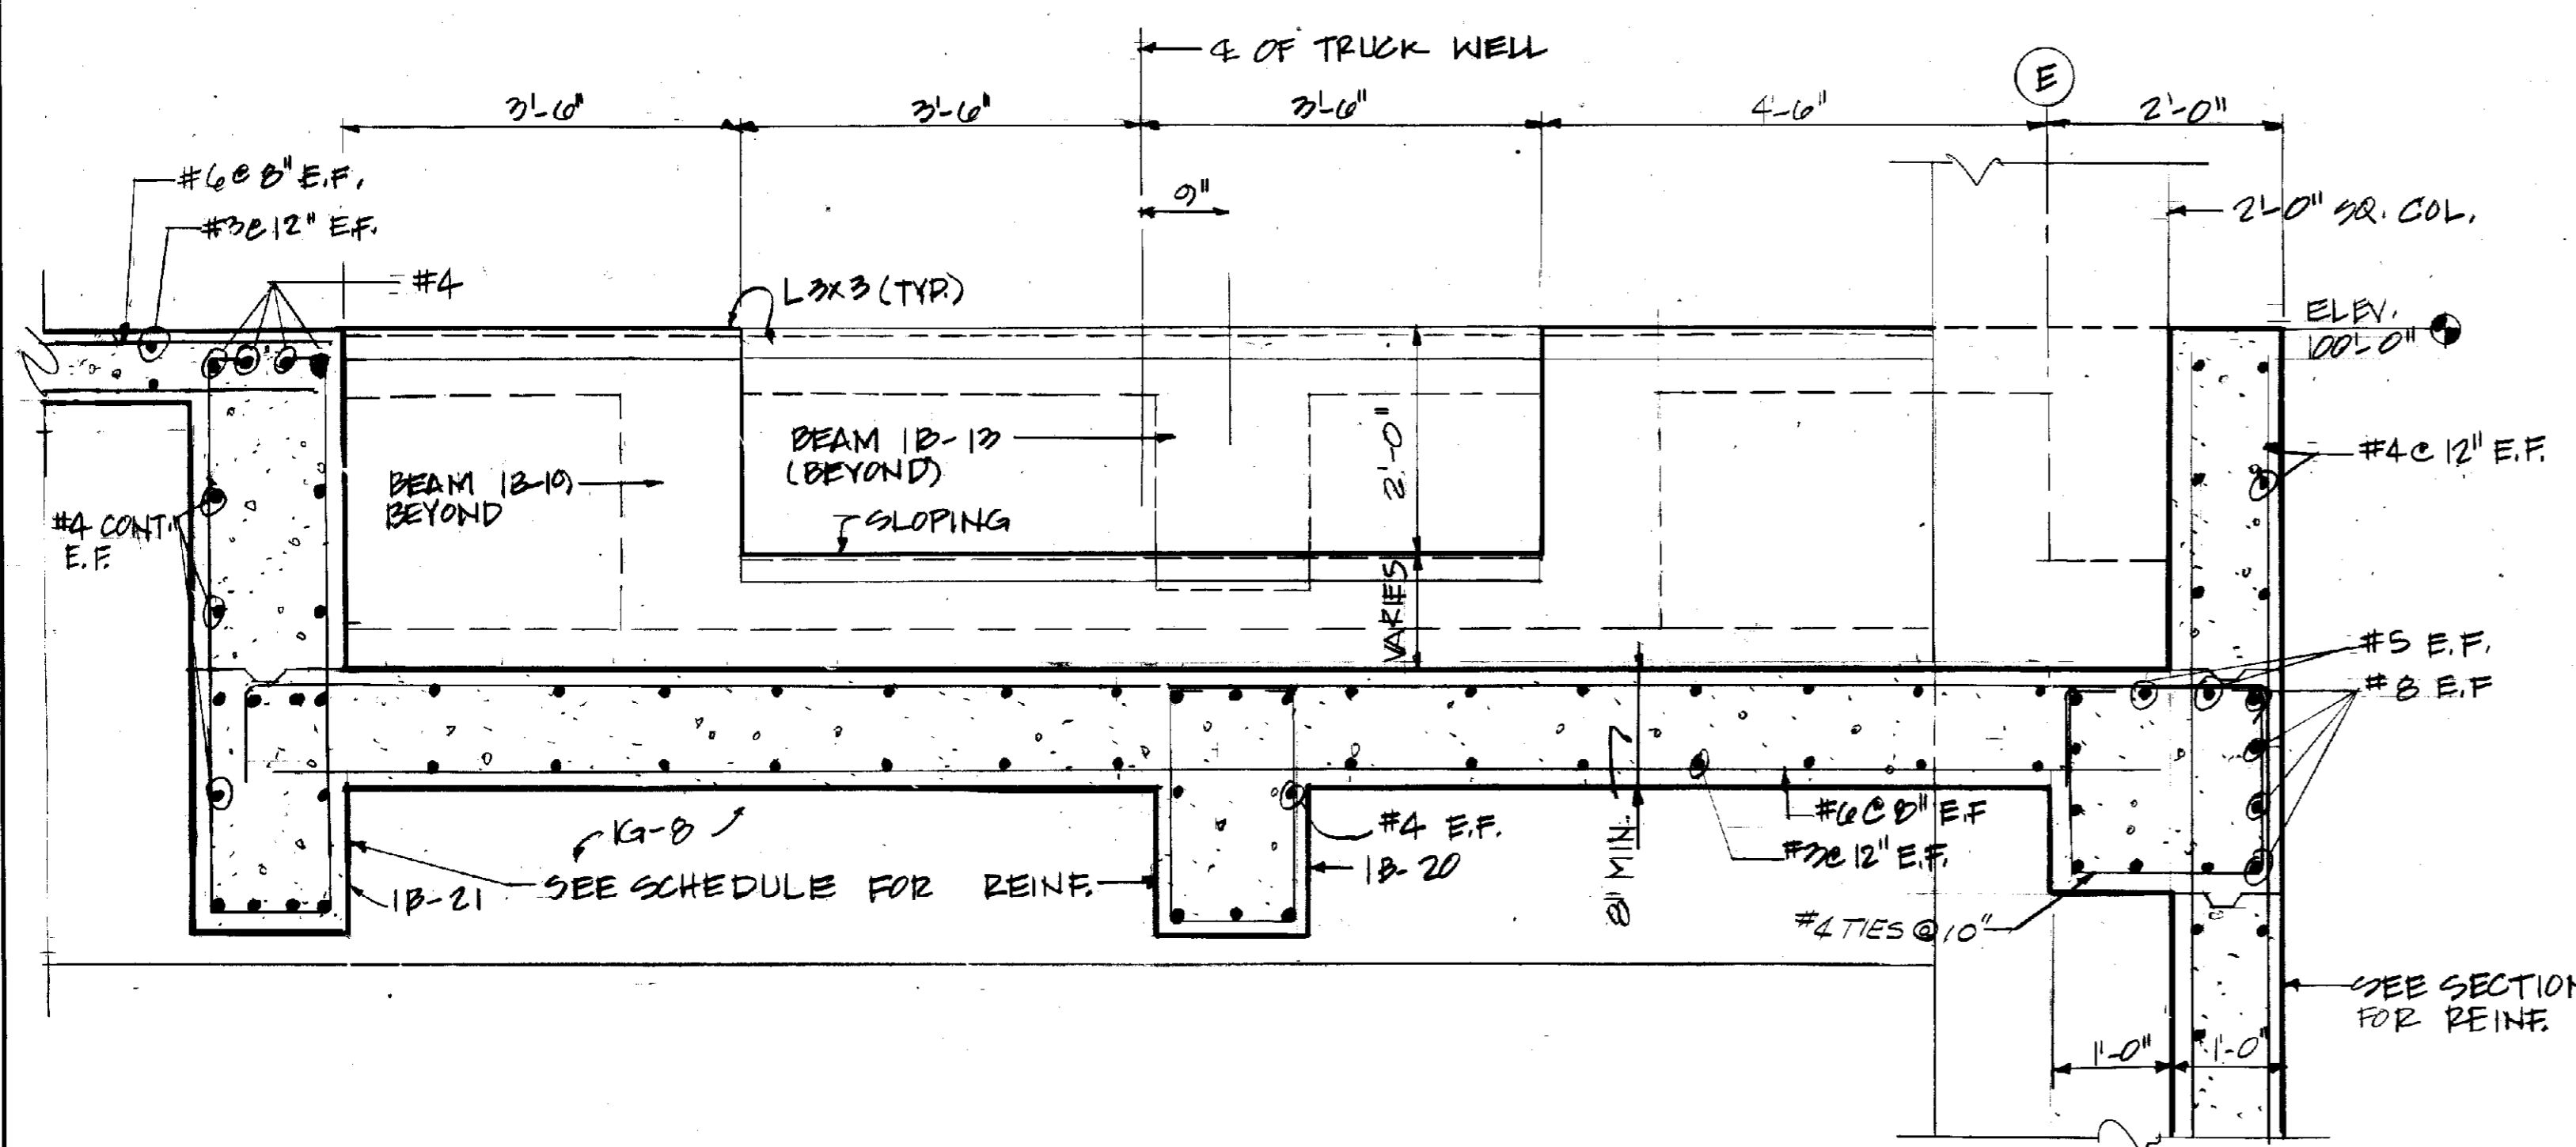

SECTION A
S-16 SCALE: 3/4" = 1'-0"

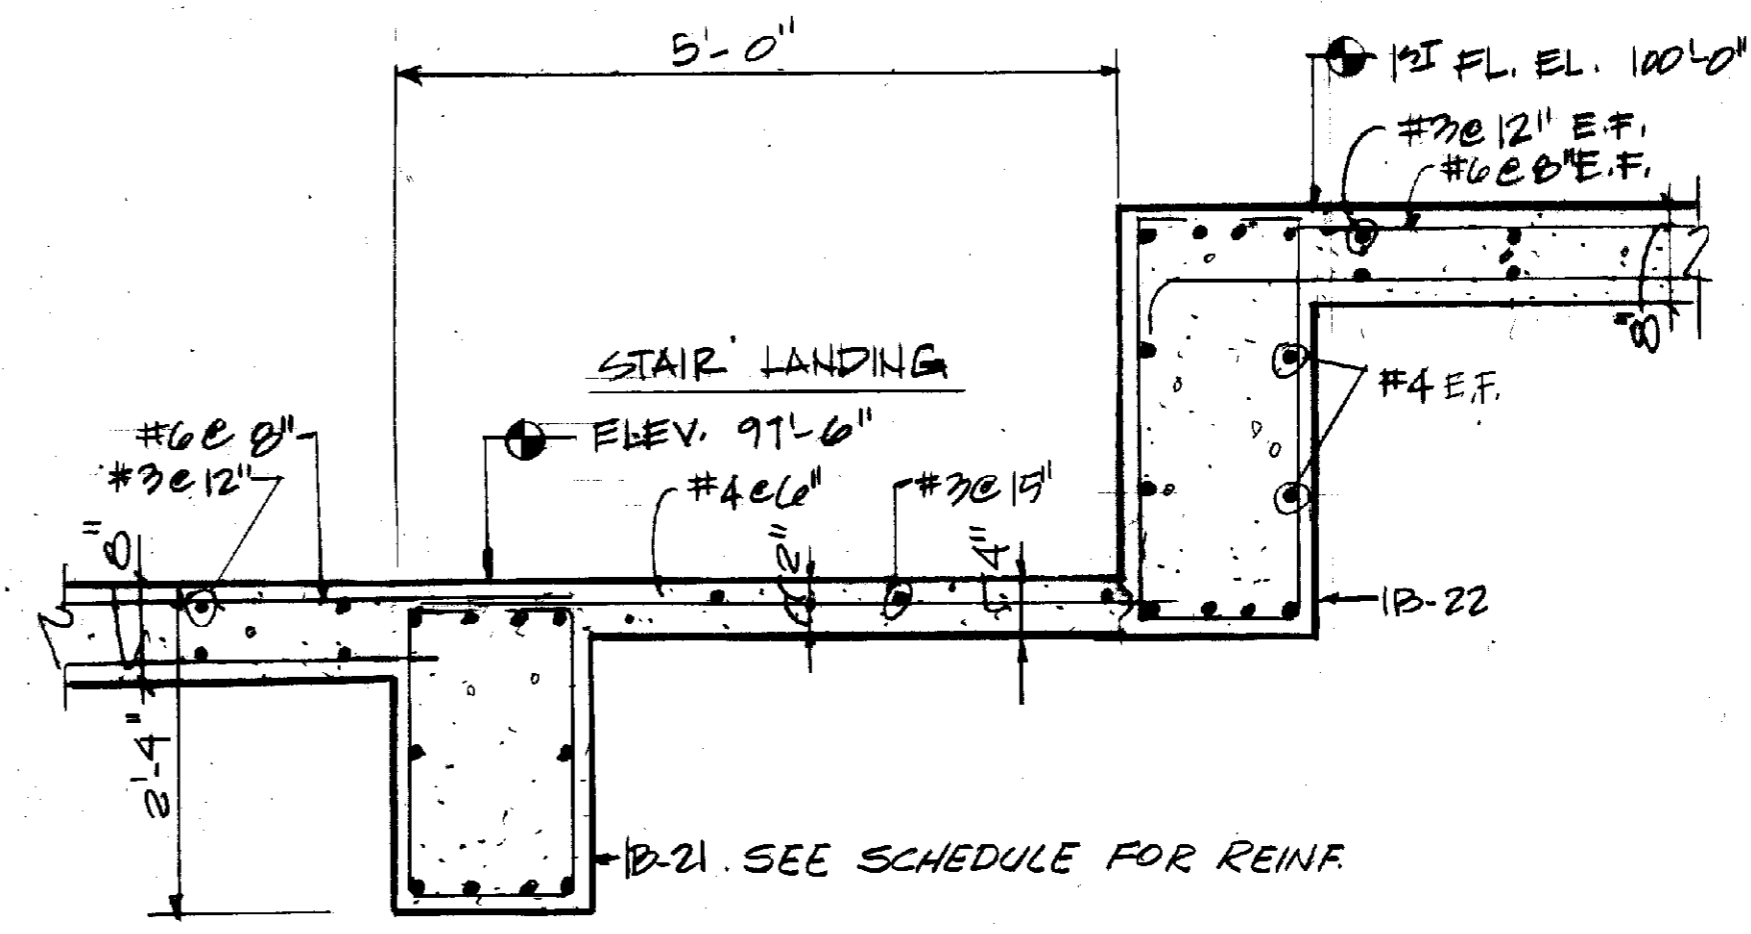

SECTION D
S-16 SCALE: 3/4" = 1'-0"

RECORD PRINTS
 THESE ARE RECORD PRINTS OF DRAWINGS BASED UPON MARKED UP PRINTS, DRAWINGS AND OTHER DATA FURNISHED BY THE CONTRACTOR TO THE ENGINEER AND WHICH THE ENGINEER CONSIDERS SIGNIFICANT.

ROBOTICS FACILITY
 LEXINGTON CAMPUS
 UNIVERSITY OF KENTUCKY
 LEXINGTON, KENTUCKY

University of Kentucky
 Lexington, Kentucky

SECTIONS & DETAILS

Sherman Carter Barnhart
 PARTNERS IN ARCHITECTURE
 SUITE 600 • 250 WEST MAIN STREET • LEXINGTON, KY 40502 • 606-254-1510

JOB NO. 2046
 DATE 10-19-87
 DRAWN M.A.A.
 CHECKED JEB/ALP
 FILE NO. 431.0


REVISIONS

SHEET


S-16

MASON & HANGER ENGINEERING INC.
 ARCHITECT • ENGINEERS
 LEXINGTON, KENTUCKY


S-18
 NOTES
 1 SEE SHEET S-1 FOR GENERAL NOTES
 2 MINIMUM ULTIMATE CAPACITY = 15,000 POUND. DAYTON SURE GRIP B-18 OR EQUAL.

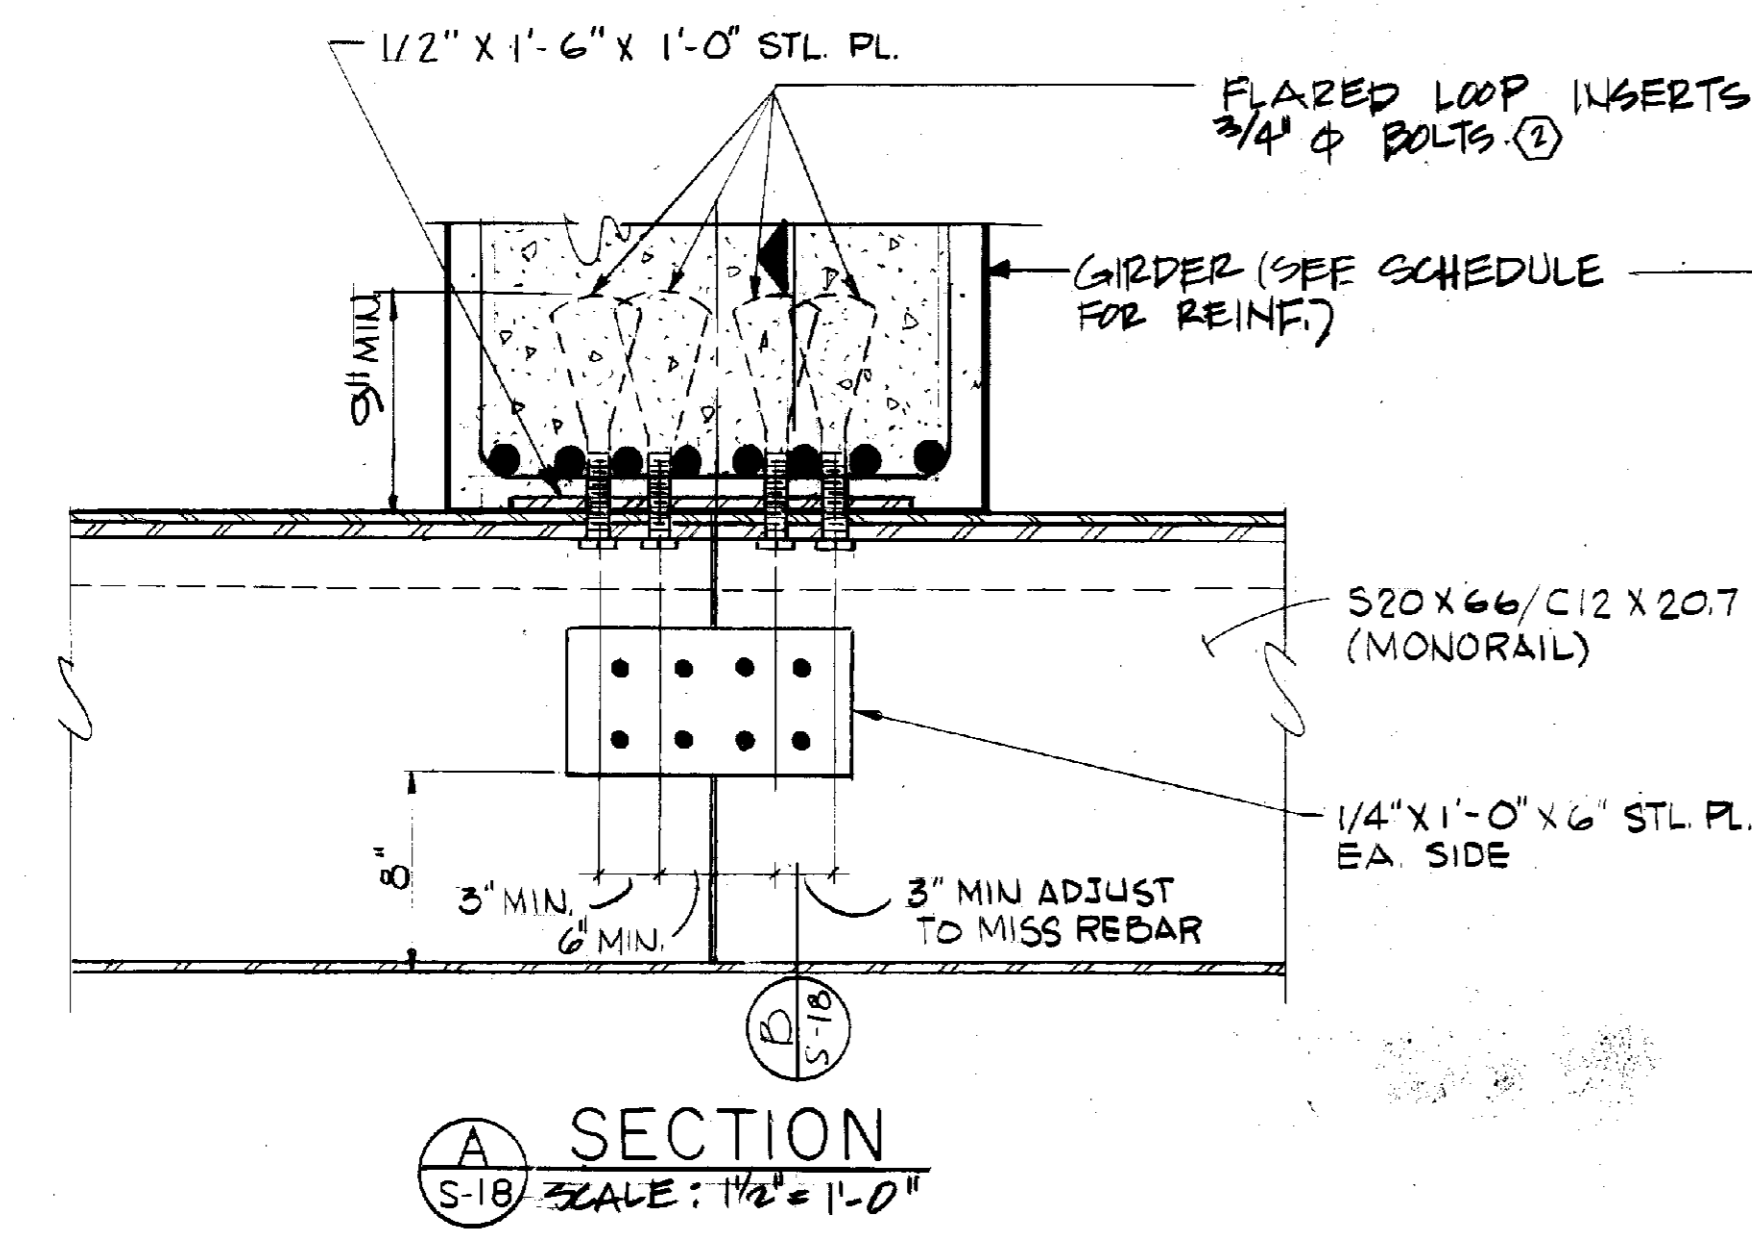


SECTION A
 S-18 SCALE: 1/2" = 1'-0"

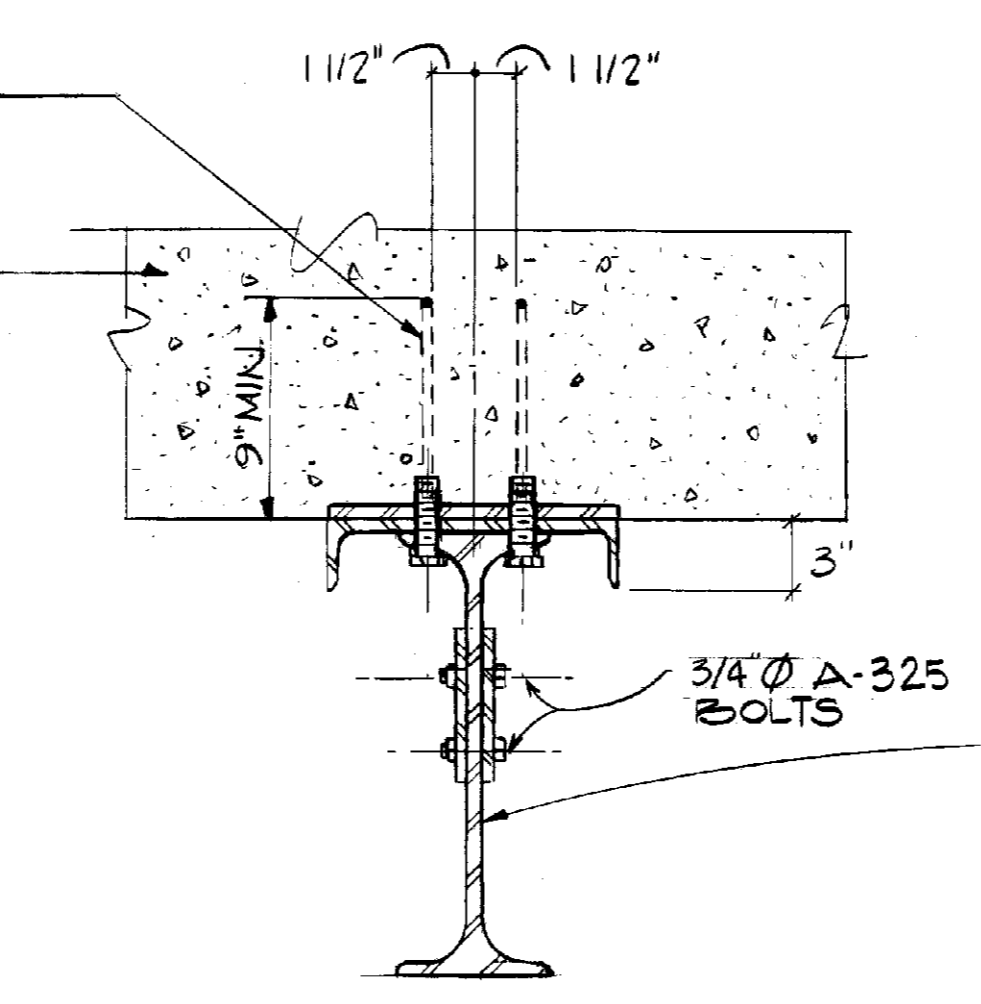


SECTION B
 S-18 SCALE: 1/2" = 1'-0"

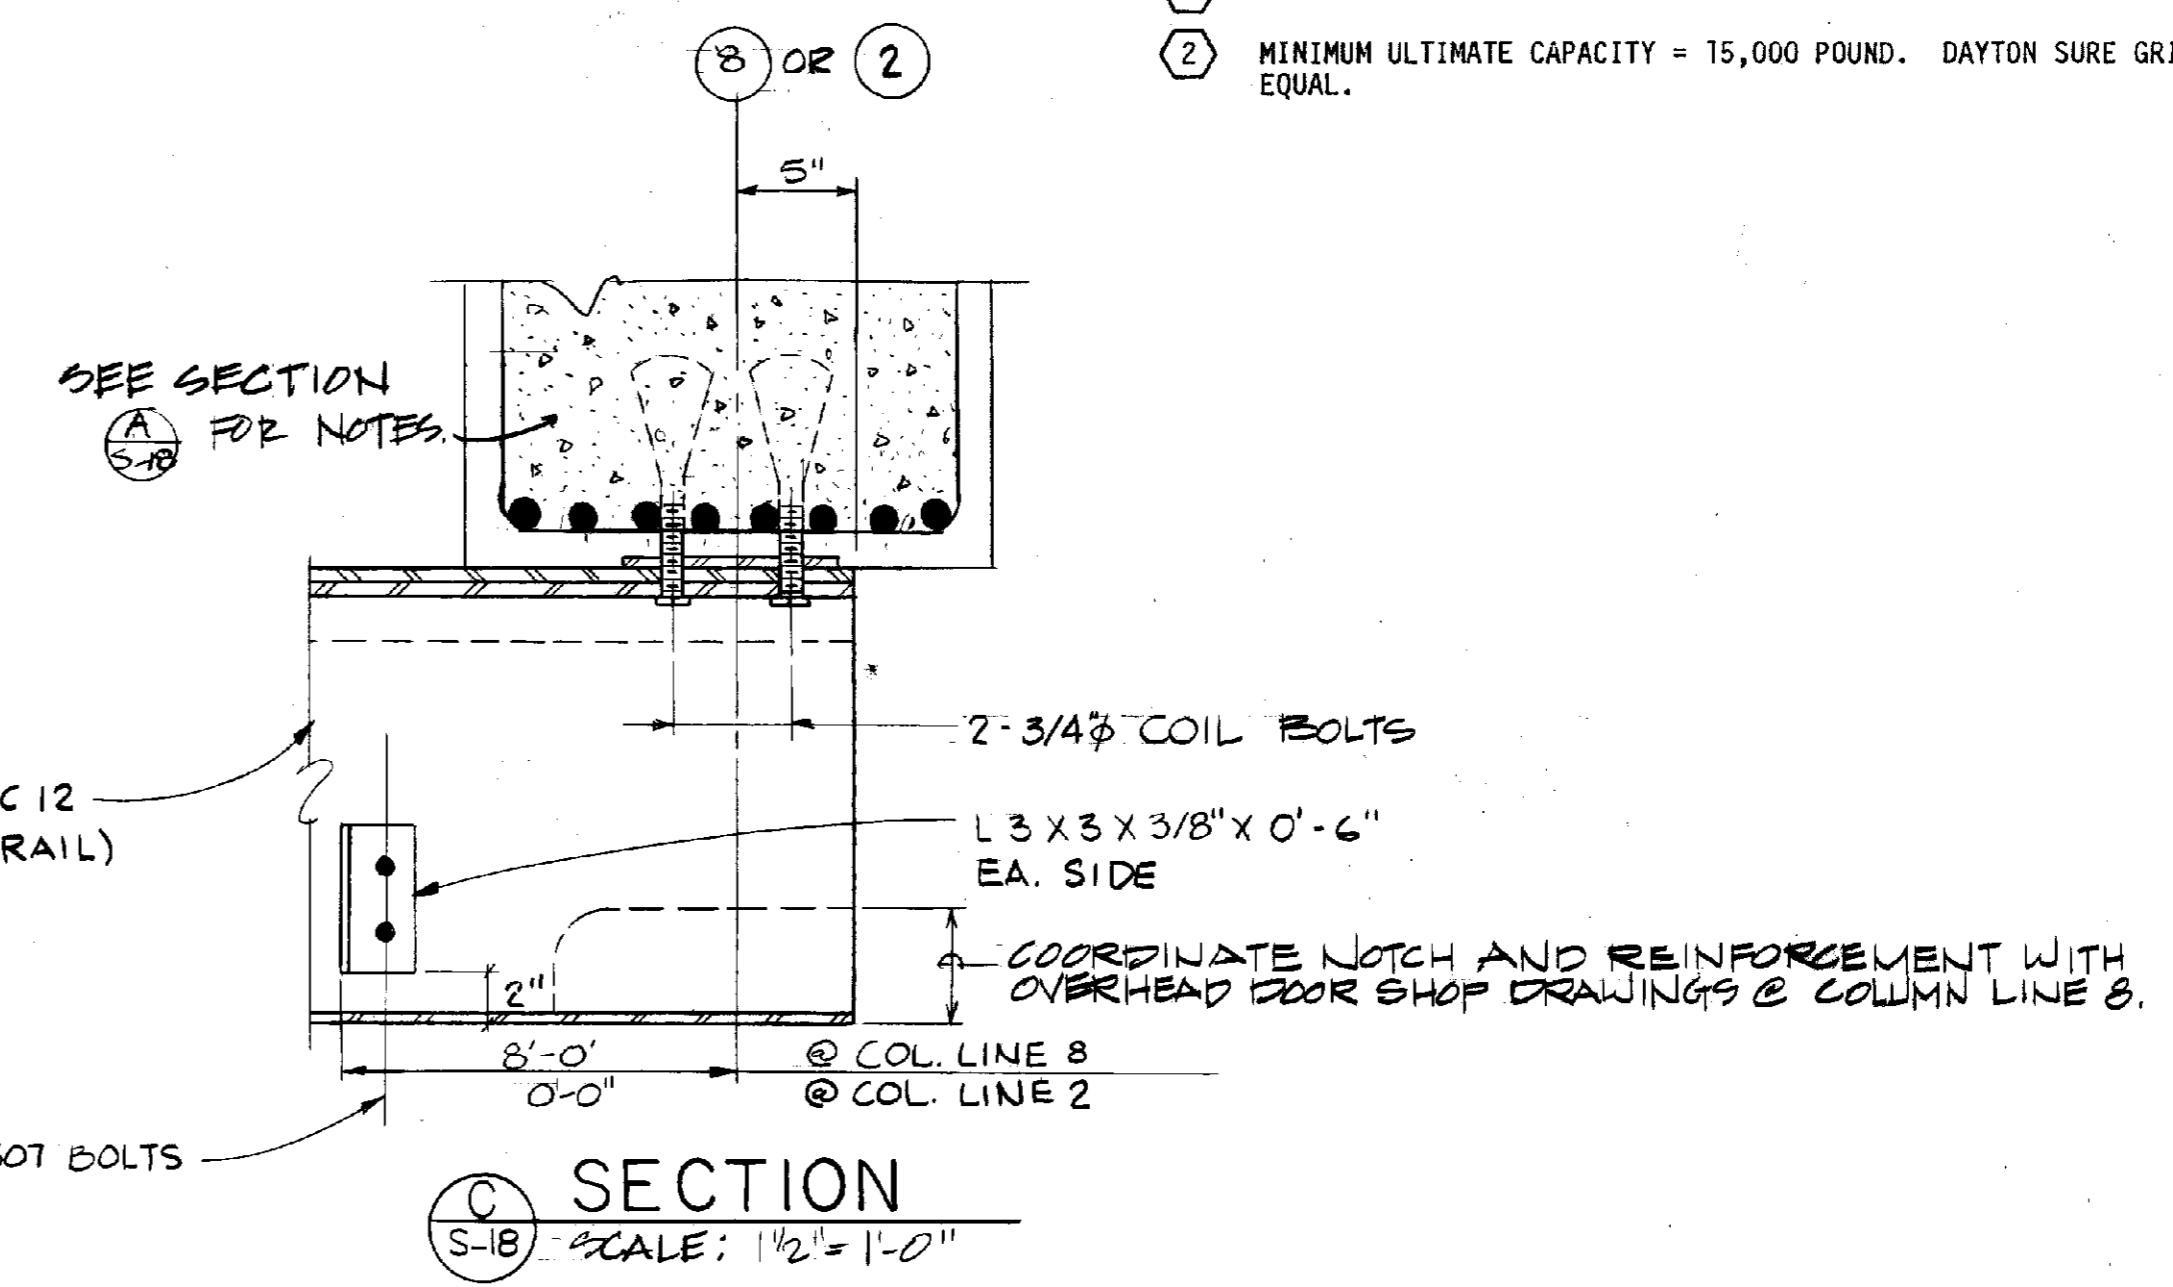

SECTION C
 S-18 SCALE: 1/2" = 1'-0"

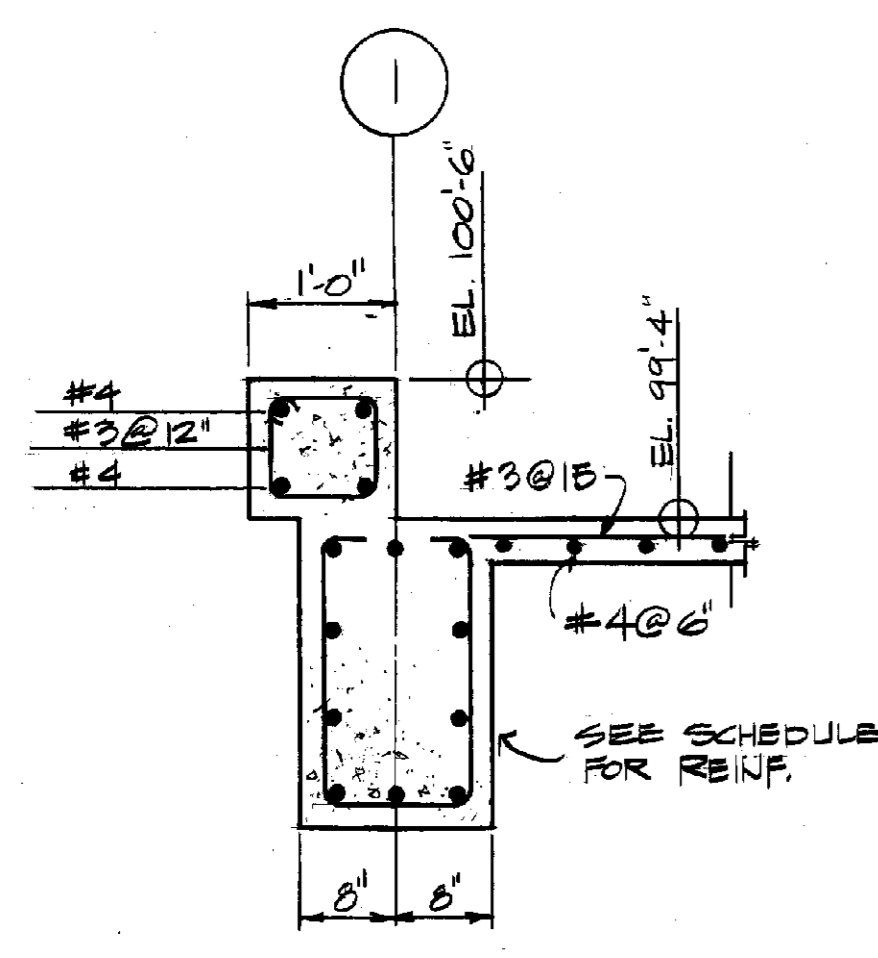

SECTION D
 S-18 SCALE: 3/4" = 1'-0"

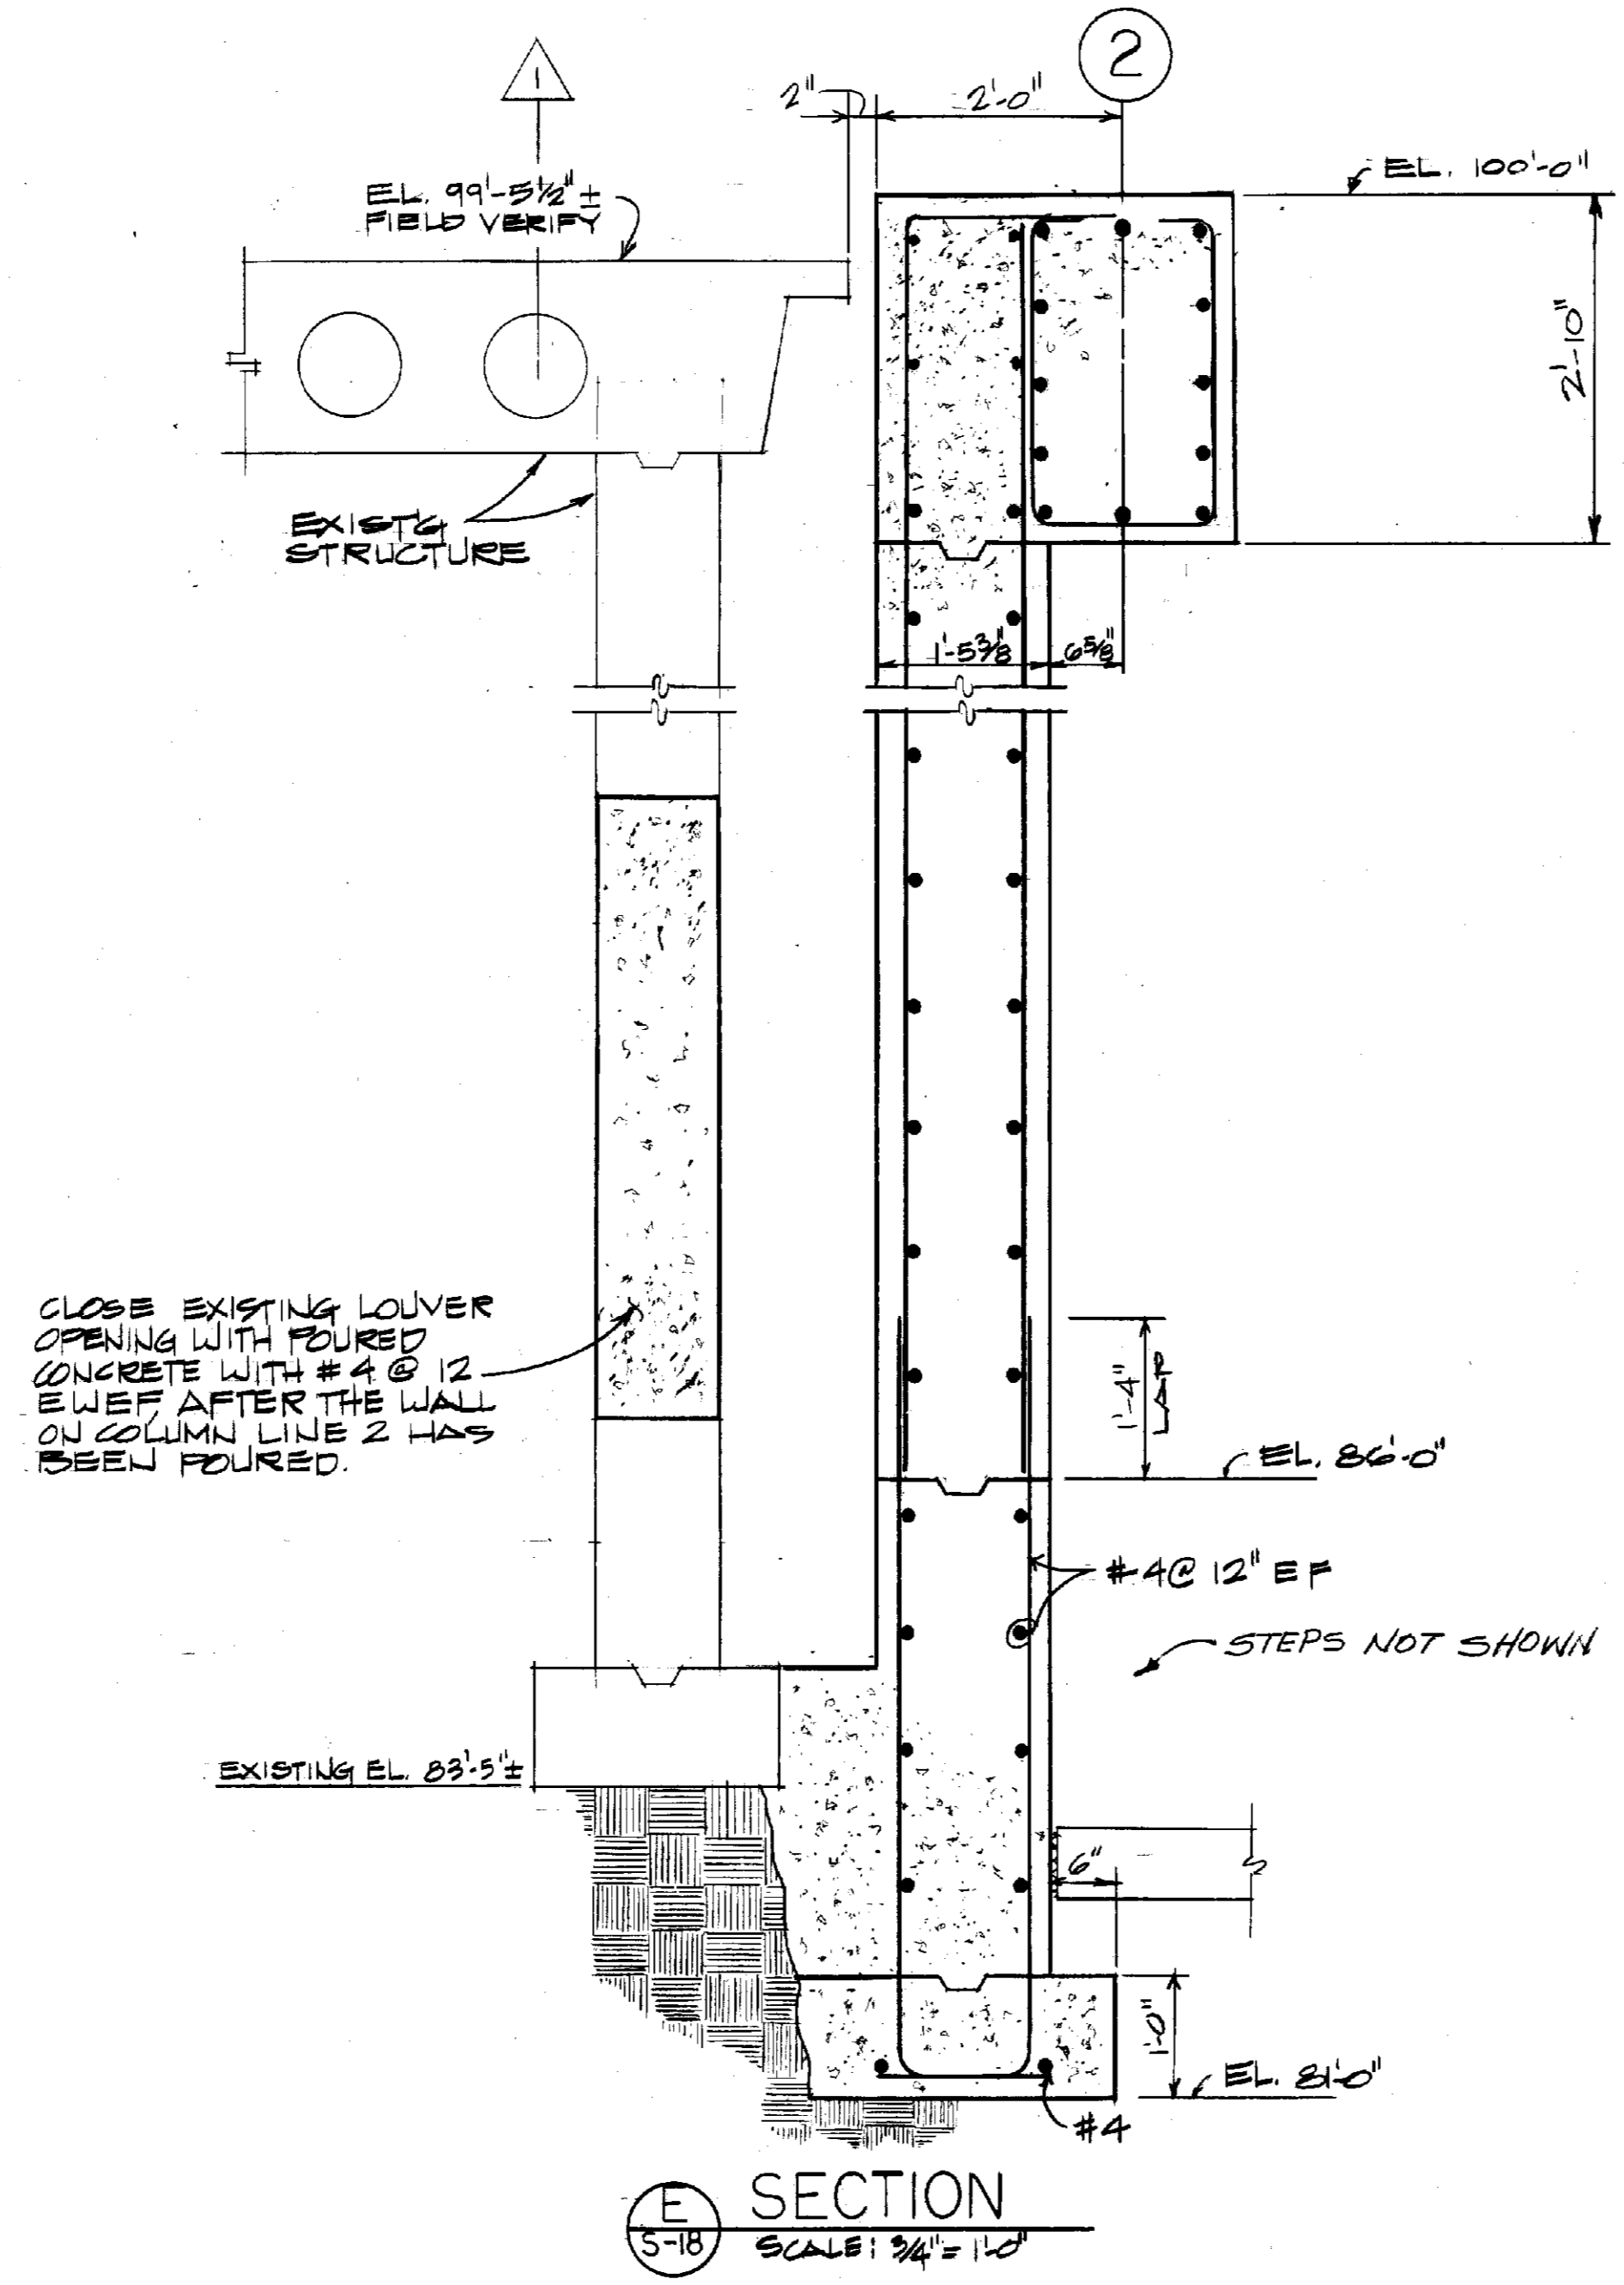

SECTION E
 S-18 SCALE: 3/4" = 1'-0"

RECORD PRINTS
 THESE ARE RECORD PRINTS OF DRAWINGS BASED UPON MARKED UP PRINTS, DRAWINGS AND OTHER DATA FURNISHED BY THE CONTRACTOR TO THE ENGINEER AND WHICH THE ENGINEER CONSIDERS SIGNIFICANT



ROBOTICS FACILITY
 LEXINGTON CAMPUS
 UNIVERSITY OF KENTUCKY
 LEXINGTON, KENTUCKY

University of Kentucky
 Lexington, Kentucky
 Approved By: *William W. Hanger*
 Director - design and construction division
 10.19.87


SECTIONS & DETAILS
Sherman Carter Barnhart
 PARTNERS IN ARCHITECTURE
 SUITE 1000 • 250 WEST MAIN STREET • LEXINGTON, KY 40501 • 502.254.1200

JOB NO. 2046
 DATE 10-19-87
 DRAWN ST/MB
 CHECKED RBW/AWP
 FILE NO. 431.0


NO.	REVISIONS

SHEET
S-18


MASON & HANGER ENGINEERING INC.
 ARCHITECT • ENGINEERS
 LEXINGTON, KENTUCKY

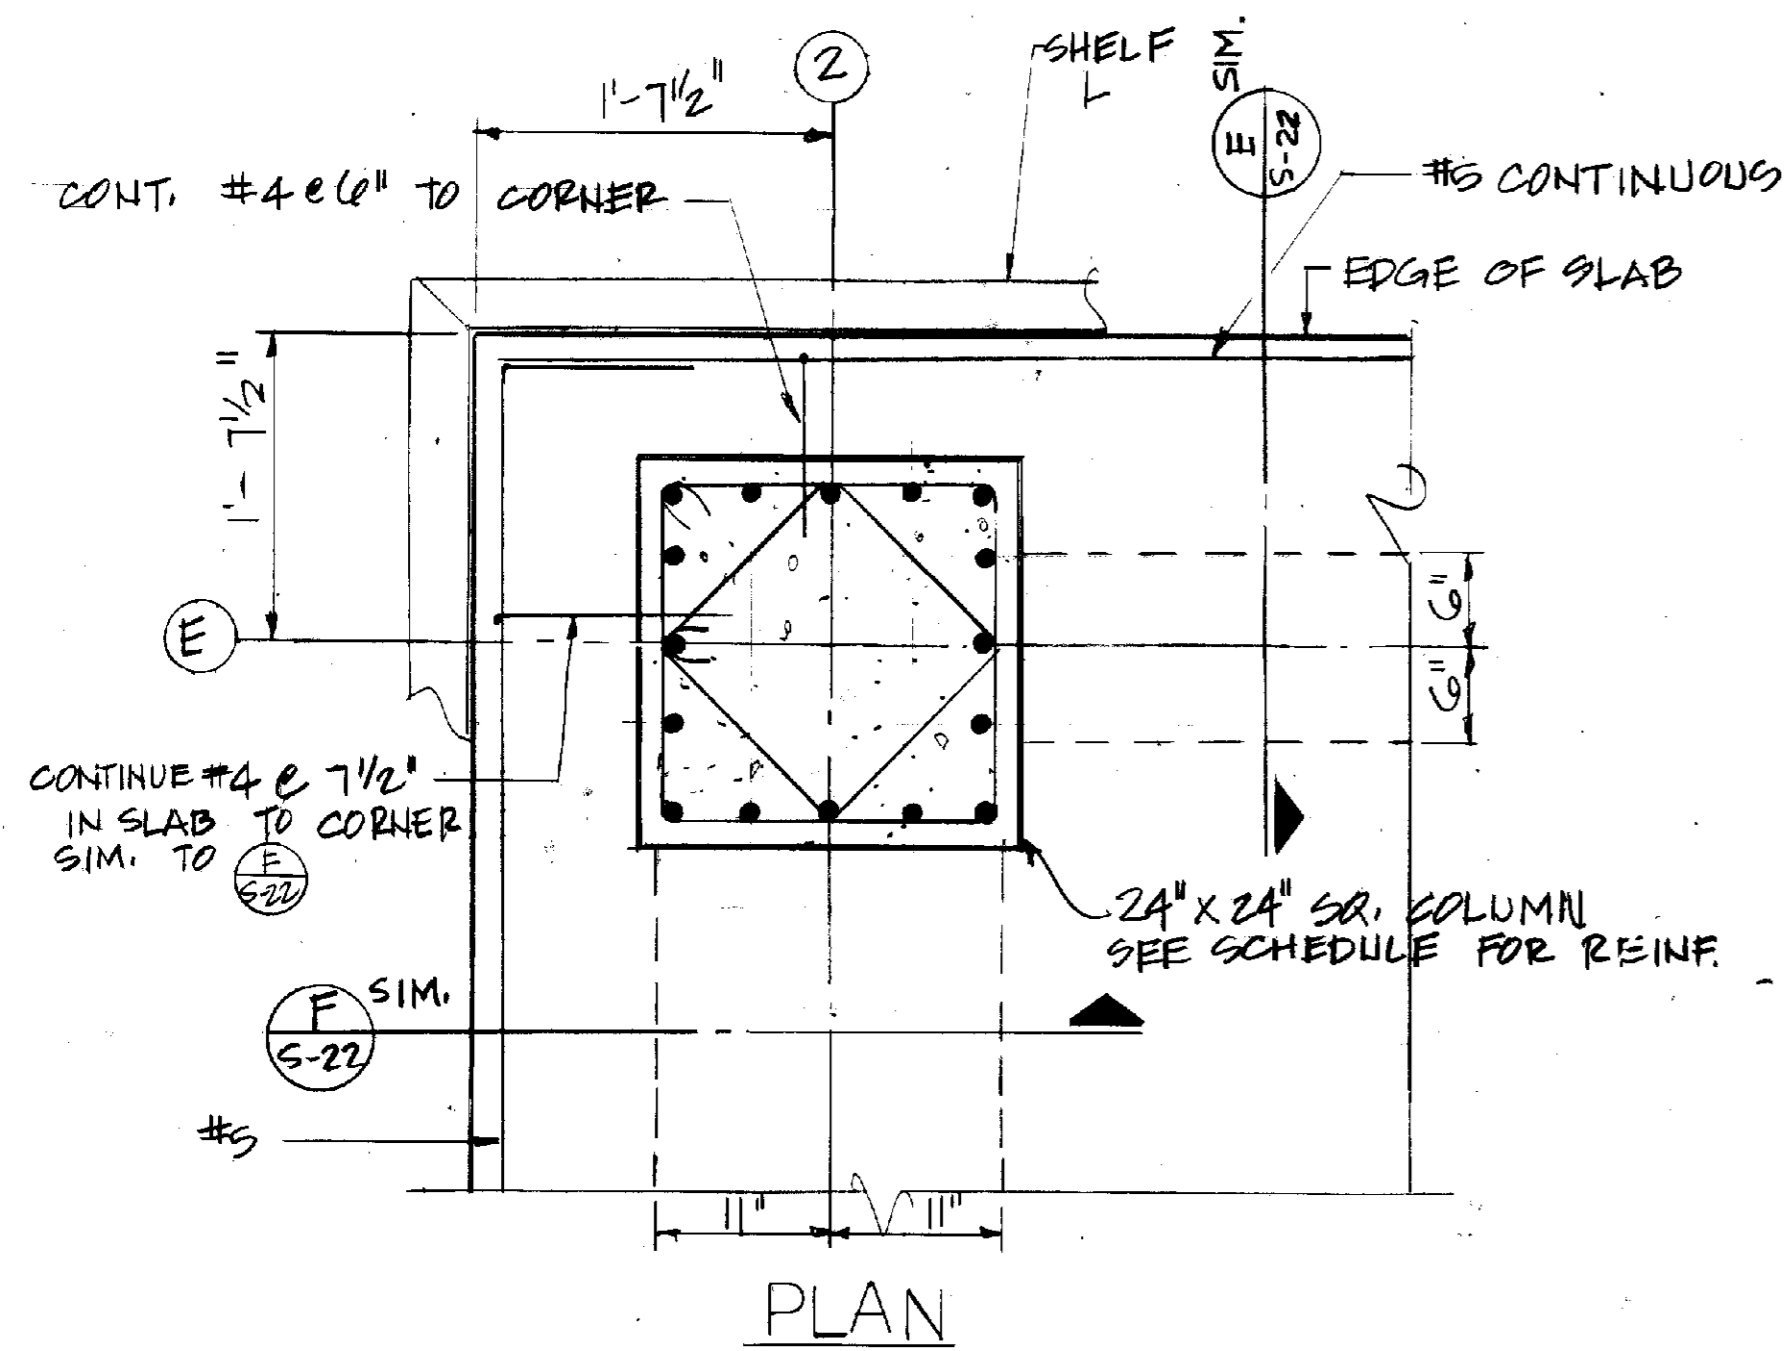


1 DETAIL
S-20 SCALE: 1"=1'-0"

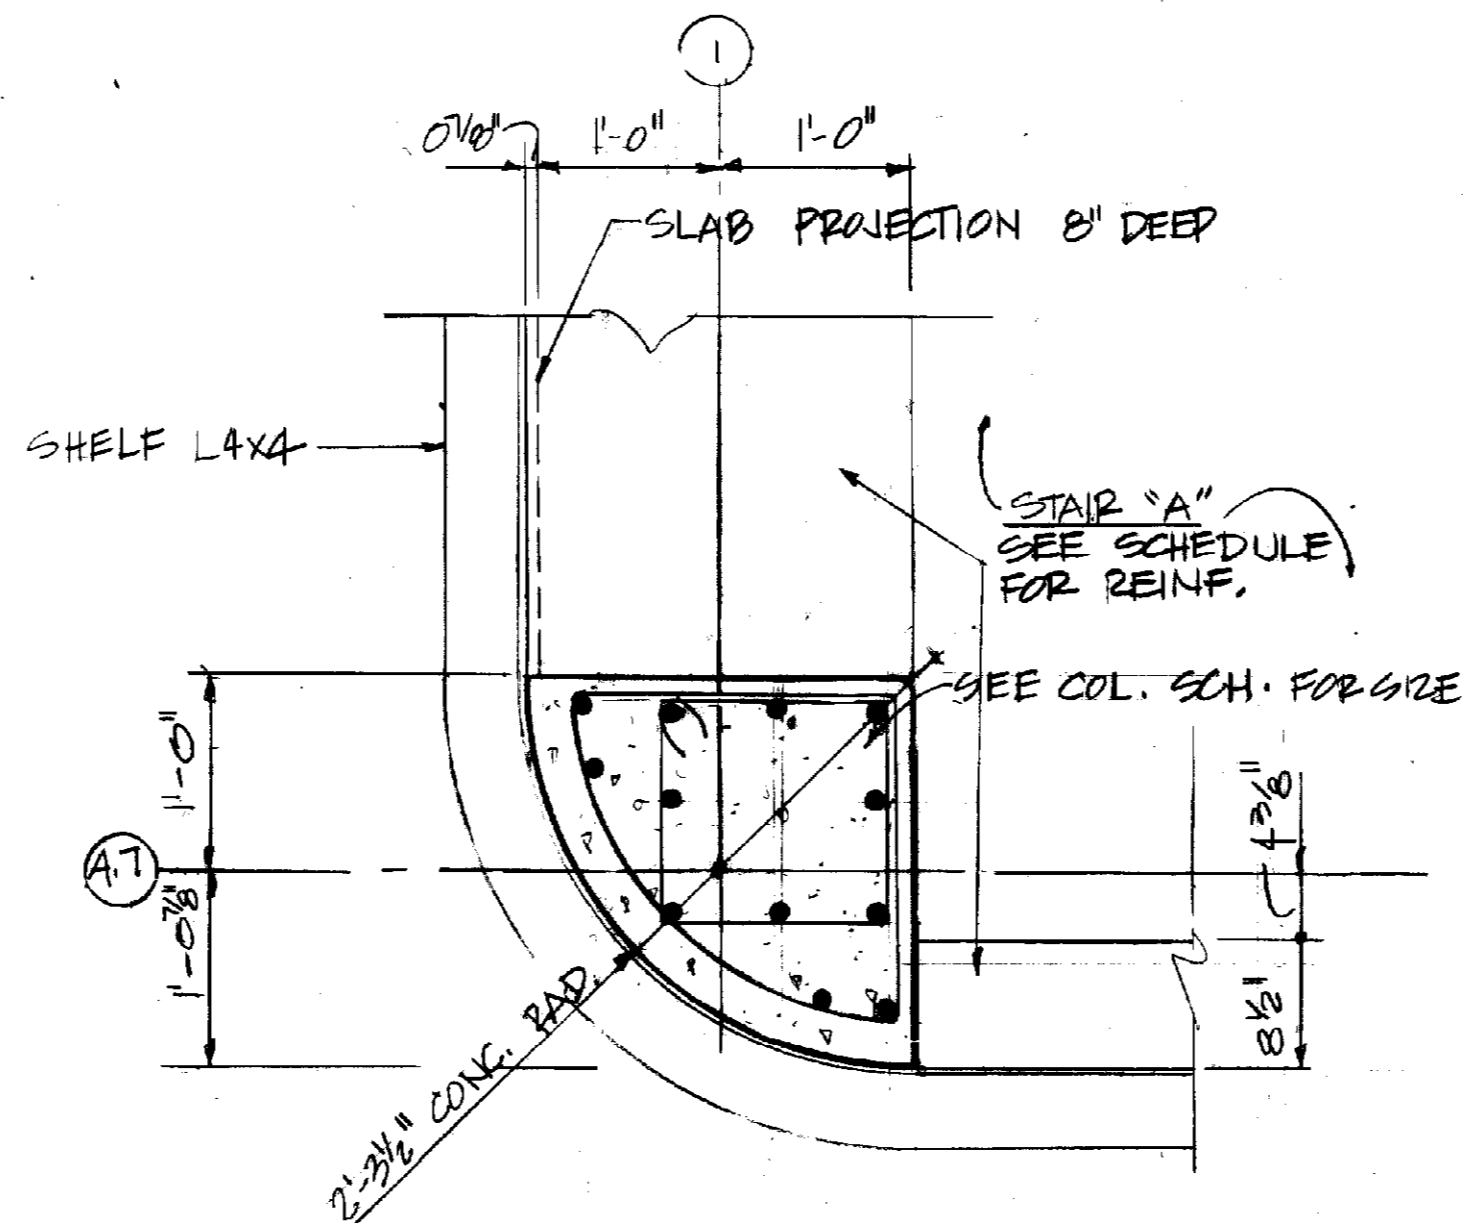


2 DETAIL
S-20 SCALE: 1"=1'-0"

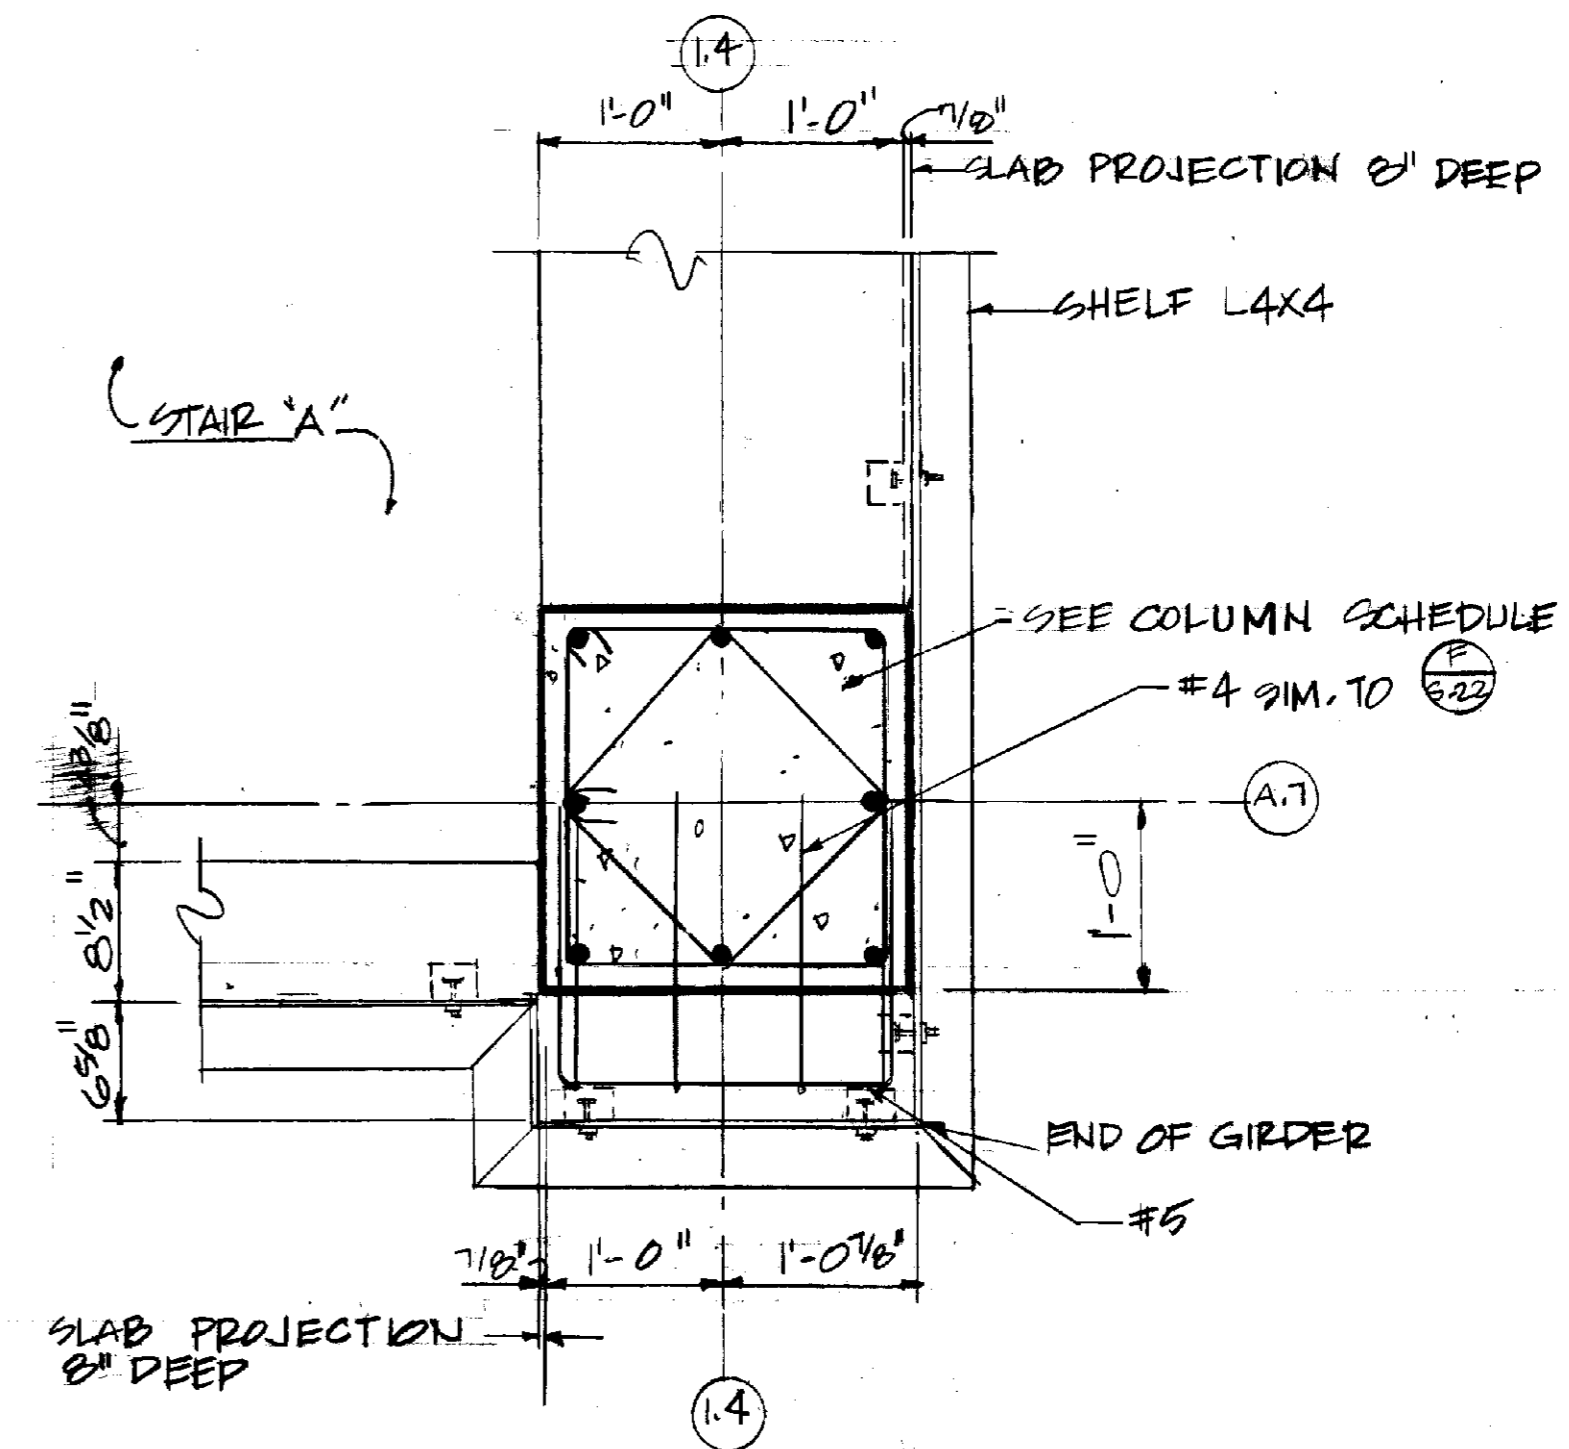


3 DETAIL
S-20 SCALE: 1"=1'-0"

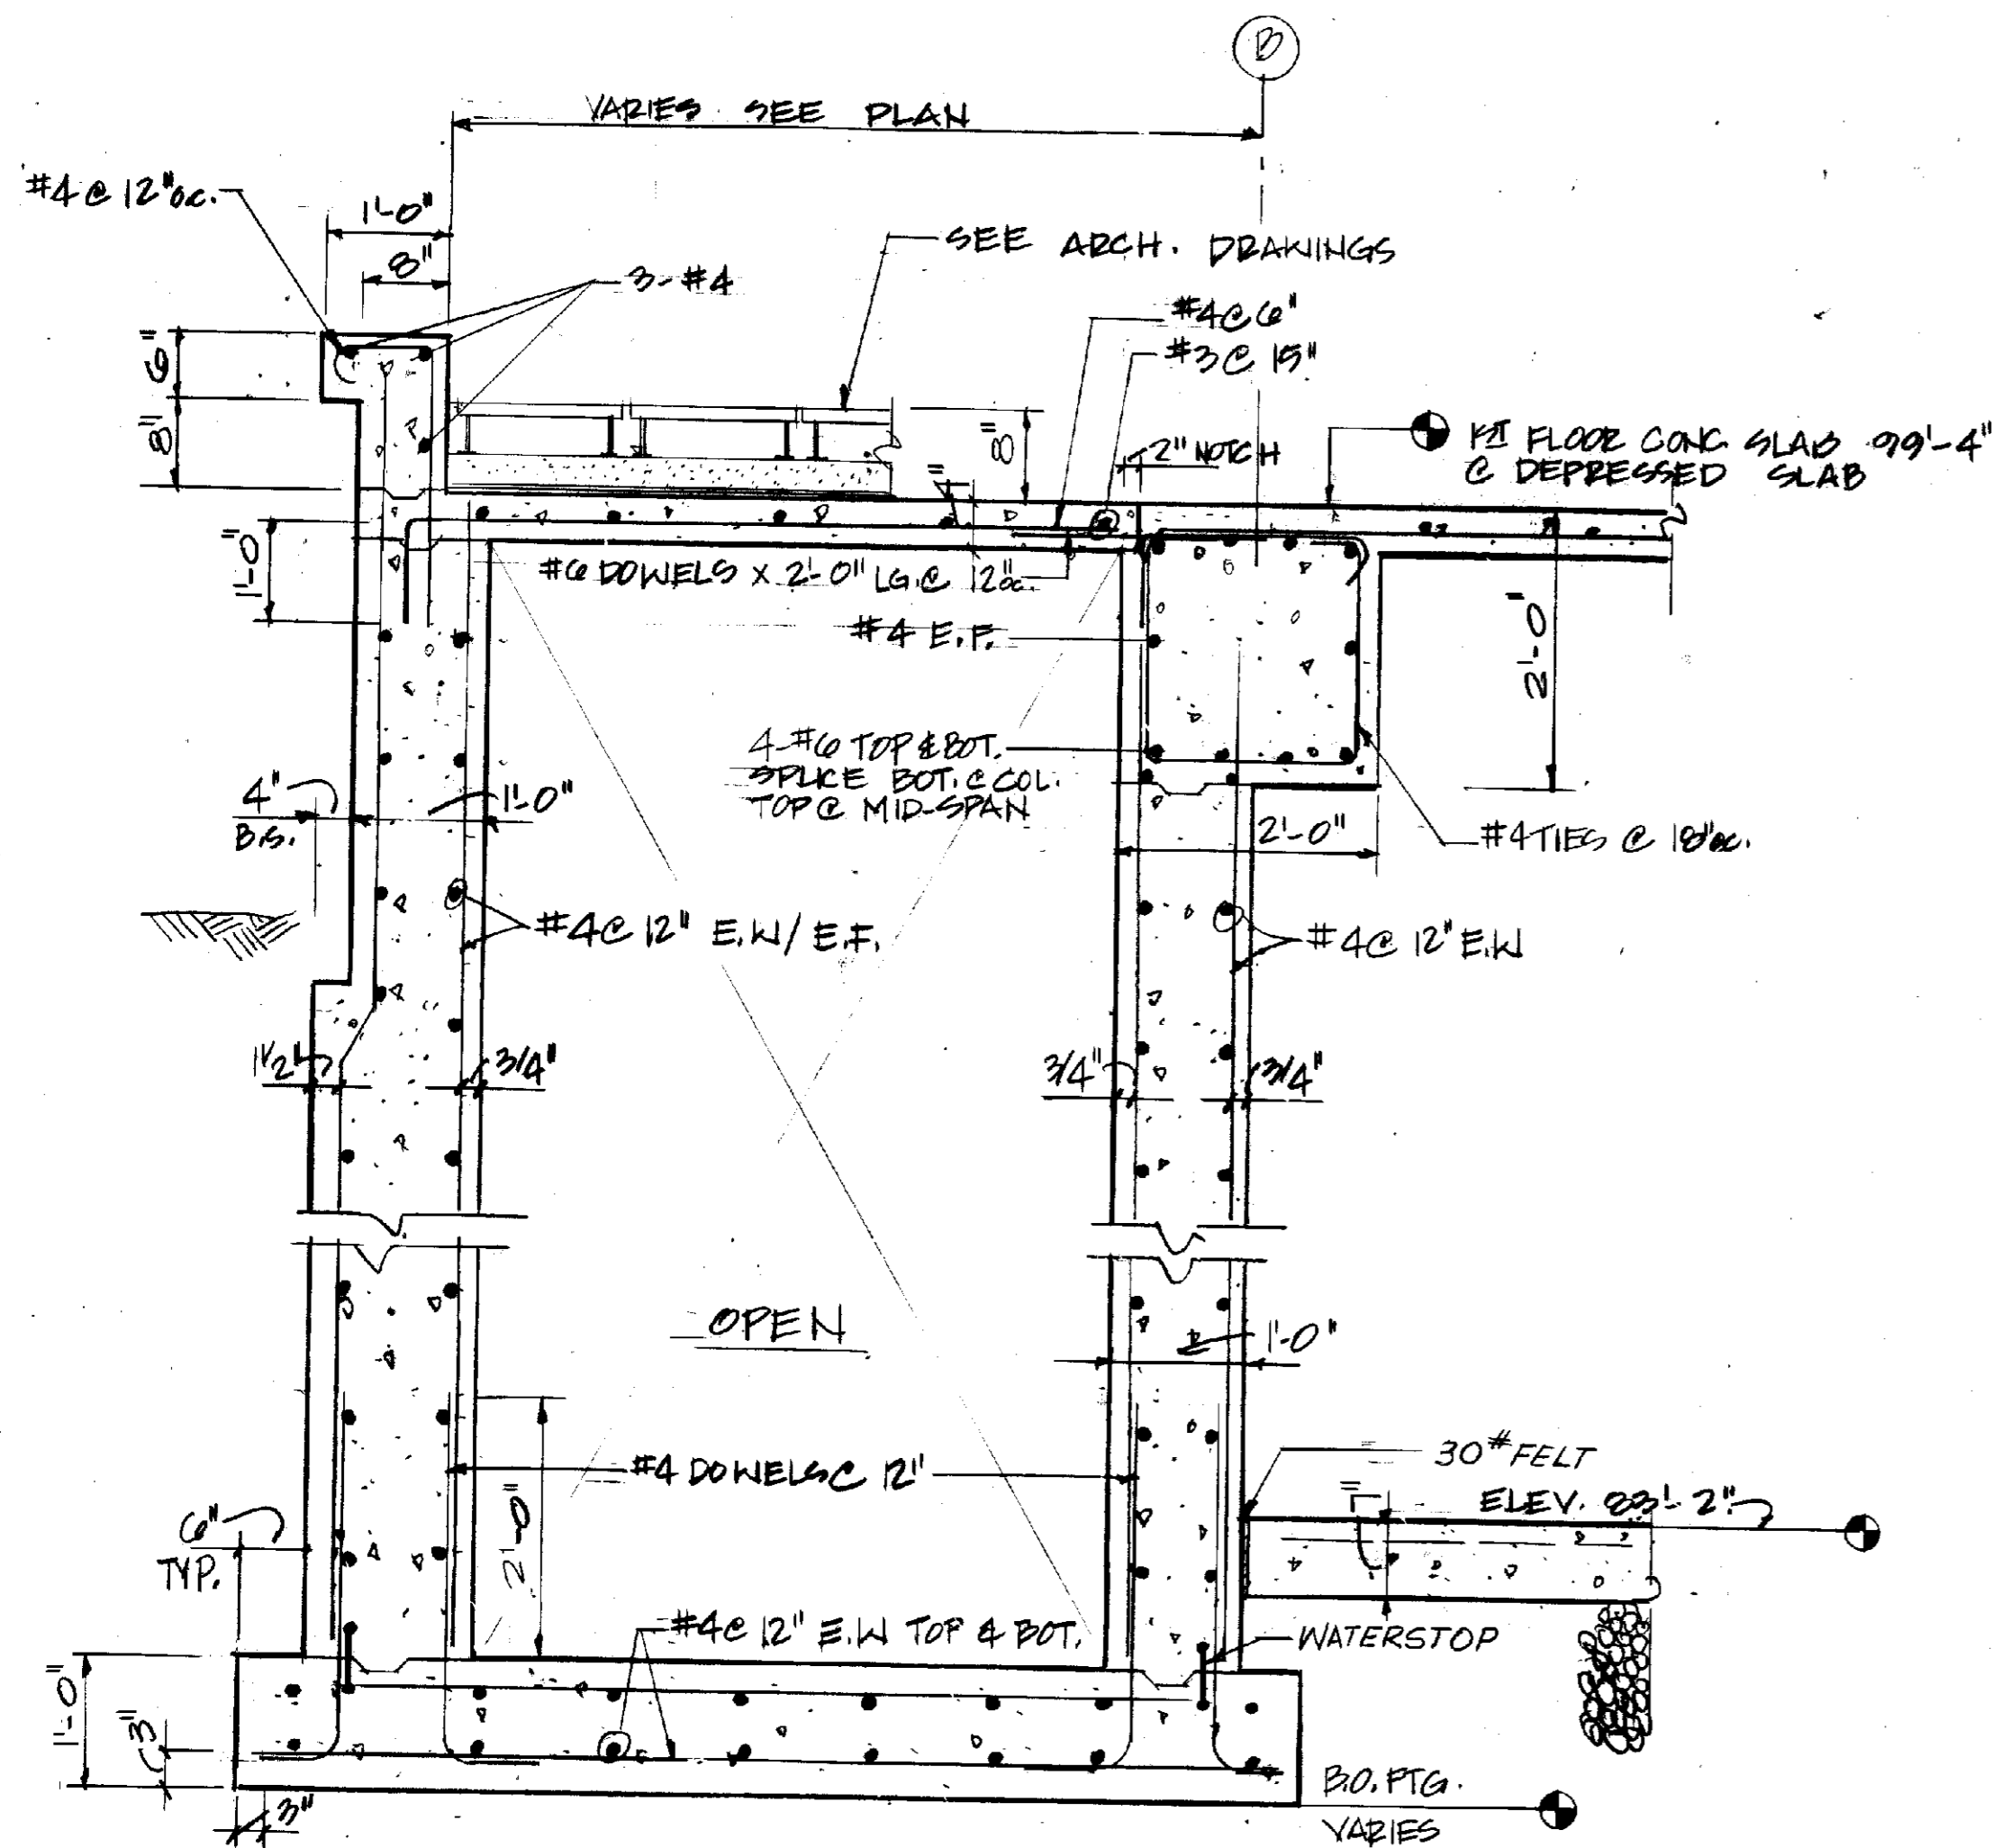


A SECTION
S-20 SCALE: 3/4"=1'-0"

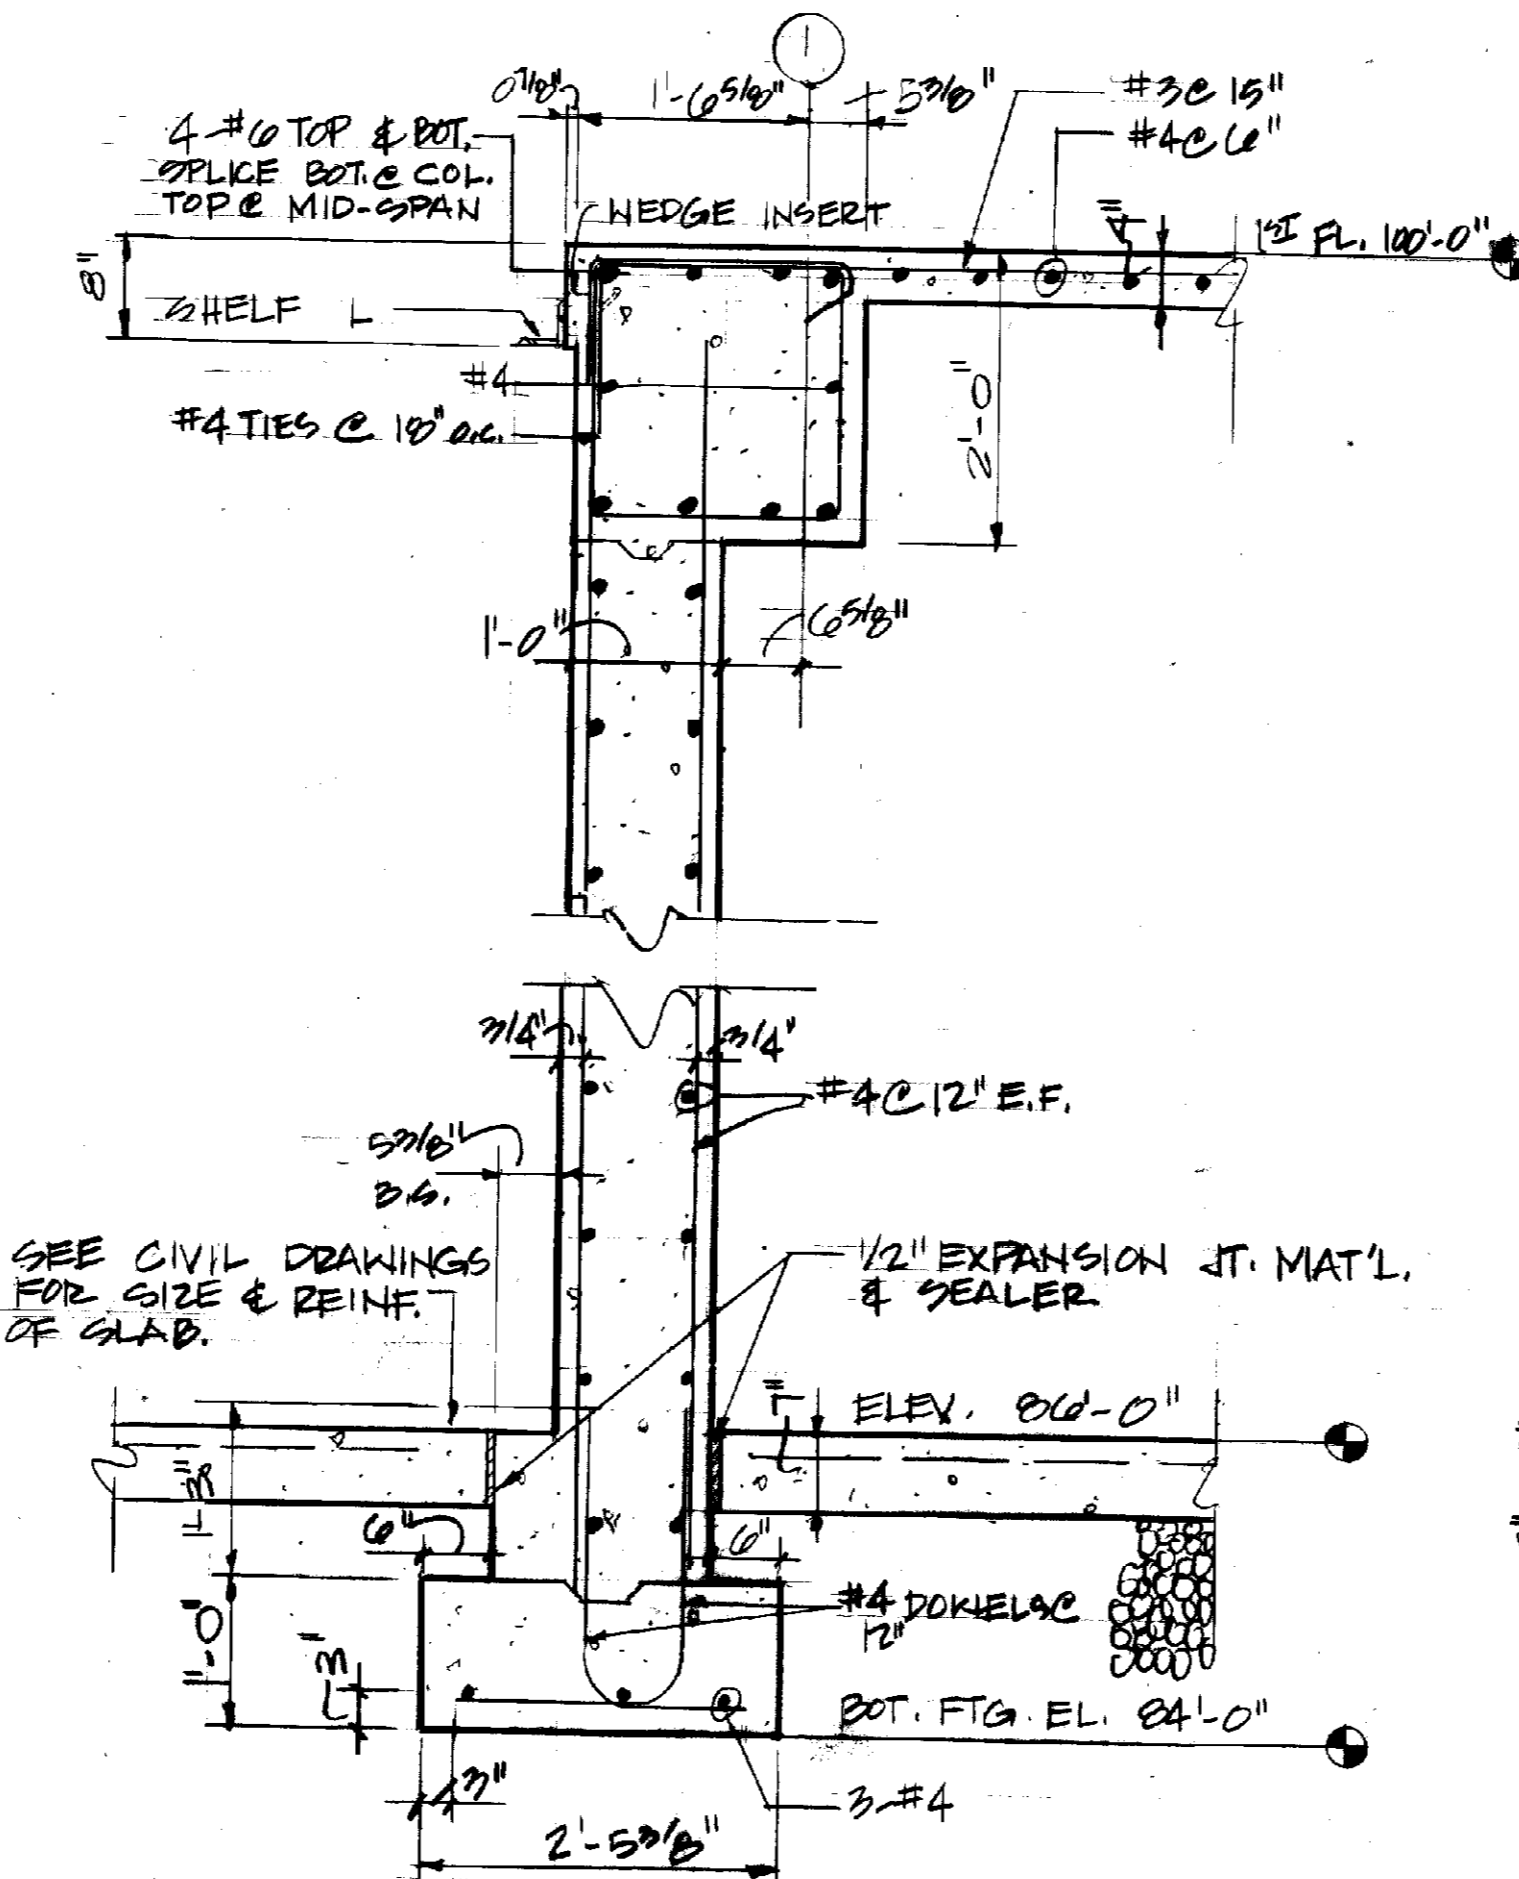


B SECTION
S-20 SCALE: 3/4"=1'-0"

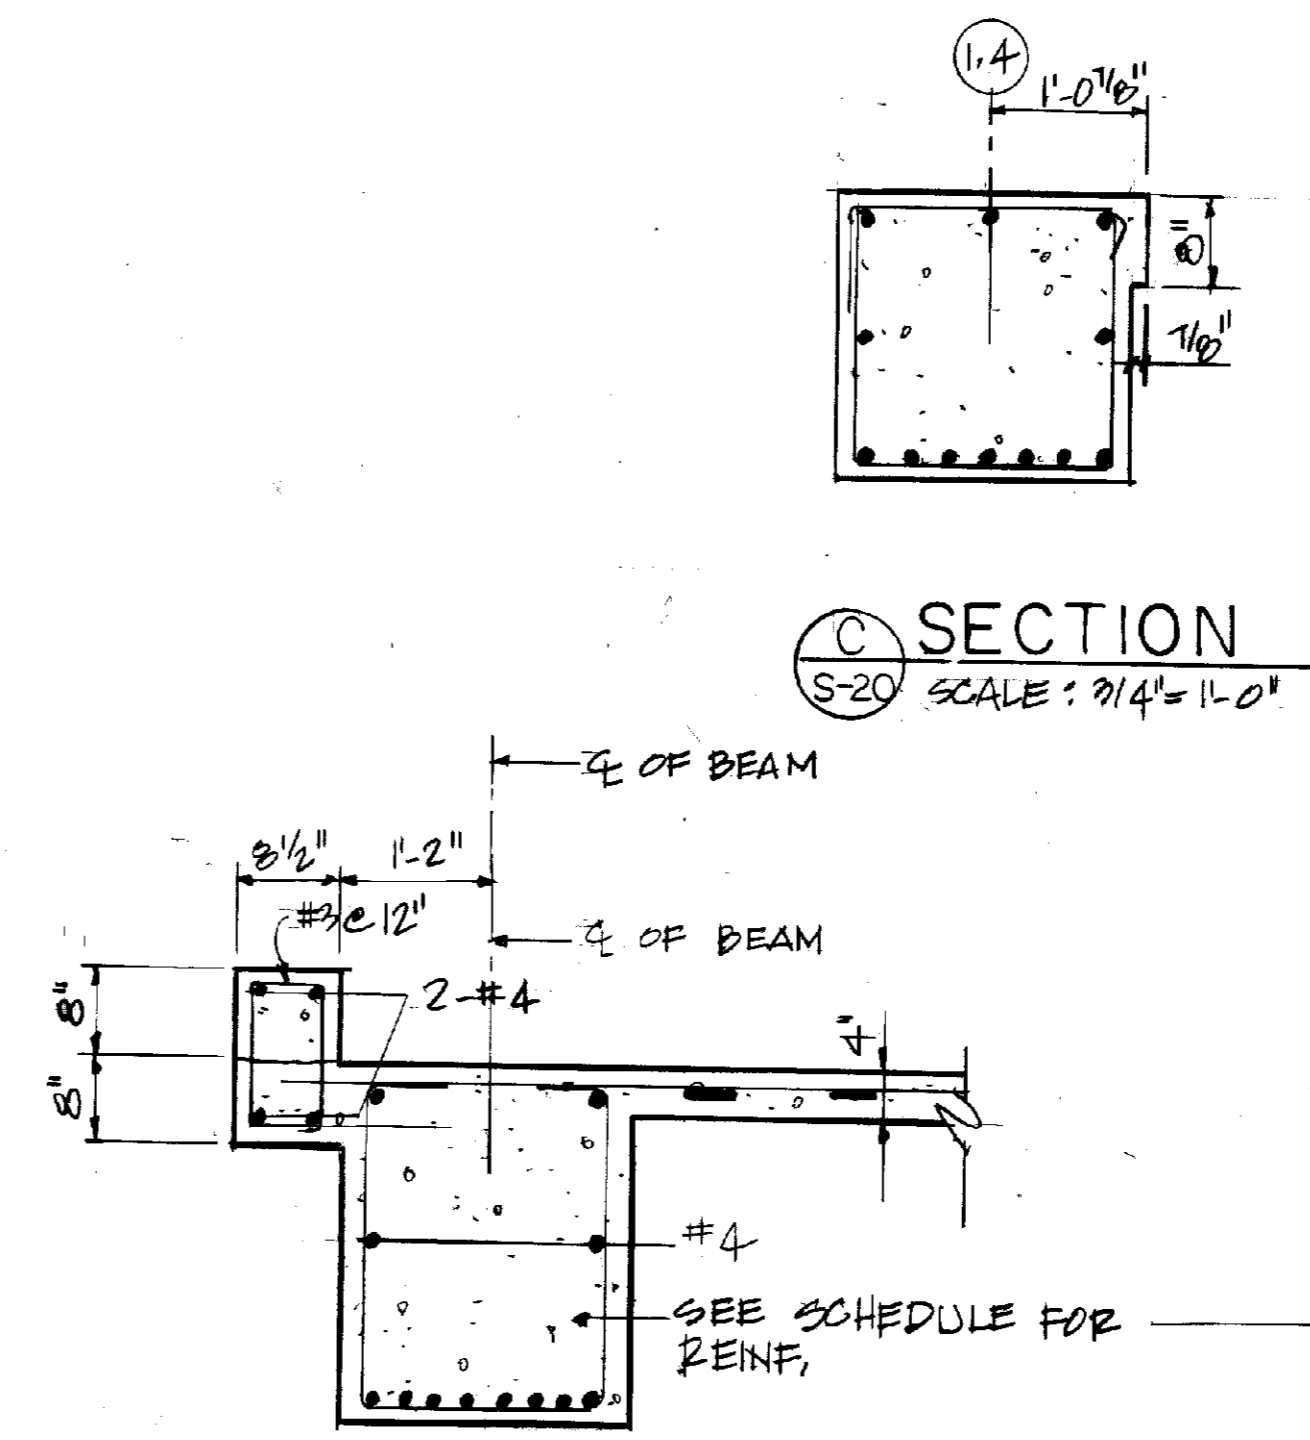

C SECTION
S-20 SCALE: 3/4"=1'-0"

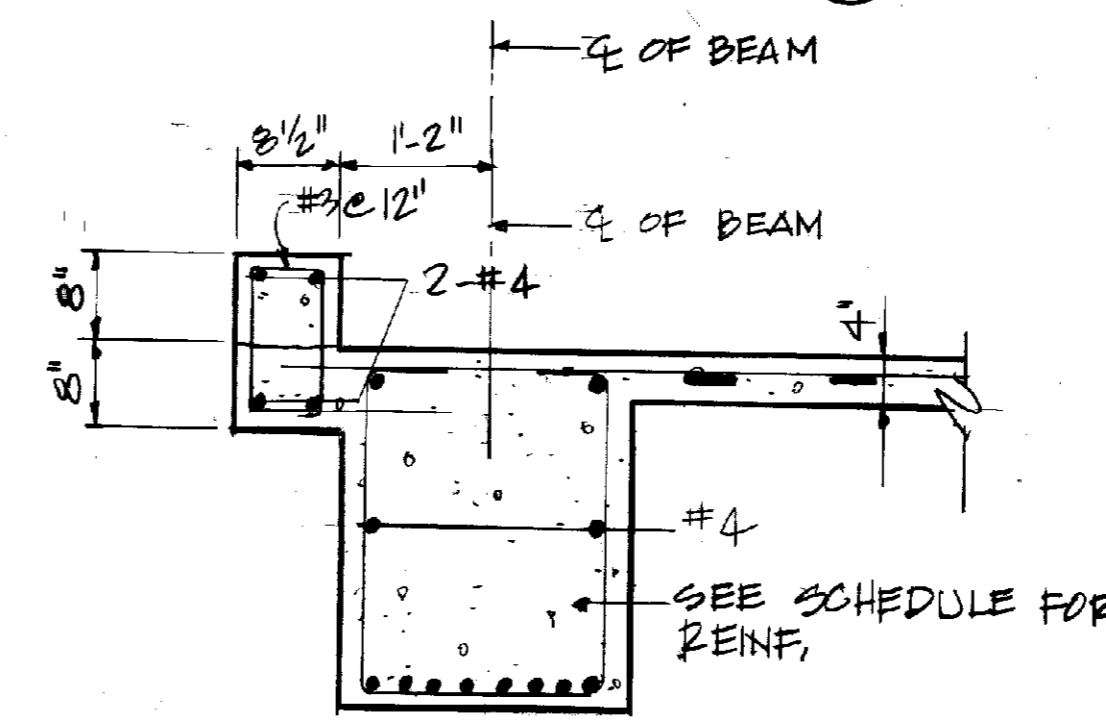

D SECTION
S-20 SCALE: 3/4"=1'-0"

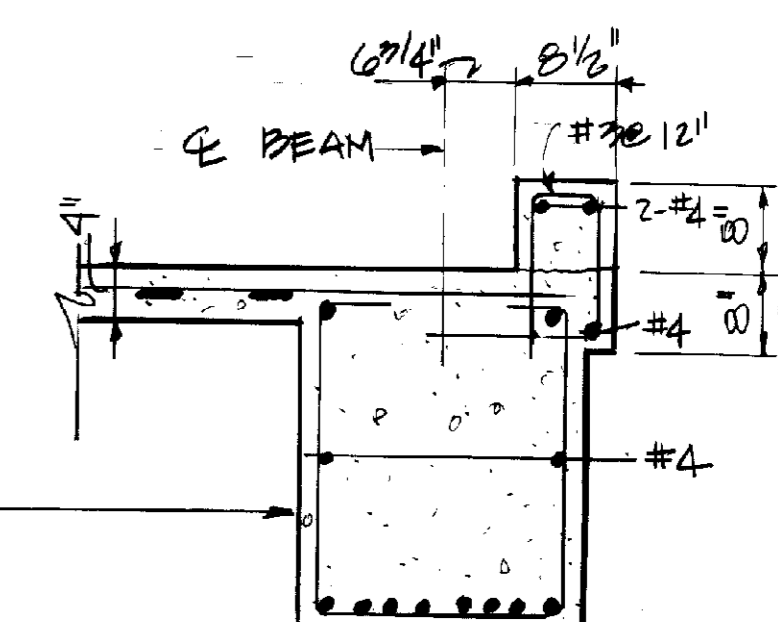

E SECTION
S-20 SCALE: 3/4"=1'-0"

RECORD PRINTS
THESE ARE RECORD PRINTS OF DRAWINGS BASED UPON THE RECORDS OF THE PROJECT. THESE DRAWINGS AND OTHER DATA FURNISHED BY THE CONTRACTOR TO THE ENGINEER AND WHICH THE ENGINEER CONSIDERS NECESSARY.

MASON & HANGER ENGINEERING INC.
ARCHITECT • ENGINEERS
LEXINGTON, KENTUCKY



ROBOTICS FACILITY
LEXINGTON CAMPUS
UNIVERSITY OF KENTUCKY
LEXINGTON, KENTUCKY

University of Kentucky
Lexington, Kentucky

10-19-87

Wendy Bunn
DIRECTOR OF ARCHITECTURE

SECTIONS & DETAILS

Sherman Carter Barnhart
PARTNERS IN ARCHITECTURE


JOB NO. 2046
DATE 10-19-87
DRAWN M.A.A.
CHECKED A.L.P.
FILE NO. 431.0

REVISIONS


NO.	DATE	DESCRIPTION

SHEET


S-20

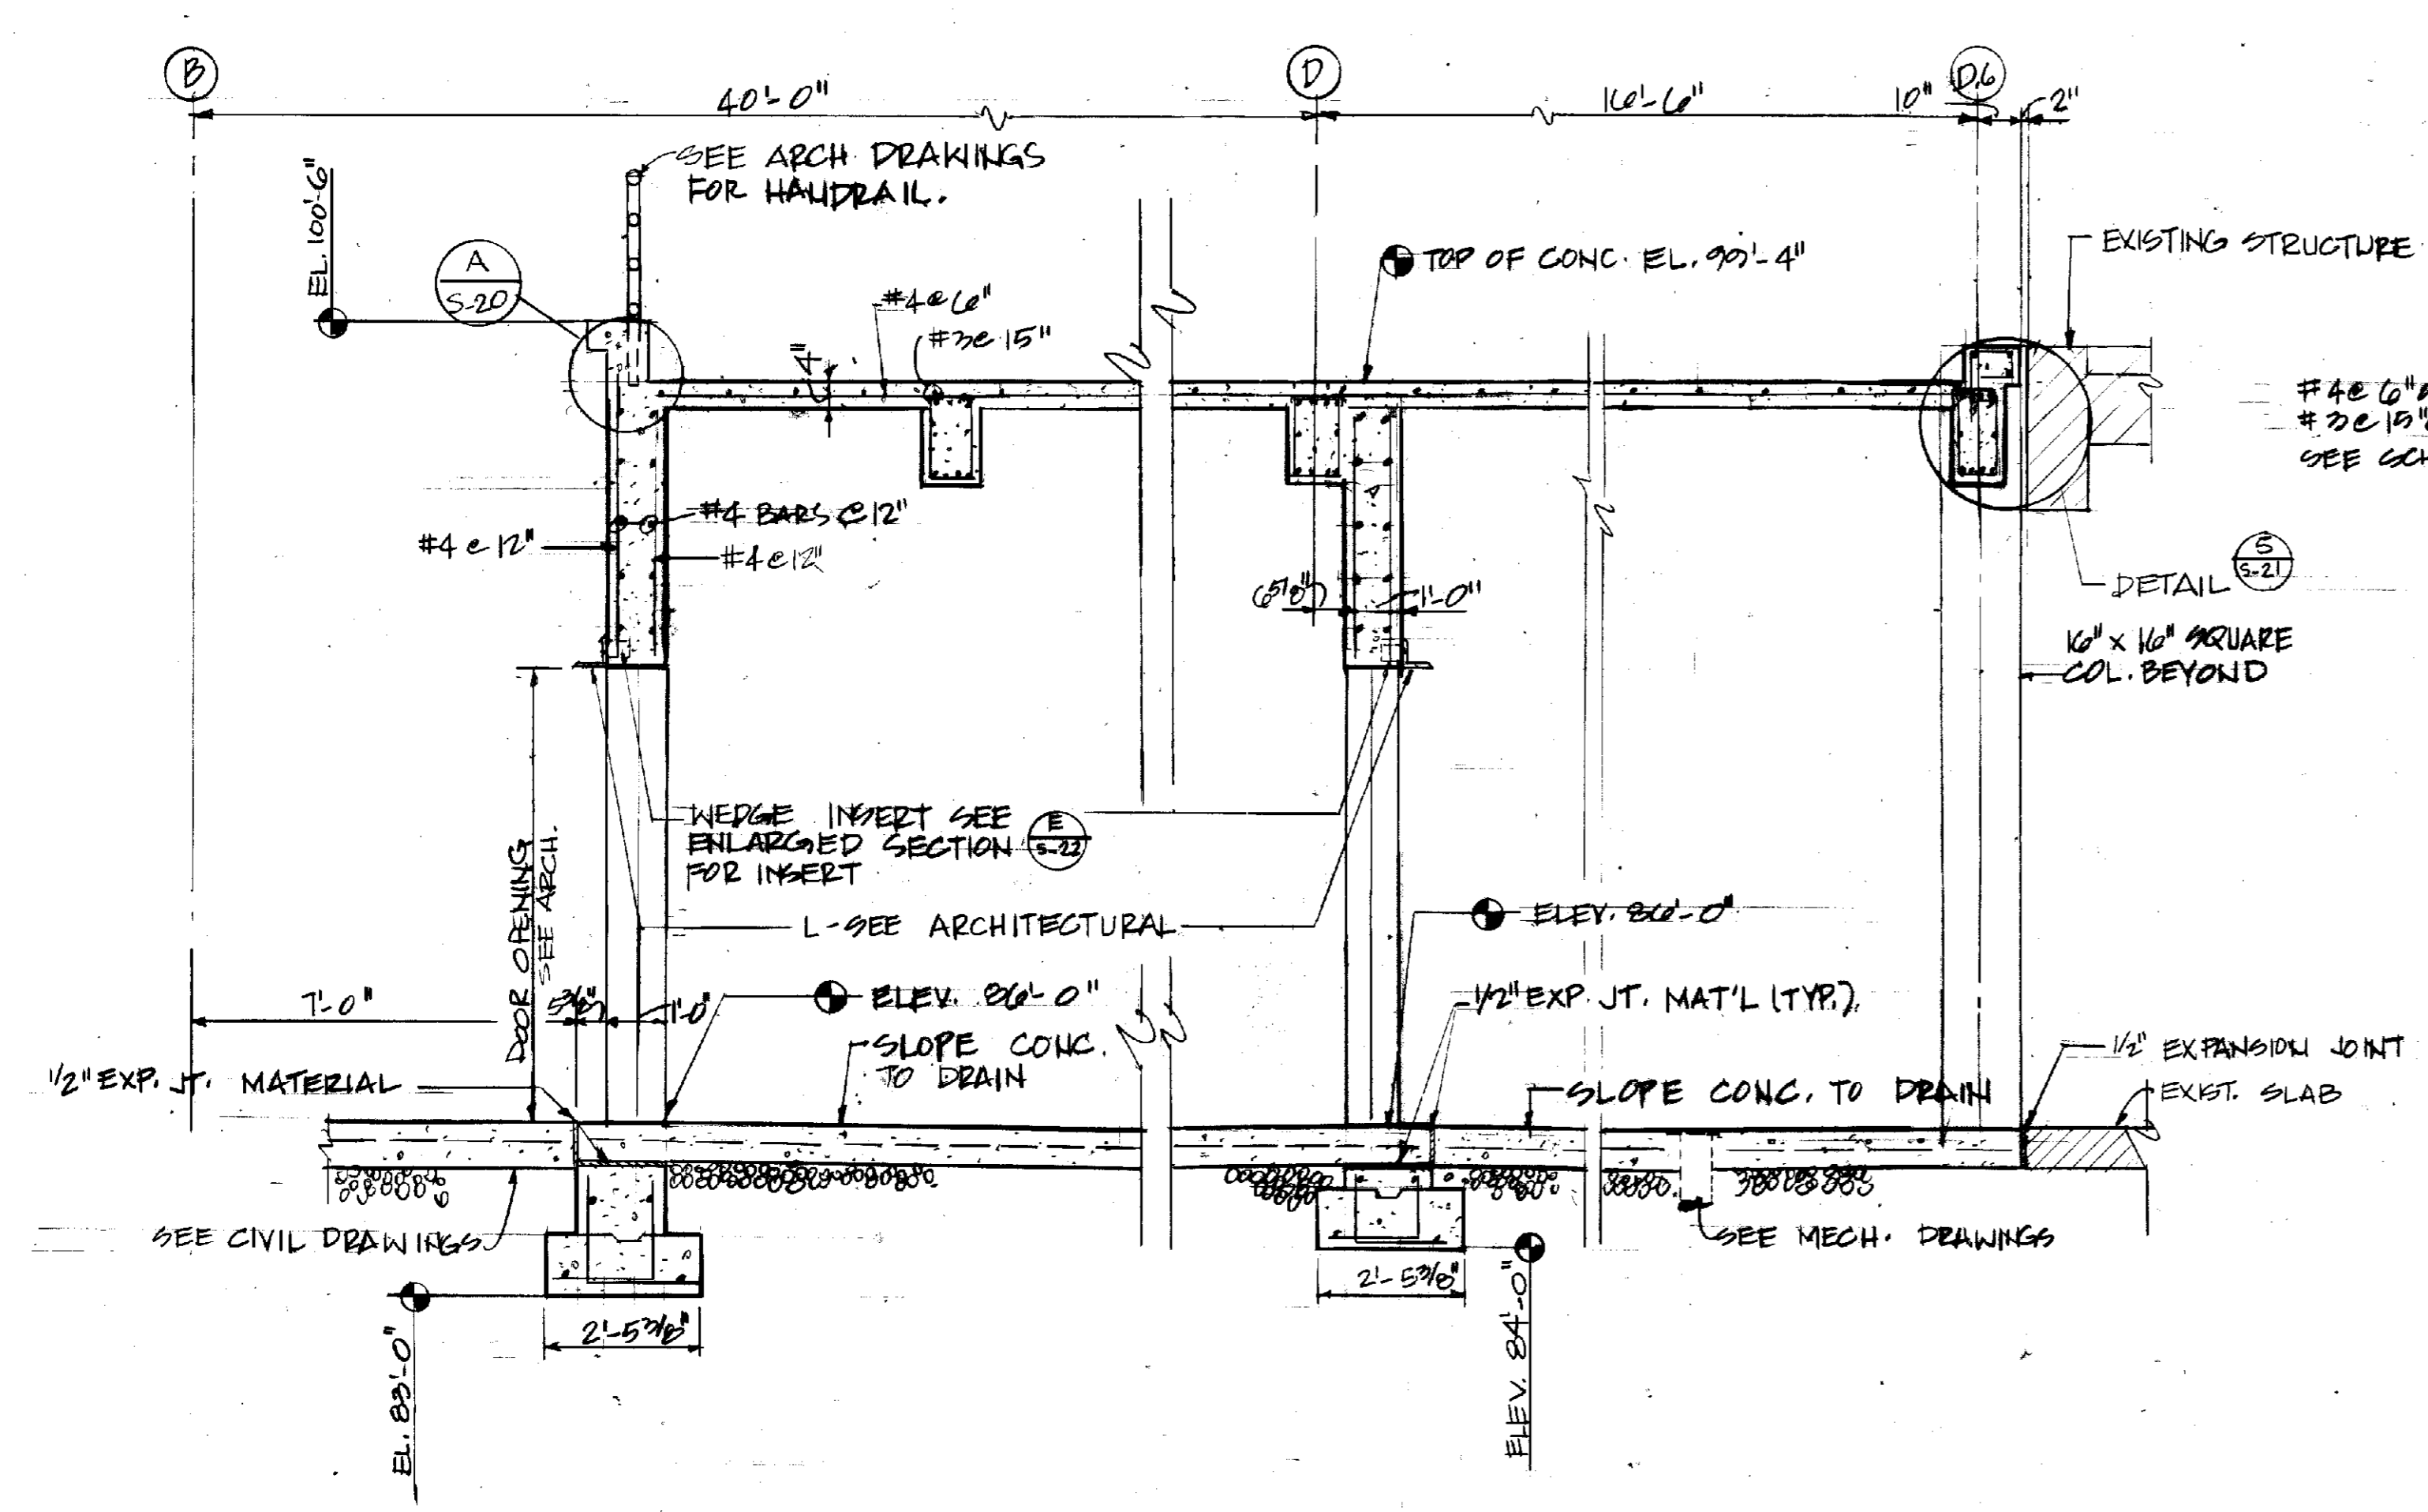


A SECTION
S-21 SCALE: 3/8" = 1'-0"

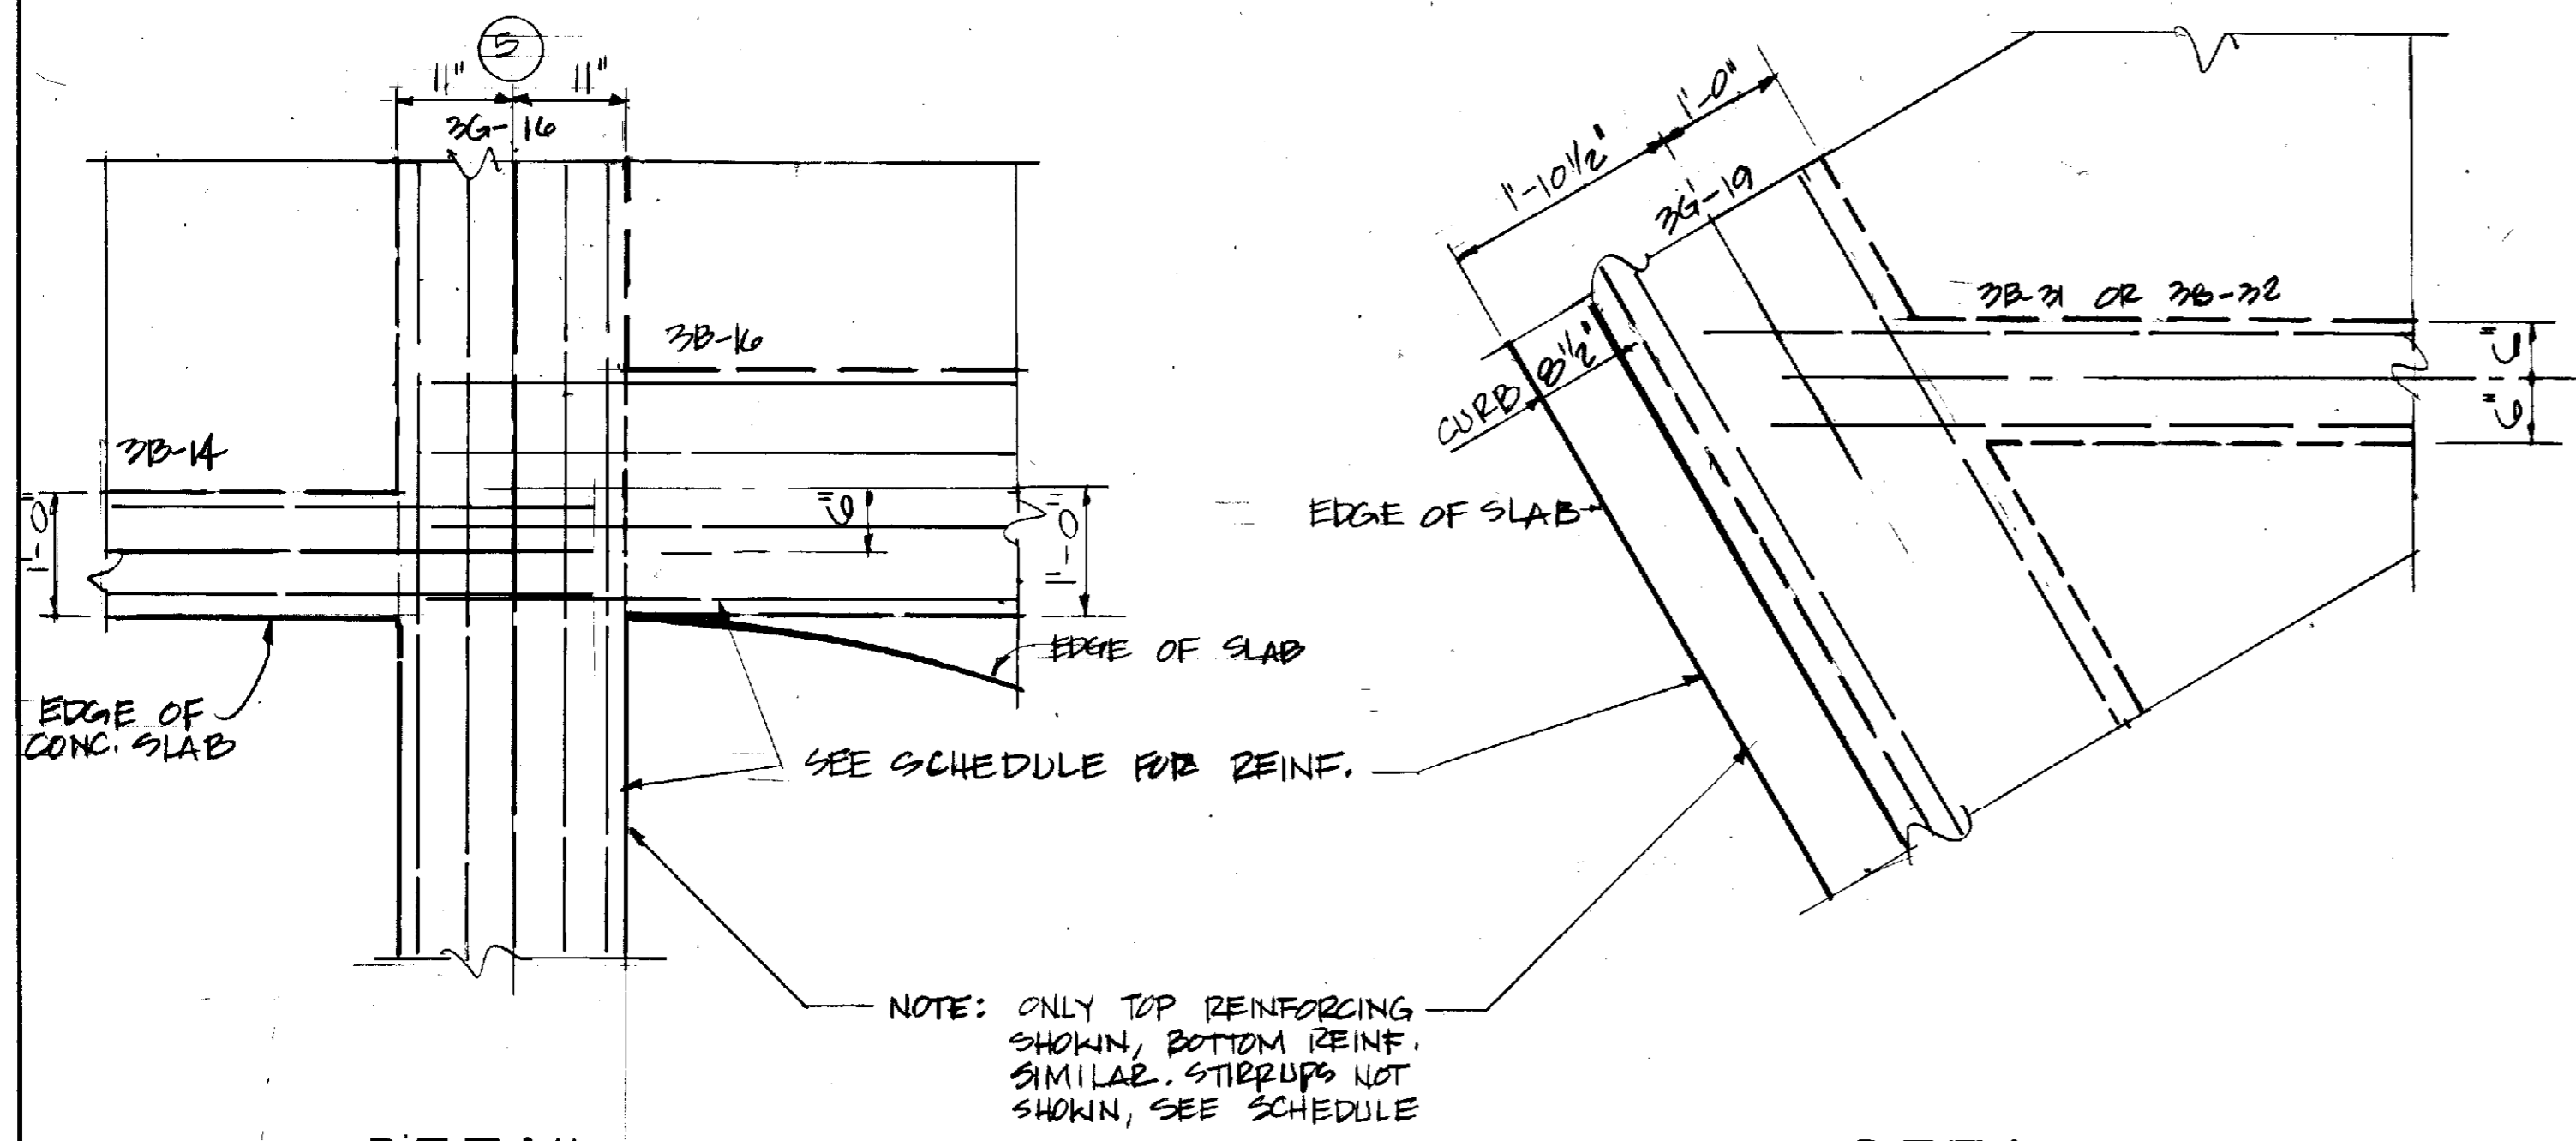


2 DETAIL
S-21 SCALE: 3/4" = 1'-0"

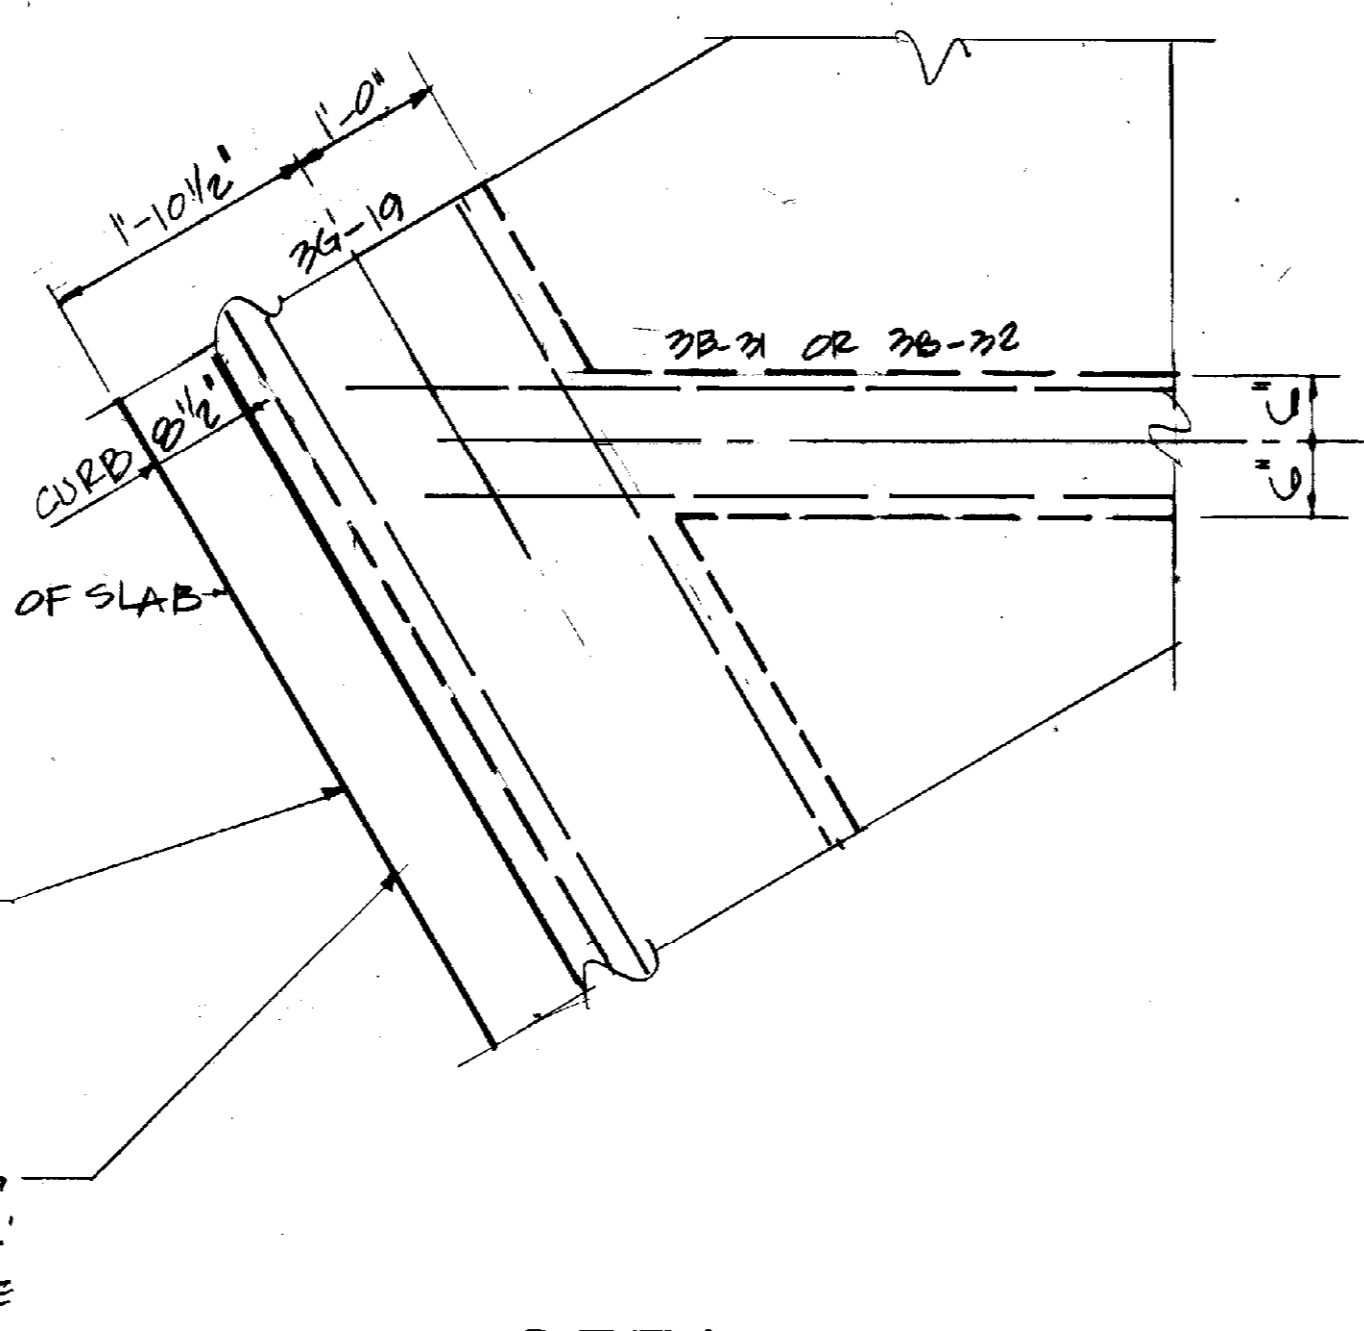


3 DETAIL
S-21 SCALE: 3/4" = 1'-0"

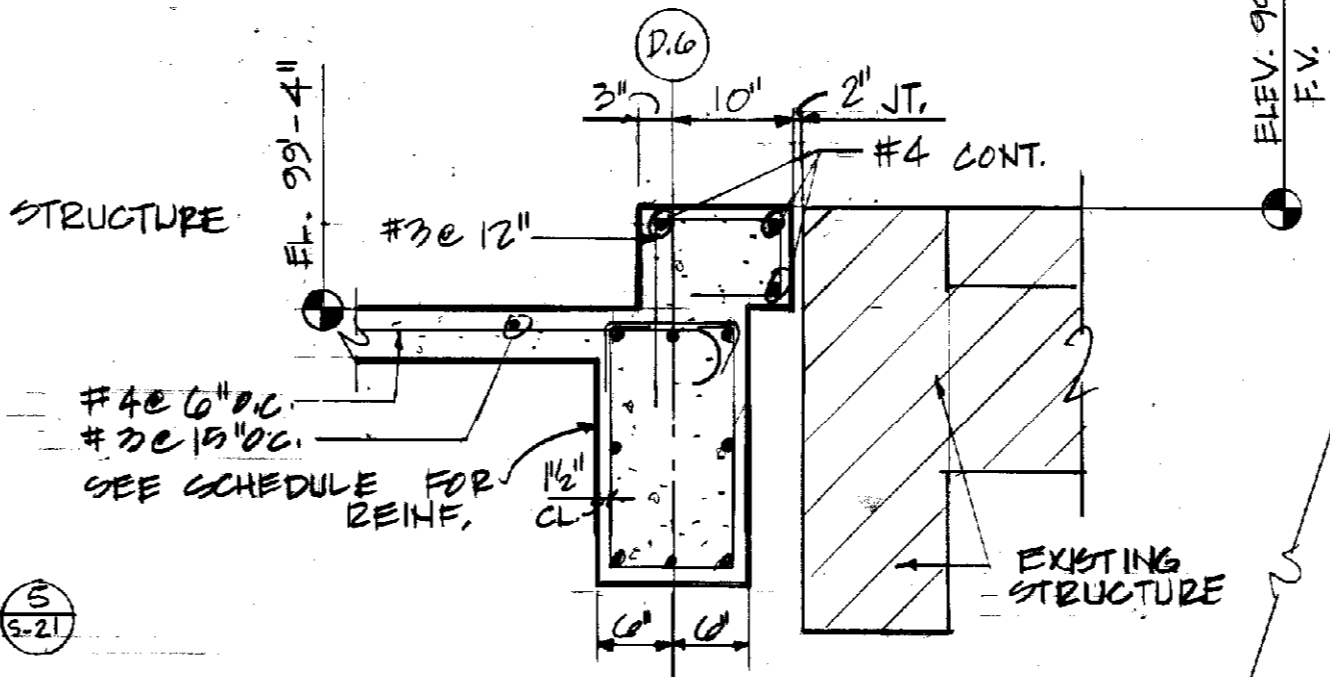

5 DETAIL
S-21 SCALE: 3/4" = 1'-0"

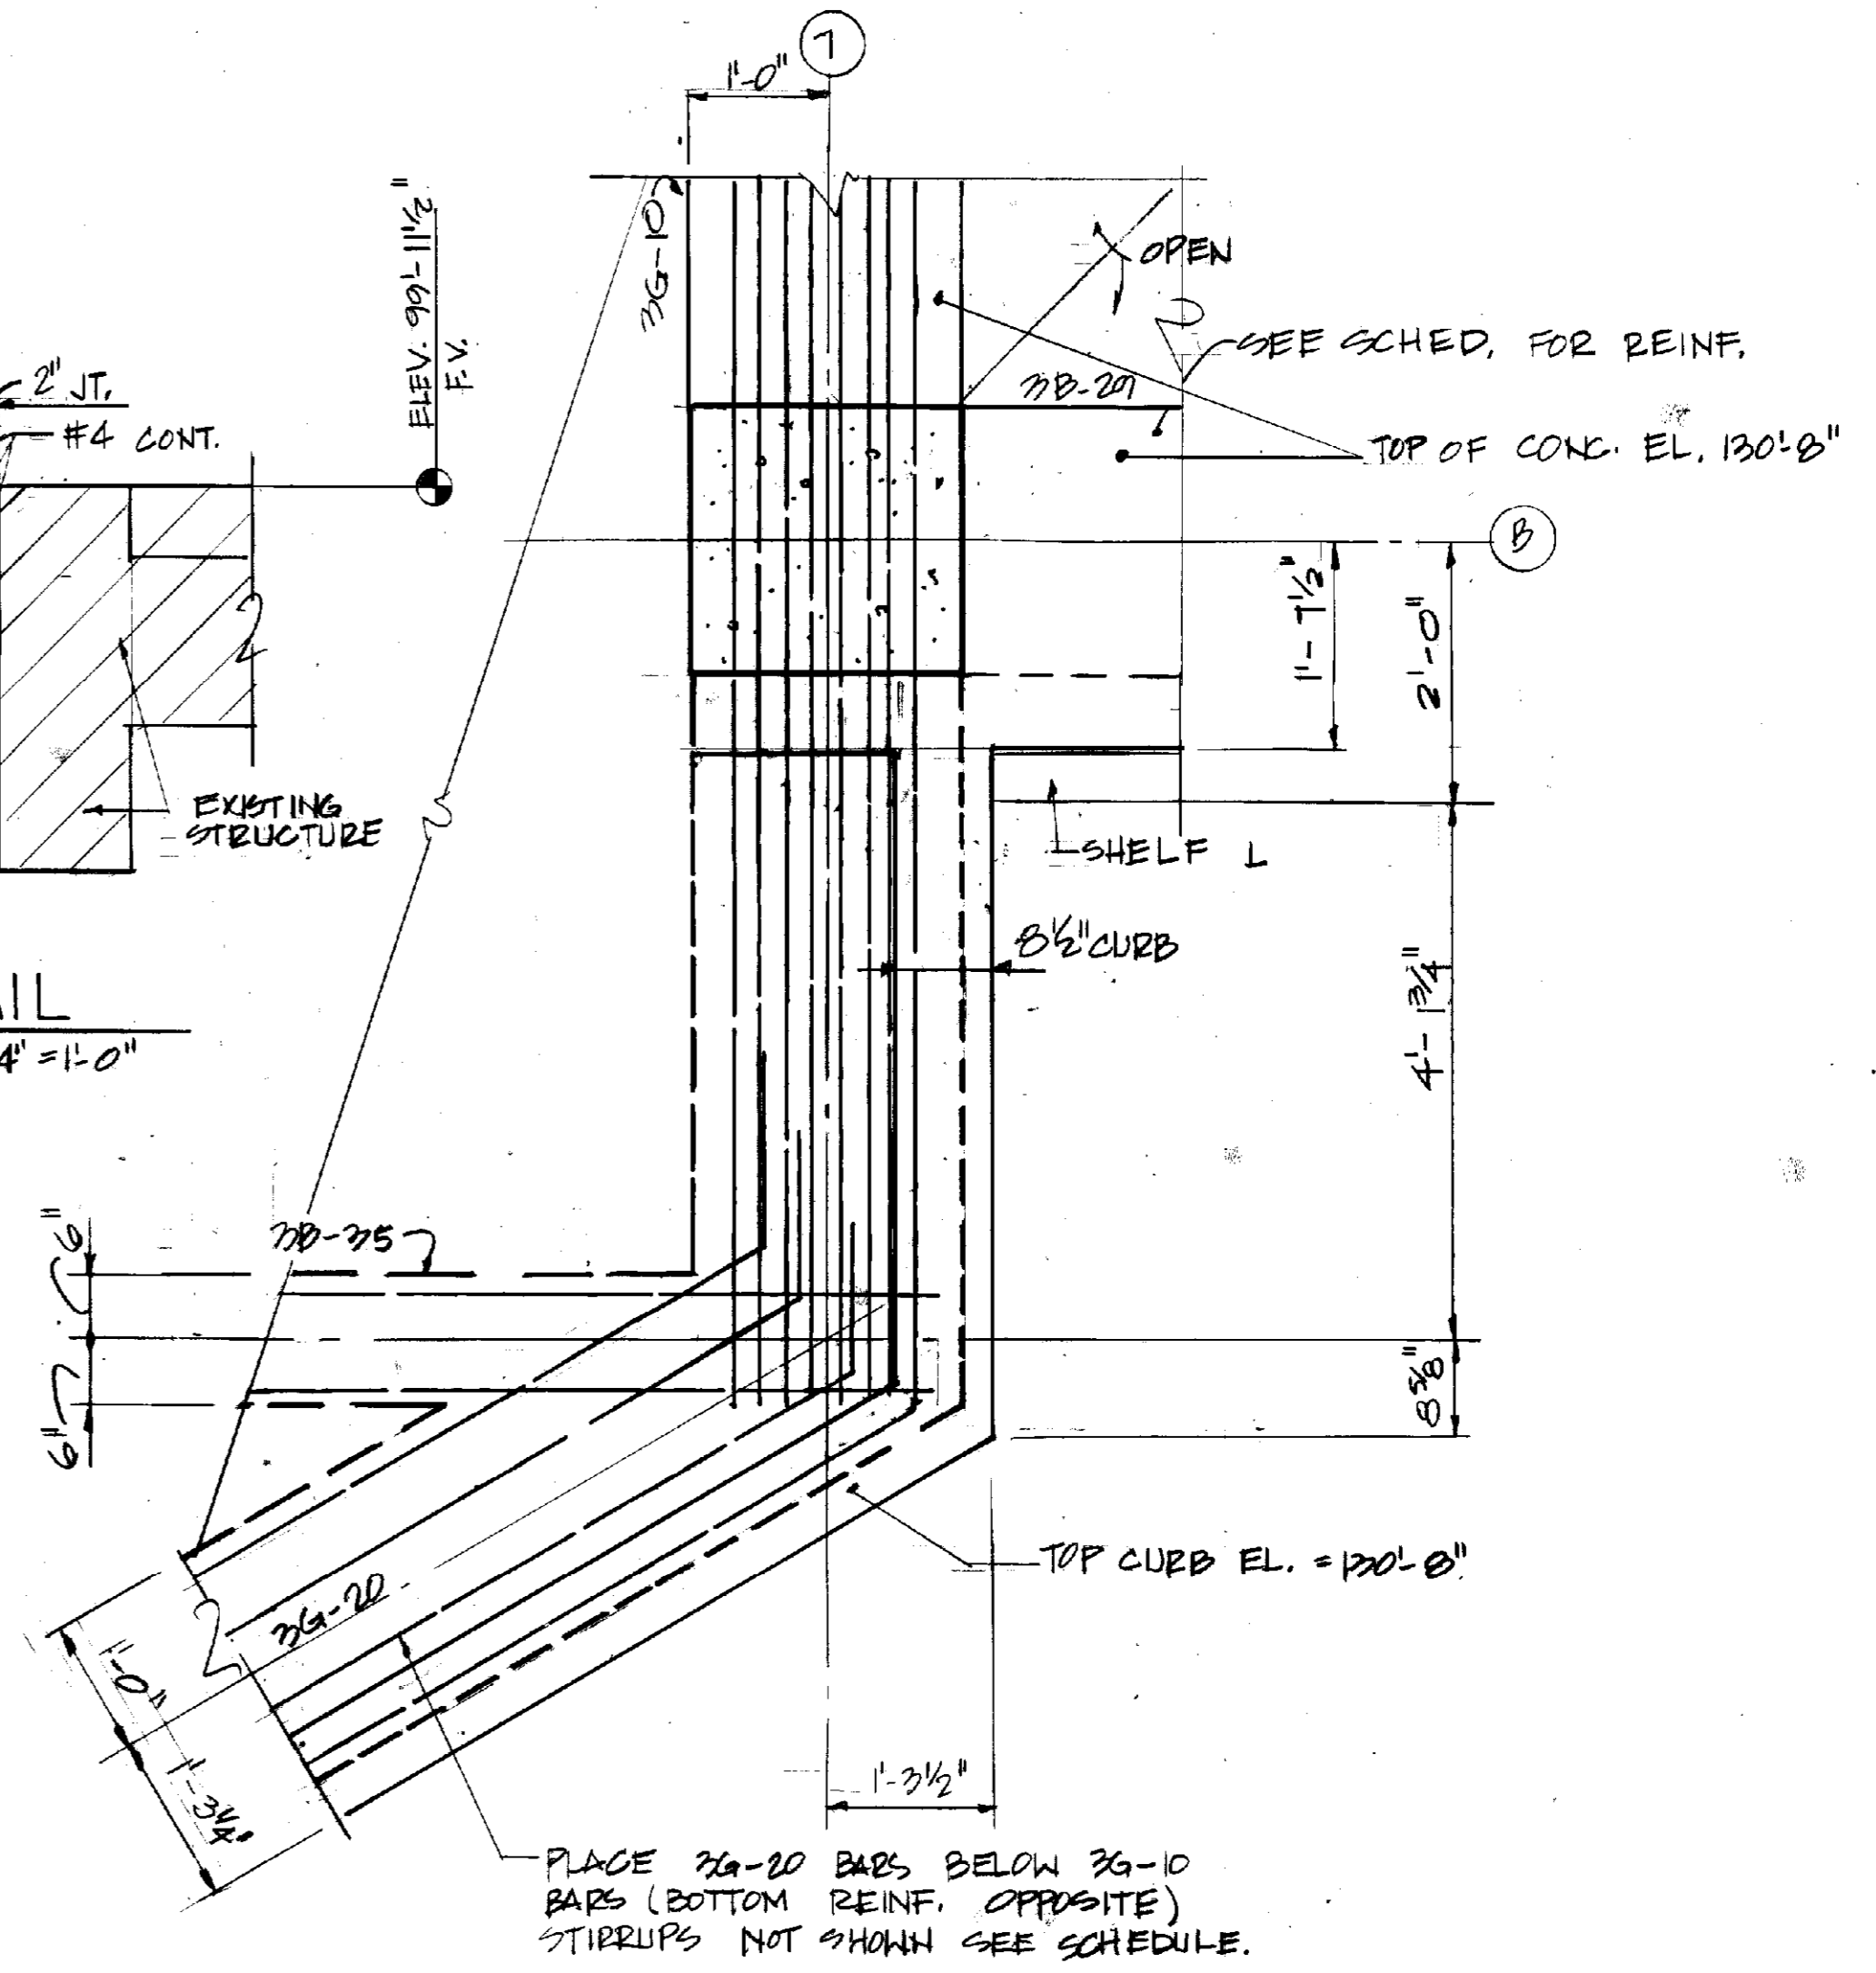

1 DETAIL
S-21 SCALE: 3/4" = 1'-0"

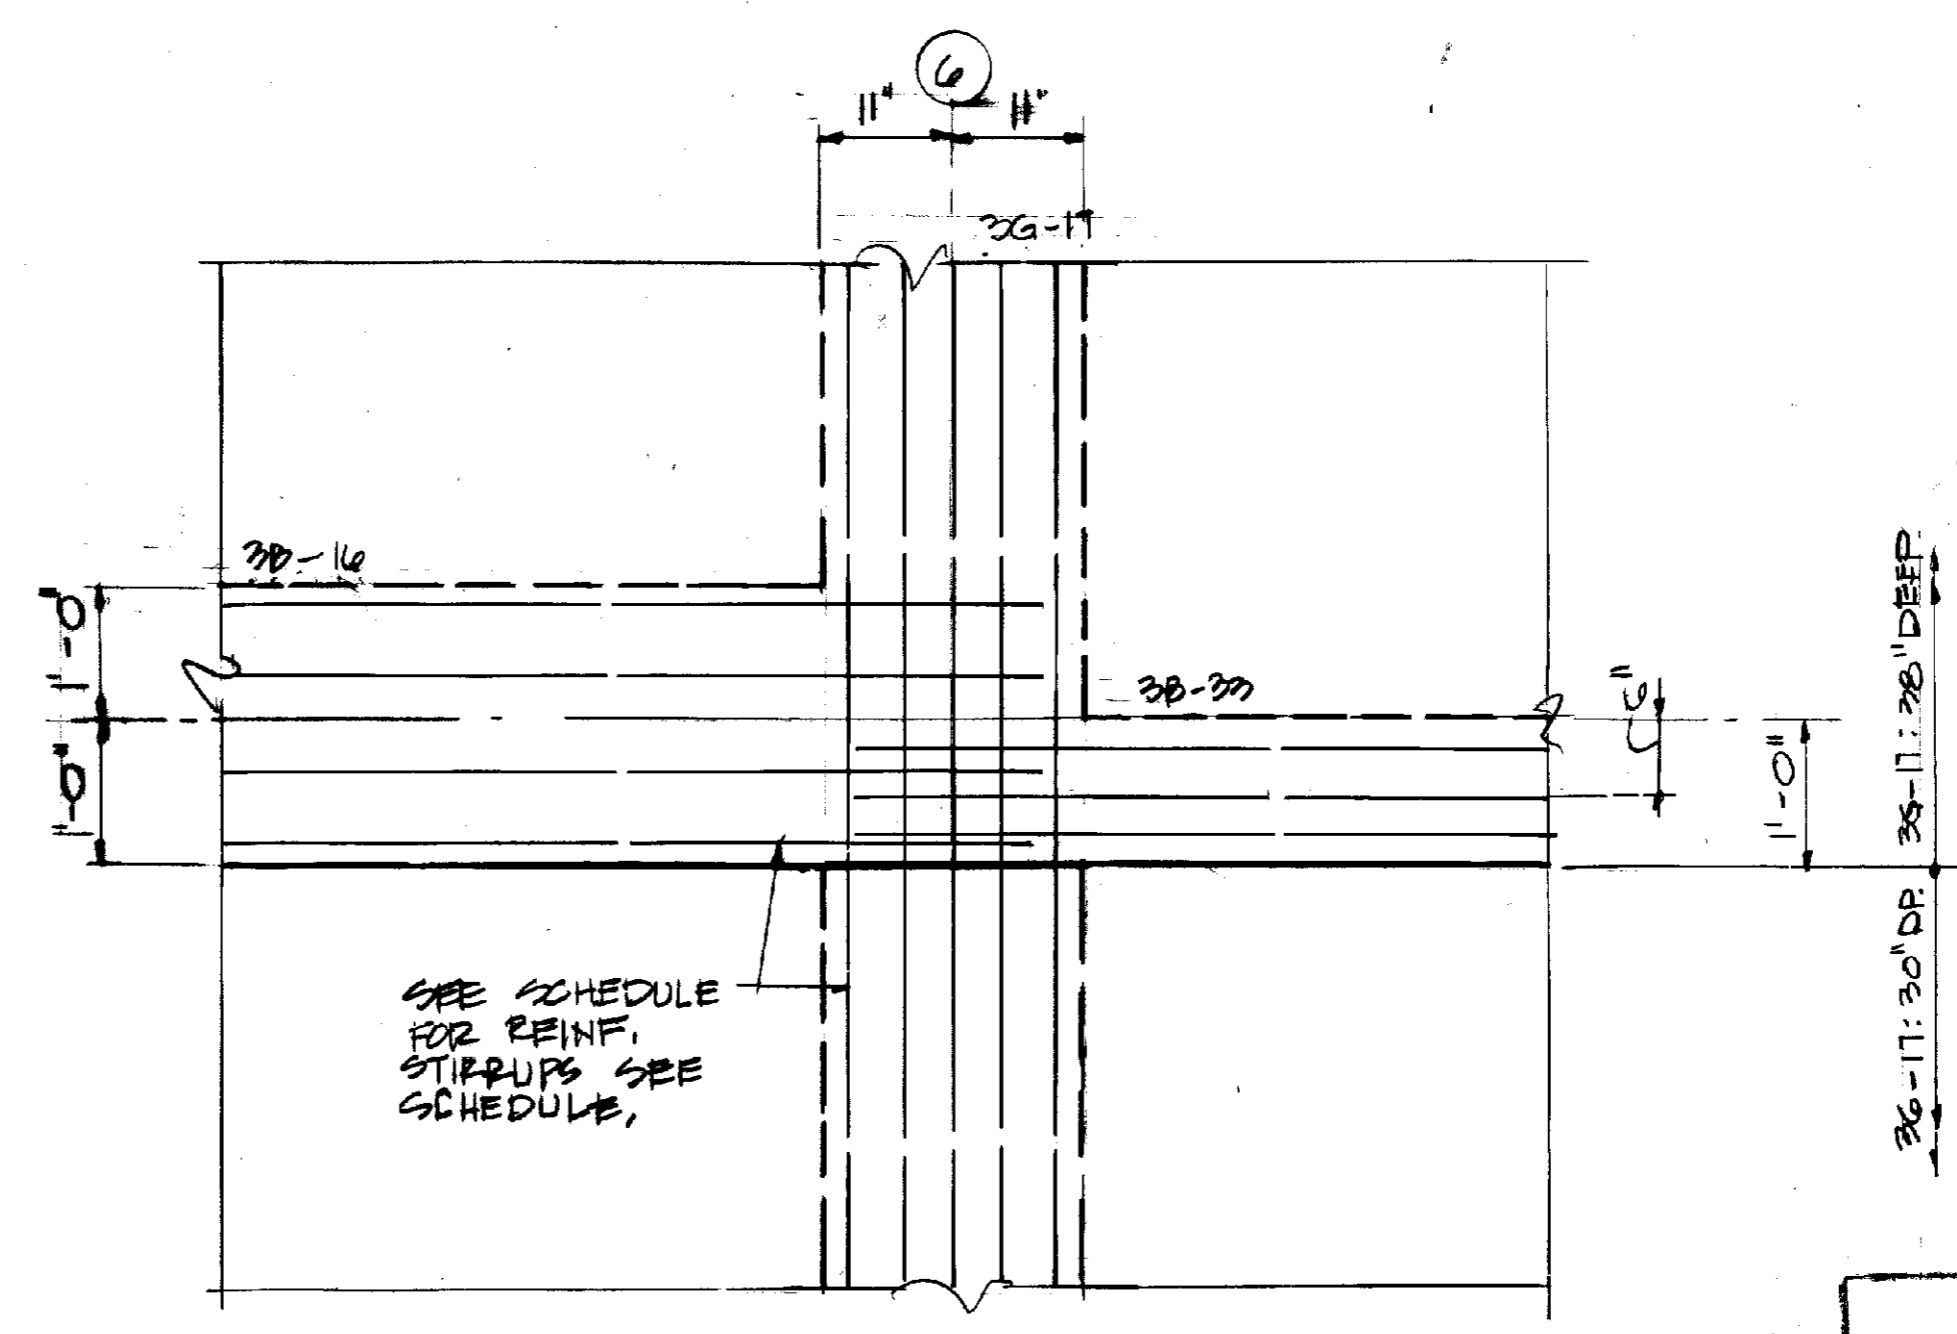

4 DETAIL
S-21 SCALE: 3/4" = 1'-0"

RECORD PRINTS

THESE ARE RECORD PRINTS OF DRAWINGS BASED UPON MARKED UP PRINTS, DRAWINGS AND OTHER DATA FURNISHED BY THE CONTRACTOR TO THE ENGINEER AND WHICH THE ENGINEER CONSIDERS SIGNIFICANT.



ROBOTICS FACILITY
LEXINGTON CAMPUS
UNIVERSITY OF KENTUCKY
LEXINGTON, KENTUCKY

University of Kentucky
Lexington, Kentucky

Sherman Carter Barnhart
10-19-87

SECTIONS & DETAILS

Sherman Carter Barnhart
PARTNERS IN ARCHITECTURE
SUITE 1800 • 750 WEST MAIN STREET • LEXINGTON, KY 40502 • 606-254-1451


JOB NO 2046
DATE 10-19-87
DRAWN M.A.A.
CHECKED JEB/ALP
FILE NO 431.0

NO.	REVISIONS


SHEET

S-21


MASON & HANGER ENGINEERING INC.
ARCHITECT • ENGINEERS
LEXINGTON, KENTUCKY

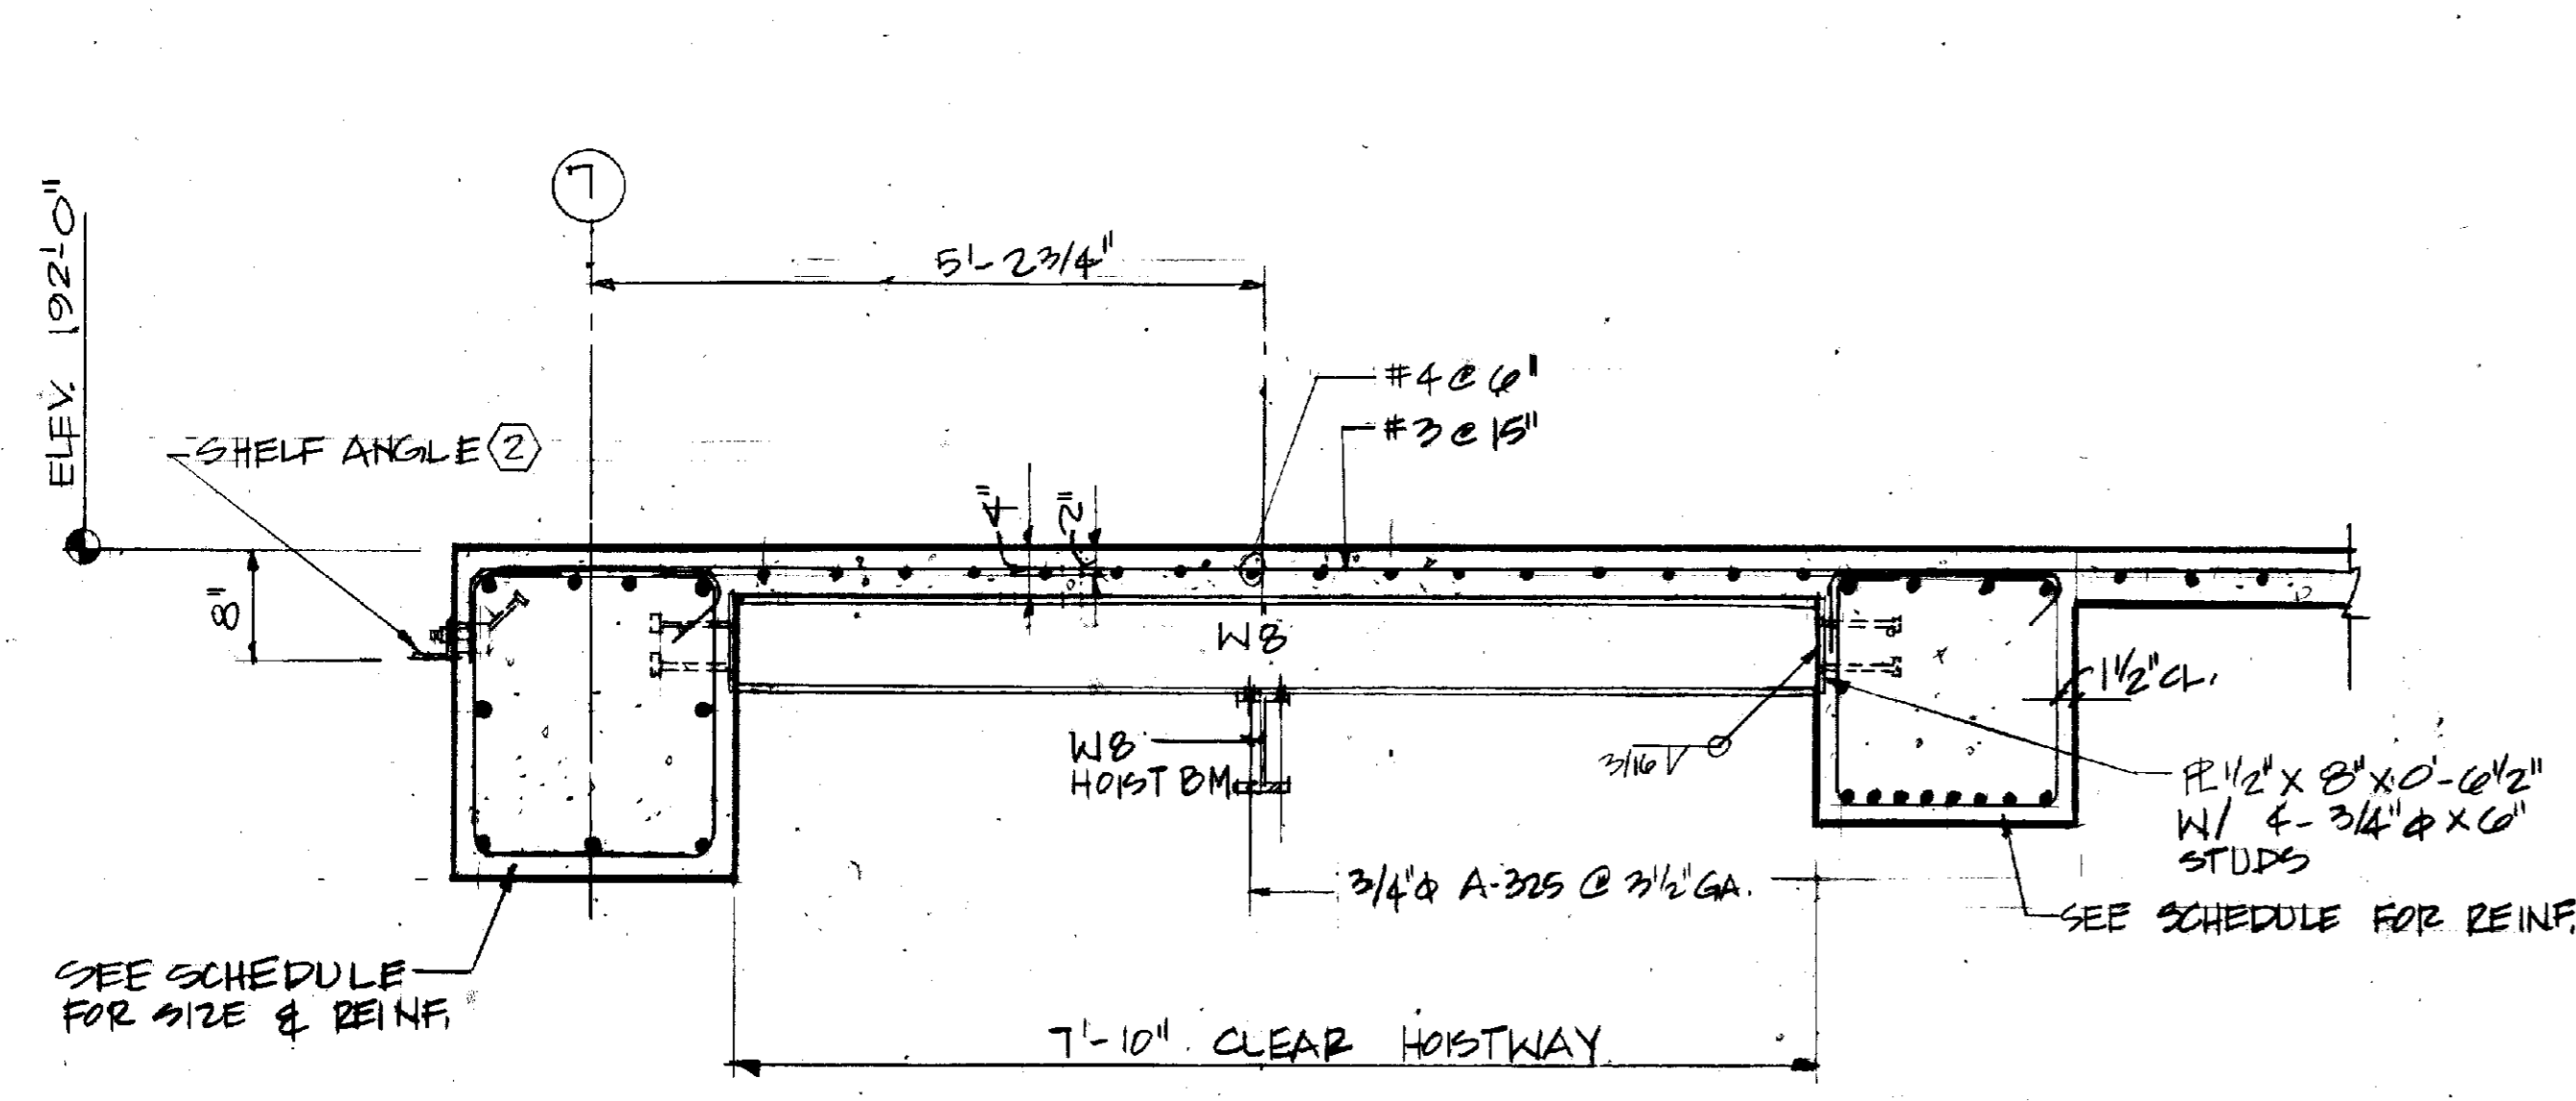


A SECTION
S-22 SCALE: 3/4" = 1'-0"

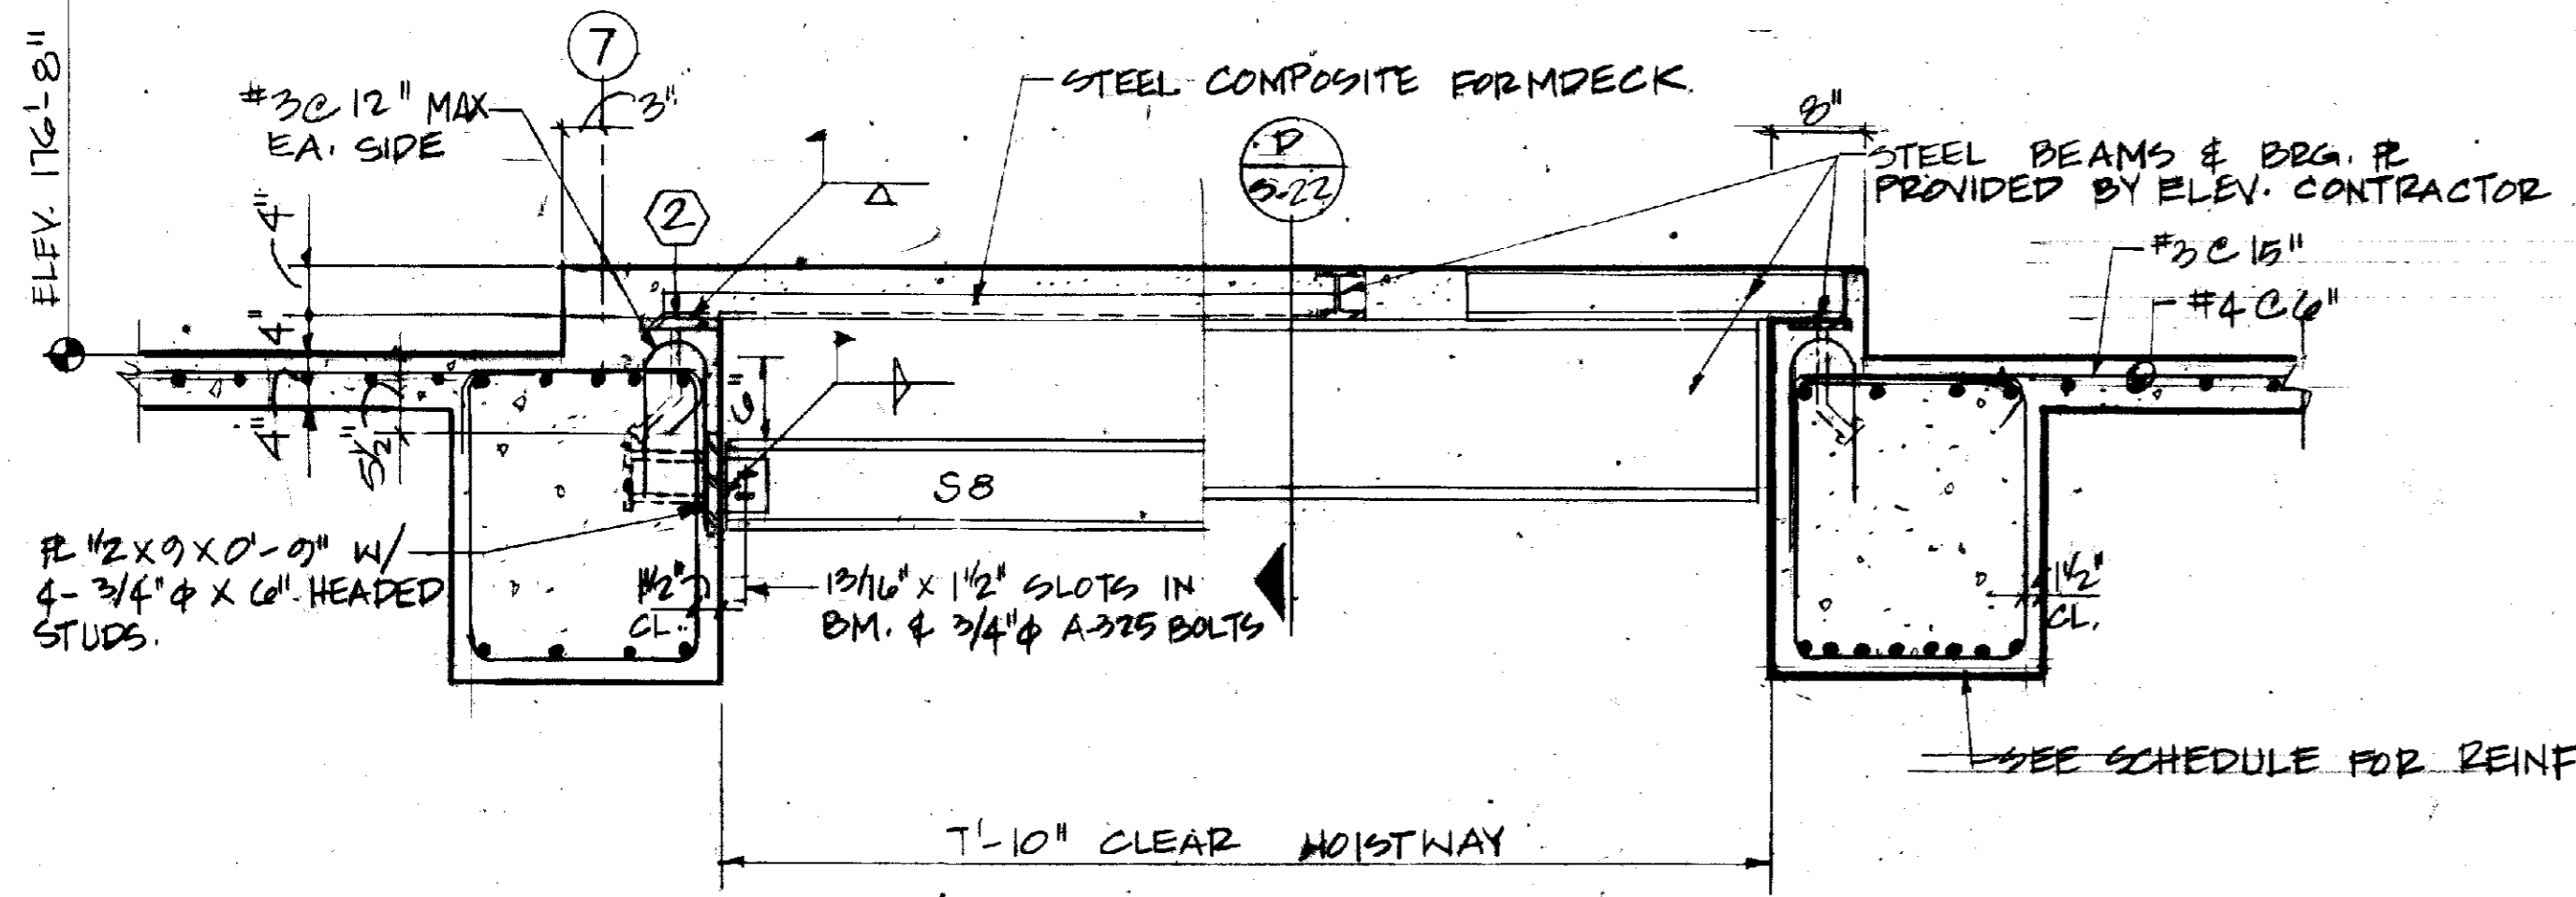


B SECTION
S-22 SCALE: 3/4" = 1'-0"

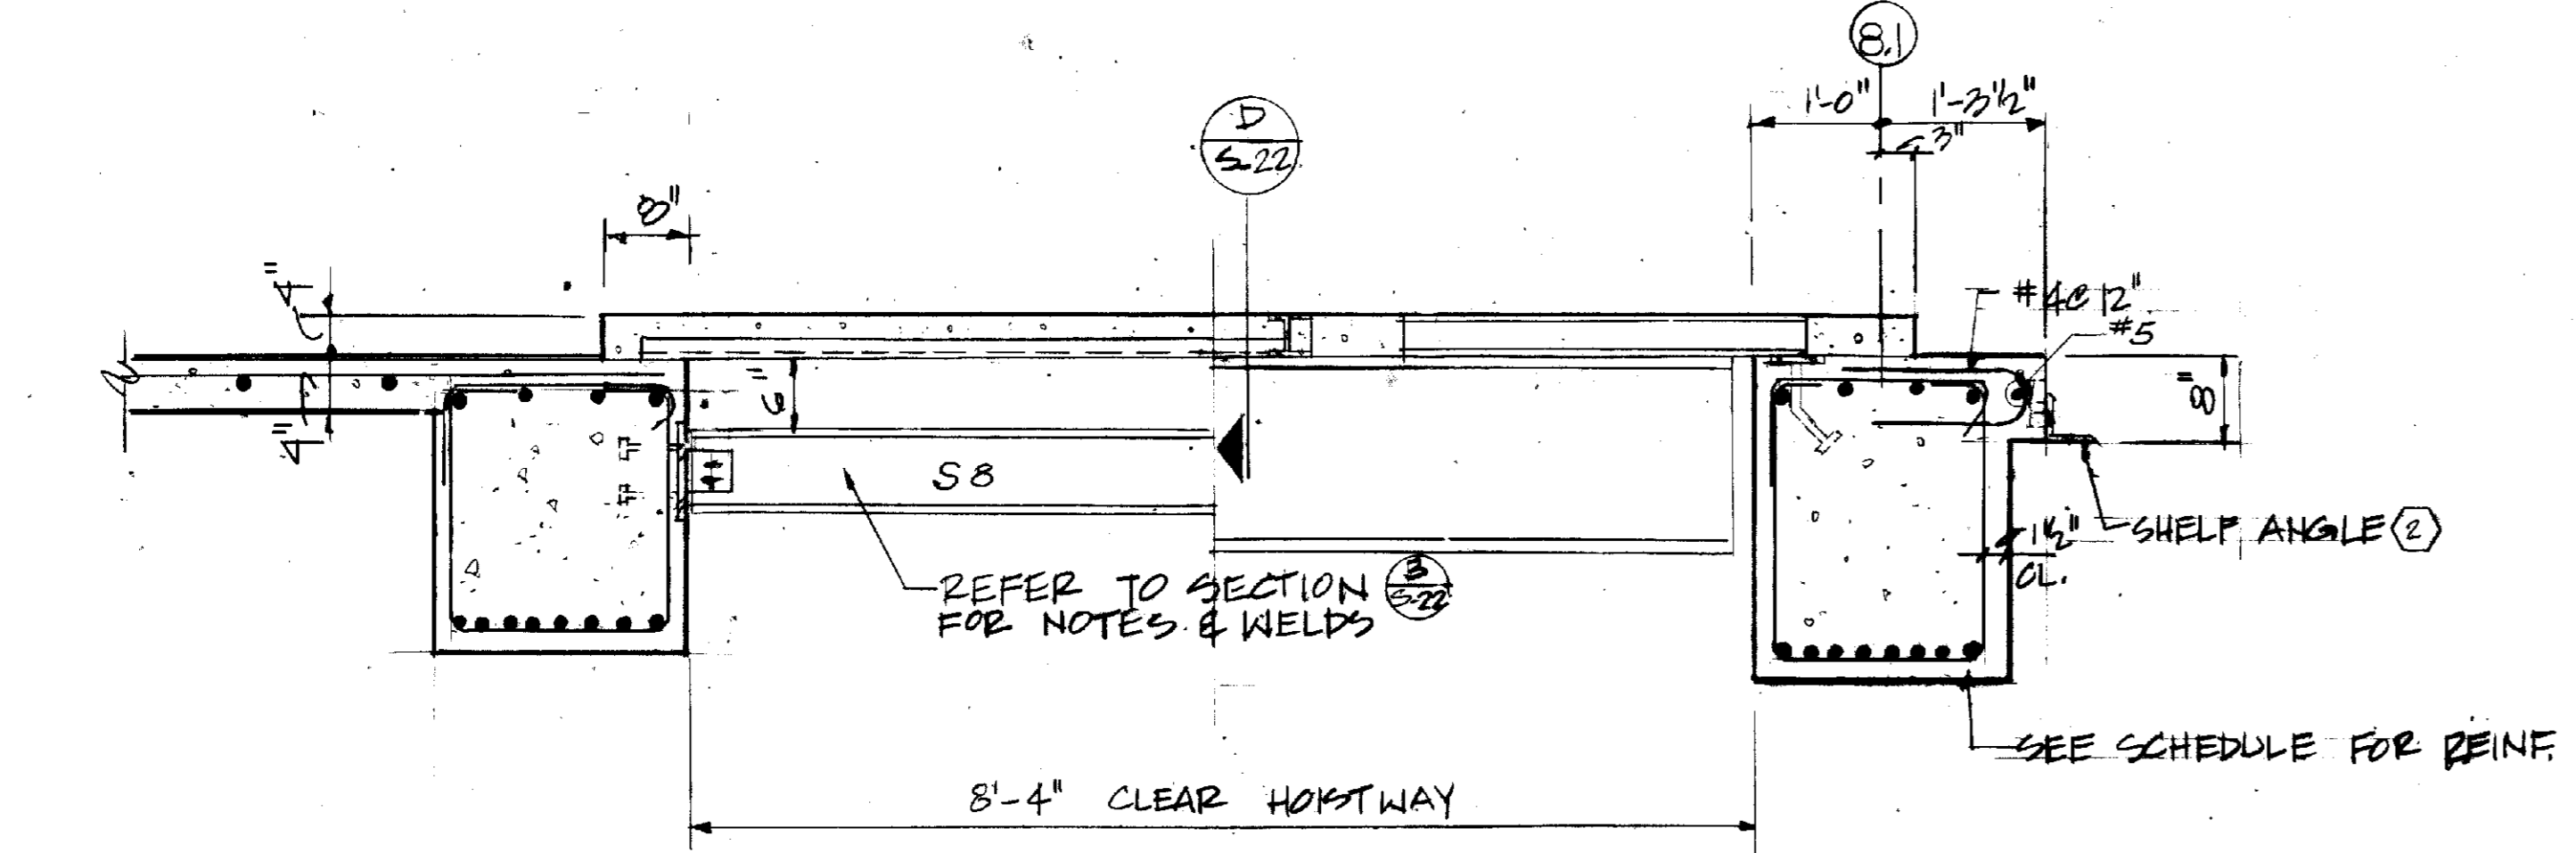


C SECTION
S-22 SCALE: 3/4" = 1'-0"

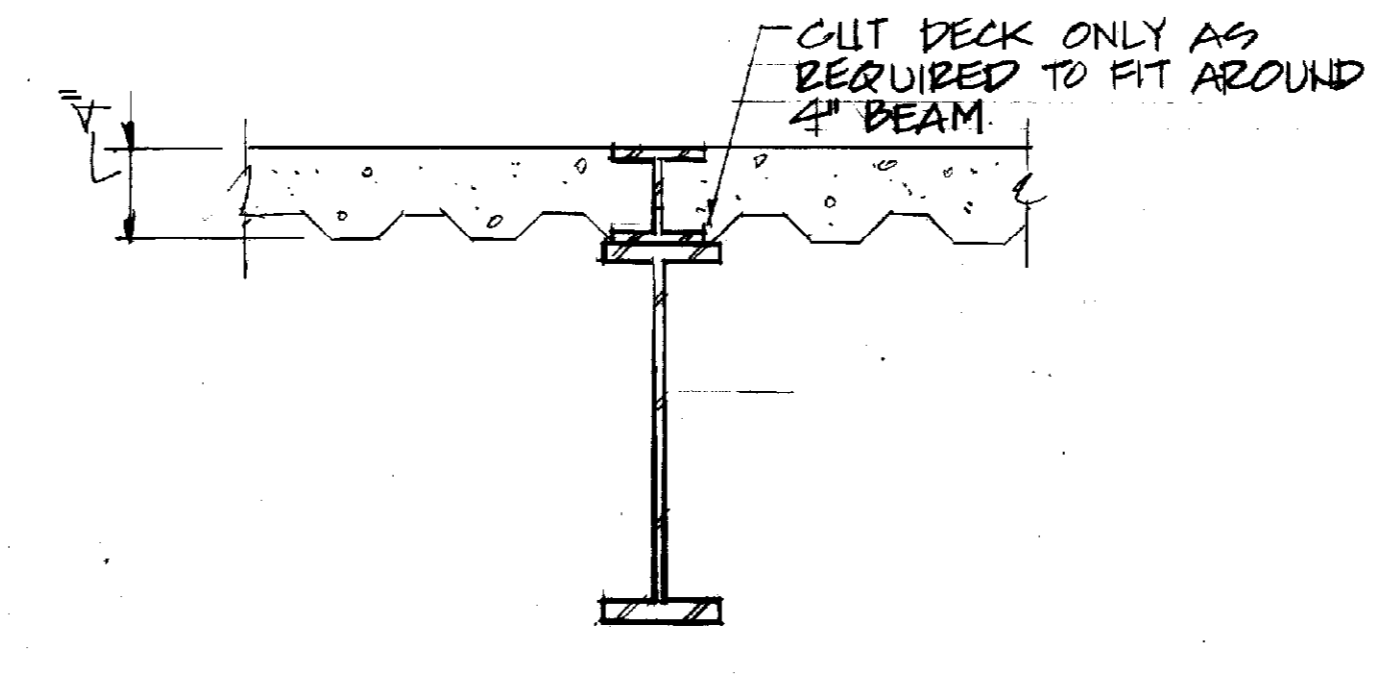

D SECTION
S-22 SCALE: 1 1/2" = 1'-0"

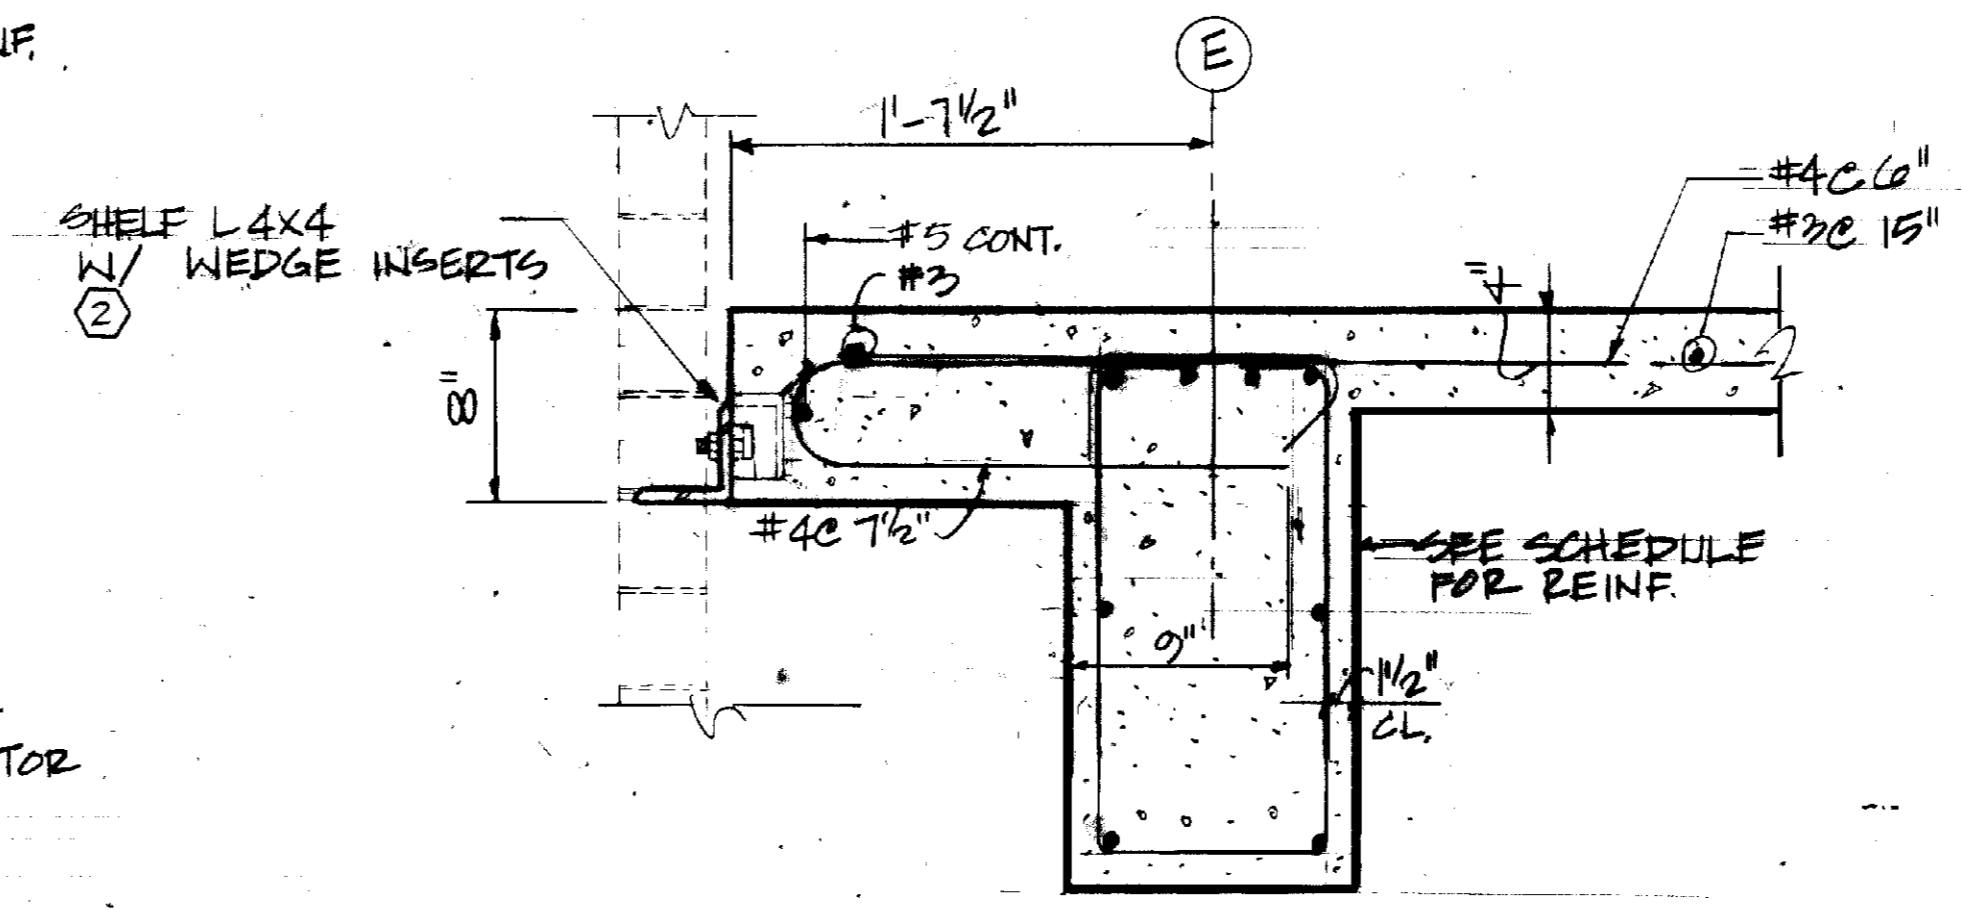

E SECTION
S-22 SCALE: 1 1/2" = 1'-0"

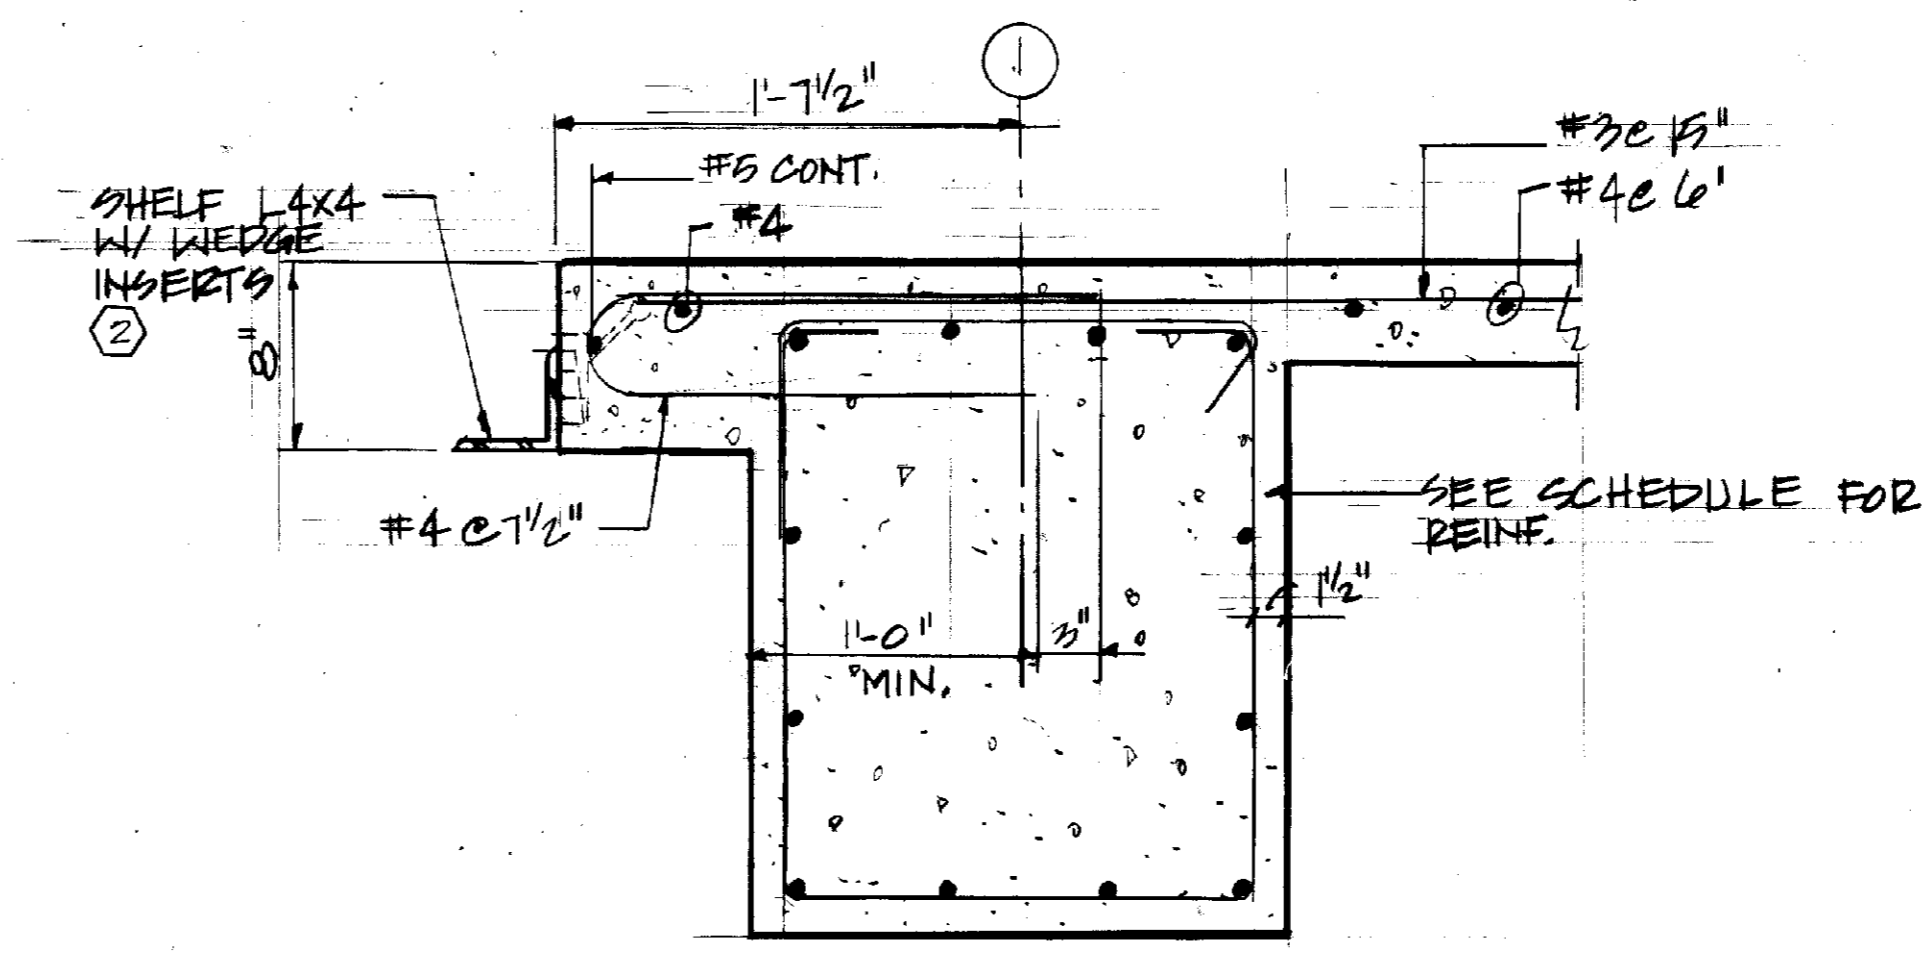

F SECTION
S-22 SCALE: 1 1/2" = 1'-0"

NOTES
 1 SEE SHEET S-1 FOR GENERAL NOTES
 2 WEDGE TYPE CONCRETE INSERTS FOR ATTACHMENT OF SHELF ANGLES SHALL BE DAYTON SURE GRIP NO. F-8 OR APPROVED EQUAL.



ROBOTICS FACILITY
LEXINGTON CAMPUS
UNIVERSITY OF KENTUCKY
LEXINGTON, KENTUCKY

University of Kentucky
Lexington, Kentucky


SECTIONS & DETAILS
Sherman Carter Barnhart
 PARTNERS IN ARCHITECTURE
 500 WEST MAIN STREET, LEXINGTON, KY 40502-2643

JOB NO. 2046
 DATE 10-19-07
 DRAWN M.A.A.
 CHECKED A.L.P.
 FILE NO. 431.0


REVISIONS

RECORD PRINTS
 THESE ARE RECORD PRINTS OF DRAWINGS BASED UPON MARKED UP PRINTS, DRAWINGS AND OTHER DATA FURNISHED BY THE CONTRACTOR TO THE ENGINEER AND WHICH THE ENGINEER CONSIDERS CORRECT.


SHEET
S-22

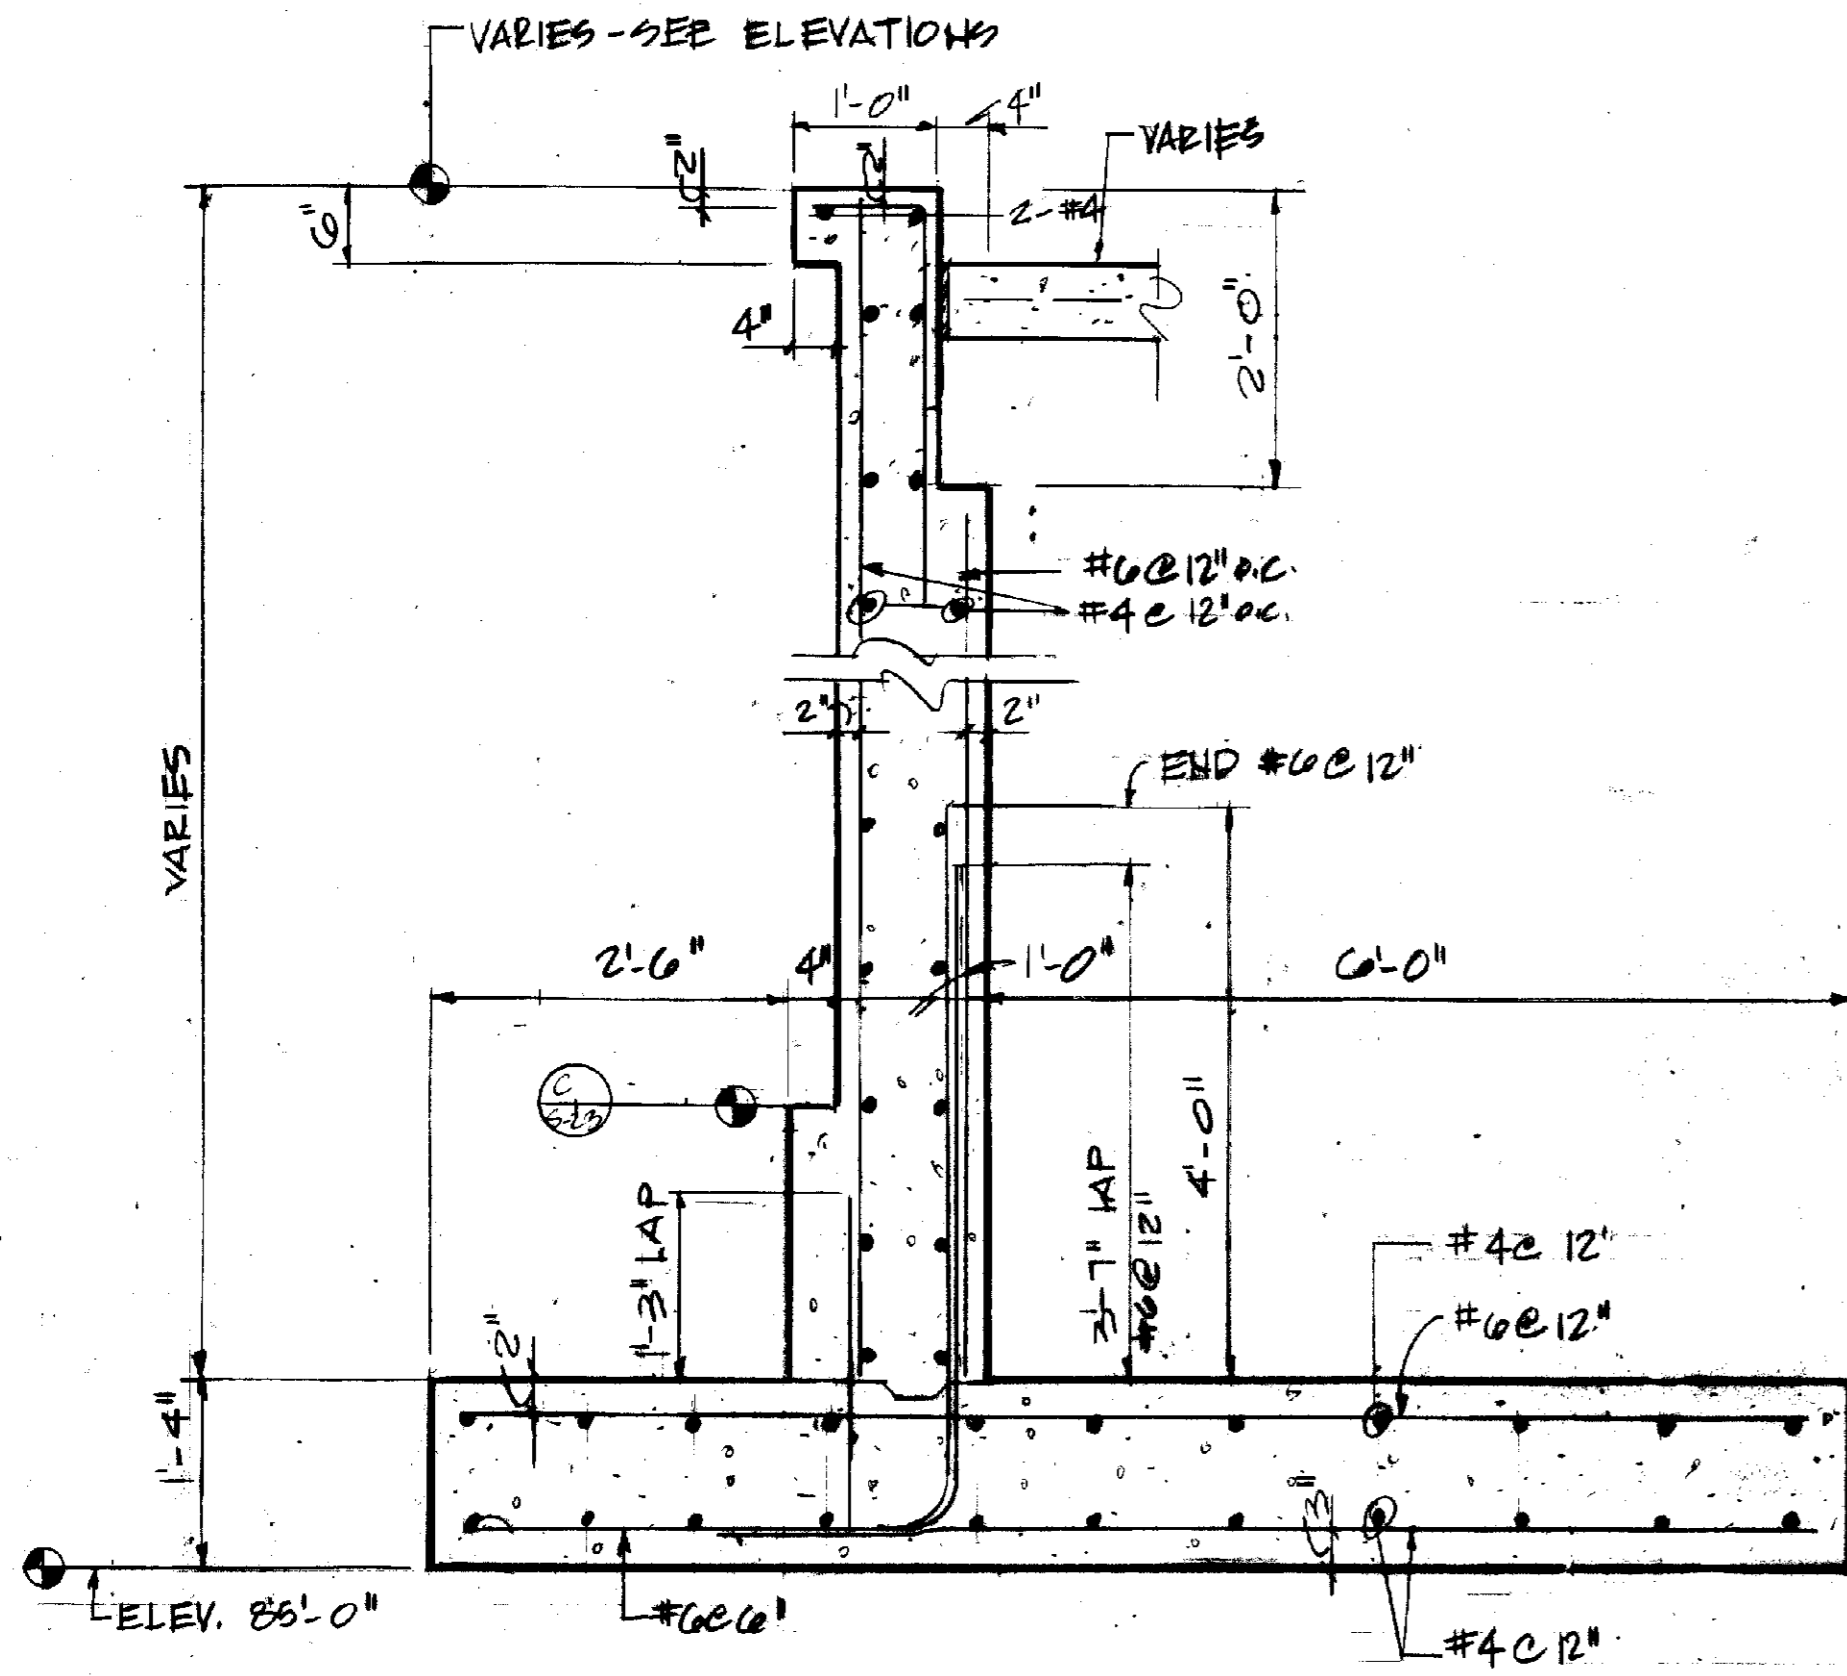


A SECTION
S-23 SCALE: 3/4" = 1'-0"

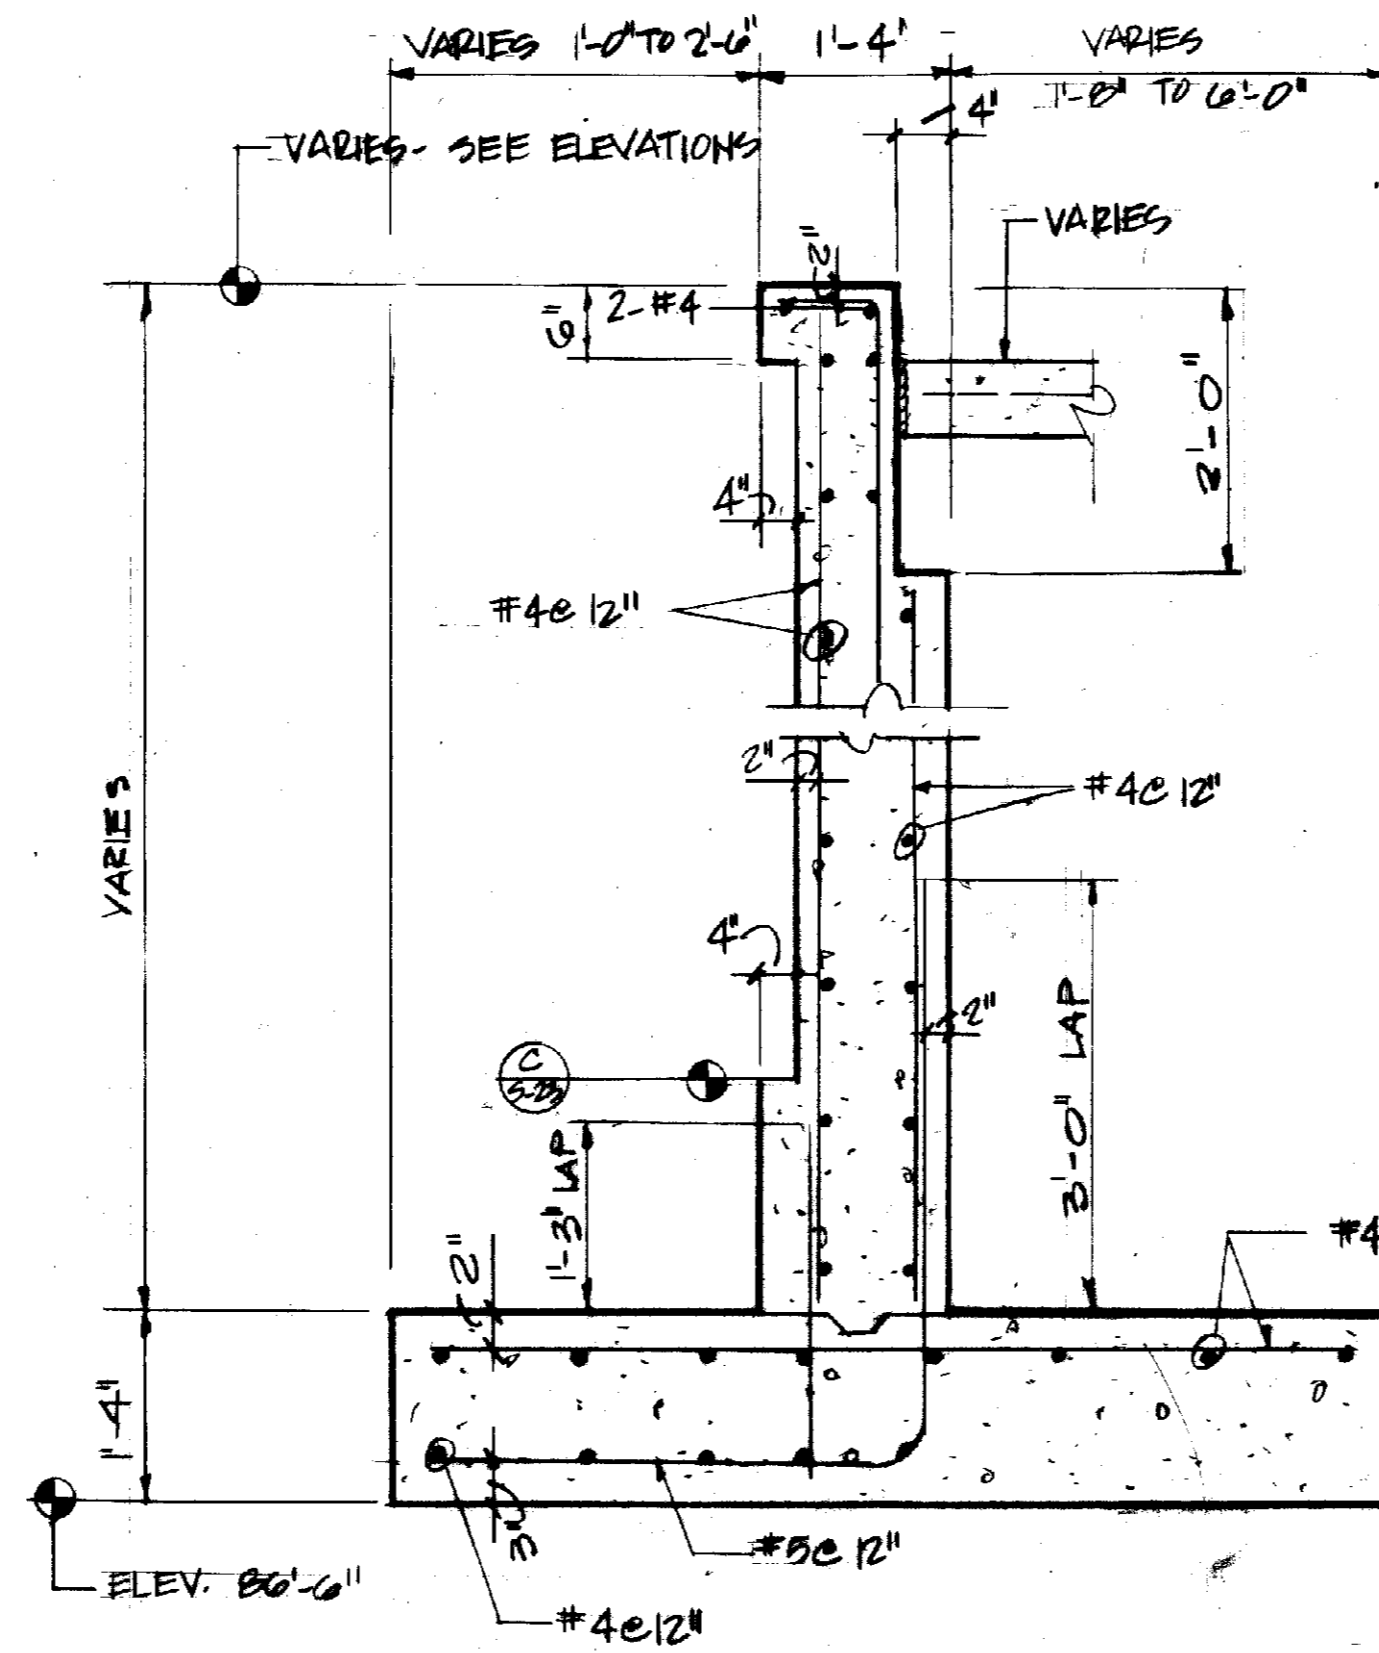

B SECTION
S-23 SCALE: 3/4" = 1'-0"

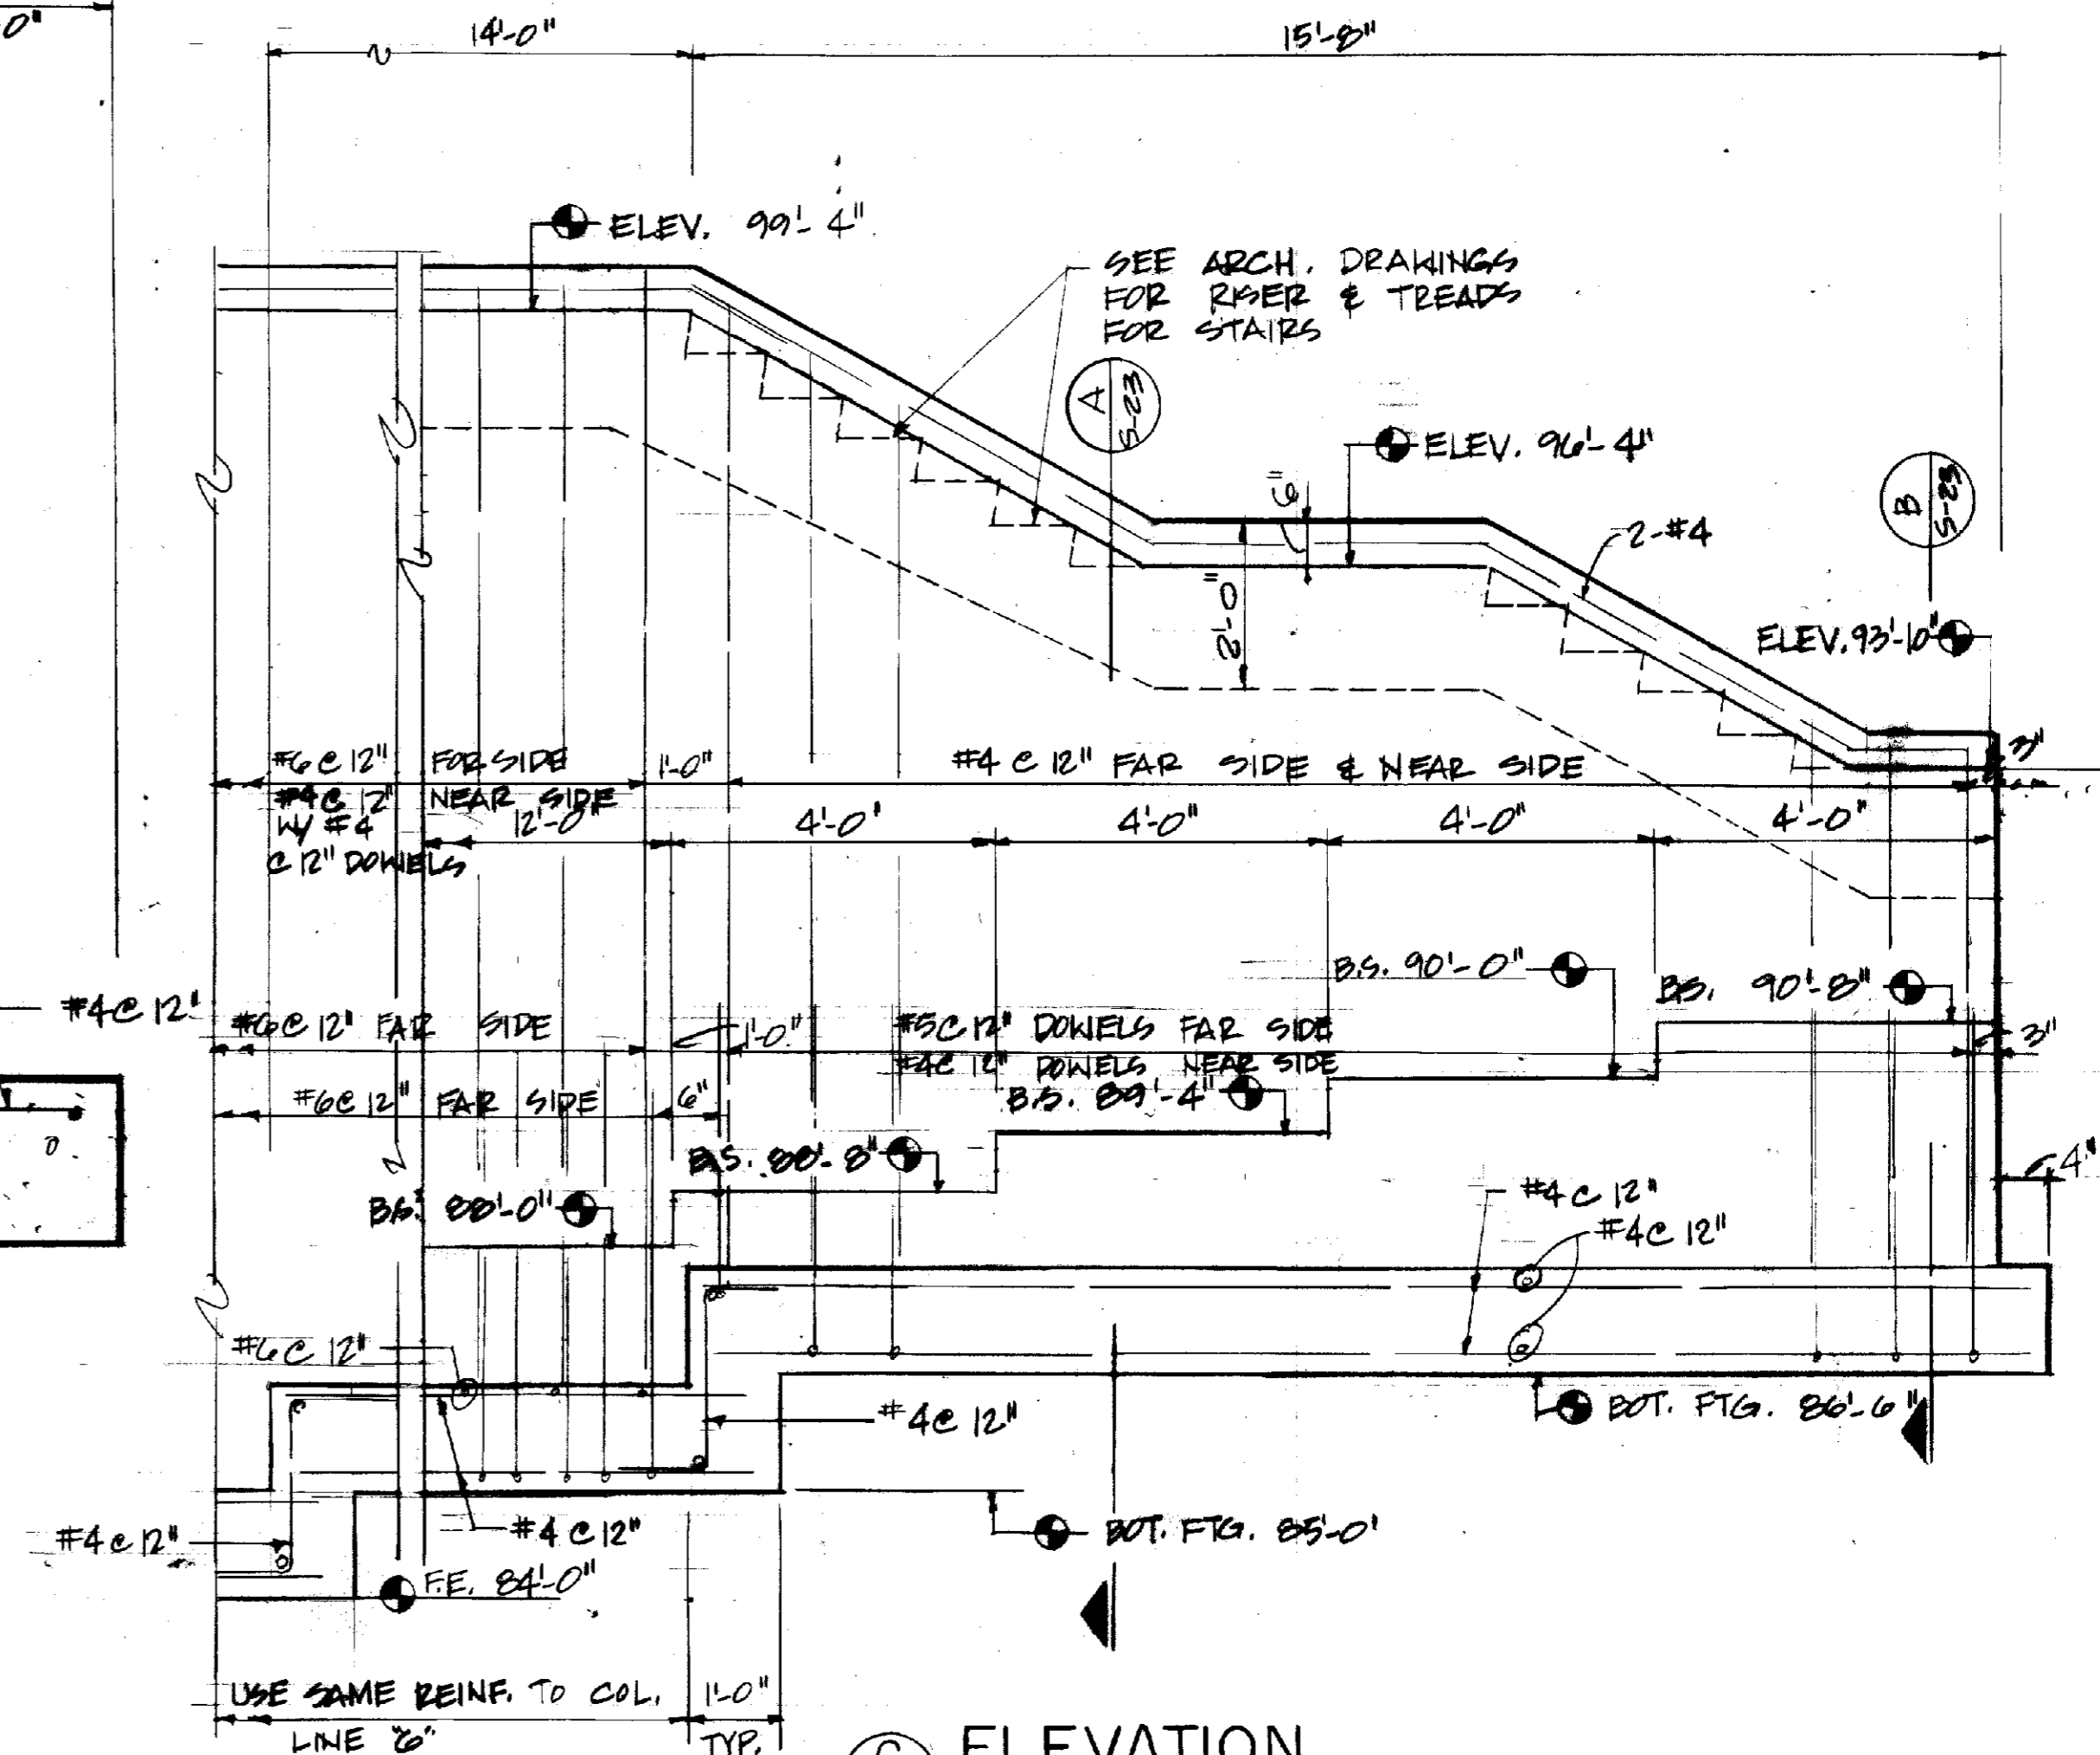

C ELEVATION
S-23 SCALE: 1/2" = 1'-0"

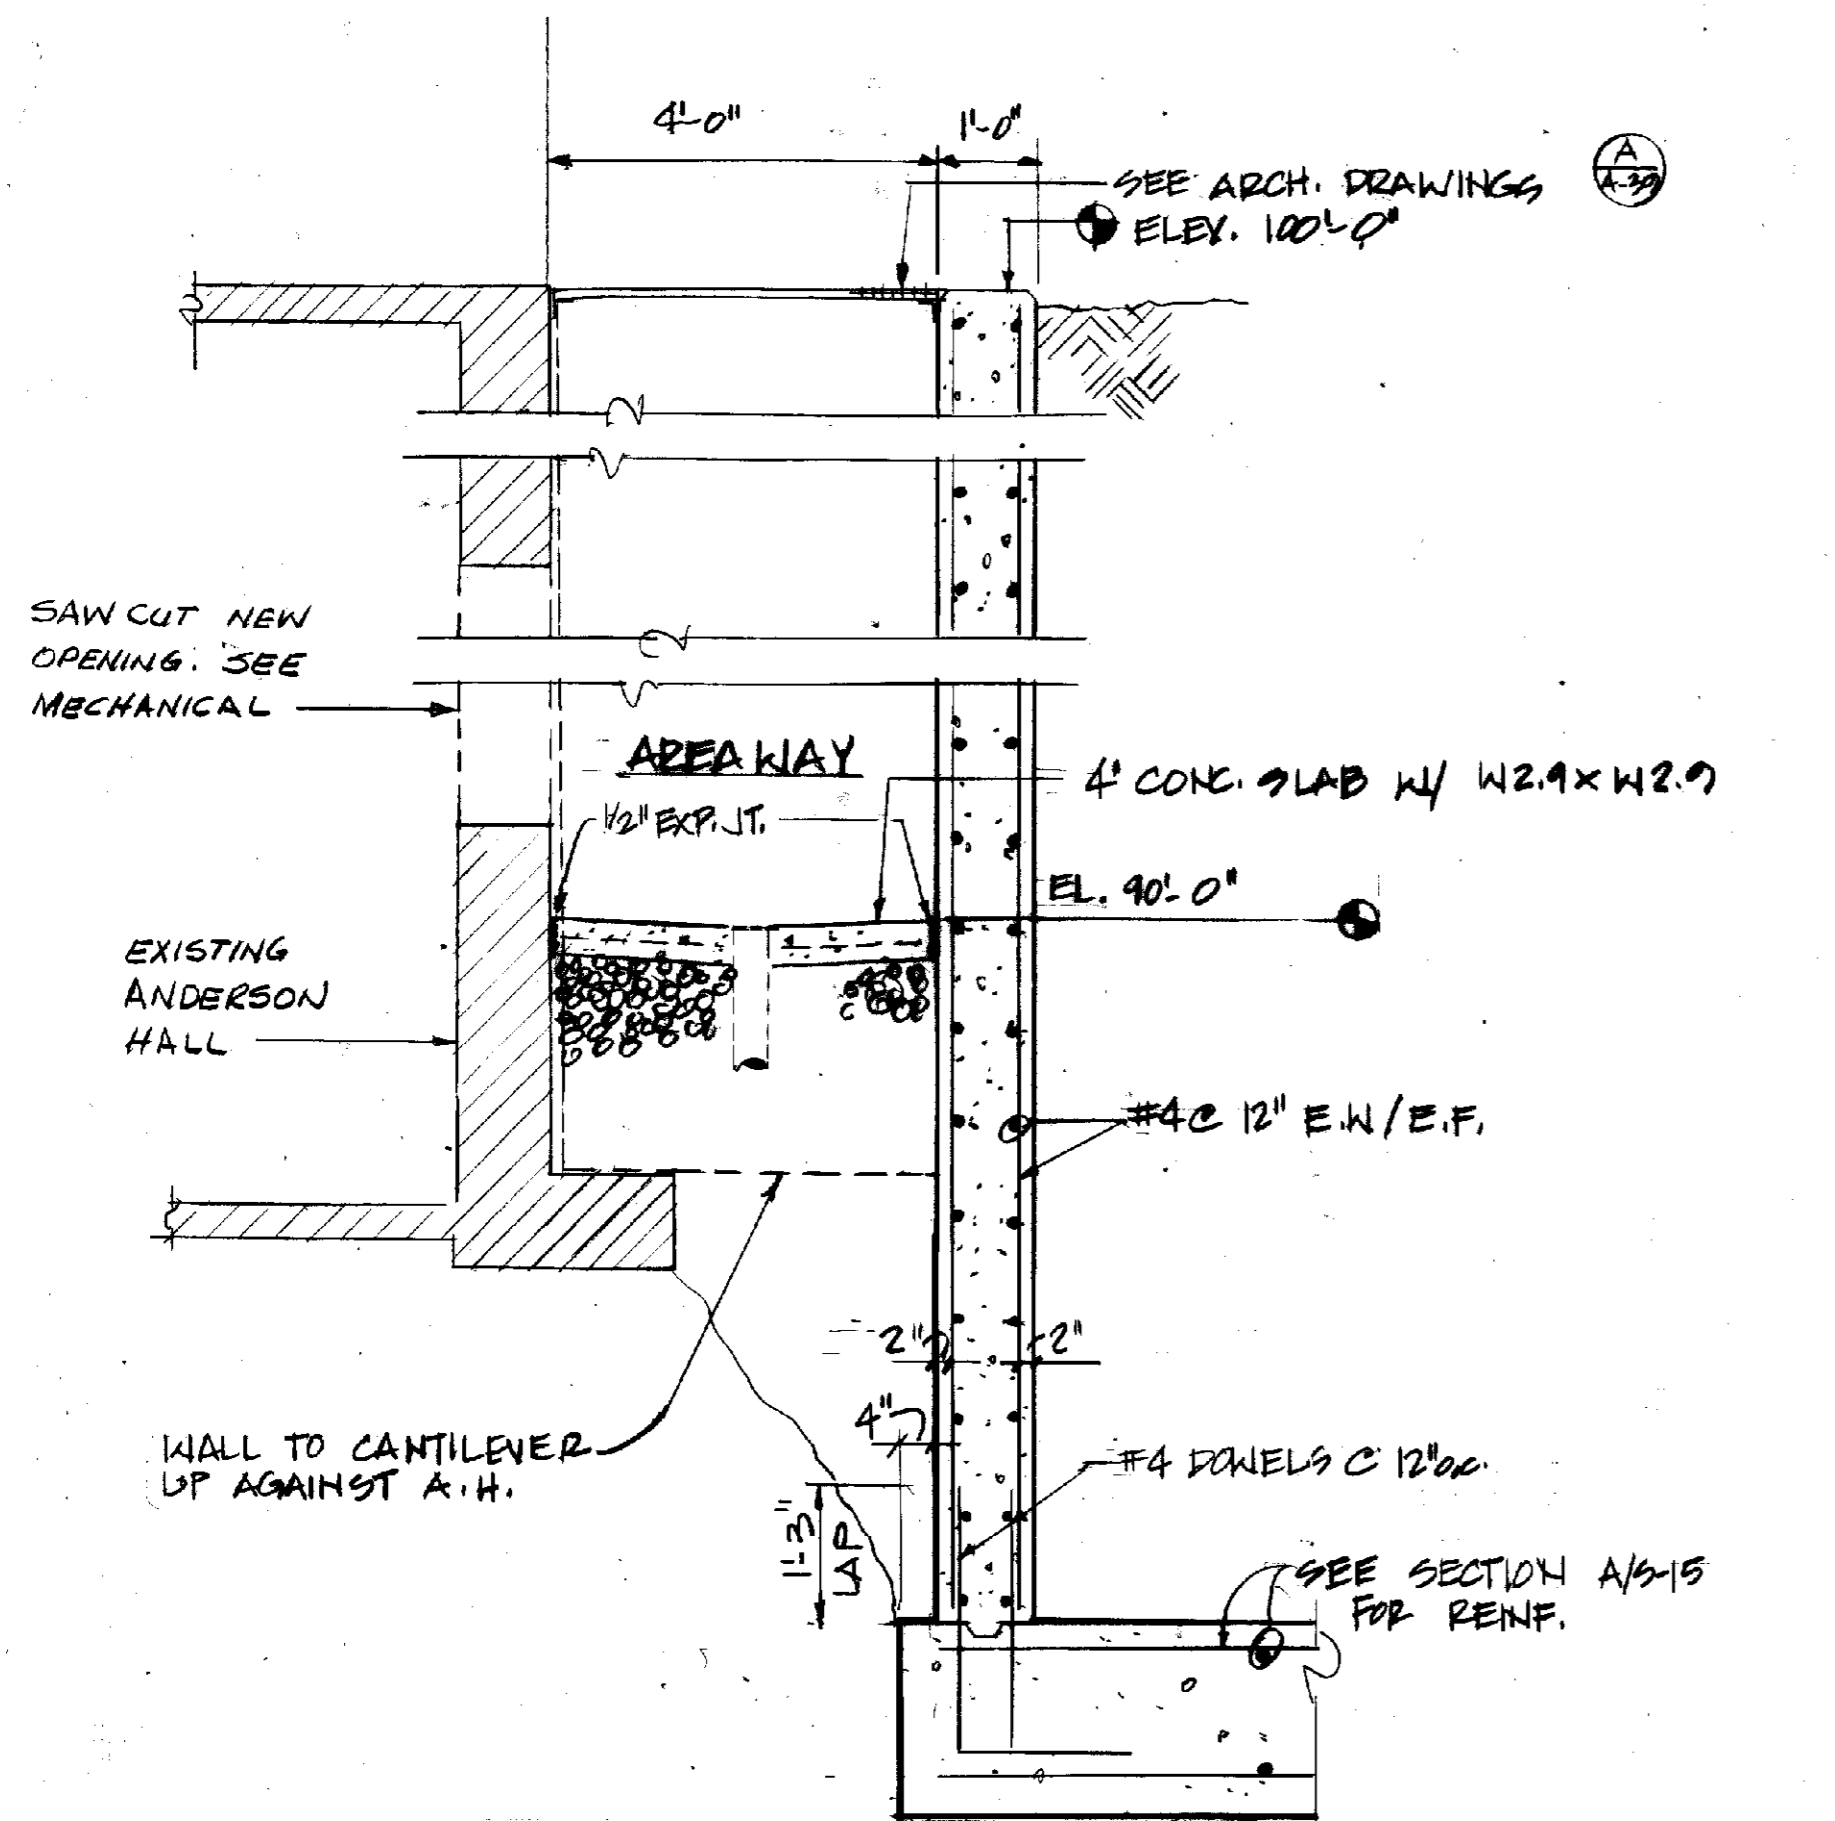

D SECTION
S-23 SCALE: 1/2" = 1'-0"



ROBOTICS FACILITY
LEXINGTON CAMPUS
UNIVERSITY OF KENTUCKY
LEXINGTON, KENTUCKY

University of Kentucky
Lexington, Kentucky

SECTIONS & DETAILS
Sherman Carter - Barnhart
PARTNERS IN ARCHITECTURE
SHEL 1500 • 750 WEST MAIN STREET • LEXINGTON, KY 40501 • 502.254.1351

ICB NO	2046
DATE	10-19-87
DRAWN	MAA
CHECKED	PFH
FILE NO.	421.0

REVISIONS

RECORD PRINTS
THESE ARE RECORD PRINTS OF DRAWINGS BASED UPON MARKED UP PRINTS, DRAWINGS AND OTHER DATA FURNISHED BY THE CONTRACTOR TO THE ENGINEER AND *W/M* THE ENGINEER'S CONSENT SIGNIFICANT

MASON & HANGER ENGINEERING INC.
ARCHITECT • ENGINEERS
LEXINGTON, KENTUCKY

SHEET
S-23



ROBOTICS FACILITY
LEXINGTON CAMPUS
UNIVERSITY OF KENTUCKY
LEXINGTON, KENTUCKY

University of Kentucky
Lexington, Kentucky

10-19-87

BASEMENT FLOOR PLAN


Sherman Carter Barnhart
PARTNERS IN ARCHITECTURE
SUITE 1900 • 250 WEST MAIN STREET • LEXINGTON, KY 40507 • 606-254-9351

JOB NO. 8708
DATE
DRAWN
CHECKED
FILE NO. 431.0

REVISIONS
A- AS SHOWN 2/18/91

SHEET

A-1

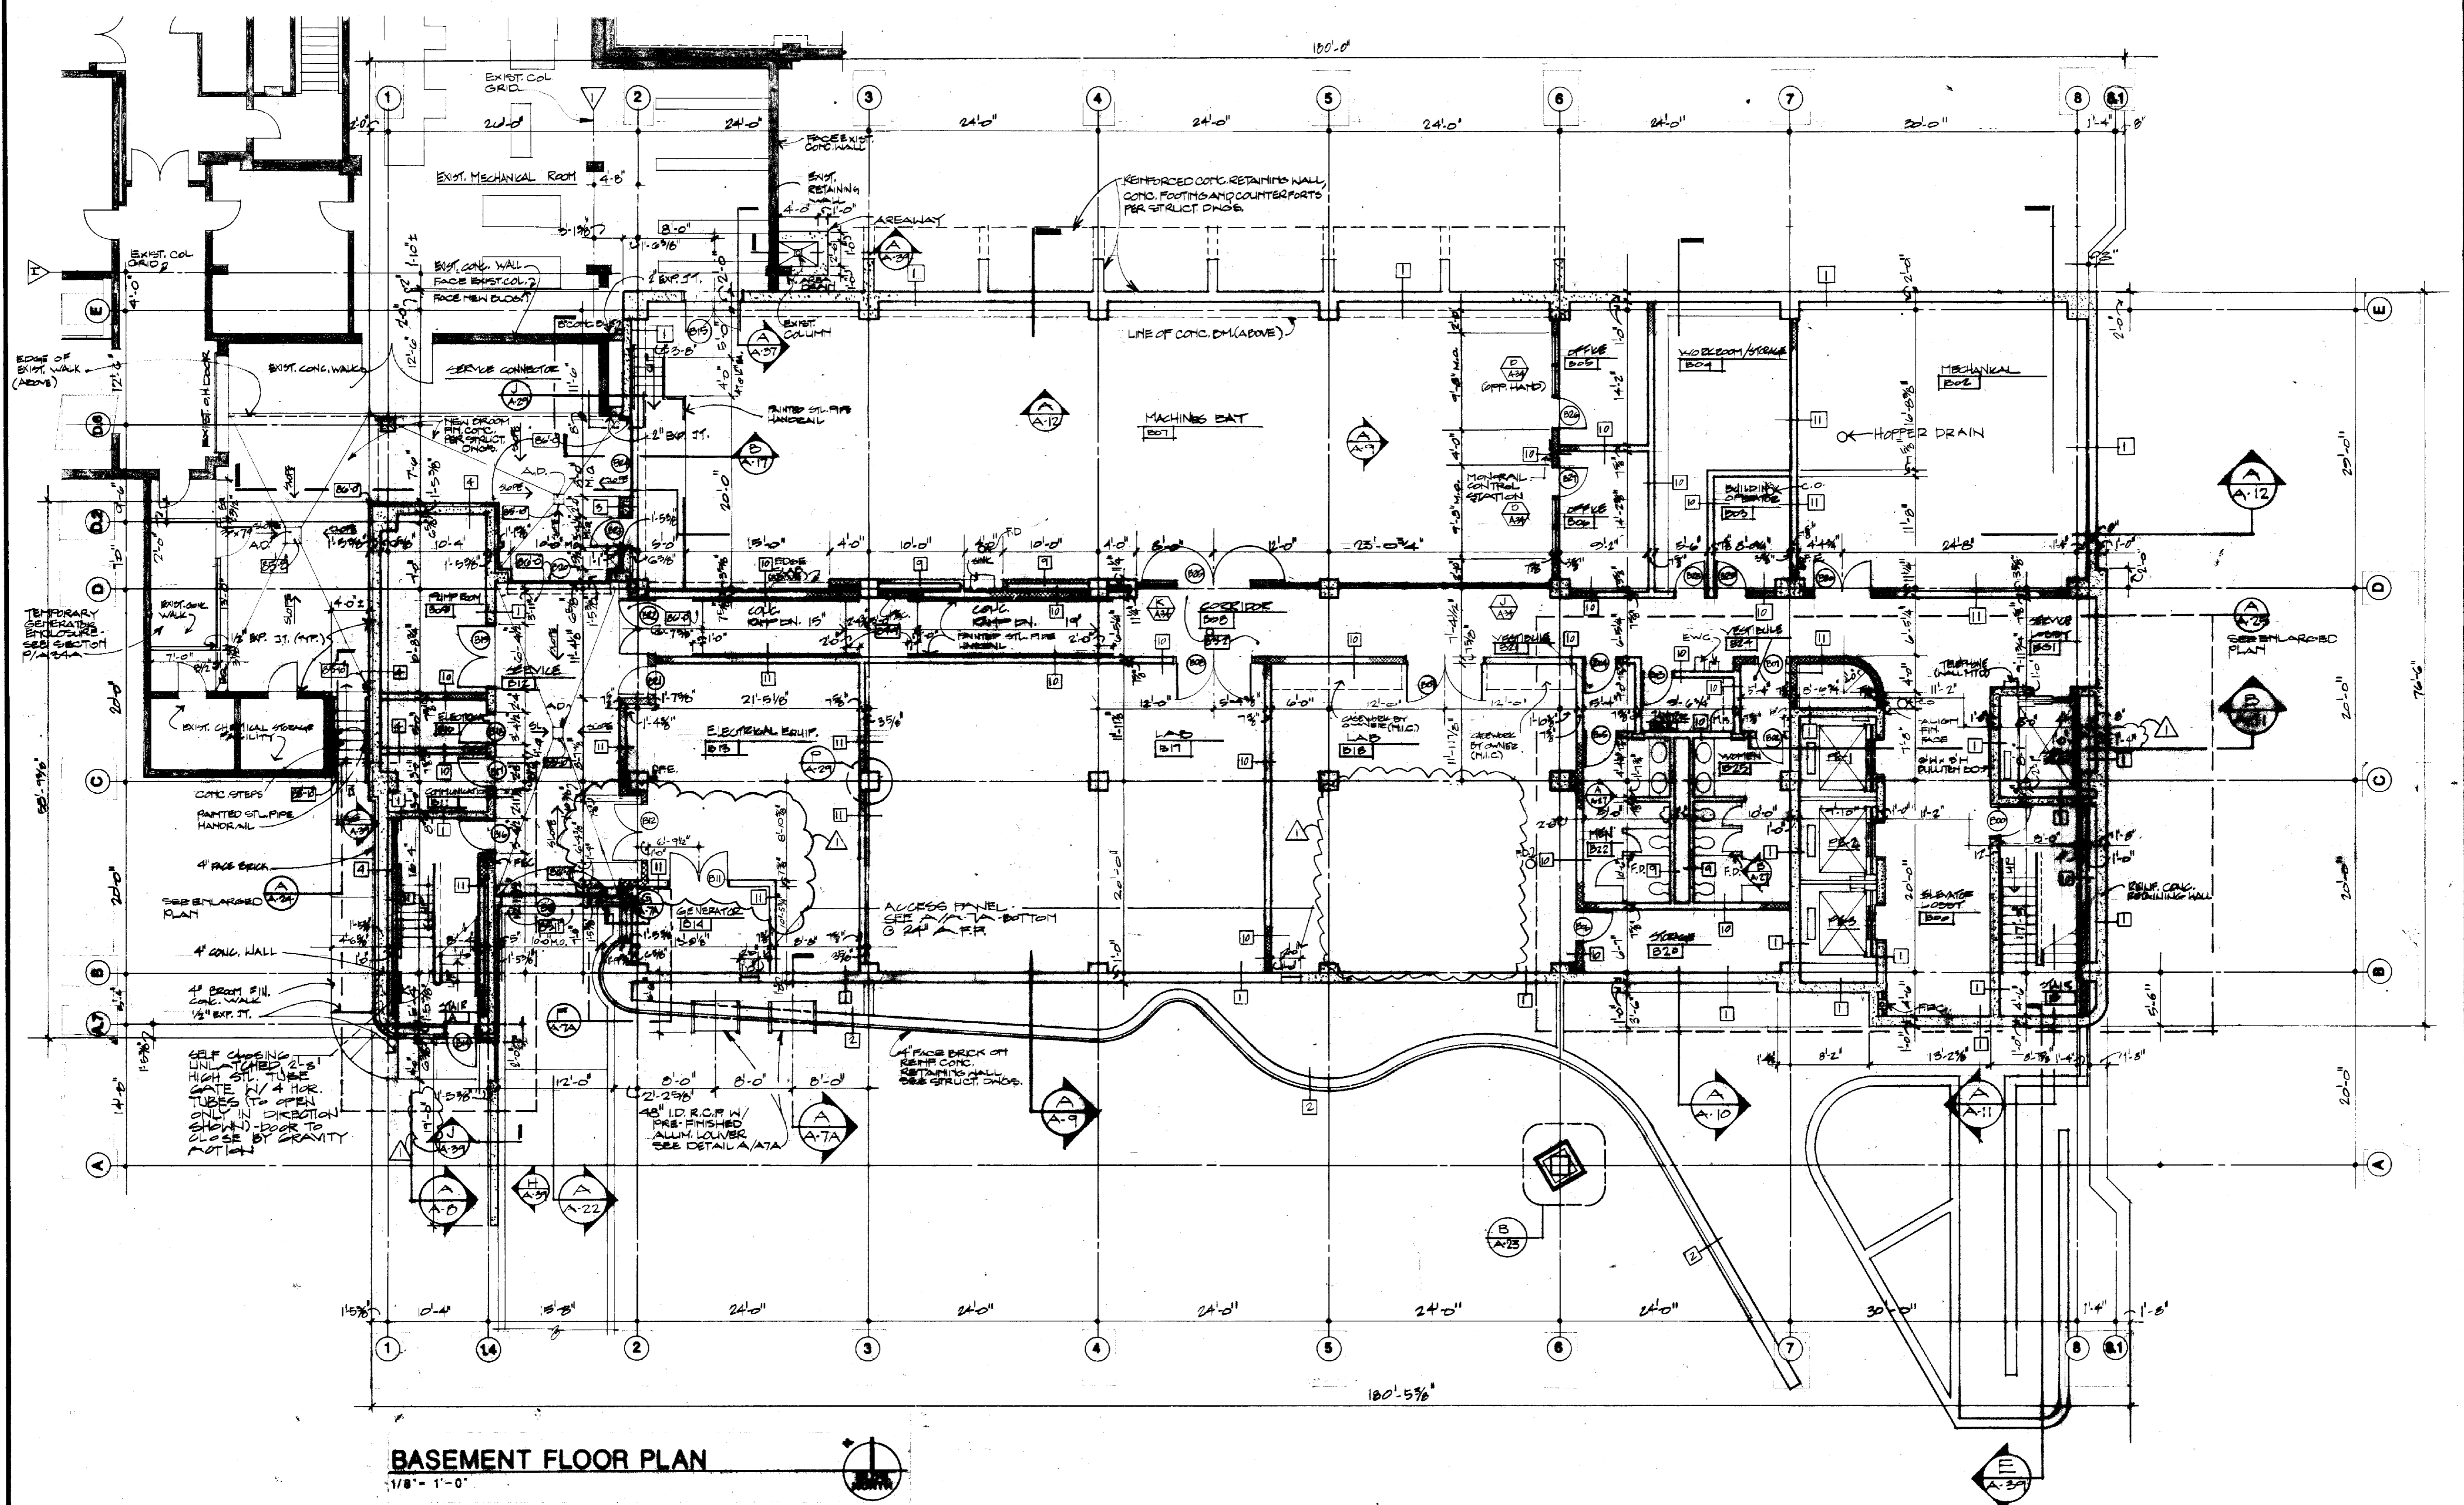


BASEMENT FLOOR PLAN

1/8" = 1'-0"

LEGEND


- (1) DOOR/FRAME NUMBER. REFER TO SCHED., SHT. A-33.
- (2) ROOM NUMBER. REFER TO FINISH SCHED., SHTS. A-31, A-32.
- (3) CURTAINWALL TYPE. REFER TO BLDG. ELEVATIONS & SHTS. A-35, A-36.
- (4) WALL/PARTITION TYPE. REFER TO SCHED., SHT. A-33.

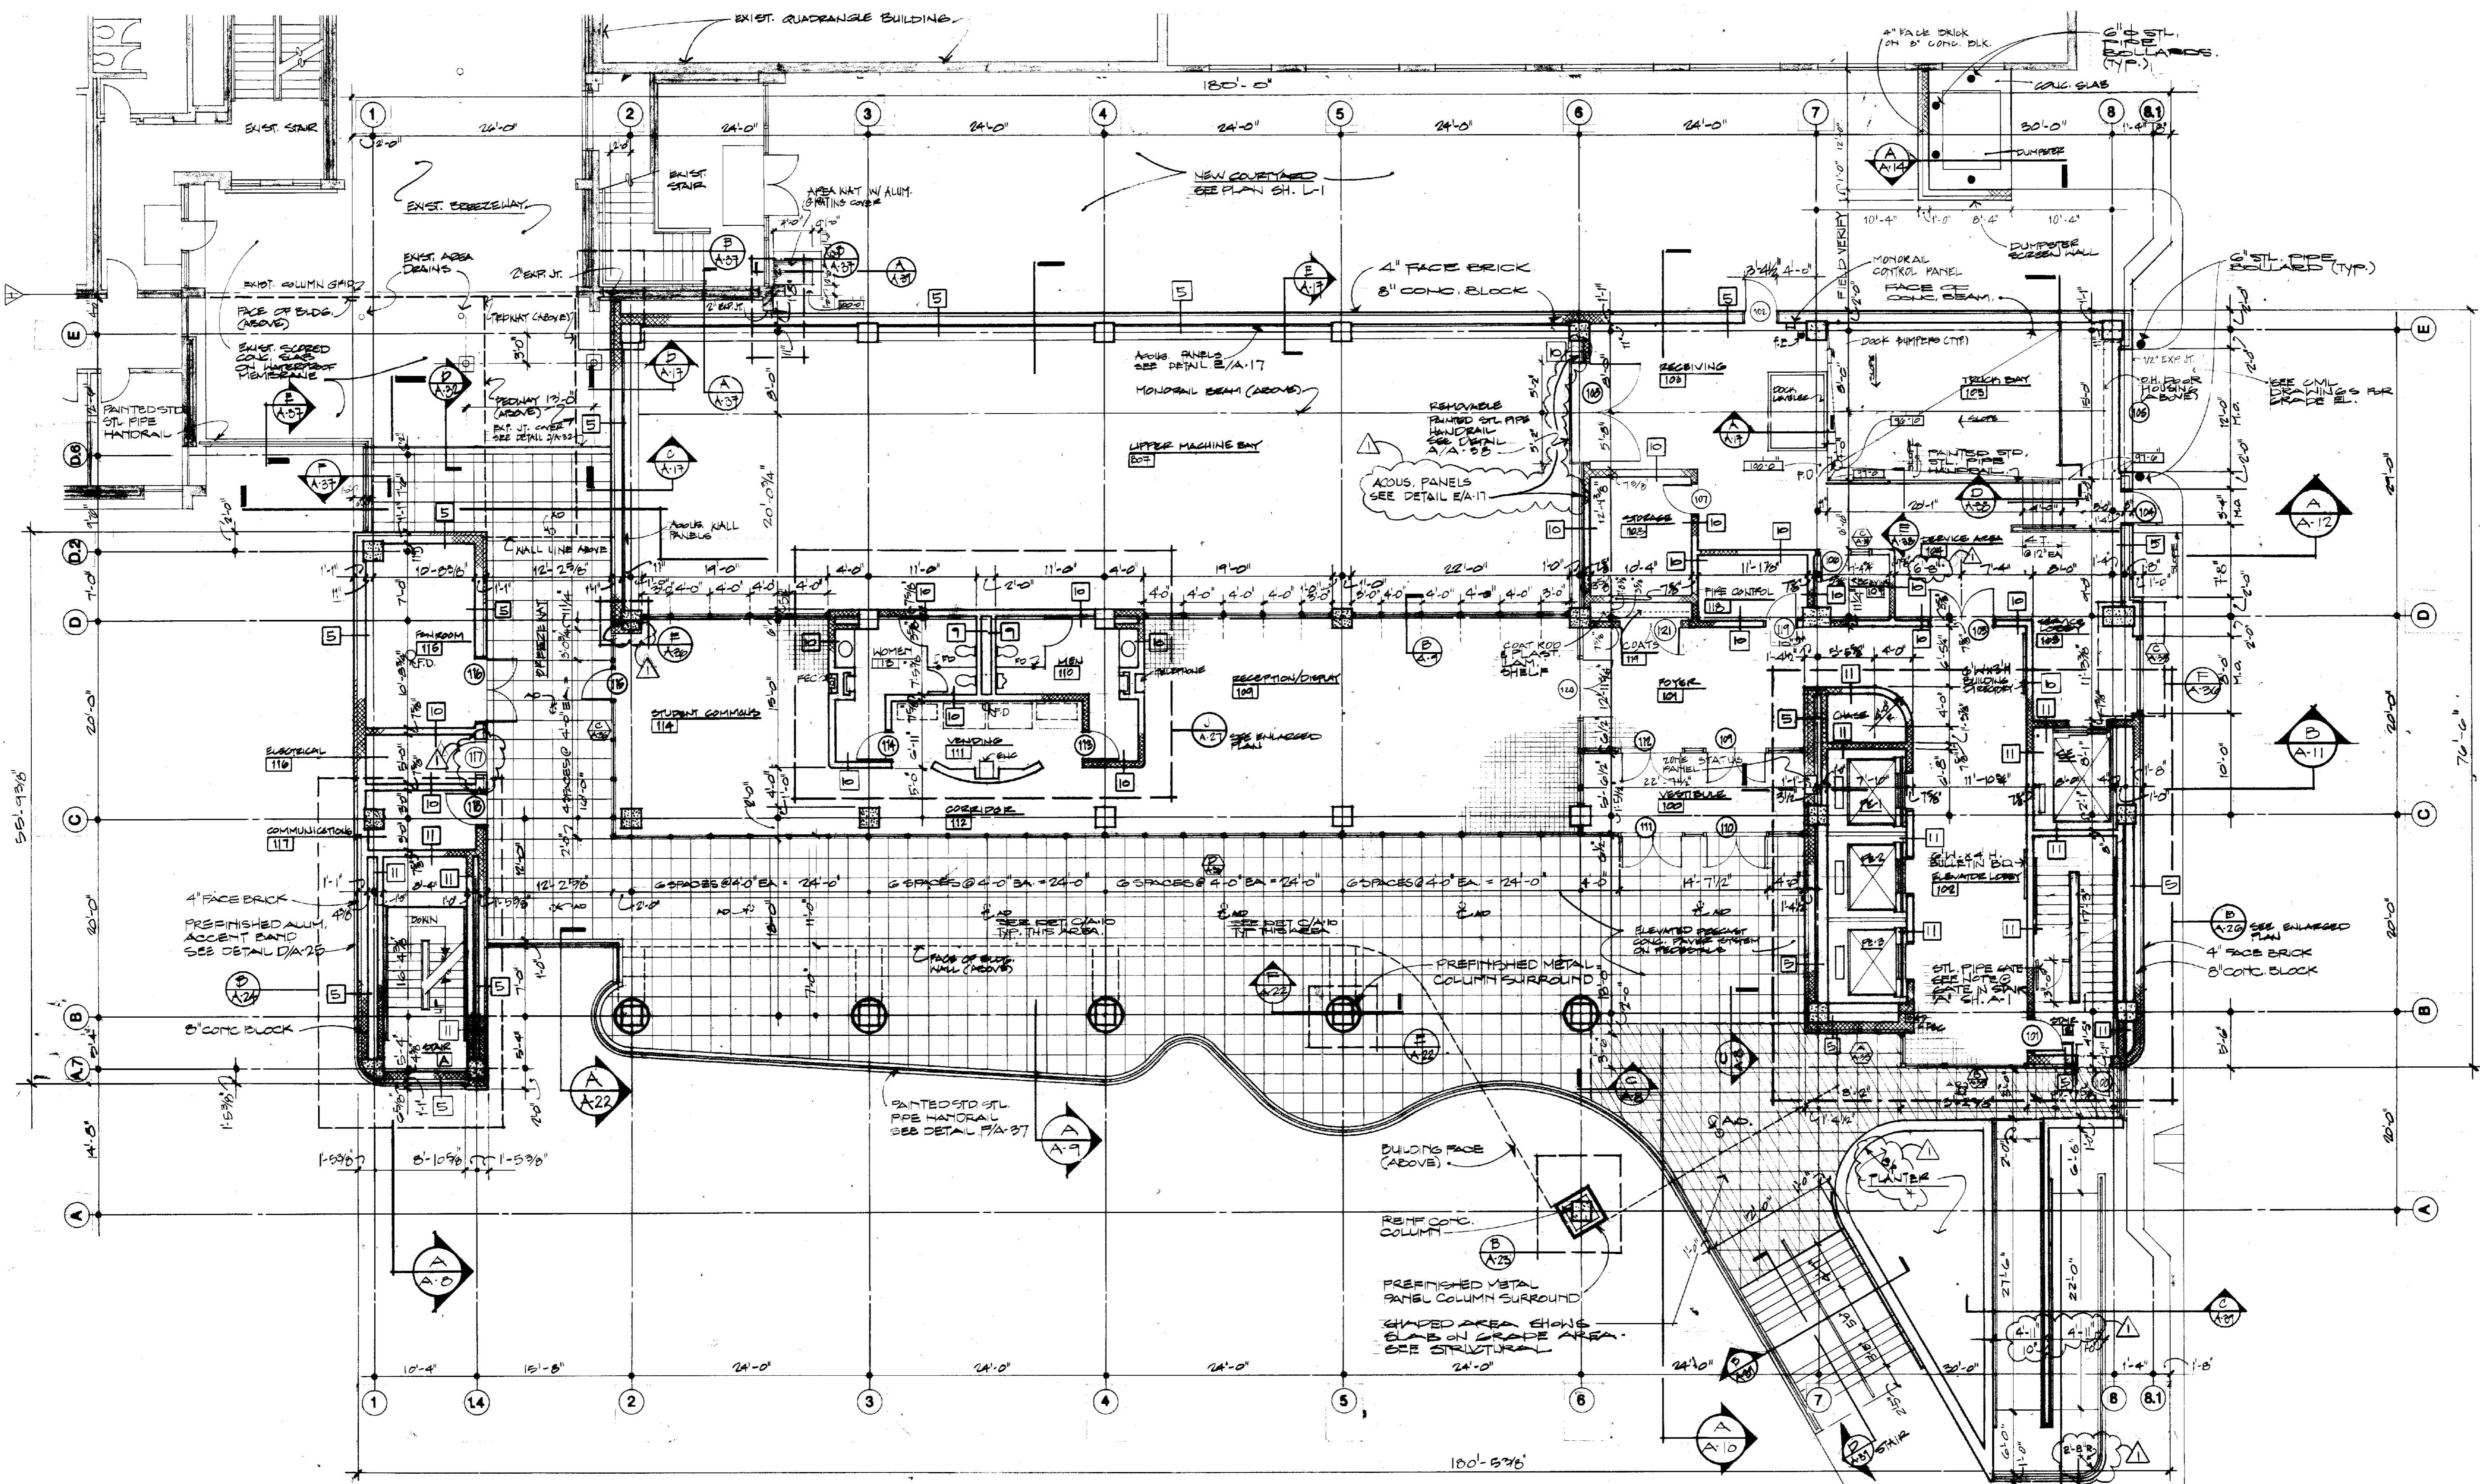

FIRST FLOOR PLAN
1/8" = 1'-0"

LEGEND

- (8) DOOR/FRAME NUMBER. REFER TO SCHED., SHT. A-33.
- (101) ROOM NUMBER. REFER TO FINISH SCHED., SHTS. A-31, A-32.
- (A) CURTAINWALL TYPE. REFER TO BLDG. ELEVATIONS & SHTS. A-35, A-36
- (I) WALL/PARTITION TYPE. REFER TO SCHED., SHT. A-23

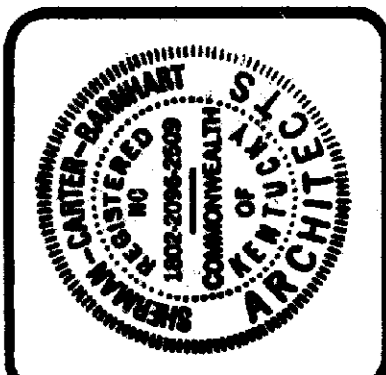

ROBOTICS FACILITY
LEXINGTON CAMPUS
UNIVERSITY OF KENTUCKY
LEXINGTON, KENTUCKY

University of Kentucky
Lexington, Kentucky
Approved by
Wendell Gentry
Director, Design and Construction Services


FIRST FLOOR PLAN
Sherman Carter-Barnhart
PARTNERS IN ARCHITECTURE
SUITE 1800 • 750 WEST MAIN STREET • LEXINGTON, KY 40507 • 502-254-1351

JOB NO. 8706
DATE 10-1-87
DRAWN [Signature]
CHECKED CEB
FILE NO. 431.0

REVISIONS
A AS-BUILT 2/13/94

SHEET

A•2

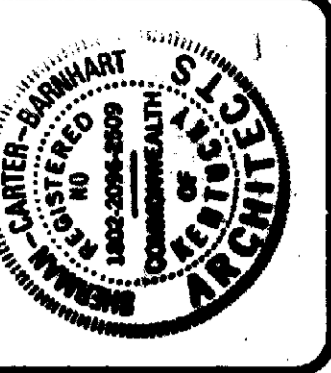

ROBOTICS FACILITY
LEXINGTON CAMPUS
UNIVERSITY OF KENTUCKY
LEXINGTON, KENTUCKY

University of Kentucky
Lexington, Kentucky

W. W. BARNHART
ARCHITECTS
10-19-87

THIRD FLOOR PLAN


Sherman Carter Barnhart
PARTNERS IN ARCHITECTURE
SUITE 1900 • 250 WEST MAIN STREET • LEXINGTON, KY 40507 • 606-254-3501

JOB NO. 8706
DATE 10-7-87
DRAWN STAFF
CHECKED CEB
FILE NO. 431.0


REVISIONS
A FEB. 7, 1990
B AS BUILT 2-28-91

SHEET

AS BUILT
A-4

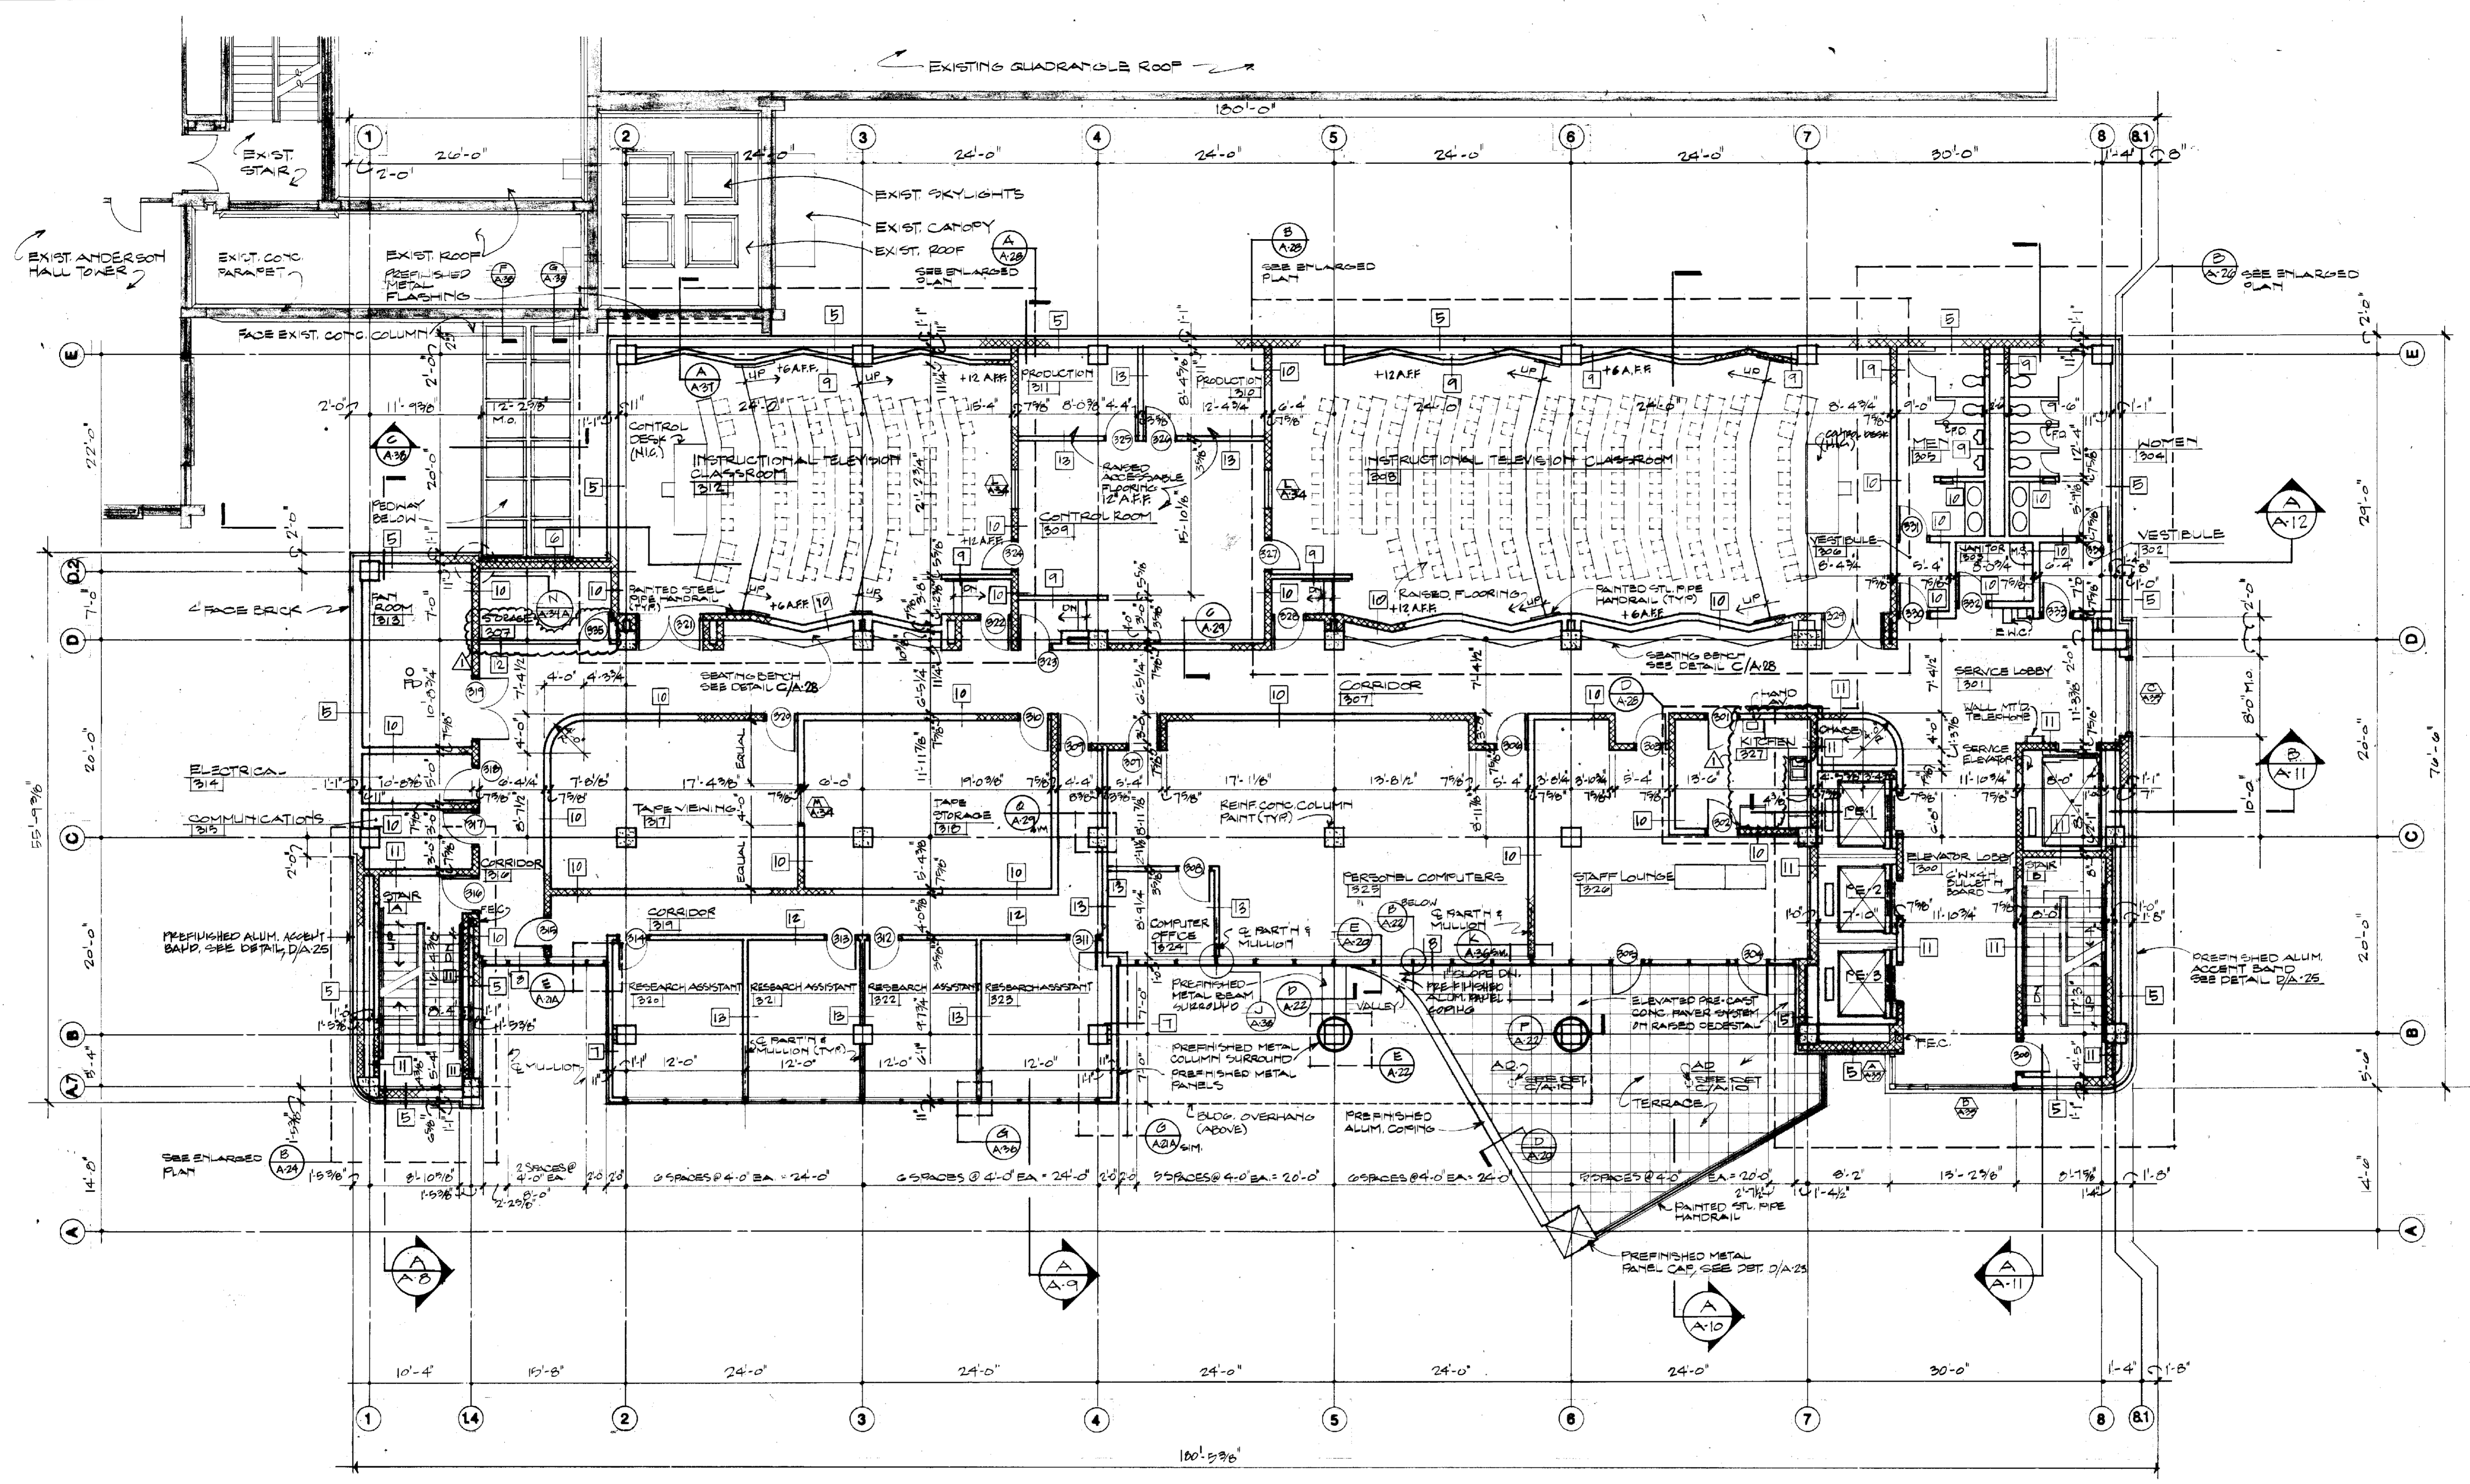


THIRD FLOOR PLAN
1/8" = 1'-0"

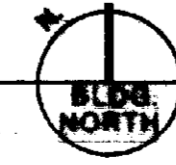

LEGEND

- (01) DOOR/FRAME NUMBER. REFER TO SCHED., SHY. A-33.
- (02) ROOM NUMBER. REFER TO FINISH SCHED., SHYS. A-31, A-32.
- (03) CURTAINWALL TYPE. REFER TO BLDG. ELEVATIONS & SHYS. A-35, A-36.
- (04) WALL/PARTITION TYPE. REFER TO SCHED., SHY. A-23.

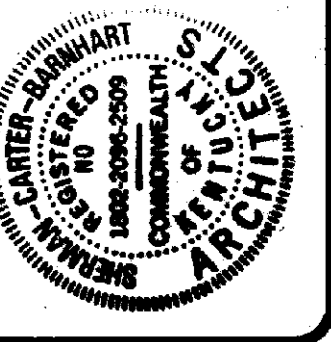

ROBOTICS FACILITY
LEXINGTON CAMPUS
UNIVERSITY OF KENTUCKY
LEXINGTON, KENTUCKY

University of Kentucky
Lexington, Kentucky

10.19.97
DATE

FOURTH FLOOR PLAN


Sherman Carter Barnhart
PARTNERS IN ARCHITECTURE
SUITE 1900 • 750 WEST MAIN STREET • LEXINGTON, KY 40501 • 502/254-1551

JOB NO. 8708
DATE 10-1-97
DRAWN STAFF
CHECKED CEB
FILE NO. 431.0

REVISIONS
1 FEB 7 1998
2 AS BUILT 2/18/98


SHEET

A-5

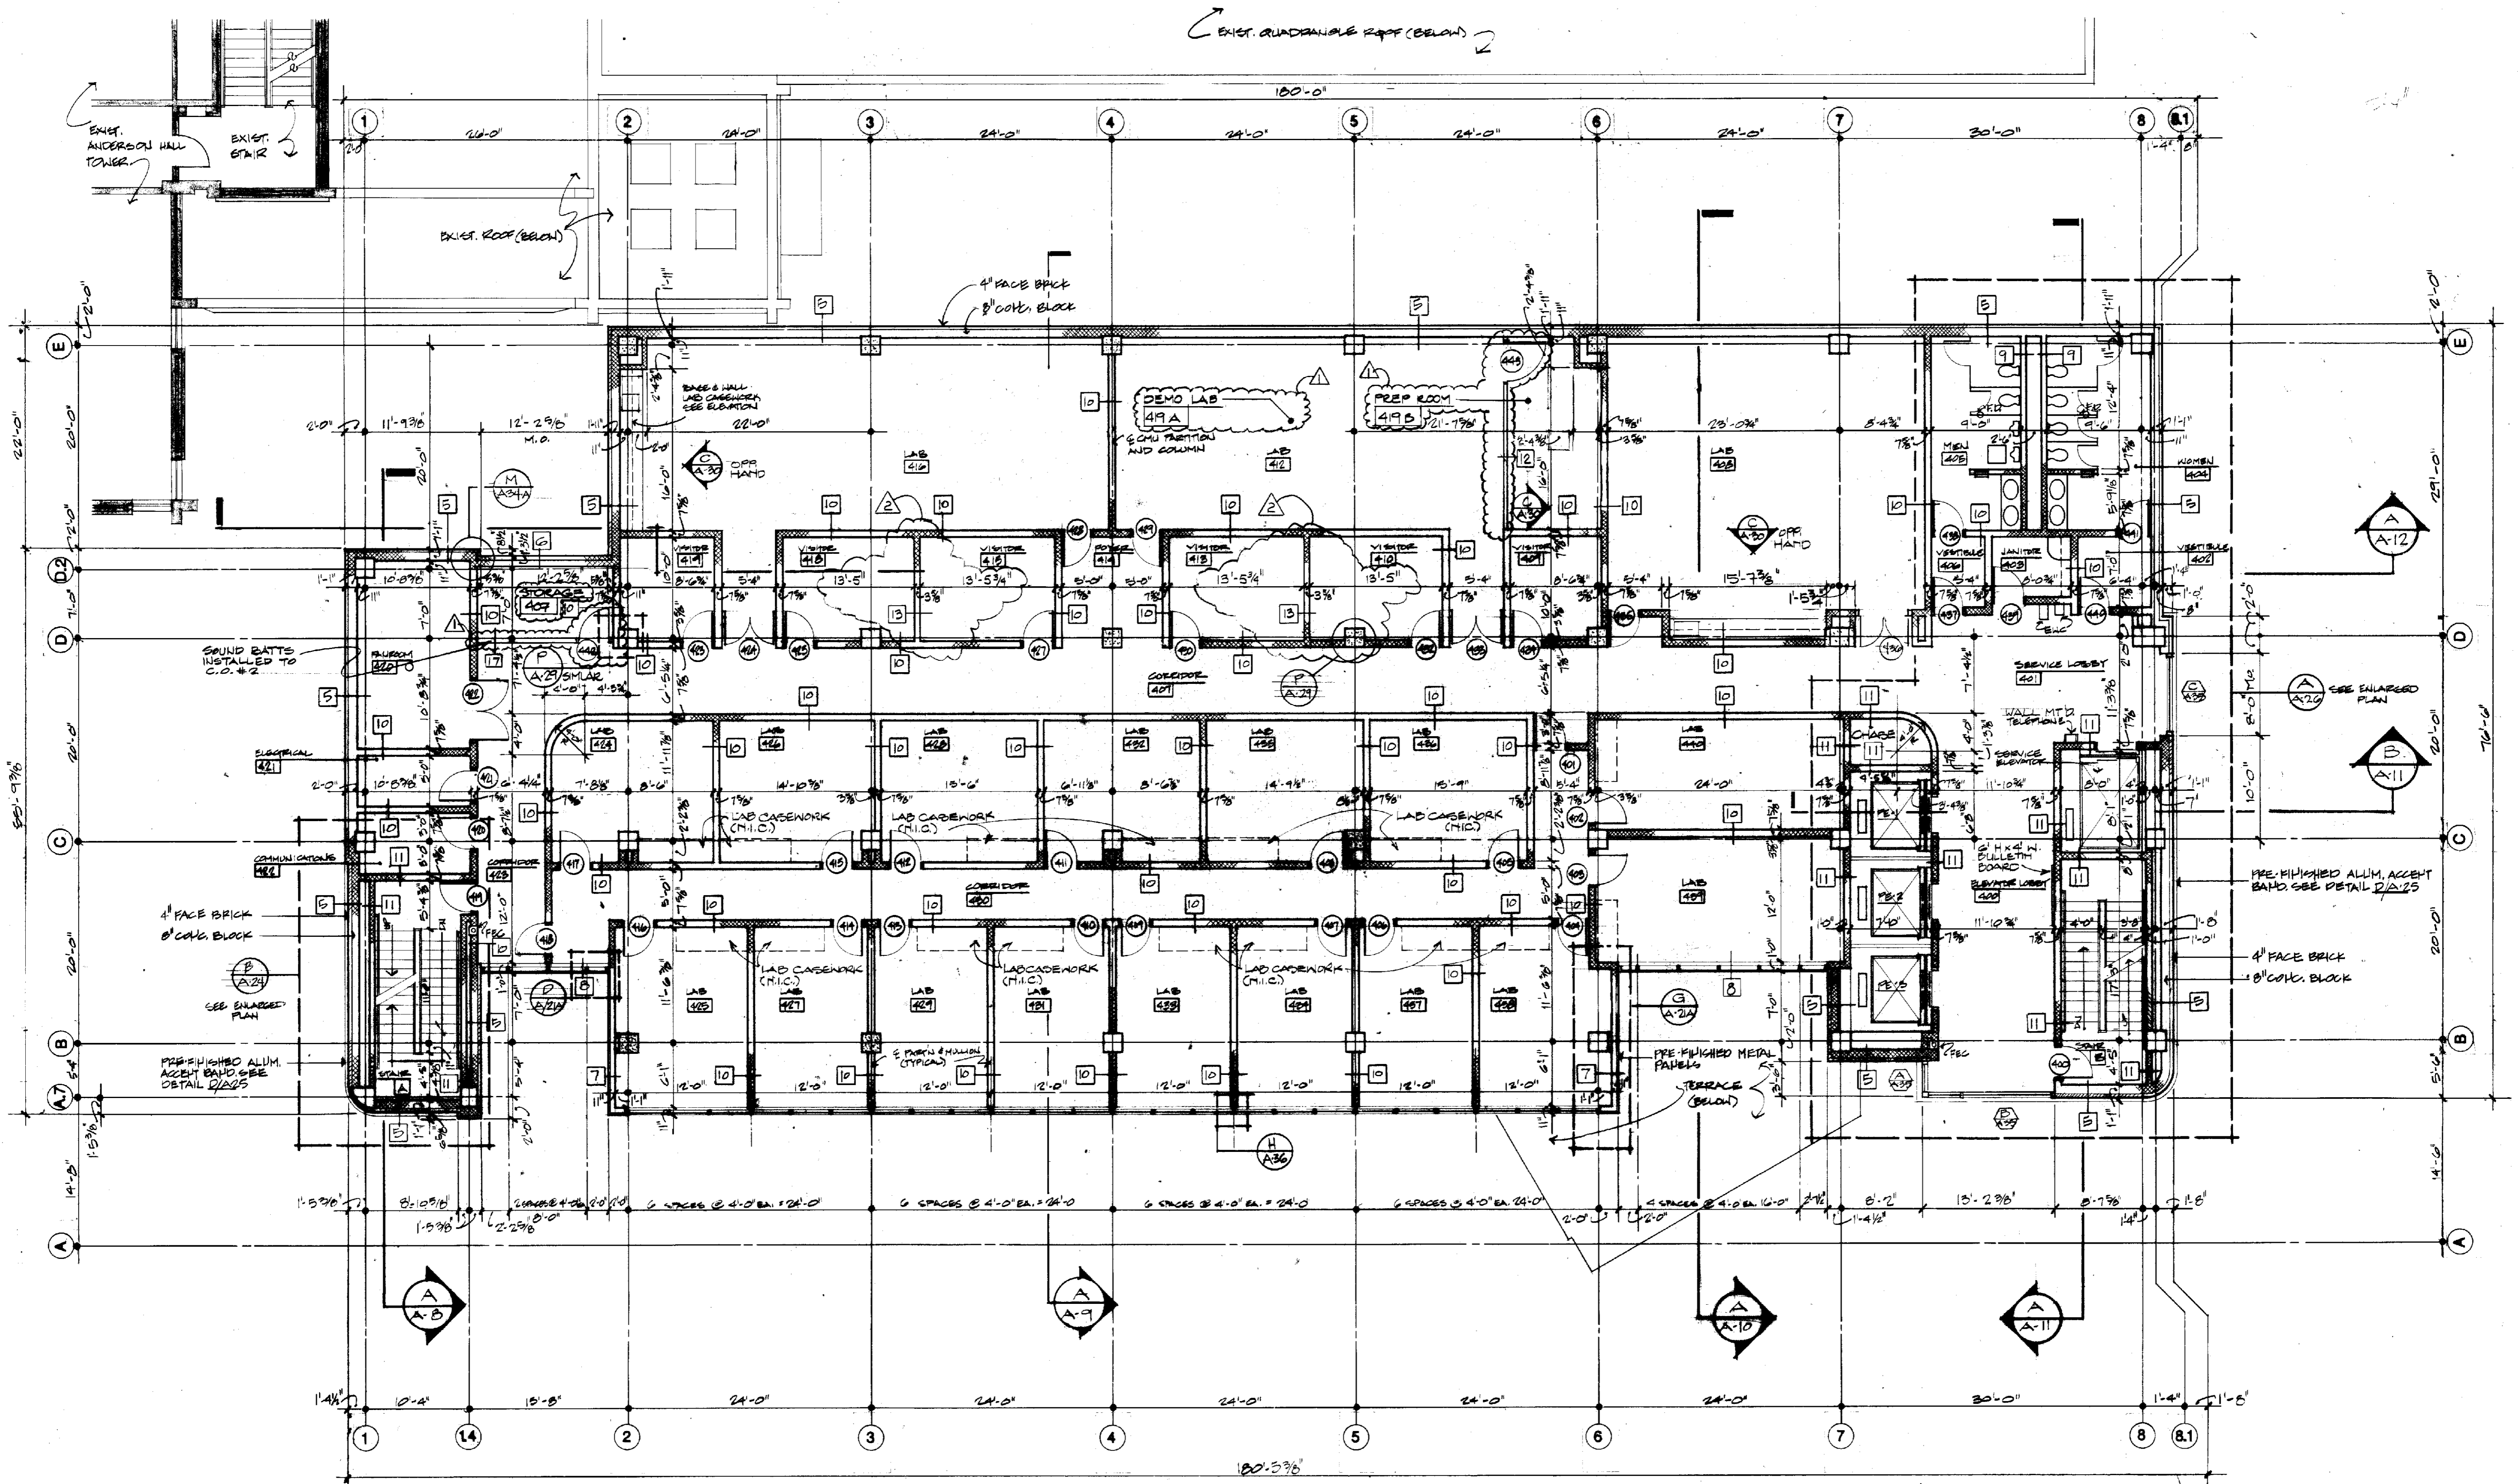

FOURTH FLOOR PLAN

1/8" = 1'-0"

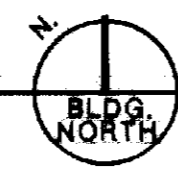

LEGEND

- (10) DOOR/FRAME NUMBER. REFER TO SCHED., SH. A-33.
- (101) ROOM NUMBER. REFER TO FINISH SCHED., SH. A-31, A-32.
- (A) CURTAINWALL TYPE. REFER TO BLDG. ELEVATIONS & SH. A-35, A-36.
- (W) WALL PARTITION TYPE. REFER TO SCHED., SH. A-23.

AS BUILT



ROBOTICS FACILITY
LEXINGTON CAMPUS
UNIVERSITY OF KENTUCKY
LEXINGTON, KENTUCKY

University of Kentucky
Lexington, Kentucky

Sherman Carter Barnhart
ARCHITECTS
14-9-87

FIFTH FLOOR PLAN

Sherman Carter Barnhart
PARTNERS IN ARCHITECTURE
SUITE 1900 • 250 WEST MAIN STREET • LEXINGTON, KY 40507 • 606-254-1350


JOB NO. 8708
DATE 10-1-87
DRAWN STAFF
CHECKED CEB
FILE NO. 431.0

REVISIONS
FEB. 7, 1990
AS BUILT 2/10/91

SHEET


A-6

82 C-1 045888

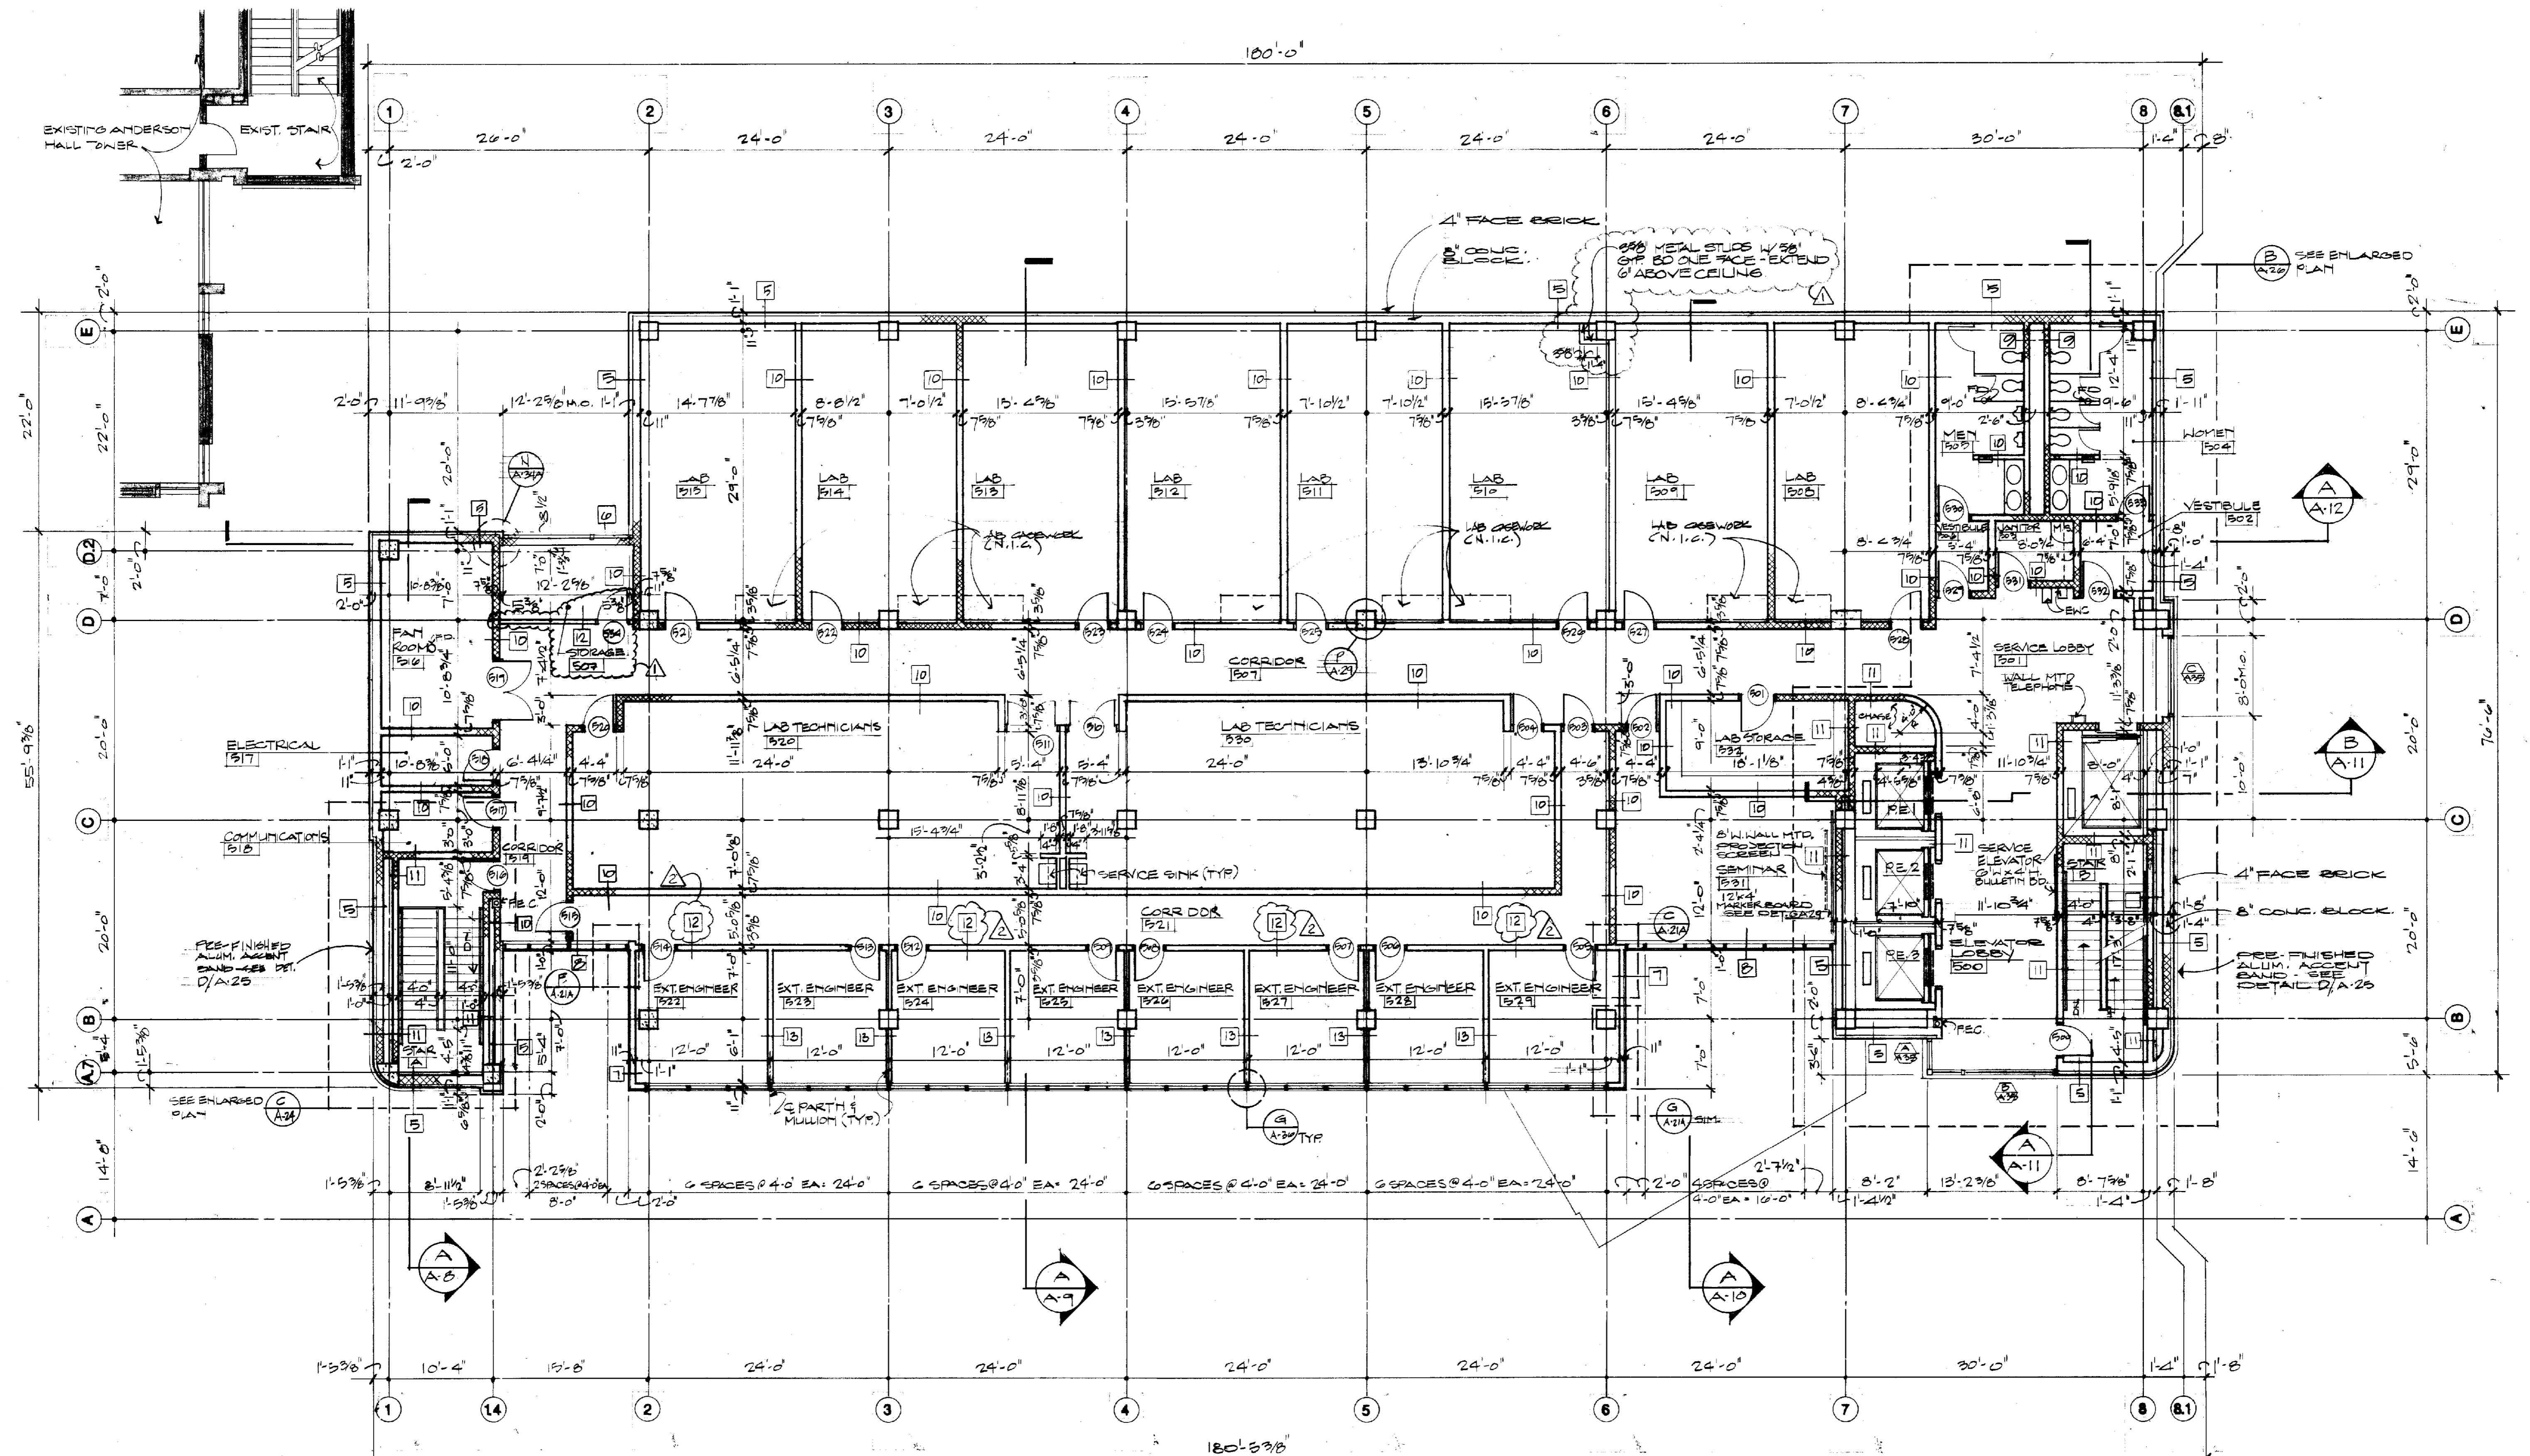

FIFTH FLOOR PLAN


1/8" = 1'-0"

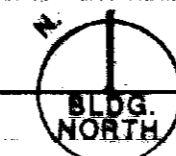


LEGEND

- (10) DOOR/FRAME NUMBER. REFER TO SCHED., SHT. A-33.
- (101) ROOM NUMBER. REFER TO FINISH SCHED., SHTS. A-31, A-32.
- (A) CURTAINWALL TYPE. REFER TO BLDG. ELEVATIONS & SHTS. A-35, A-36.
- (1) WALL/PARTITION TYPE. REFER TO SCHED., SHT. A-23.


AS BUILT

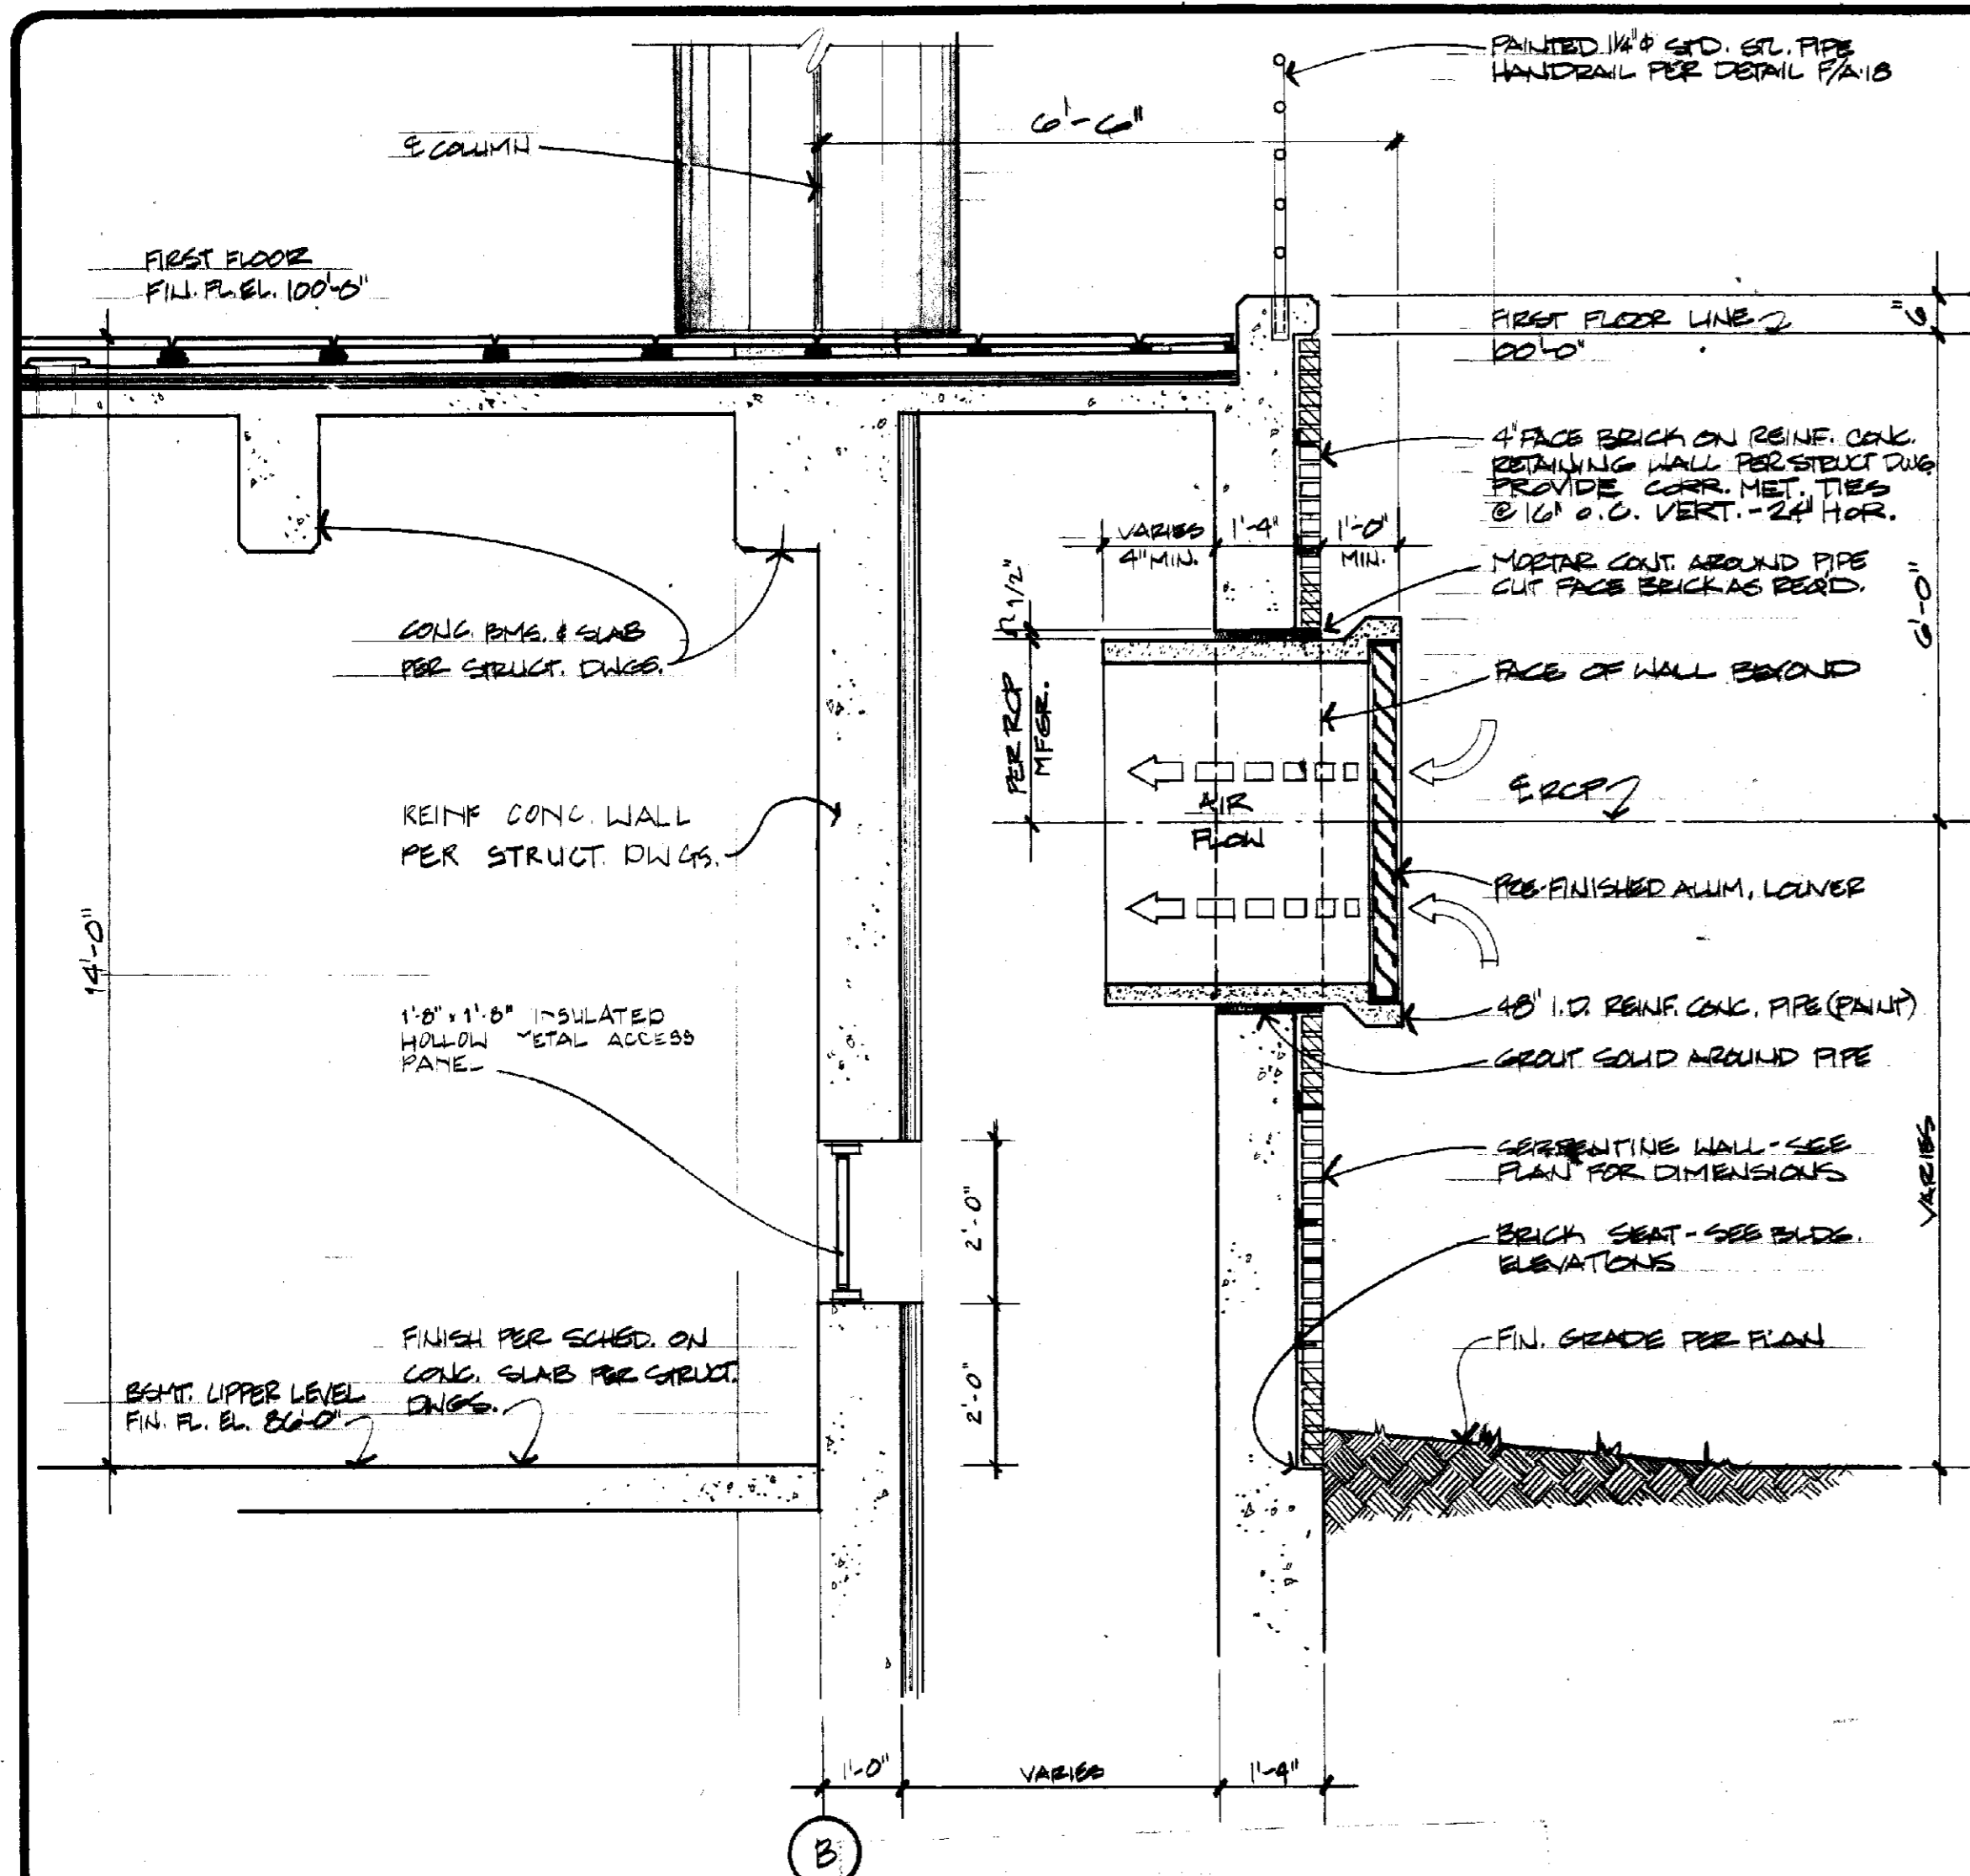


PIPE LOUVER DETAIL
 1/2" = 1'-0"
 A A-7A

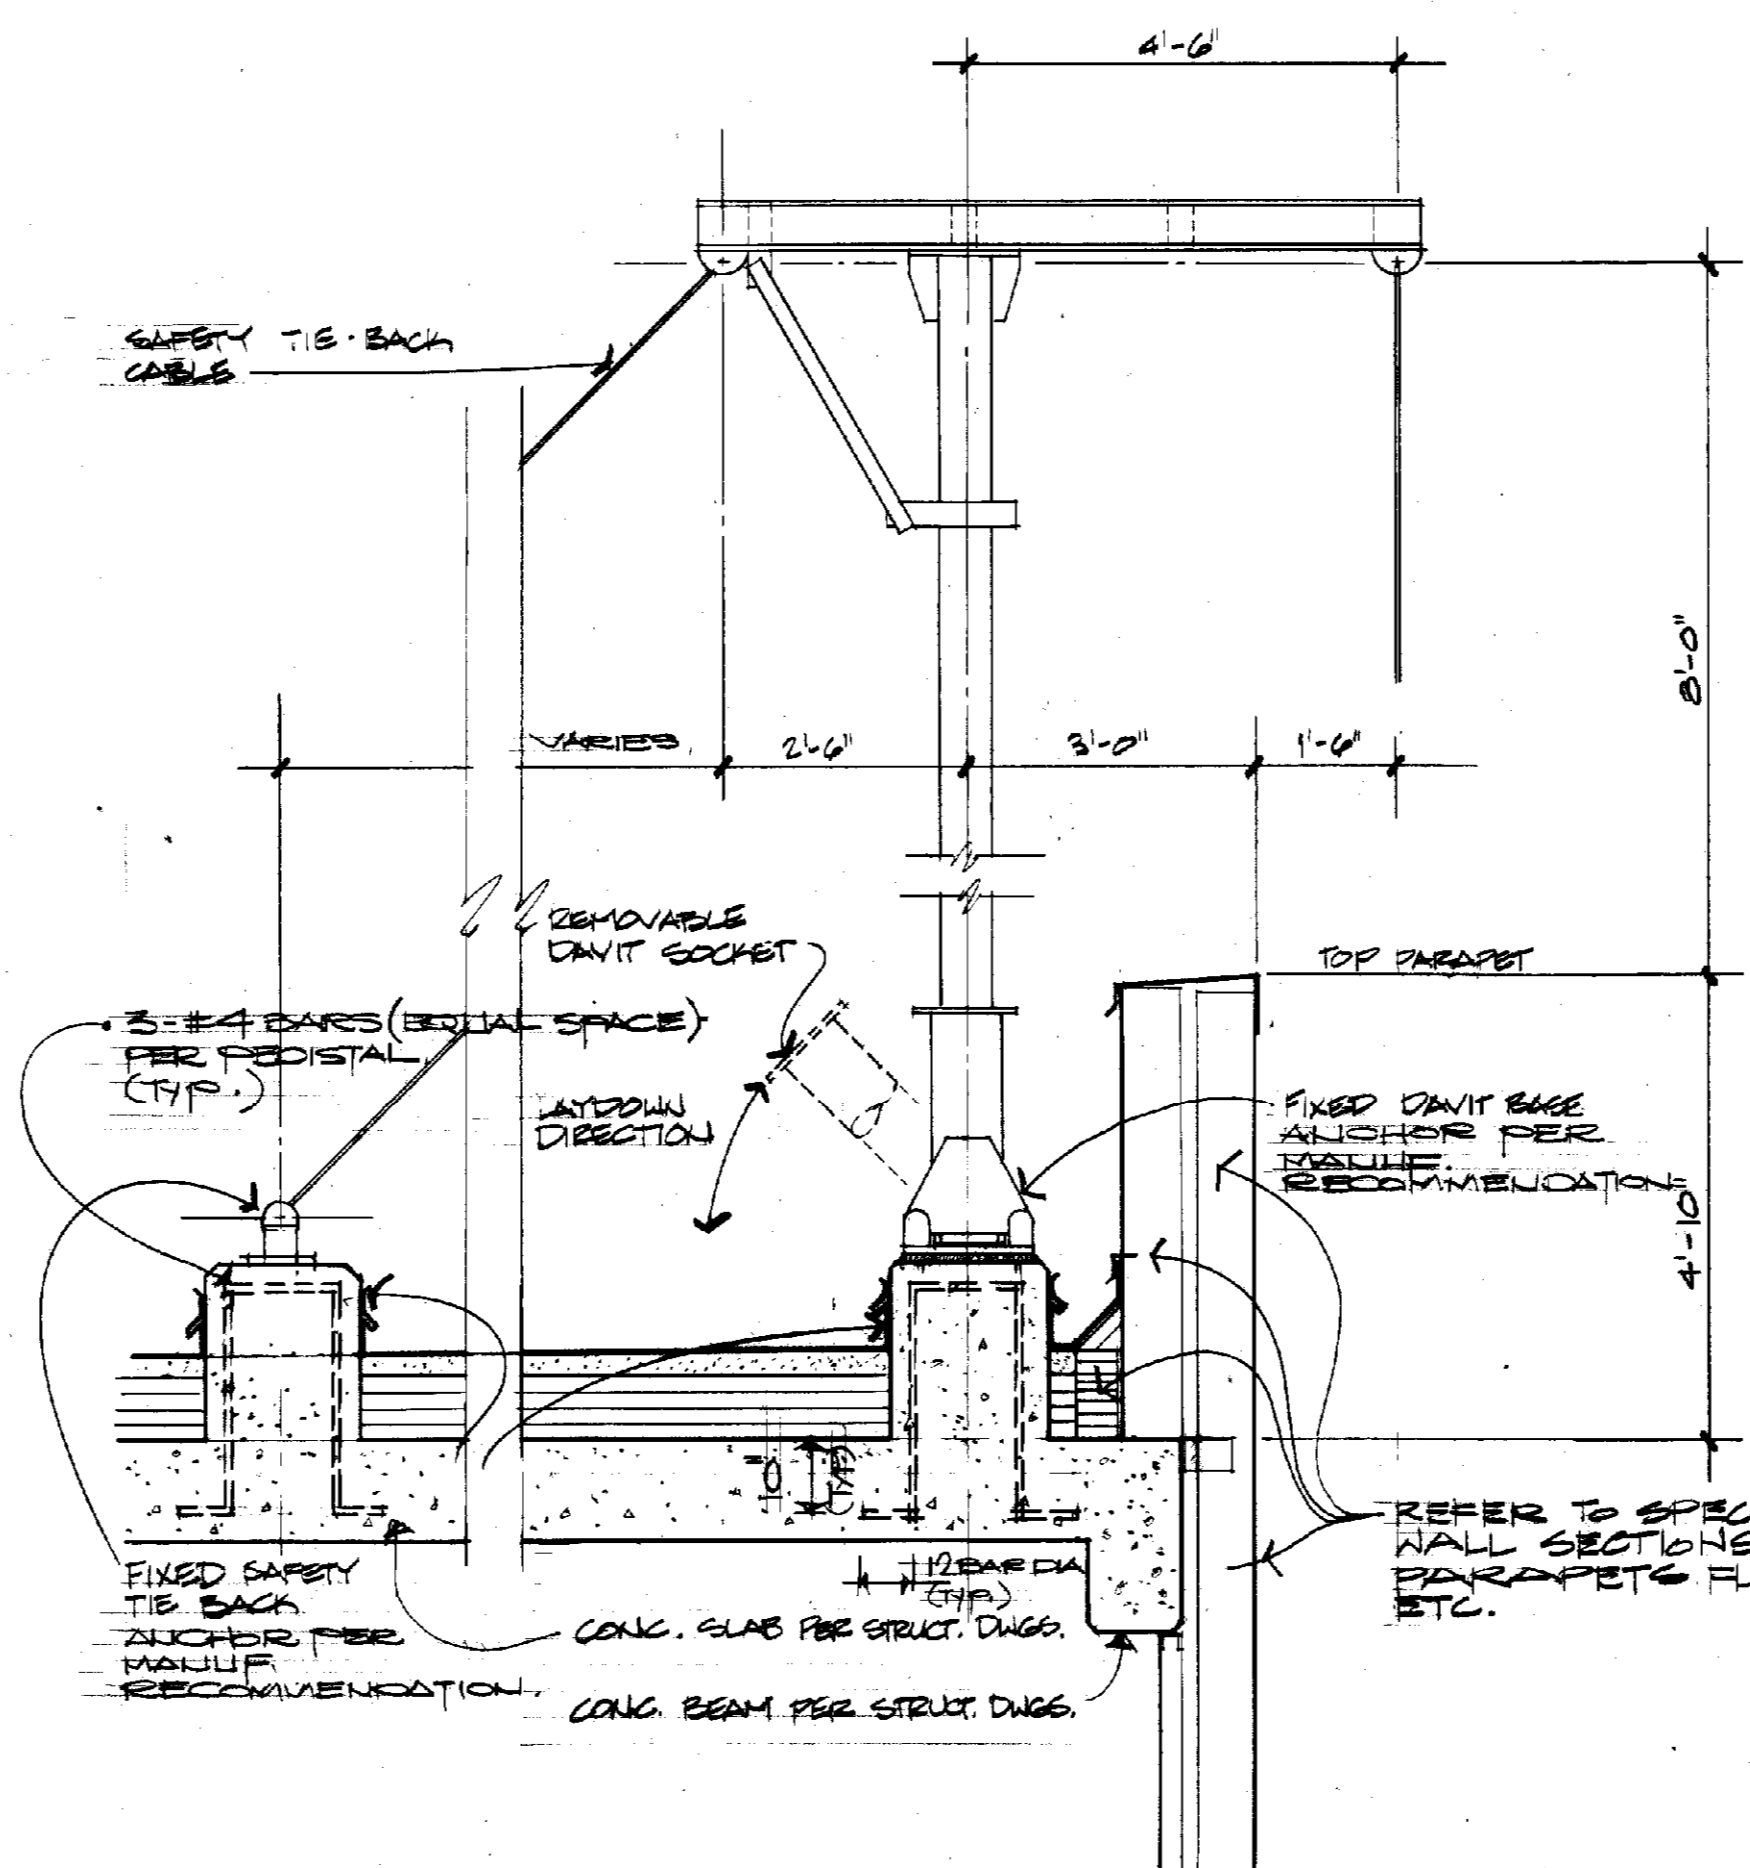


DAVIT DETAIL
 1/2" = 1'-0"
 B B-7A

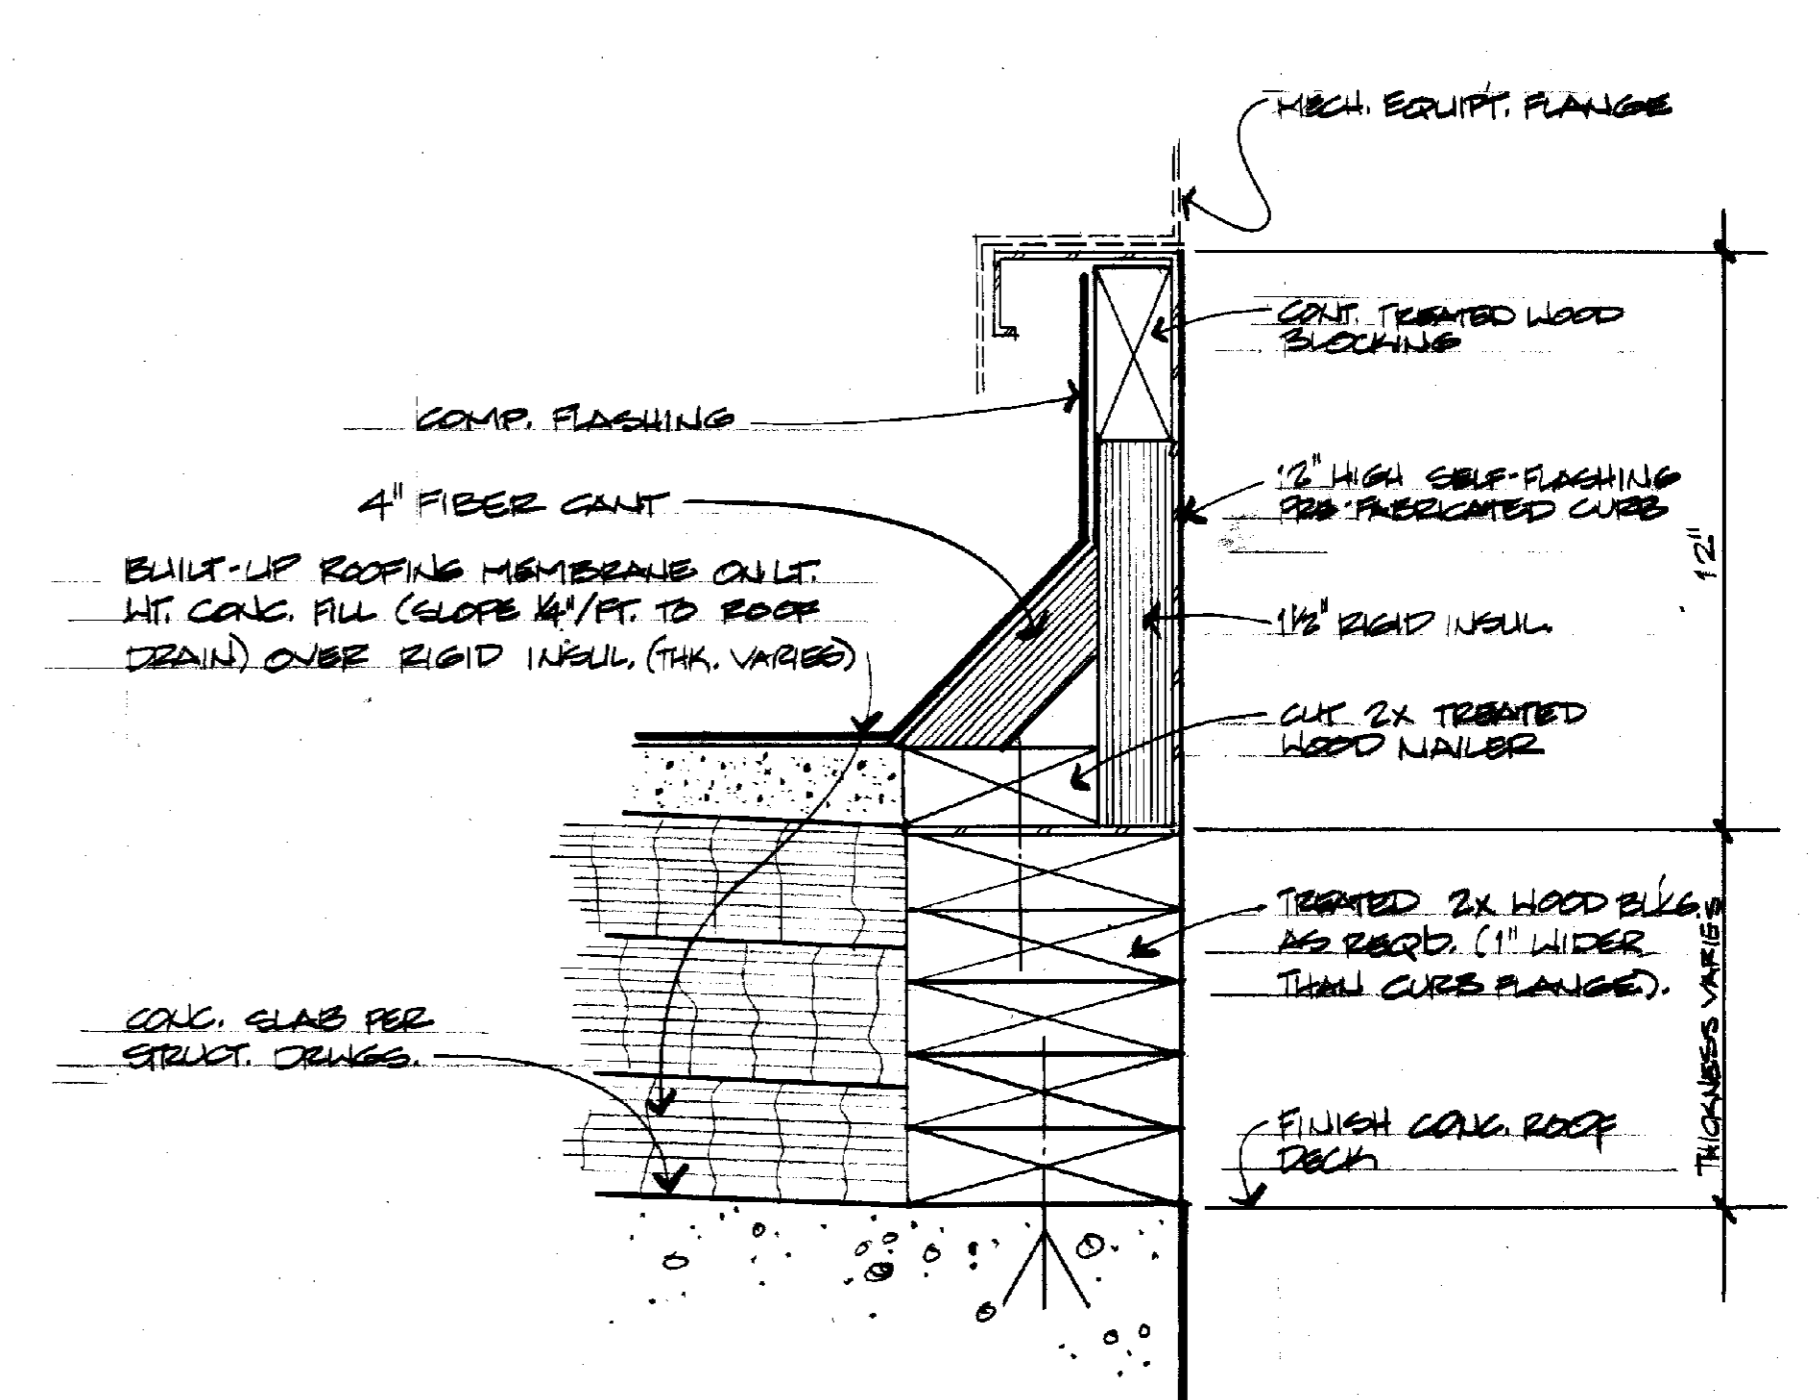


ROOF CURB DETAIL
 3" = 1'-0"
 C C-7A

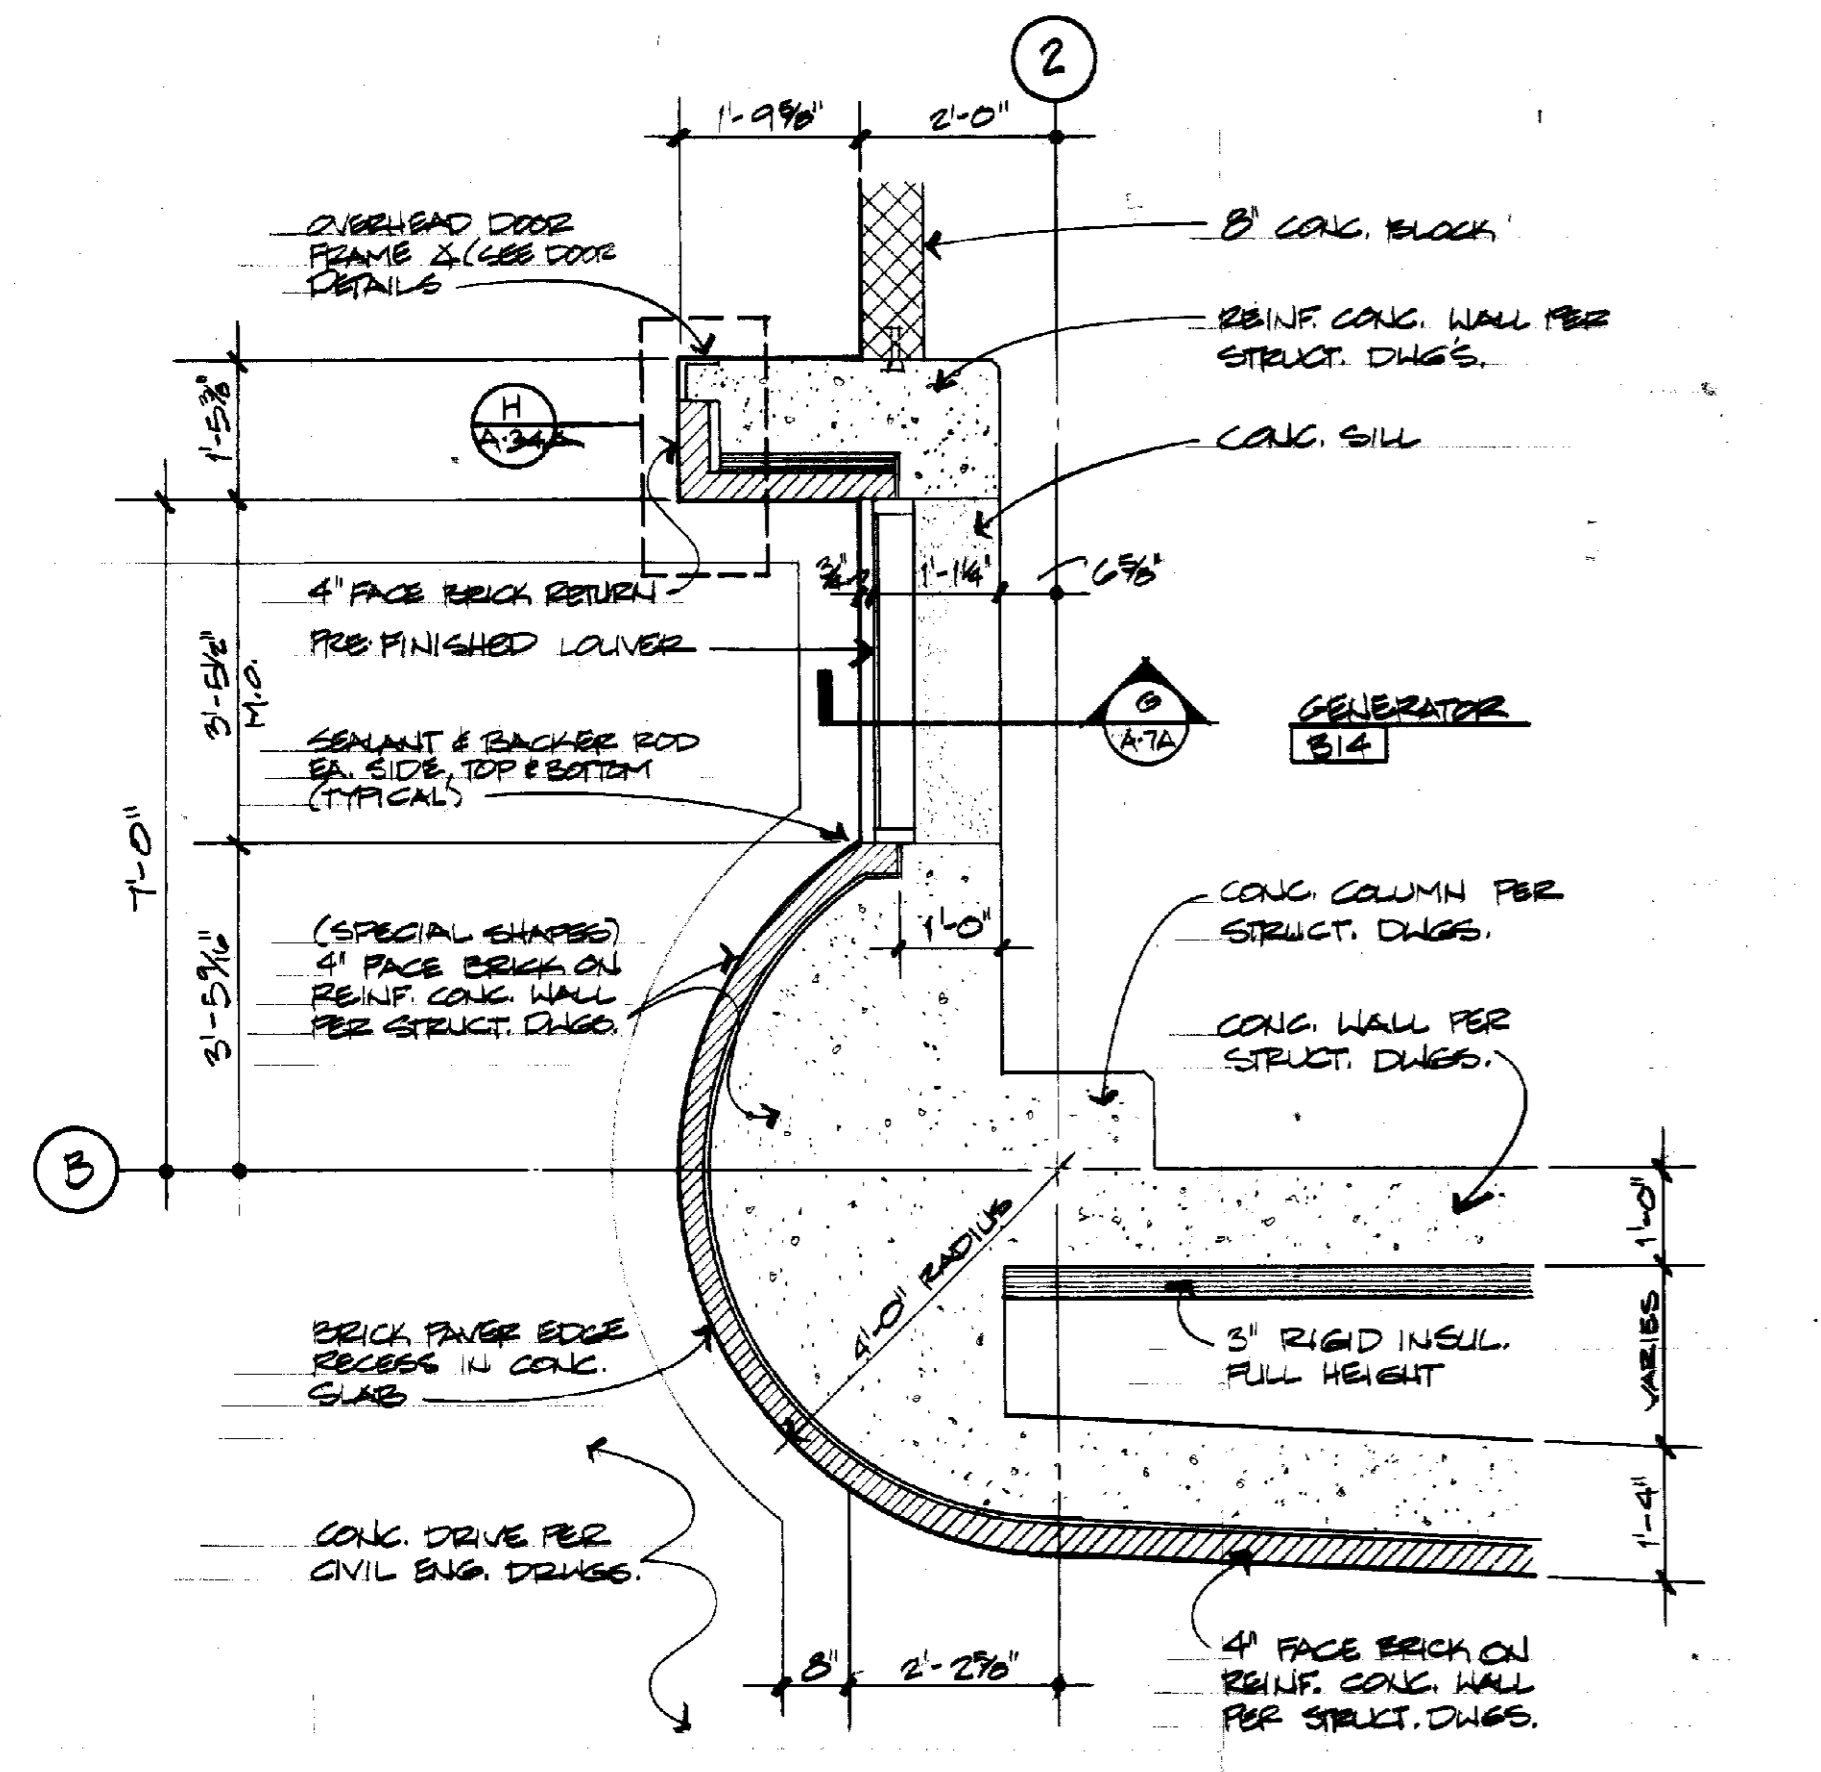


SERPENTINE WALL DETAIL
 1/2" = 1'-0"
 F A-7A

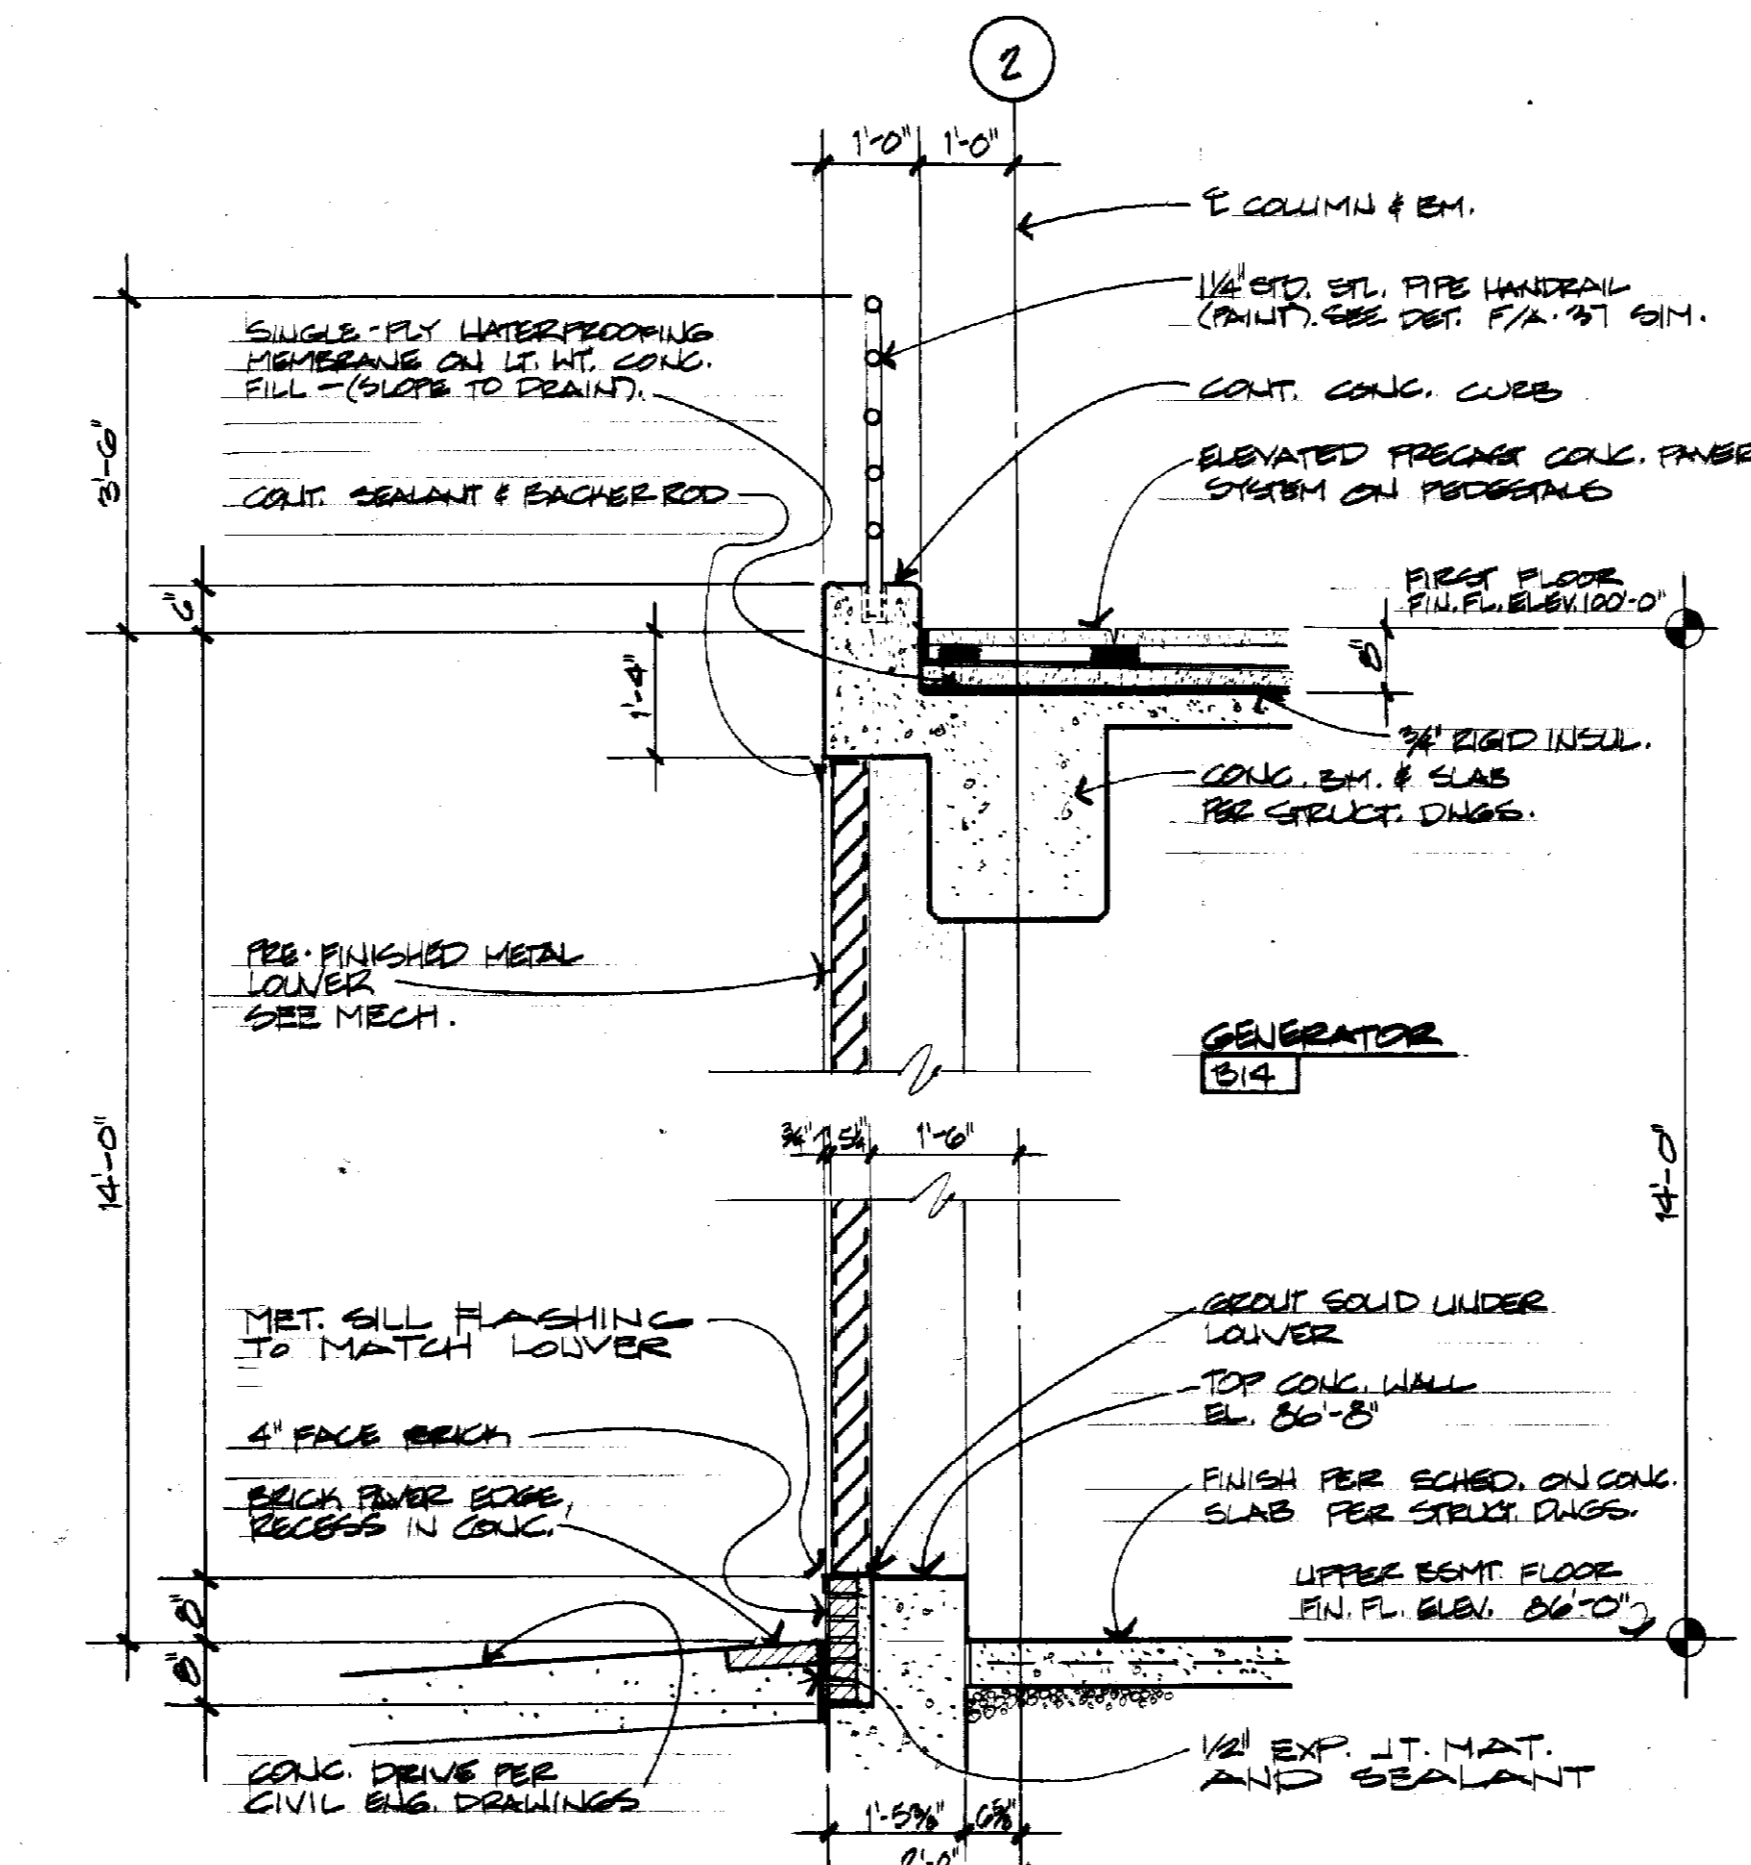


LOUVER DETAIL
 1/2" = 1'-0"
 G A-7A

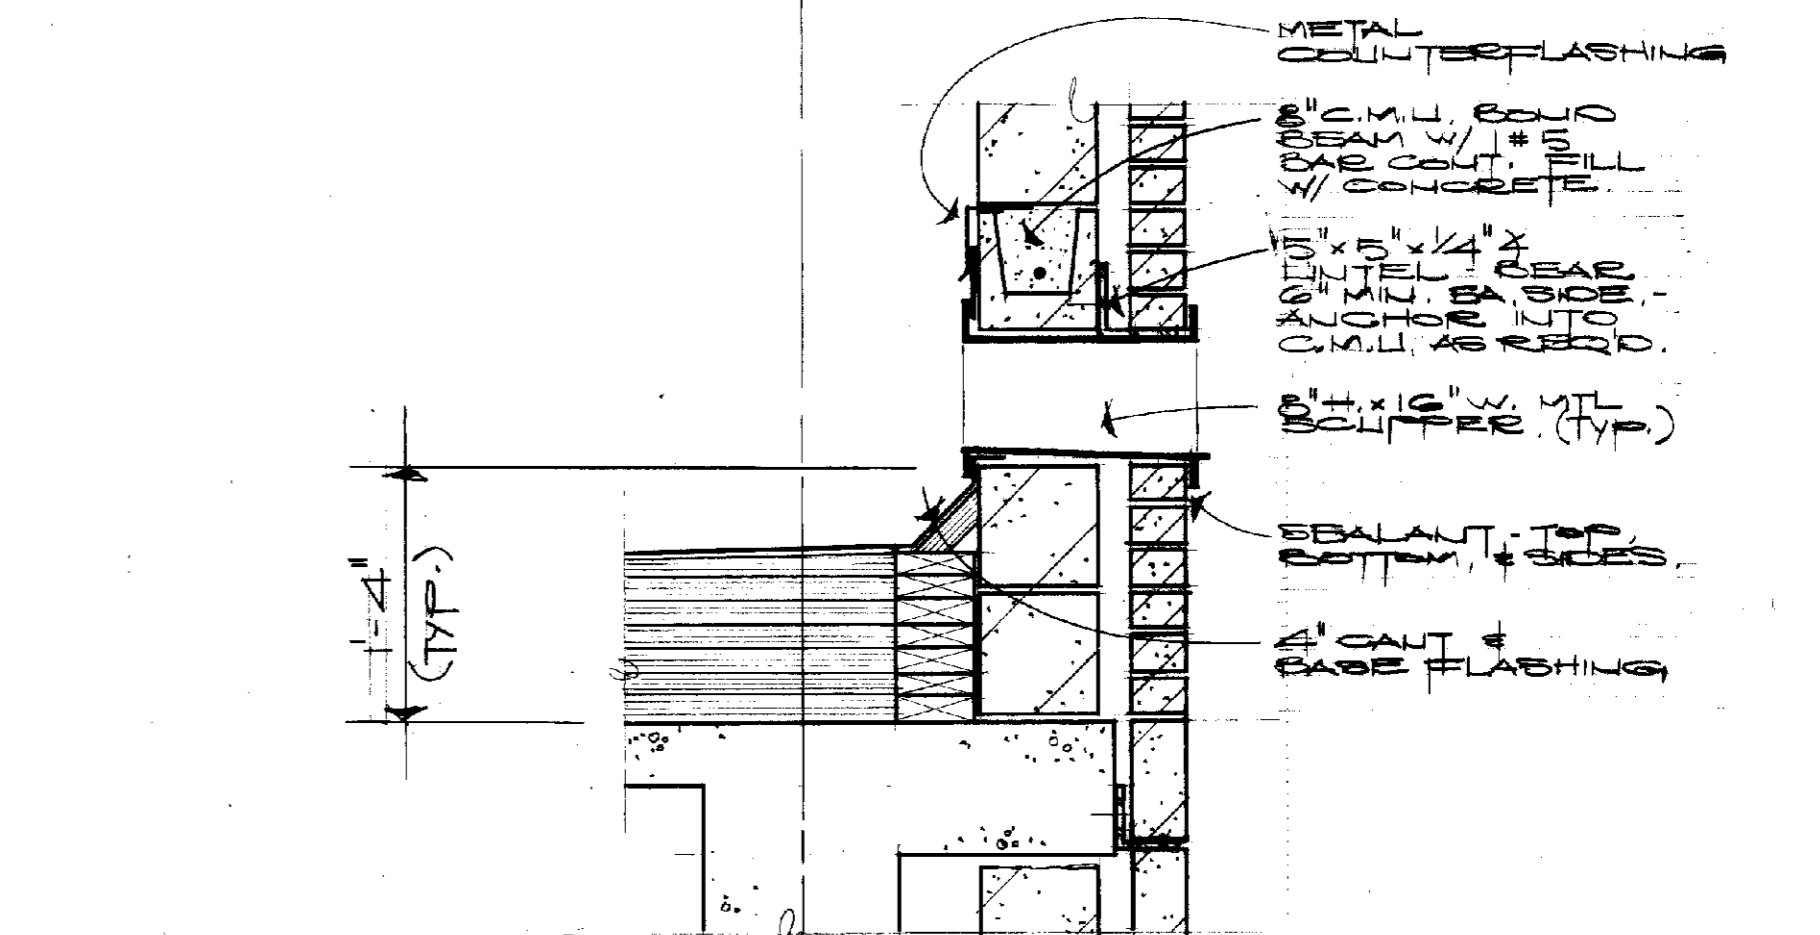

SCUPPER DETAIL
 SCALE: 1" = 1'-0"
 H A-7A

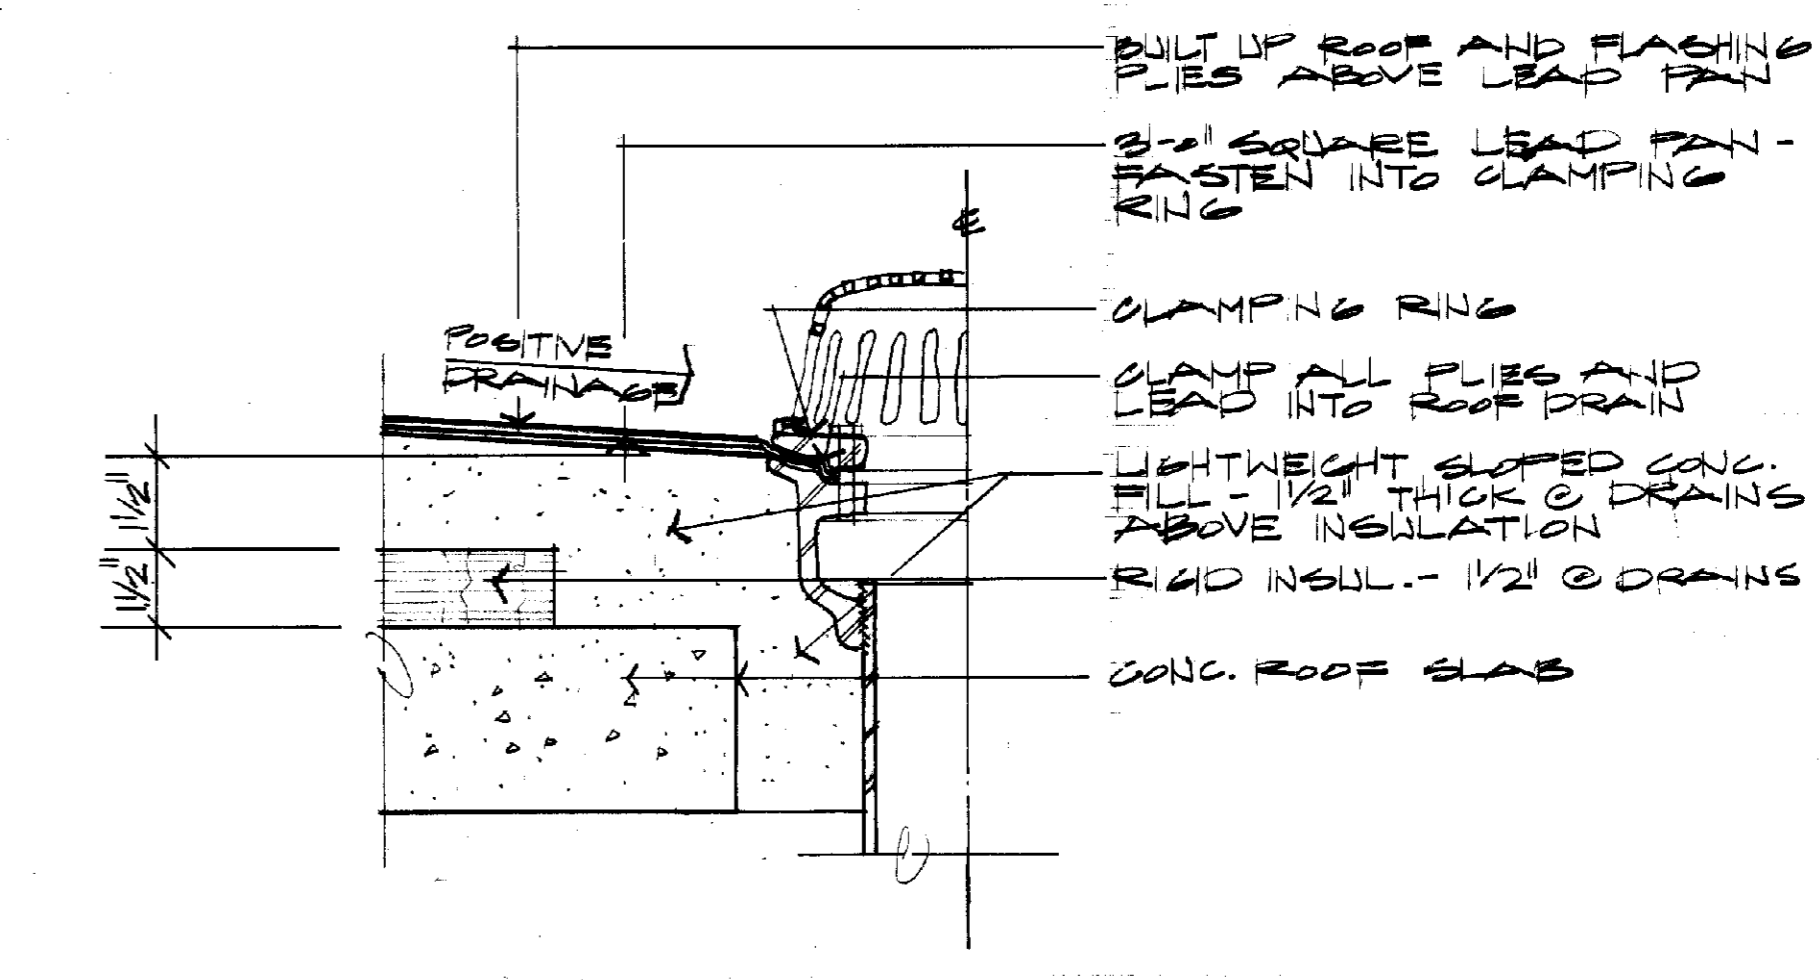

ROOF DRAIN DETAIL
 NOT TO SCALE
 L A-7A

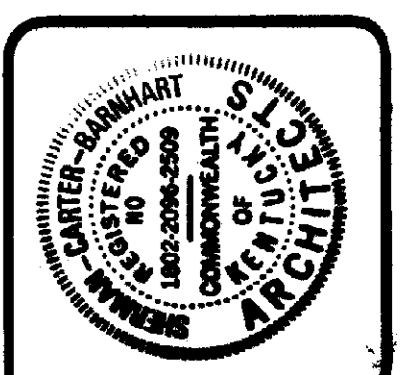

ROBOTICS FACILITY
 LEXINGTON CAMPUS
 UNIVERSITY OF KENTUCKY
 LEXINGTON, KENTUCKY


University of Kentucky
 Lexington, Kentucky
 Sherman Carter Barnhart
 ARCHITECTS
 10-18-87

SECTION AND DETAILS
 Sherman Carter Barnhart
 PARTNERS IN ARCHITECTURE
 FARMINGTON PARADE CENTER - SUITE 1900 - 725 W. MAIN - LEXINGTON, KY 40507 - 606-254-7357

JOB NO.	8708
DATE	10-1-87
DRAWN	PRESTON
CHECKED	CEB
FILE NO.	431.8

NO.	REVISIONS

SHEET
 A-7A
 C-1

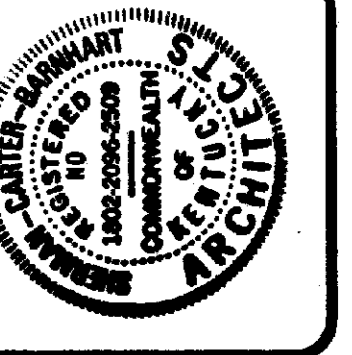

ROBOTICS FACILITY
 LEXINGTON CAMPUS
 UNIVERSITY OF KENTUCKY
 LEXINGTON, KENTUCKY

University of Kentucky
 Lexington, Kentucky

10-19-87
 DIRECTOR, DESIGN AND CONSTRUCTION DIVISION

BUILDING SECTION

Sherman Carter Barnhart
 PARTNERS IN ARCHITECTURE
 SUITE 1800 • 750 WEST MAIN STREET • LEXINGTON, KY 40507 • 606-254-1351

JOB NO. 8708
 DATE 10-1-87
 DRAWN STAFF
 CHECKED CEB
 FILE NO. 431.0


NO.	REVISIONS

SHEET


A•8

GENERAL STEEL STAIR NOTES


1. ALL EXPOSED STEEL STAIR COMPONENTS SHALL BE PAINTED.
2. THOROUGH REMOVAL OR FIRE-PAINING OF "FIECE MARKINGS" IS REQUIRED. BLEED SURFACE SHALL NOT BE ACCEPTED.
3. MITER CUT AND WELD ALL TURNS IN STRINGERS.
4. "OPEN" STRINGER ENDS ARE NOT ACCEPTABLE. ENDS SHOULD BE "CLOSED" WITH 1/4" PLATE STEEL, WELDED AND GROUND.
5. PROVIDE 1/4" STEEL PLATE "CLOSERS" BETWEEN STRINGERS & LANDINGS. CONTINUOUS WELD AND GRIND JOINTS.

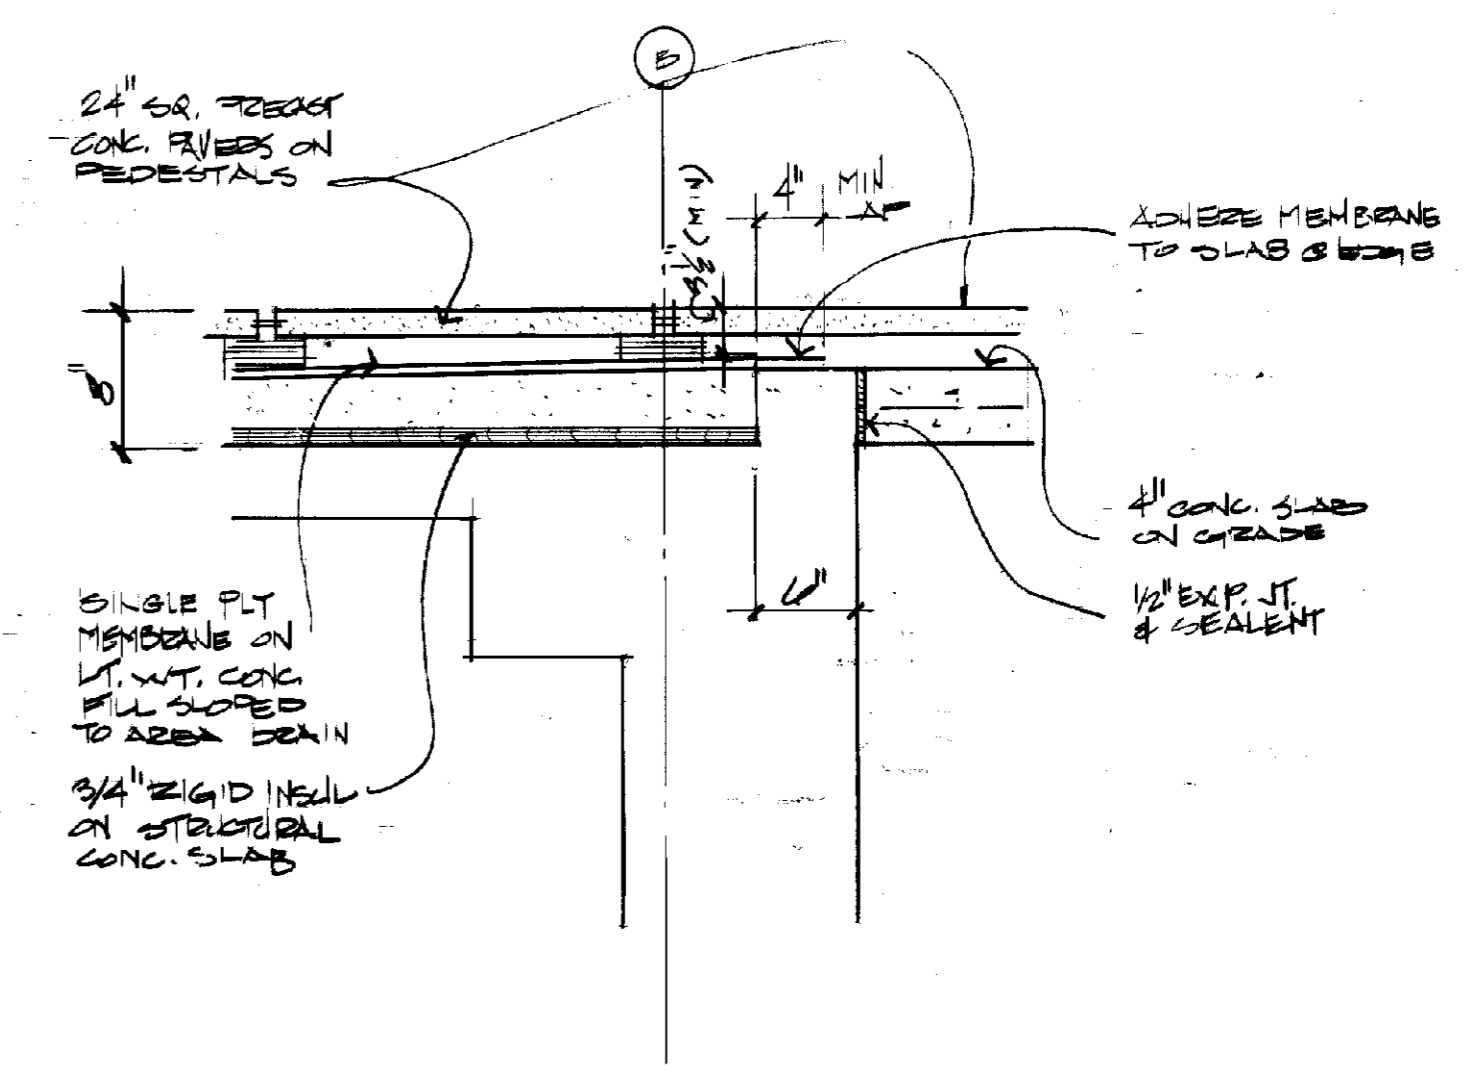


DETAIL
 1" = 1'-0"

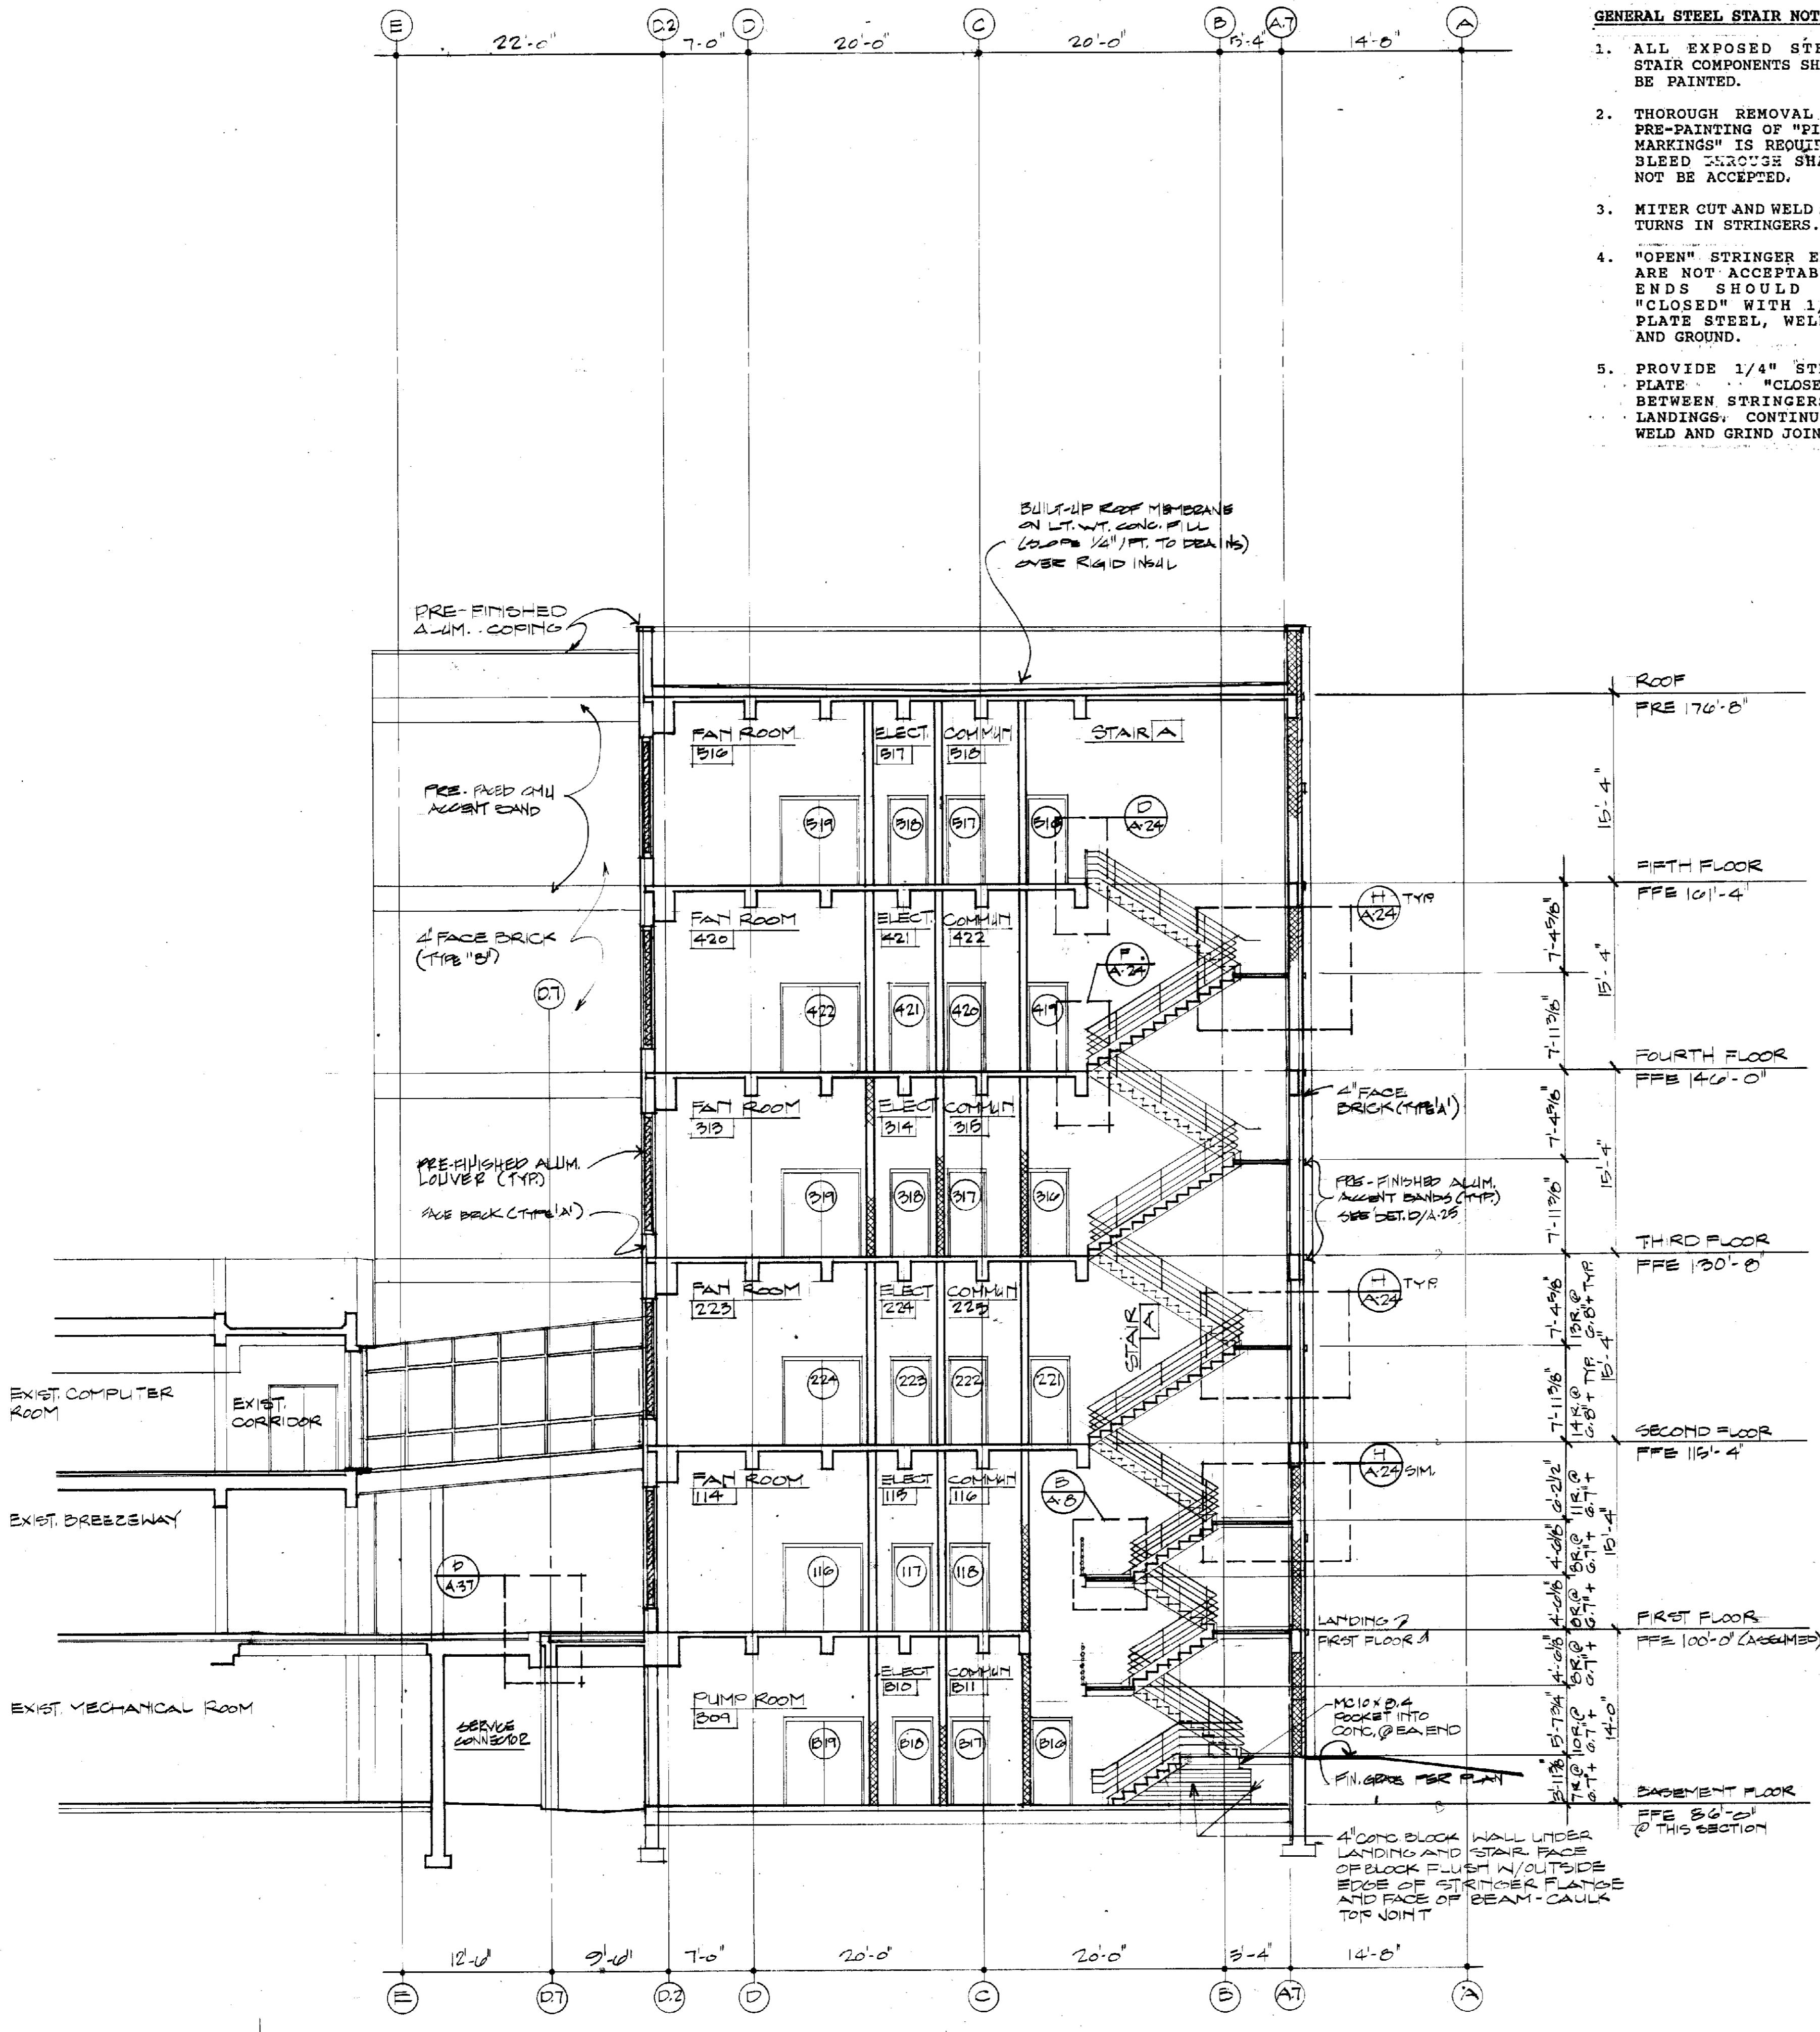

BUILDING SECTION
 1/8" = 1'-0"

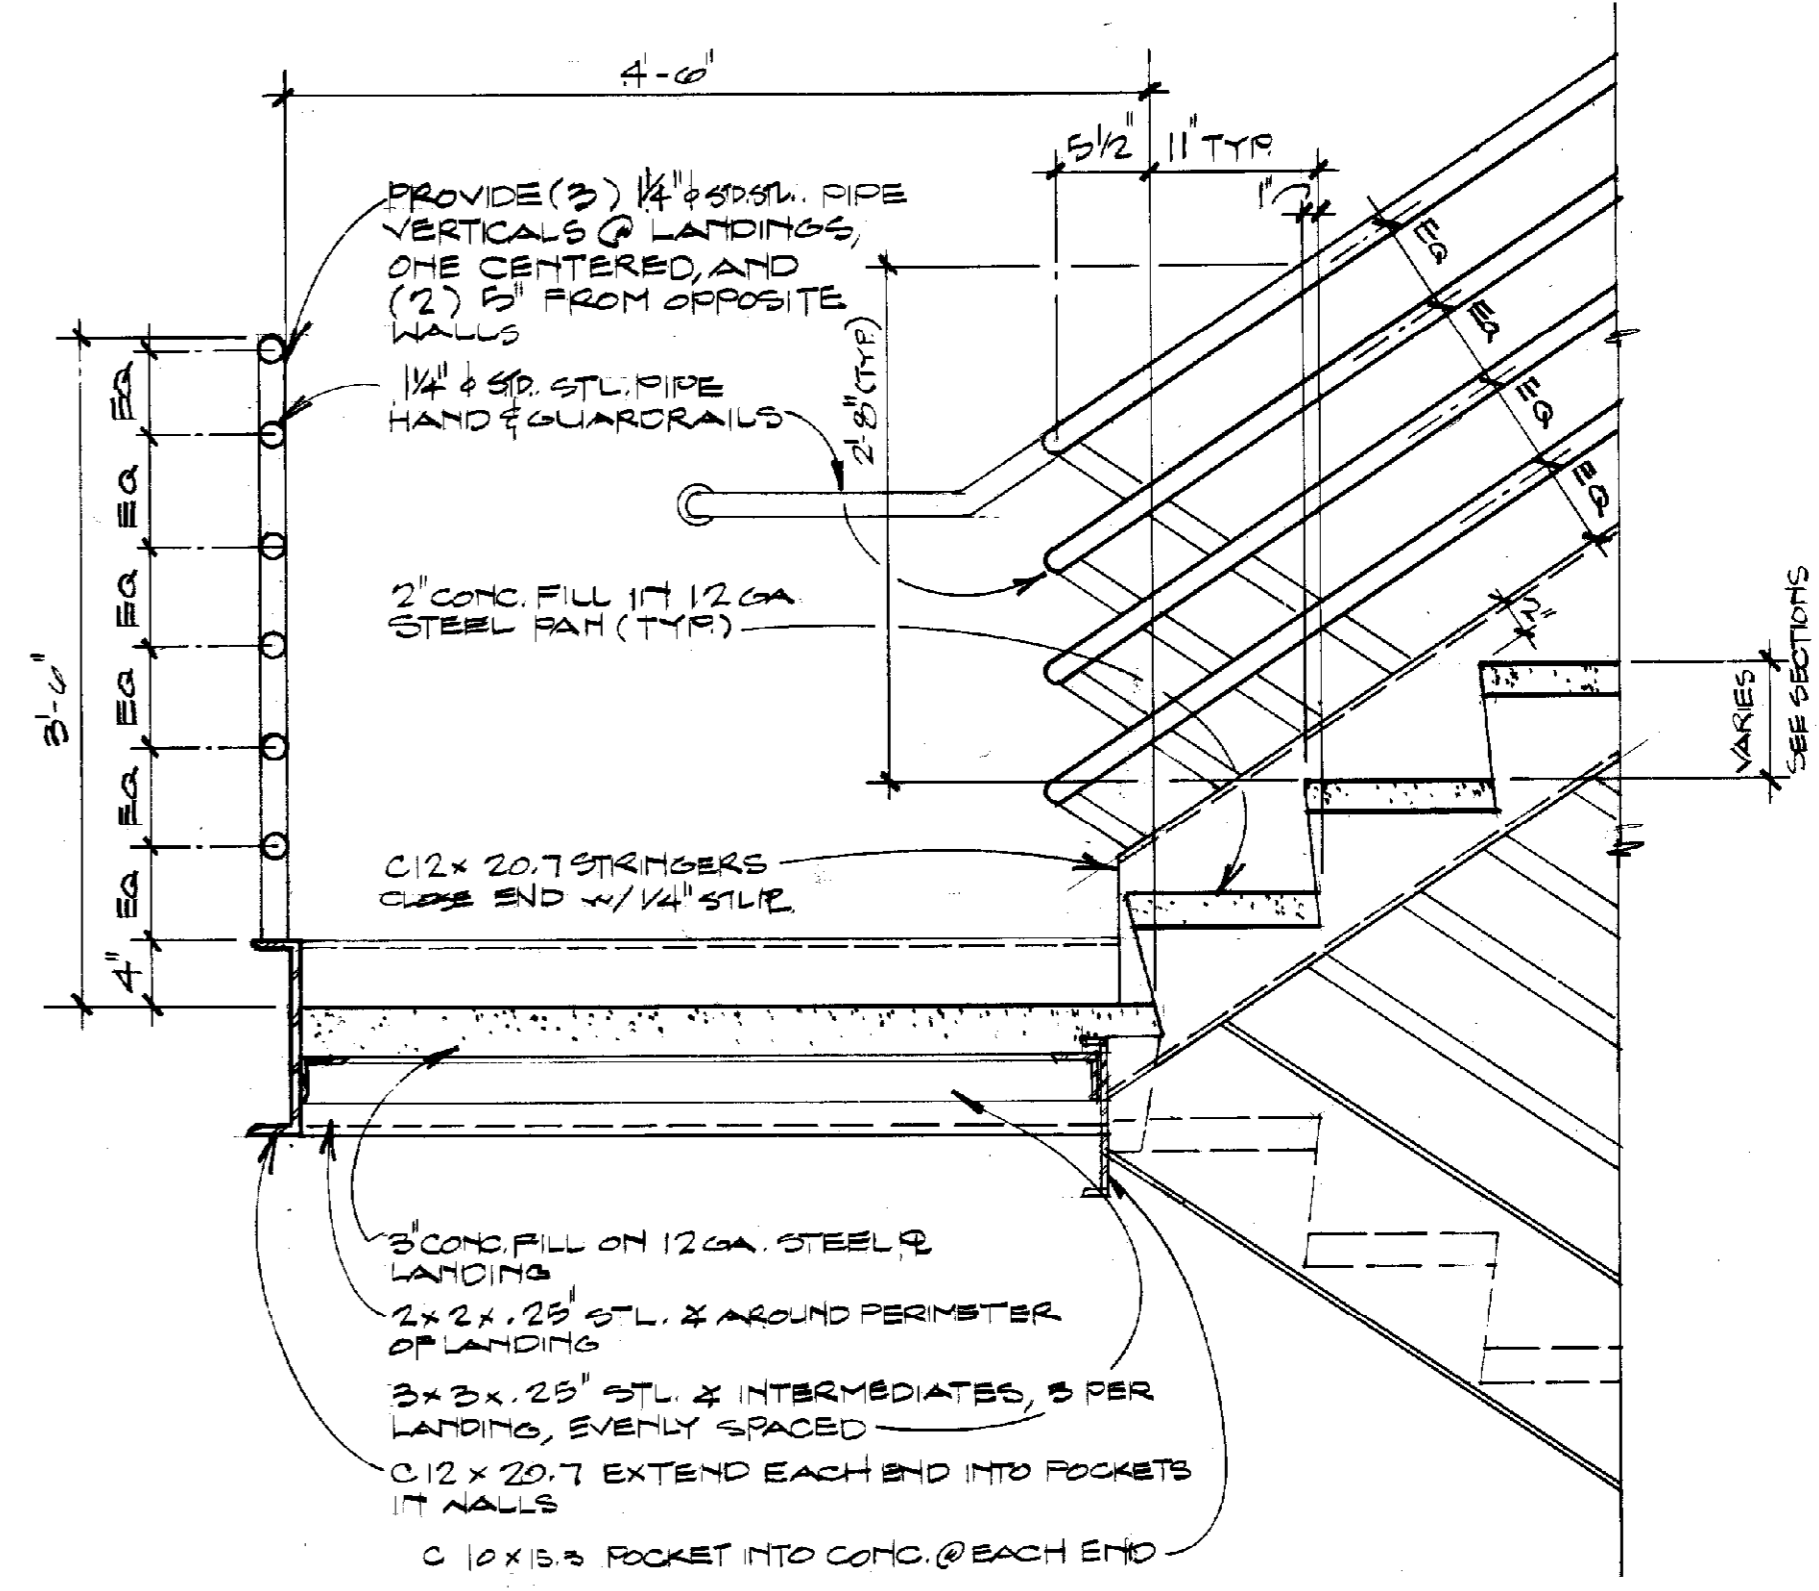


LANDING DETAIL
 1" = 1'-0"

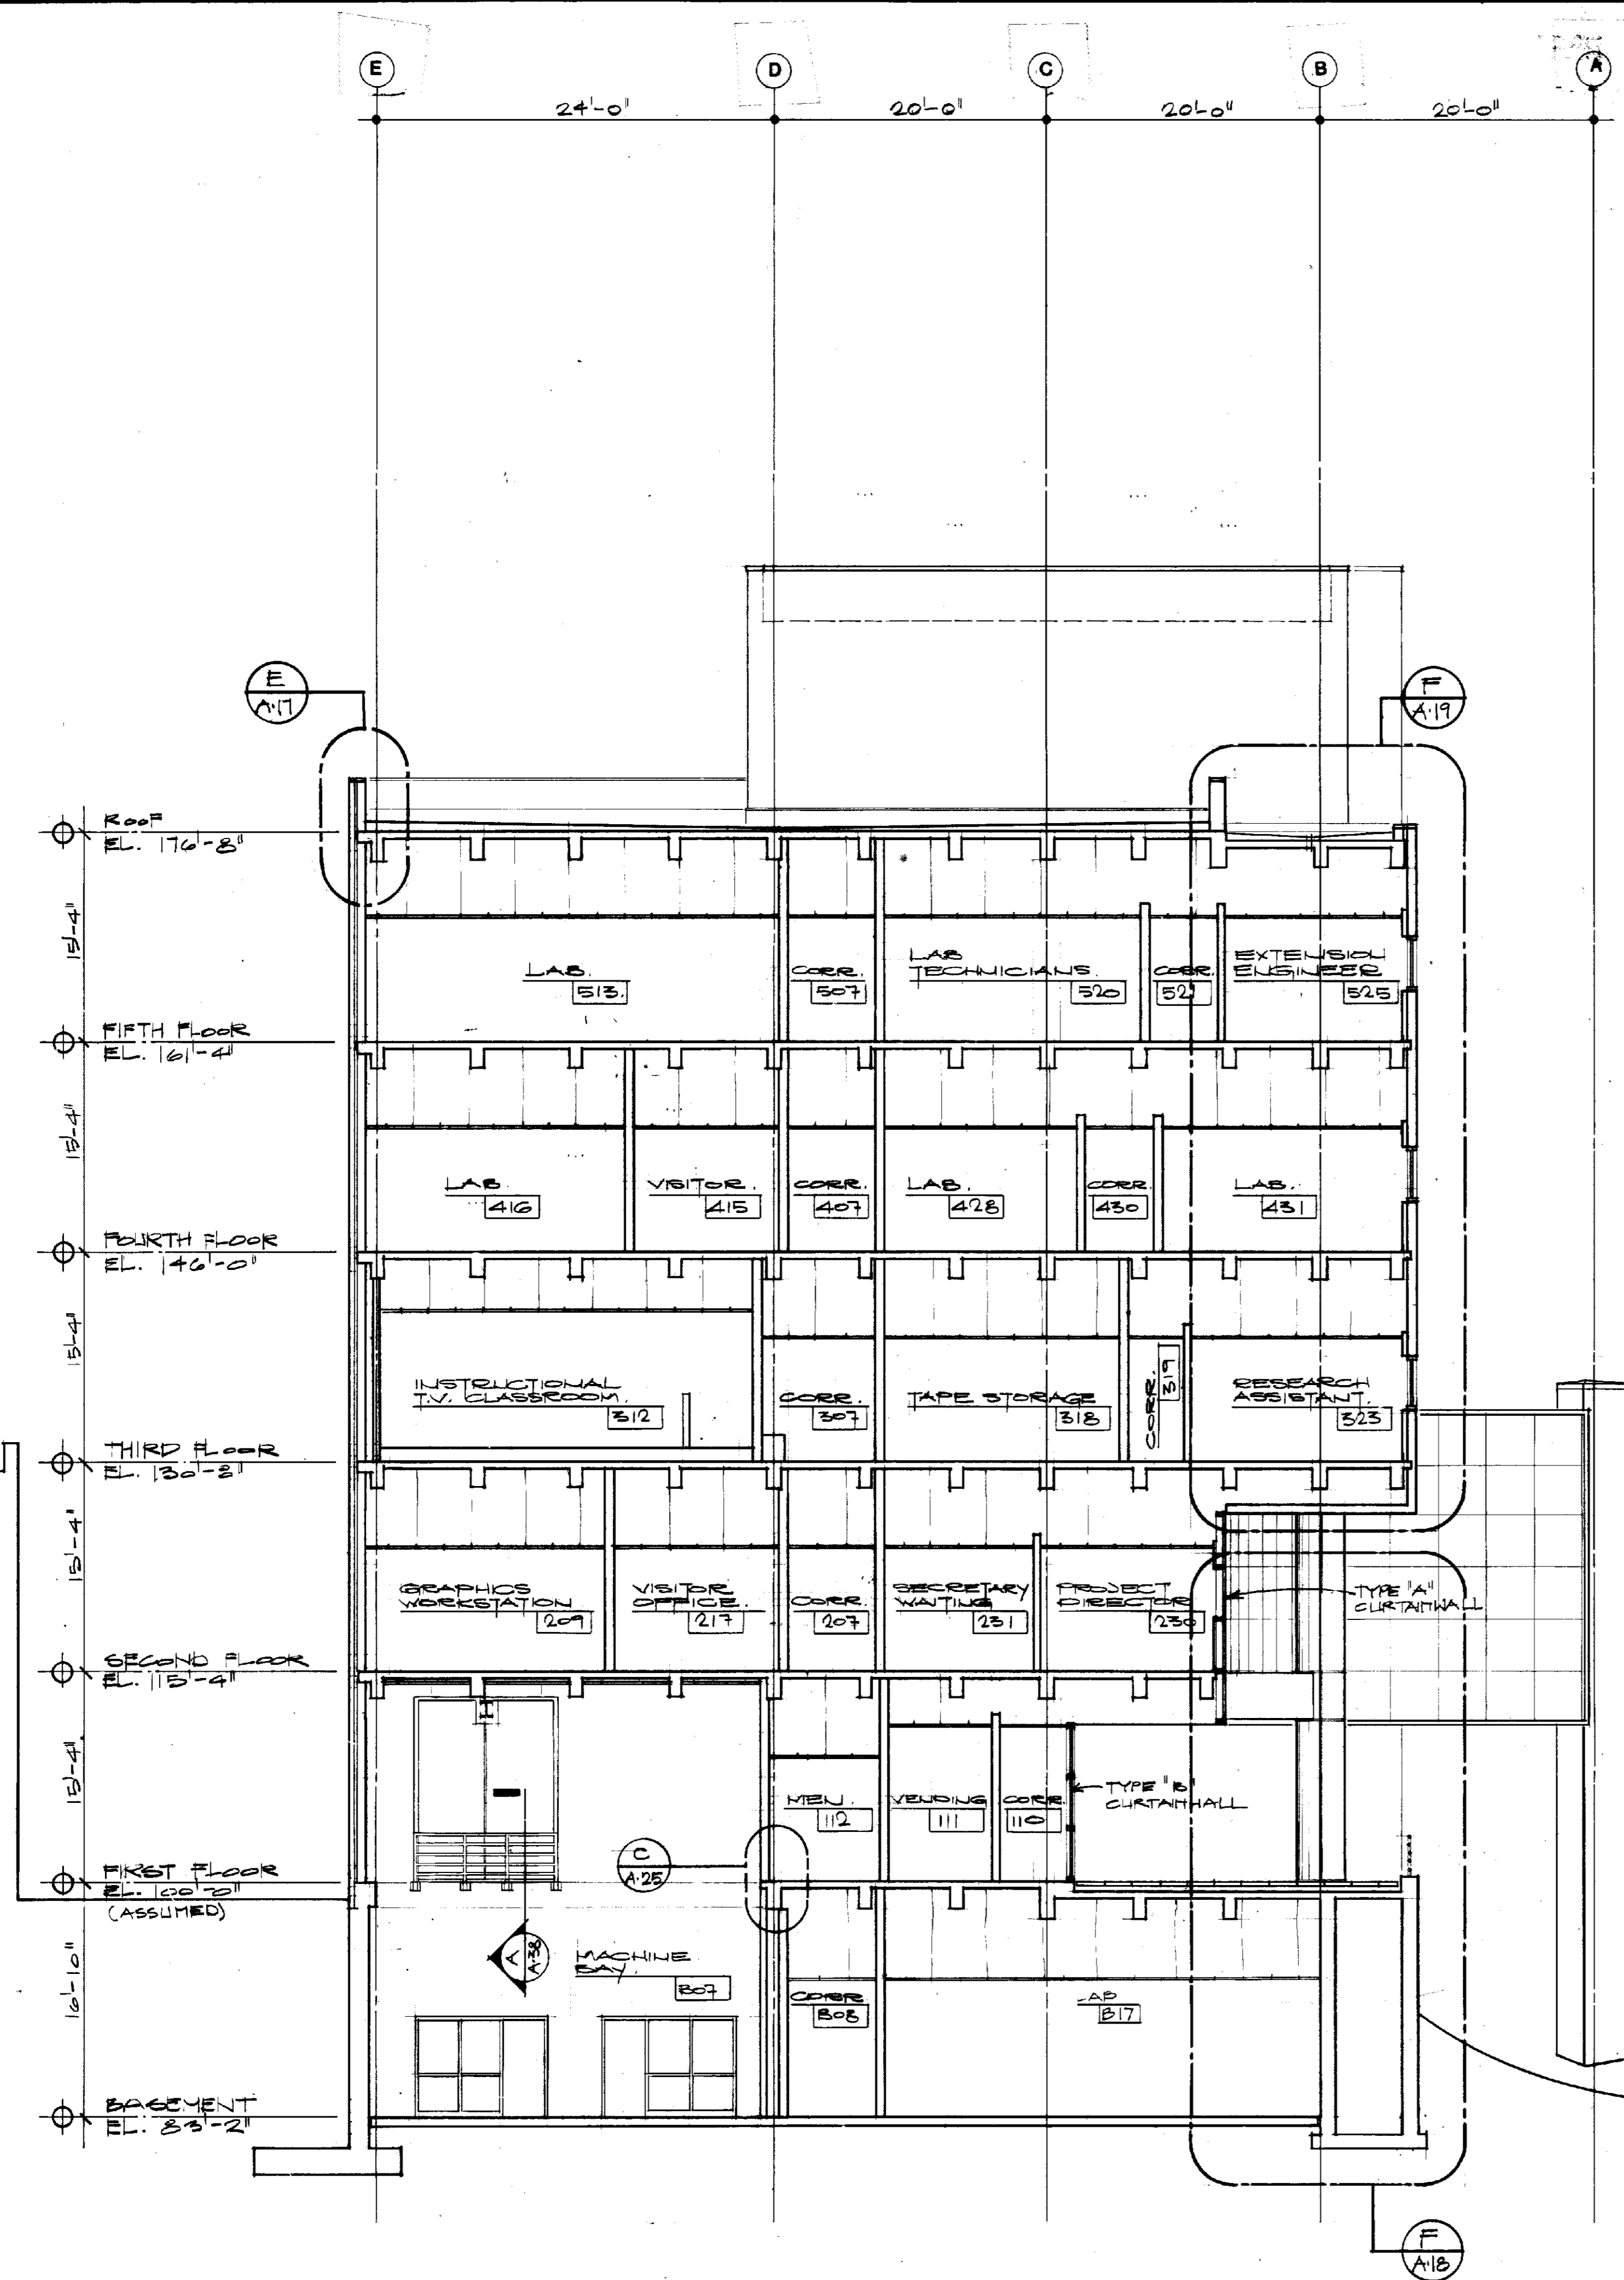

BUILDING SECTION

1/2" = 1'-0"

A
A.9

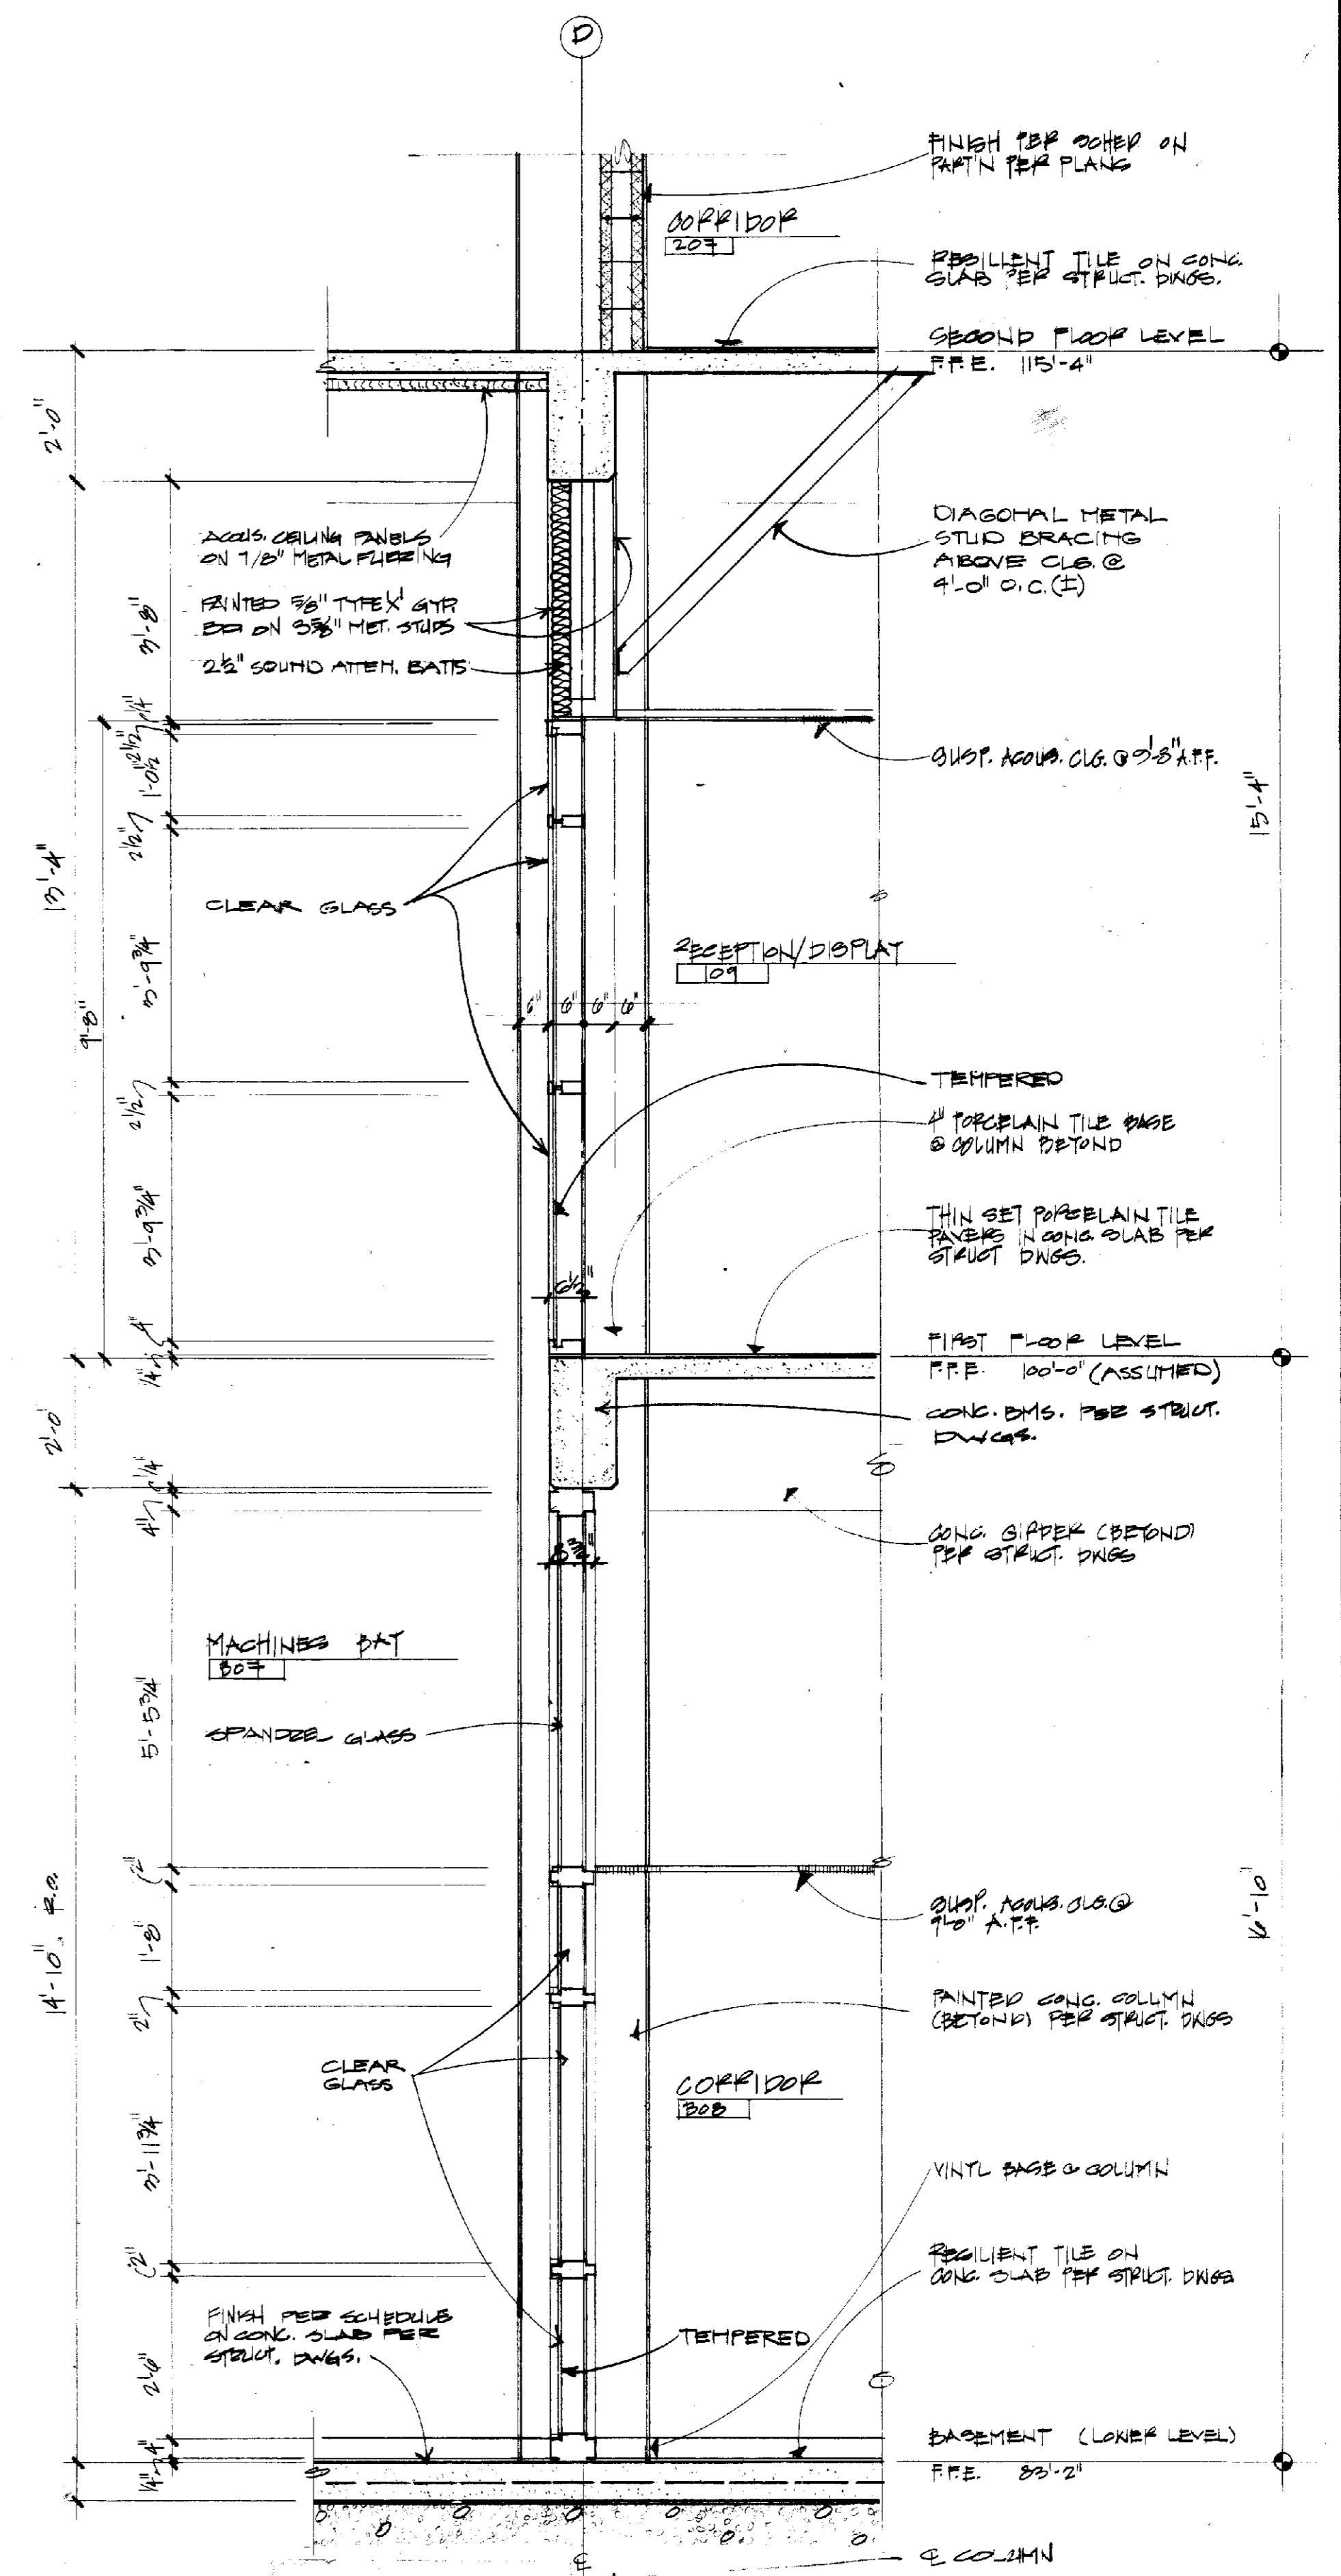

SECTION

1/2" = 1'-0"

B
A.9



ROBOTICS FACILITY
LEXINGTON CAMPUS
UNIVERSITY OF KENTUCKY
LEXINGTON, KENTUCKY


University of Kentucky
Lexington, Kentucky

BUILDING SECTION
Sherman Carter Barnhart
PARTNERS IN ARCHITECTURE
SUITE 1900 • 250 WEST MAIN STREET • LEXINGTON, KY 40507 • 606.254.3357


JOB NO. 8708
DATE 10-1-87
DRAWN STAFF
CHECKED CEB
FILE NO. 431.0

REVISIONS


SHEET
A.9
C-1
004892

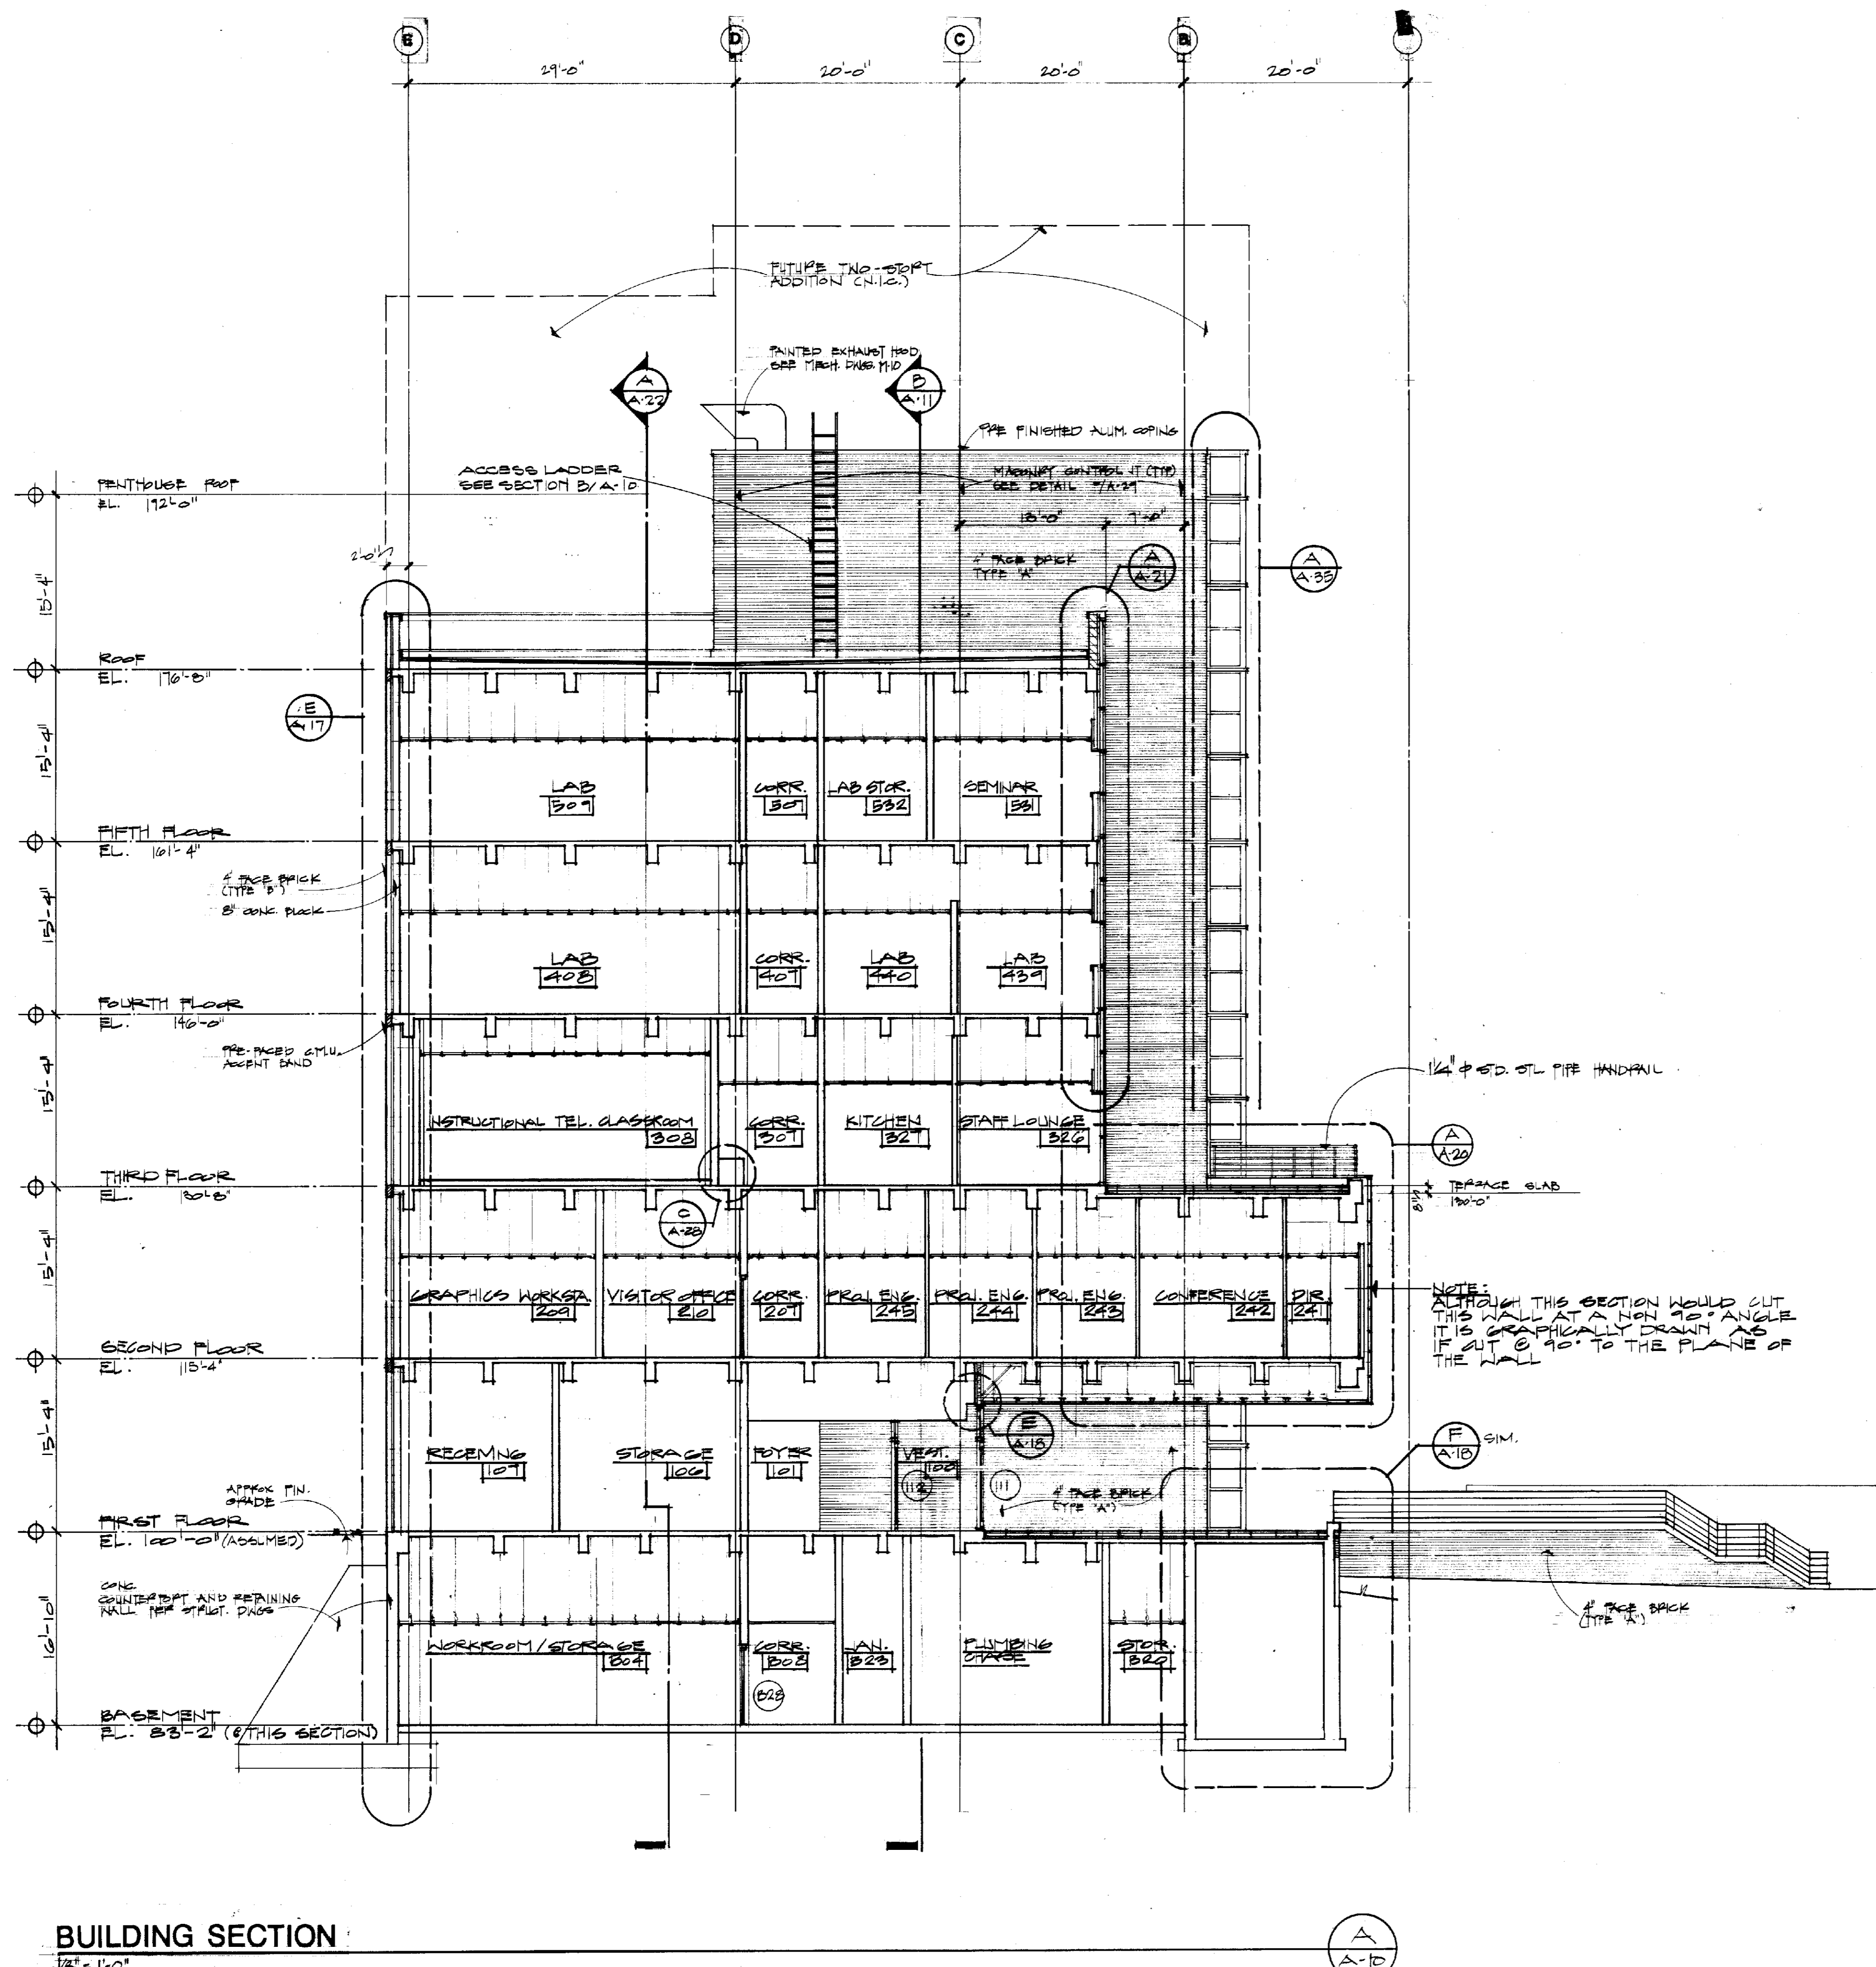


BUILDING SECTION
1/8" = 1'-0"

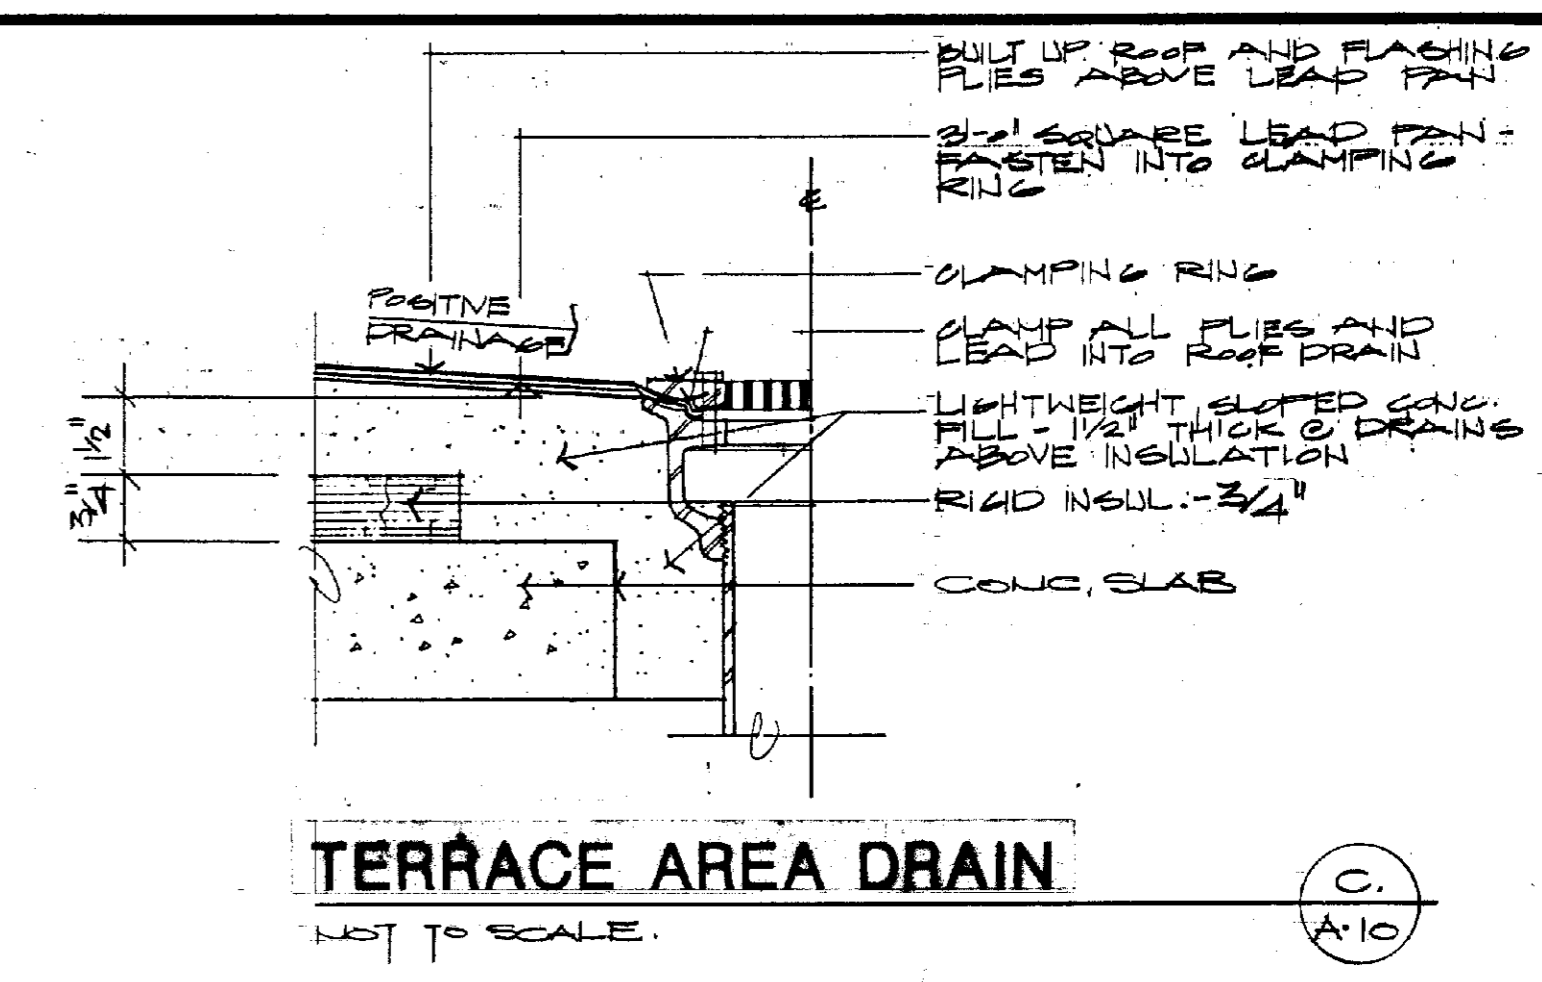

TERRACE AREA DRAIN
NOT TO SCALE

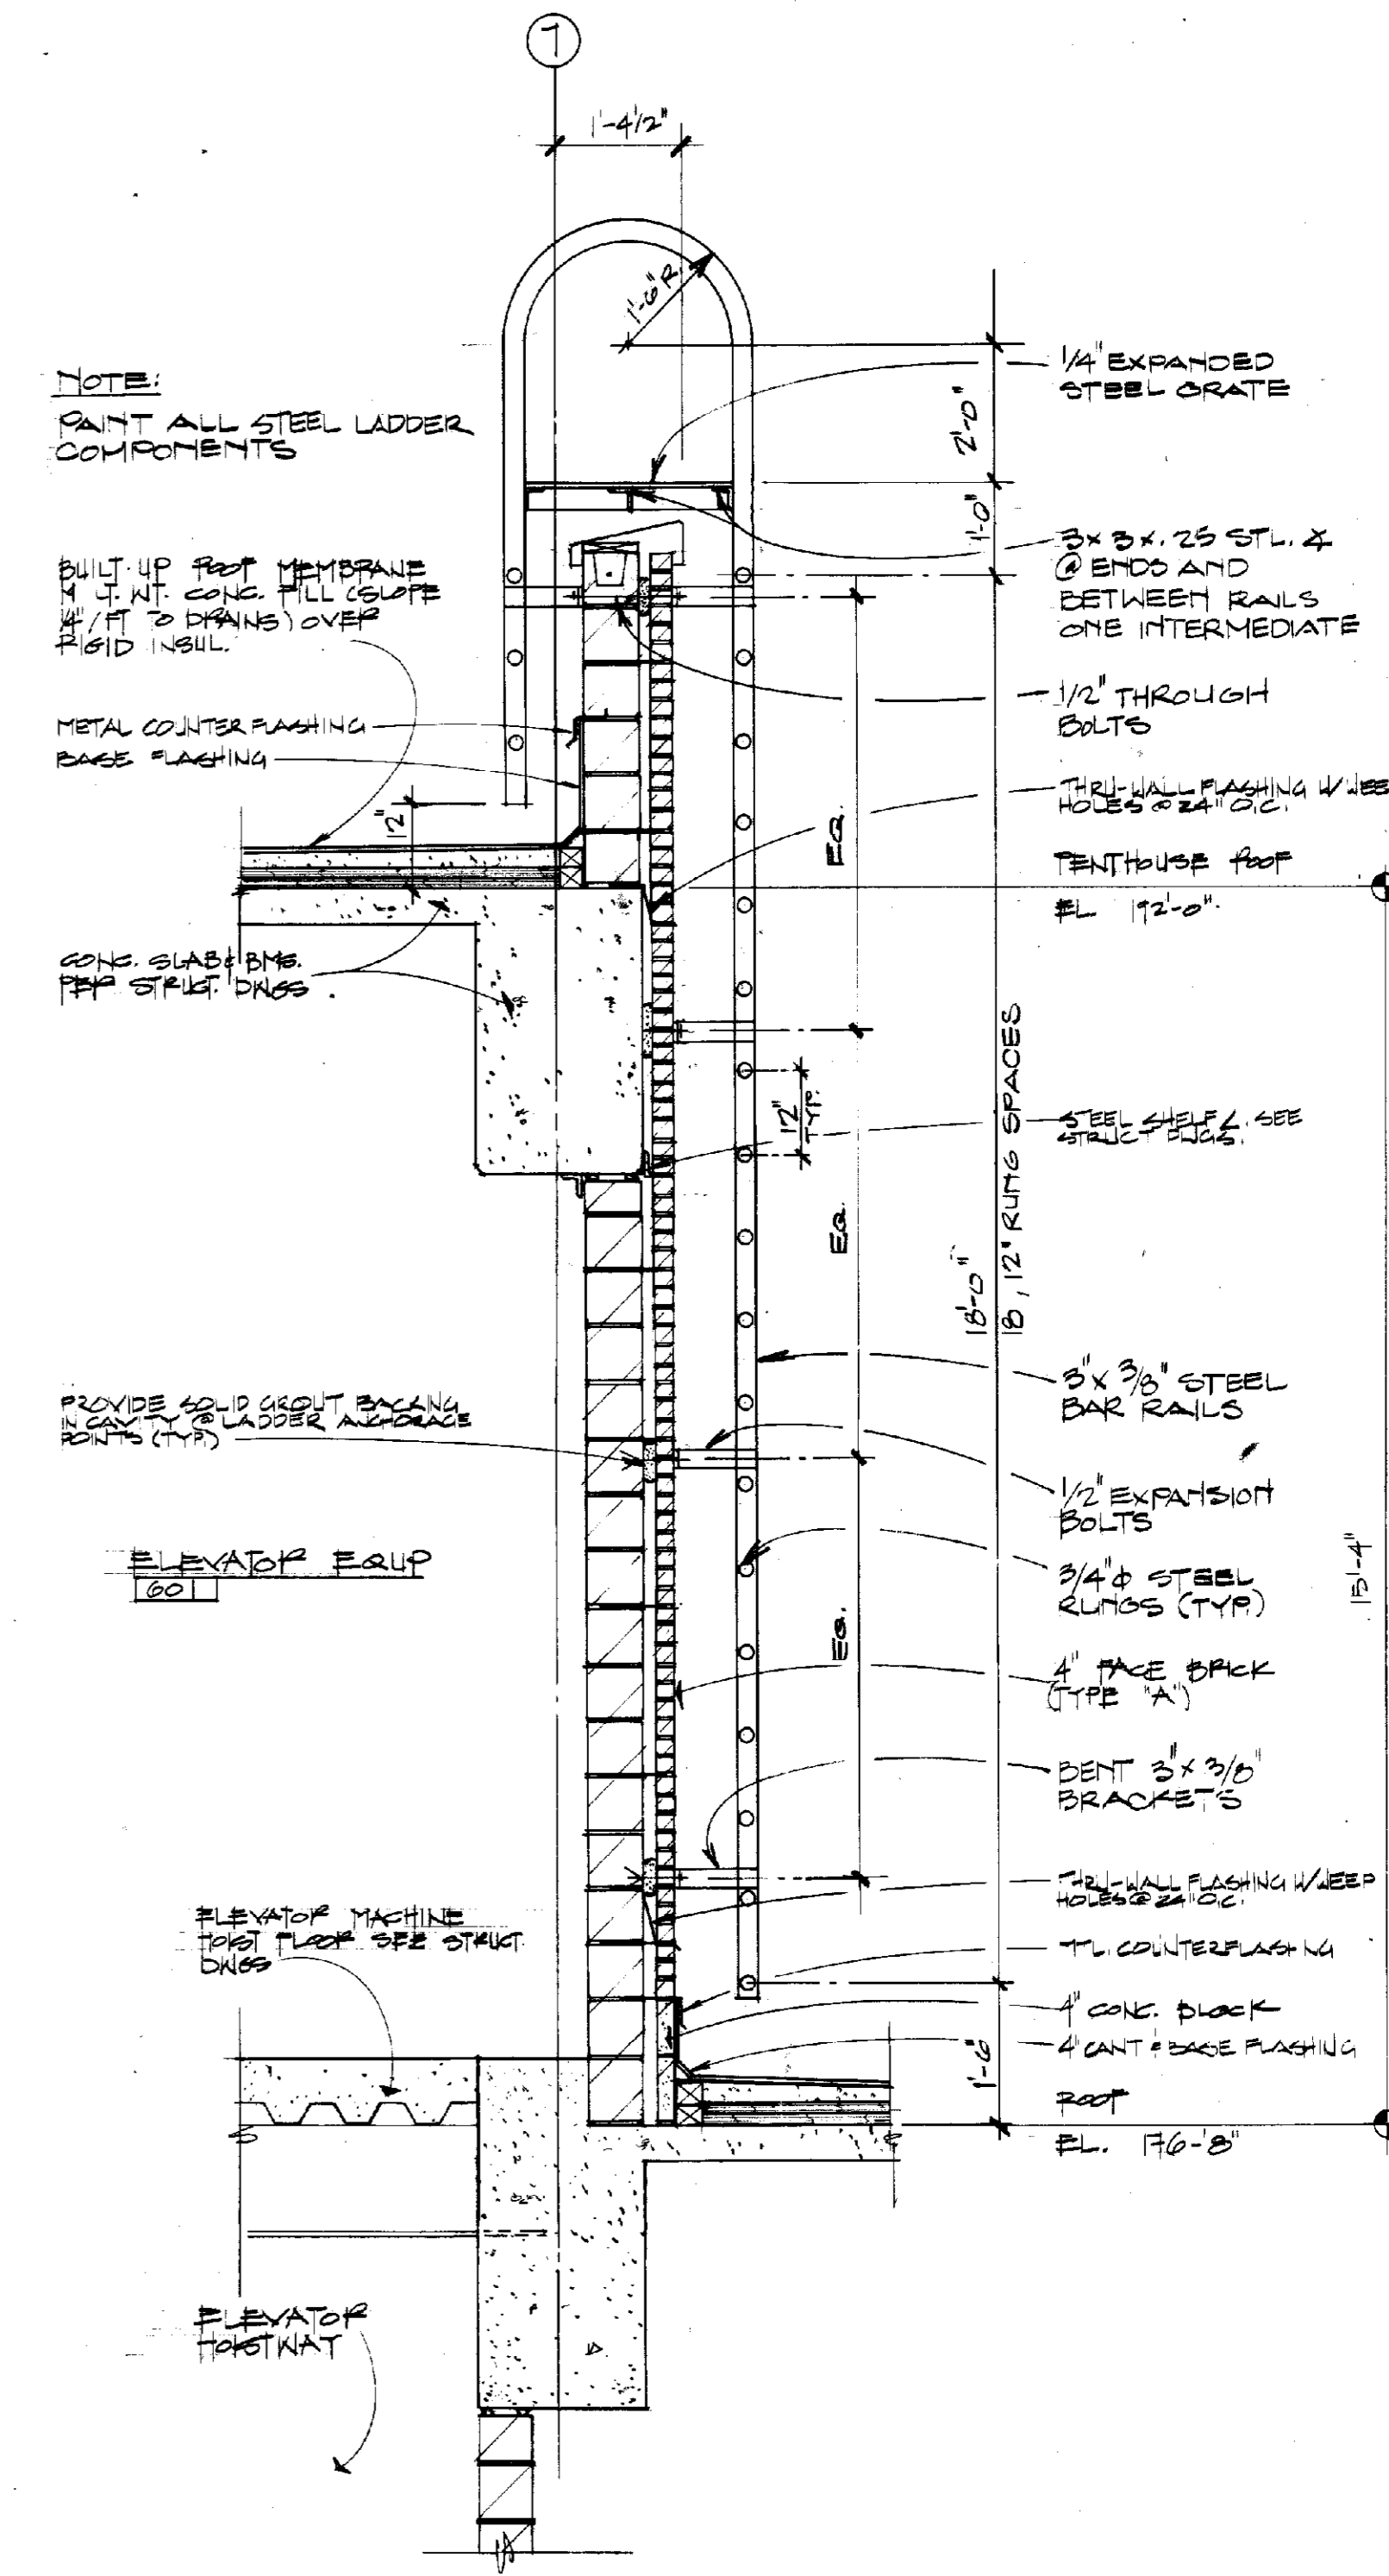

LADDER SECTION
1/2" = 1'-0"

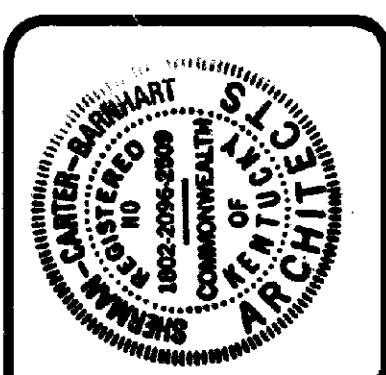

ROBOTICS FACILITY
LEXINGTON CAMPUS
UNIVERSITY OF KENTUCKY
LEXINGTON, KENTUCKY


University of Kentucky
Lexington, Kentucky
10-1-87
SHERMAN CARTER BARNHART
ARCHITECTS

BUILDING SECTION
Sherman Carter Barnhart
PARTNERS IN ARCHITECTURE
SUITE 1900 • 250 WEST MAIN STREET • LEXINGTON, KY 40507 • 606-254-1910

JOB NO. 8708
DATE 10-1-87
DRAWN STAFF
CHECKED CEB
FILE NO. 431.0

REVISIONS

SHEET
A-10
C-1

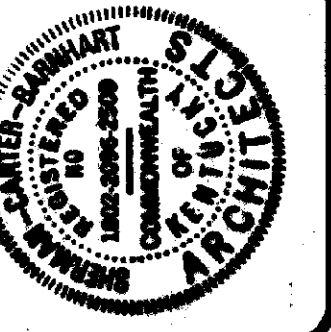

ROBOTICS FACILITY
 LEXINGTON CAMPUS
 UNIVERSITY OF KENTUCKY
 LEXINGTON, KENTUCKY

University of Kentucky
 Lexington, Kentucky

Wendell ...
 ARCHITECT


SOUTH ELEVATION

Sherman Carter Barnhart
 PARTNERS IN ARCHITECTURE
 LEXINGTON FINANCIAL CENTER, SUITE 900 - 250 W. MAIN - LEXINGTON, KY 40501 - (606) 254-1851

JOB NO.	0700
DATE	10-1-87
DRAWN	TUNE
CHECKED	CEB
FILE NO.	4810


REVISIONS

SHEET
A-13
 C-1

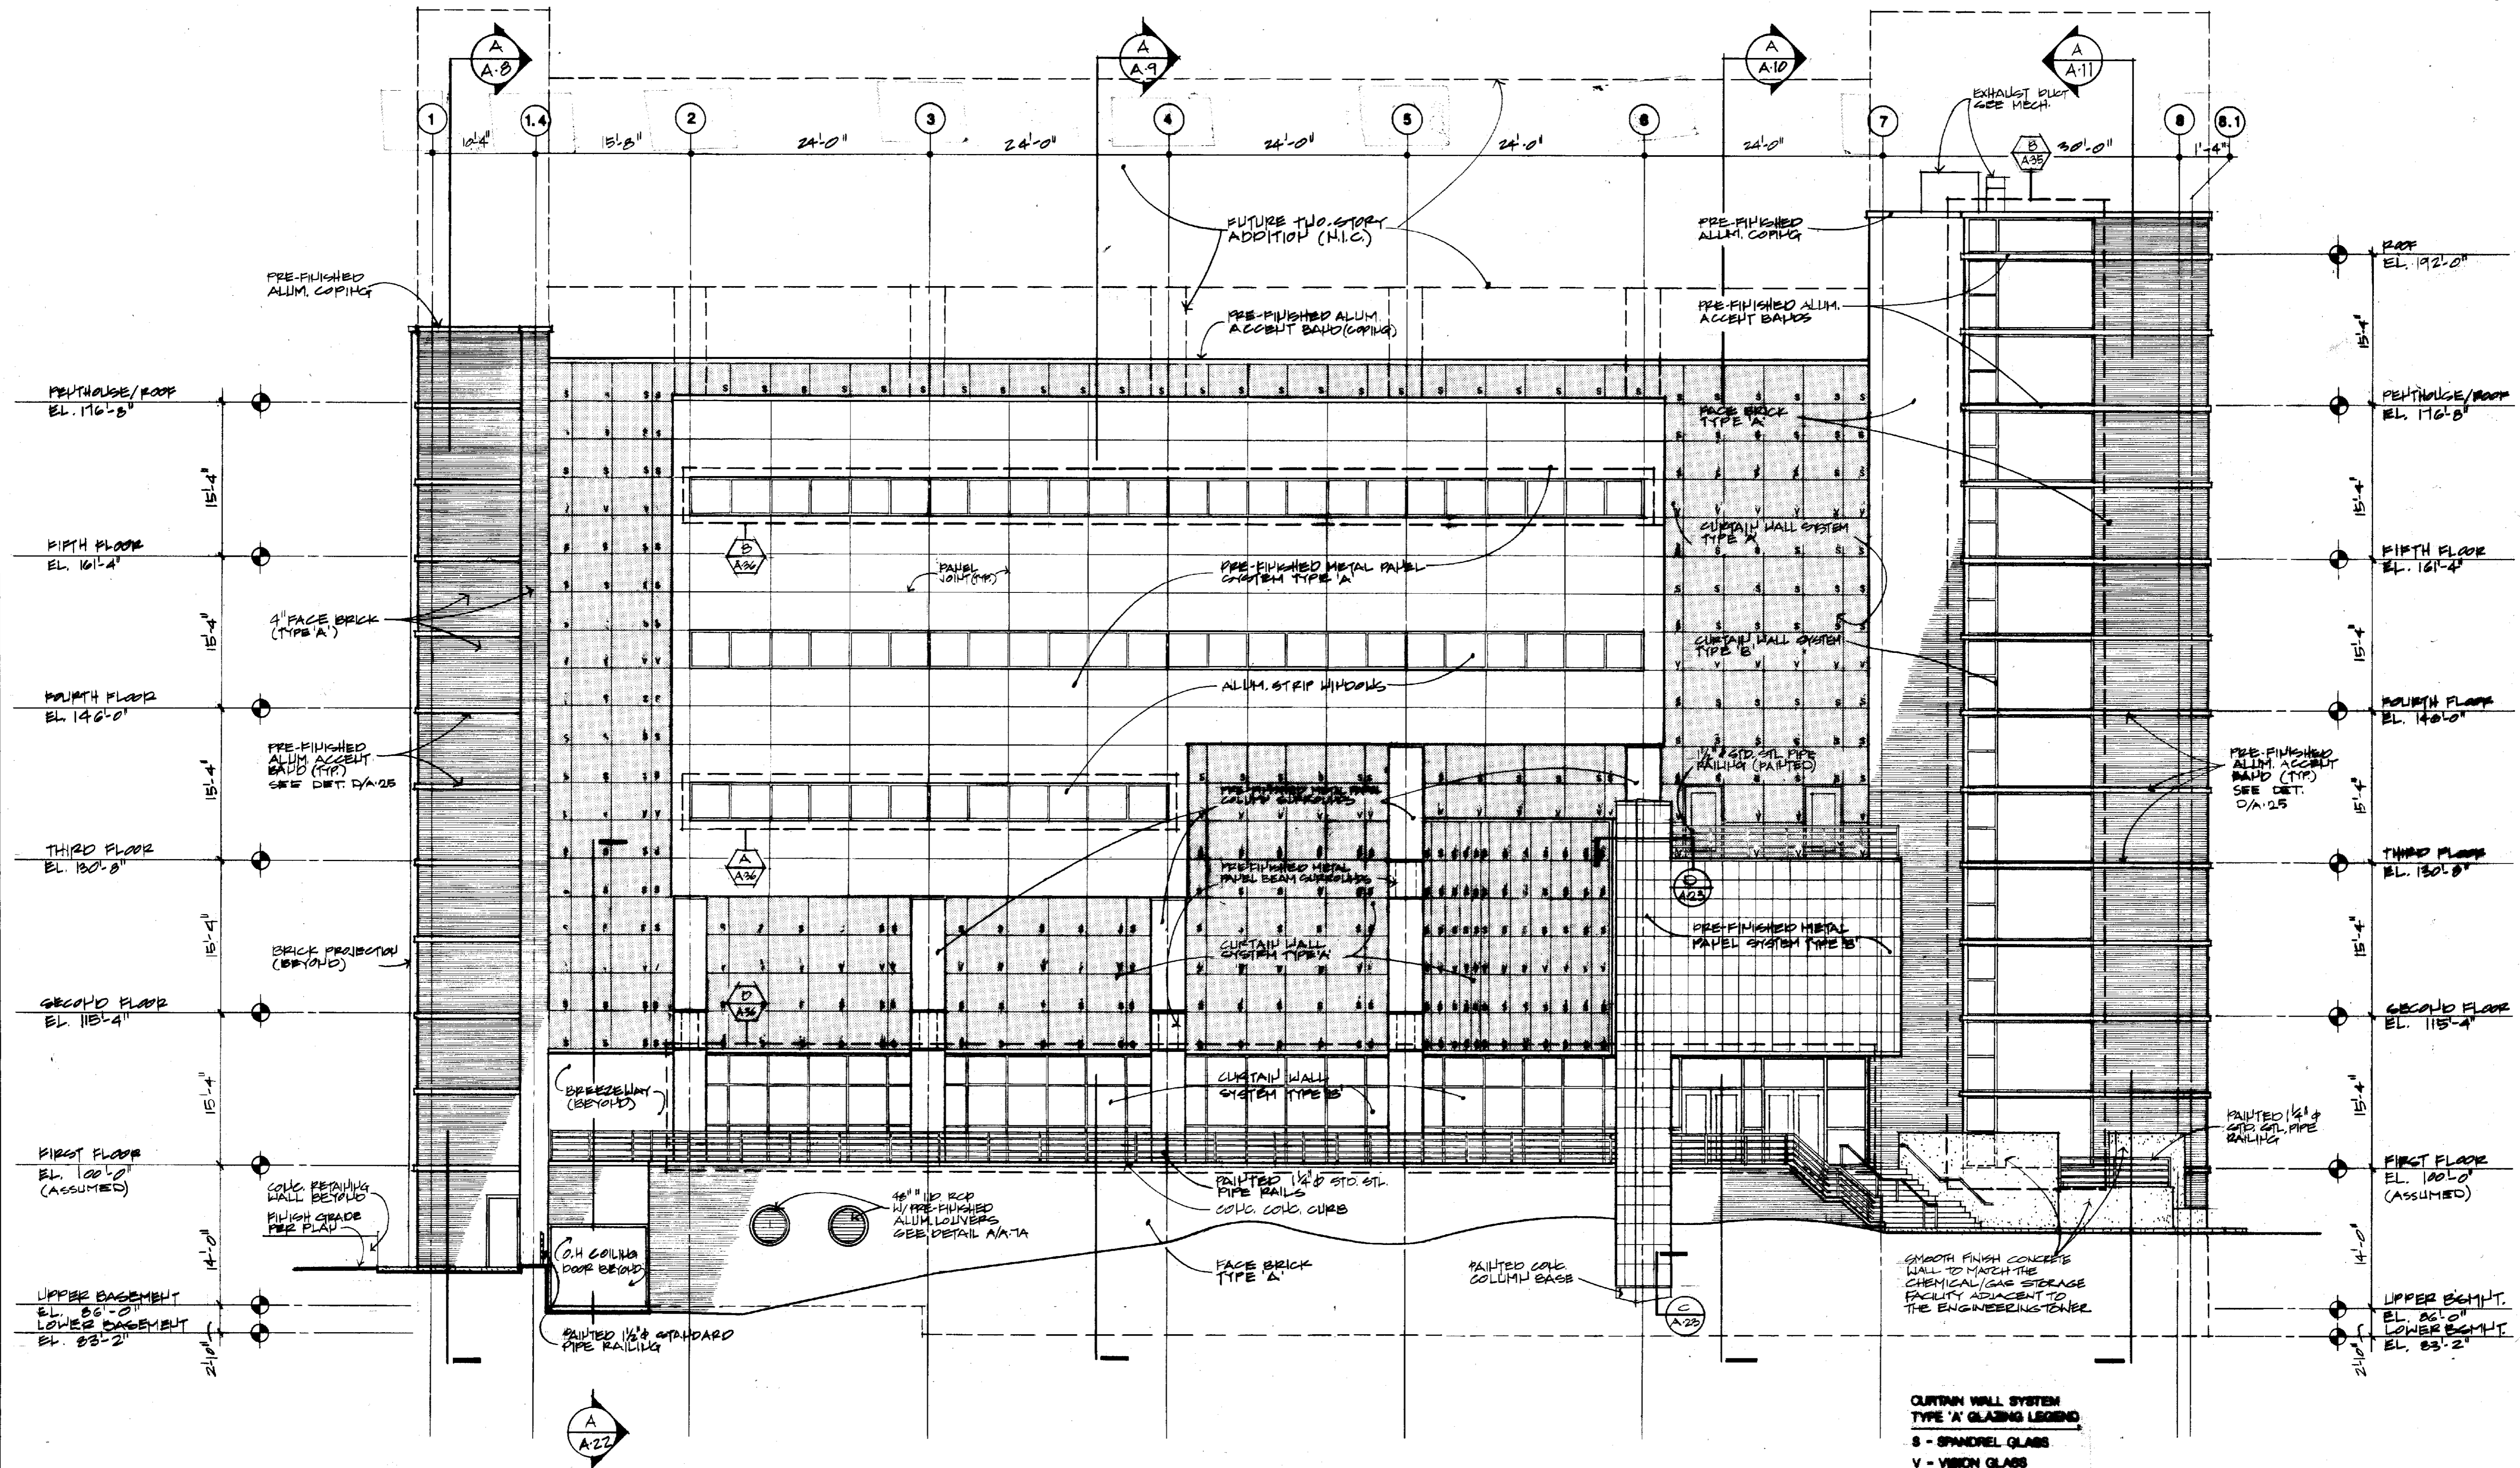

SOUTH ELEVATION
 1/8" = 1'-0"

CURTAIN WALL SYSTEM TYPE 'A' GLAZING LEGEND
 S - SPANDREL GLASS
 V - VISION GLASS

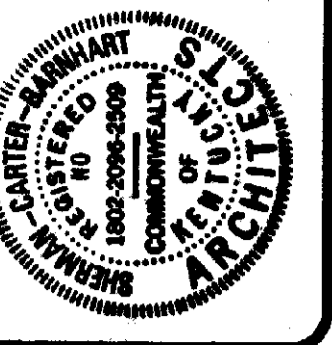

ROBOTICS FACILITY
 LEXINGTON CAMPUS
 UNIVERSITY OF KENTUCKY
 LEXINGTON, KENTUCKY

University of Kentucky
 Lexington, Kentucky

10-19-87

Sherman Carter
 ARCHITECT

WEST ELEVATION

Sherman Carter
 PARTNERS IN ARCHITECTURE
 LEXINGTON FINANCIAL CENTER, SUITE 1900 - 250 W. MAIN - LEXINGTON, KY 40507 - 606-254-1351

JOB NO.	8706
DATE	10-1-87
DRAWN	TUNE
CHECKED	CEB
FILE NO.	431.0


REVISIONS
Δ AS BUILT 2/18/91

SHEET

A-14

UNIVERSITY OF KENTUCKY
CENTER FOR ROBOTICS AND MANUFACTURING SYSTEMS

BUILDING SIGN
 SCALE: 3/8" = 1'-0"

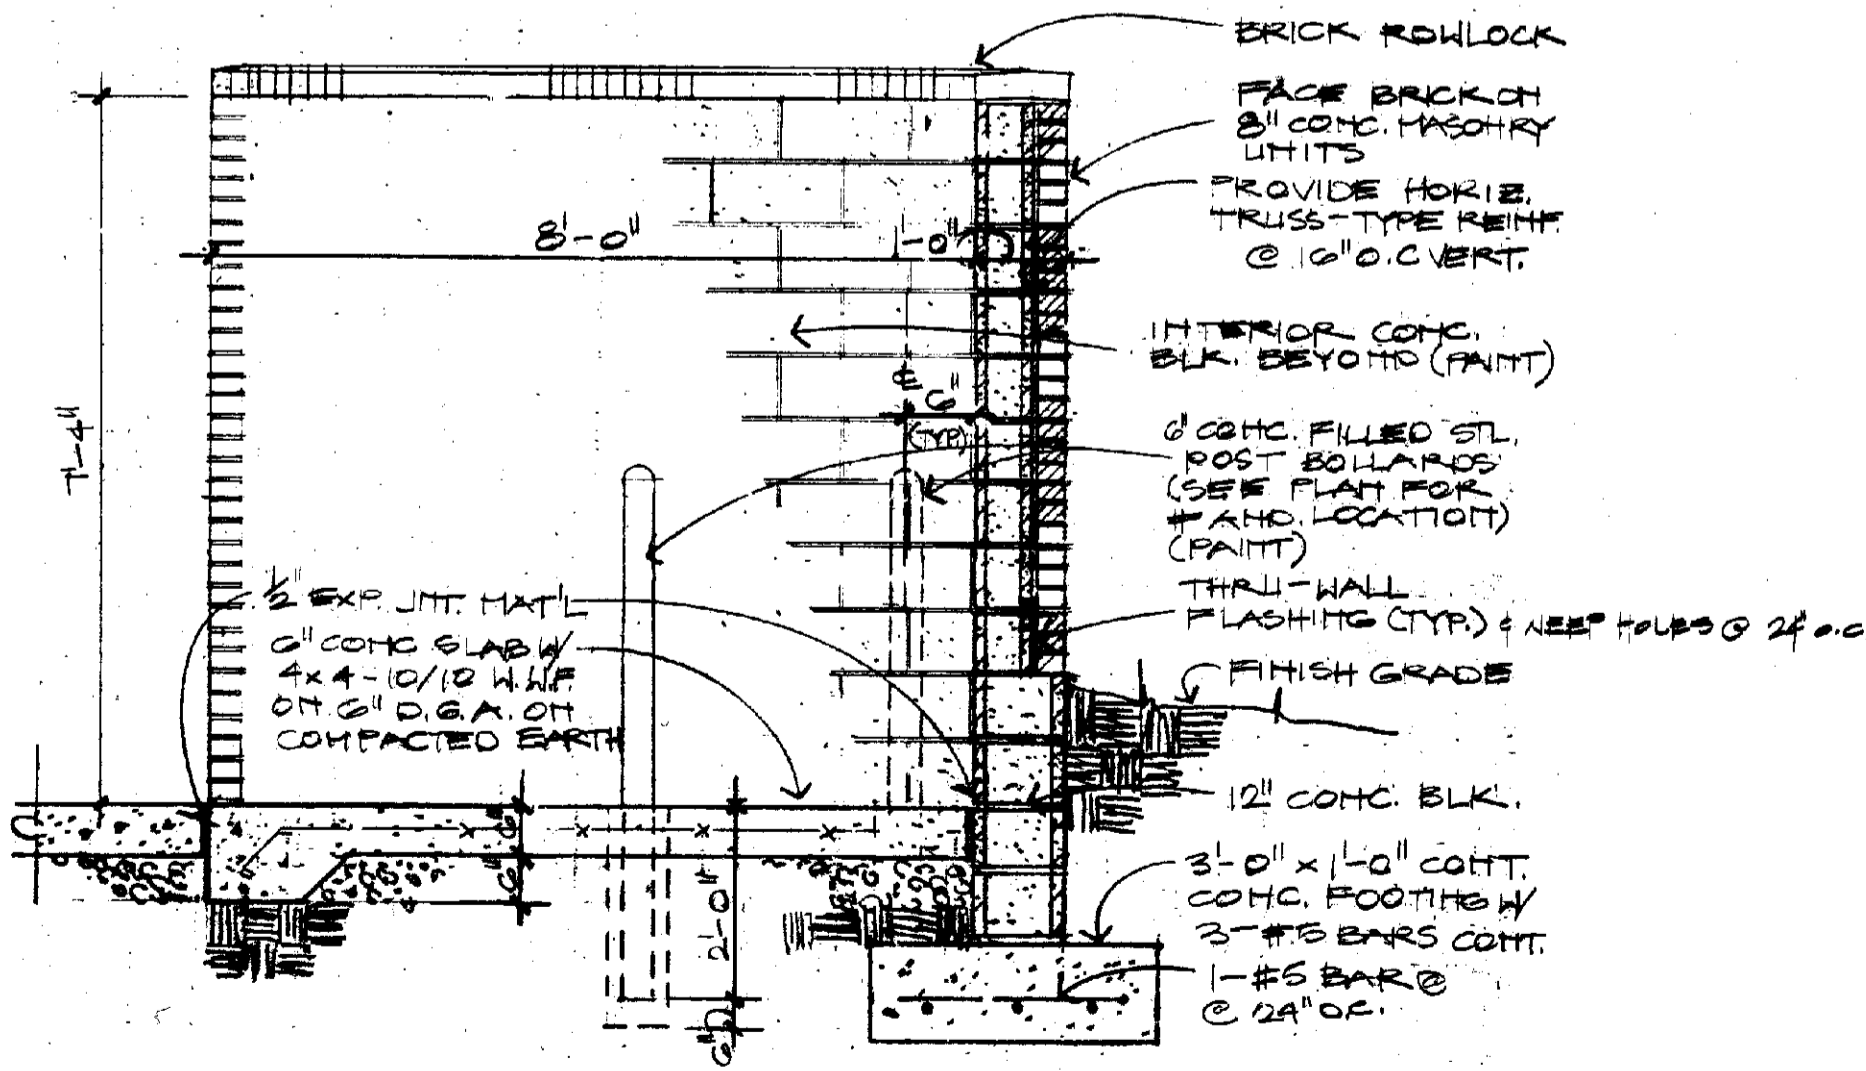



DETAIL
 1/2" = 1'-0"

A-14

WEST ELEVATION

1/8" = 1'-0"

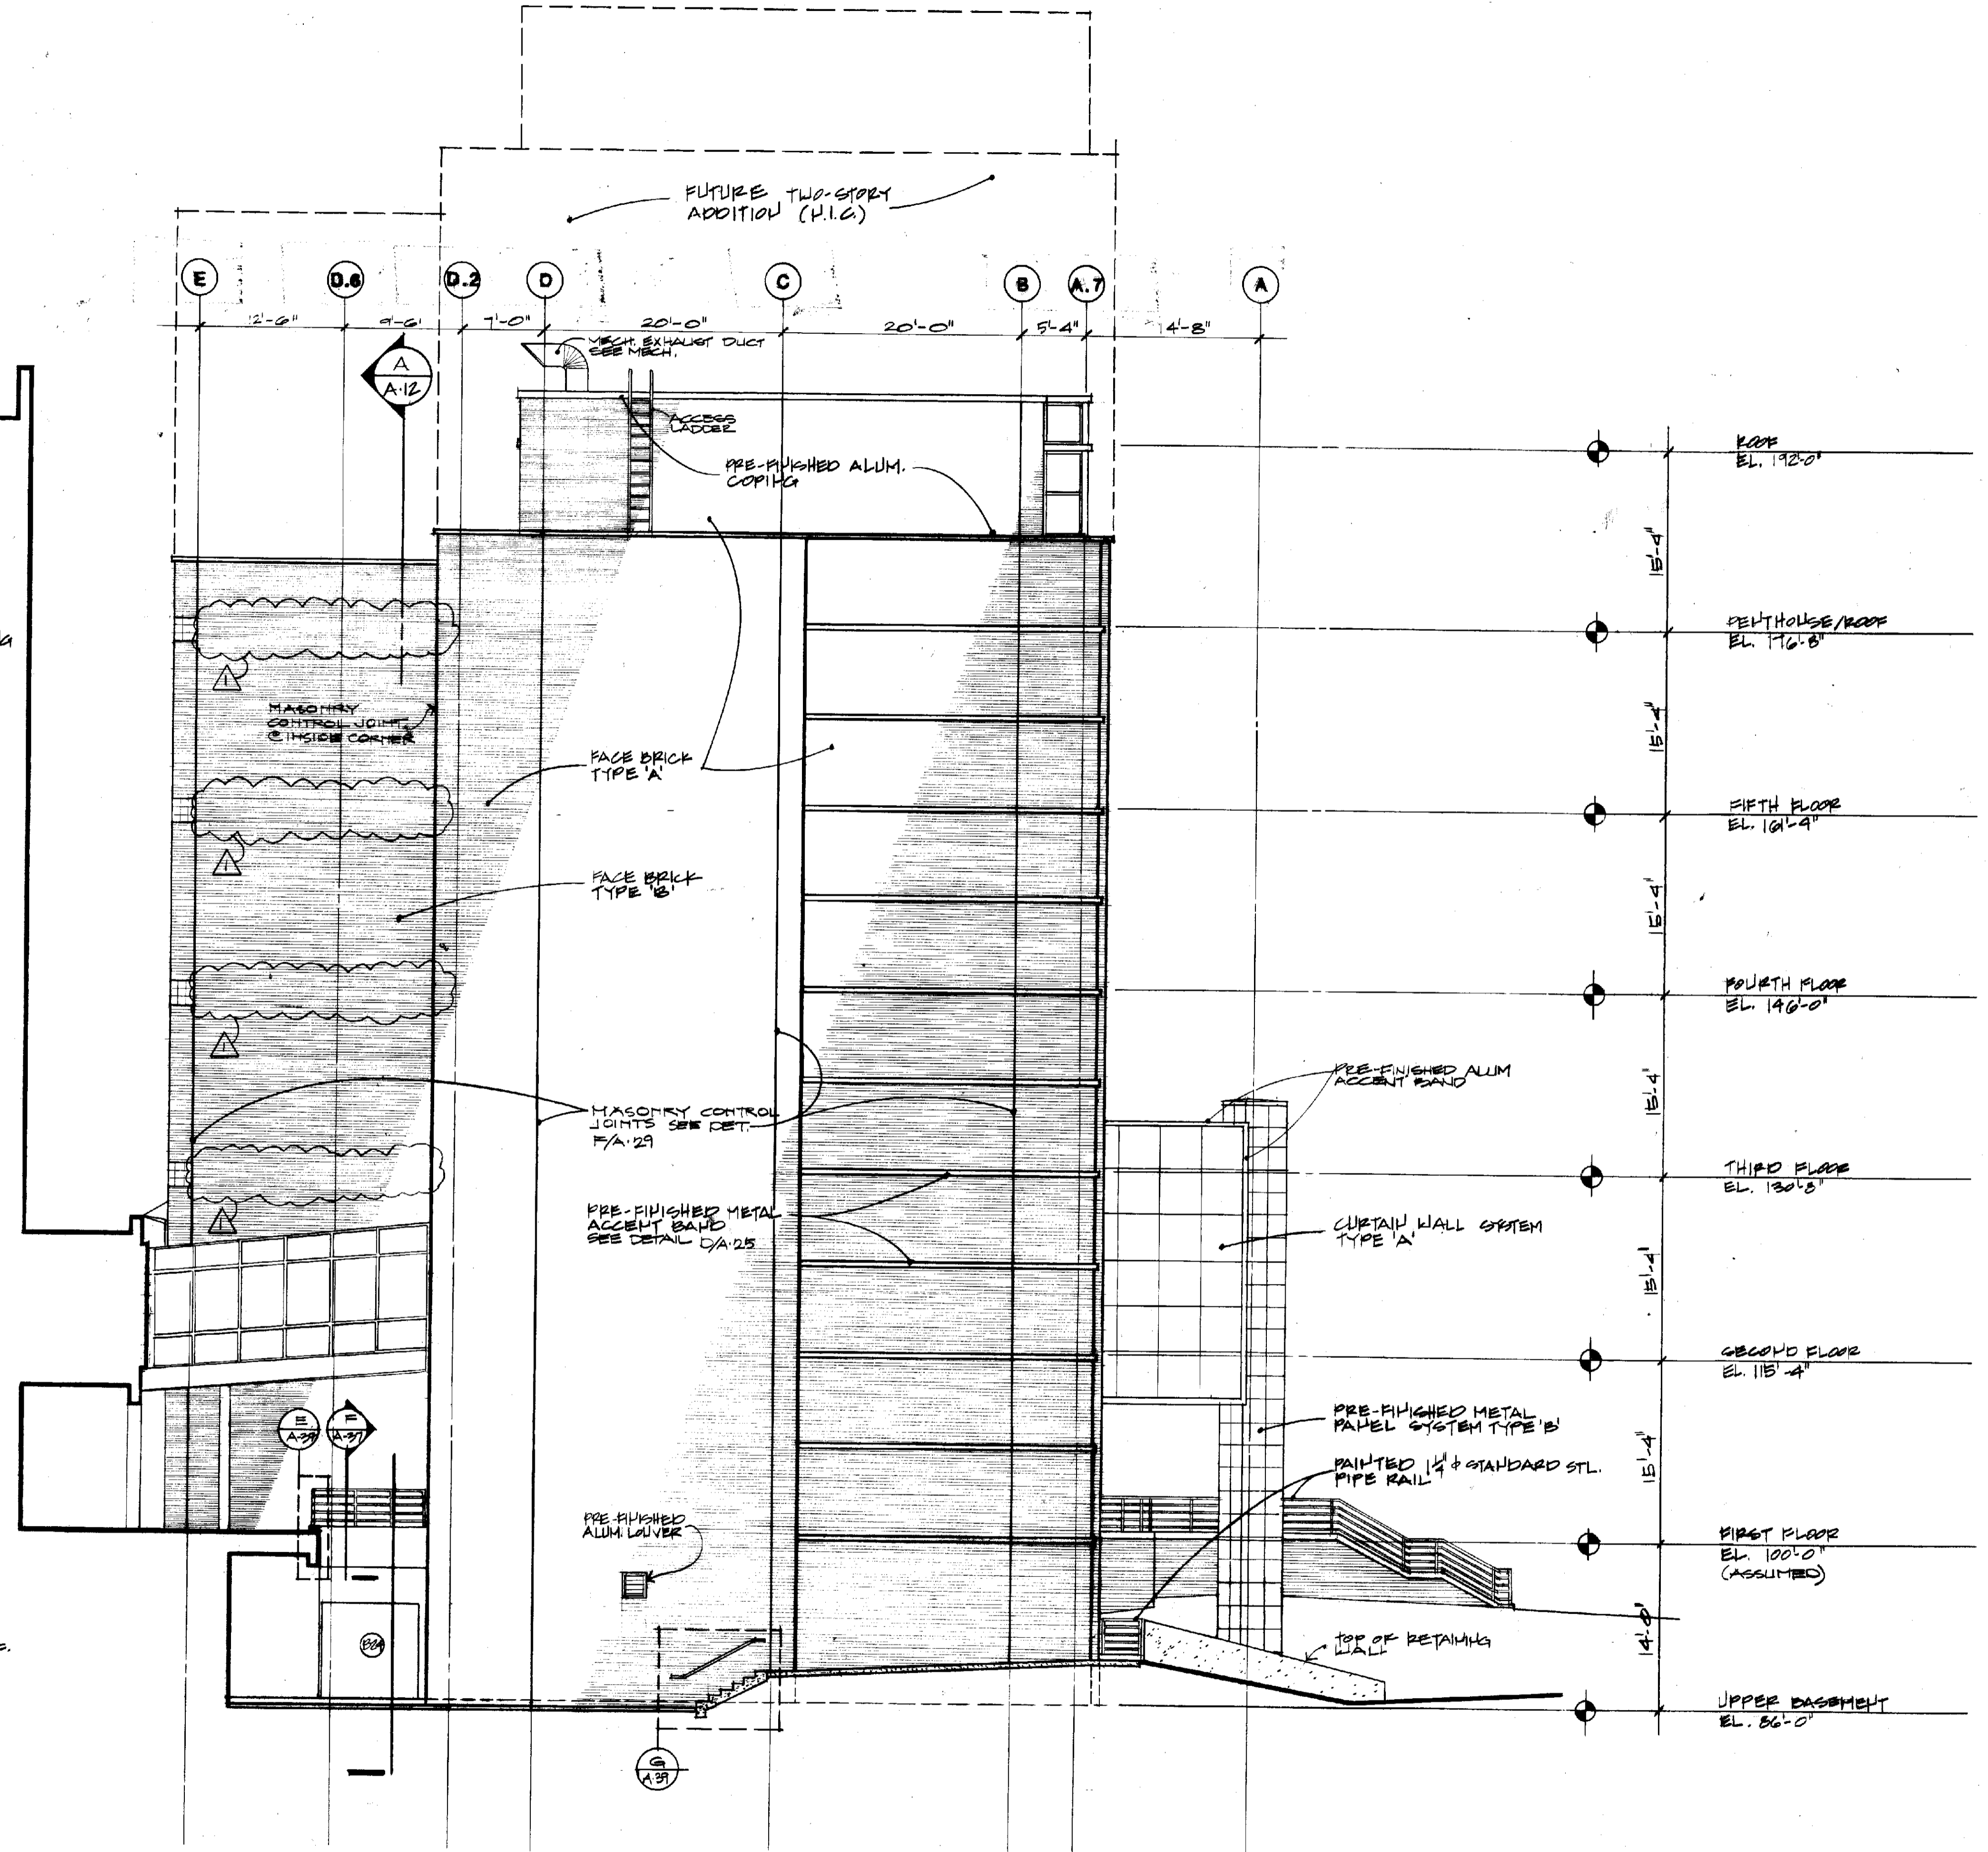

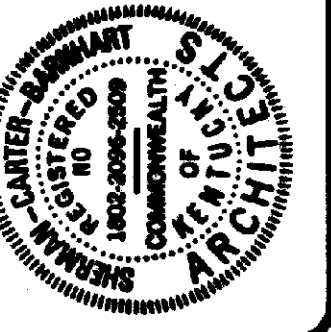

ROBOTICS FACILITY
 LEXINGTON CAMPUS,
 UNIVERSITY OF KENTUCKY
 LEXINGTON, KENTUCKY

University of Kentucky
 Lexington, Kentucky


North Elevation
Sherman Carter-Barnhart
 PARTNERS IN ARCHITECTURE
 LEXINGTON FINANCIAL CENTER, SUITE 1900 - 250 W. MAIN - LEXINGTON, KY 40507 - (606) 254-1851

JOB NO. 8708
 DATE 10-1-87
 DRAWN TUNE
 CHECKED CEB
 FILE NO. 431.0

REVISIONS
 1. AS BUILT 2/18/91

SHEET

A•15

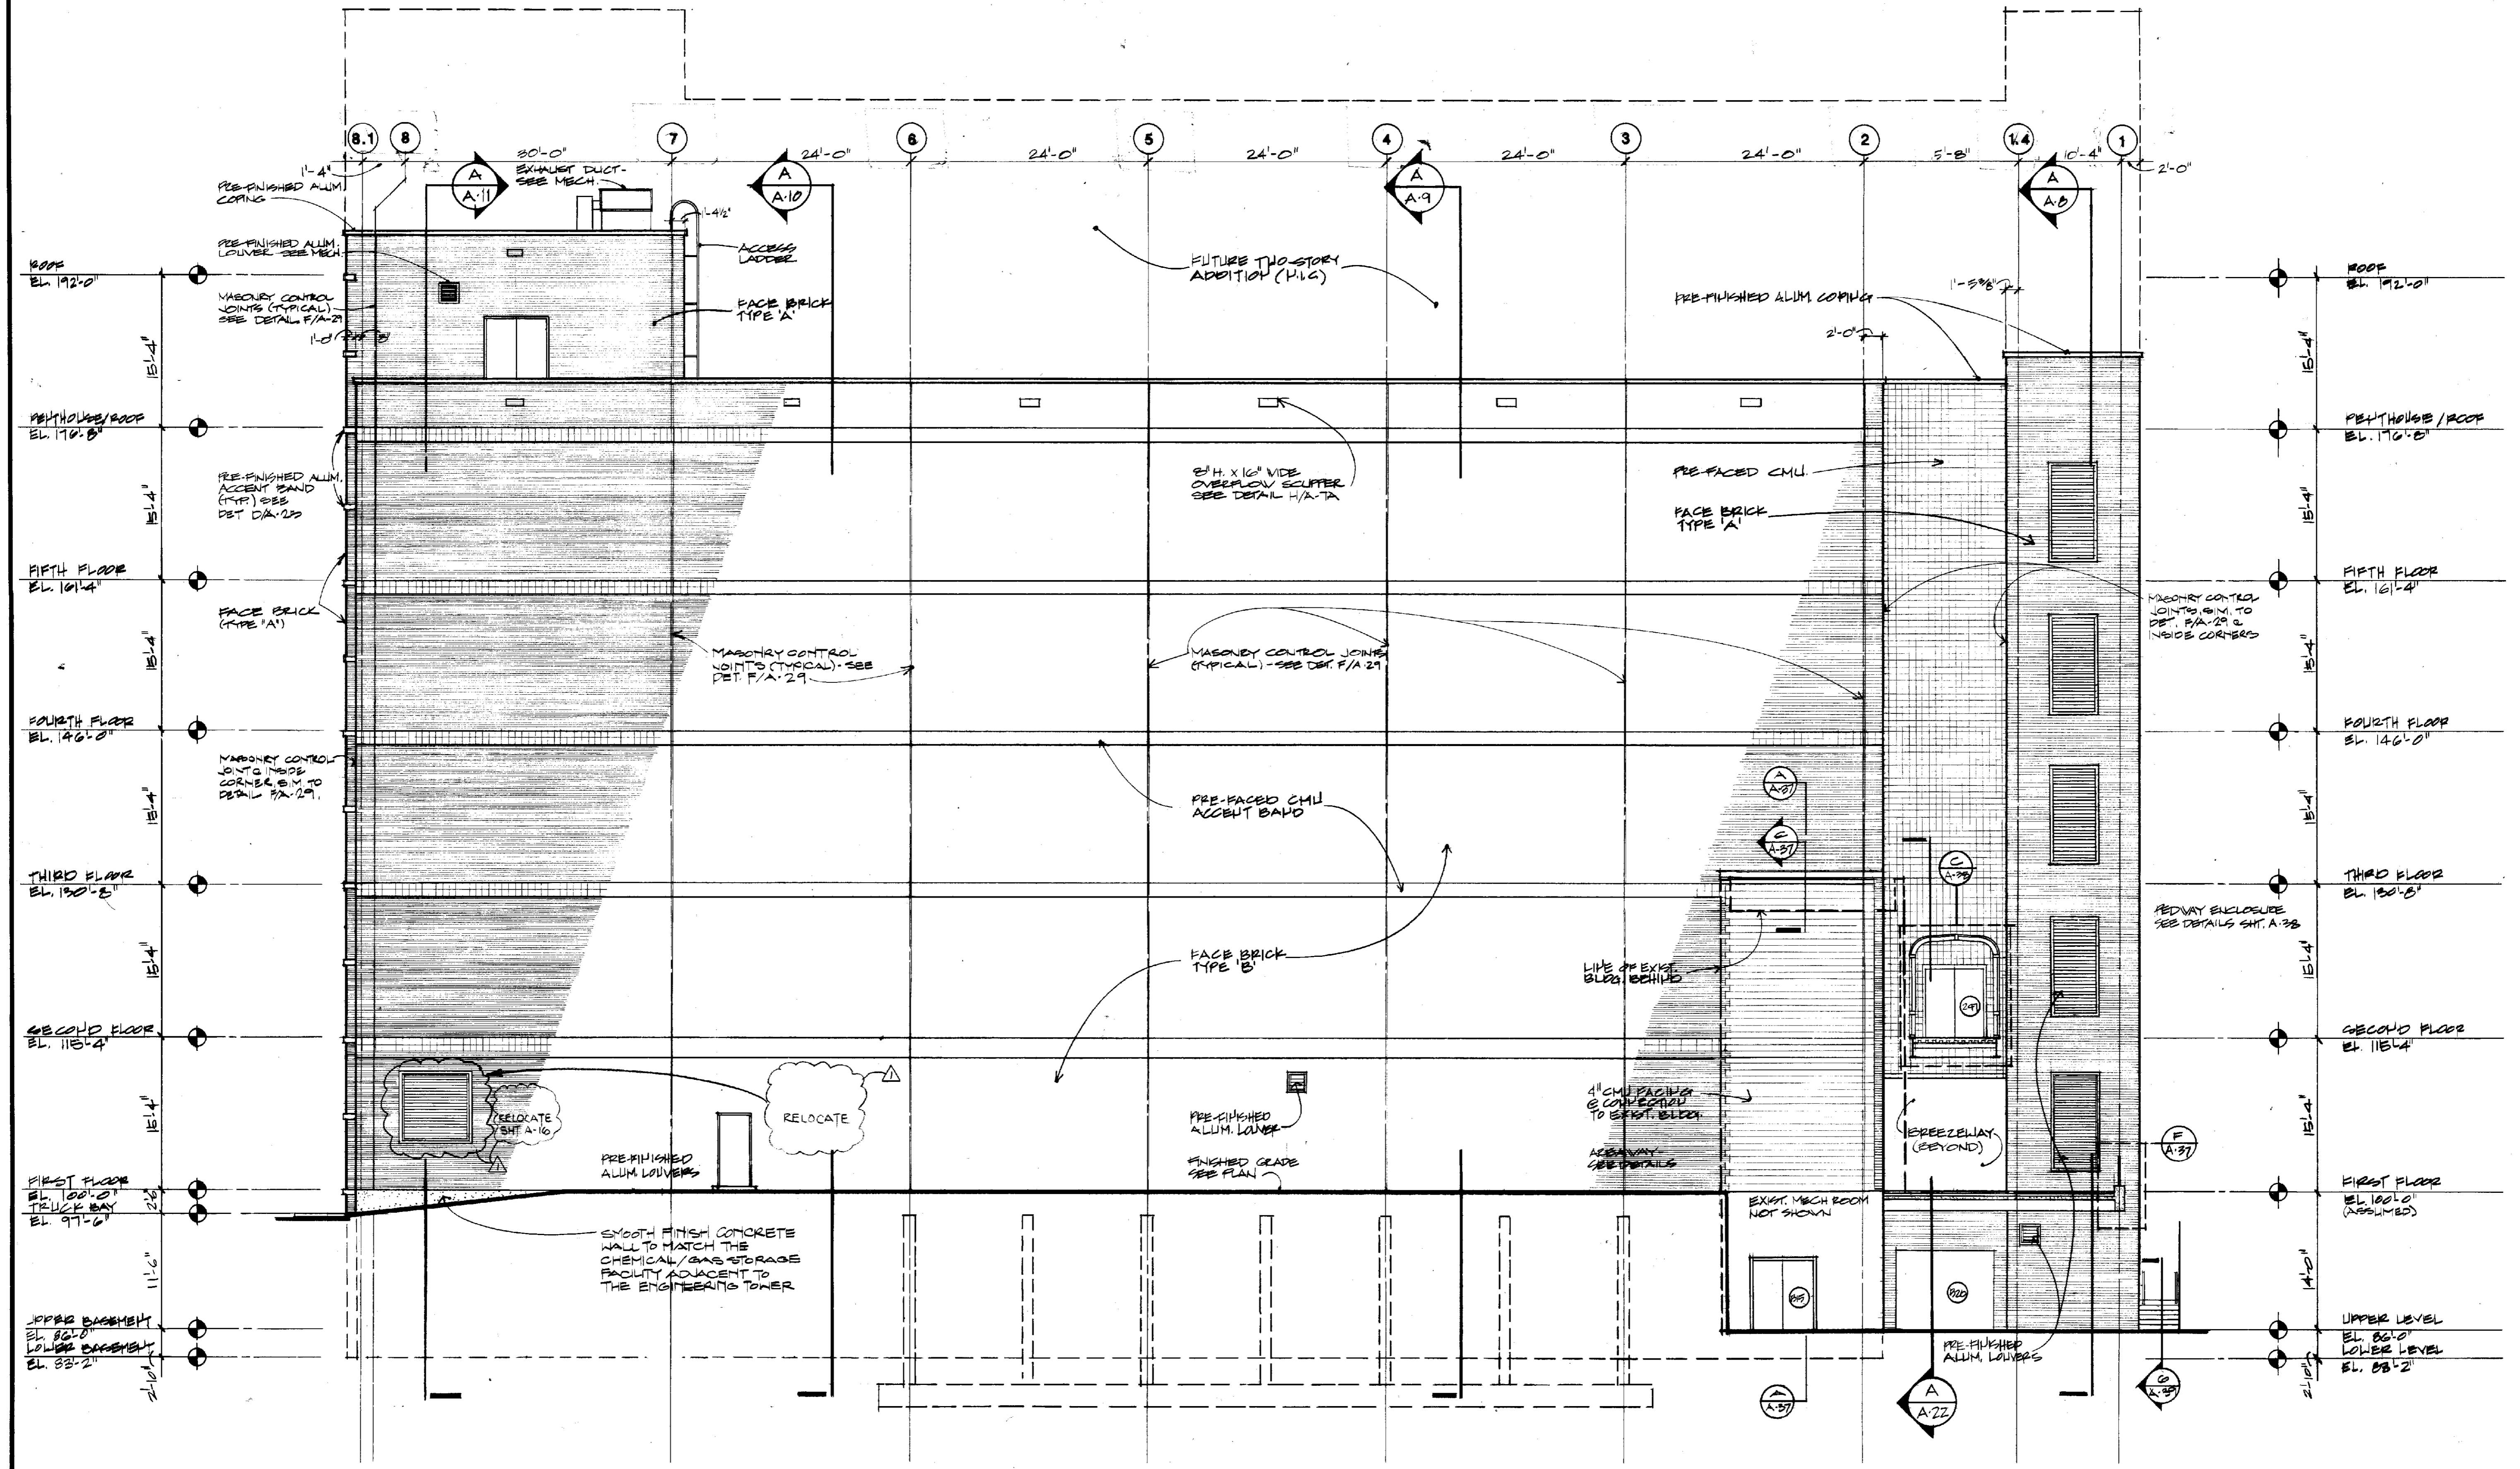

NORTH ELEVATION

1/8" = 1'-0"

001898

Sheet 001898 C-1



ROBOTICS FACILITY
 LEXINGTON CAMPUS
 UNIVERSITY OF KENTUCKY
 LEXINGTON, KENTUCKY

University of Kentucky
 Lexington, Kentucky

Prepared by **WALTER BURNING** 10-19-87
ARCHITECT - DESIGN AND CONSTRUCTION DIVISION

EAST ELEVATION


Sherman Carter Barnhart
 PARTNERS IN ARCHITECTURE
LEXINGTON FINANCIAL CENTER - SUITE 1900 - 250 W. MAIN - LEXINGTON, KY 40507 - 486-7447 FAX

JOB NO. 8706
 DATE 10-1-87
 DRAWN TUNE
 CHECKED CEB
 FILE NO 431.0

REVISIONS
 A AS BUILT 2/18/91


SHEET
 Document # 004899

A-16

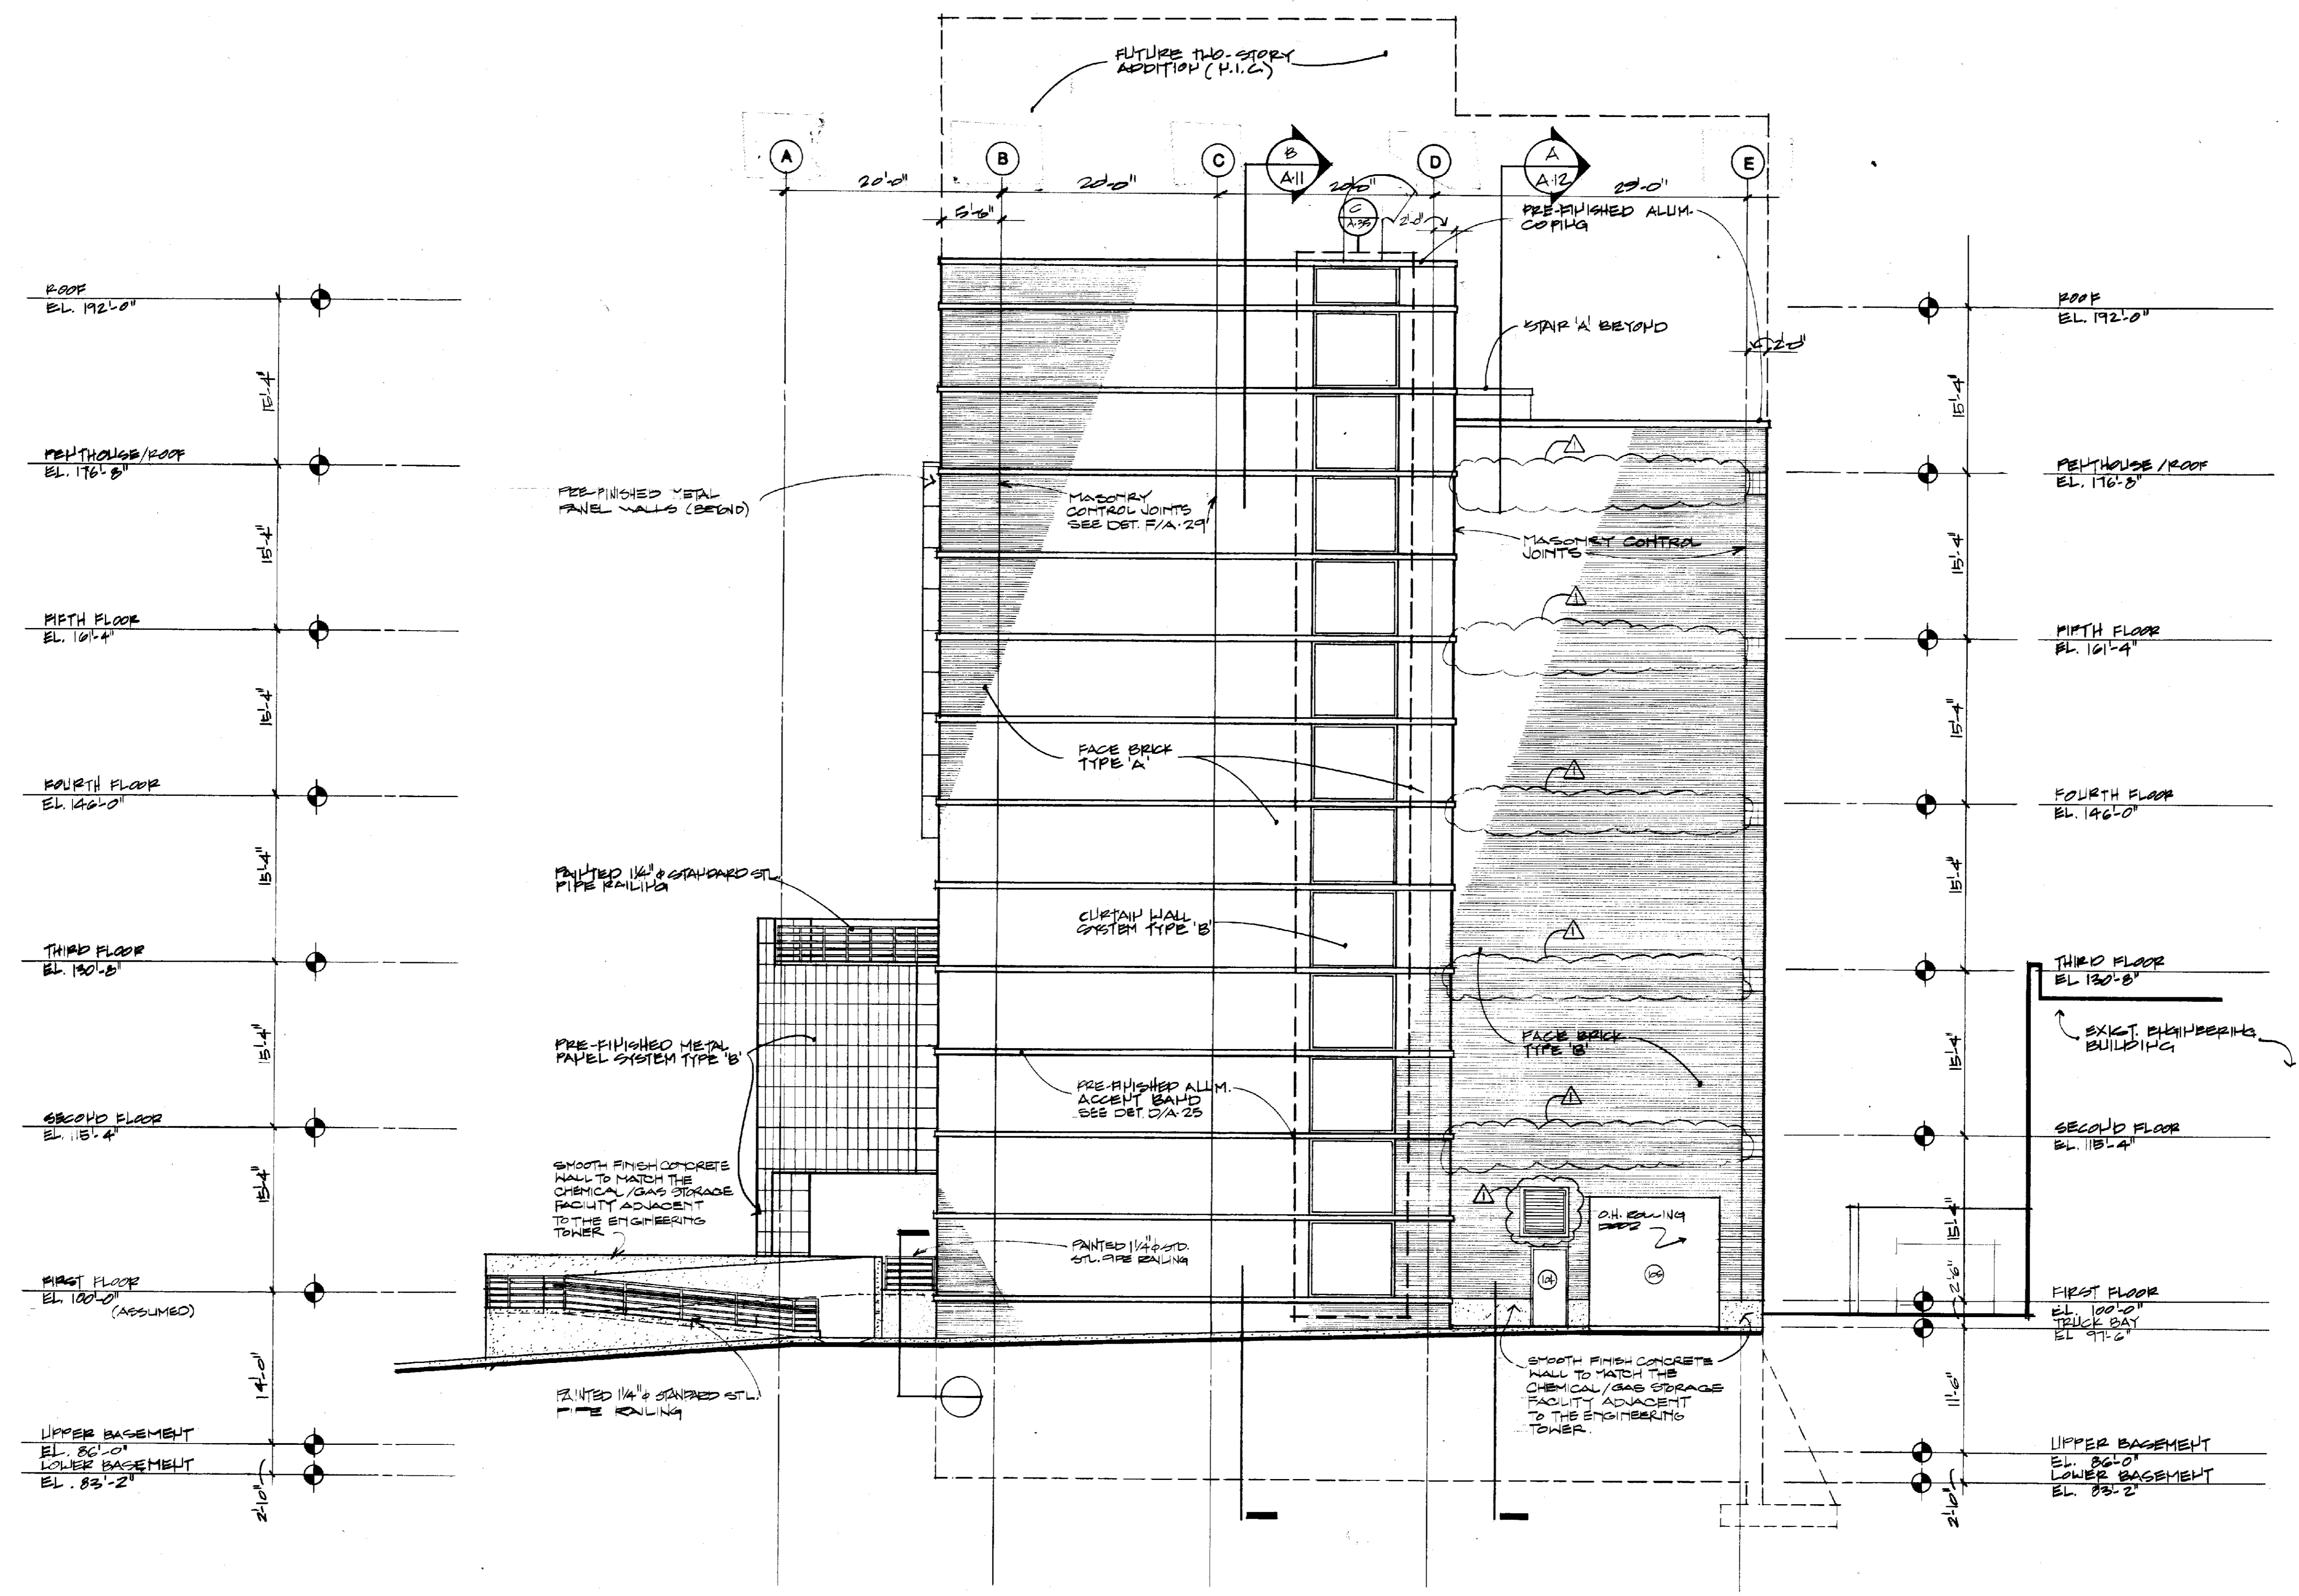

EAST ELEVATION

1/8" = 1'-0"

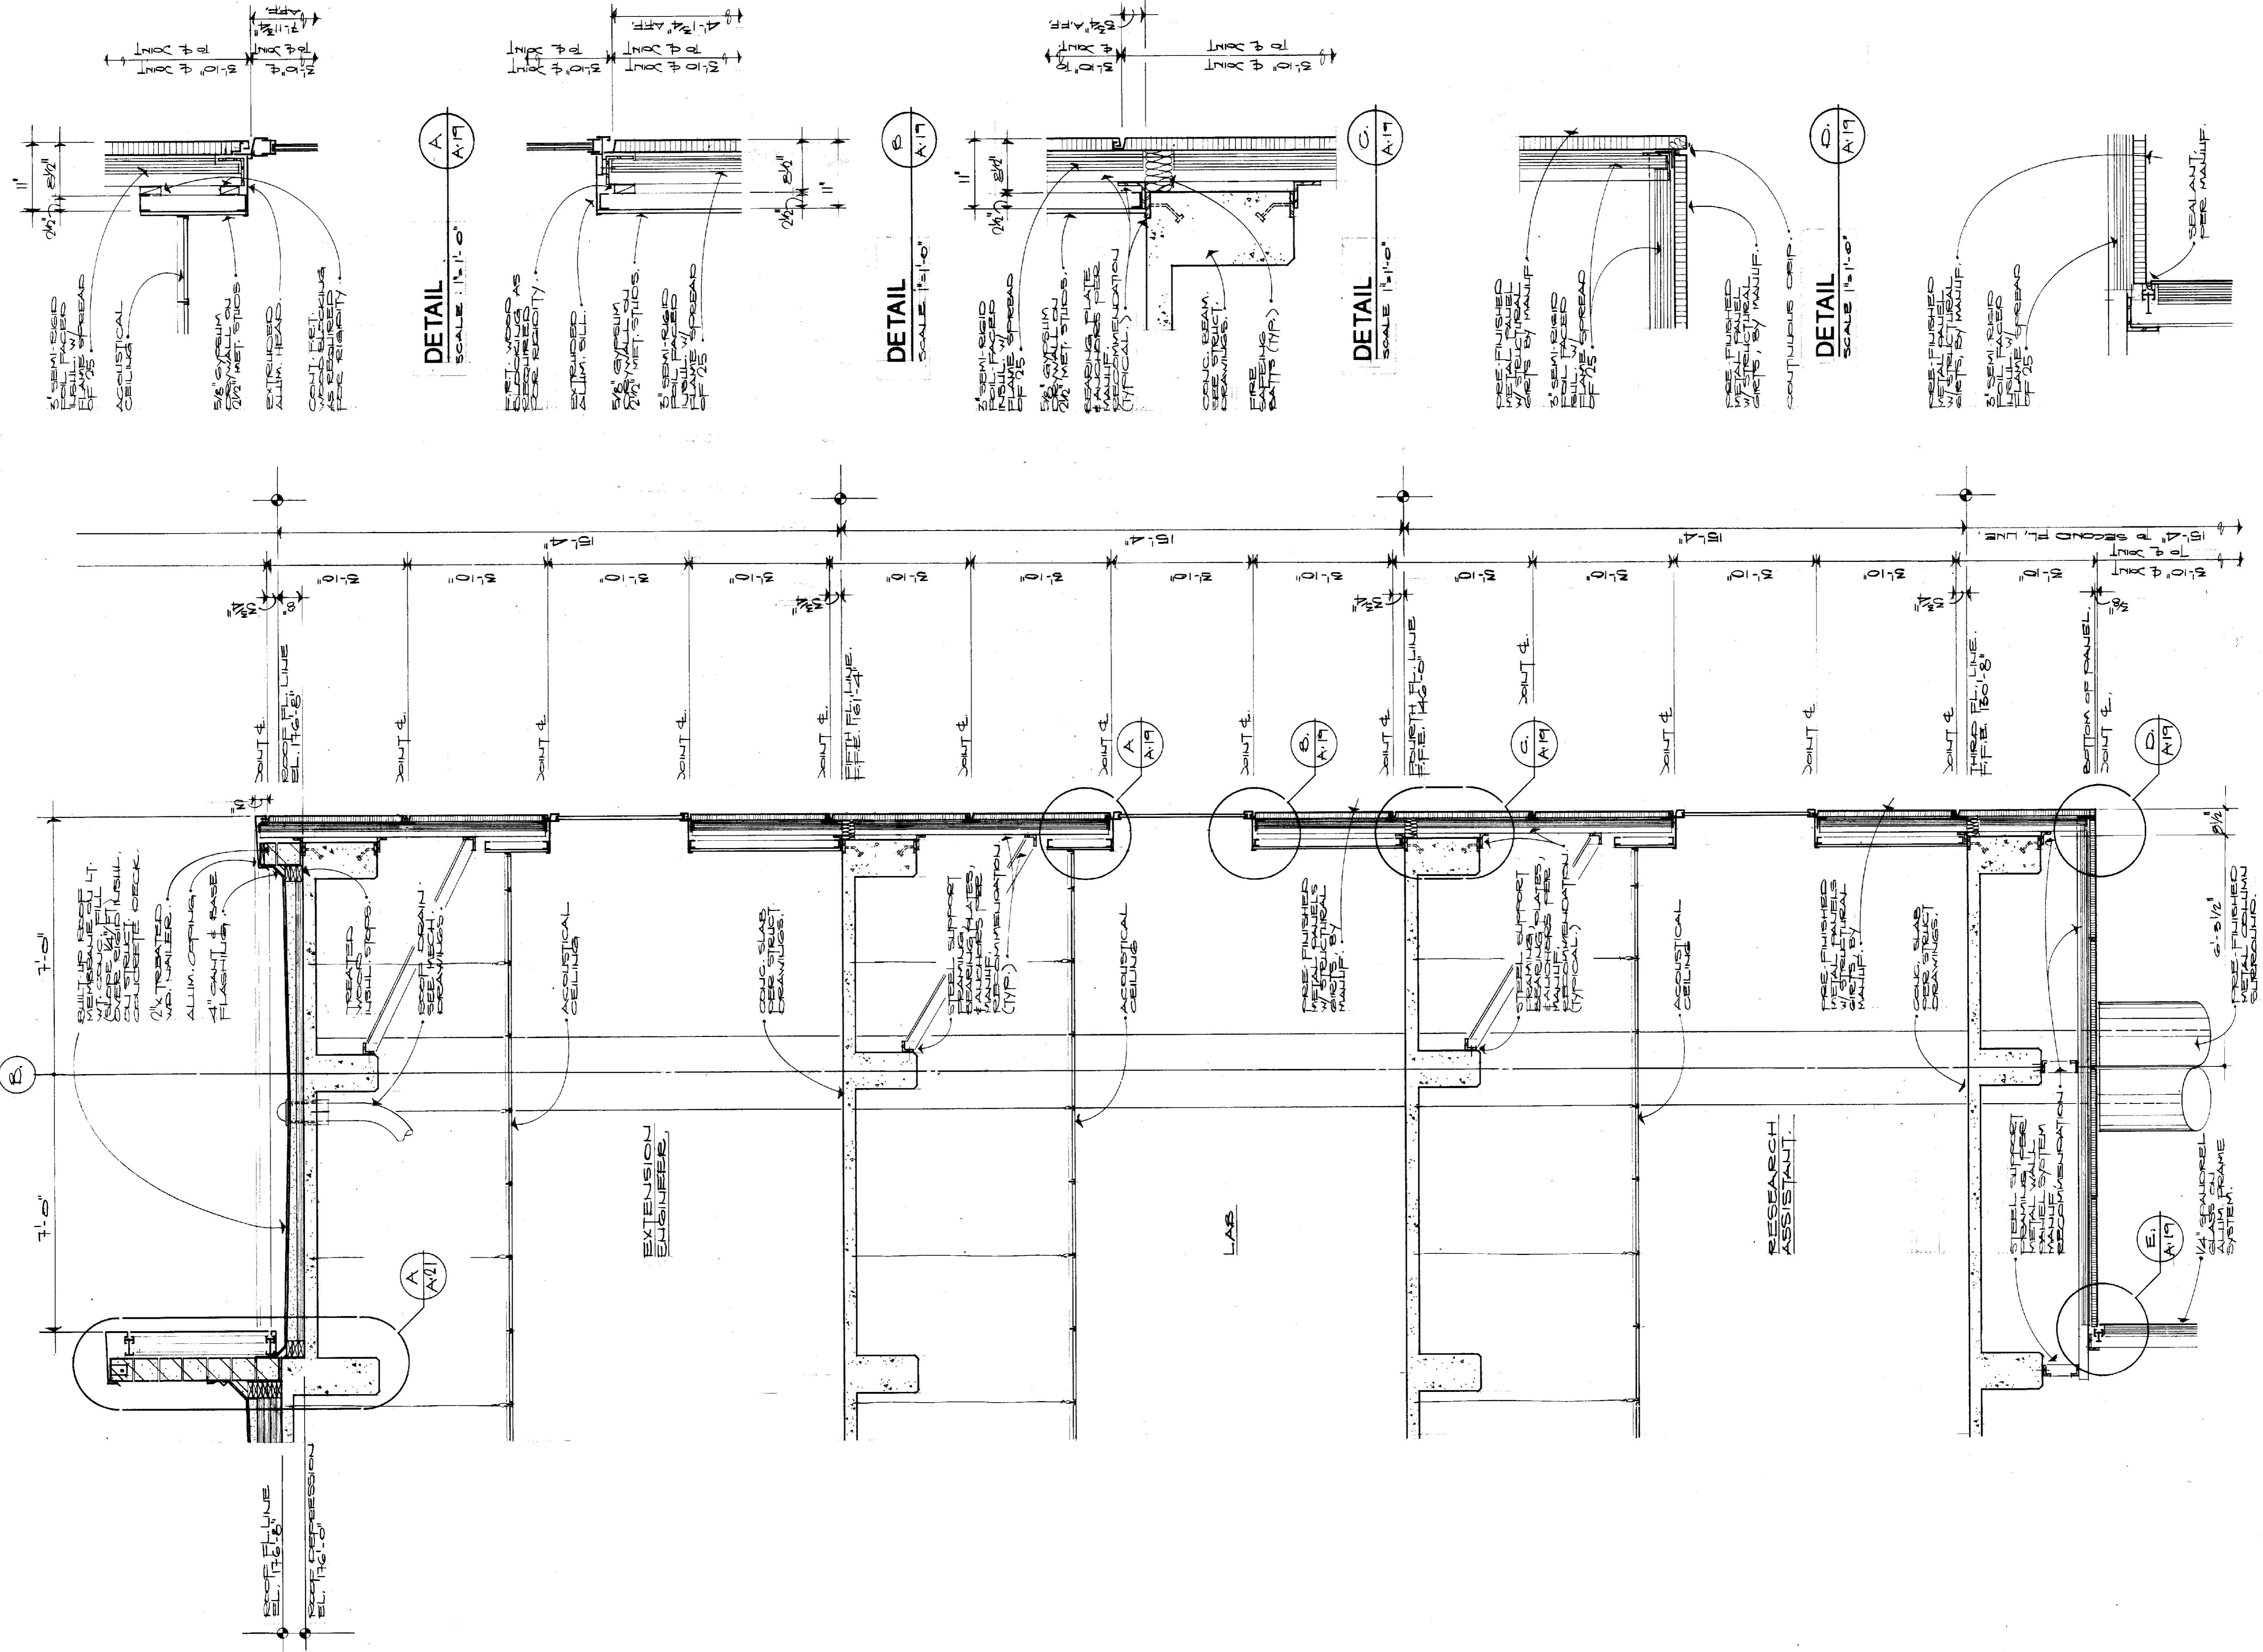

DETAIL
SCALE: 1/2" = 1'-0"

DETAIL
SCALE: 1/2" = 1'-0"

DETAIL
SCALE: 1/2" = 1'-0"

DETAIL
SCALE: 1/2" = 1'-0"

SECTION
SCALE: 1/2" = 1'-0"

JOB NO.	8706
DATE	10-1-87
DRAWN	TEN.
CHECKED	CEB
FILE NO.	431.0


NO.	REVISIONS


SHEET
A-19
DocuSign # 004902
C-1

WALL SECTIONS AND DETAILS
Sherman Carter Barnhart
PARTNERS IN ARCHITECTURE
LEXINGTON FINANCIAL CENTER - SUITE 1901 - 250 W. MAIN - LEXINGTON, KY 40507 - 606-254-1351

University of Kentucky
Lexington, Kentucky
Approved by: *William R. ...*
10-1-87
GRAND: ...

ROBOTICS FACILITY
LEXINGTON CAMPUS
UNIVERSITY OF KENTUCKY
LEXINGTON, KENTUCKY

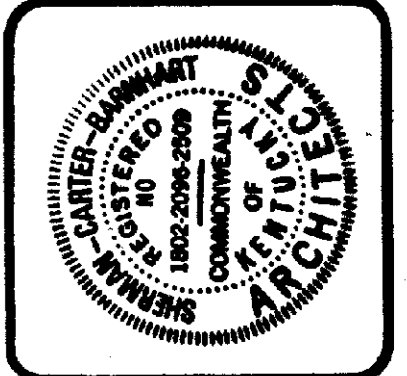

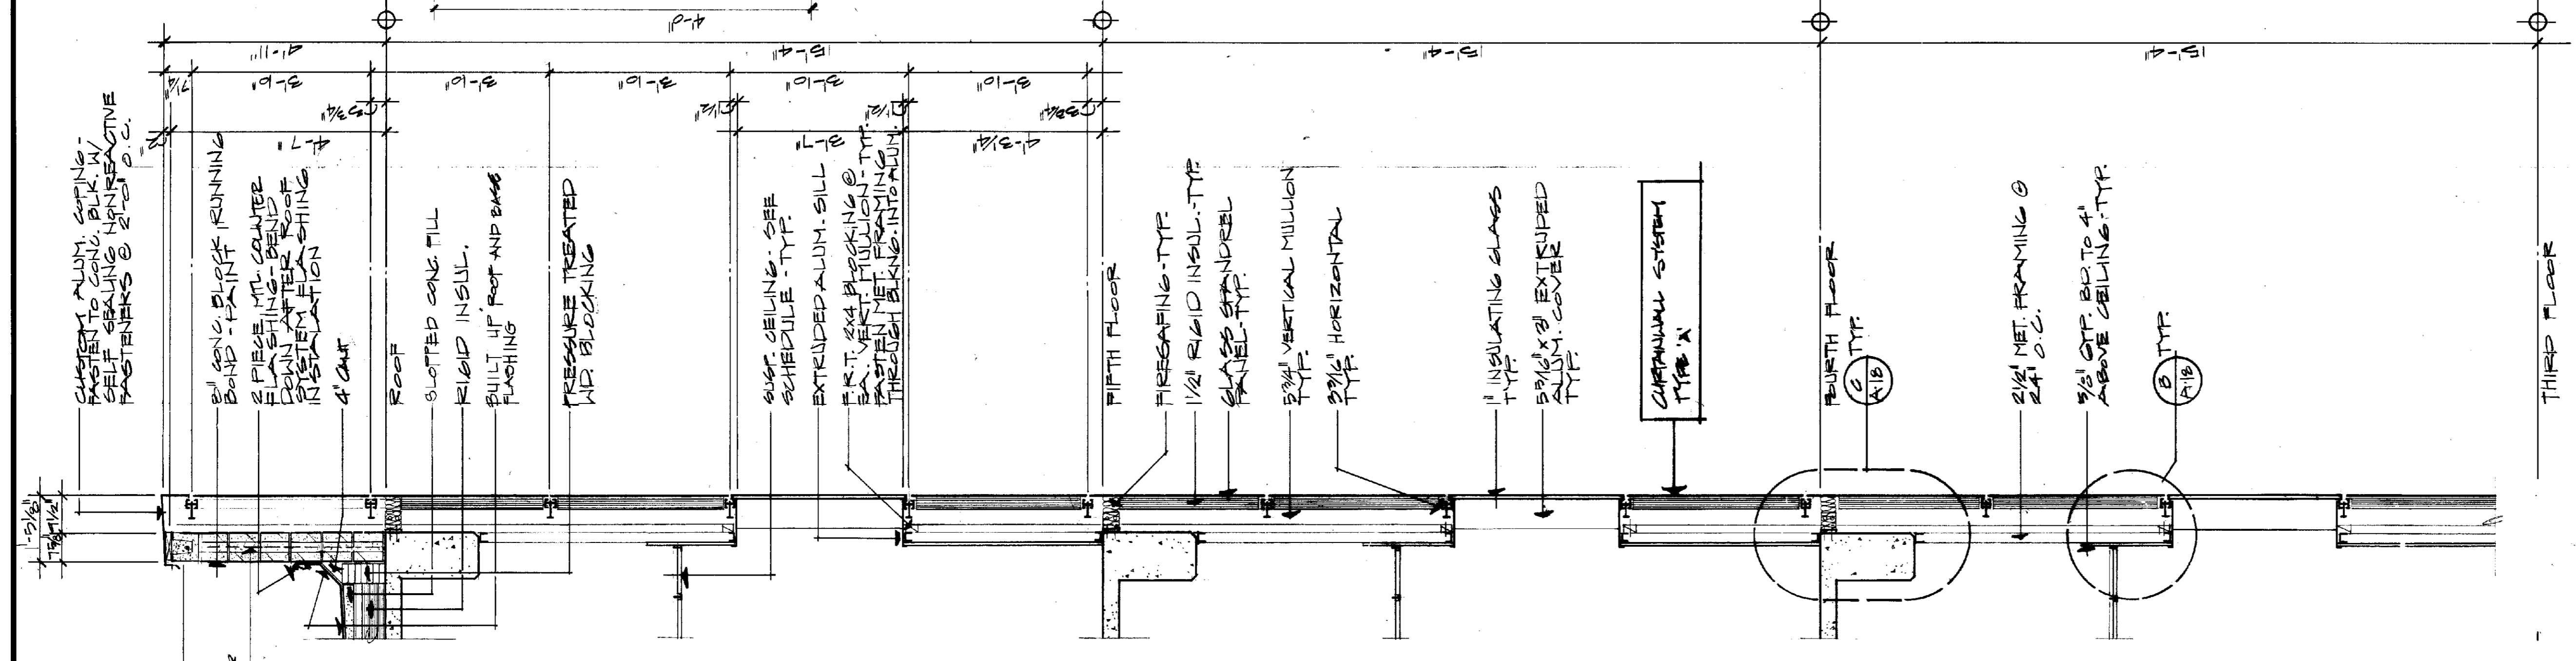

CONT. BEAM AND BEAM HILL W/ CONC.
 PROVIDE #5 VERT. REBAR @ 4'-0" O.C. AND HILL CORE W/ CONC. @ EACH REBAR

CUSTOMER ALUM. COATING - FASTENERS TO CONC. BLK. W/ SELF-SEALING NON-REACTIVE FASTENERS @ 2'-0" O.C.

8" CONC. BLOCK RUNNING BAND - PAINT
 2 PIECE MIL. CENTER FLASHING - BEND DOWN AFTER ROOF SYSTEM FLASHING
 4" GUT
 ROOF
 SLOTTED CONC. TILL RIGID INSUL. BUILT UP ROOF AND EDGE FLASHING
 PRESSURE TREATED MID BLOCKING

SUSP. CEILING - SEE SCHEDULE - TYP.
 EXTENDED ALUM. SILL
 P.R.T. 2x4 BLOCKING @ EA. VERT. MULLION - TYP.
 FASTEN NET FLASHING THROUGH BLK. INTO ALUM.

FIFTH FLOOR
 FIRE-RATING - TYP.
 1/2" RIGID INSUL. - TYP. GLASS SPANDREL PANEL - TYP.
 3/4" VERTICAL MULLION - TYP.
 2 3/4" HORIZONTAL - TYP.

1" INSULATING GLASS - TYP.
 3 3/4" X 3" EXTRUDED ALUM. COVER - TYP.

CURTAIN WALL SYSTEM TYPE X









FOURTH FLOOR
 2 1/2" TYP. (A/B)

2 1/2" NET. FRAMING @ 2'-0" O.C.

3/8" STP. BR TO 4" ABOVE CEILING - TYP. (B/B)

THIRD FLOOR
 A (A/2)

SECTION
 1/2" = 1'-0"

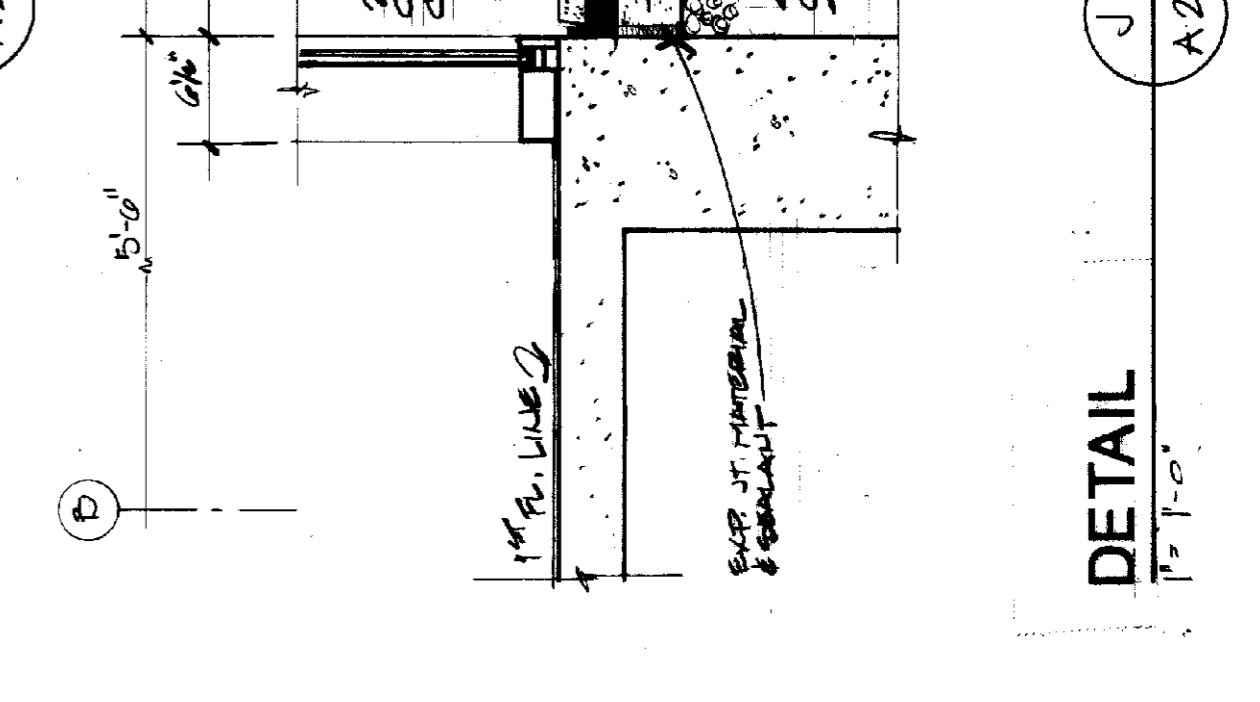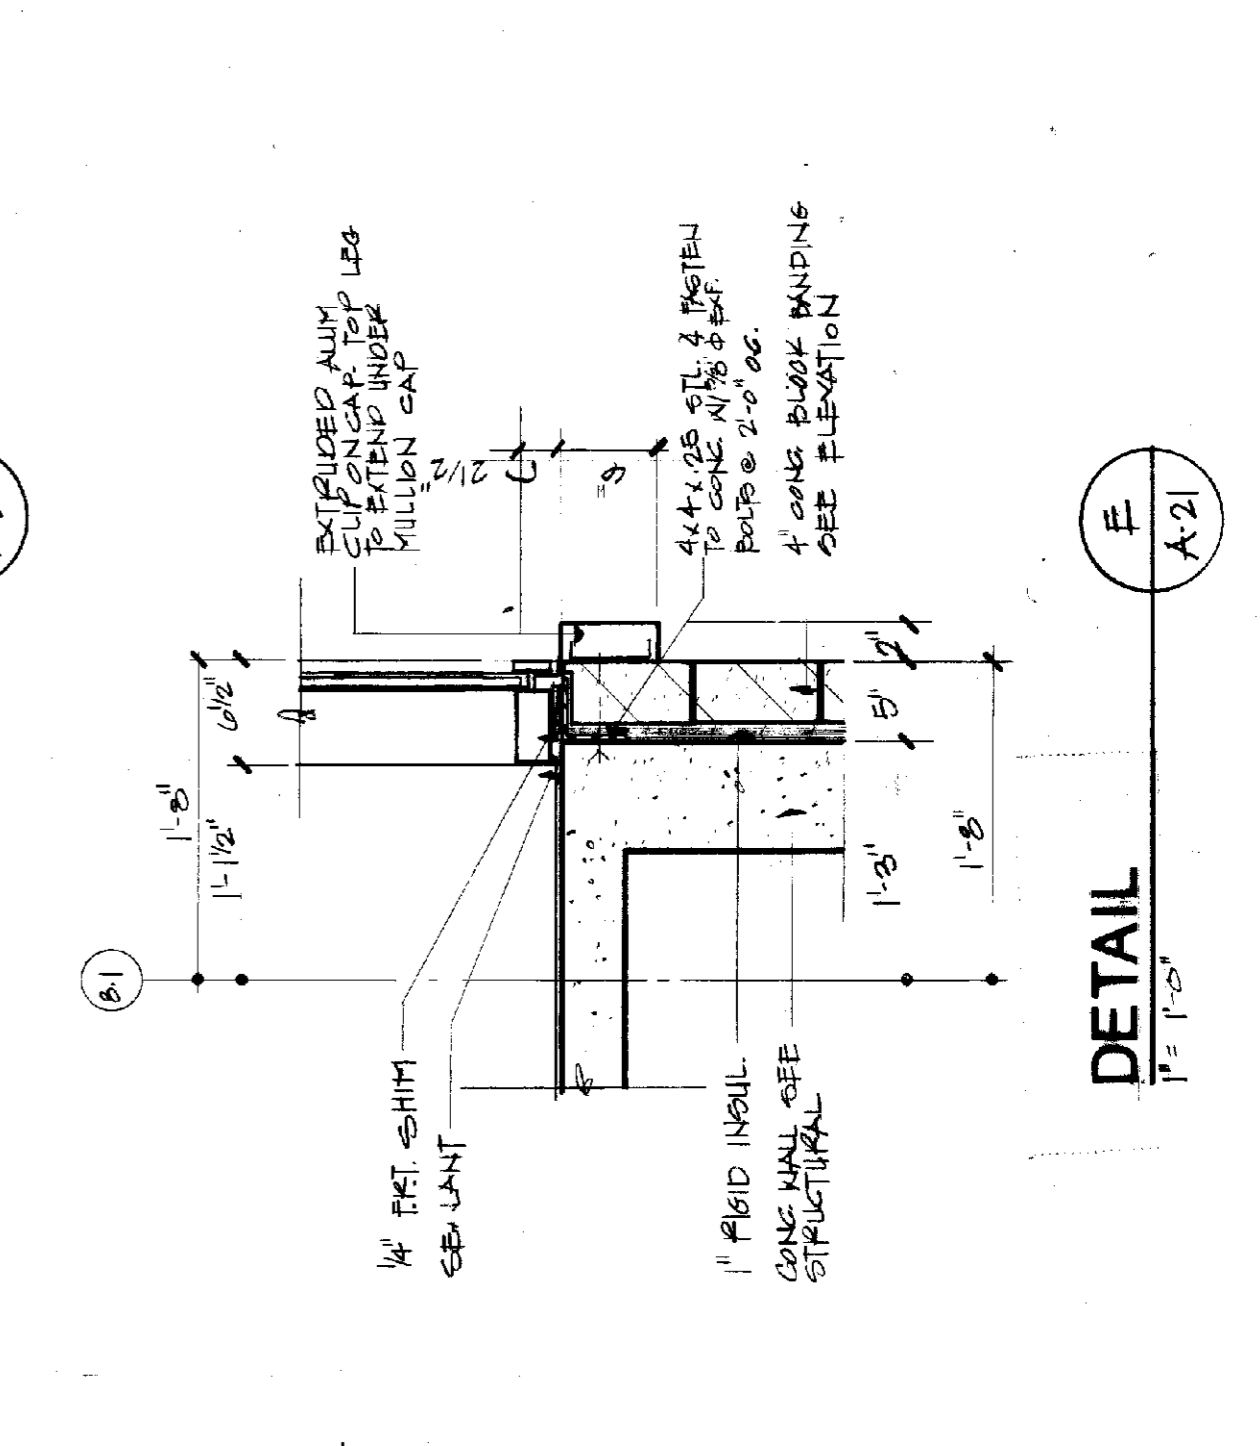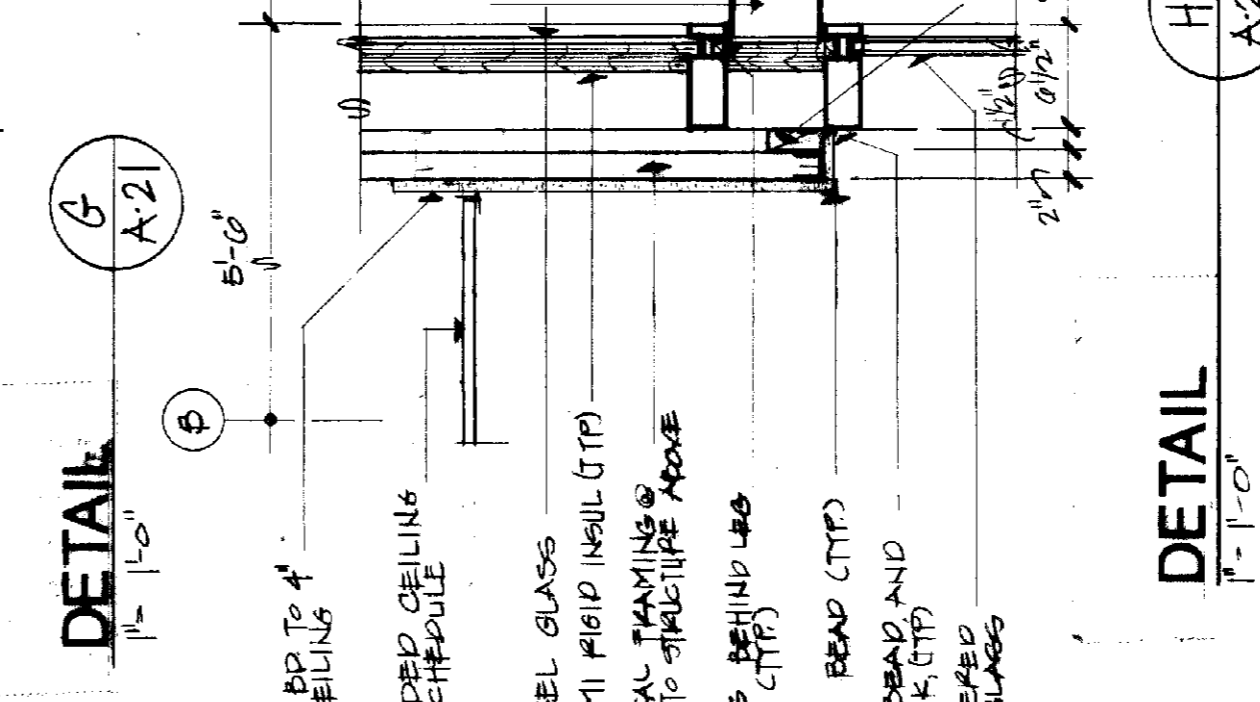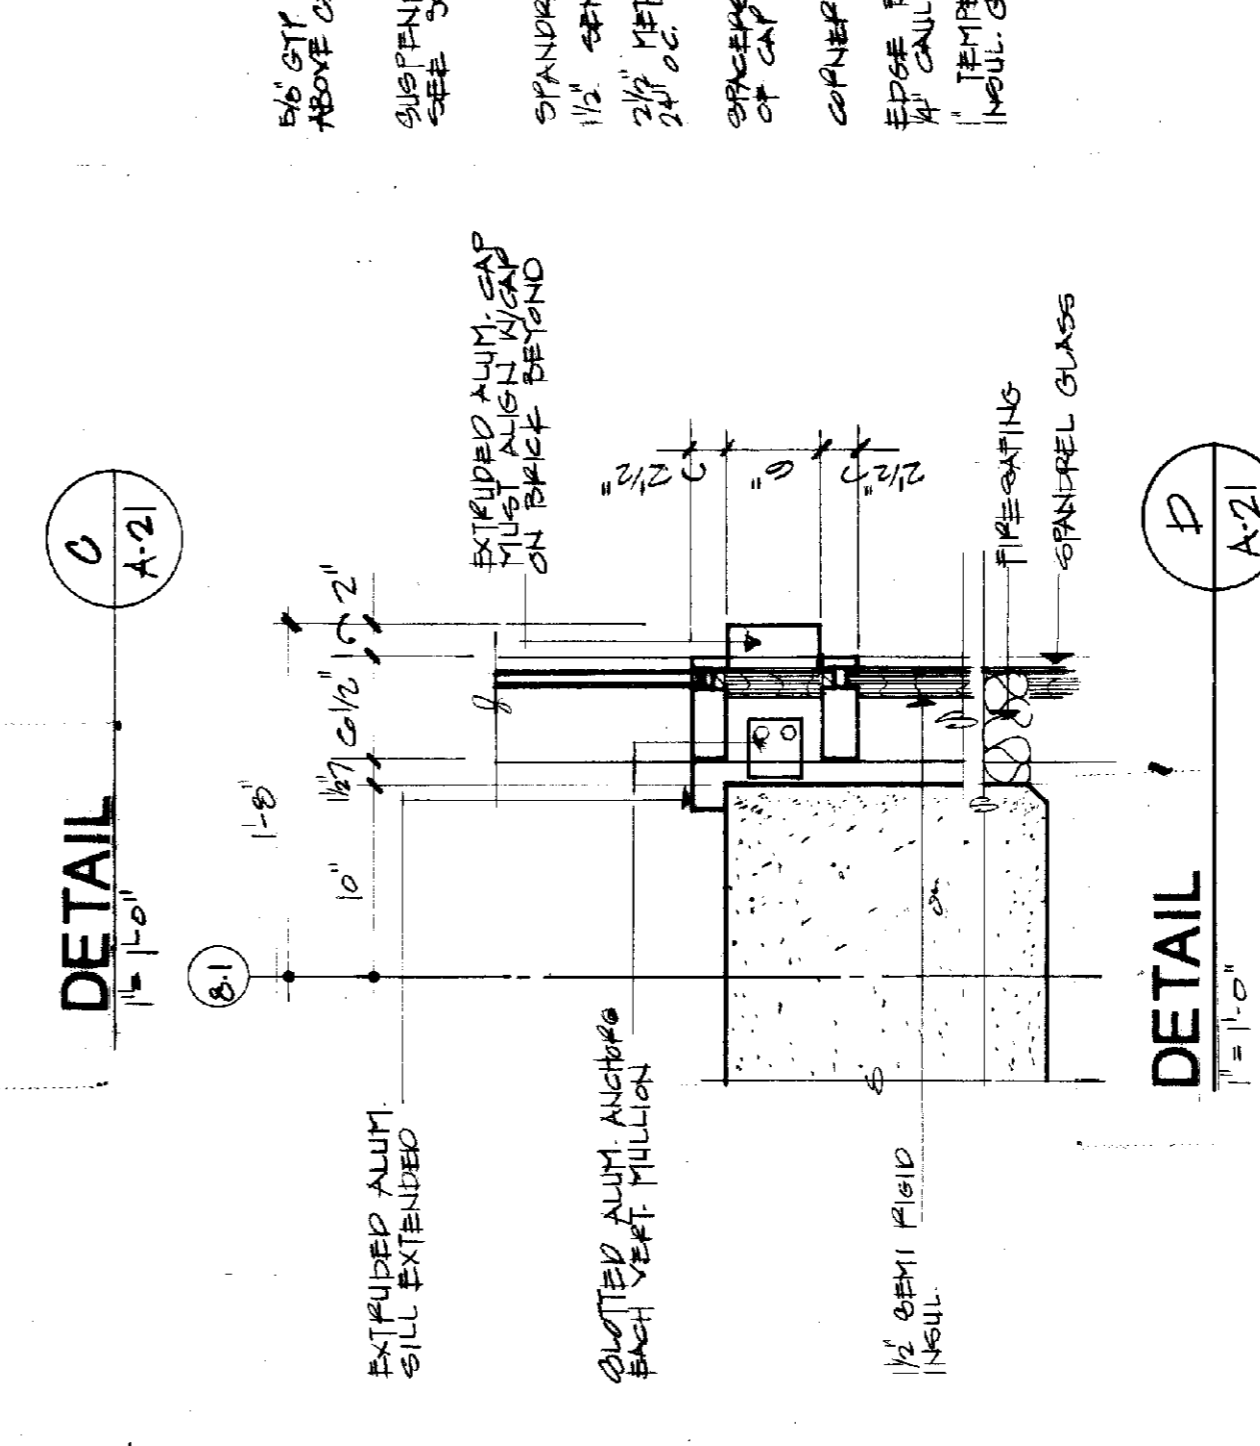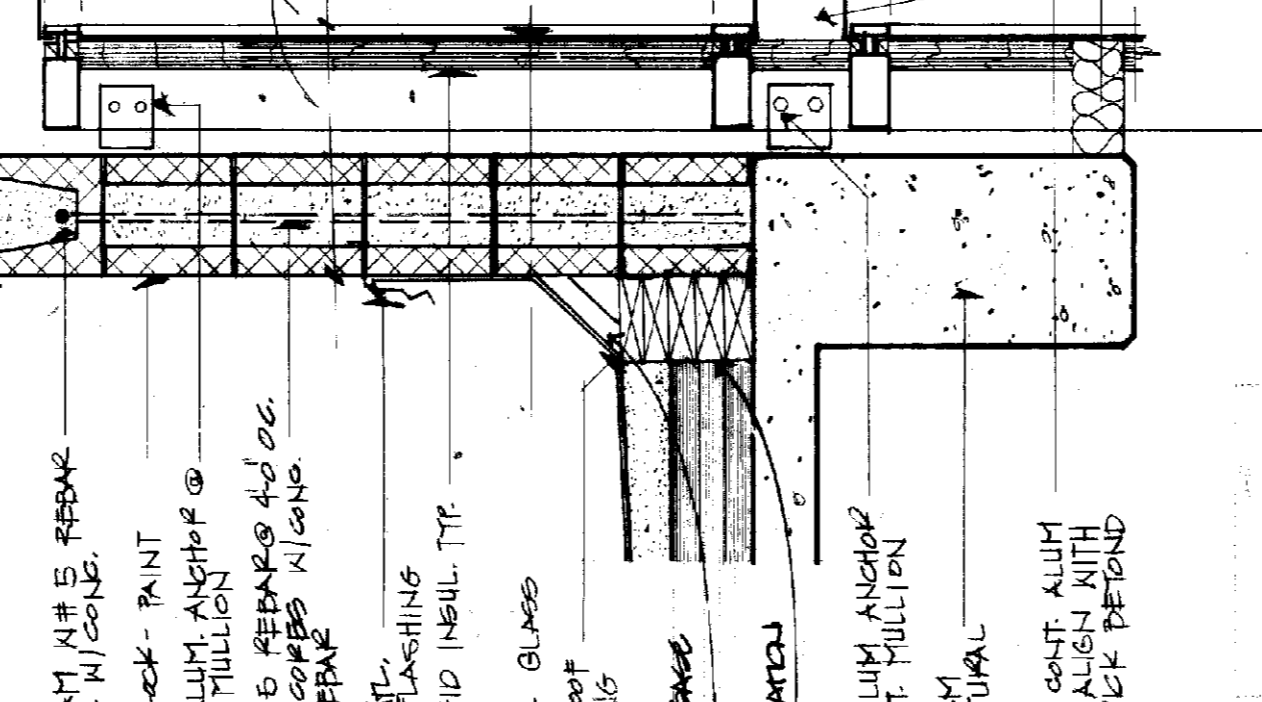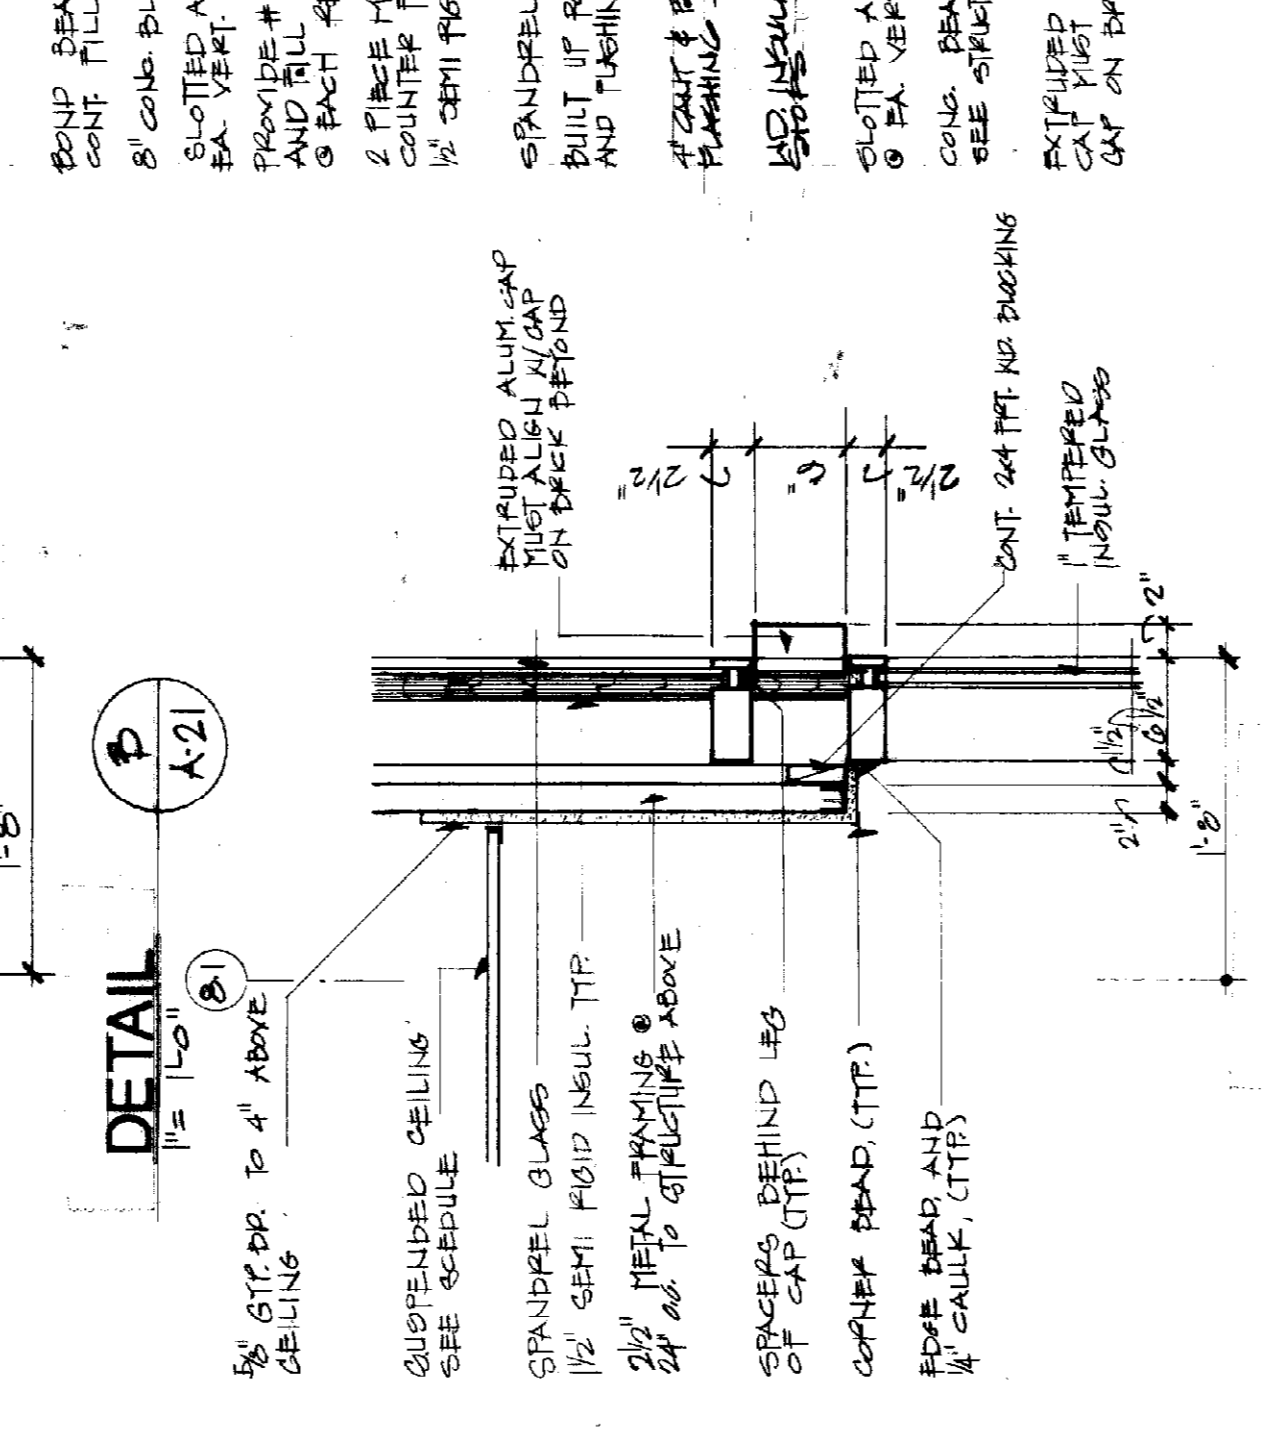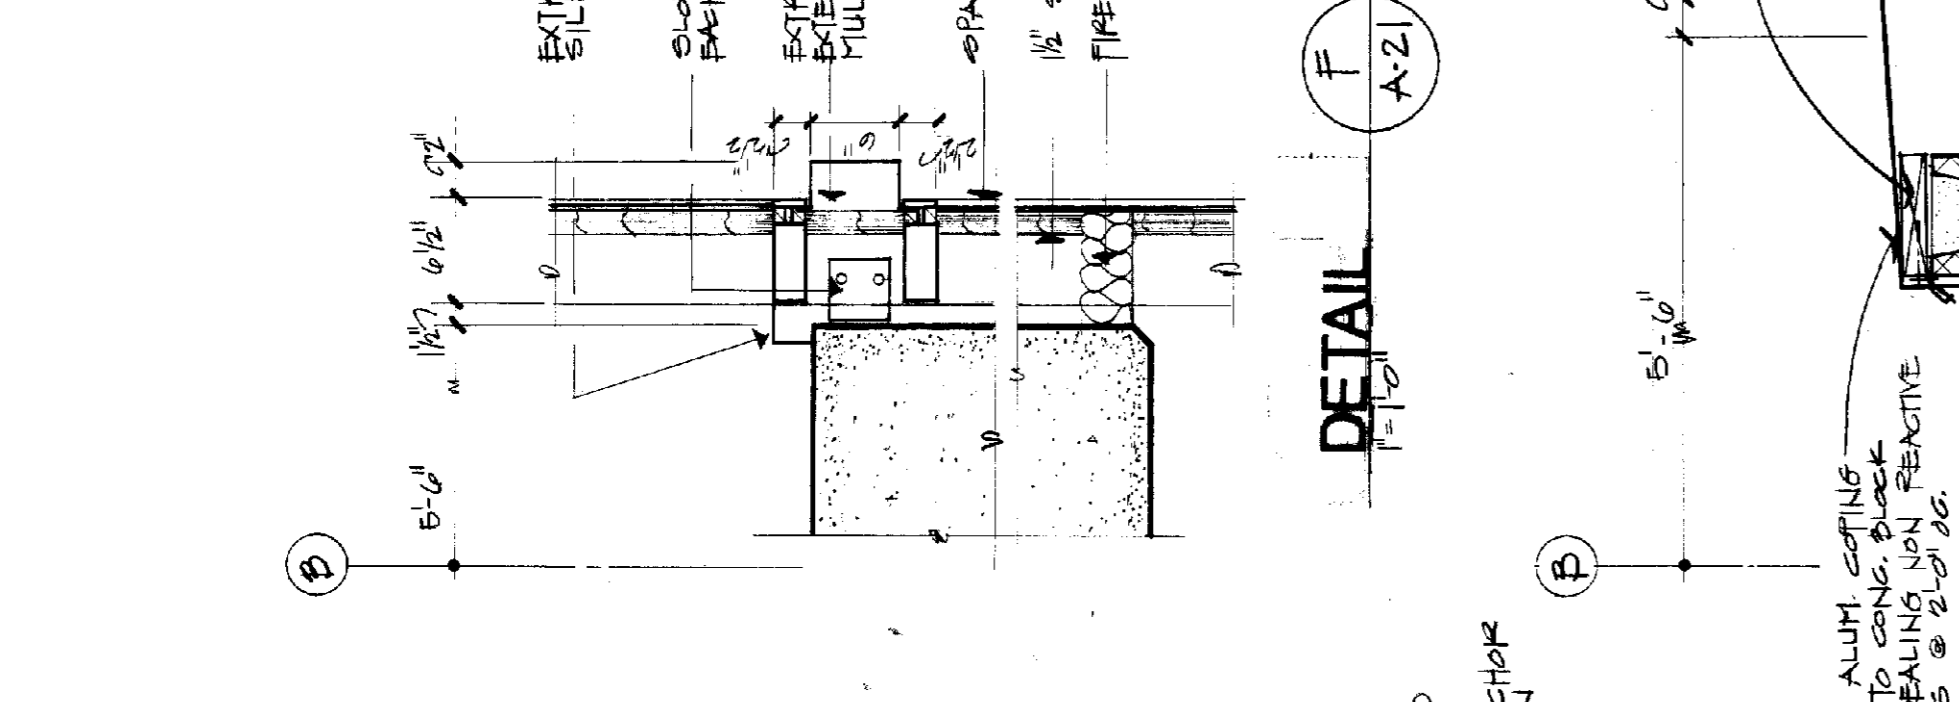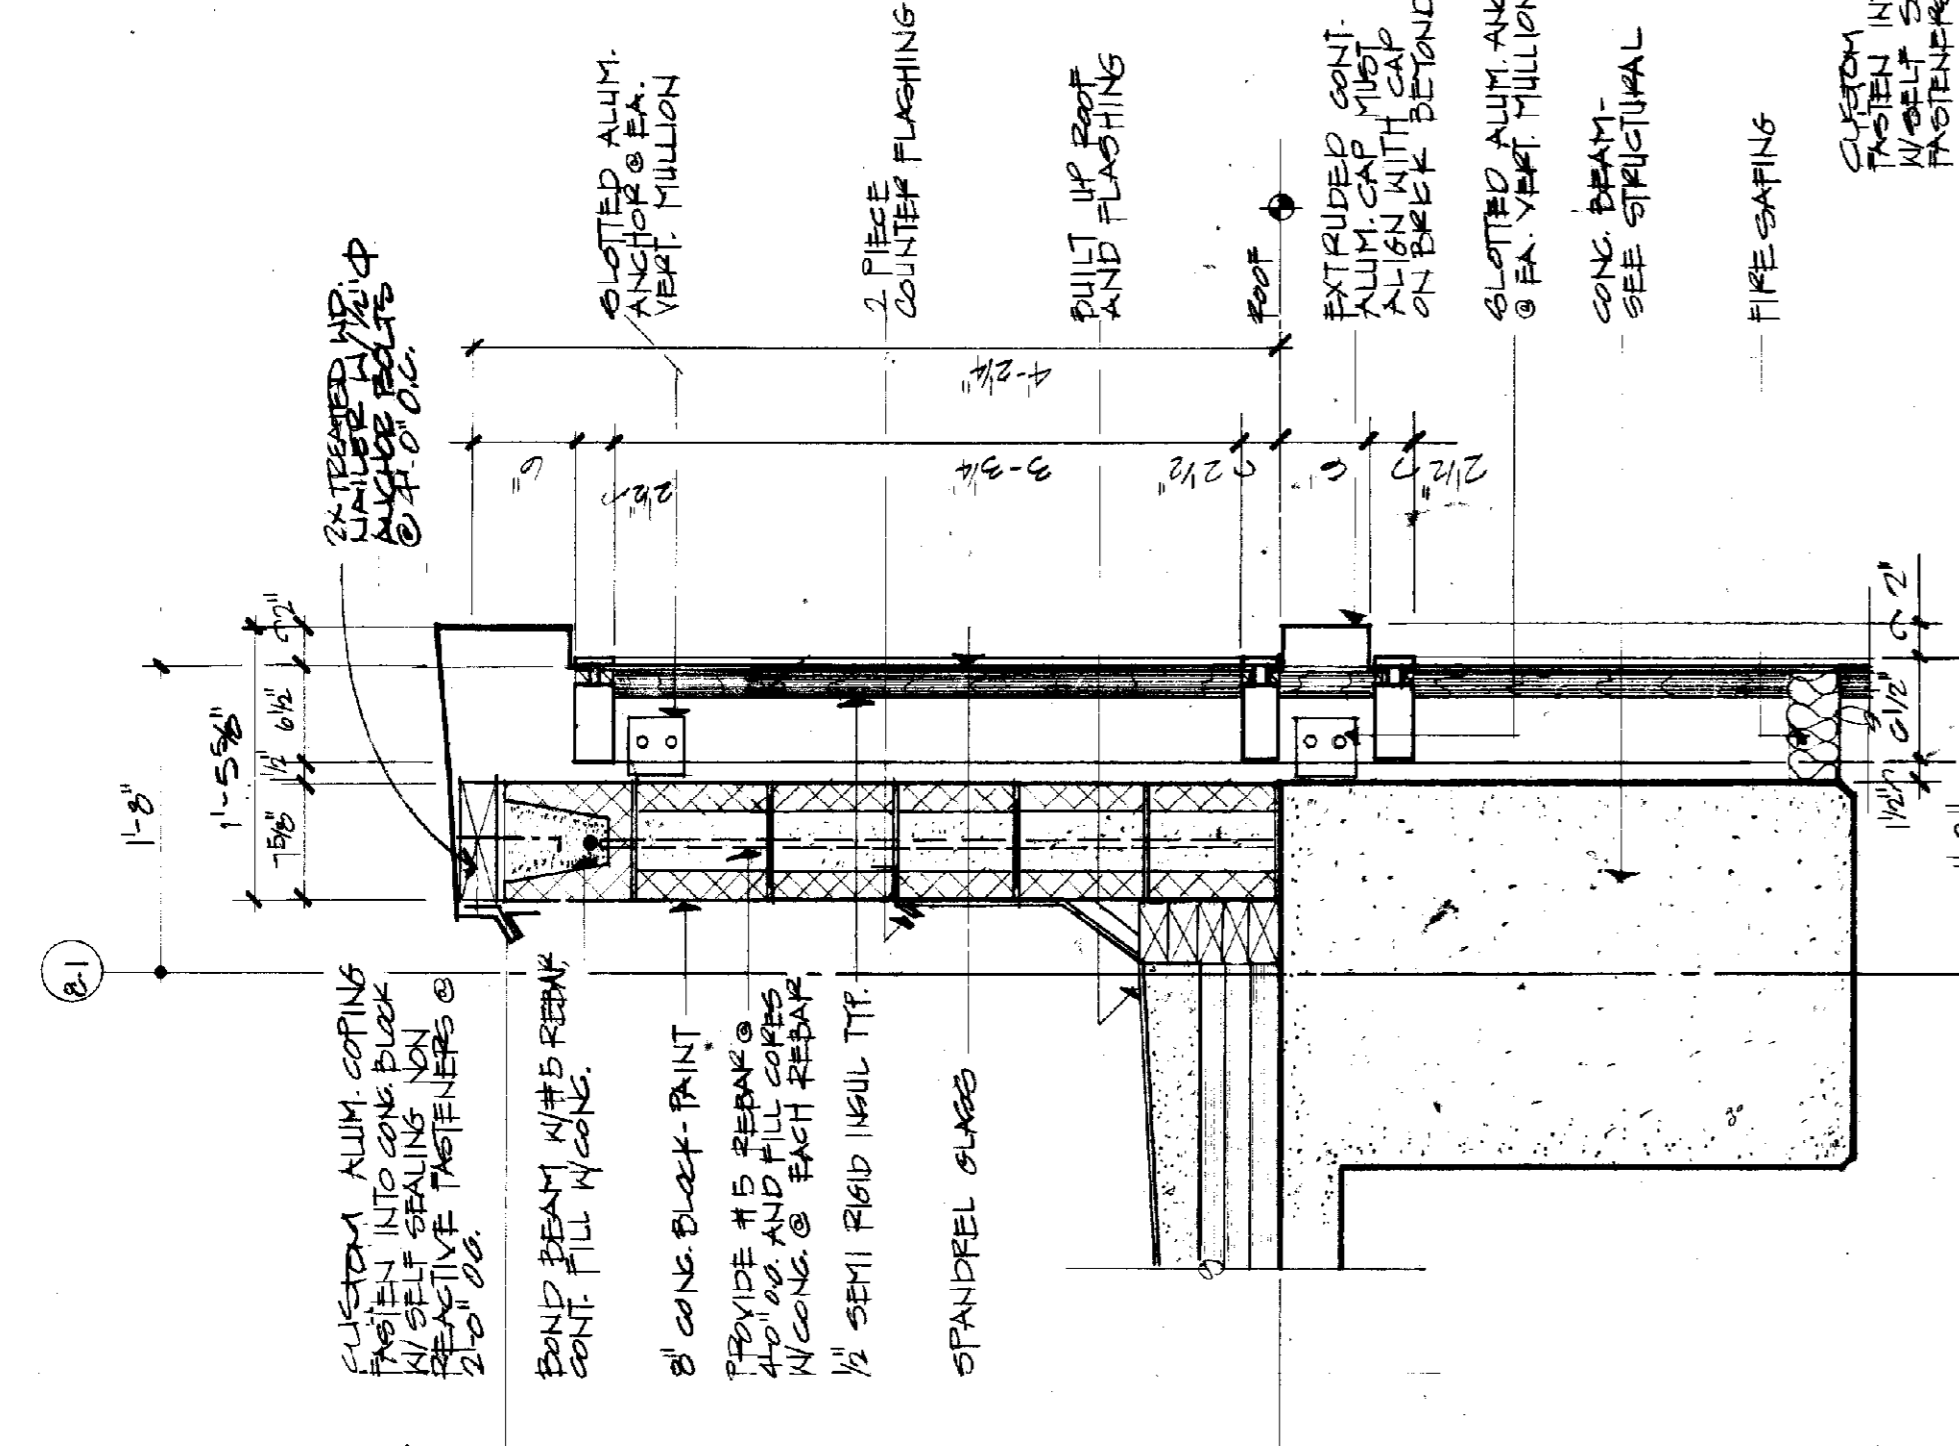

REVISIONS


WALL SECTIONS AND DETAILS

JOB NO.	8700
DATE	10-1-82
DRAWN	STAFF
CHECKED	CEE
FILE NO.	431.0

Sherman Carter Barnhart
 PARTNERS IN ARCHITECTURE
 FRANKLIN PARKWAY CENTER - SUITE 100 - 750 W. MAIN - LEXINGTON, KY 40501 - 502-254-1551

University of Kentucky
 Lexington, Kentucky
 Approved by: *Walter R. ...* 10.10.87
 DIRECTOR, CAPITAL AND CONSTRUCTION DIVISION

ROBOTICS FACILITY
 LEXINGTON CAMPUS
 UNIVERSITY OF KENTUCKY
 LEXINGTON, KENTUCKY

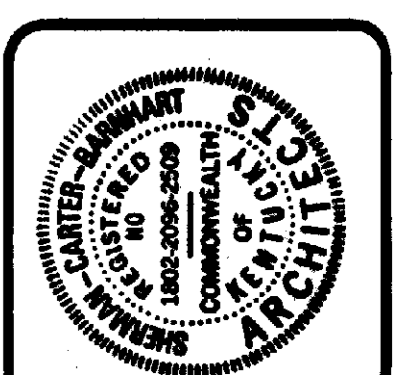



ROBOTICS FACILITY
 LEXINGTON CAMPUS
 UNIVERSITY OF KENTUCKY
 LEXINGTON, KENTUCKY

University of Kentucky
 Lexington, Kentucky

10-19-87
 SHERMAN CARTER ARCHITECTS

DOCK SECTION AND DETAILS


Sherman Carter PARTNERS IN ARCHITECTURE
 LEXINGTON FINANCIAL CENTER, SUITE 900, 250 W. MAIN - LEXINGTON, KY 40507 - 606-254-1951

JOB NO. 8706
 DATE 10-1-87
 DRAWN TUNE
 CHECKED CER
 FILE NO. 431.0

NO.	REVISIONS


SHEET

A-22

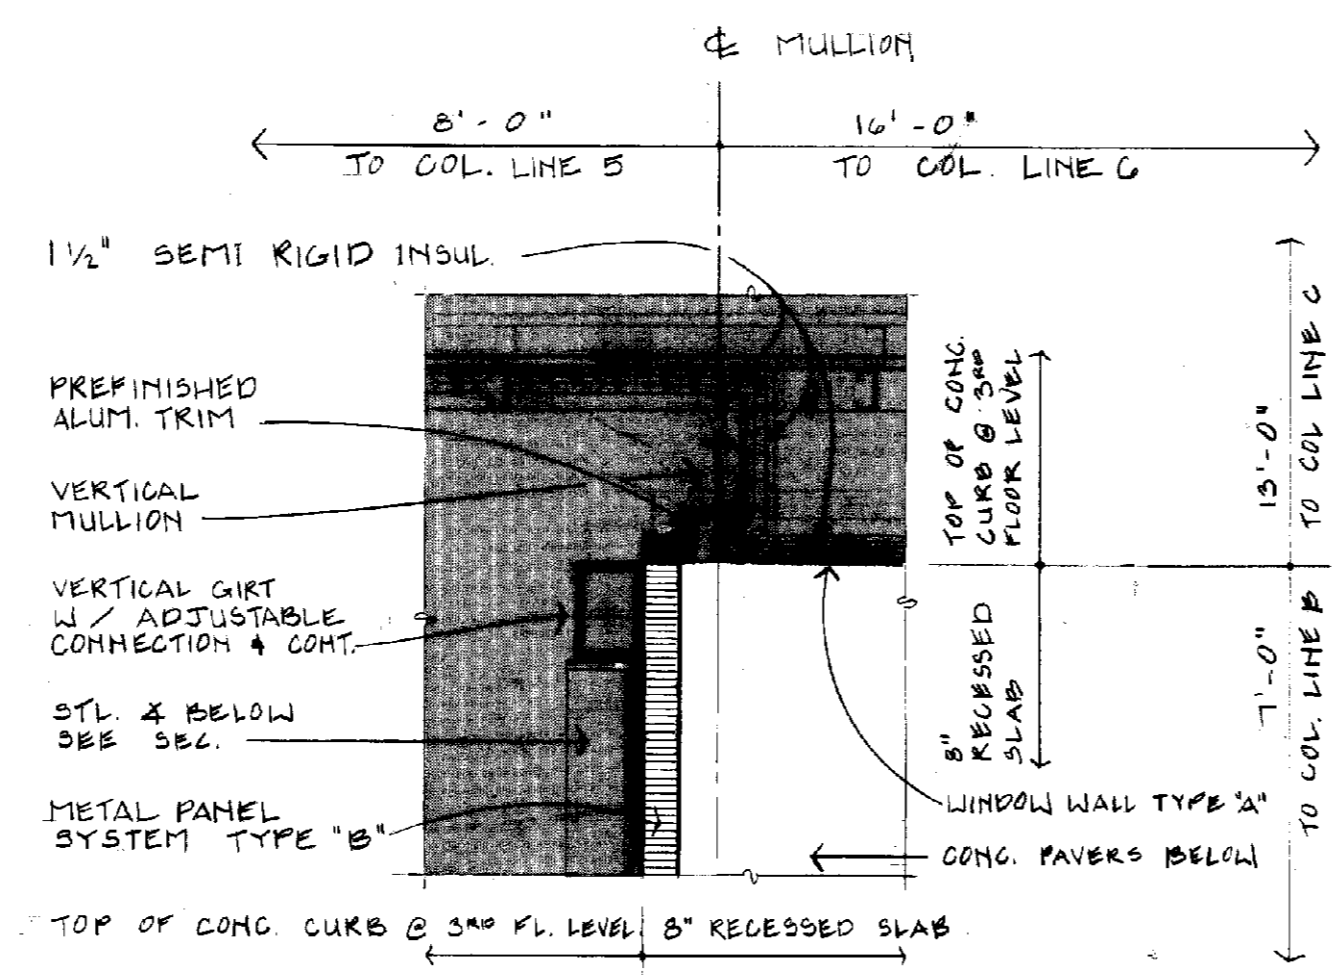


JOINT ELEVATION
 FULL SCALE


BEAM SURROUND DETAIL
 1/4"=1'-0"

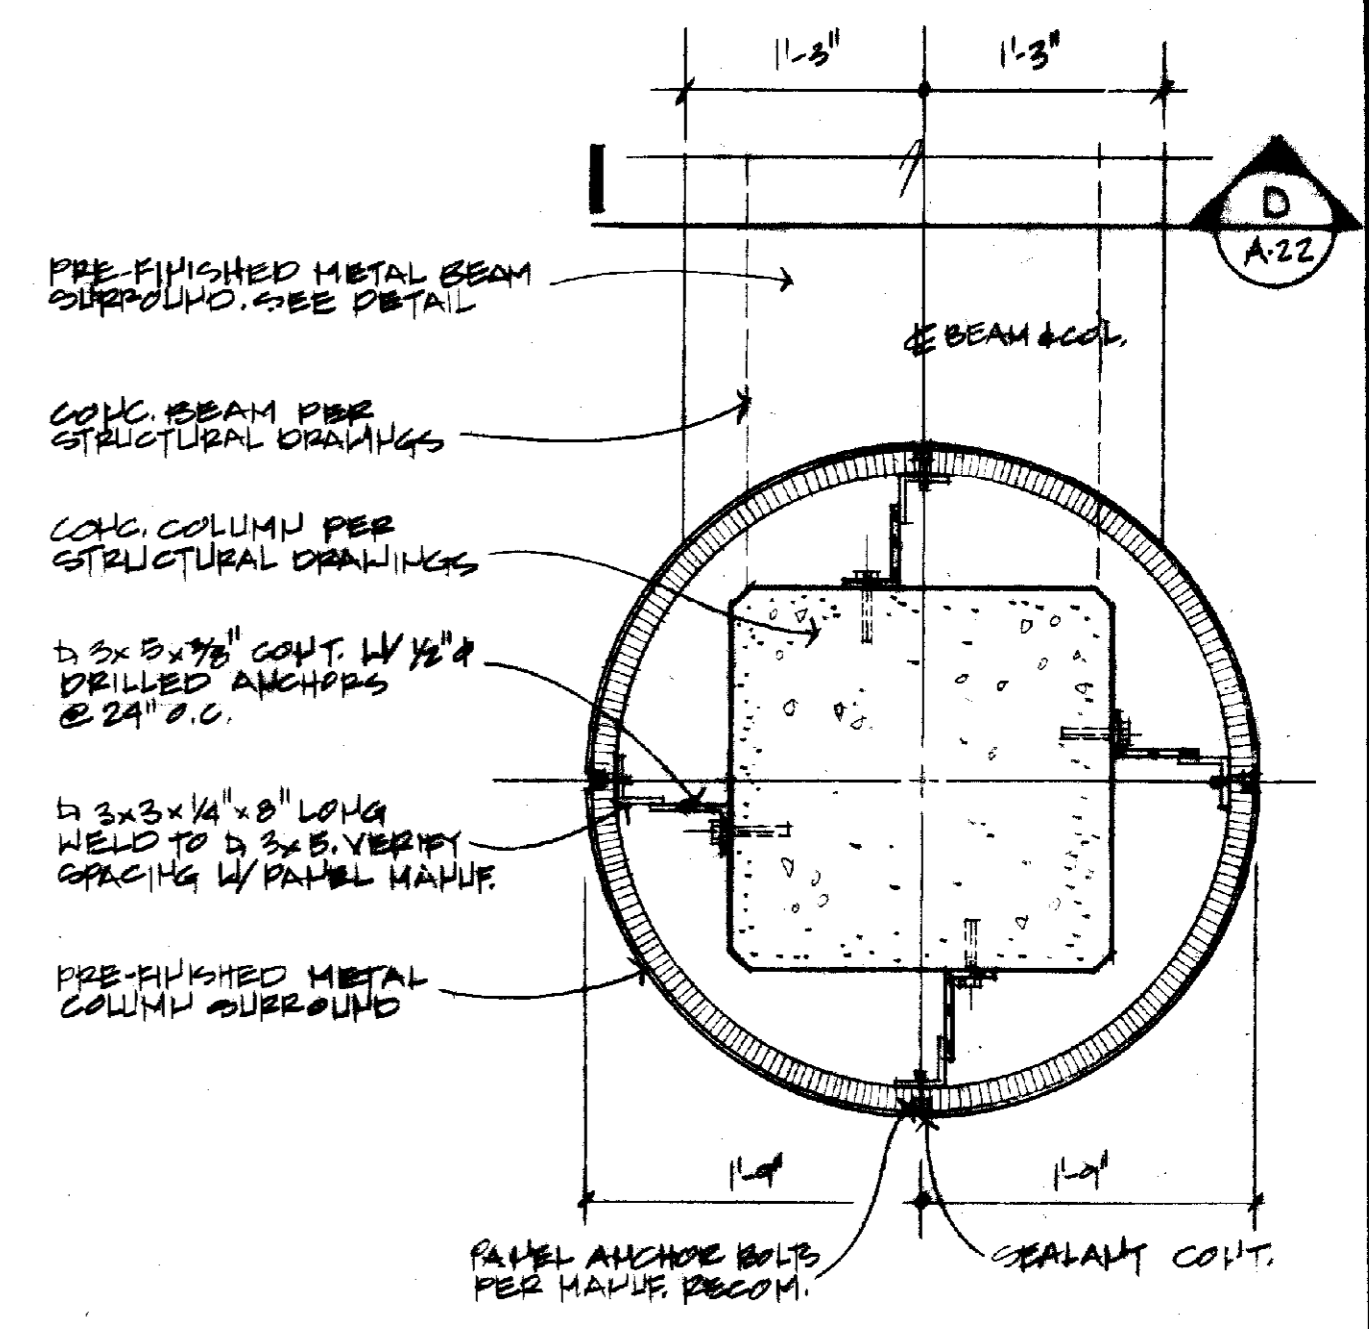

COLUMN DETAIL
 1/4"=1'-0"

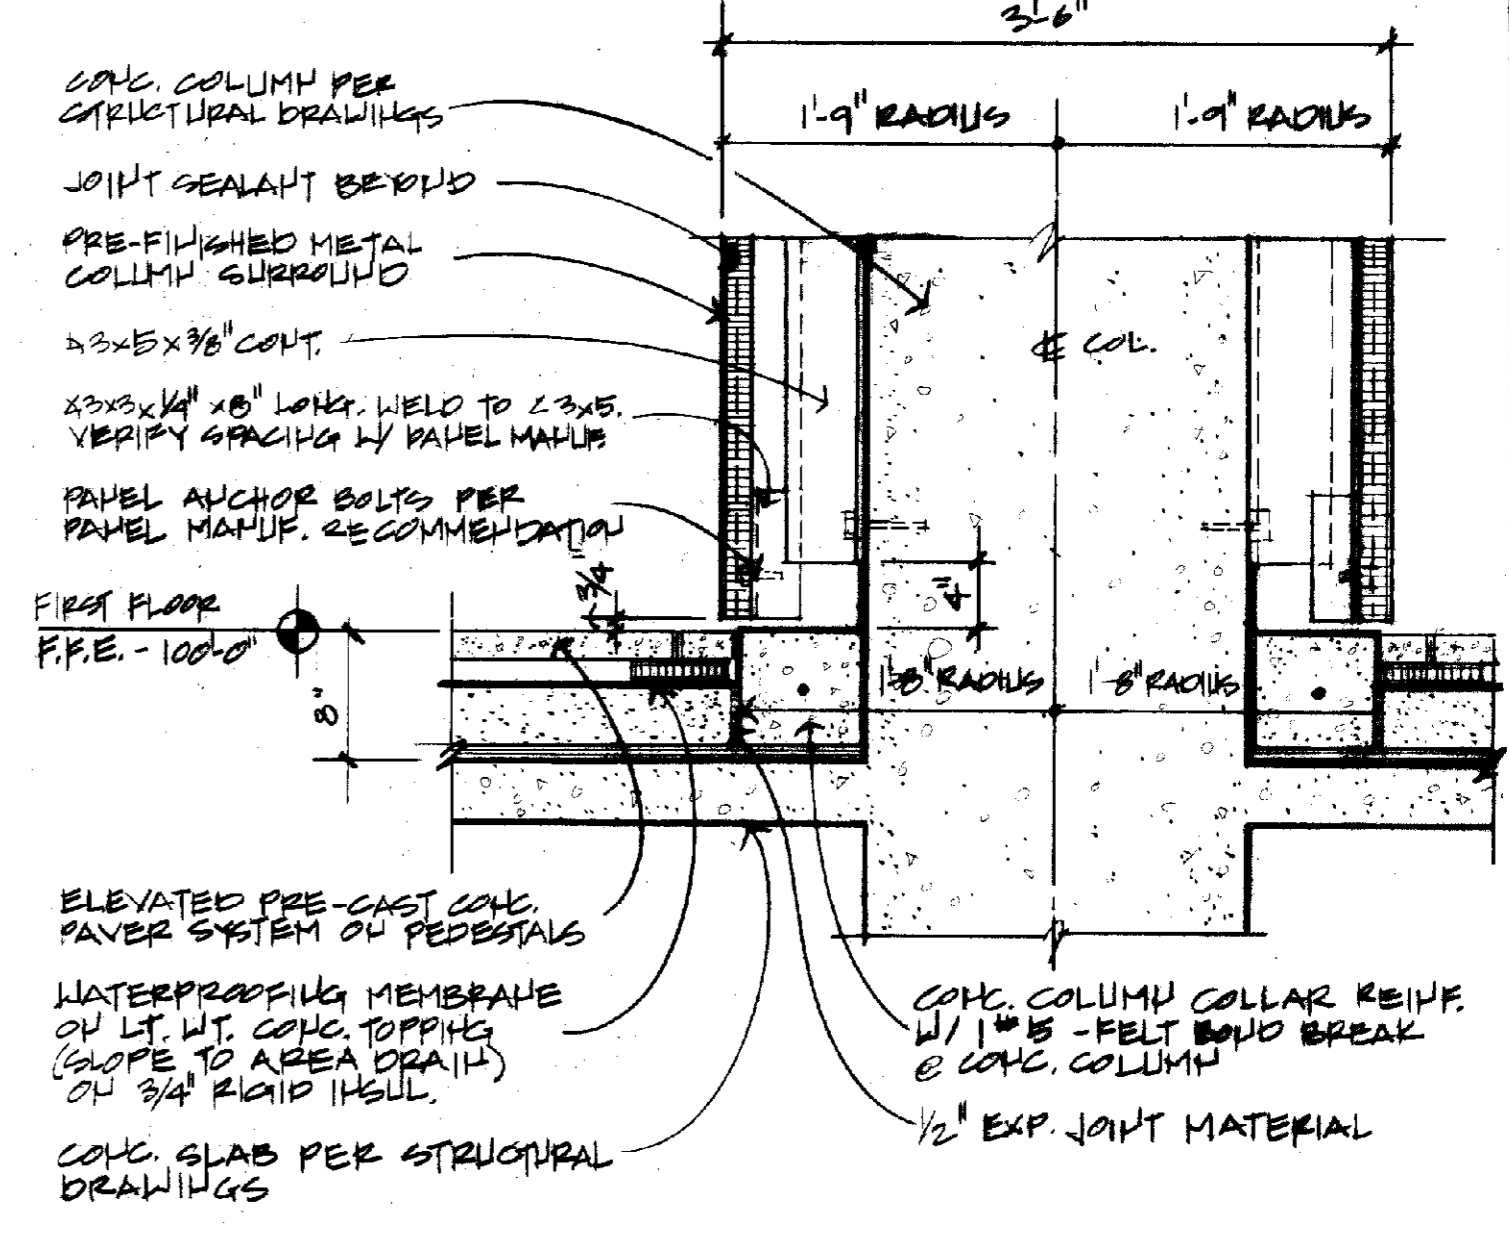


COLUMN BASE DETAIL
 1/4"=1'-0"

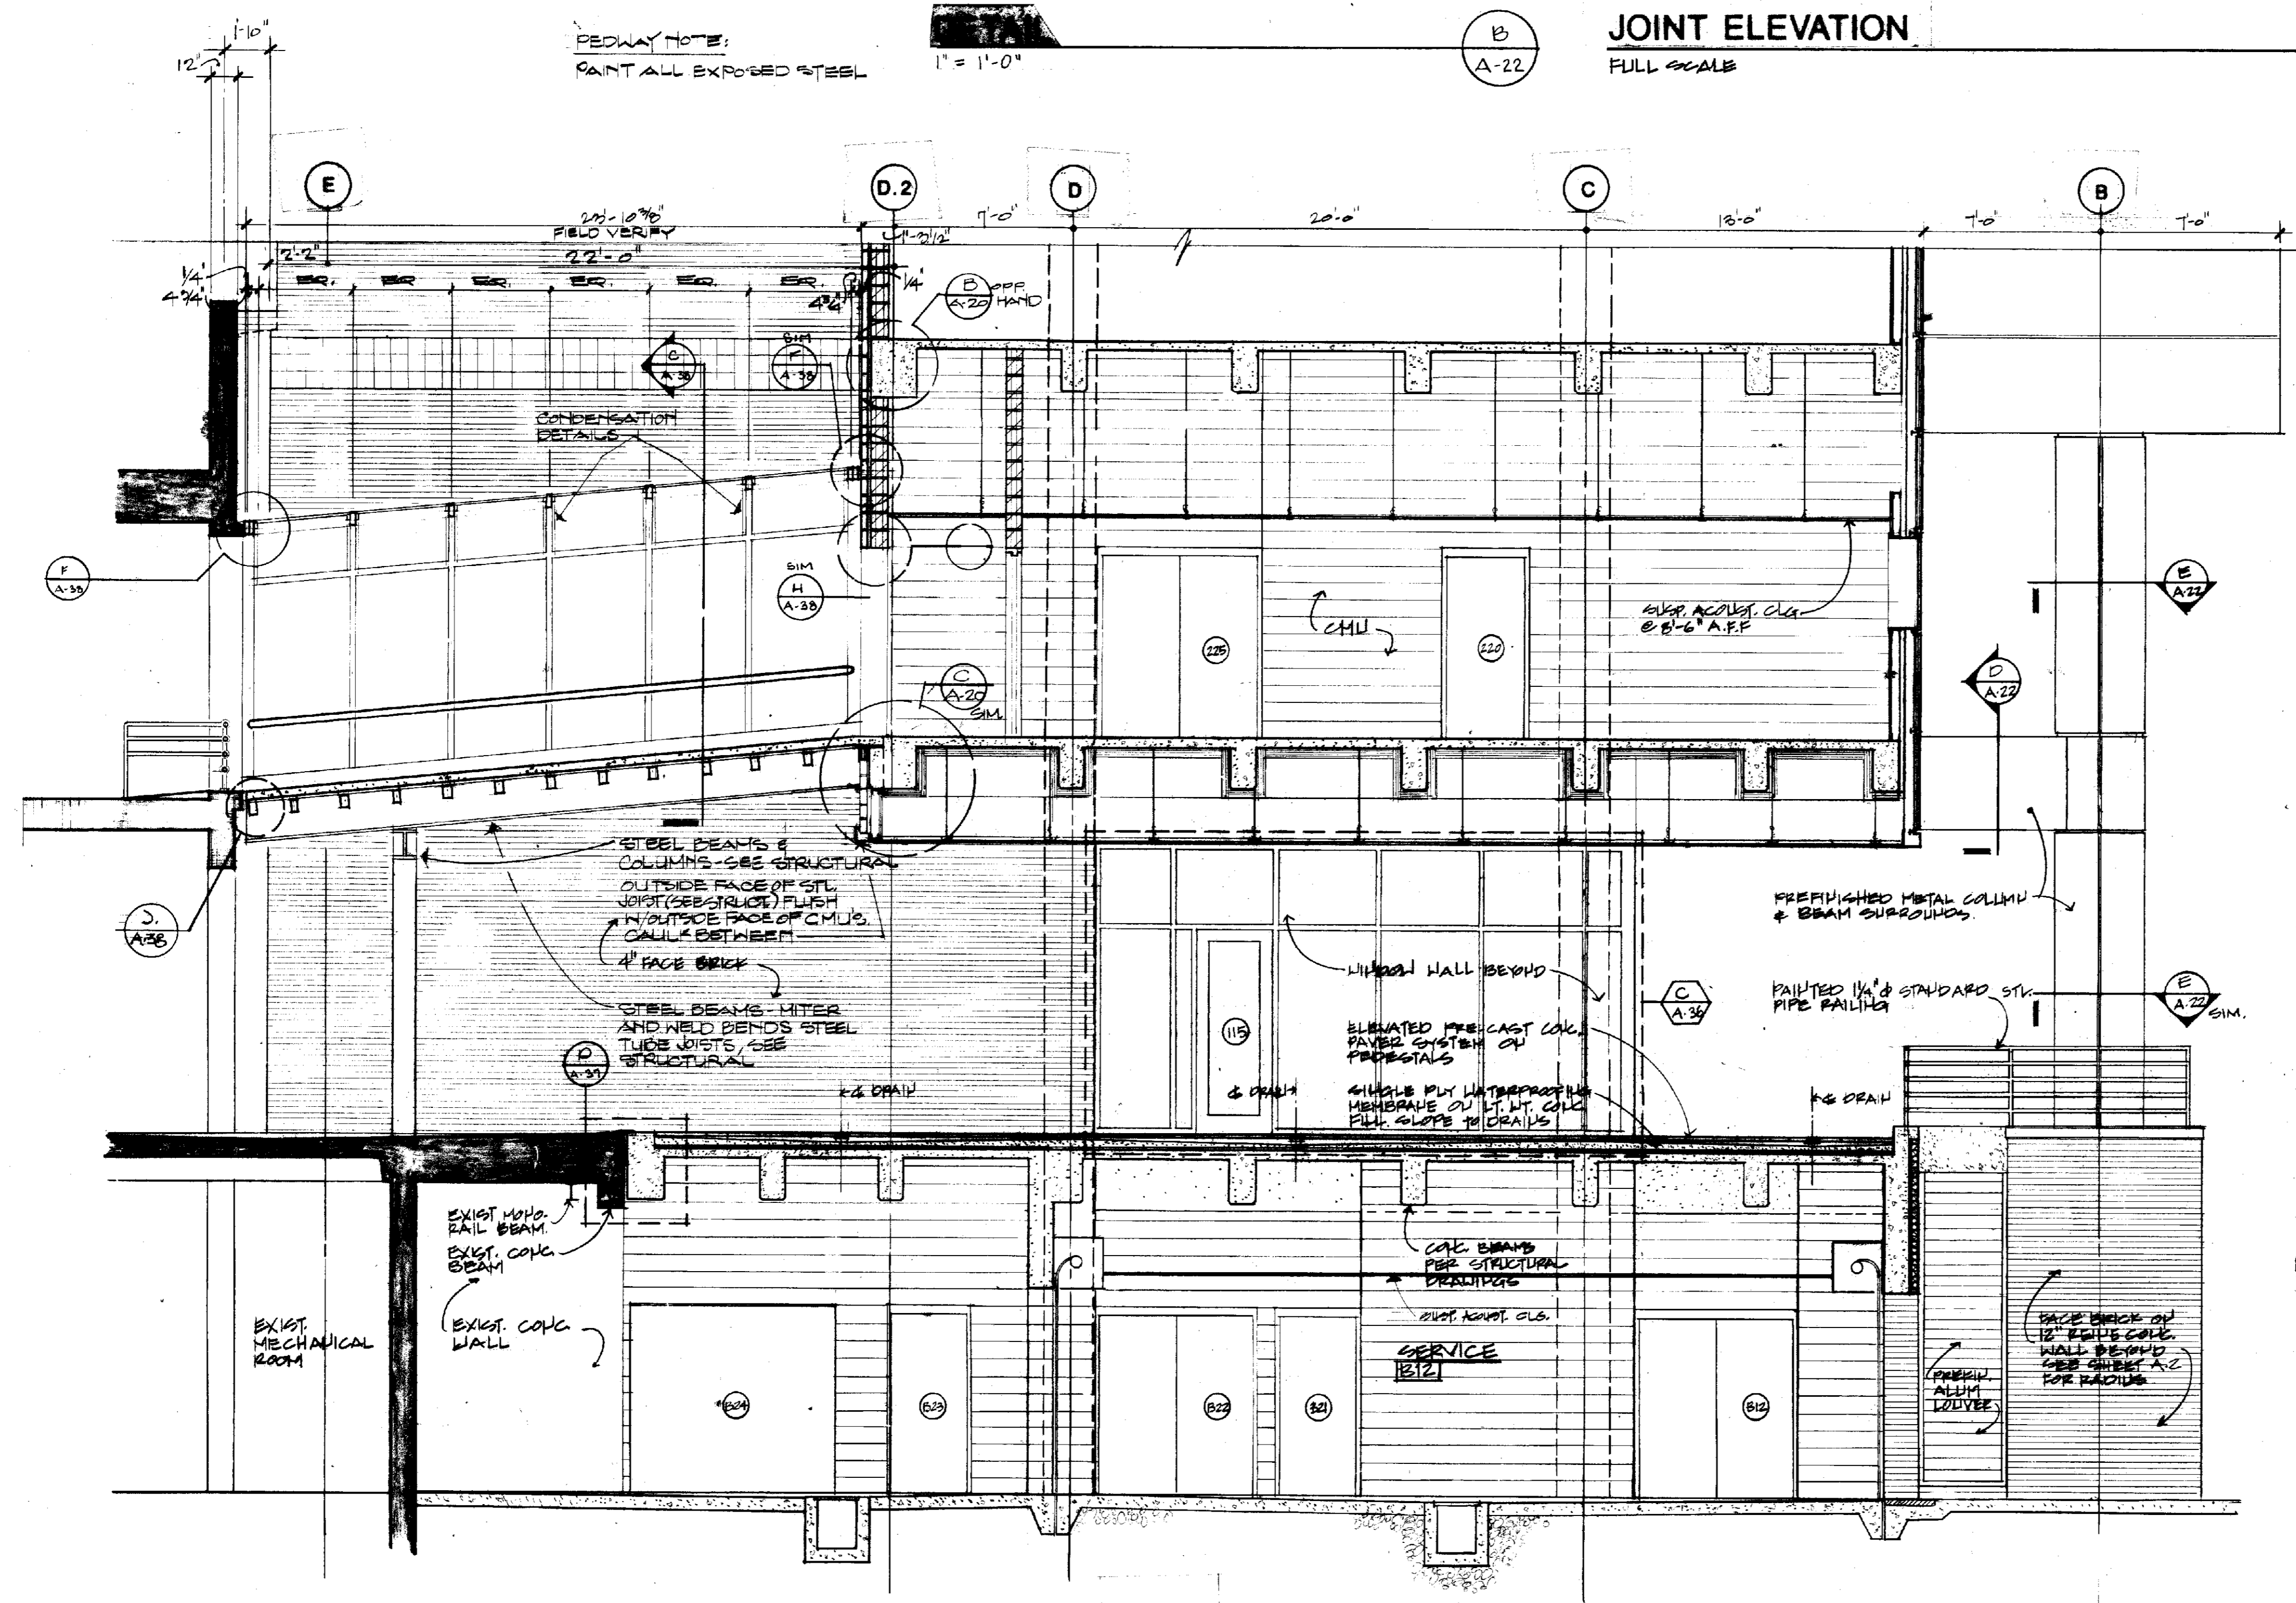


PARTIAL BUILDING SECTION
 1/4"=1'-0"

A
 A-22


F
 A-22

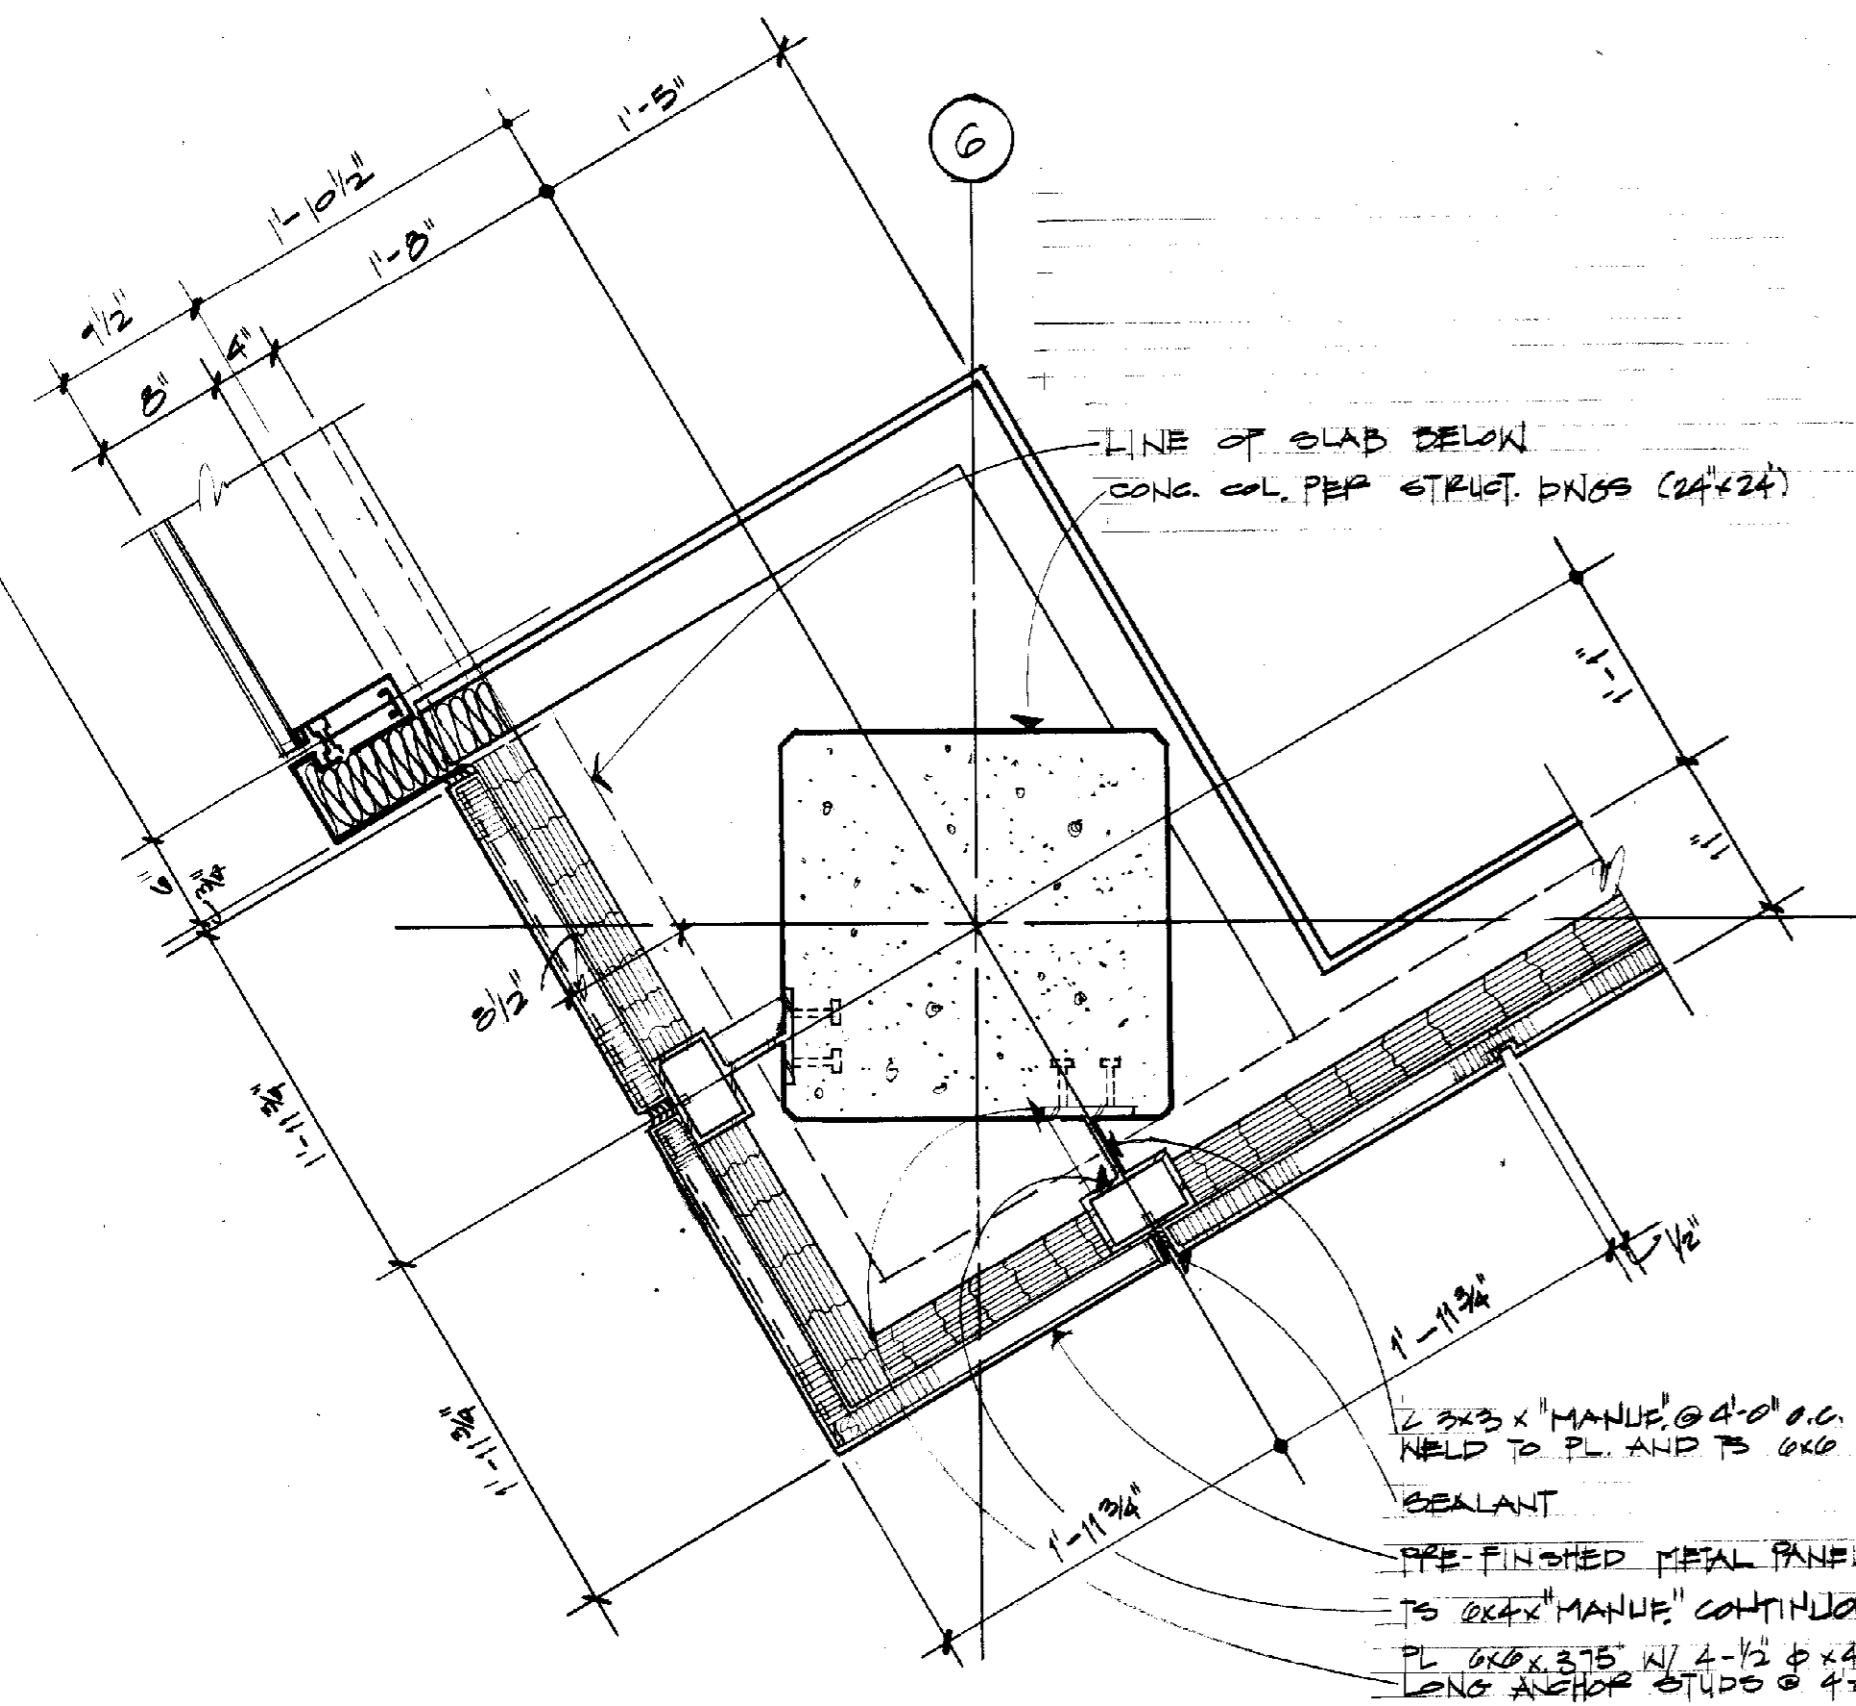


DETAIL
1" = 1'-0"
A
A/23

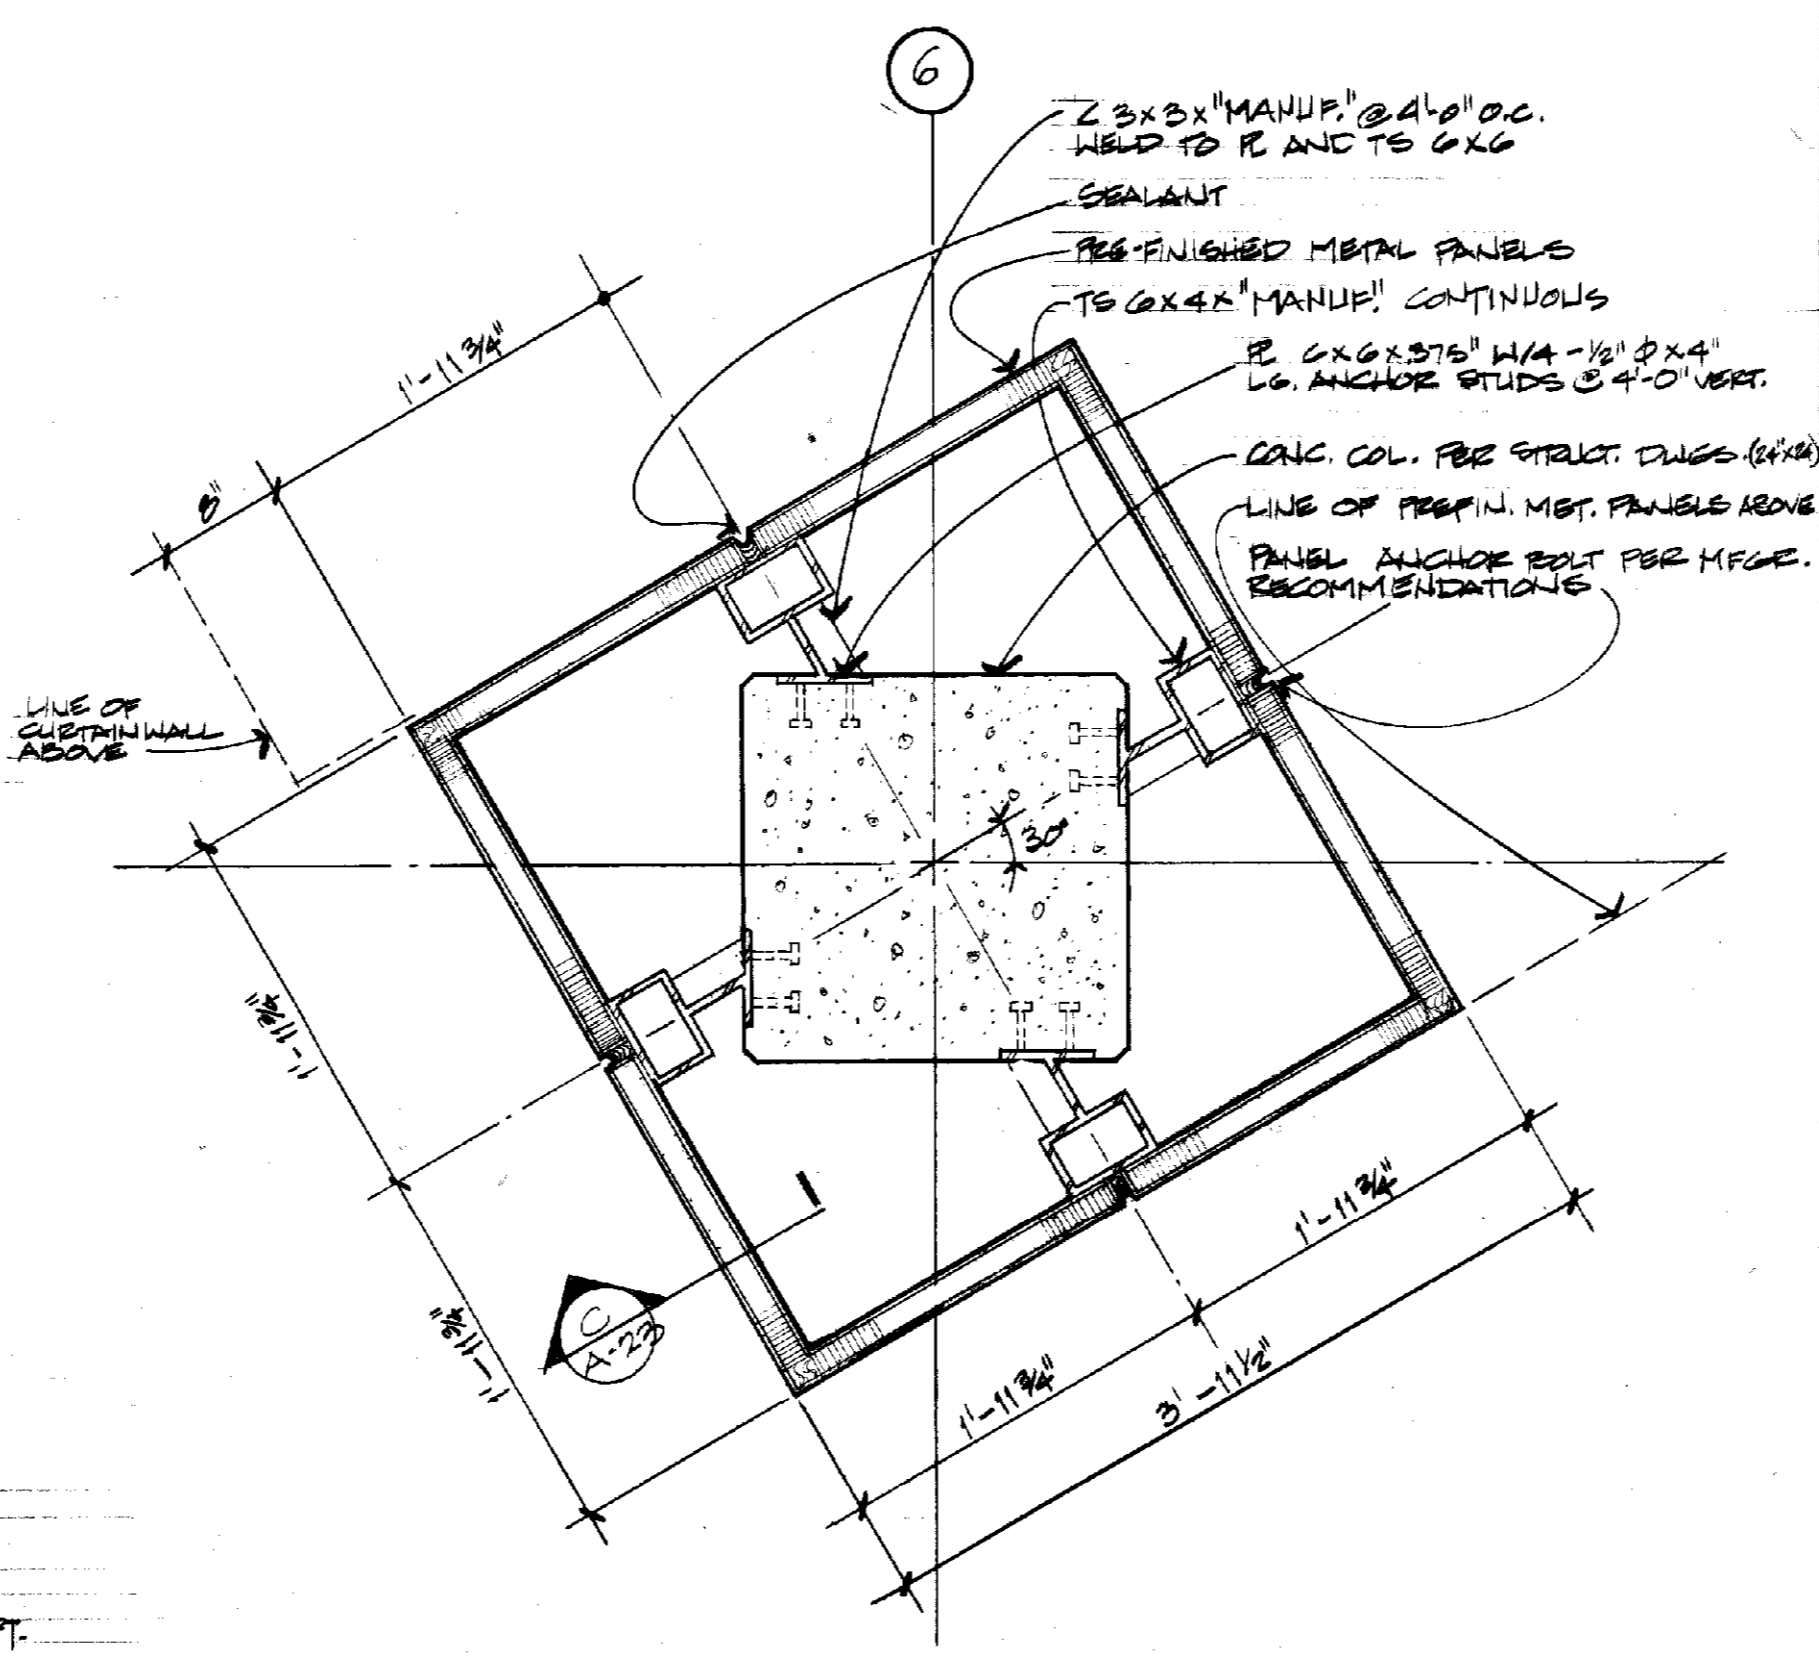

DETAIL
1" = 1'-0"
B
A/23

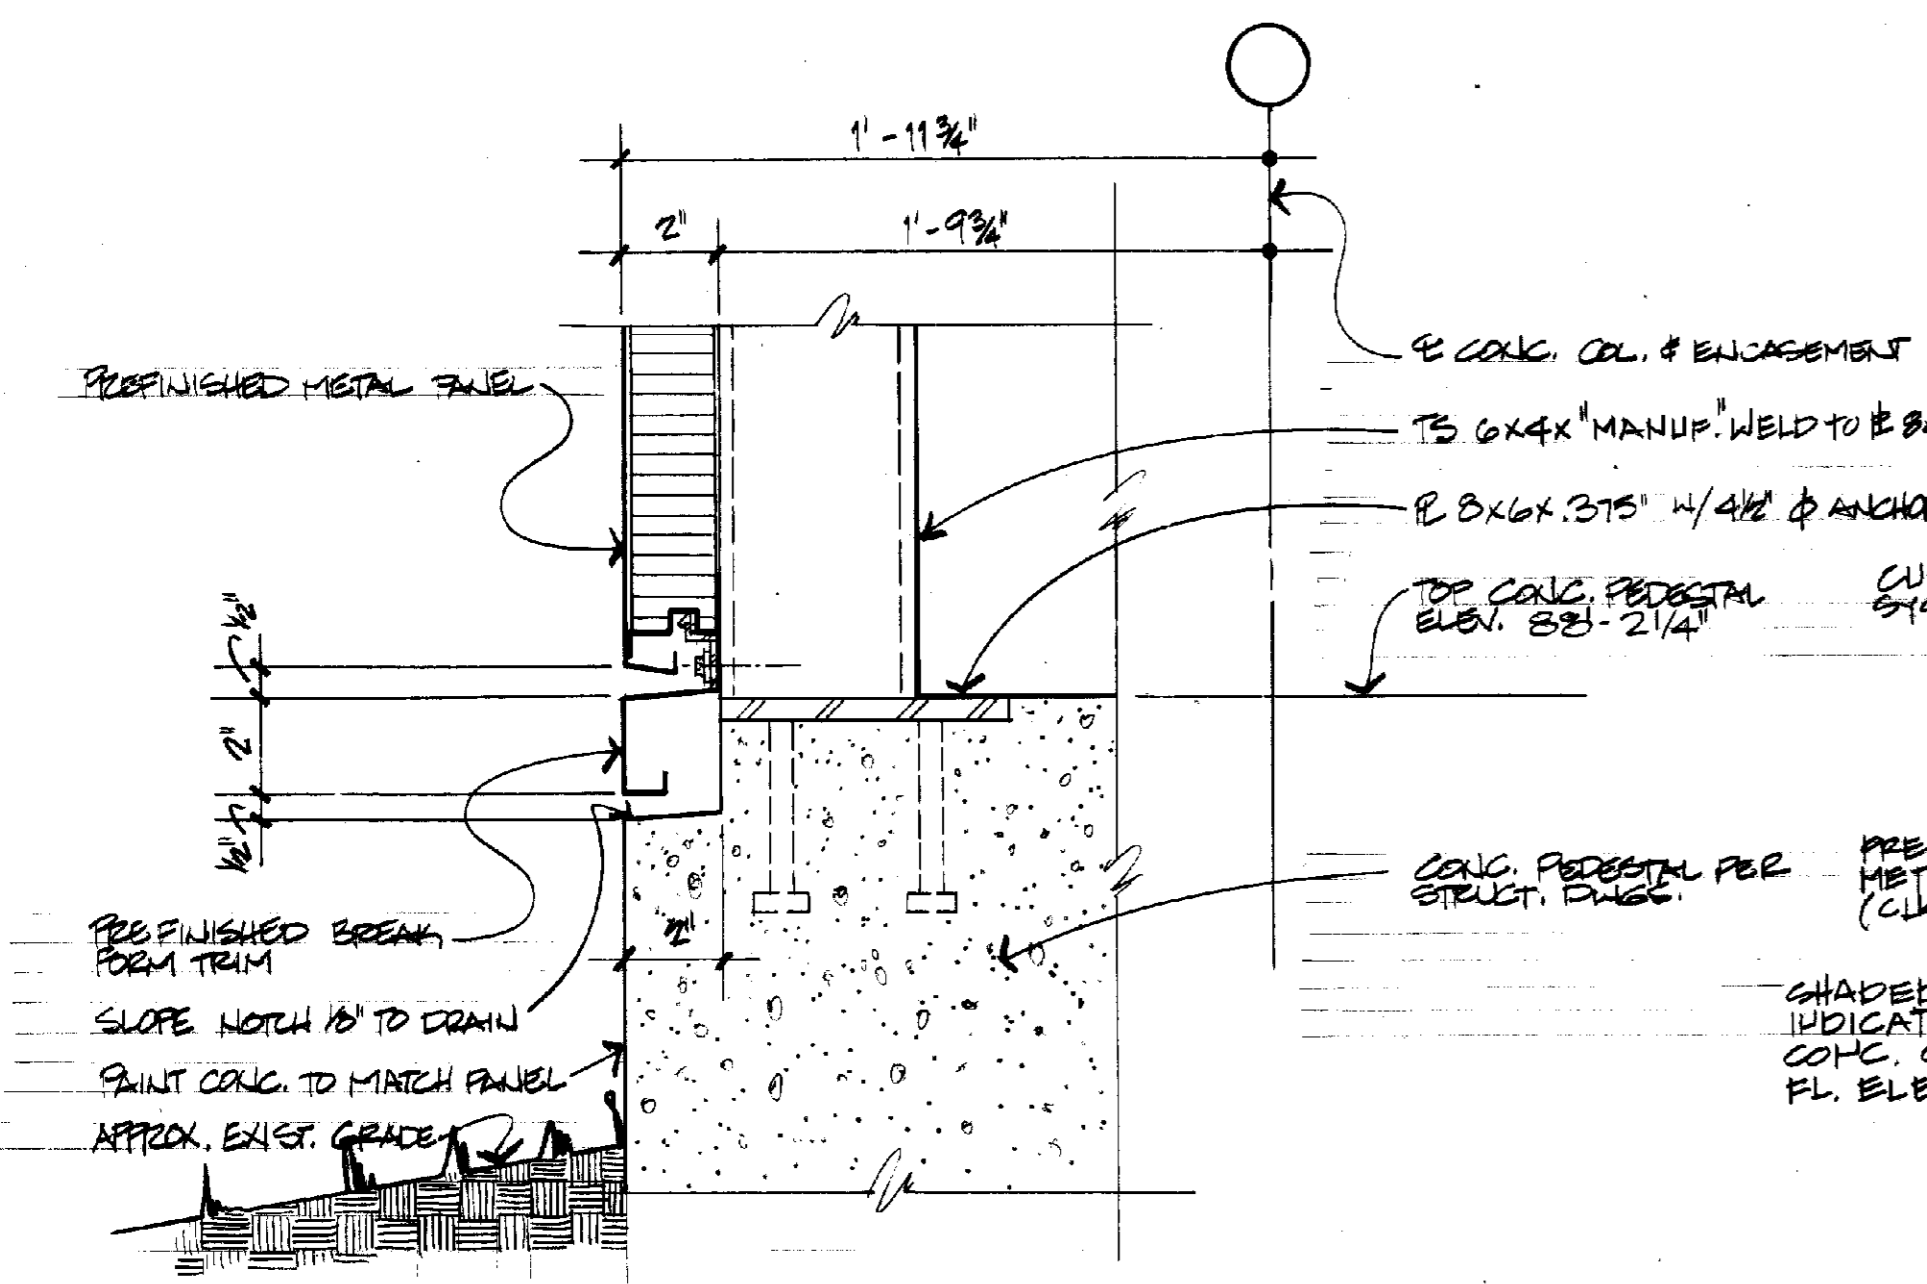

DETAIL
3" = 1'-0"
C
A/23

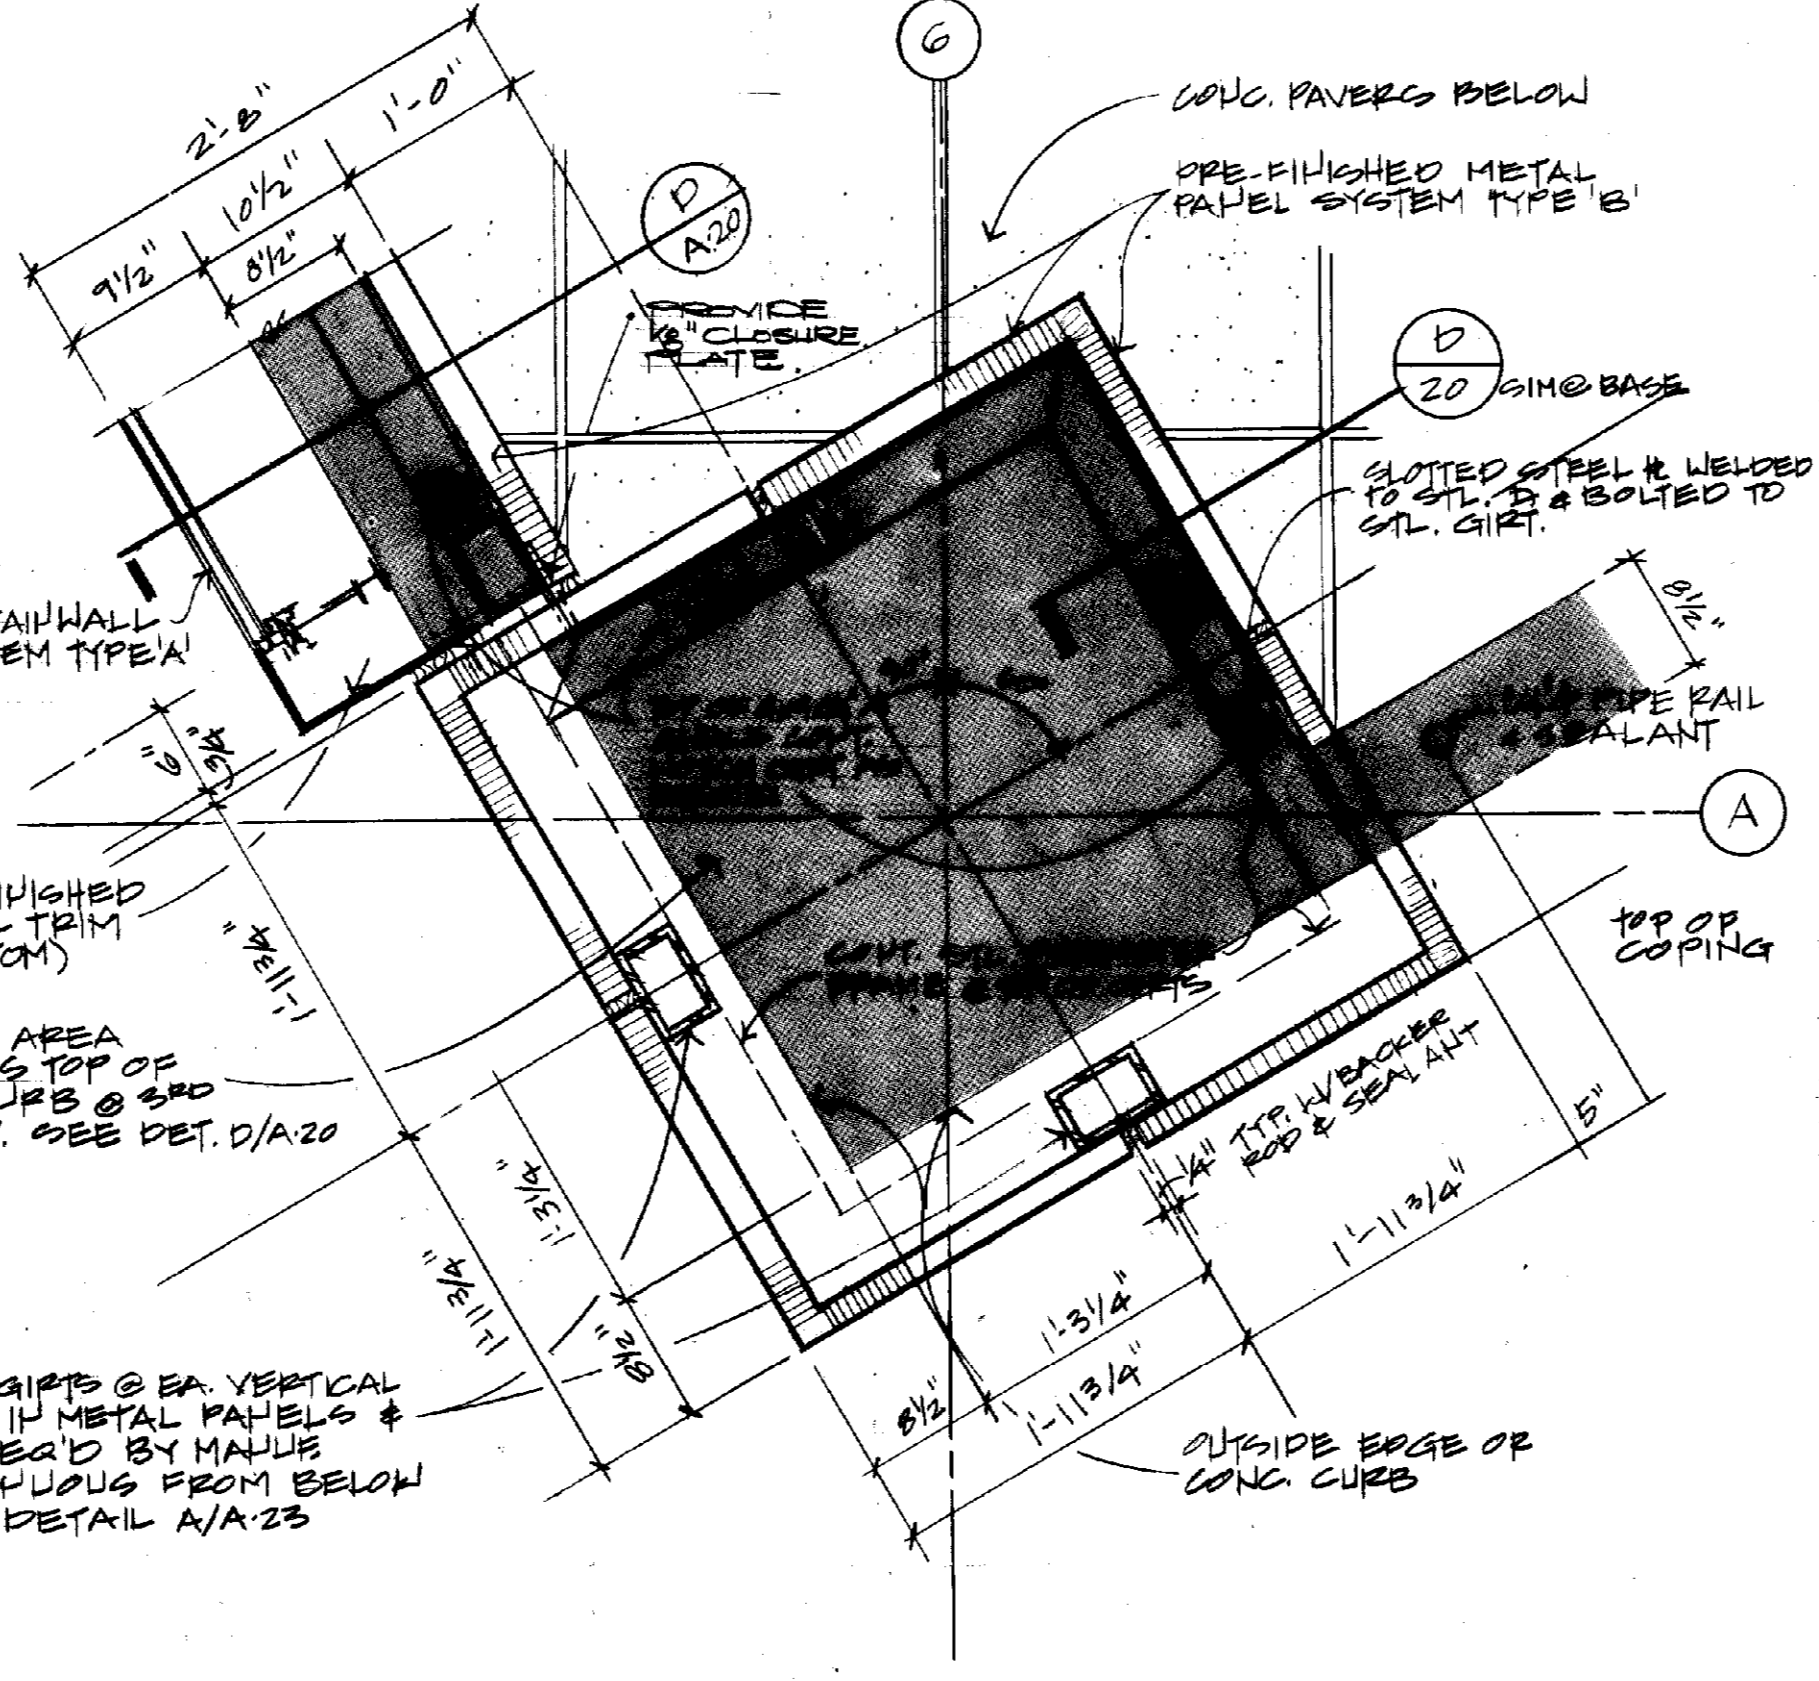


DETAIL
1" = 1'-0"
D
A/23

PARTITION TYPES

NOTE: REFER TO REFLECTED CEILING PLANS FOR INDICATION OF WHICH WALLS CONTINUE TO UNDERSIDE OF CONG. SLAB ABOVE

1. 1/2" REINFORCED CONCRETE RESTAINING WALL
2. REINFORCED CONCRETE RESTAINING WALL W/ 1/2" FACE BRICK
3. REINFORCED CONCRETE WALL W/ 1/2" RIGID INSULATION, 4" CONG. BLOCK
4. REINFORCED CONCRETE WALL W/ 1/2" RIGID INSULATION, 4" FACE BRICK
5. 8" CONG. BLOCK, 1/2" RIGID INSUL., 4" FACE BRICK
6. 8" CONG. BLOCK, 1/2" RIGID INSUL., 4" STRUCT. FACE CONG. BLOCK
7. PRE-FINISHED MTL PANELS W/ STRUCTURAL GIRTS @ 3'-0" W/ RIGID ROLL-FACED INSULATION, 2 1/2" MTL STUDS, 3/8" GYP. BD.
8. 1" EFFECTIVE INSULATING GLASS (2 REFRACTIVE SPANDRELS) ON ALUM. FRAME (4 SIDE STRUCT. GLUCONER) @ 3" SPAN-TO-GLID INSUL. (2 SPANDRELS), 2 1/2" MET. STUDS @ 3'-0" GYP. BD.
9. 8" CONG. BLOCK
10. 8" CONCRETE BLOCK EXTEND FULL HEIGHT TO DECK ABOVE
11. 8" CONCRETE BLOCK (2 HR. UL EXTEND) EXTEND FULL HEIGHT TO DECK ABOVE
12. 5/8" F.C. GYP. BD. (TYPE X) EA. FACE ON 3/8" MTL STUDS @ 1'-0" O.C.
13. 3/8" GYP. BD. EA. FACE ON 3/8" MTL STUDS @ 1'-0" O.C. W/ SOUND ATTENUATION BLANKETS BETWEEN METAL STUDS, ETC. CAULK PERIMETER OF WALLS
14. 3/8" GYP. BD. EACH FACE ON 3/8" MTL STUDS
15. 3/8" GYP. BD. ON 2 1/2" METAL STUDS (SPANDRELS @ 3'-0" O.C.) W/ SOUND ATTENUATION BLANKETS BETWEEN STUDS, ETC. CAULK PERIMETER OF WALLS
16. 2 LAYERS 5/8" F.C. GYP. BD. (TYPE X) EA. FACE ON 3/8" MTL STUDS
17. 2 LAYERS 5/8" F.C. GYP. BD. EA. FACE W/ WIRE MESH ONE SIDE ON 3/8" MTL STUDS @ 1'-0" O.C. W/ SOUND ATTENUATION BLANKETS BETWEEN STUDS. CAULK PERIMETER OF WALLS

AS BUILT

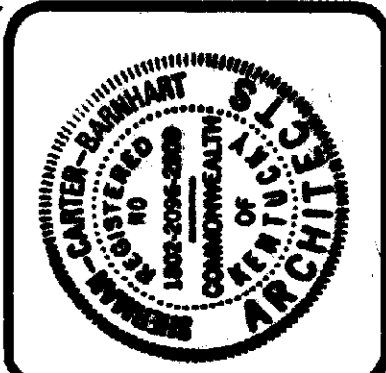

ROBOTICS FACILITY
LEXINGTON CAMPUS
UNIVERSITY OF KENTUCKY
LEXINGTON, KENTUCKY

University of Kentucky
Lexington, Kentucky


PARTITION SCHEDULE AND DETAILS
Sherman Carter Barnhart
PARTNERS IN ARCHITECTURE
LEXINGTON FINANCIAL CENTER, SUITE 800 • 255 W. MAIN • LEXINGTON, KY 40507 • 606-254-8535

JOB NO. 8708
DATE 10-1-87
DRAWN PFB
CHECKED OEB
FILE NO. 431.0

REVISIONS
▲ FEB 7, 1991

SHEET

A-23

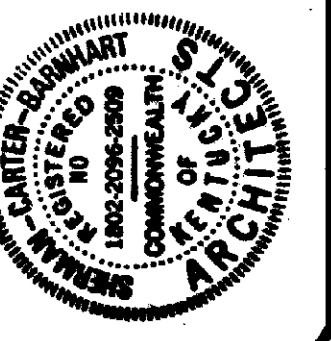

ROBOTICS FACILITY
LEXINGTON CAMPUS
UNIVERSITY OF KENTUCKY
LEXINGTON, KENTUCKY

University of Kentucky
Lexington, Kentucky

10.19.87
SHERMAN CARTER
ARCHITECT

ENLARGED STAIR PLANS & DETAILS

Sherman Carter - Barnhart
PARTNERS IN ARCHITECTURE
LEXINGTON FINANCIAL CENTER - SUITE 900 - 250 W. MAIN - LEXINGTON, KY 40507 - 606/254-6551


JOB NO. 8708
DATE 10-1-87
DRAWN STAFF
CHECKED CEB
FILE NO. 431.0

NO.	REVISIONS


SHEET

A-24


- GENERAL STEEL STAIR NOTES**
1. ALL EXPOSED STEEL STAIR COMPONENTS SHALL BE PAINTED.
 2. THOROUGH REMOVAL OR PRE-PAINTING OF "PIECE MARKINGS" IS REQUIRED. BLEED THROUGH SHALL NOT BE ACCEPTED.
 3. MITER CUT AND WELD ALL TURNS IN STRINGERS.
 4. "OPEN" STRINGER ENDS ARE NOT ACCEPTABLE. ENDS SHOULD BE "CLOSED" WITH 1/4" PLATE STEEL, WELDED AND GRIND.
 5. PROVIDE 1/4" STEEL PLATE "CLOSERS" BETWEEN STRINGERS @ LANDINGS. CONTINUOUS WELD AND GRIND JOINTS.

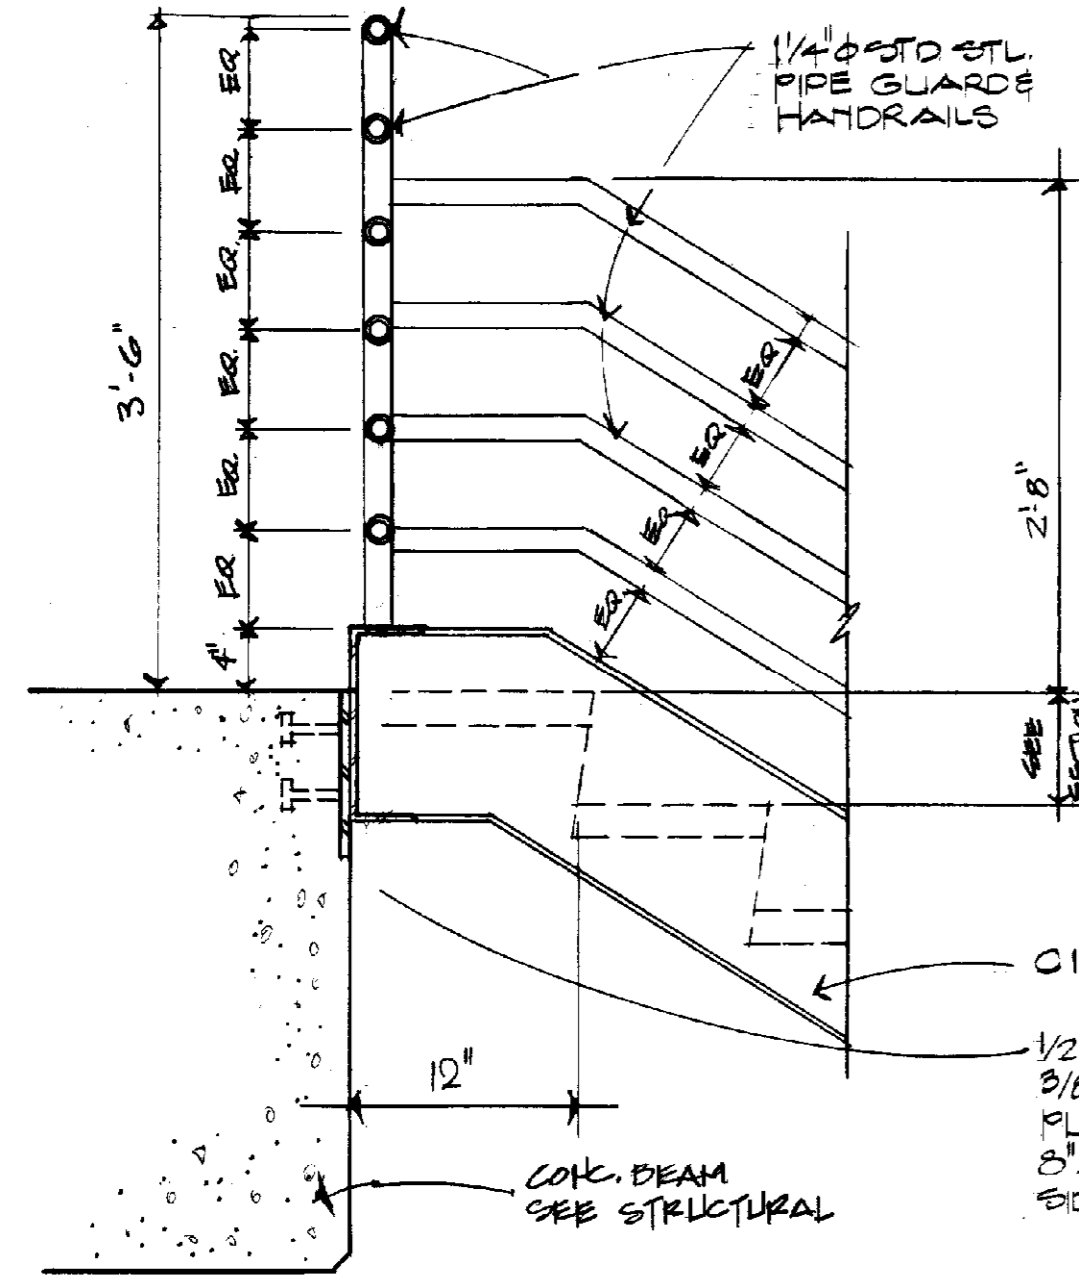


GUARD DETAIL
1/4"=1'-0"

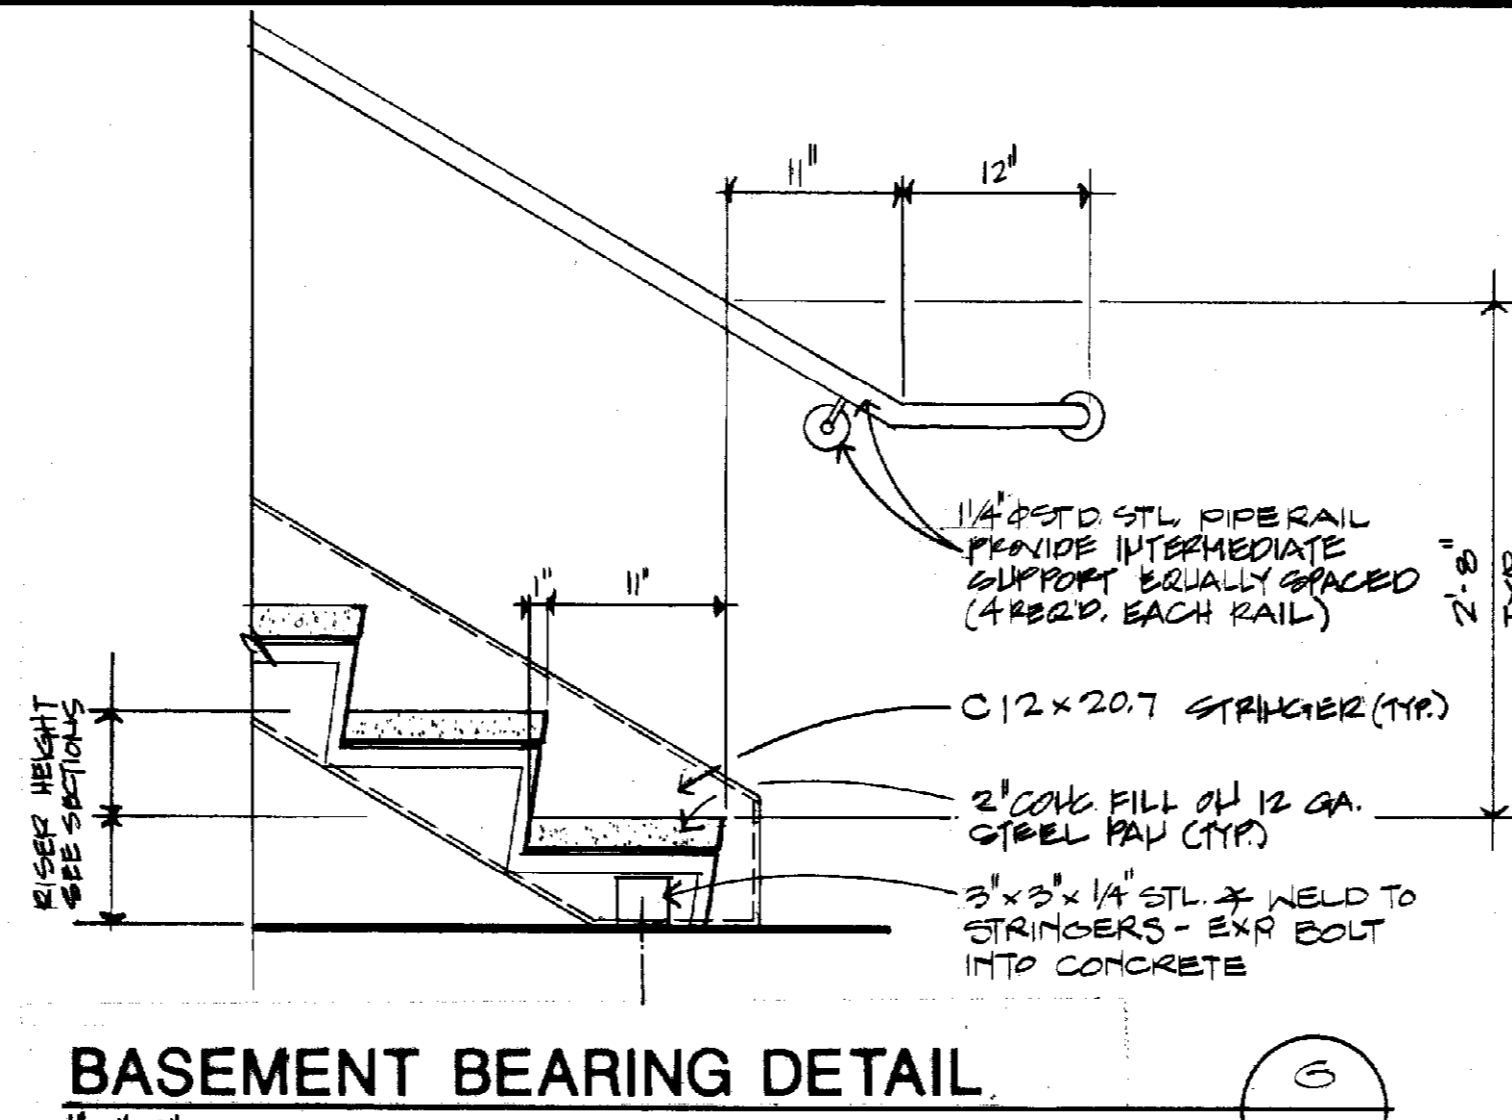


BASEMENT BEARING DETAIL
1/4"=1'-0"

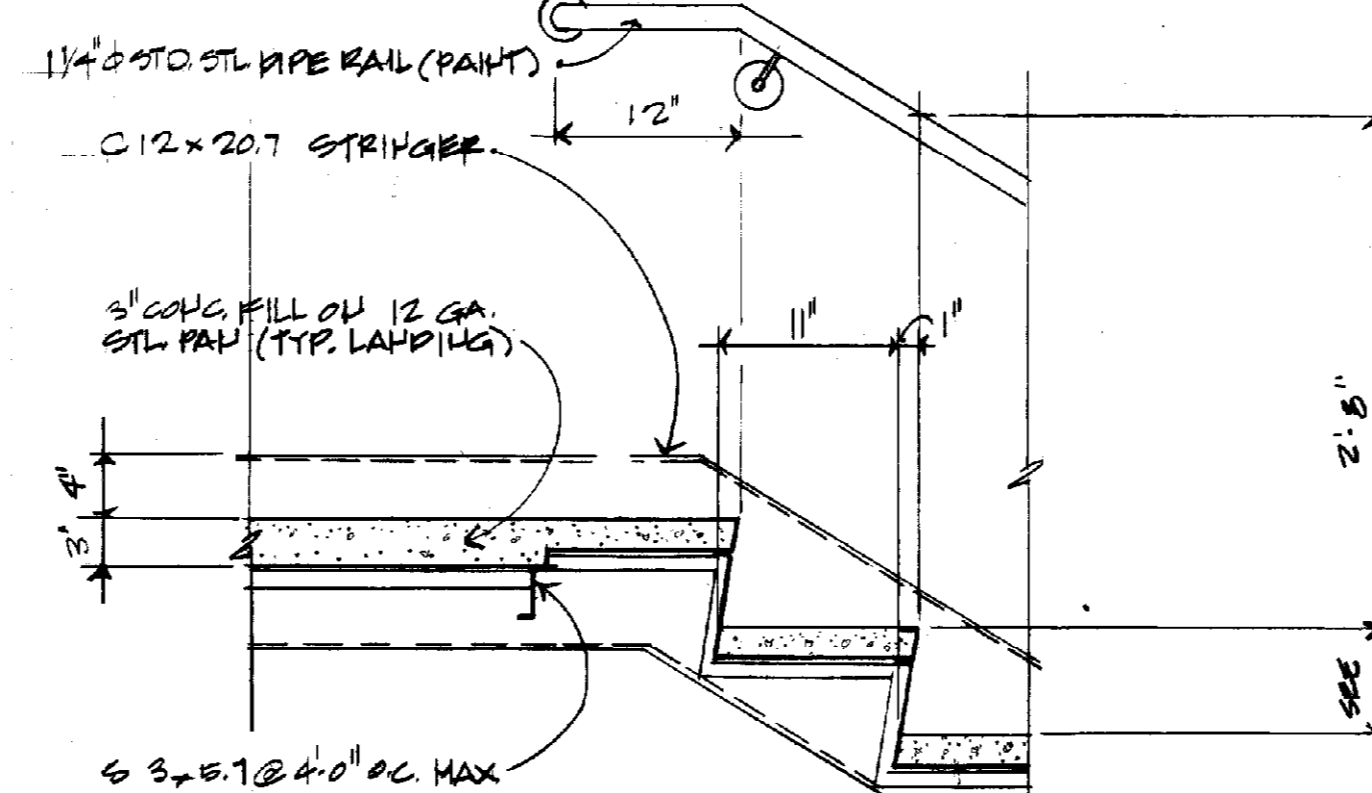


DETAIL
1/4"=1'-0"

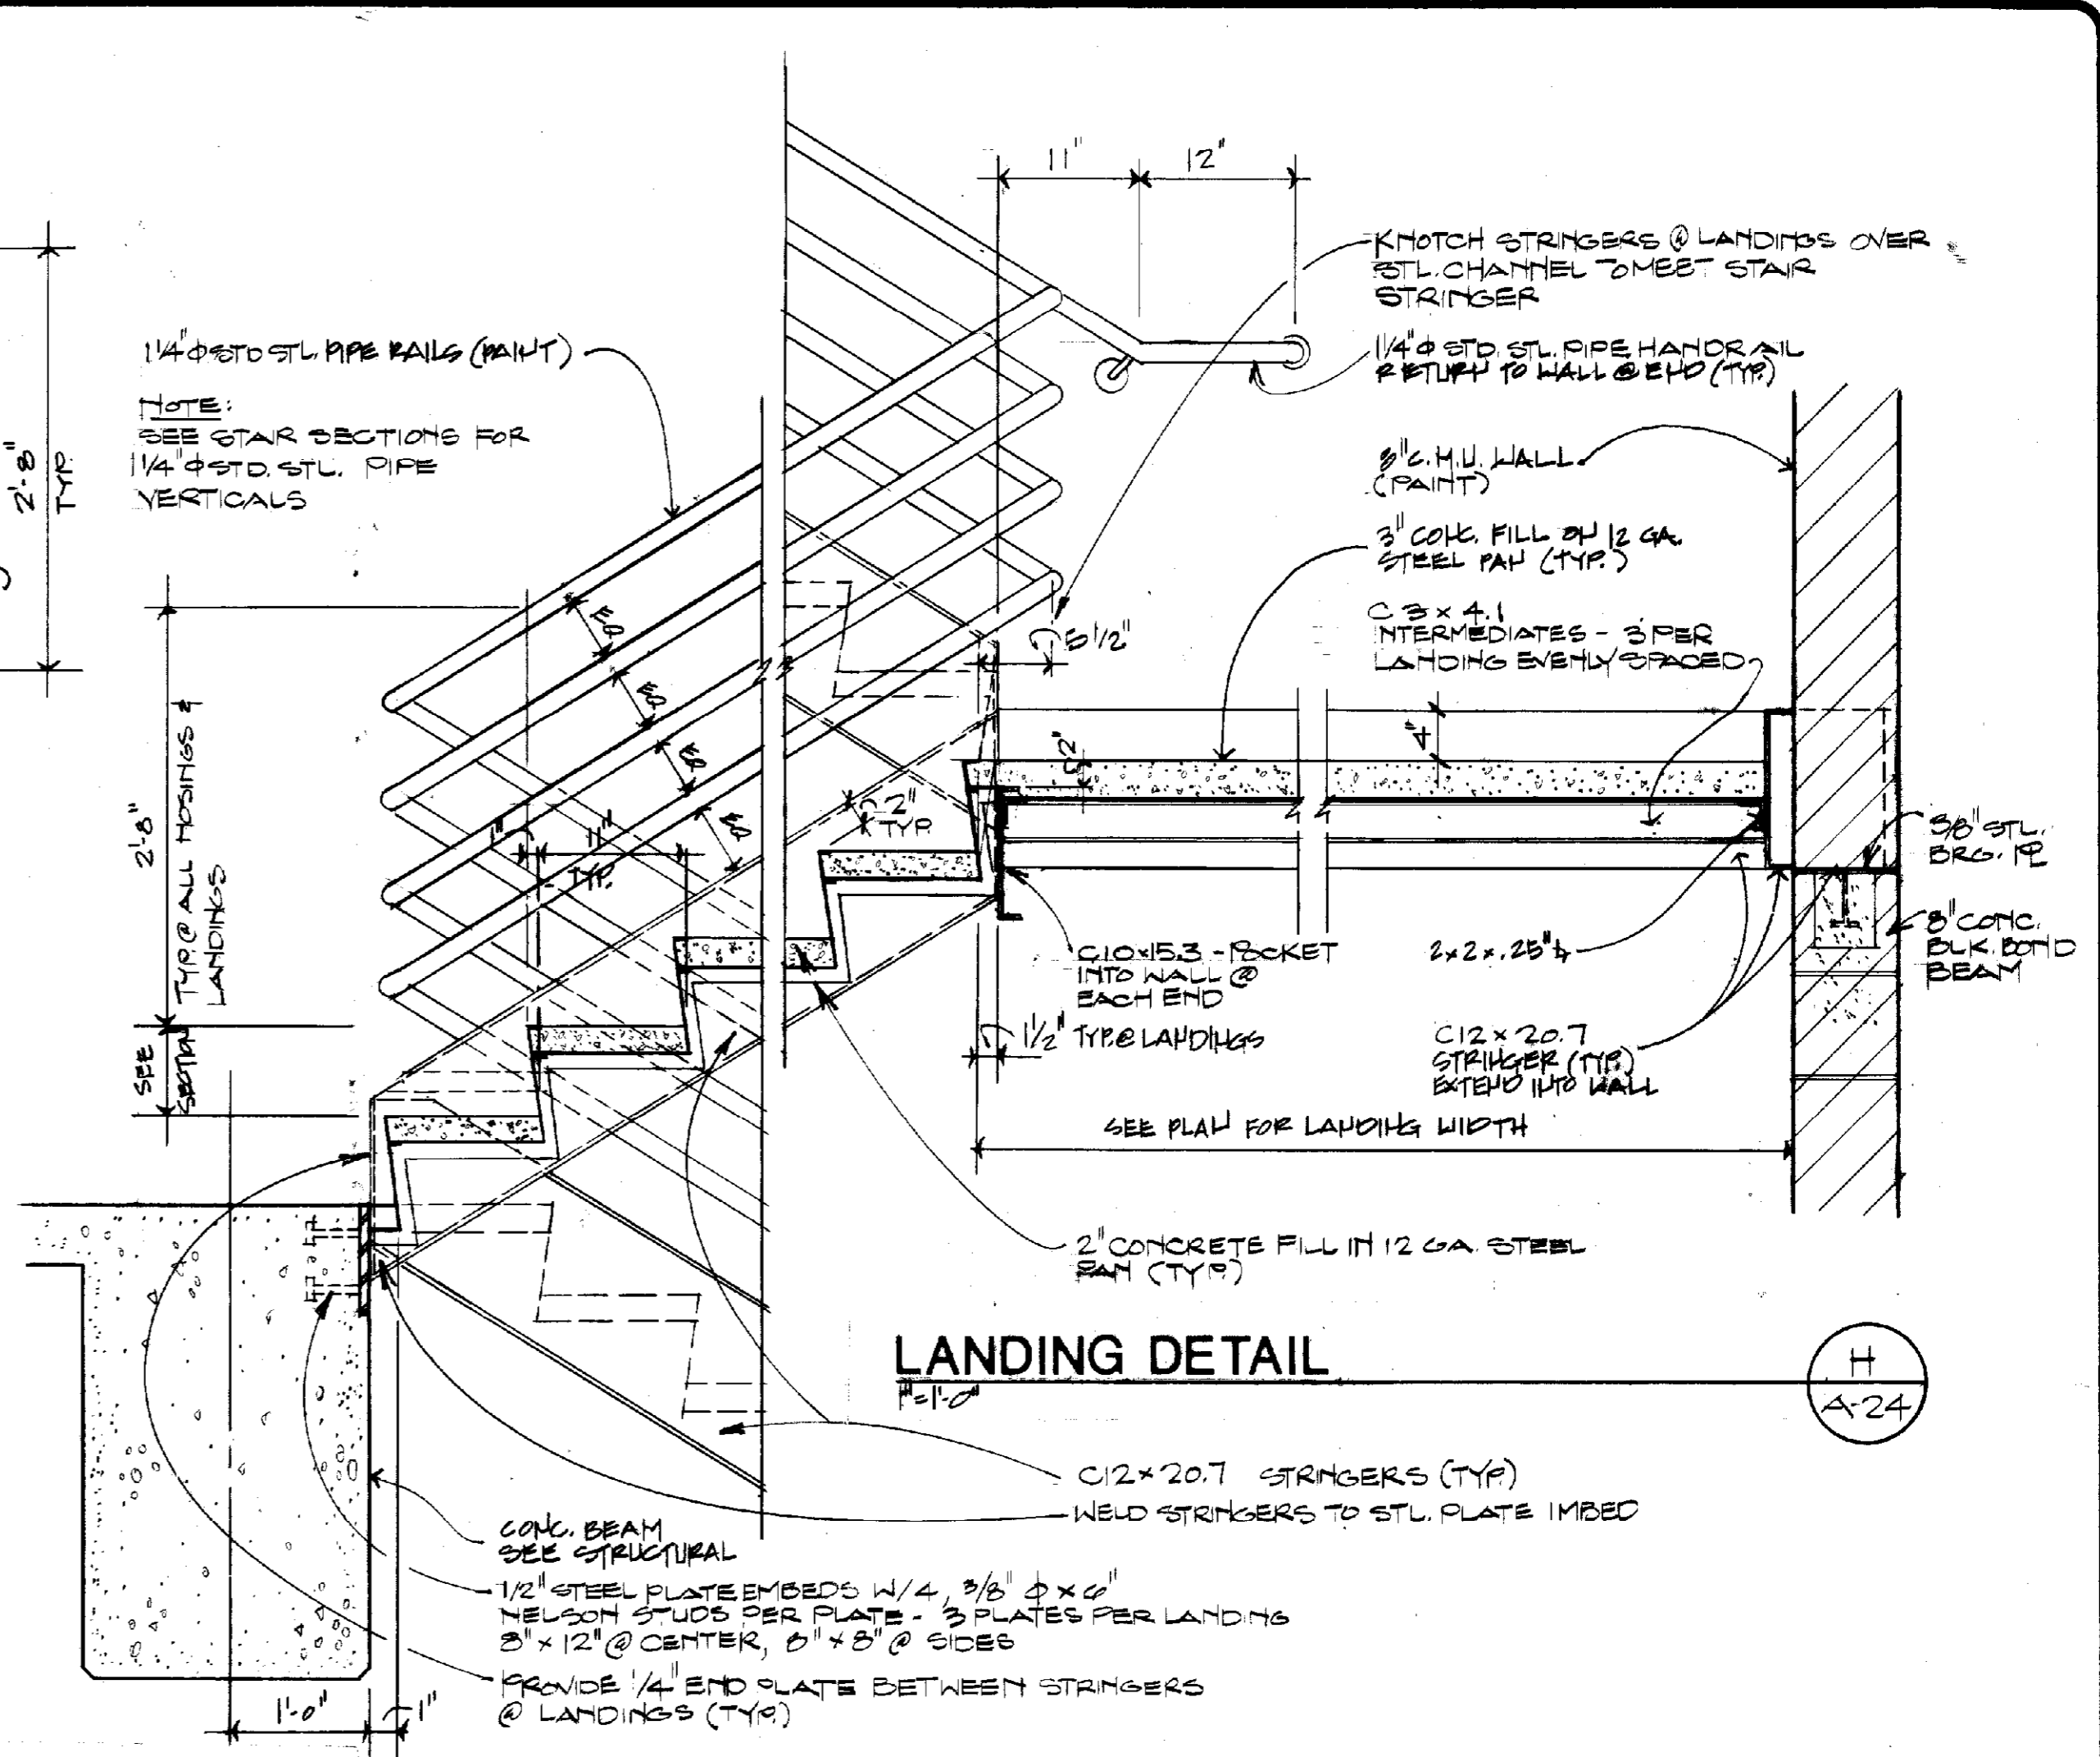


LANDING DETAIL
1/4"=1'-0"

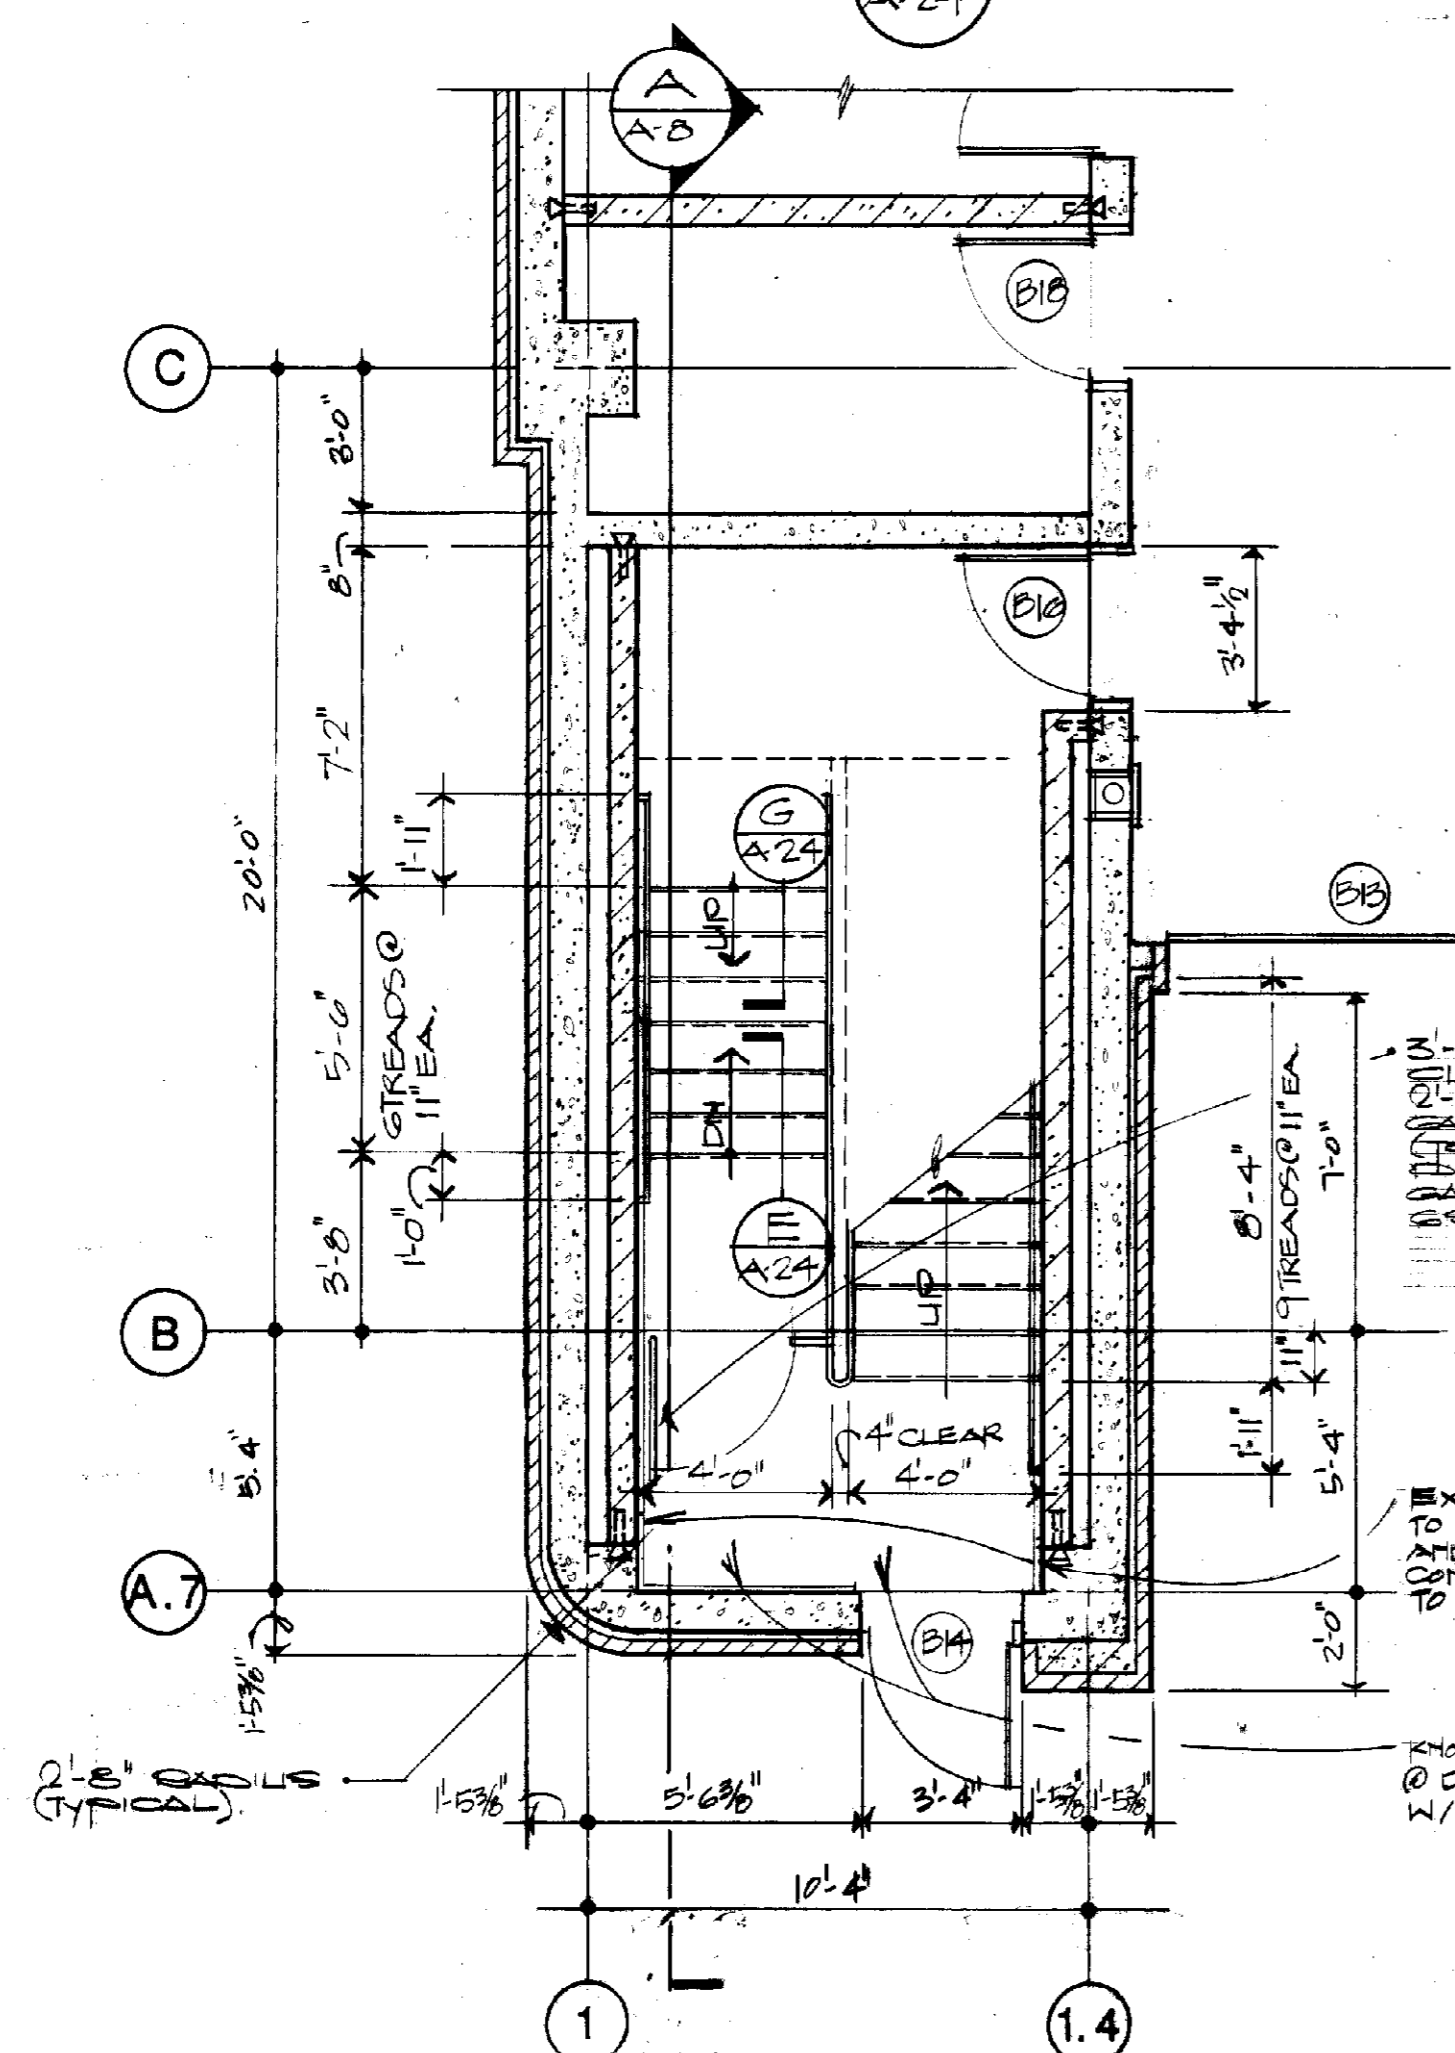


ENLARGED STAIR PLAN (Basement)
1/4"=1'-0"

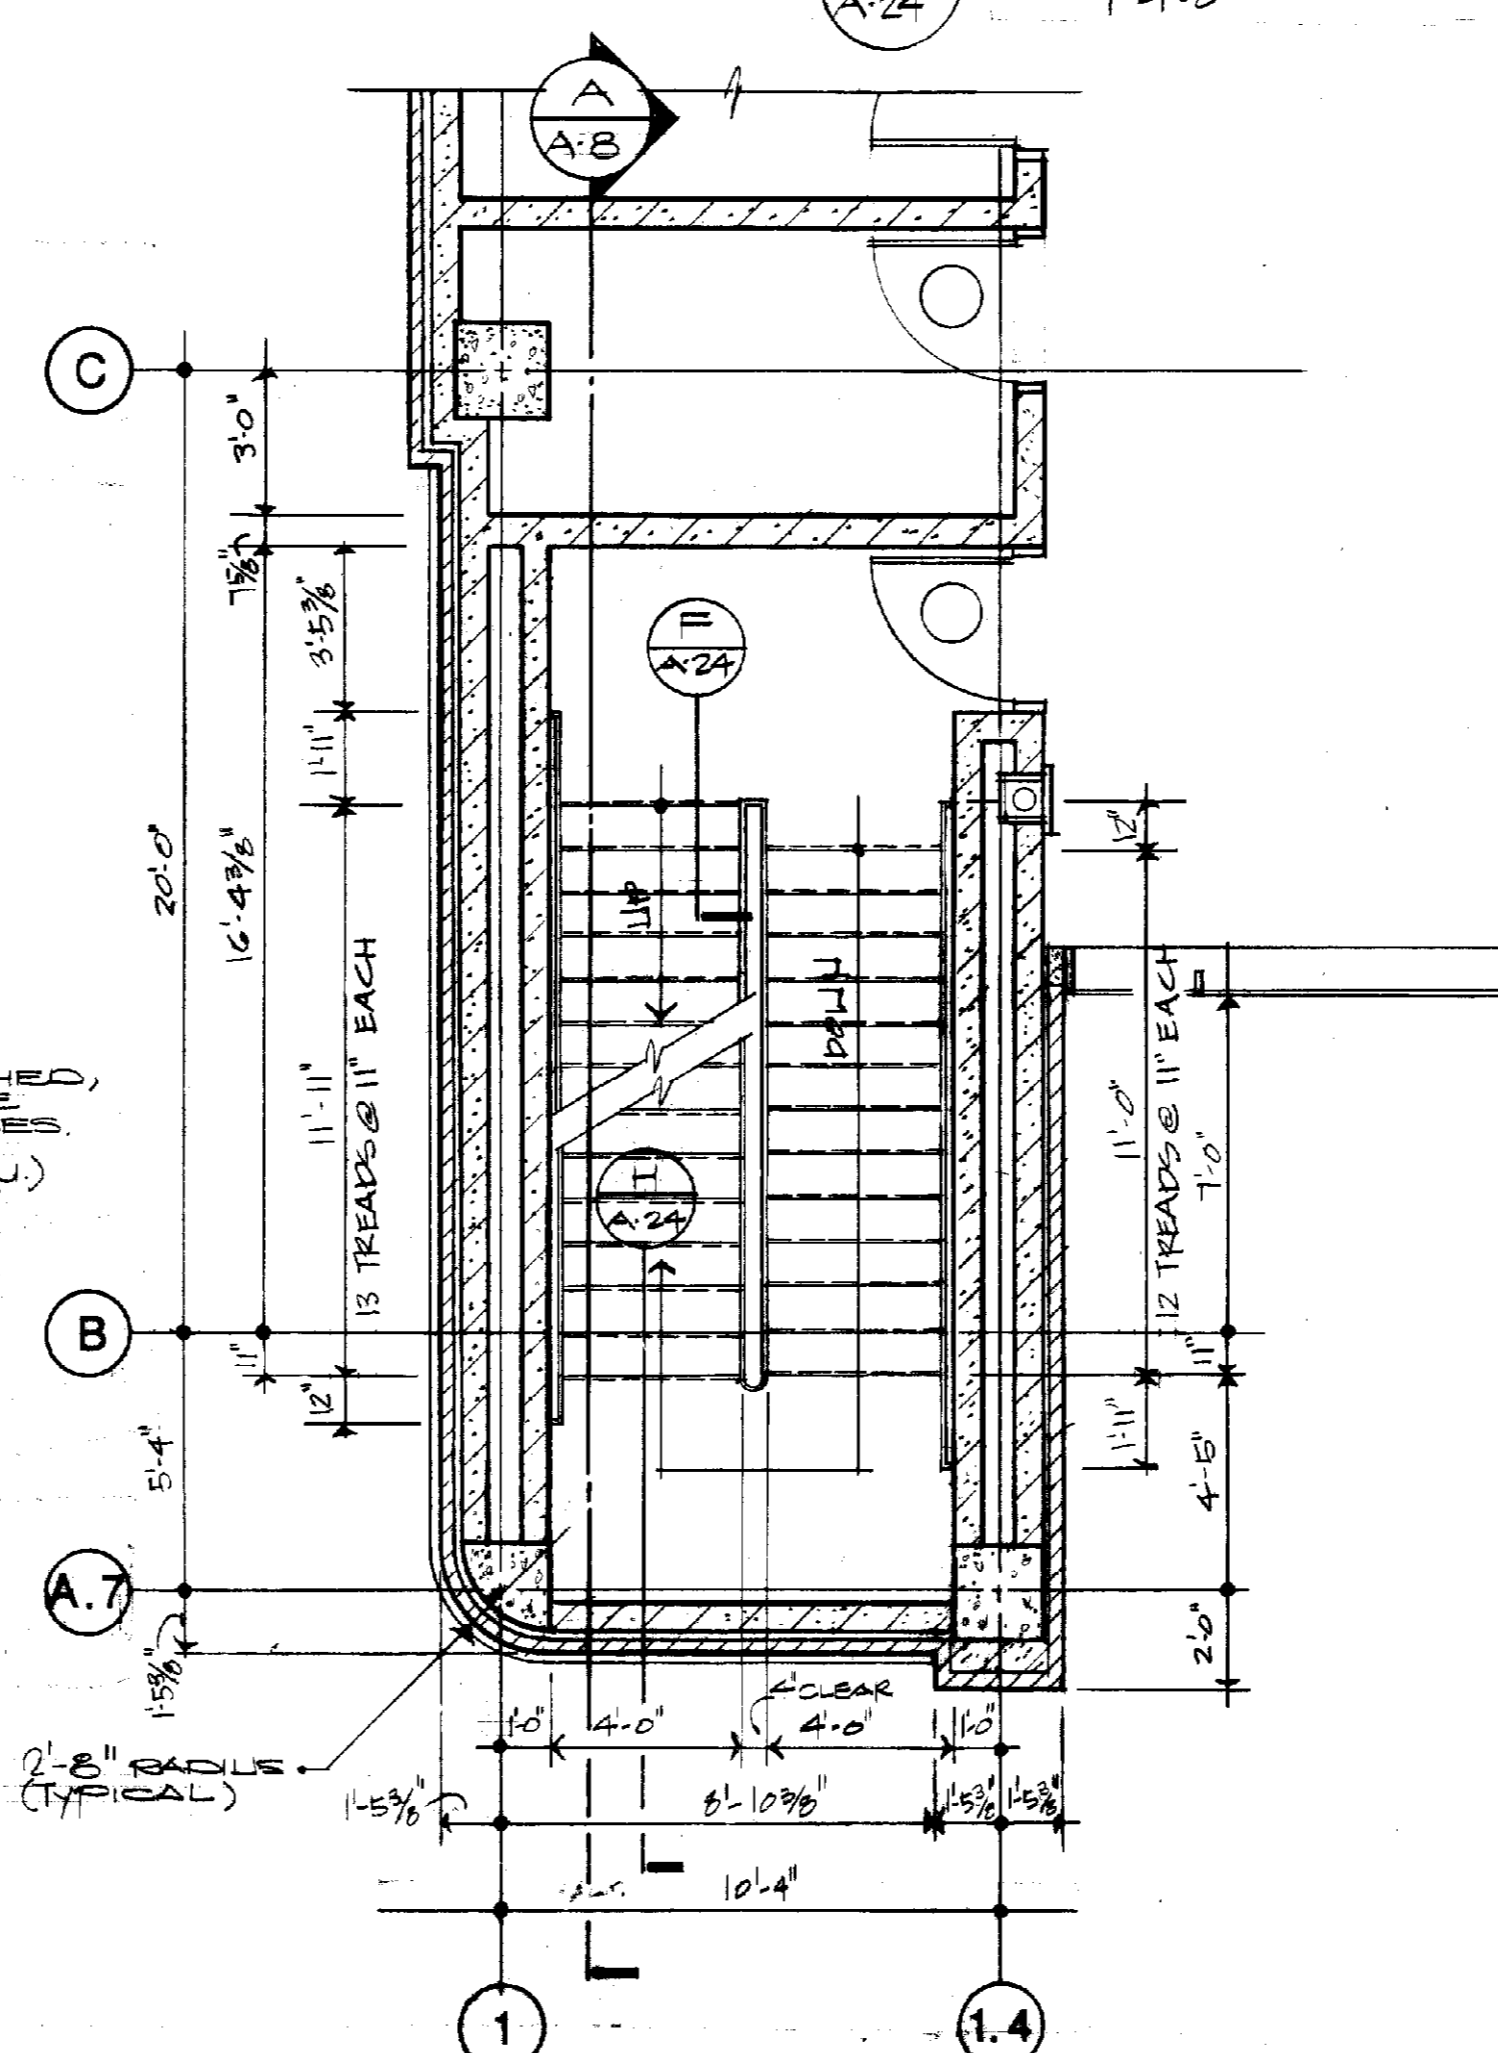

ENLARGED STAIR PLAN (2nd, 3rd & 4th Floors)
1/4"=1'-0"

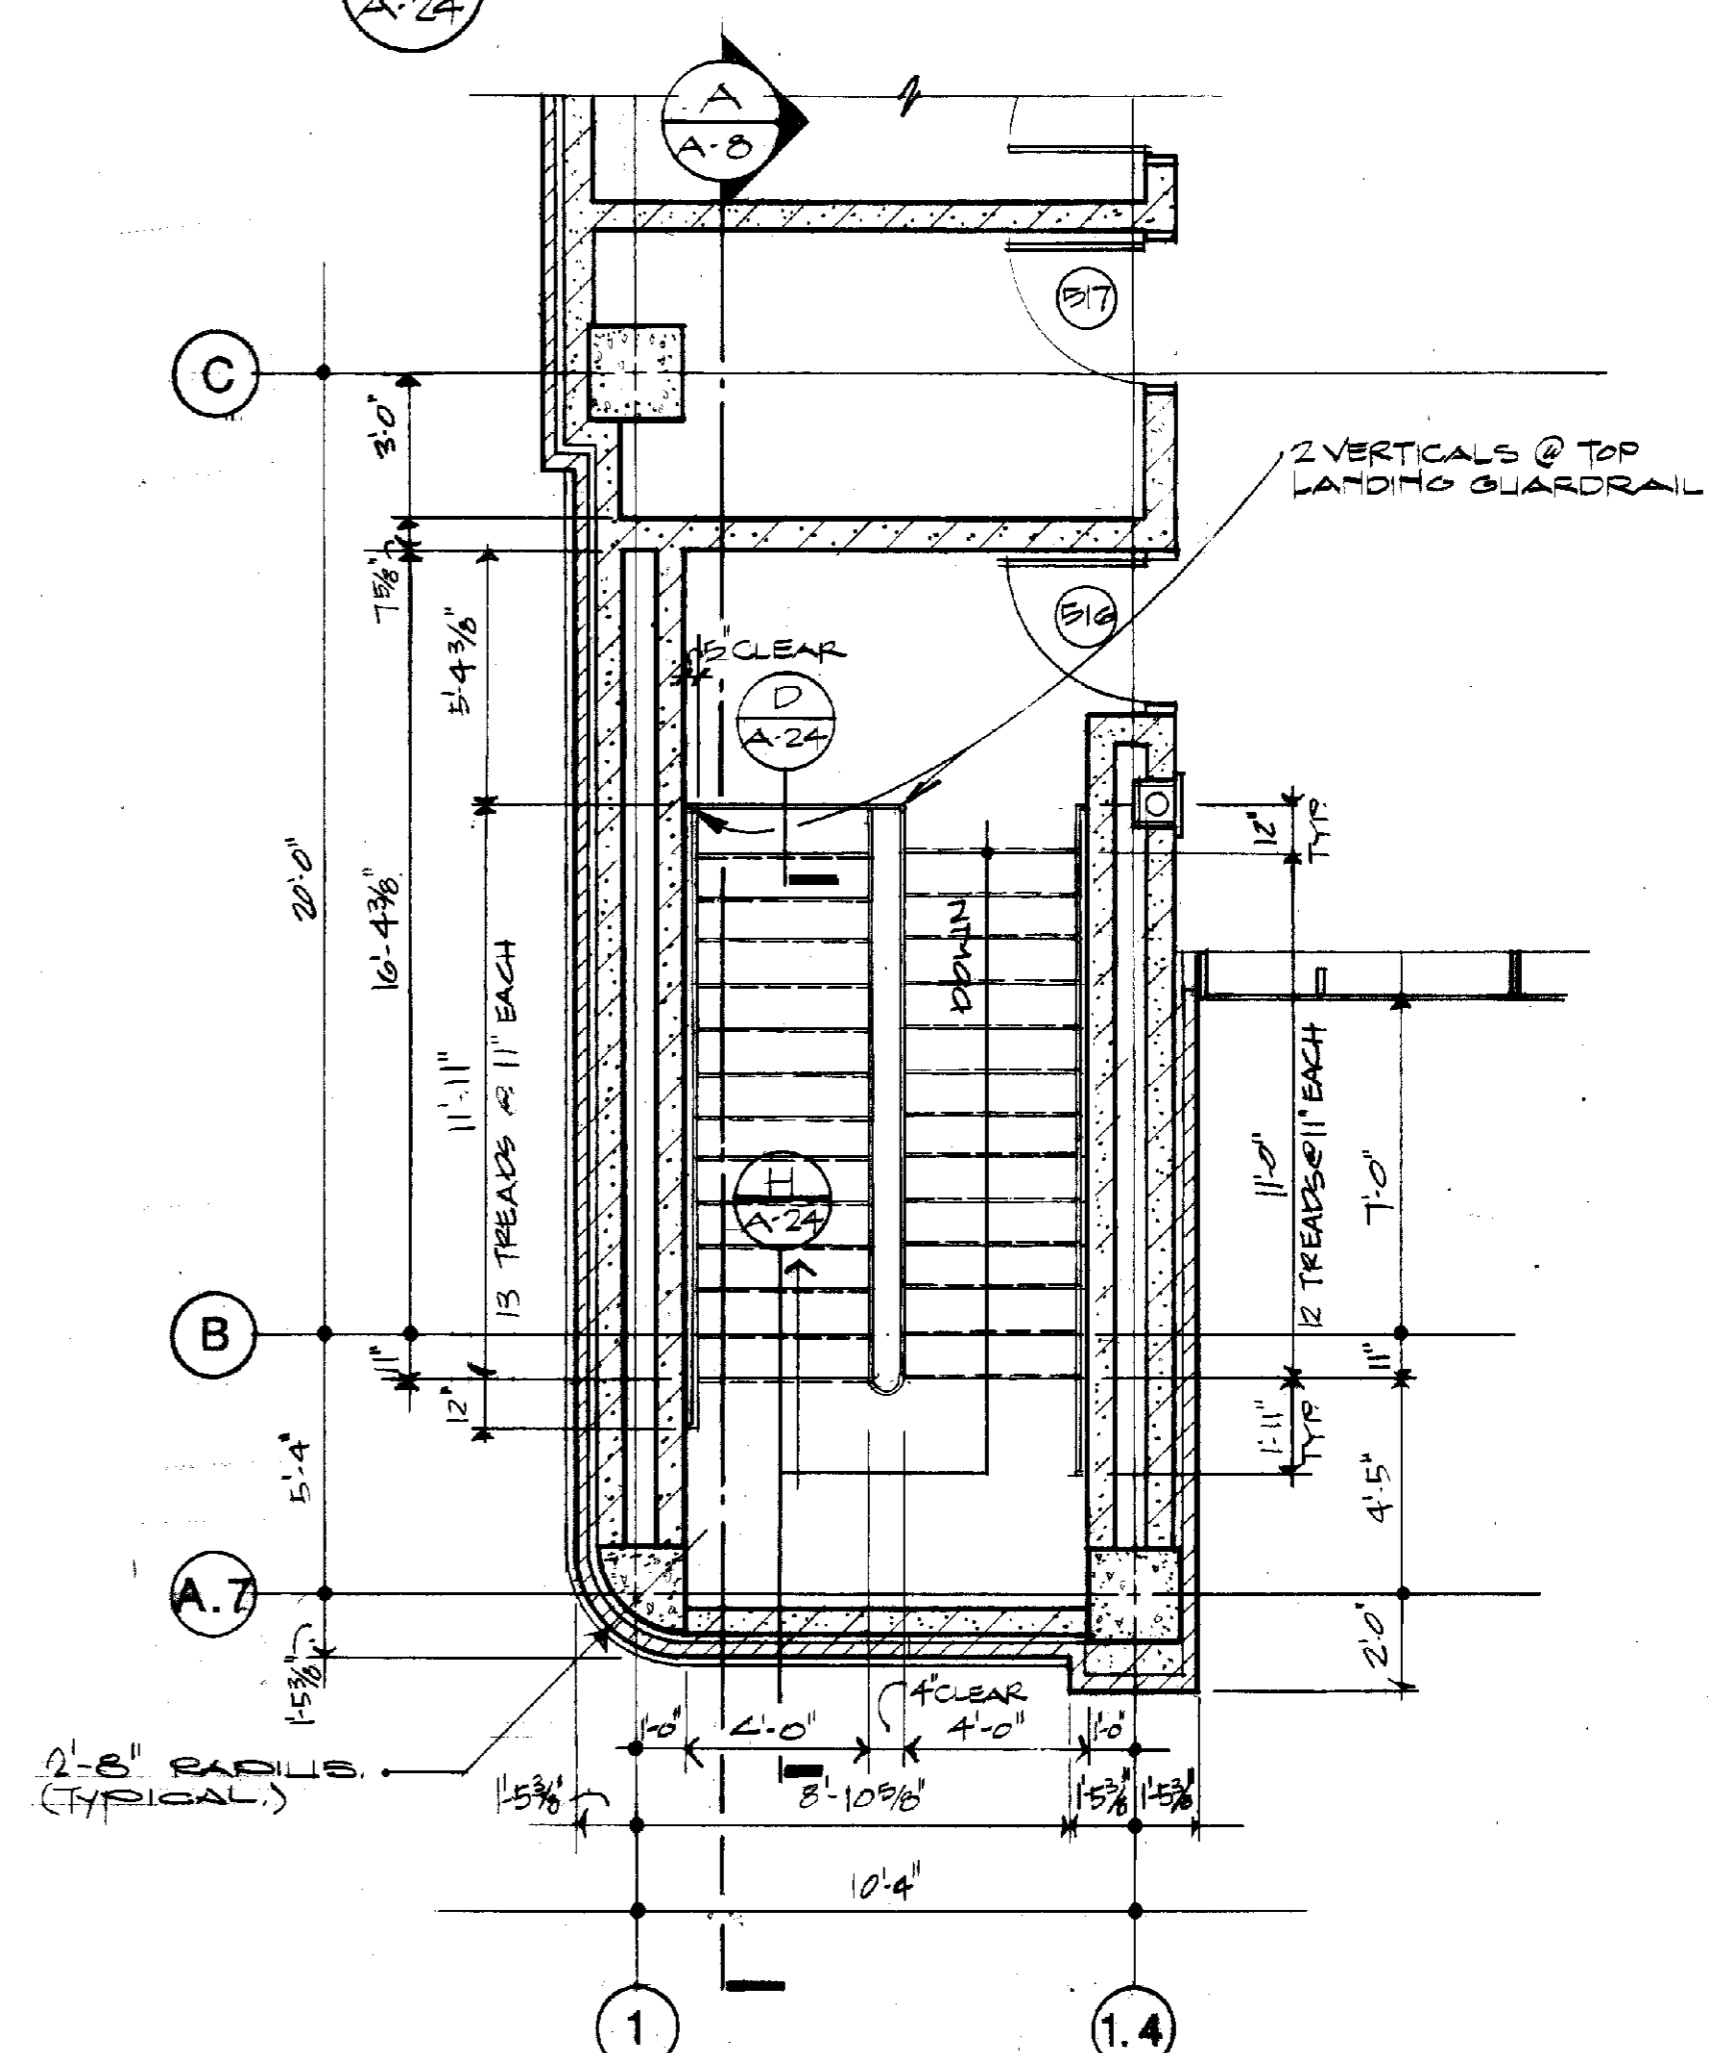

ENLARGED STAIR PLAN (Fifth Floor)
1/4"=1'-0"

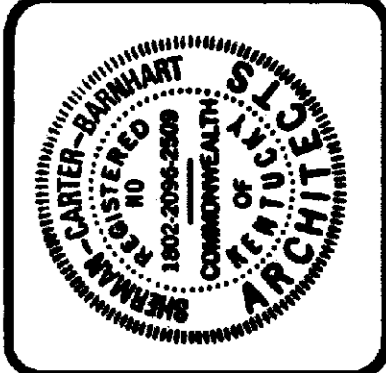

ROBOTICS FACILITY
LEXINGTON CAMPUS
UNIVERSITY OF KENTUCKY
LEXINGTON, KENTUCKY


University of Kentucky
Lexington, Kentucky
Approved by: *[Signature]* 10.19.07
Architect: Sherman Carter Barnhart Architects, Inc.

ENLARGED PLANS & DETAILS
Sherman Carter Barnhart
PARTNERS IN ARCHITECTURE
SUITE 1800 • 250 WEST MAIN STREET • LEXINGTON, KY 40507 • 606/254-1951


JOB NO. 07.08
DATE 10-1-07
DRAWN STAFF
CHECKED CEB
FILE NO. 431.0

NO.	REVISIONS

SHEET **A-25**
Cah # Sit Document # 004909

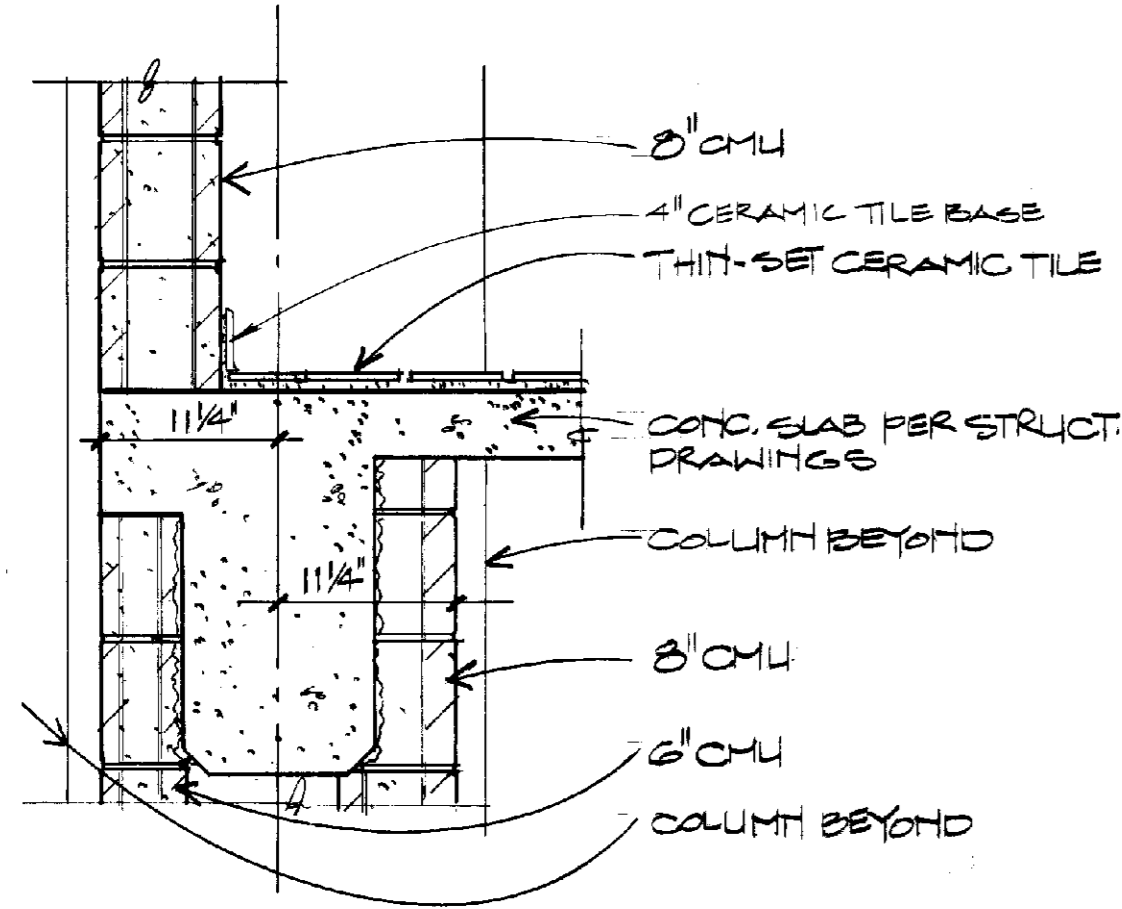


NOTE: DETAIL SHOWS MIDPOINT BETWEEN FLOORS SEE STRUCTURAL FOR SLAB EDGE LOCATIONS @ FLOORS.

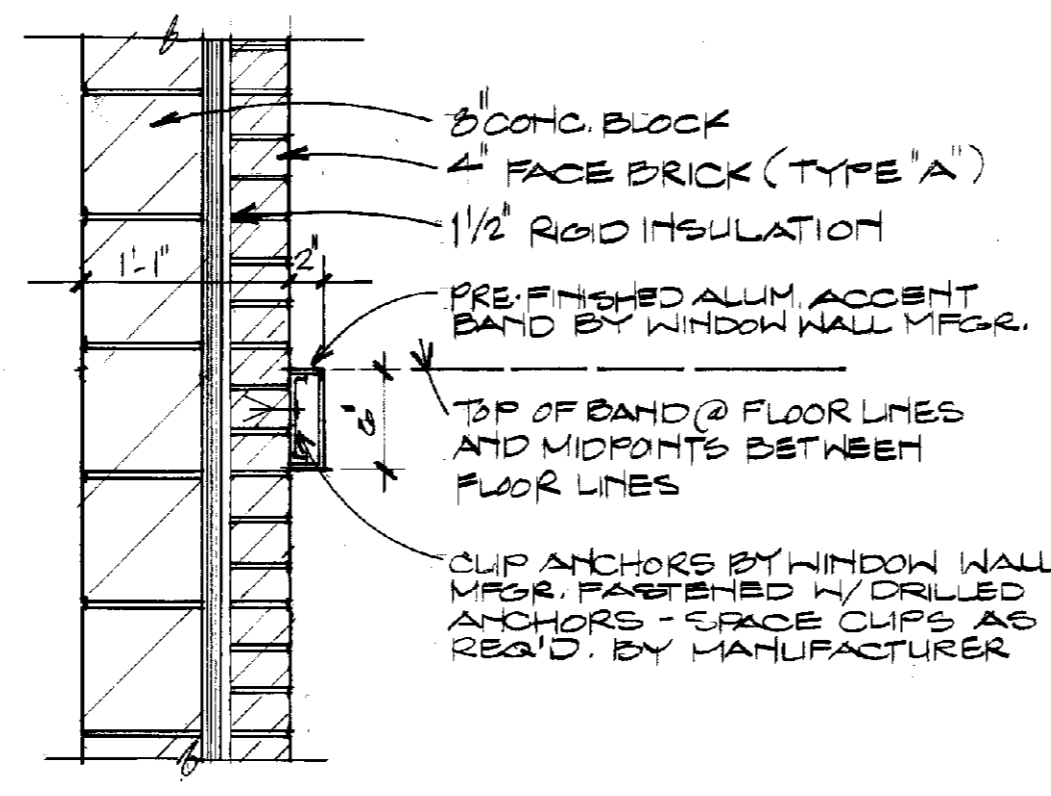

- | | |
|-------------------------------|--------------|
| ITEM | MOUNTING |
| ① GRAB BAR | 35" TO 6" |
| ② SOAP DISPENSER | 21" TO 6" |
| ③ TOILET TISSUE DISPENSER | 21" TO 6" |
| ④ ROSS HOOK | 46" TO 6" |
| ⑤ PAPER TOWEL DISPENSER | 46" TO TOWEL |
| ⑥ NAPKIN DISPOSAL (RECESSED) | 29" TO TOP |
| ⑦ NAPKIN DISPOSAL (PARTITION) | 29" TO TOP |
| ⑧ MIRROR | SEE F/A-20 |
| ⑨ MIRROR | SEE F/A-20 |
| ⑩ SOAP DISPENSER | VANITY TOP |
| ⑪ MOP RACK W/ SHELF | 68" TO SHELF |

NOTE: SEE TOILET ACCESSORIES SCHEDULE, E/A-25

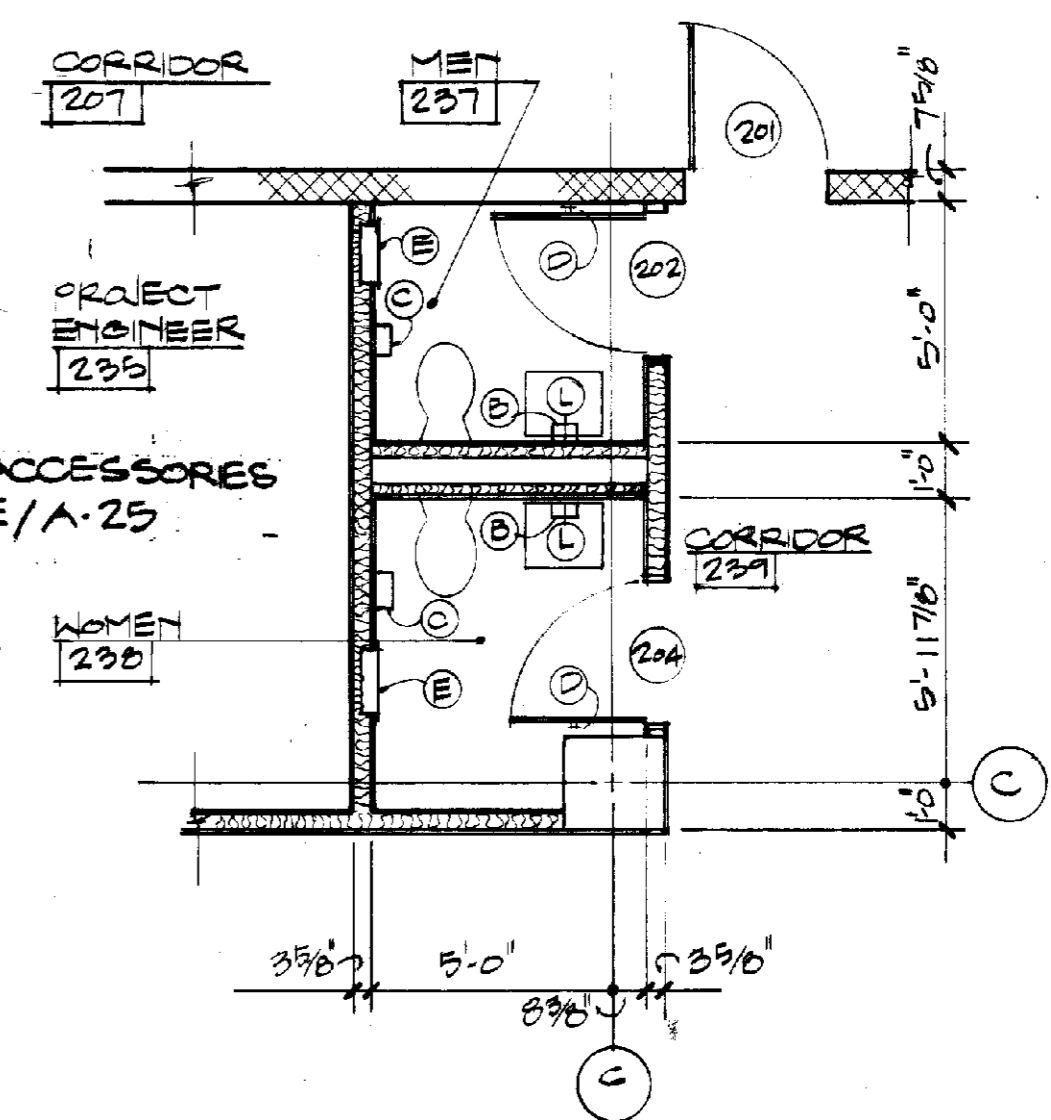


DETAIL
1" = 1'-0"


C ACCENT BAND DETAIL
1" = 1'-0"

E TOILET ACCESSORIES
1" = 1'-0"

B ENLARGED TOILET PLAN
1/4" = 1'-0"

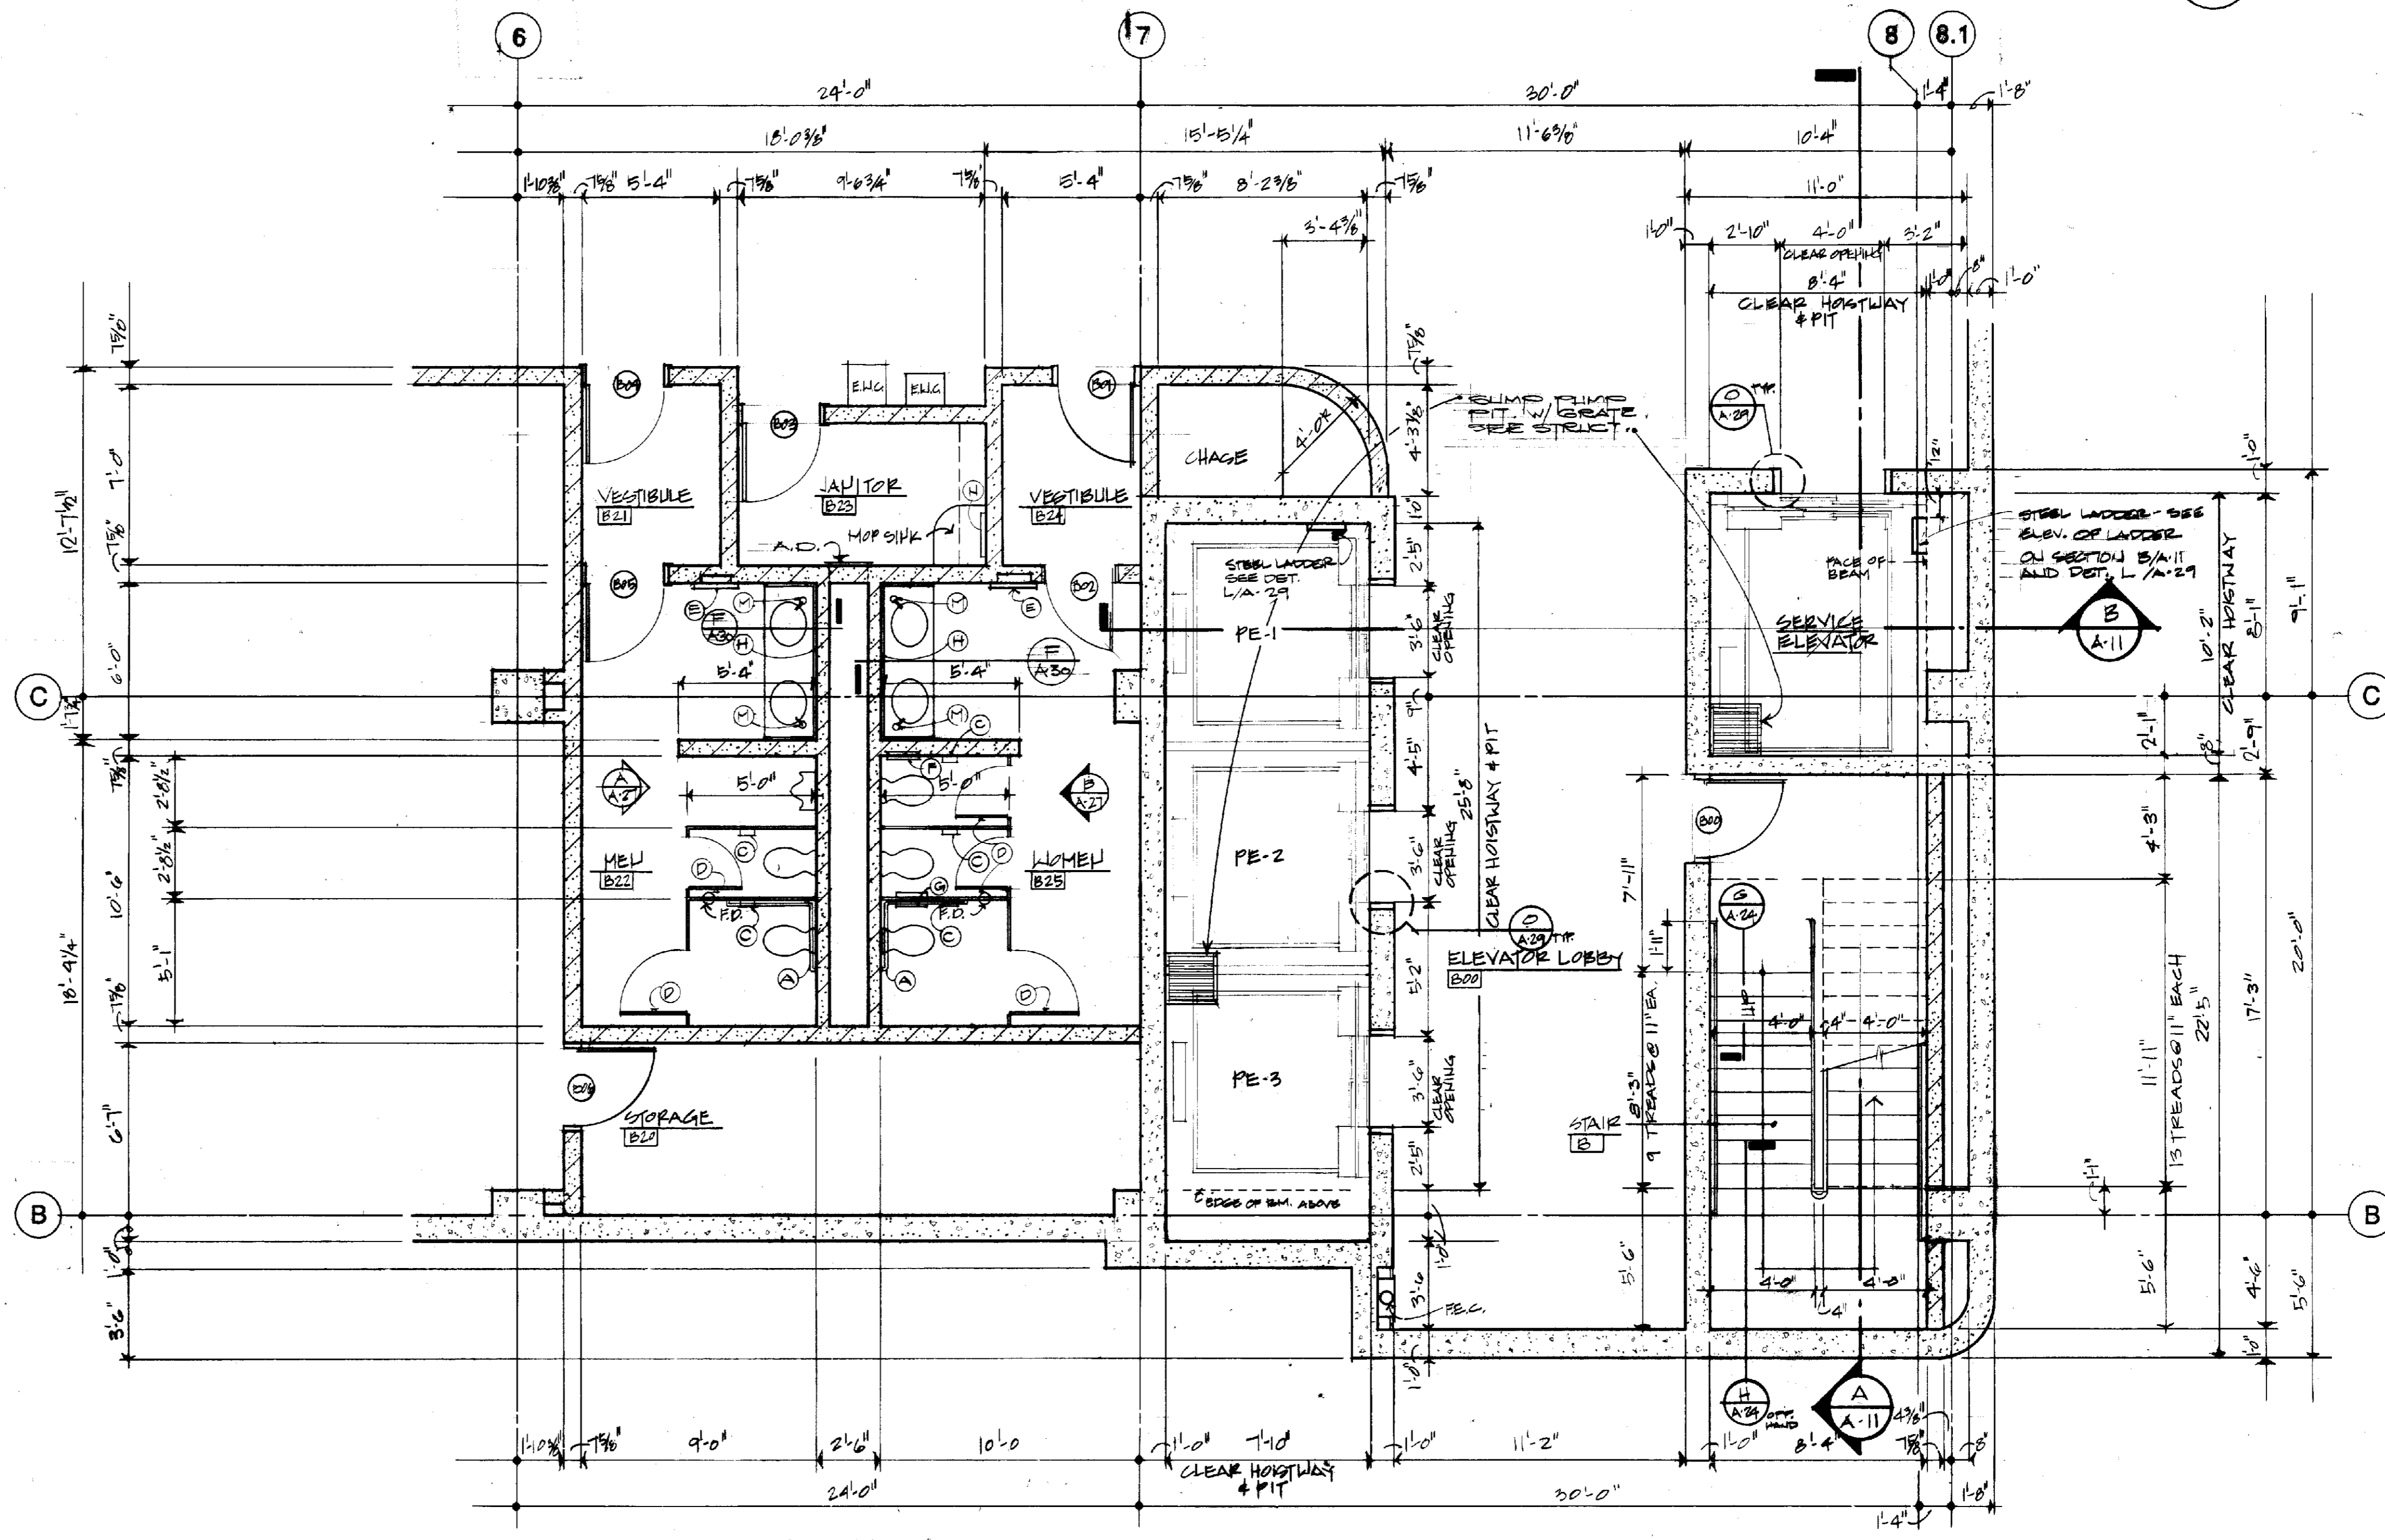

A ENLARGED CORE PLAN (BSMNT)
SCALE: 1/4" = 1'-0"

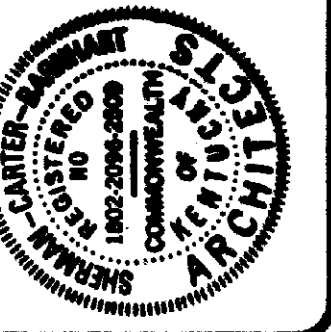

ROBOTICS FACILITY
 LEXINGTON CAMPUS
 UNIVERSITY OF KENTUCKY
 LEXINGTON, KENTUCKY

University of Kentucky
 Lexington, Kentucky

12-19-27
 SHERMAN CARTER BARNHART
 ARCHITECTS

ENLARGED PLANS & DETAILS


Sherman Carter Barnhart
 PARTNERS IN ARCHITECTURE
 SUITE 1900 • 250 WEST MAIN STREET • LEXINGTON, KY 40507 • 800-254-1501

JOB NO. 8708
 DATE 10-1-87
 DRAWN STAFF
 CHECKED CEB
 FILE NO. 431.0


NO.	REVISIONS

SHEET


A-26

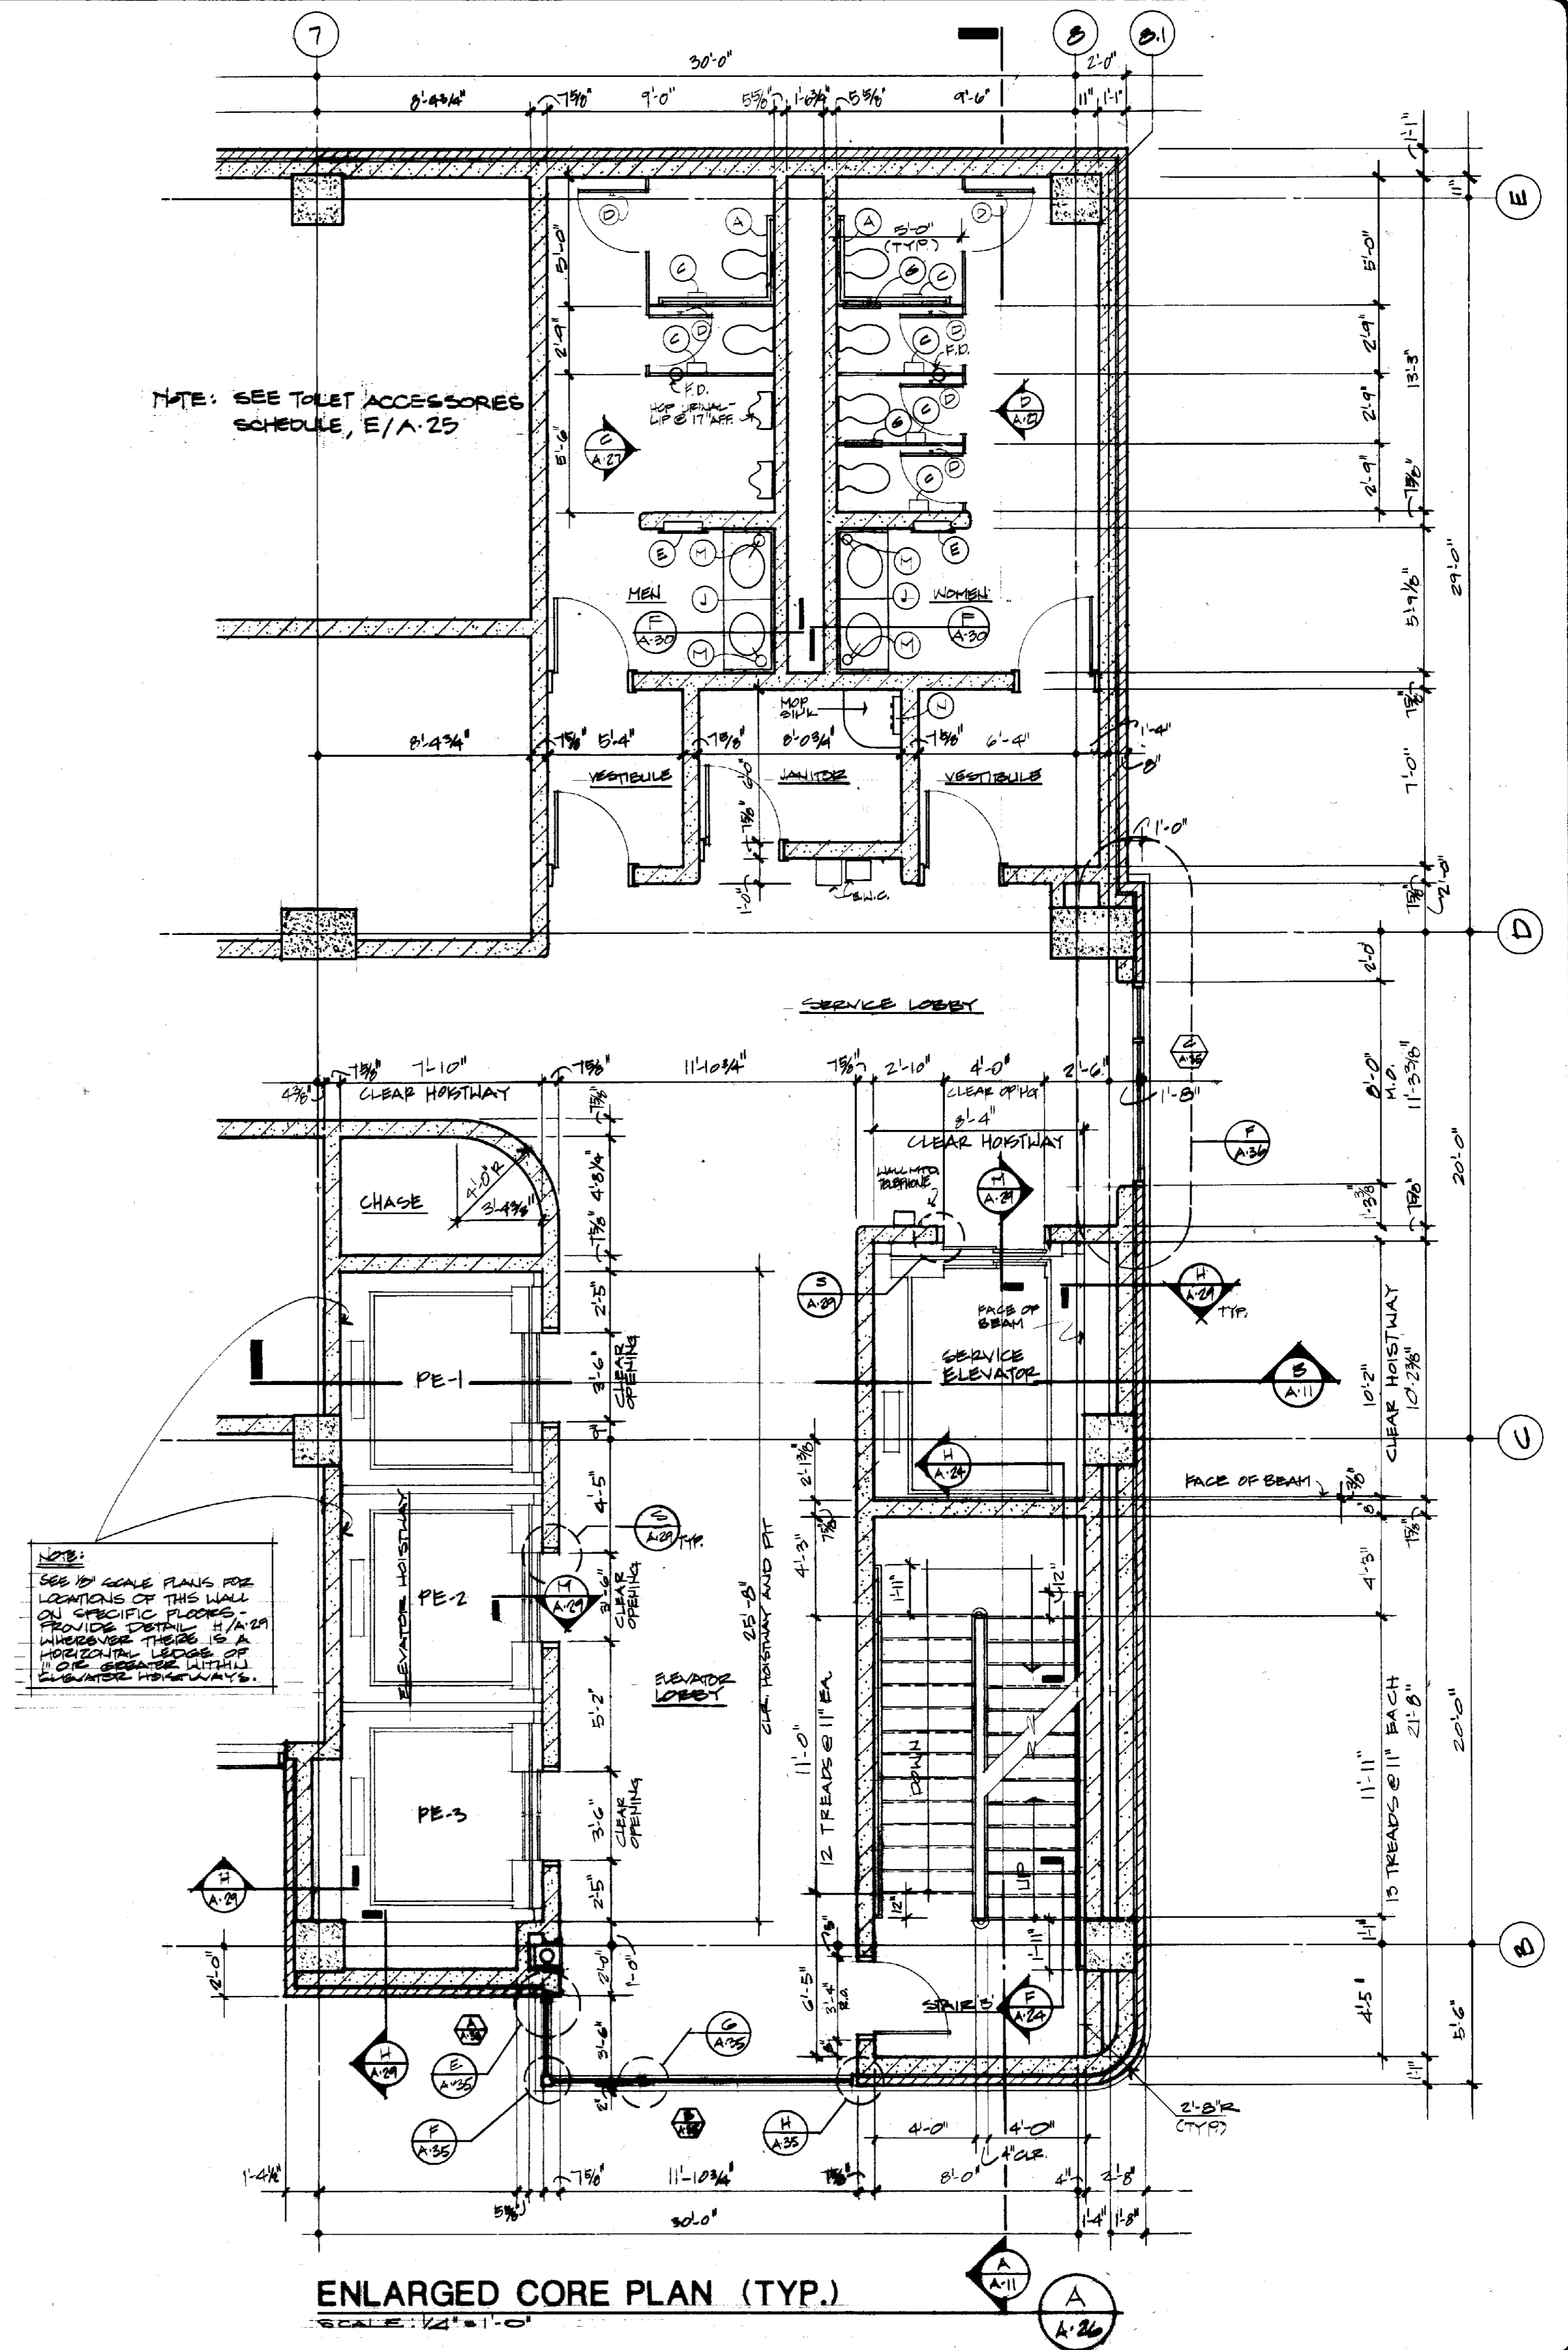

ENLARGED CORE PLAN (TYP.)
 SCALE: 1/4" = 1'-0"

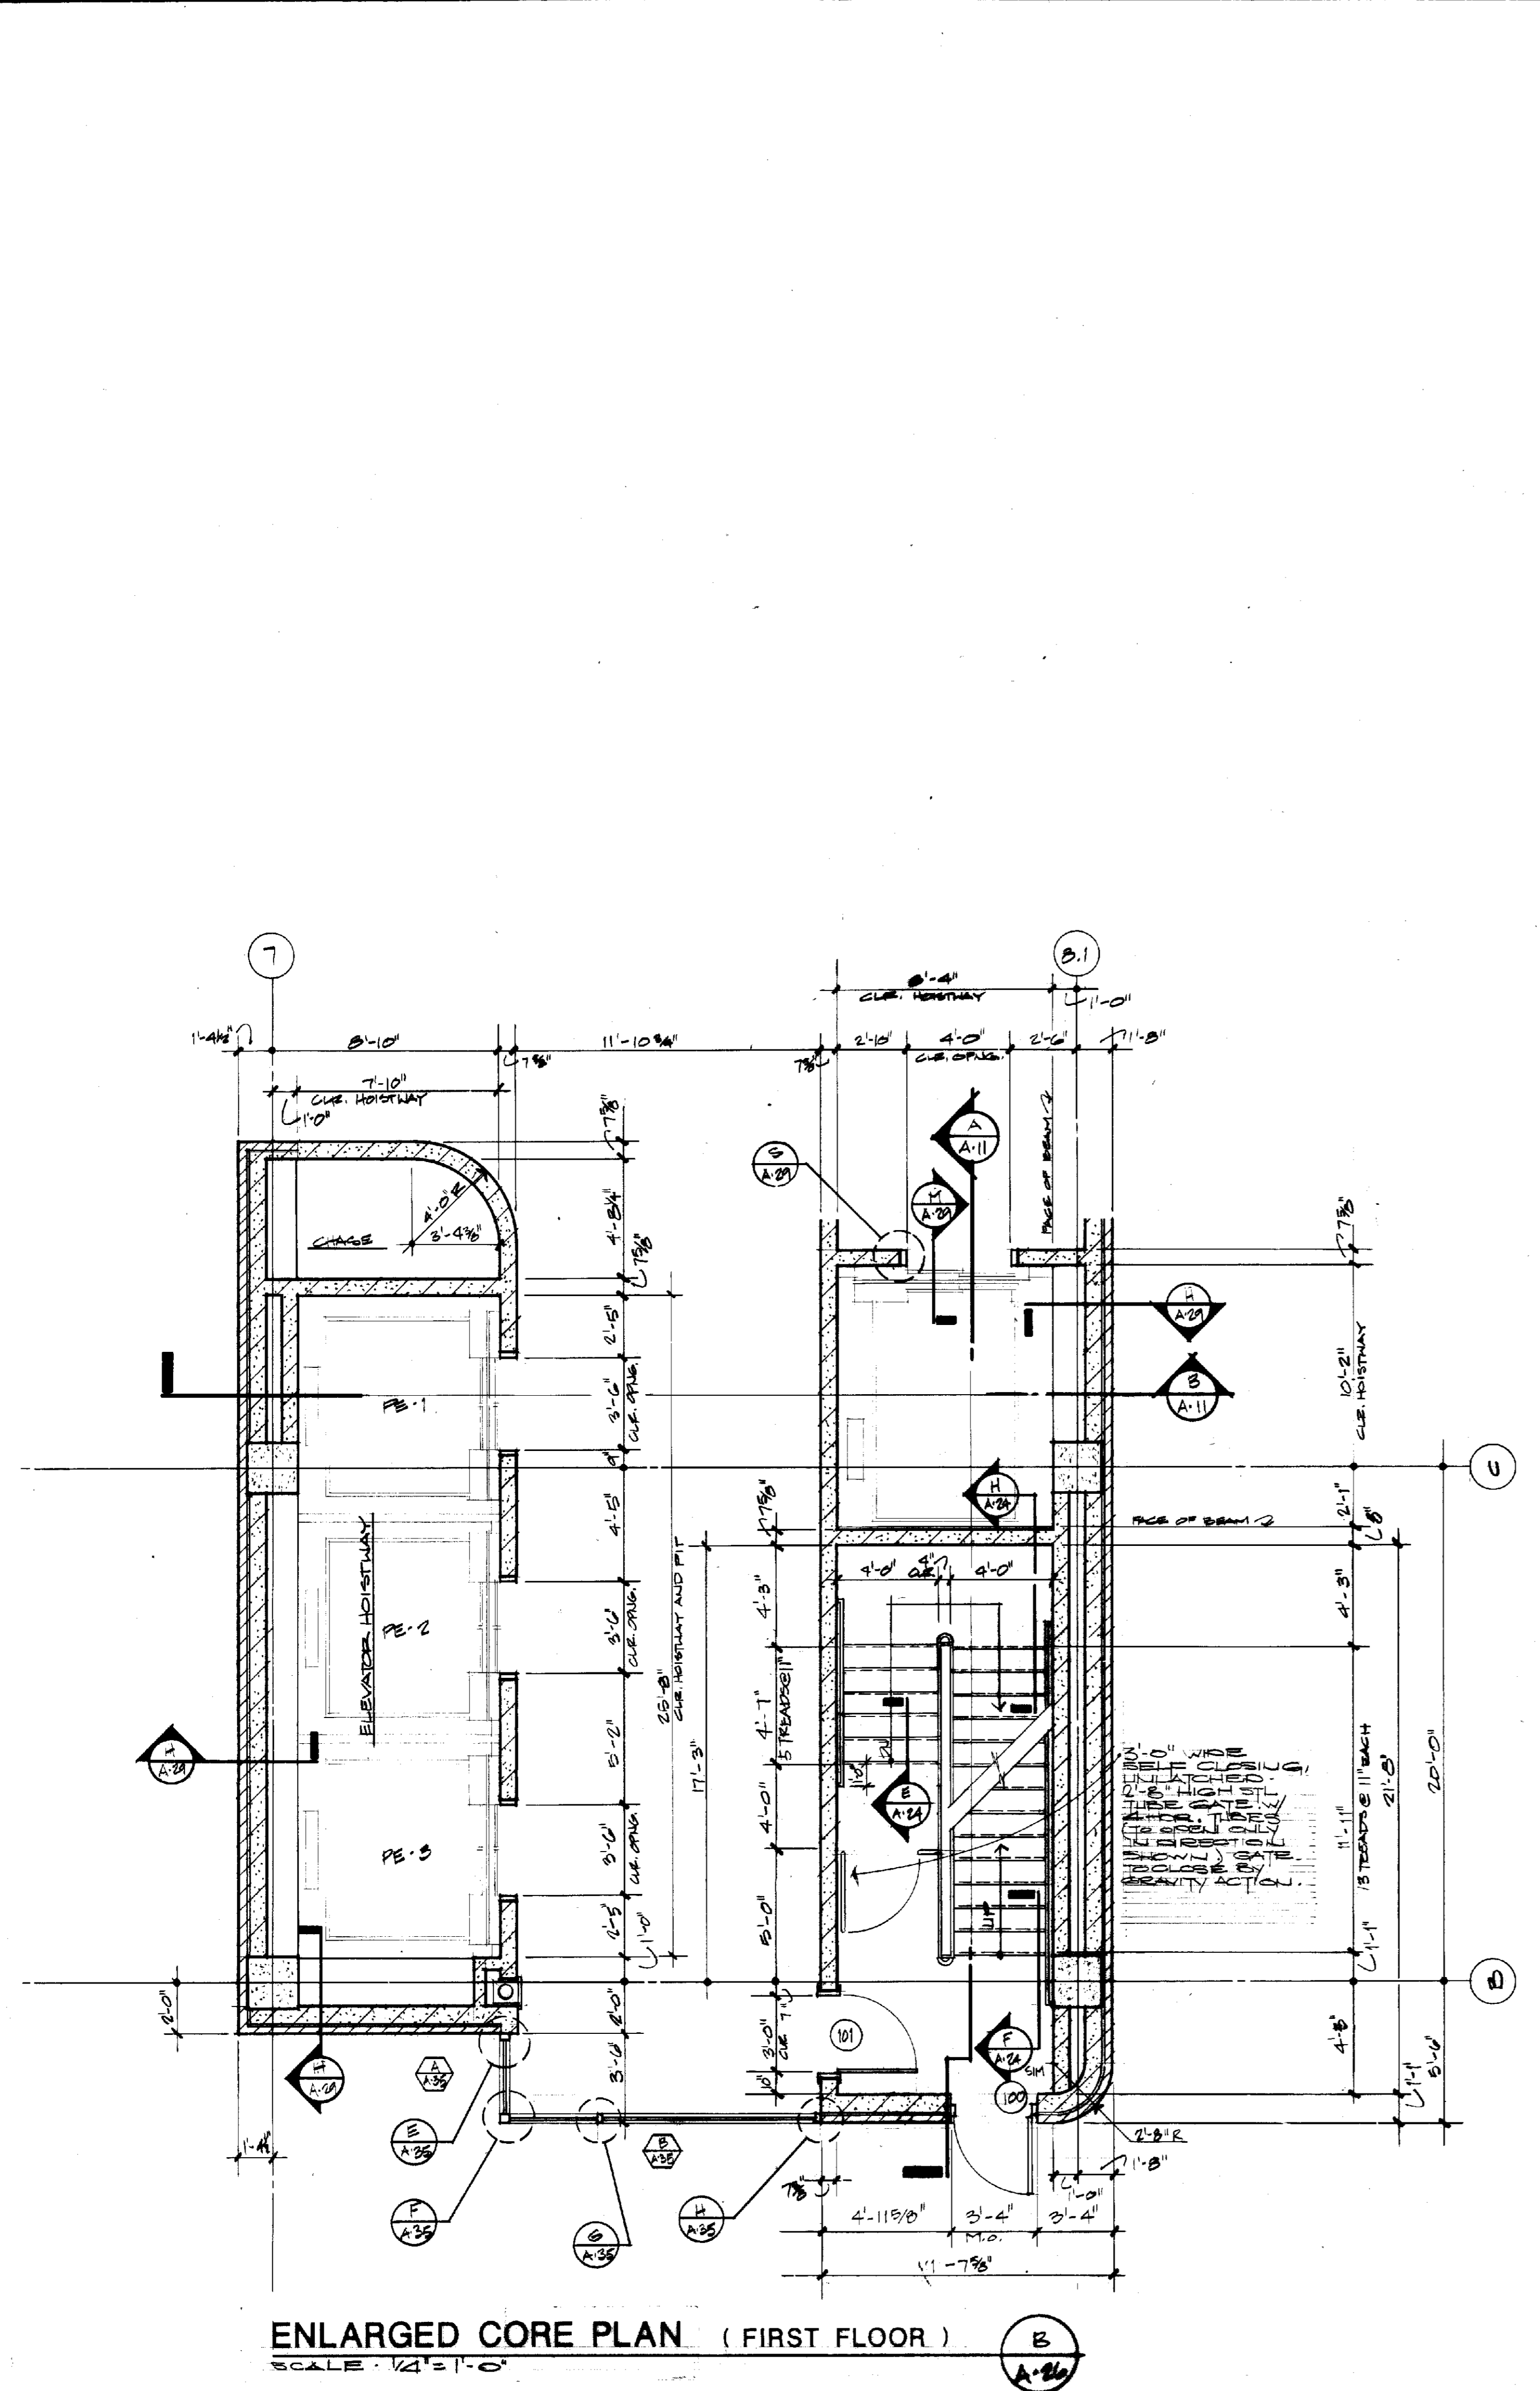

ENLARGED CORE PLAN (FIRST FLOOR)
 SCALE: 1/4" = 1'-0"

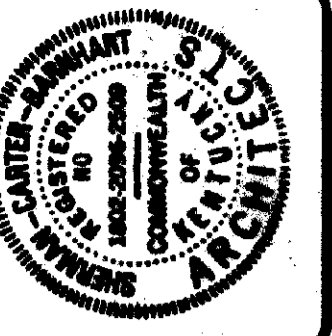

ROBOTICS FACILITY
 LEXINGTON CAMPUS
 UNIVERSITY OF KENTUCKY
 LEXINGTON, KENTUCKY

University of Kentucky
 Lexington, Kentucky


ENLARGED PLANS & DETAILS
 Sherman Carter-Barhart
 PARTNERS IN ARCHITECTURE
 LEXINGTON FINANCIAL CENTER, SUITE 1900, 250 W. MAIN • LEXINGTON, KY 40507 • 606.224.1851

JOB NO. 8708
 DATE 10-1-87
 DRAWN STAFF
 CHECKED CEB
 FILE NO. 431.0


REVISIONS
 FEB 7, 1988

SHEET


A-28

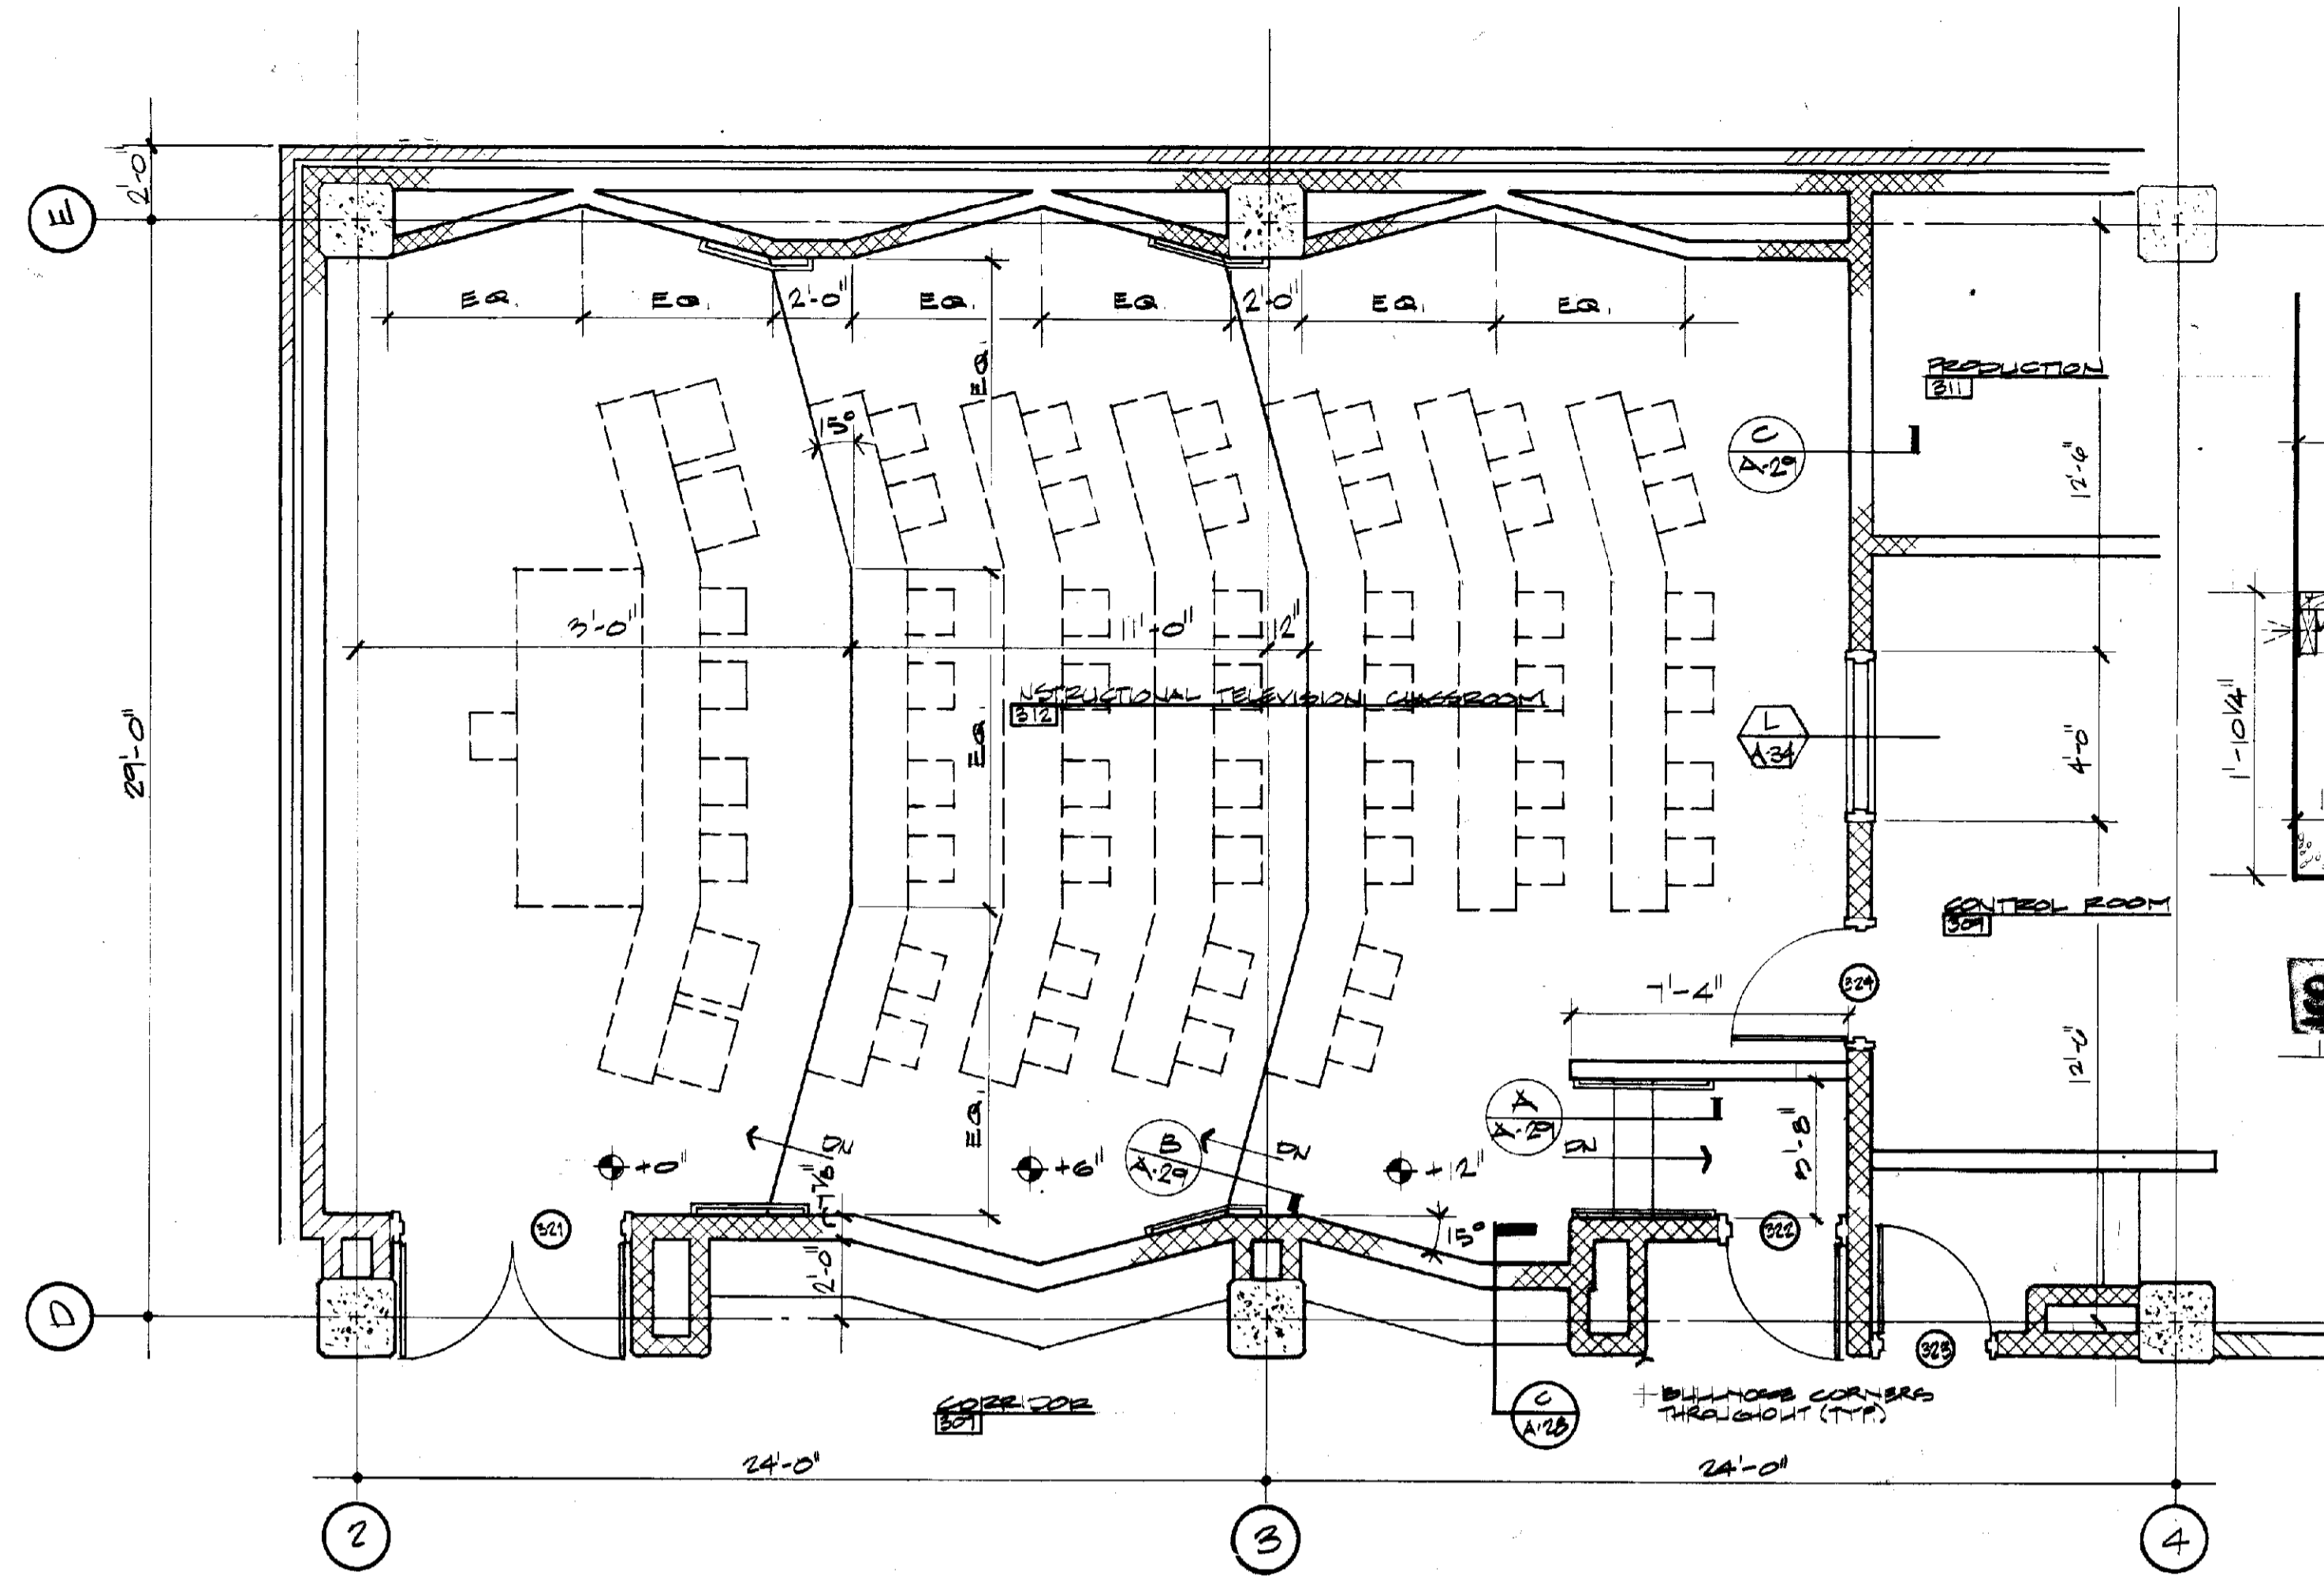


ENLARGED ITV CLASSROOM 312 PLAN
 1/4" = 1'-0"

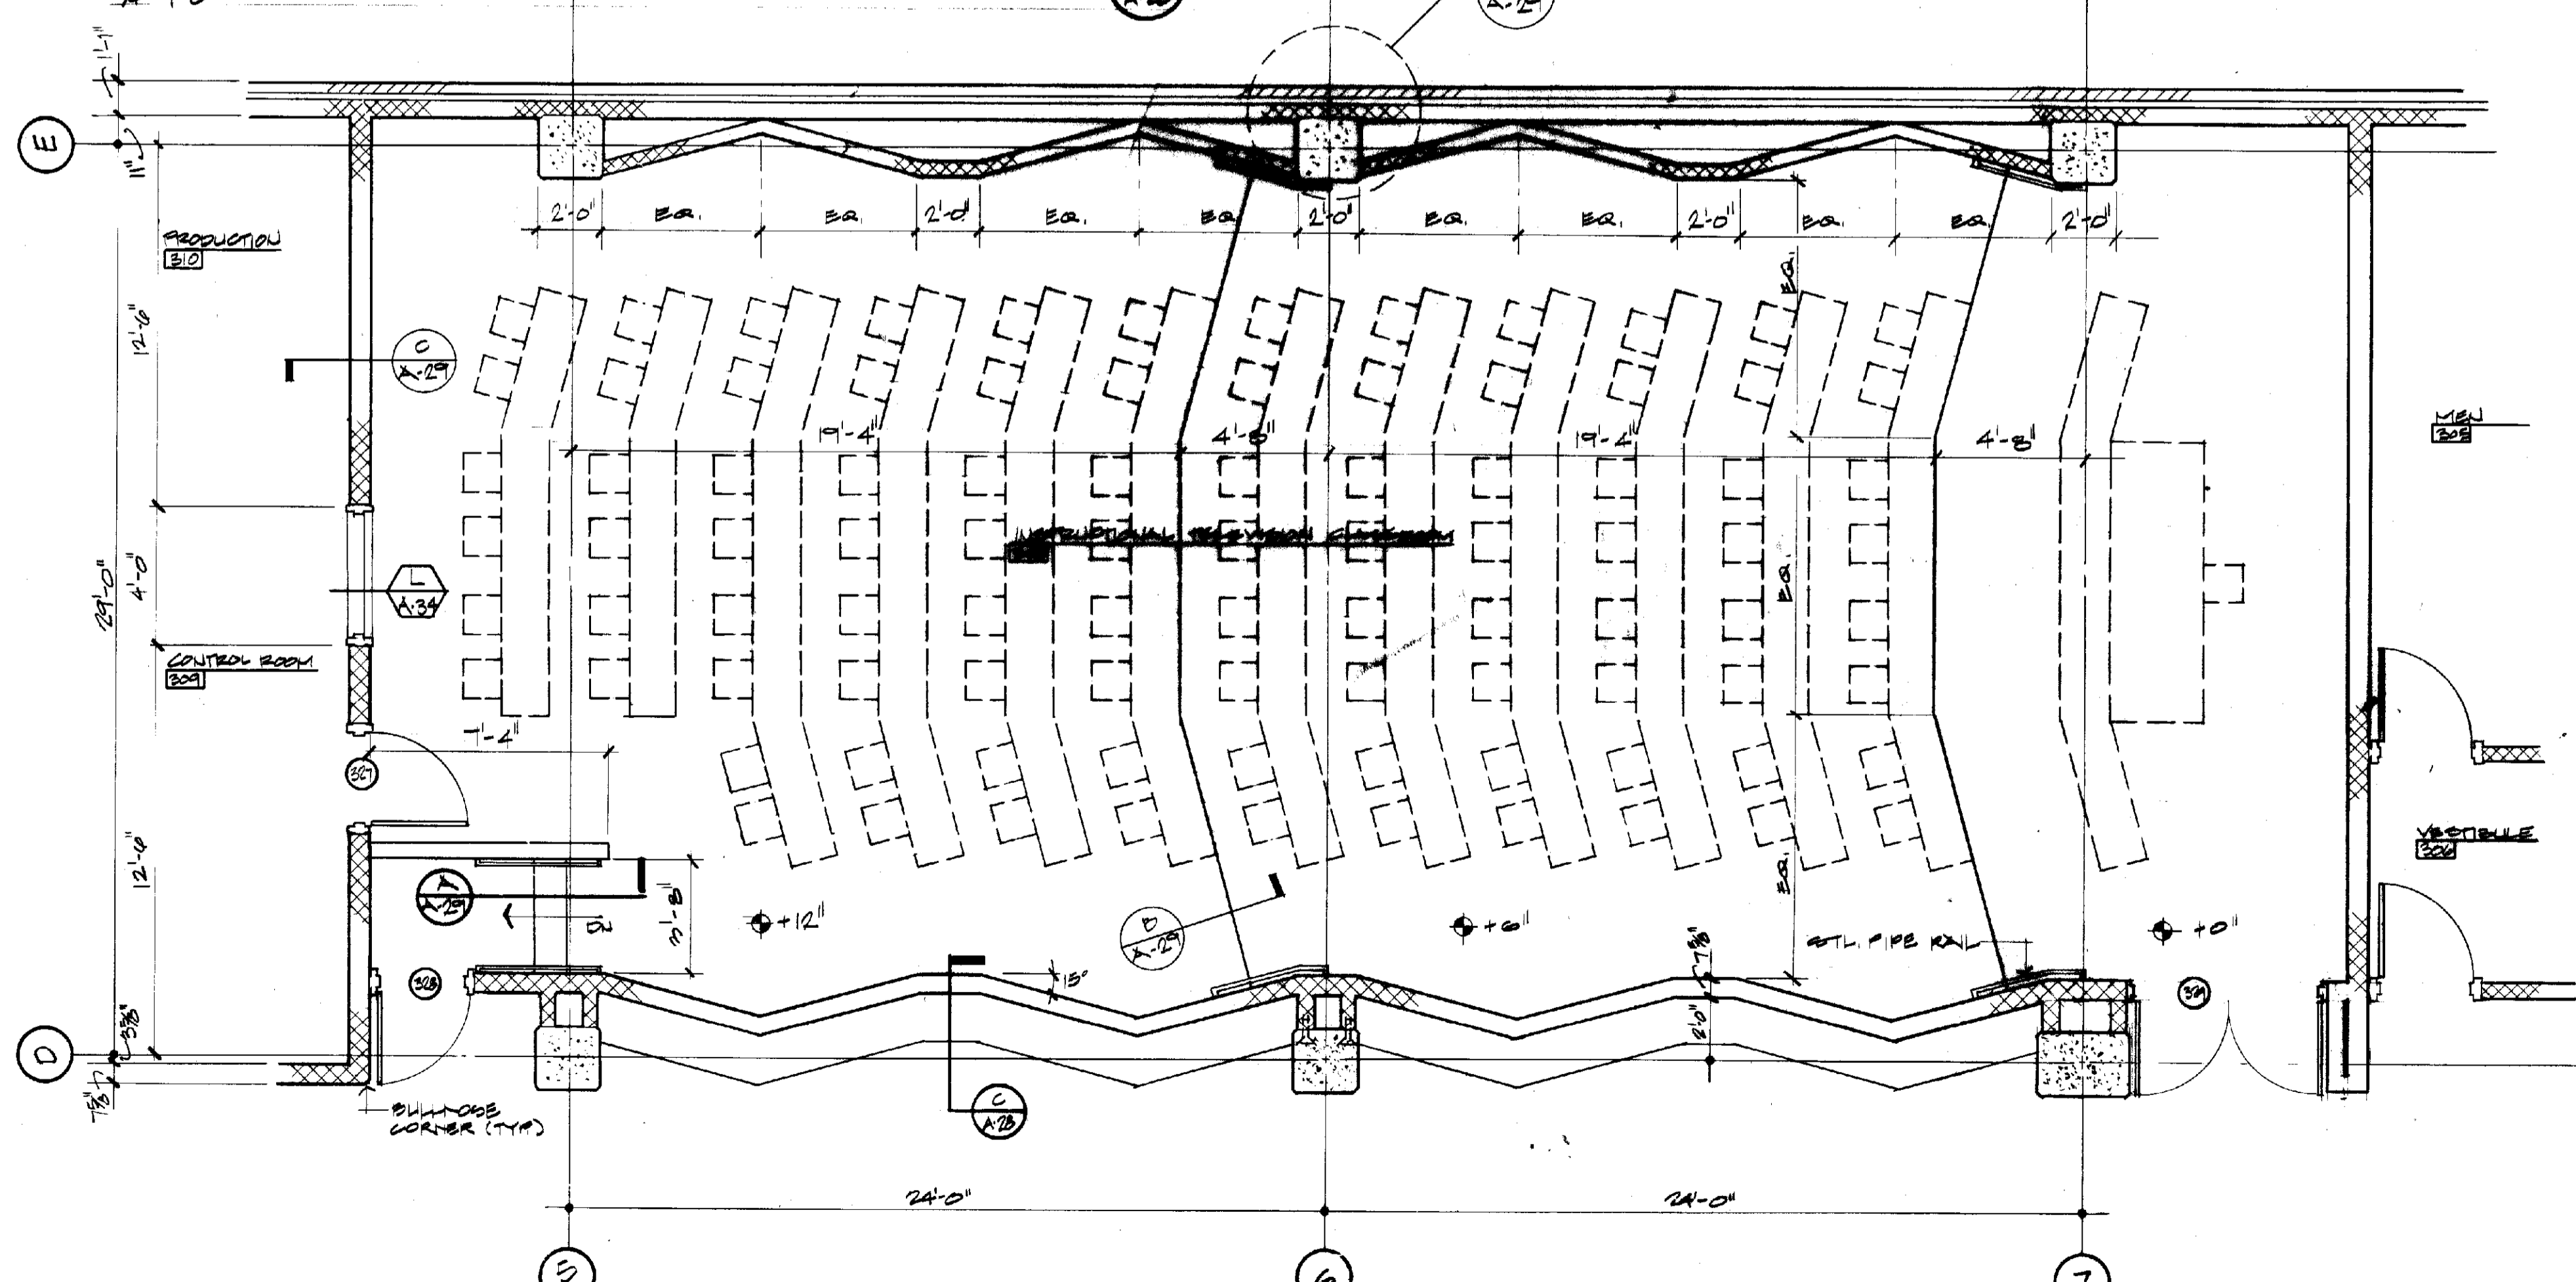


ENLARGED ITV CLASSROOM 308
 1/4" = 1'-0"

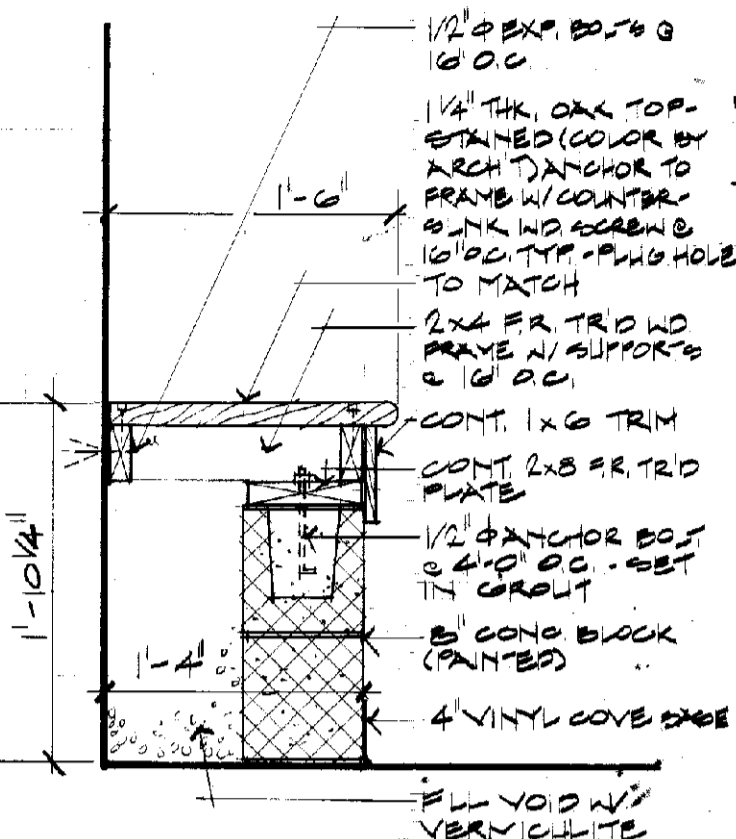


SEAT DETAIL
 1/4" = 1'-0"

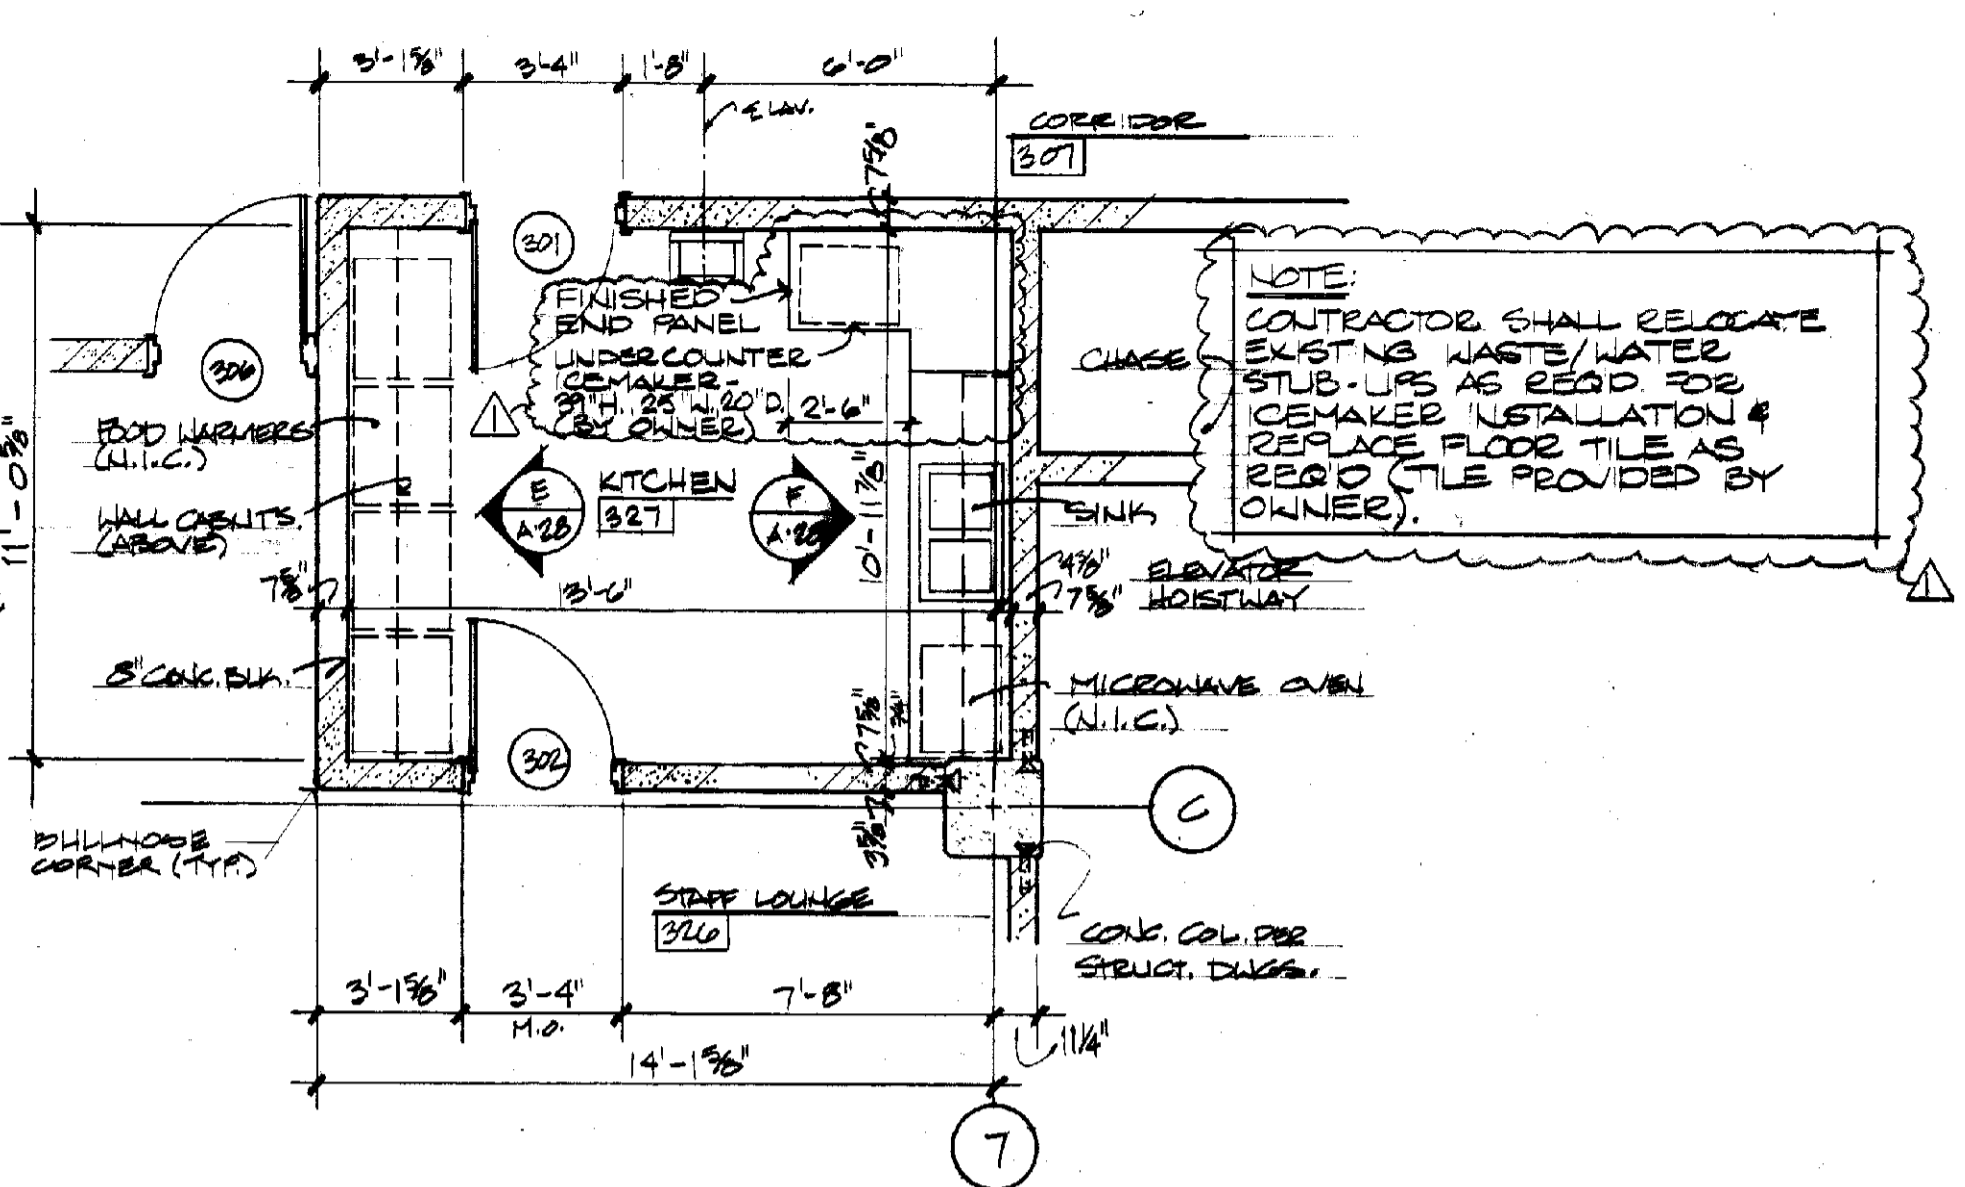

KITCHEN 327 PLAN
 1/4" = 1'-0"

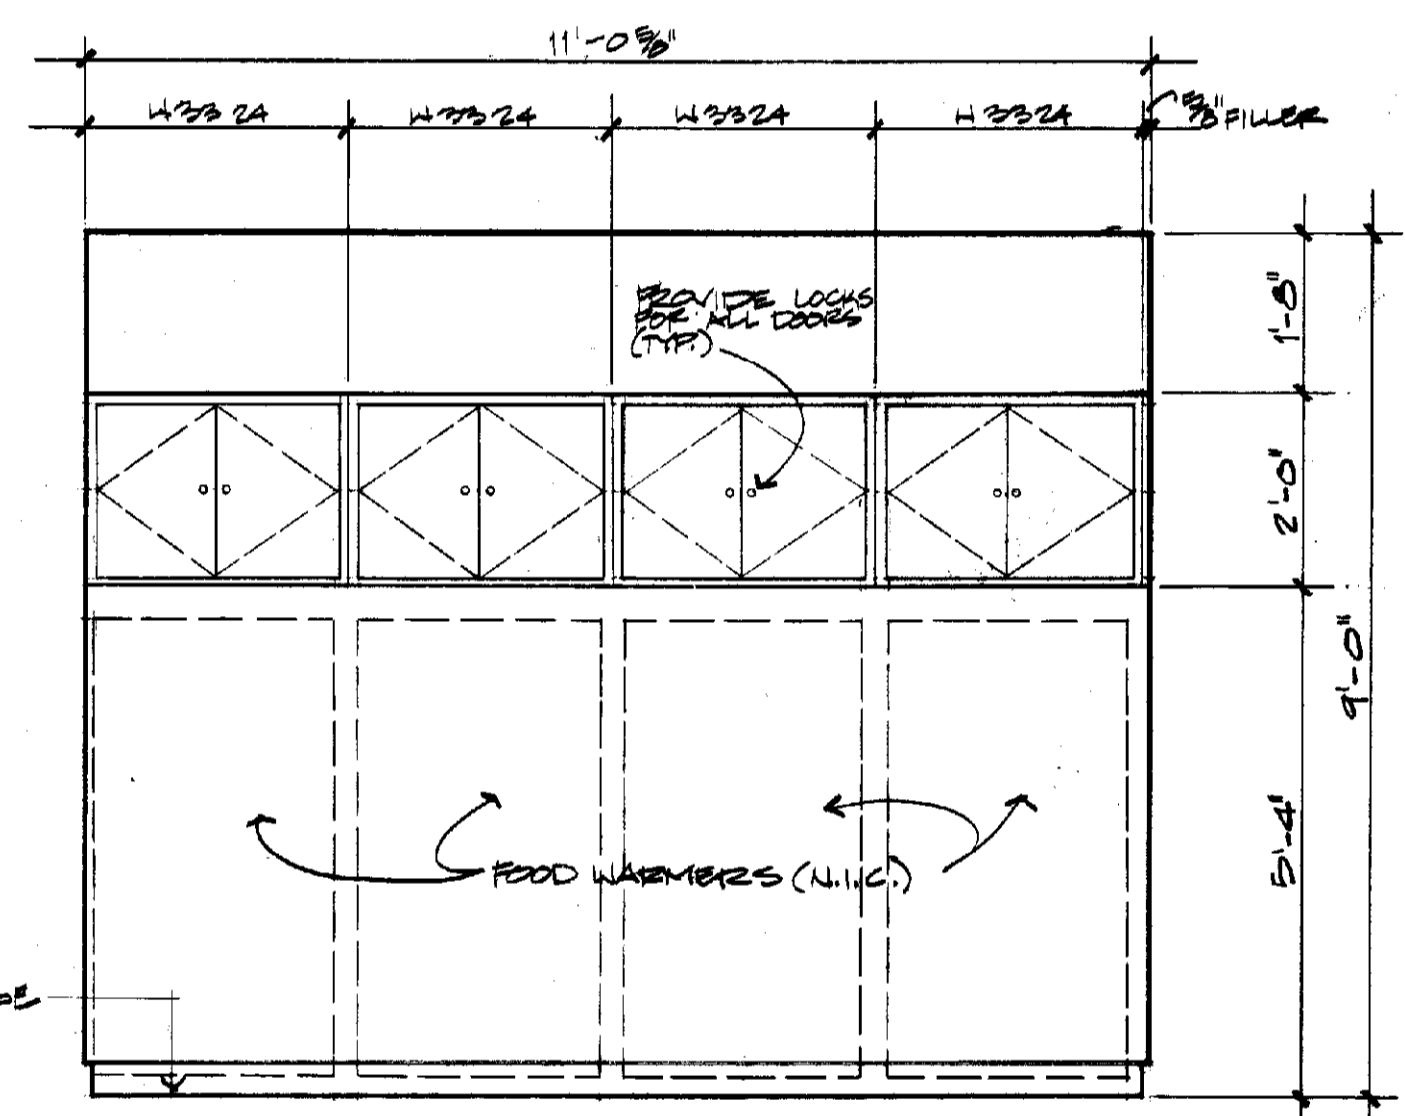

KITCHEN 327 ELEVATION
 1/2" = 1'-0"

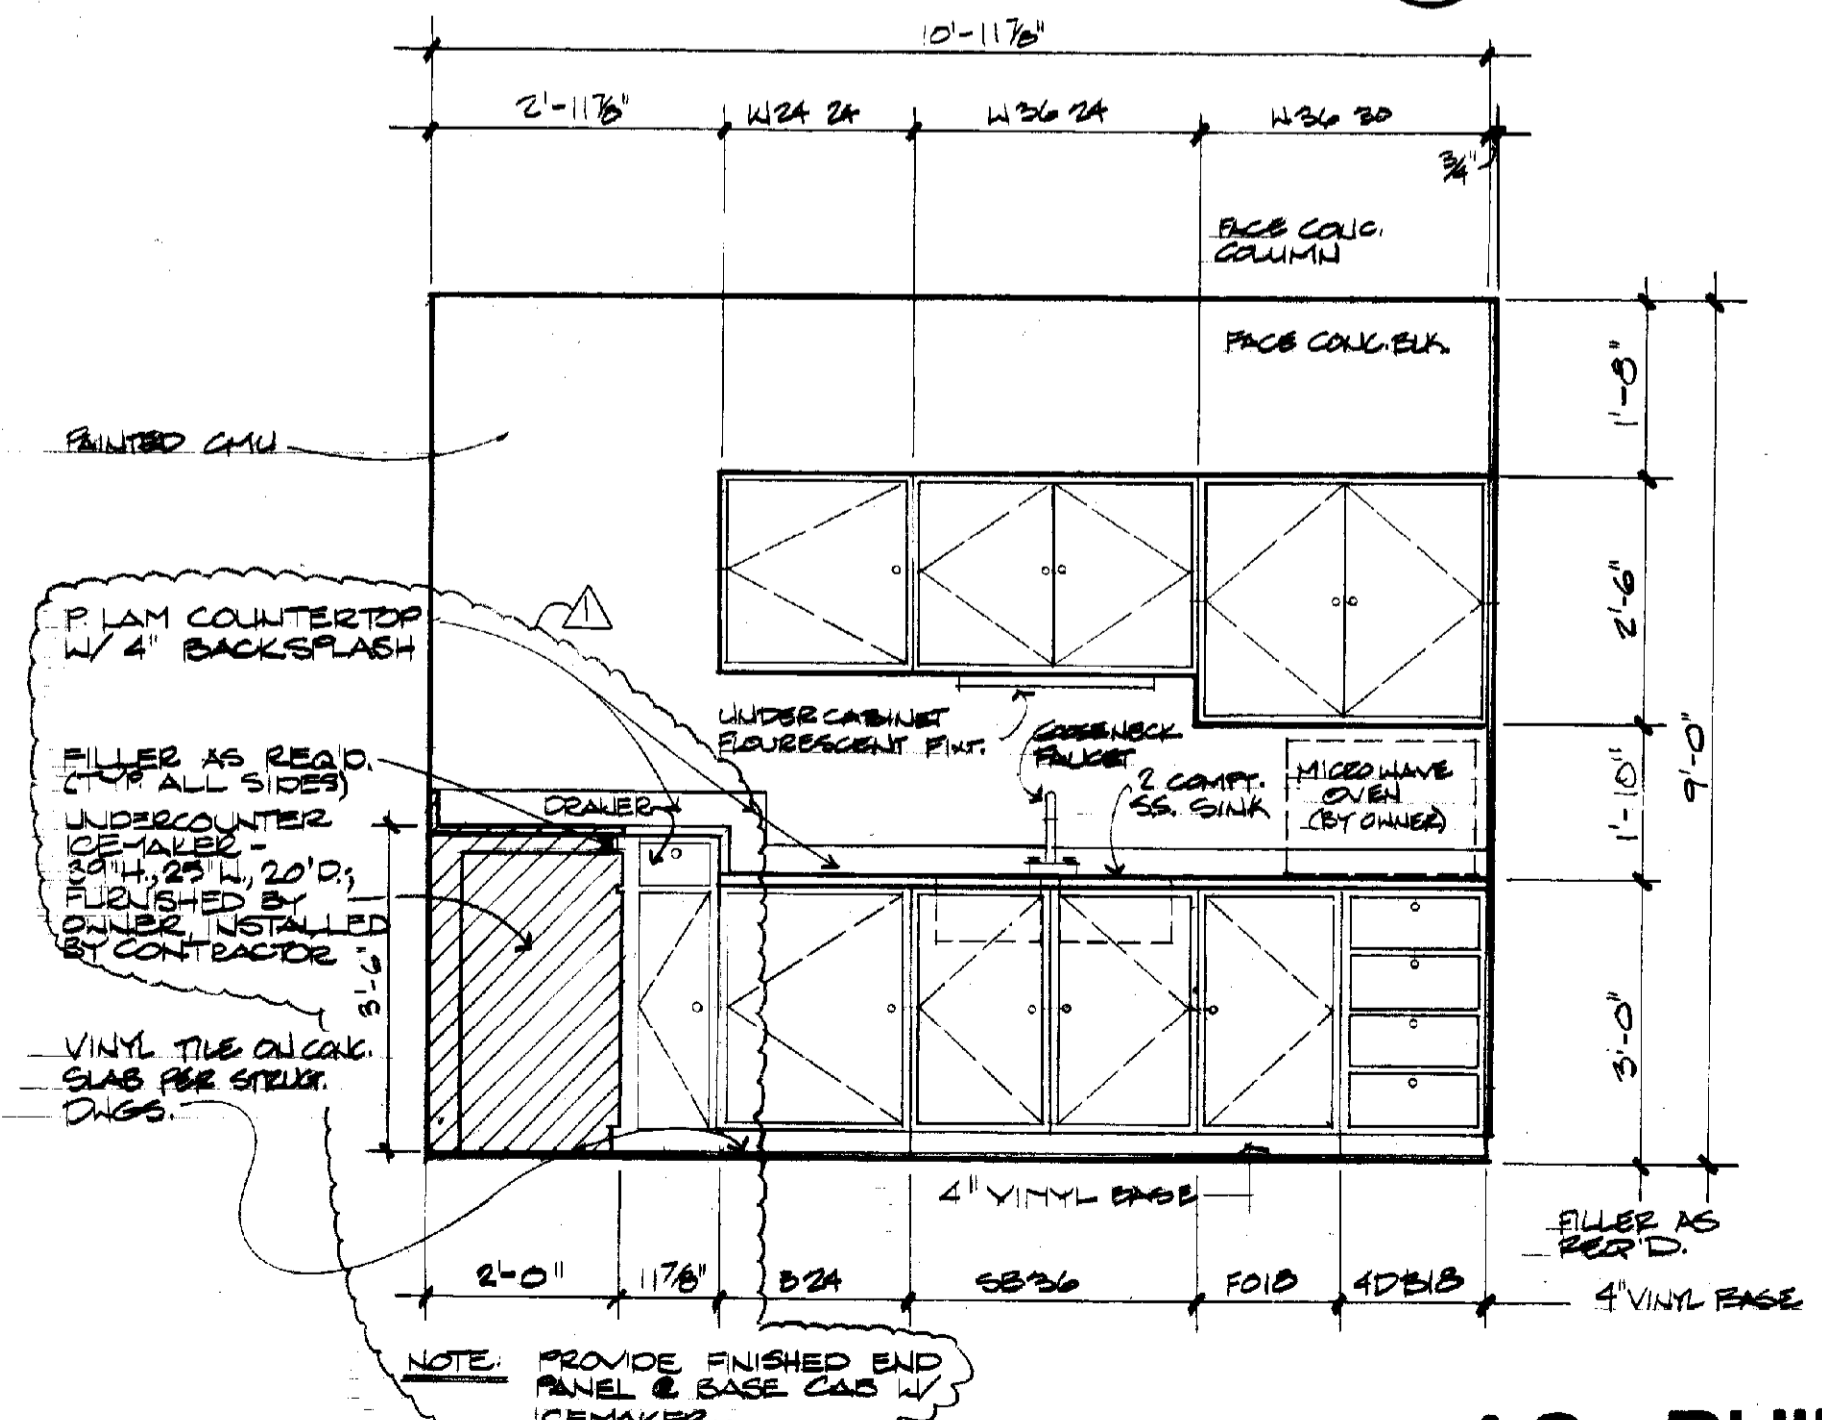

KITCHEN 308 ELEVATION
 1/2" = 1'-0"

AS BUILT



ROBOTICS FACILITY
LEXINGTON CAMPUS
UNIVERSITY OF KENTUCKY
LEXINGTON, KENTUCKY

University of Kentucky
Lexington, Kentucky

10-18-87
10-18-87
SHERMAN CARTER BARNHART ARCHITECTS, INC.

CASEWORK ELEVATIONS & DETAILS

Sherman Carter Barnhart
PARTNERS IN ARCHITECTURE
LEXINGTON FINANCIAL CENTER - SUITE 1900 - 750 W. MAIN - LEXINGTON, KY 40501 - 606-254-1851


JOB NO. 8706
DATE 10-1-87
DRAWN STAFF
CHECKED CEB

FILE NO. 431.0

REVISIONS	


SHEET

A-30

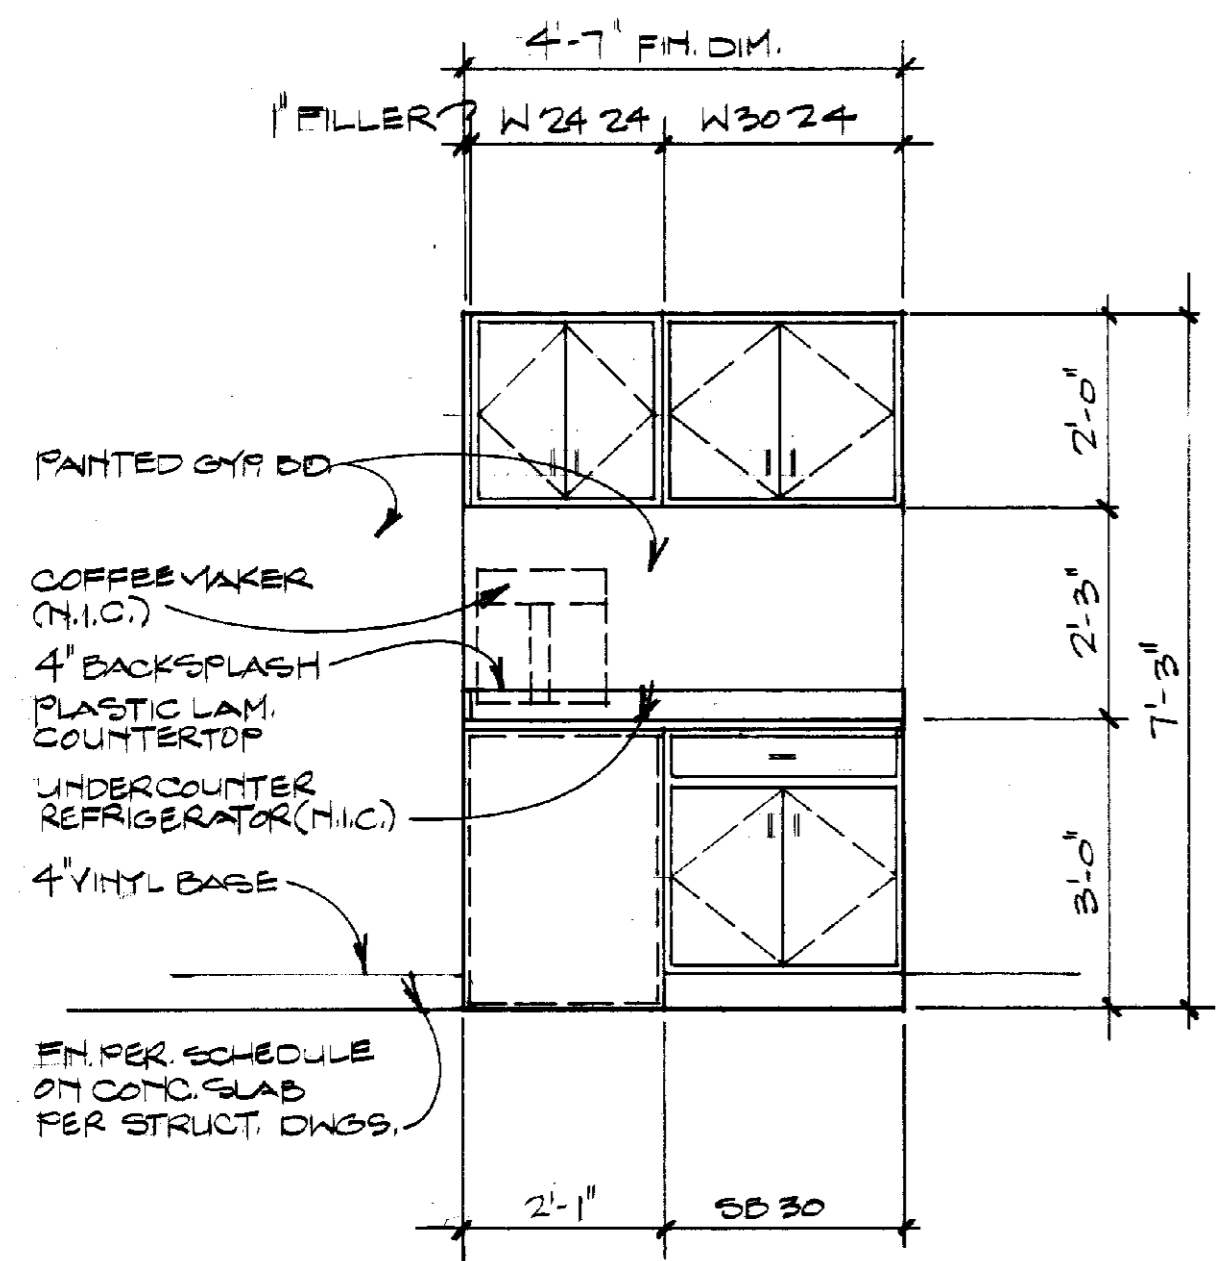


CASEWORK ELEVATION
1/2" = 1'-0"

A
A-30

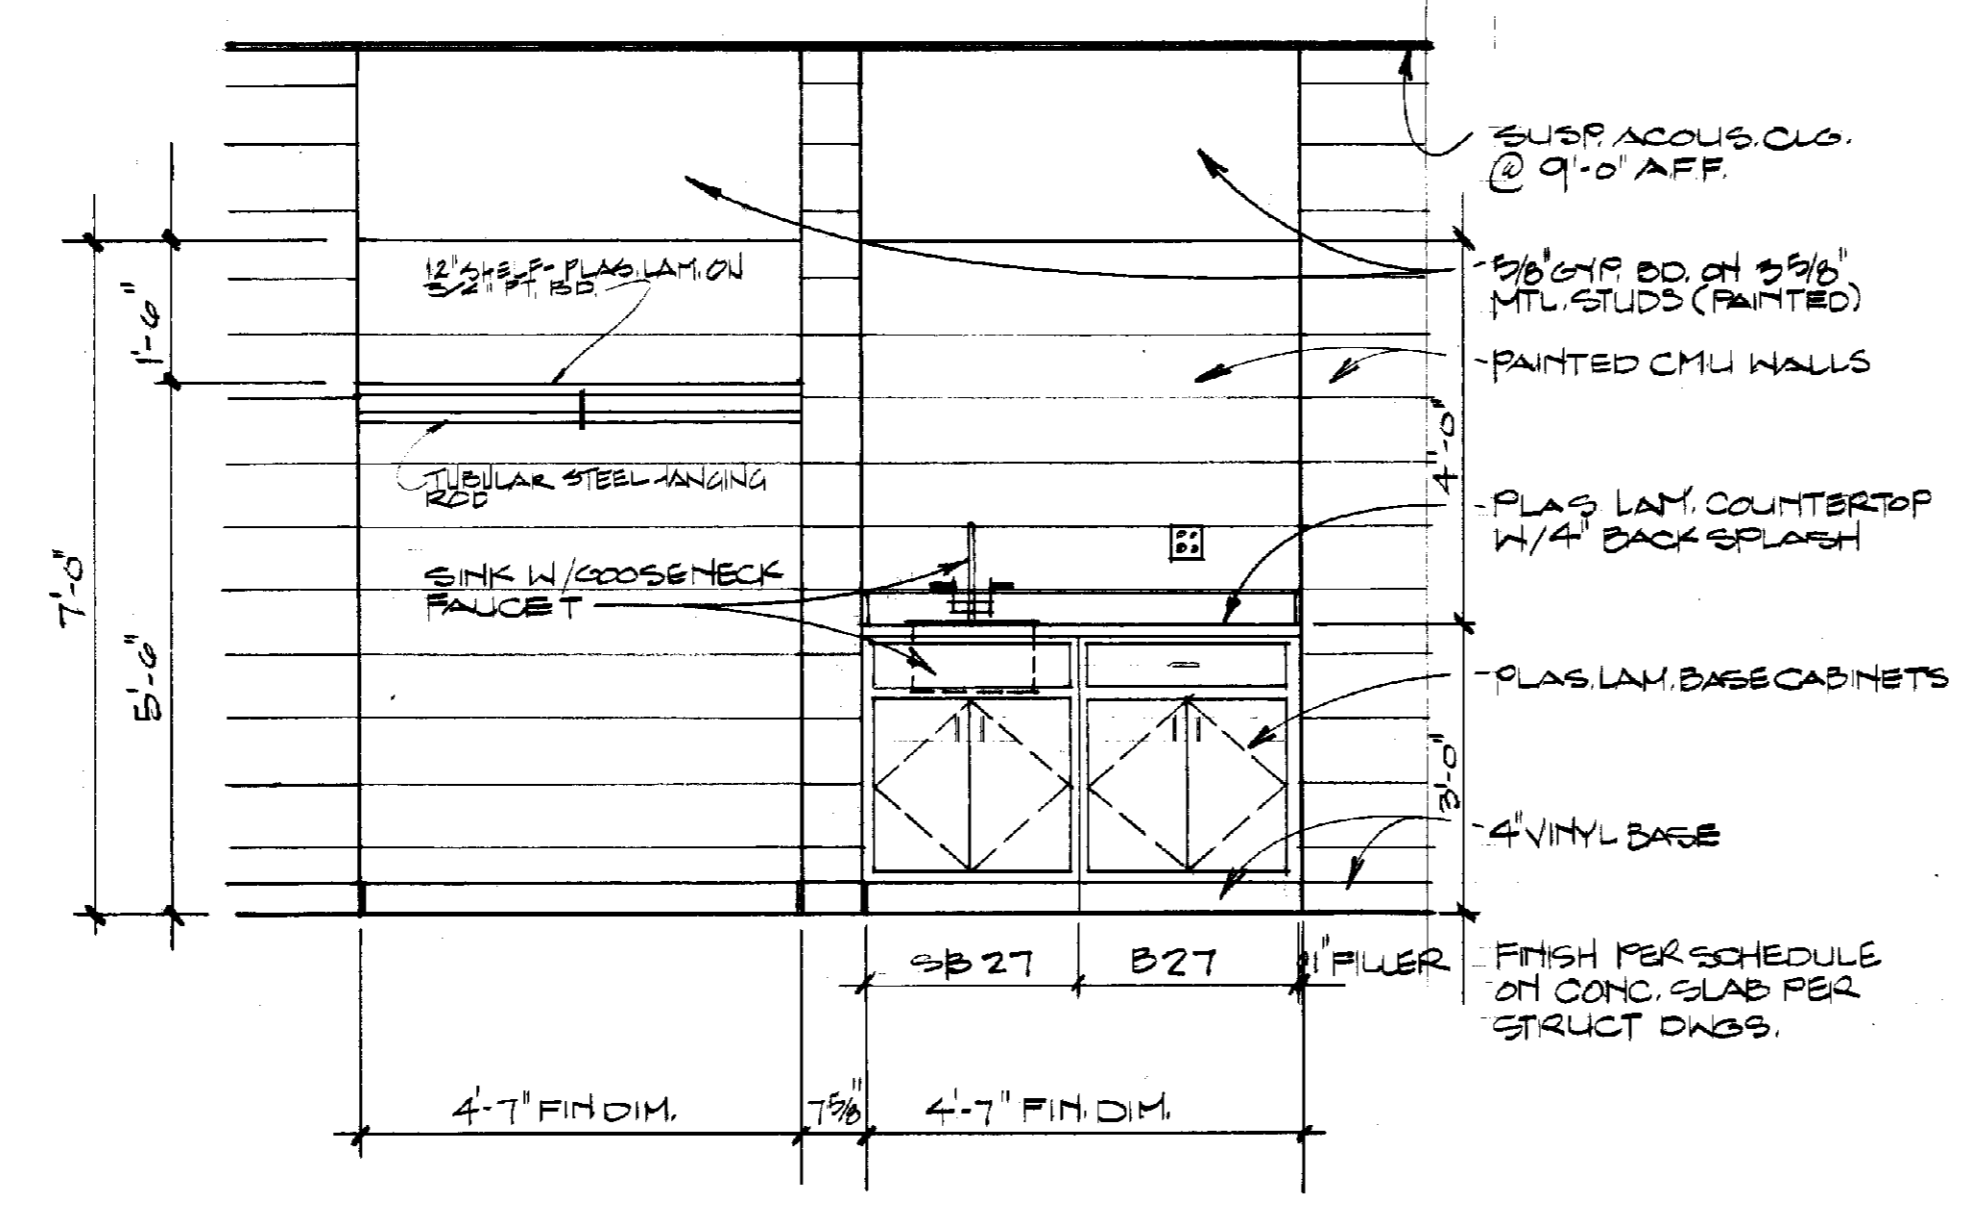


CASEWORK ELEVATION
1/2" = 1'-0"

B
A-30

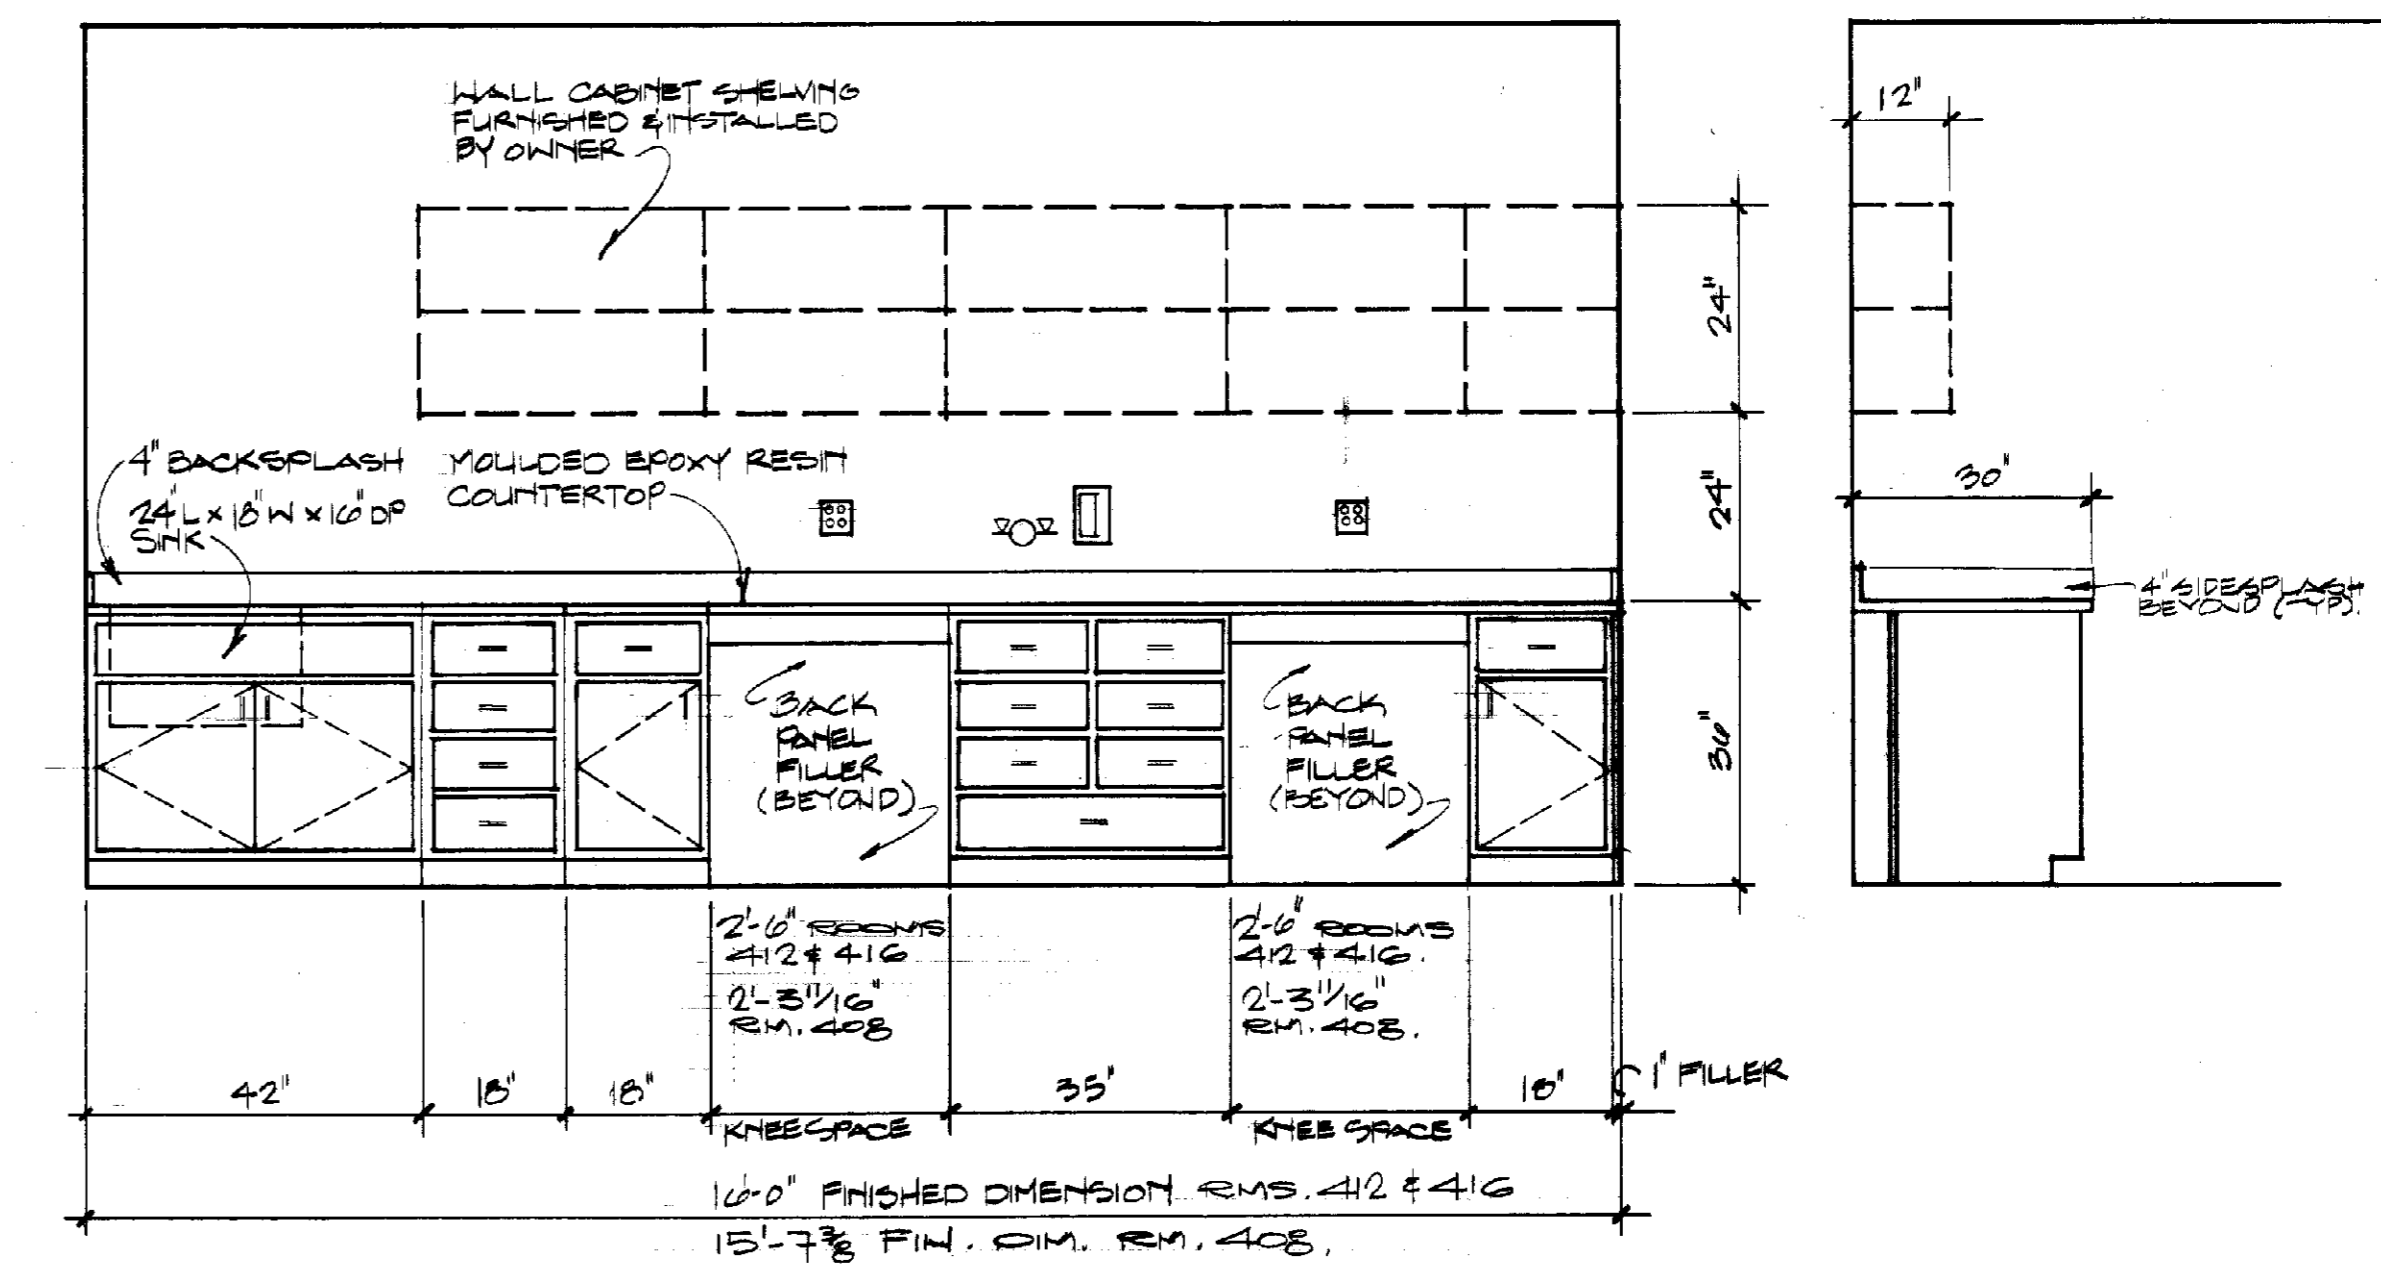


LABORATORY CASEWORK ELEVATION
1/2" = 1'-0"

C
A-30

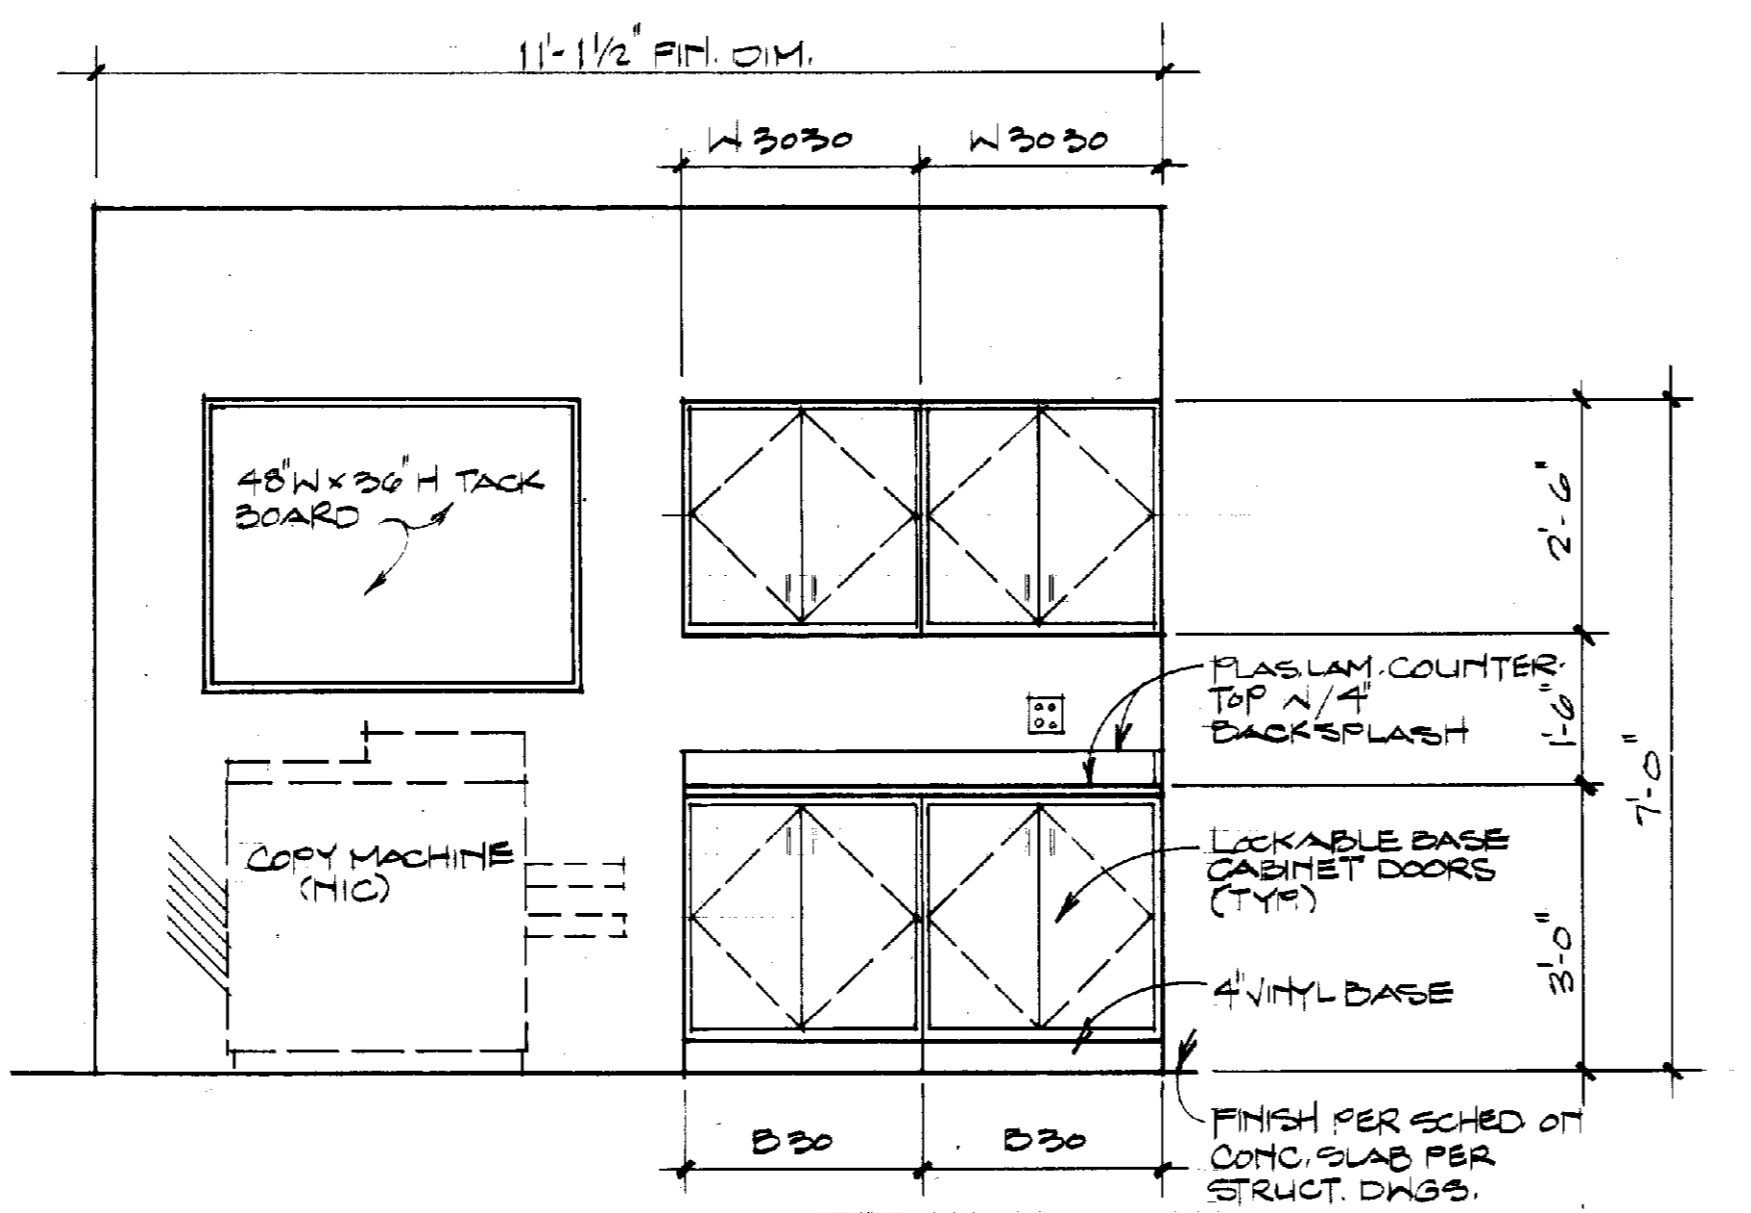

WORKROOM CASEWORK ELEVATION
1/2" = 1'-0"

E
A-30

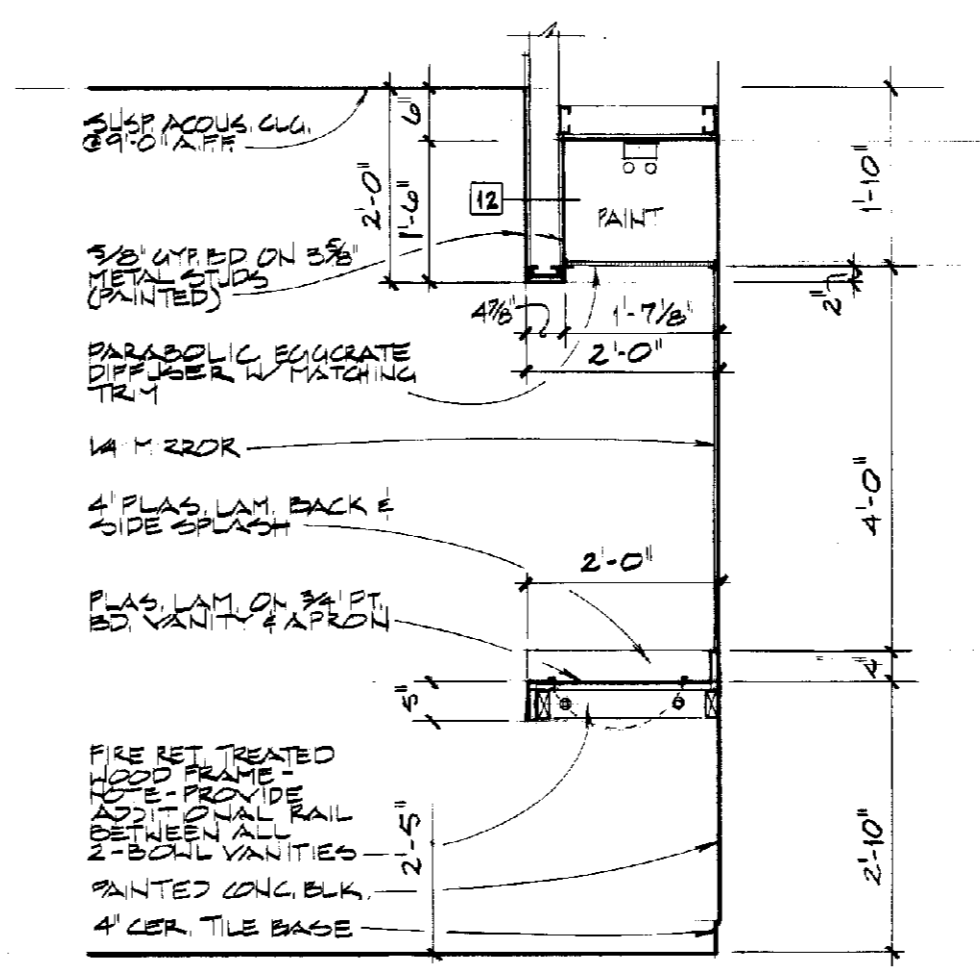


VANITY SECTION
1/2" = 1'-0"

F
A-30

FINISHES SCHEDULE

ROOM		FLOORS		BASE		WALLS		CEILINGS		REMARKS	
NO.	DESCRIPTION	RES. TILE	CONCRETE	CARPET	CER. TILE	PORCELAIN TILE	VINYL COVE	WINDOW WALL	CER. TILE	PAINTED MASONRY	CEILING HEIGHT
B00	ELEVATOR LOBBY	●			●						9'-0"
B01	SERVICE LOBBY	●			●						9'-0"
B02	MECHANICAL	●			●						VARIES (1) NO BASE
B03	BLOG OPERATIONS	●			●						9'-0"
B04	WORKROOM/STORAGE	●			●						10'-0"
B05	OFFICE	●			●						9'-0"
B06	OFFICE	●			●						9'-0"
B07	MACHINES BAY	●			●						31'-1 1/2" (1) SEE PLANS & SECTIONS FOR LOCATIONS
B08	CORRIDOR	●			●						VARIES (1) 9'-0" MIN.
B09	PUMP ROOM	●			●						13'-0" (1) NO BASE
B10	ELECTRICAL	●			●						13'-0" (1) NO BASE
B11	COMMUNICATIONS	●			●						13'-0" (1) NO BASE
B12	SERVICE	●			●						8'-0" (1) NO BASE
B13	ELECTRICAL EQUIP.	●			●						13'-0" (1) NO BASE
B14	GENERATOR	●			●						13'-0" (1) NO BASE
B15	NOT USED										
B16	NOT USED										
B17	LAB	●			●						10'-0" PROVIDE VINYL COVE AROUND B17
B18	LAB	●			●						10'-0"
B19	TESTING CHAMBER	●			●						(1) PER TESTING CHAMBER EQUIP. MFG. (NIG)
B20	STORAGE	●			●						9'-0"
B21	VESTIBULE	●			●						8'-0"
B22	MEN	●			●						9'-0"
B23	JANITOR	●			●						10'-6"
B24	VEST BULE	●			●						8'-0"
B25	WOMEN	●			●						9'-0"
100	VESTIBULE			(1)							9'-0" (1) CORCA MAT
101	FOYER										9'-0" (1) PORCELAIN BASES MAS. WALLS
102	ELEVATOR LOBBY										9'-0" (1) PORCELAIN BASES MAS. WALLS
103	SERVICE LOBBY	●			●						15'-0" (1) NO BASE
104	SERVICE AREA	●			●						15'-0" (1) NO BASE
105	TRUCK BAY	●			●						18'-0" (1) NO BASE
106	RECEIVING	●			●						15'-0" (1) NO BASE
107	RECEIVING OFFICE	●			●						9'-0" (1) NO BASE
108	STORAGE	●			●						15'-0" (1) NO BASE
109	RECEPTION/DISPLAY	●			●						9'-0" (1) PORCELAIN @ MAS. WALLS
110	MEN	●			●						9'-0"
111	VENDING	●			●						8'-0" (1) PORCELAIN @ MAS. WALLS
112	CORRIDOR	●			●						9'-0" (1) PORCELAIN @ MAS. WALLS
113	WOMEN	●			●						9'-0"
114	STUDENT COMMONS	●			●						9'-0" (1) PORCELAIN @ MAS. WALLS
115	FAT ROOM	●			●						15'-0" (1) NO BASE
116	ELECTRICAL	●			●						15'-0" (1) NO BASE
117	COMMUNICATIONS	●			●						15'-0" (1) NO BASE
118	PIRE CONTROL	●			●						15'-0" (1) NO BASE
119	CLOSET	●			●						8'-0" PORCELAIN @ MAS. WALLS
200	ELEVATOR LOBBY	●			●						9'-0"
201	SERVICE LOBBY	●			●						9'-0"
202	VESTIBULE	●			●						8'-0"
203	JANITOR	●			●						15'-0"
204	WOMEN	●			●						9'-0"
205	MEN	●			●						9'-0"
206	VESTIBULE	●			●						8'-0"
207	CORRIDOR	●			●						9'-0"
208	VISITOR OFFICE	●			●						9'-0"
209	GRAPHICS WORKSTATION	●			●						9'-0"
210	VISITOR OFFICE	●			●						9'-0"
211	VISITOR OFFICE	●			●						9'-0"
212	VISITOR OFFICE	●			●						9'-0"
213	VISITOR OFFICE	●			●						9'-0"
214	VISITOR OFFICE	●			●						9'-0"
215	VISITOR OFFICE	●			●						9'-0"
216	VISITOR OFFICE	●			●						9'-0"
217	VISITOR OFFICE	●			●						9'-0"
218	STORAGE	●			●						9'-0"
219	COMPUTER OFFICE	●			●						9'-0"
220	VISITOR OFFICE	●			●						9'-0"
221	SEM/HR	●			●						9'-0"
222	CORRIDOR	●			●						9'-0"
223	FAT ROOM	●			●						15'-0" (1) NO BASE
224	ELECTRICAL	●			●						15'-0" (1) NO BASE
225	COMMUNICATIONS	●			●						15'-0" (1) NO BASE
226	PROJECT DIRECTOR	●			●						9'-0" (1) STRAIGHT
227	PROJECT DIRECTOR	●			●						9'-0" (1) STRAIGHT
228	PROJECT DIRECTOR	●			●						9'-0" (1) STRAIGHT
229	PROJECT DIRECTOR	●			●						9'-0" (1) STRAIGHT
230	PROJECT DIRECTOR	●			●						9'-0" (1) STRAIGHT
231	SECRETARY/WAITING	●			●						9'-0" (1) STRAIGHT
232	WORKROOM	●			●						9'-0" (1) STRAIGHT
233	IND. LIASON	●			●						9'-0" (1) STRAIGHT
234	CONT. ED. EXTENSION	●			●						9'-0" (1) STRAIGHT
235	PROJECT ENGINEER	●			●						9'-0" (1) STRAIGHT
236	SECRETARY/WAITING	●			●						9'-0" (1) STRAIGHT
237	MEN	●			●						8'-0"
238	WOMEN	●			●						8'-0"
239	CORRIDOR	●			●						9'-0" (1) STRAIGHT
240	BUSINESS	●			●						9'-0" (1) STRAIGHT
241	DIRECTOR	●			●						9'-0" (1) STRAIGHT
242	CONFERENCE	●			●						9'-0" (1) STRAIGHT
243	PROJECT ENGINEER	●			●						9'-0" (1) STRAIGHT
244	PROJECT ENGINEER	●			●						9'-0" (1) STRAIGHT
245	PROJECT ENGINEER	●			●						9'-0" (1) STRAIGHT
300	ELEVATOR LOBBY	●			●						9'-0"
301	SERVICE LOBBY	●			●						9'-0"
302	VESTIBULE	●			●						8'-0"
303	JANITOR	●			●						15'-0"
304	WOMEN	●			●						9'-0"
305	MEN	●			●						9'-0"
306	VESTIBULE	●			●						8'-0"
307	CORRIDOR	●			●						9'-0"
308	ITV CLASSROOM	●			●						8'-0" (1) ON RAISED FLOORING (2) CARPET OVER RES. TILE (3) STRAIGHT CARPET FLOORING (4) STRAIGHT CARPET
309	CONTROL ROOM	●			●						8'-0" (1) ON RAISED FLOORING (2) CARPET OVER RES. TILE (3) STRAIGHT CARPET FLOORING (4) STRAIGHT CARPET
310	PRODUCTION	●			●						9'-0" (1) ON RAISED FLOORING (2) CARPET OVER RES. TILE (3) STRAIGHT CARPET FLOORING (4) STRAIGHT CARPET
311	PRODUCTION	●			●						9'-0" (1) ON RAISED FLOORING (2) CARPET OVER RES. TILE (3) STRAIGHT CARPET FLOORING (4) STRAIGHT CARPET
312	ITV CLASSROOM	●			●						10'-0" (1) ON RAISED FLOORING (2) CARPET OVER RES. TILE (3) STRAIGHT CARPET FLOORING (4) STRAIGHT CARPET
313	FAT ROOM	●			●						15'-0" (1) NO BASE
314	ELECTRICAL	●			●						15'-0" (1) NO BASE
315	COMMUNICATIONS	●			●						15'-0" (1) NO BASE
316	CORRIDOR	●			●						9'-0"
317	TAPE VIEWING	●			●						9'-0"
318	TAPE STORAGE	●			●						9'-0"
319	CORRIDOR	●			●						9'-0"
320	RESEARCH ASSISTANT	●			●						9'-0"
321	RESEARCH ASSISTANT	●			●						9'-0"
322	RESEARCH ASSISTANT	●			●						9'-0"
323	RESEARCH ASSISTANT	●			●						9'-0"
324	COMPUTER OFFICE	●			●						9'-0"
325	PERSONEL COMPUTERS	●			●						9'-0"
326	STAFF LOUNGE	●			●						9'-0" (1) STRAIGHT @ CARPET
327	KITCHEN	●			●						9'-0"

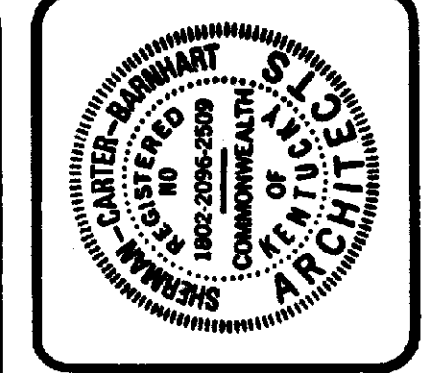

ROBOTICS FACILITY
 LEXINGTON CAMPUS
UNIVERSITY OF KENTUCKY
 LEXINGTON, KENTUCKY

University of Kentucky
 Lexington, Kentucky

10-19-87
 SHEET NO. 431.0

ROOM FINISH SCHEDULE

Sherman Carter Barnhart
 PARTNERS IN ARCHITECTURE

SUITE 1800 • 250 WEST MAIN STREET • LEXINGTON, KY 40507 • 606-254-1051

JOB NO. 8708
 DATE 10-1-87
 DRAWN STAFF
 CHECKED CEB
 FILE NO. 431.0

REVISIONS

1. _____

2. _____

3. _____

4. _____

5. _____

SHEET

A-31



ROBOTICS FACILITY
LEXINGTON CAMPUS
UNIVERSITY OF KENTUCKY
LEXINGTON, KENTUCKY

University of Kentucky
Lexington, Kentucky
















Sherman Carter Barnhart
PARTNERS IN ARCHITECTURE
LEXINGTON FINANCIAL CENTER - SUITE 1900 - 750 W. MAIN - LEXINGTON, KY 40507 - 405.244.1851

DETAILS


JOB NO. 8706
DATE 10-1-87
DRAWN STAFF
CHECKED CEB
FILE NO. 431.0

REVISIONS
FEB 7, 1990

SHEET
A-344

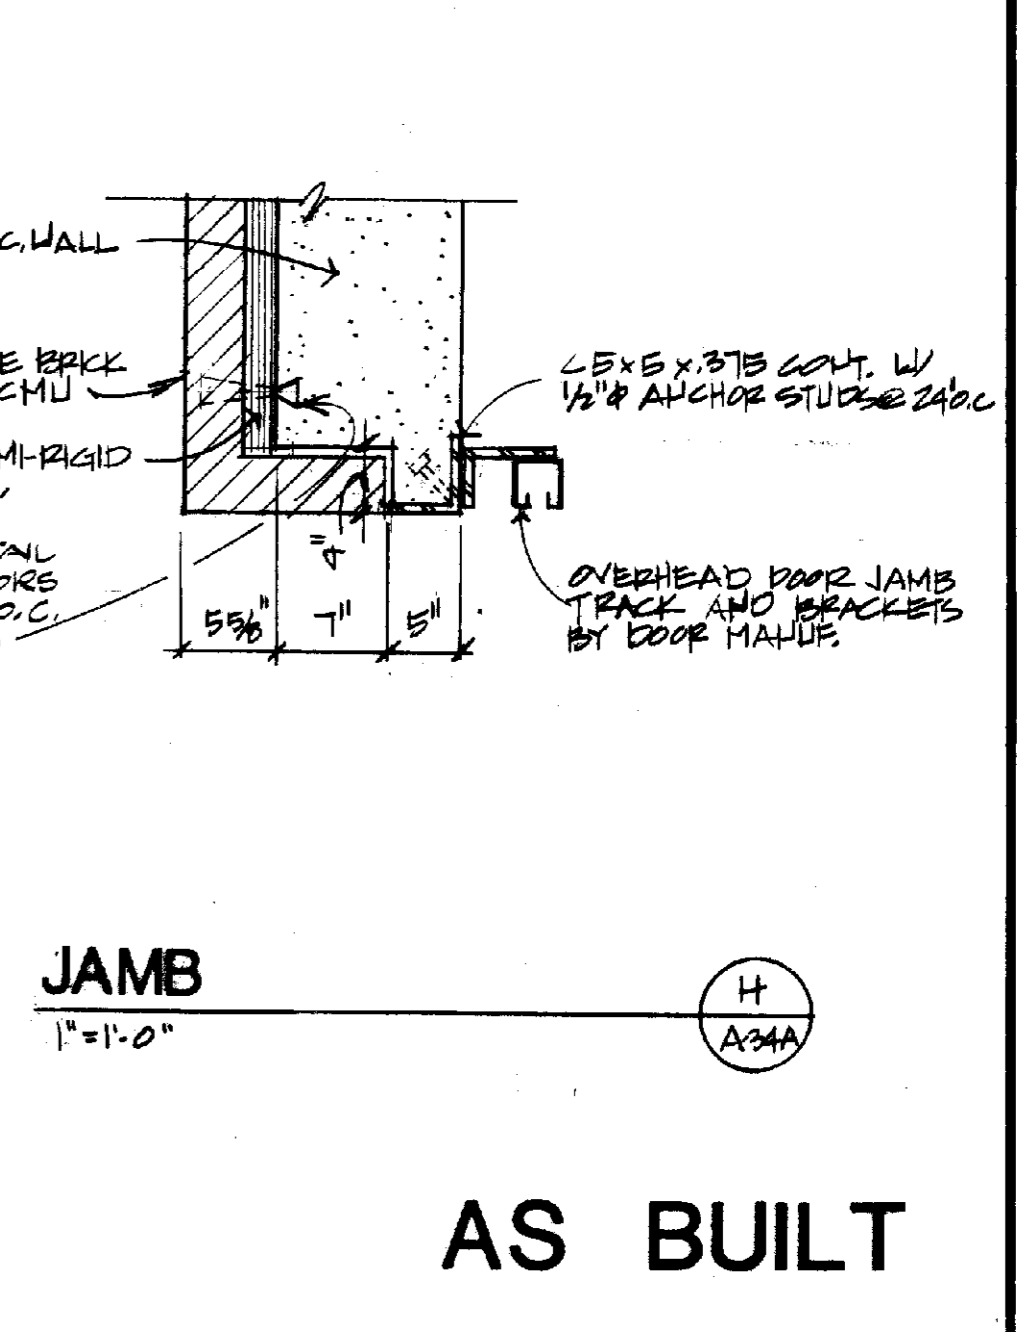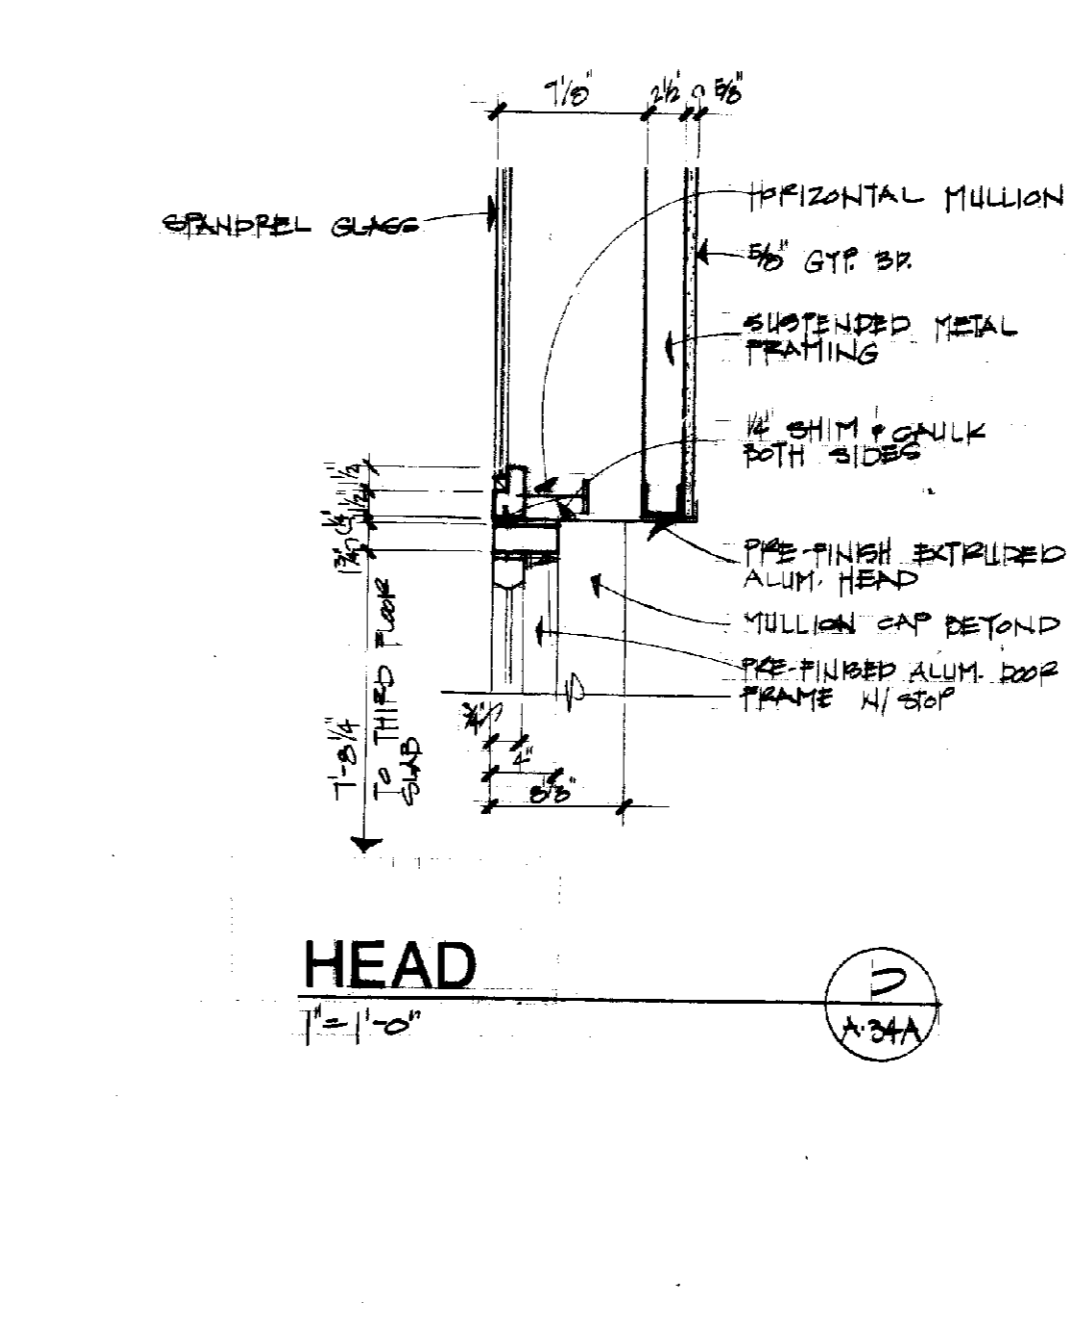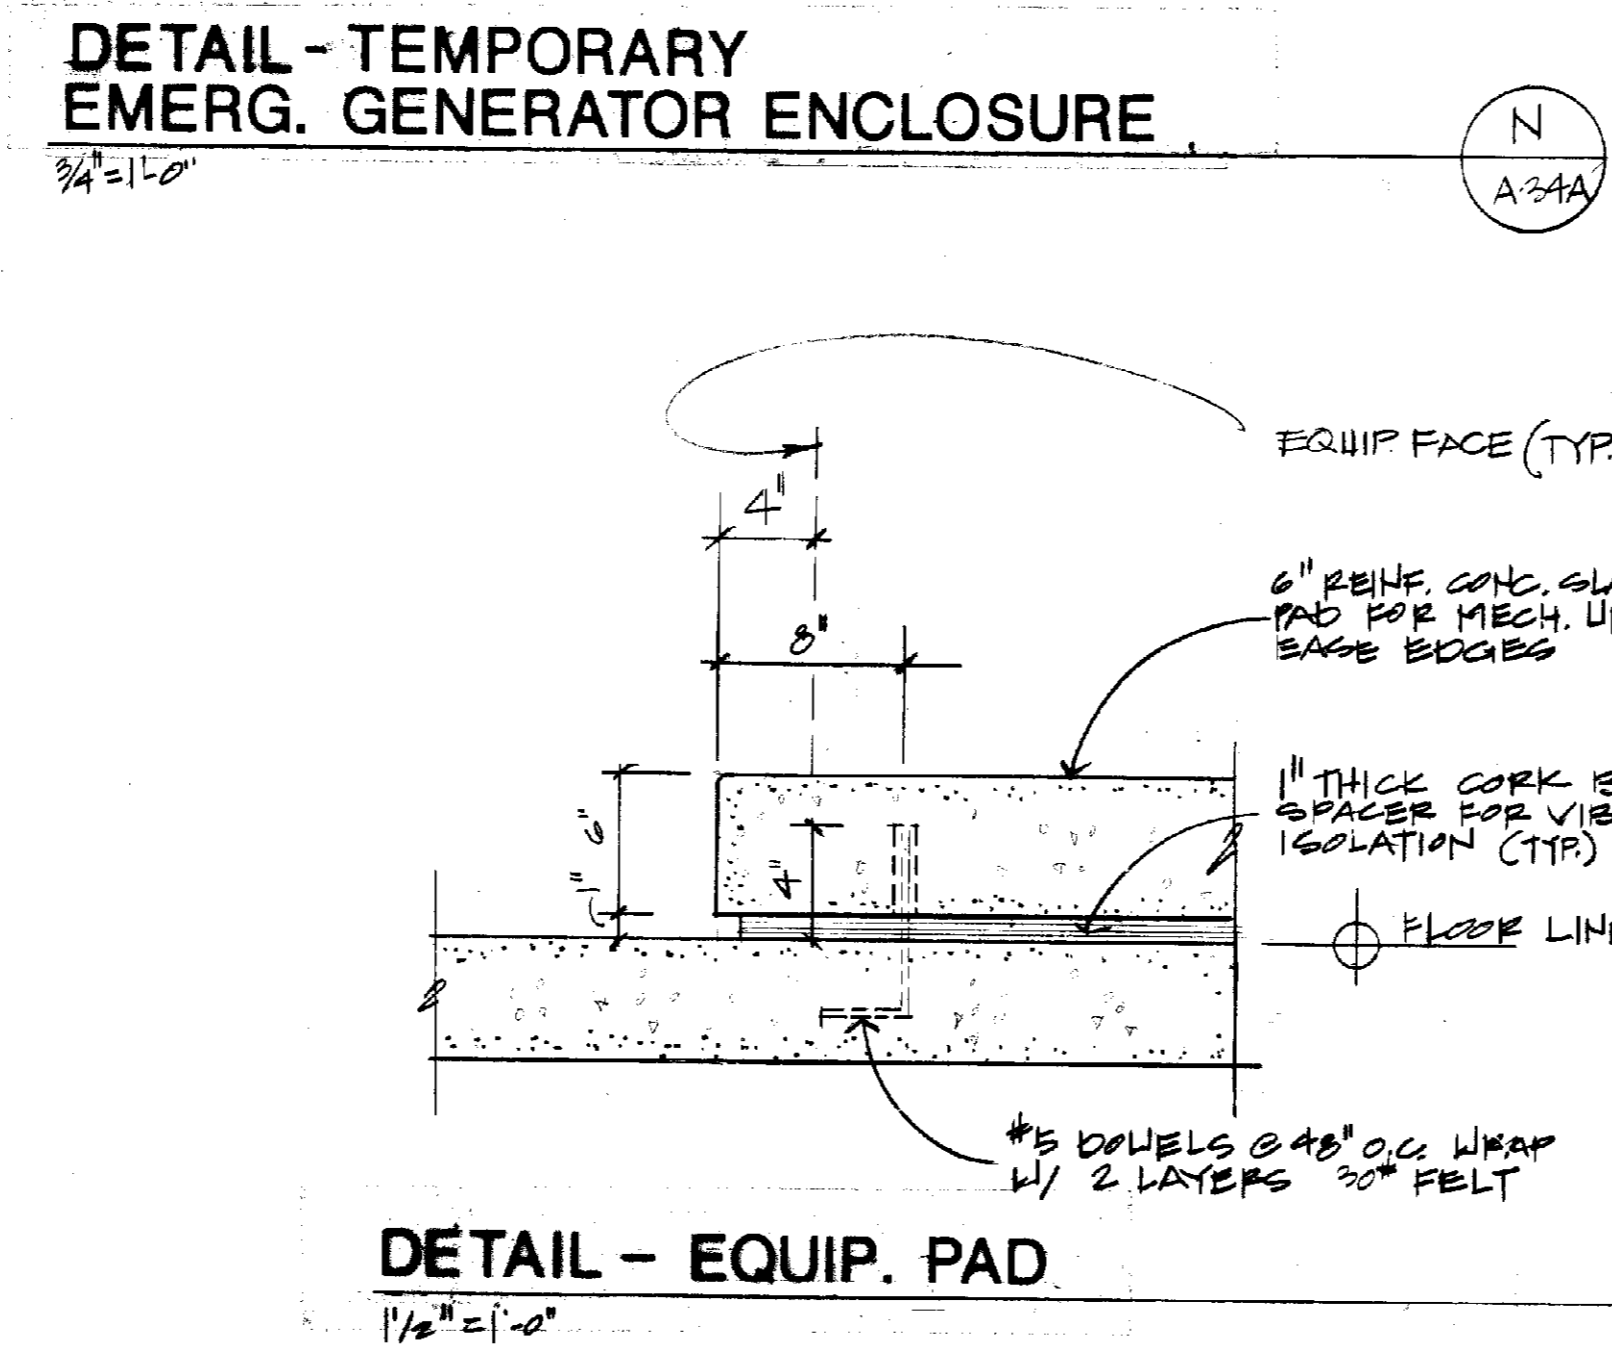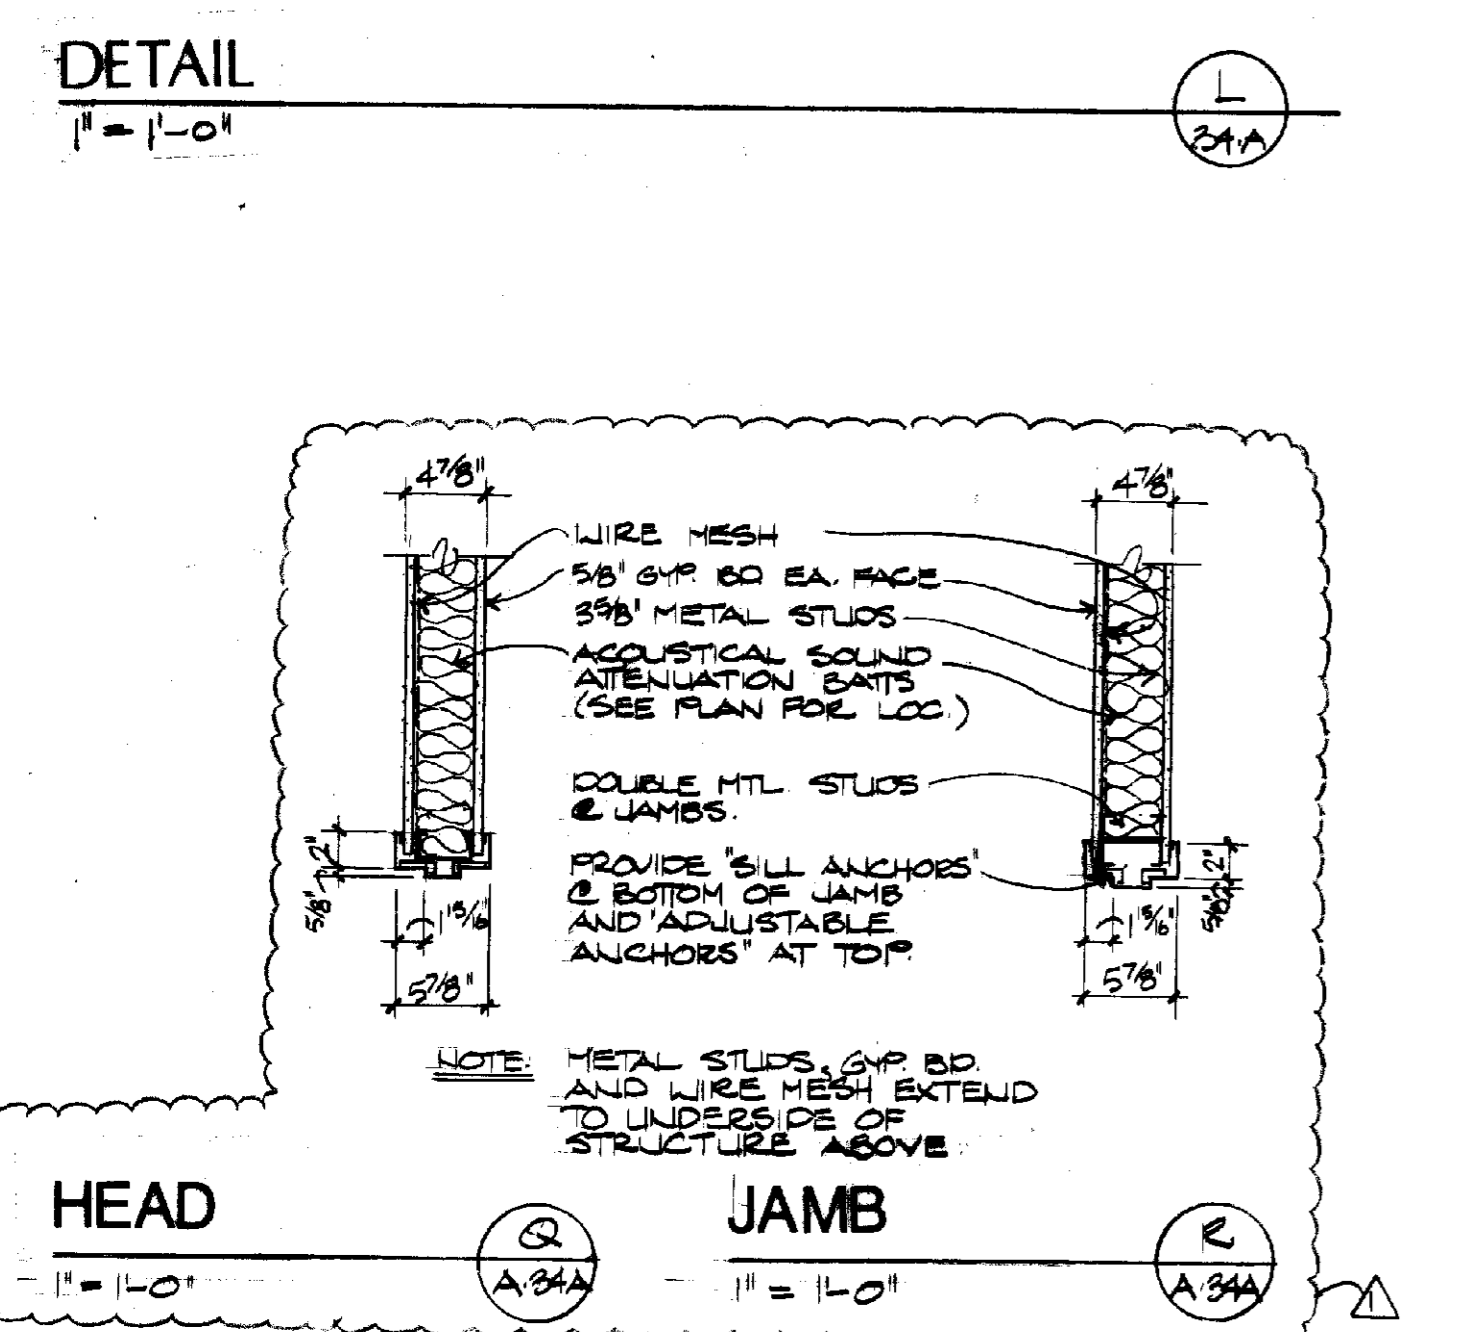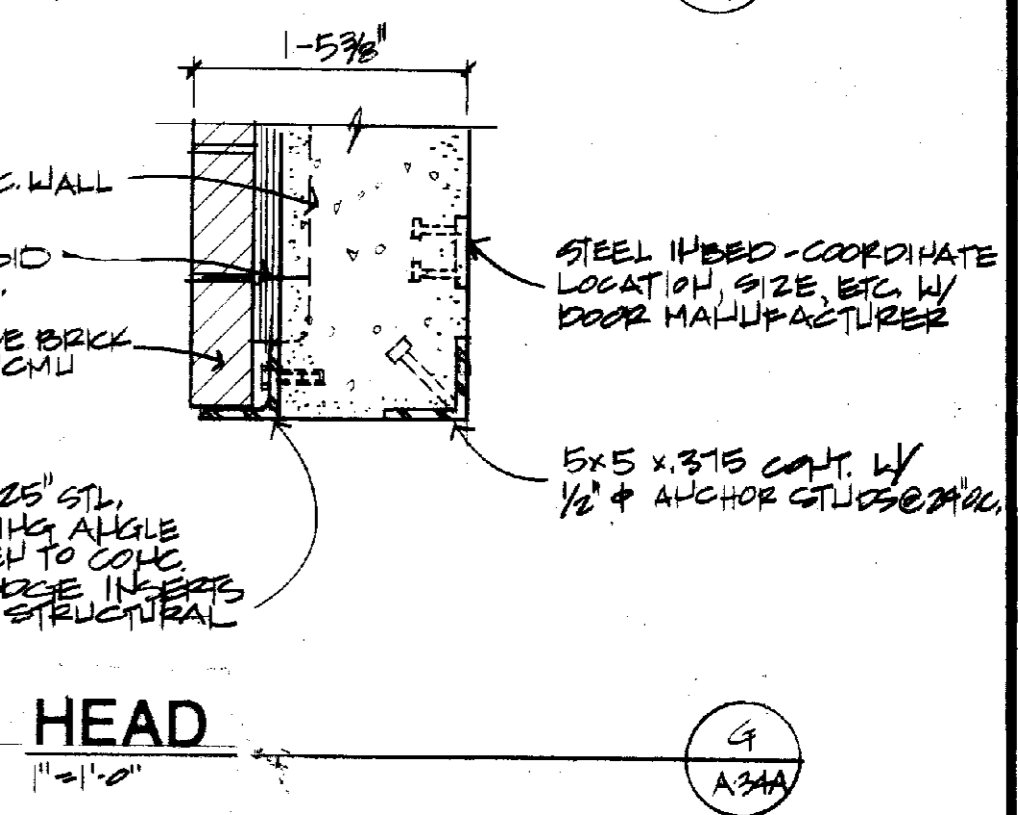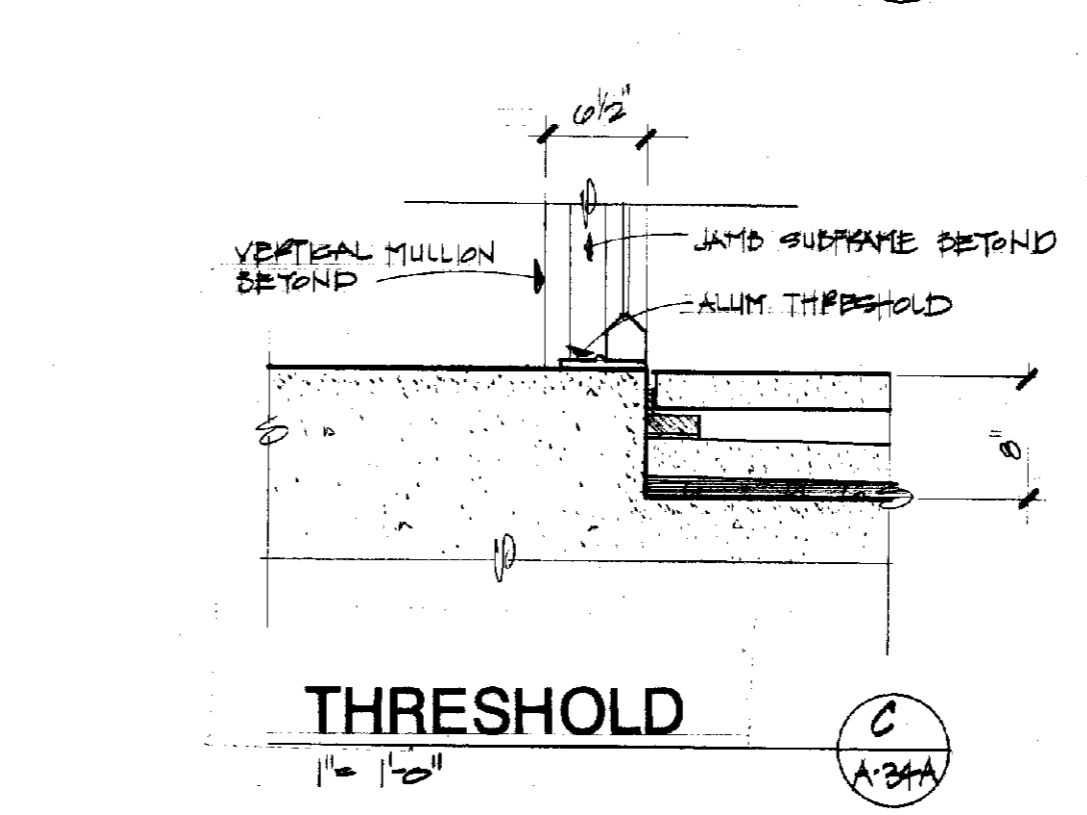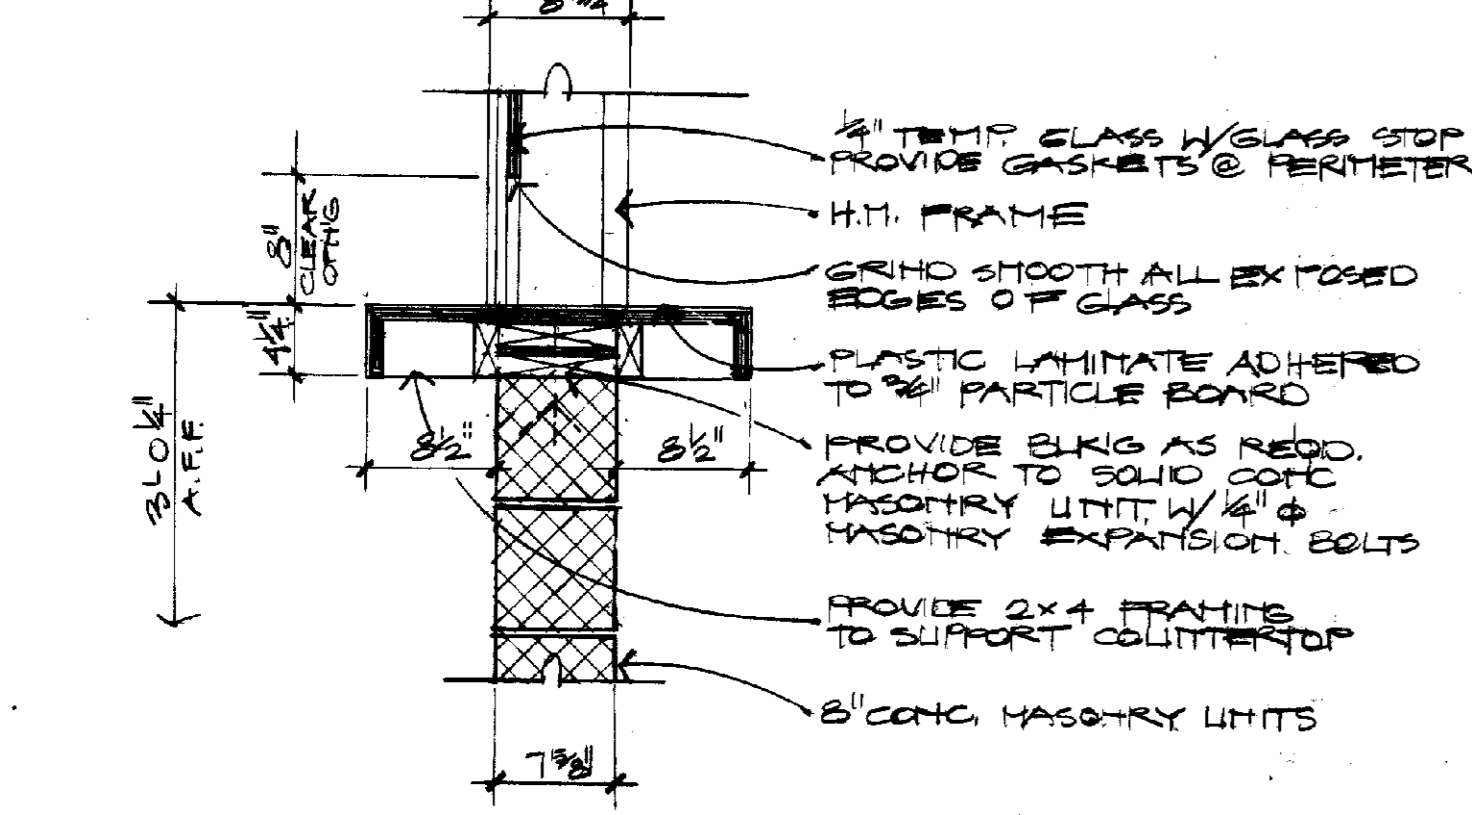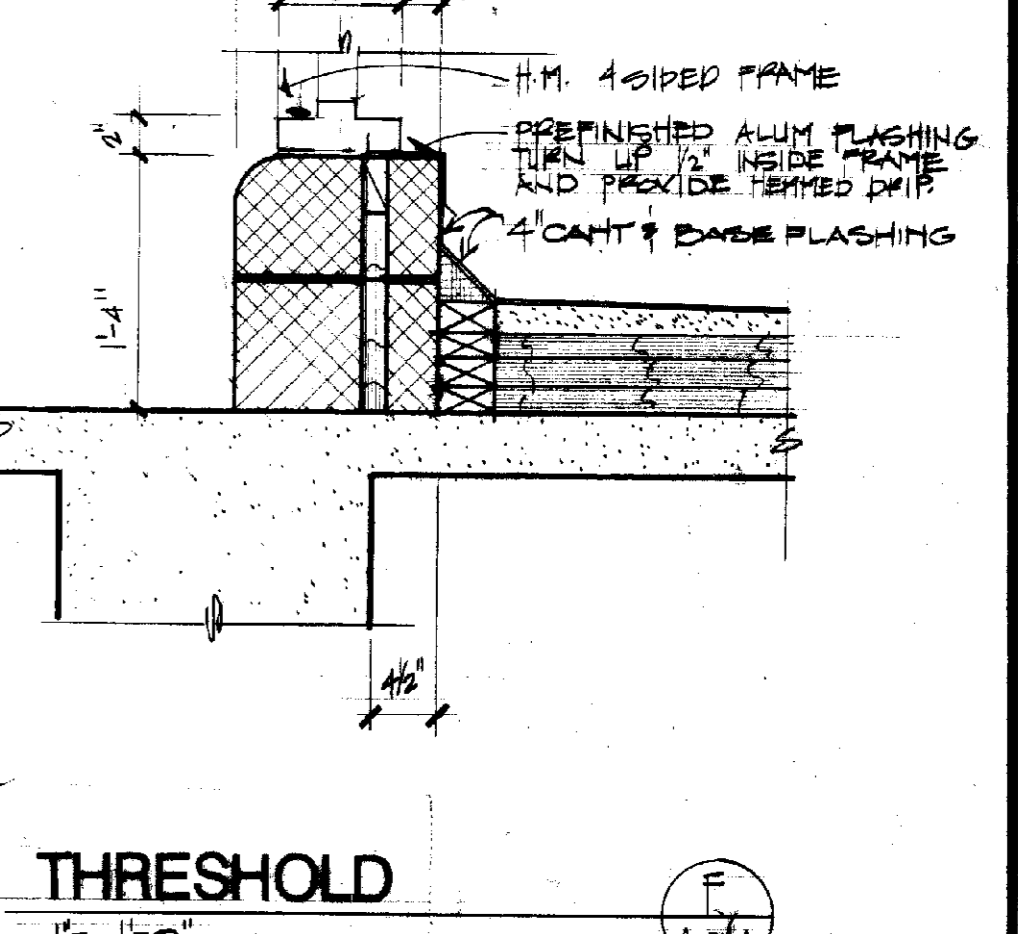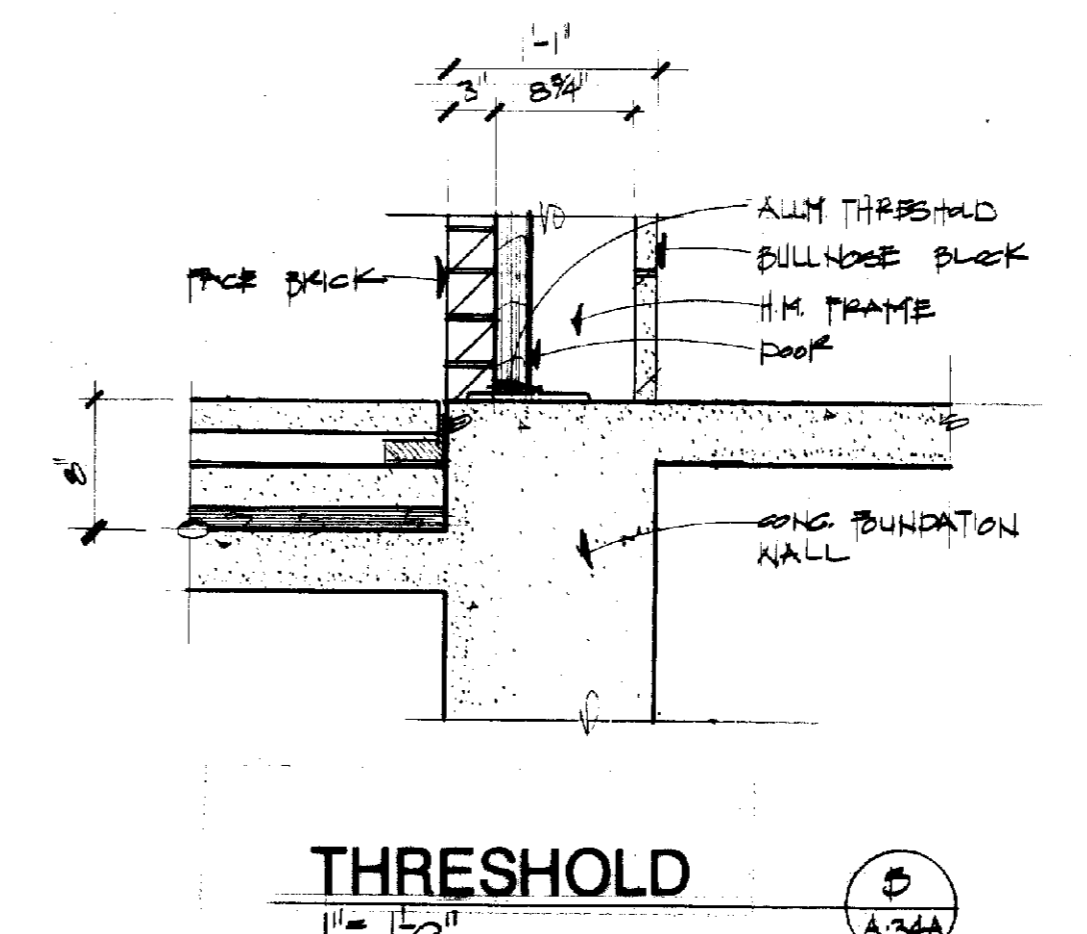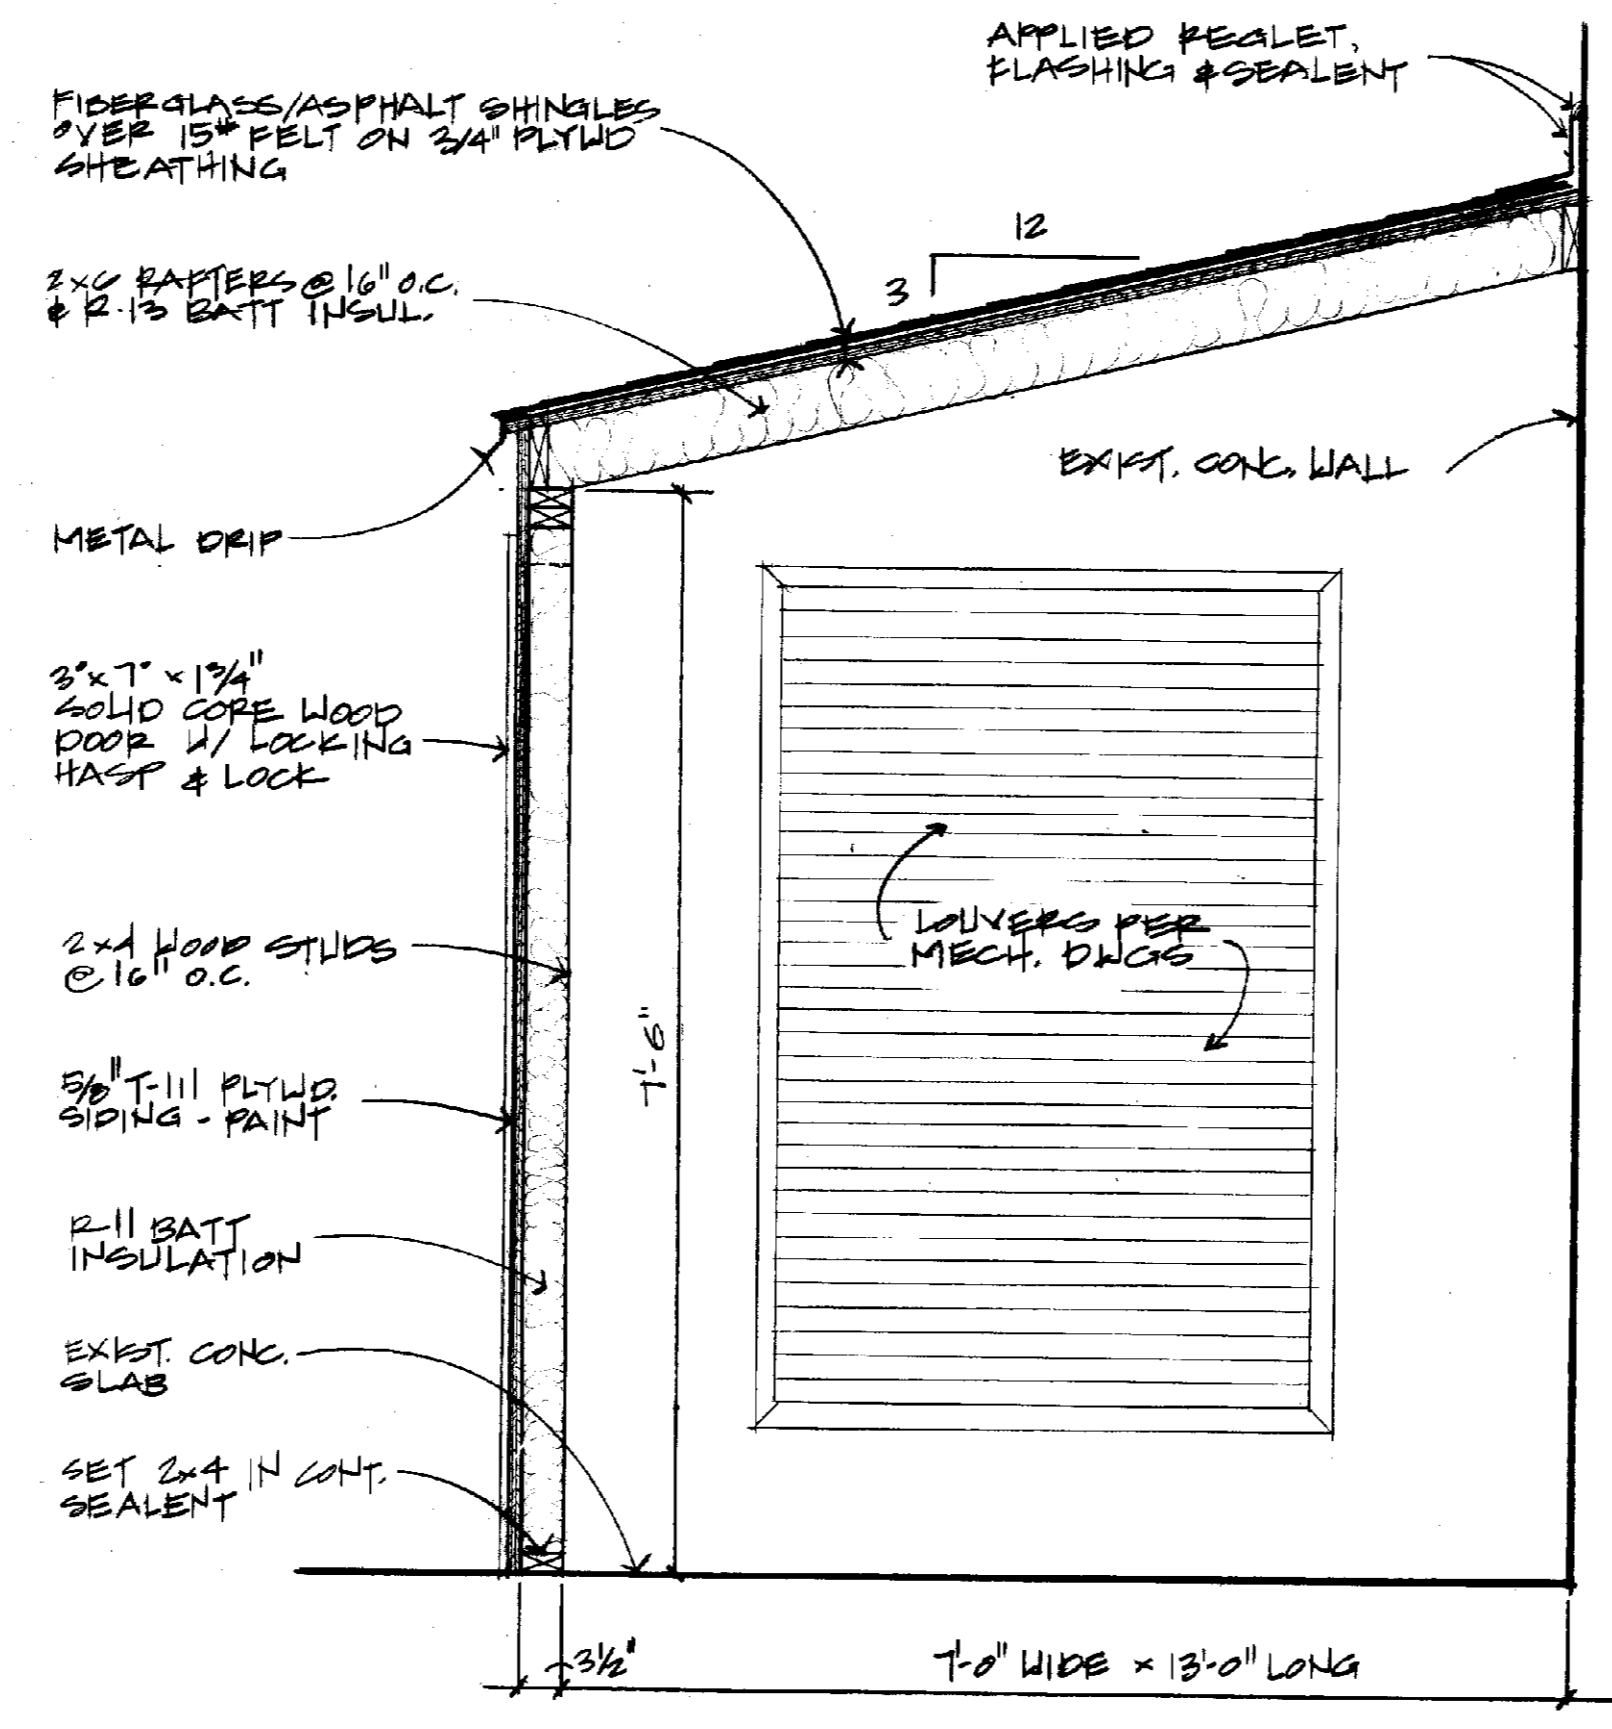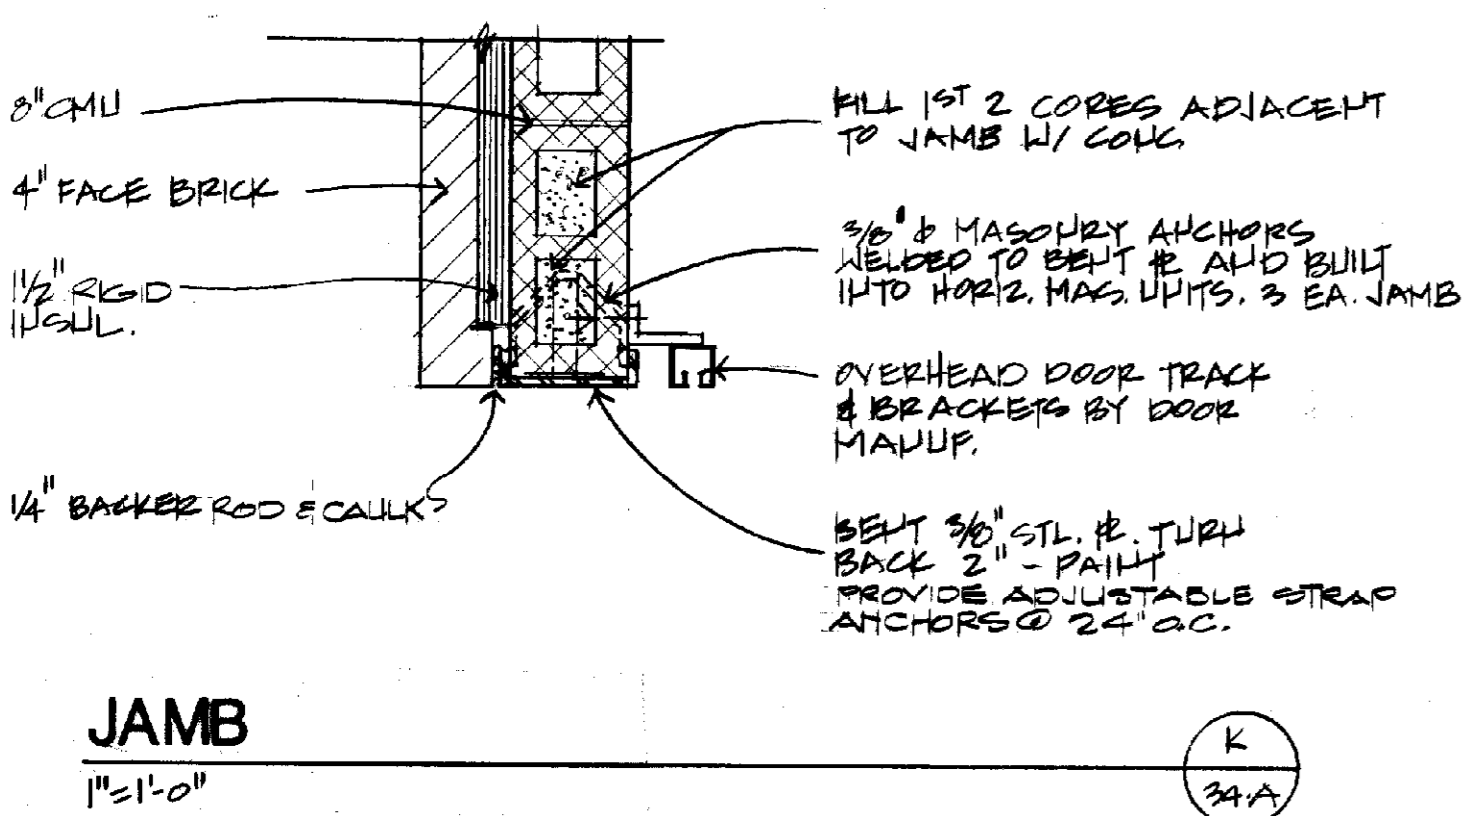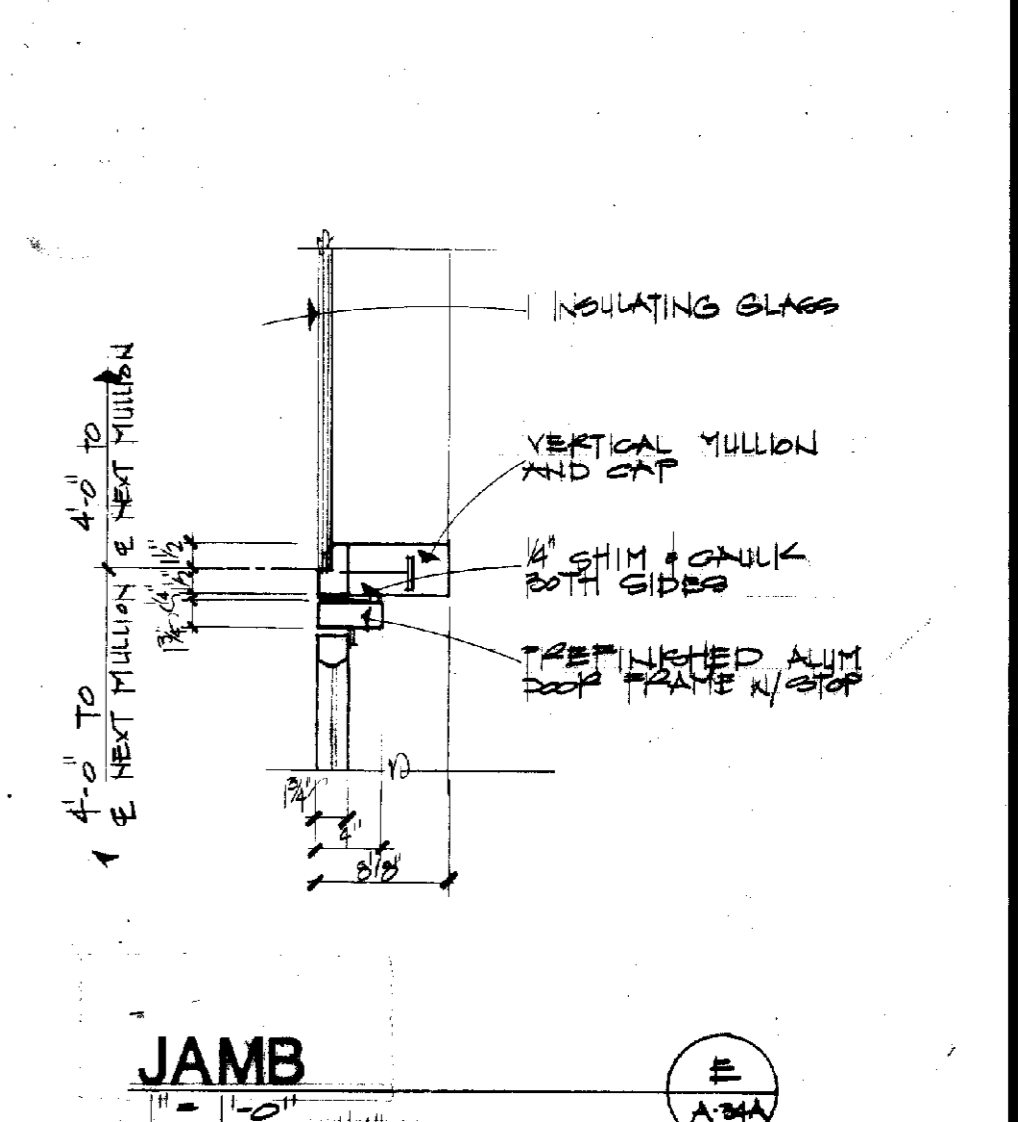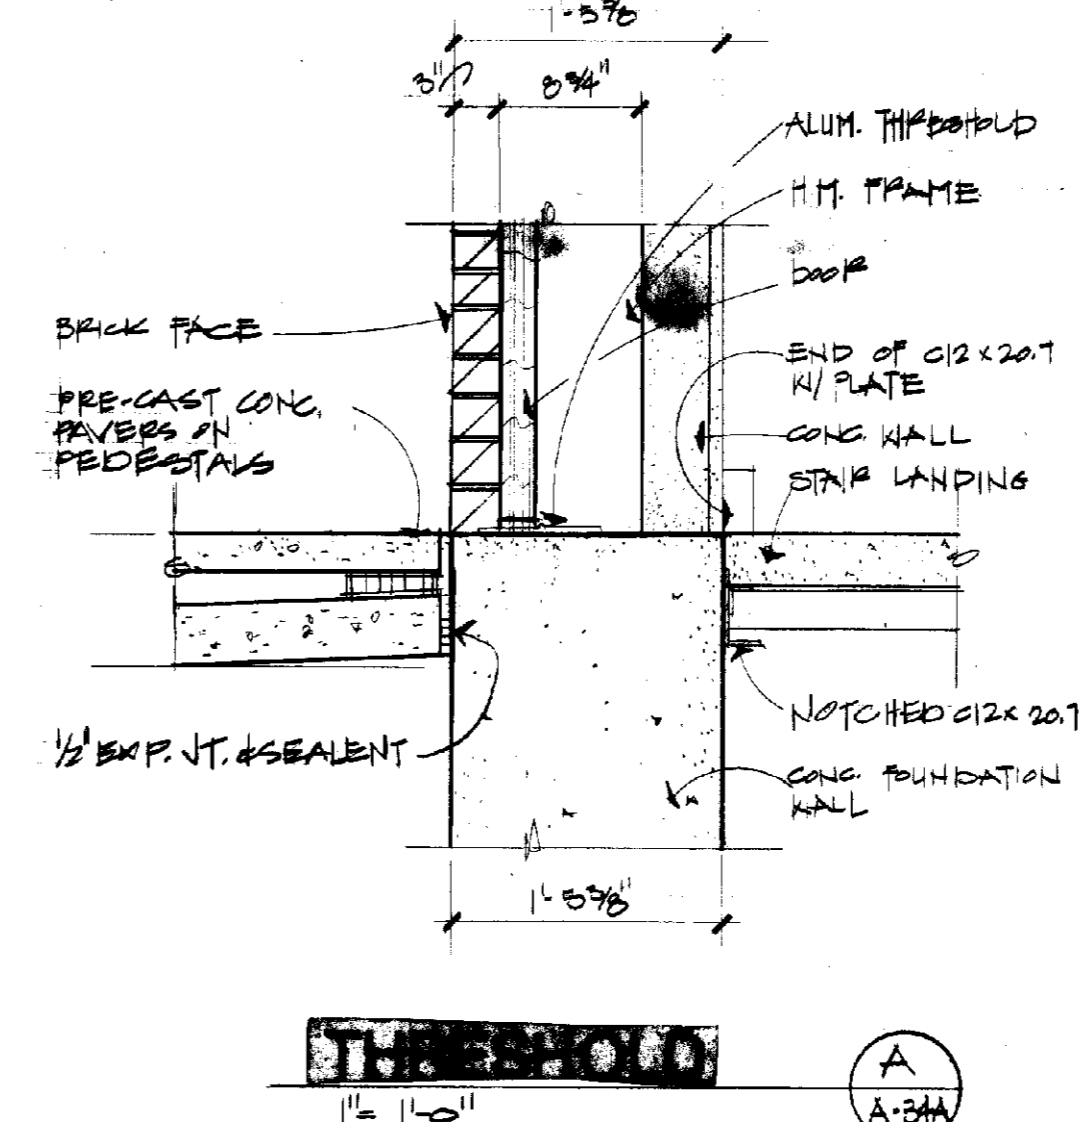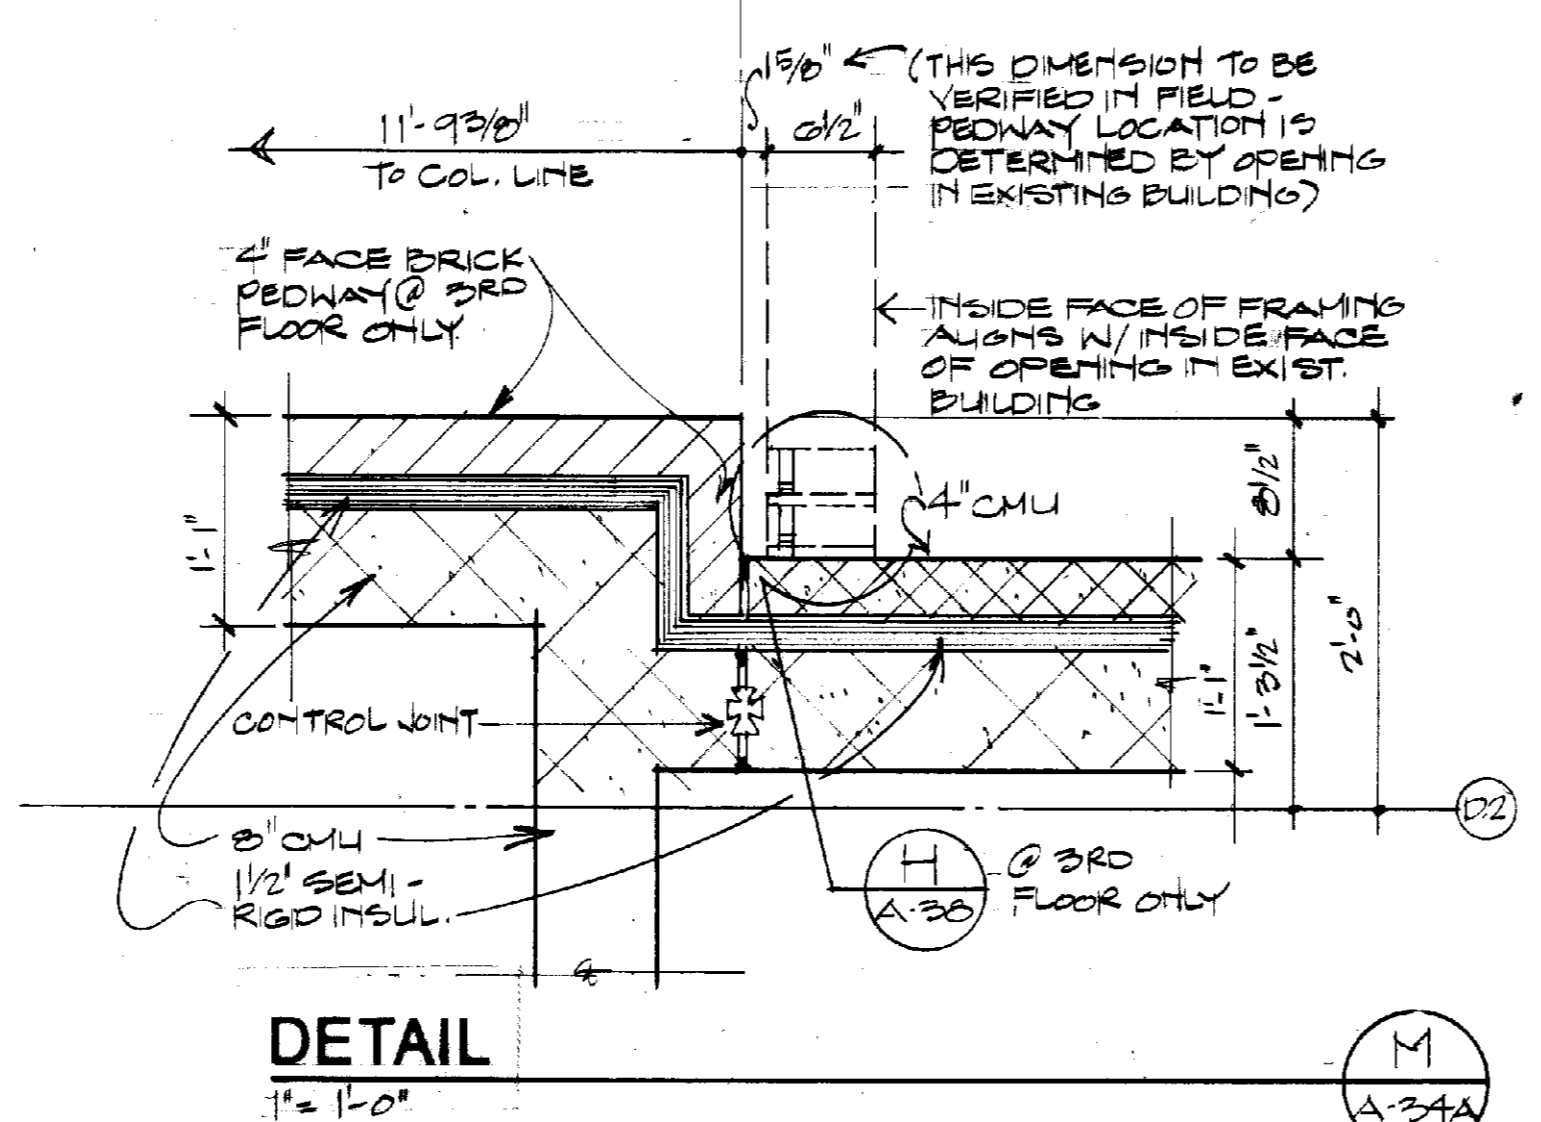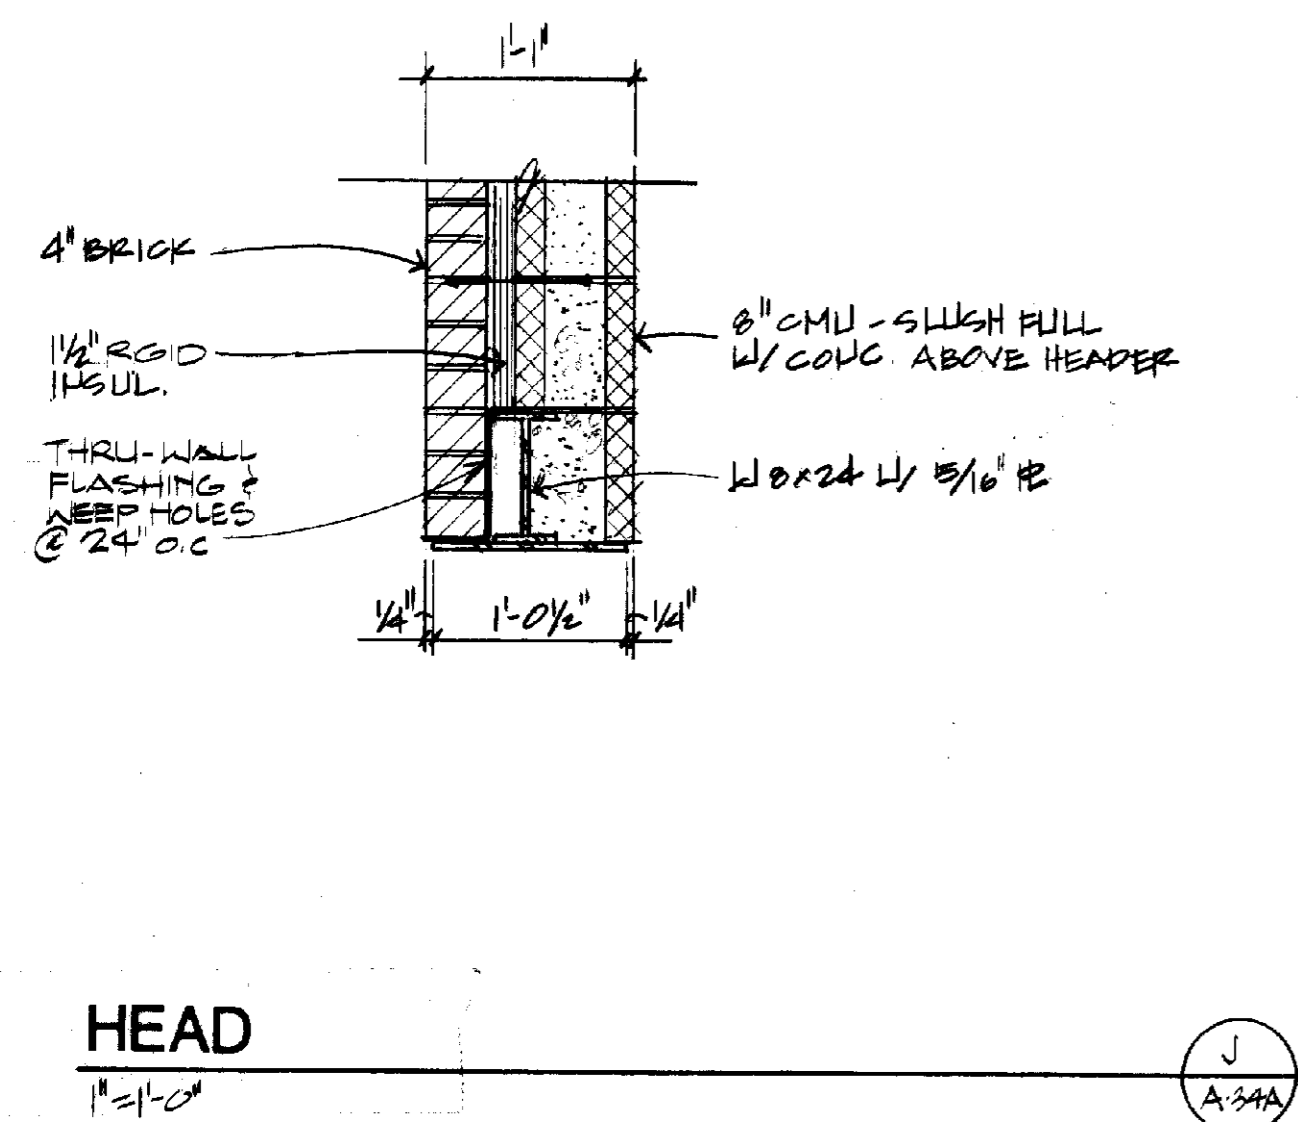

AS BUILT

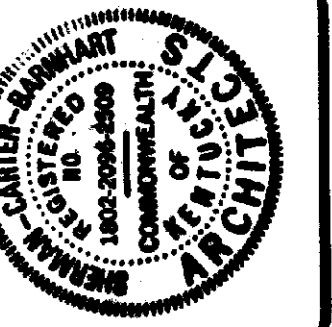

ROBOTICS FACILITY
LEXINGTON CAMPUS
UNIVERSITY OF KENTUCKY
LEXINGTON, KENTUCKY

University of Kentucky
Lexington, Kentucky
10-19-87
Carter-Barnhart
ARCHITECTS - ENGINEERS AND CONSTRUCTION MANAGERS



WINDOW ELEVATIONS & DETAILS
Stelman-Carter-Barnhart
PARTNERS IN ARCHITECTURE
LEXINGTON FINANCIAL CENTER - SUITE 900 - 250 W. MAIN - LEXINGTON, KY 40507 - 686-2415

JOB NO. 8706
DATE 10-1-87
DRAWN DWH
CHECKED CEB
FILE NO. 431.0


NO.	REVISIONS

SHEET


A-35

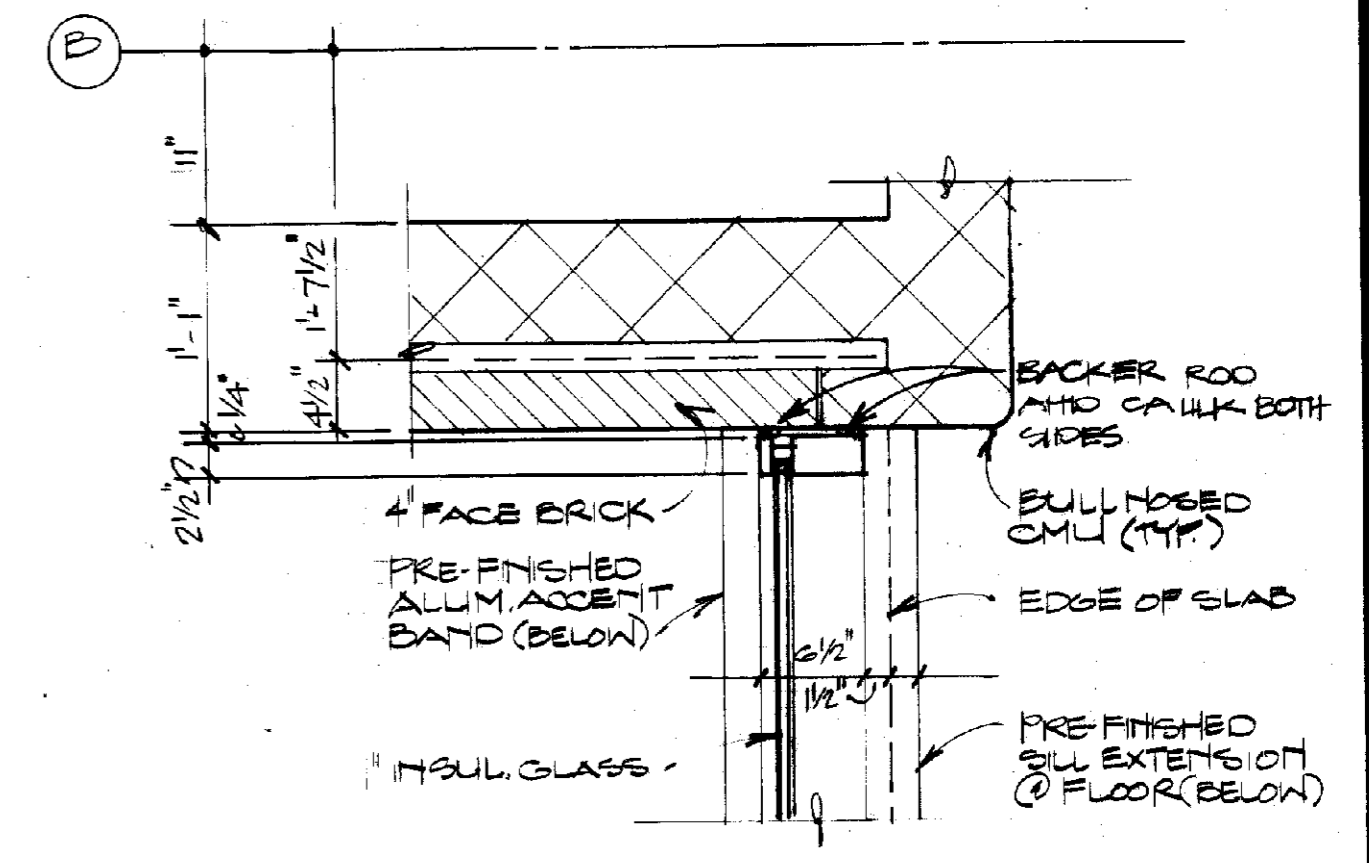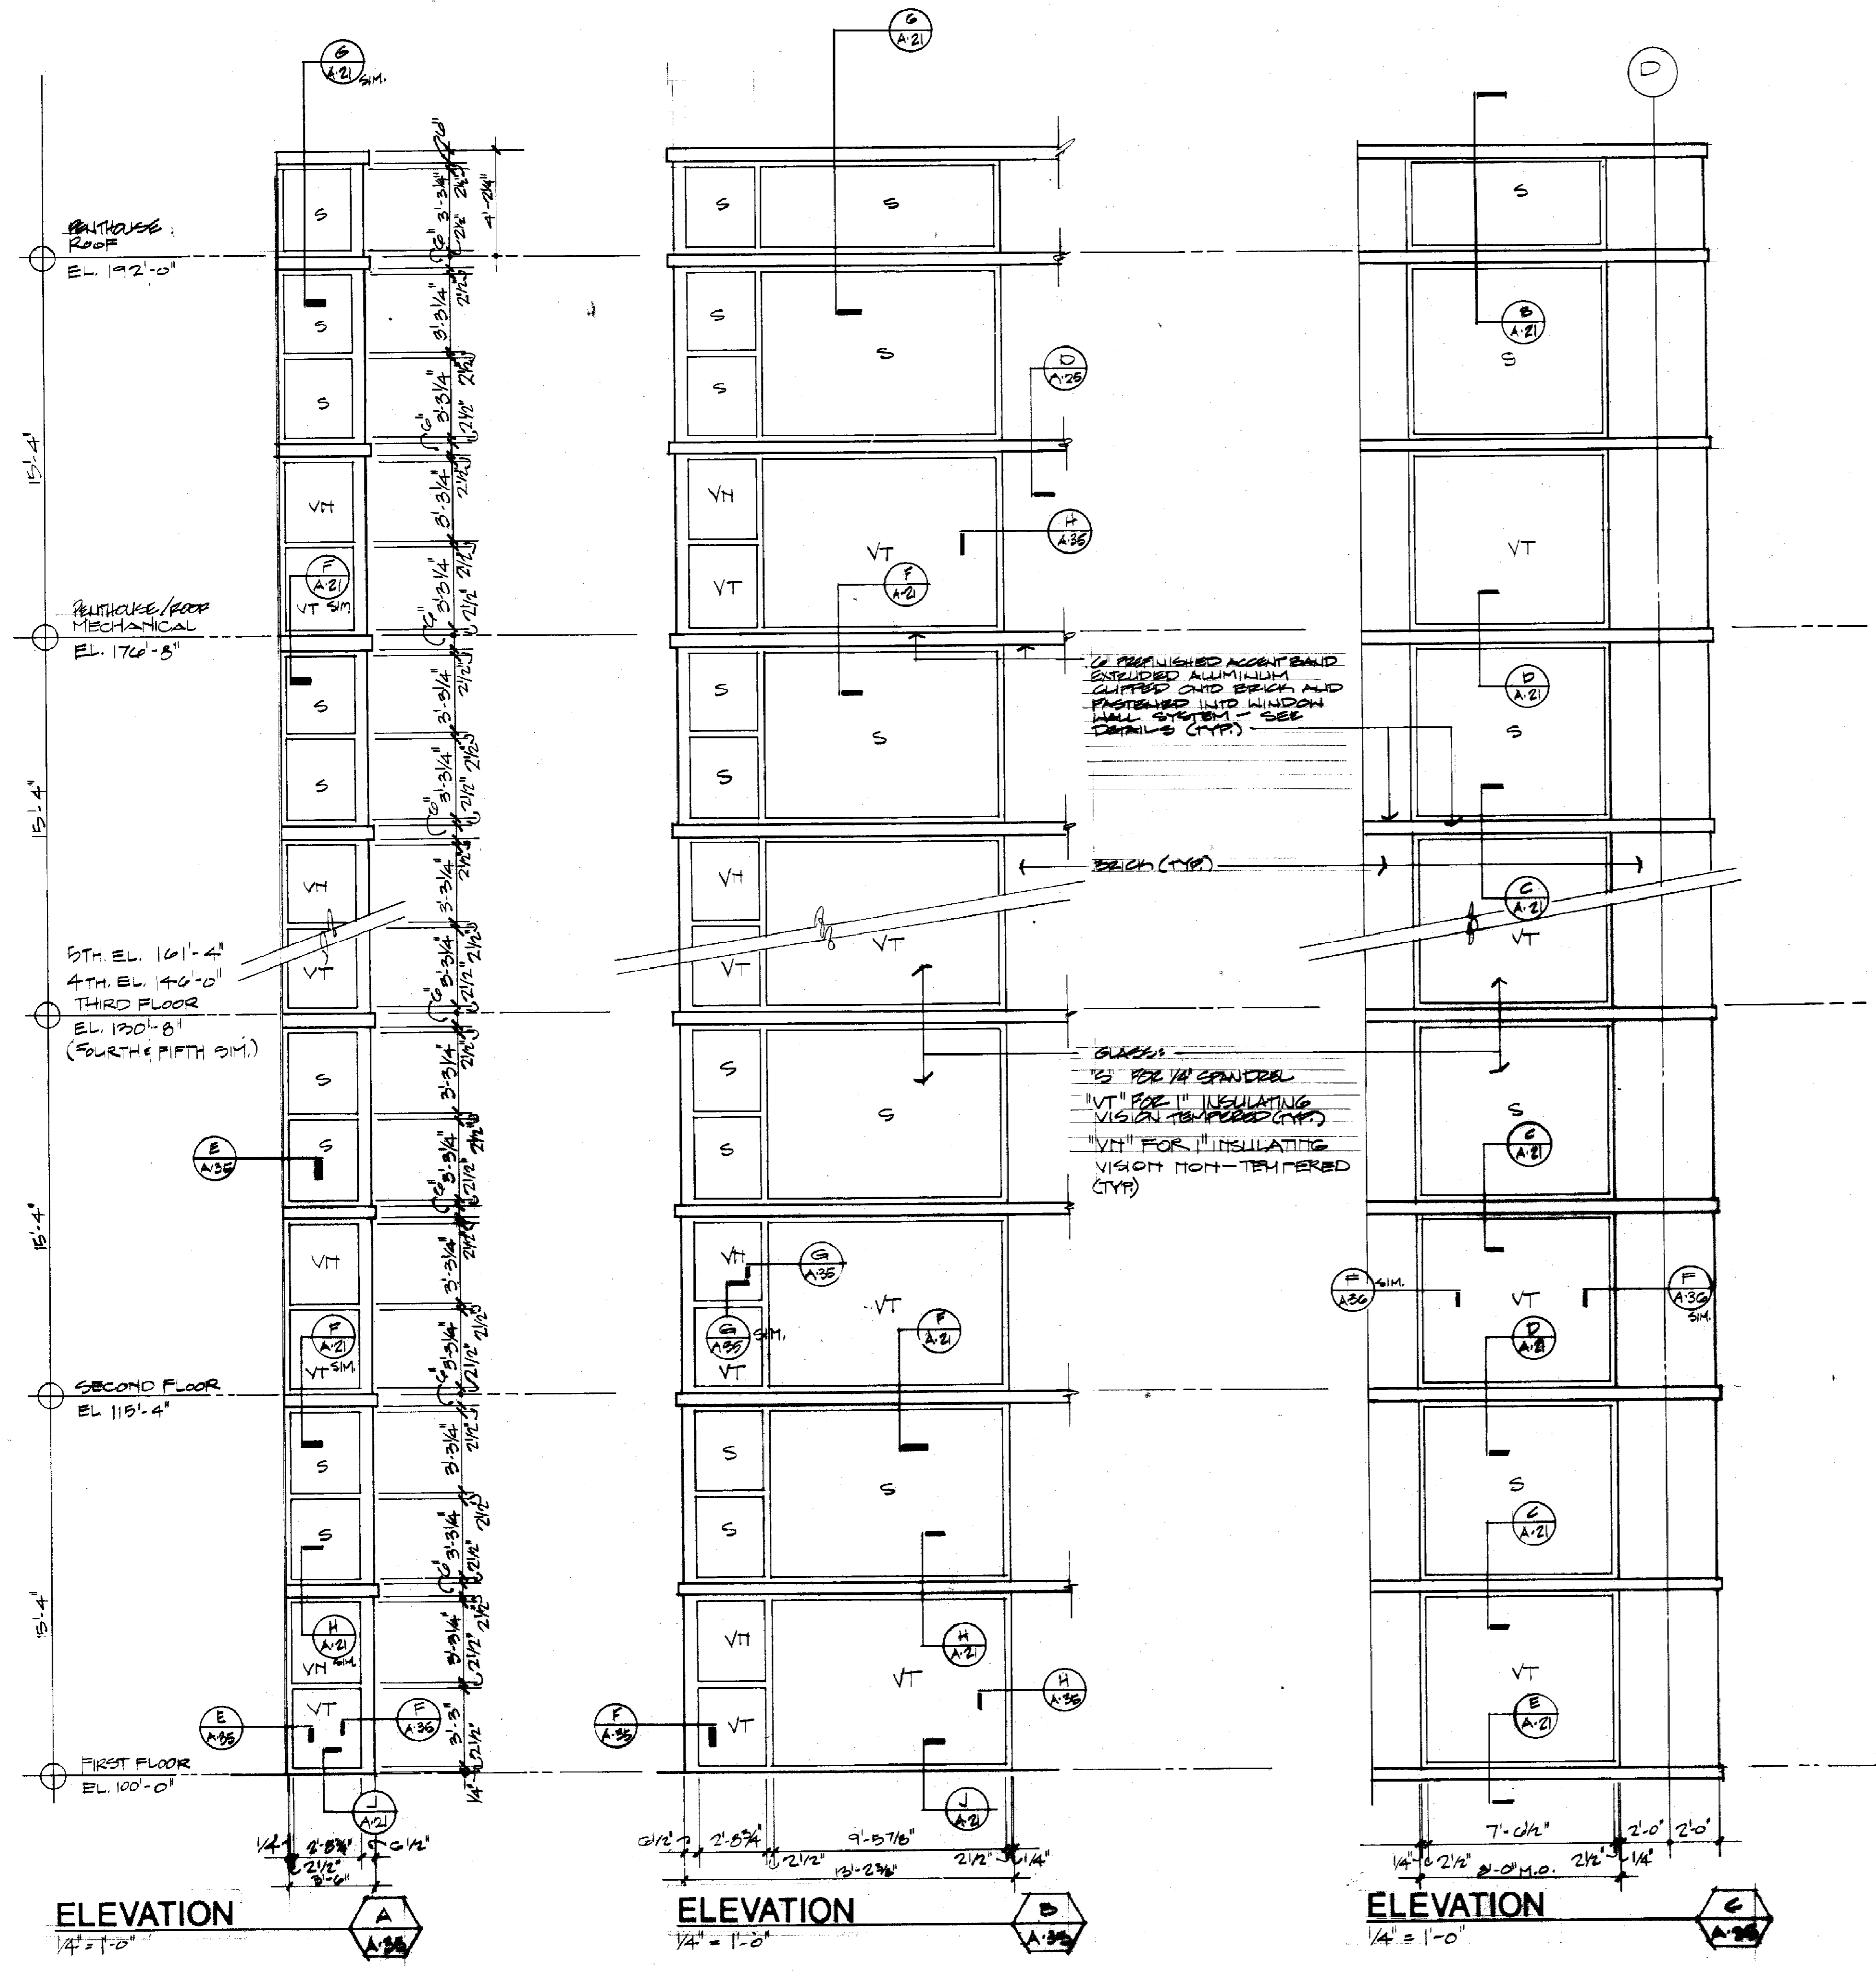


JAMB
1\"/>

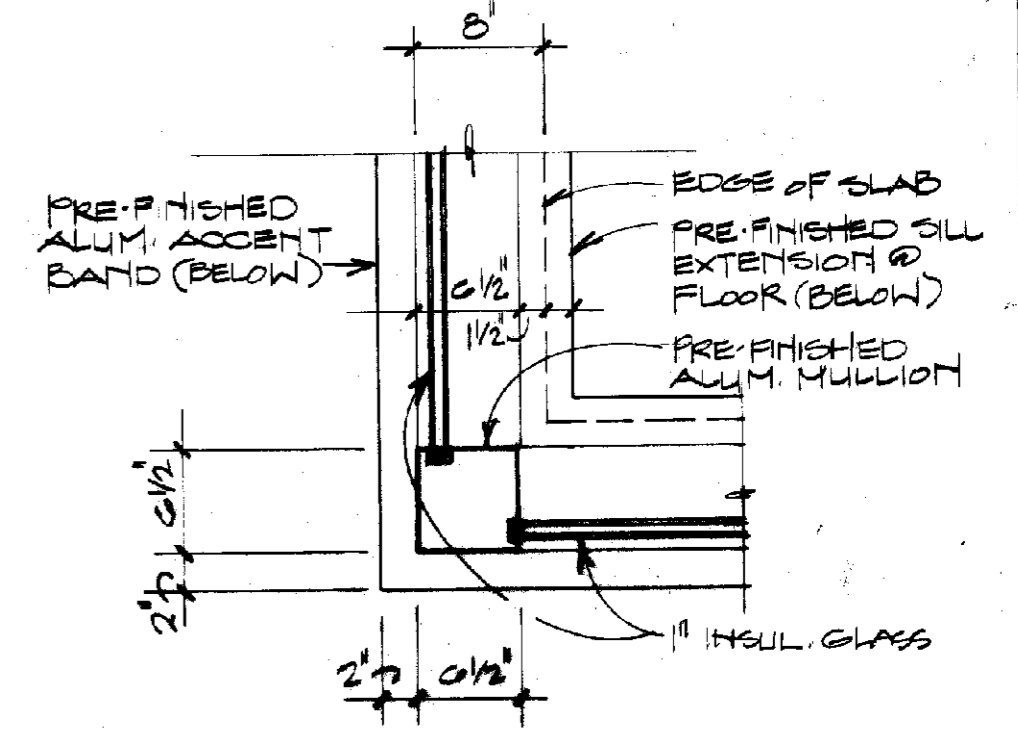

MULLION
1\"/>

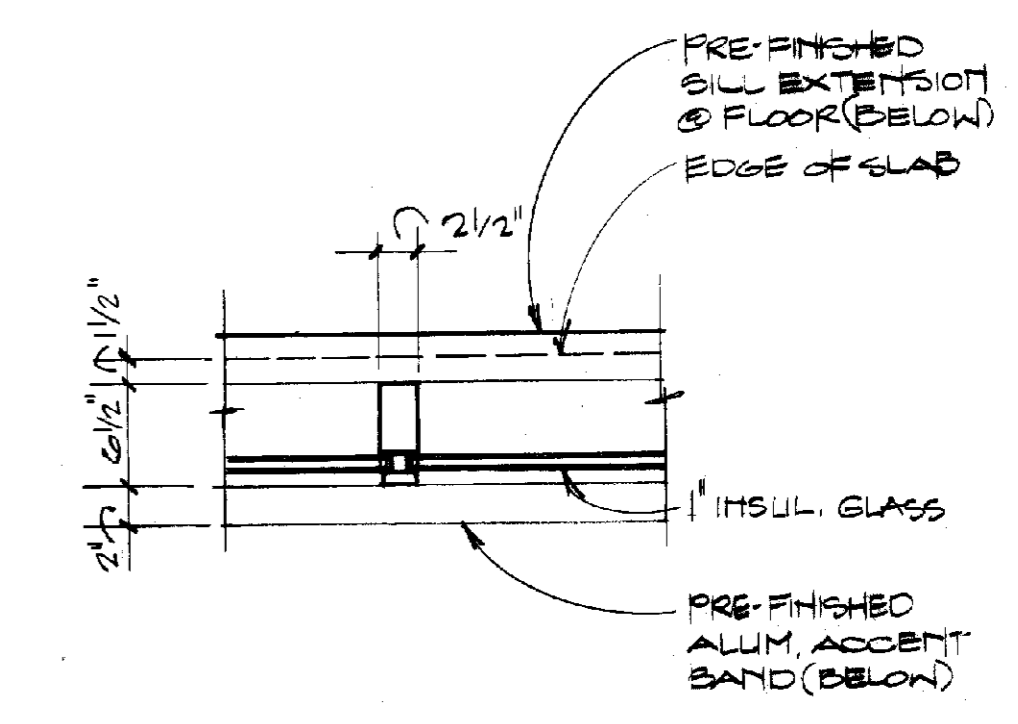

MULLION
1\"/>

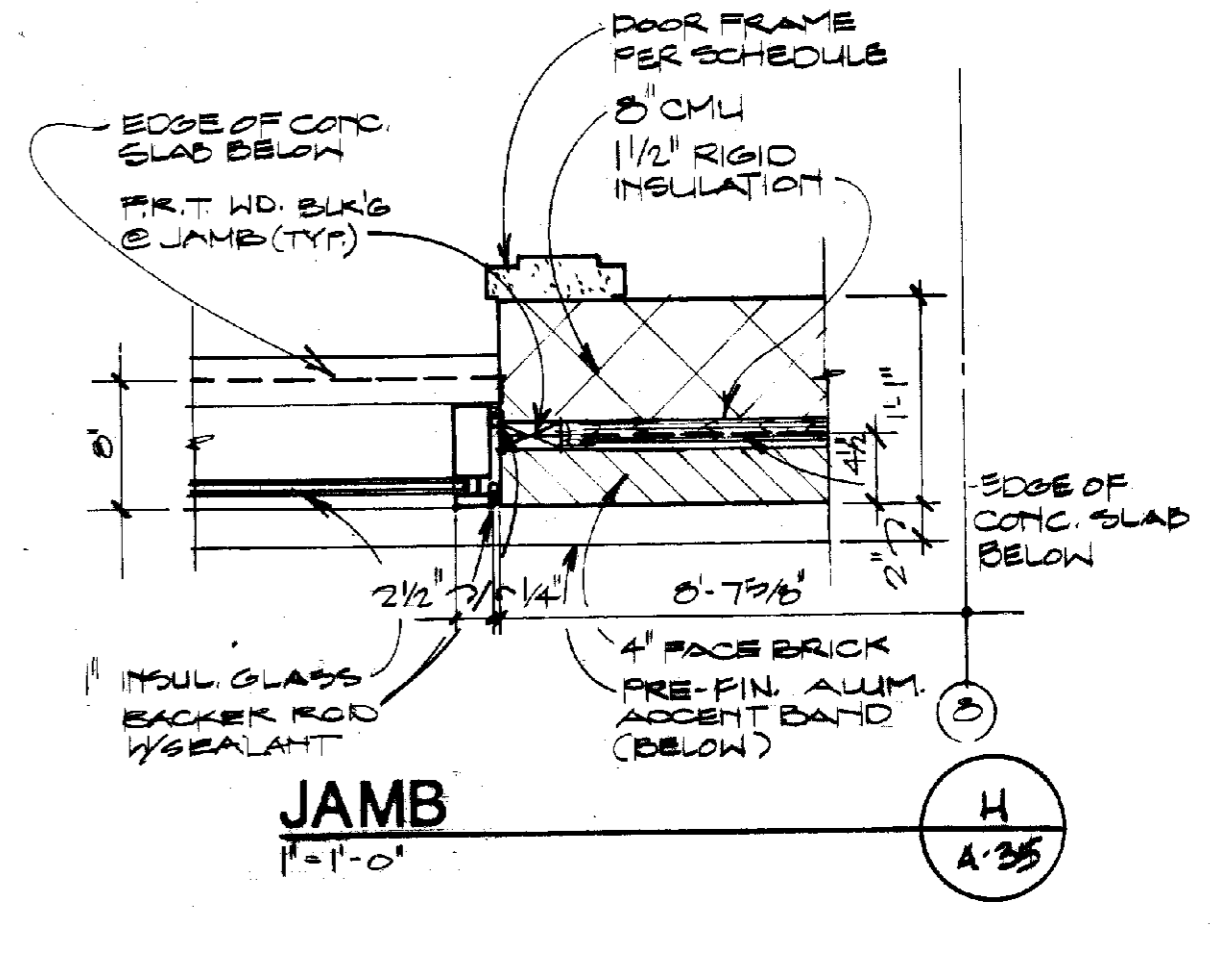

JAMB
1\"/>



ROBOTICS FACILITY
 LEXINGTON CAMPUS
 UNIVERSITY OF KENTUCKY
 LEXINGTON, KENTUCKY

University of Kentucky
 Lexington, Kentucky


WINDOW ELEVATIONS & DETAILS
Sherman Carter Barnhart
 PARTNERS IN ARCHITECTURE
 LEXINGTON FINANCIAL CENTER, SUITE 1900, 750 W. MAIN, LEXINGTON, KY 40507-6865-6455

JOB NO. 8708
 DATE 10-1-89
 DRAWN DWH
 CHECKED CER
 FILE NO. 431.0


REVISIONS
 1 AS BUILT 2/19/91

SHEET


A-36

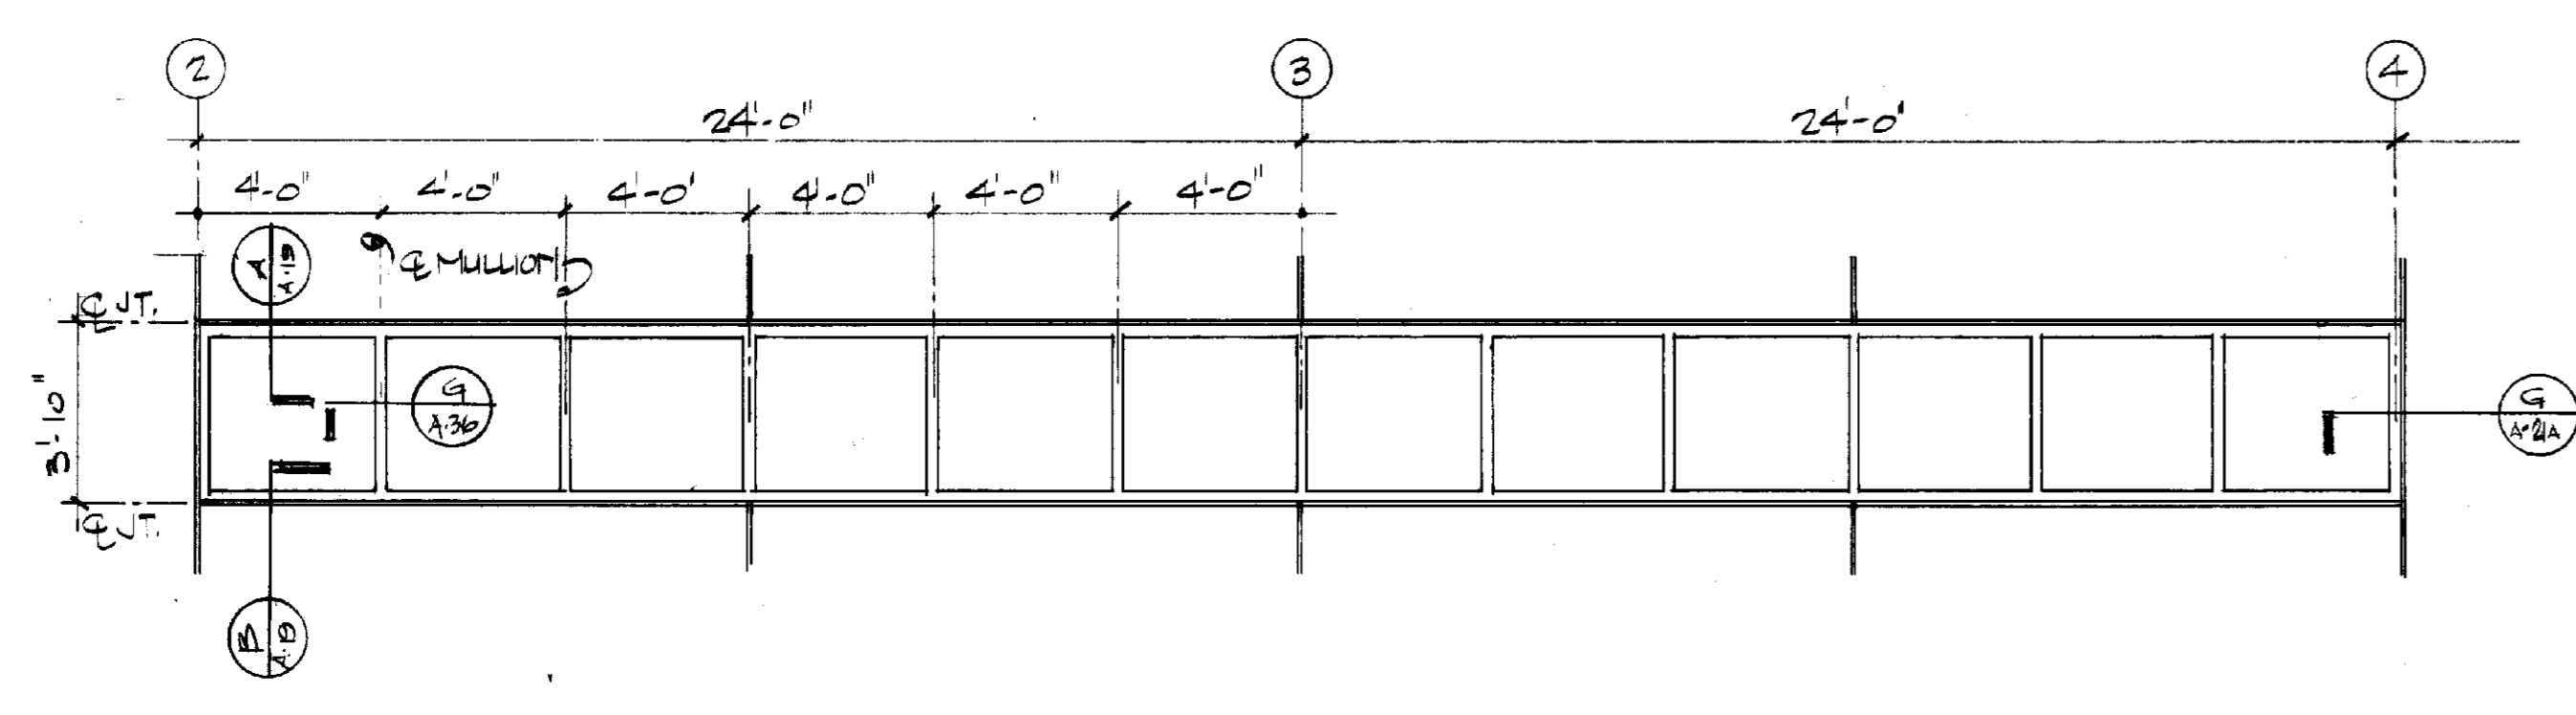

ELEVATION
 1/4" = 1'-0"

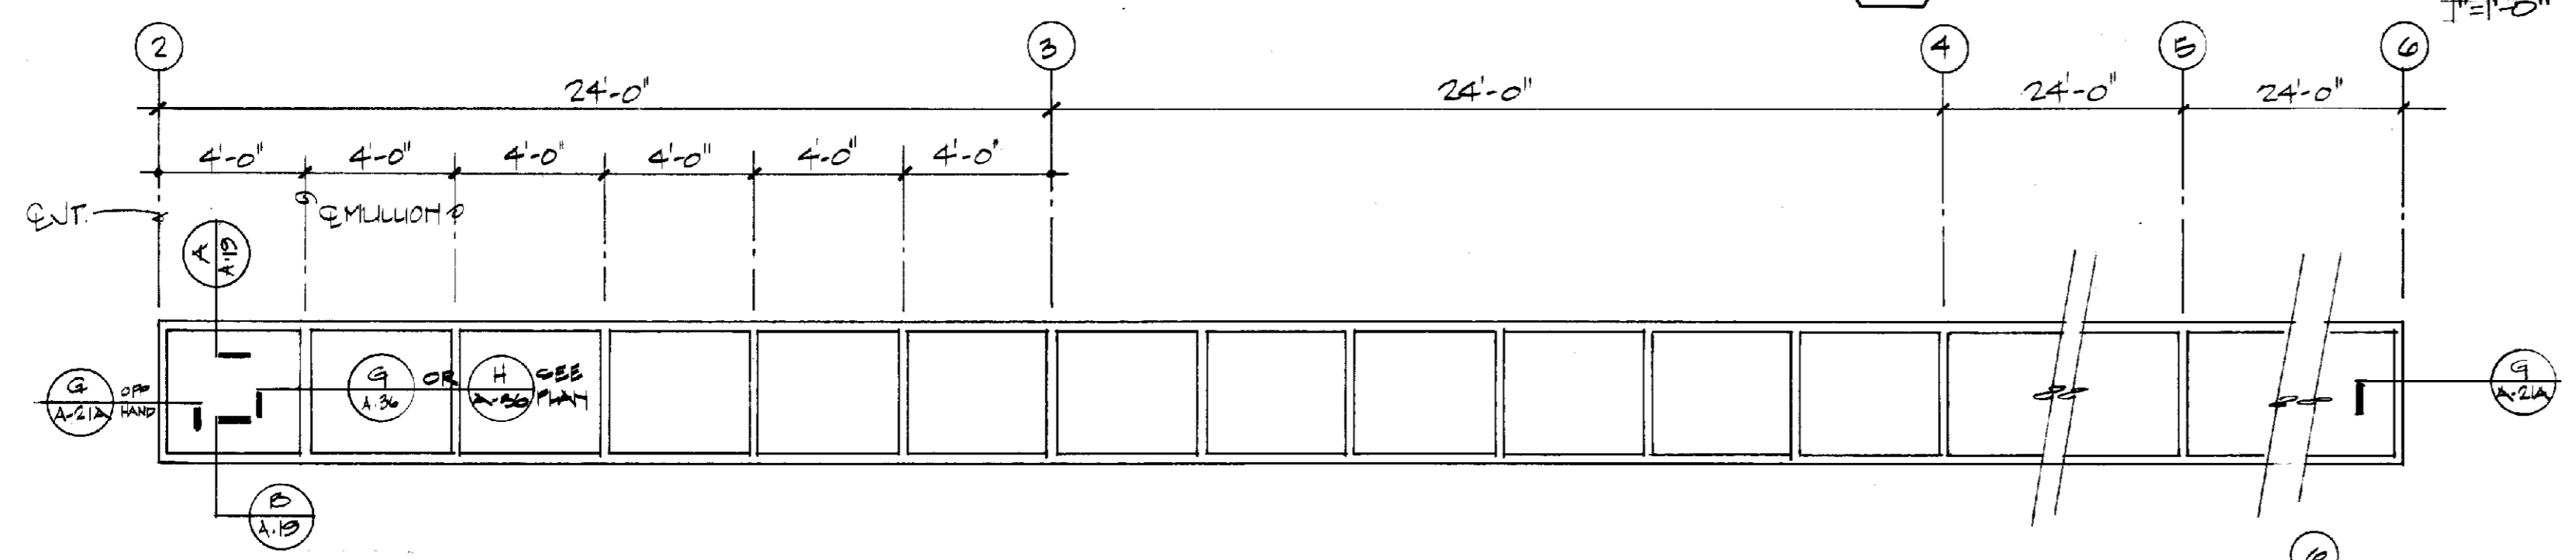


ELEVATION
 1/4" = 1'-0"

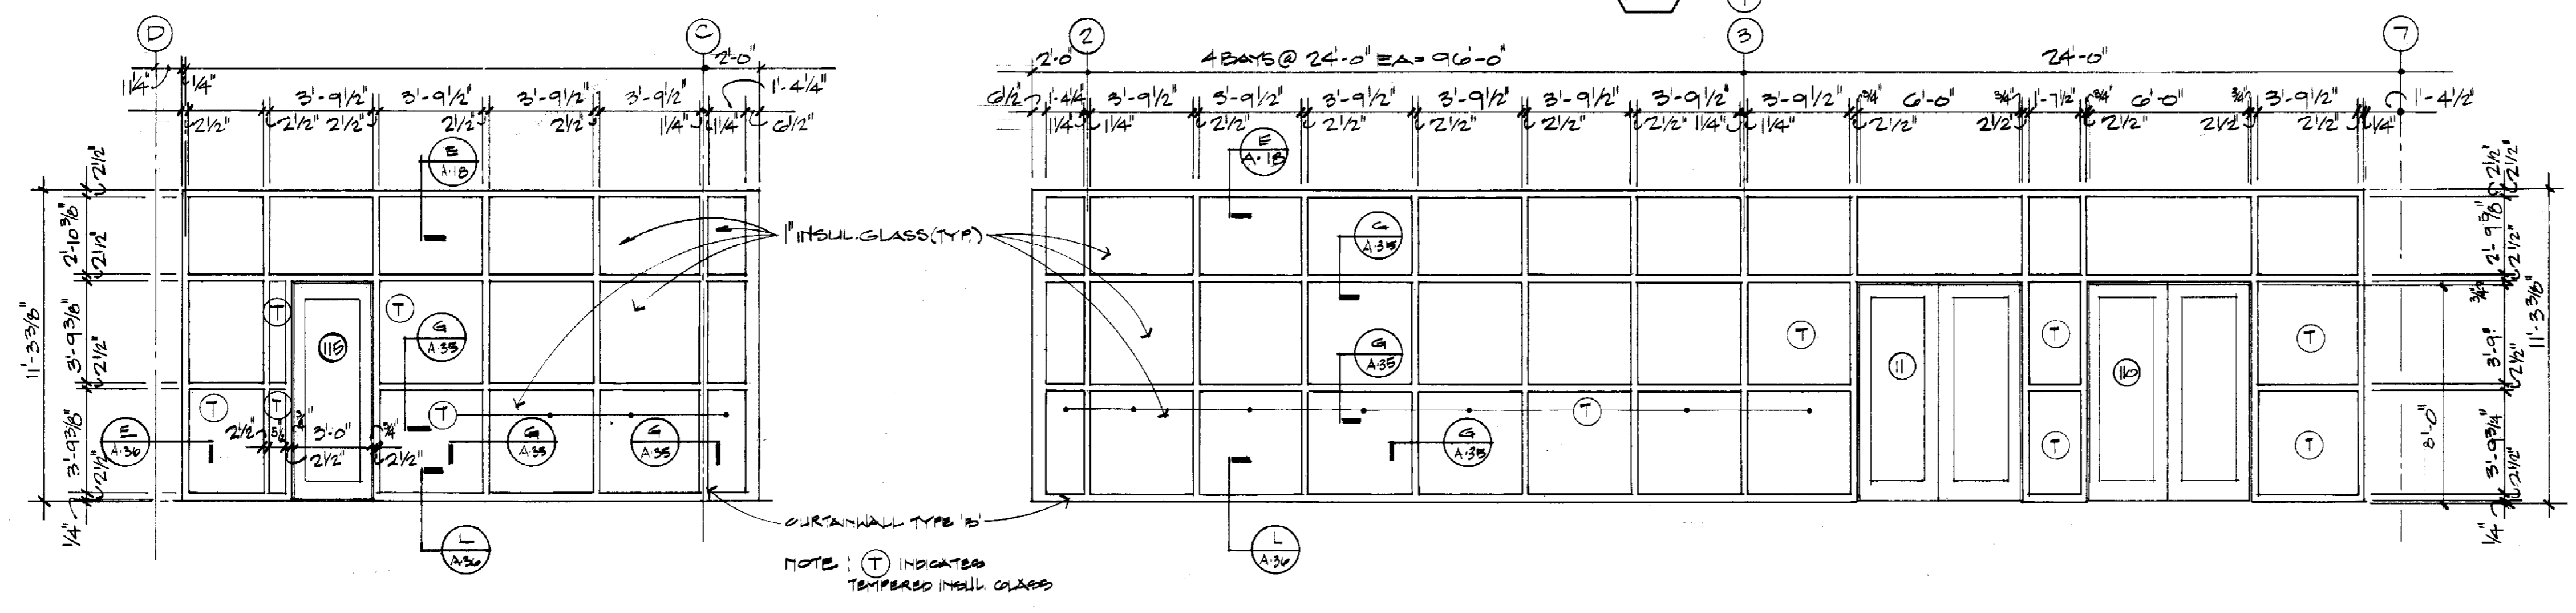


ELEVATION
 1/4" = 1'-0"


ELEVATION
 1/4" = 1'-0"

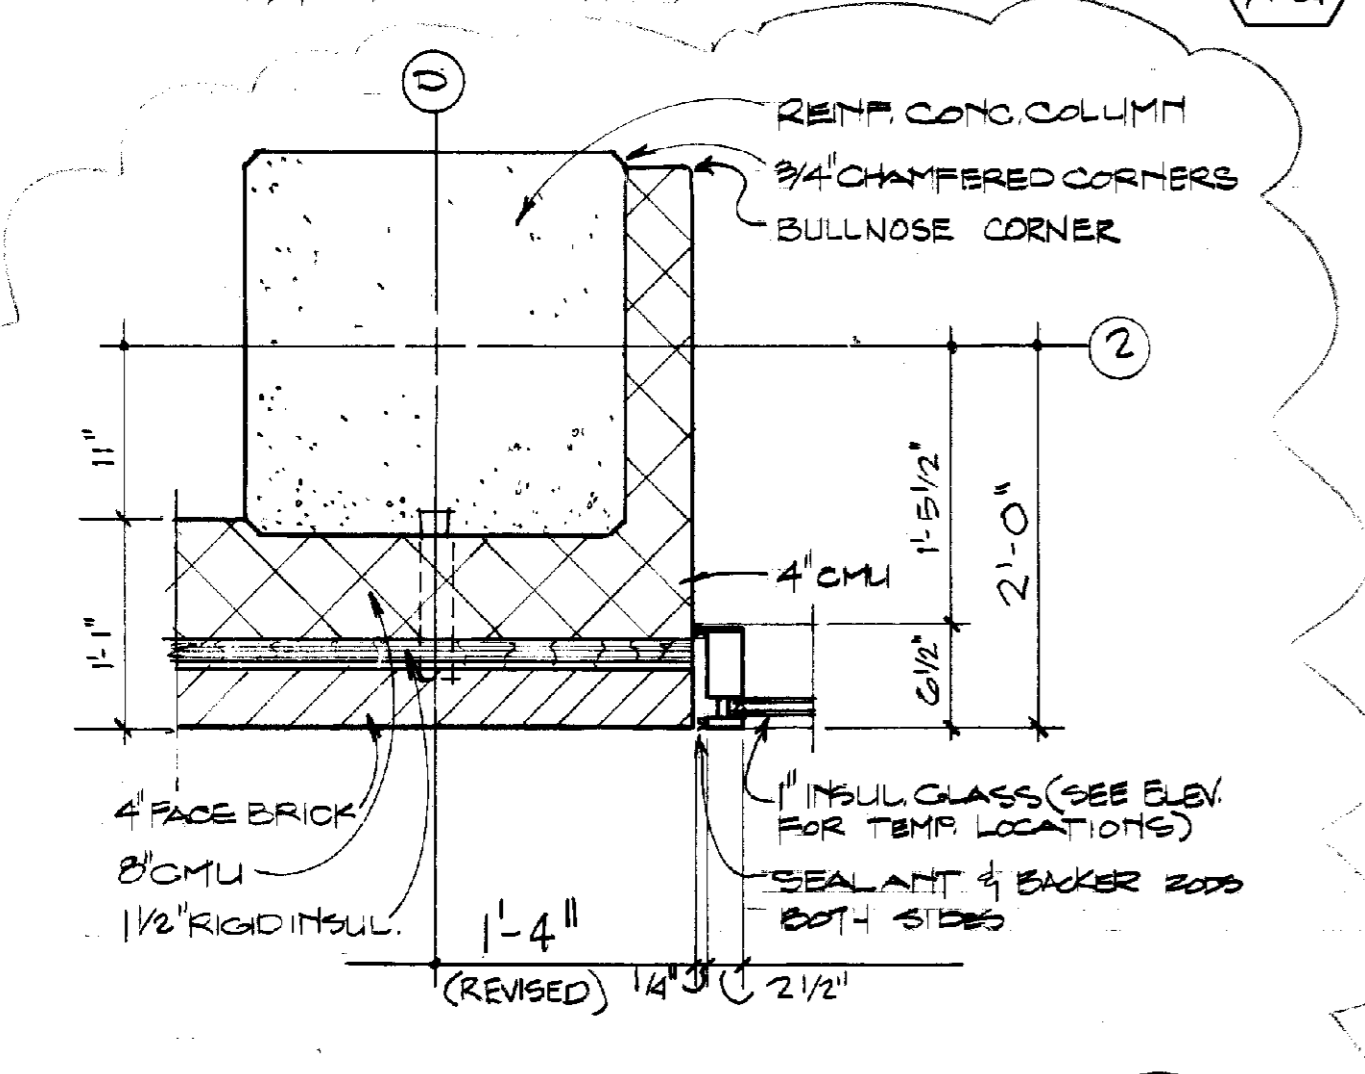


JAMB
 1" = 1'-0"

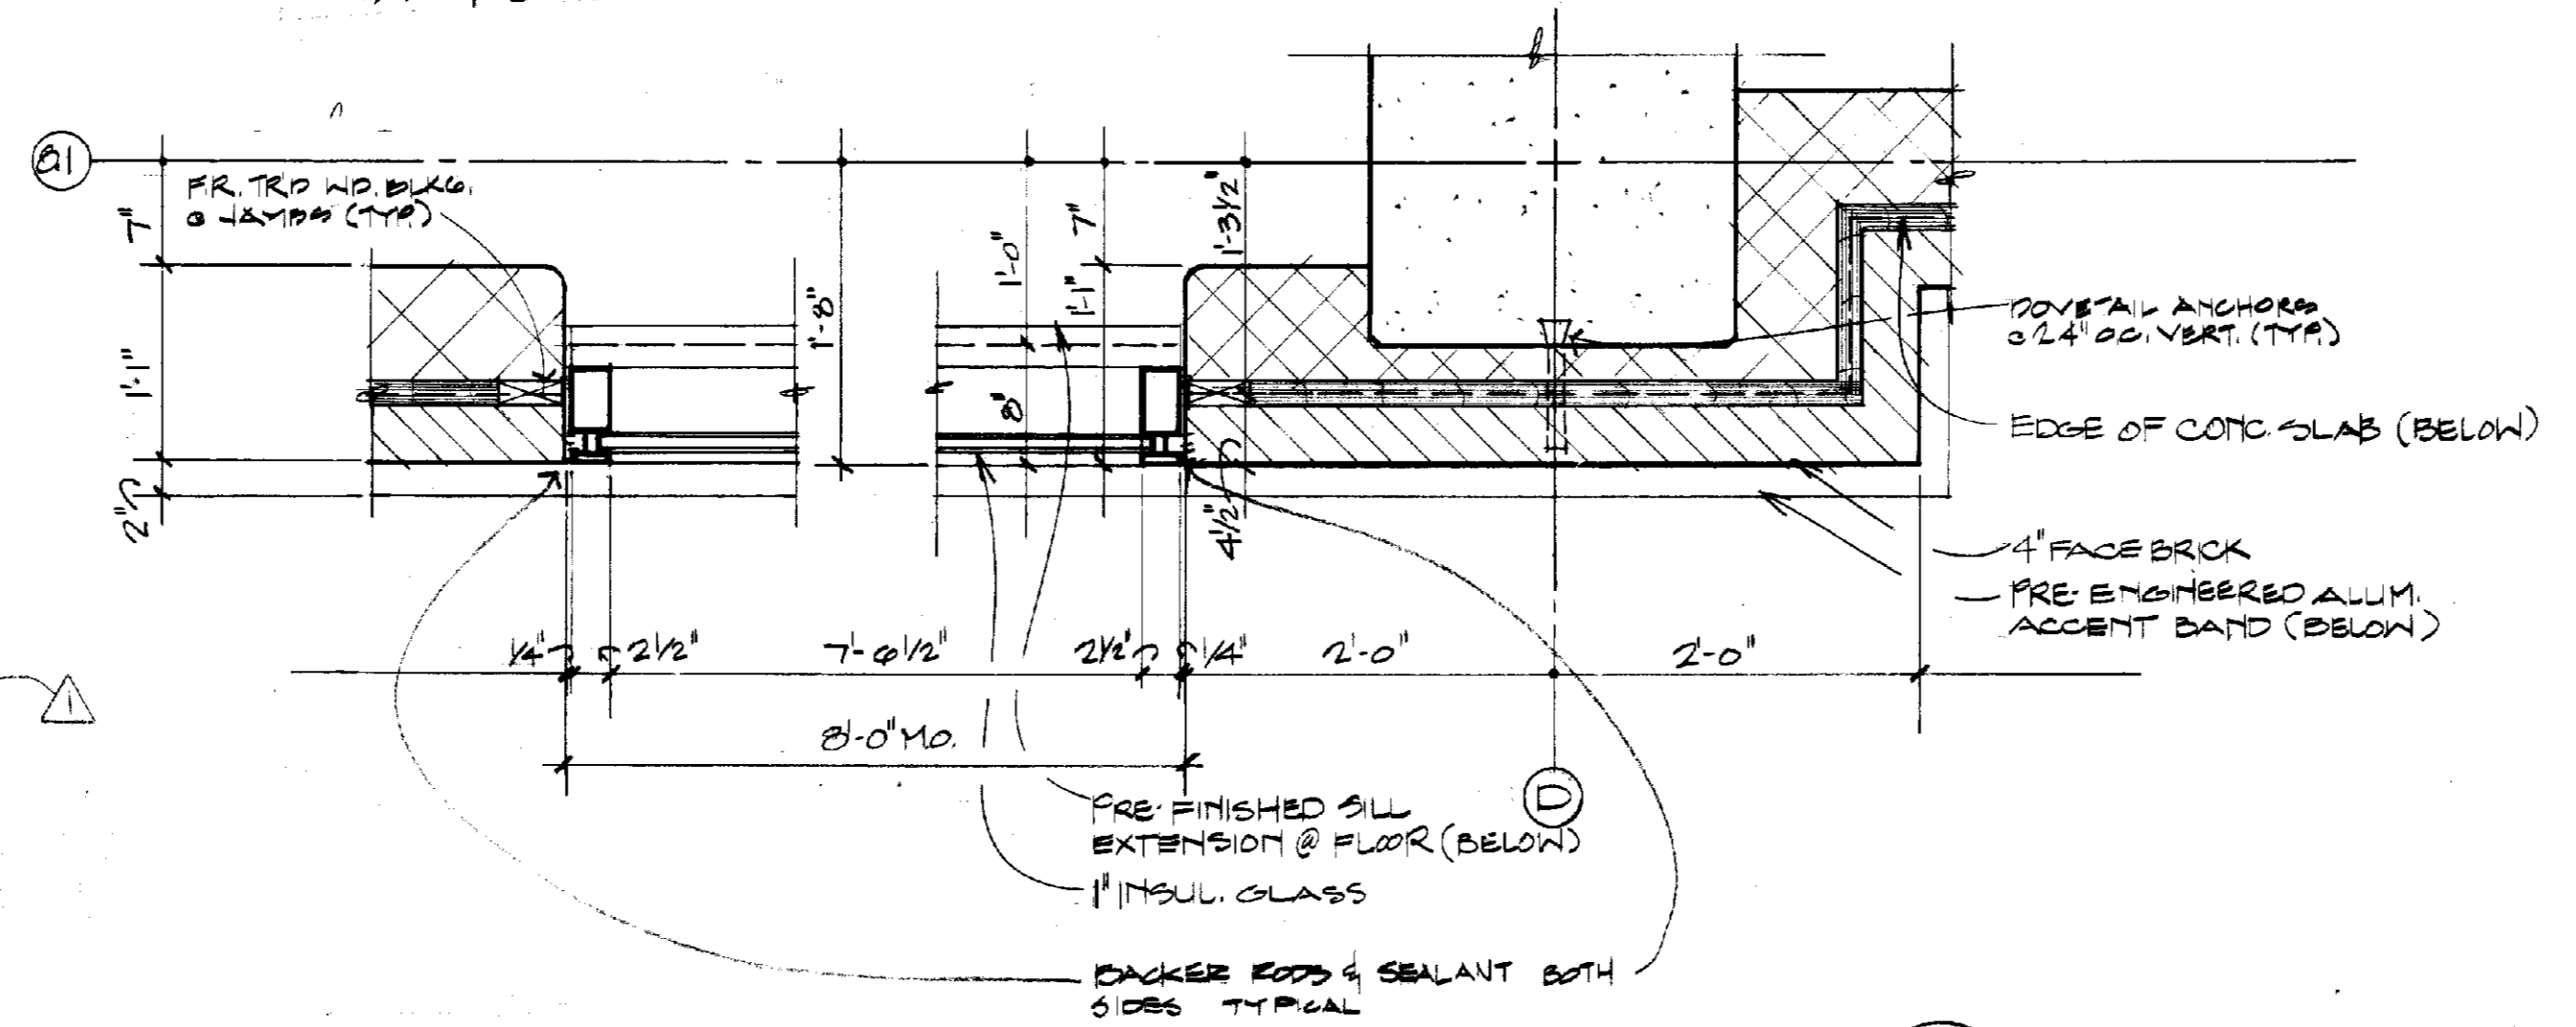


JAMB
 1" = 1'-0"

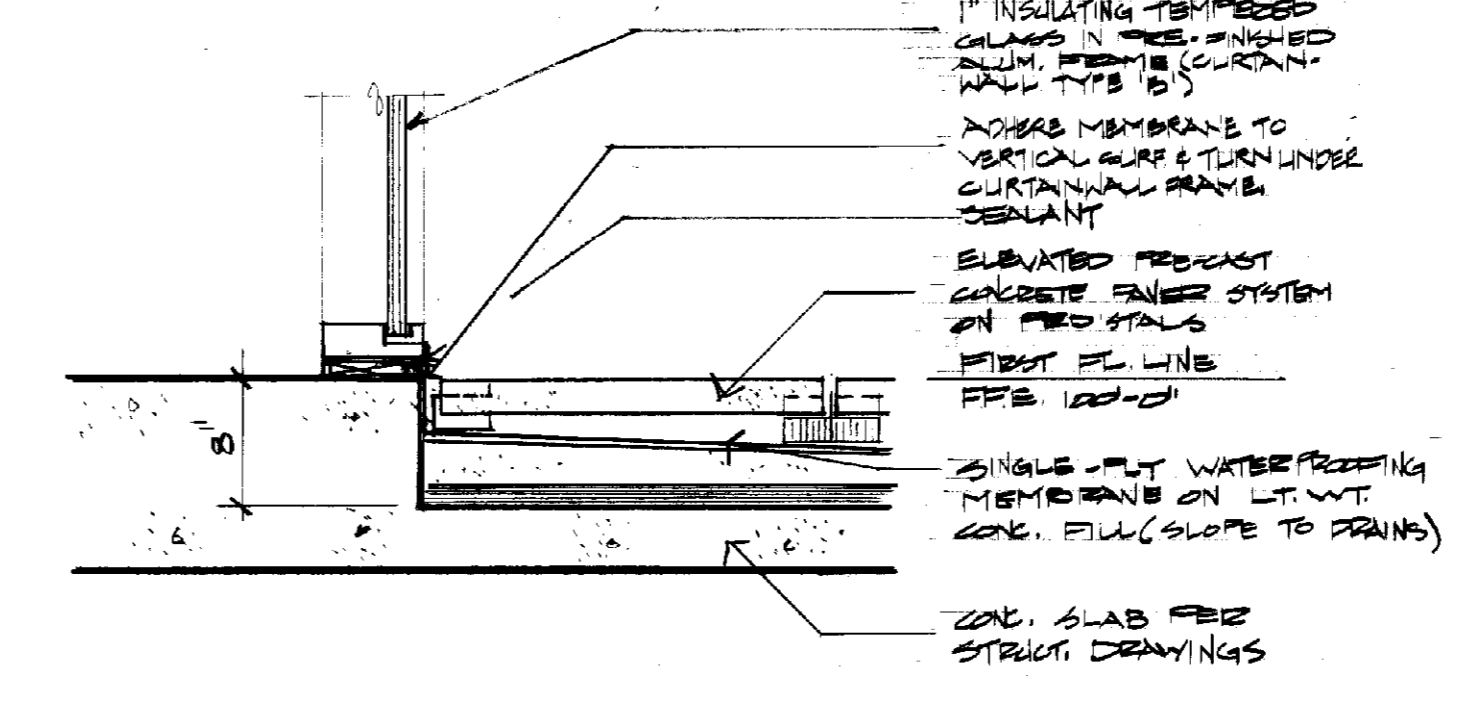


DETAIL
 1" = 1'-0"

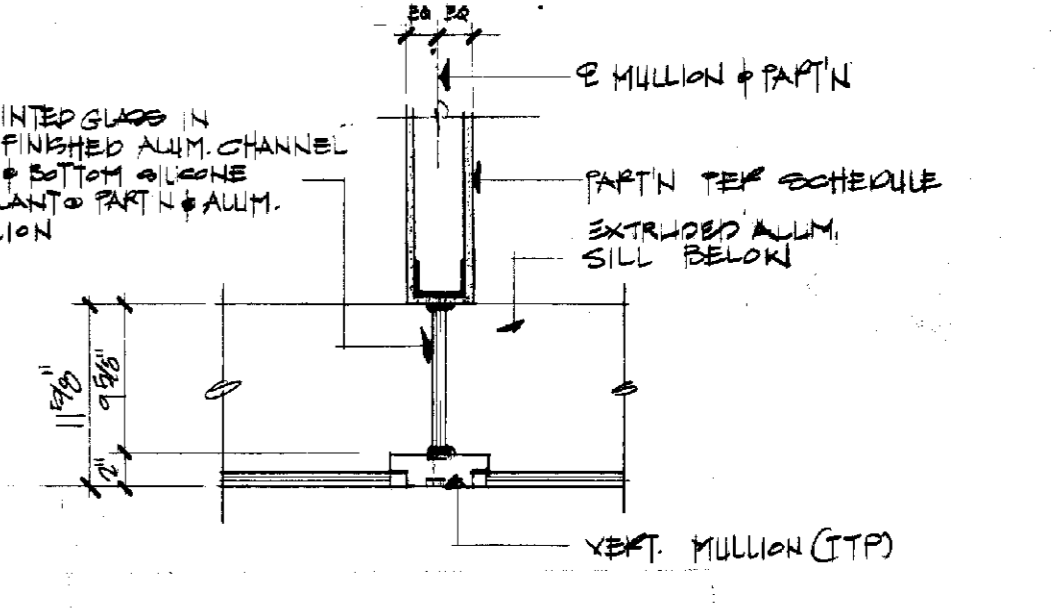


MULLION DETAIL
 1" = 1'-0"

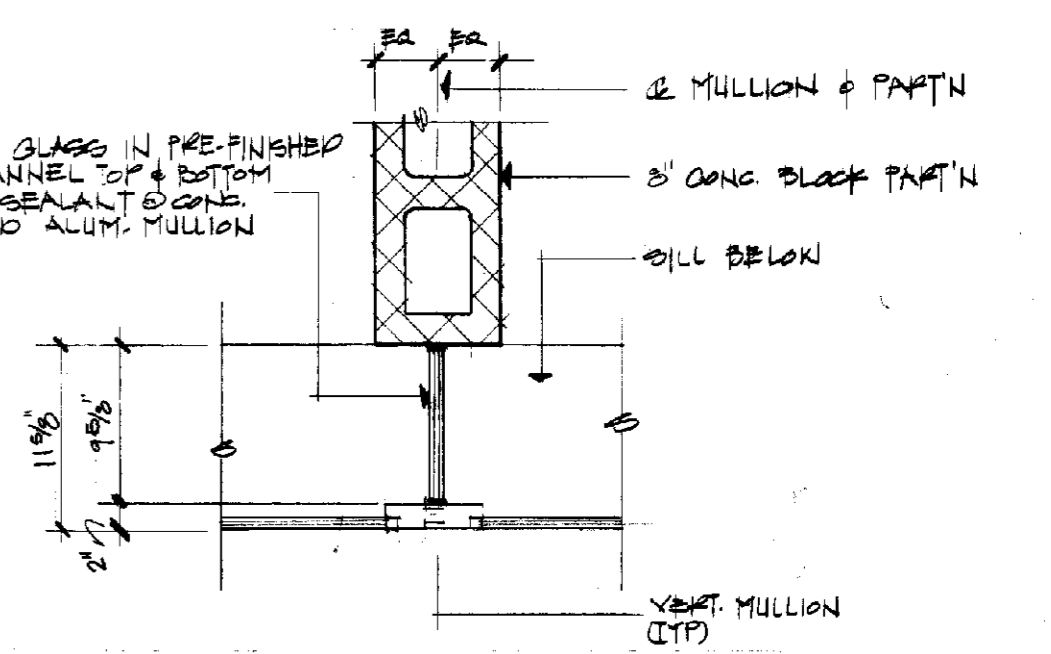

MULLION DETAIL
 1" = 1'-0"

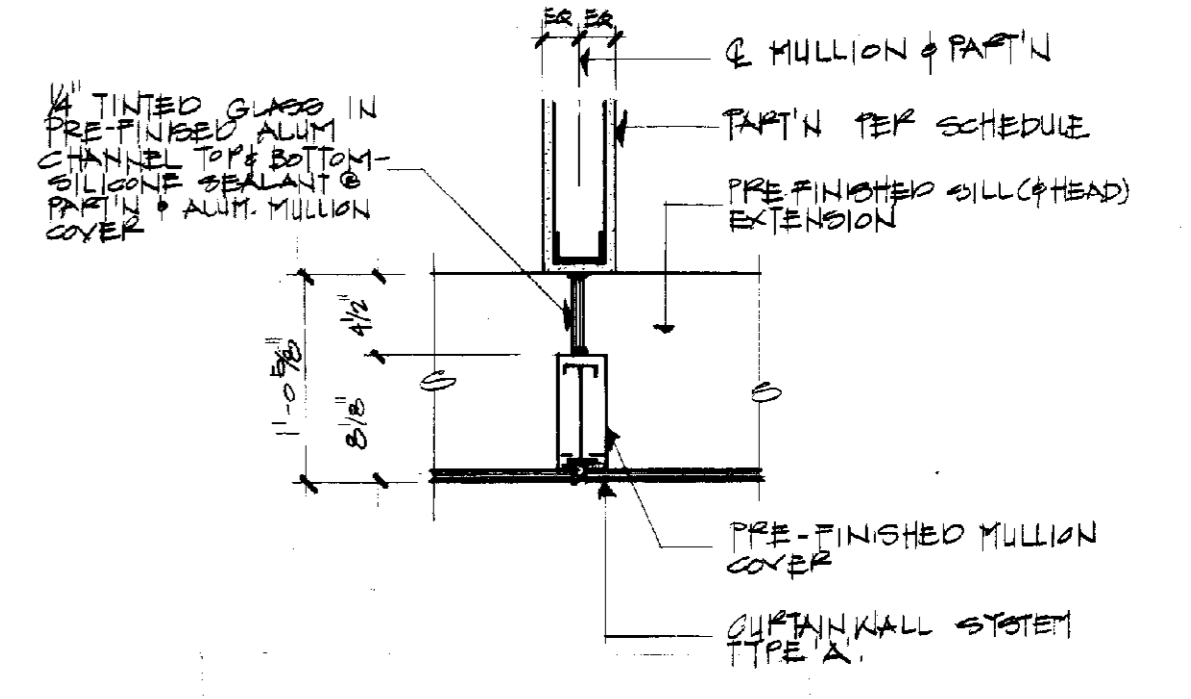


MULLION DETAIL
 1" = 1'-0"

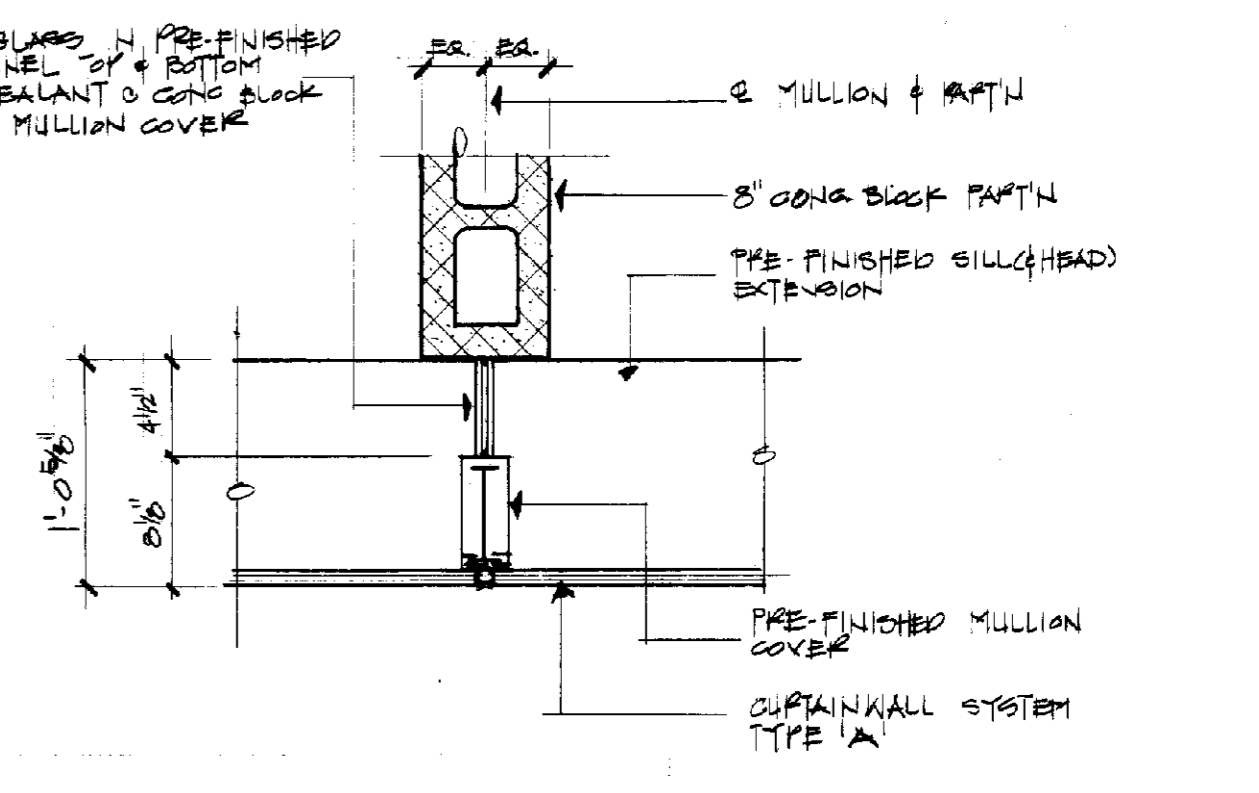


MULLION DETAIL
 1" = 1'-0"

5/20/00


82

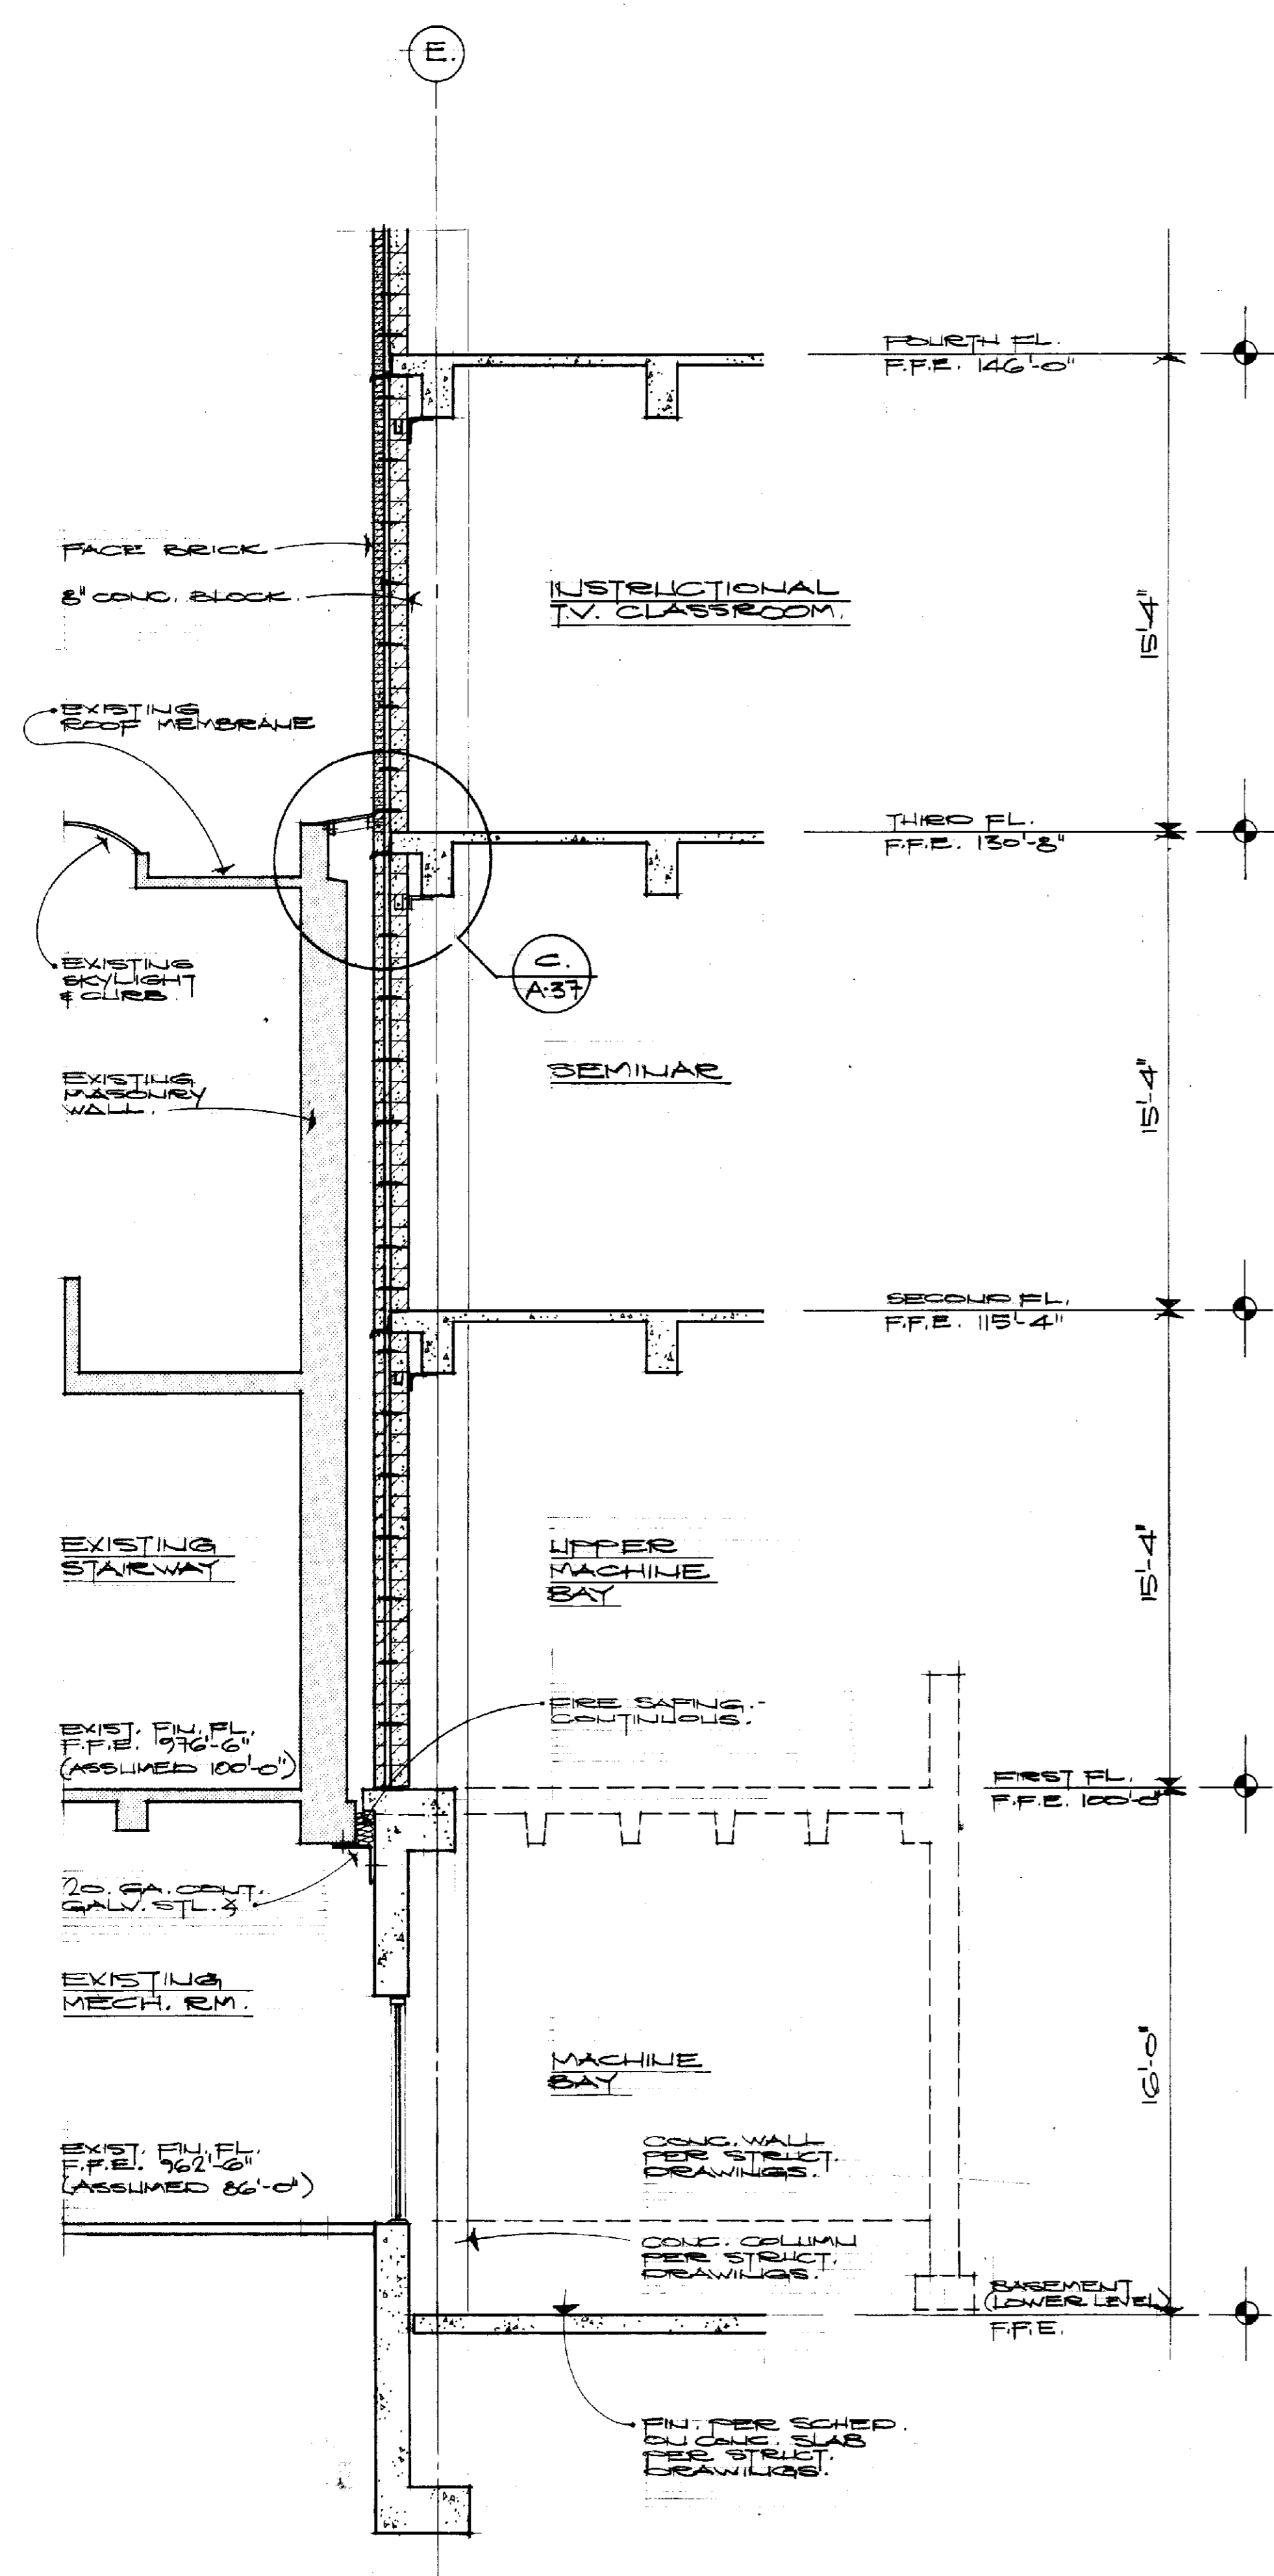


SECTION A-A
SCALE: 1/4" = 1'-0"
A.37

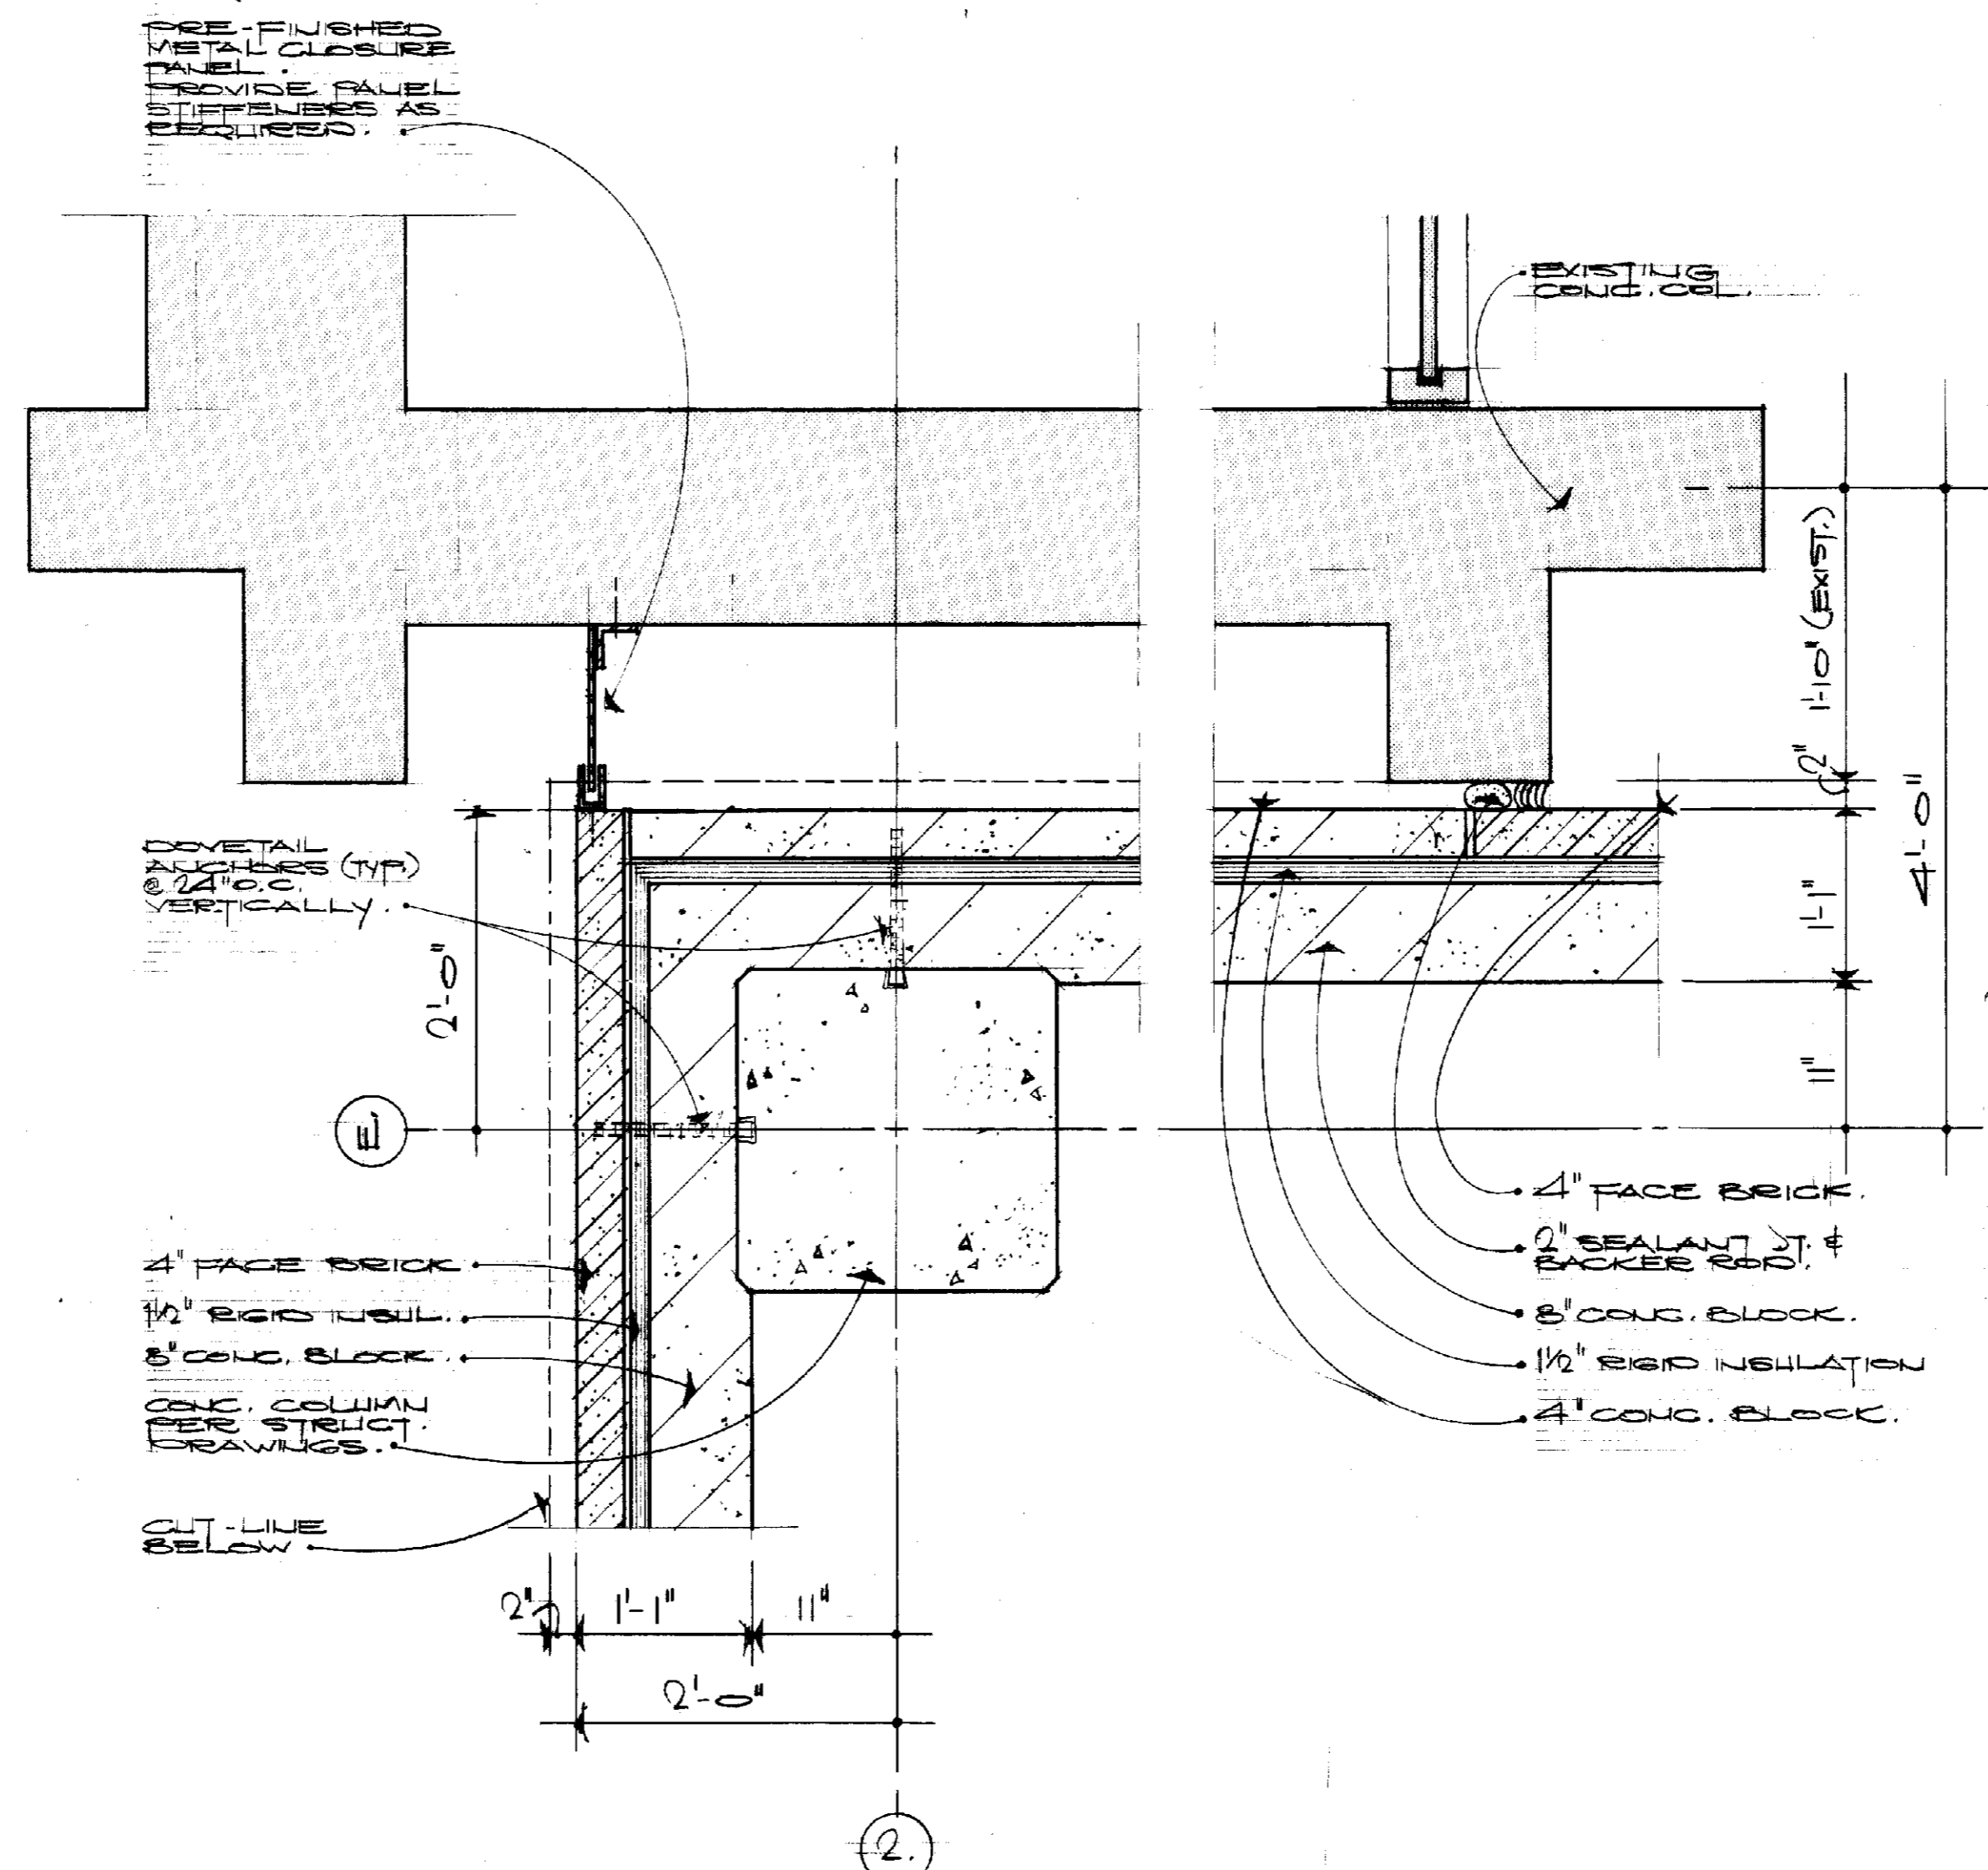


EXPANSION JOINT DETAIL
SCALE: 1" = 1'-0"
B. A.37

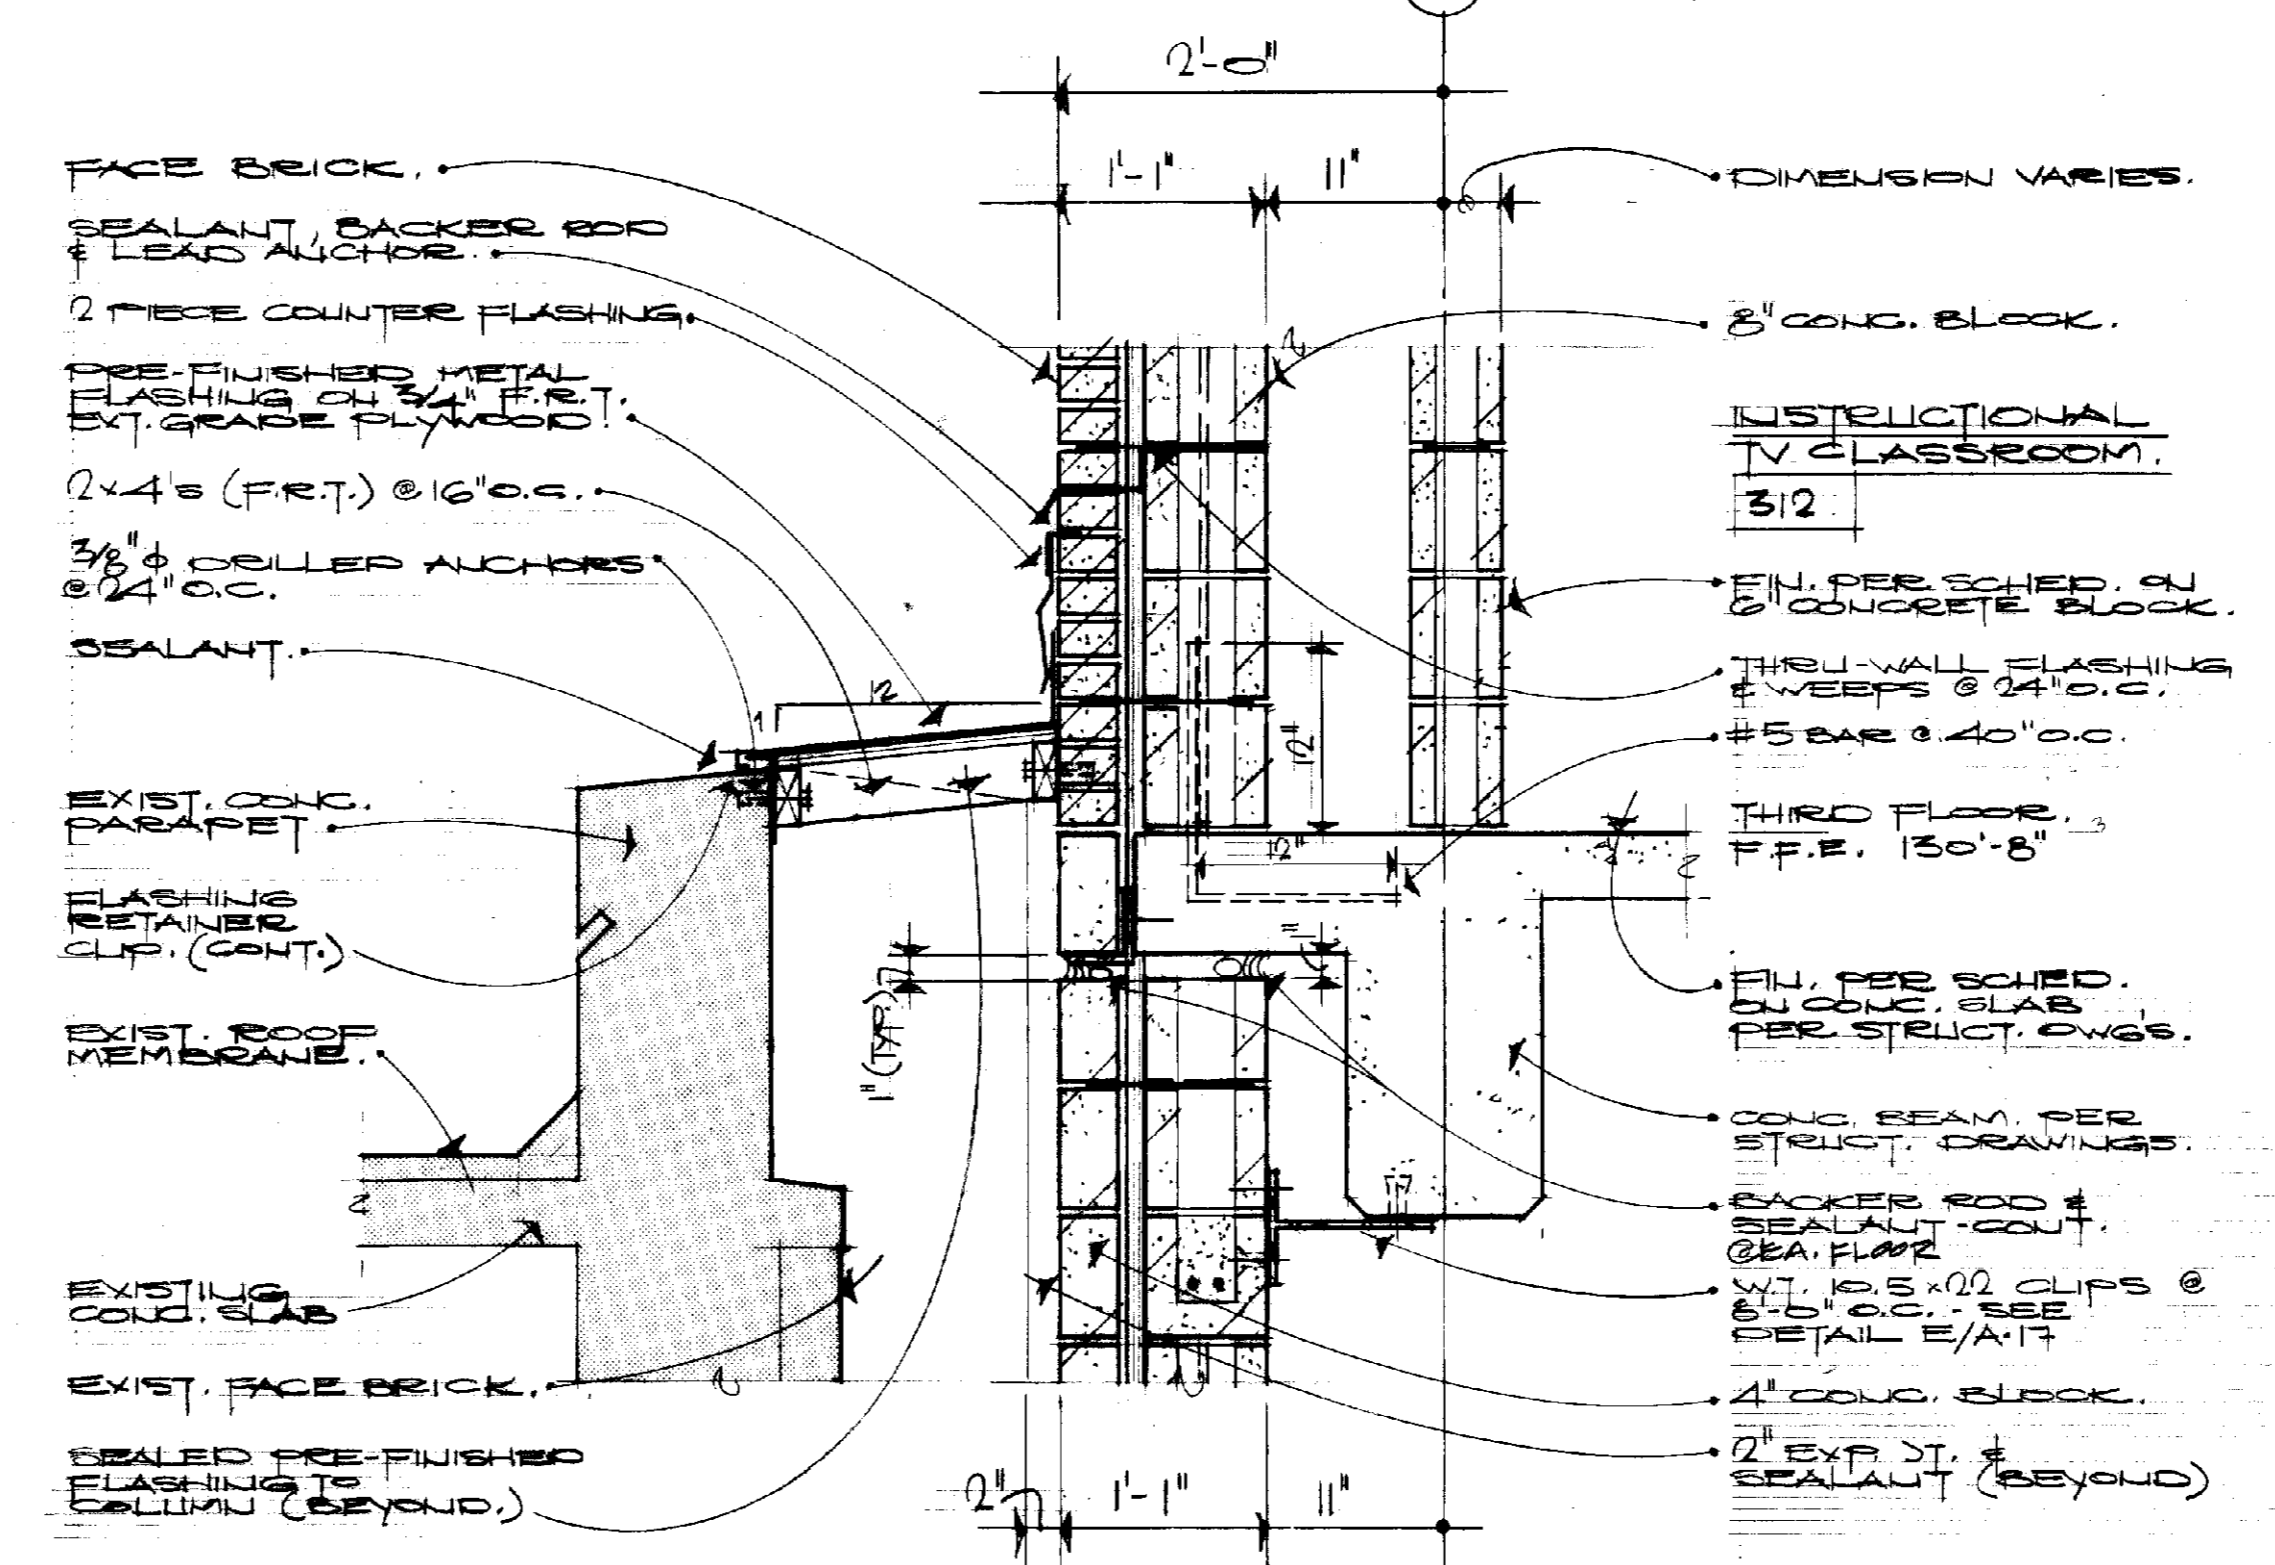


FLASHING DETAIL
SCALE: 1" = 1'-0"
C. A.37

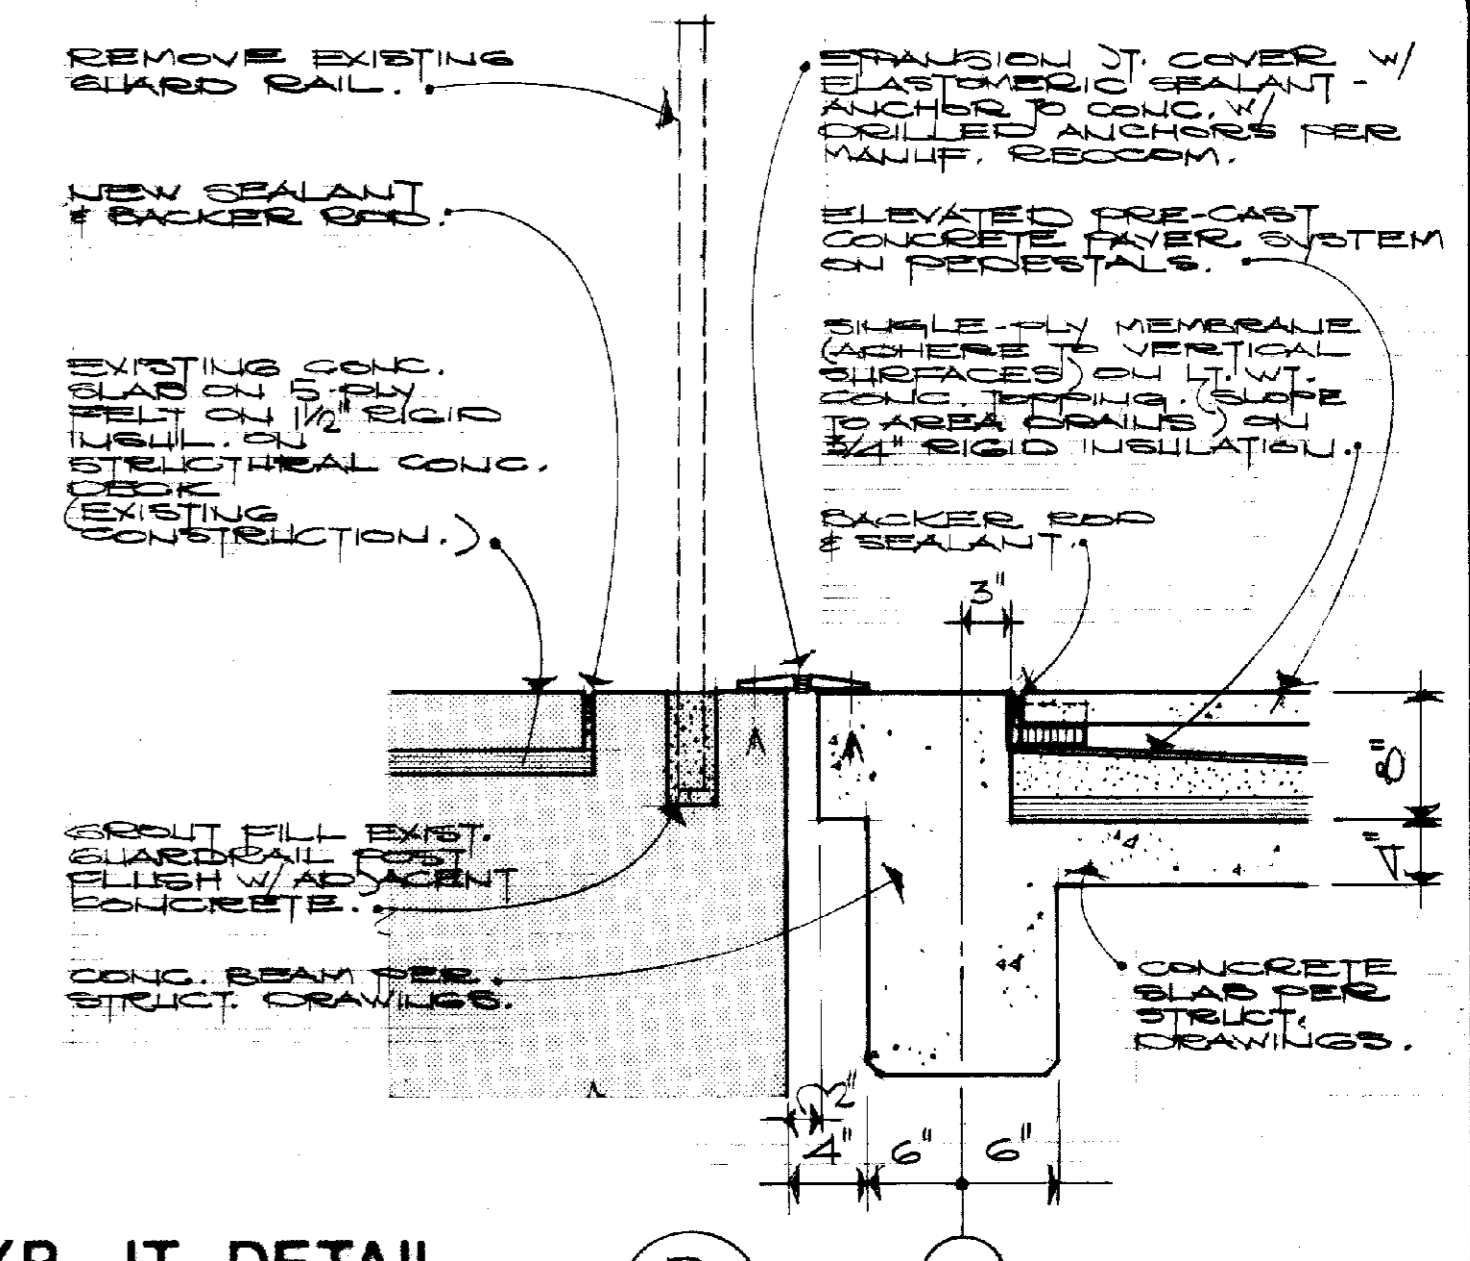

EXP. JT. DETAIL
SCALE: 1" = 1'-0"
D. A.37

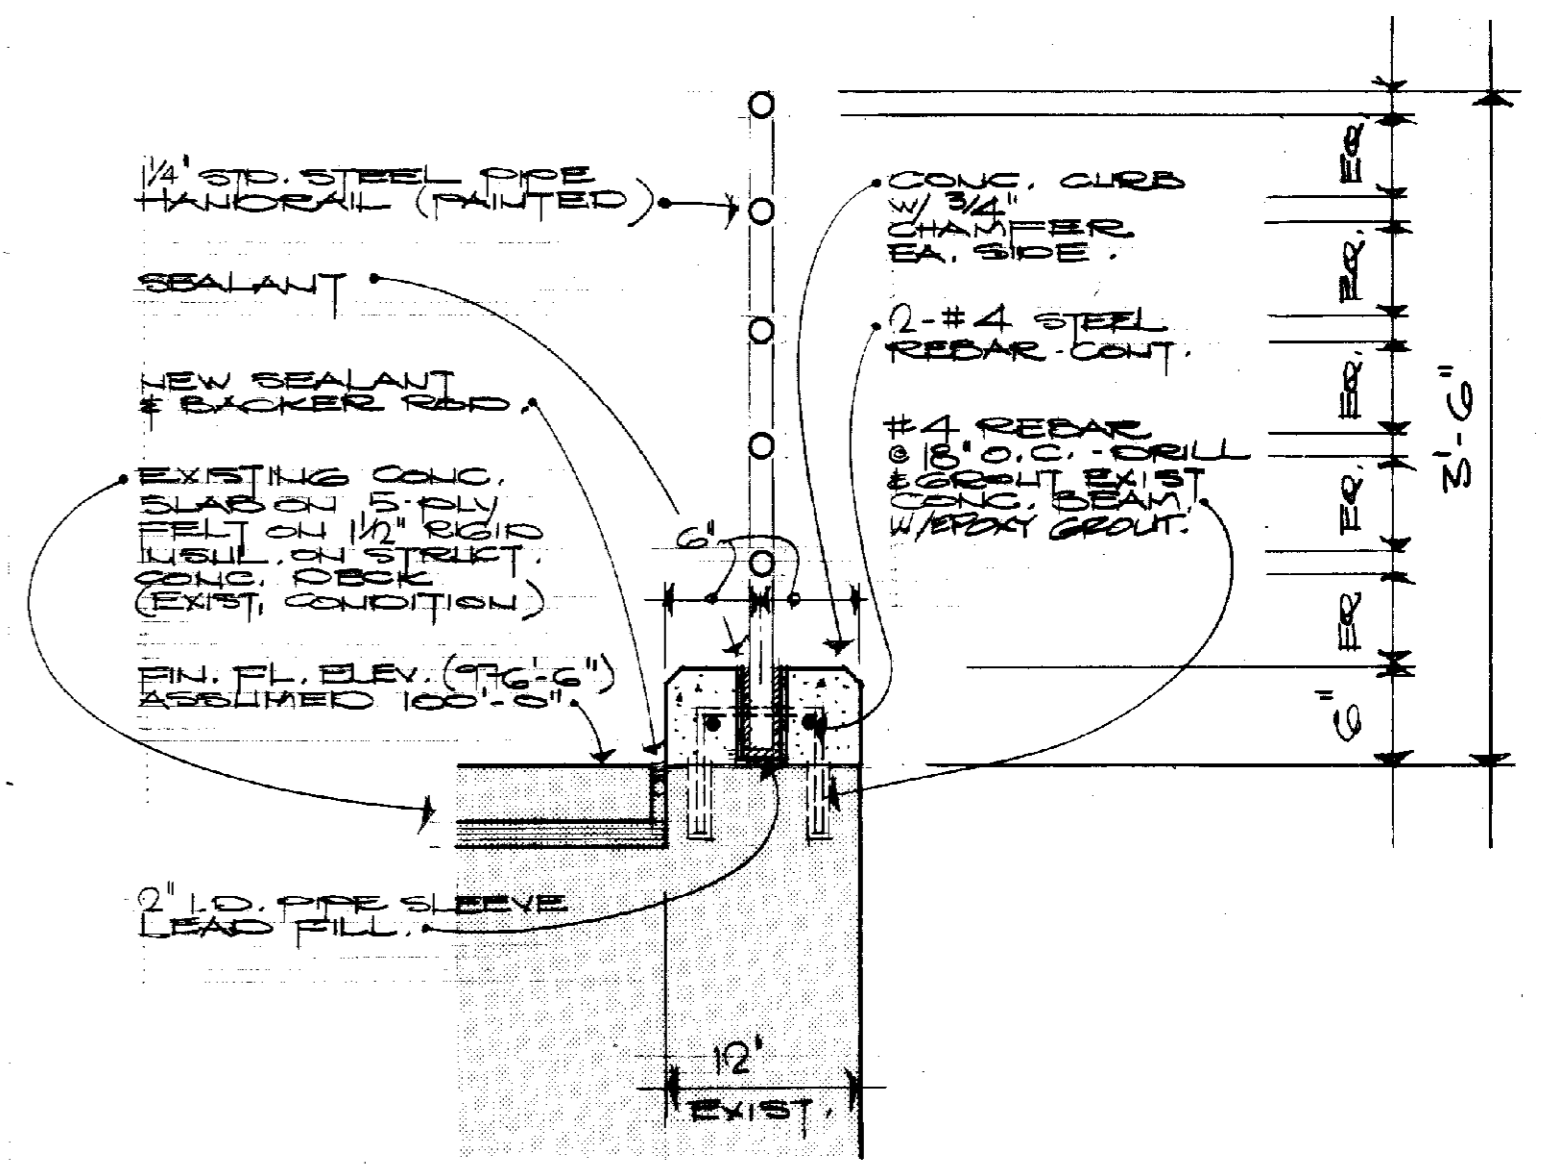

GUARDRAIL CURB DETAIL
SCALE: 1/4" = 1'-0"
E. A.37

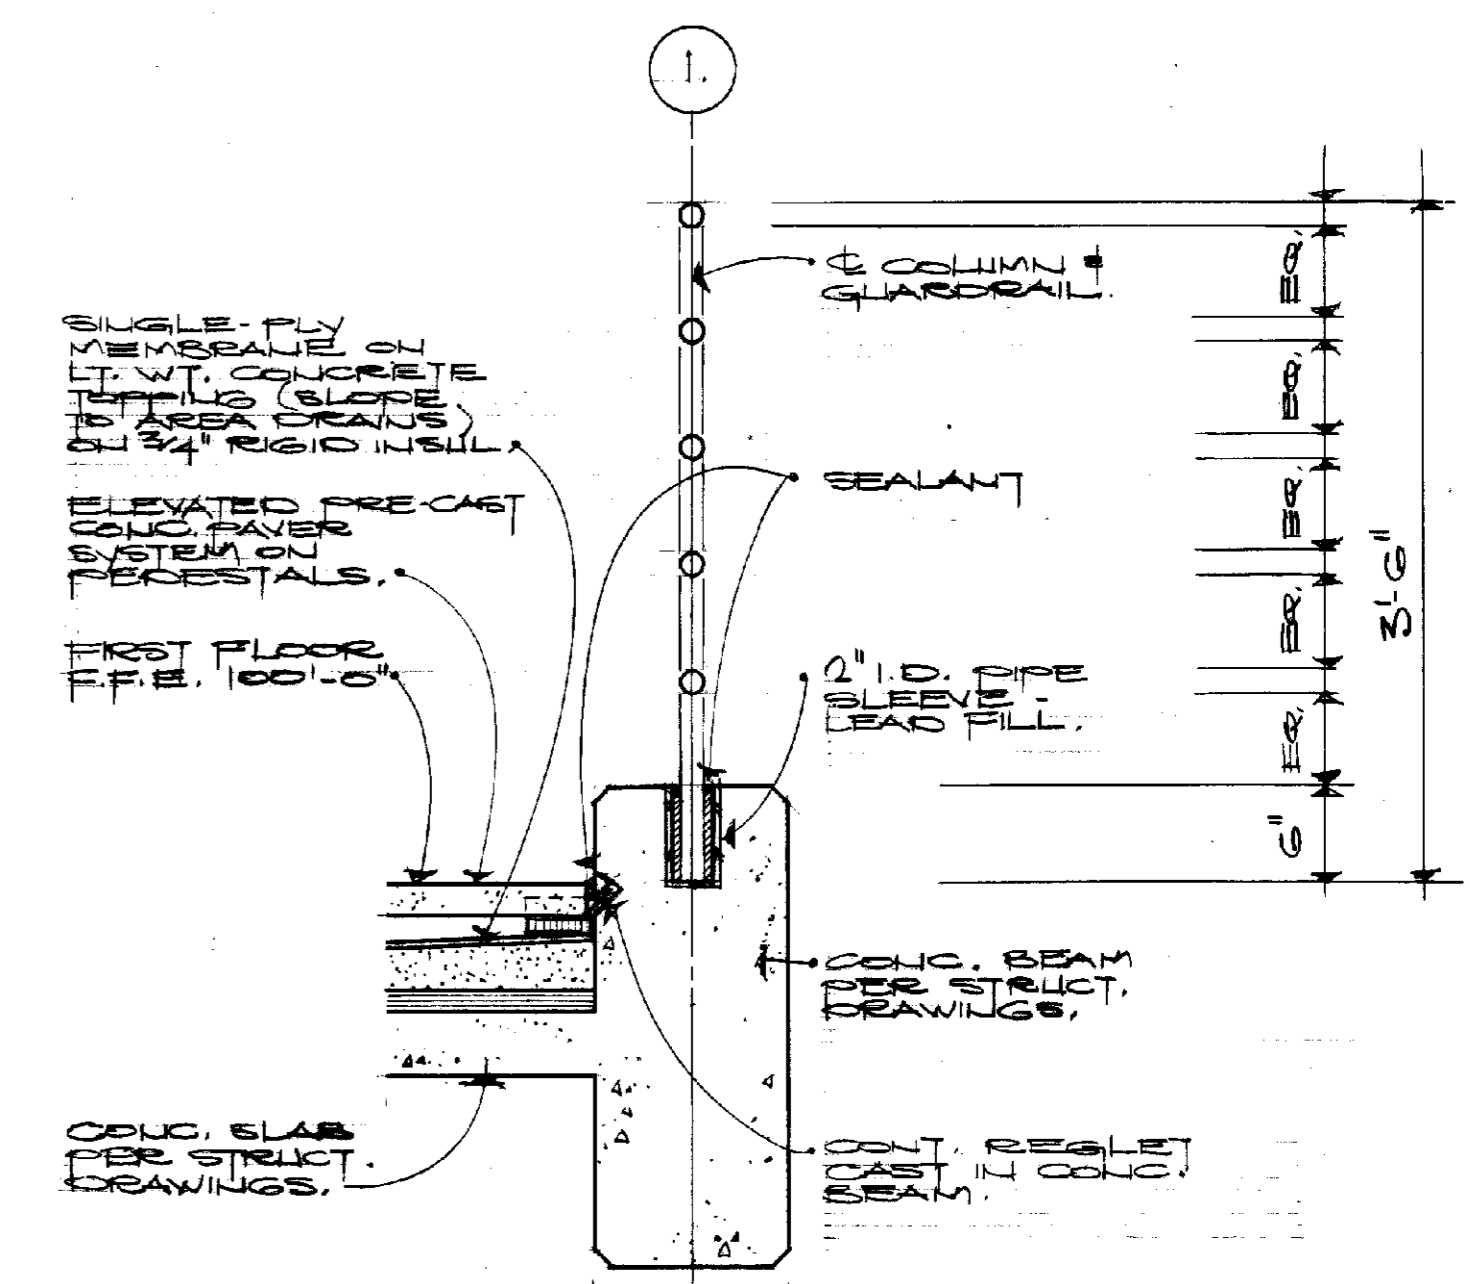

GUARDRAIL DETAIL
SCALE: 1" = 1'-0"
F. A.37




ROBOTICS FACILITY
LEXINGTON CAMPUS
UNIVERSITY OF KENTUCKY
LEXINGTON, KENTUCKY

University of Kentucky
Lexington, Kentucky
Approved by: **Wendy Bunn** 10-19-87
ARCHITECT, ENGINEER AND CONSTRUCTION DIVISION

SECTIONS & DETAILS
Sherman Carter Barnhart
PARTNERS IN ARCHITECTURE
LEXINGTON, FRANKLIN CENTER, SUITE 100, 725 W. MAIN, FORT KENTUCKY, KY 40501 • 606-254-1351

JOB NO.	8778
DATE	06-1-87
DRAWN	DM
CHECKED	CM
FILE NO.	8510

REVISIONS	

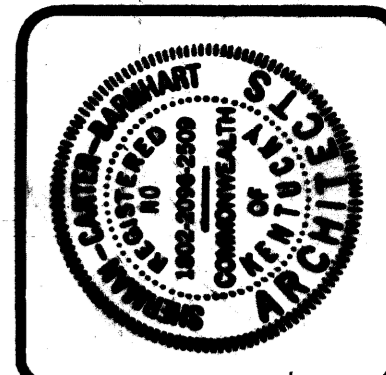

ROBOTICS FACILITY
LEXINGTON CAMPUS
UNIVERSITY OF KENTUCKY
LEXINGTON, KENTUCKY

University of Kentucky
Lexington, Kentucky

Approved by: *William R. Spang*
10-10-87

BASEMENT REF. CEILING PLAN

Sherman Carter Barnhart
PARTNERS IN ARCHITECTURE
SUITE 1900 • 250 WEST MAIN STREET • LEXINGTON, KY 40507 • 806-244-1951

JOB NO. 8708
DATE 10-1-87
DRAWN STAFF
CHECKED CEM
FILE NO. 431.0

REVISIONS



SHEET

A-40

DATE: 08/92
A-3

LEGEND

- SHADED WALLS INDICATE WALLS WHICH EXTEND TO UNDERSIDE OF SLAB ABOVE, SEE DET. A/A-40.
 - DASHED WALLS INDICATE WALLS WHICH EXTEND TO UNDERSIDE OF SLAB ABOVE, SEE DET. B/A-40.
 - UNSHADED WALLS EXTEND ONE FULL BLOCK COURSE COZ. OF PER. INTER-WALL PARTITION ABOVE ADJACENT COLLARS.
- NOTE: SEE MECHANICAL & ELECTRICAL DRAWINGS & LEGEND SHEETS FOR SYMBOL DESIGNATIONS FOR DIFFUSERS, GRILLES, SPRINKLER HEADS, LIGHT FIXTURES, & OTHER ITEMS.

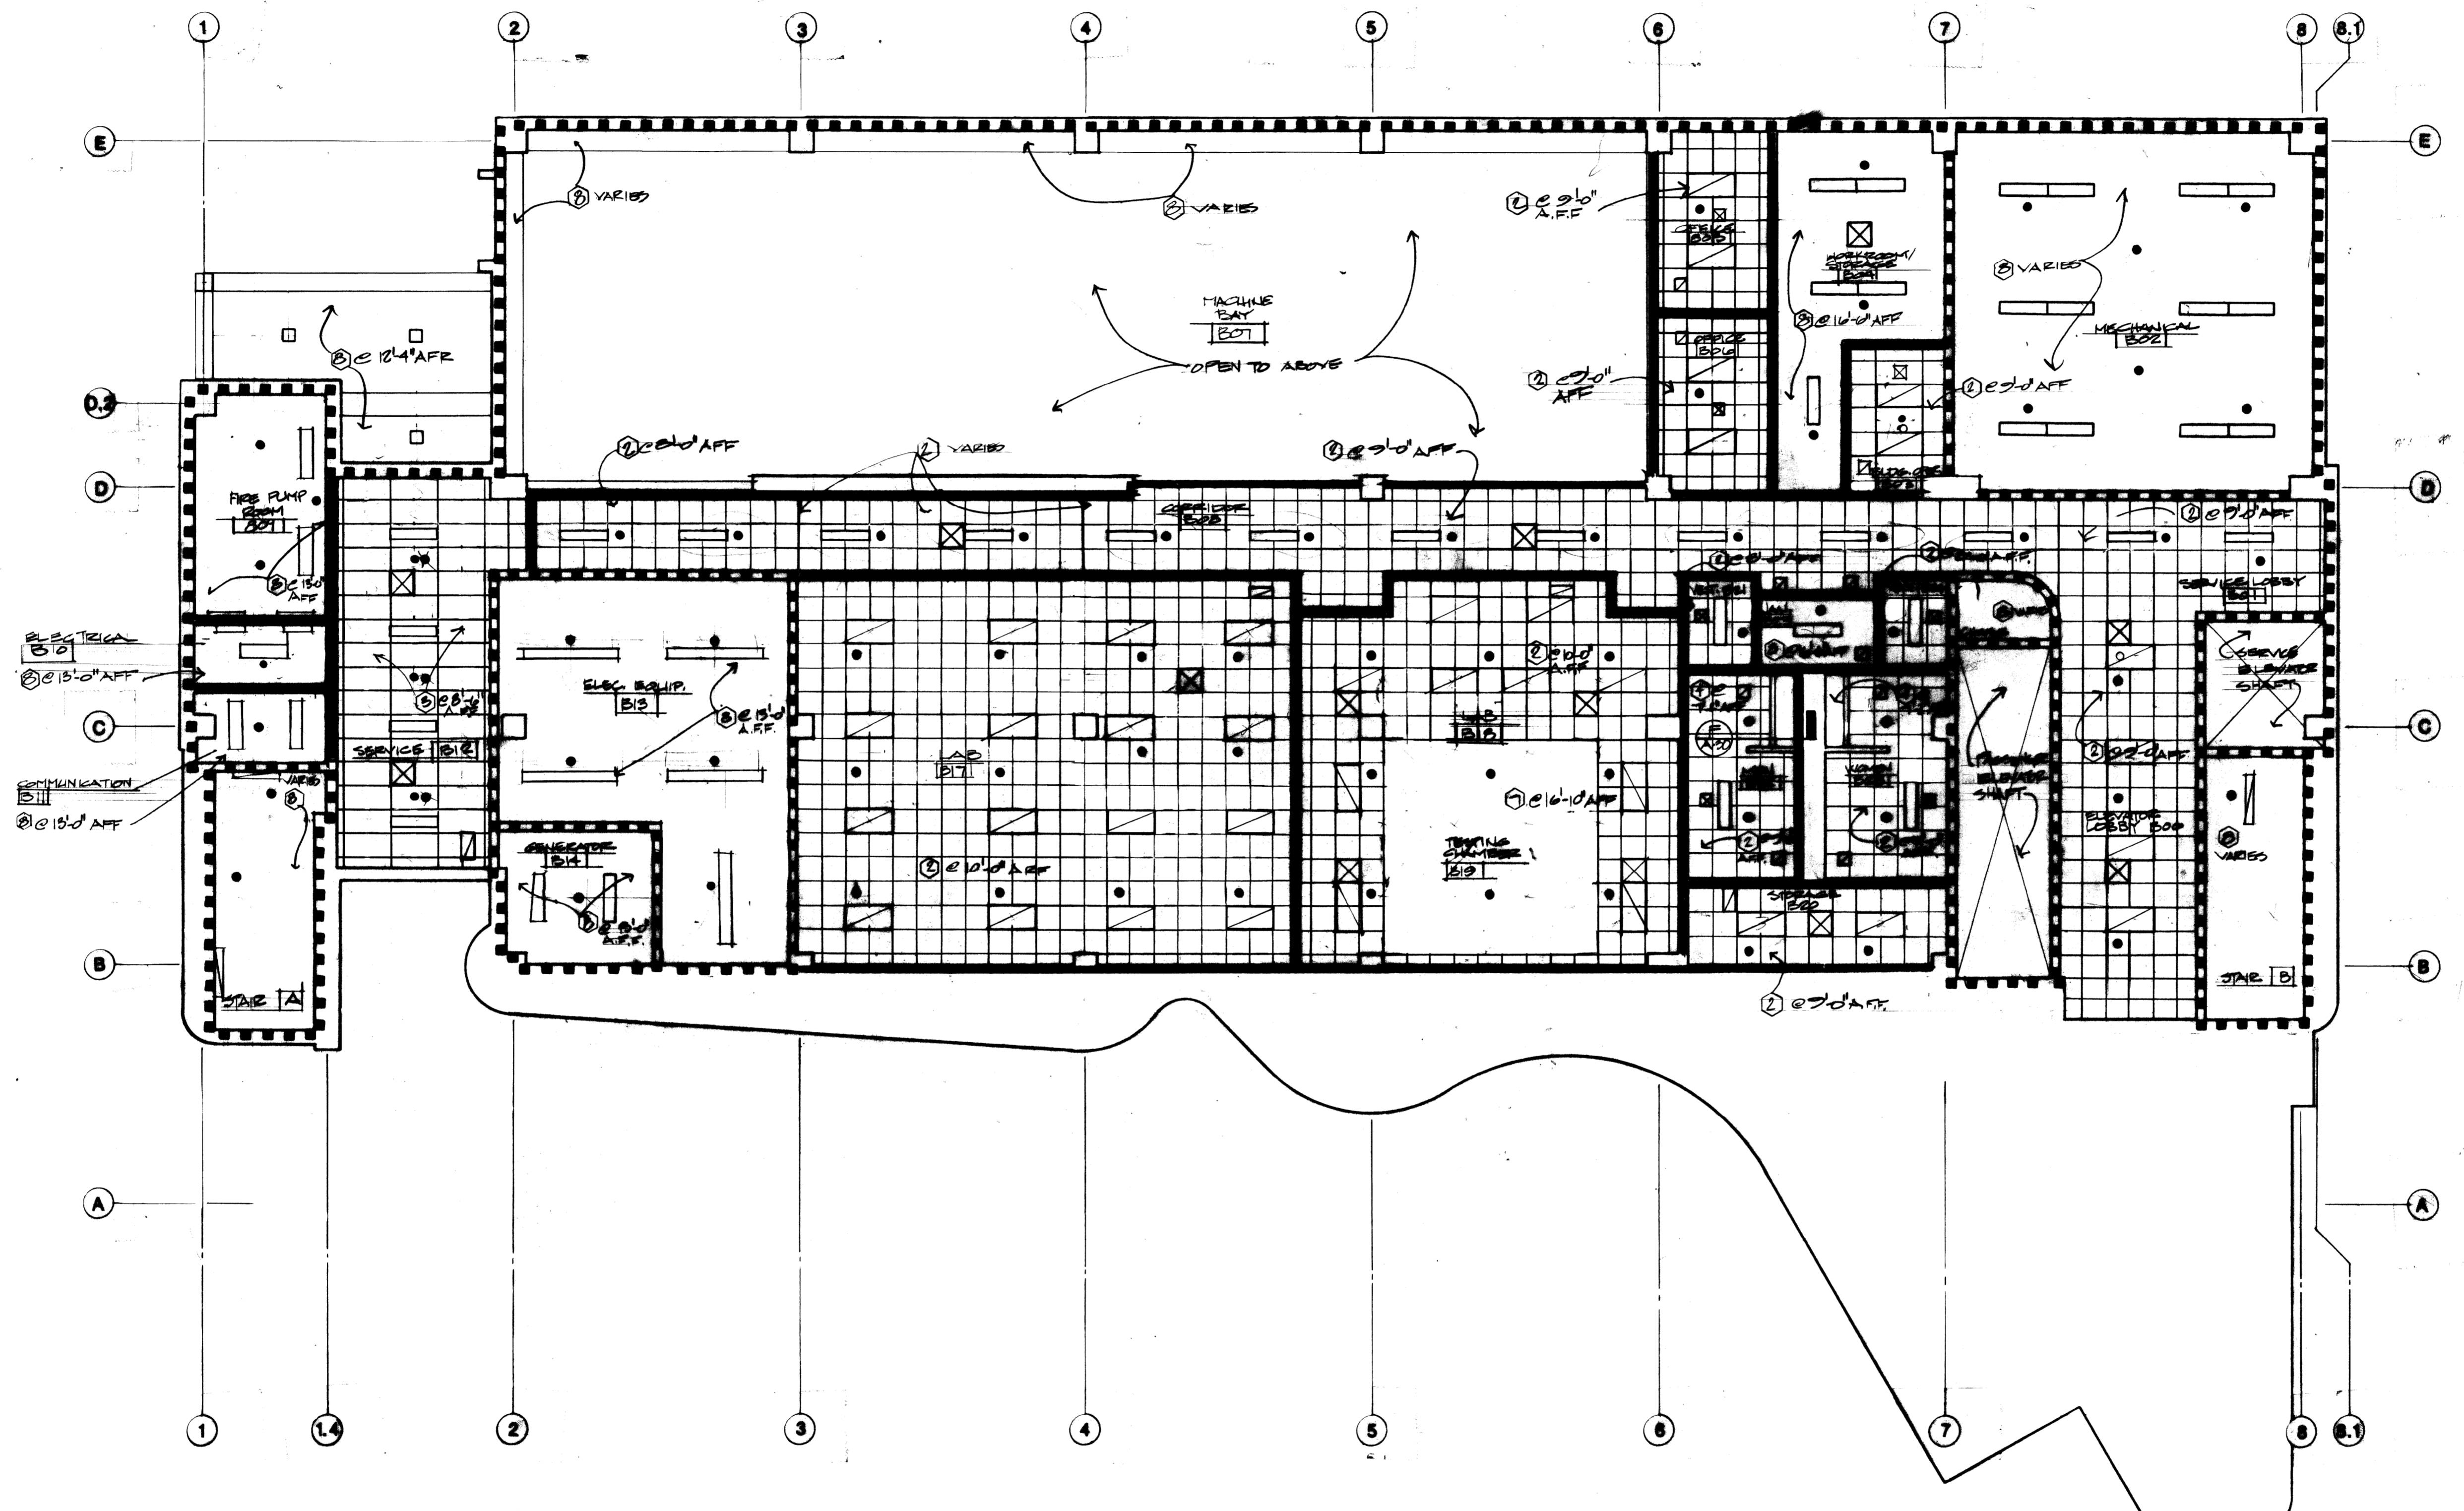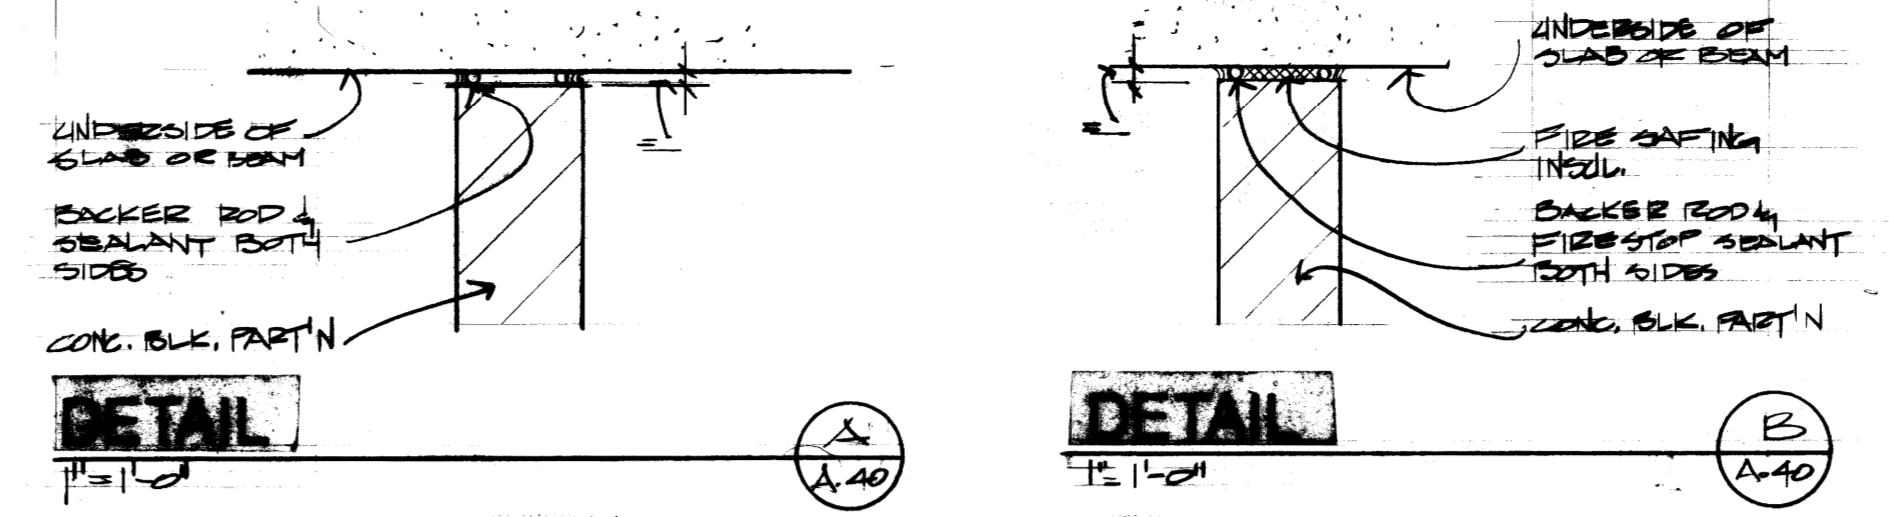


BASEMENT REFLECTED CEILING PLAN
1/8"=1'-0"

CEILING TYPES SCHEDULE

- 1 2x2 SUSP. ACOUS. CEILING W/ EXPOSED GRID (TYPE A)
- 2 2x2 SUSP. ACOUS. CEILING W/ EXPOSED GRID (TYPE B)
- 3 2x4 SUSP. ACOUS. CEILING W/ EXPOSED GRID (TYPE B)
- 4 PARABOLIC LENS EGG CRATE
- 5 5/8" EXTERIOR GYP. BD. ON SUSPENSION SYSTEM
- 6 5/8" GYP. BD. ON METAL STUDS
- 7 ACOUS. PANELS ON METAL FURRING
- 8 EXPOSED STRUCTURE
- 9 PRE-FINISHED METAL PANEL

ABBREVIATIONS

APF-ABOVE FINISHED FLOOR
ARF-ABOVE RAISED FLOOR

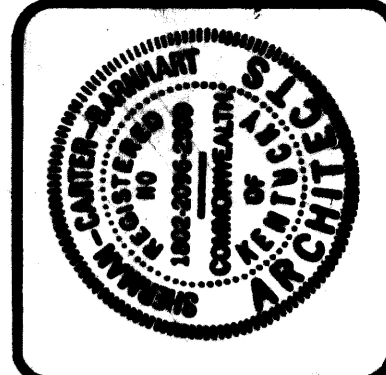

ROBOTICS FACILITY
LEXINGTON CAMPUS
UNIVERSITY OF KENTUCKY
LEXINGTON, KENTUCKY

University of Kentucky
Lexington, Kentucky
10-18-87
DATE

FIRST FL. REF. CEILING PLAN
Sherman Carter Barnhart
PARTNERS IN ARCHITECTURE
SUITE 1900 • 350 WEST MAIN STREET • LEXINGTON, KY 40507 • 606-254-1951


JOB NO. 8706
DATE 10-1-87
DRAWN STAFF
CHECKED CER
FILE NO. 431.0

REVISIONS

SHEET
A-41
1/25/87

LEGEND

- CHASED WALLS INDICATE WALLS WHICH EXTEND TO UNDERSIDE OF SLAB ABOVE, SEE DET. A/A-40.
 - FINISHED WALLS INDICATE FIRE-RATED WALLS WHICH EXTEND TO UNDERSIDE OF SLAB ABOVE, SEE DET. B/A-40.
 - UNCHASED WALLS EXTEND ONE FULL BLOCK COURSE (OR 6" FOR DET. WALL PARTITION) ABOVE ADJACENT CEILING.
- NOTE: SEE MECHANICAL & ELECTRICAL DRAWING & LEGEND SHEETS FOR SYMBOL DESIGNATIONS FOR DIFFUSERS, GRILLES, SPRINKLER HEADS, LIGHT FIXTURES, & OTHER ITEMS.


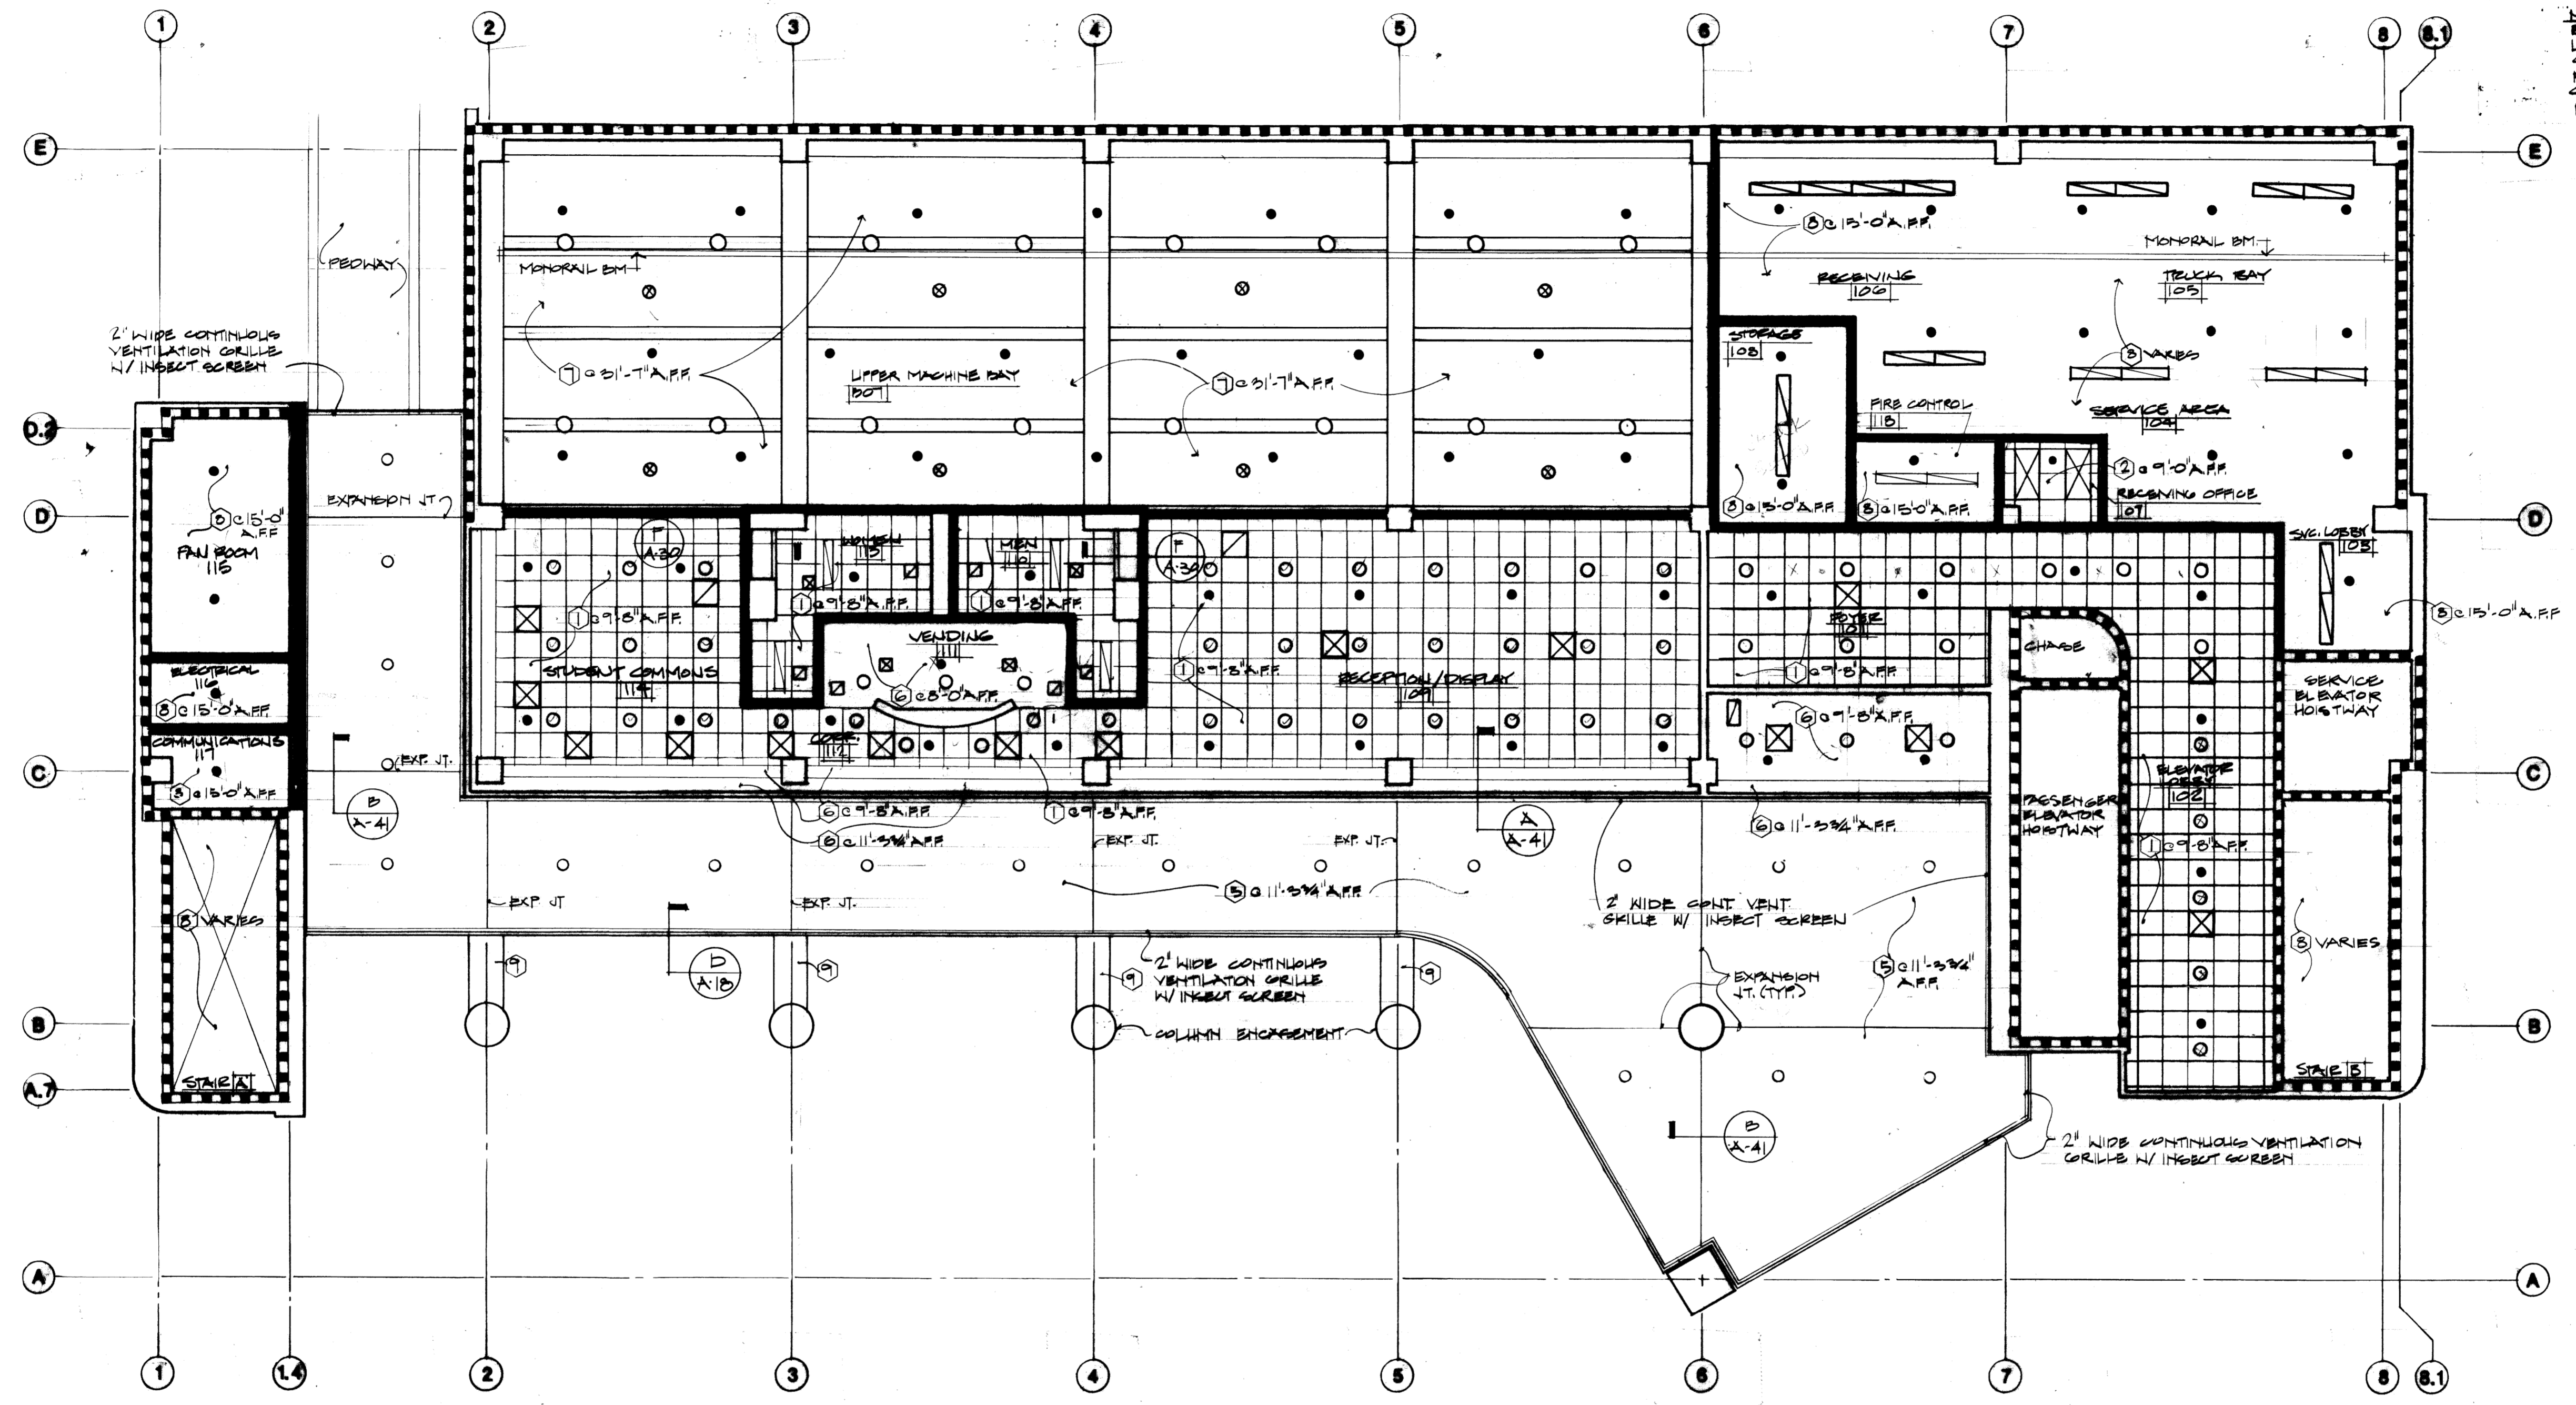



CEILING TYPES SCHEDULE

- 2x2 SUSP. ACOUS. CEILING w/ EXPOSED GRID (TYPE A)
- 2x2 SUSP. ACOUS. CEILING w/ EXPOSED GRID (TYPE B)
- 2x4 SUSP. ACOUS. CEILING w/ EXPOSED GRID (TYPE B)
- PARABOLIC LENS EGG CRATE
- 5/8" EXTERIOR GYP. BD. ON SUSPENSION SYSTEM
- 5/8" GYP. BD. ON METAL STUDS
- ACOUS. PANELS ON METAL FURRING
- EXPOSED STRUCTURE
- PRE-FINISHED METAL PANEL

ABBREVIATIONS
AFF-ABOVE FINISHED FLOOR
ARF-ABOVE RAISED FLOOR

FIRST FLOOR REFLECTED CEILING PLAN
1/8" = 1'-0"

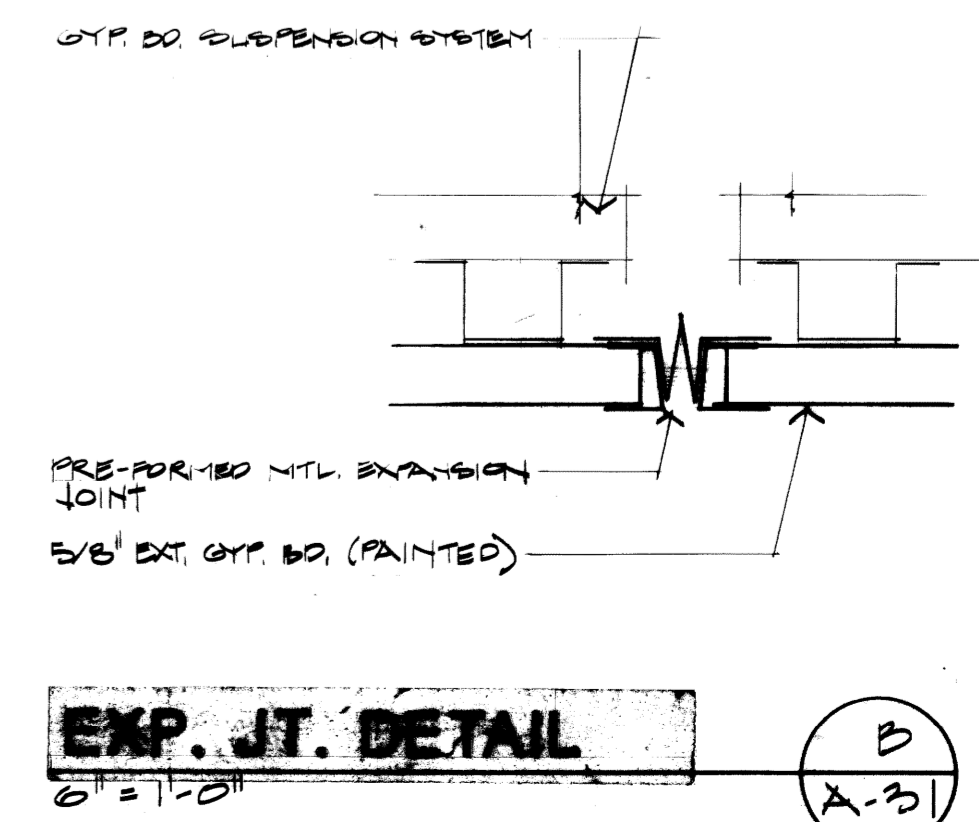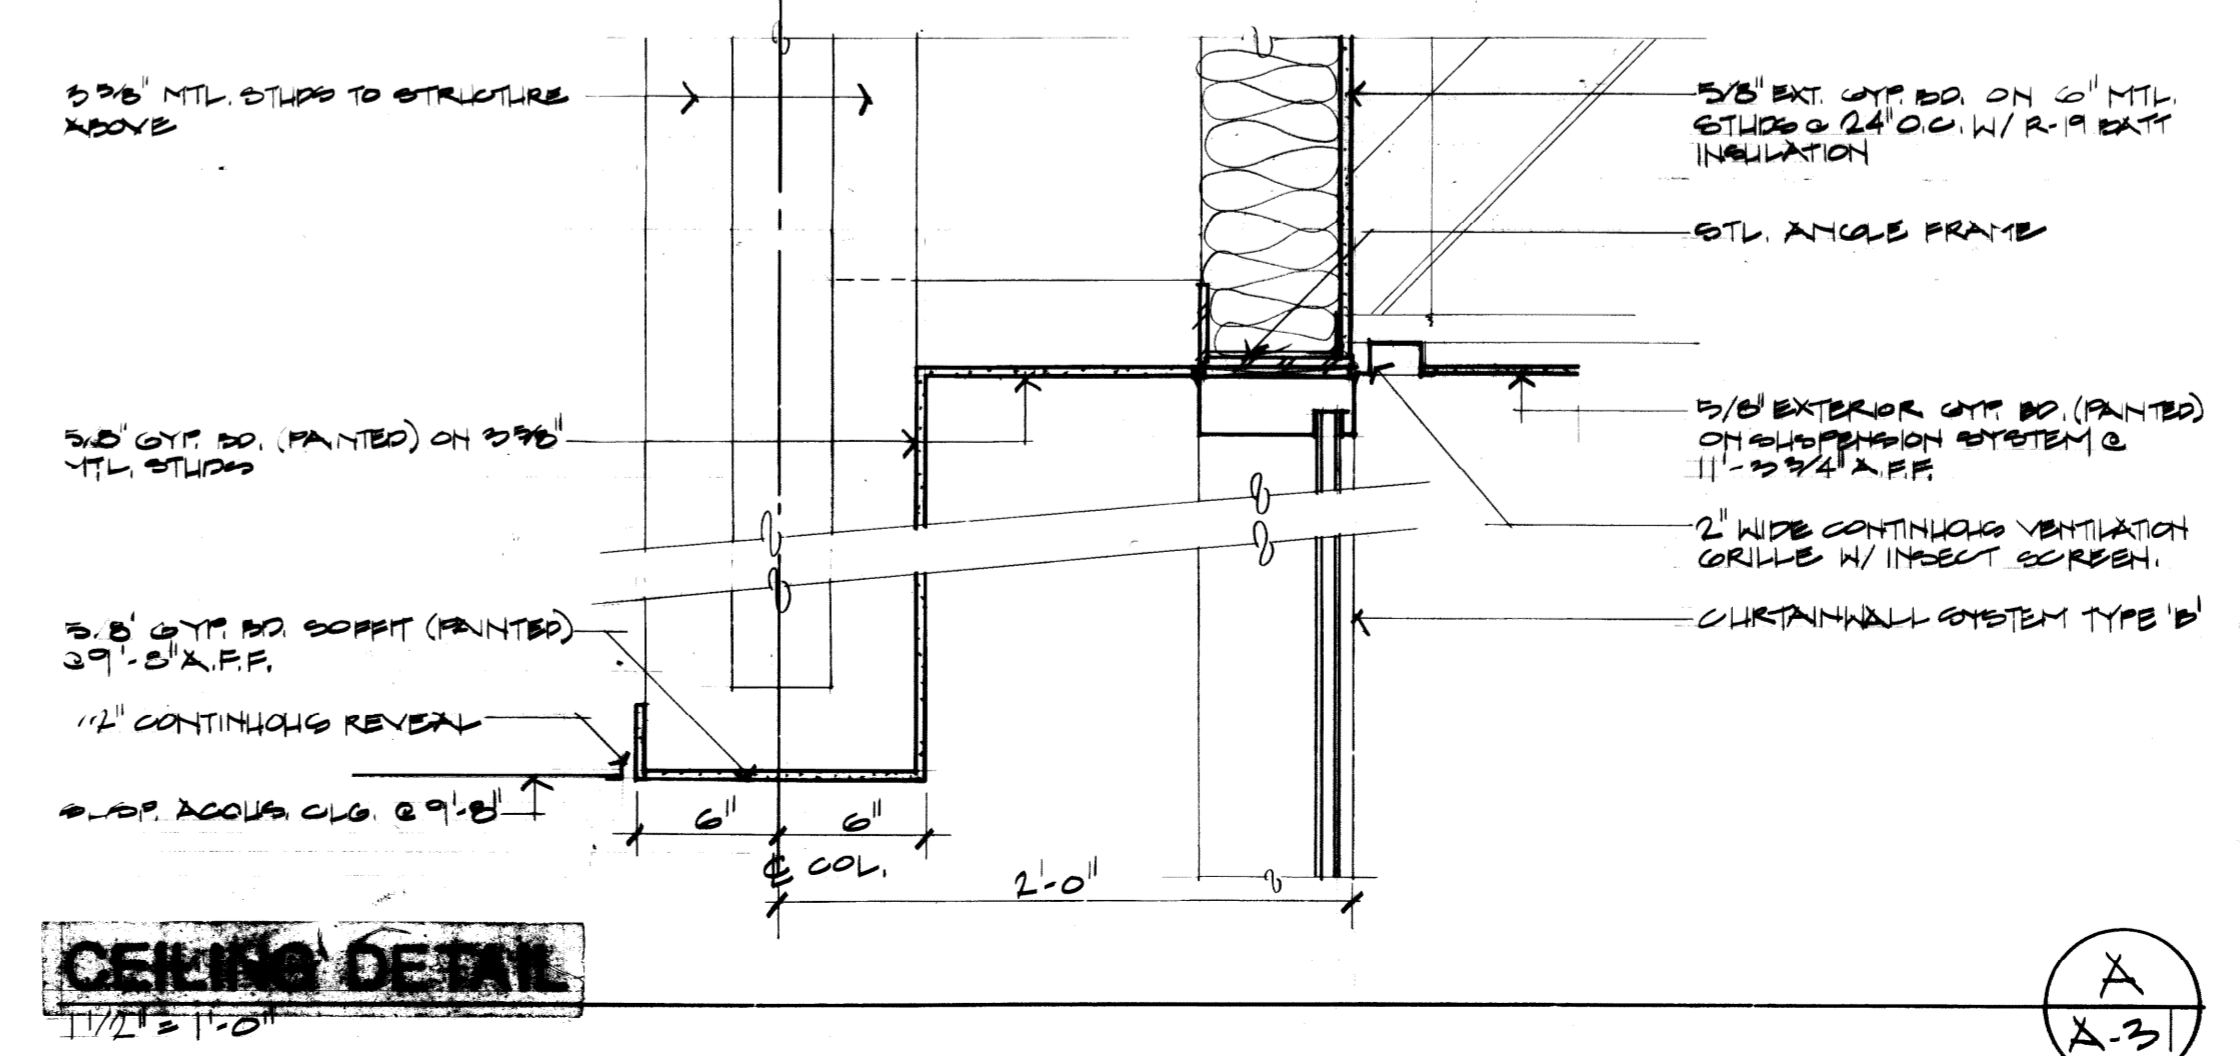

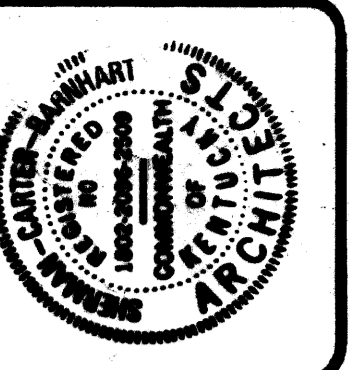

ROBOTICS FACILITY
LEXINGTON CAMPUS
UNIVERSITY OF KENTUCKY
LEXINGTON, KENTUCKY

University of Kentucky
Lexington, Kentucky

Approved by: *Sherman Carter-Barnhart*
DATE: 10-1-87

SECOND FL. REFL. CEILING PLAN

Sherman Carter-Barnhart
PARTNERS IN ARCHITECTURE
SUITE 1900 • 250 WEST MAIN STREET • LEXINGTON, KY 40507 • 502-254-1951

JOB NO. 3708
DATE 10-1-87
DRAWN STAFF
CHECKED CEB
FILE NO. 4310

REVISIONS

1 FEB. 7, 1988

Document # 064927


SHEET

Call # A-3
82

A-42


LEGEND

- SHADED WALLS INDICATE WALLS WHICH EXTEND TO UNDERSIDE OF SLAB ABOVE. SEE DET. A-1, A-2.
 - EXP. WALLS INDICATE FIRE-RATED WALLS WHICH EXTEND TO UNDERSIDE OF SLAB ABOVE. SEE DET. B-1, B-2.
 - UNSHADED WALLS EXTEND ONE FULL BLOCK ABOVE COG L FOR DET. WALL PARTITION ABOVE ADJACENT CEILING.
- NOTE: SEE MECHANICAL & ELECTRICAL DRAWING & SYMBOL SHEETS FOR SYMBOL DESIGNATIONS FOR DIFFUSERS, GRILLES, SPRINKLER HEADS, LIGHT FIXTURES, & OTHER ITEMS.

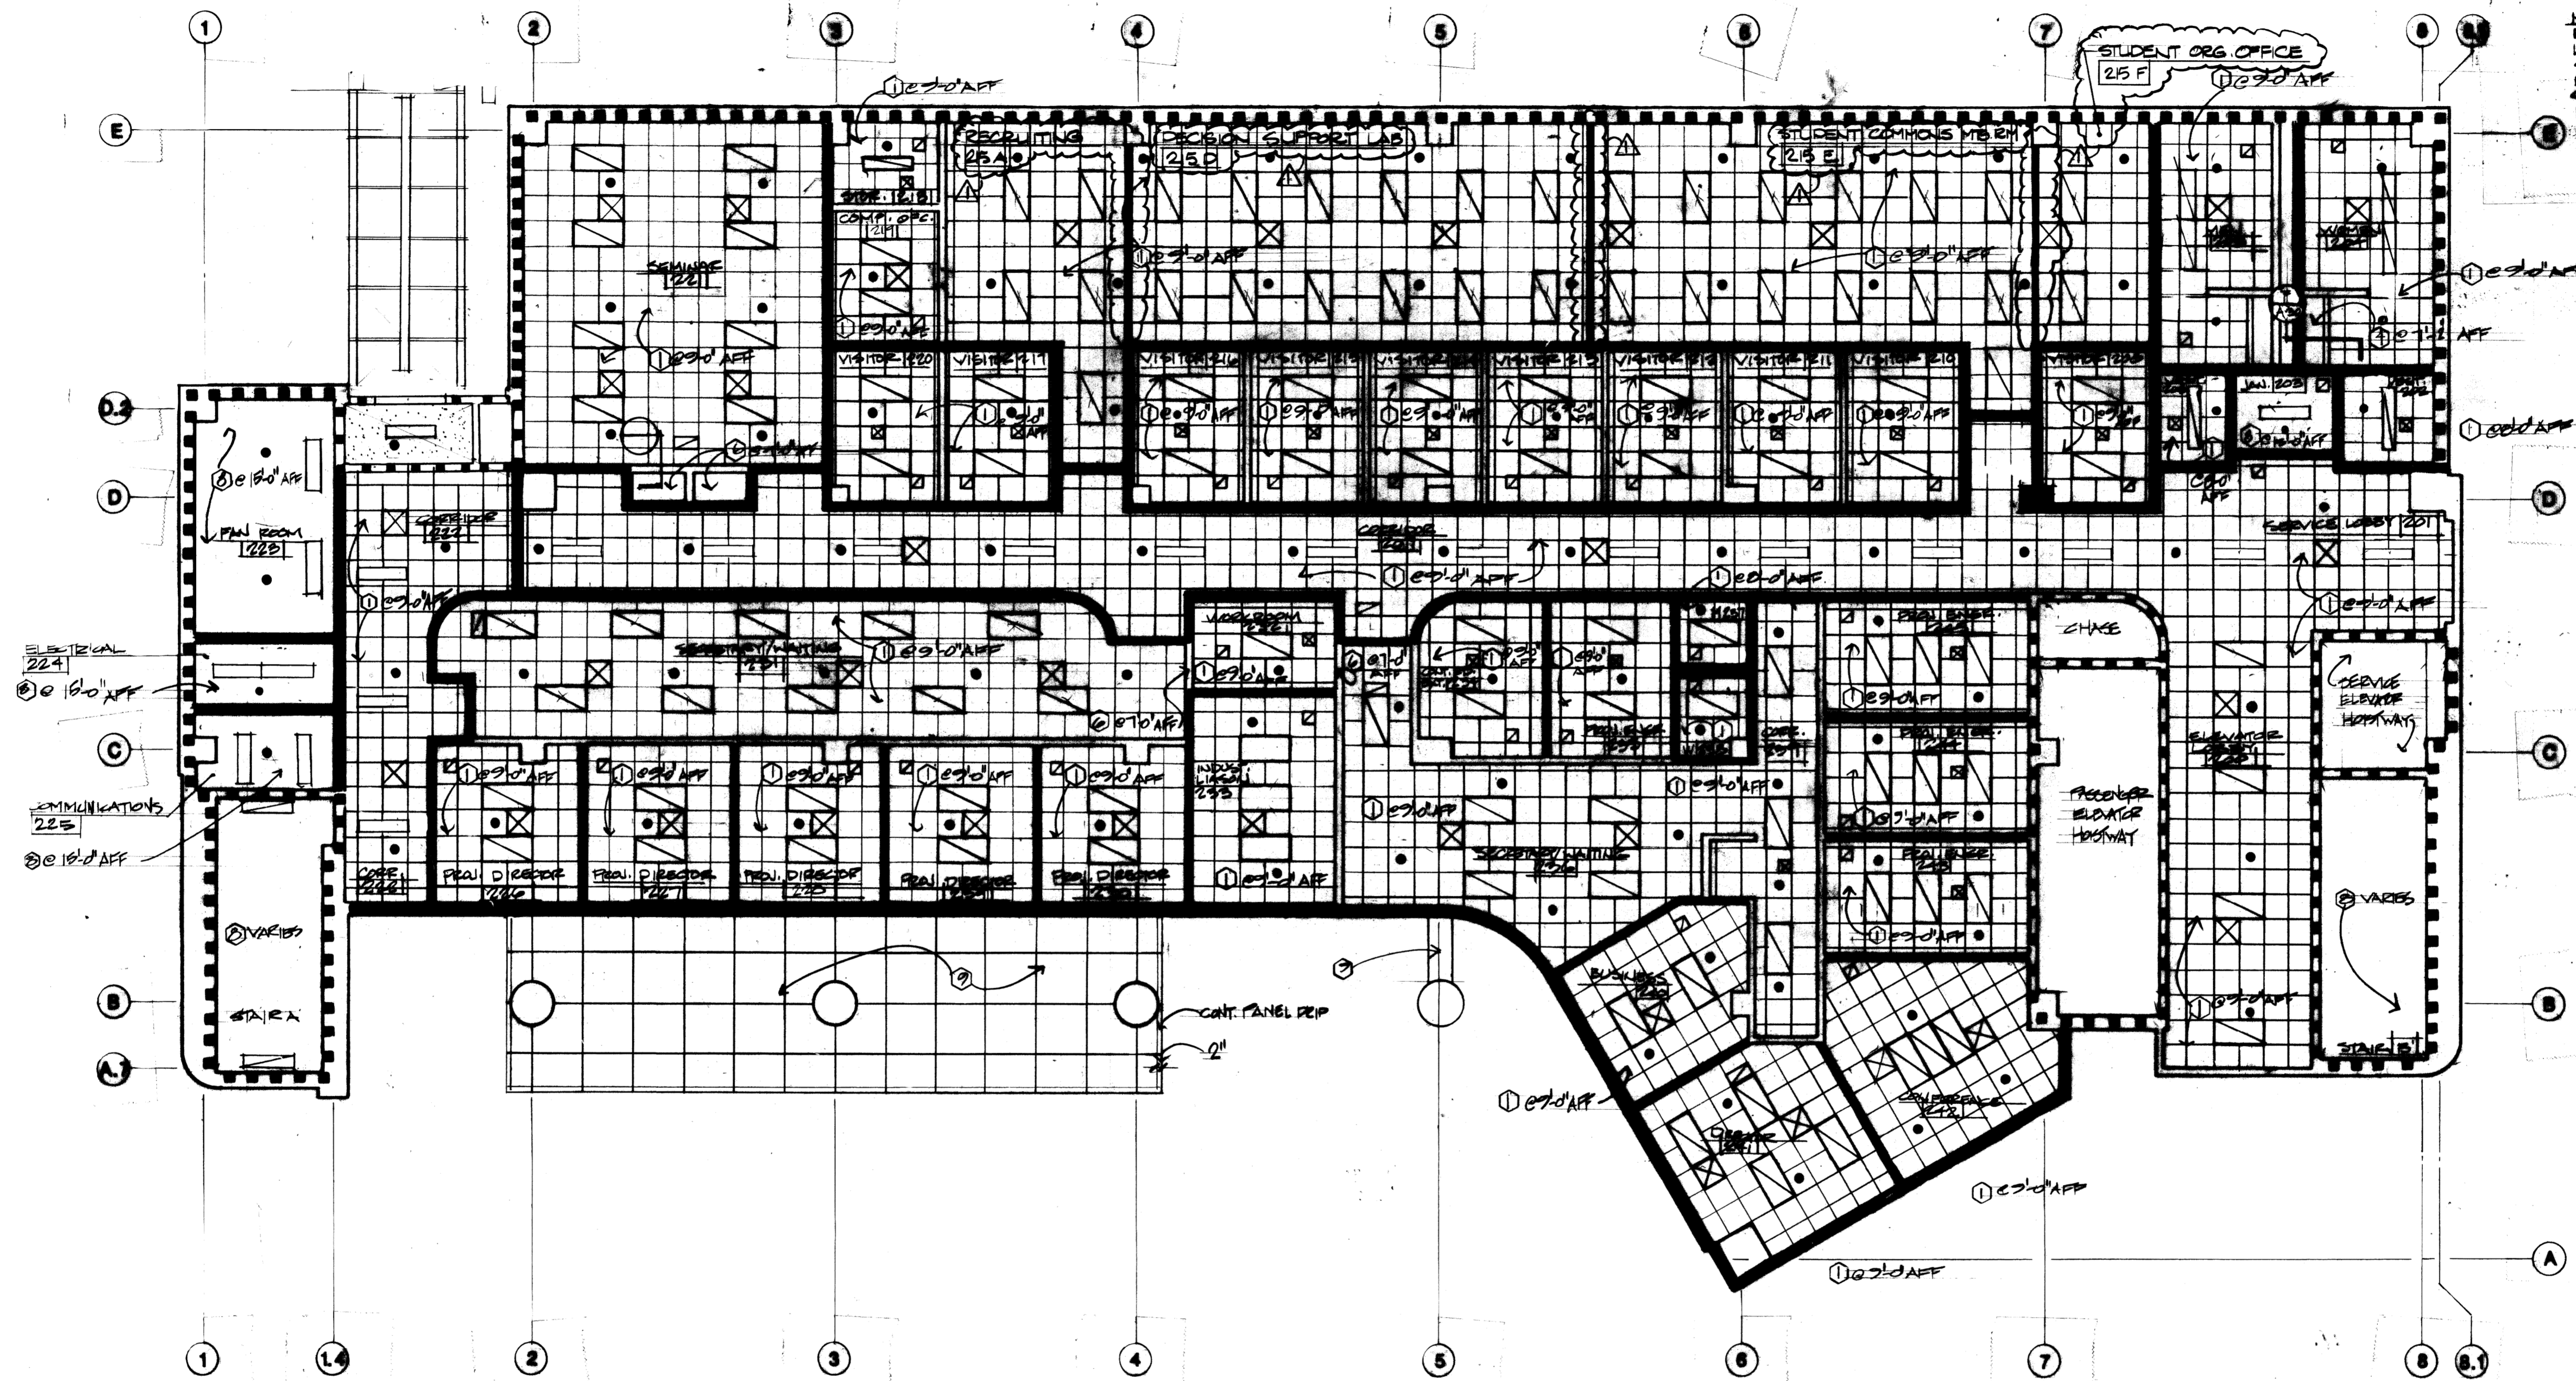

SECOND FLOOR
REFLECTED CEILING PLAN

1/8" = 10'

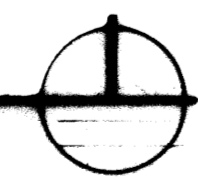


CEILING TYPES SCHEDULE

1	2x2 SUSP. ACOUS. CEILING w/ EXPOSED GRID (TYPE A)
2	2x2 SUSP. ACOUS. CEILING w/ EXPOSED GRID (TYPE B)
3	2x4 SUSP. ACOUS. CEILING w/ EXPOSED GRID (TYPE B)
4	PARABOLIC LENS EGG CRATE
5	5/8" EXTERIOR GYP. BD. ON SUSPENSION SYSTEM
6	5/8" GYP. BD. ON METAL STUDS
7	ACOUS. PANELS ON METAL FURRING
8	EXPOSED STRUCTURE
9	PRE-FINISHED METAL PANEL

ABBREVIATIONS
AFF-ABOVE FINISHED FLOOR
ARF-ABOVE RAISED FLOOR

AS BUILT

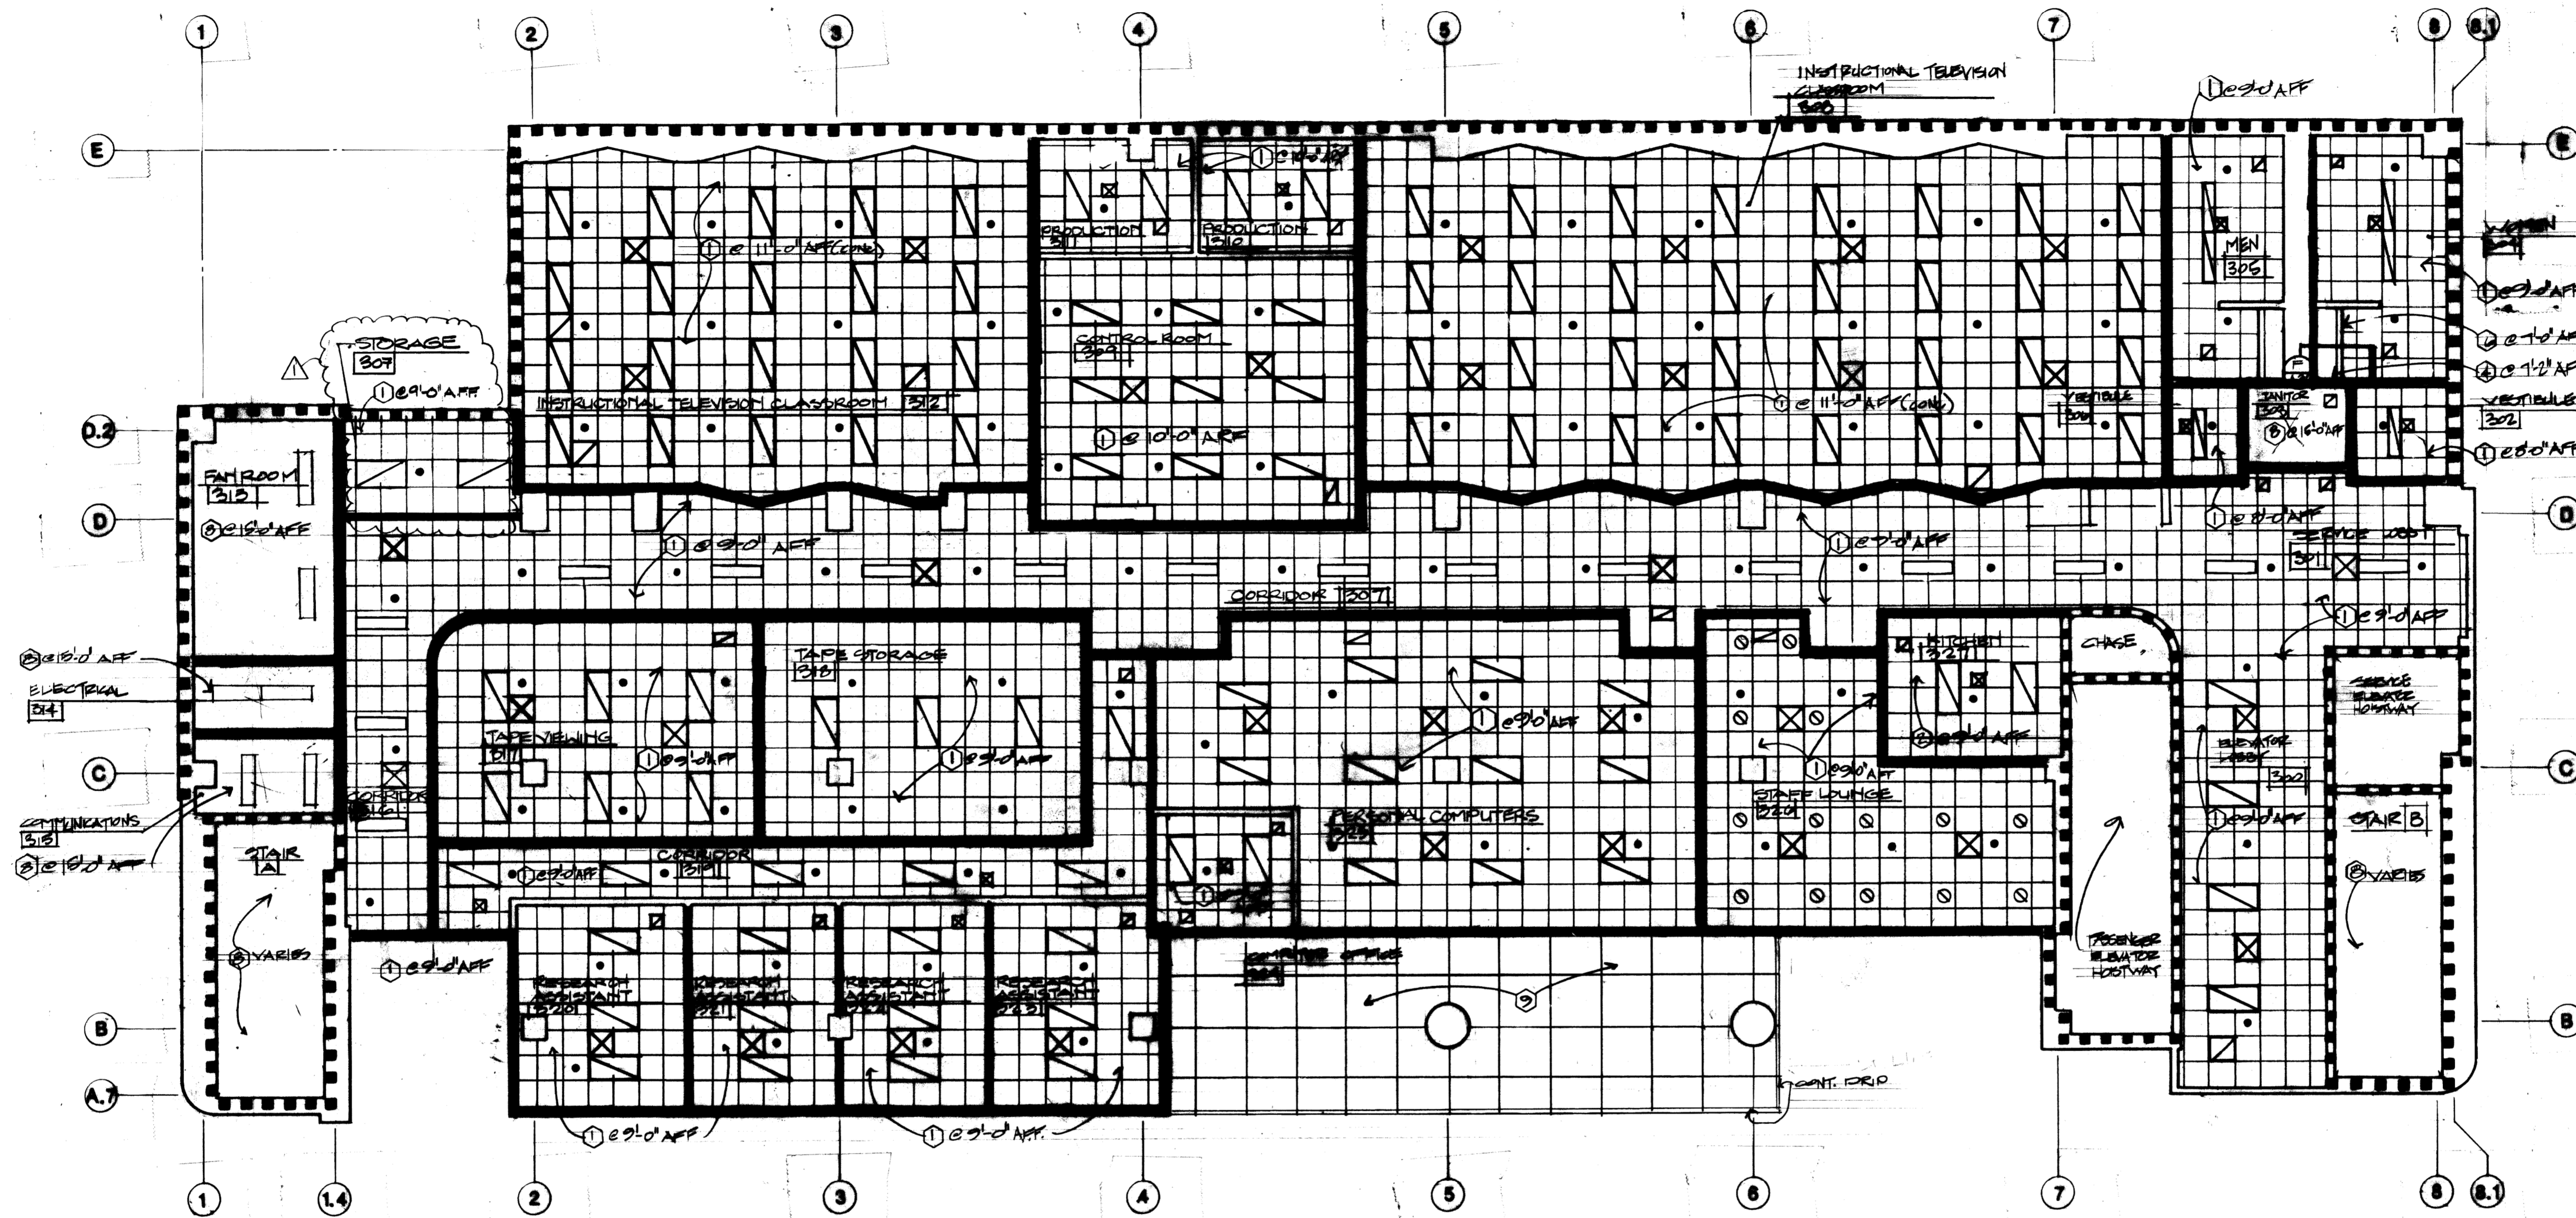

THIRD FLOOR
REFLECTED CEILING PLAN
1/8" = 1'-0"

LEGEND

SHADE WALLS INDICATE WALLS WHICH EXTEND TO UNDERSIDE OF SLAB ABOVE, SEE DET. A/A. 40.

DASHED WALLS INDICATE WALLS WHICH EXTEND TO UNDERSIDE OF SLAB ABOVE, SEE DET. A/A. 40.

UNSHADE WALLS EXTEND AND FILL ROOMS ABOVE. SEE DET. A/A. 40 FOR DETAIL POSITION ABOVE ADJACENT CEILING.

NOTE: SEE MECHANICAL & ELECTRICAL DRAWINGS AND SHEETS FOR SYMBOL DESIGNATIONS FOR DIFFUSERS, GRILLES, SPRINKLER HEADS, LIGHT FIXTURES, & OTHER ITEMS.

CEILING TYPES SCHEDULE

- 1 2x2 SUSP. ACOUS. CEILING w/ EXPOSED GRID (TYPE A)
- 2 2x2 SUSP. ACOUS. CEILING w/ EXPOSED GRID (TYPE B)
- 3 2x4 SUSP. ACOUS. CEILING w/ EXPOSED GRID (TYPE B)
- 4 PARABOLIC LENS EGG CRATE
- 5 5/8" EXTERIOR GYP. BD. ON SUSPENSION SYSTEM
- 6 5/8" GYP. BD. ON METAL STUDS
- 7 ACOUS. PANELS ON METAL FURRING
- 8 EXPOSED STRUCTURE
- 9 PRE-FINISHED METAL PANEL

ABBREVIATIONS

AFF-ABOVE FINISHED FLOOR
ARF-ABOVE RAISED FLOOR

AS BUILT



ROBOTICS FACILITY
LEXINGTON CAMPUS
UNIVERSITY OF KENTUCKY
LEXINGTON, KENTUCKY

University of Kentucky
Lexington, Kentucky

Wanda Bunn
DIRECTOR OF DESIGN AND CONSTRUCTION SERVICES

10-18-87

THIRD FL. REF. CEILING PLAN

Sherman Carter Barnhart
PARTNERS IN ARCHITECTURE

SUITE 1900 • 750 WEST MAIN STREET • LEXINGTON, KY 40507 • 506-254-1351

JOB NO. 8704
DATE 10-1-87
DRAWN STAFF
CHECKED CEB
FILE NO. 431.0


REVISIONS

▲ FEB 7, 1990

SHEET

A-43

004928
A-3

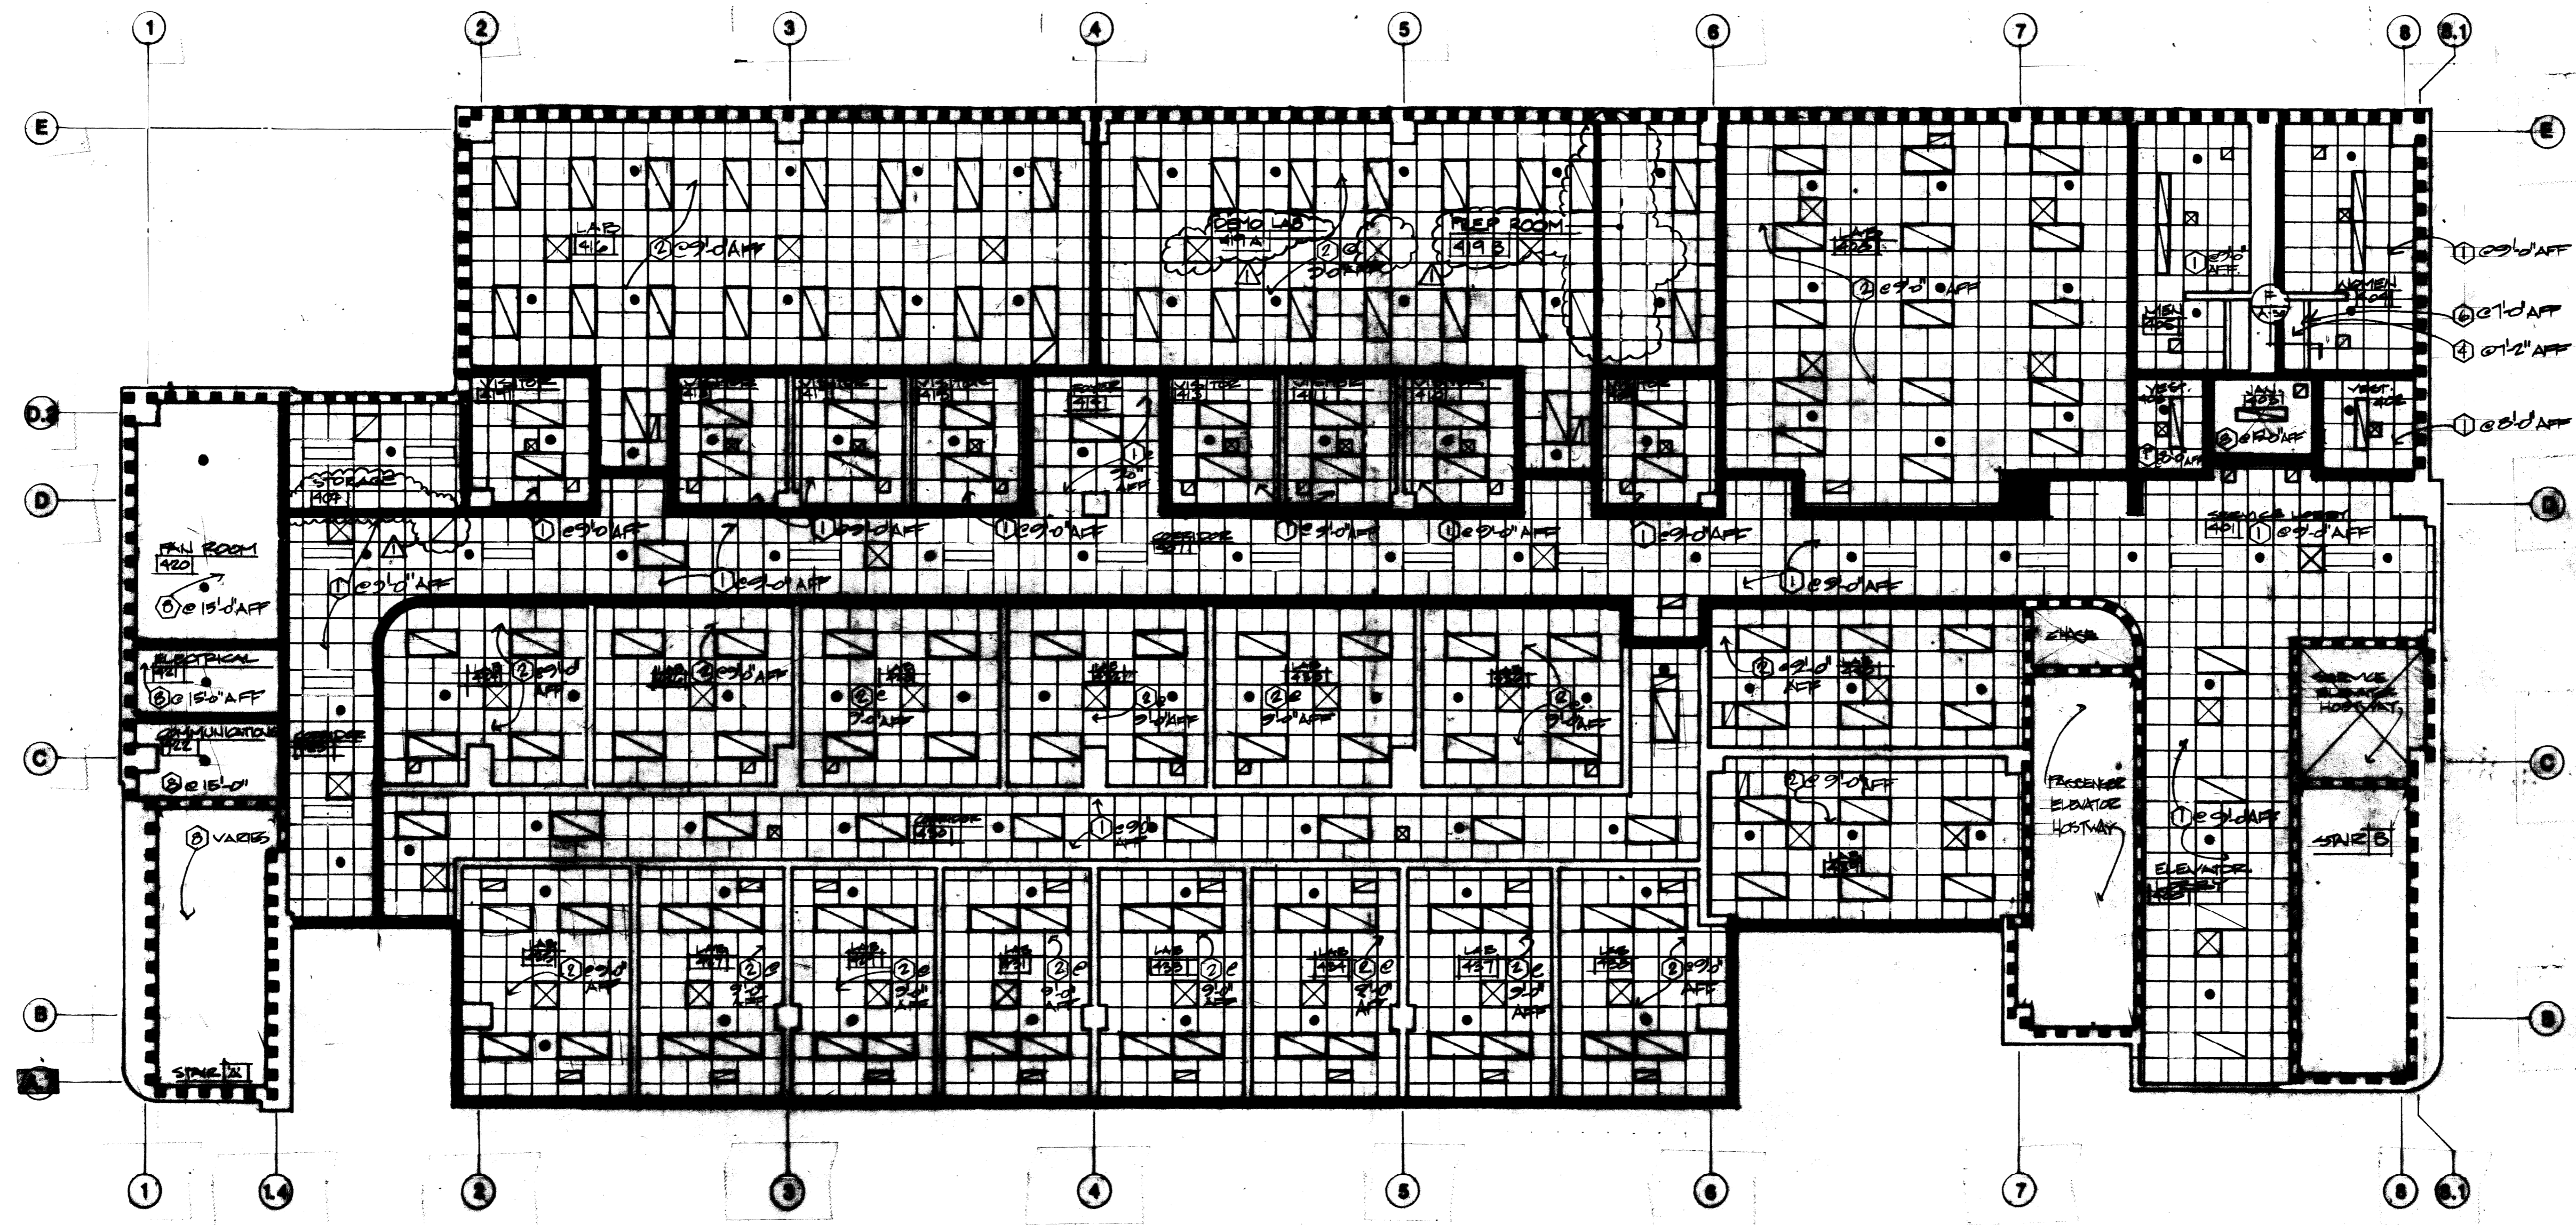

LEGEND


SHADE WALLS INDICATE WALLS WHICH EXTEND TO UNDERSIDE OF SLAB ABOVE, SEE DET. A/A-40.

DASHED WALLS INDICATE WALLS WHICH EXTEND TO UNDERSIDE OF SLAB ABOVE, SEE DET. B/A-40.

UNSHADED WALLS EXTEND ONE FULL BLOCK COURSE FOR ACTUAL PARTITIONS ABOVE ADJACENT CEILINGS.

NOTE: SEE MECHANICAL & ELECTRICAL DRAWING LEGEND SHEETS FOR SYMBOL DESIGNATIONS FOR DIFFUSERS, GRILLES, SPRINKLER HEADS, LIGHT FIXTURES, & OTHER ITEMS.


FOURTH FLOOR REFLECTED CEILING PLAN
1/8" = 1'-0"

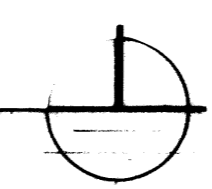

CEILING TYPES SCHEDULE	
1	2x2 SUSP. ACOUS. CEILING W/ EXPOSED GRID (TYPE A)
2	2x2 SUSP. ACOUS. CEILING W/ EXPOSED GRID (TYPE B)
3	2x4 SUSP. ACOUS. CEILING W/ EXPOSED GRID (TYPE B)
4	PARABOLIC LENS EGG CRATE
5	5/8" EXTERIOR GYP. BD. ON SUSPENSION SYSTEM
6	5/8" GYP. BD. ON METAL STUDS
7	ACOUS. PANELS ON METAL FURRING
8	EXPOSED STRUCTURE
9	PRE-FINISHED METAL PANEL

ABBREVIATIONS	
APP	ABOVE FINISHED FLOOR
ARR	ABOVE RAISED FLOOR

AS BUILT

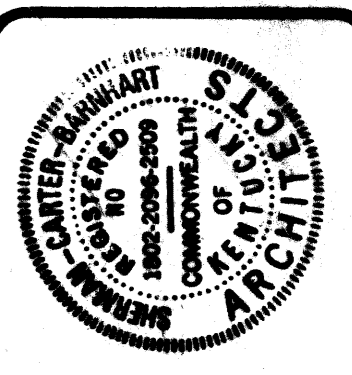

ROBOTICS FACILITY
LEXINGTON CAMPUS
UNIVERSITY OF KENTUCKY
LEXINGTON, KENTUCKY

University of Kentucky
Lexington, Kentucky

DESIGNED BY
Sherman Carter Barnhart
10-10-87


FOURTH FL. REF. CEILING PLAN

Sherman Carter Barnhart
PARTNERS IN ARCHITECTURE
SUITE 1900 • 250 WEST MAIN STREET • LEXINGTON, KY 40507 • 800-254-1351

JOB NO. 8788
DATE 10-1-87
DRAWN STAFF
CHECKED CEB
FILE NO. 431.0

REVISIONS
FEB 7 1990

SHEET
A-44
82 A-3 004929

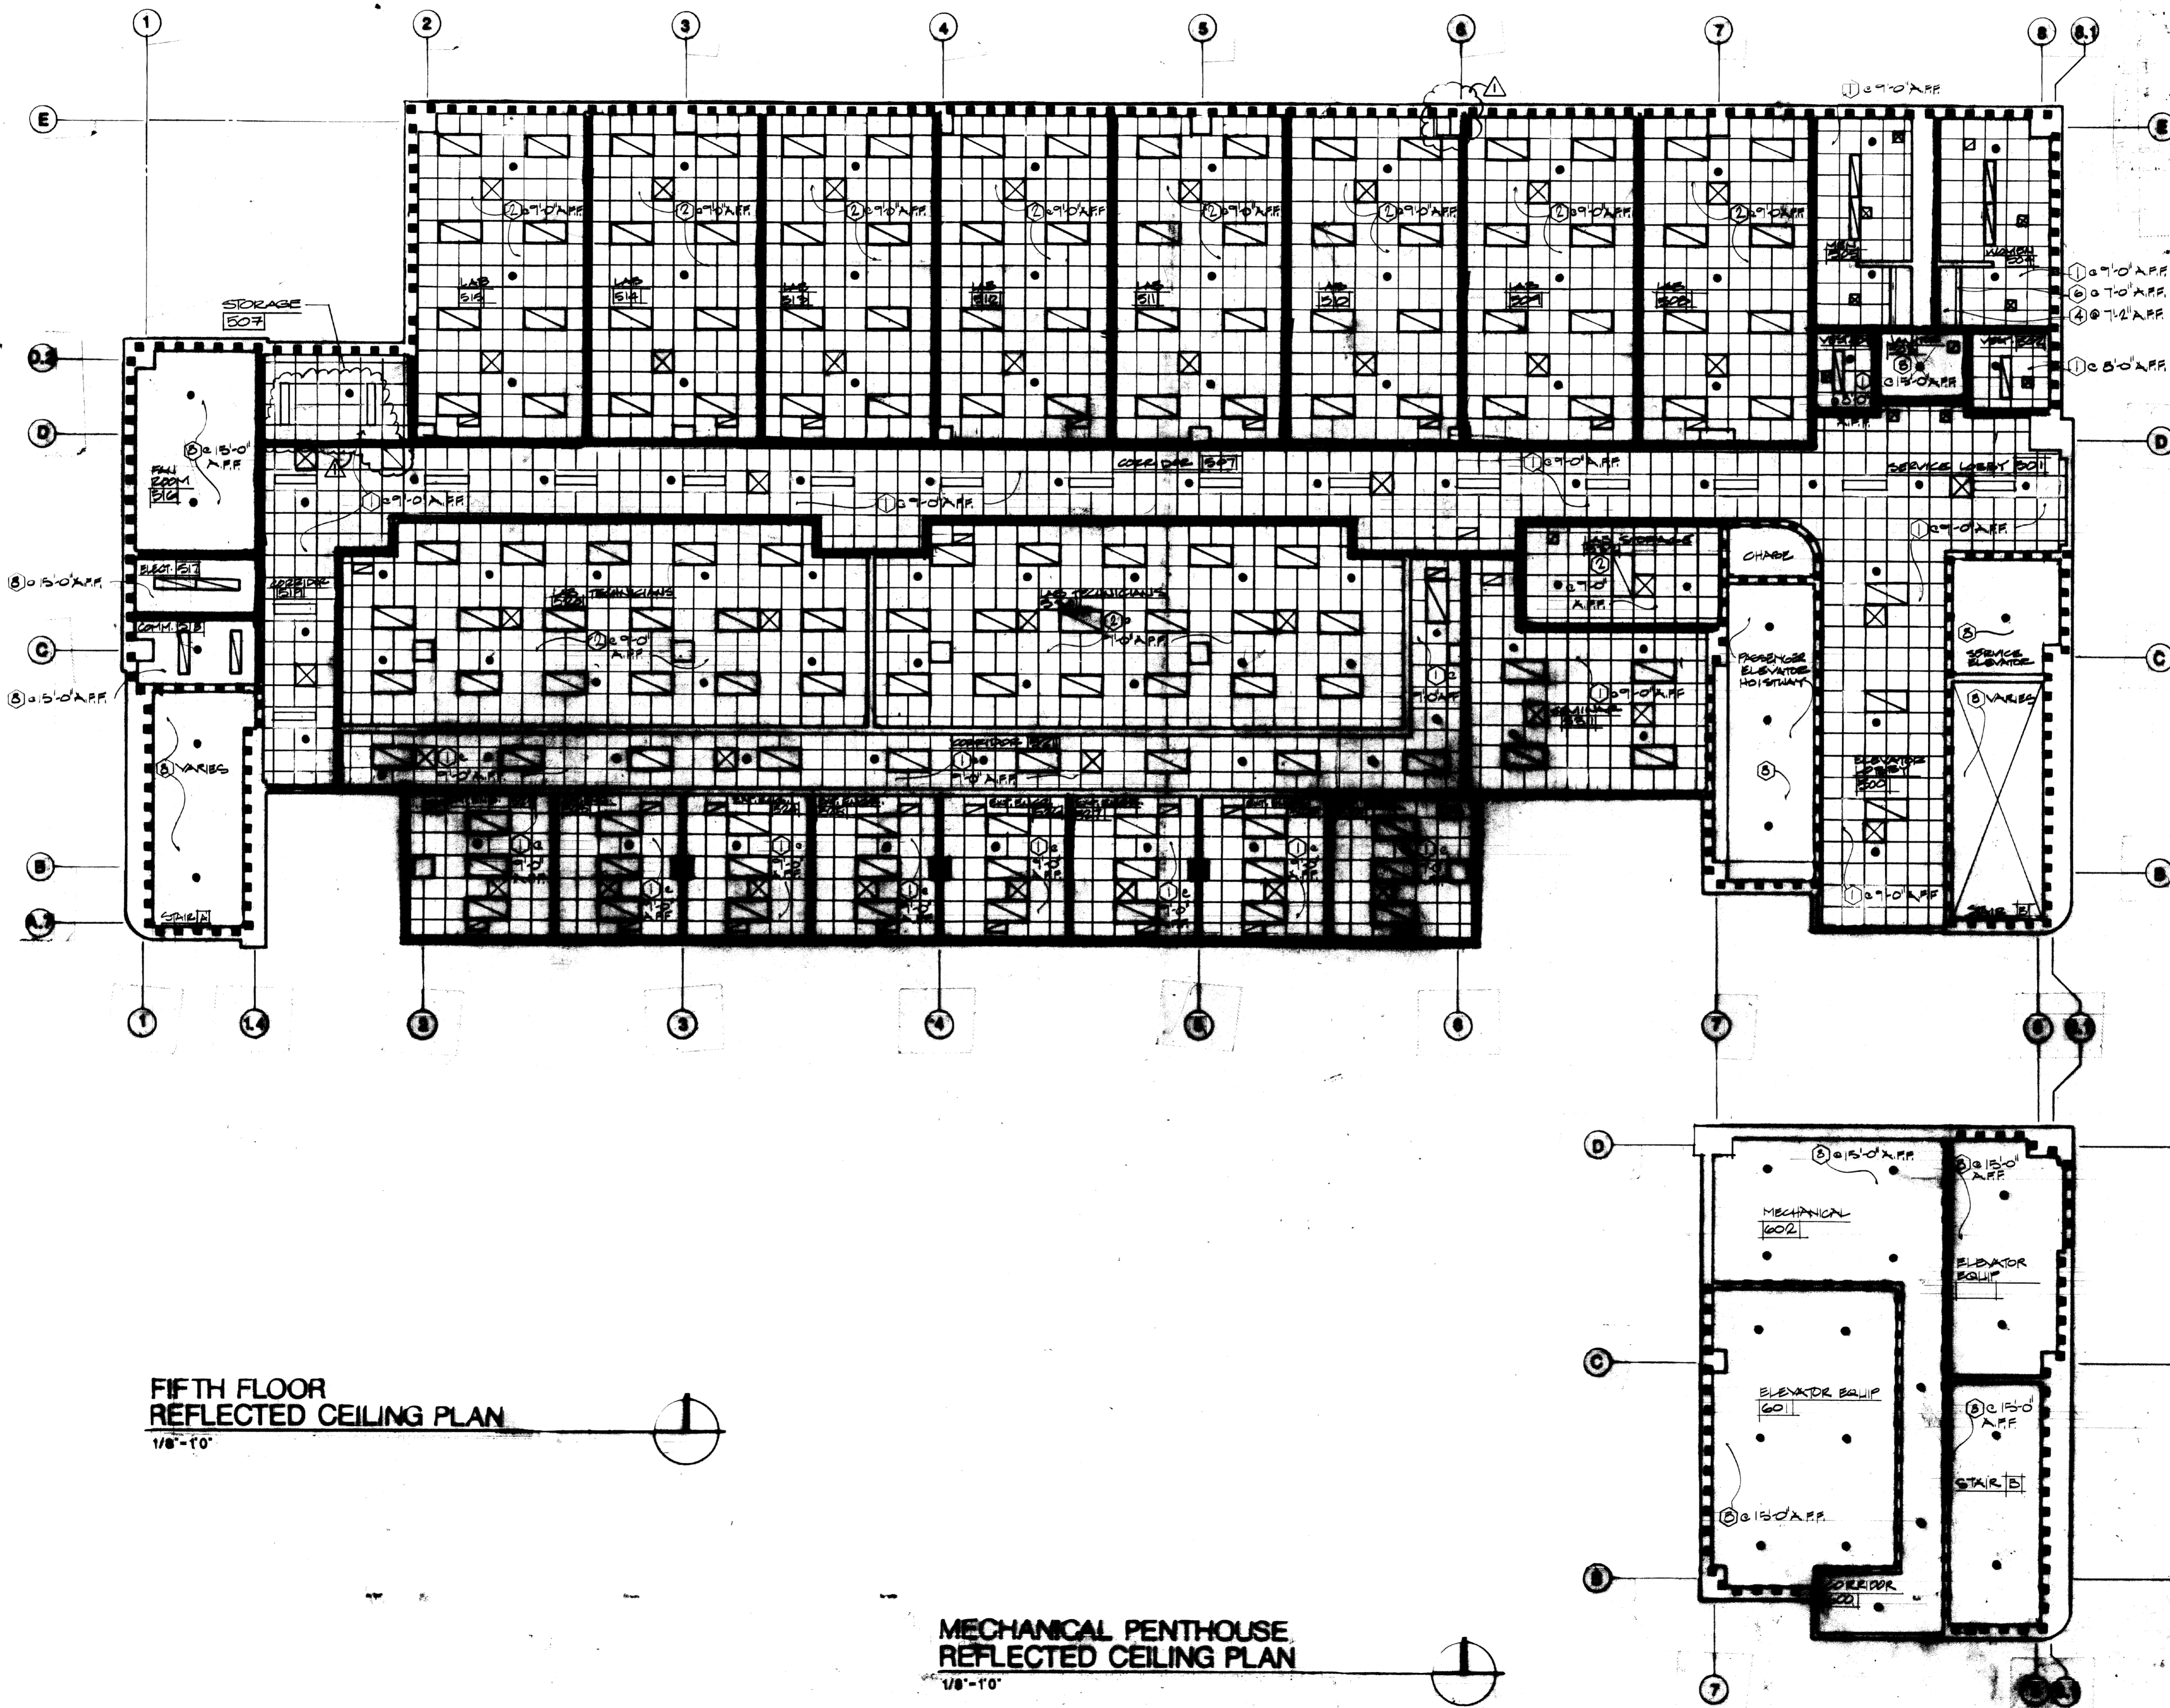

LEGEND

CHASE WALLS INDICATE WALLS WHICH EXTEND TO UNDERSIDES OF SLABS ABOVE. SEE DET. 9A-10.

FRONT WALLS INDICATE CHASE WALLS WHICH EXTEND TO UNDERSIDES OF SLABS ABOVE. SEE DET. 9A-10.

ENCLOSED WALLS EXTEND ONE FULL BLOCK ABOVE CO. 2' FOR CEILING FINISHES ABOVE ADJACENT CEILING.

NOTE: SEE MECHANICAL & ELECTRICAL DRAWING & LEGEND SHEETS FOR SYMBOL DESIGNATIONS FOR DIFFUSERS, GRILLES, SPRINKLER HEADS, LIGHT FIXTURES, & OTHER ITEMS.

CEILING TYPES SCHEDULE

- 1 2x2 SUSP. ACOUS. CEILING w/ EXPOSED GRID (TYPE A)
- 2 2x2 SUSP. ACOUS. CEILING w/ EXPOSED GRID (TYPE B)
- 3 2x4 SUSP. ACOUS. CEILING w/ EXPOSED GRID (TYPE B)
- 4 PARABOLIC LENS EGG CRATE
- 5 5/8" EXTERIOR GYP. BD. ON SUSPENSION SYSTEM
- 6 5/8" GYP. BD. ON METAL STUDS
- 7 ACOUS. PANELS ON METAL FURRING
- 8 EXPOSED STRUCTURE
- 9 PRE-FINISHED METAL PANEL

ABBREVIATIONS

AFF-ABOVE FINISHED FLOOR
ARF-ABOVE RAISED FLOOR

FIFTH FLOOR REFLECTED CEILING PLAN
1/8" = 1'-0"

MECHANICAL PENTHOUSE REFLECTED CEILING PLAN
1/8" = 1'-0"

AS BUILT



ROBOTICS FACILITY
LEXINGTON CAMPUS
UNIVERSITY OF KENTUCKY
LEXINGTON, KENTUCKY

University of Kentucky
Lexington, Kentucky

10-10-87

FIFTH FLOOR REFLECTED CEILING PLAN

Sherman Carter Barnhart
PARTNERS IN ARCHITECTURE
SUITE 1900 • 230 WEST MAIN STREET • LEXINGTON, KY 40507 • 502-254-1951

JOB NO.	8758
DATE	10-1-87
DRAWN	BRADY
CHECKED	CEB
FILE NO.	431.6

REVISIONS
1. 10-7-87

SHEET	A-45
-------	------

ROBOTICS FACILITY

PROJECT NO. 431.0

UNIVERSITY OF KENTUCKY

LEXINGTON, KENTUCKY

SHERMAN / CARTER / BARNHART

SUITE 1900 LEXINGTON FINANCIAL CENTER
250 WEST MAIN STREET
LEXINGTON, KENTUCKY 40507

MASON & HANGER ENGINEERING, INC

1500 WEST MAIN STREET
LEXINGTON, KENTUCKY 40507

BELCAN CORPORATION

10200 ANDERSON WAY
CINCINNATI, OHIO 45242

JAMES B. EVANS & ASSOCIATES



628 NORTH BROADWAY
LEXINGTON, KENTUCKY 40507

ARCHITECT

STRUCTURAL ENGINEER
CIVIL ENGINEER

MECHANICAL ENGINEER
ELECTRICAL ENGINEER

LANDSCAPE ARCHITECT

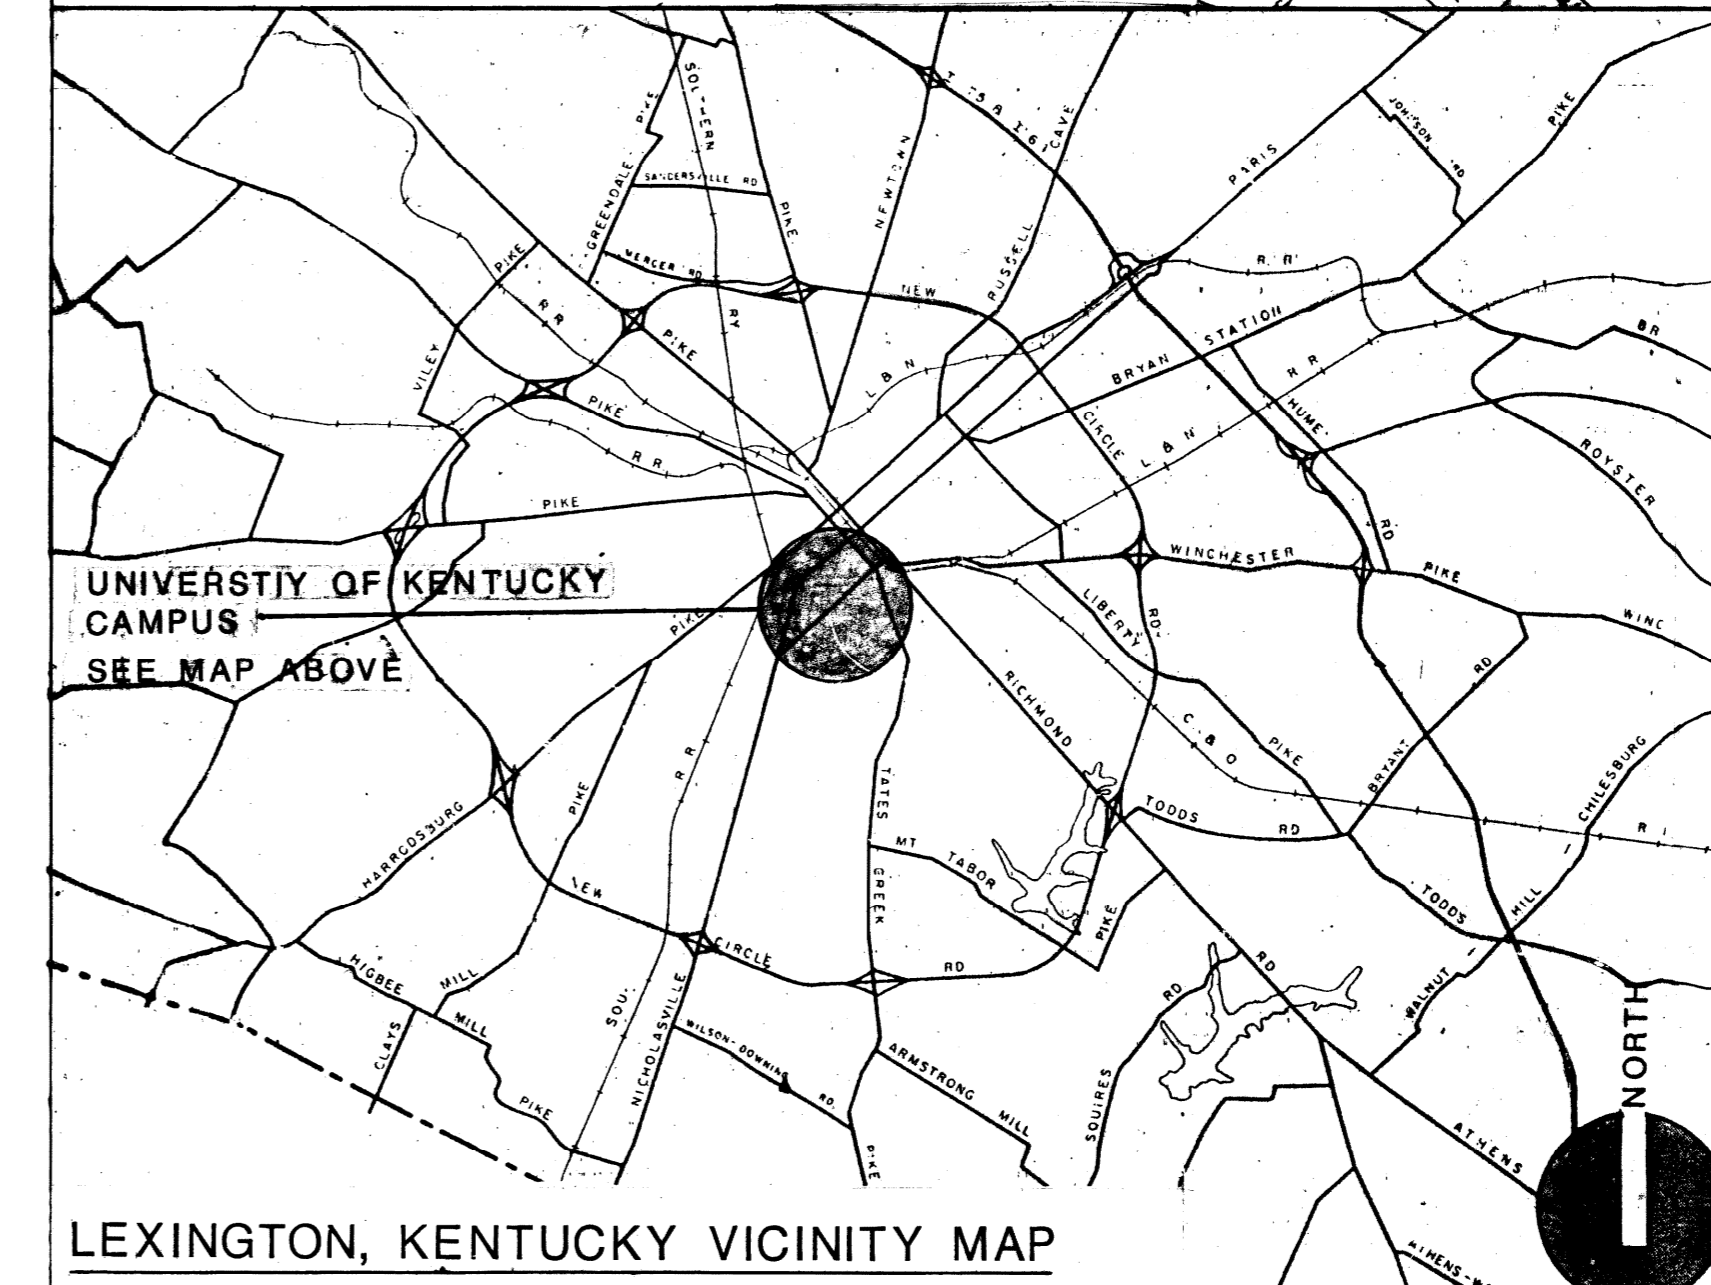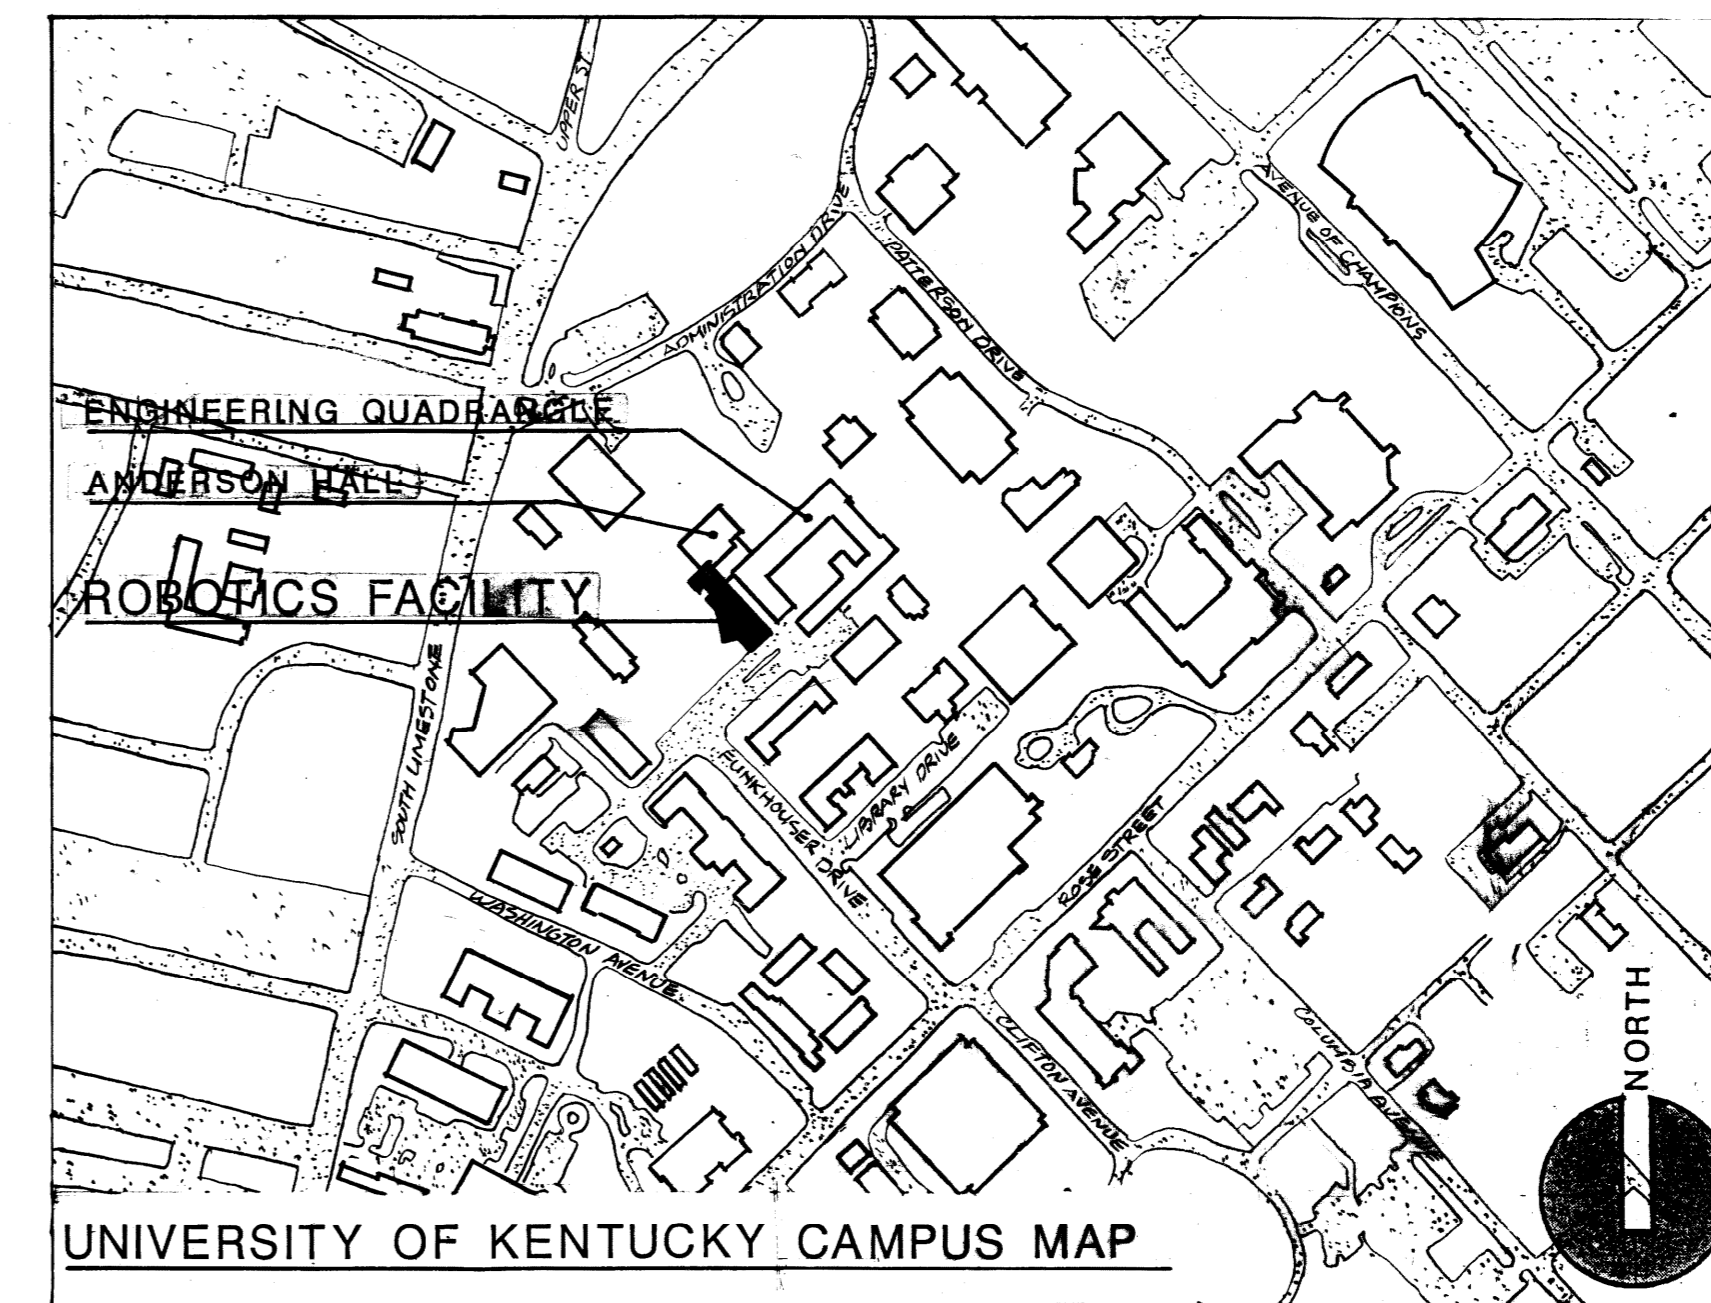

AS BUILT

BUILDING STATISTICS

- KENTUCKY BUILDING CODE (KBC) COMPLIANCE 1985 (3RD EDITION)
- USE GROUP (B) BUSINESS (LABORATORIES; TESTING & RESEARCH)
- BUILDING CLASSIFICATION 1B
- GROSS SQUARE FOOTAGE 74,183 SQ. FEET

BUILDING INCLUDES:

- SMOKE DETECTORS
- SPRINKLERS
- EMERGENCY LIGHTING WITH EMERGENCY GENERATOR
- OCCUPANT LOAD 575

BUILDING "R" VALUES	
Built-up Roof	24.14
Terrace Roof	17.2
Masonry Walls (Type A & B)	11.2
Metal Panel Walls	13.08
Curtainwall A & B	13.64
Spandrels	13.64
Vision Glass	1.8

DATE

PROJECT

SET NO.



ROBOTICS FACILITY
LEXINGTON CAMPUS
UNIVERSITY OF KENTUCKY
LEXINGTON, KENTUCKY

University of Kentucky
Lexington, Kentucky
10-19-87
DATE

LEGEND
Shelton Carter - Barnhart
PARTNERS IN ARCHITECTURE
1001 MAIN STREET, SUITE 200, LEXINGTON, KY 40502

JOB NO. **8706**
DATE **10-16-87**
DRAWN **WE CASE**
CHECKED
OK FILE NO. **431-0**


REVISIONS
3 - 90% REVIEW

SHEET


M-1
SHEET

"This seal and signature apply only to the unaltered document to which they are affixed. I expressly disclaim any responsibility for any and all changes made after the issue date, for other plans, specifications, estimates, reports or other documents or instruments relating to or intended to be used for any part or portion of the architectural or engineering project or survey."
SINGLE LINE

DUCTWORK SYMBOLS

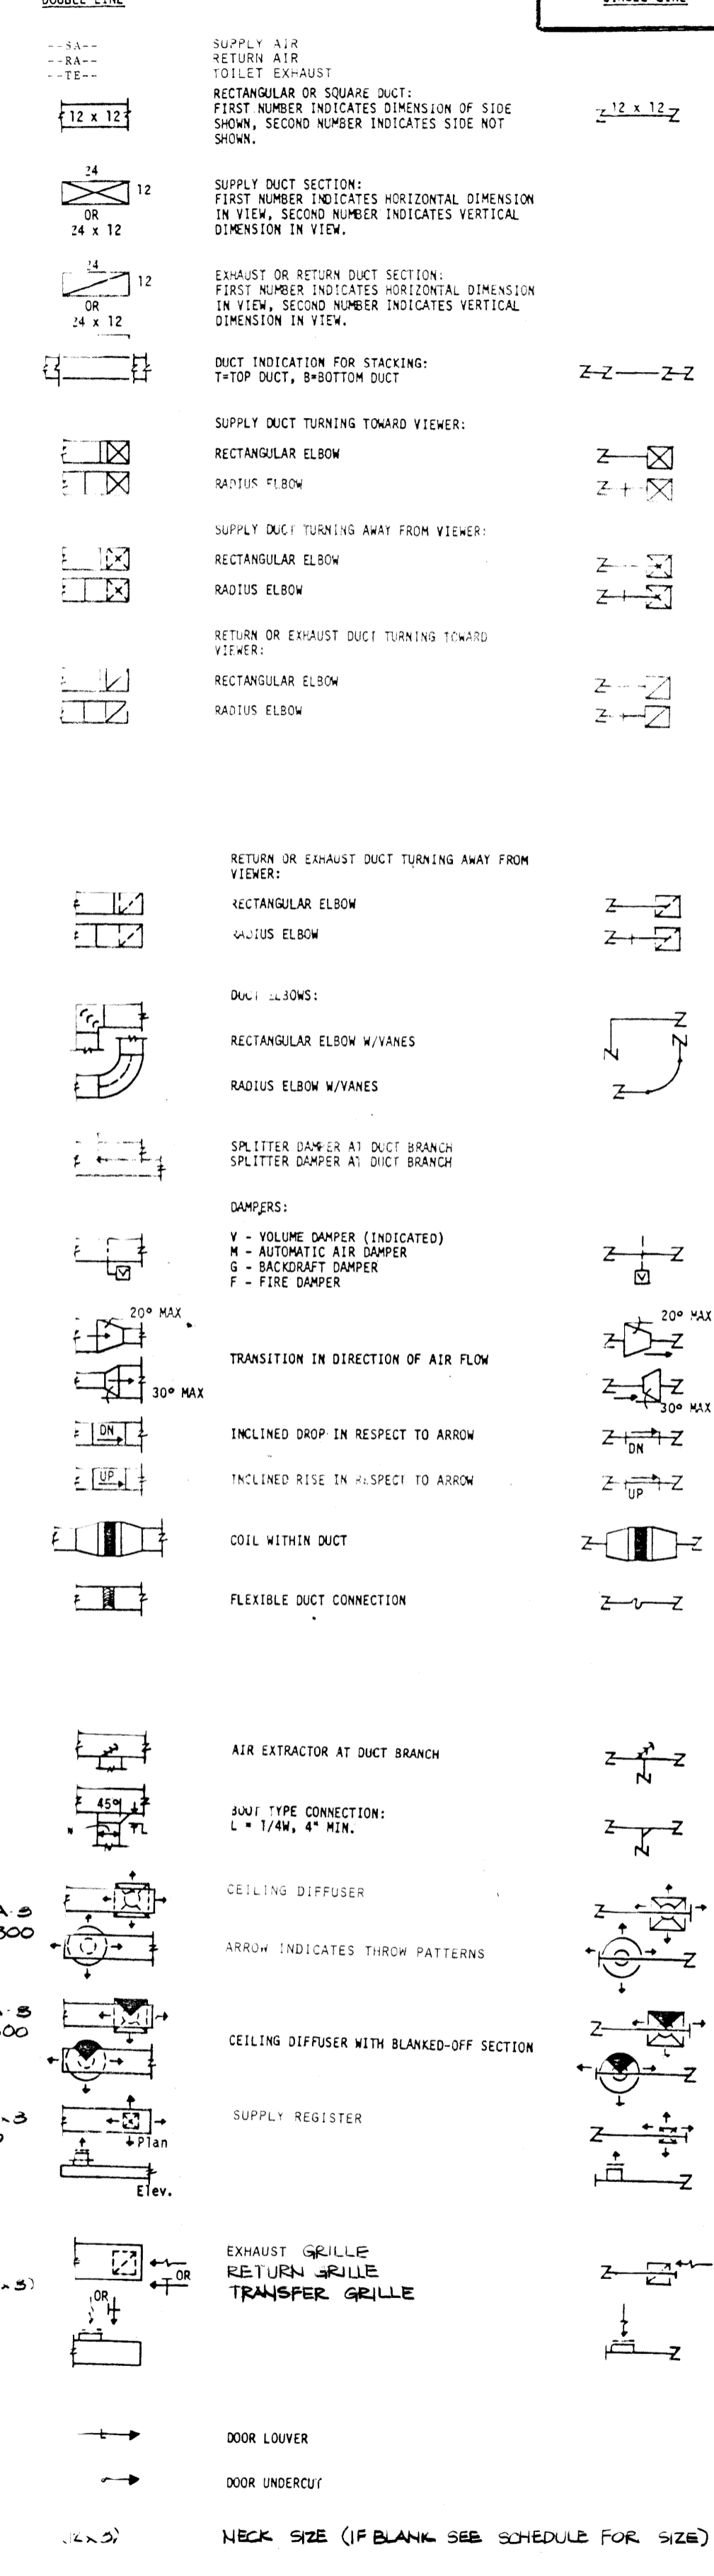

DUCTWORK SYMBOLS

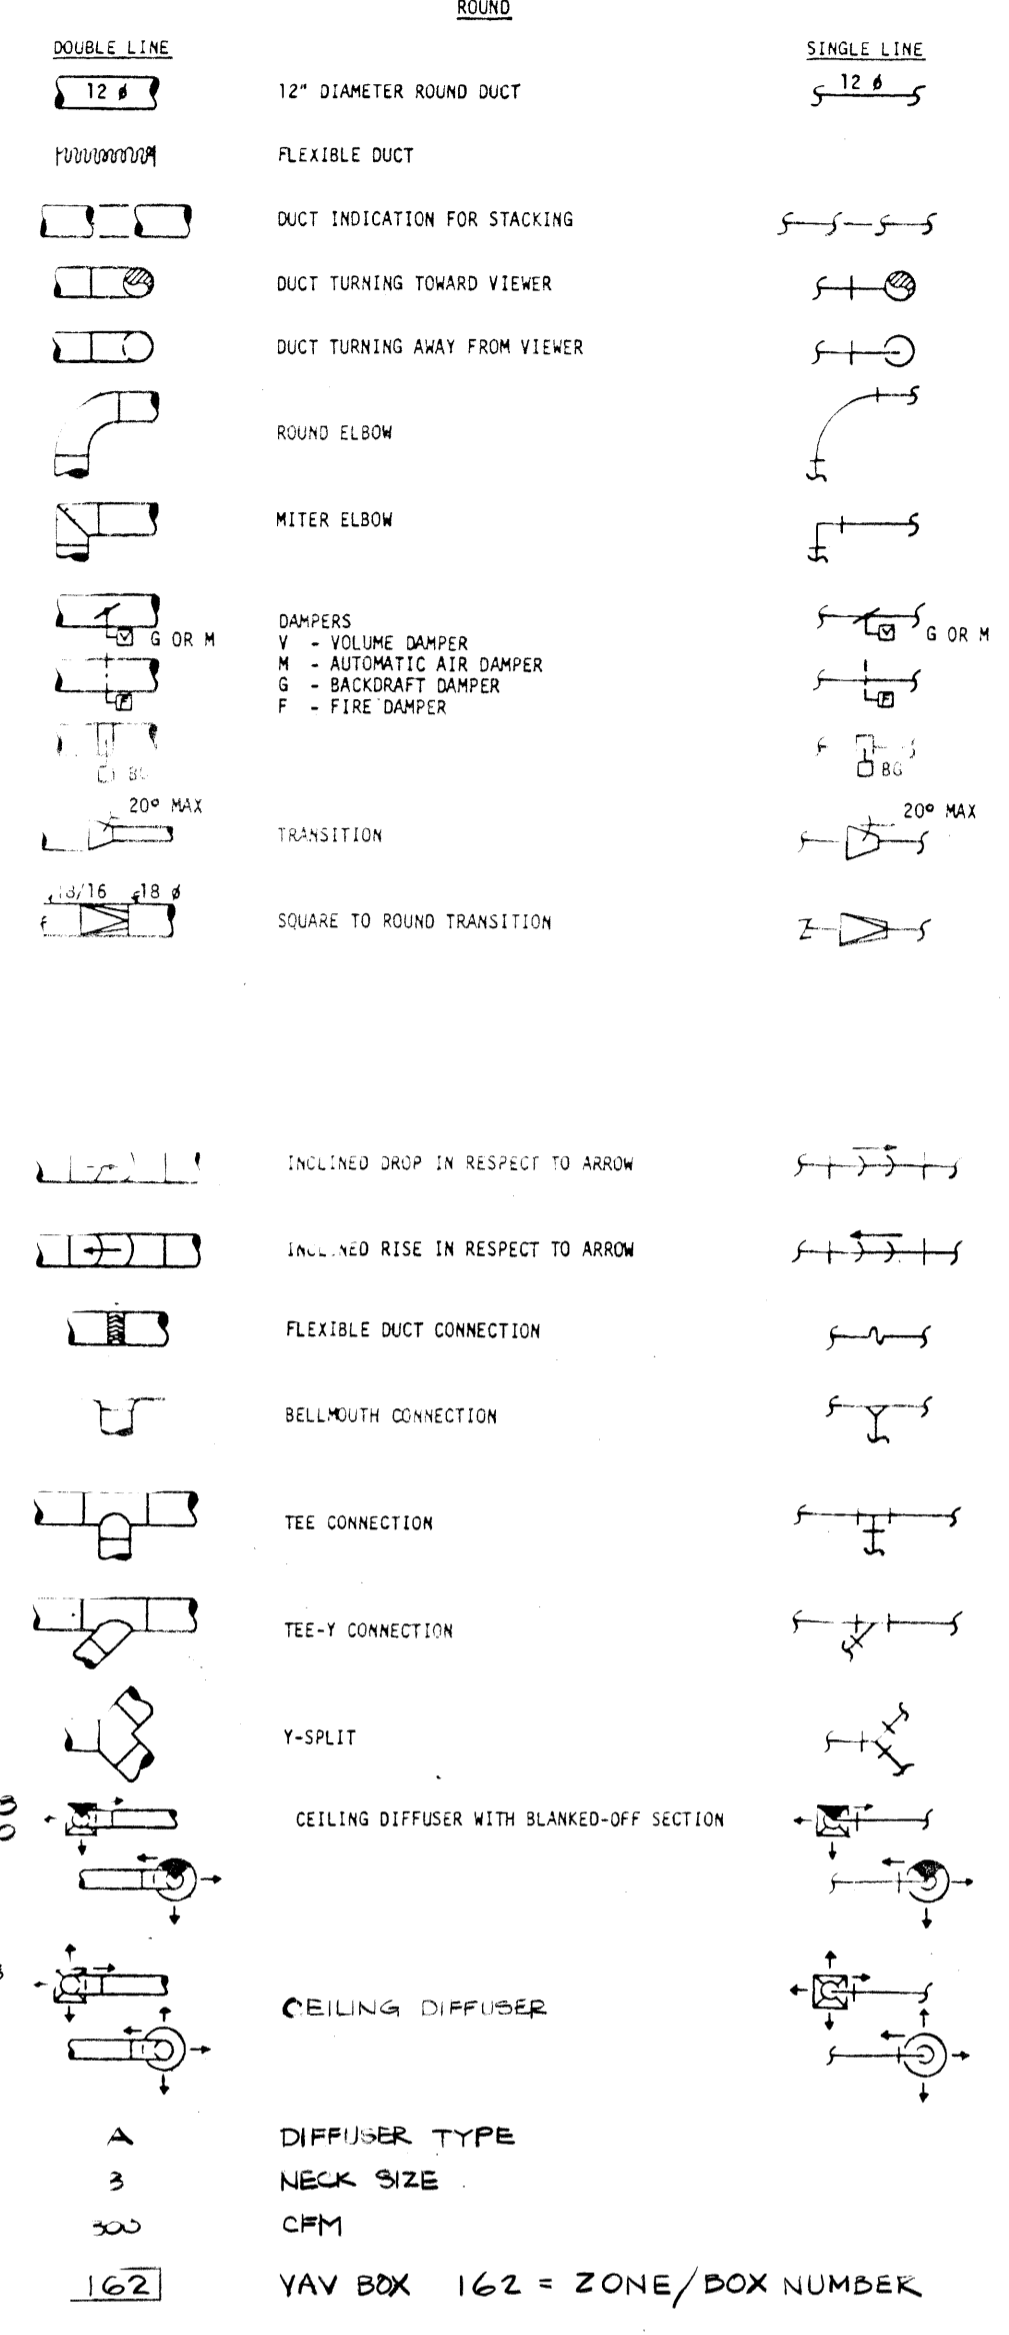

STEAM REQUIREMENTS
NORMAL - 3,700,000 BTU/H
UNDER SHOCK CONDITION - 2,500,000 BTU/H

COOLING LOAD - 2,631,000 BTU/H PRESENT; 3,333,000 BTU/H FUTURE

CHILLED WATER FLOW - 415.8 GPM PRESENT; 555.6 FUTURE

DESIGN CONDITIONS:
OUTSIDE
SUMMER - 95°F DB / 73°F WB
WINTER - 3°F DB
INSIDE
OFFICE, CLASS, ETC. - 75°F DB / 65°F WB / 40% RH / NOT CONTROLLED-COOLING
COMPUTER ROOM - 70°F DB / 65°F WB / 45% RH / 5%
FILE STORAGE ROOM - 75°F DB / 65°F WB / 50% RH / NOT CONTROLLED

OVERALL BUILDING THERMAL TRANSMITTANCE (UO) - 1/7 BTU / (HR · SQ FT · °F)

GROSS BUILDING SQUARE FOOTAGE - 74,183 SQ. FT.
GROSS BUILDING EXT. SURFACE AREA - 510,000 SQ. FT.

ABBREVIATIONS FOR DRAWINGS

ABBREVIATION	DESCRIPTION
AC	AIR CONDITIONING UNIT
A COMP	AIR COMPRESSOR
AD	ACCESS DOOR
AF	ABOVE FINISH FLOOR
AH	AIR HANDLING UNIT
AP	ACCESS PANEL
BD	BOTTOM OF DUCT
SUP	BOTTOM OF PIPE
BT	BUTTON
CC	COOLING COIL
CD	CEILING DIFFUSER
CFM	CUBIC FEET PER MINUTE
CH	CHILLER
CHWP	CHILLED WATER PUMP
CL	CLEANOUT
DB	DOOR BRILLE
Ø	DIAMETER
DN	DOWN
DR	DRAINING
EA	EXHAUST AIR
EA	EXHAUST AIR TOILET
EA	EXHAUST AIR LOUVER
EA	EXHAUST AIR REGISTER
EA	EXHAUST FAN
EA	EXHAUST WATER COOLER
EL	ELECTRICAL
GL	GLYCOL SUPPLY
GLR	GLYCOL RETURN
HC	FIRE HOSE COUPLER
HP	FUEL OIL PUMP
FP	FIRE PUMP
HC	HEATING COIL
HUM	HUMIDIFIER
HV	HEATING AND VENTILATING UNIT
HW	HOT WATER CIRCULATING PUMP
HW	HOT WATER HEATING PUMP
LEV	INVERT ELEVATION
LAV	LAVATORY
L	LINEAR DIFFUSER
MB	MAN SERVICE BASIN
NS	NOT TO SCALE
NS	NO SIDE AIR
OL	OUTSIDE AIR INTAKE LOUVER
RA	RETURN AIR
RA	RELIEF AIR LOUVER
RA	RADIUS
RA	RETURN AIR GRILLE
RA	RETURN AIR REGISTER
RA	TOILET FAN
RA	SUPPLY AIR
RA	SUPPLY AIR REGISTER
RA	STEAM CONDENSATE PUMP
RA	SUPPLY FAN
RA	SOUND TRAP
RA	TRANSFER AIR GRILLE
RA	URINAL
RA	UNIT HEATER
RA	VARIABLE AIR VOLUME BOX
RA	WATER CLOSET
HW	PACKAGE HOT WATER HEATING SYSTEM
DWP	DOMESTIC WATER PUMP
DHWP	DOMESTIC HOT WATER PUMP
DHWRP	DOMESTIC HOT WATER RECIRCULATING PUMP
FHC	FIRE HOSE CONNECTION
VTR	VENT THRU ROOF


PIPING LEGEND

SYMBOL	ABBREVIATION	DESCRIPTION
---	CM	CITY WATER (DOMESTIC)
---	HW	HOT WATER
---	HW	HOT WATER CIRCULATING
---	SAN	SANITARY SOIL OR WASTE
---	SAN V	SANITARY VENT
---	STR	STORM DRAIN
---	CA	COMPRESSED AIR
---	G	NATURAL GAS
---	F	FIRE PROTECTION WATER
---	DR	DRAIN FROM EQUIPMENT
---	CHS	CHILLED WATER SUPPLY
---	CHR	CHILLED WATER RETURN
---	HPS	HIGH PRESSURE STEAM (175 PSIG)
---	LPS	LOW PRESSURE STEAM (15 PSIG)
---	HWS	HOT WATER HEATING SUPPLY
---	HWR	HOT WATER HEATING RETURN
---	HPC	HIGH PRESSURE CONDENSATE
---	LPC	LOW PRESSURE CONDENSATE
---	PC	PIPE CONDENSATE
---	SV	STEAM OR SAFETY RELIEF VENT
---	FOS	FUEL OIL SUPPLY
---	FOR	FUEL OIL RETURN
---	FOV	FUEL OIL VENT
---	PC	PIPE CAP
---	PCW	PUMPED CITY WATER
---	PHW	PUMPED HOT WATER
---	PHWC	PUMPED HOT WATER CIRCULATING
---	90°	90° ELBOW UP
---	TEE	TEE DOWN
---	TEE	TEE UP
---	---	PIPE OFFSETTING DOWN IN RESPECT TO ARROW
---	---	PIPE OFFSETTING UP IN RESPECT TO ARROW
---	---	PIPE FLANGES
---	EXP.	EXPANSION VALVE
---	ANC	ANCHOR
---	---	ECCENTRIC REDUCER OR INCREASER
---	---	CONCENTRIC REDUCER OR INCREASER
---	---	DIRECTION OF FLOW ARROW
---	UN	UNION
---	S/R	STRAINER (WYE TYPE)
---	STP	STRAINER (WYE TYPE) WITH 3/4" BLOWOFF VALVE, PIPE TO FLOOR DRAIN
---	GV	GATE VALVE
---	GLV	GLOBE VALVE
---	CV	CHECK VALVE
---	BFV	BUTTERFLY VALVE
---	PV	PLUG VALVE
---	---	CIRCUIT SETTER
---	---	CIRCUIT SENSOR
---	BV	BALL VALVE
---	SV	RELIEF OR SAFETY VALVE
---	CV-2	CONTROL VALVE - TWO WAY
---	CV-3	CONTROL VALVE - THREE WAY
---	PRV	PRESSURE REDUCING VALVE
---	TI	TEMPERATURE INDICATOR WITH THERMOMETER WELL
---	PI	PRESSURE INDICATOR WITH SIPHON AND GAGE COCK
---	AV	AIR VENT - MAV = MANUAL AIR VENT AAV = AUTOMATIC AIR VENT TAV = THERMOSTATIC AIR VENT
---	VB	VACUUM BREAKER
---	FT	STEAM TRAP (FLOAT & THERMOSTATIC)
---	---	DRAIN - FD - FLOOR DRAIN AD - AREA DRAIN RD - ROOF DRAIN
---	INV	INVERTED BUCKET TRAP
---	HO	HUB JOULET
---	BP	BACKFLOW PREVENTER - REDUCED PRESSURE TYPE
---	HB	HOSE BIBB
---	---	COMPRESSED AIR OUTLET

AS BUILT

BELCAN CORPORATION
10200 ANDERSON WAY
CINCINNATI, OHIO 45242
NUMBER: 4361-CM-001-3

"This seal and signature apply only to the unaltered document to which they are affixed. I expressly disclaim any responsibility for any and all changes made after the issue date, for other plans, specifications, estimates, reports or other documents or instruments relating to or intended to be used for any part or portion of the architectural or engineering project or survey."

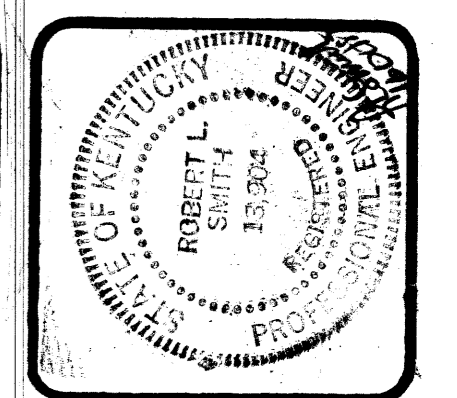

ROBOTICS FACILITY
LEXINGTON CAMPUS
UNIVERSITY OF KENTUCKY
LEXINGTON, KENTUCKY

University of Kentucky
Lexington, Kentucky
10-19-87
DATE



BASEMENT HVAC PLAN
Sherman Carter Barnhart
PARTNERS IN ARCHITECTURE
SUITE 1900 • 250 WEST MAIN STREET • LEXINGTON KY 40507 • 805-254-1351

JOB NO. **3706**
DATE **10-16-87**
DRAWN **KE CASE**
CHECKED **KILG**
FILE NO. **4376**

REVISIONS
3 - 90% REVIEW

SHEET
M-2

BELCAN CORPORATION
10200 ANDERSON WAY
CINCINNATI, OHIO 45242
NUMBER: **4301-CM-002-3**

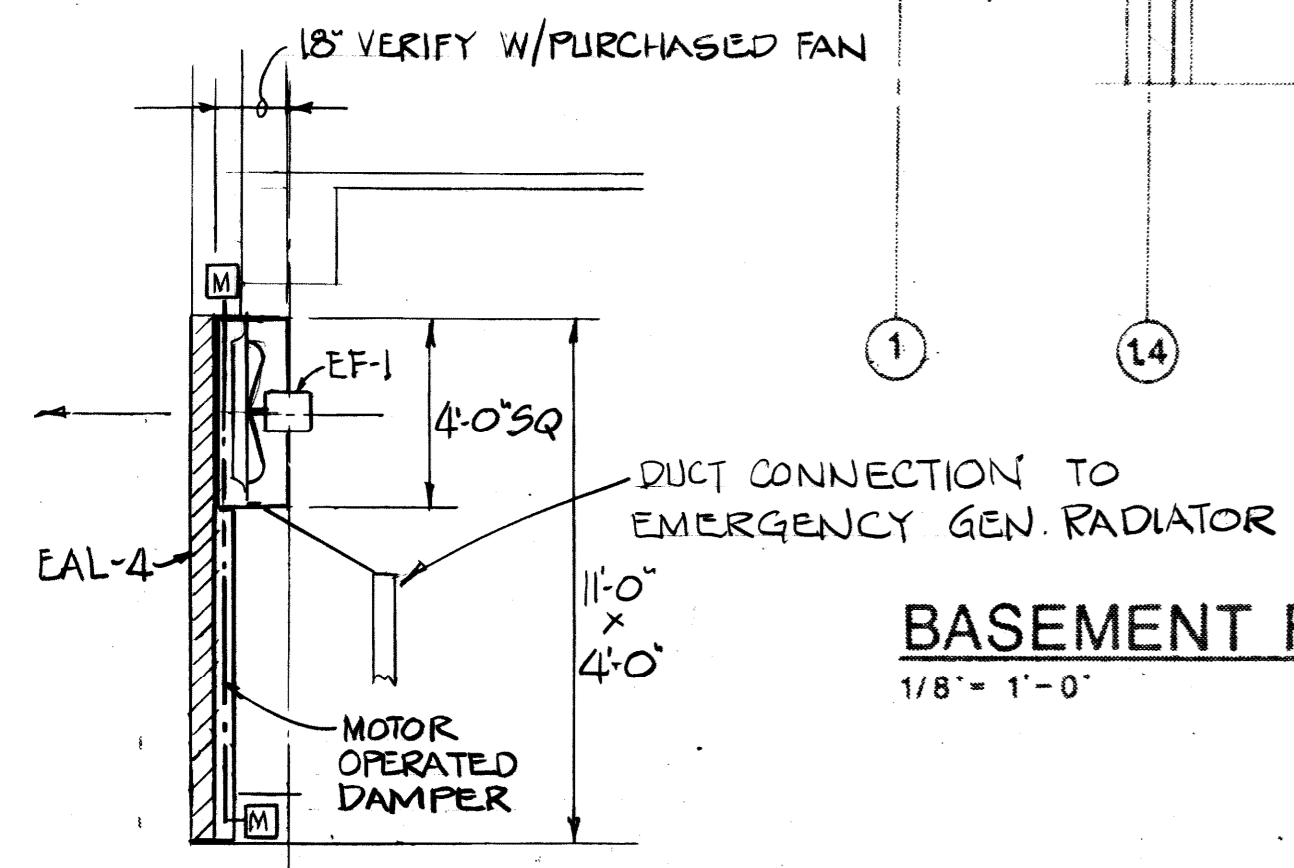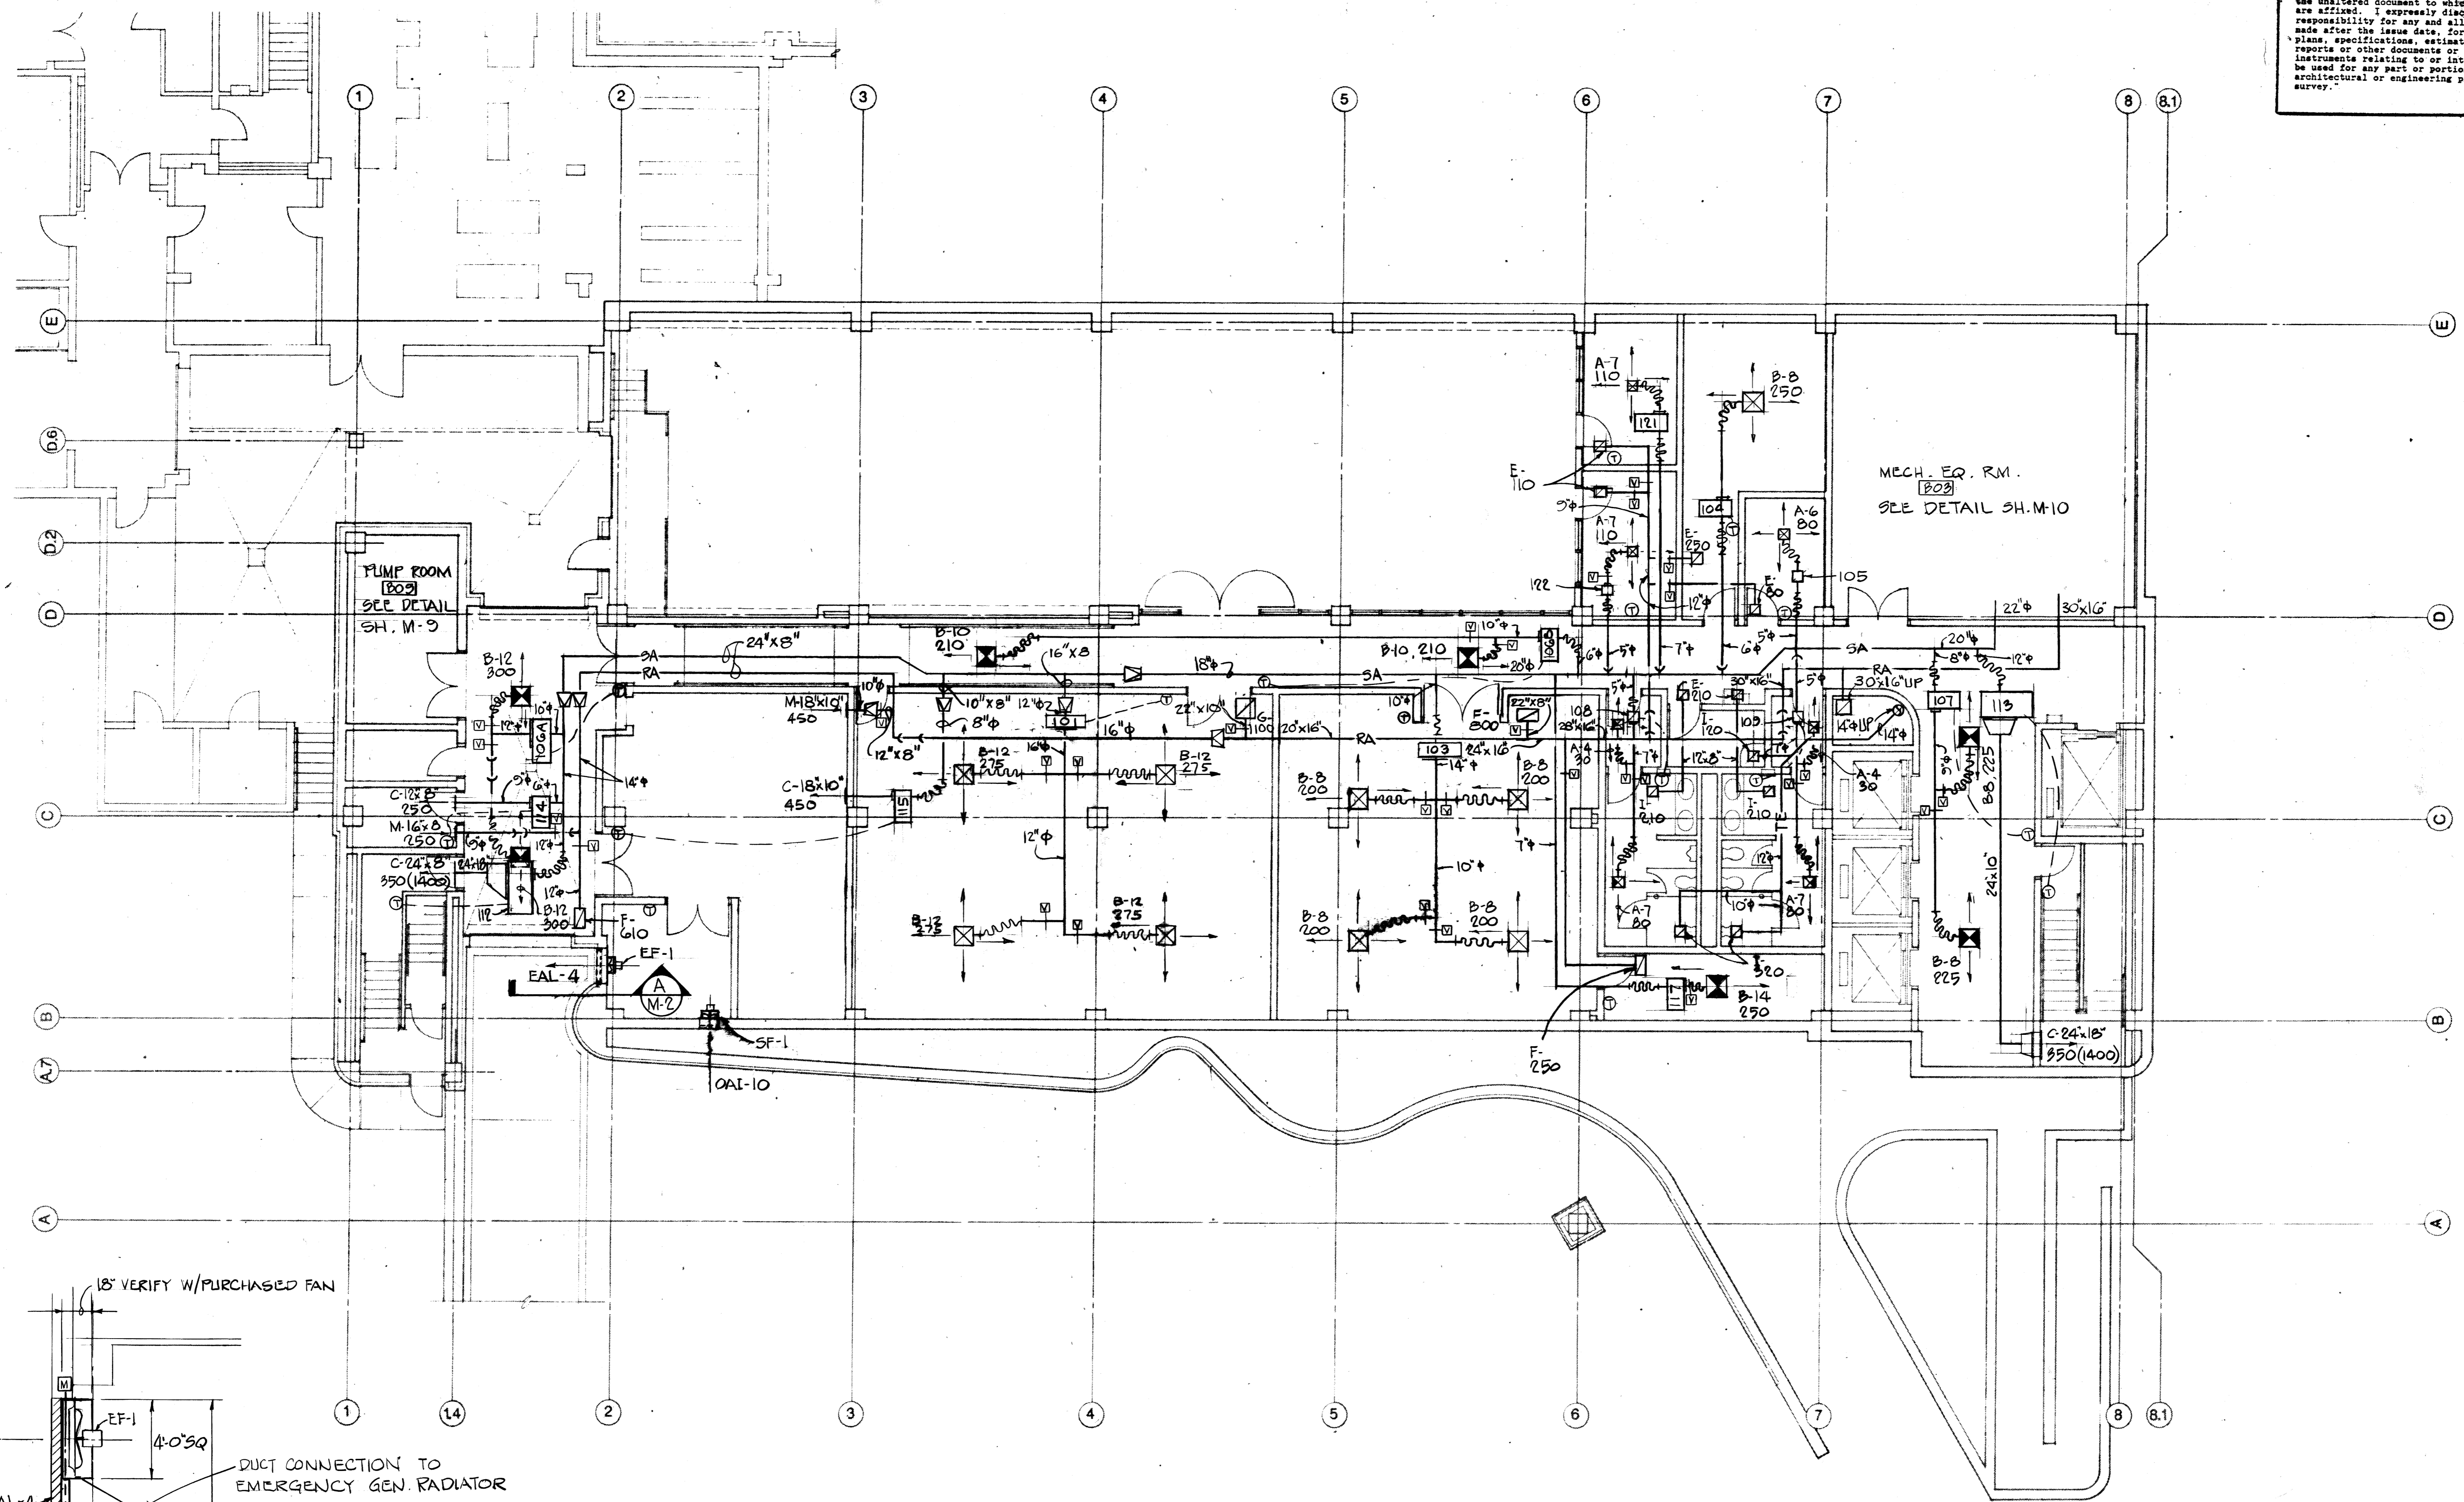


BASEMENT FLOOR PLAN
1/8" = 1'-0"
BLDG. NORTH

SECTION A-M2
SCALE: 1/4" = 1'-0"

AS BUILT

This seal and signature apply only to the unaltered document to which they are affixed. I expressly disclaim any responsibility for any and all changes made after the issue date, for other plans, specifications, estimates, reports or other documents or instruments relating to or assigned to be used for any part or portion of the architectural or engineering project or survey.

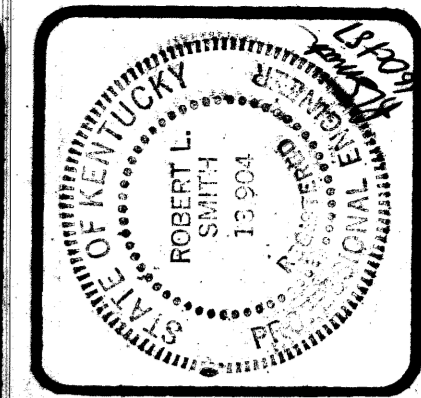

ROBOTICS FACILITY
 LEXINGTON CAMPUS
 UNIVERSITY OF KENTUCKY
 LEXINGTON, KENTUCKY


University of Kentucky
 Lexington, Kentucky
 10.19.87
 Robert Smith

1ST FLOOR PLAN
 Sherman Carter Barnhart
 PARTNERS IN ARCHITECTURE
 SUITE 1000 • 250 WEST MAIN STREET • LEXINGTON KY 40507 • 606-254-1351

JOB NO. **B706**
 DATE **10-16-87**
 DRAWN BY **THOMAS**
 CHECKED **MS**
 FILE NO. **436**



REVISIONS
 3-90% REVIEW

SHEET
M-3

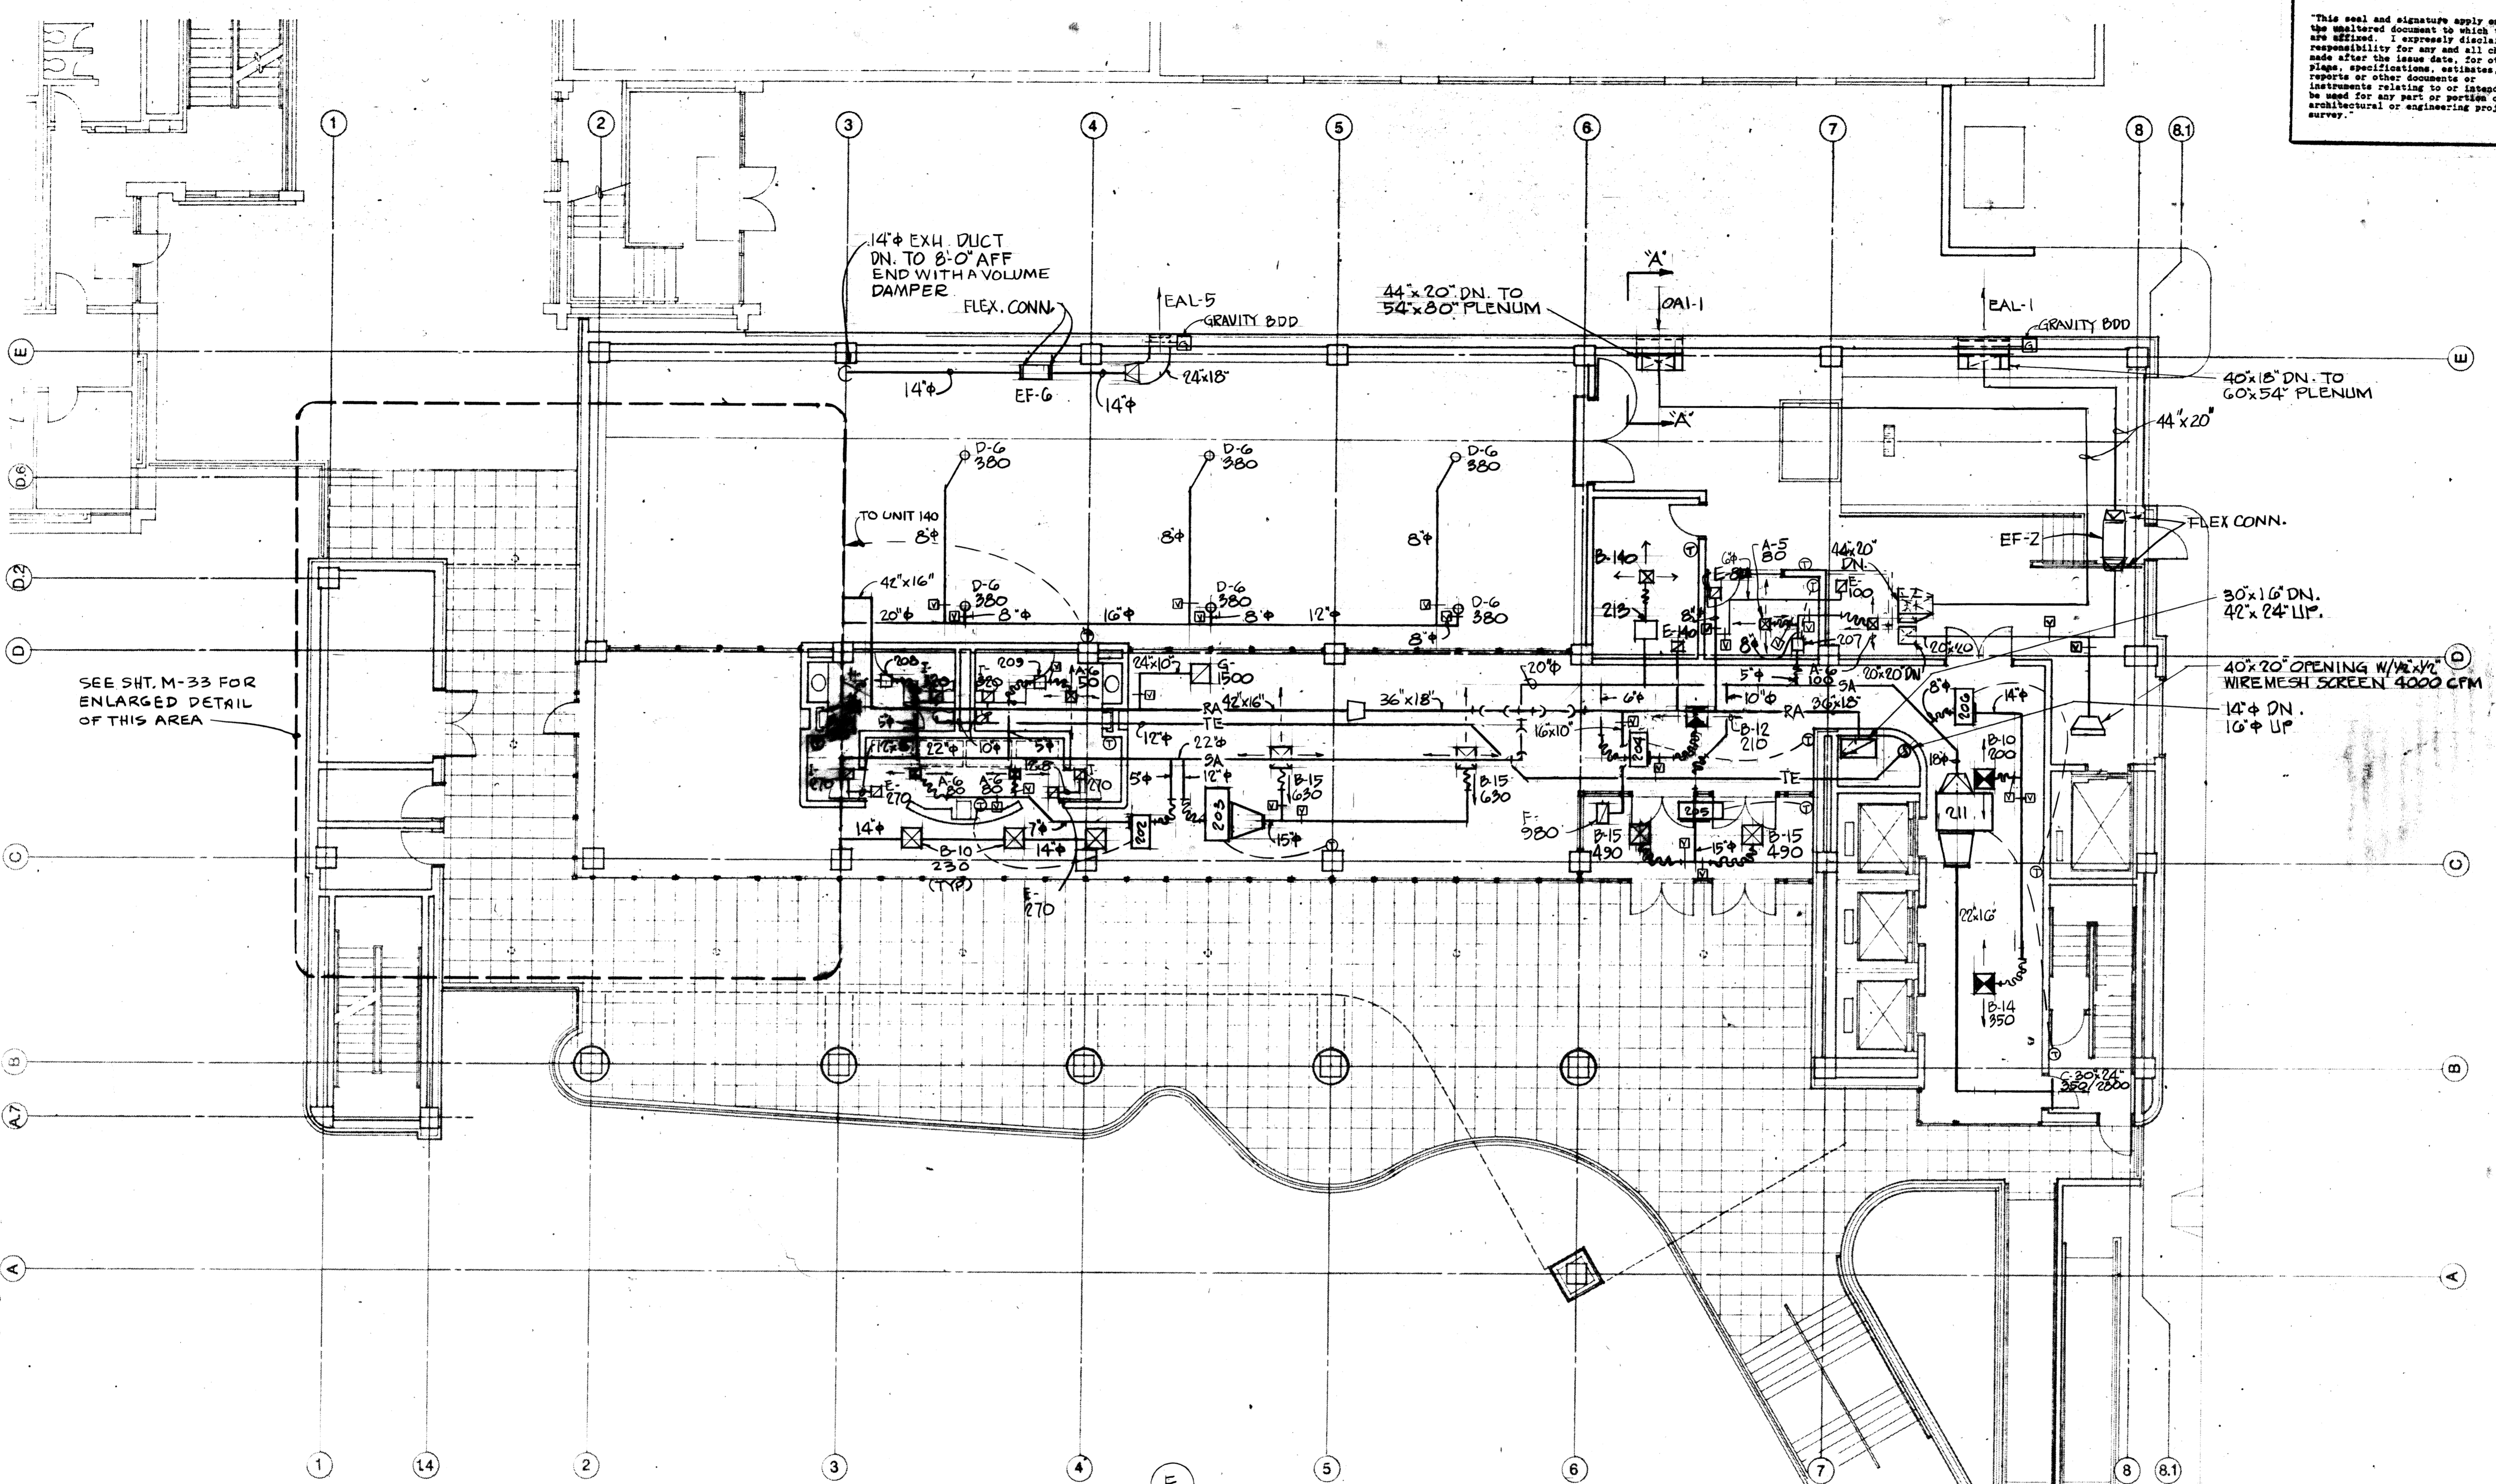

SEE SHT. M-33 FOR ENLARGED DETAIL OF THIS AREA

FIRST FLOOR PLAN
 1/8" = 1'-0"

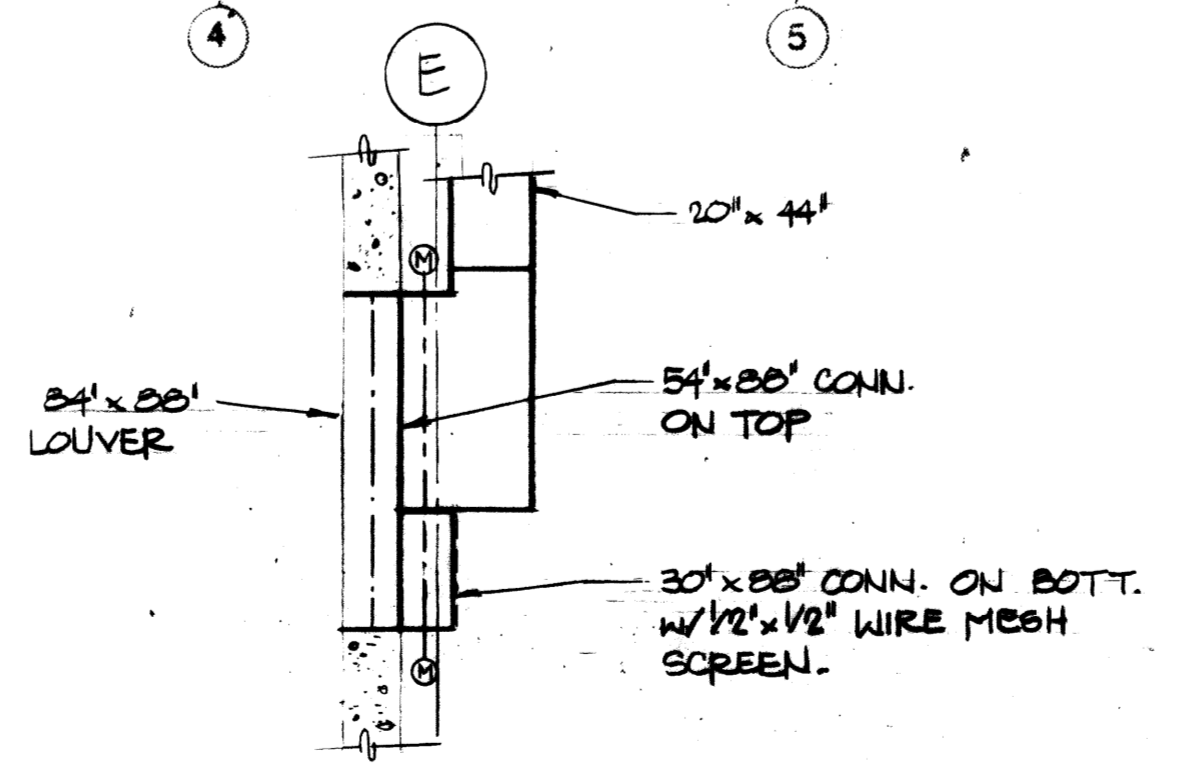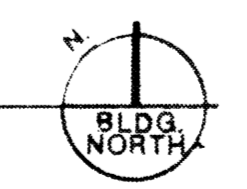


AS BUILT

BELCAN CORPORATION
 10200 ANDERSON WAY
 CINCINNATI, OHIO 45242
 NUMBER: 4361-CM-003-3

Document #
 004934
 82 B-3

"This seal and signature apply only to the unaltered document to which they are affixed. I expressly disclaim any responsibility for any and all changes made after the issue date, for other plans, specifications, estimates, reports or other documents or instruments relating to or intended to be used for any part or portion of the architectural or engineering project or survey."

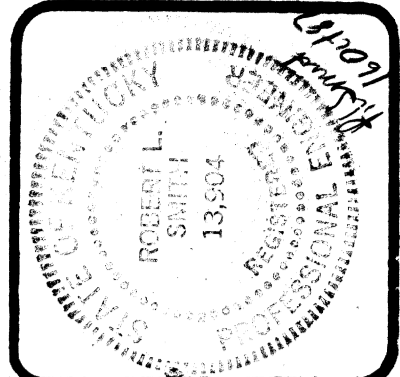

ROBOTICS FACILITY
LEXINGTON CAMPUS
UNIVERSITY OF KENTUCKY
LEXINGTON, KENTUCKY

University of Kentucky
Lexington, Kentucky
Robert Smith
10-16-87


2ND FLOOR HVAC PLAN
Sherman Carter Barnhart
PARTNERS IN ARCHITECTURE
SUITE 1900 • 250 WEST MAIN STREET • LEXINGTON KY 40507 • 606-254-0351

JOB NO. **8706**
DATE **10-16-87**
DRAWN **KE CASE**
CHECKED **WCH**
FILE NO. **431.0**

REVISIONS
3-90% REVIEW

SHEET
M-4

BELCAN CORPORATION
10200 ANDERSON WAY
CINCINNATI, OHIO 45242
NUMBER: **4361-CM-004-3**

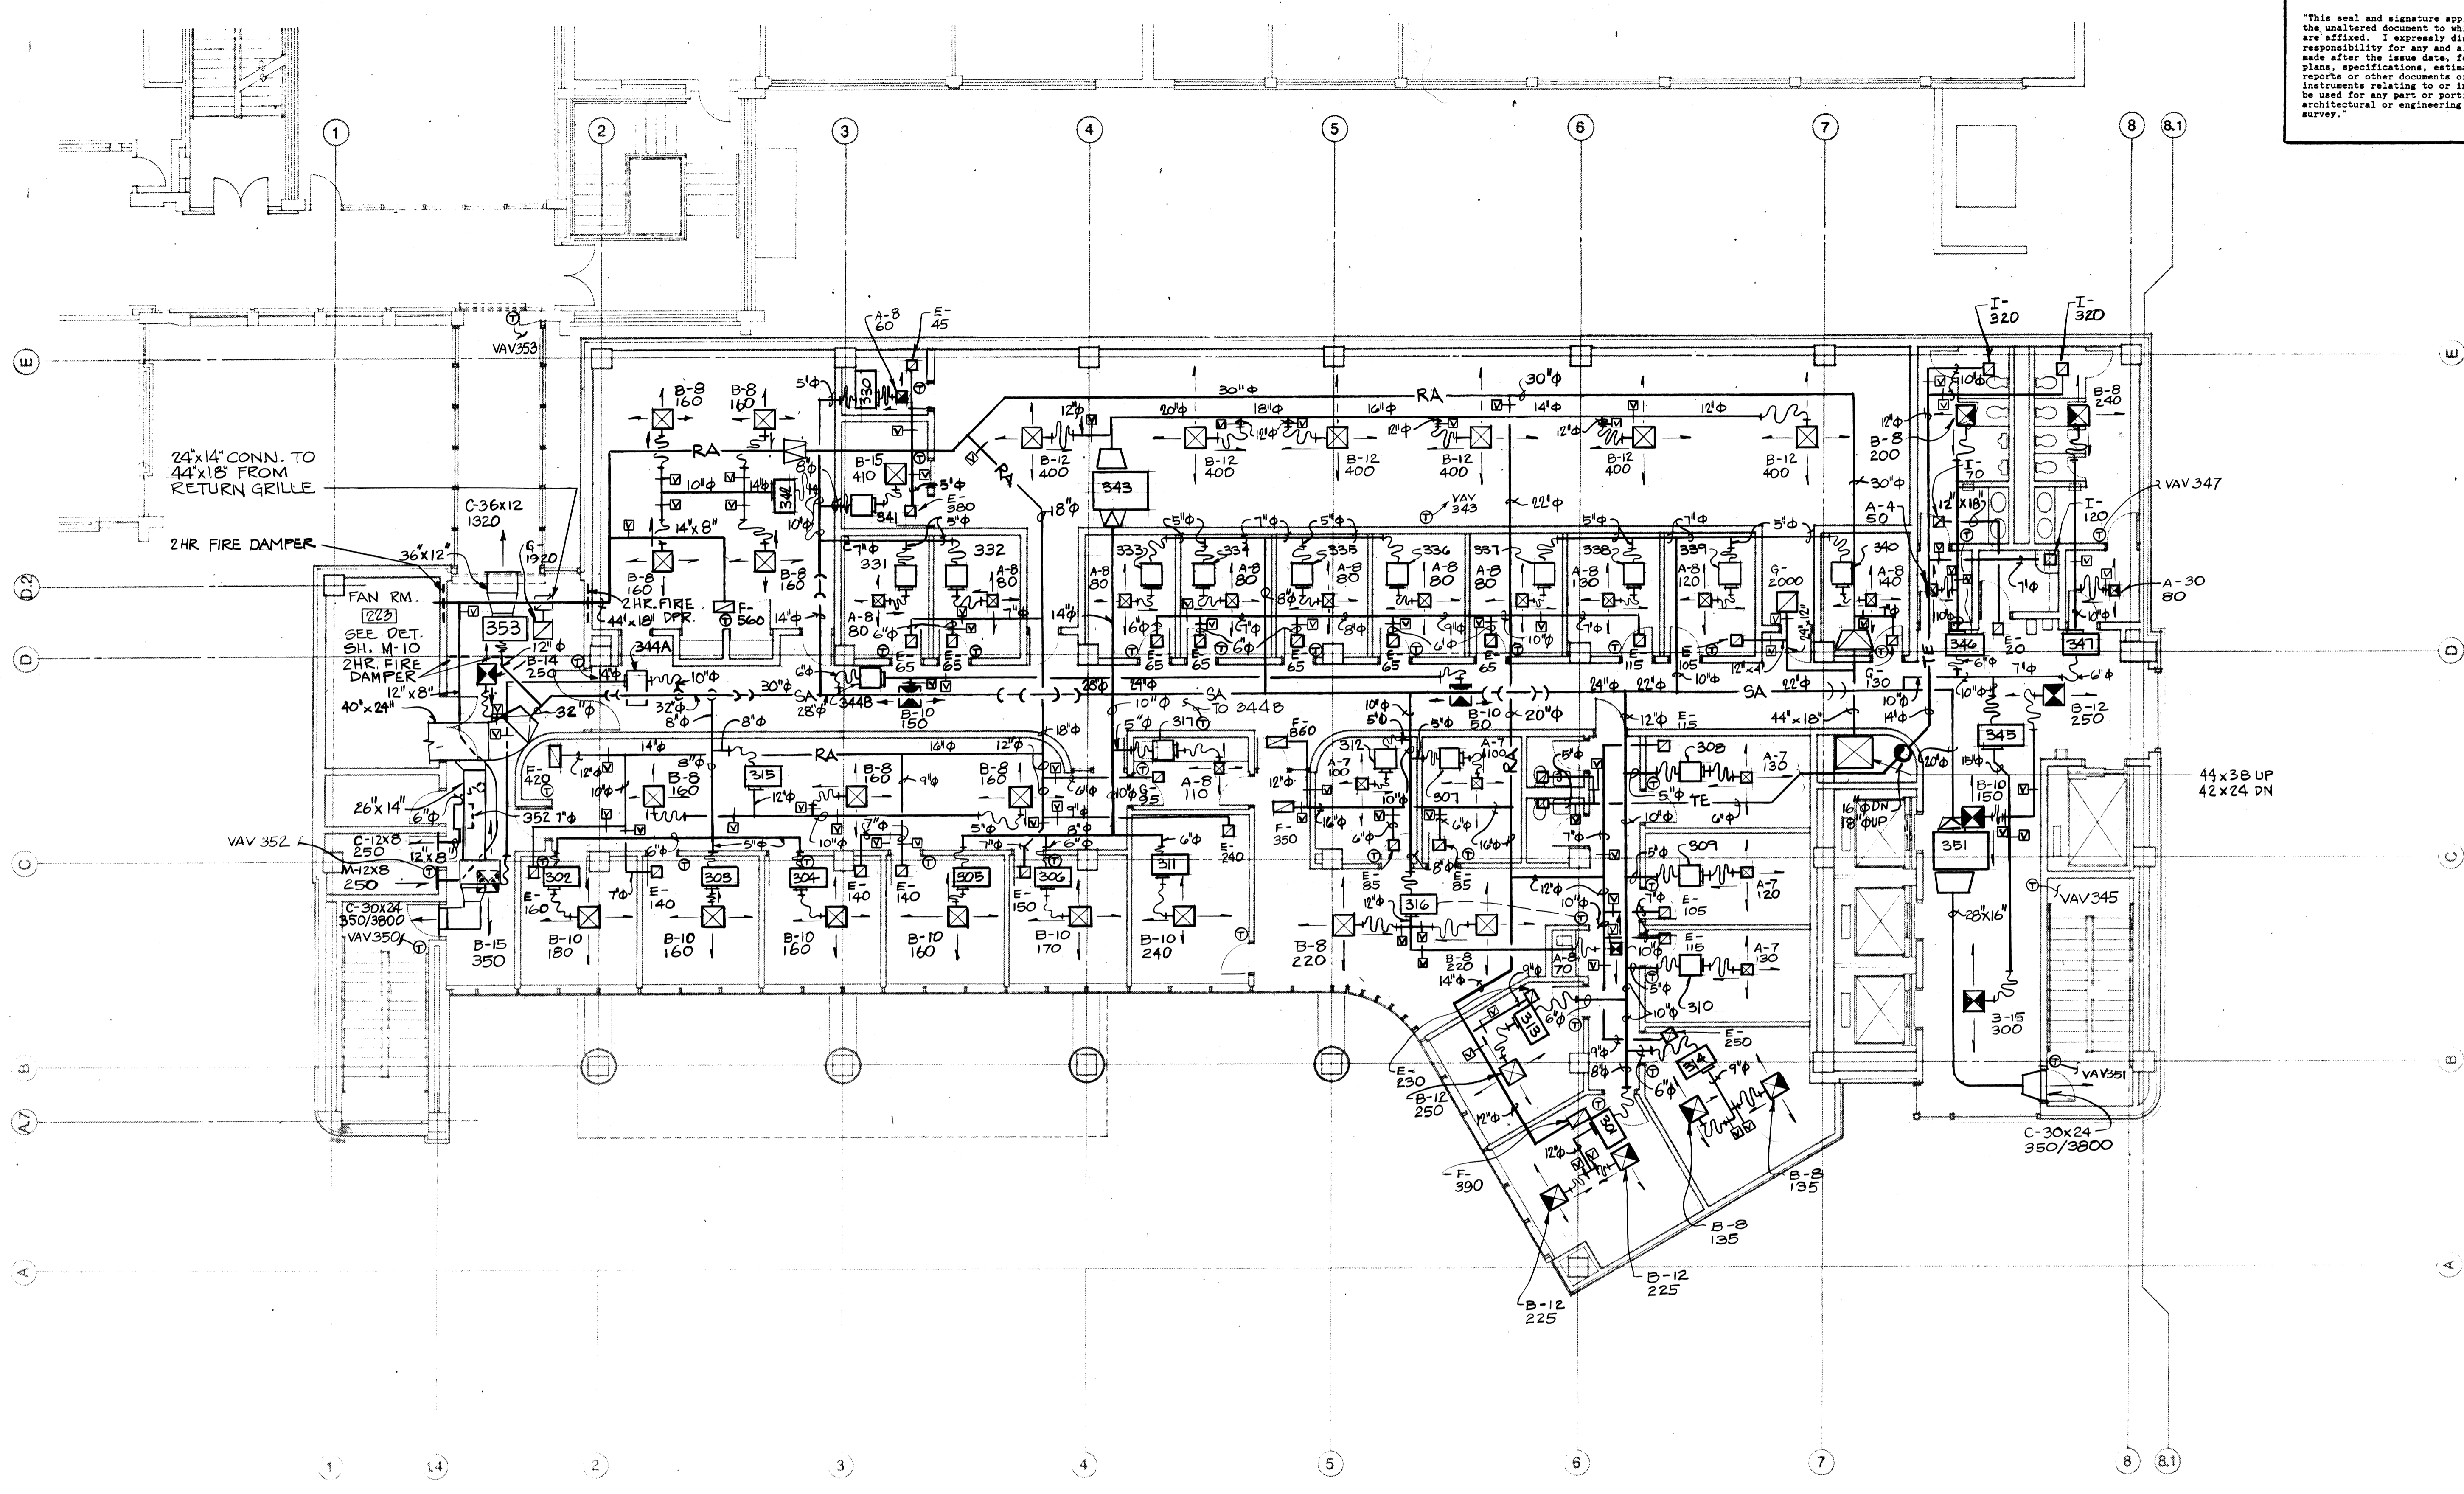


SECOND FLOOR PLAN
1/8" = 1'-0"



AS BUILT

This seal and signature apply only to the unaltered document to which they are affixed. I expressly disclaim any responsibility for any and all changes made after the issue date, for other plans, specifications, estimates, reports or other documents or instruments relating to or intended to be used for any part or portion of the architectural or engineering project of survey.

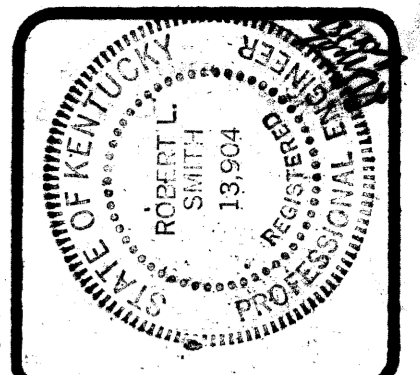

ROBOTICS FACILITY
LEXINGTON CAMPUS
UNIVERSITY OF KENTUCKY
LEXINGTON, KENTUCKY


University of Kentucky
Lexington, Kentucky
10-12-87

3RD FLOOR HVAC PLAN
Sherman-Carter-Barnhart
PARTNERS IN ARCHITECTURE
SUITE 1900 • 230 WEST MAIN STREET • LEXINGTON KY 40507 • 606-754-1351

JOB NO. **3706**
DATE **10-16-87**
DRAWN **WE CASE**
CHECKED **WLL**
FILE NO. **4316**

REVISIONS
3-90% REVIEW

SHEET
1-5

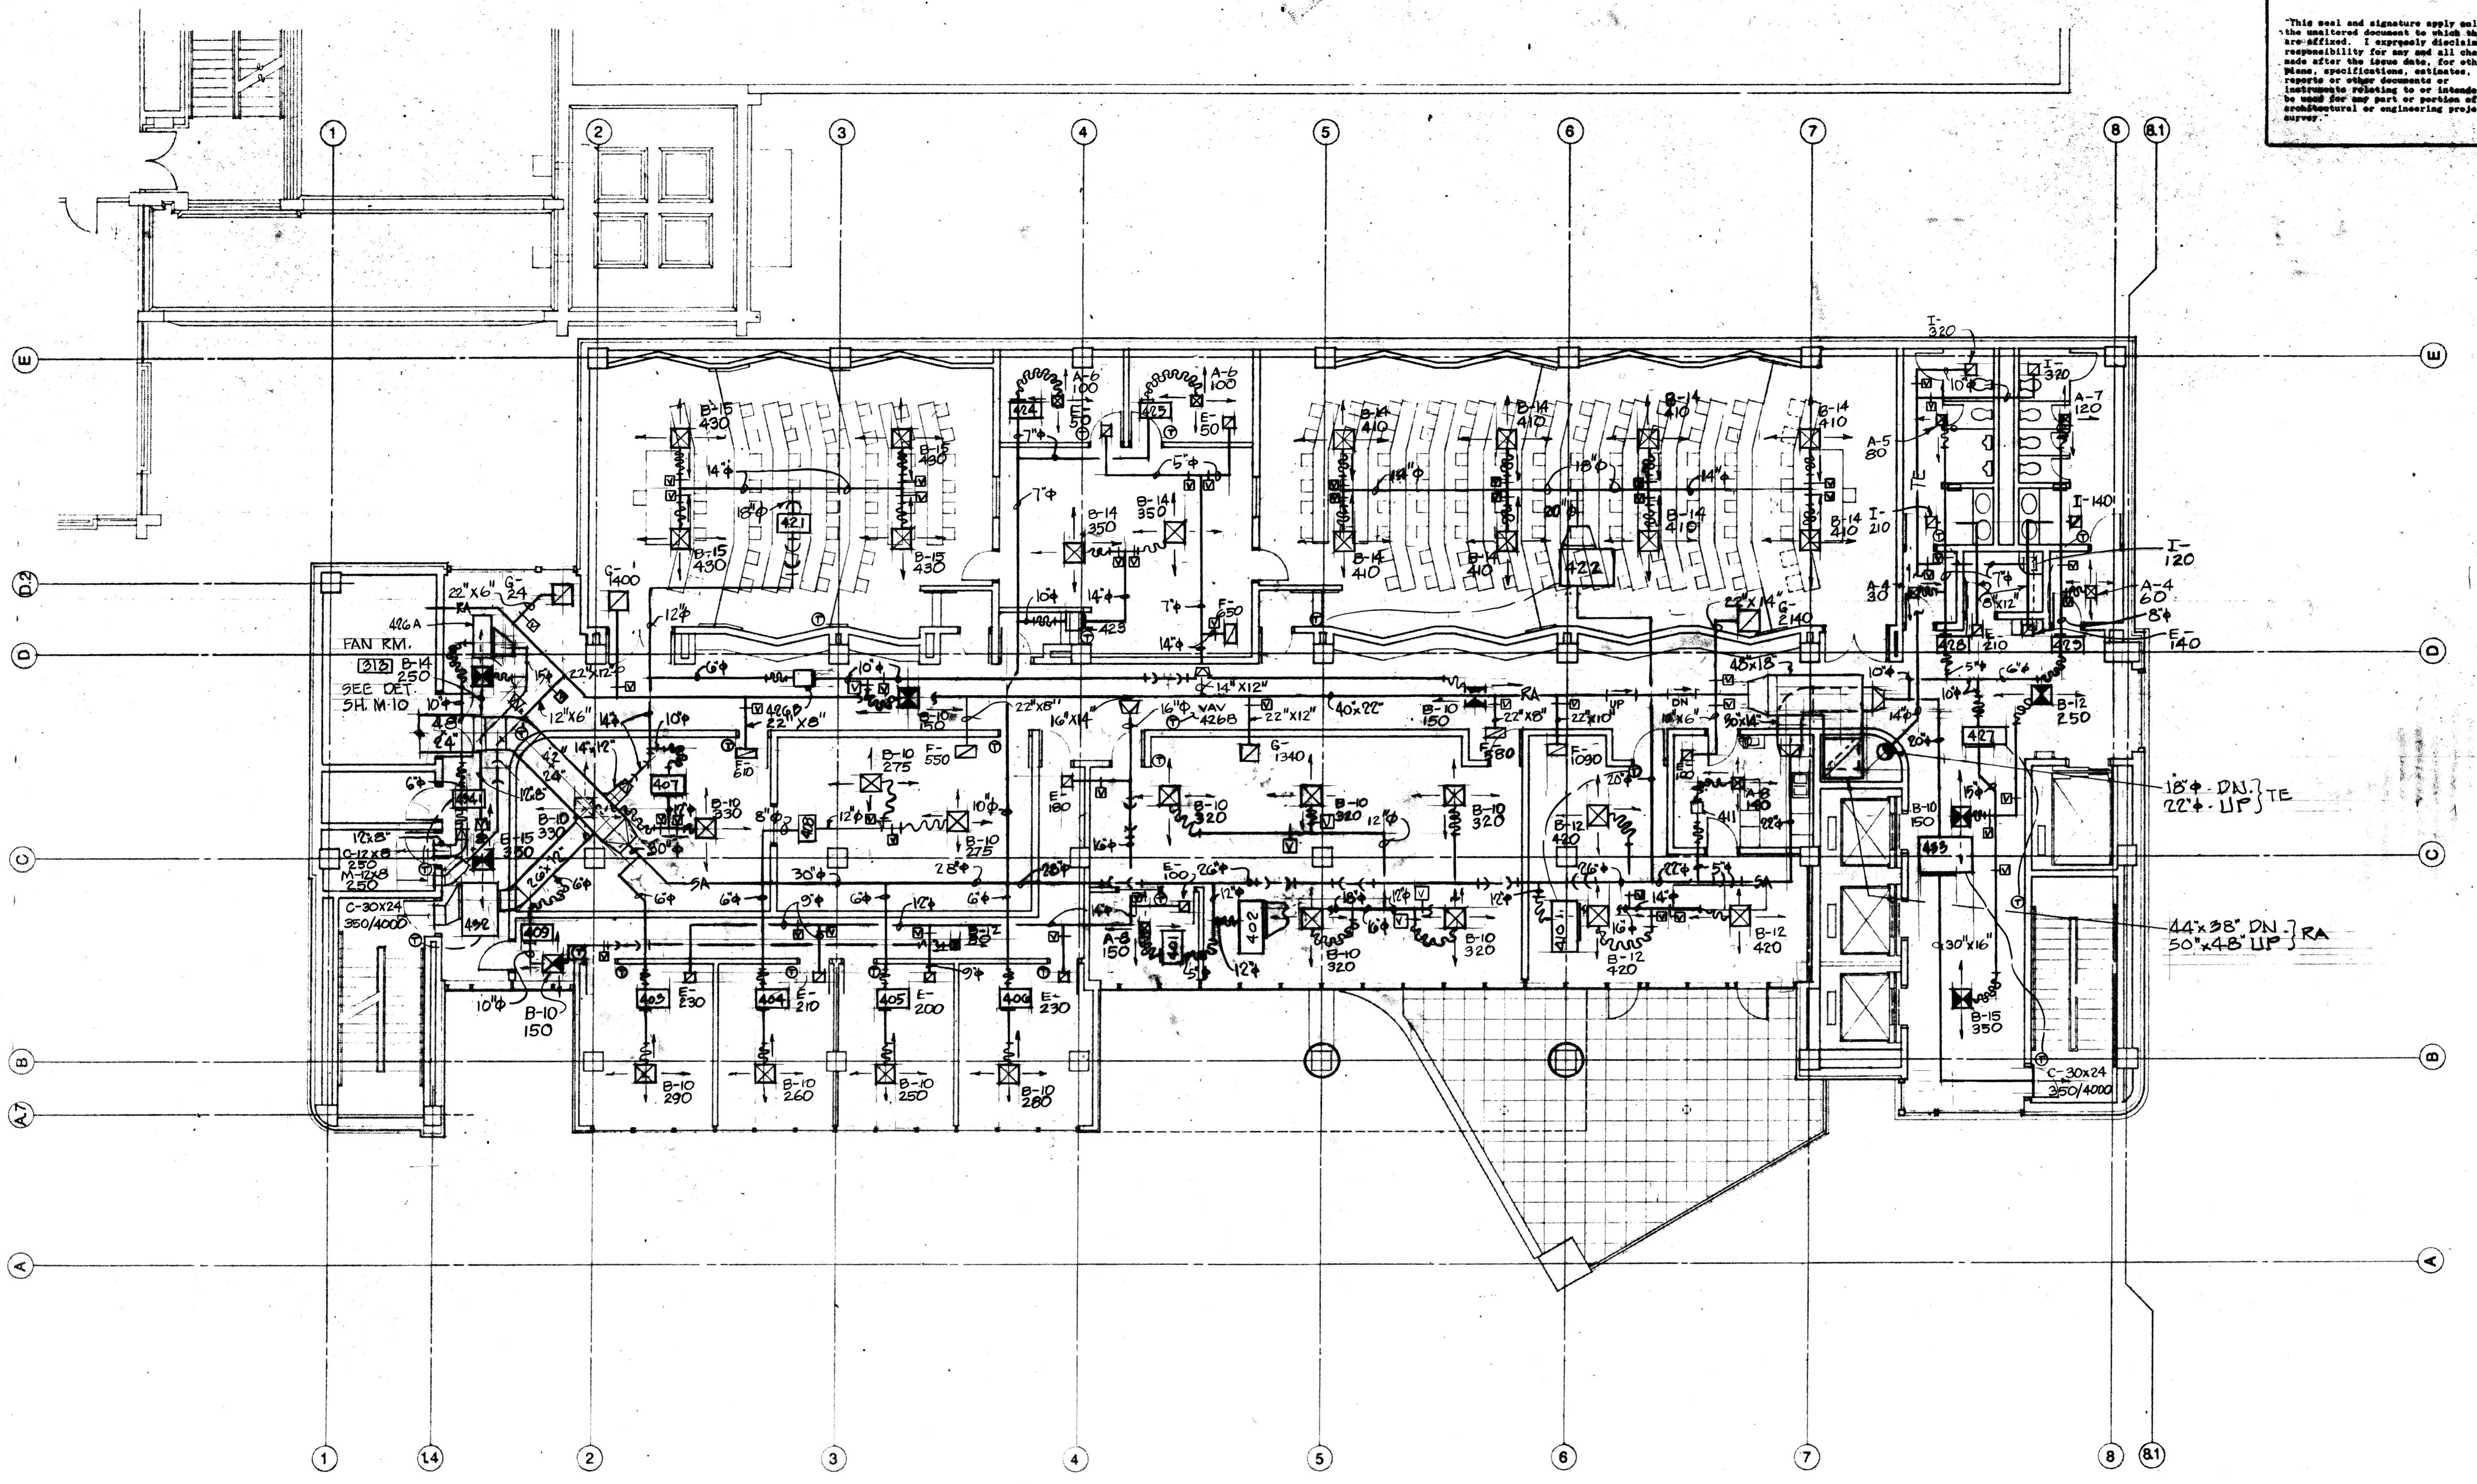

THIRD FLOOR PLAN
1/8" = 1'-0"




AS BUILT

BELCAN CORPORATION
10200 ANDERSON WAY
CINCINNATI, OHIO 45242
NUMBER: **4361-CM-005-B**

Sheet
E-3
004936

"This seal and signature apply only to the unaltered document to which they are affixed. I expressly disclaim any responsibility for any and all changes made after the issue date, for other plans, specifications, estimates, reports or other documents or instruments relating to or intended to be used for any part or portion of the architectural or engineering project or survey."

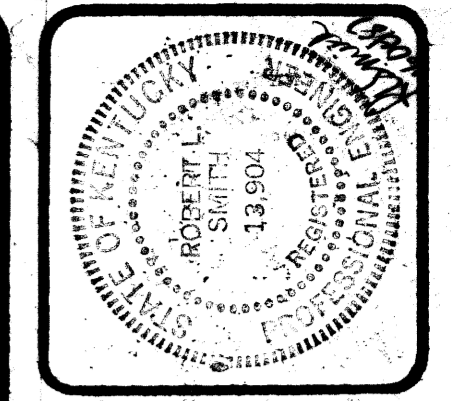

ROBOTICS FACILITY
 LEXINGTON CAMPUS
 UNIVERSITY OF KENTUCKY
 LEXINGTON, KENTUCKY


University of Kentucky
 Lexington, Kentucky
 11-19-87
 Robert W. Bann
 Mechanical Engineer and Construction Administrator

4TH FLOOR HVAC PLAN
 Sherman Carter Barnhart
 PARTNERS IN ARCHITECTURE
 SUITE 1900 • 750 WEST MAIN STREET • LEXINGTON KY 40507 • 506-754-1351

JOB NO. **8706**
 DATE **10-16-87**
 DRAWN **S. Thompson**
 CHECKED **[Signature]**
 FILE NO. **431-6**

REVISIONS
 3- 40% REVIEW
 4- ADD COMPUTER ROOM SYSTEM

SHEET
 1 of 3
 044937

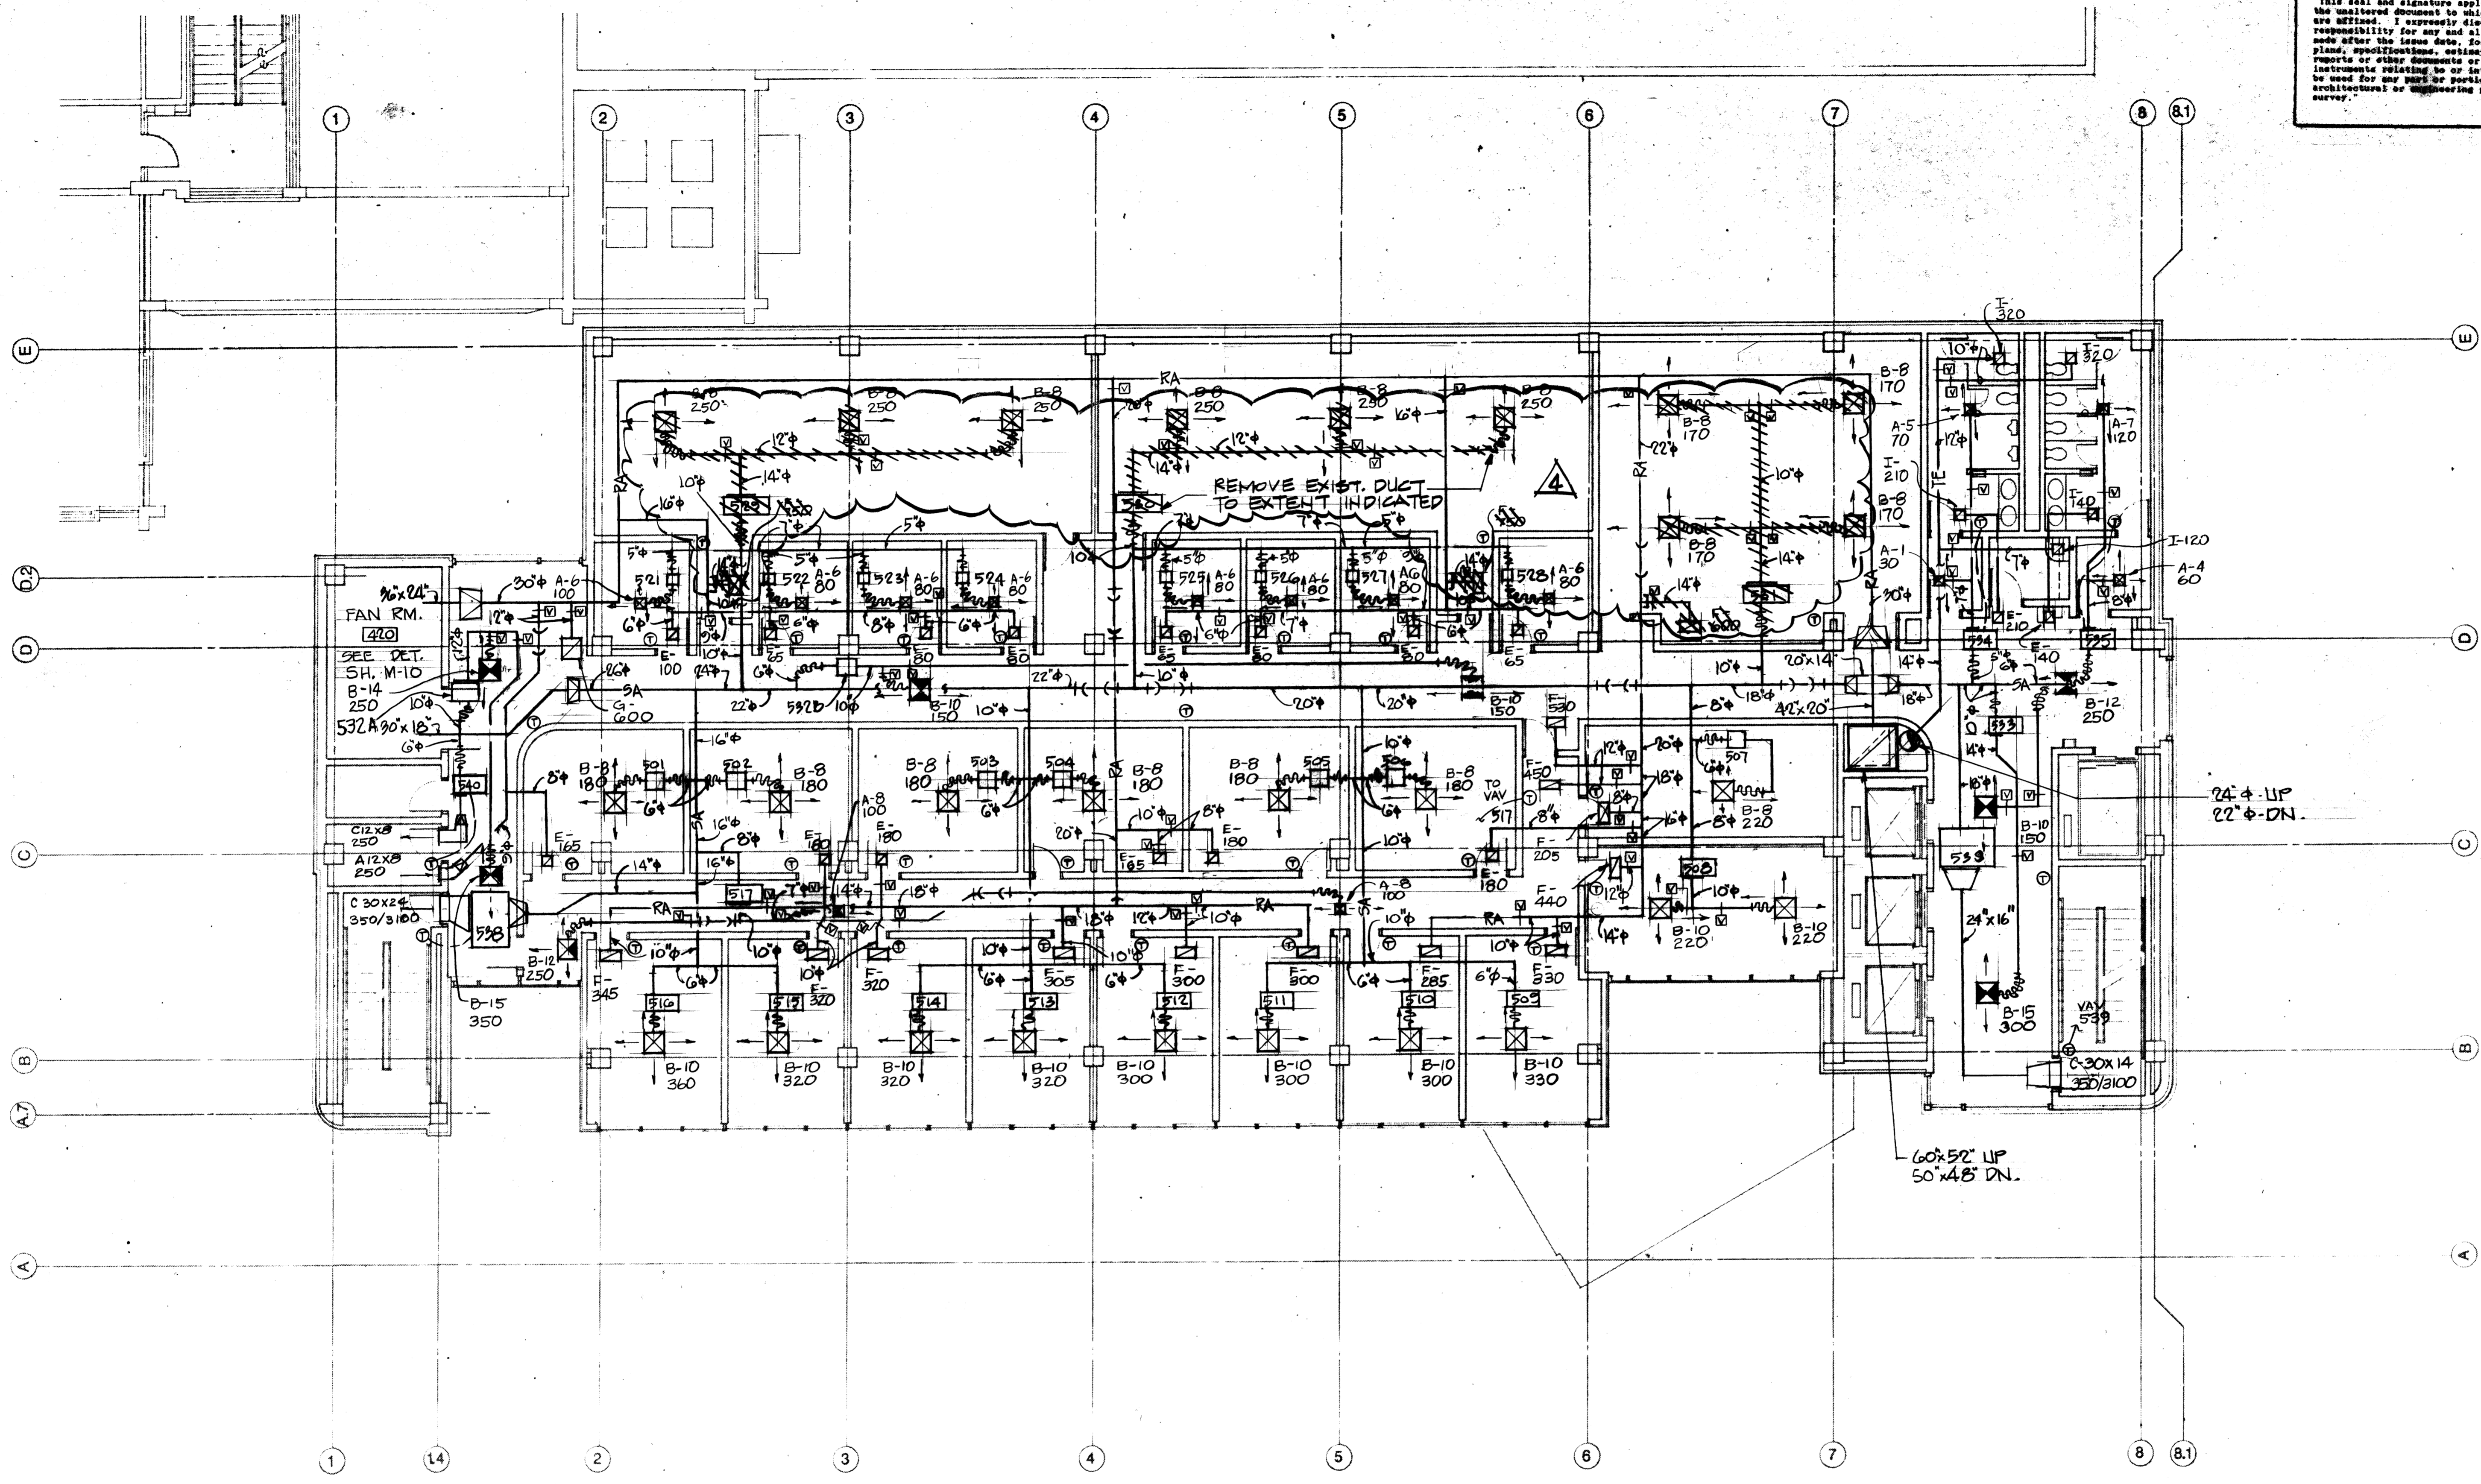


FOURTH FLOOR PLAN
 1/8" = 1'-0"

NOTES -
 1- WORK UNDER REV. 4 SHOWN ON THIS SHEET INCLUDE DUCTWORK REMOVAL, AIR TERMINAL & VAV BOX REMOVAL TO THE EXTENT INDICATED.

AS BUILT
BELCAN CORPORATION
 10200 ANDERSON WAY
 CINCINNATI, OHIO 45242
 NUMBER: **4361-CM-006-3**

"This seal and signature apply only to the unissued document to which they are affixed. I expressly disclaim any responsibility for any and all changes made after the issue date, for other plans, specifications, estimates, reports or other documents or instruments relating to or intended to be used for any part or portion of the architectural or engineering project, or survey."

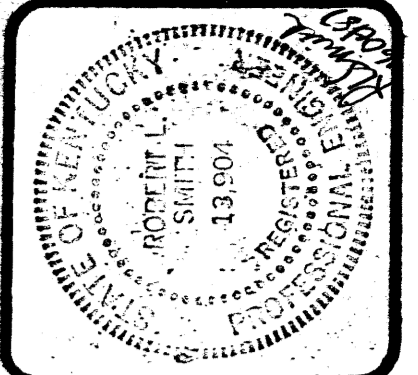

ROBOTICS FACILITY
LEXINGTON CAMPUS
UNIVERSITY OF KENTUCKY
LEXINGTON, KENTUCKY

University of Kentucky
Lexington, Kentucky
16.19.87


4TH FLOOR HVAC PLAN
Shepherd Carter Barham
PARTNERS IN ARCHITECTURE
SUITE 1800 • 250 WEST MAIN STREET • LEXINGTON, KY 40507 • 606.254.1051

JOB NO. **B706**
DATE 10-16-87
DRAWN S. THOMPSON
CHECKED [Signature]
FILE NO. 431.8



REVISIONS
3- 90% REVIEW
4- ADD COMPUTER ROOM SYSTEM

SHEET
B-3

M-6A

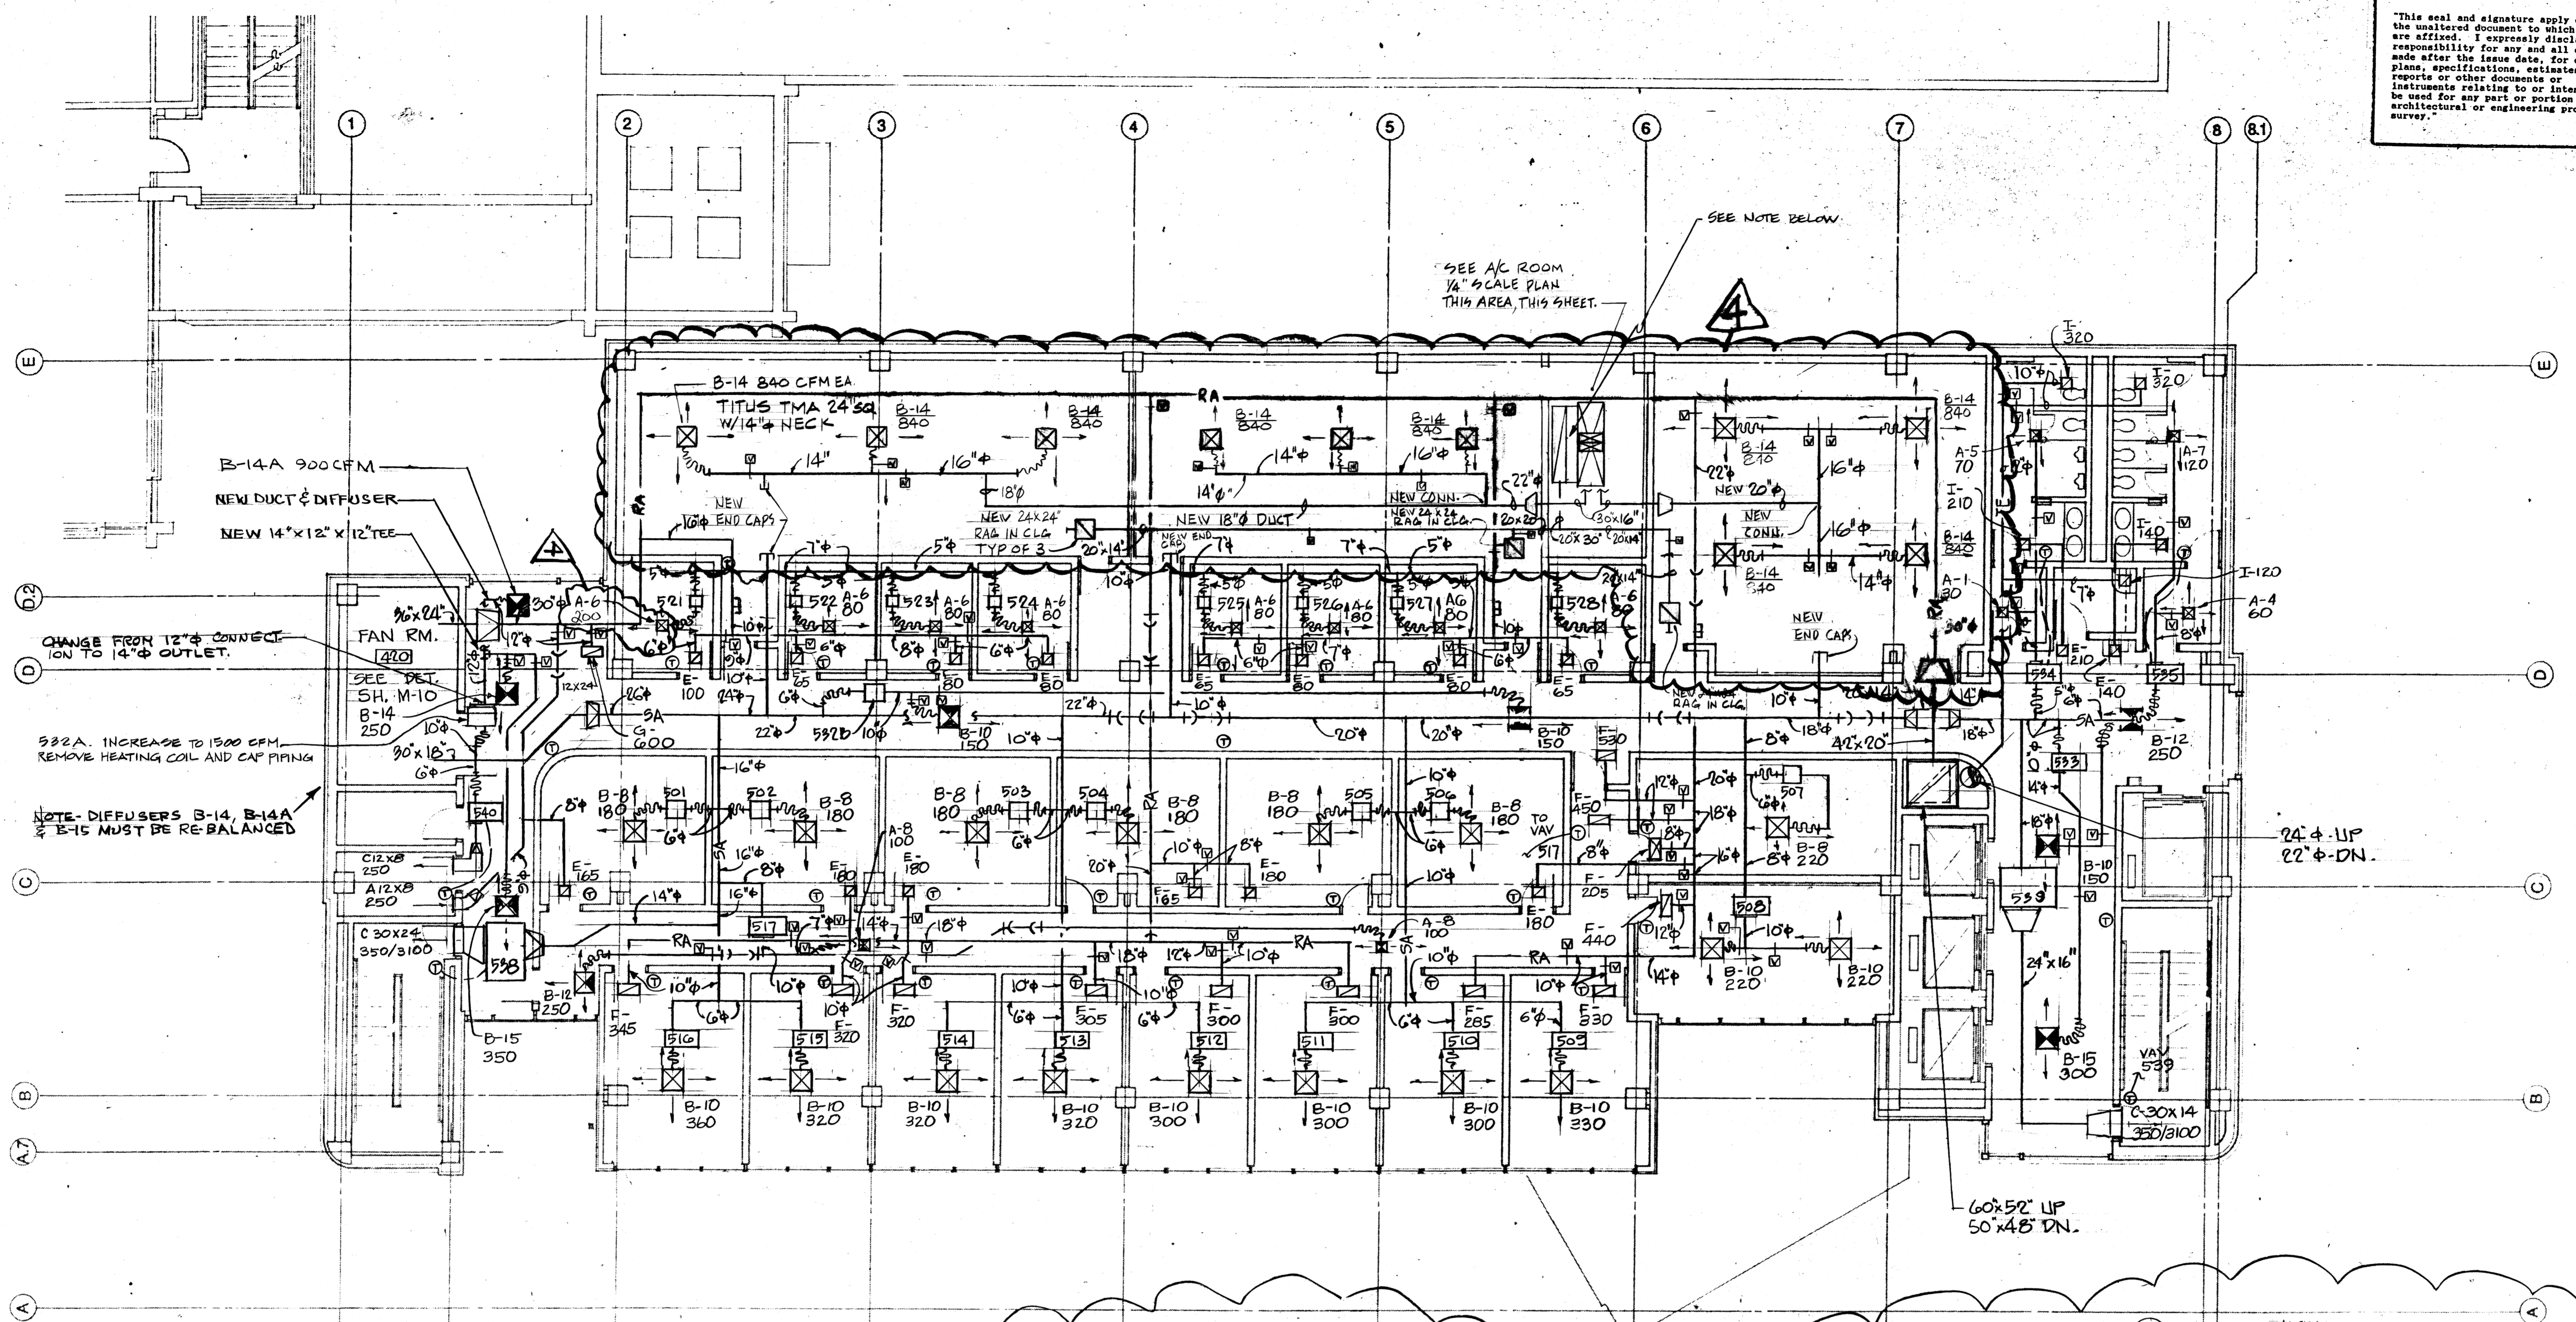

FOURTH FLOOR PLAN
1/8" = 1'-0"

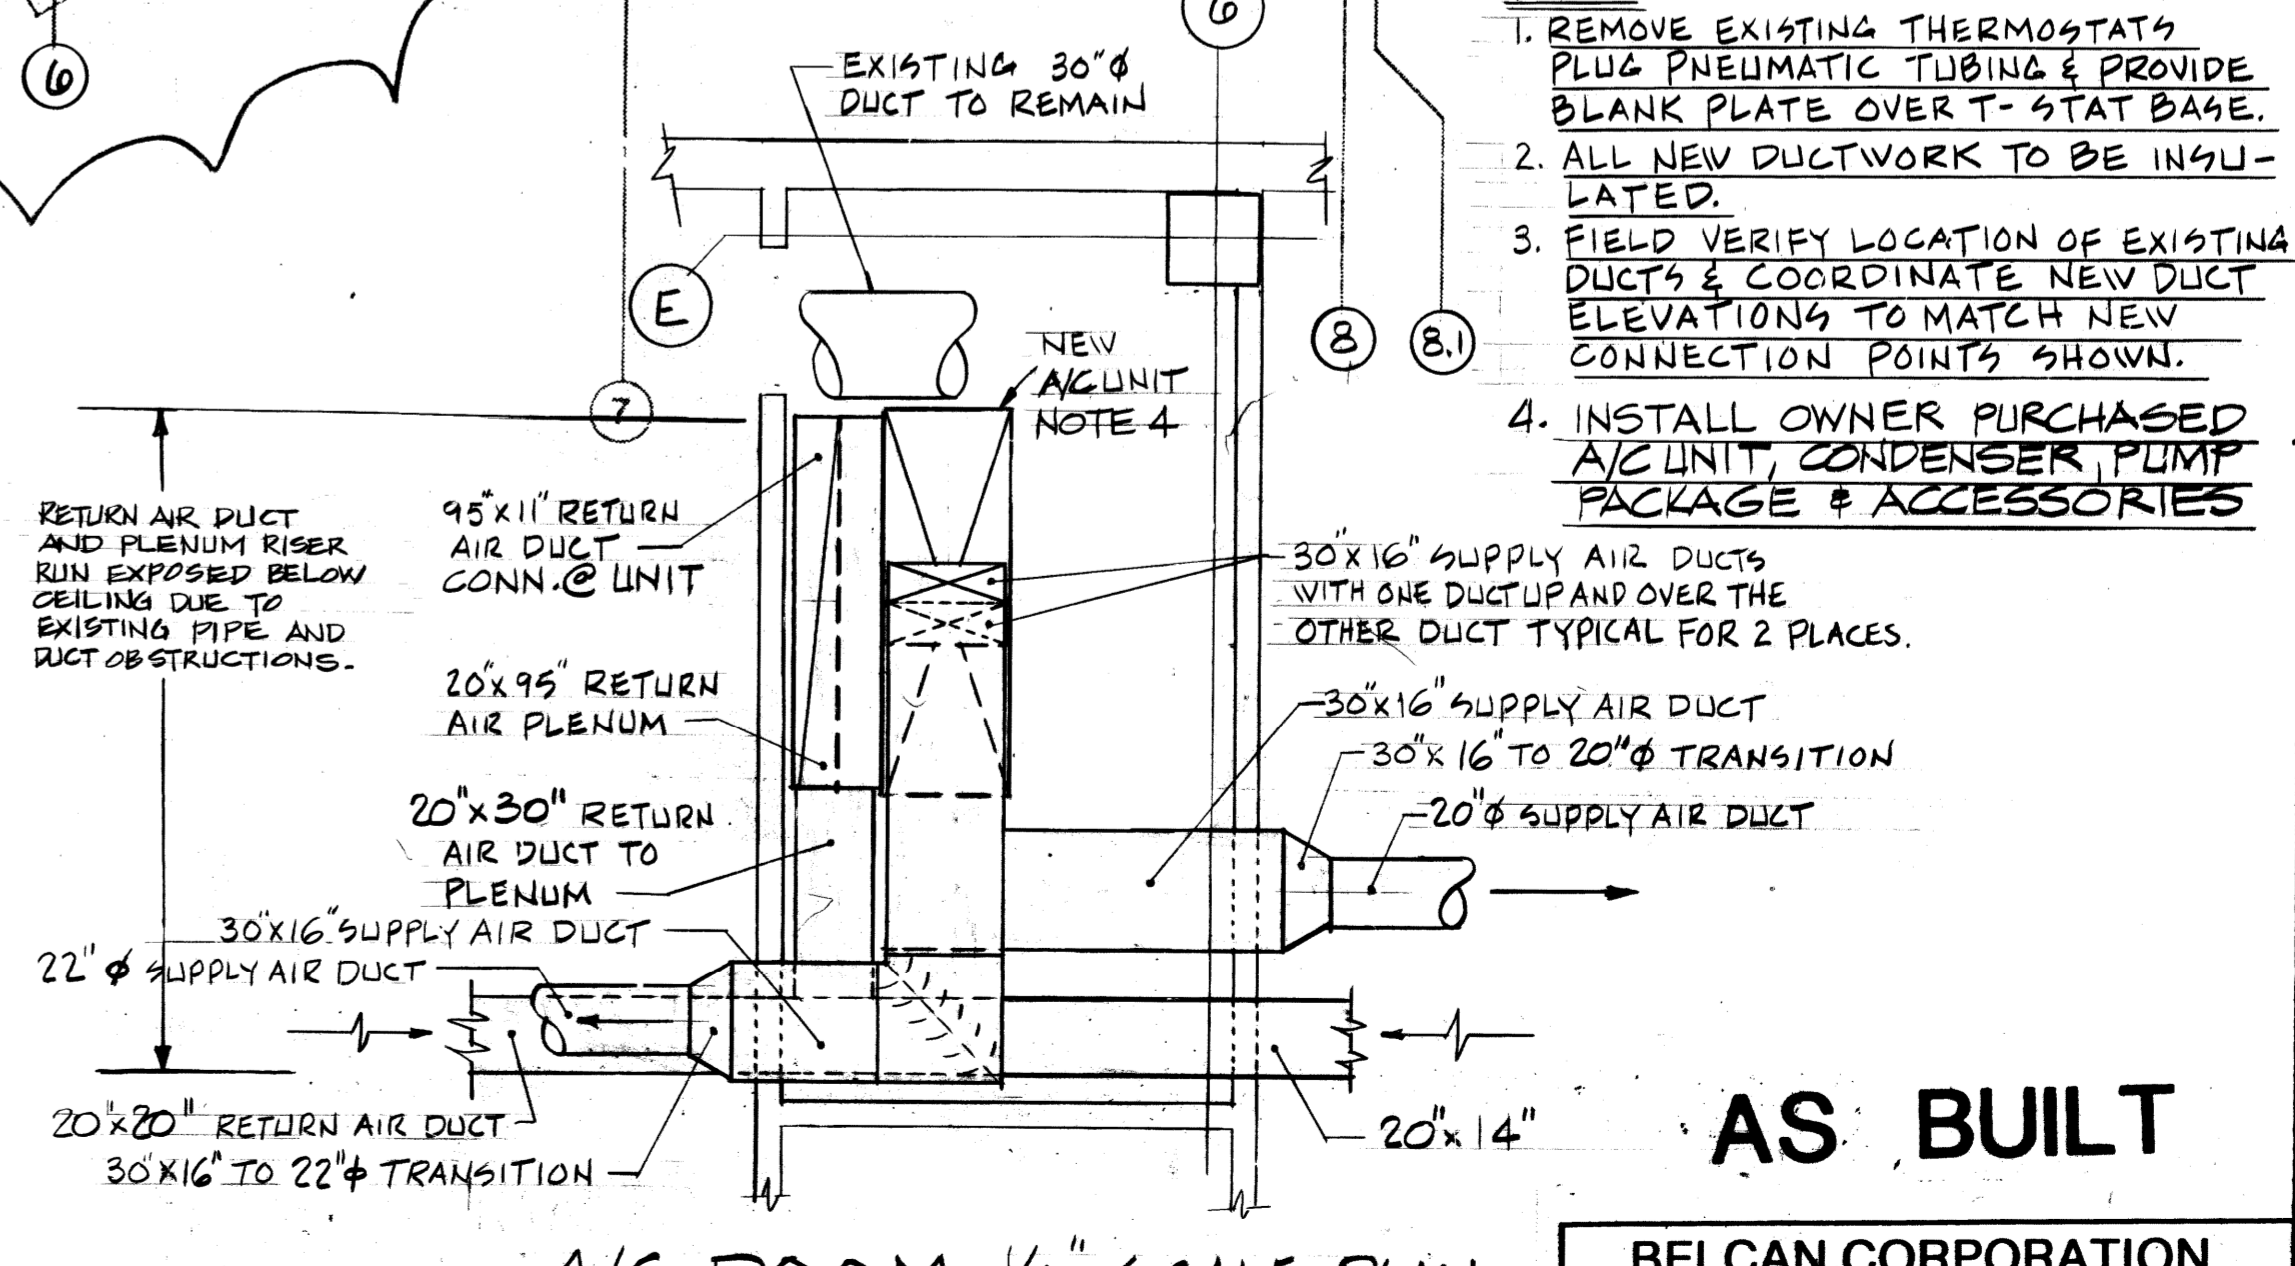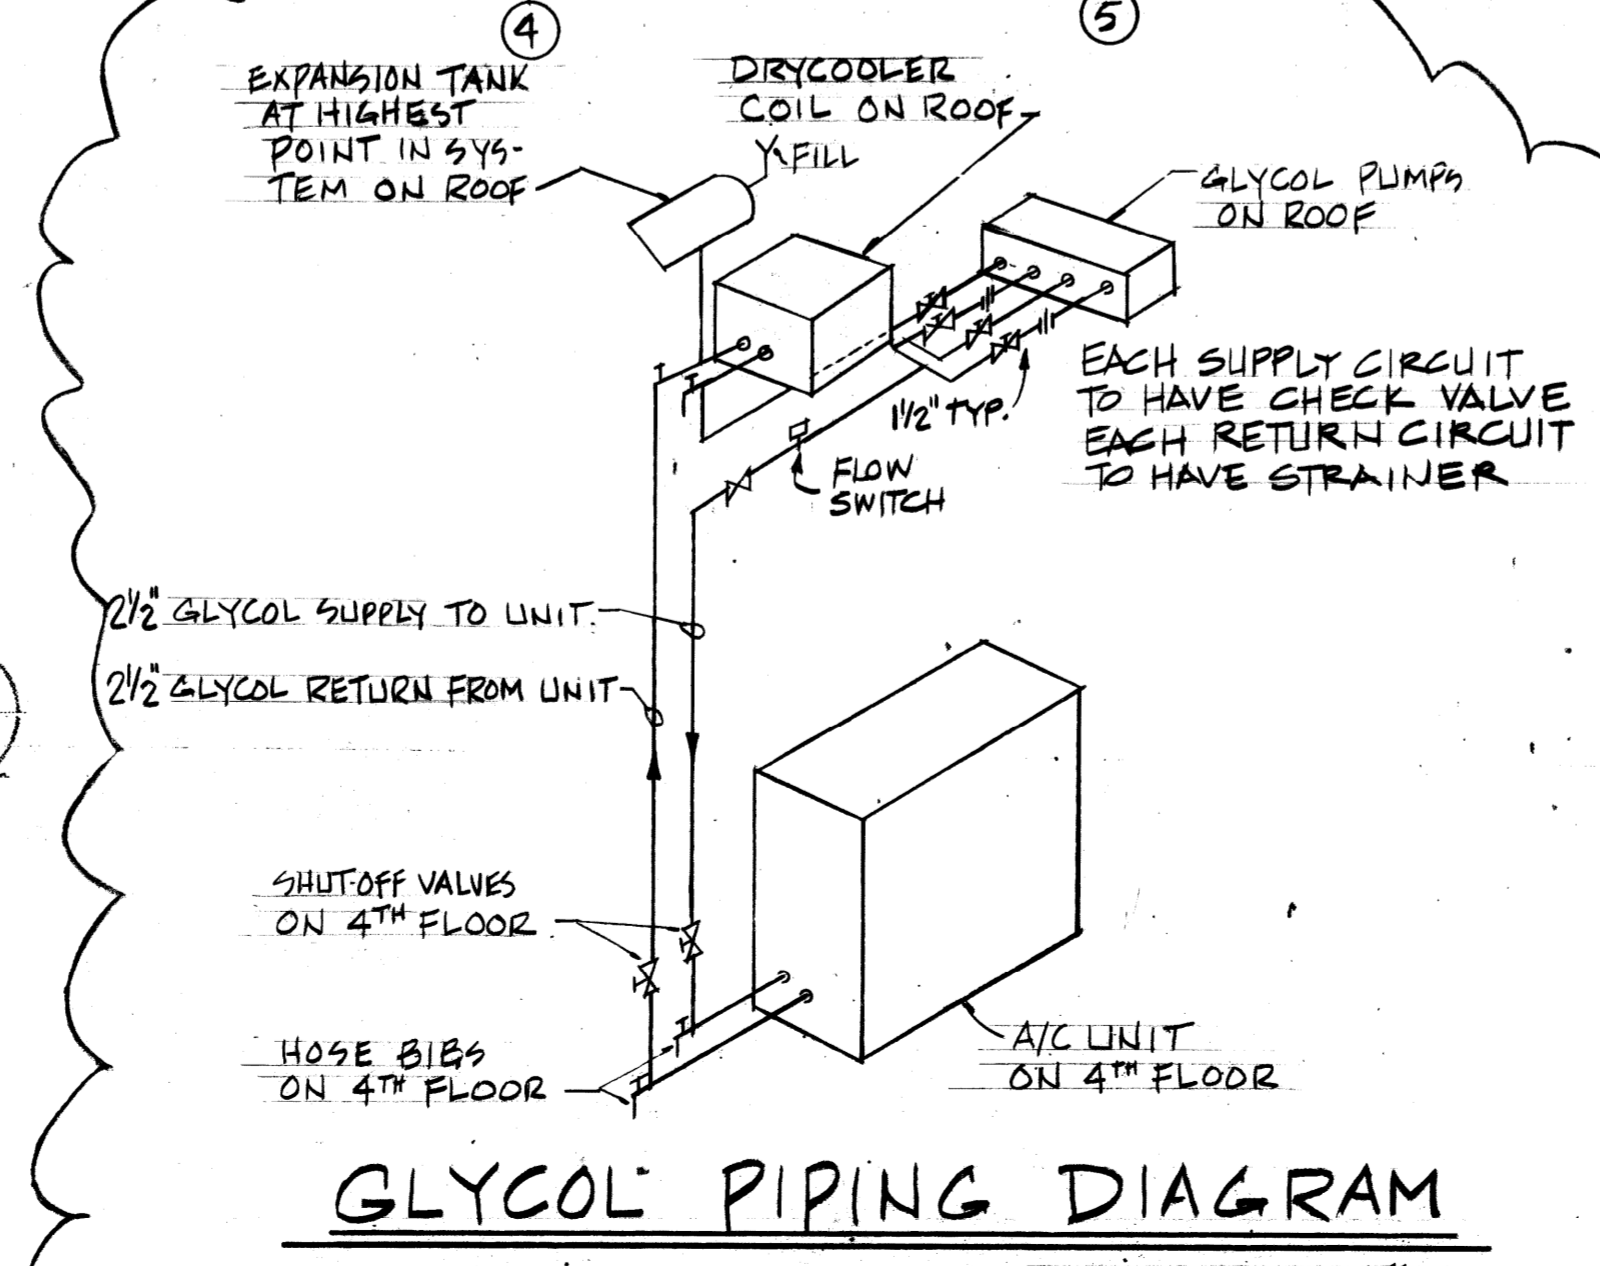


- NOTES:
1. REMOVE EXISTING THERMOSTATS PLUS PNEUMATIC TUBING & PROVIDE BLANK PLATE OVER T-STAT BASE.
 2. ALL NEW DUCTWORK TO BE INSULATED.
 3. FIELD VERIFY LOCATION OF EXISTING DUCTS & COORDINATE NEW DUCT ELEVATIONS TO MATCH NEW CONNECTION POINTS SHOWN.
 4. INSTALL OWNER PURCHASED A/C UNIT, CONDENSER PUMP PACKAGE & ACCESSORIES

AS BUILT

BELCAN CORPORATION
10200 ANDERSON WAY
CINCINNATI, OHIO 45242
NUMBER: 4361-CM-006-3

This seal and signature apply only to the unaltered document to which they are affixed. I expressly disclaim any responsibility for any and all changes made after the issue date, for other plans, specifications, estimates, reports or other documents or instruments relating to or intended to be used for any part or portion of the architectural or engineering project or survey.

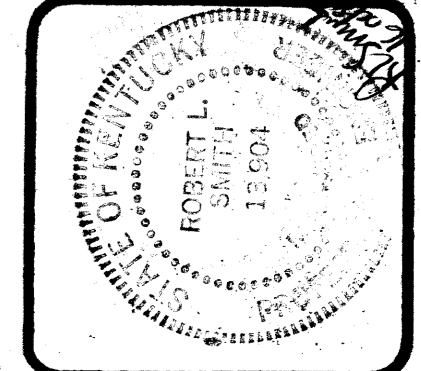

ROBOTICS FACILITY
LEXINGTON CAMPUS
UNIVERSITY OF KENTUCKY
LEXINGTON, KENTUCKY

University of Kentucky
Lexington, Kentucky
Robert L. Smith
Professional Engineer
No. 12504


5TH FLOOR HVAC PLAN
Sherman Carter Barnhart
PARTNERS IN ARCHITECTURE
SUITE 1900 • 250 WEST MAIN STREET • LEXINGTON, KY 40507 • 606-254-1351

JOB NO. **3706**
DATE **10-16-87**
DRAWN **WE CASE**
CHECKED **[Signature]**
FILE NO. **4312**

REVISIONS
3- 90% REVIEW

SHEET
M-7

BELCAN CORPORATION
10200 ANDERSON WAY
CINCINNATI, OHIO 45242
NUMBER: **4361-CM-007-3**

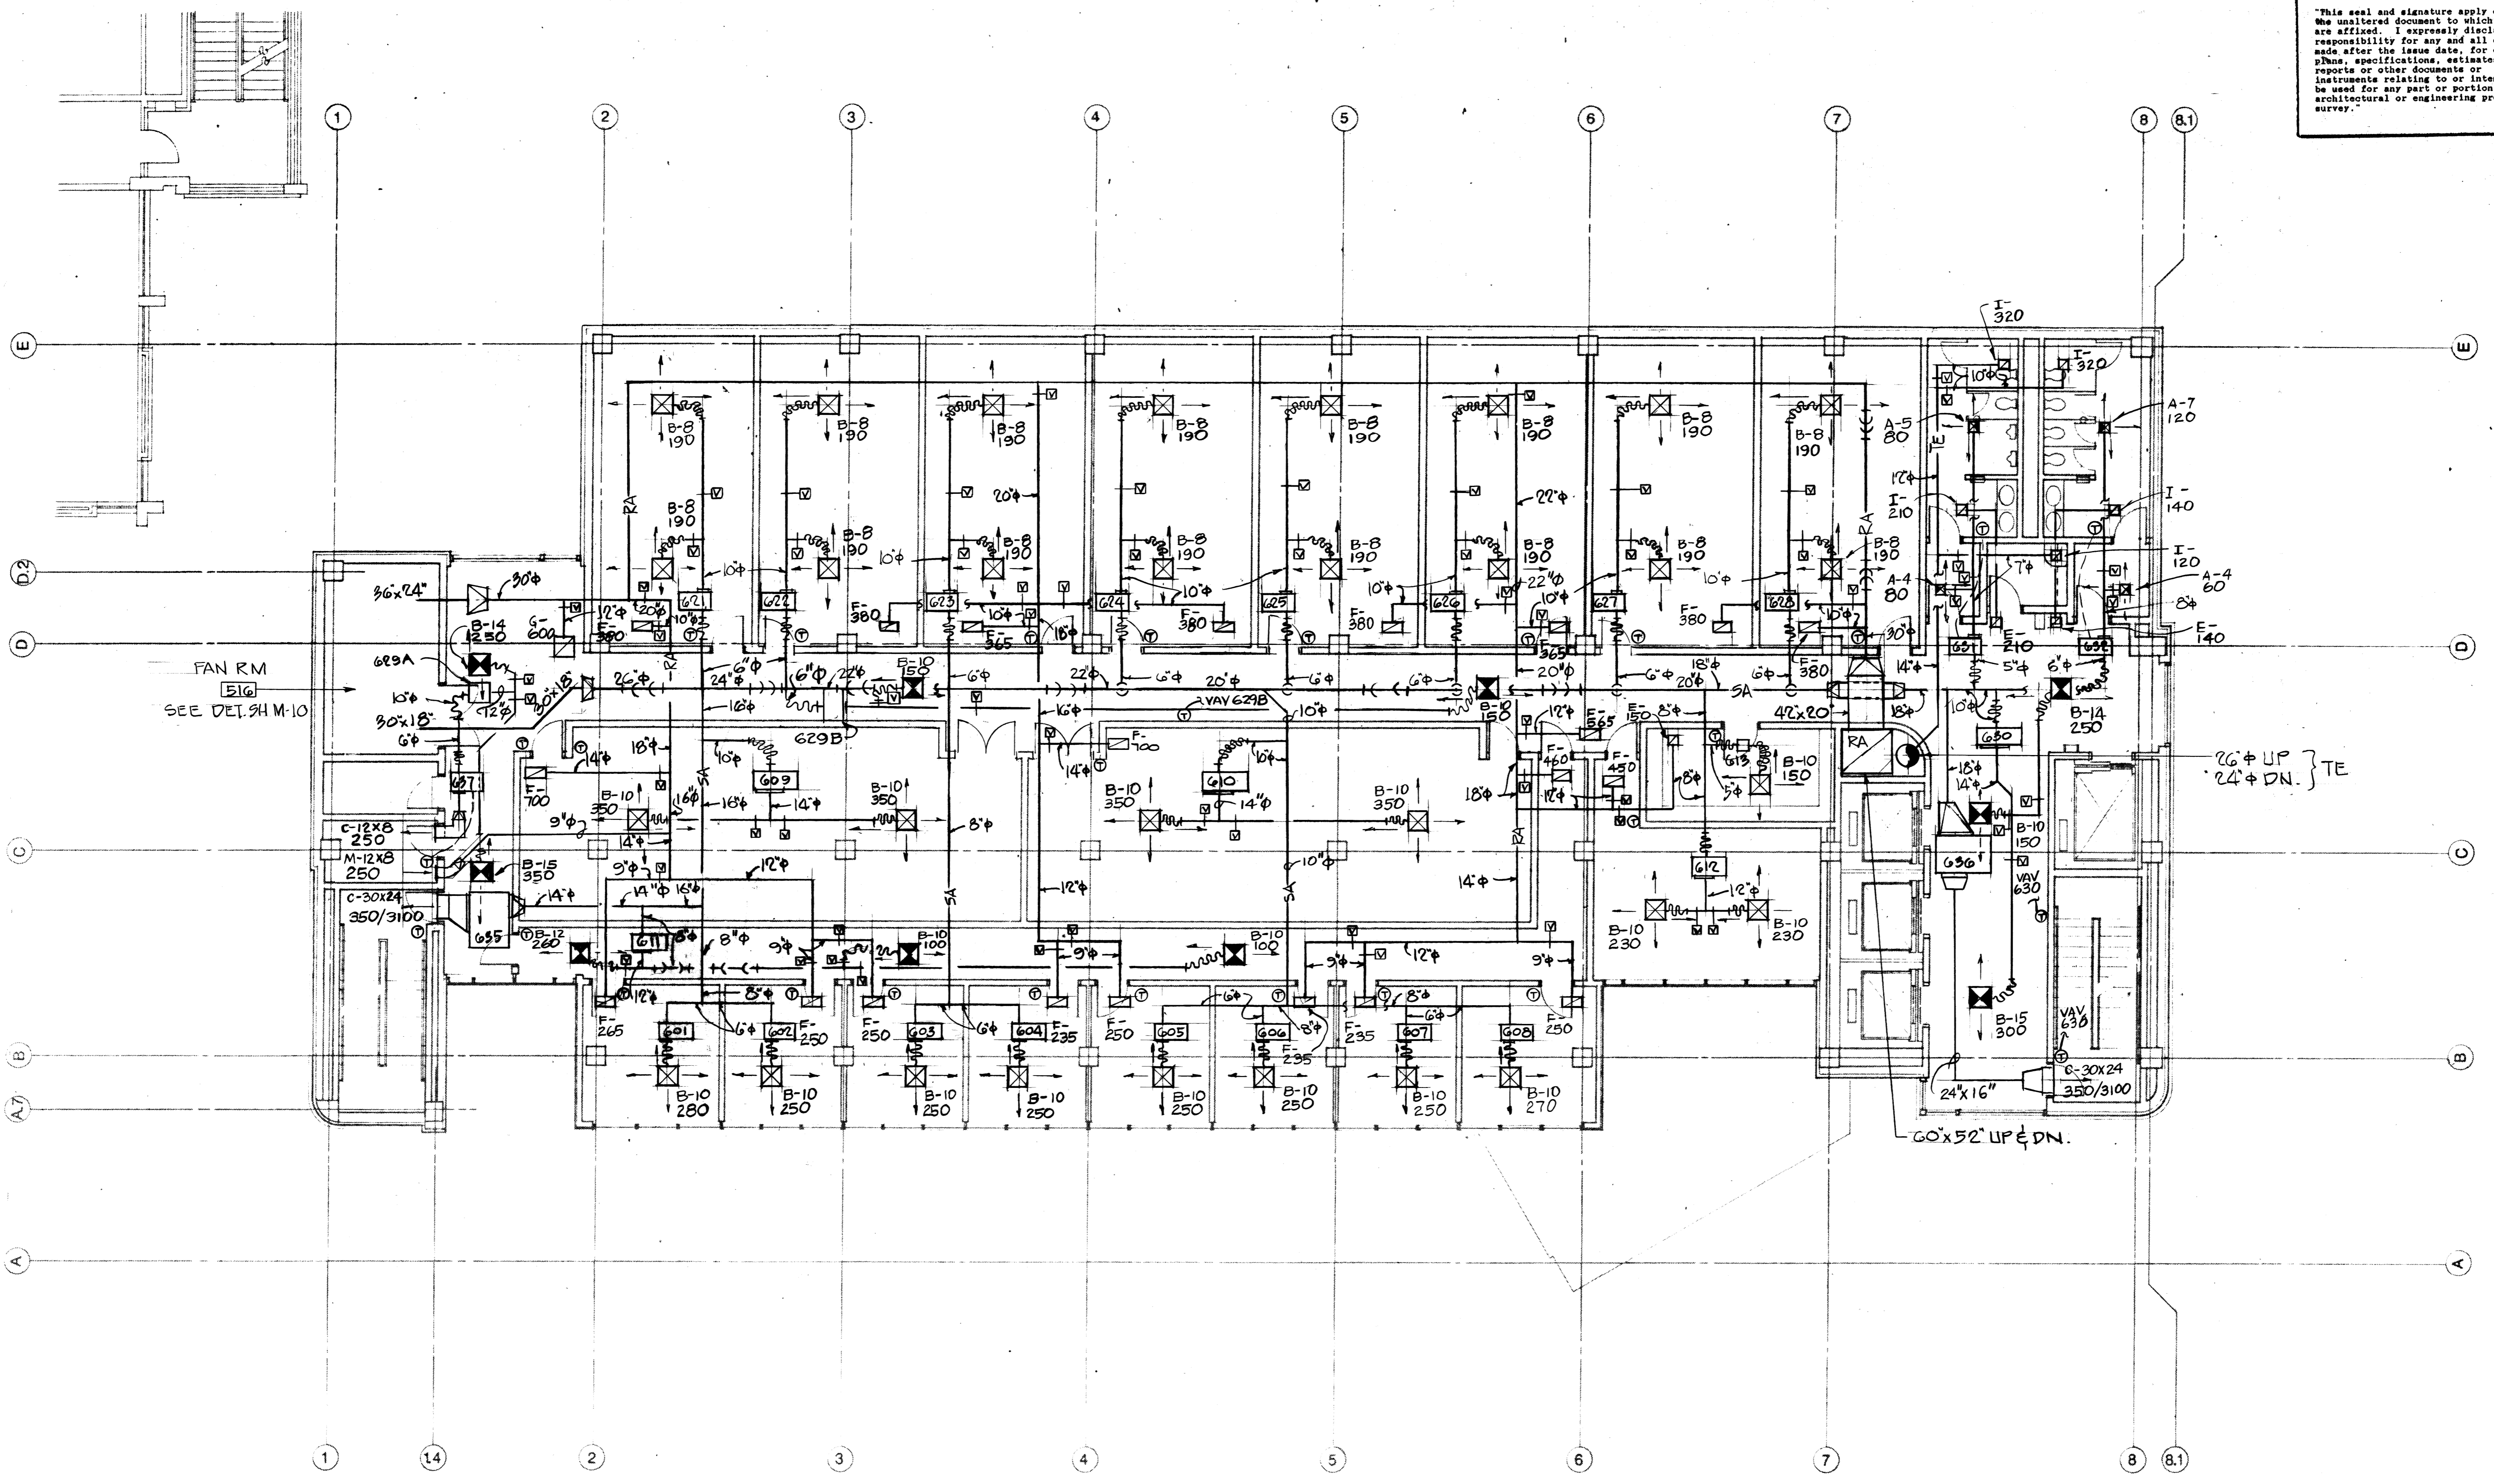


FIFTH FLOOR PLAN
1/8" = 1'-0"
BLDG. NORTH

AS BUILT

DocuSign
094938
82 B-3

"This seal and signature apply only to the unaltered document to which they are affixed. I expressly disclaim any responsibility for any and all changes made after the issue date, for other plans, specifications, estimates, reports or other documents or instruments relating to or intended to be used for any part or portion of the architectural or engineering project or survey."

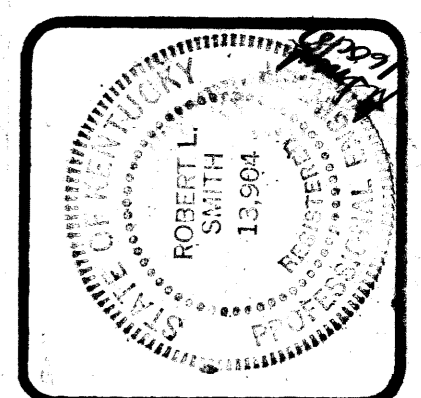

ROBOTICS FACILITY
LEXINGTON CAMPUS
UNIVERSITY OF KENTUCKY
LEXINGTON, KENTUCKY


University of Kentucky
Lexington, Kentucky
Walter J. Smith
DIRECTOR OF DESIGN AND CONSTRUCTION

PENTHOUSE/ROOF HVAC PLAN
Sherman Carter Barnhart
PARTNERS IN ARCHITECTURE
SUITE 1800 • 750 WEST MAIN STREET • LEXINGTON KY 40507 • 606-254-1351



JOB NO. **8706**
DATE **10-16-87**
DRAWN **S. Thompson**
CHECKED **WJL**
FILE NO. **431.0**

REVISIONS
3- 90% REVIEW
4- ADD COMPUTER ROOM SYSTEM
5- AS BUILT

SHEET
M-8
049339
B-3

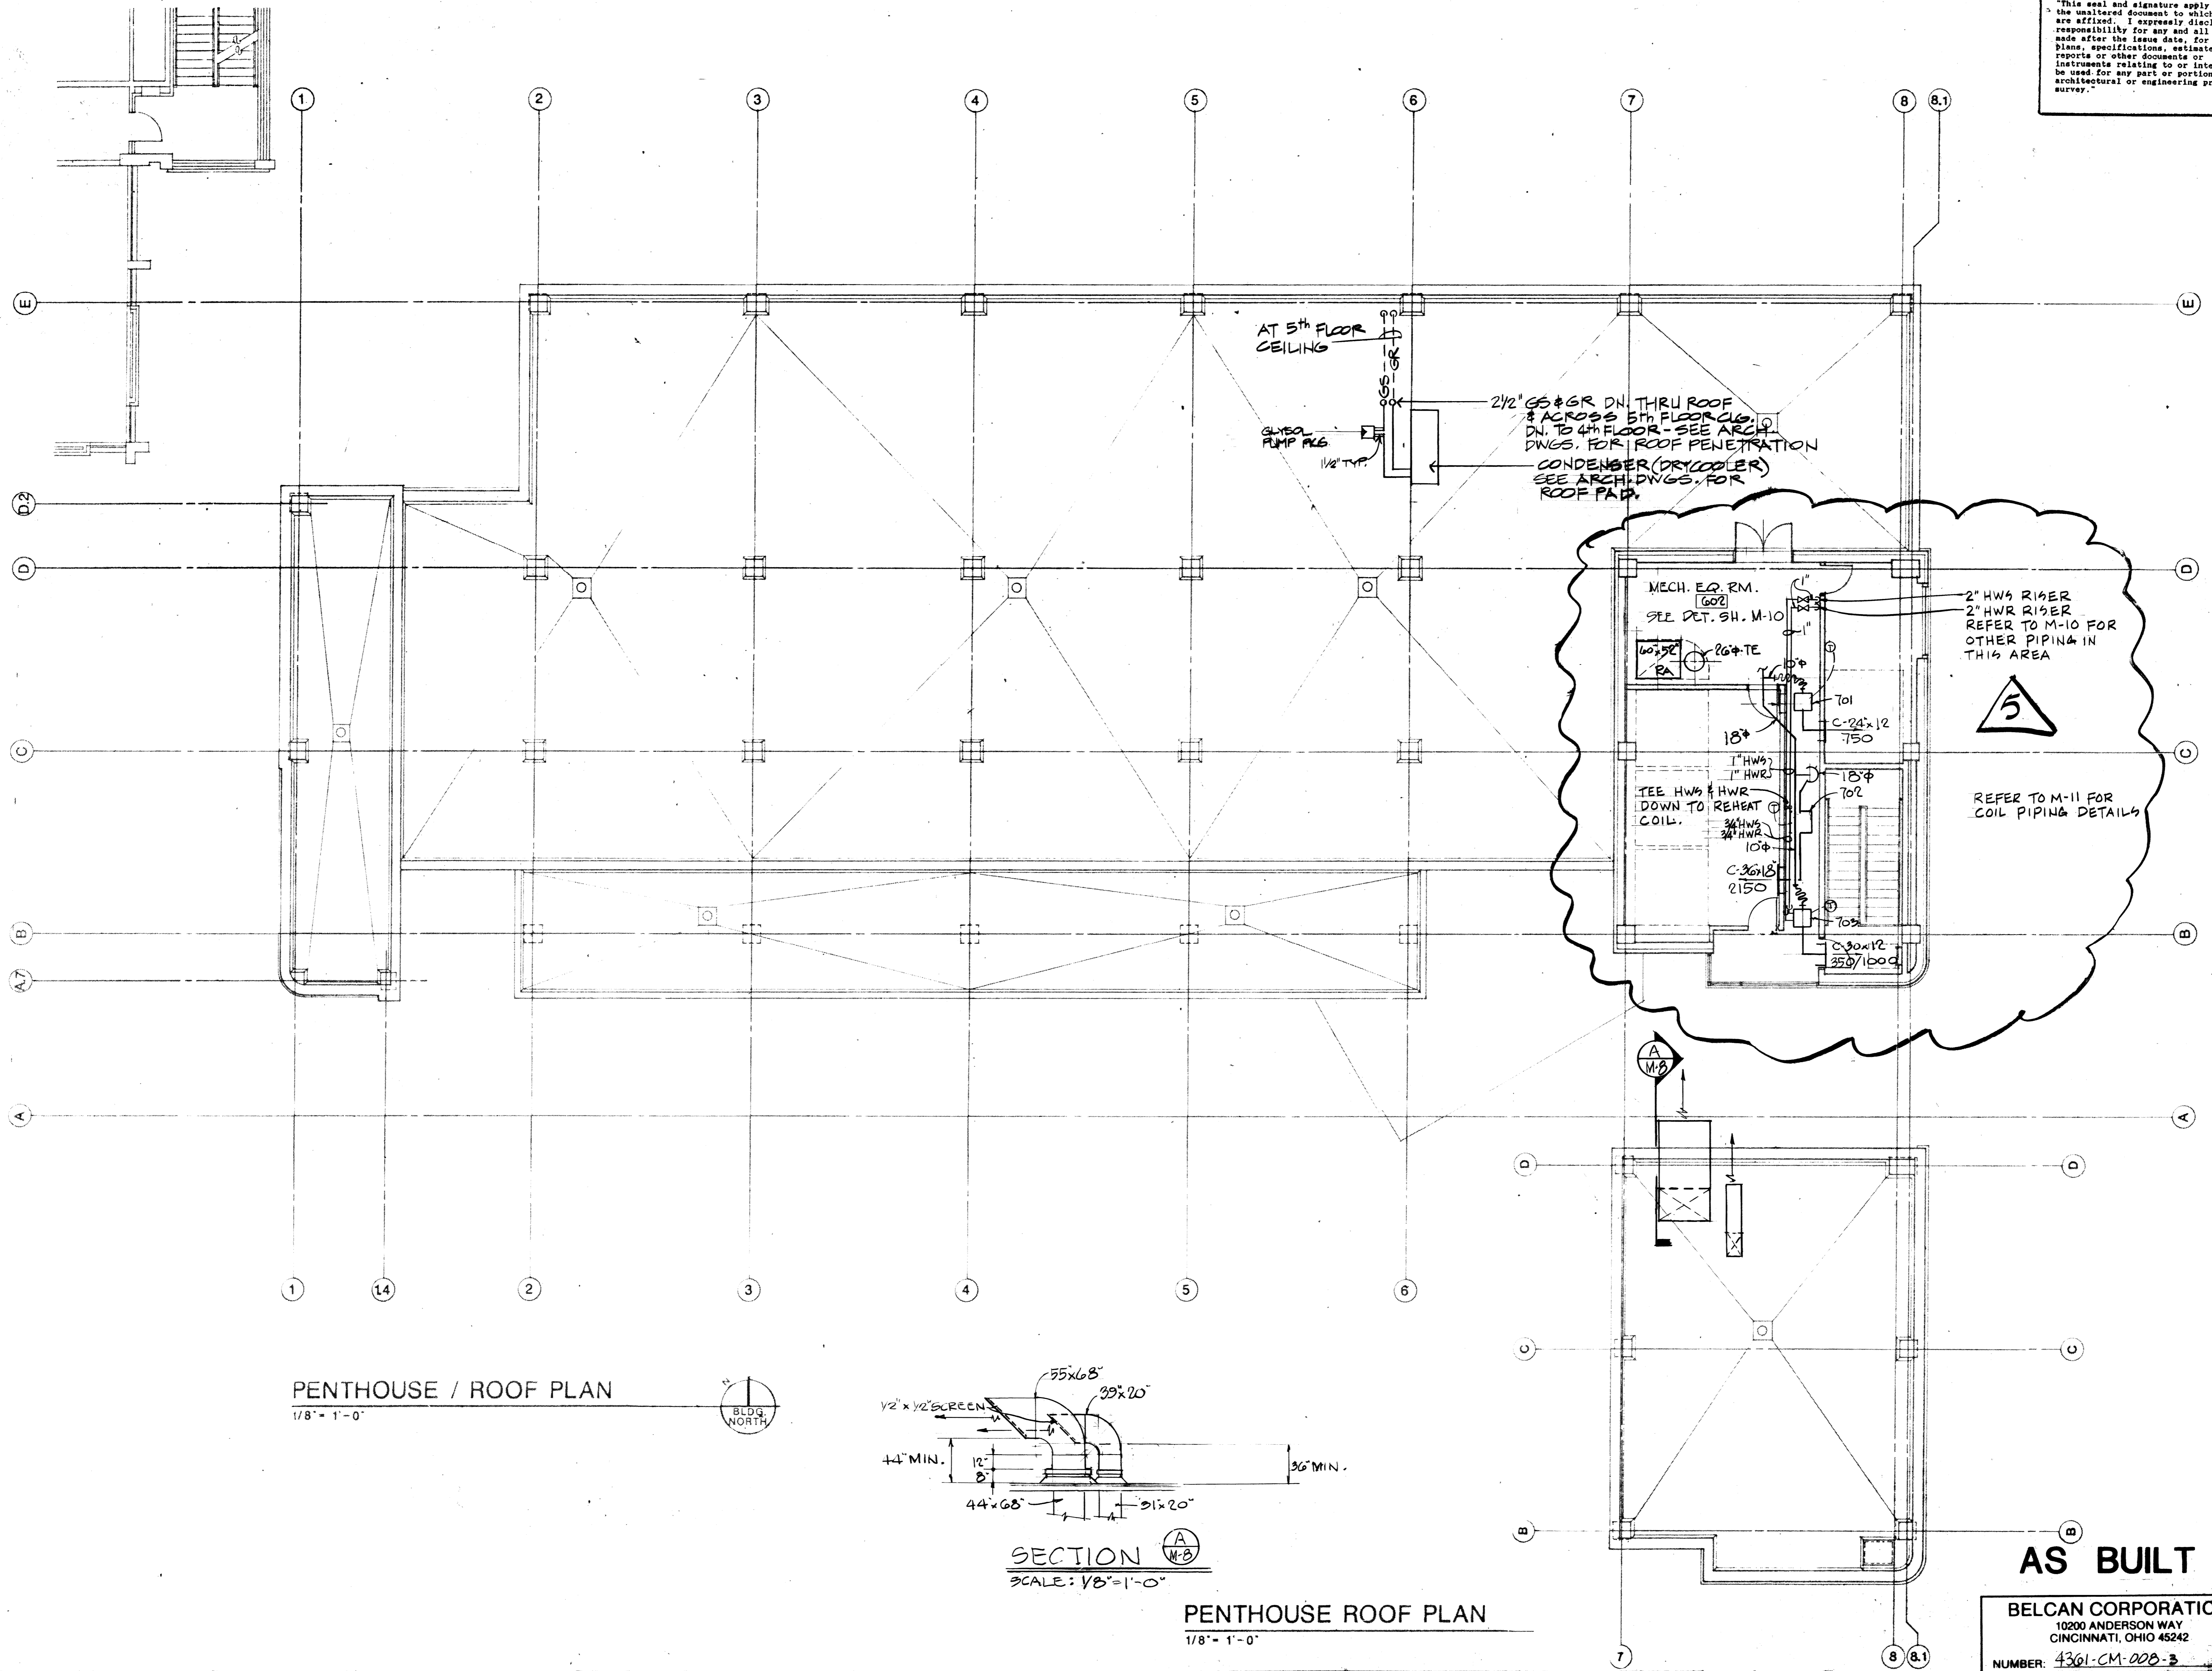

PENTHOUSE / ROOF PLAN
1/8" = 1'-0"

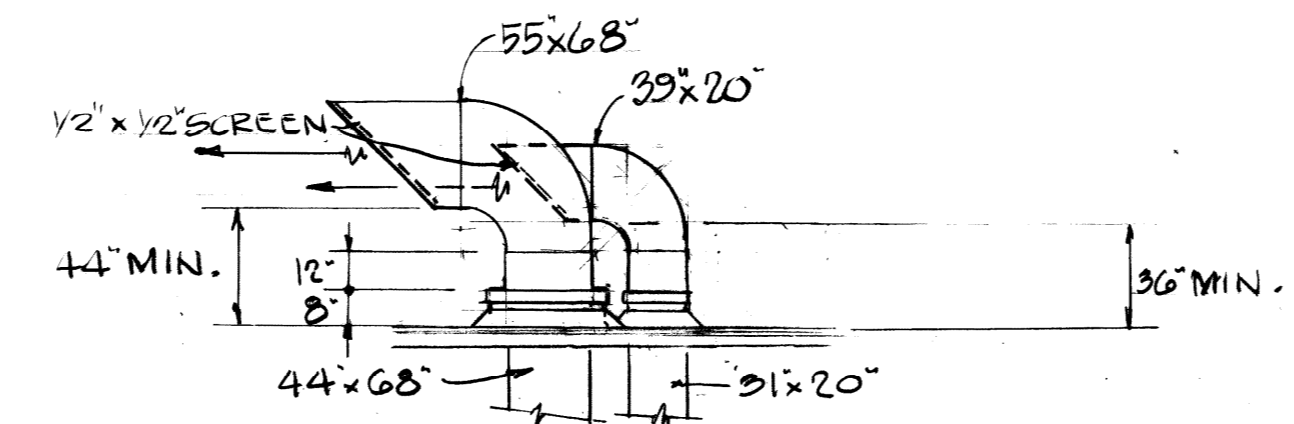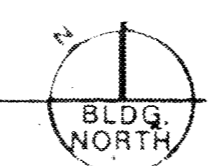


SECTION A-M-B
SCALE: 1/8" = 1'-0"

PENTHOUSE ROOF PLAN
1/8" = 1'-0"

AS BUILT

BELCAN CORPORATION
10200 ANDERSON WAY
CINCINNATI, OHIO 45242
NUMBER: **4361-CM-028-3**

This seal and signature apply only to the unaltered document to which they are affixed. I expressly disclaim any responsibility for any and all changes made after the issue date, for other plans, specifications, estimates, reports or other documents or instruments relating to or intended to be used for any part or portion of the architectural or engineering project or survey.

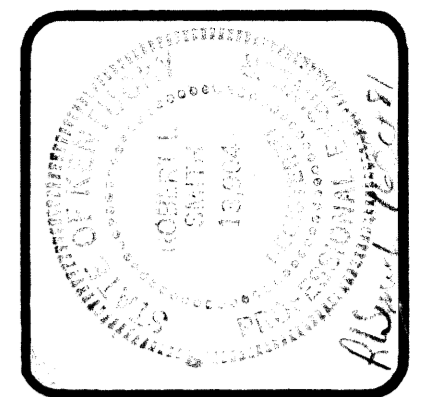

ROBOTICS FACILITY
LEXINGTON CAMPUS
UNIVERSITY OF KENTUCKY
LEXINGTON, KENTUCKY







University of Kentucky
Lexington, Kentucky
10-19-97
William J. Bunn
Principal, design and construction division

PART PLANS HVAC & PIPING
Sherman Carter Barnhart
PARTNERS IN ARCHITECTURE
SUITE 900 • 250 WEST MAIN STREET • LEXINGTON, KY 40507 • 606-254-1351

JOB NO. 8700
DATE 10-16-97
DRAWN S. THOMPSON
CHECKED [Signature]
BY FILE NO. [Signature]


REVISIONS
3- 90% REVIEW
4- AS BUILT

SHEET
M-10
B-3
004941

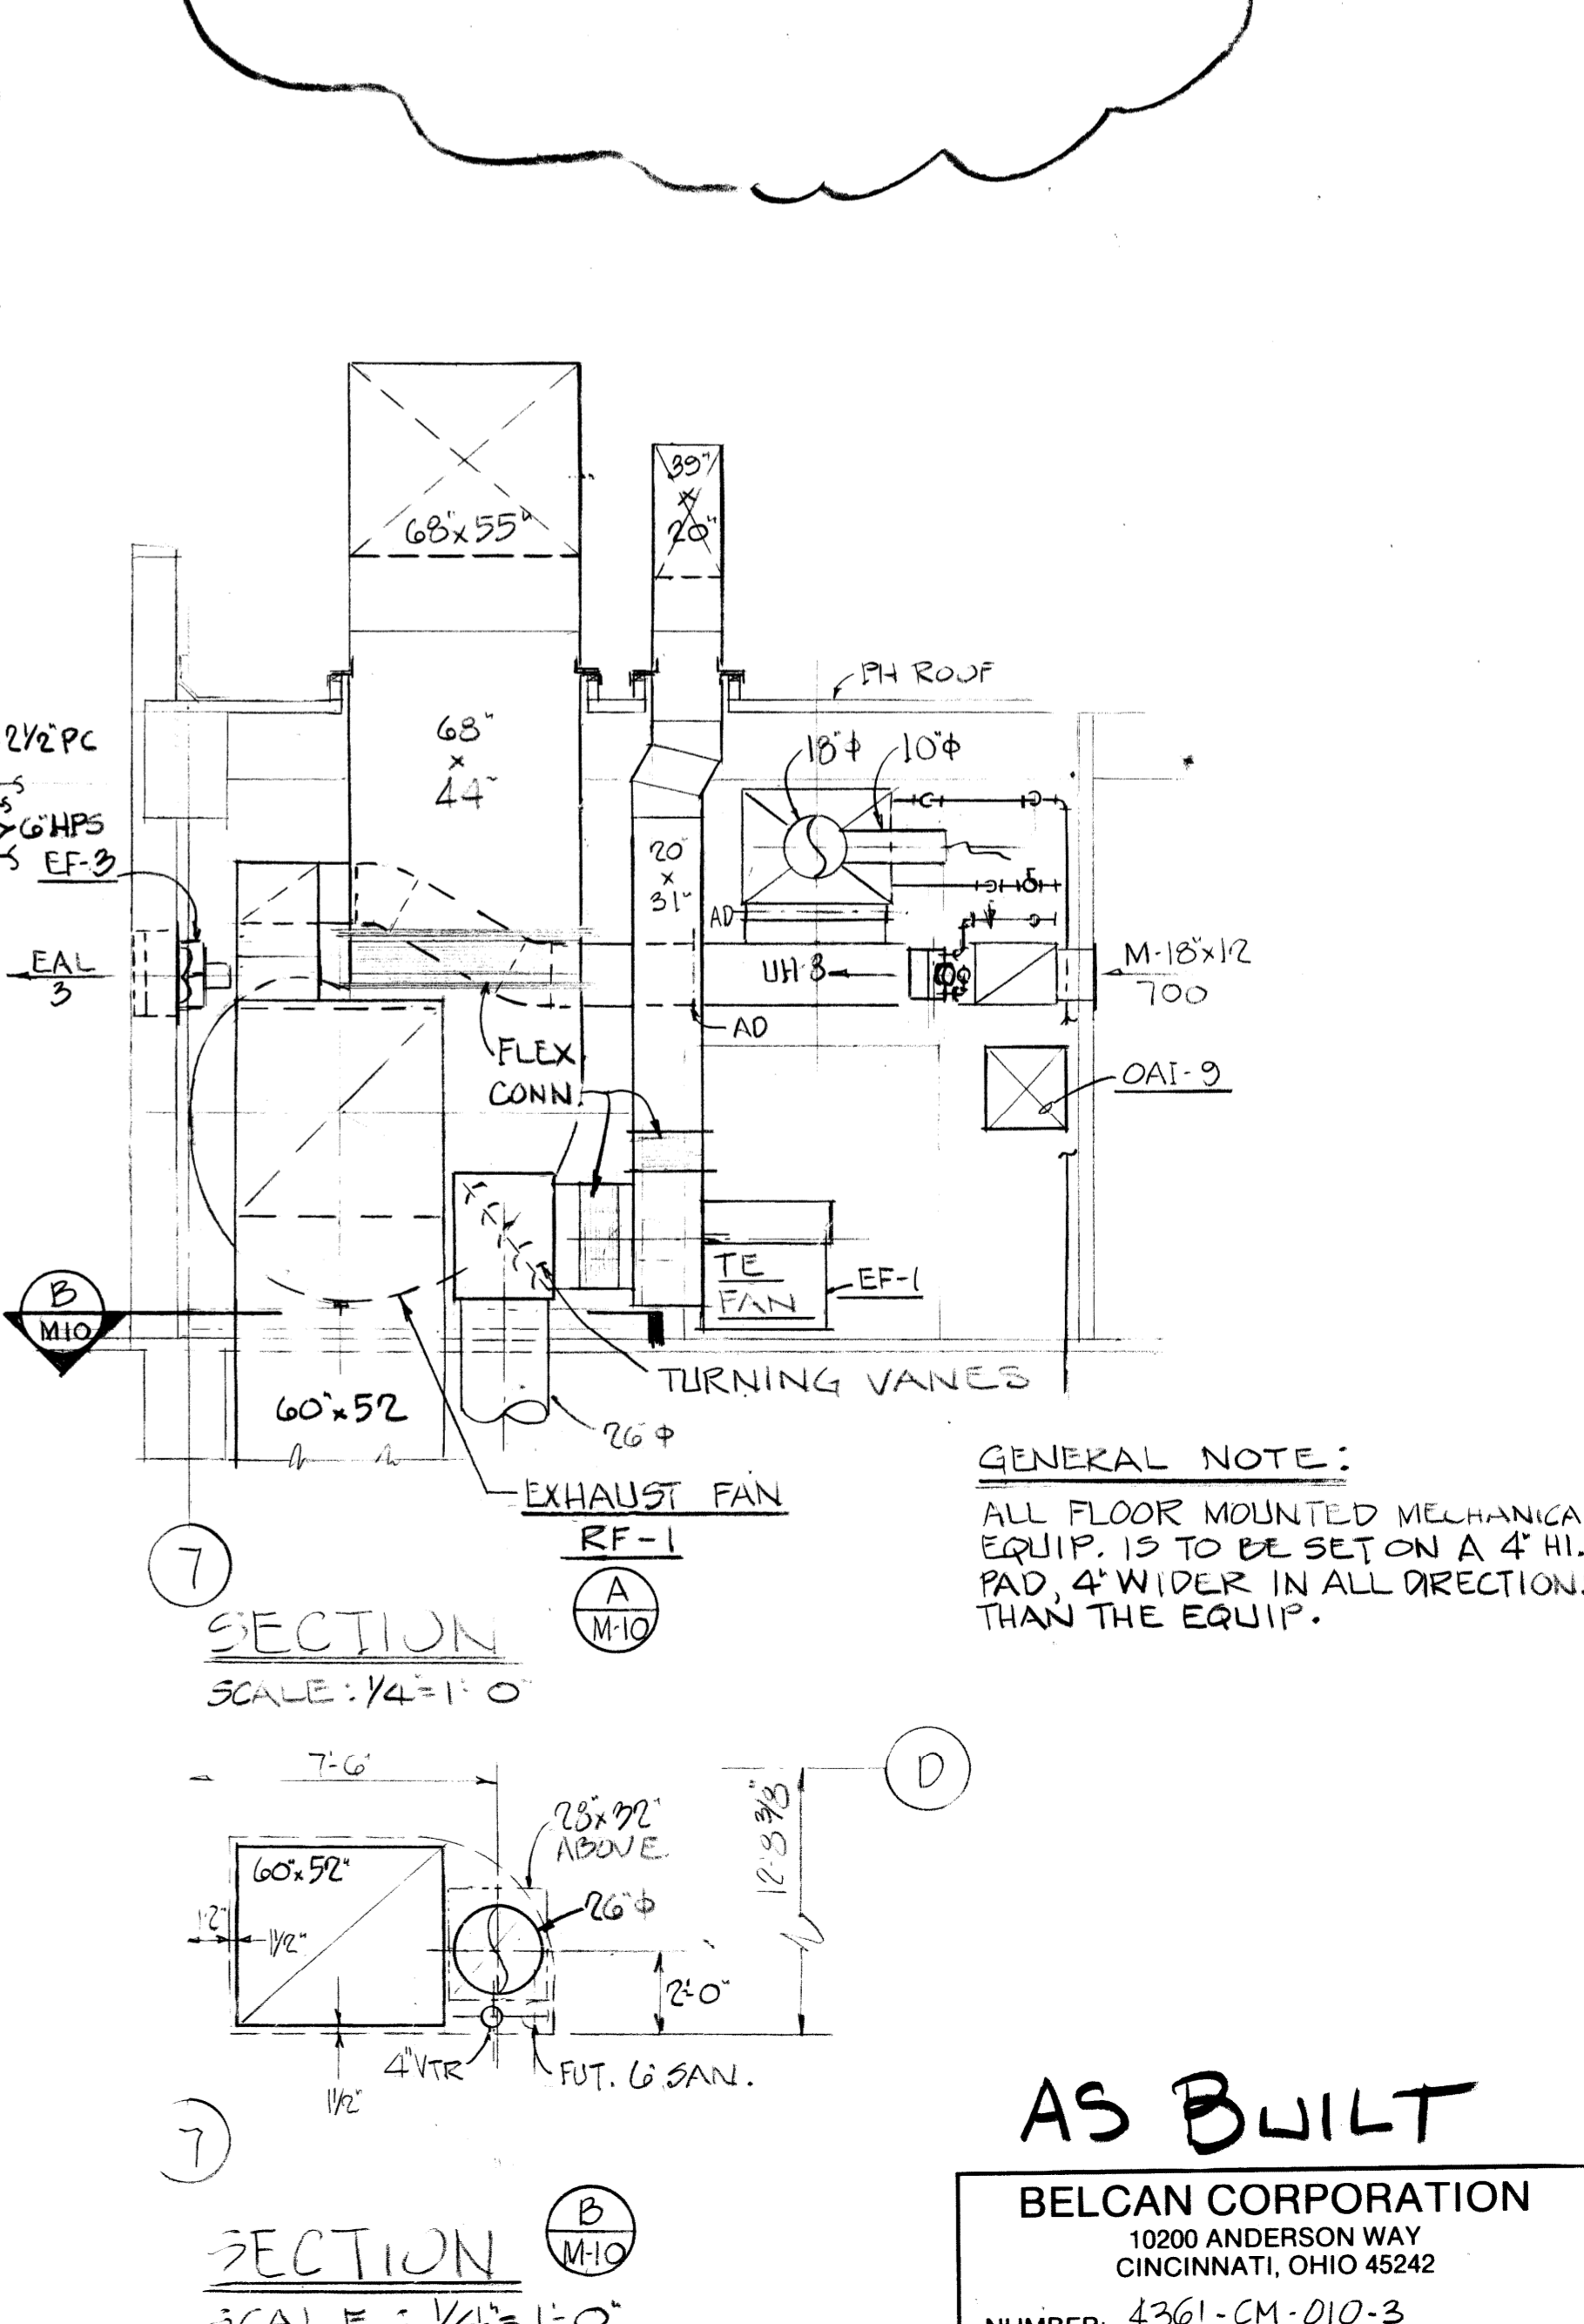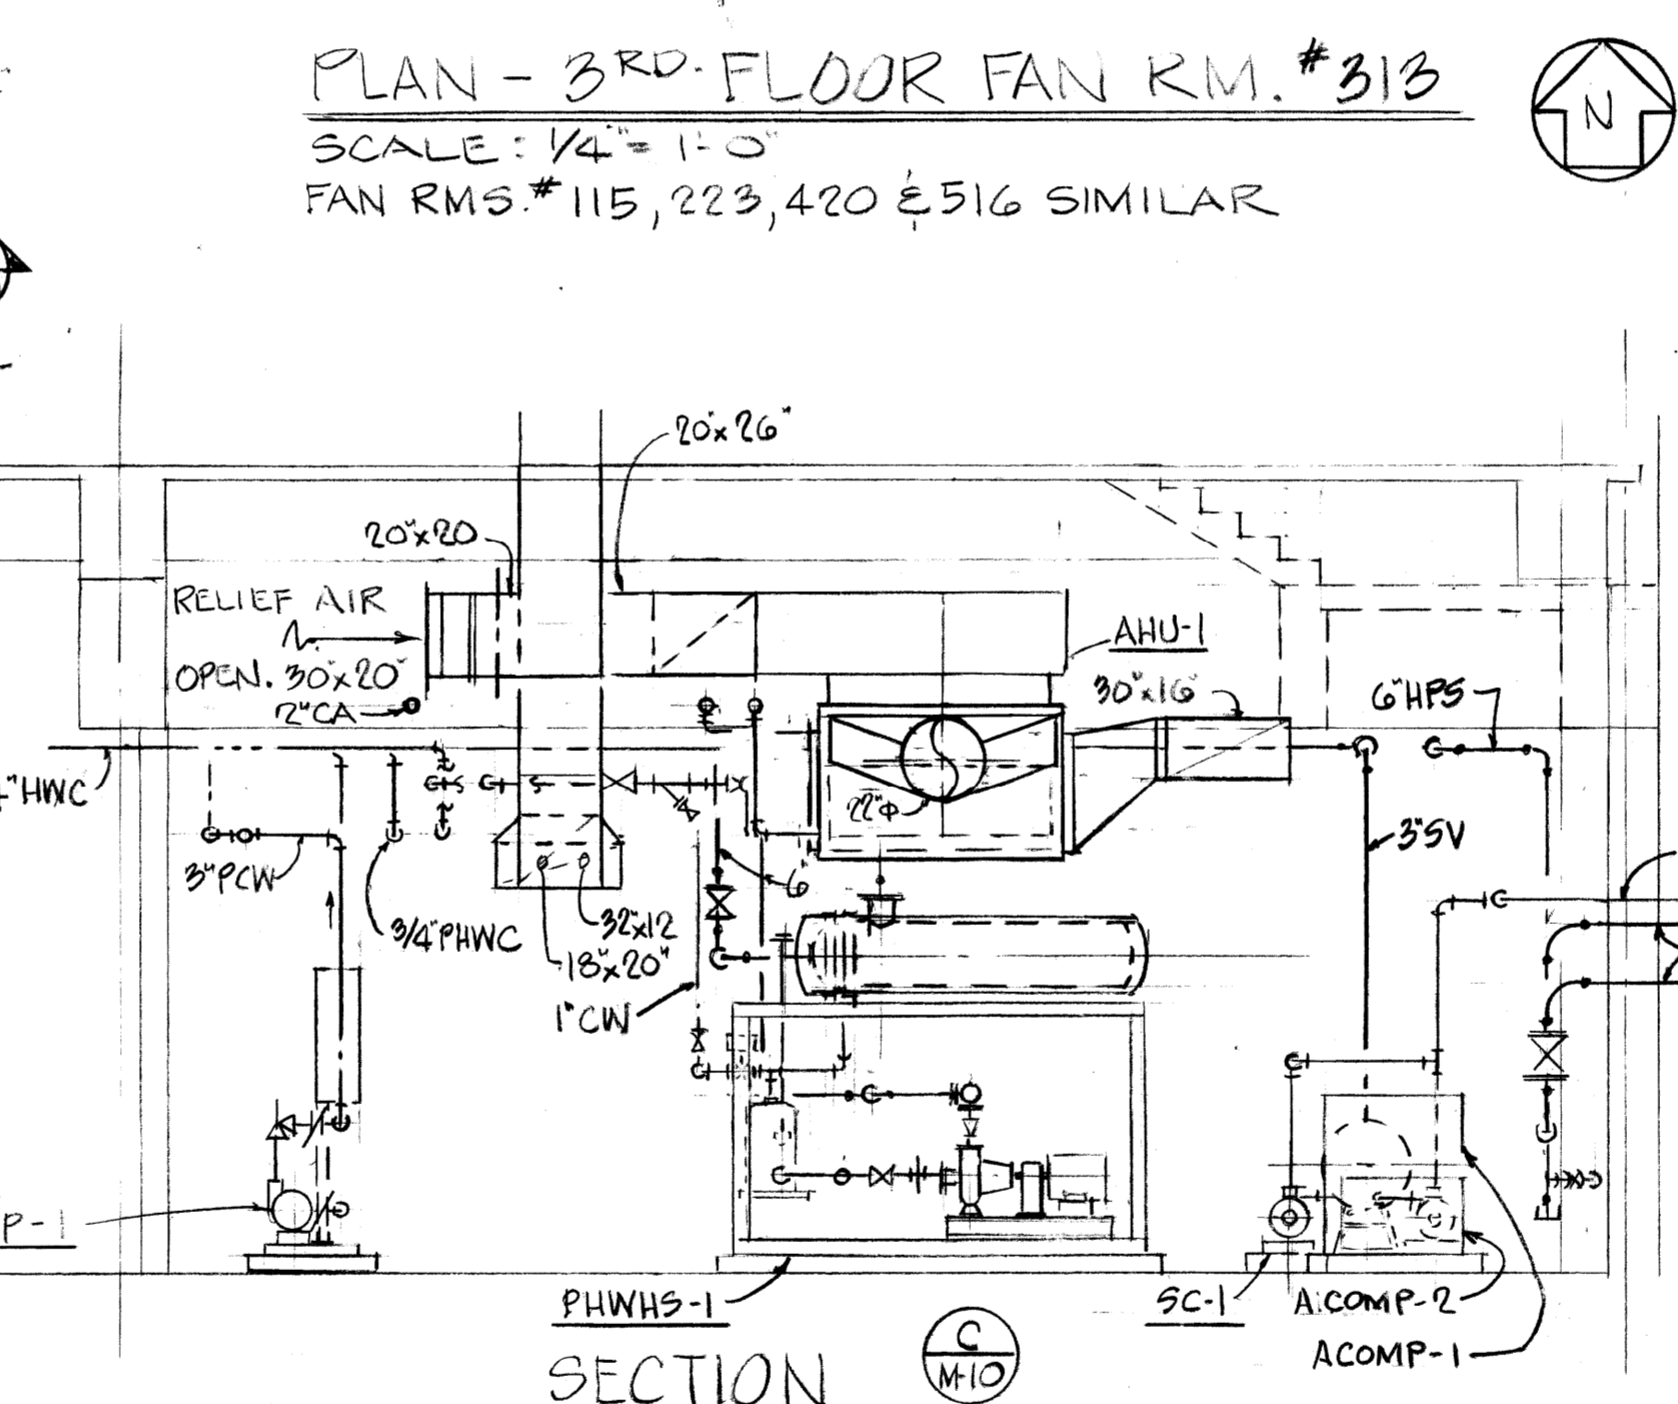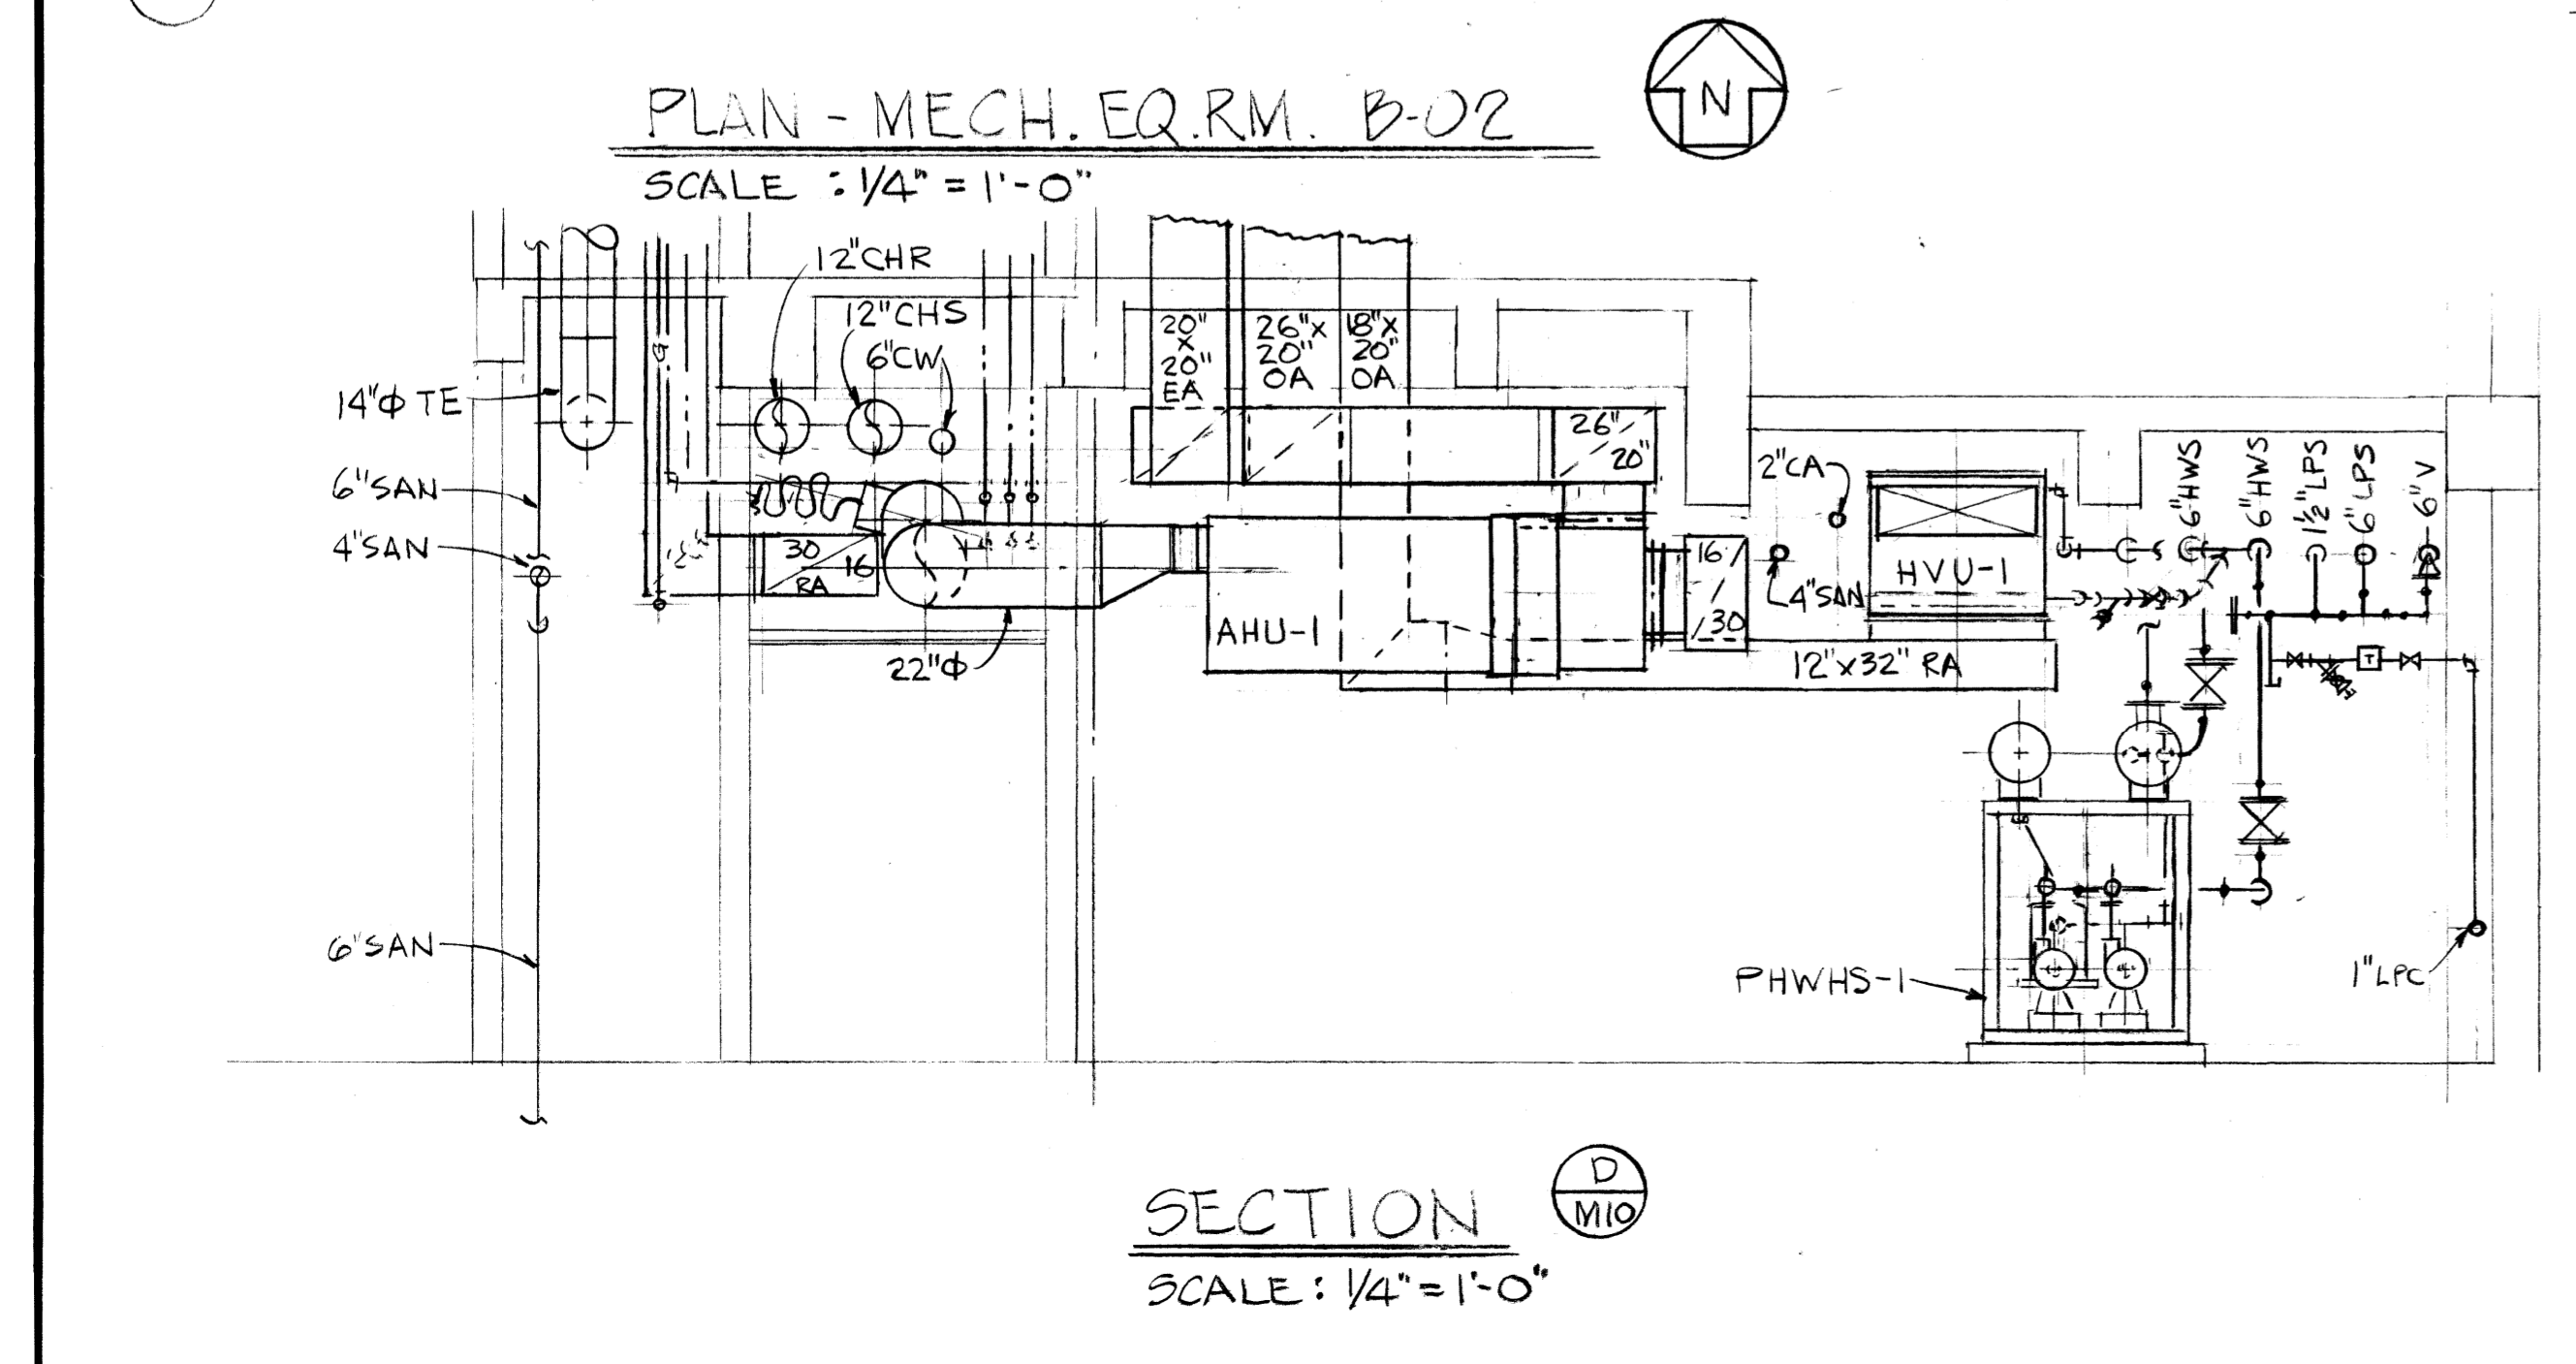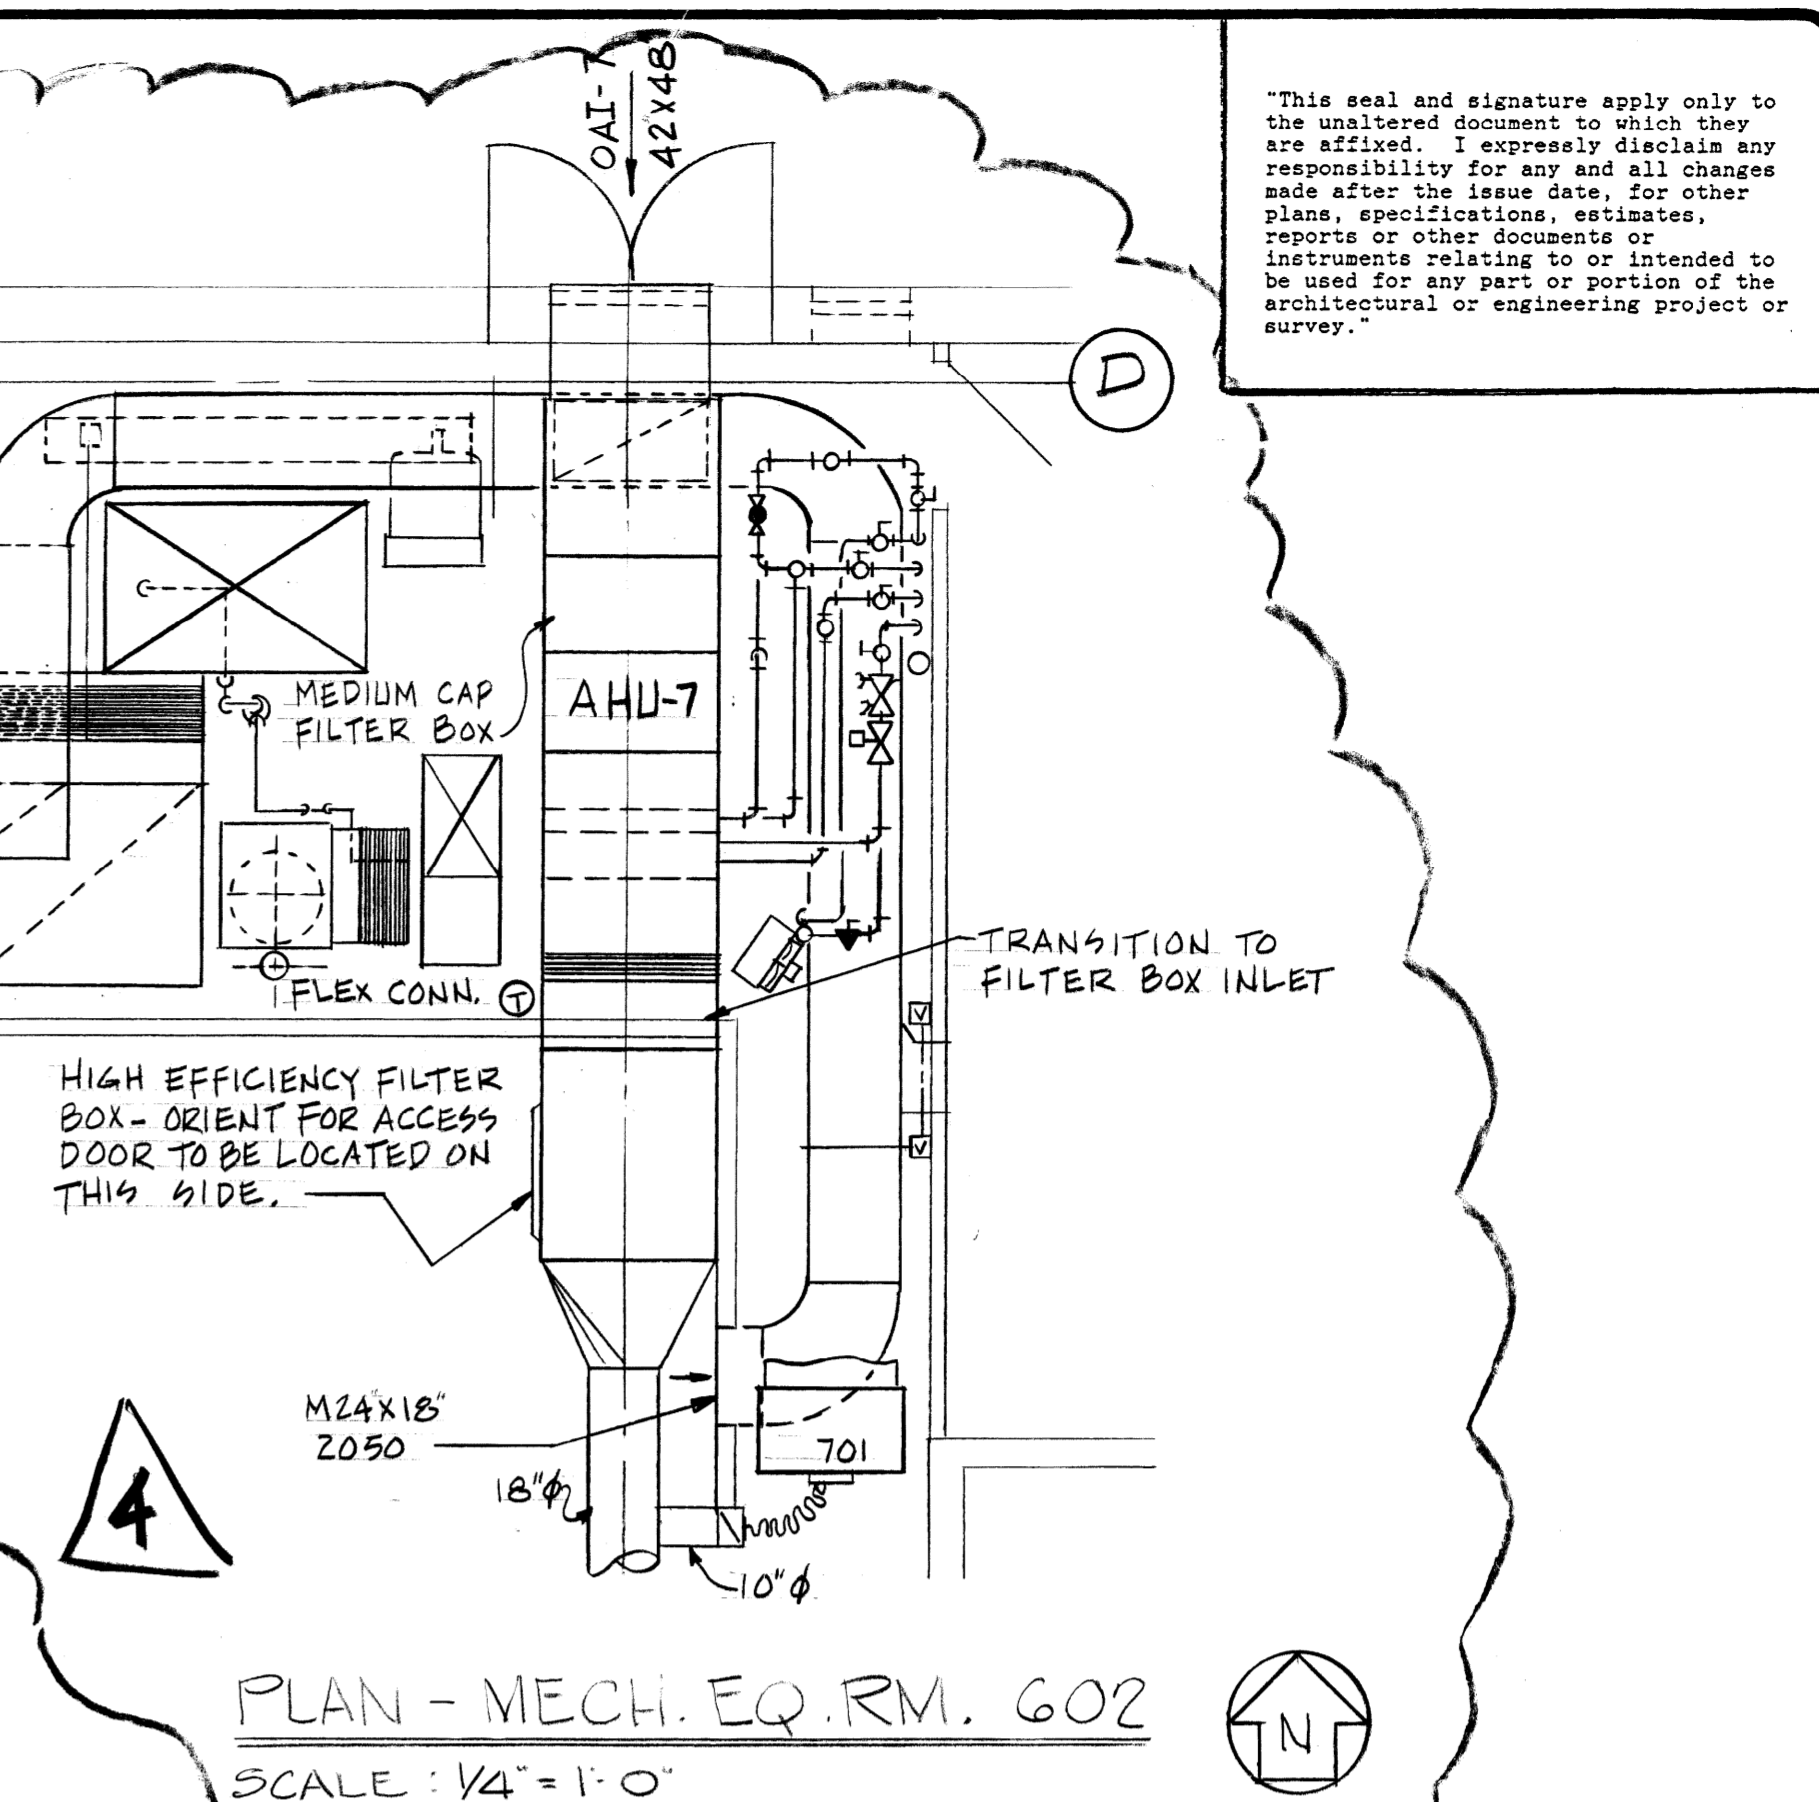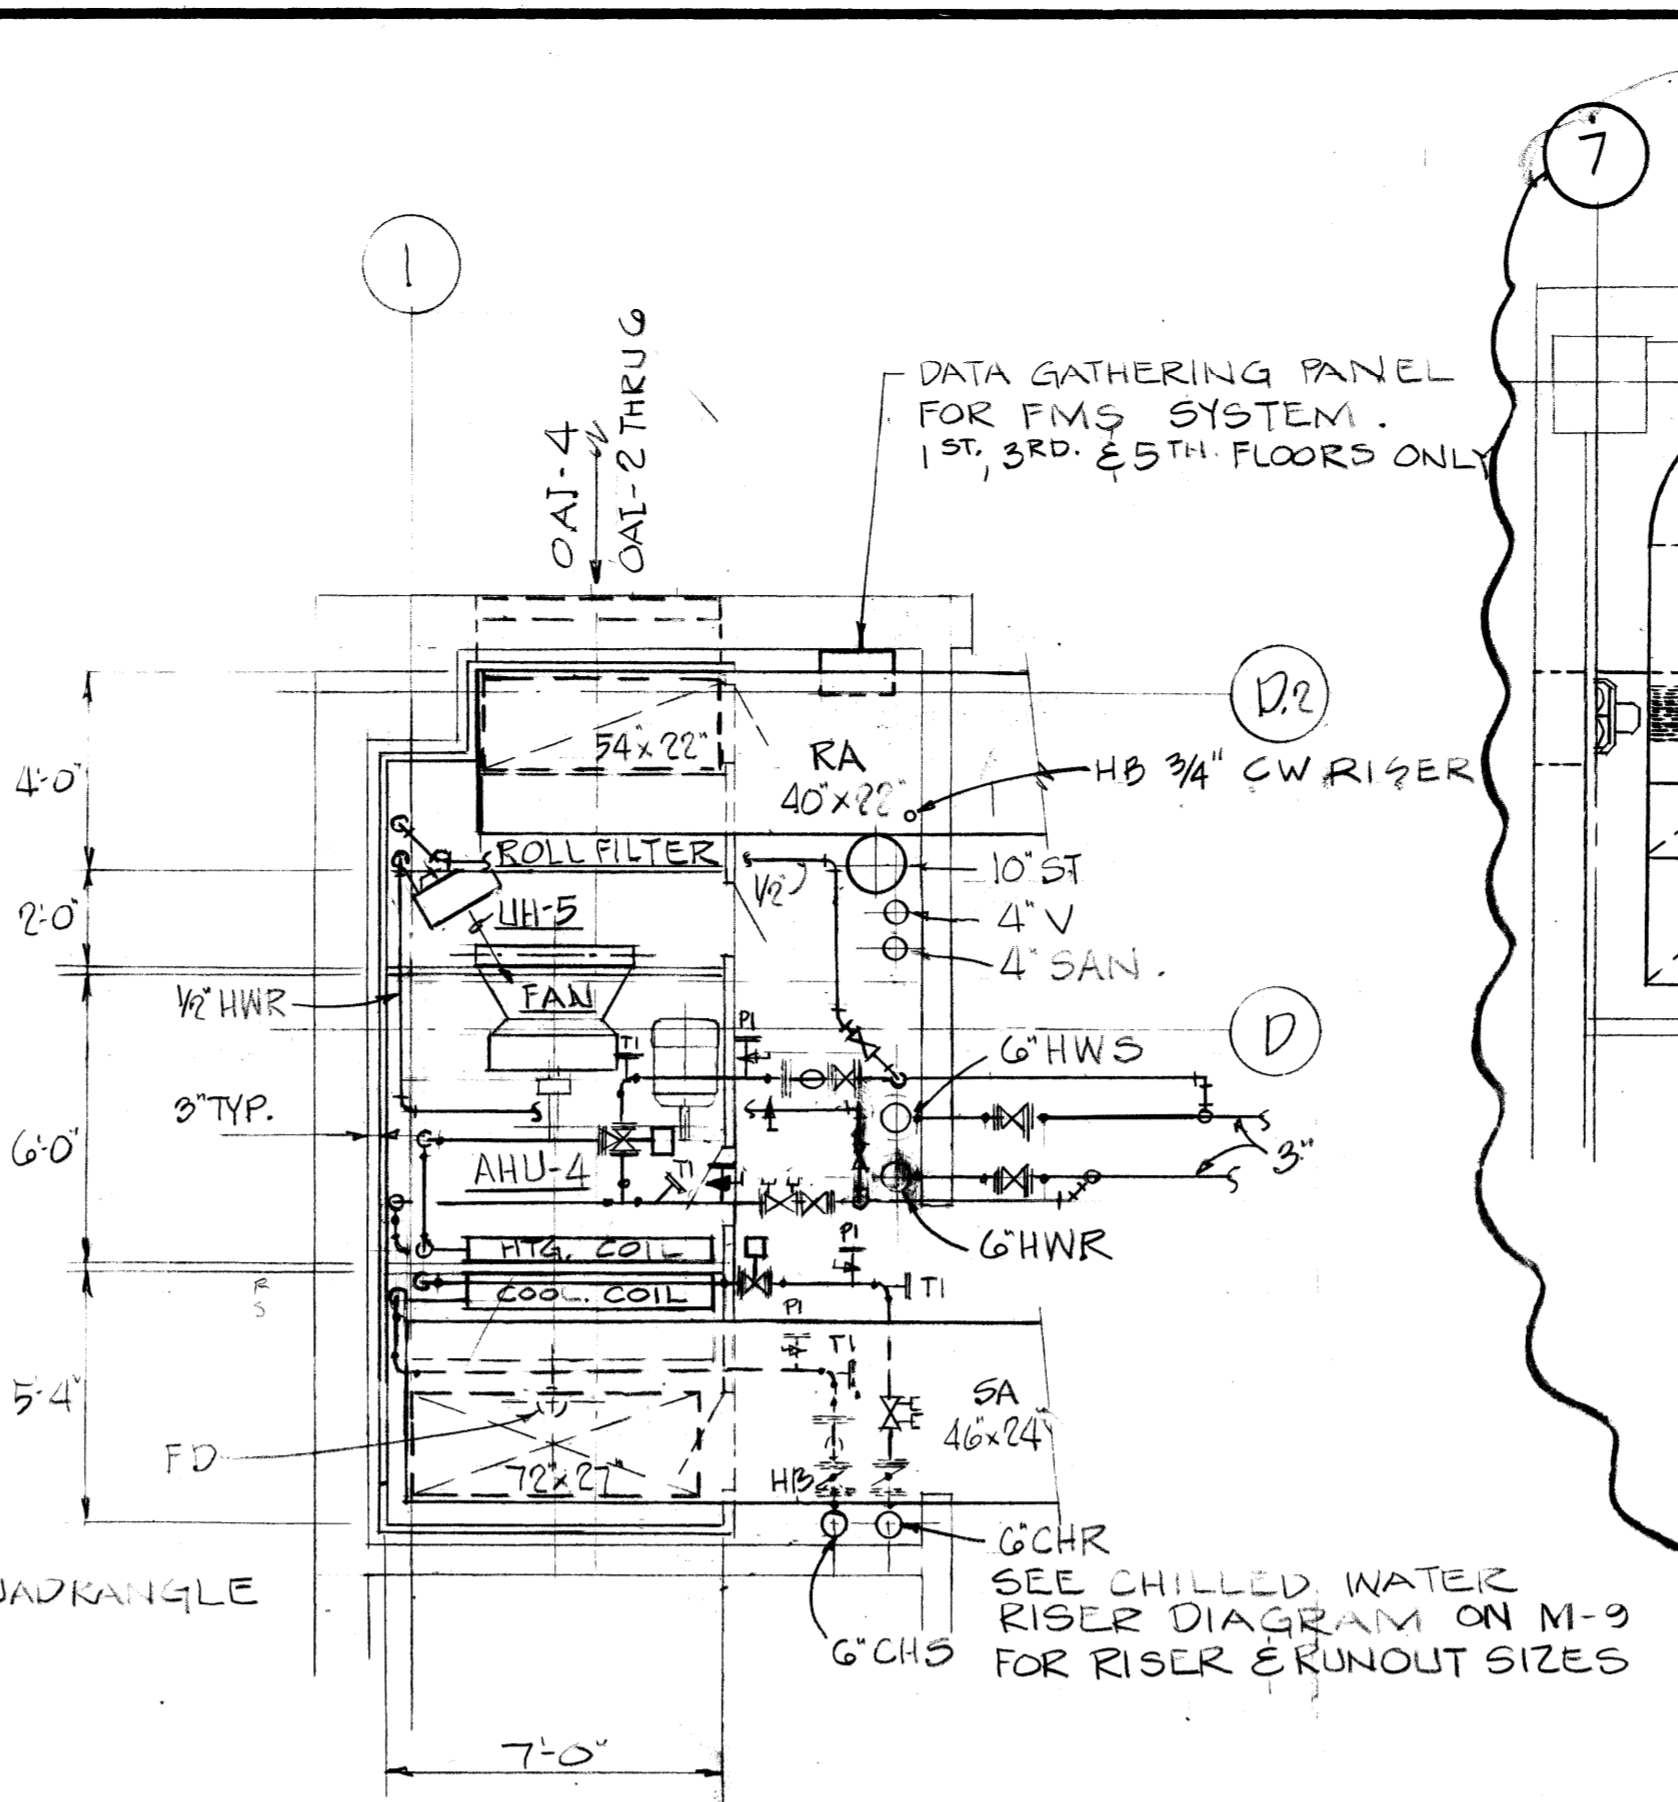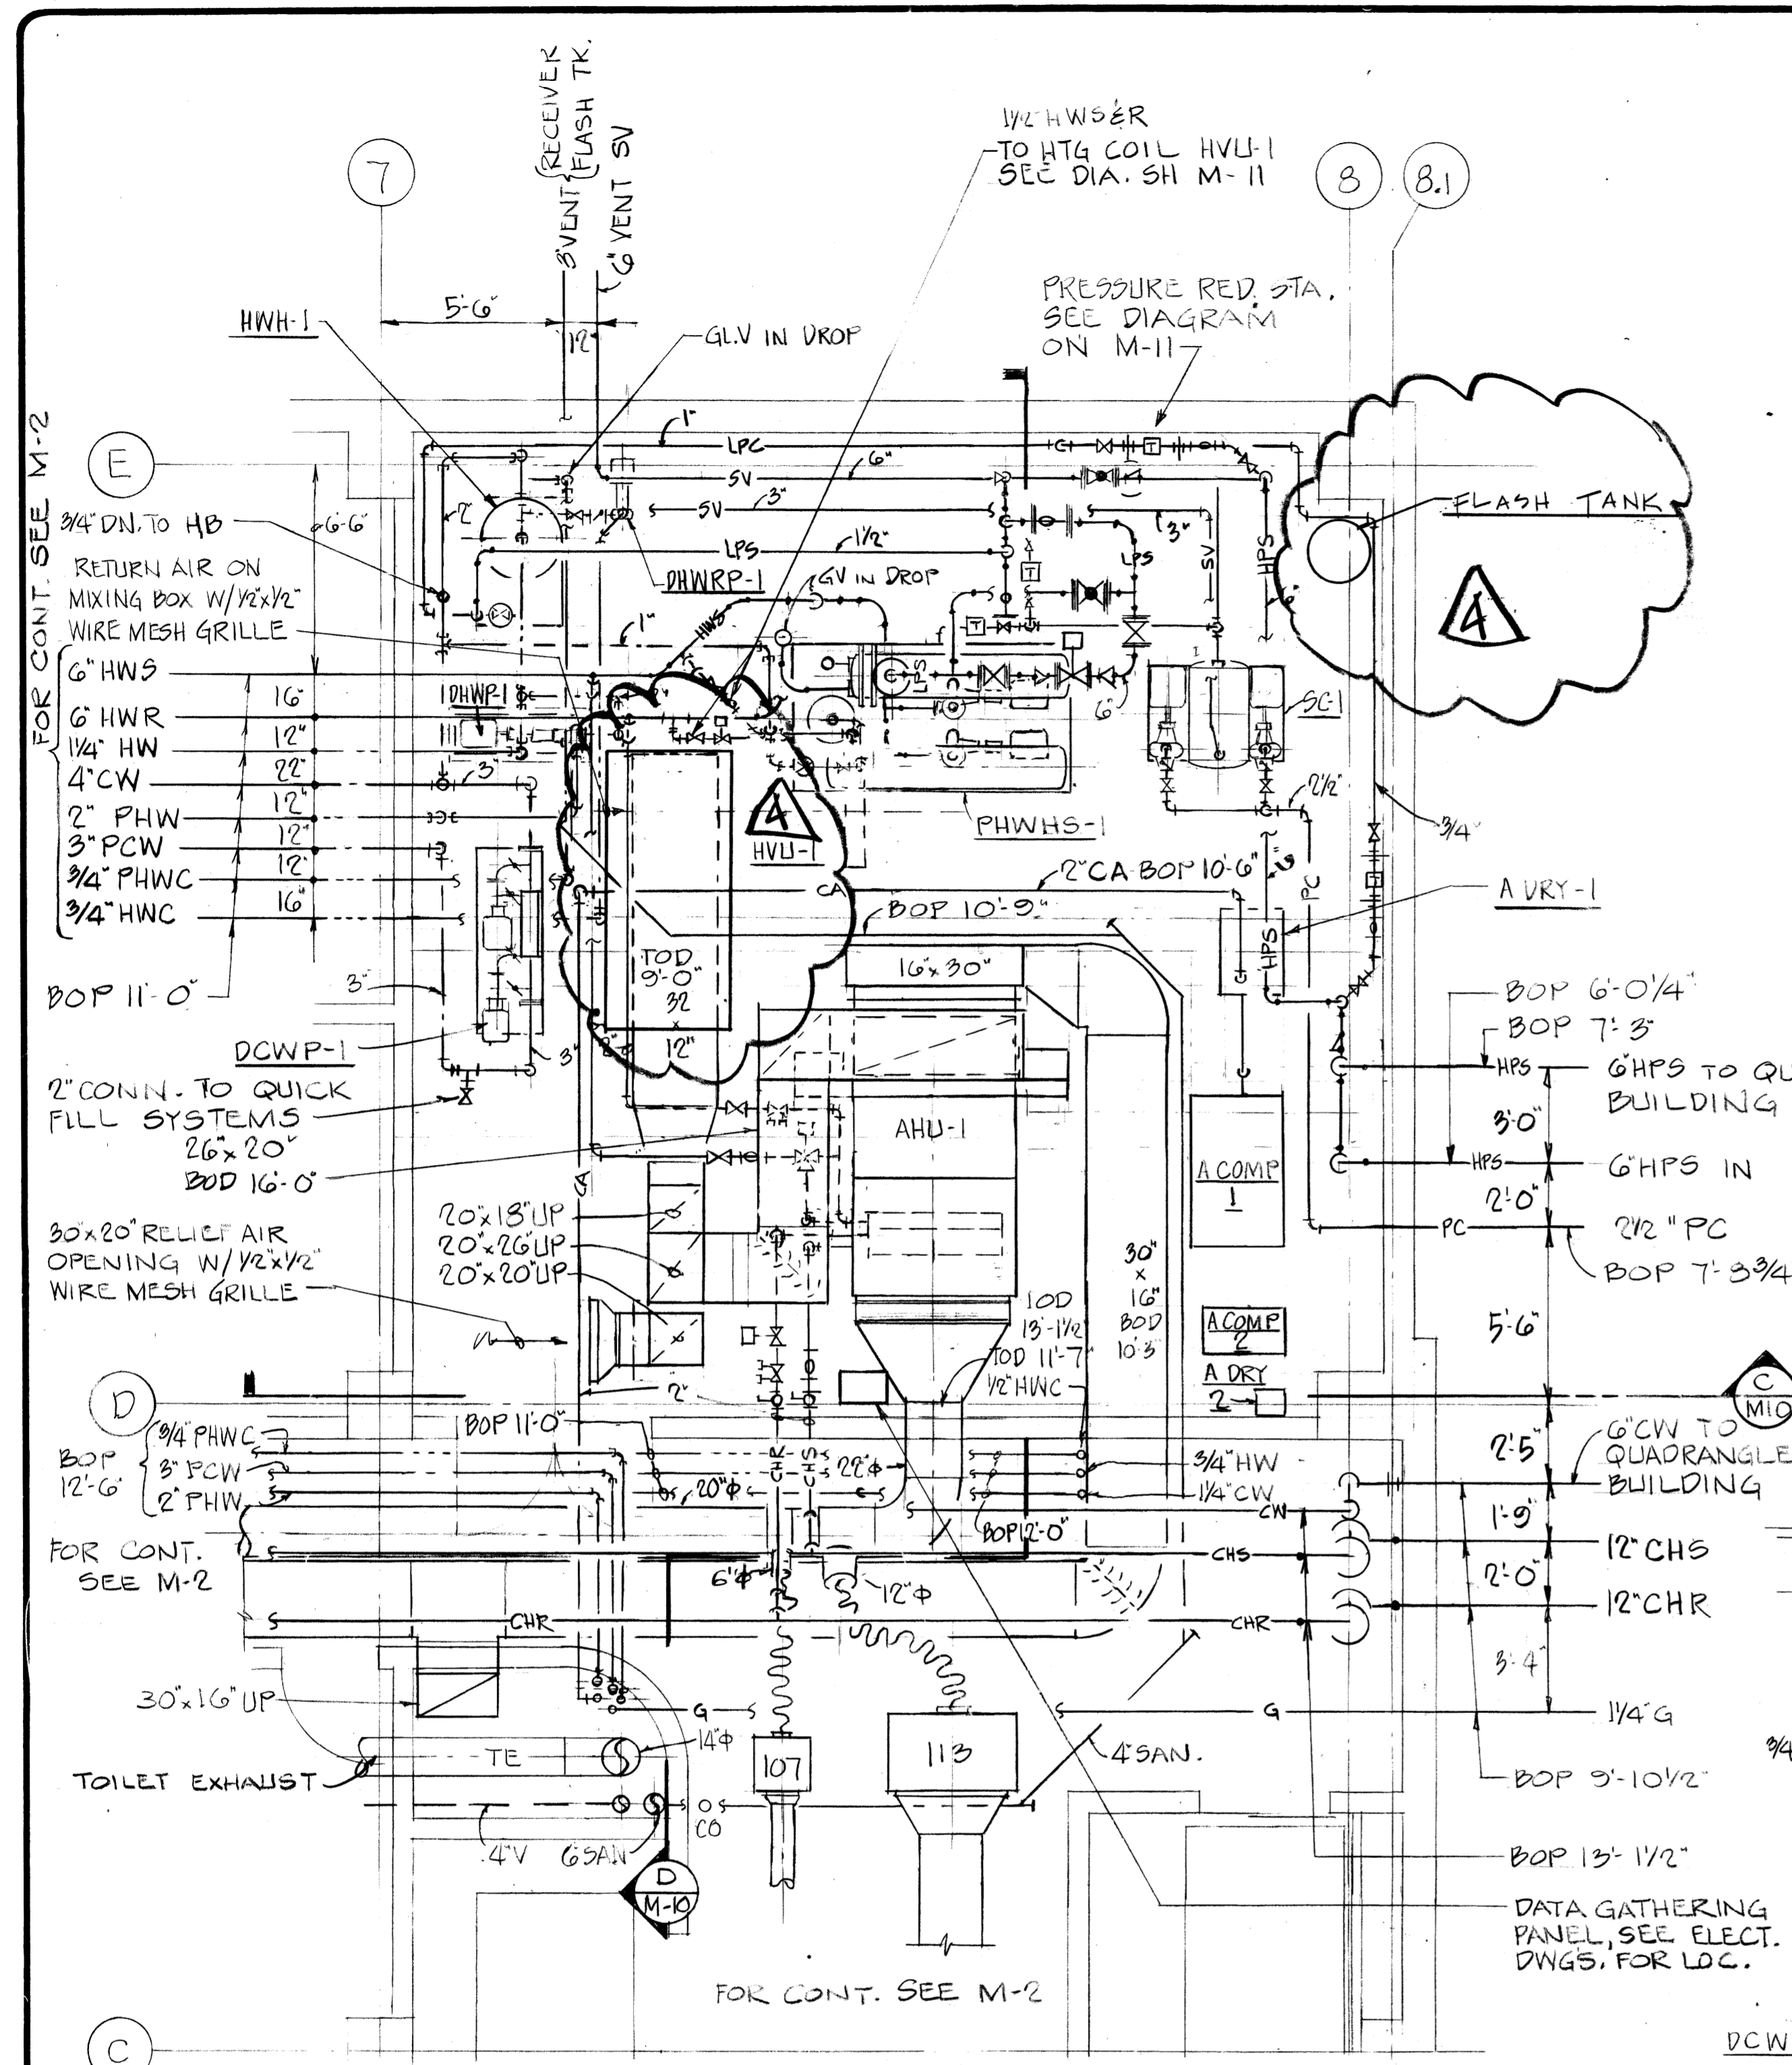

GENERAL NOTE:
ALL FLOOR MOUNTED MECHANICAL EQUIP. IS TO BE SET ON A 4" HI. PAD, 4" WIDER IN ALL DIRECTIONS THAN THE EQUIP.

AS BUILT
BELCAN CORPORATION
10200 ANDERSON WAY
CINCINNATI, OHIO 45242
NUMBER: 4361-CM-010-3

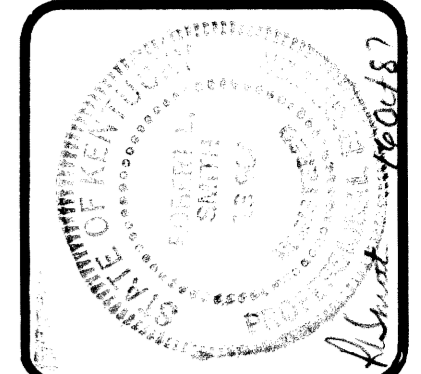

ROBOTICS FACILITY
LEXINGTON CAMPUS
UNIVERSITY OF KENTUCKY
LEXINGTON, KENTUCKY

University of Kentucky
Lexington, Kentucky
10-19-87
SHERMAN CARTER
ARCHITECTS
design and construction division


MECHANICAL DETAILS
Sherman Carter Architects
PARTNERS IN ARCHITECTURE
SUITE 1500 • 250 WEST MAIN STREET • LEXINGTON, KY 40507 • 606.254.1051

JOB NO. 8706
DATE 10-16-87
DRAWN S. THOMPSON
CHECKED [Signature]
ON FILE NO. 421.3


REVISIONS
3 - 90% REVIEW
4 - AS BUILT

SHEET
M-12
B-3
82
NUMBER: 4301-CM-012-3


This seal and signature apply only to the unaltered document to which they are affixed. I expressly disclaim any responsibility for any and all changes made after the issue date. For other plans, specifications, estimates, reports or other documents or instruments relating to or intended to be used for any part or portion of the architectural or engineering project or survey.

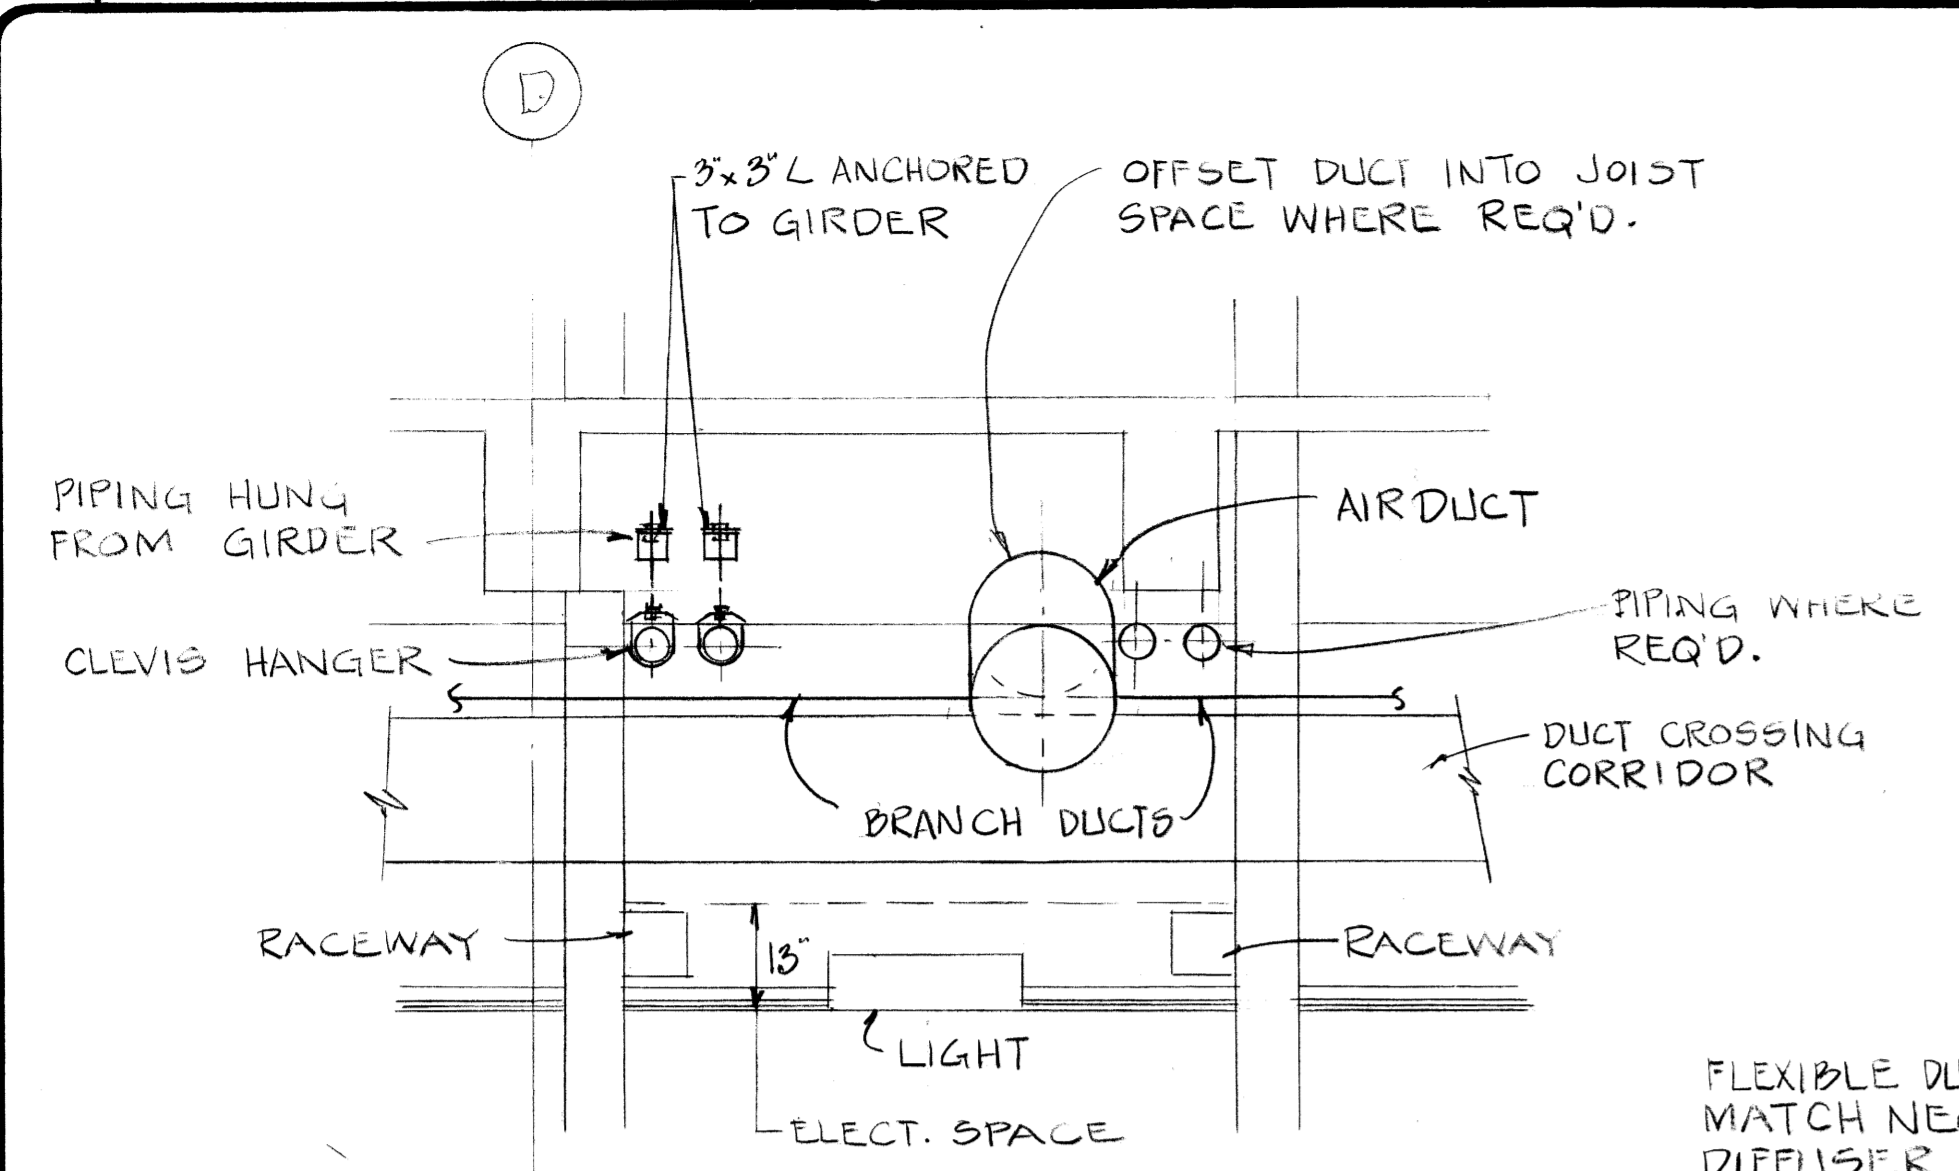


TYPICAL CORRIDOR SECTION
2ND. THRU 5TH. FLOOR
SCALE: 1/2" = 1'-0"

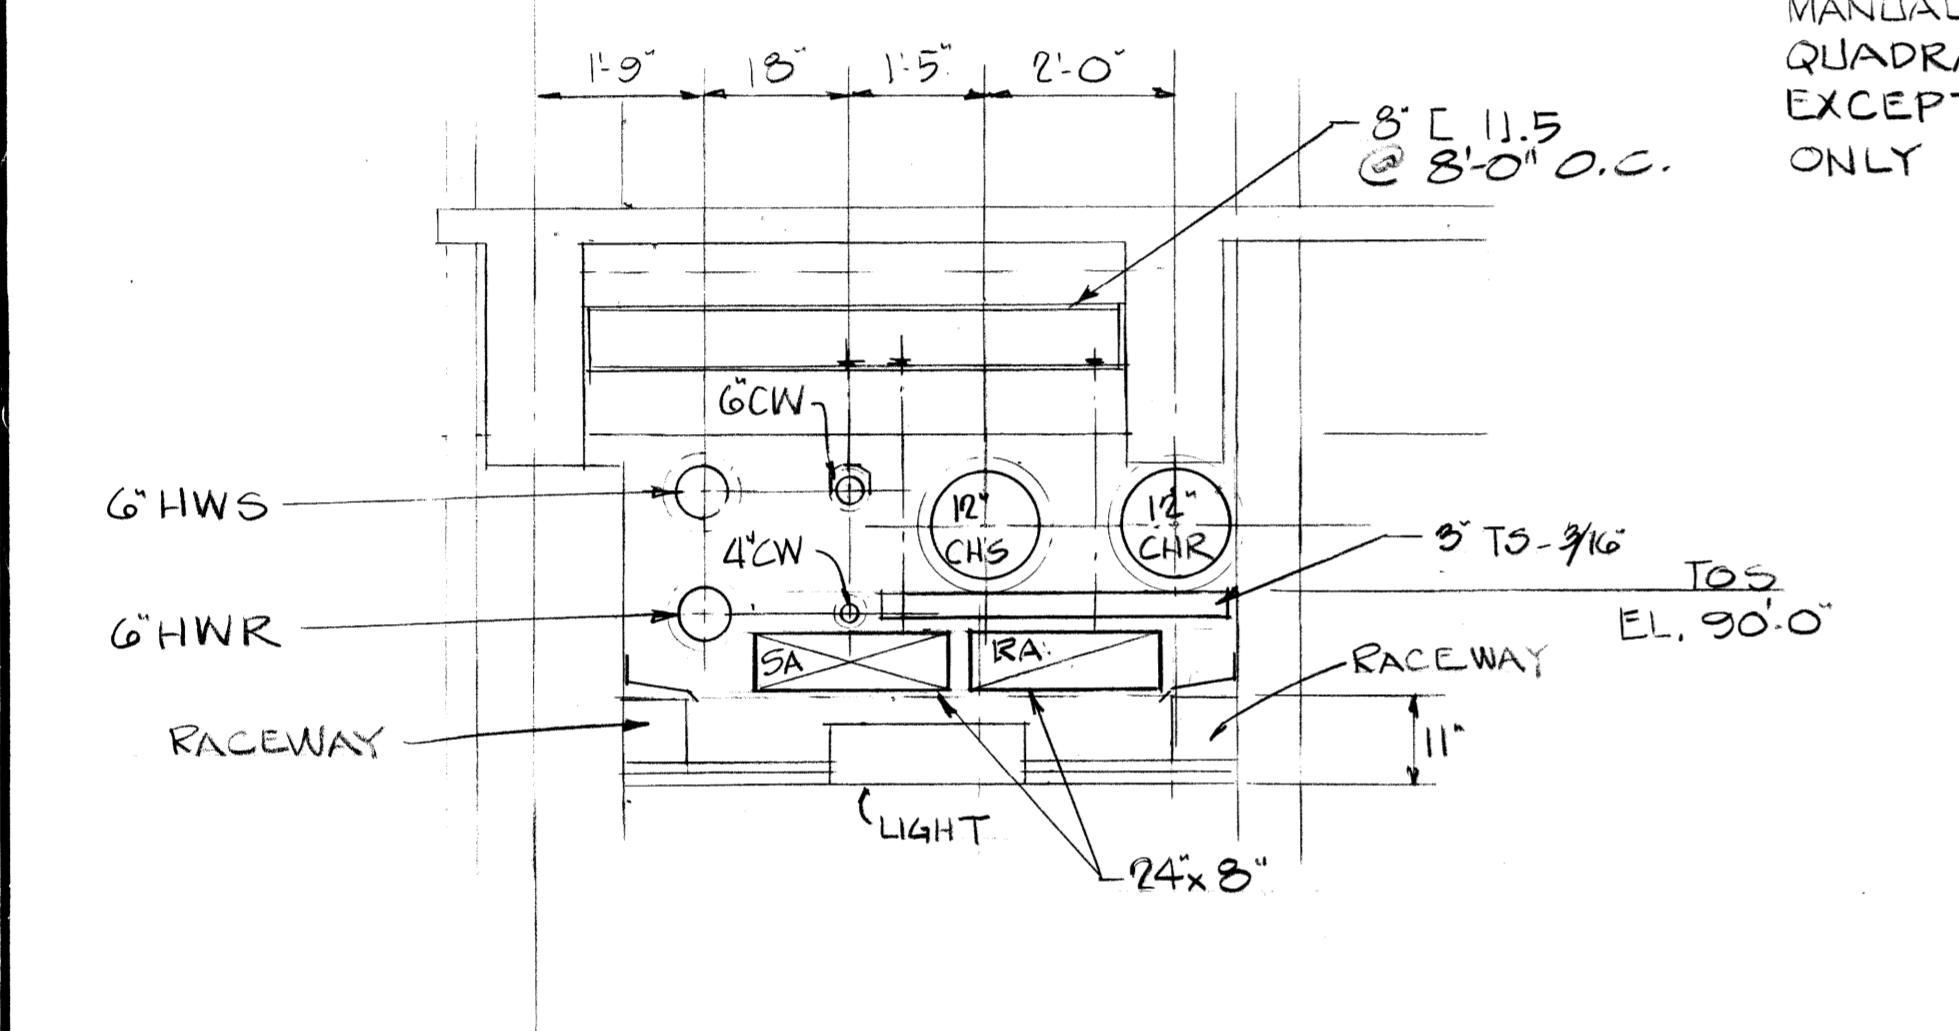


BASMT. CORRIDOR EAST
SCALE: 1/2" = 1'-0"

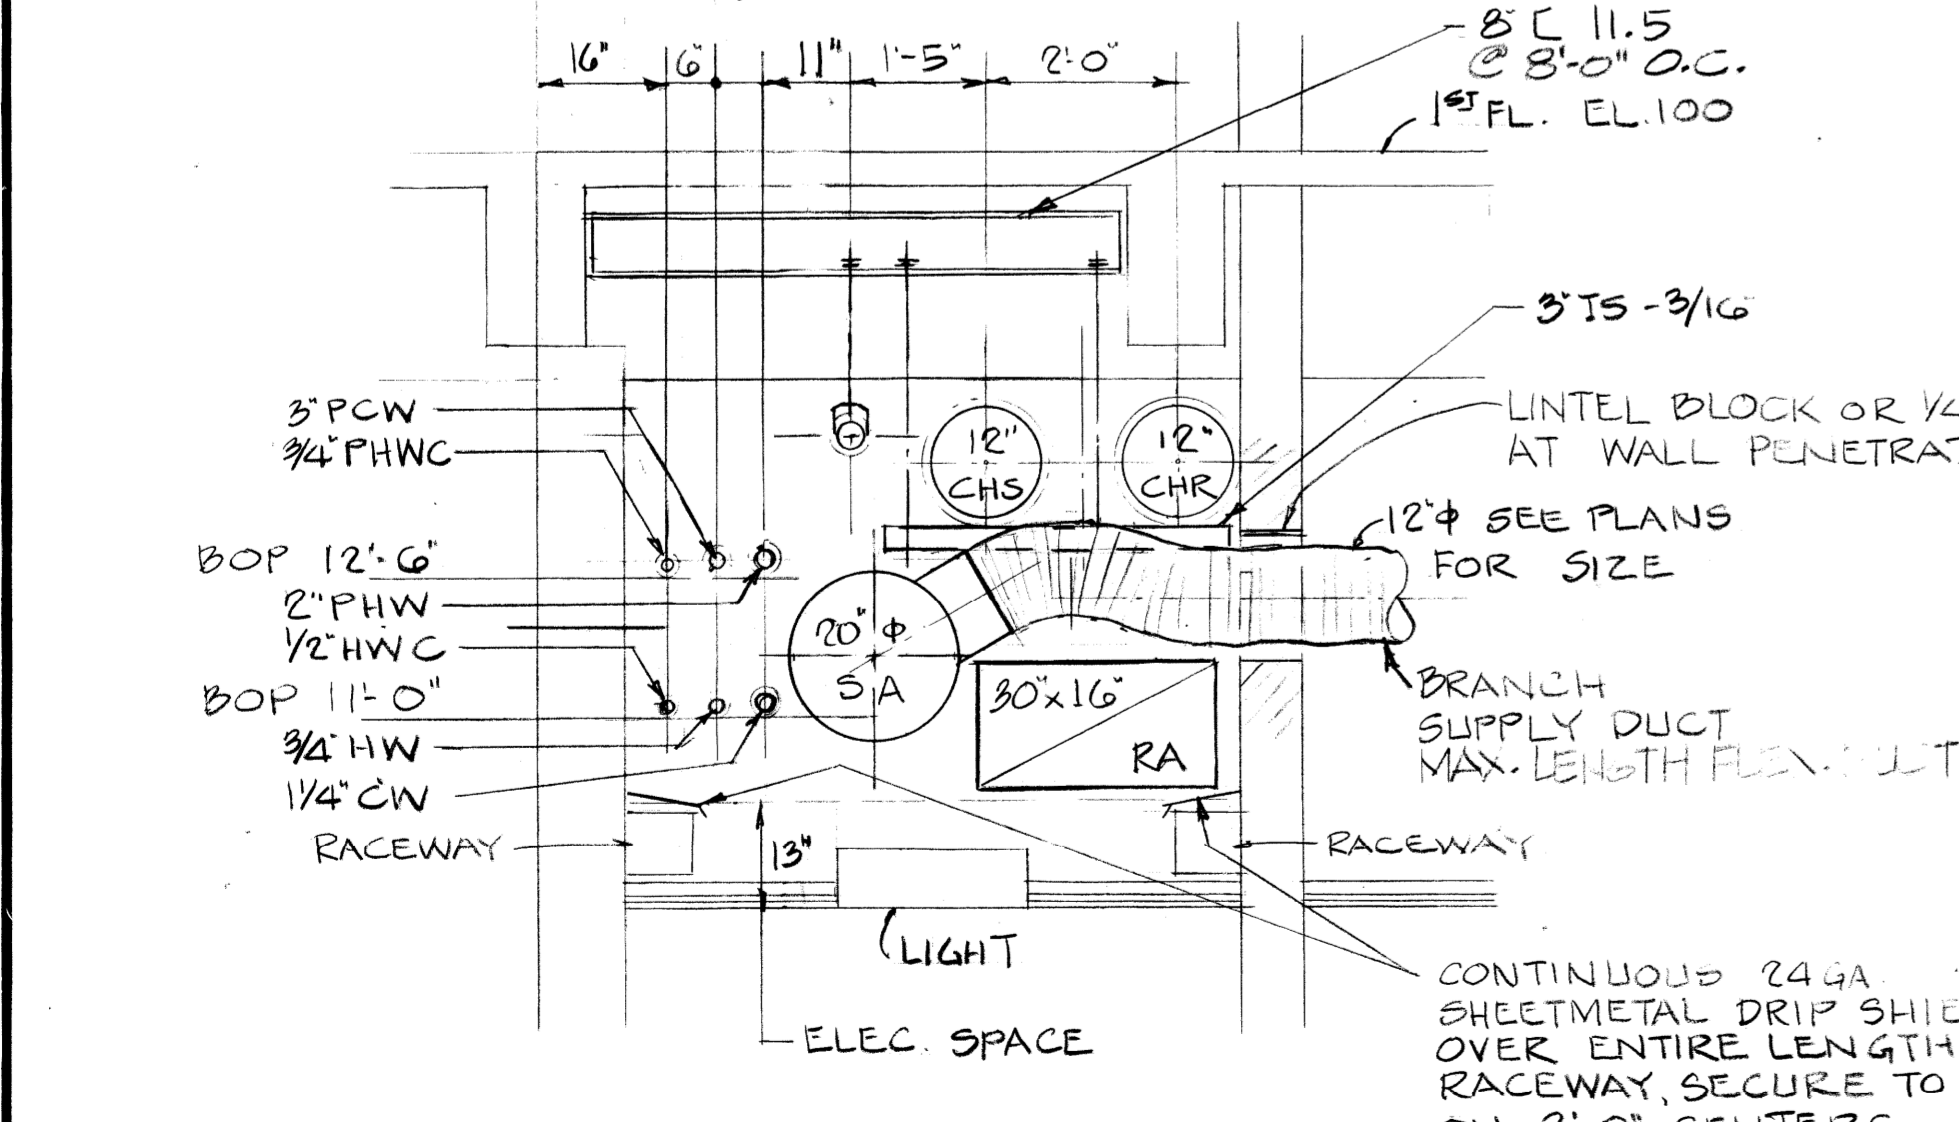


BASMT. CORRIDOR WEST
SCALE: 1/2" = 1'-0"

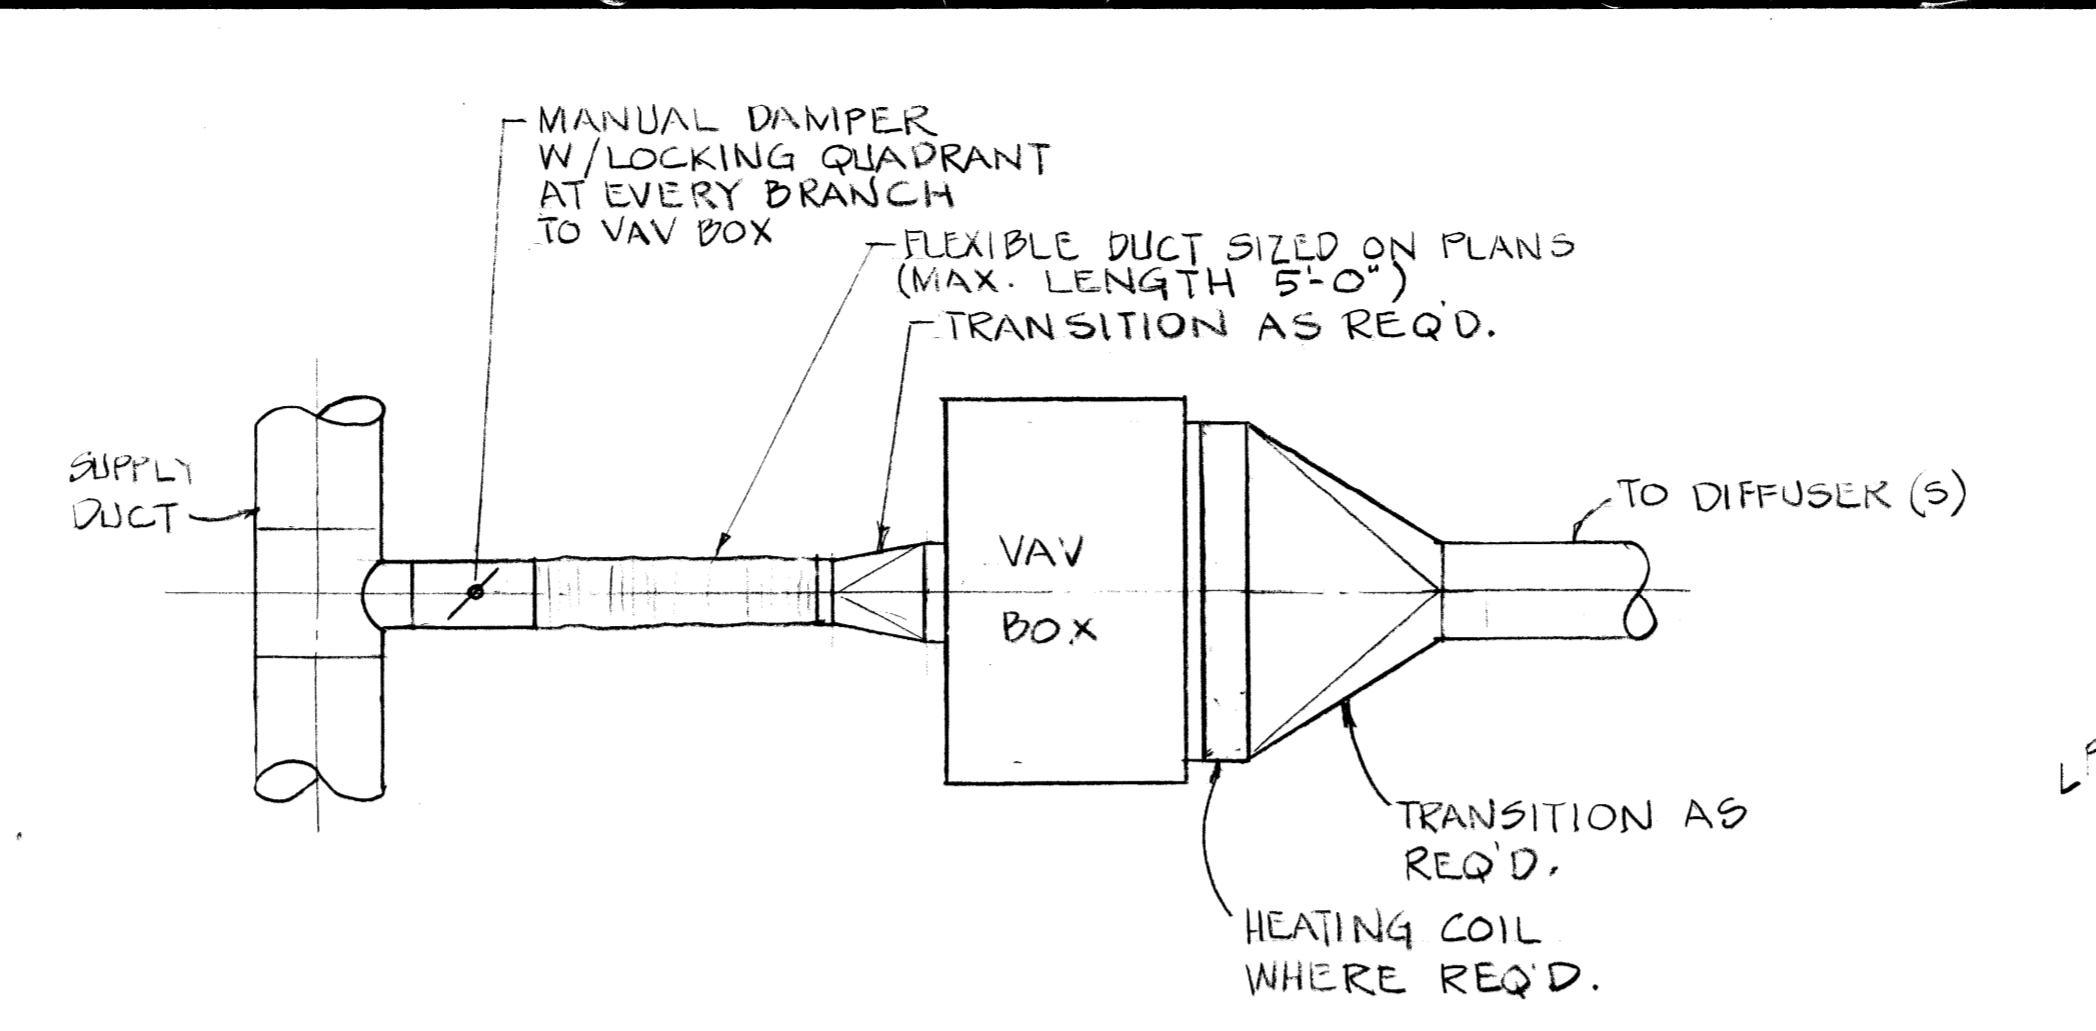

VAV BOX CONNECTION DETAIL
N.T.S.

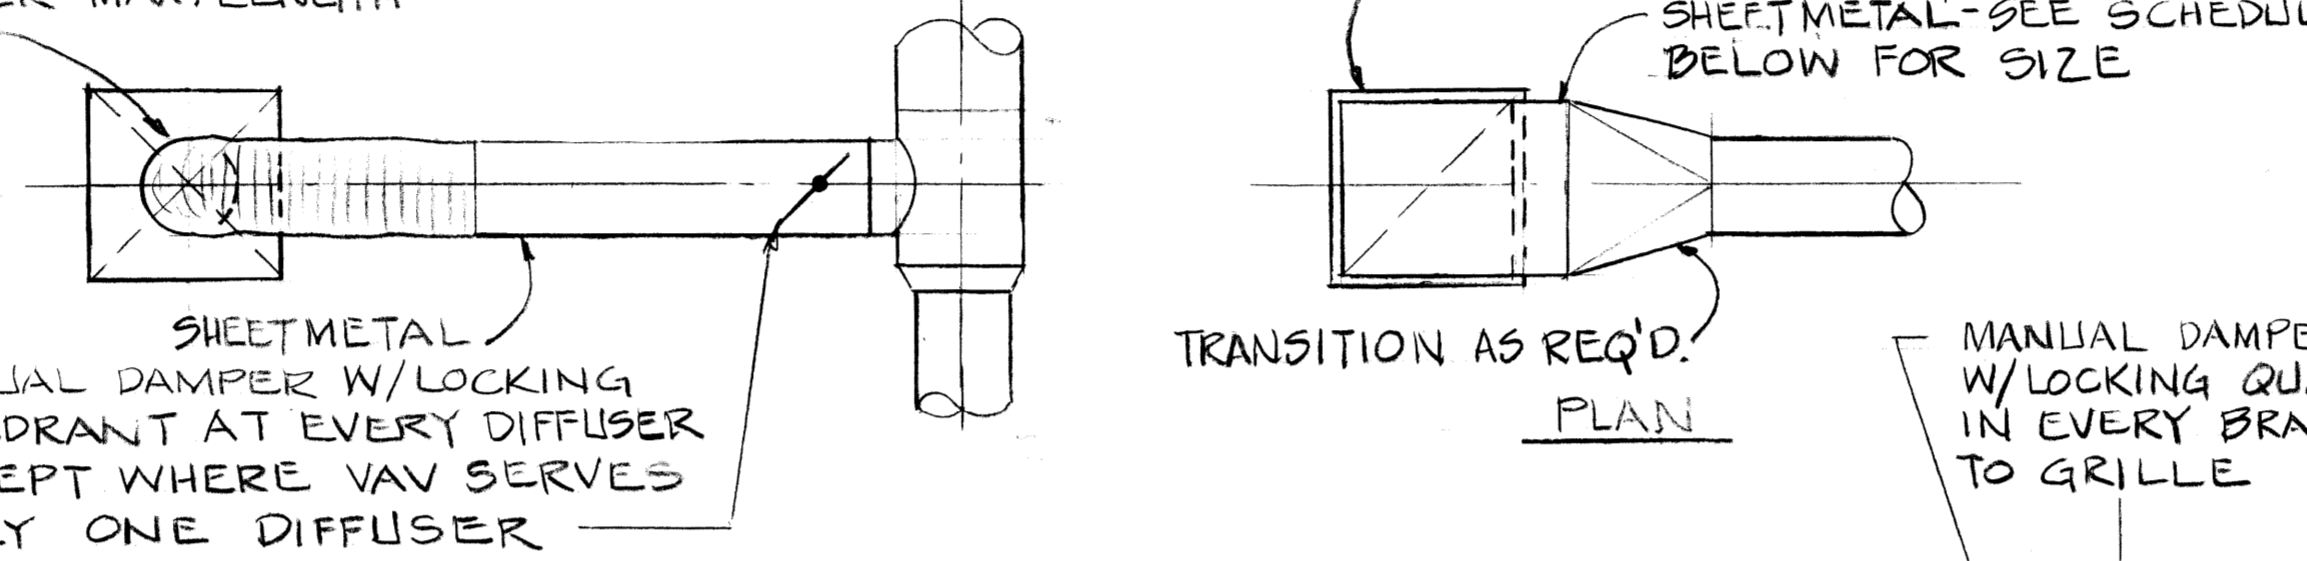


CEILING DIFFUSER DETAIL
N.T.S.

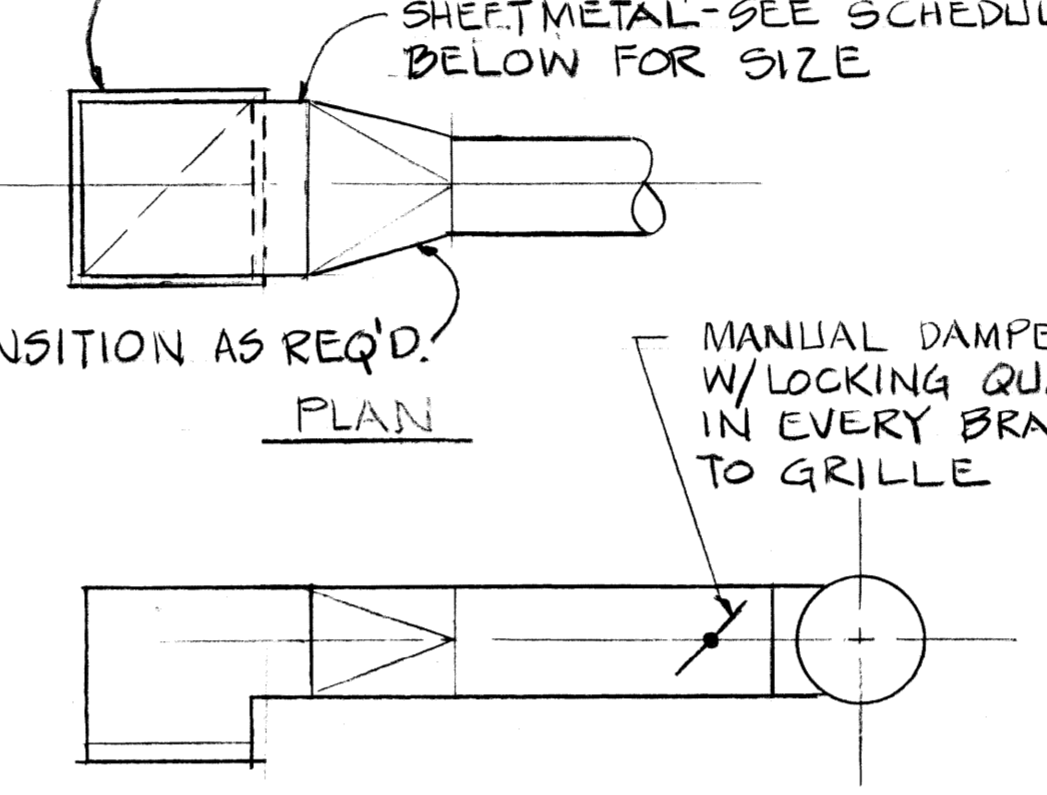


ELEVATION

DUCT SIZE - SCHEDULE	NECK SIZE	DUCT SIZE
10" x 10"	10" x 10"	10" x 10"
10" x 22"	10" x 22"	10" x 22"
12" x 22"	22" x 14"	22" x 14"


RETURN/EXHAUST GRILLE DETAIL
N.T.S.

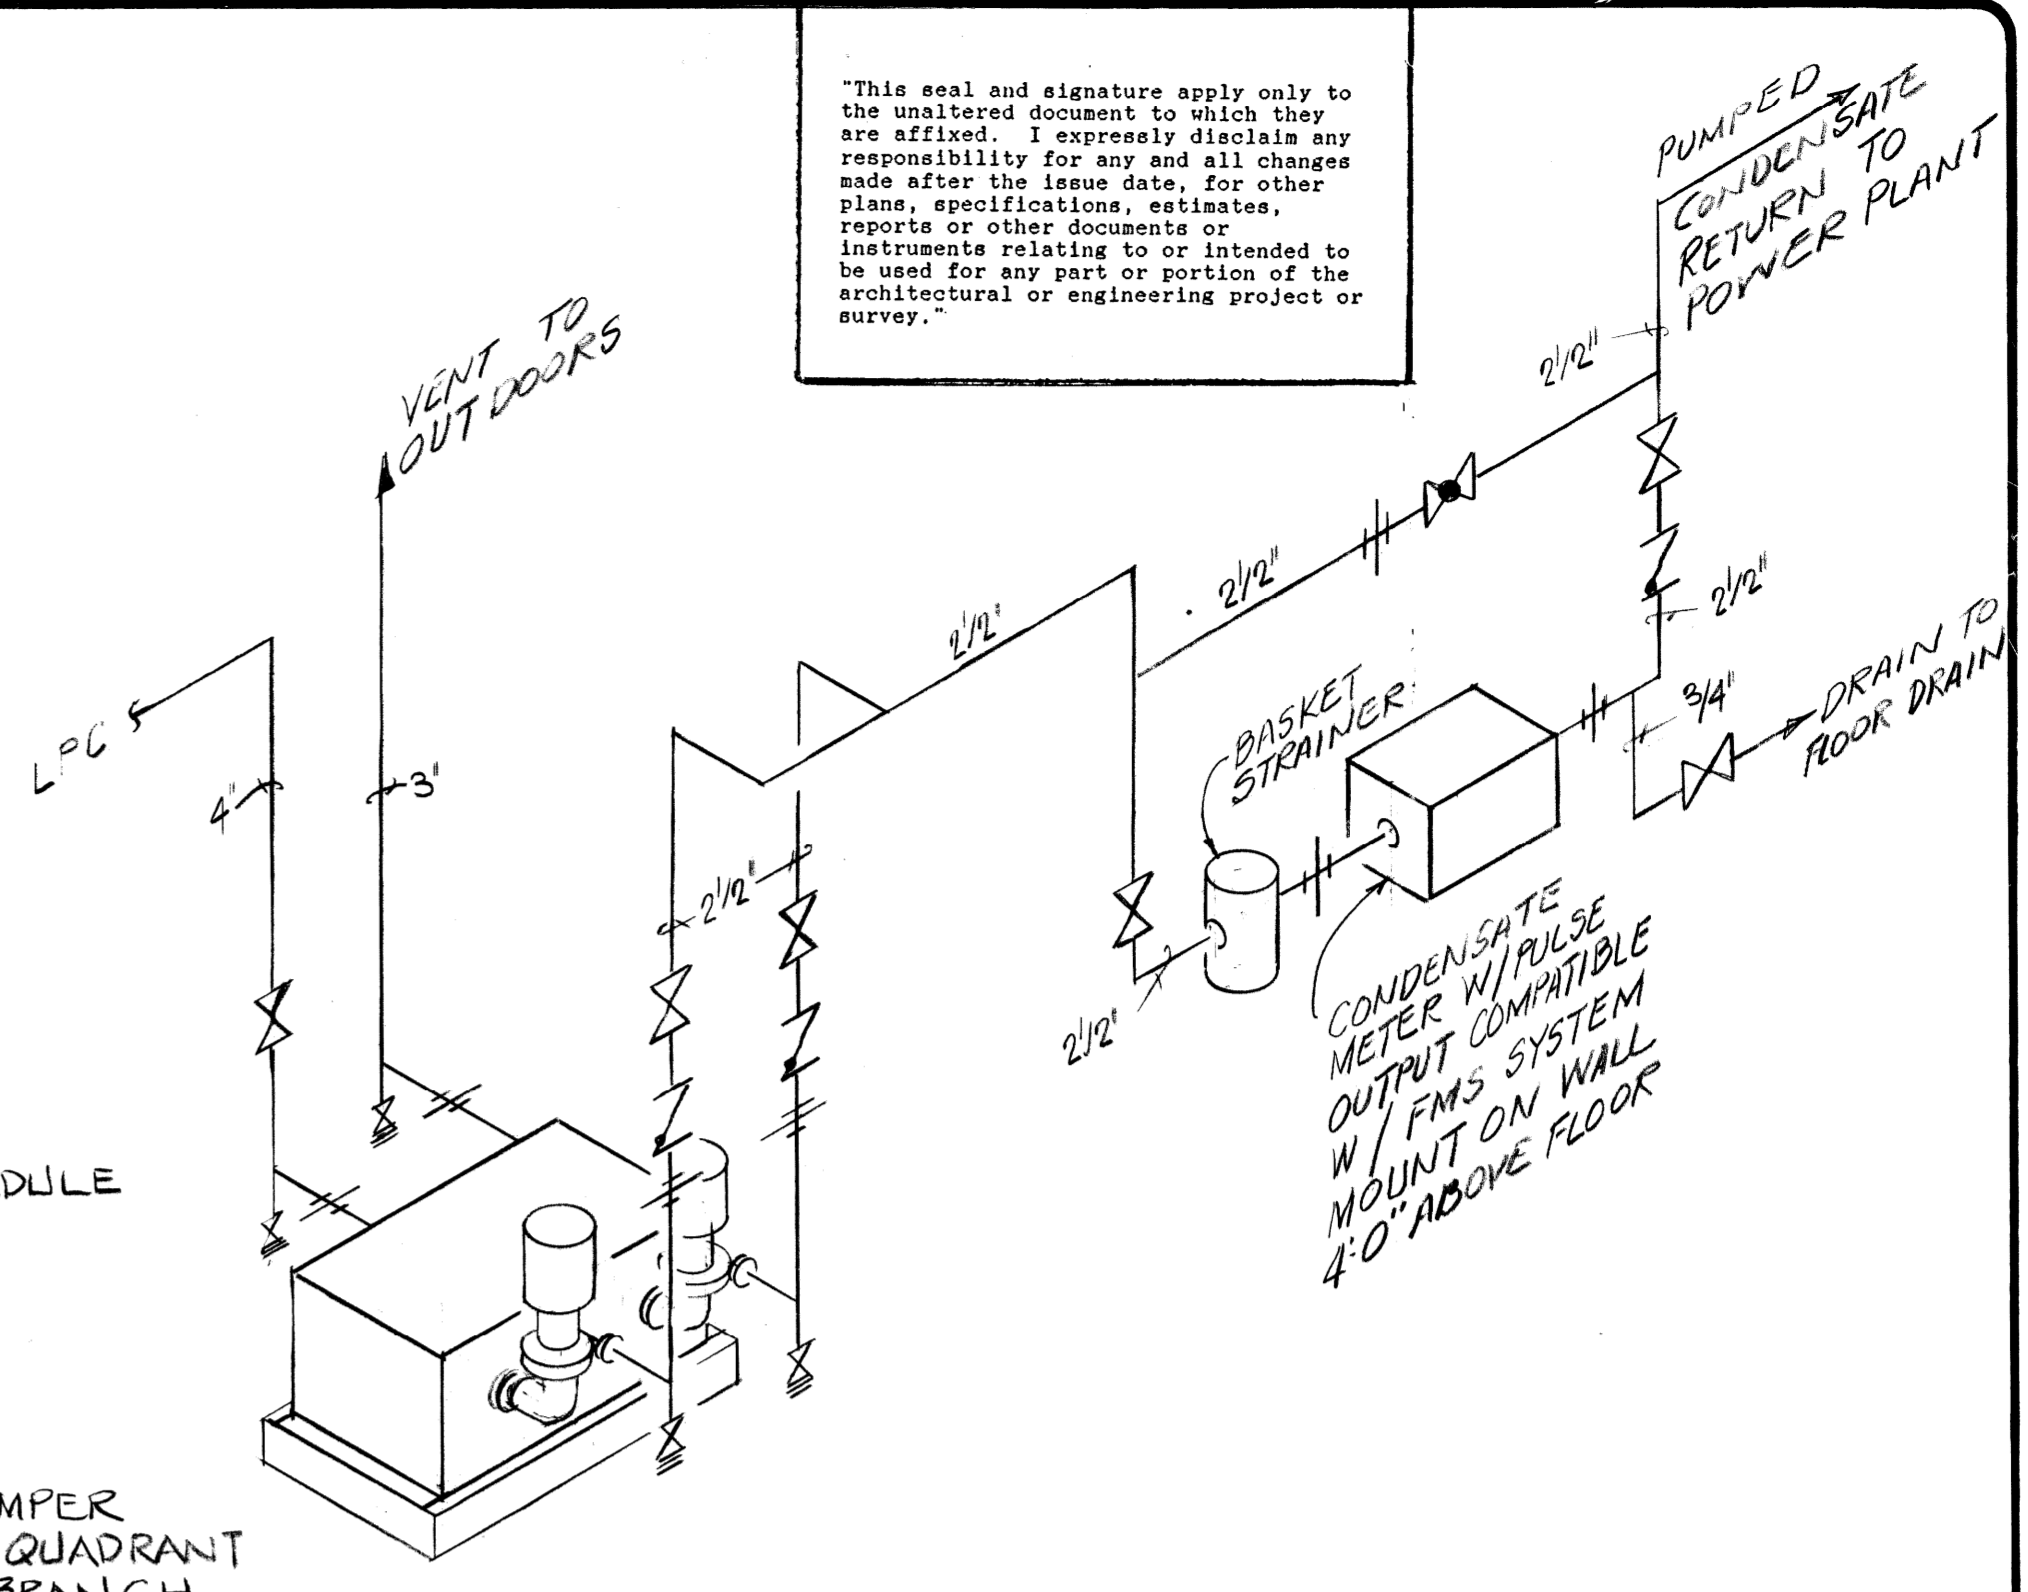


CONDENSATE PUMP AND METER PIPING
N.T.S.

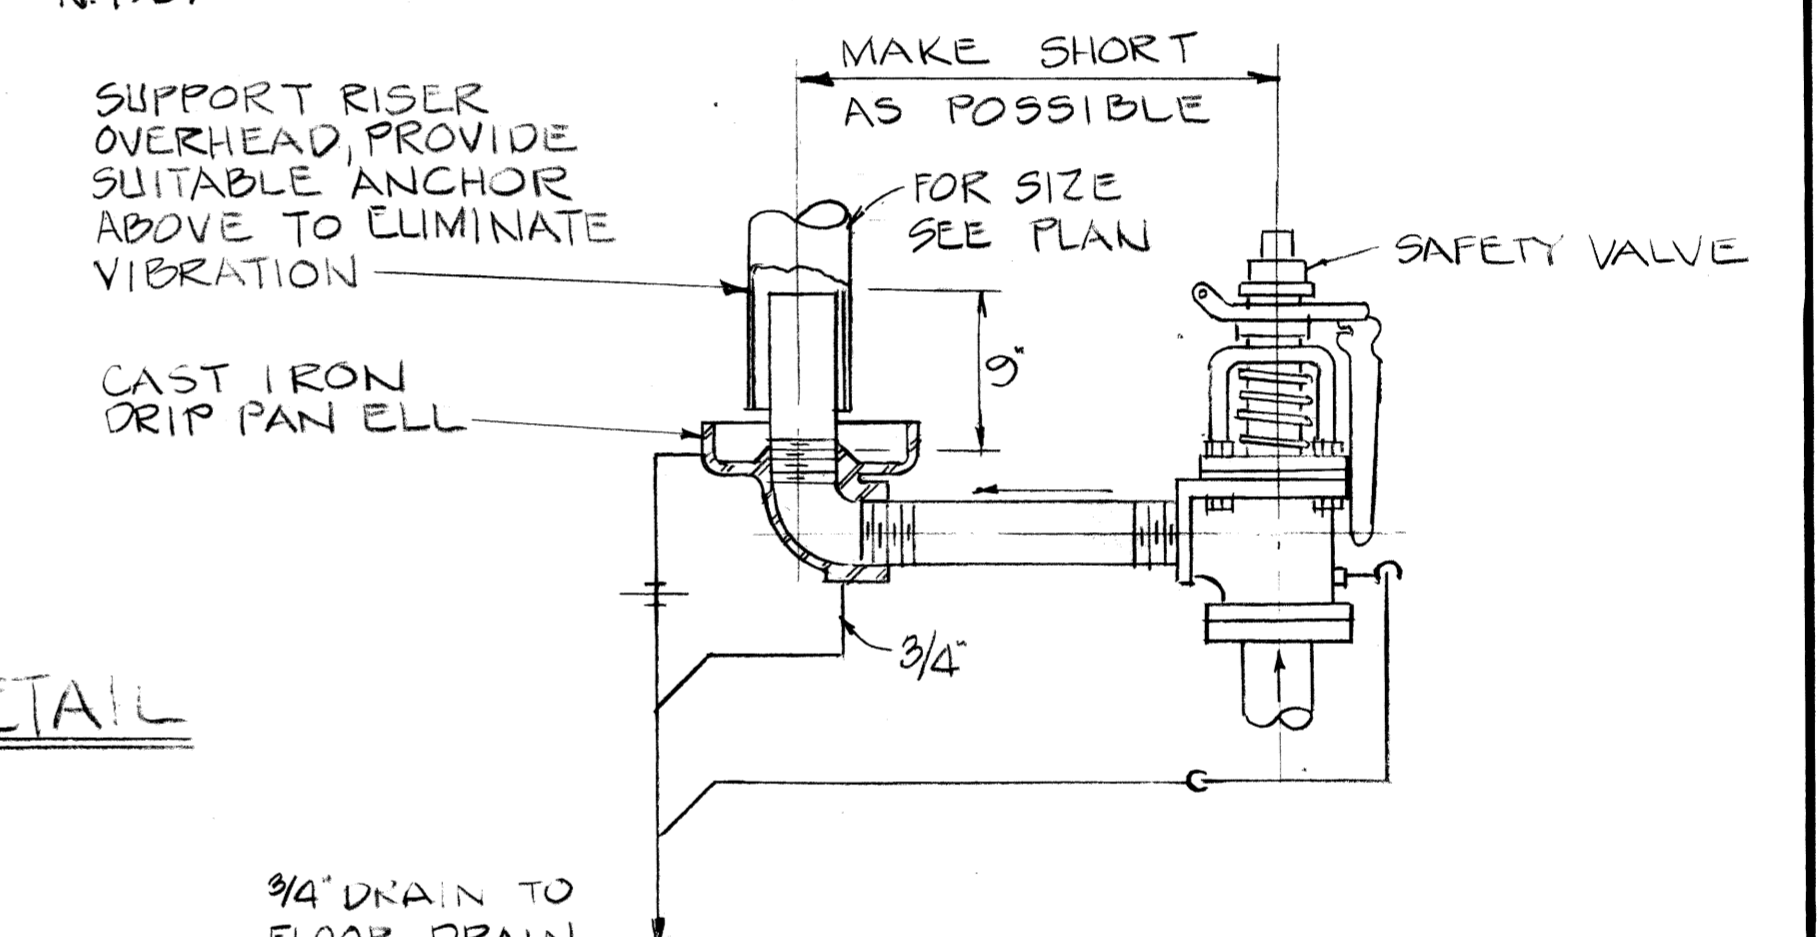

DRIP PAN ELBOW INSTALLATION
N.T.S.

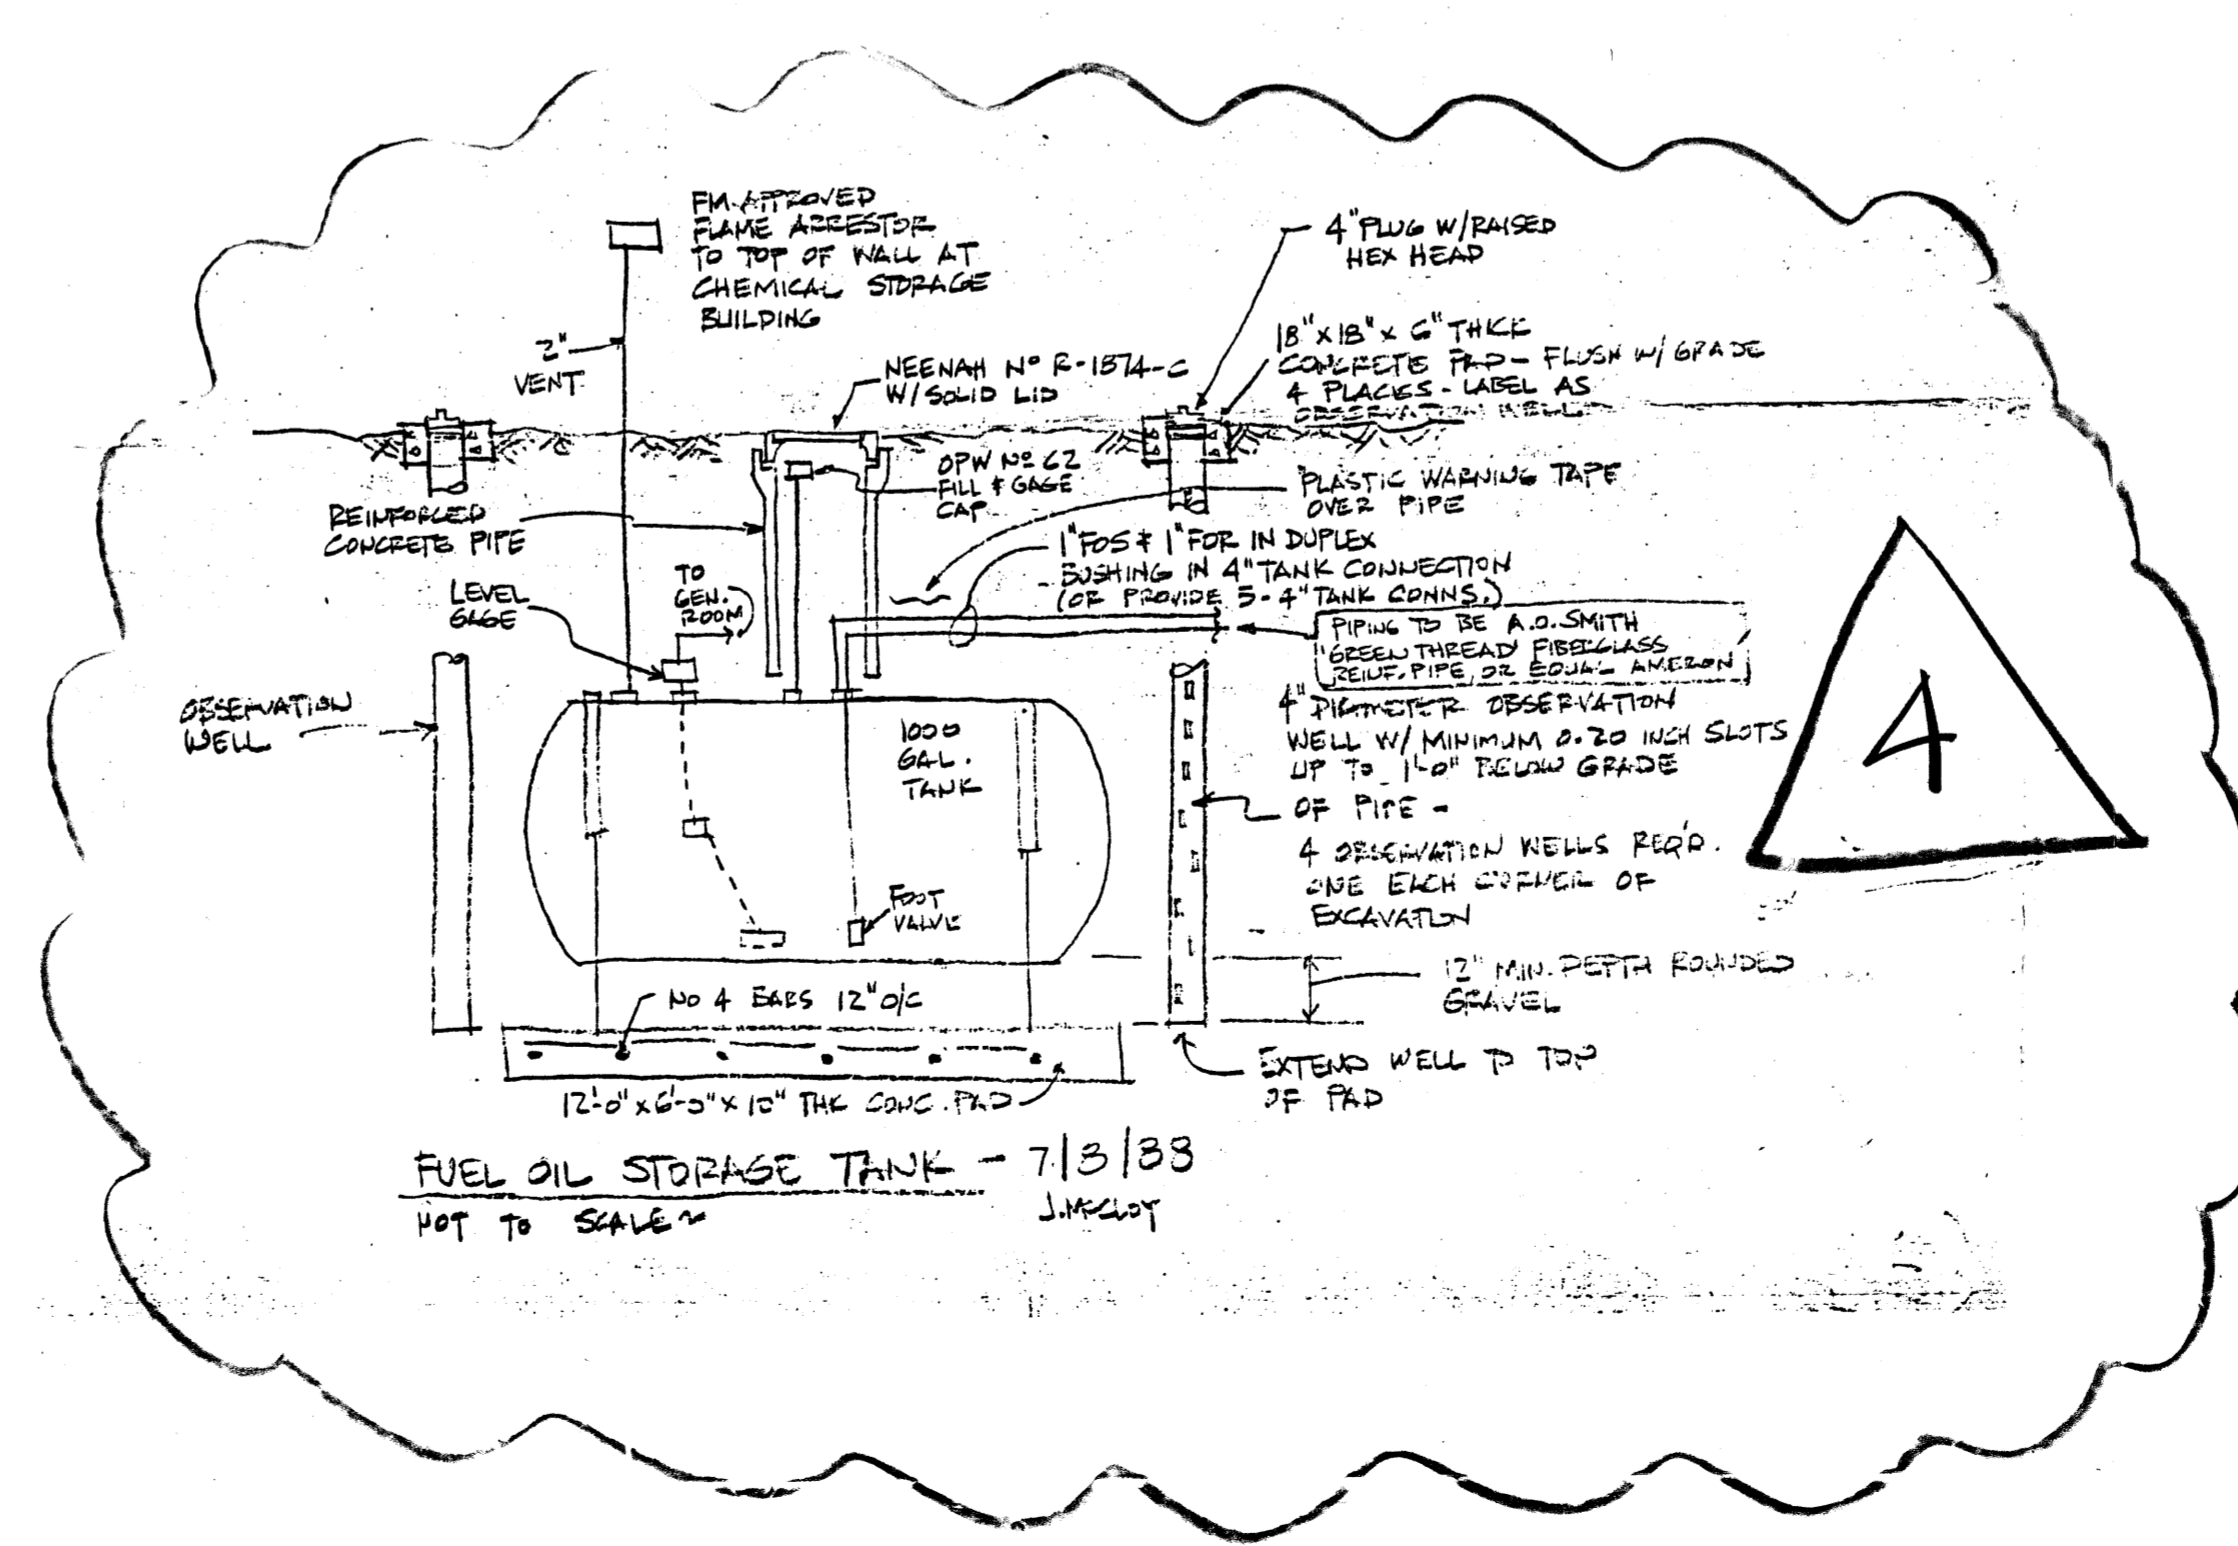


FUEL OIL STORAGE TANK - 7/3/83
HOT TO SAVE
J.M.C.M.

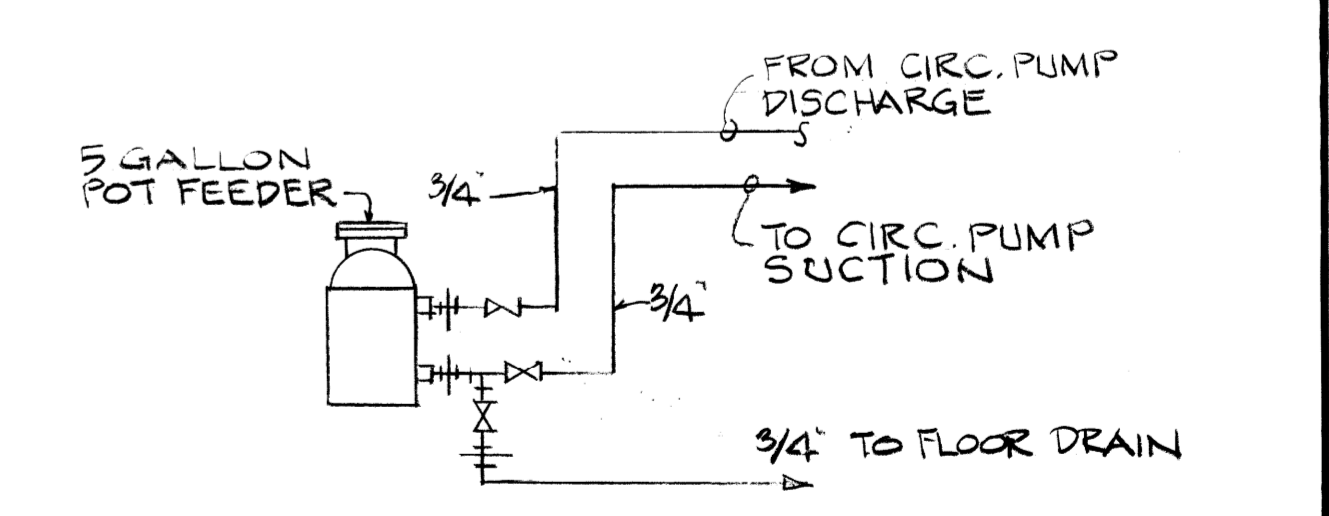

CHEMICAL FEEDER PIPING
N.T.S.

AS BUILT

BELCAN CORPORATION
10200 ANDERSON WAY
CINCINNATI, OHIO 45242
NUMBER: 4301-CM-012-3

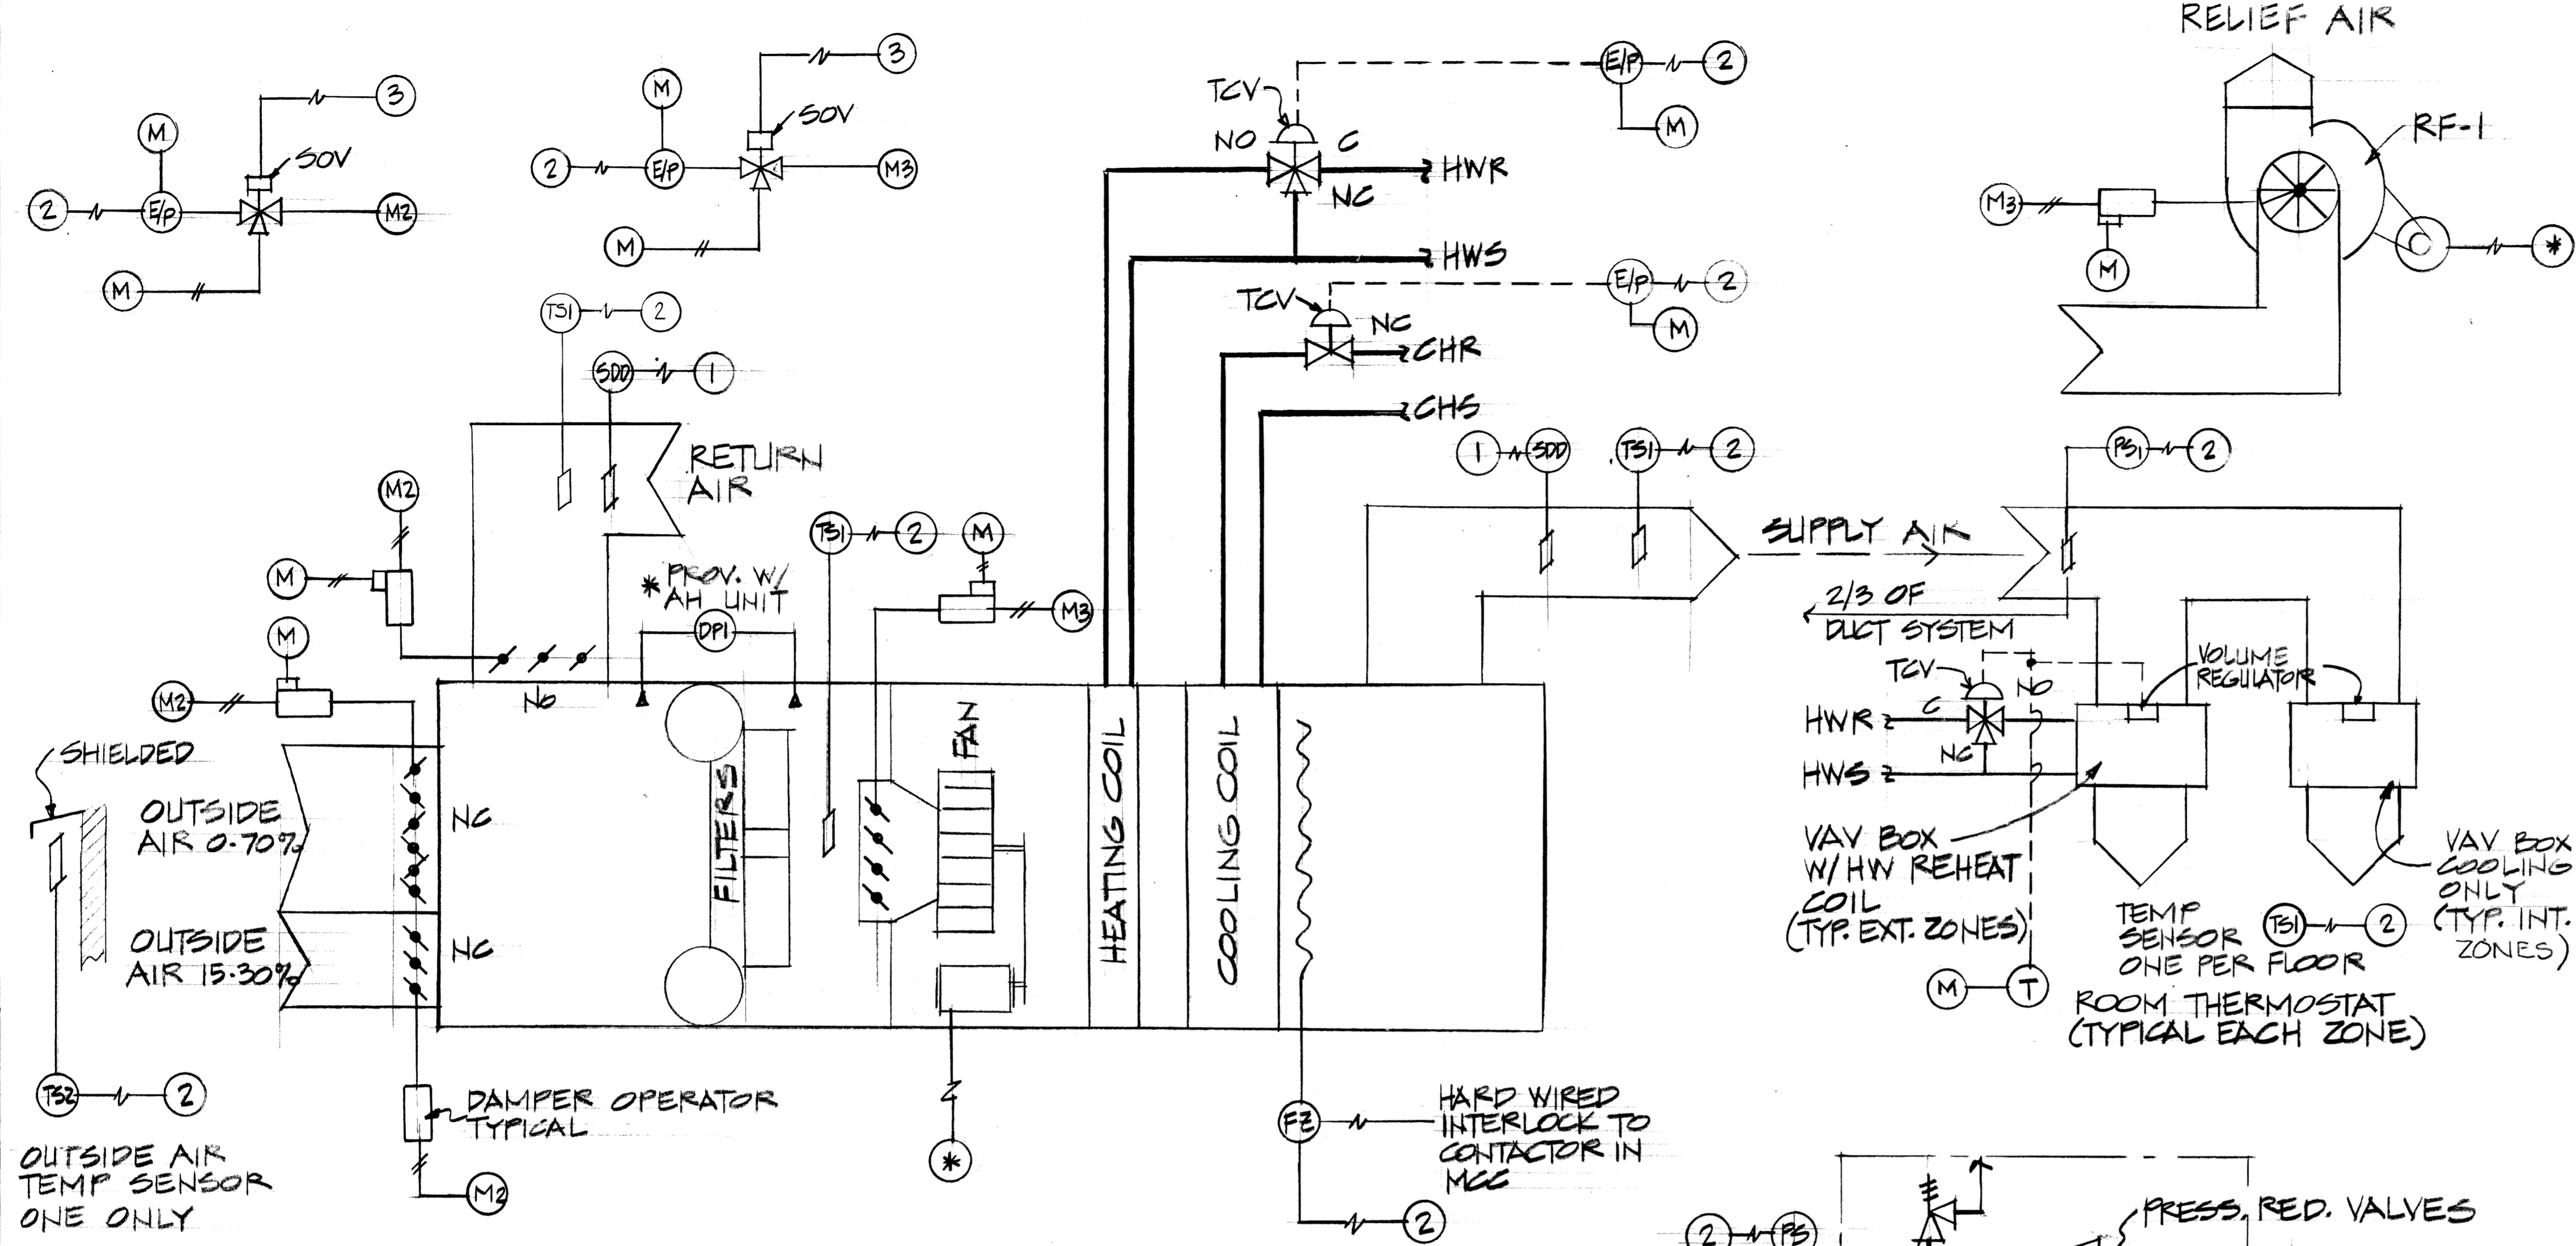

TEMPERATURE CONTROL - AH-1
TYPICAL FOR AH-1 THRU AH-7

- TEMPERATURE CONTROL LEGEND**
- (AA) 20 PSIG MAIN AIR
 - (M) CONTROL AIR - MIXING DAMPERS & VALVES
 - (M) CONTROL AIR - FAN INLET VALVES
 - (24V) 24V SIGNAL TO FIRE ALARM SYSTEM (WIRING UNDER DIV 15, SECTION 15973)
 - (24V) 24V SIGNAL TO EMS SYSTEM (WIRING UNDER DIV 15, SECTION 15973)
 - (SC) SMOKE CONTROL ACTUATED FROM FIRE ALARM SYSTEM (SMOKE CONTROL PROVIDED UNDER DIV 15, SECTION 15973)
 - (M) INCLINED GAGE BAROMETER
 - (TSI) TEMPERATURE SENSOR - OMEGA PR-12-2-100
 - (PS) PRESSURE SENSOR - ROBINSON-HALPERN 157G W050S
 - (SD) PHOTOELECTRIC SMOKE DETECTOR - (FURNISHED & WIRED UNDER DIV 16, INSTALLED UNDER DIV 15)
 - (EIP) FREEZE STAT - (WIRED UNDER DIV 15, SECTION 15973)
 - (EIP) PNEUMATIC TRANSDUCER (FURNISHED & WIRED UNDER DIV 15, SECTION 15973)
 - (M) TEMPERATURE CONTROL VALVES (FURNISHED UNDER SECTION 15973, INSTALLED UNDER SECTION 15510) SEE EQUIPMENT SCHEDULES FOR CAPACITY REQUIREMENTS
 - (*) REFER TO DESCRIPTION OF OPERATION
 - (M) TEMPERATURE SENSOR - OMEGA PR-12-2-10 W/ 1/2" OR 3/4" WELL (FURN. UNDER SECTION 15973, INST. SECTION 15510)

CONTROL - UNOCCUPIED ZONE


WHEN UNIT SUPPLY FAN IS DE-ENERGIZED THRU THE FMS, OUTSIDE AIR DAMPERS TO GO TO MINIMUM POSITION.

NIGHT CYCLE

SPACE HEATER CURVE SENSOR SHALL, TRIP THE FMS, CYCLE THE UNIT FAN TO MAINTAIN DESIGN UNOCCUPIED TEMPERATURE (78F SUMMER, 55F W. 198)

TEMPERATURE CONTROL

TEMPERATURE SENSORS IN SUPPLY AIR DUCT SHALL, THRU FMS, MODULATE HEATING OR CHILLED WATER COIL OR TRIP UNIT FAN TO MAINTAIN SETPOINT AIR TEMPERATURE. SENSORS SHALL, TRIP UNIT FAN TO MAINTAIN SETPOINT OR BRING RESET FROM AND BY SPACE TEMPERATURE LOAD RESET SCHEDULE.

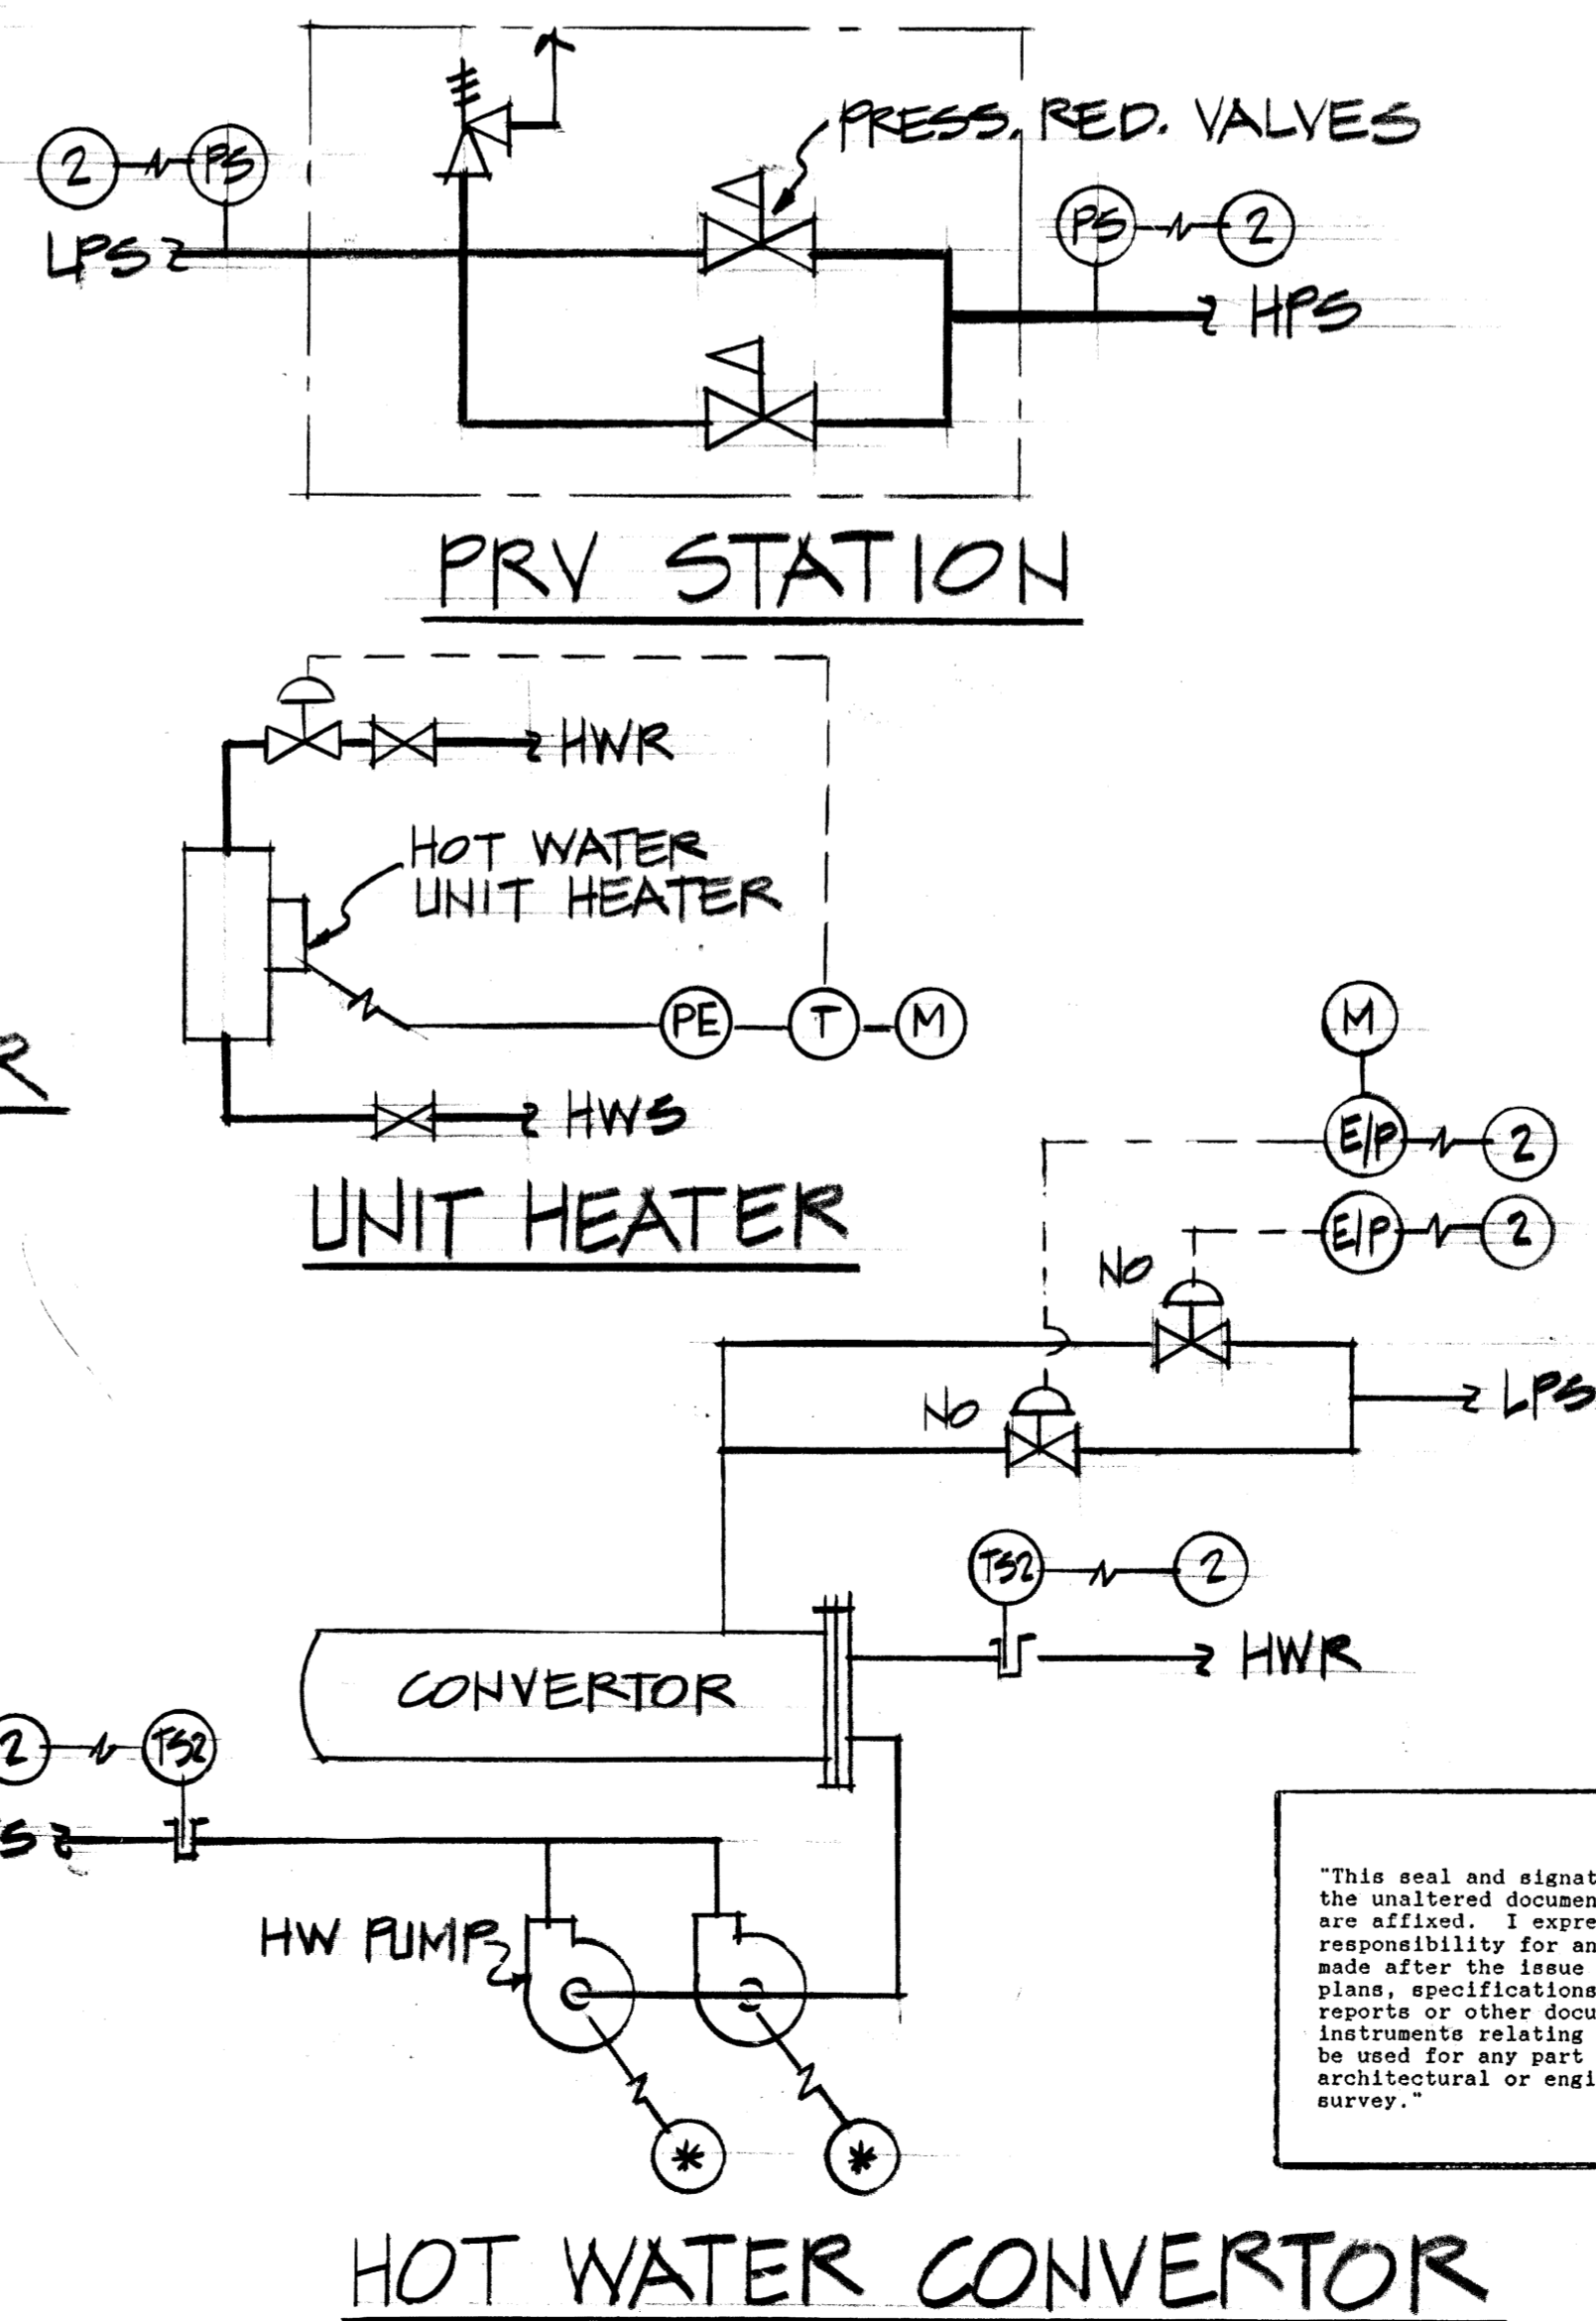

SMOKE CONTROL

ACTUATION OF MANUAL CALL STATION, DUCT HOAR DETECTOR, AREA SMOKE DETECTOR, SPRINKLER FLOW SWITCH, IN BUILDING FIRE ALARM SYSTEM (NO PART OF EMS SYSTEM) TO CAUSE THE FOLLOWING ACTIONS:

1. TRANSMIT A SMOKE ALARM SIGNAL TO THE FMS.
2. FOR THE FIRE ZONE ACTUATED, AND FUNCTIONING AS PART OF THE BUILDING TEMPERATURE CONTROL SYSTEM, SEMI-INDEPENDENT OF THE FMS:
 - A. ACTIVATE HEATING WATER CONVERTER VALVES TO FULL OPEN POSITION WHENEVER OUTSIDE TEMPERATURE IS 55F OR LESS.
 - B. AFTER A 5 MINUTE TIME DELAY (ADJUSTABLE) SHUT DOWN UNIT SUPPLY FAN IN ACTUATED FIRE ZONE, ENERGIZE RELIEF FAN AND UNIT SUPPLY FANS ON ALL OTHER FLOORS.
 - C. OPEN VANE DAMPERS ON ENERGIZED UNIT SUPPLY FANS RELIEF FAN DAMPER TO 50 PERCENT OPEN (ADJUSTABLE) TO FULL OPEN POSITION, AND OPEN OUTSIDE AIR DAMPERS ON ENERGIZED UNITS TO FULL OPEN POSITION.
 - D. OPEN VAV BOX SUPPLIES TO STAIRWELLS TO FULL AIR FLOW AND CLOSE EXTERIOR ZONE BOXES TO MINIMUM POSITION AIR FLOW. INTERIOR ZONE BOXES TO GO TO FULL SHUTOFF.
 - E. SMOKE CONTROL SYSTEM DEACTIVATED BY NORMAL CONDITION IN FIRE ALARM SYSTEM.

FREEZE STAT

A DOUBLE POLE SWITCH FROM FREEZE STAT WITH CURRENT LACED ACROSS FACE OF CHILLED WATER COIL SHALL BE HARD WIRED INTERLOCKED TO STOP SUPPLY FAN AND CLOSE UNIT DAMPERS WHEN ANY ONE FOOT SECTION OF ELEMENT SENSES 40F. ON LINE ALARM SIGNAL SHALL ALSO BE TRANSMITTED TO FMS.

VARIABLE VOLUME BOXES

INTERIOR ZONE BOXES SHALL BE TIGHT SHUTOFF, COOLING ONLY WITH PNEUMATIC THERMOSTAT FOR RESPECTIVE BOX.

EXTERIOR ZONE BOXES SHALL HAVE MINIMUM SUPPLY POSITION AND HOT WATER HEATING COILS WITH THREE WAY CONTROL VALVES CONTROLLED FROM PNEUMATIC HEATING COILING THERMOSTAT FOR RESPECTIVE BOX.

SEQUENCE OF OPERATION

TYPICAL FOR AH-1 THRU AH-7

POWER FOR AIR HANDLING UNIT FANS AND RELIEF VAV IS SUPPLIED BY 208V BASEMENT WITH 0-0-A SWITCHES FOR EACH RESPECTIVE MOTOR.

IN THE AUTOMATIC SWITCH POSITION, FANS ARE STARTED FROM THE FMS. ON START-UP, INLET VANES SHALL BE IN THE MINIMUM POSITION.

A STATIC PRESSURE CONTROLLER FOR EACH SYSTEM SHALL, THROUGH THE FMS MODULATE INLET VANES TO MAINTAIN DESIGN DUCT STATIC PRESSURE.

UNOCCUPIED CYCLE

WHEN UNIT SUPPLY FAN IS STARTED, OUTDOOR AIR DAMPER TO OPEN TO MINIMUM POSITION. BASED ON OUTSIDE TEMPERATURE, OUTSIDE AIR, RETURN AIR AND INLET VANE ON RELIEF FAN TO MODULATE TO MAINTAIN MIXED AIR SETPOINT TEMPERATURE (55F).

A MORNING WARM-UP CYCLE TO BE INCORPORATED WHICH MAINTAINS OUTSIDE AIR DAMPERS IN CLOSED POSITION UNTIL SPACE TEMPERATURE IS 70F (ADJUSTABLE).

SUMMER WINTER SWITCHOVER

SYSTEM TO SWITCH TO SUMMER OPERATION WHEN THE FOLLOWING CONDITIONS HAVE BEEN MET, AS DETERMINED THROUGH THE FMS:

- SPACE TEMPERATURE INDICATES COOLING IS REQUIRED
- OUTSIDE AIR TEMPERATURE INDICATES COOLING IS REQUIRED
- CHILLED WATER IS AVAILABLE
- CHILLED WATER TEMPERATURE INDICATES COOLING IS AVAILABLE

CONTINUED

AS BUILT

NOTE

THIS DRAWING ISSUED FOR REFERENCE FOR CORRECTION OF CONTROL VALVES, THERMOWELLS, SMOKE DETECTORS AND PRESSURE TAPS INSTALLED UNDER DIV 15, THESE SPECIFICATIONS.

"This seal and signature apply only to the unaltered document to which they are affixed. I expressly disclaim any responsibility for any and all changes made after the issue date, for other plans, specifications, estimates, reports or other documents or instruments relating to or intended to be used for any part or portion of the architectural or engineering project or survey."

BELCAN CORPORATION
10200 ANDERSON WAY
CINCINNATI, OHIO 45242
NUMBER: 43G1-CM-013-3

ROBOTICS FACILITY
LEXINGTON CAMPUS
UNIVERSITY OF KENTUCKY
LEXINGTON, KENTUCKY

University of Kentucky
Lexington, Kentucky

Robert L. Hester
Professional Engineer
No. 12287
State of Kentucky

TEMPERATURE CONTROLS

Steffen Carter - Barnhart
PARTNERS IN ARCHITECTURE
100 WEST MAIN STREET • LEXINGTON KY 40507 • 606-254-1951

JOB NO. 3700
DATE 10-16-87
DRAWN J.M.P.
CHECKED J.M.P.
NO. 43100

REVISIONS
3-96% REVIEW

SHEET
M-13

"This seal and signature apply only to the unaltered document to which they are affixed. I expressly disclaim any responsibility for any and all changes made after the issue date, for other plans, specifications, estimates, reports or other documents or instruments relating to or intended to be used for any part or portion of the architectural or engineering project or survey."

AS BUILT 10-19-87

ROBOTICS FACILITY
LEXINGTON CAMPUS
UNIVERSITY OF KENTUCKY
LEXINGTON, KENTUCKY

University of Kentucky
Lexington, Kentucky

10-19-87

WALTER BUNNY
ARCHITECTS AND ENGINEERS

BASEMENT PLBG. & PIPING PLAN

Sherman-Carter-Barnhart
PARTNERS IN ARCHITECTURE
SUITE 1900 • 250 WEST MAIN STREET • LEXINGTON, KY 40507 • 606-753-1351


JOB NO. 3706
DATE 10-16-87
DRAWN W.E. CASE
CHECKED W.E. CASE
FILE NO. 431.0

REVISIONS
3- 50% REVIEW
4- AS BUILT

SHEET


M-14

AS BUILT
BELCAN CORPORATION
10200 ANDERSON WAY
CINCINNATI, OHIO 45242
NUMBER: 4361-CM-014.3

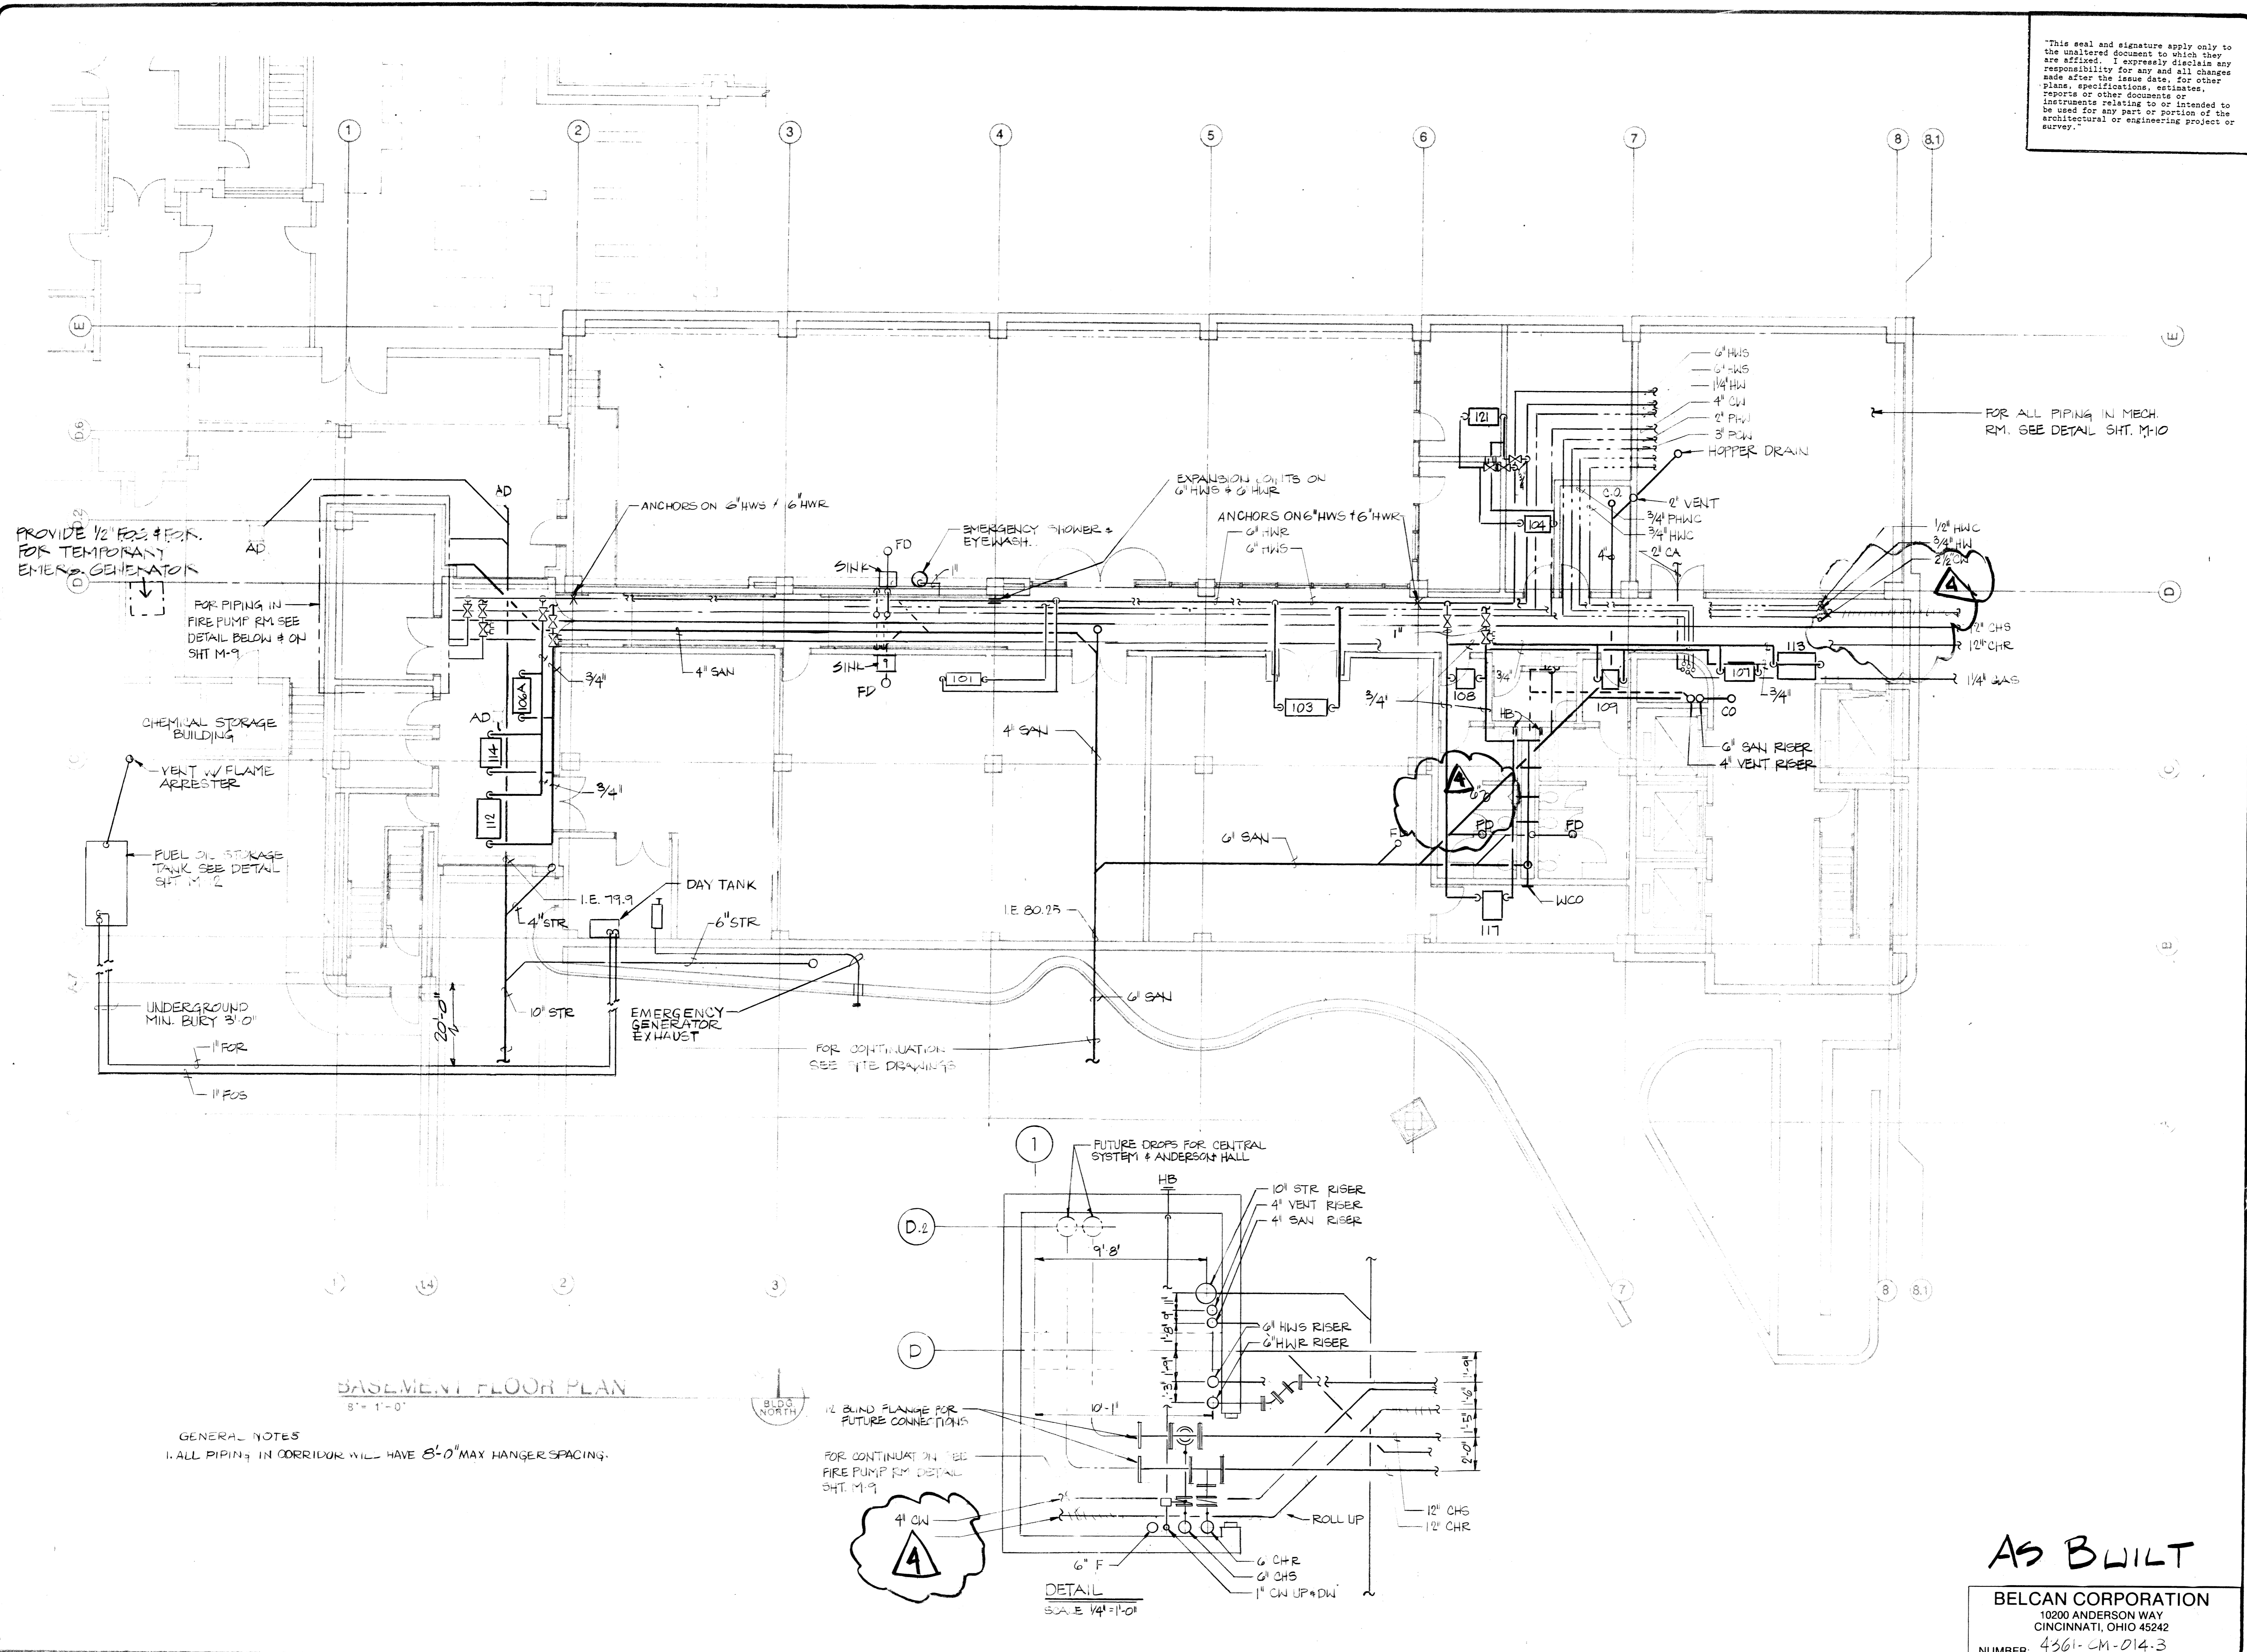



BASEMENT FLOOR PLAN
8" = 1'-0"

GENERAL NOTES
1. ALL PIPING IN CORRIDOR WILL HAVE 8'-0" MAX HANGER SPACING.

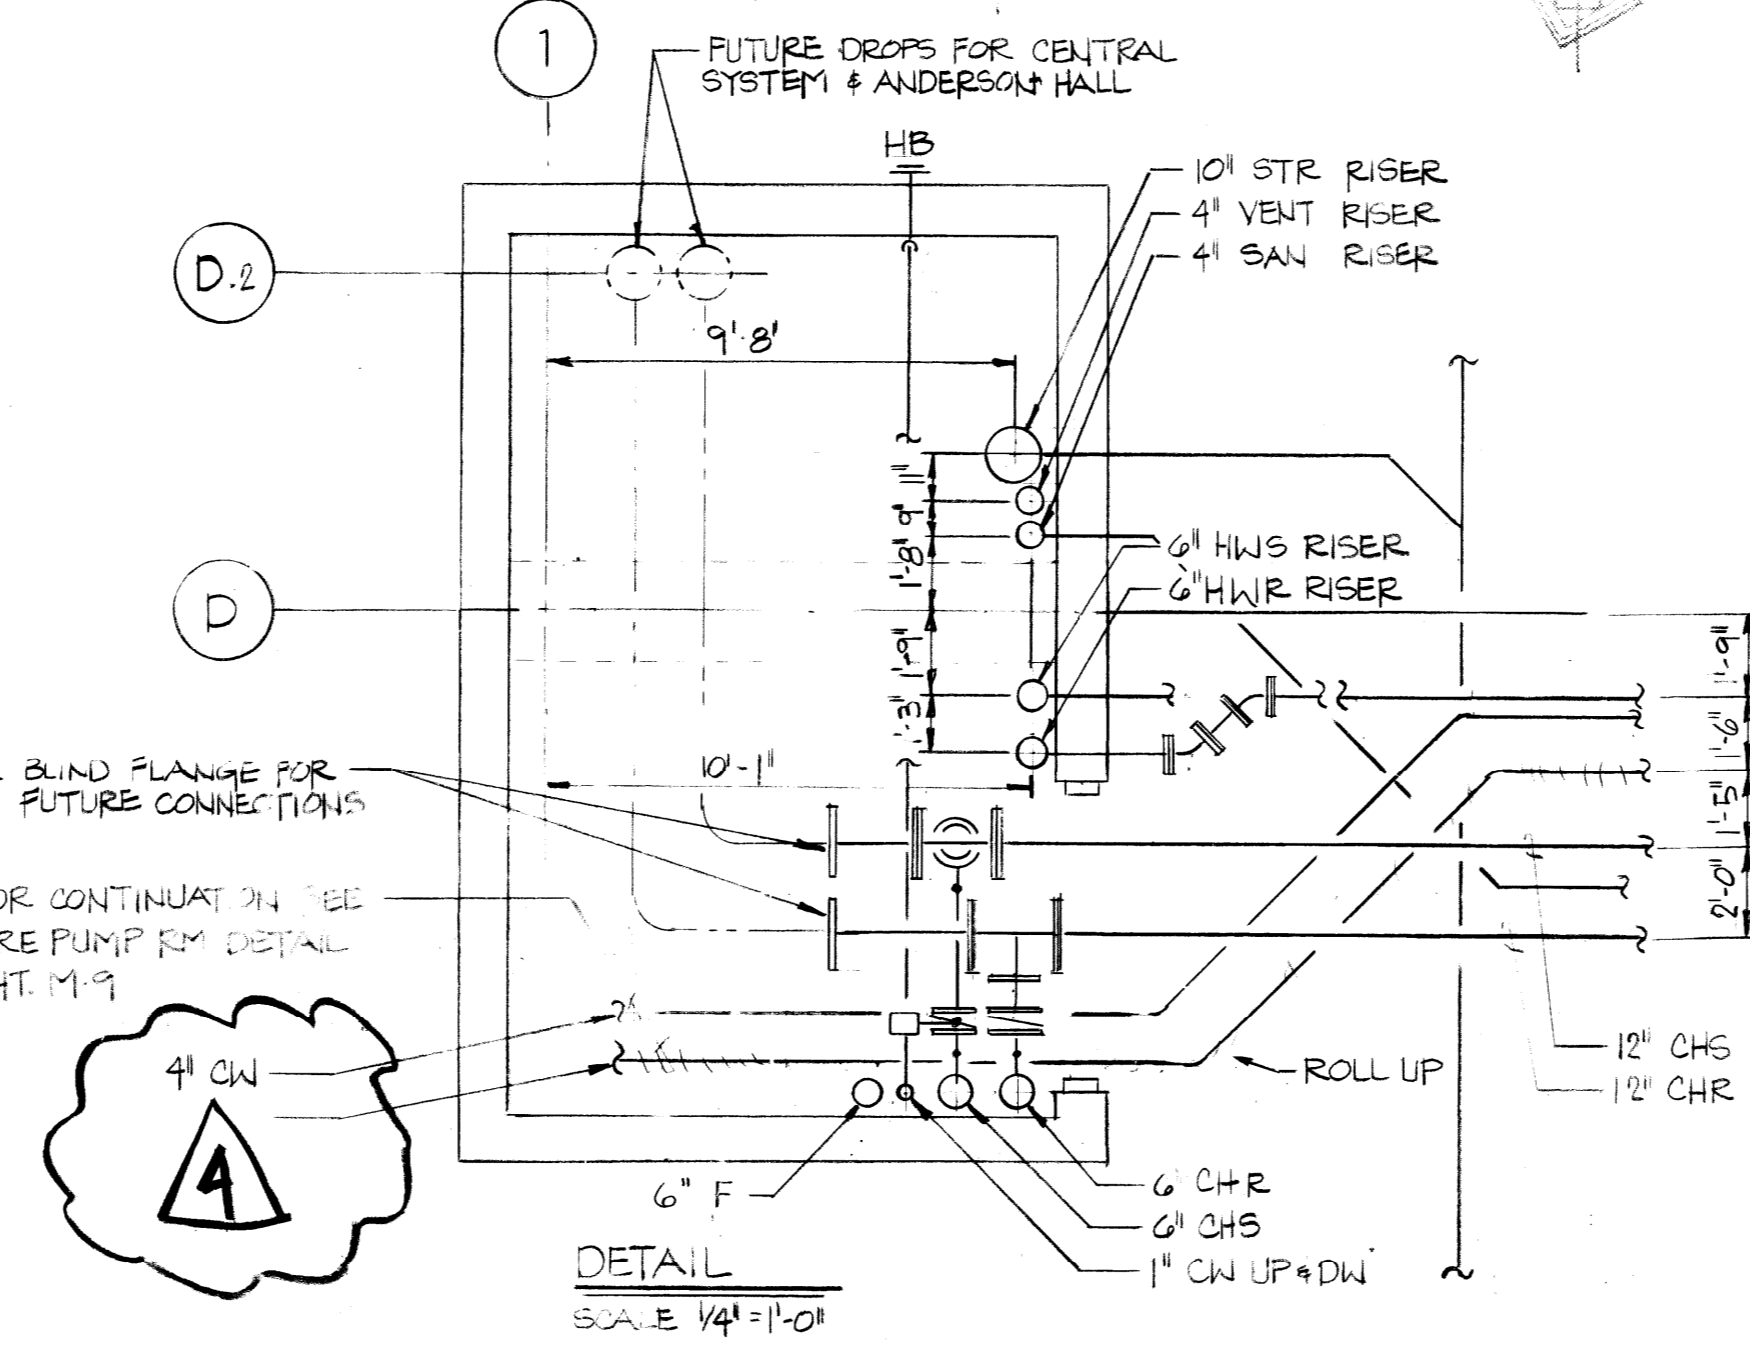

DETAIL
SCALE 1/4" = 1'-0"

"This seal and signature apply only to the unaltered document to which they are affixed. I expressly disclaim any responsibility for any and all changes made after the issue date, for other plans, specifications, estimates, reports or other documents or instruments relating to or intended to be used for any part or portion of the architectural or engineering project or survey."

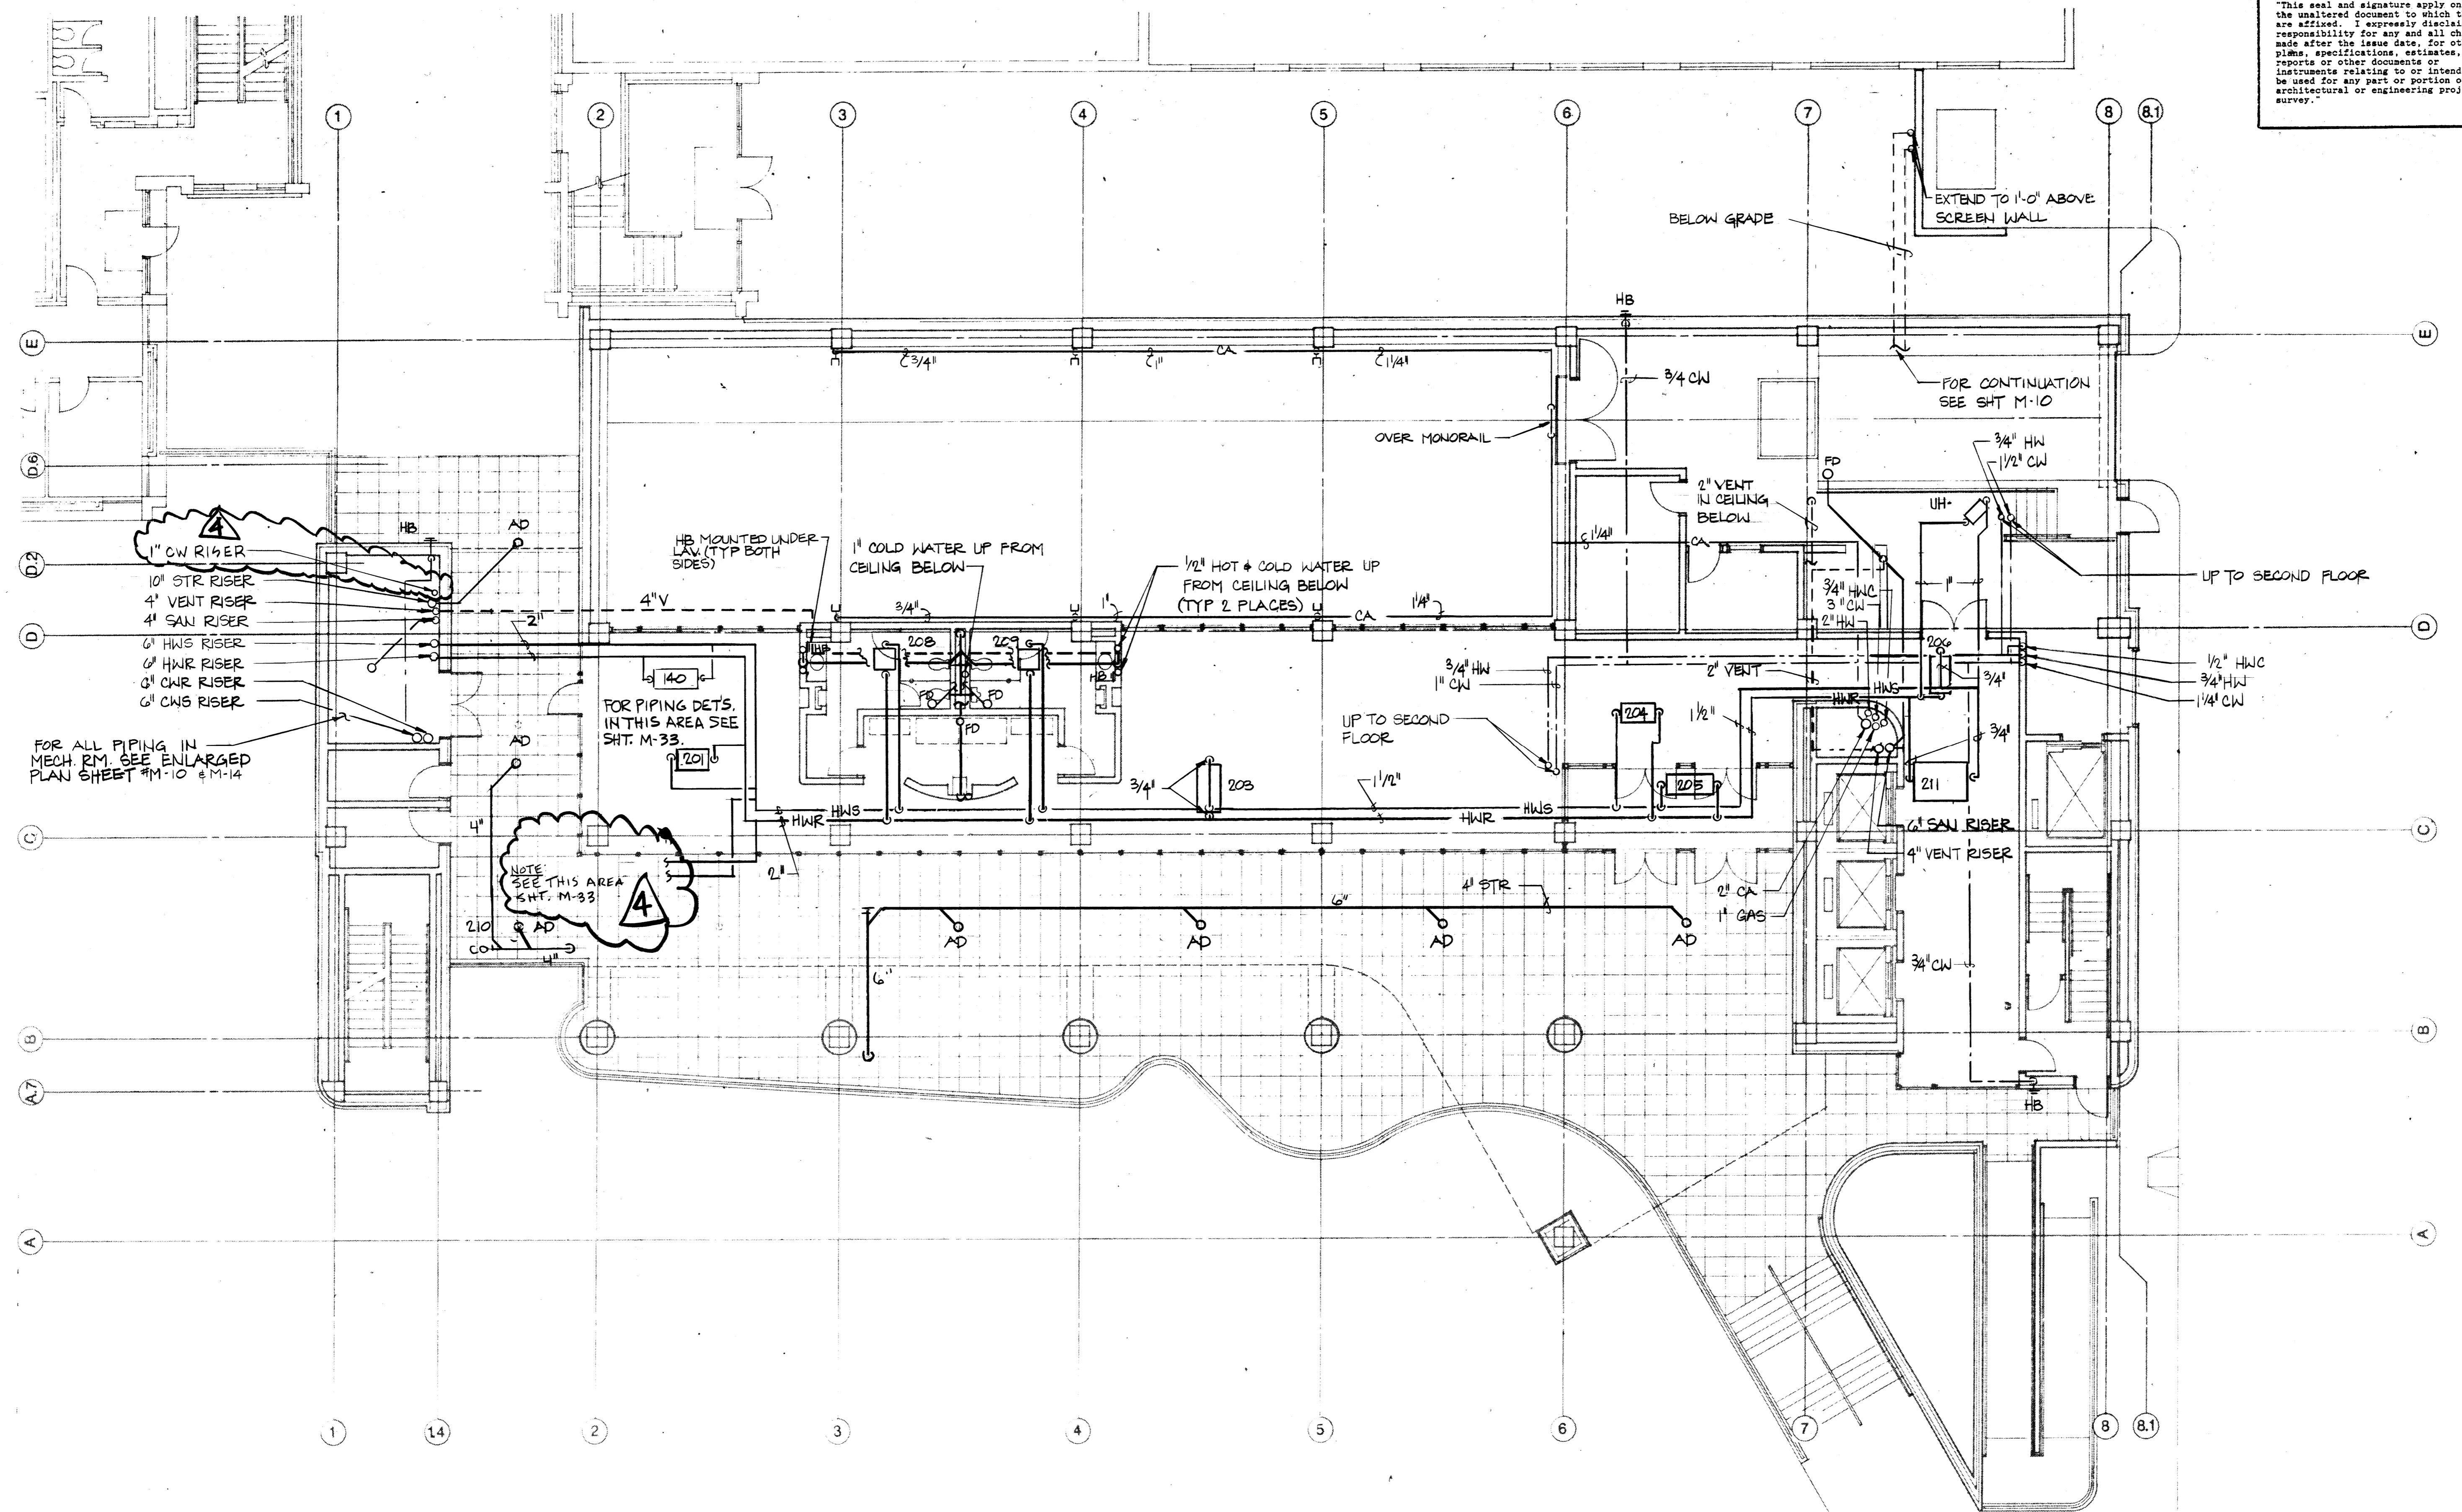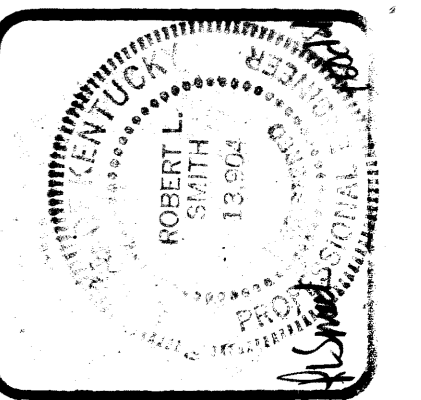

FIRST FLOOR PLAN
1/8" = 1'-0"



ROBOTICS FACILITY
LEXINGTON CAMPUS
UNIVERSITY OF KENTUCKY
LEXINGTON, KENTUCKY

University of Kentucky
Lexington, Kentucky
10-19-87
NORMAN SWANN
DIRECTOR, DESIGN AND CONSTRUCTION DIVISION

1ST FLOOR PLBG. & PIPING PLAN
Sherman Carter Barnhart
PARTNERS IN ARCHITECTURE
SUITE 1900 • 250 WEST MAIN STREET • LEXINGTON, KY 40507 • 606 254-1351



JOB NO.	8706
DATE	10-16-87
DRAWN BY	KE CASE
CHECKED	[Signature]
FILE NO.	4361

REVISIONS
3 - 90% REVIEW
4 - AS BUILT

AS BUILT
BELCAN CORPORATION
10200 ANDERSON WAY
CINCINNATI, OHIO 45242
NUMBER: 4361-CM-015-3

SHEET
M-15
Calt.#
Shir

This seal and signature apply only to the unaltered document to which they are affixed. I expressly disclaim any responsibility for any and all changes made after the issue date, for other plans, specifications, estimates, reports or other documents or instruments relating to or intended to be used for any part or portion of the architectural or engineering project or survey.

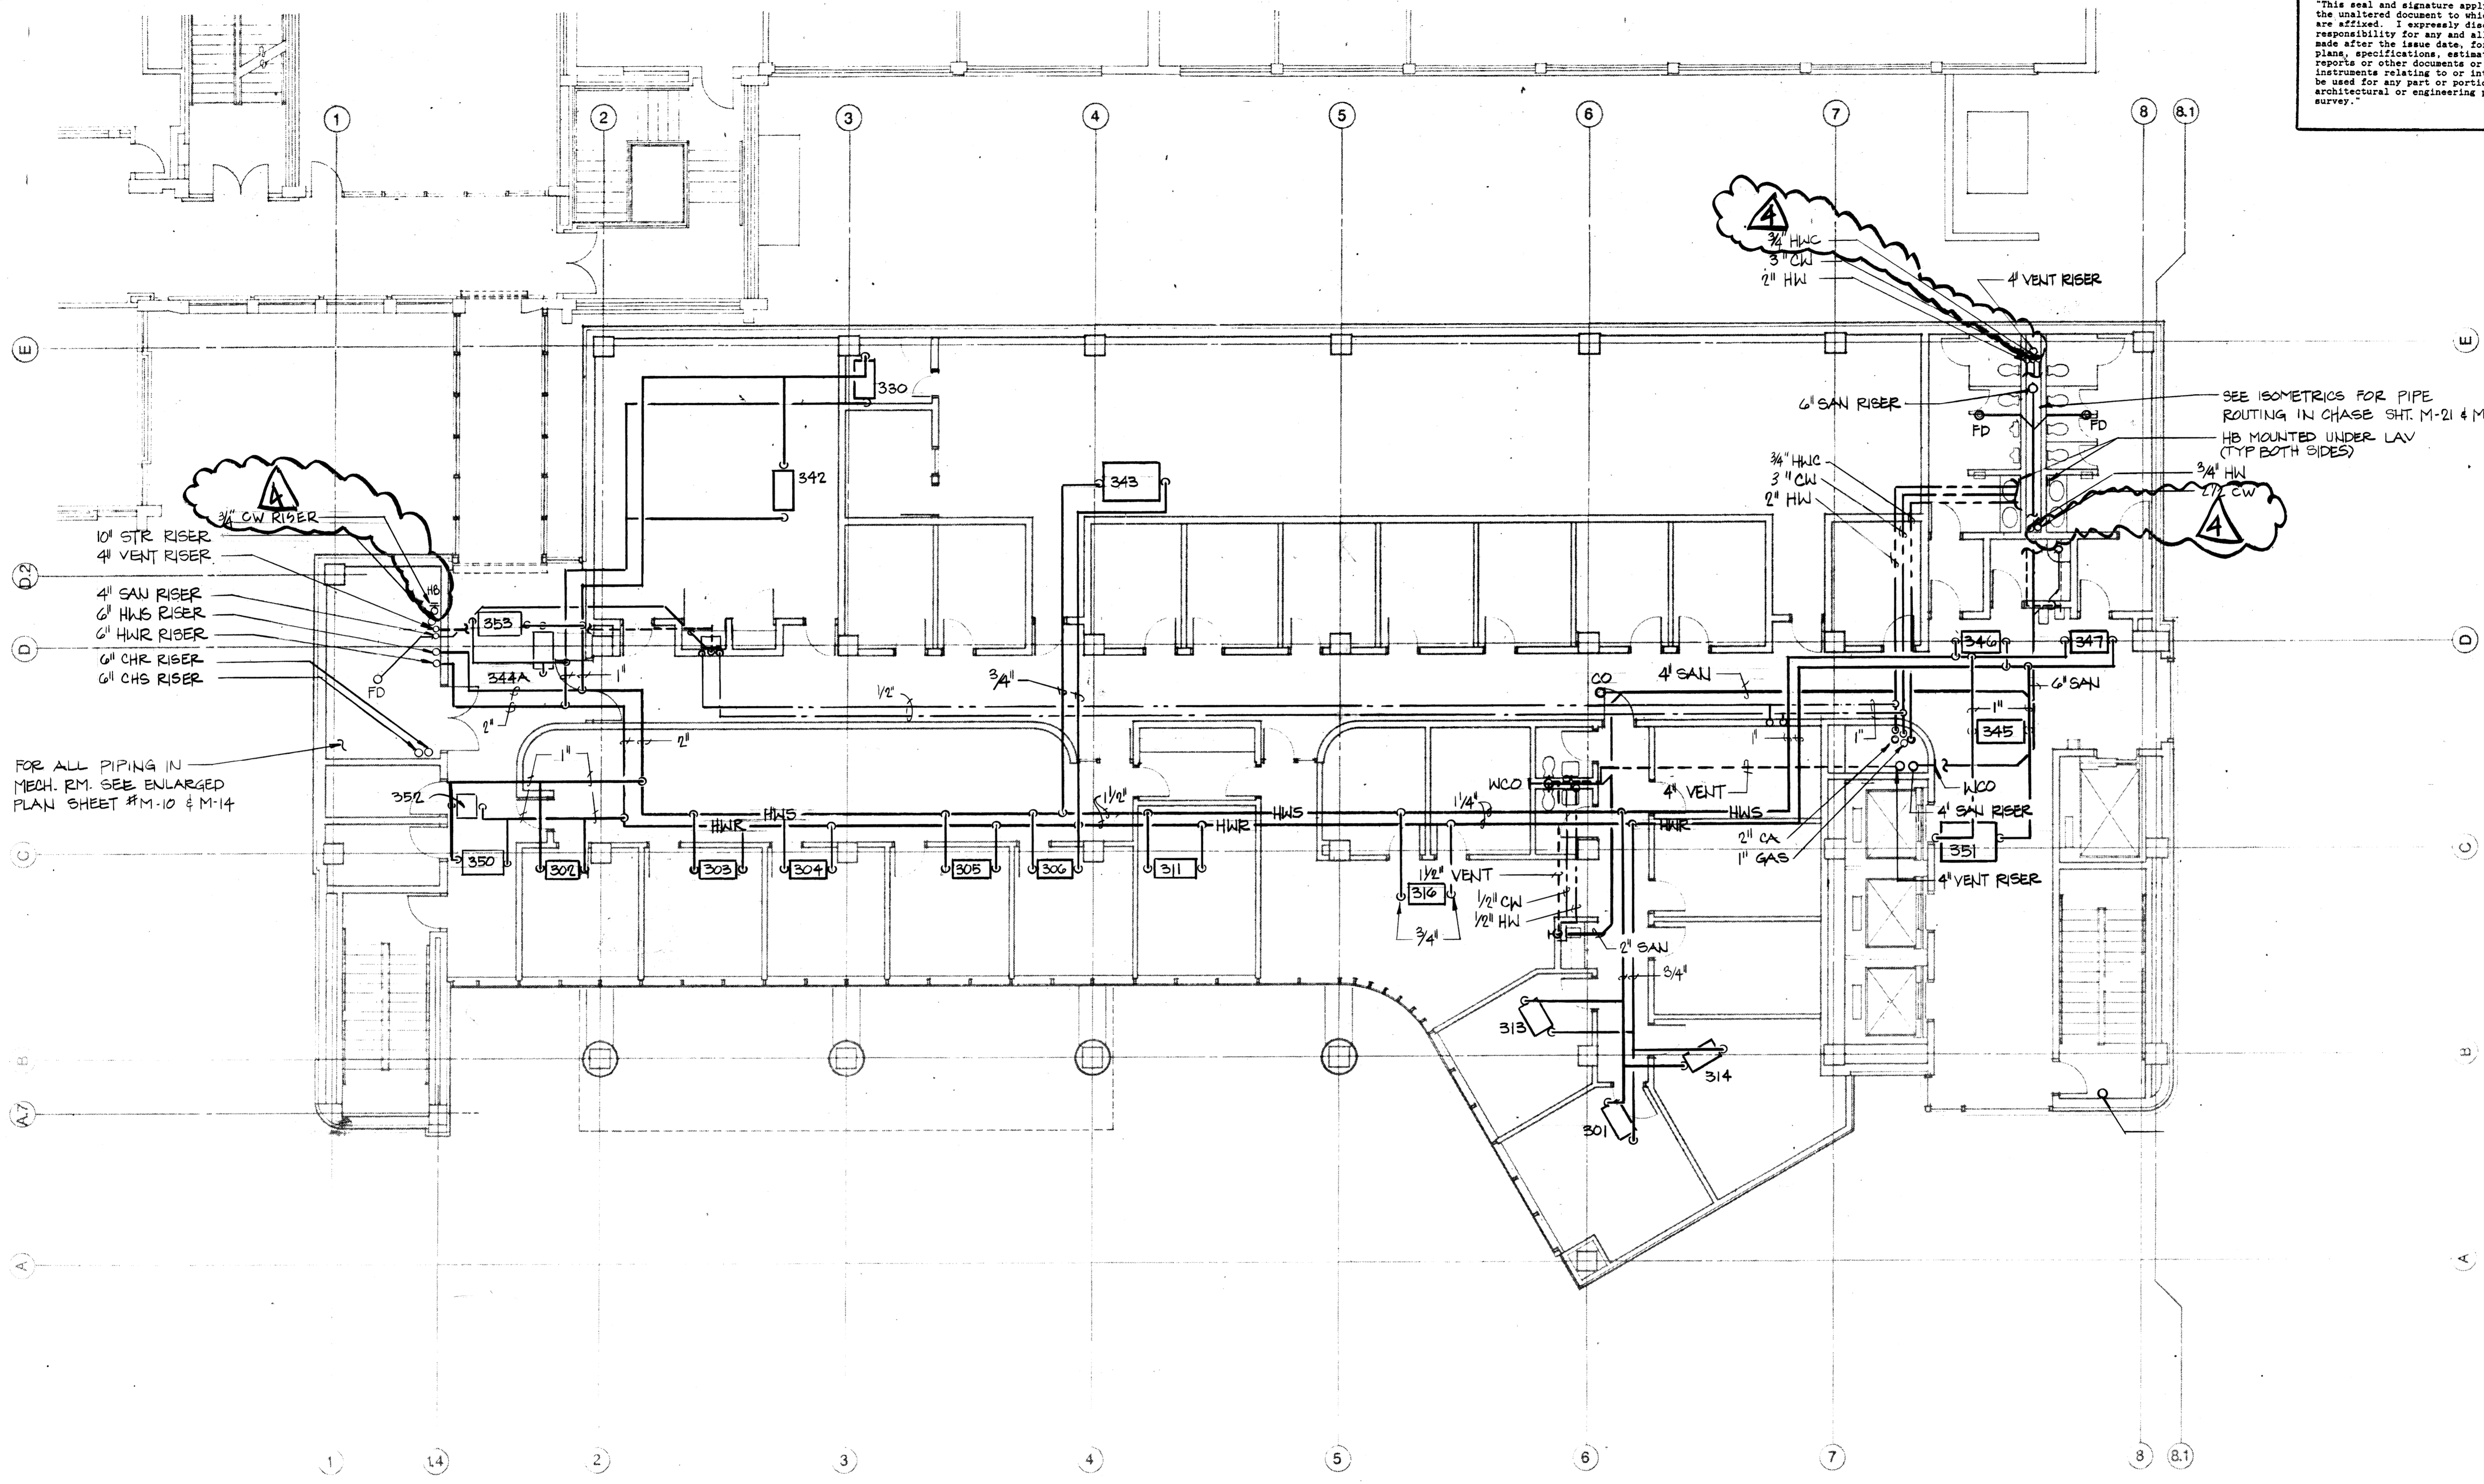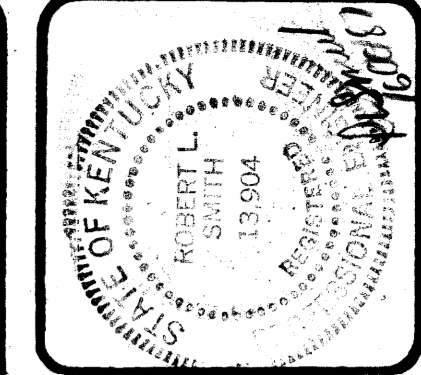

- 10" STR RISER
- 4" VENT RISER
- 4" SAN RISER
- 6" HWS RISER
- 6" HWR RISER
- 6" CHR RISER
- 6" CHS RISER

FOR ALL PIPING IN MECH. RM. SEE ENLARGED PLAN SHEET #M-10 & M-14

SECOND FLOOR PLAN
1/8" = 1'-0"



ROBOTICS FACILITY
LEXINGTON CAMPUS
UNIVERSITY OF KENTUCKY
LEXINGTON, KENTUCKY

University of Kentucky
Lexington, Kentucky

10-17-87
Walter B. Bunn
ARCHITECT

2ND FLOOR PLBG. & PIPING PLAN
Sherman Carter Barnhart
PARTNERS IN ARCHITECTURE
SUITE 1900 • 250 WEST MAIN STREET • LEXINGTON, KY 40507 • 606-254-1351

JOB NO.	8706
DATE	10-16-87
DRAWN BY	W. CASE
CHECKED BY	W. CASE
FILE NO.	431.0



REVISIONS
3- 90% REVIEW
4- AS BUILT

AS BUILT

BELCAN CORPORATION
10200 ANDERSON WAY
CINCINNATI, OHIO 45242
NUMBER: 4361-CM-016-3

SHEET
M-16

This seal and signature apply only to the unaltered document to which they are affixed. I expressly disclaim any responsibility for any and all changes made after the issue date, for other plans, specifications, estimates, reports or other documents or instruments relating to or intended to be used for any part or portion of the architectural or engineering project or survey.

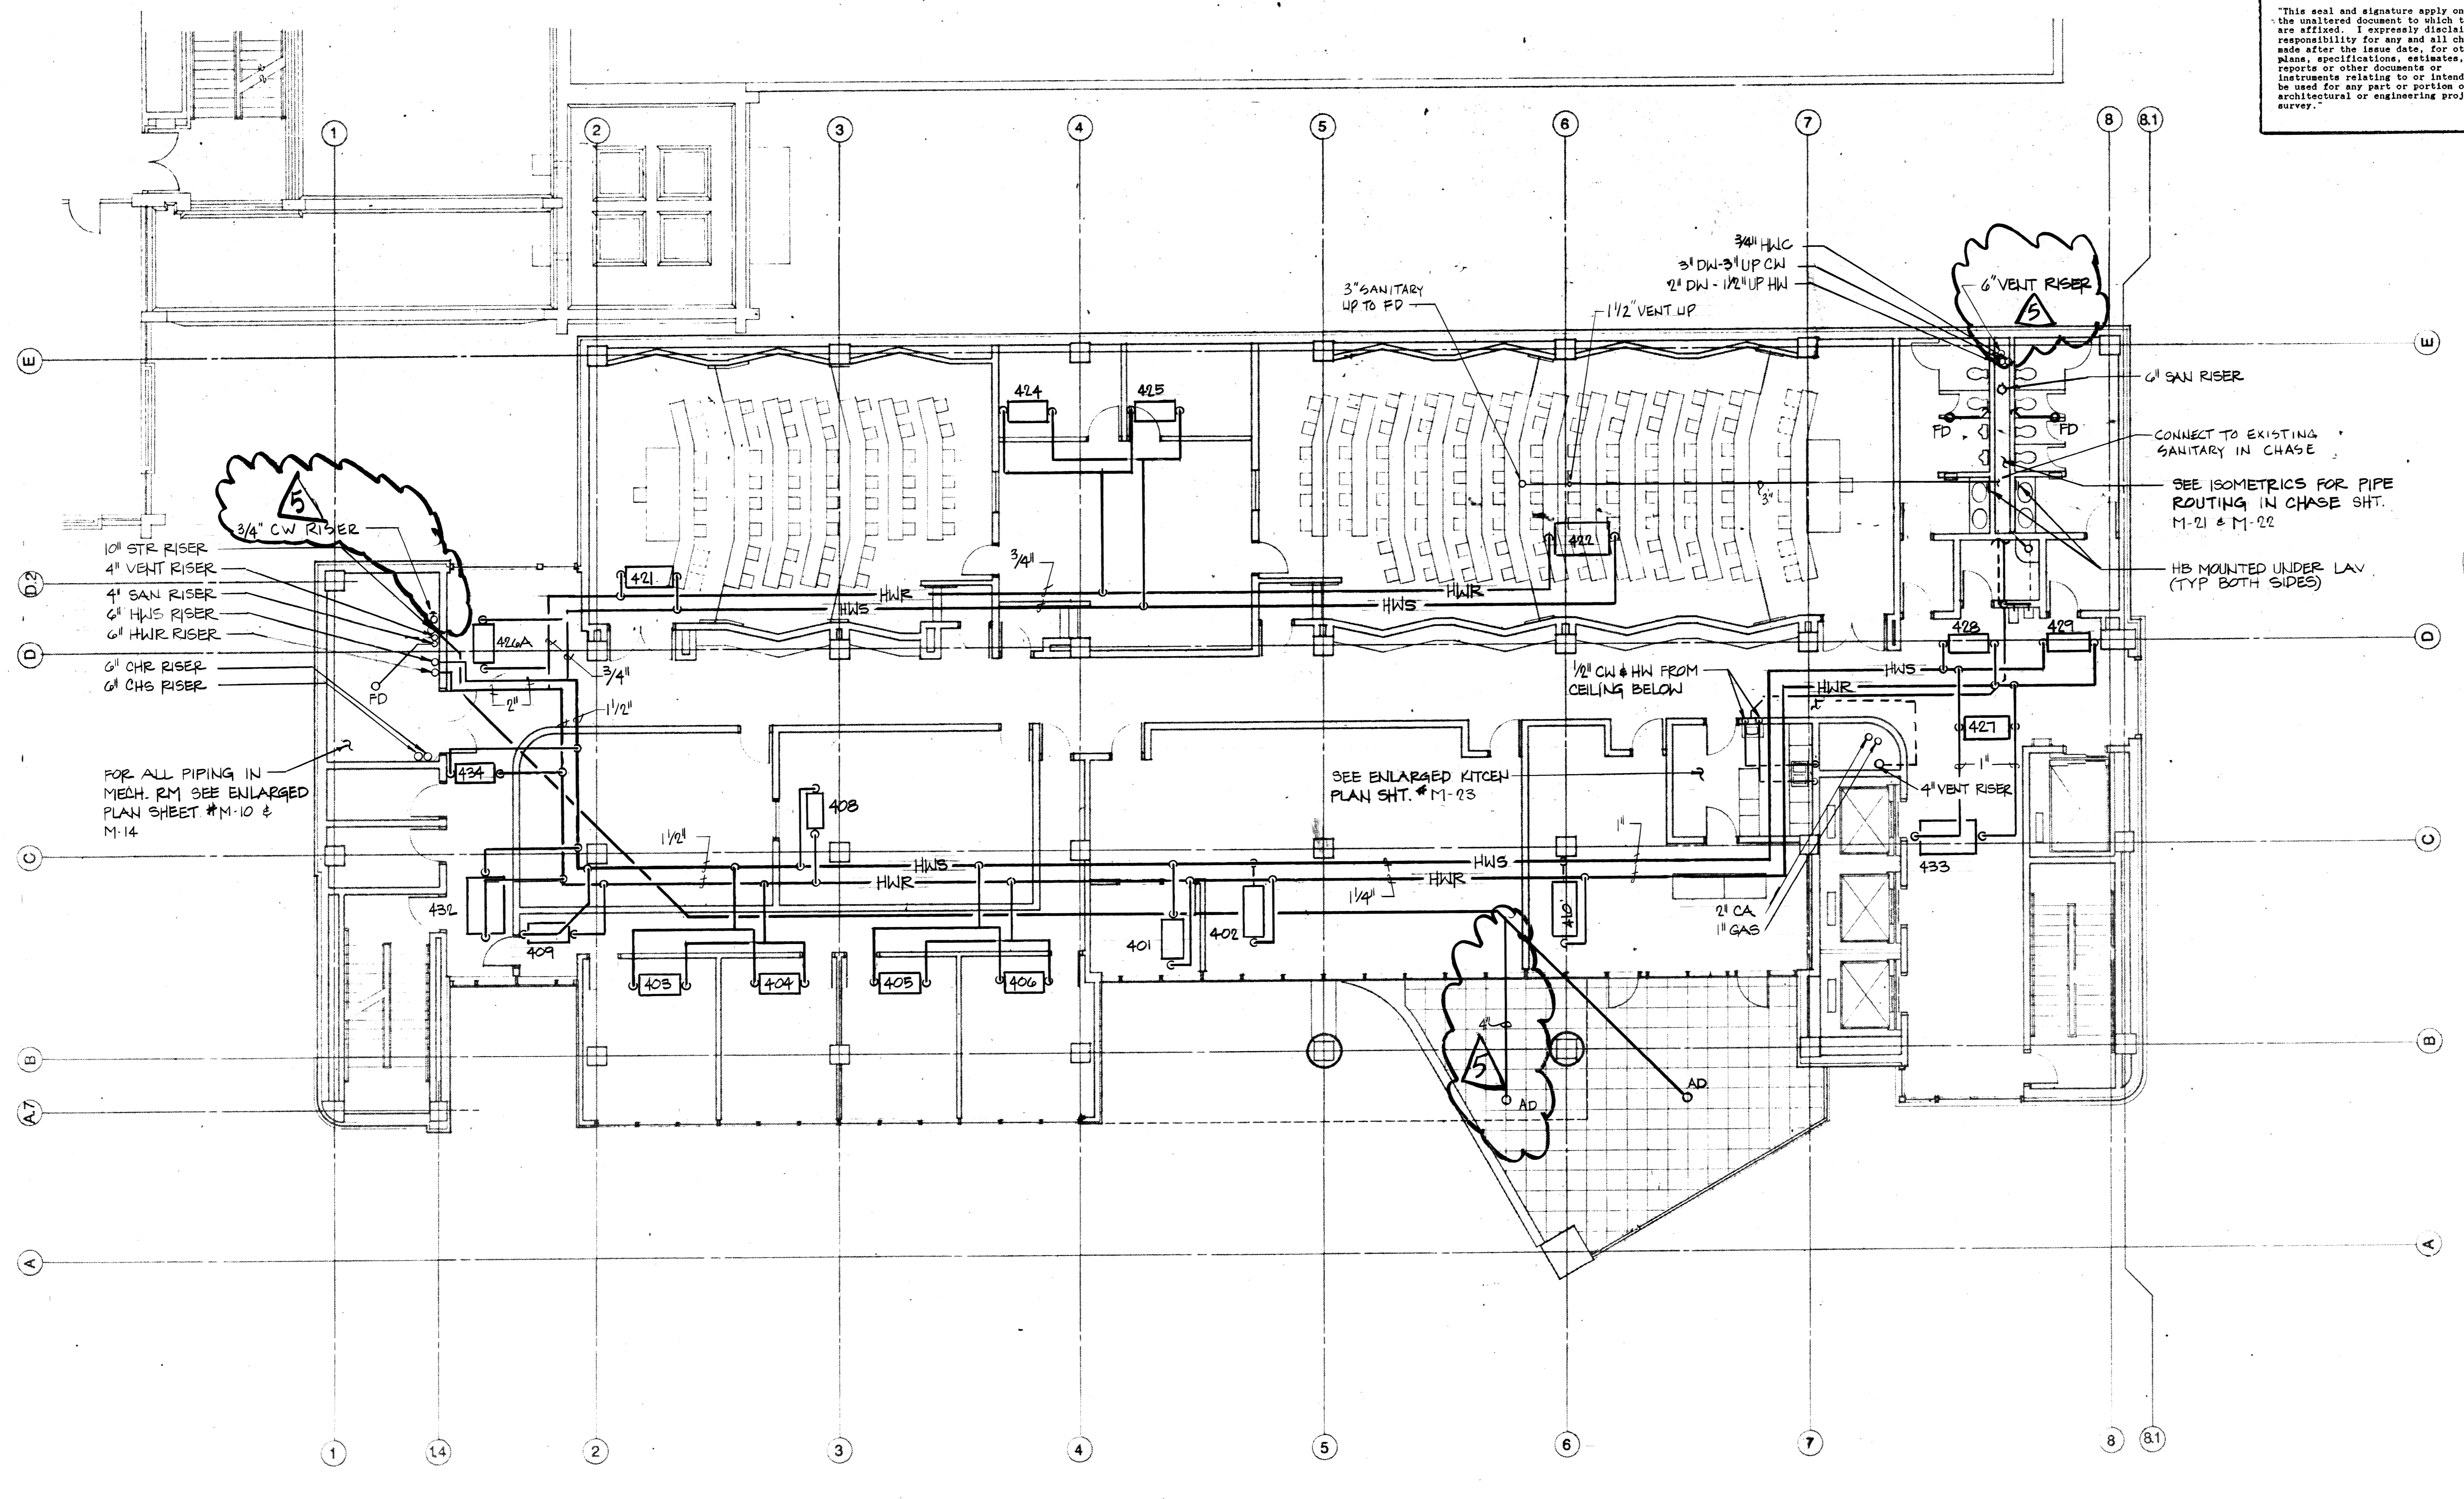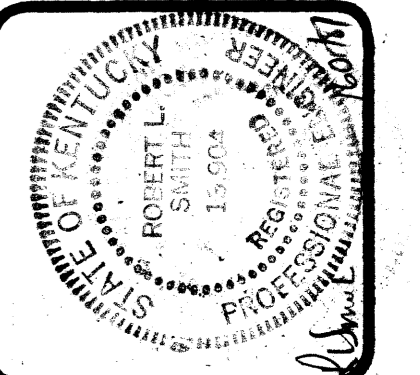

ROBOTICS FACILITY
 LEXINGTON CAMPUS
 UNIVERSITY OF KENTUCKY
 LEXINGTON, KENTUCKY

University of Kentucky
 Lexington, Kentucky
 10-17-81
 Robert Smith
 DESIGN AND CONSTRUCTION DIVISION

3RD FLOOR PLBG. & PIPING PLAN
 Sherman Carter Barnhart
 PARTNERS IN ARCHITECTURE
 SUITE 1900 • 250 WEST MAIN STREET • LEXINGTON, KY 40507 • 806-254-1351

JOB NO. 8706
 DATE 10-16-81
 DRAWN KE CASE
 CHECKED [Signature]
 FILE NO. 4310

REVISIONS
 3- 90% REVIEW
 4- ADD COMPUTER ROOM SYSTEM
 5- AS BUILT

THIRD FLOOR PLAN
 1/8" = 1'-0"




AS BUILT

BELCAN CORPORATION
 10200 ANDERSON WAY
 CINCINNATI, OHIO 45242
 NUMBER: 4361-CM-017-3

SHEET
M-17

"This seal and signature apply only to the unaltered document to which they are affixed. I expressly disclaim any responsibility for any and all changes made after the issue date, for other plans, specifications, estimates, reports or other documents or instruments relating to or intended to be used for any part or portion of the architectural or engineering project, or survey."

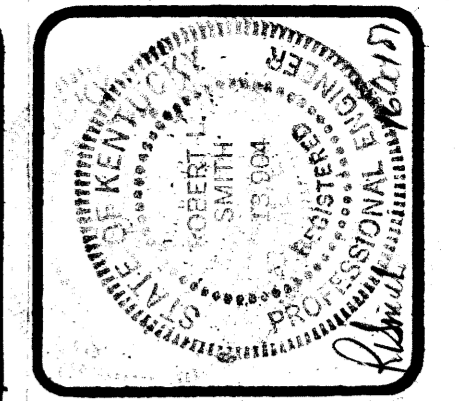

ROBOTICS FACILITY
 LEXINGTON CAMPUS
 UNIVERSITY OF KENTUCKY
 LEXINGTON, KENTUCKY


University of Kentucky
 Lexington, Kentucky
 10-19-87
 Sherman Carter Barnhart
 ARCHITECT

4TH FLOOR PLAN
 PLBG. & PIPING PLAN
 Sherman Carter Barnhart
 PARTNERS IN ARCHITECTURE
 SUITE 1900 • 750 WEST MAIN STREET • LEXINGTON, KY 40507 • 606-754-0351

JOB NO. 8706
 DATE 10-16-87
 DRAWN W.E. CASE
 CHECKED [Signature]
 FILE NO. 431.6

REVISIONS
 3- 90% REVIEW
 4- ADD COMPUTER ROOM SYSTEM
 5- AS BUILT


SHEET
M-18

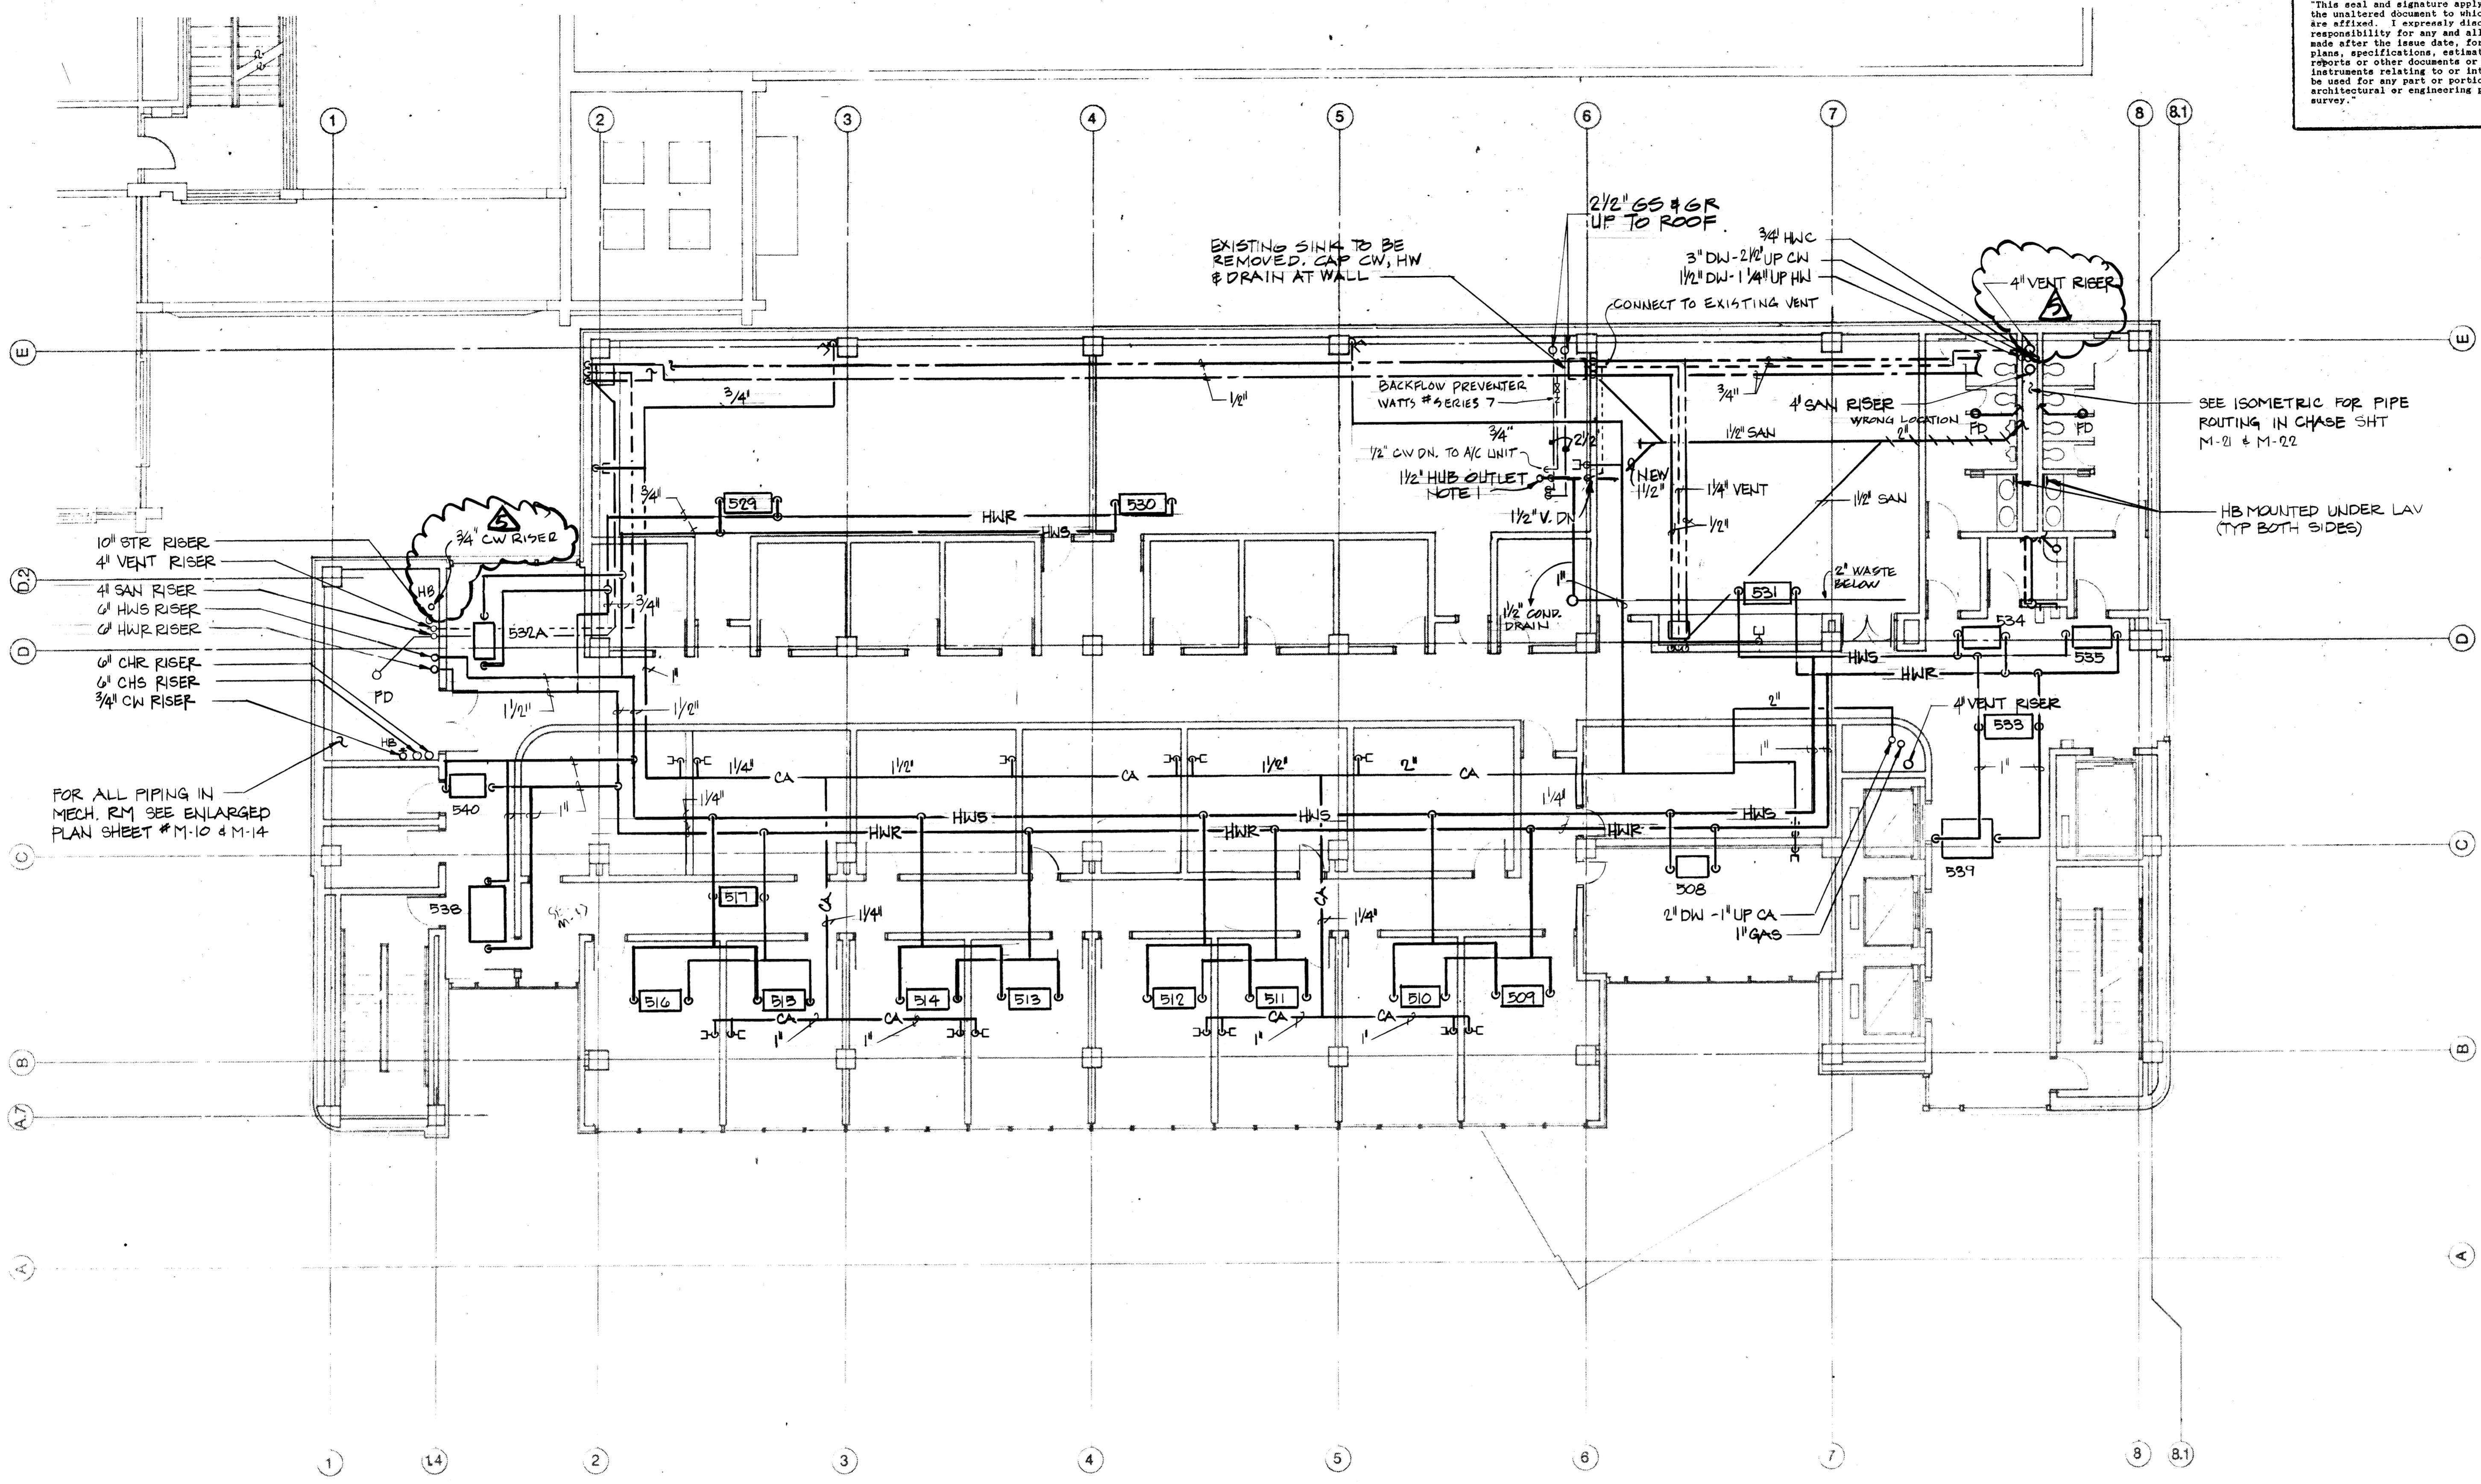

- 10" BTR RISER
- 4" VENT RISER
- 4" SAN RISER
- 6" HWS RISER
- 6" HWR RISER
- 6" CHR RISER
- 6" CHS RISER
- 3/4" CW RISER

FOR ALL PIPING IN MECH. RM SEE ENLARGED PLAN SHEET # M-10 & M-14

FOURTH FLOOR PLAN
 1/8" = 1'-0"


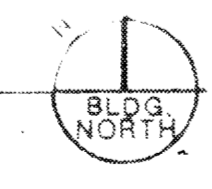


NOTES-
 1- WORK UNDER REV. 4 INCLUDES NEW CW TO AC UNIT HUMIDIFIER, HUBOUTLET, DRAIN & VENT FOR AC CONDENSATE & REMOVAL OF EXIST. SINK. NEW MATLS. TO MATCH EXIST.

AS BUILT
 BELCAN CORPORATION
 10200 ANDERSON WAY
 CINCINNATI, OHIO 45242
 NUMBER: 4361-CM-018-3

Sheet C-3 004949

"This seal and signature apply only to the unaltered document to which they are affixed. I expressly disclaim any responsibility for any and all changes made after the issue date, for other plans, specifications, estimates, reports or other documents or instruments relating to or intended to be used for any part or portion of the architectural or engineering project or survey."

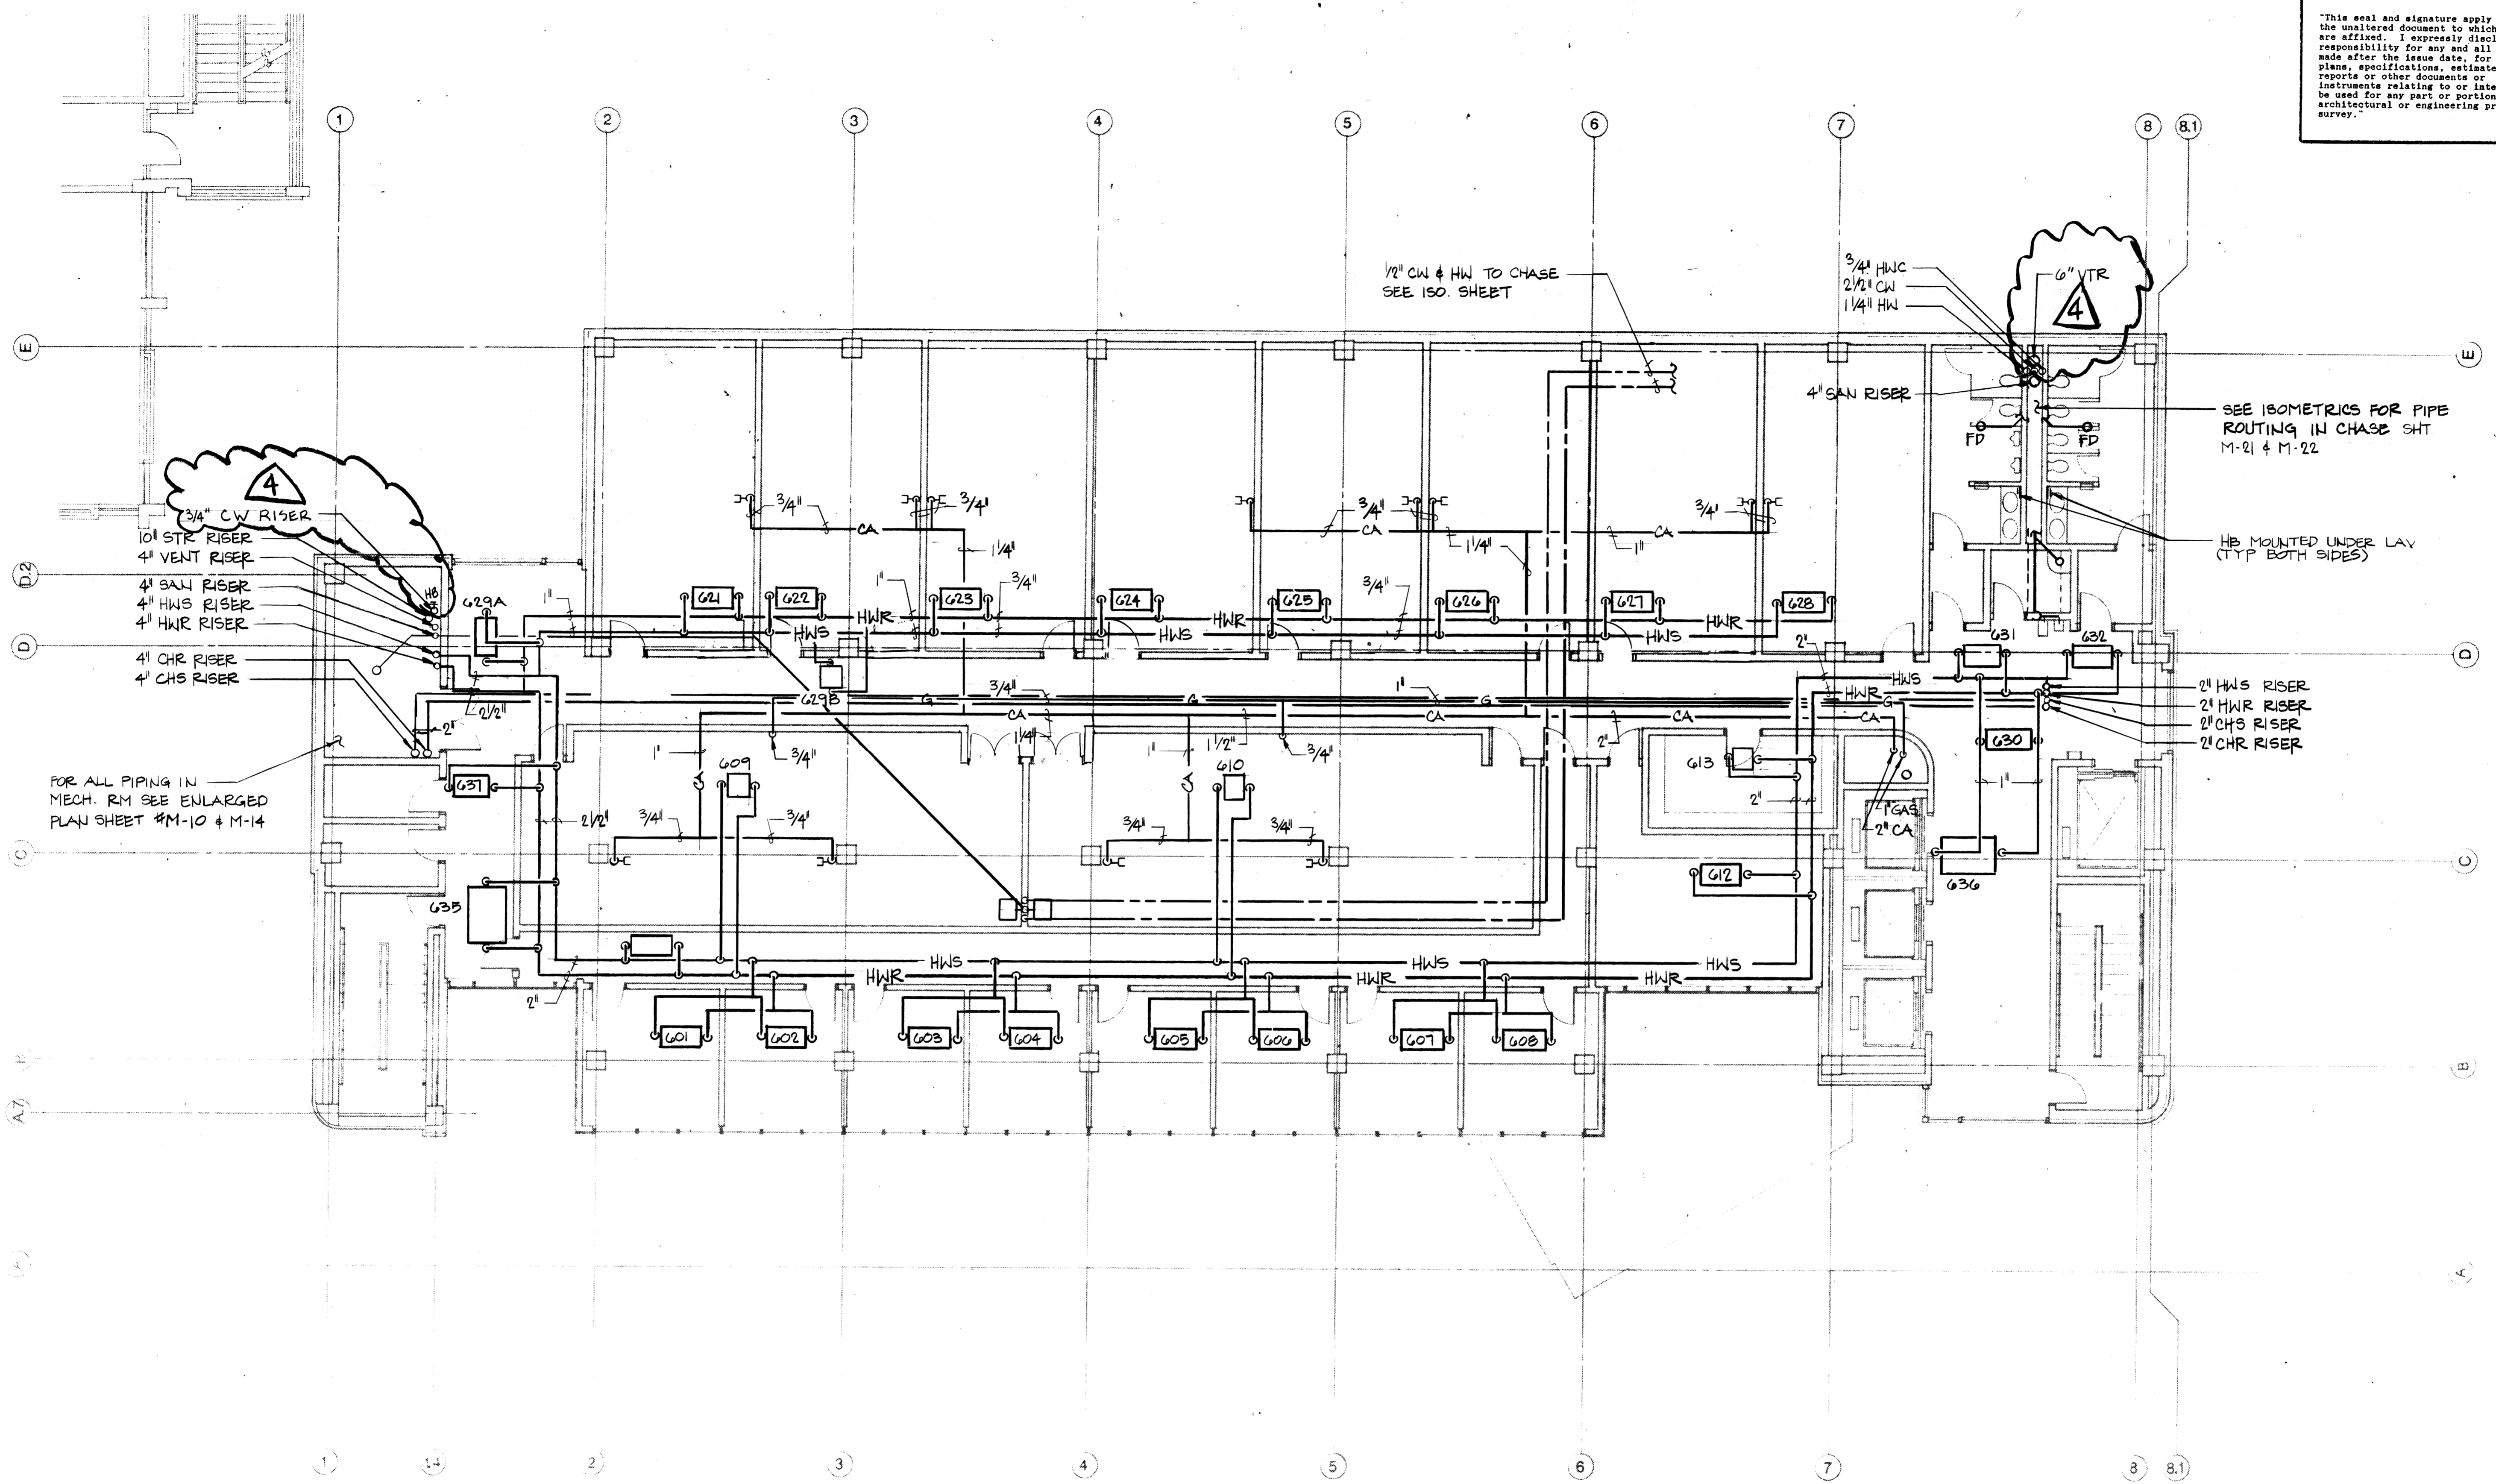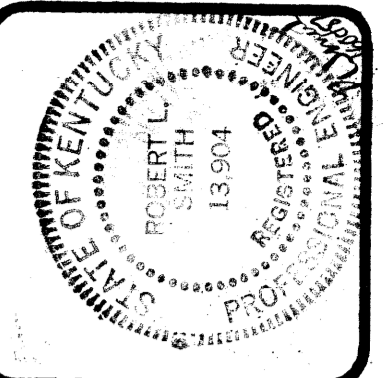

FIFTH FLOOR PLAN

1/8" = 1'-0"



ROBOTICS FACILITY
LEXINGTON CAMPUS
UNIVERSITY OF KENTUCKY
LEXINGTON, KENTUCKY

University of Kentucky
Lexington, Kentucky
Approved by: *Walter J. Smith*
10.19.87

SHERMAN-CARTER-BARNHART
PARTNERS IN ARCHITECTURE
SUITE 900 • 250 WEST MAIN STREET • LEXINGTON, KY 40507 • 606-254-1351


JOB NO.	8706
DATE	10-16-87
DRAWN BY	WE CASE
CHECKED	<i>WJL</i>
FILE NO.	4310

REVISIONS
3- 90% REVIEW
4- AS BUILT

SHEET
M-19

AS BUILT
BELCAN CORPORATION
10200 ANDERSON WAY
CINCINNATI, OHIO 45242
NUMBER: 4361-CM-09-3

"This seal and signature apply only to the unaltered document to which they are affixed. I expressly disclaim any responsibility for any and all changes made after the issue date, for other plans, specifications, estimates, reports or other documents or instruments relating to or intended to be used for any part or portion of the architectural or engineering project or survey."

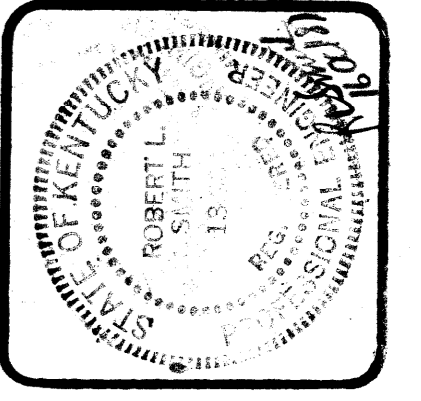

ROBOTICS FACILITY
LEXINGTON CAMPUS
UNIVERSITY OF KENTUCKY
LEXINGTON, KENTUCKY


University of Kentucky
Lexington, Kentucky
Approved: *Wendy Manning*
Director, design and construction division
10-19-87

PENTHOUSE/ROOF PLB.G. & PIPING PLAN
Stephan Carter - Barnhart
PARTNERS IN ARCHITECTURE
SUITE 1900 • 750 WEST MAIN STREET • LEXINGTON, KY 40507 • 808 754-9351

JOB NO.	8706
DATE	10-16-87
DRAWN BY	JE CASE
CHECKED	<i>JK</i>
FILE NO.	431.8

REVISIONS
3 - 70% REVIEW
4 - AS BUILT

SHEET
M-20
SHEET # 82
SHEET C-3
Document # 004951

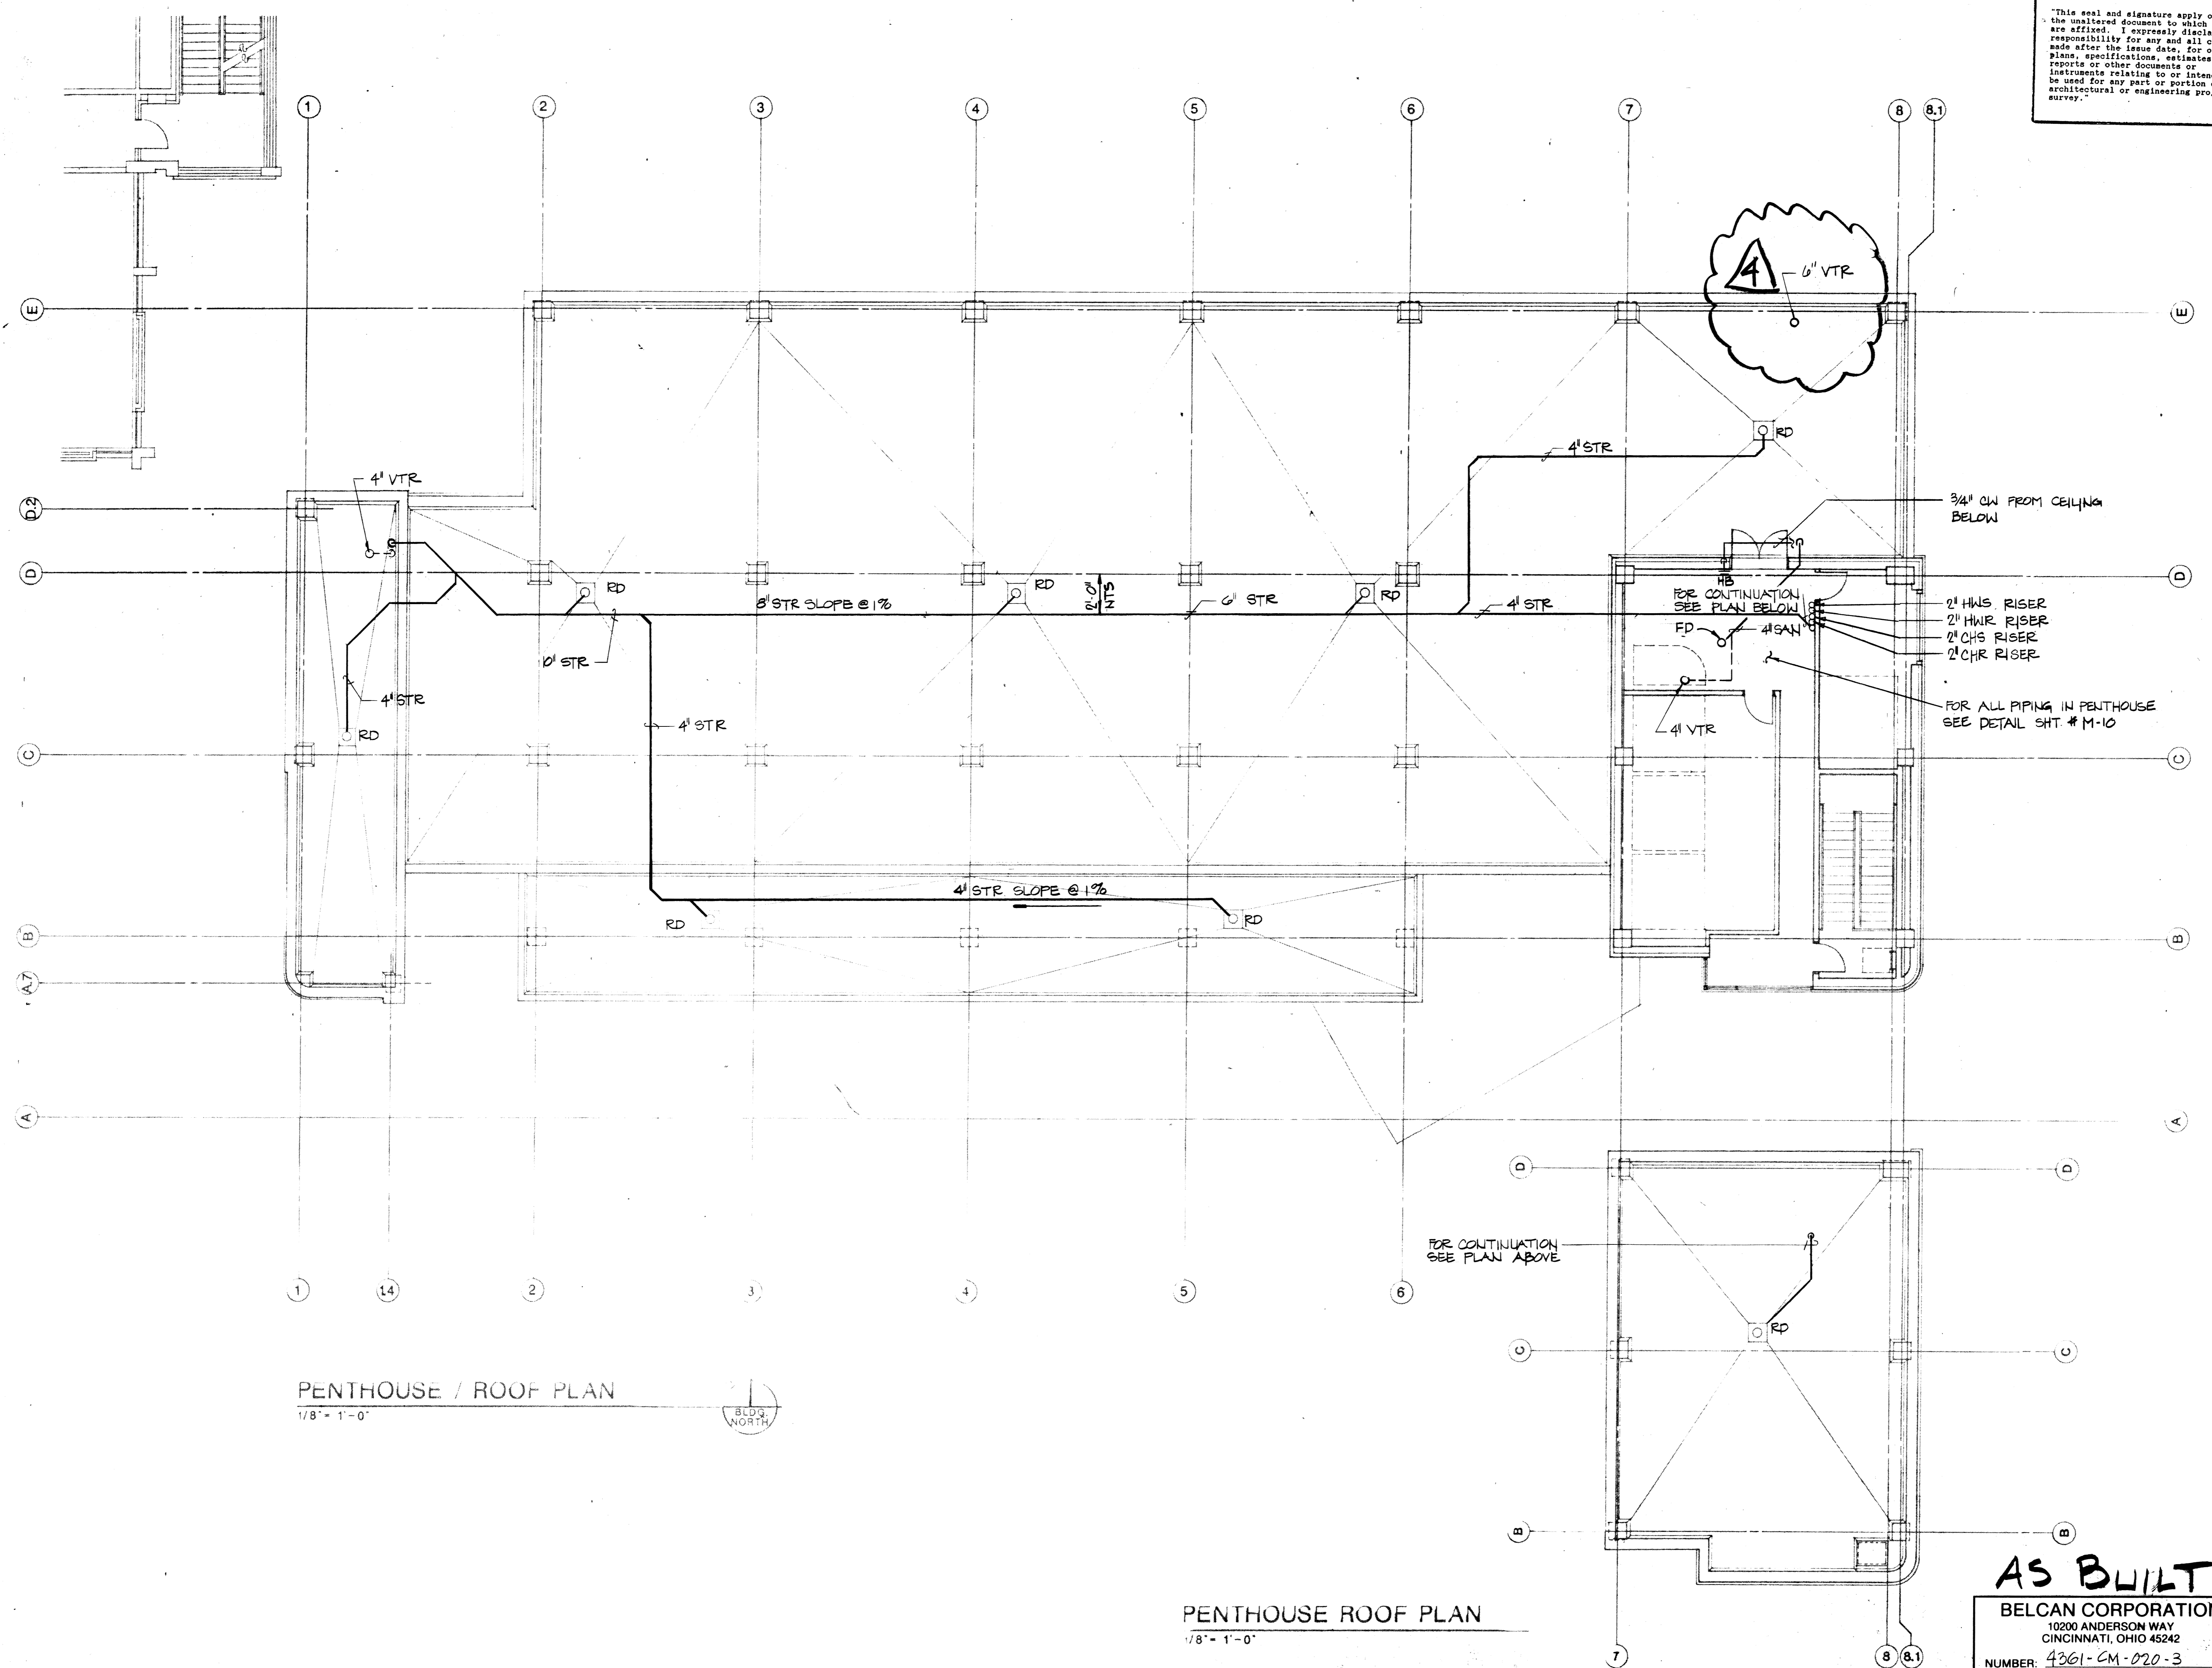


PENTHOUSE / ROOF PLAN
1/8" = 1'-0"
BLDG. NORTH

PENTHOUSE ROOF PLAN
1/8" = 1'-0"

AS BUILT
BELCAN CORPORATION
10200 ANDERSON WAY
CINCINNATI, OHIO 45242
NUMBER: 4361-CM-020-3

"This seal and signature apply only to the unaltered document to which they are affixed. I expressly disclaim any responsibility for any and all changes made after the issue date, for other plans, specifications, estimates, reports or other documents or instruments relating to or intended to be used for any part or portion of the architectural or engineering project or survey."

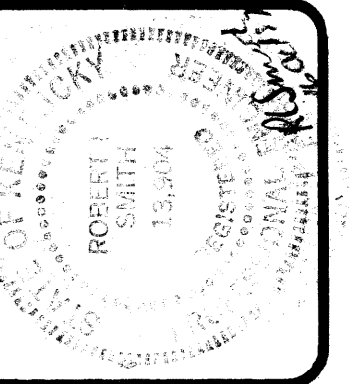

ROBOTICS FACILITY
LEXINGTON CAMPUS
UNIVERSITY OF KENTUCKY
LEXINGTON, KENTUCKY

University of Kentucky
Lexington, Kentucky

10.19.97

Robert L. Bunn
Director - design and construction

SANITARY ISOMETRIC

Sherman Carter Barnhart
PARTNERS IN ARCHITECTURE
SUITE 1800 • 250 WEST MAIN STREET • LEXINGTON, KY 40507 • 800.254.1351

JOB NO. 8706
DATE 10-16-97
DRAWN KE CASE
CHECKED [Signature]
IN FILE NO. 431.0

REVISIONS
3- 90% REVIEW
4- AS BUILT

SHEET


M-21

AS BUILT
BELCAN CORPORATION
10200 ANDERSON WAY
CINCINNATI, OHIO 45242
NUMBER: 4361-CM21-3

SANITARY ISOMETRIC
N.T.S.

* ROUGH-IN THIS URINAL AT EACH FLOOR FOR STANDARD CHILDREN ROUGH-IN ELEVATION

NOTE:
PROVIDE A FULL SIZE WYE W/ CAP AT EACH FLOOR ON BOTH SAN RISERS FOR FUTURE CONNECTION.

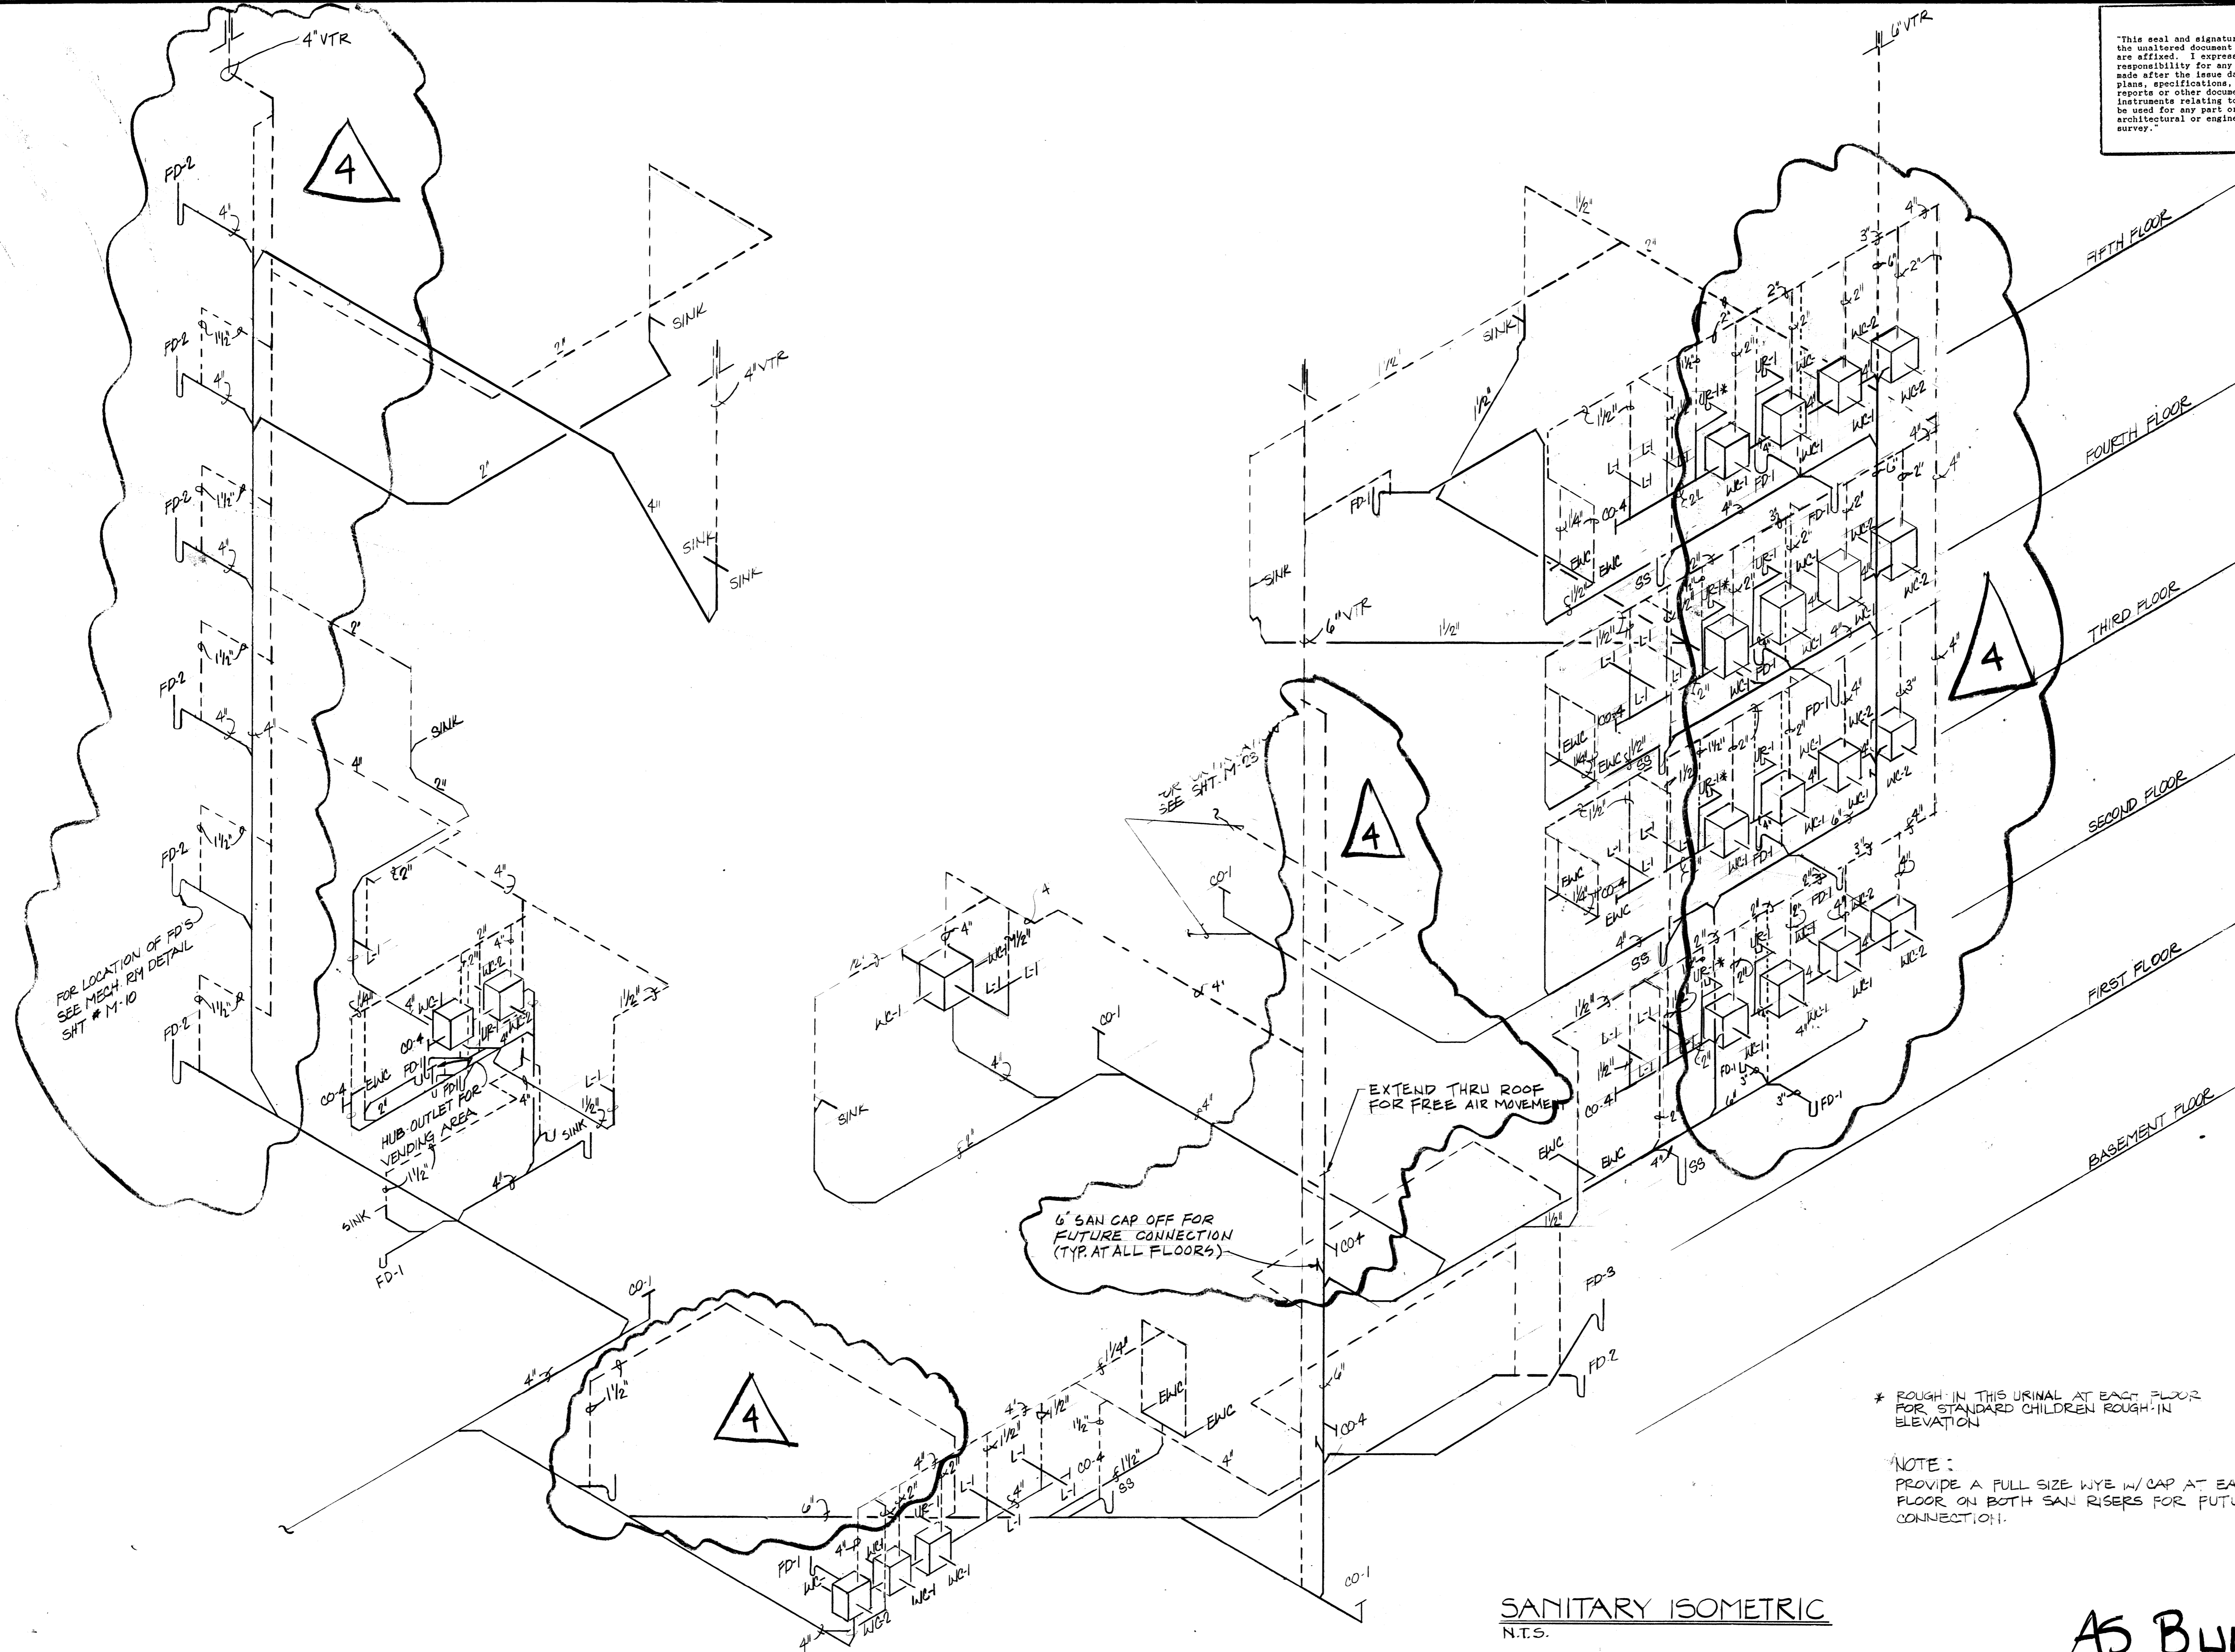


FOR LOCATION OF F.D.'S
SEE MECH. RM DETAIL
SHT # M-10

HUB OUTLET FOR
VENDING AREA

6" SAN CAP OFF FOR
FUTURE CONNECTION
(TYP. AT ALL FLOORS)

EXTEND THRU ROOF
FOR FREE AIR MOVEMENT

"This seal and signature apply only to the unaltered document to which they are affixed. I expressly disclaim any responsibility for any and all changes made after the issue date, for other plans, specifications, estimates, reports or other documents or instruments relating to or intended to be used for any part or portion of the architectural or engineering project or survey."

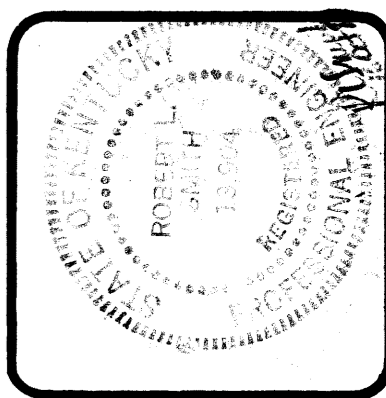

ROBOTICS FACILITY
 LEXINGTON CAMPUS
 UNIVERSITY OF KENTUCKY
 LEXINGTON, KENTUCKY


University of Kentucky
 Lexington, Kentucky
 Approved by: *Deborah ...*
 Director - design and construction services
 10.19.87

DOMESTIC WATER ISOMETRIC
Sherman Carter Barnhart
 PARTNERS IN ARCHITECTURE
 SUITE 1800 • 250 WEST MAIN STREET • LEXINGTON, KY 40501 • 606-251-1501

JOB NO. 8706
 DATE 10-16-87
 DRAWN KE CASE
 CHECKED [Signature]
 4310

REVISIONS
3- 90% REVIEW
4- AS BUILT


SHEET
 M-22
 04953

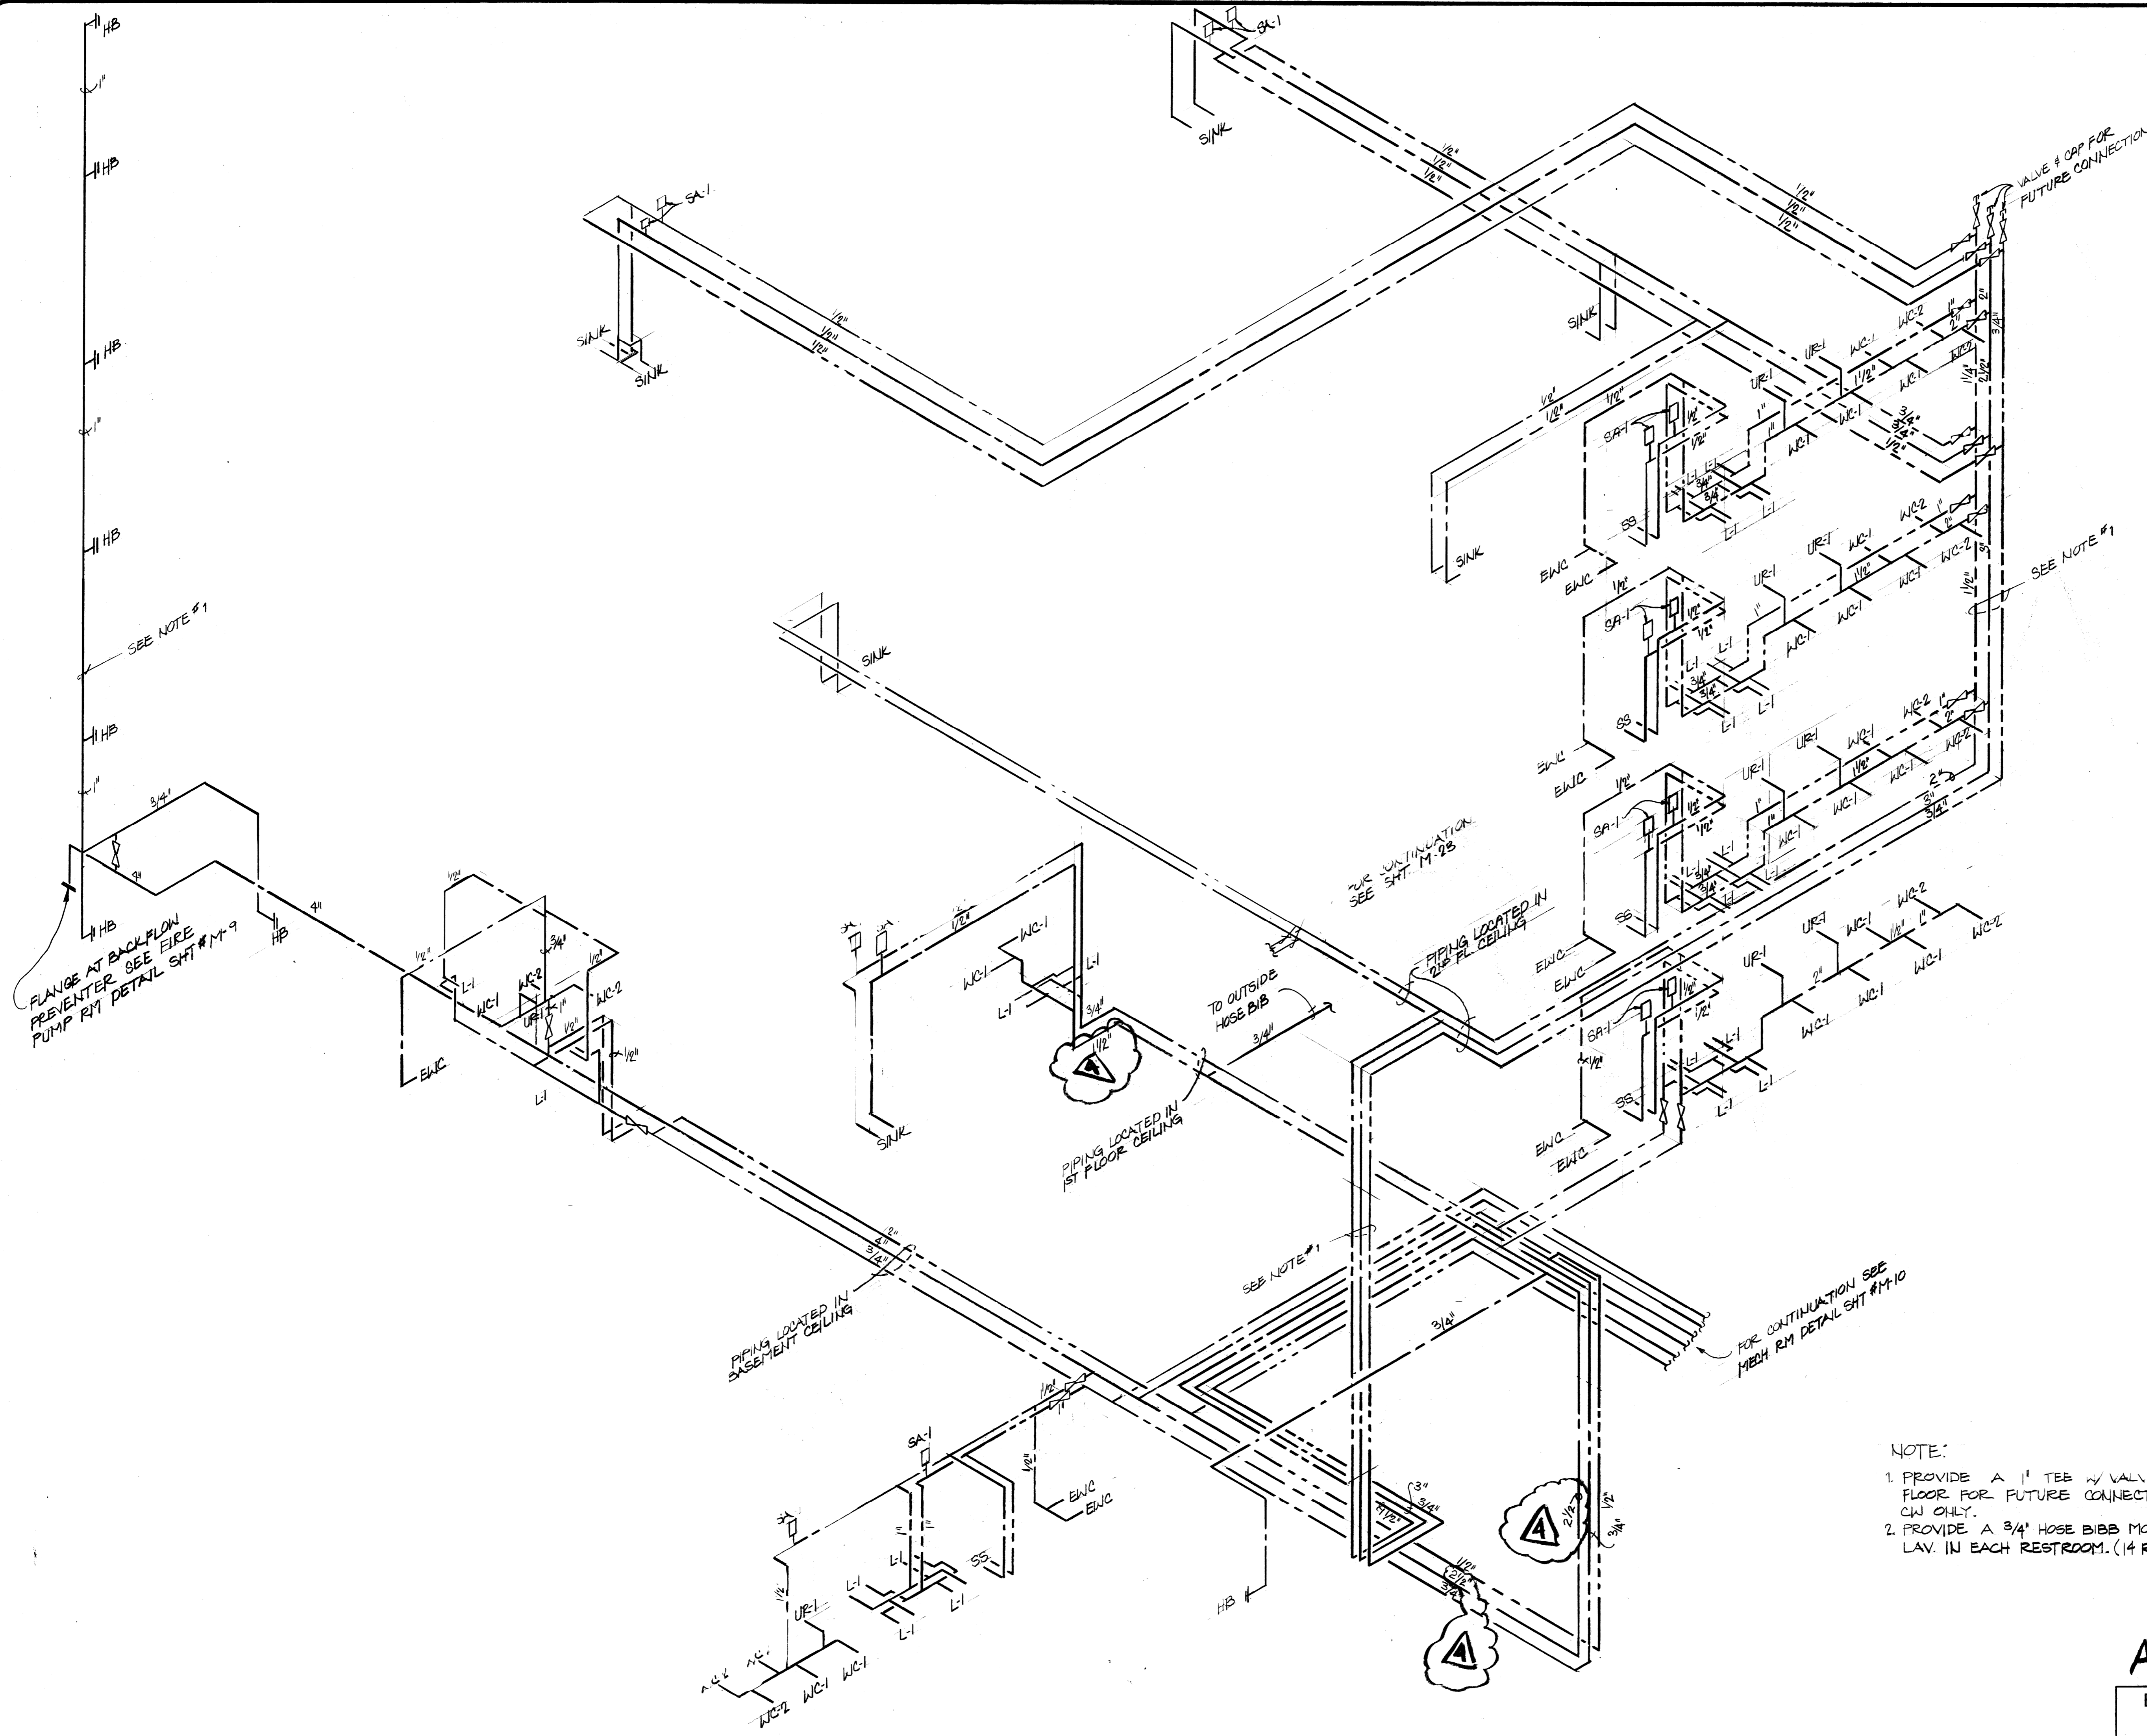

- NOTE:
1. PROVIDE A 1" TEE W/ VALVE + CAP AT EACH FLOOR FOR FUTURE CONNECTION HW & CW ONLY.
 2. PROVIDE A 3/4" HOSE BIBBS MOUNTED UNDER LAV. IN EACH RESTROOM. (14 REQ'D)

AS BUILT
 BELCAN CORPORATION
 10200 ANDERSON WAY
 CINCINNATI, OHIO 45242
 NUMBER: 4261-CM-022-3

This seal and signature apply only to the unaltered document to which they are affixed. I expressly disclaim any responsibility for any and all changes made after the issue date, for other plans, specifications, estimates, reports or other documents or instruments relating to or intended to be used for any part or portion of the architectural or engineering project or survey.

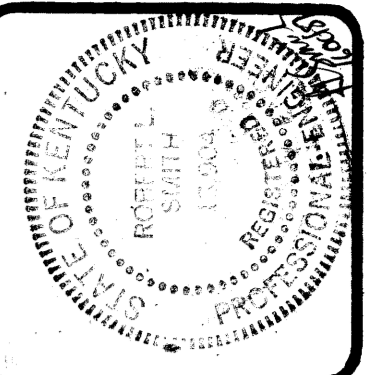

ROBOTICS FACILITY
LEXINGTON CAMPUS
UNIVERSITY OF KENTUCKY
LEXINGTON, KENTUCKY

University of Kentucky
Lexington, Kentucky
Approved by: *Wendy Spawny*
DATE: 10-19-87

BASEMENT FIRE PROTECTION
Ashman Carter Barnhart
PARTNERS IN ARCHITECTURE
SUITE 1900 • 250 WEST MAIN STREET • LEXINGTON KY 40507 • 502-254-1951


JOB NO. 3706
DATE 10-16-87
DRAWN THOMPSON
CHECKED [Signature]
FILE NO. 43.05

REVISIONS
3- 90% REVIEW

SHEET
M-24

AS BUILT


BELCAN CORPORATION
10200 ANDERSON WAY
CINCINNATI, OHIO 45242
NUMBER: 4301-6M-024-3

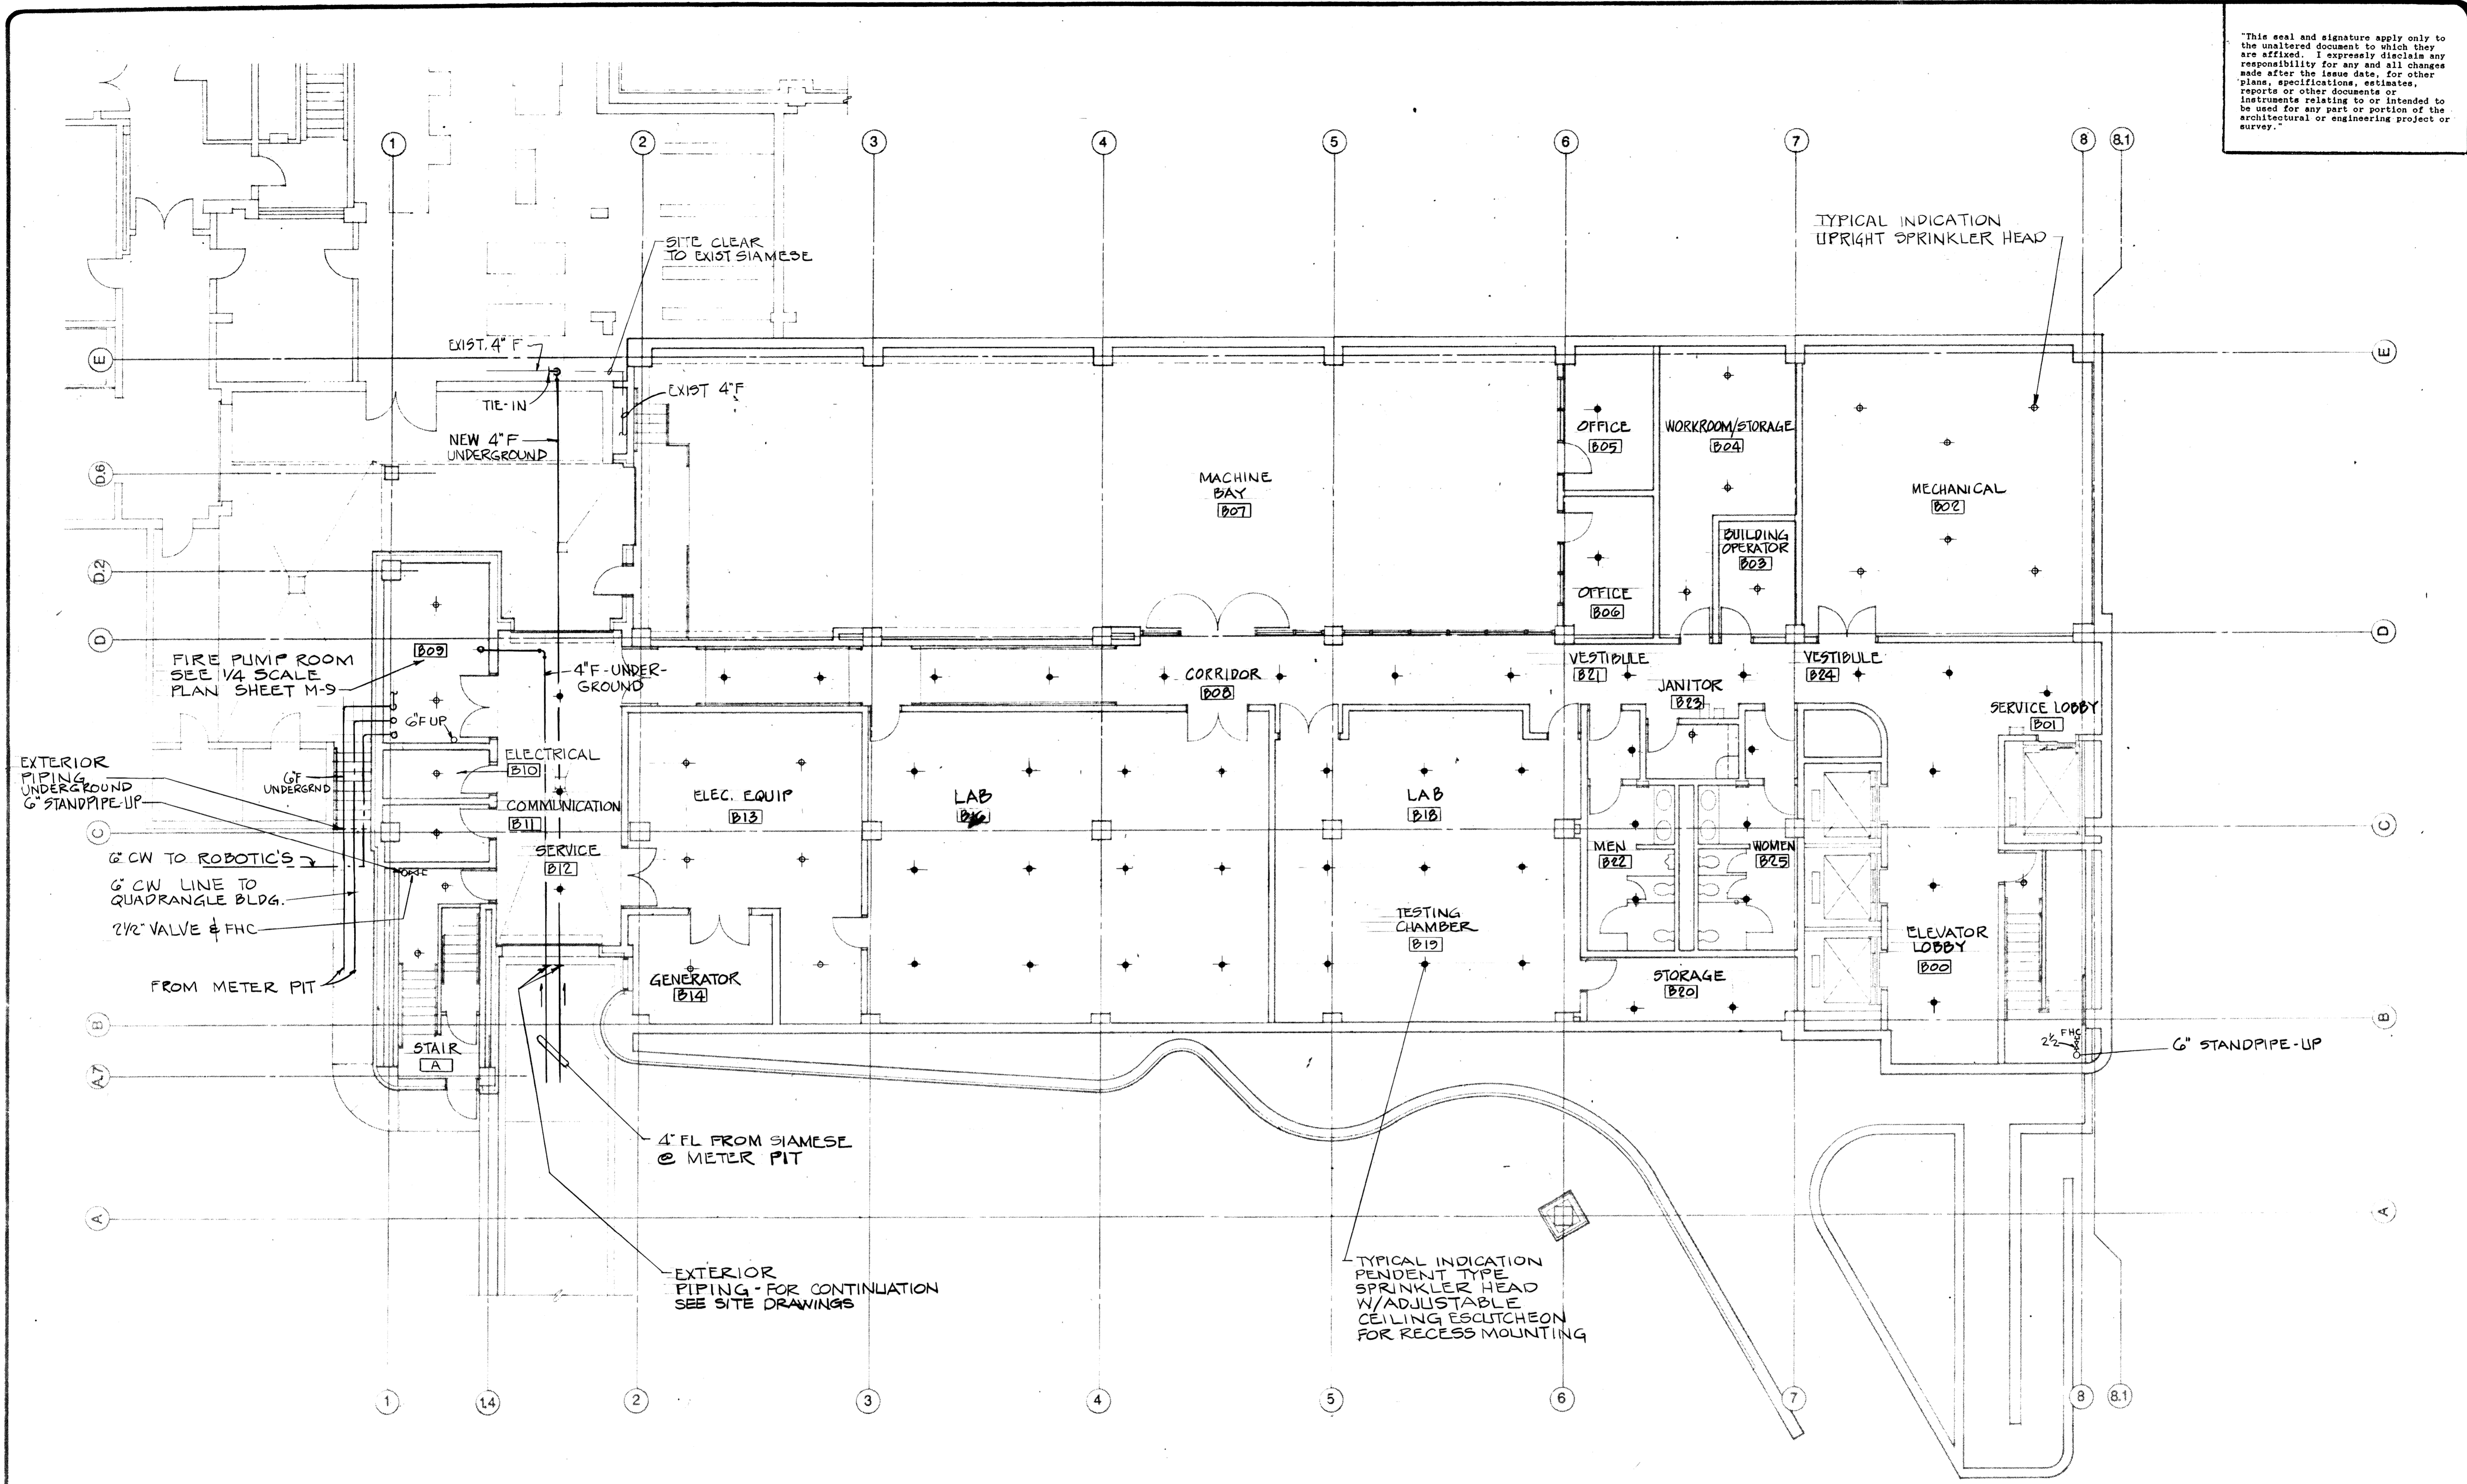

BASEMENT FLOOR PLAN
1/8" = 1'-0"
B.L.D.G. NORTH

DocuSign
04/955
C-1
9

"This seal and signature apply only to the unaltered document to which they are affixed. I expressly disclaim any responsibility for any and all changes made after the issue date, for other plans, specifications, estimates, reports or other documents or instruments relating to or intended to be used for any part or portion of the architectural or engineering project or survey."

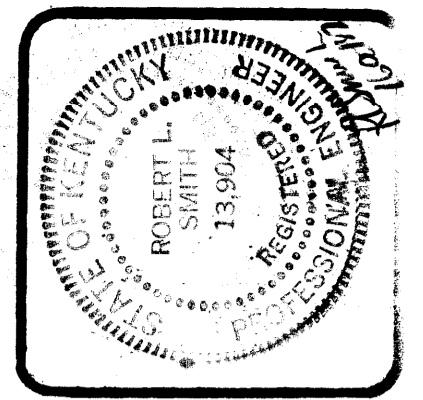

ROBOTICS FACILITY
 LEXINGTON CAMPUS
 UNIVERSITY OF KENTUCKY
 LEXINGTON, KENTUCKY


University of Kentucky
 Lexington, Kentucky
 10-19-87
 W. B. BARNHART

1 ST FLOOR FIRE PROTECTION
 Sherman Carter Barnhart
 PARTNERS IN ARCHITECTURE
 SUITE 1800 • 250 WEST MANN STREET • LEXINGTON KY 40507 • 606-254-1051

JOB NO. 8706
 DATE 10-16-87
 DRAWN S. THOMPSON
 CHECKED [Signature]
 FILE NO. 4318

REVISIONS
 3-90% REVIEW

SHEET
 M-25
 084956
 C-3


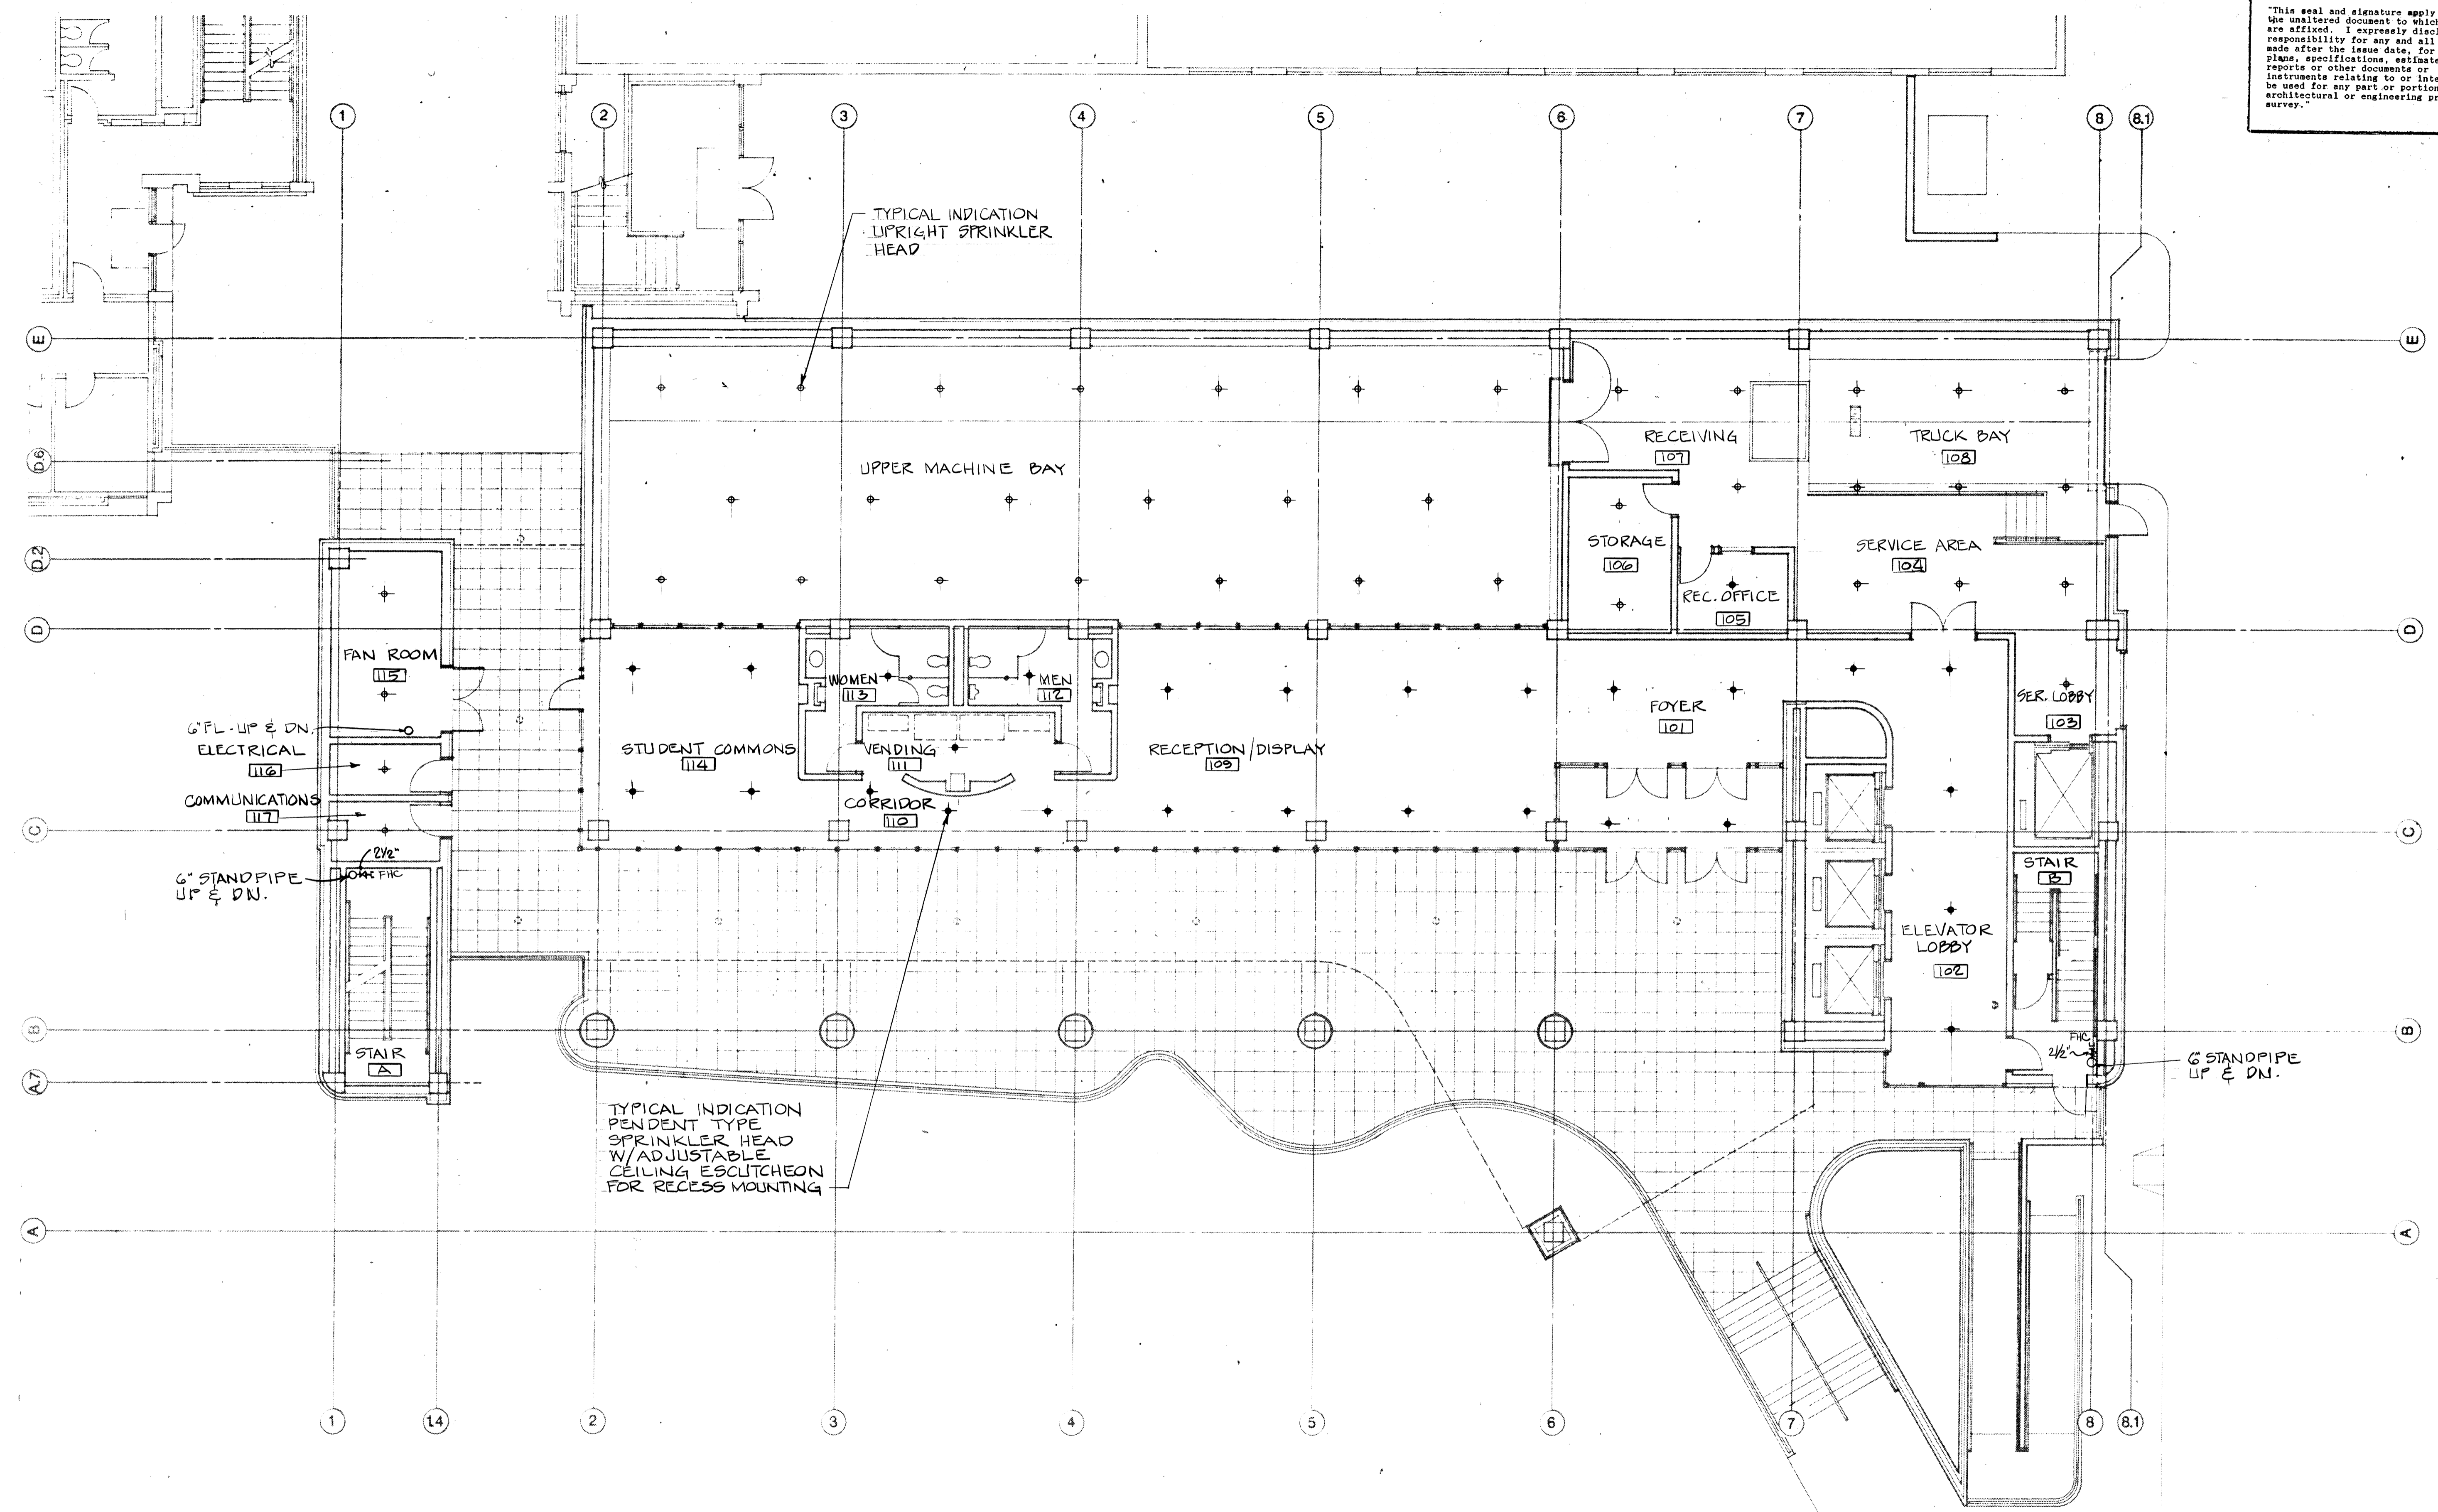


FIRST FLOOR PLAN
 1/8" = 1'-0"
 BLDG. NORTH

AS BUILT

BELCAN CORPORATION
 10200 ANDERSON WAY
 CINCINNATI, OHIO 45242
 NUMBER: 4361-CM-025-3

"This seal and signature apply only to the unaltered document to which they are affixed. I expressly disclaim any responsibility for any and all changes made after the issue date, for other plans, specifications, estimates, reports or other documents or instruments relating to or intended to be used for any part or portion of the architectural or engineering project or survey."

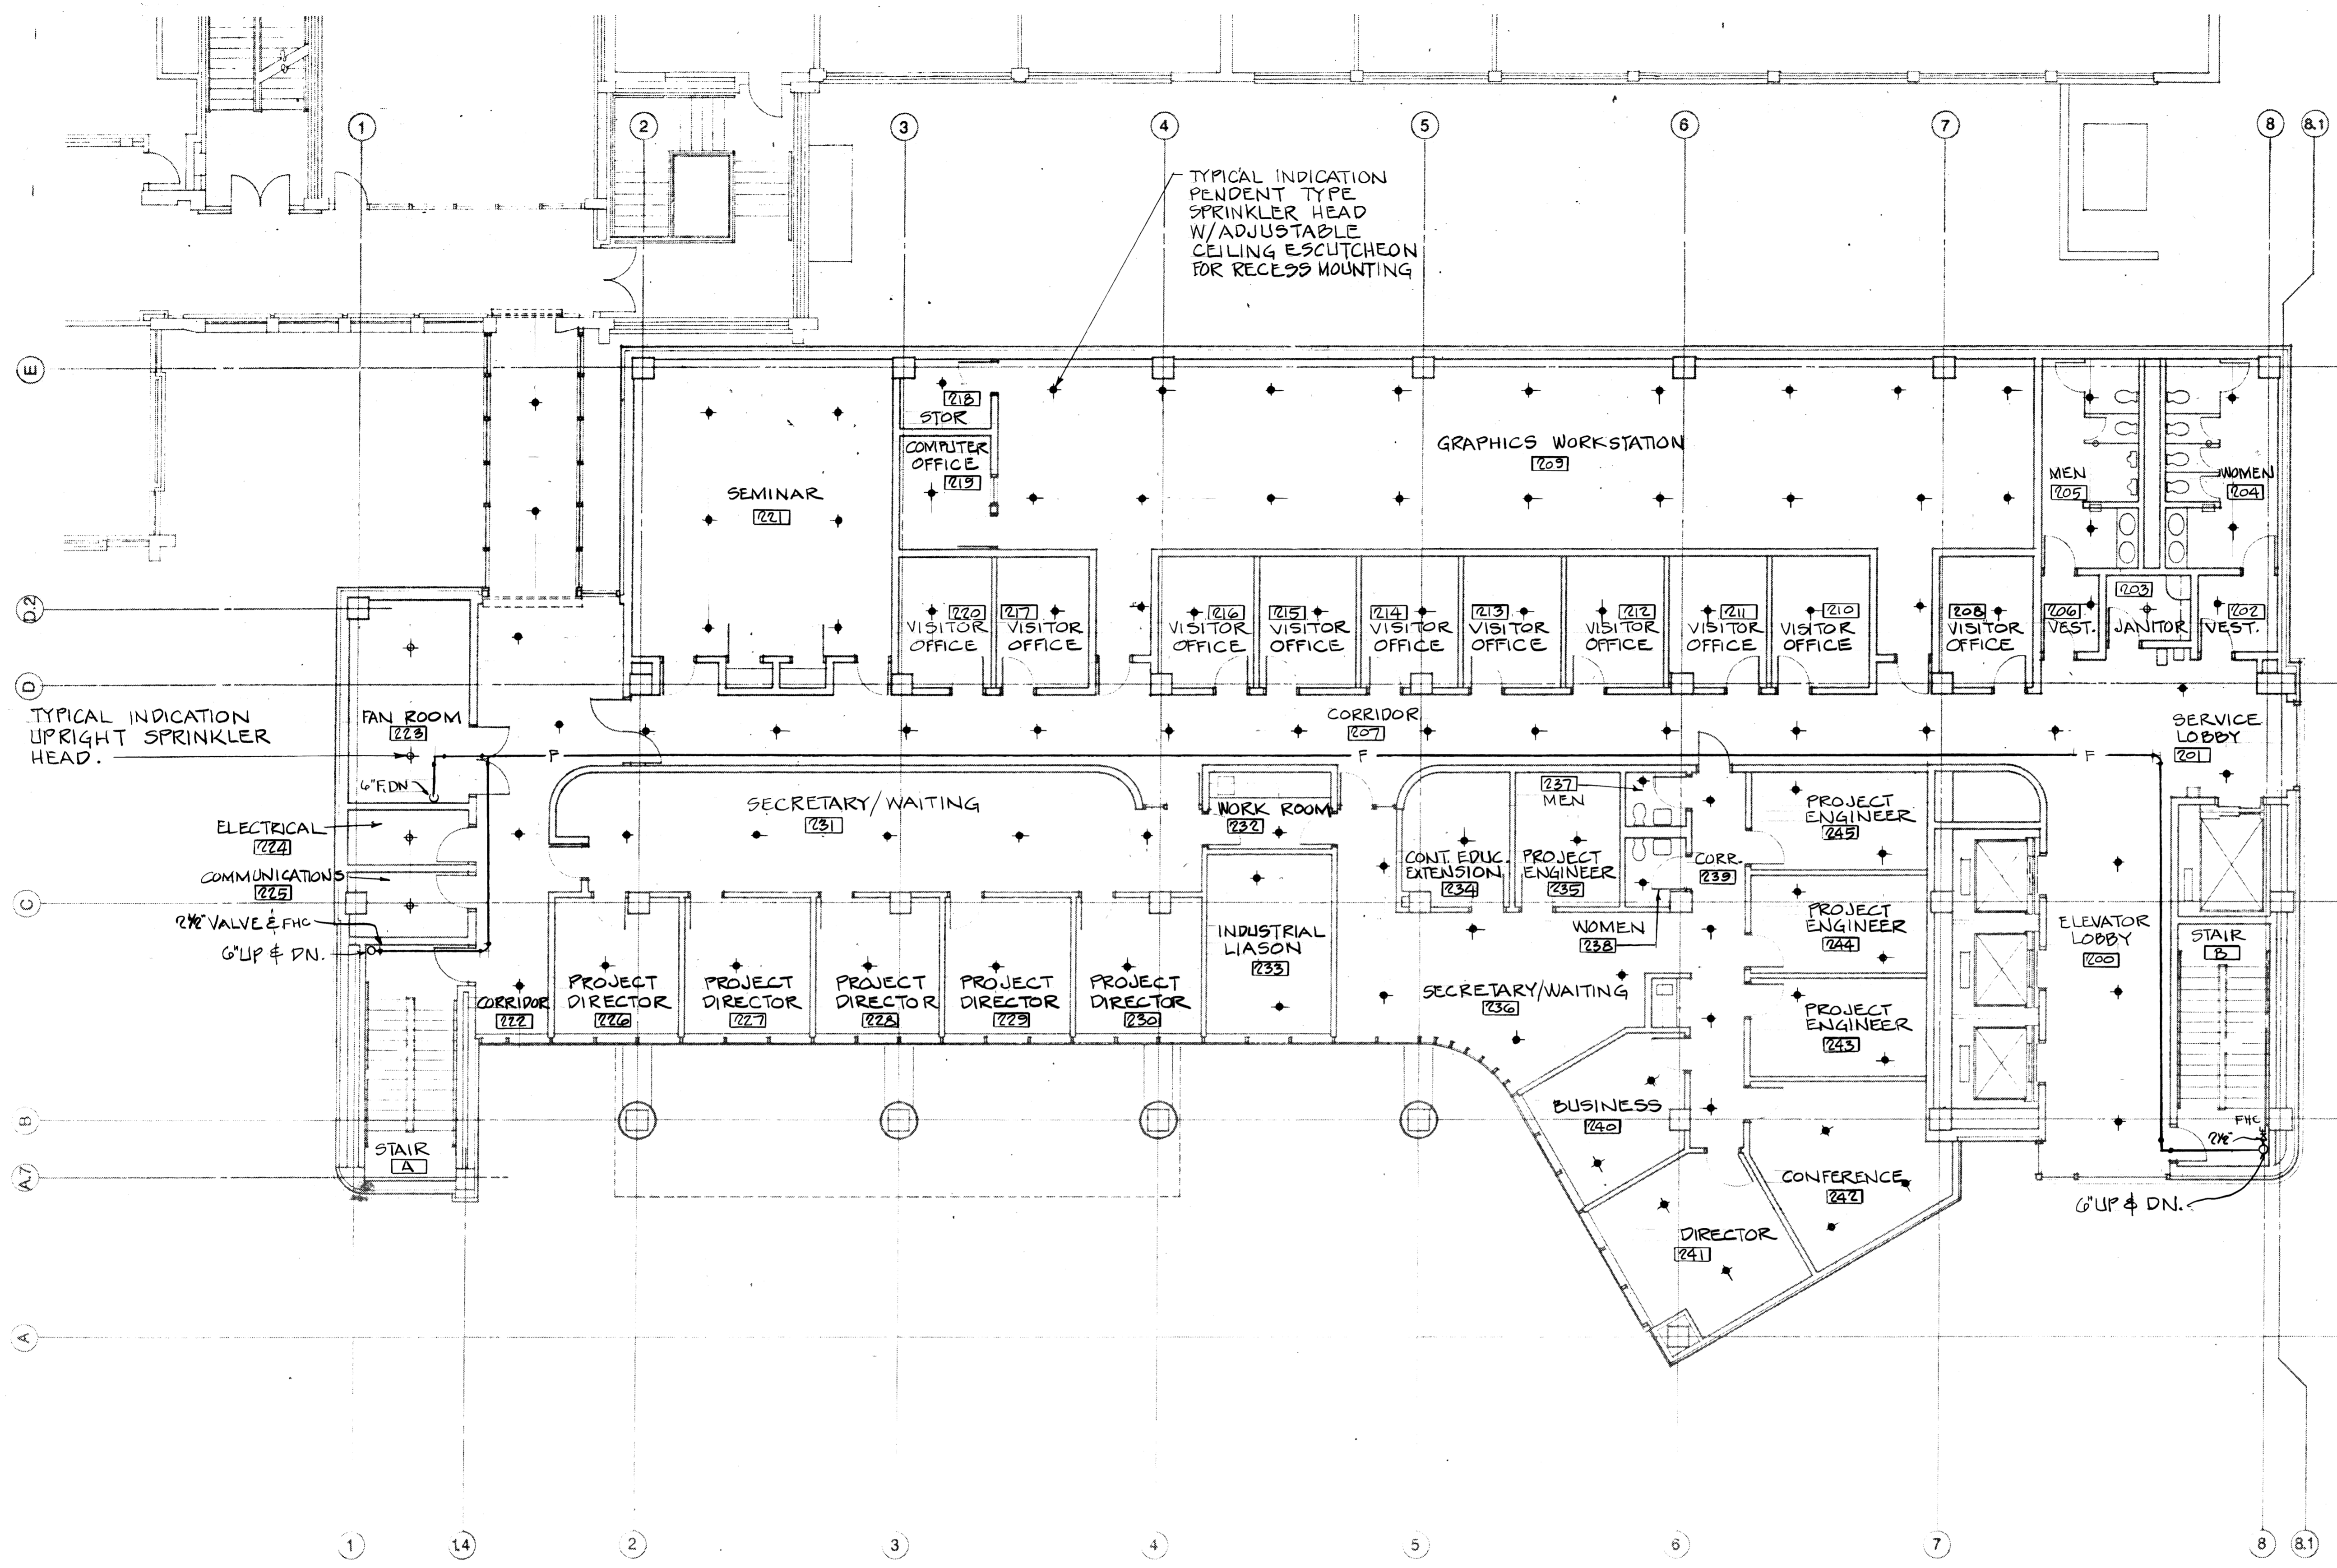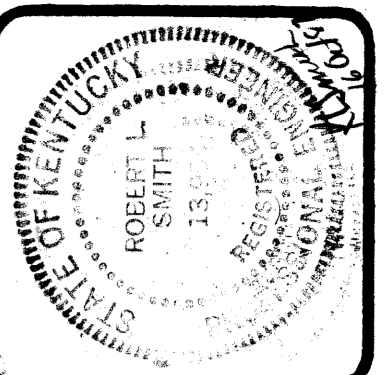

TYPICAL INDICATION
PENDENT TYPE
SPRINKLER HEAD
W/ADJUSTABLE
CEILING ESCUTCHEON
FOR RECESS MOUNTING

TYPICAL INDICATION
UPRIGHT SPRINKLER
HEAD.

SECOND FLOOR PLAN
1/8" = 1'-0"



ROBOTICS FACILITY
LEXINGTON CAMPUS
UNIVERSITY OF KENTUCKY
LEXINGTON, KENTUCKY

University of Kentucky
Lexington, Kentucky
Wendy J. Smith
10.16.87

2 ND FLOOR FIRE PROTECTION
Stelman Carter Barnhart
PARTNERS IN ARCHITECTURE
SUITE 1900 • 250 WEST MAIN STREET • LEXINGTON KY 40507 • 506-254-1351



JOB NO. 8706
DATE 10-16-87
DRAWN: THOMPSON
CHECKED: [Signature]
FILE NO. 4310

REVISIONS
3-90% REVIEW

SHEET
M-26

AS BUILT
BELCAN CORPORATION
10200 ANDERSON WAY
CINCINNATI, OHIO 45242
NUMBER: 4361-CM-026-3

"This seal and signature apply only to the unaltered document to which they are affixed. I expressly disclaim any responsibility for any and all changes made after the issue date, for other plans, specifications, estimates, reports or other documents or instruments relating to or intended to be used for any part or portion of the architectural or engineering project or survey."

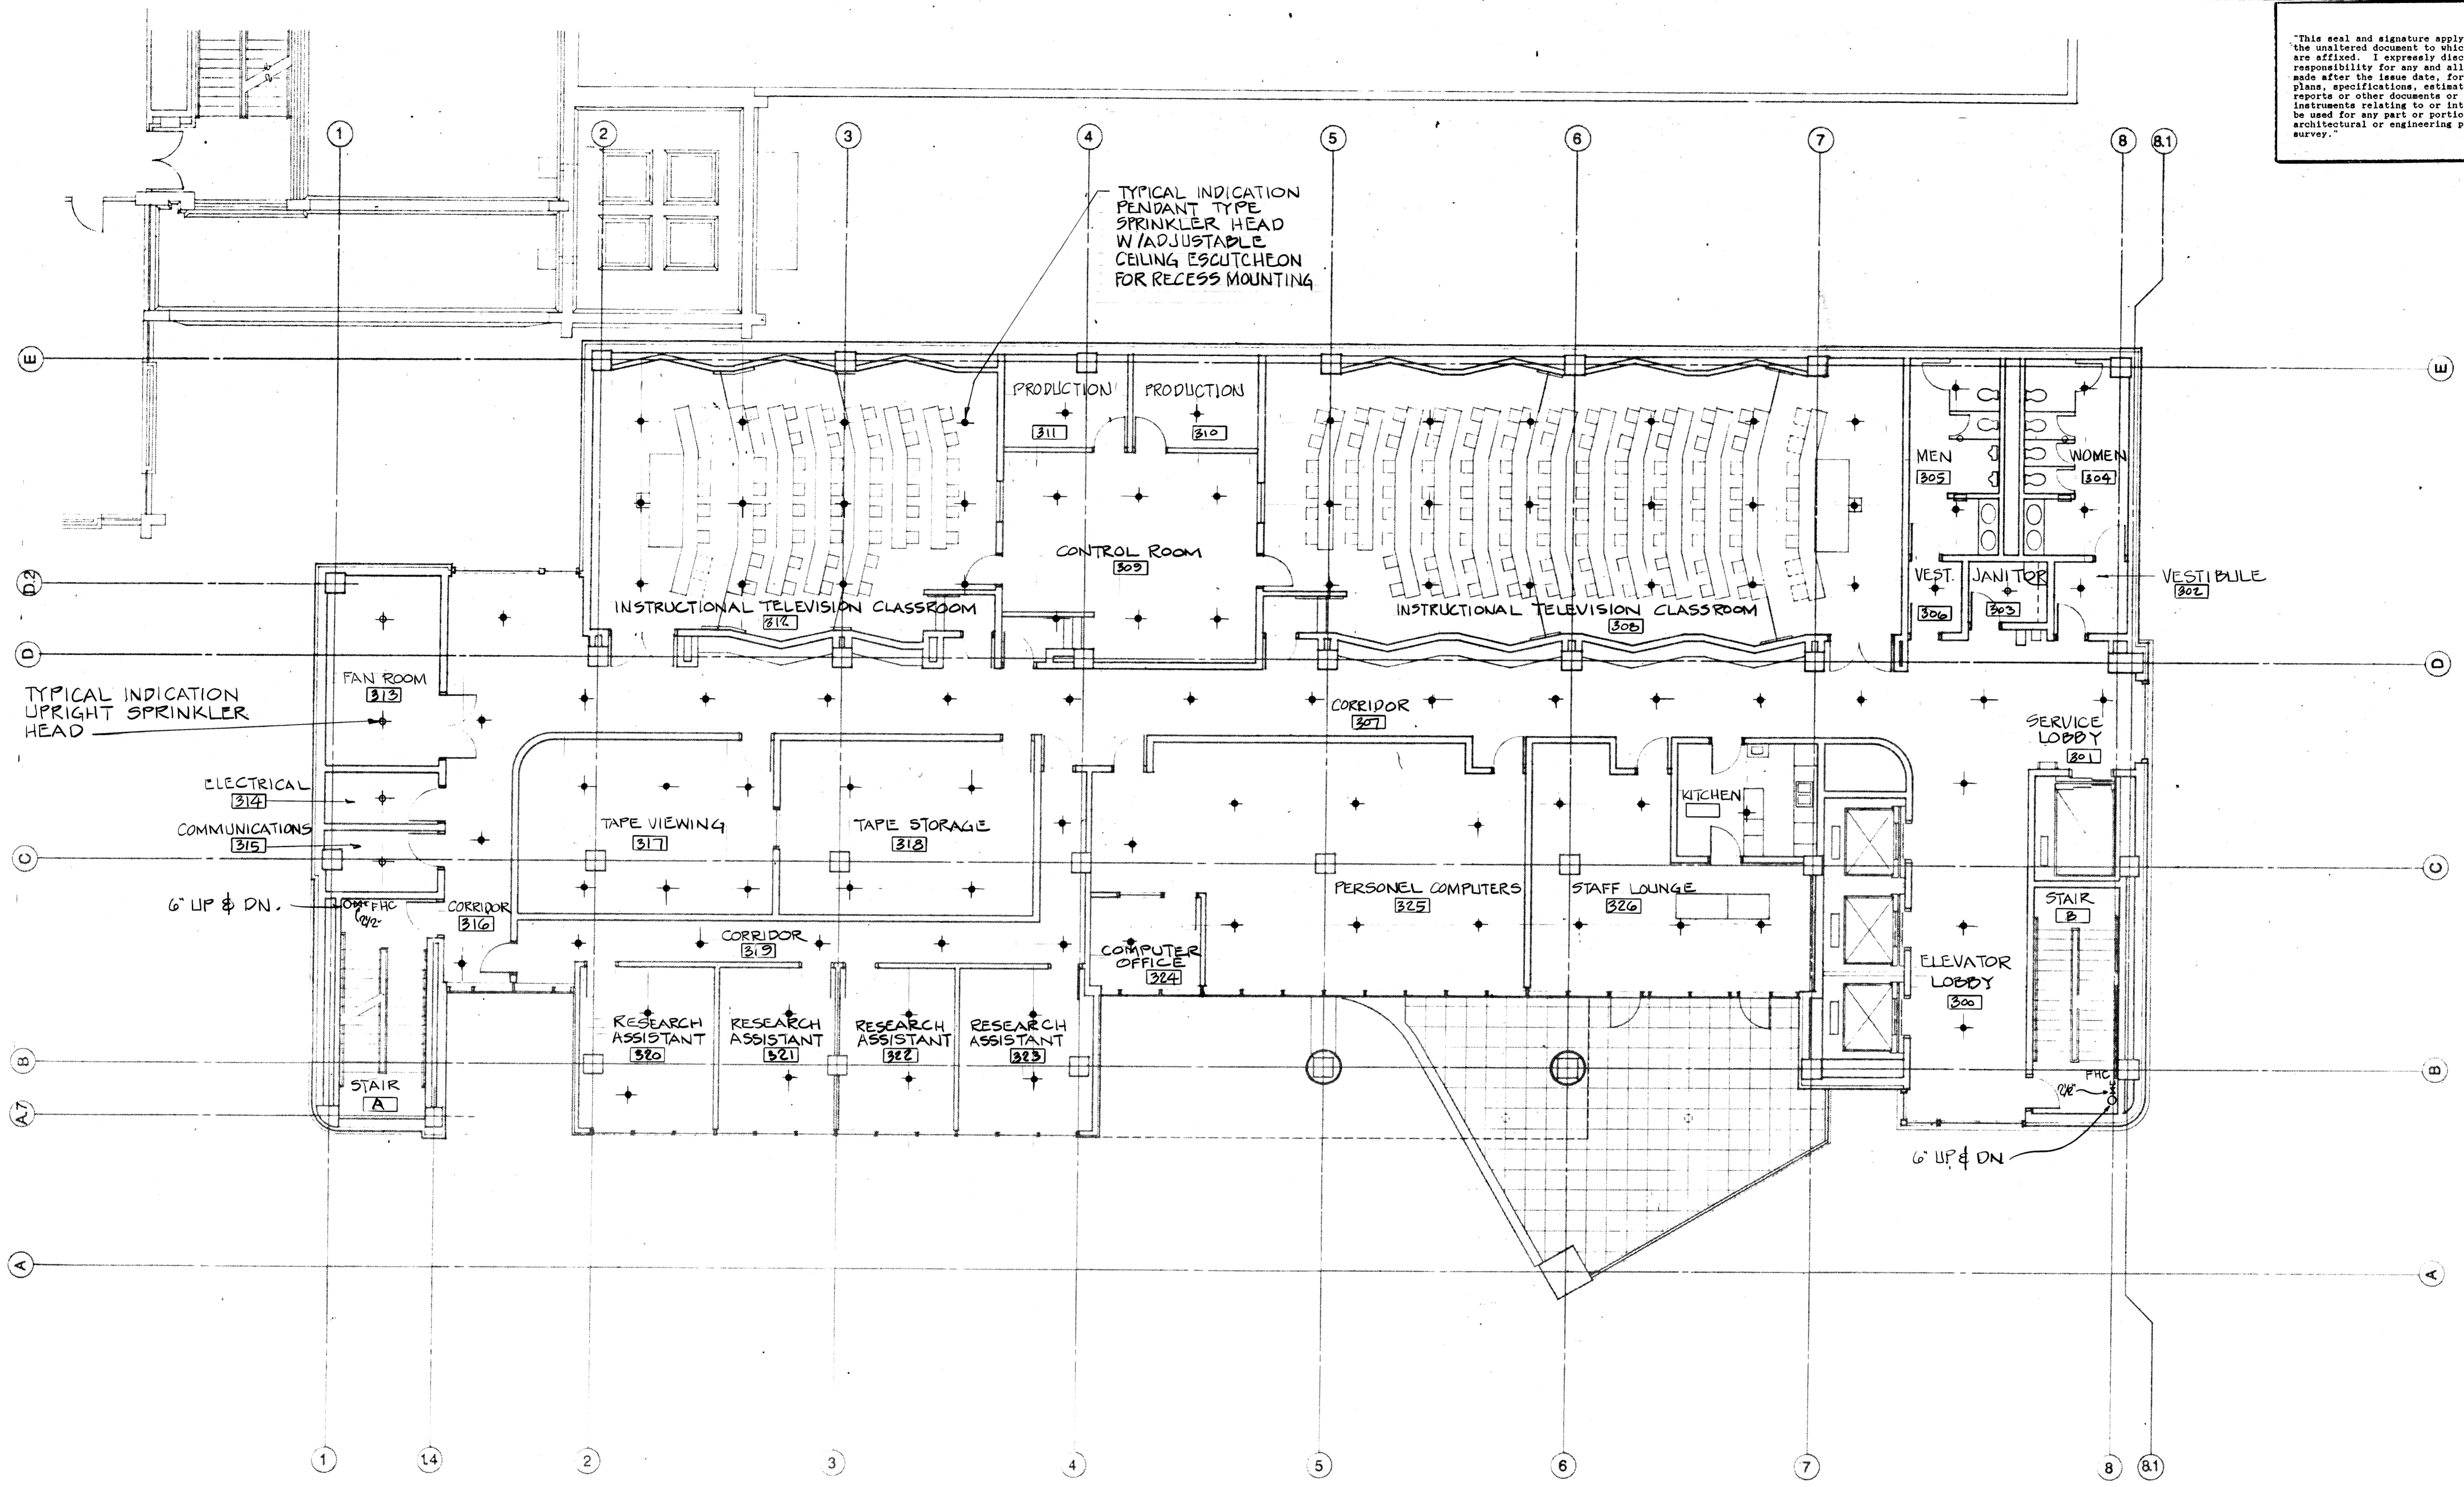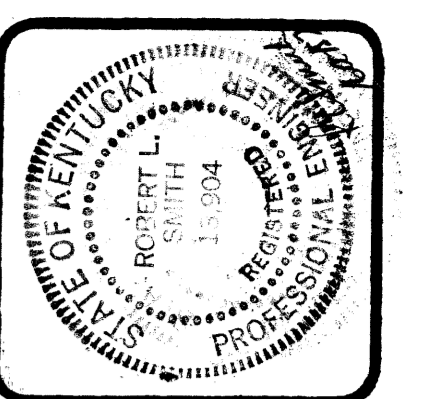

THIRD FLOOR PLAN
1/8" = 1'-0"
BLDG NORTH

ROBOTICS FACILITY
LEXINGTON CAMPUS
UNIVERSITY OF KENTUCKY
LEXINGTON, KENTUCKY

University of Kentucky
Lexington, Kentucky
10-19-87
W. B. BUNNY
ARCHITECT AND CONSTRUCTION ADMIN.

3 RD FLOOR FIRE PROTECTION
Sherman Carter Barnhart
PARTNERS IN ARCHITECTURE
SUITE 1900 • 750 WEST MAIN STREET • LEXINGTON KY 40507 • 606-554-1351

JOB NO. 8706
DATE 10-16-87
DRAWN S. THOMPSON
CHECKED [Signature]
FILE NO. 431.6


REVISIONS
3 - 90% REVIEW

AS BUILT

BELCAN CORPORATION
10200 ANDERSON WAY
CINCINNATI, OHIO 45242
NUMBER: 4361-CM-027-3

SHEET
M-27

This seal and signature apply only to the unaltered document to which they are affixed. I expressly disclaim any responsibility for any and all changes made after the issue date, for other plans, specifications, estimates, reports or other documents or instruments relating to or intended to be used for any part or portion of the architectural or engineering project, or survey.

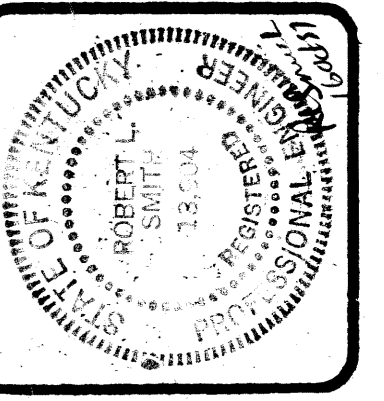

ROBOTICS FACILITY
 LEXINGTON CAMPUS
 UNIVERSITY OF KENTUCKY
 LEXINGTON, KENTUCKY


University of Kentucky
 Lexington, Kentucky
 10-19-87
 WALTER BUNNY
 ARCHITECT

4 TH FLOOR FIRE PROTECTION
 Sherman Carter Barnhart
 PARTNERS IN ARCHITECTURE
 SUITE 900 • 250 WEST MAIN STREET • LEXINGTON, KY 40507 • 606-254-1351

JOB NO.	3706
DATE	10-16-87
DRAWN BY	THOMPSON
CHECKED BY	W.B.
FILE NO.	431.6

REVISIONS
5-70% REVIEW

SHEET
M-28

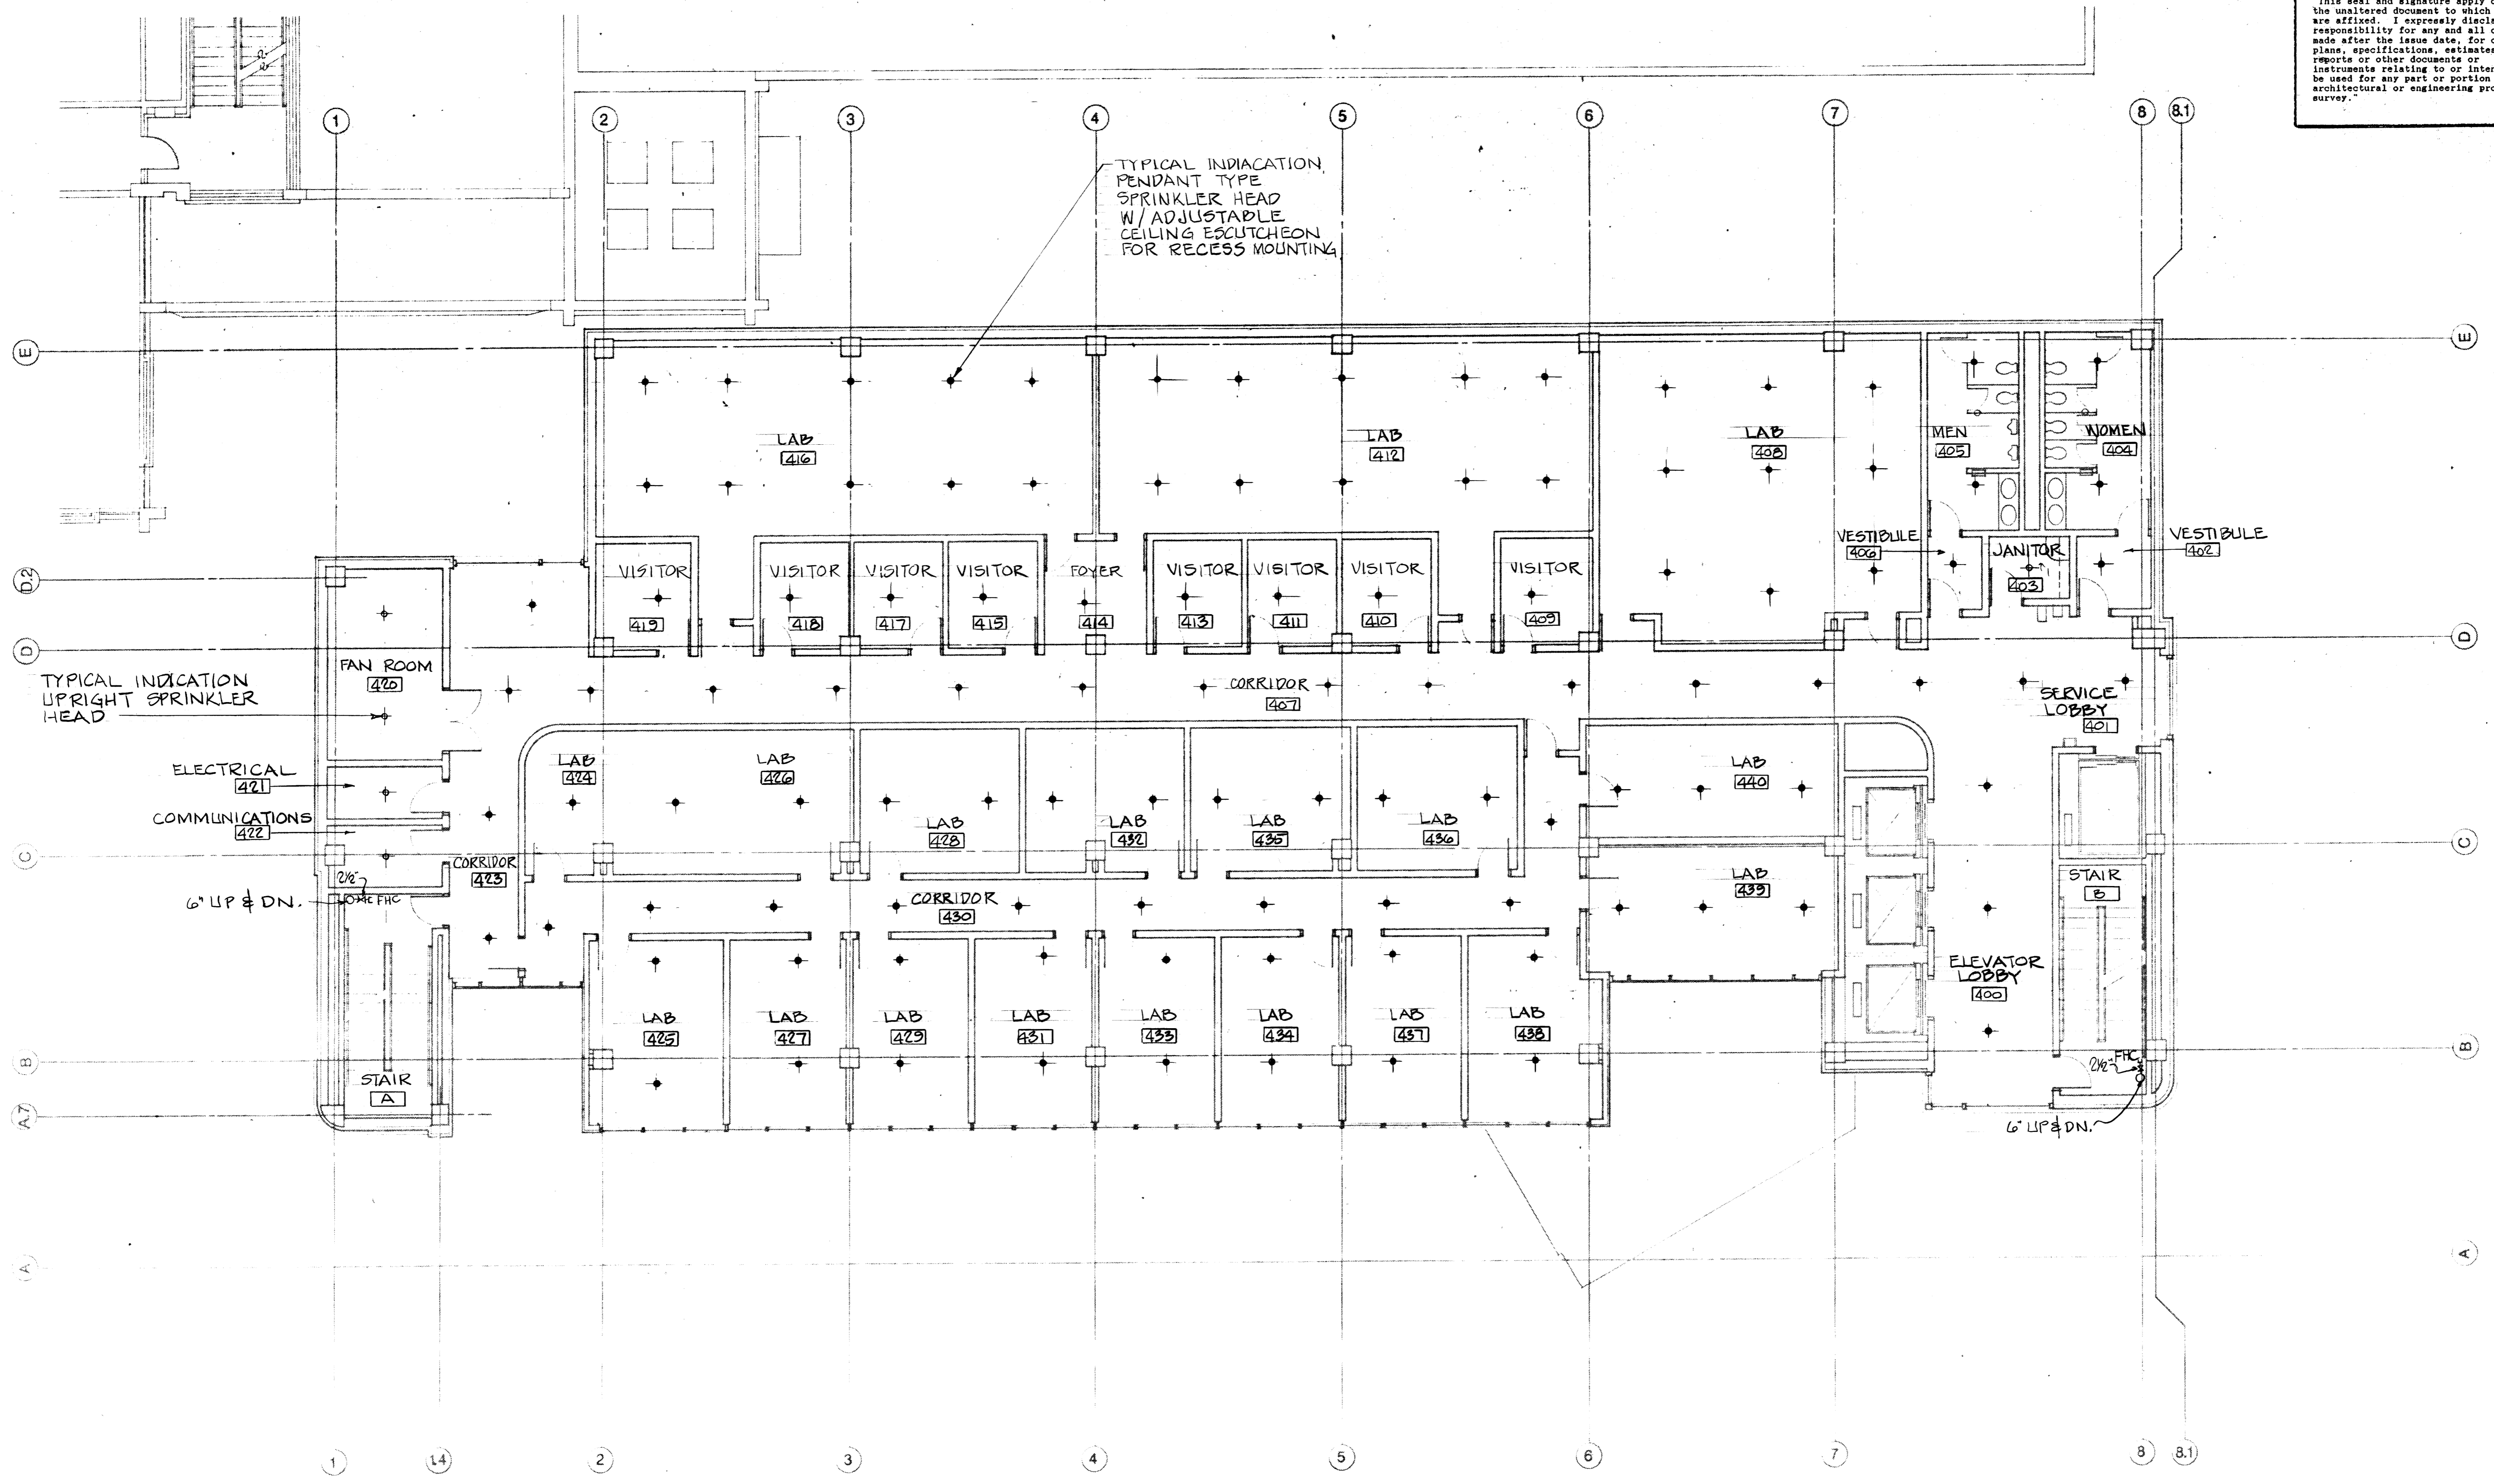


FOURTH FLOOR PLAN
 1/8" = 1'-0"
 BLDG NORTH

AS BUILT

BELCAN CORPORATION
 10200 ANDERSON WAY
 CINCINNATI, OHIO 45242
 NUMBER: 4361-CM-028-3

"This seal and signature apply only to the unaltered document to which they are affixed. I expressly disclaim any responsibility for any and all changes made after the issue date, for other plans, specifications, estimates, reports or other documents or instruments relating to or intended to be used for any part or portion of the architectural or engineering project or survey."

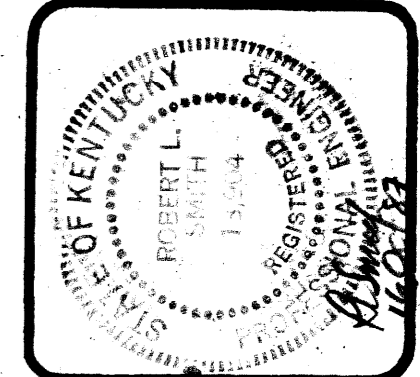

ROBOTICS FACILITY
LEXINGTON CAMPUS
UNIVERSITY OF KENTUCKY
LEXINGTON, KENTUCKY

University of Kentucky
Lexington, Kentucky
10-19-87
Wendy Summy
ARCHITECT

5 TH FLOOR FIRE PROTECTION
Sherman Carter Barnhart
PARTNERS IN ARCHITECTURE
SUITE 1900 - 250 WEST MAIN STREET - LEXINGTON, KY 40507 • 506-254-1351


JOB NO. 8706
DATE 10-16-87
DRAWN G. THOMPSON
CHECKED [Signature]
FILE NO. 431.0

REVISIONS
3-90% REVIEW

SHEET

M-29


BELCAN CORPORATION
10200 ANDERSON WAY
CINCINNATI, OHIO 45242
NUMBER: 4361-CM-029-3

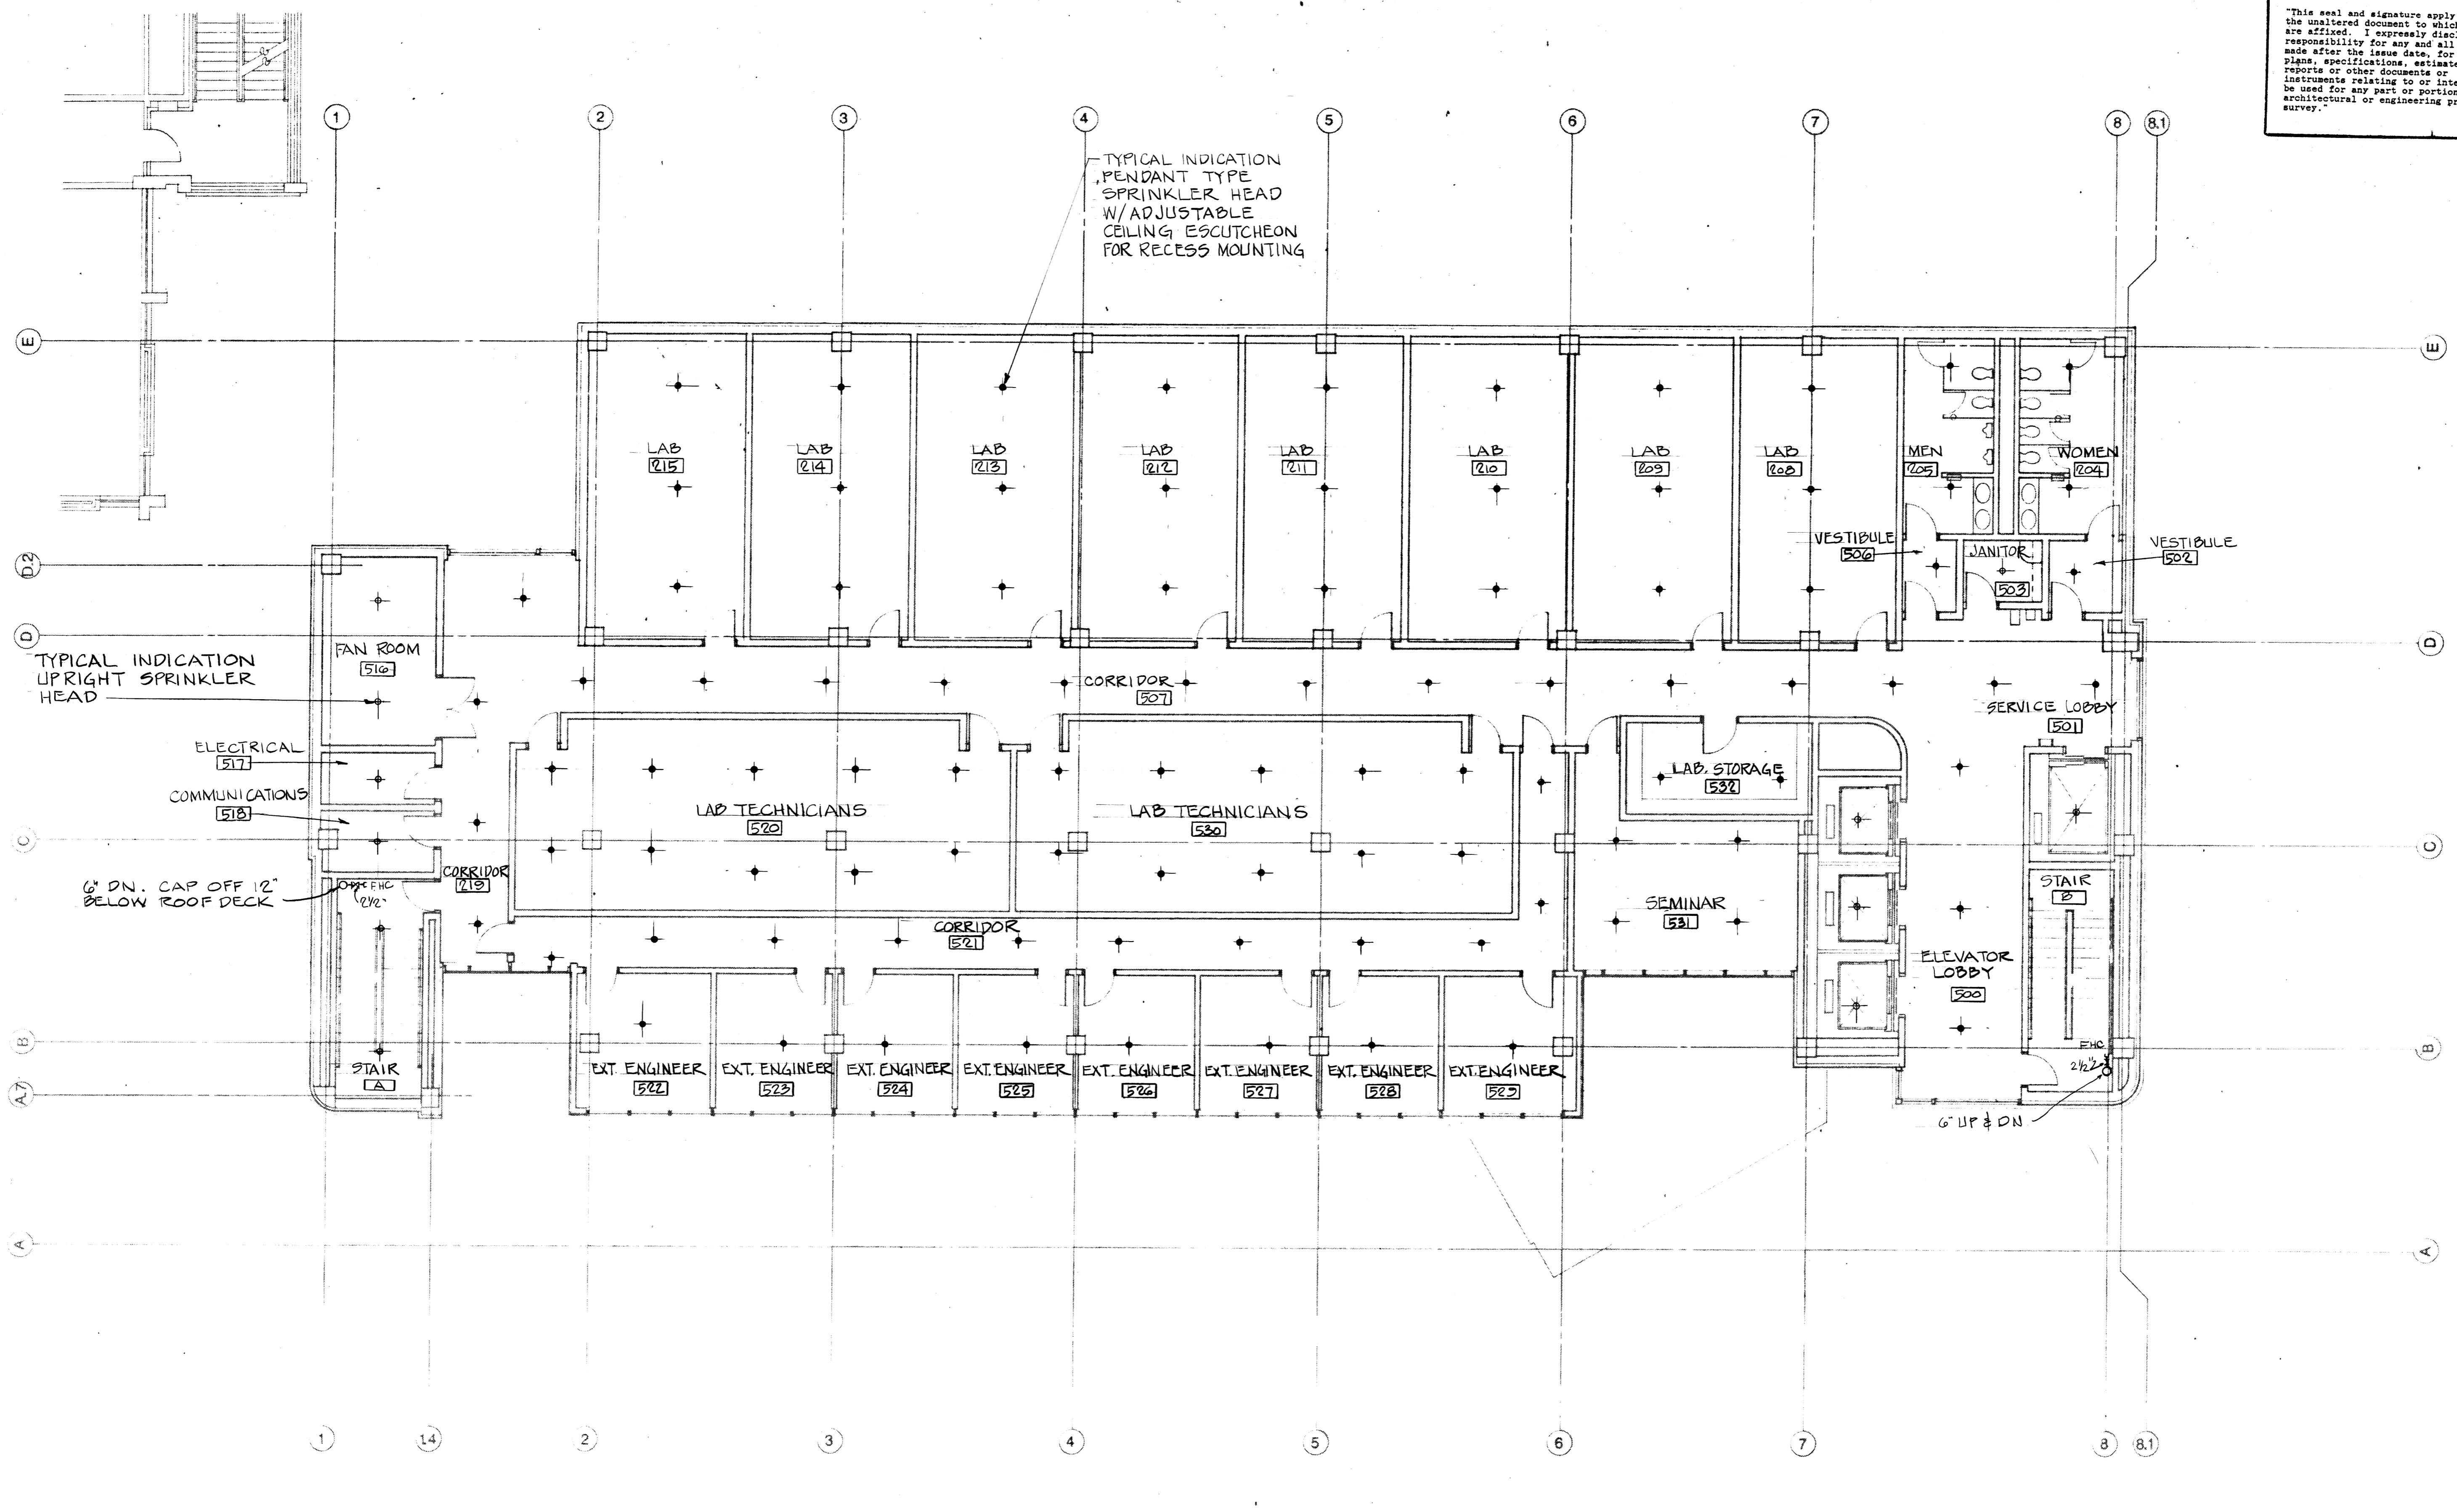

FIFTH FLOOR PLAN
1/8" = 1'-0"


AS BUILT

"This seal and signature apply only to the unaltered document to which they are affixed. I expressly disclaim any responsibility for any and all changes made after the issue date, for other plans, specifications, estimates, reports or other documents or instruments relating to or intended to be used for any part or portion of the architectural or engineering project or survey."

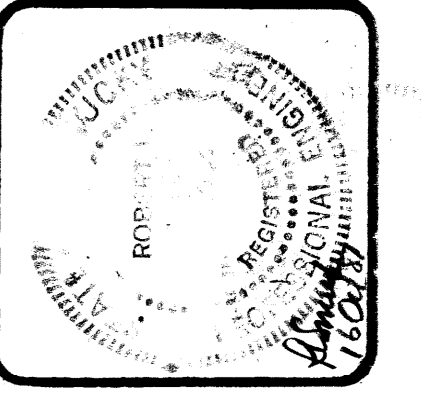


ROBOTICS FACILITY
 LEXINGTON CAMPUS
 UNIVERSITY OF KENTUCKY
 LEXINGTON, KENTUCKY

University of Kentucky
 Lexington, Kentucky
 10-19-82
Robert W. Thompson
 REGISTERED PROFESSIONAL ENGINEER
 DESIGN AND CONSTRUCTION DIVISION

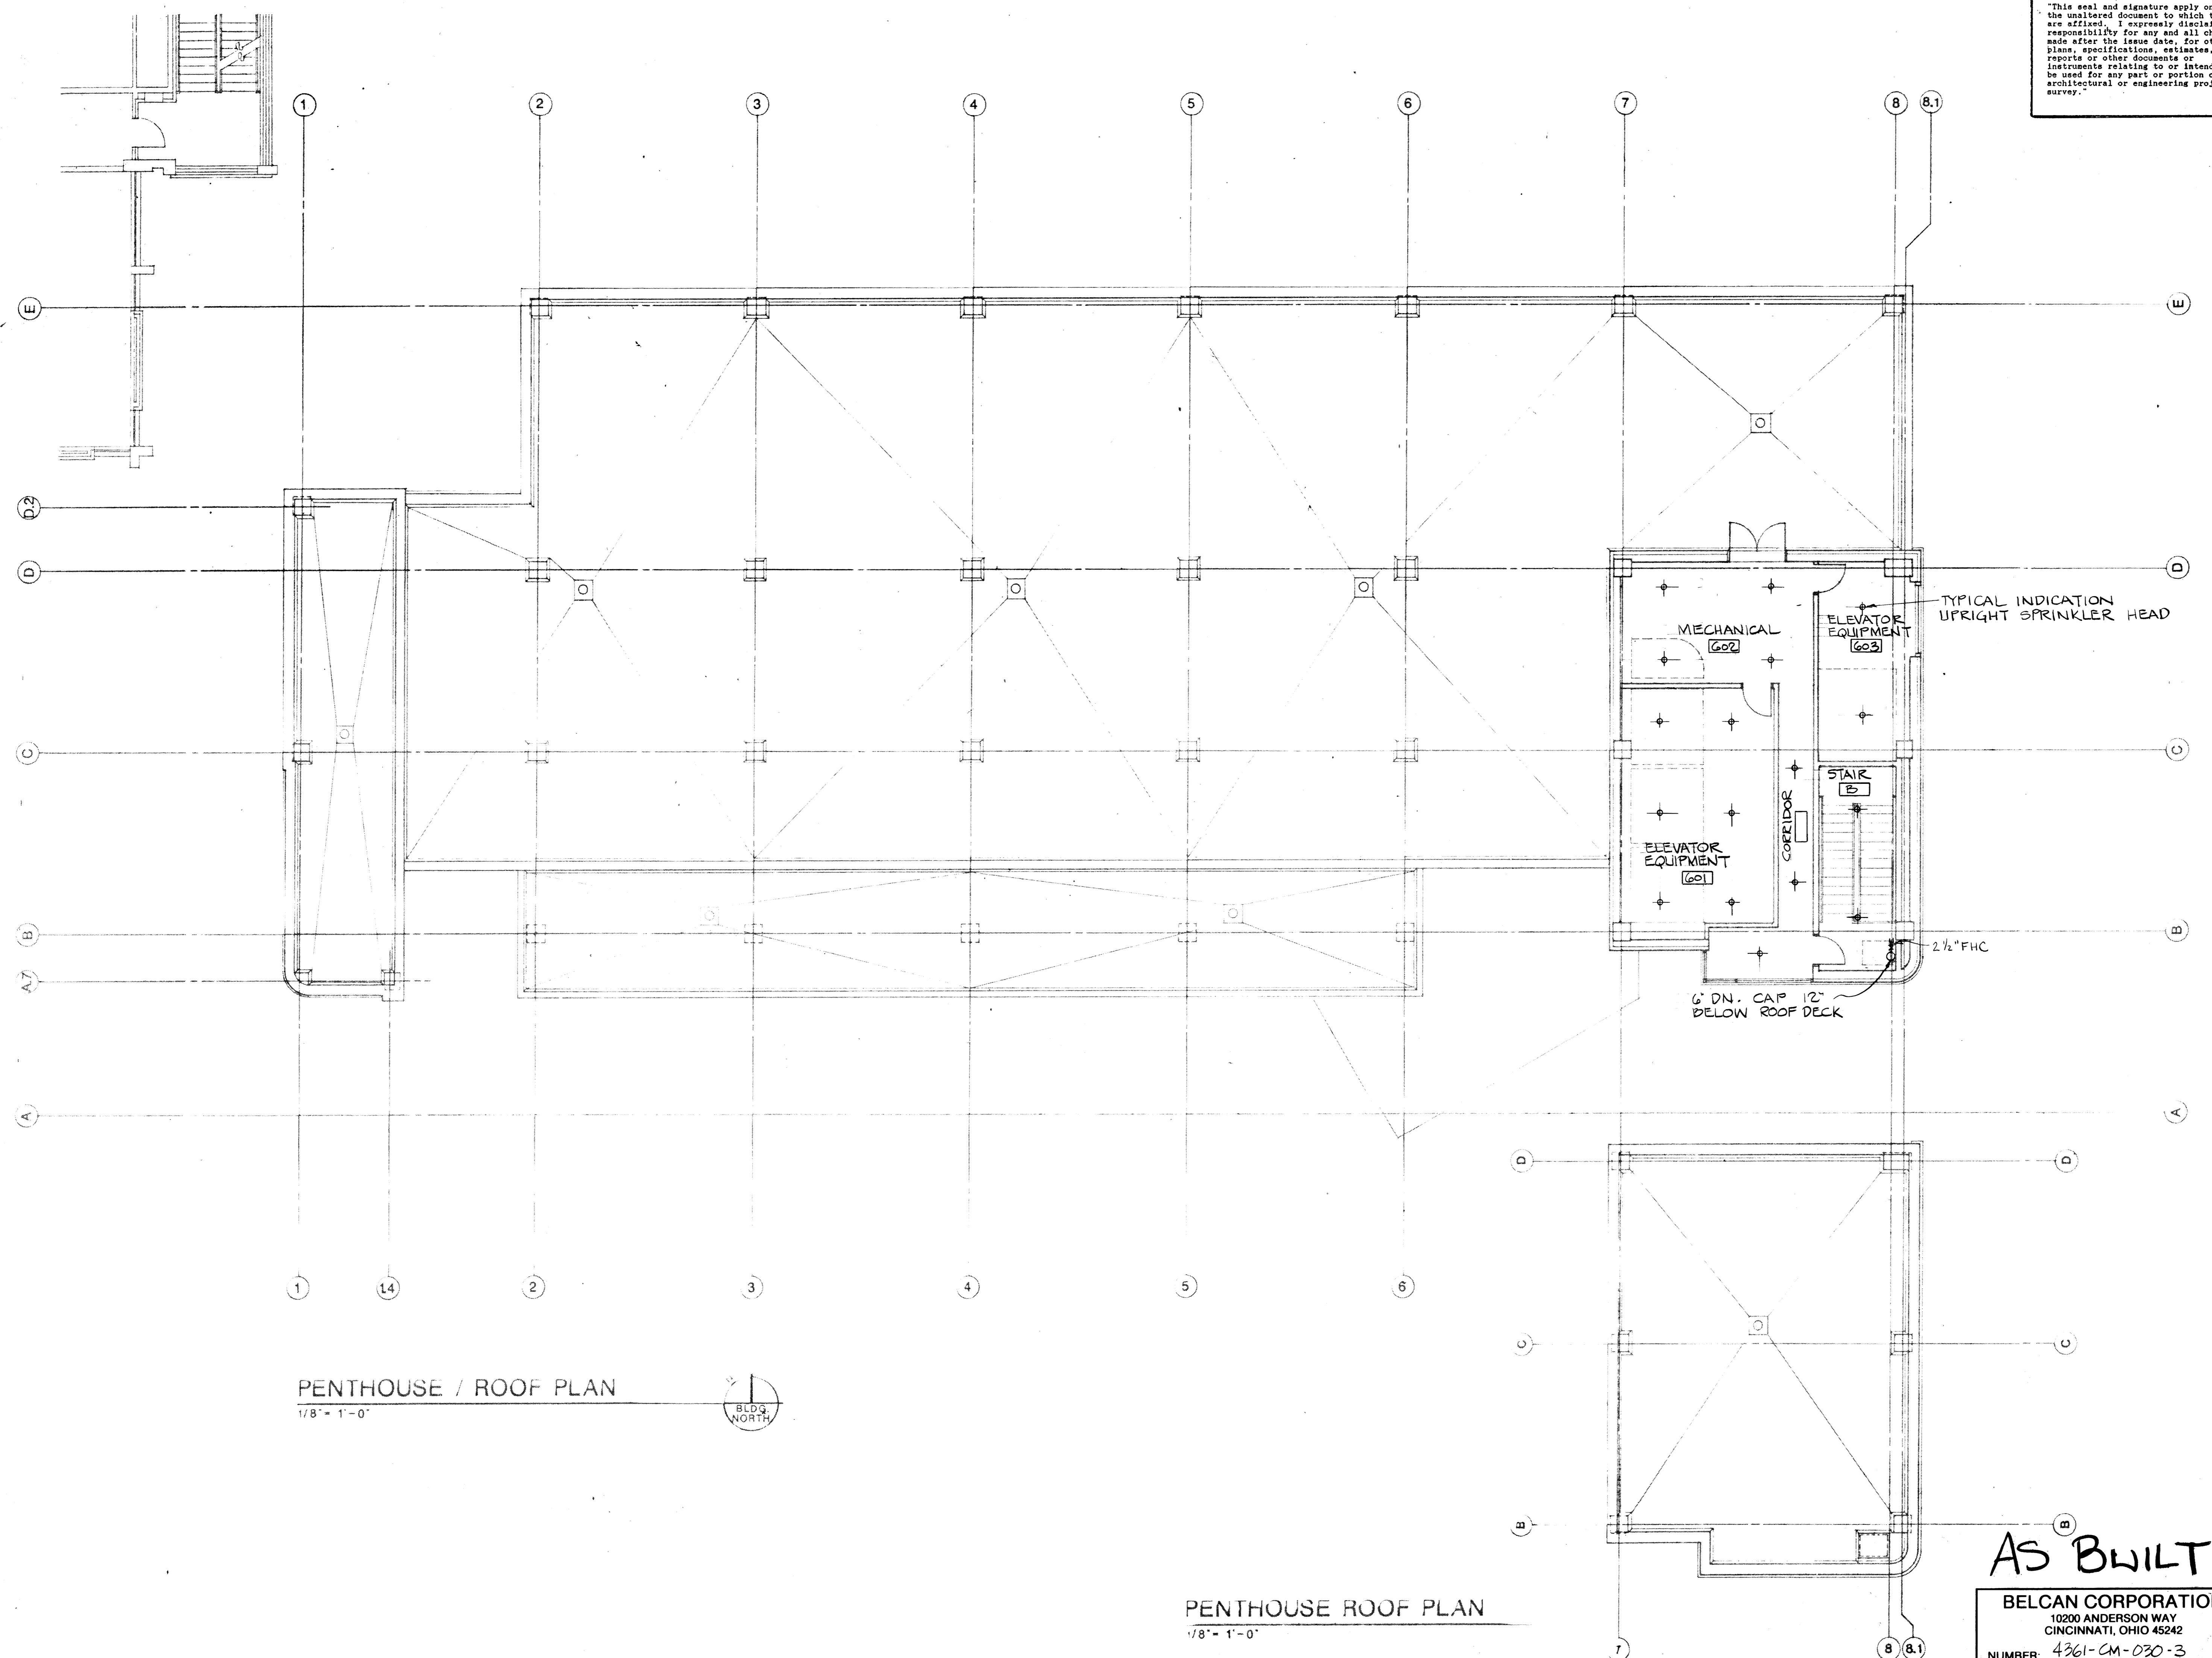

PENTHOUSE / ROOF PLAN
 1/8" = 1'-0"

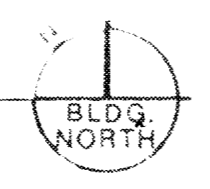

PENTHOUSE ROOF PLAN
 1/8" = 1'-0"

AS BUILT
 BELCAN CORPORATION
 10200 ANDERSON WAY
 CINCINNATI, OHIO 45242
 NUMBER: 4361-CM-030-3

PENTHOUSE/ROOF
 FIRE PROTECTION
Sherman Carter Barnhart
 PARTNERS IN ARCHITECTURE
 SUITE 1910 • 250 WEST MAIN STREET • LEXINGTON, KY 40507 • 806-254-1351

JOB NO. 8700
 DATE 10-16-87
 DRAWN S. THOMPSON
 CHECKED [Signature]
 FILE NO. 4361

REVISIONS
 3-90% REVIEW

SHEET
M-30

VARIABLE AIR VOLUME BOX SCHEDULE					
BOX DESIG.	TRANE MODEL NO./SIZE	MAX. CFM	MIN. CFM	MAX. UNIT PRES. DROP (PRES. DROP)	MBH HT'G REQ'D
101	VCWC/2000	1200	400	.22	24
103	VCWC/1200	800	280	.20	11
104	VCWC/400	250	90	.16	8
105	VCCC/200	80	0	.07	-
106A	VCWC/1200	600	600	.11	40
106B	VCCC/400	300	0	.24	-
107	VCWC/800	450	320	.20	25
108	VCWC/200	110	110	.13	4
109	VCWC/200	110	110	.13	4
112	VCWC/2000	1400	350	.28	30
113	VCWC/2000	1400	350	.28	21
114	VCWC/400	250	250	.16	7
115	VCWC/800	450	150	.24	-
117	VCWC/400	250	250	.16	9
121	VCWC/2000	110	40	.03	3
122	VCCC/200	110	0	.03	-
140	VCWC/3000	3040	1500	.40	73
201	VCWC/2000	1860	920	.49	47
202	VCCC/200	160	0	.07	-
203	VCWC/2000	1260	440	.23	23
204	VCWC/400	210	80	.12	10
205	VCWC/1200	980	680	.31	87
206	VCWC/800	550	380	.27	22
207	VCCC/200	80	0	.07	-
208	VCCC/200	50	0	.03	-
209	VCCC/200	50	0	.03	-
210	VCWC/3000	2800	350	.34	50
211	VCWC/3000	2800	350	.34	42
212	VCWC/200	250	250	.16	7
213	VCCC/400	140	0	.06	-
301	VCWC/800	440	150	.18	10
302	VCWC/400	180	70	.09	5
303	VCWC/400	160	70	.07	5
304	VCWC/400	160	70	.07	5
305	VCWC/400	160	70	.07	5
306	VCWC/400	170	70	.08	5
307	VCCC/200	100	0	.11	-
308	VCCC/200	130	0	.18	-
309	VCCC/200	120	0	.15	-
310	VCCC/200	130	0	.18	-
311	VCWC/400	260	100	.18	-
312	VCCC/200	100	0	.11	-
313	VCWC/400	250	90	.16	8
314	VCWC/400	270	110	.19	5
315	VCCC/800	480	0	.27	-

VARIABLE AIR VOLUME BOX SCHEDULE					
BOX DESIG.	TRANE MODEL NO./SIZE	MAX. CFM	MIN. CFM	MAX. UNIT PRES. DROP (PRES. DROP)	MBH HT'G REQ'D
316	VCWC/800	510	200	.24	28
317	VCCC/200	110	0	.13	-
330	VCWC/200	60	15	.01	2
331	VCCC/200	80	0	.07	-
332	VCCC/200	80	0	.07	-
333	VCCC/200	80	0	.07	-
334	VCCC/200	80	0	.07	-
335	VCCC/200	80	0	.07	-
336	VCCC/200	80	0	.07	-
337	VCCC/200	80	0	.07	-
338	VCCC/200	130	0	.18	-
339	VCCC/200	120	0	.15	-
340	VCCC/200	140	0	.21	-
341	VCCC/800	410	0	.20	-
342	VCWC/1200	640	170	.13	10
343	VCWC/3000	2400	450	.25	20
344A	VCWC/1200	600	300	.11	11
344B	VCCC/400	300	0	.30	-
345	VCWC/1200	700	440	.16	25
346	VCWC/400	250	50	.16	2
347	VCWC/400	320	100	.27	5
350	VCWC/4000	3800	350	.62	57
351	VCWC/4000	3800	350	.62	57
352	VCWC/400	250	250	.16	7
353	VCWC/2000	1320	450	.25	26
401	VCWC/200	150	50	.06	4
402	VCWC/2000	1600	240	.36	14
403	VCWC/400	290	90	.22	6
404	VCWC/400	260	80	.18	6
405	VCWC/400	250	80	.16	6
406	VCWC/400	280	90	.21	6
407	VCCC/1200	660	0	.17	-
408	VCWC/800	550	250	.30	5
409	VCWC/400	230	80	.14	4
410	VCWC/2000	1260	570	.23	32
411	VCCC/200	140	0	.21	-
421	VCWC/2000	1720	280	.42	10
422	VCWC/4000	3280	450	.46	15
423	VCWC/1200	700	0	.19	-
424	VCWC/400	100	40	.03	2
425	VCWC/400	100	40	.03	2
426A	VCWC/1200	600	330	.11	14
426B	VCWC/400	300	0	.30	-
427	VCWC/1200	700	420	.24	15
428	VCWC/400	110	30	.16	2


VARIABLE AIR VOLUME BOX SCHEDULE					
BOX DESIG.	TRANE MODEL NO./SIZE	MAX. CFM	MIN. CFM	MAX. UNIT PRES. DROP (PRES. DROP)	MBH HT'G REQ'D
429	VCWC/400	180	50	.20	4
432	VCWC/4000	4000	350	.69	57
433	VCWC/4000	4000	350	.69	57
434	VCWC/400	250	250	.16	7
501	VCCC/400	180	0	.11	-
502	VCCC/400	180	0	.11	-
503	VCCC/400	180	0	.11	-
504	VCCC/400	180	0	.11	-
505	VCCC/400	180	0	.11	-
506	VCCC/400	180	0	.11	-
507	VCCC/400	220	0	.16	-
508	VCWC/800	440	140	.18	10
509	VCWC/400	330	100	.29	5
510	VCWC/400	300	80	.24	5
511	VCWC/400	200	80	.25	5
512	VCWC/400	300	80	.24	5
513	VCWC/400	320	50	.27	5
514	VCWC/400	320	50	.27	5
515	VCWC/400	320	50	.27	5
516	VCWC/400	360	70	.34	5
517	VCWC/800	450	150	.18	4
521	VCCC/200	100	0	.07	-
522	VCCC/200	80	0	.07	-
523	VCCC/200	80	0	.07	-
524	VCCC/200	80	0	.07	-
525	VCCC/200	80	0	.07	-
526	VCCC/200	80	0	.07	-
527	VCCC/200	80	0	.07	-
528	VCCC/200	80	0	.07	-
529	VCWC/1200	750	250	.18	2
530	VCWC/1200	750	250	.18	10
531	VCWC/1200	680	230	.15	10
532A	VCWC/1200	600	320	.11	14
532B	VCCC/400	300	0	.30	-
533	VCWC/1200	700	470	.16	15
534	VCWC/200	110	20	.03	4
535	VCWC/400	180	50	.09	7
538	VCWC/4000	3100	350	.41	47
539	VCWC/4000	250	350	.41	47
540	VCWC/400	250	250	.16	7
601	VCWC/400	280	90	.21	6
602	VCWC/400	250	70	.16	6
603	VCWC/400	250	70	.16	6
604	VCWC/400	250	70	.16	6
605	VCWC/400	250	70	.16	6

VARIABLE AIR VOLUME BOX SCHEDULE					
BOX DESIG.	TRANE MODEL NO./SIZE	MAX. CFM	MIN. CFM	MAX. UNIT PRES. DROP (PRES. DROP)	MBH HT'G REQ'D
606	VCWC/400	250	70	.16	6
607	VCWC/400	250	70	.16	6
608	VCWC/400	270	80	.19	6
609	VCWC/1200	700	240	.19	7
610	VCWC/1200	700	240	.19	7
611	VCWC/800	460	160	.19	7
612	VCWC/800	460	160	.19	2
613	VCWC/200	150	50	.24	10
621	VCWC/400	380	130	.38	8
622	VCWC/400	380	130	.38	8
623	VCWC/400	380	130	.38	8
624	VCWC/400	380	130	.38	8
625	VCWC/400	380	130	.38	8
626	VCWC/400	380	130	.38	8
627	VCWC/400	380	130	.38	8
628	VCWC/400	380	130	.38	8
629A	VCWC/1200	600	320	.11	17
629B	VCWC/400	300	100	.30	6
630	VCWC/1200	700	490	.16	15
631	VCWC/200	110	30	.03	3
632	VCWC/400	180	30	.09	5
633	VCWC/4000	3100	350	.41	49
634	VCWC/4000	3100	350	.41	49
637	VCWC/400	250	250	.16	7
701	VCWC/1200	750	190	.18	11
702	VCWC/3000	2150	540	.20	19
703	VCWC/1200	1000	350	.32	24

- VAV BOX NOTES
- ALL UNITS REQUIRE 0.5" STATIC PRESSURE AT DISCHARGE.
 - ALL VCWC UNITS HAVE A WATER HEATING COIL. THE DUTY OF EACH BOX IS 56F ENTERING AIR TEMP, 200F ENTERING WATER TEMP. AND 20F WATER TEMP. DROP. THE REQUIRED HEATING LOAD IS AS LISTED ON THE SCHEDULE.
 - VAV BOXES AND ASSOCIATED DUCT SYSTEM ARE REQUIRED TO HAVE A MAXIMUM SOUND LEVEL OF A NC OF 30 IN ANY ROOM BEING SUPPLIED FROM A VAV BOX.

PACKAGE HOT WATER HEATING SYSTEM SCHEDULE	
DESIGNATION	PHWHS-1
SHELL	
FOUNDATIONS OF STEAM/DRUM	7936
STEAM PRESSURE (PSIG)	10
TUBE	
GPM	750
E.W.T./L.W.T. (F)	180/200
MAX. WATER PRESSURE DROP (FT.WTR.)	10
PUMPS	
MODEL NO.	12-1310-536
GPM/TOTAL HEAT (FT.WTR.)	1375 EA/140
HP/RPM	125 EA/1750
VOLTAGE/PHASE/HERTZ	208/3/60
AIR SEPARATOR/HEAT TREATMENT FITTING	
GPM/MAX. LOSS (FT.WTR.)	375/6
MODEL NO.	12-1310-536
TRIPLE CHECK VALVE	100
MODEL NO.	12-1310-536
EXPANSION TANK	
CAPACITY (GALLONS)	120
OVERALL SIZE (IN.)	1/2x24 DIA.
MAX. OPERATING PRESSURE (PSIG)	125
MANUFACTURER'S DATA	
MANUFACTURER	B & B
MODEL NUMBER	11P2-850
REMARKS: UNIT COMPLETE WITH PREPARED, PREWIRED & PRETESTED WATER VALVE, REDUCING VALVE, TEMP. AND PRESS. SENSORS, 1/2" ANGLE IRON FRAME, MOTOR STARTER, DUAL STEAM CONTROL VALVES AND DUAL CONDENSATE TRAPS.	


HOT WATER UNIT HEATER SCHEDULE			
GENERAL			
UNIT DESIGNATION	UH-1	UH-2	UH-3 TO 10
HEATER			
TOTAL HEATING (MBH)	11	19	6.3
CFM	2381	37	100
HP/FAN RPM	17/100	03/155	04/1030
E.A.T./L.A.T. (F)	60/105	60/93	60/31
E.W.T./L.W.T. (F)	200/180	200/180	200/180
MOUNTING HEIGHT (FT.)	12	10	12
DISCHARGE ARRANGEMENT	HORIZ.	HORIZ.	VERT.
ELECTRICAL			
VOLTAGE/PHASE/HERTZ	120/1/60	100/1/60	120/3/60
MANUFACTURER'S DATA			
MANUFACTURER	TRANE	TRANE	TRANE
MODEL NUMBER	168-S	38-S	18-S
REMARKS: COMPLETE WITH WALL MOUNTING BRACKET AND LOUVER FIN DIFFUSER.			
% EFFICIENCY/AREA (SQ.FT.)	30/7.87		
A.P.D. CLEAN/DIRTY (IN.WG.)	.2/5		
HP/NO OF MOTORS	.18/1		
VOLTAGE/PHASE/HERTZ	120/1/60		
ELECTRICAL			
VOLTAGE/PHASE/HERTZ	208/3/60		
MANUFACTURER'S DATA			
MANUFACTURER	TRANE		
MODEL NUMBER	CLCH-8		
ARRANGEMENT	BLOW-THRU		
OPERATING WEIGHT (LBS.)	1600		
REMARKS: COMPLETE WITH MIXING BOX			
% EFFICIENCY/AREA (SQ.FT.)	30/7.87		
A.P.D. CLEAN/DIRTY (IN.WG.)	.2/5		
HP/NO OF MOTORS	.18/1		
VOLTAGE/PHASE/HERTZ	120/1/60		
ELECTRICAL			
VOLTAGE/PHASE/HERTZ	208/3/60	208/3/60	208/3/60
MANUFACTURER'S DATA			
MANUFACTURER	SYSTEMCON	AURORA	B.&B.
MODEL NUMBER	ES	344A	60
REMARKS			

NOTE

 FOR INSTALLED EQUIPMENT
 PHYSICAL DATA SEE MAINTENANCE
 AND OPERATING MANUAL

AS BUILT

"This seal and signature apply only to the unaltered document to which they are affixed. I expressly disclaim any responsibility for any and all changes made after the issue date, for other plans, specifications, estimates, reports or other documents or instruments relating to or intended to be used for any part or portion of the architectural or engineering project or survey."

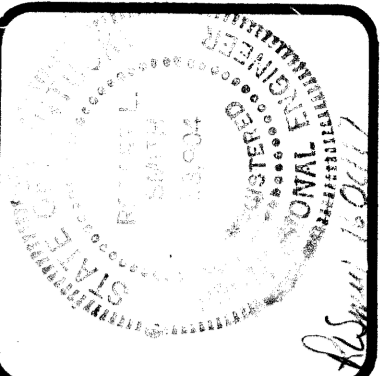BELCAN CORPORATION
 10200 ANDERSON WAY
 CINCINNATI, OHIO 45242
 NUMBER: 4361-CM-031-3



ROBOTICS FACILITY
 LEXINGTON CAMPUS
 UNIVERSITY OF KENTUCKY
 LEXINGTON, KENTUCKY

University of Kentucky
 Lexington, Kentucky
 10-19-07
 ROBERT L. BUNN
 Director, design and construction group

SCHEDULES
 Sherman Carter Barnhart
 PARTNERS IN ARCHITECTURE
 501 E. 9th St., Lexington, KY 40502 • 606-254-3351

JOB NO. 3706
 DATE 10/16/07
 DRAWN AFB
 CHECKED [Signature]
 IN FILE NO. 431.5

REVISIONS
 3- 90% REVIEW
 4- AS BUILT

SHEET
 M-31
 82 C-3 004962

AIR HANDLING UNIT SCHEDULE							
UNIT							
DESIGNATION	AHU-1	AHU-2	AHU-3	AHU-4	AHU-5	AHU-6	AHU-7
FAN							
CFM	5670	9190	12630	14510	10420	10420	3250
EXTERNAL STATIC PRESSURE (IN.WG.)	2.8	4.1	4.2	4.0	3.2	3.4	2.5
TOTAL STATIC PRESSURE (IN.WG.)	5.4	5.9	6.1	6.5	5.2	5.4	4.8
FAN WHEEL SIZE/TYPE	16/FC	24.5/AF	27/AF	30/AF	24.5/AF	24.5/AF	13/FC
HP/FAN RPM	10/1478	20/1888	25/1819	30/1881	20/1937	20/1961	7.5/1708
CHILLED WATER COIL							
FACE AREA (SQ.FT.)/TRANE FIN TYPE	10.63/PF	20/PF	27.5/PF	30.25/PF	22.5/PF	22.5/PF	7/PF
ROWS/FINS PER FOOT	8/118	8/118	8/109	10/91	8/106	8/103	8/93
AIR PRESSURE DROP (IN.WG.)	.74	.63	.60	.73	.57	.56	.44
E.A.T. (F.D.B./ F.W.B.)	182.5/65.5	182.3/65.6	182/64.9	183.5/66.7	181.4/63.9	181.3/63.8	180.0/62.4
L.A.T. (F.D.B./ F.W.B.)	152.7/52.5	152.4/52.3	152.2/52	152.5/52.3	152.1/51.8	153.1/51.9	153.5/51.3
GPM/WATER TEMP. RISE (F)	34.7/12	60.5/12	79.7/12	104.8/12	60.8/12	59.8/12	16.6/12
WATER PRESSURE DROP (FT.WTR.)	4.4	3.8	7.3	13.2	3.8	3.7	1.1
WATER HEATING COIL							
FACE AREA (SQ.FT.)/TRANE FIN TYPE	10.63/PF	27.5/PF	27.5/PF	30.25/PF	22.5/PF	22.5/PF	7/PF
ROWS/FINS PER FOOT	1/90	1/89	1/87	1/89	1/88	1/88	1/124
AIR PRESSURE DROP (IN.WG.)	.08	.06	.06	.07	.06	.06	.07
E.A.T./L.A.T. (F)	0/50	0/50	0/50	0/50	0/50	0/50	0/70
GPM/WATER TEMP. DROP (F)	29.3/20	49.9/20	68.6/20	78.8/20	56.6/20	56.6/20	24.7/20
WATER PRESSURE DROP (FT.WTR.)	1.5	.7	1.6	1.8	1.0	1.0	1.8
AIR FILTER - ROLL TYPE							
% EFFICIENCY	30	30	30	30	30	30	** 30
A.P.D. CLEAN/DIRTY (IN.WG.)	.2/.4	.2/.4	.2/.4	.2/.4	.2/.4	.2/.4	.2/.4
OVERALL SIZE OR FACE AREA(SQ.FT.)	10.6	72x72	72x72	72x72	72x72	72x72	7.87
HP/NUMBER OF MOTORS	.18/1	.18/1	.18/1	.18/1	.18/1	.18/1	N/A
VOLTAGE/PHASE/HERTZ	120/1/60	120/1/60	120/1/60	120/1/60	120/1/60	120/1/60	N/A
AIR FILTER - FLEATED CARTRIDGE							
% EFFICIENCY	55	55	55	55	55	55	55
A.P.D. CLEAN/DIRTY (IN.WG.)	.2/.6	.3/.8	.3/.8	.3/.8	.3/.8	.3/.8	.2/.6
OVERALL SIZE OR FACE AREA(SQ.FT.)	6	60x60	60x60	60x60	60x60	60x60	8
UNIT ELECTRICAL							
VOLTAGE/PHASE/HERTZ	208/3/60	208/3/60	208/3/60	208/3/60	208/3/60	208/3/60	208/3/60
MANUFACTURER'S DATA							
MANUFACTURER	TRANE	WEBCO	WEBCO	WEBCO	WEBCO	WEBCO	TRANE
MODEL NUMBER	CLCH-12	CUS-10000	CUS-13000	CUS-15000	CUS-11000	CUS-11000	CLCH-8
ARRANGEMENT	BLOW-THRU	BLOW-THRU	BLOW-THRU	BLOW-THRU	BLOW-THRU	BLOW-THRU	BLOW-THRU
OPERATING WEIGHT (LBS.)	2200						1900
REMARKS: AHU-1 & AHU-7 COMPLETE WITH HI-EFFICIENCY MIXING BOX AND INLET VANES. AHU-1 HAS WIDE COIL							
* EXTERNAL STATIC PRESSURE INCLUDES ALL STATIC PRESSURE LOSSES EXTERNAL TO THE UNIT.							
† ALL COIL, PLENUM, BAFFLES, INTERNAL DAMPERS, AND FILTERS (USE A TOTAL OD 1.2" LOSS							
‡ FOR DIRTY FILTERS FOR AHU-2 TO AHU-6, 1" FOR AHU-1 AND AHU-7. .4" IS FOR THE ROLL FILTER AND .8" FOR THE CARTRIDGE FILTERS) IS CONSIDERED INTERNAL TO THE UNIT AND WILL BE INCLUDED WITH THE TOTAL STATIC PRESSURE.							
** 2" THROWAWAY FILTER							


EXHAUST STEAM CONDENSATE PUMP SCHEDULE	
UNIT	
DESIGNATION	SV-1
HP	45
MAXIMUM HORSEPOWER (S.P.)	30000
TOTAL HEAD (PSI)	50
HP/ELECTRIC MOTOR	3/1750
RECEIVER SIZE (GALLONS)	60
RECEIVER	
VOLTAGE/PHASE/HERTZ	208/3/60
MANUFACTURER'S DATA	
MANUFACTURER	WURRA
MODEL NUMBER	SERIES 212
REMARKS: COMPLETE WITH THERMOSTATIC PRESSURE GAUGES, MANUAL CONTROL, 2 STARTERS	
‡ HAND-OFF AUTO SWITCHES, 2 ELECTRICAL SWITCHES, AN VENT CONNECTION, ELECTRIC ALTERNATOR, ENDS NOT SHOWN, TOTALY INSTALLED, PUMP AND TRUSS	

STEAM PRESS. SAFETY RELIEF VALVE SCHEDULE	
UNIT	
DESIGNATION	SV-1
VALVE	
SIZE (IN.)	4 x 6
PRESSURE SETTING (PSIG)	15
CAPACITY (LBS./HOUR)	12629
MANUFACTURER'S DATA	
MANUFACTURER	CONSOLIDATED
MODEL NUMBER	1905P/P1 & P2
REMARKS	


FAN SCHEDULE												
UNIT												
DESIGNATION	EF-1	EF-2	EF-3	EF-4	EF-5	EF-6	SF-1	SF-2	RF-1	EF-7		
DUTY	TOILET EXHAUST	BSMT. MECH. EXHAUST	ROOF MECH. EXHAUST	F. PUMP RM. EXHAUST	EMER. GEN. RM. EXH.	WELDING EXHAUST	EMER. GEN. RM. SUP.	F. PUMP RM. SUPPLY	RELIEF AIR	ANDERSON HALL MECH ROOM EXH		
FAN												
CFM	4540	8000	1000	1000	5000	1000	5000	1000	53500	5000		
EXTERNAL STATIC PRESSURE (IN.WG.)	1.5	.75	.5	.5	.5	.75	.75	.75	2.8	.4		
TOTAL STATIC PRESSURE (IN.WG.)	1.7	.95	.6	.6	.6	.9	.9	.9	3.5	.5		
HP/FAN RPM	3/922	5/1651	.5/3450	.5/3450	.75/1750	.5/1227	1/1750	.5/1227	50/628	.75/1742		
DRIVE TYPE	BELT	BELT	DIRECT	DIRECT	BELT	BELT	DIRECT	BELT	BELT	BELT		
DISCHARGE ARRANGEMENT	UPBLAST	1	N/A	N/A	N/A	2	N/A	2	UPBLAST	N/A		
FAN TYPE	SWSI	INLINE	*PROP	*PROP	*PROP	INLINE	*PROP	INLINE	SWSI	*PROP		
ELECTRICAL												
VOLTAGE/PHASE/HERTZ	208/3/60	208/3/60	208/3/60	208/3/60	208/3/60	208/3/60	208/3/60	208/3/60	208/3/60	208/3/60		
MANUFACTURER'S DATA												
MANUFACTURER	TRANE	TRANE	AEROVENT	AEROVENT	AEROVENT	TRANE	AEROVENT	TRANE	TRANE	AEROVENT		
MODEL NUMBER	**24AFSW	0-24	12M618	12M618	24L222	0-16	24L420	0-16	**60AFSW	24L222		
REMARKS: * WITH MOUNTING ADAPTER AND FLAT WIRE GUARD												
** COMPLETE WITH BELT GUARD AND INERTIA BASE												

OUTSIDE AIR INTAKE LOUVER SCHEDULE						
GENERAL						
UNIT DESIGNATION	DAI-1	DAI-2 TO 6	DAI-7	DAI-8	DAI-9	DAI-10
LOUVER						
CAPACITY, CFM	9400	114510 MAX.	3250	1000	1000	5000
AIR PRESSURE DROP (IN.WG.)	.1	.1	.1	.1	.1	.1
DAMPER SIZE (IN.)	54x88	-	-	24x24	24x24	30x30
OVERALL SIZE (IN.)	84x88	60x120	42x48	24x24	24x24	30x30
MANUFACTURER'S DATA						
MANUFACTURER	AIROLITE	AIROLITE	AIROLITE	AIROLITE	AIROLITE	AIROLITE
MODEL NUMBER	K-609	K-609	K-609	K-609	K-609	K-609
REMARKS: COLOR TO BE SELECTED						
ARCHITECT						

RELIEF AND EXHAUST LOUVER SCHEDULE						
GENERAL						
UNIT DESIGNATION	EAL-1	EAL-2	EAL-3	EAL-4	EAL-5	EAL-6
LOUVER						
CAPACITY, CFM	8000	1000	1000	5000	1000	7000
AIR PRESSURE DROP (IN.WG.)	.15	.15	.15	.15	.15	.15
OVERALL SIZE (IN.)	60x56	24x24	24x24	41.5x144	24x24	30x60
MANUFACTURER'S DATA						
MANUFACTURER	AIROLITE	AIROLITE	AIROLITE	AIROLITE	AIROLITE	AIROLITE
MODEL NUMBER	K-609	K-609	K-609	K-609	K-609	K-609
REMARKS: COLOR TO BE SELECTED BY ARCHITECT						

NOTE

 FOR INSTALLED EQUIPMENT
 PHYSICAL DATA SEE MAINTENANCE
 AND OPERATING MANUAL.

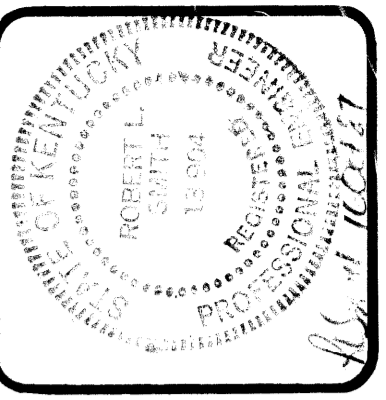This seal and signature apply only to the unaltered document to which they are affixed. I expressly disclaim any responsibility for any and all changes made after the issue date, for other plans, specifications, estimates, reports or other documents or instruments relating to or intended to be used for any part or portion of the architectural or engineering project or survey.



ROBOTICS FACILITY
 LEXINGTON CAMPUS
 UNIVERSITY OF KENTUCKY
 LEXINGTON, KENTUCKY

University of Kentucky
 Lexington, Kentucky
 Sherman Carter
 Director - design and construction division
 10-19-97

SCHEDULES
 Sherman Carter
 PARTNERS IN ARCHITECTURE
 SUITE 1800 • 250 WEST MAIN STREET • LEXINGTON, KY 40507 • 606.254.1931

JOB NO. 3706
 DATE 10/16/97
 DRAWN 11P
 CHECKED
 OR FILE NO. 431.0


REVISIONS
 3- 90% REVIEW
 4- AS BUILT

AS BUILT
 BELCAN CORPORATION
 10200 ANDERSON WAY
 CINCINNATI, OHIO 45242
 NUMBER: 4361-CM-032-3

SHEET
 M-32
 04/26/97
 C-3

DIFFUSER, GRILLE AND REGISTER SCHEDULE													
UNIT													
DESIGNATION	A	B	C	D	E	F	G	H	I	J	K	L	M
TYPE	CEILING DIFFUSER	CEILING DIFFUSER	SUPPLY REGISTER	TERMINAL OUTLET	CEILING GRILLE	CEILING GRILLE	CEILING GRILLE	CEILING GRILLE	CEILING GRILLE	CEILING GRILLE	CEILING GRILLE	CEILING GRILLE	WALL GRILLE
OVERALL SIZE (IN.)	12x12	24x24	**	**	12x12	12x24	24x24	**	12x12	12x24	24x24	**	**
NECK SIZE (IN.)	*	*	*	*	10x10	10x22	22x22	*	10x10	10x22	22x22	*	*
MAXIMUM NC	30	30	30	30	30	30	30	30	30	30	30	30	30
OPPOSED BLADE DAMPER	YES	YES	YES	NO	YES	YES	NO	NO	NO	NO	NO	NO	NO
FRAME TYPE	T-BAR	T-BAR	SURFACE	N/A	T-BAR	T-BAR	T-BAR	T-BAR	T-BAR	T-BAR	T-BAR	T-BAR	SURFACE
MANUFACTURER'S DATA													
MANUFACTURER	TITUS	TITUS	TITUS	UNITED SHT. METAL	TITUS	TITUS	TITUS	TITUS	TITUS	TITUS	TITUS	TITUS	TITUS
SERIES NO.	TMSA	TMSA	272FL5	FACTAIR MODEL 100	50F5	50F5	50F5	50F5	23RL	23RL	23RL	23RL	23RL
REMARKS: COLOR TO BE SELECTED BY ARCHITECT * AS INDICATED ON THE DRAWINGS ** SAME AS THE NECK SIZE													

"This seal and signature apply only to the unaltered document to which they are affixed. I expressly disclaim any responsibility for any and all changes made after the issue date, for other plans, specifications, estimates, reports or other documents or instruments relating to or intended to be used for any part or portion of the architectural or engineering project or survey."


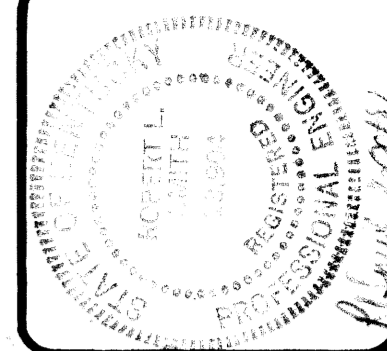


ROBOTICS FACILITY
LEXINGTON CAMPUS
UNIVERSITY OF KENTUCKY
LEXINGTON, KENTUCKY


University of Kentucky
Lexington, Kentucky
Approved by: *Wendell Gentry*
Director, design and construction division
10-19-07

STEAM PRESSURE REDUCING VALVE SCHEDULE		
GENERAL		
UNIT OF DESIGNATION	PRV-1	PRV-2
VALVE		
BODY SIZE (IN.)	3/4	2
CAPACITY (GPM/HOUR)	1768	7280
FLOW RANGE (LBS./HOUR)	0-1768	0-7280
INLET PRESSURE (PSIG)	175	175
OUTLET PRESSURE (PSIG)	13	13
TYPE	BRONZE	BRONZE
MANUFACTURER'S DATA		
MANUFACTURER	LESLIE	LESLIE
MODEL NUMBER	GPB	428
REMARKS		

STEAM WATER HEATER SCHEDULE	
UNIT	
DESIGNATION	HWH-1
WATER	
GALLONS PER HOUR	120
E.W.T./L.H.T. (F)	40/140
STEAM	
POUNDS OF STEAM/HOUR	110
STEAM PRESSURE (PSIG)	10
OPERATING PRESSURE (PSIG)	60
STORAGE	
STORAGE CAPACITY (GALLON)	240
MANUFACTURER'S DATA	
MANUFACTURER	SPAT. KEL.
MODEL NUMBER	120" 2/2-V
REMARKS: SUPPLY FACTORY INSTALLED TEMPERATURE AND PRESSURE RELIEF VALVE ON WATER SIDE.	

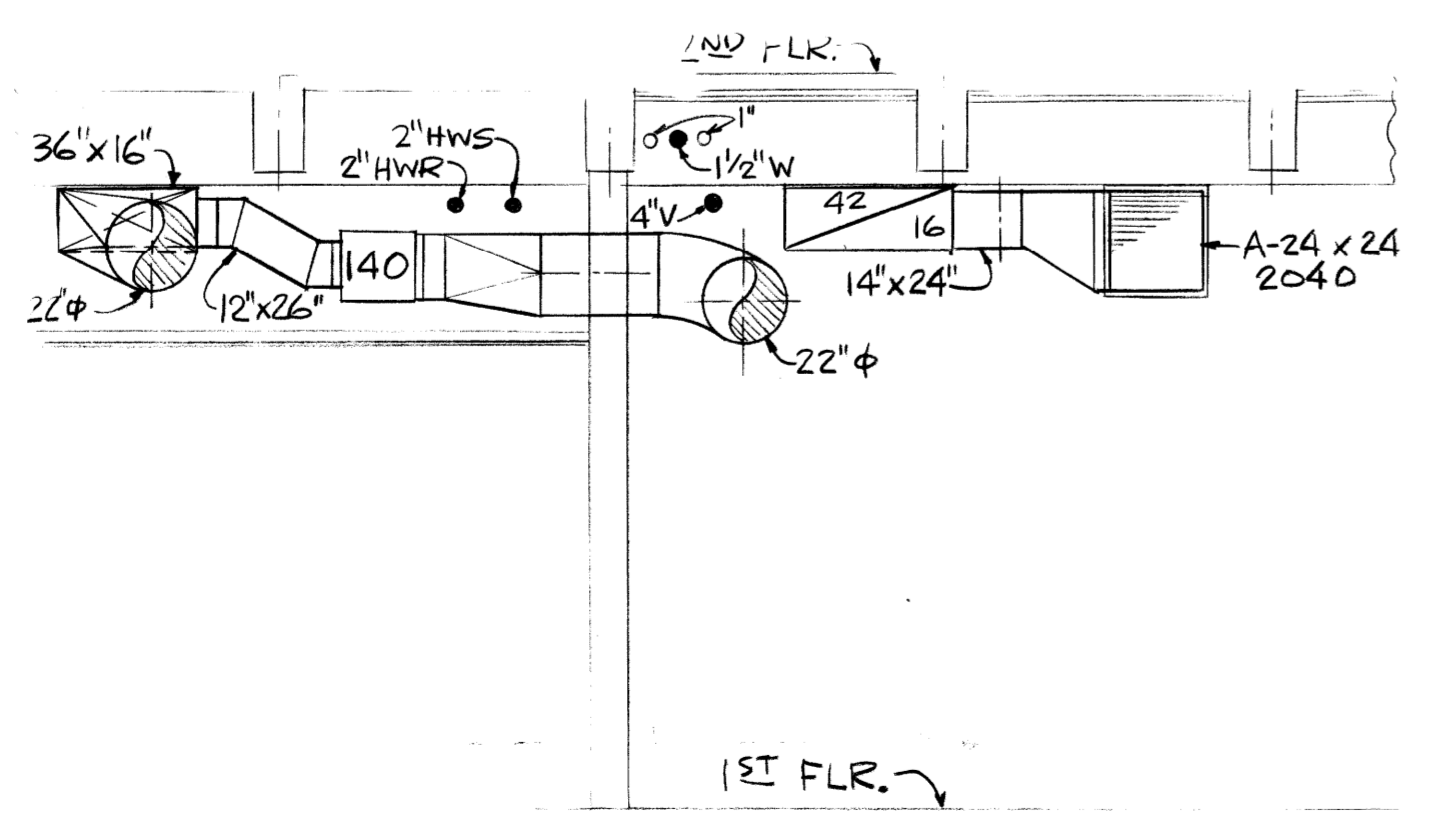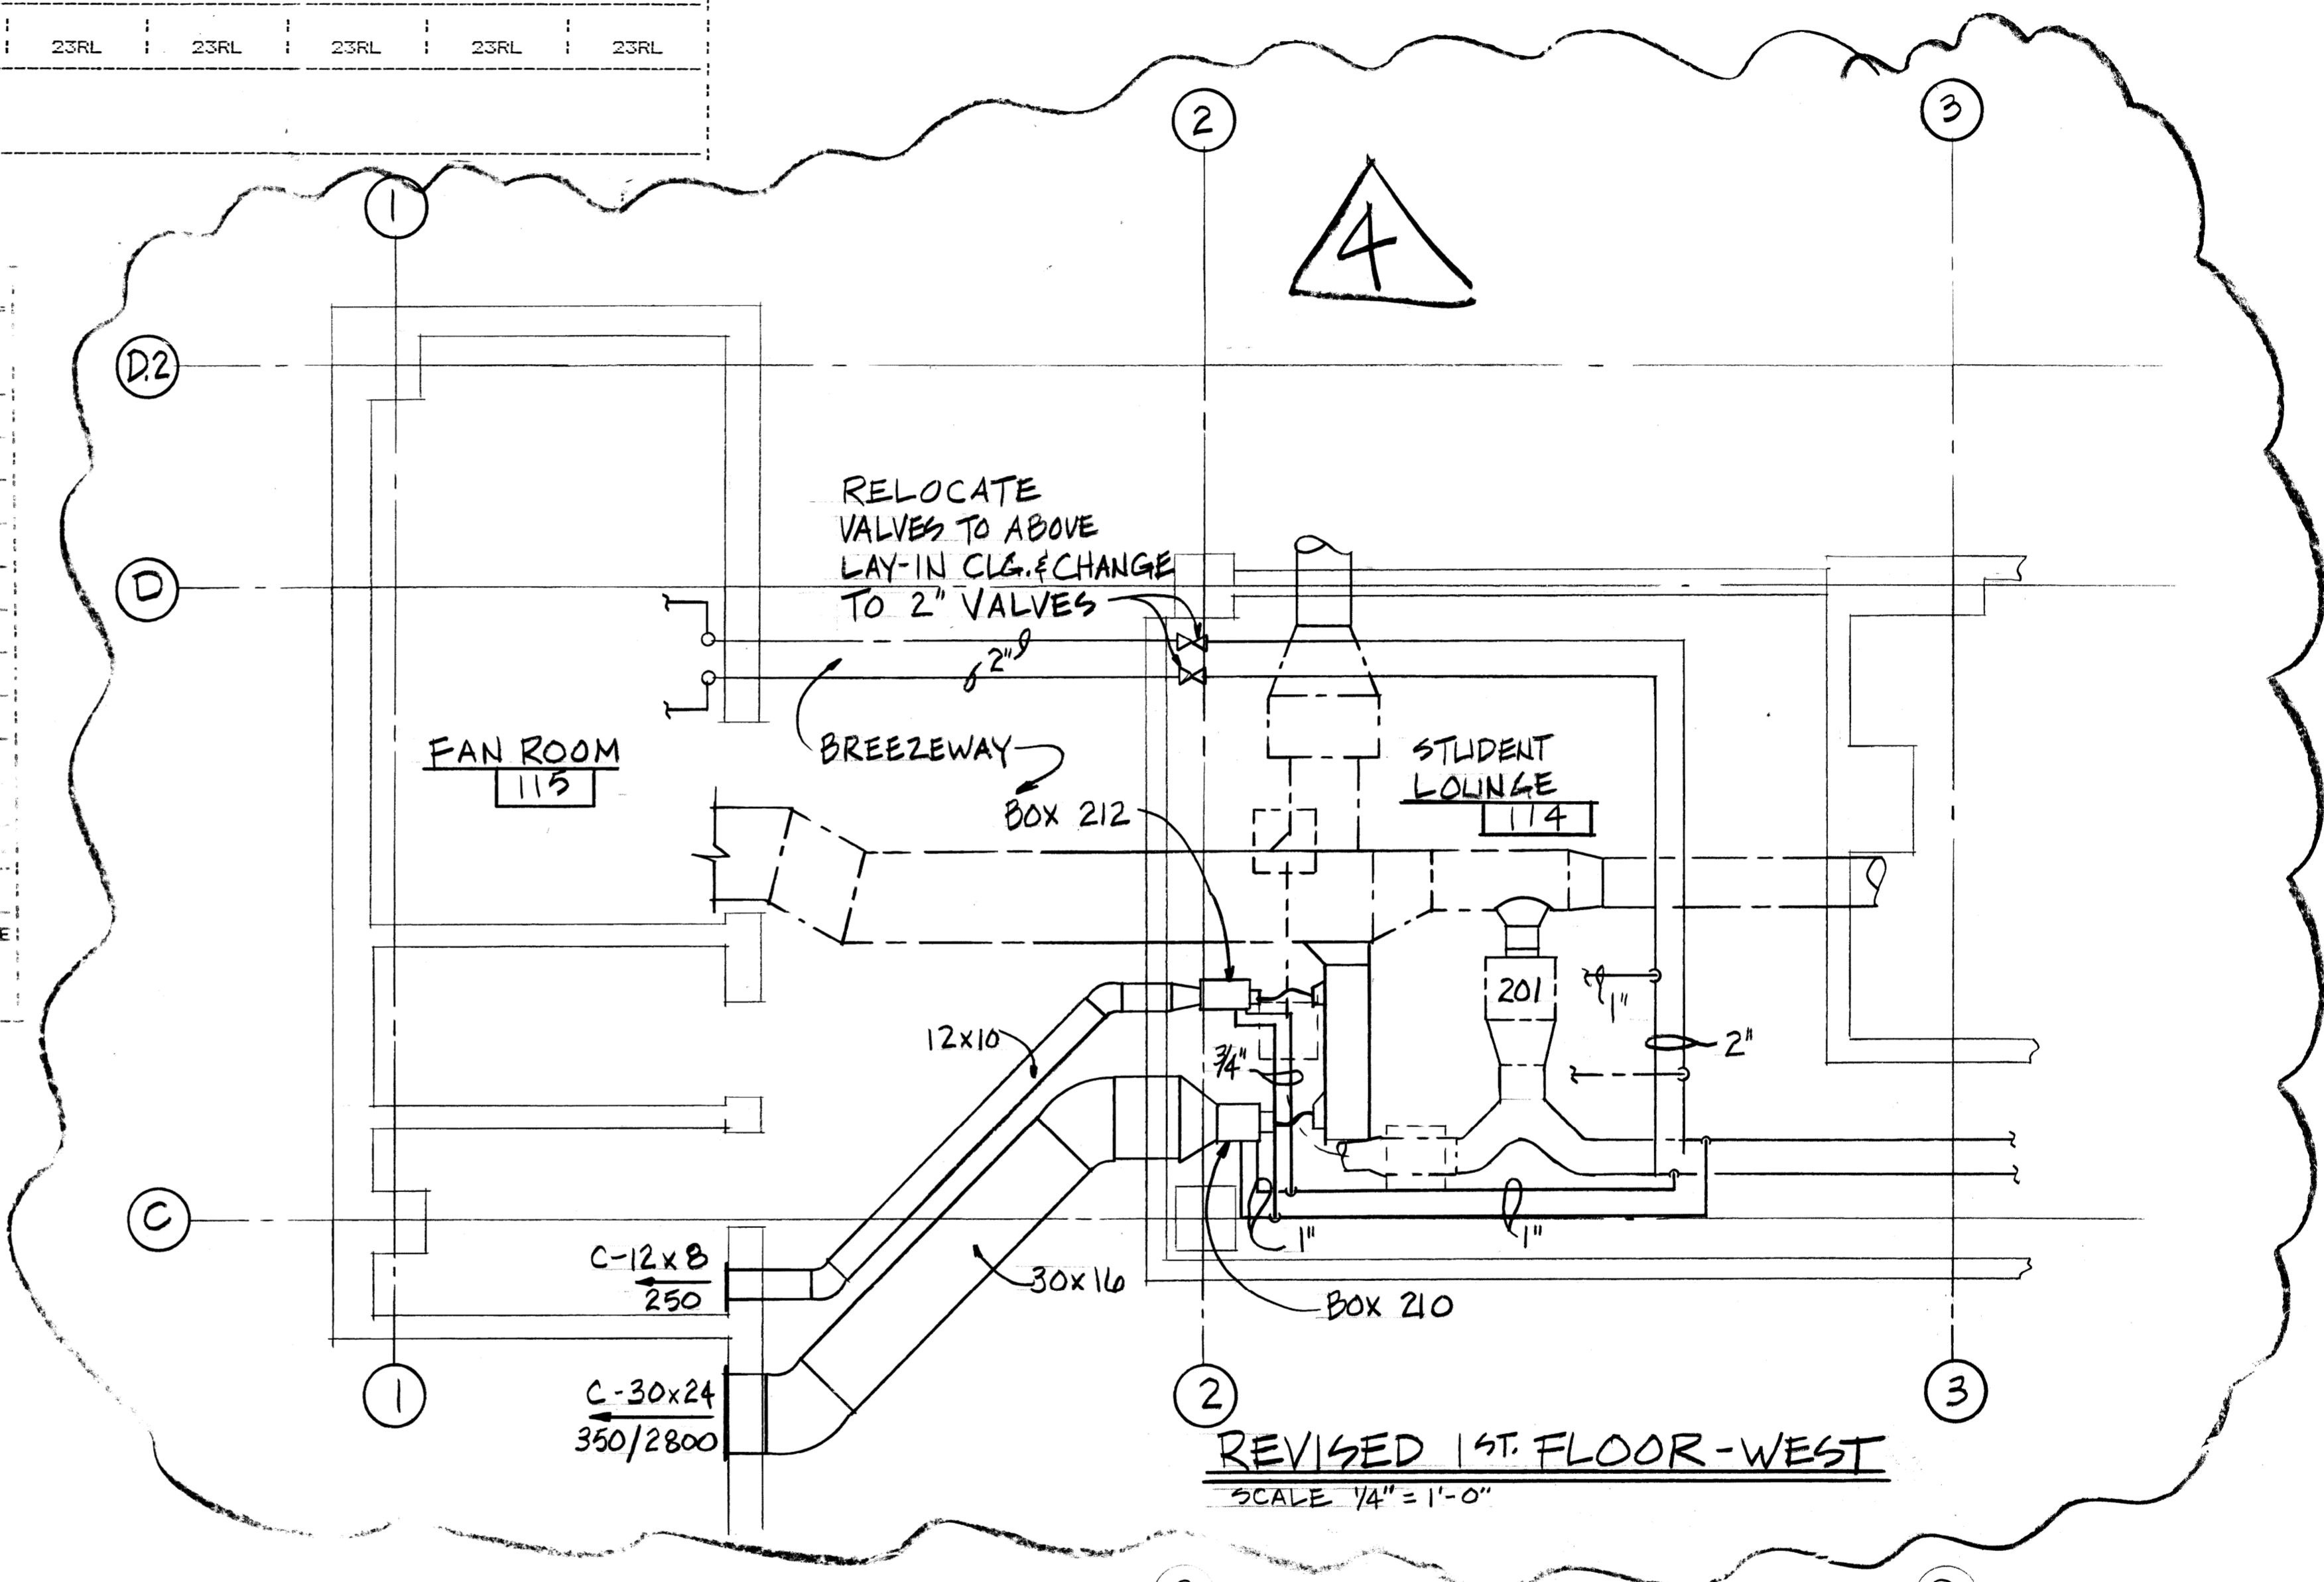

SECTION "B-B"
SCALE: 1/4" = 1'-0"

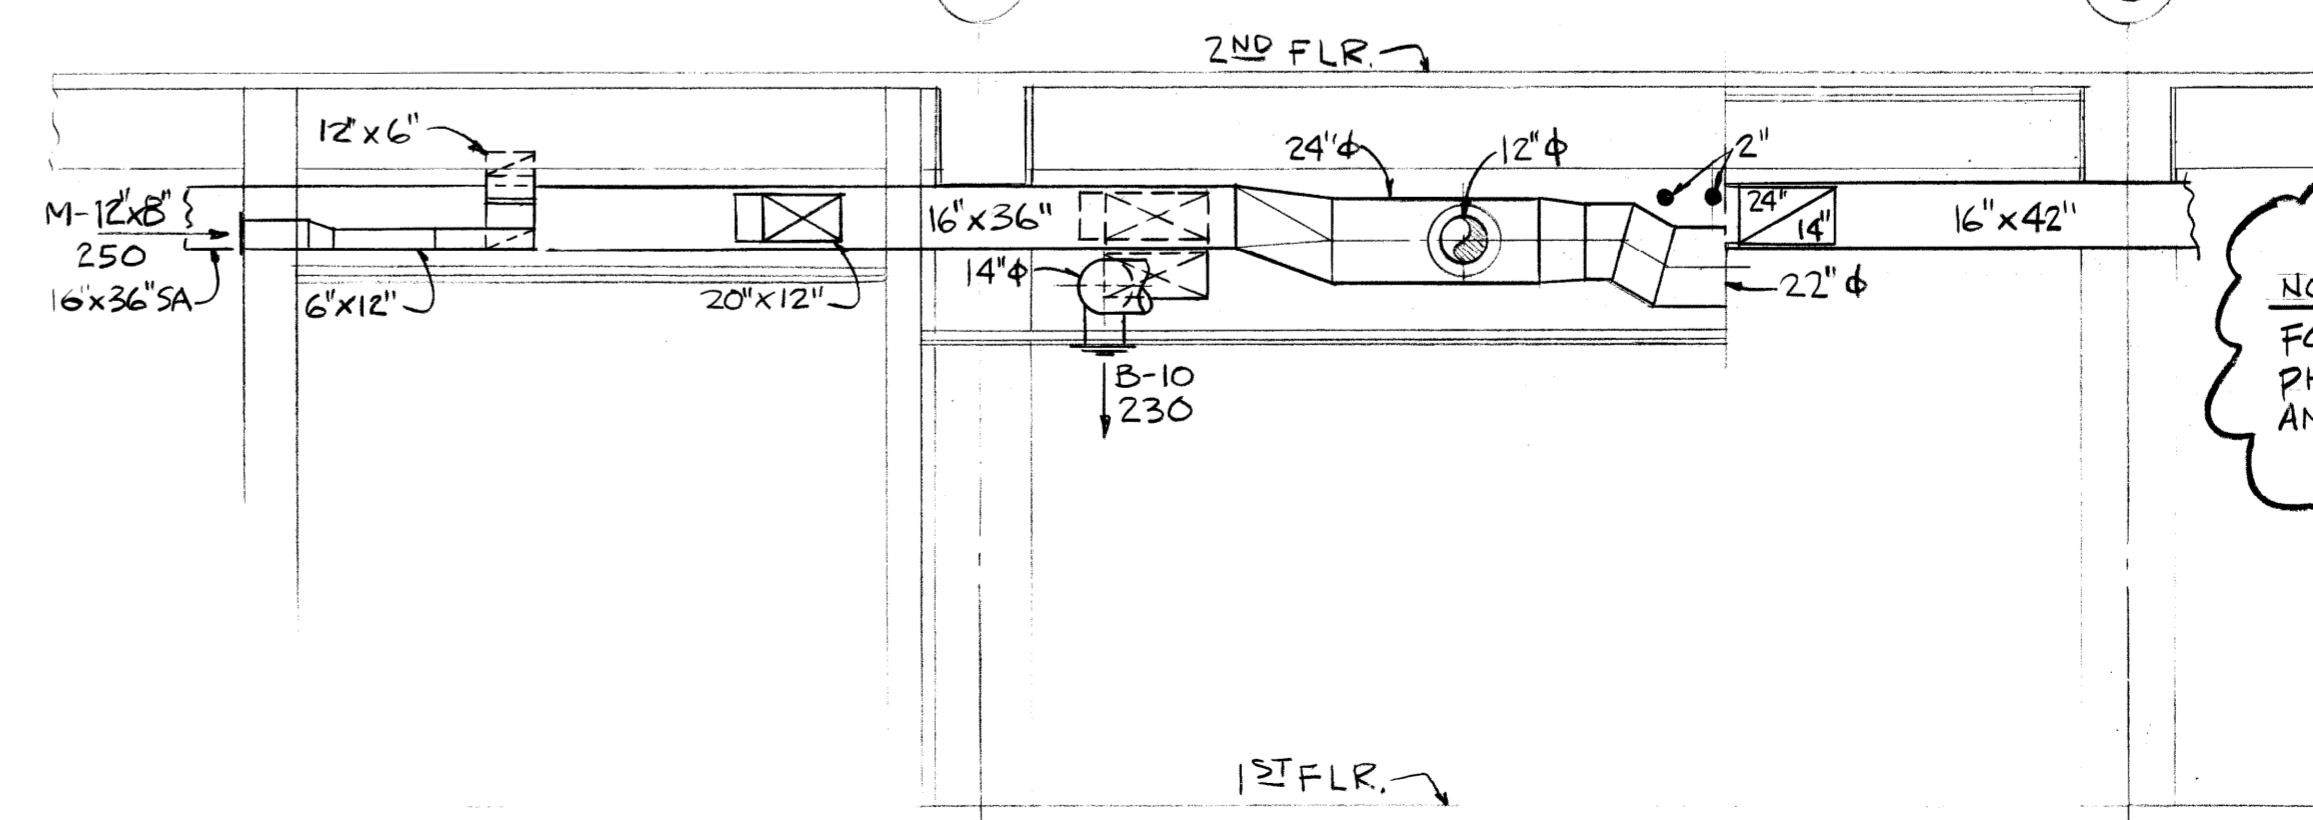

SECTION "A-A"
SCALE: 1/4" = 1'-0"

NOTE
FOR INSTALLED EQUIPMENT
PHYSICAL DATA, SEE MAINTENANCE
AND OPERATING MANUAL.

AS BUILT
BELCAN CORPORATION
10200 ANDERSON WAY
CINCINNATI, OHIO 45242
NUMBER: 4361-CM-033-3


SCHEDULES
Shelley Carter, Architect
PARTNERS IN ARCHITECTURE
3101 WEST MAIN STREET • LEXINGTON, KY 40502 • 606-254-1331

JOB NO 3706
DATE 10/16/07
DRAWN *[Signature]*
CHKD BY *[Signature]*
NO. 43115

REVISIONS:
3- 92% REVIEW
4- AS BUILT

SHEET
M-33
C-3
82

This seal and signature apply only to the unaltered document to which they are affixed. I expressly disclaim any responsibility for any and all changes made after the issue date, for other than the original design, or for other instruments relating to or intended to be used in connection with the execution of the architectural or engineering project or survey.

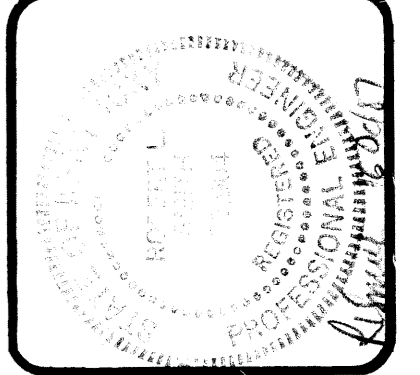

FORM EDCUK		EQUIPMENT COORDINATION SCHEDULE										
JOBNAME: U.K. ROBOTICS		COMM. NO.: 4361		DATE: 9/25/87		BY: JOHN MCCLDY						
MARK	DESCRIPTION	LOCATION	FURN:INST: BY: BY: HP: KW: FLA:	VOLTS: PH: HZ: DIR: P.LUG:	DISCONNECT DEVICE			CONTROLLER			CONNECT TYPE	WIRING BY: INTER: SCHEM. NO.
					FURN:INST: BY: BY: LOC. LINE:LOAD:	FURN:INST: BY: BY: LINE:LOAD:	FURN:INST: BY: BY: LINE:LOAD:	FURN:INST: BY: BY: LINE:LOAD:	FURN:INST: BY: BY: LINE:LOAD:	FURN:INST: BY: BY: LINE:LOAD:		
AH-1	AIR HANDLING UNIT	MECH. RM. BSM'T	M : M : 10 :	208 : 3 : 60 :	FSD : E : E : MCC : E : E :	FVNR : E : E : E : E : E :	HDA : E : E : E : E : E :	SDD : E : M : E : E : SPCL :	SDD : E : M : E : E : SPCL :	FZ : M : M : M : M : DDC :		
AH-2	AIR HANDLING UNIT	1ST FLOOR VAV ROOM	M : M : 20 :	208 : 3 : 60 :	FSD : E : E : MCC : E : E :	FVNR : E : E : E : E : E :	HDA : E : E : E : E : E :	SDD : E : M : E : E : SPCL :	SDD : E : M : E : E : SPCL :	FZ : M : M : M : M : DDC :		
AH-3	AIR HANDLING UNIT	2ND FLOOR VAV ROOM	M : M : 25 :	208 : 3 : 60 :	FSD : E : E : MCC : E : E :	FVNR : E : E : E : E : E :	HDA : E : E : E : E : E :	SDD : E : M : E : E : SPCL :	SDD : E : M : E : E : SPCL :	FZ : M : M : M : M : DDC :		
AH-4	AIR HANDLING UNIT	3RD FLOOR VAV ROOM	M : M : 30 :	208 : 3 : 60 :	FSD : E : E : MCC : E : E :	FVNR : E : E : E : E : E :	HDA : E : E : E : E : E :	SDD : E : M : E : E : SPCL :	SDD : E : M : E : E : SPCL :	FZ : M : M : M : M : DDC :		
AH-5	AIR HANDLING UNIT	4TH FLOOR VAV ROOM	M : M : 20 :	208 : 3 : 60 :	FSD : E : E : MCC : E : E :	FVNR : E : E : E : E : E :	HDA : E : E : E : E : E :	SDD : E : M : E : E : SPCL :	SDD : E : M : E : E : SPCL :	FZ : M : M : M : M : DDC :		
AH-6	AIR HANDLING UNIT	5TH FLOOR VAV ROOM	M : M : 20 :	208 : 3 : 60 :	FSD : E : E : MCC : E : E :	FVNR : E : E : E : E : E :	HDA : E : E : E : E : E :	SDD : E : M : E : E : SPCL :	SDD : E : M : E : E : SPCL :	FZ : M : M : M : M : DDC :		
AH-7	AIR HANDLING UNIT	MECH. RM. PENTHOUSE	M : M : 7.5 :	208 : 3 : 60 :	FSD : E : E : MCC : E : E :	FVNR : E : E : E : E : E :	HDA : E : E : E : E : E :	SDD : E : M : E : E : SPCL :	SDD : E : M : E : E : SPCL :	FZ : M : M : M : M : DDC :		
ACOMP-1	AIR COMPRESSOR	MECH. RM. BSM'T	M : M : 30 :	208 : 3 : 60 :	NFSD : V : V : U : E : V :	FVNR : V : V : V : V : V :	IGN-OFF: V : V : V : V :	DOC				
ADRY-1	ICOMP. AIR DRYER	MECH. RM. BSM'T	M : M : 3 :	208 : 3 : 60 :	NFSD : V : V : U : E : V :	FVNR : V : V : V : V : V :	IGN-OFF: V : V : V : V :	DOC				
ACOMP-2	AIR COMPRESSOR	MECH. RM. BSM'T	M : M : 5 :	208 : 3 : 60 :	NFSD : V : V : U : E : V :	FVNR : V : V : V : V : V :	IGN-OFF: V : V : V : V :	DOC				
ADRY-2	ICOMP. AIR DRYER	MECH. RM. BSM'T	M : M : 1 :	208 : 3 : 60 :	NFSD : V : V : U : E : V :	FVNR : V : V : V : V : V :	IGN-OFF: V : V : V : V :	DOC				
SCP-1	CONDENSATE PUMP	MECH. RM. BSM'T	M : M : (2) 3 :	208 : 3 : 60 :	FSD : V : V : U : E : V :	(2)FVNR : V : V : V : V :	LS : V : V : V : V :	DOC				
HRWP-1,2	HEATING HW PUMP		M : M : (2) 20 :	208 : 3 : 60 :	FSD : E : E : MCC : E : E :	FVNR : E : E : E : E : E :	HDA : E : E : E : E : E :	DOC				
FP-1	FIRE PUMP	FIRE PUMP ROOM	M : M : 50 :	208 : 3 : 60 :	NFSD : V : V : U : E : V :	FVNR : V : V : V : V : V :	HDA : V : V : E : V : SPCL :					
JP-1	JOCKEY PUMP		M : M : 0 :	208 : 3 : 60 :	NFSD : V : V : U : E : V :	FVNR : V : V : V : V : V :	HDA : V : V : E : V : SPCL :					
DWP-1,2	DOMESTIC WATER PUMP	MECH. RM. BSM'T	M : M : (2) 5 :	208 : 3 : 60 :	FSD : V : V : U : E : V :	(2)FVNR : V : V : V : V :	HDA : V : V : V : V :					
DHP-1	DOMESTIC HOT WATER PUMP	MECH. RM. BSM'T	M : M : 2 :	208 : 3 : 60 :	FSD : E : E : MCC : E : E :	FVNR : E : E : E : E : E :	SS : E : E : E : E :					
DHRP-1	DOM. HOT WATER RECIRC. PUMP	MECH. RM. BSM'T	M : M : .75 :	208 : 3 : 60 :	FSD : E : E : MCC : E : E :	FVNR : E : E : E : E : E :	SS : E : E : E : E :					

FORM EDCUK		EQUIPMENT COORDINATION SCHEDULE										
JOBNAME: U.K. ROBOTICS		COMM. NO.: 4361		DATE: 9/25/87		BY: JOHN MCCLDY						
MARK	DESCRIPTION	LOCATION	FURN:INST: BY: BY: HP: KW: FLA:	VOLTS: PH: HZ: DIR: P.LUG:	DISCONNECT DEVICE			CONTROLLER			CONNECT TYPE	WIRING BY: INTER: SCHEM. NO.
					FURN:INST: BY: BY: LOC. LINE:LOAD:	FURN:INST: BY: BY: LINE:LOAD:	FURN:INST: BY: BY: LINE:LOAD:	FURN:INST: BY: BY: LINE:LOAD:	FURN:INST: BY: BY: LINE:LOAD:	FURN:INST: BY: BY: LINE:LOAD:		
SF-1	SUPPLY FAN EMER. GEN.	EMER. GEN RM.	M : M : 1 :	208 : 3 : 60 :	FSD : E : E : MCC : E : E :	FVNR : E : E : E : E : E :	HDA : E : E : E : E : E :	SDD : E : M : E : E : SPCL :	SDD : E : M : E : E : SPCL :	FZ : M : M : M : M : DDC :		
RF-1	RELIEF FAN	MECH. RM. PENTHOUSE	M : M : 50 :	208 : 3 : 60 :	FSD : E : E : MCC : E : E :	FVNR : E : E : E : E : E :	HDA : E : E : E : E : E :	SDD : E : M : E : E : SPCL :	SDD : E : M : E : E : SPCL :	FZ : M : M : M : M : DDC :		
EF-1	EXHAUST FAN TOILET	MECH. RM. PENTHOUSE	M : M : 2 :	208 : 3 : 60 :	FSD : E : E : MCC : E : E :	FVNR : E : E : E : E : E :	HDA : E : E : E : E : E :	DOC				
EF-2	EXHAUST FAN MECH RM. BSM'T	MECH. RM. BSM'T	M : M : 5 :	208 : 3 : 60 :	FSD : E : E : MCC : E : E :	FVNR : E : E : E : E : E :	HDA : E : E : E : E : E :	DOC				
EF-3	EXH. FAN MECH RM. PENTHOUSE	MECH. RM. PENTHOUSE	M : M : 5 :	208 : 3 : 60 :	FSD : E : E : MCC : E : E :	FVNR : E : E : E : E : E :	HDA : E : E : E : E : E :	DOC				
EF-4	FIRE PUMP ROOM EXHAUST	FIRE PUMP ROOM	M : M : .5 :	208 : 3 : 60 :	FSD : E : E : E : E : E :	FVNR : E : E : E : E : E :	HDA : E : E : E : E : E :	SF-2				
EF-5	EXHAUST EMERGENCY GENERATOR	EMERGENCY GENERATOR RM.	M : M : 1 :	208 : 3 : 60 :	FSD : E : E : E : E : E :	FVNR : E : E : E : E : E :	HDA : E : E : E : E : E :	SF-1				
EF-6	WELDING EXHAUST	MACHINE BAY	M : M : .5 :	208 : 3 : 60 :	FSD : E : E : MCC : E : E :	FVNR : E : E : E : E : E :	HDA : E : E : E : E : E :	SS : E : E : E : E :				
SF-2	FIRE PUMP ROOM SUPPLY	FIRE PUMP ROOM	M : M : .5 :	208 : 3 : 60 :	FSD : E : E : E : E : E :	FVNR : E : E : E : E : E :	HDA : E : E : E : E : E :	TS : M : M : E : E :				
FF-1	FIRE FILTERS	MECH. RM. BSM'T	M : M : 1 :	208 : 3 : 60 :	FSD : E : E : E : E : E :	FVNR : E : E : E : E : E :	HDA : E : E : E : E : E :	SS : M : M : E : E :				
HVU-1	HEAT & VENT. UNIT	MECH. RM. BSM'T	M : M : 3 :	208 : 3 : 60 :	FSD : E : E : MCC : E : E :	FVNR : E : E : E : E : E :	HDA : E : E : E : E : E :	SDD : E : M : E : E : SPCL :	SDD : E : M : E : E : SPCL :	FZ : M : M : M : M : DDC :		
UH-1	UNIT HEATER	TRUCK DOCK	M : M : .17 :	120 : 1 : 60 :				MAN : E : E : E : E :	TS : M : M : E : E :			
UH-2	UNIT HEATER	FIRE PUMP ROOM	M : M : .05 :	120 : 1 : 60 :				MAN : E : E : E : E :	TS : M : M : E : E :			
UH-3	UNIT HEATER	1ST FLOOR VAV ROOM	M : M : .05 :	120 : 1 : 60 :				MAN : E : E : E : E :	TS : M : M : E : E :			
UH-4	UNIT HEATER	2ND FLOOR VAV ROOM	M : M : .05 :	120 : 1 : 60 :				MAN : E : E : E : E :	TS : M : M : E : E :			
UH-5	UNIT HEATER	3RD FLOOR VAV ROOM	M : M : .05 :	120 : 1 : 60 :				MAN : E : E : E : E :	TS : M : M : E : E :			
UH-6	UNIT HEATER	4TH FLOOR VAV ROOM	M : M : .05 :	120 : 1 : 60 :				MAN : E : E : E : E :	TS : M : M : E : E :			
UH-7	UNIT HEATER	5TH FLOOR VAV ROOM	M : M : .05 :	120 : 1 : 60 :				MAN : E : E : E : E :	TS : M : M : E : E :			
UH-8	UNIT HEATER	MECH. ROOM ROOF	M : M : .05 :	120 : 1 : 60 :				MAN : E : E : E : E :	TS : M : M : E : E :			

CONTRACTOR		LOCATION	DISCONNECT	CONTROLLER	CONTROLS
M- PROVIDED UNDER DIV 15	U- LOCATED AT UNIT	FSD- FUSED	FVNR- FULL VOLTAGE, NON-REV	HDA- HAND-OFF/AUTO SEL SW	SC- STEP CONTROLLER
E- PROVIDED UNDER DIV 16	R- LOCATED REMOTELY	NFSD- NON-FUSED	FW- FULL VOLTAGE, REV.	ON-OFF- ON-OFF SEL SW	SCR- SILICON CONT'L RECT.
O- OWNER	S- LOCATED IN STARTER		2SP- TWO SPEED	SS- START-STOP SW	PLC- PROG LOGIC CONTROLLER
V- VENDOR OR ED. MFR.	MCC- LOCATED IN MCC		MAN- MANUAL	DOC- DIRECT DIS CONTROLLER	DDC- DIRECT DIS CONTROLLER
	ACP- LOCATED IN ED. MFR.		COMB- COMBINATION STARTER	SPCL- SPECIAL	SPCL- SPECIAL
				LS- LEVEL SW	LZ- LIMIT SWITCH
				PS- PRESSURE SW	PL- PILOT LIGHT
				SOV- SOLENOID VALVE	R- RED
				SDD- SMOKE DETECTOR	G- GREEN
				FR- FIRE STAT	A- AMBER
				F1- FREEZE STAT	
				TS- TEMP SWITCH	

AS BUILT

BELCAN CORPORATION
10200 ANDERSON WAY
CINCINNATI, OHIO 45242
NUMBER: 4361-01-034-3

ROBOTICS FACILITY
LEXINGTON CAMPUS
UNIVERSITY OF KENTUCKY
LEXINGTON, KENTUCKY

University of Kentucky
Lexington, Kentucky

Approved by: *William B. Bunn*
Professional Engineer
No. 10777, Exp. 12/31/17

SCHEDULES

Sherman Carter Barnhart
PARTNERS IN ARCHITECTURE
315 E. 900 S. 250 WEST MAIN STREET • LEXINGTON, KY 40507 • 606-254-1351

JOB NO: 8706
DATE: 10-16-87
DRAWN: KE CASE
CHECKED:
SCALE: 431.0

REVISIONS
3 - 90% REVIEW


SHEET
M-34

	DIAGRAMATIC SLIDE OR GRAPHIC	INTERCOM STATION	ANALOG INDICATION			ALARM		CONTROL				REMARKS											
			TEMPERATURE	PRESSURE	RELATIVE HUMIDITY	TOTALIZATION	CHILLER STATUS	DIGITAL (CONTROL)	ANALOG	MINOR ALARM	MAJOR ALARM		MAINTENANCE	START/STOP & STATUS	STATUS	OPEN / CLOSED	*PROGRAM CONTROL	RESET CONTROL	PL. ADJUST.	DAMPERS POS. ADJ.	POSITION FEEDBACK	FOR CPA OR DPA	
AH UNITS 1-7																							
SUPPLY FAN																							SUPPLY FAN VAV CONTROLLED BY SOFTWARE
DISCHARGE AIR			X																				EACH AHU TO HAVE GOMIN OVERRIDE
RETURN AIR			X																				RUN SWITCH ACCESSIBLE TO OCCUPANTS
MIXED AIR			X																				FAN STARTS FROM AUX. CONTACT AT STARTER
SPACE TEMP.			X																				
HOT & CHILLED WATER COILS																							CONTROLLED THRU SOFTWARE
DAMPERS																							CONTROLLED THRU SOFTWARE
FREEZE							X																
FILTERS																							
DUCT STATIC			X																				READOUT AT CENTRAL PANEL
CONDENSATE PUMP							X																FLOAT PROVIDED BY HONEYWELL
HOT WATER PUMP #1																							ALT. PUMP THRU SOFTWARE
HOT WATER PUMP #2																							ALT. PUMP THRU SOFTWARE
MAIN CHILL WATER VALVE																							
EMER. GENERATOR																							
MAIN EXHAUST FAN																							VANE ACT. CONTROLLED THRU SOFTWARE
EX. FAN #1																							
EX. FAN #2																							
EX. FAN #3																							
OUTSIDE DOORS 1 THRU 7																							
HOT WATER SUPPLY			X																				
HOT WATER RETURN			X																				
CONVERTOR VALVES																							CONTROLLED THRU SOFTWARE
OUTDOOR TEMP.			X																				
PRV STEAM IN				X																			
PRV STEAM OUT				X																			
BTU METER					X																		
AIR COMPRESSOR LAB				X																			
AIR COMPRESSOR T/C				X																			
CHILLED WATER SUPPLY			X																				
CHILLED WATER RETURN			X																				
KW METERING					X																		
DOMESTIC HOT WATER			X																				
CONDENSATE METER					X																		
LIEBERT UNIT			X	X	X		X	X		X													

* PROGRAM CONTROL CONSISTS OF :

1. SUMMER WINTER CHANGEOVER	6. LOAD SHED
2. NIGHT PURGE	7. OPTIMUM S/S
3. NIGHT CYCLE	8. DAY/NIGHT SWITCH
4. DUTY CYCLE	
5. LOAD RESET	

This seal and signature apply only to the unaltered document to which they are affixed. I expressly disclaim any responsibility for any and all changes made after the issue date, for other plans, specifications, estimates, reports or other documents or instruments relating to or intended to be used for any part or portion of the architectural or engineering project or survey.

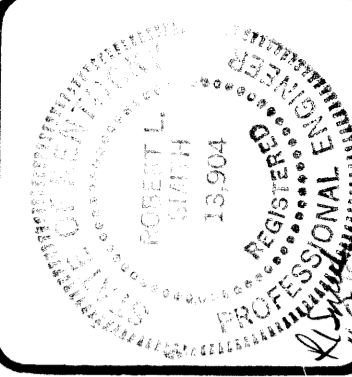

ROBOTICS FACILITY
LEXINGTON CAMPUS
UNIVERSITY OF KENTUCKY
LEXINGTON, KENTUCKY

University of Kentucky
Lexington, Kentucky
10-19-87
William E. Bannum
ARCHITECT - ENGINEER AND CONSTRUCTION ADMINISTRATION

SCHEDULES
Sherman Carter Barnhart
PARTNERS IN ARCHITECTURE
SUITE 1900 • 250 WEST MAIN STREET • LEXINGTON, KY 40507 • 606-254-1951

JOB NO. 57062
DATE 10/16/87
DRAWN S. THOMPSON
CHECKED [Signature]
IN FILE NO. 4310

REVISIONS
3 - 90% REVIEW

SHEET
M-35
C-3
004966

AS BUILT

NOTE:
THIS DRAWING ISSUED FOR REFERENCE FOR COORDINATION OF CONTROL VALVES, THERMOWELLS, SMOKE DETECTORS AND PRESSURE TAPS INSTALLED UNDER DIV. 15, THESE SPECIFICATIONS.

BELCAN CORPORATION
10200 ANDERSON WAY
CINCINNATI, OHIO 45242

NUMBER: 4361-CM-035-3

This seal and signature apply only to the unaltered document to which they are affixed. I expressly disclaim any responsibility for any and all changes made after the issue date, for other plans, specifications, estimates, reports or other documents or instruments relating to or intended to be used for any part or portion of the architectural or engineering project or survey.

Handwritten signature and date
27/10/16

ROBOTICS FACILITY
LEXINGTON CAMPUS
UNIVERSITY OF KENTUCKY
LEXINGTON, KENTUCKY

University of Kentucky
Lexington, Kentucky
Handwritten signature
10-19-87


BASEMENT FLR. LIGHTING PLAN
Shelton Carter Barnhart
PARTNERS IN ARCHITECTURE
SUITE 1900 • 250 WEST MAIN STREET • LEXINGTON KY 40507 • 606-534-1359

JOB NO. 8706
DATE 9-30-87
DRAWN D. MEYER
CHECKED H. GOLDEN
FILE NO. 431.0

REVISIONS
3-90% REVIEW 10-16-87
4-GENERAL 7-18-88
5-RENOVATION 2-15-89

SHEET

E-1

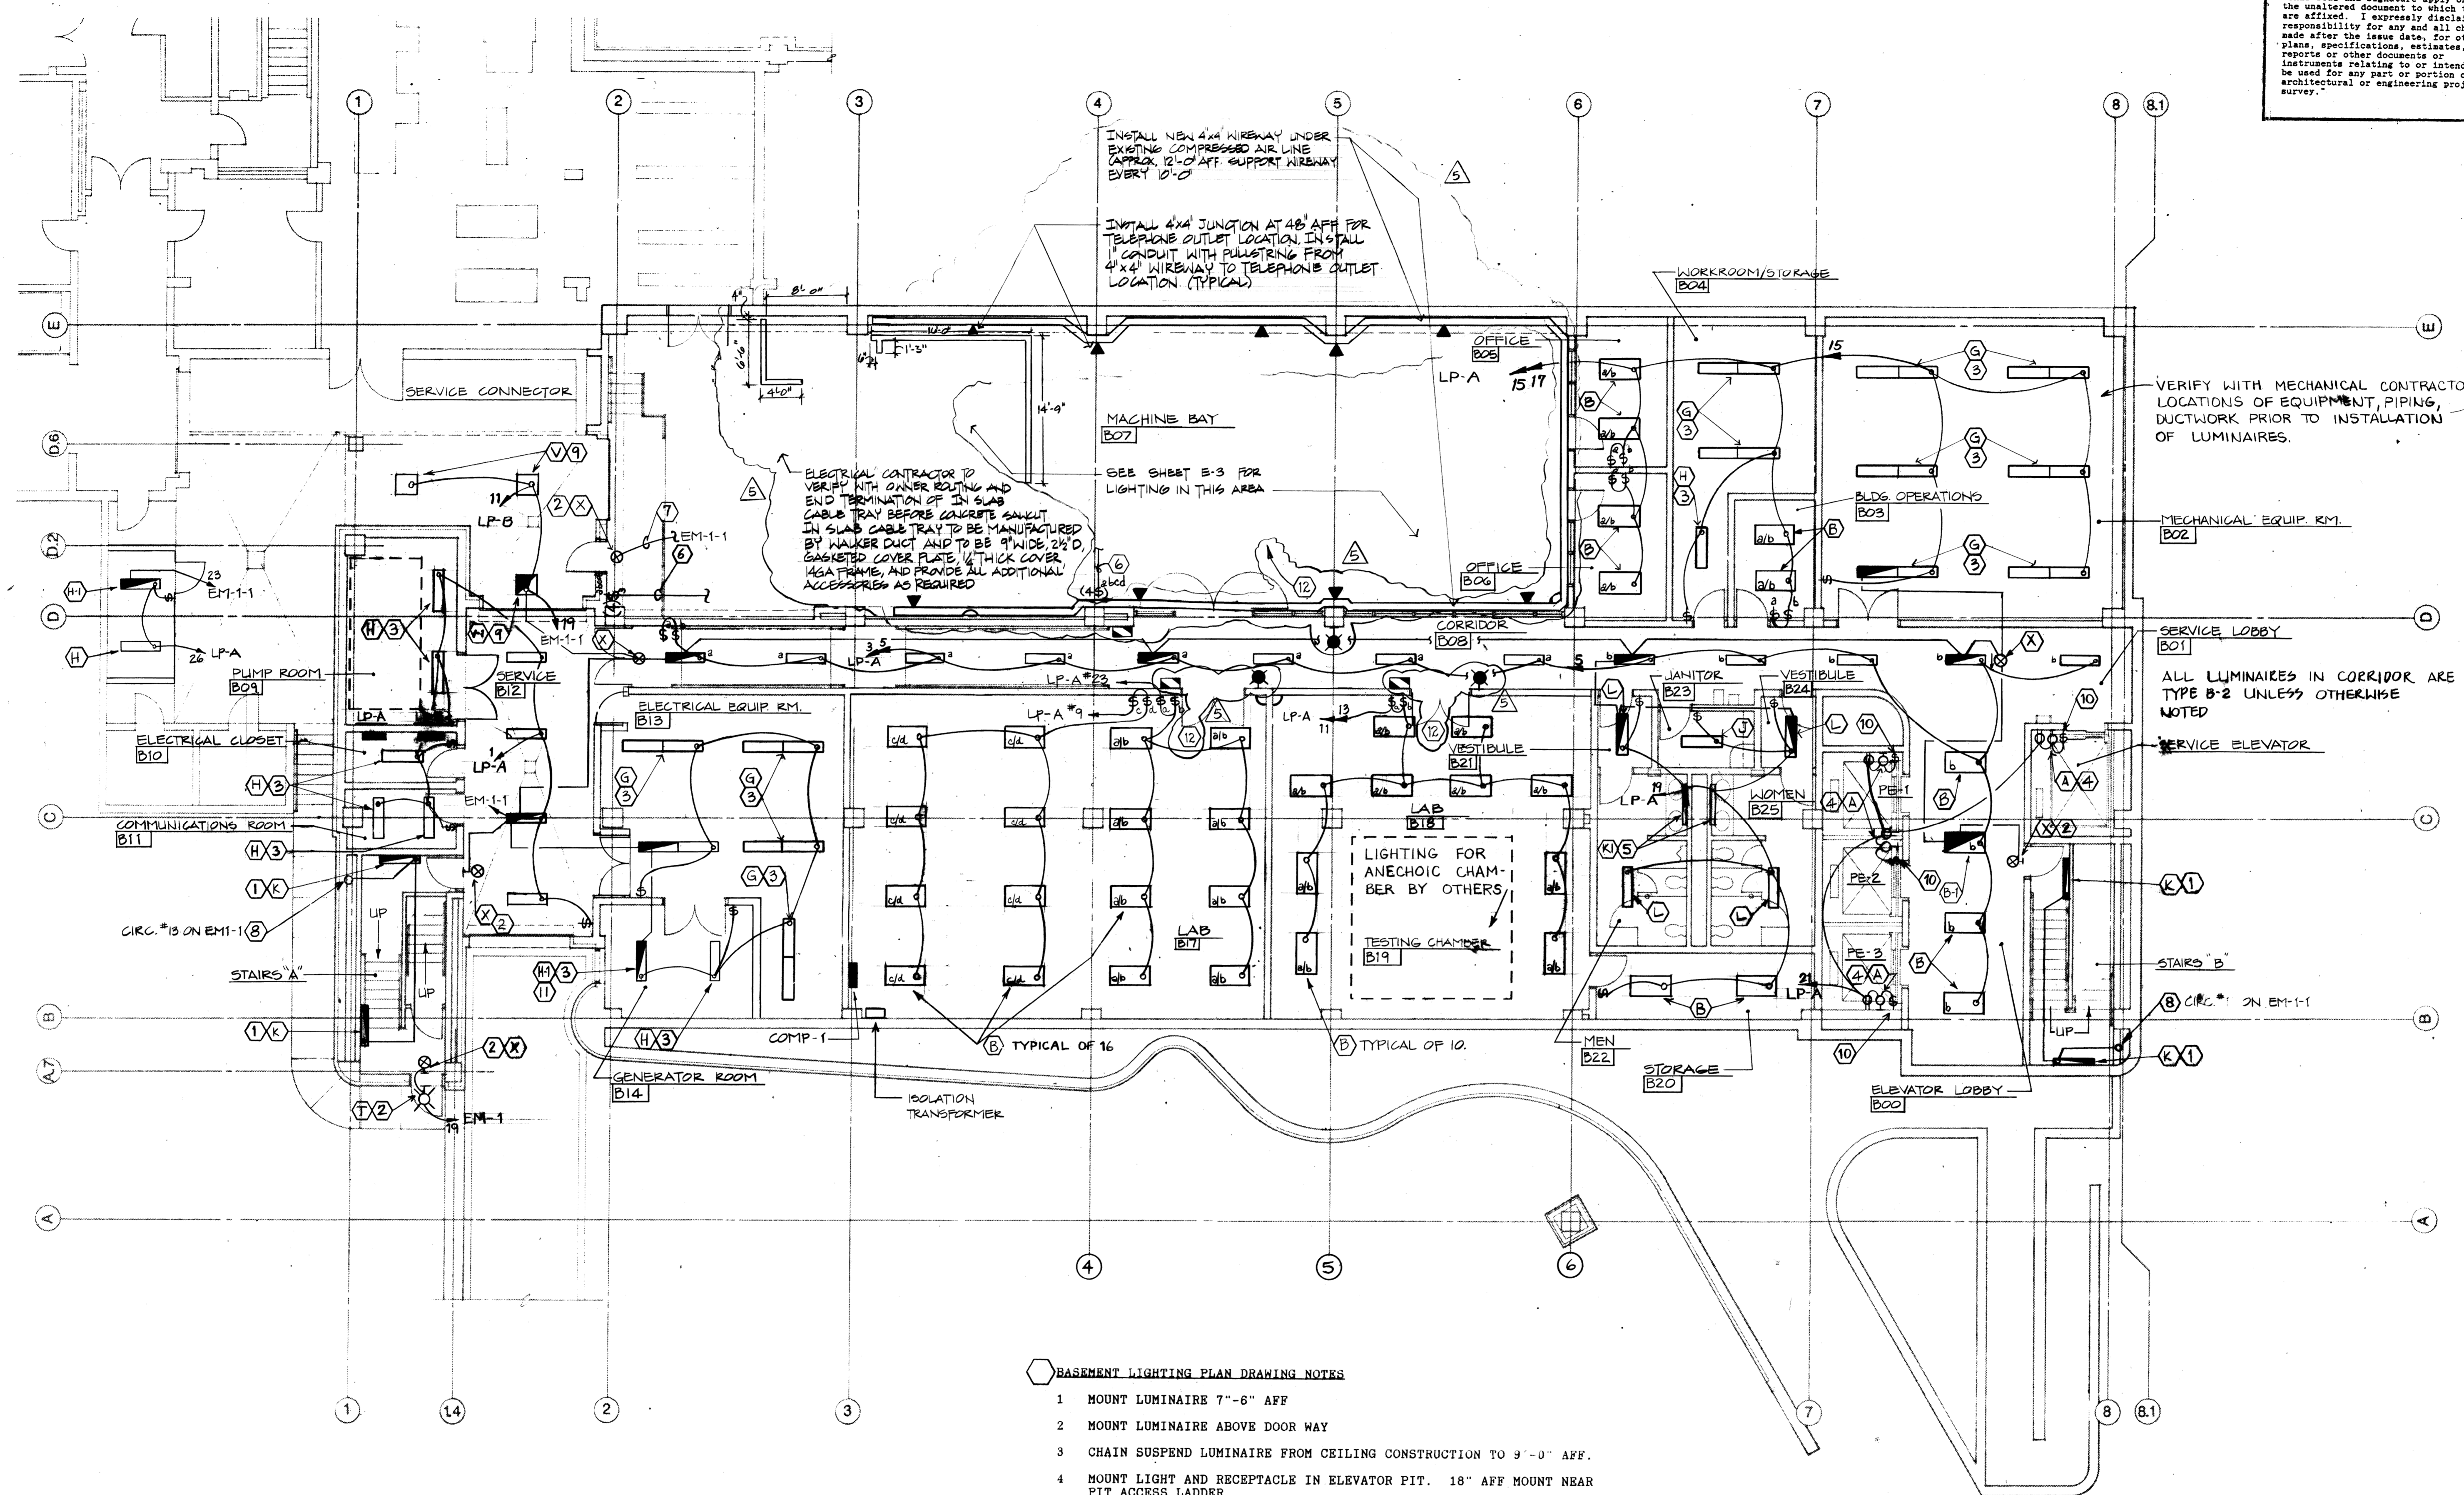


BASEMENT FLOOR PLAN
1/8" = 1'-0"

- BASEMENT LIGHTING PLAN DRAWING NOTES**
- 1 MOUNT LUMINAIRE 7'-6" AFF
 - 2 MOUNT LUMINAIRE ABOVE DOOR WAY
 - 3 CHAIN SUSPEND LUMINAIRE FROM CEILING CONSTRUCTION TO 9'-0" AFF.
 - 4 MOUNT LIGHT AND RECEPTACLE IN ELEVATOR PIT. 18" AFF MOUNT NEAR PIT ACCESS LADDER
 - 5 MOUNT LUMINAIRE DIRECTLY ABOVE MIRROR
 - 6 ROUTE SWITCH LEGS TO LUMINAIRES IN MACHINE BAY. SEE SHEET E-3 FOR LOCATIONS OF LUMINAIRES.
 - 7 CONNECT TO LUMINAIRES ON EMERGENCY CIRCUIT IN MACHINE BAY. SEE SHEET E-3 FOR LOCATION.
 - 8 STAIR POWER RISER. ROUTE UP TO THIRD FLOOR. SEE THIRD FLOOR LIGHTING PLAN FOR CONTINUATION.
 - 9 MOUNT LUMINAIRE TO UNDERSIDE OF PEDWAY CONSTRUCTION
 - 10 MOUNT SWITCH FOR PIT LIGHT 4'-0" ABOVE BASEMENT FLOOR LEVEL
 - 11 CONNECT EMERGENCY BALLAST MOUNTED IN LUMINAIRE TO LINE AHEAD OF ALL SWITCHING.
 - 12 INSTALLER TO PROVIDE MOTION DETECTORS AS REQUIRED IN SECURED ROOM

AS BUILT
3-1-91
BELCAN CORPORATION
10200 ANDERSON WAY
CINCINNATI, OHIO 45242
NUMBER: 4361-CE-001-4

83
84
85
B-1
004967

"This seal and signature apply only to the unaltered document to which they are affixed. I expressly disclaim any responsibility for any and all changes made after the issue date, for other plans, specifications, estimates, reports or other documents or instruments relating to or intended to be used for any part or portion of the architectural or engineering project or survey."

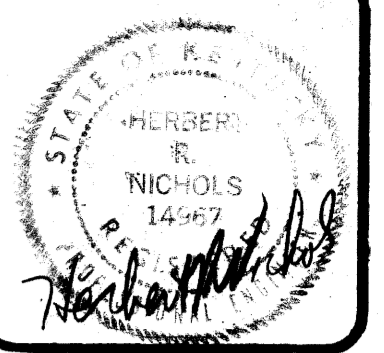

ROBOTICS FACILITY
LEXINGTON CAMPUS
UNIVERSITY OF KENTUCKY
LEXINGTON, KENTUCKY

University of Kentucky
Lexington, Kentucky

Michael S. ...
ARCHITECT


BASEMENT FLOOR POWER PLAN
Sherman Carter Barnhart
PARTNERS IN ARCHITECTURE
SUITE 900 • 250 WEST MAIN STREET • LEXINGTON, KY 40507 • 502-254-1351

JOB NO. 8706
DATE 9-30-87
DRAWN D. MEYER
CHECKED M. GOLDBERG
FILE NO. 421.0

REVISIONS
3-10-87 REVIEW 10-16-87
4- GENERAL 7-18-88
5- REVISION 2-18-91

SHEET


E-2

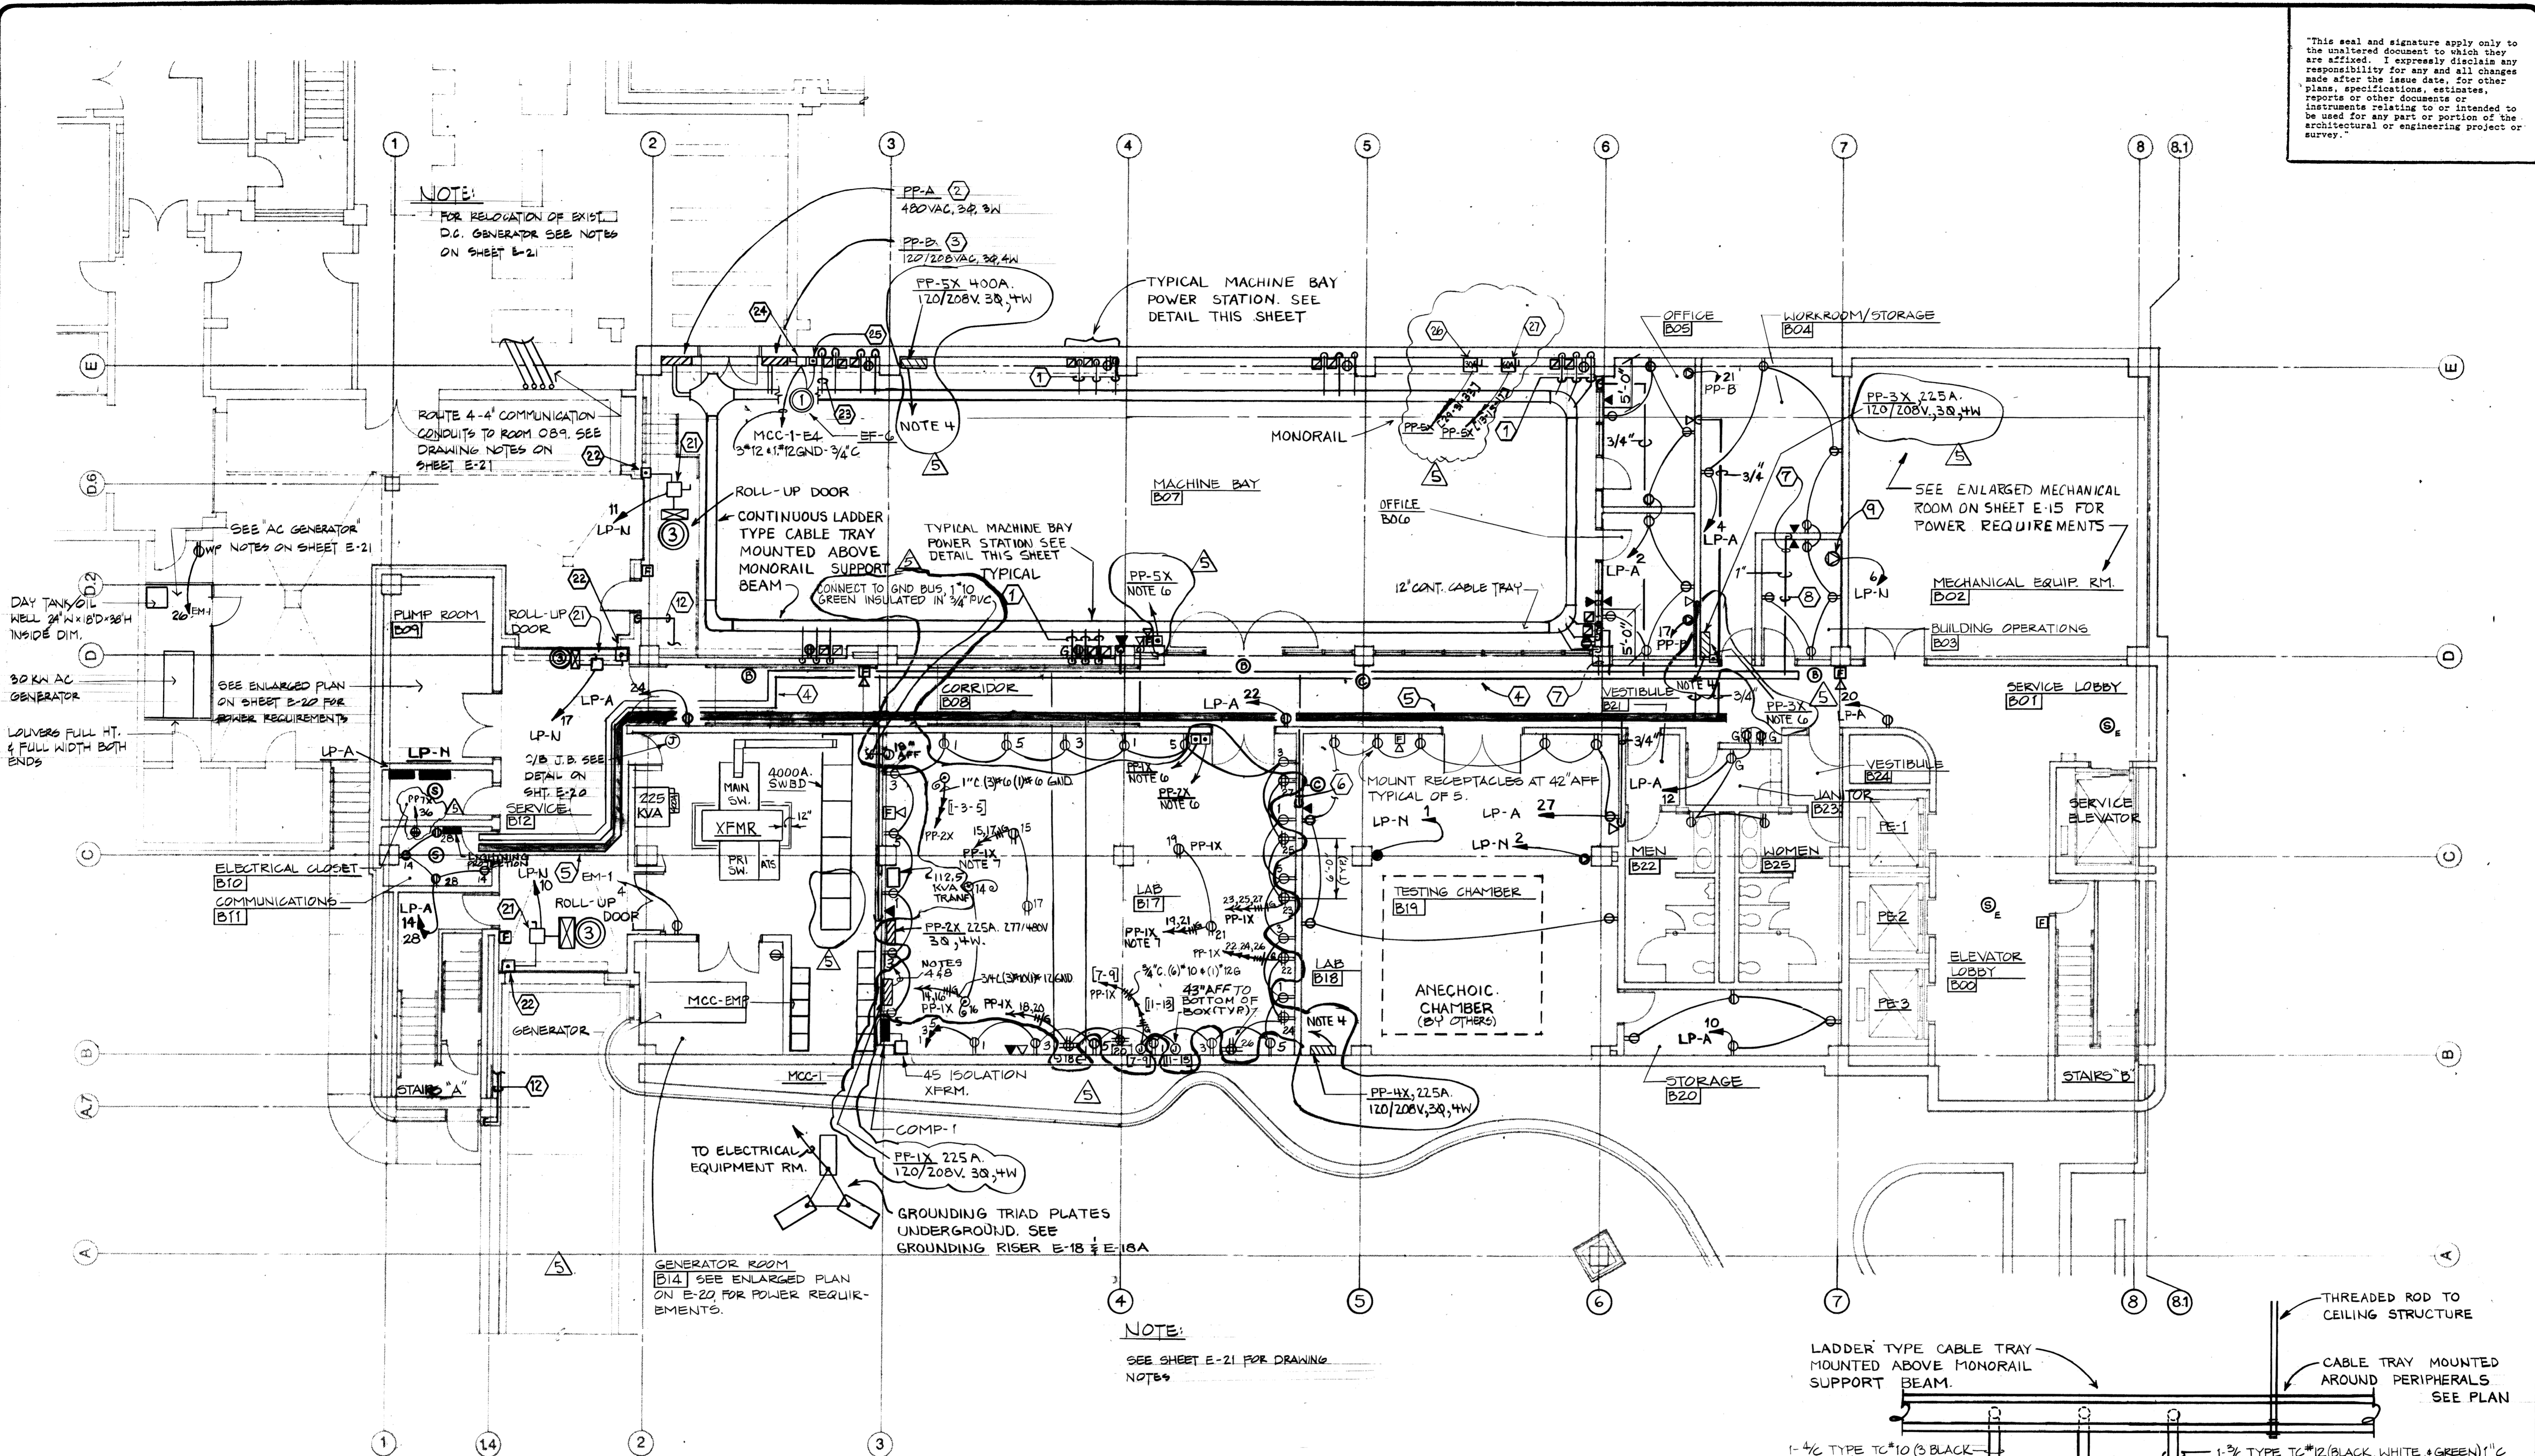

- NOTES**
- ROUTE ALL PROGRAMMED BELLS ON BASEMENT, 1ST, & 2ND FLOORS ON COMMON CIRCUIT TO C/B JUNCTION BOX LOCATED IN ELECTRICAL EQUIPMENT ROOM IN BASEMENT. ROUTE ALL BELLS TO CIRCUIT LP-A-16.
 - ROUTE ALL CLOCKS ON BASEMENT, 1ST, & 2ND FLOORS ON COMMON CIRCUIT TO C/B JUNCTION BOX LOCATED IN ELECTRICAL EQUIPMENT ROOM IN BASEMENT. ROUTE ALL CLOCKS TO CIRCUIT LP-A-18.
 - FOR WIRING OF FIRE ALARM SYSTEM AND COMPONENTS SEE FIRE ALARM RISER DIAGRAM ON SHEET E-19.
 - CONTRACTOR TO ROUTE CONDUIT AS REQUIRED. FOR CONDUIT SIZES & CONDUIT SIZES SEE DWG. E-23 (TYP.)


- BASEMENT FLOOR PLAN**
1/8" = 1'-0"
- FOR PANELS PP-6X PP-7X PP-8X ROUTE CONDUITS THROUGH VERTICAL CHASE IN ELECTRICAL CLOSETS. (SEE DWGS E4 & E-10)
 - PROVIDE RED MUSHROOM PUSH BUTTON (MOMENTARY CONTACT) STATION FOR POWER PANELS SHUNT TRIP. (3/4" C. 2 #14, 1" 12 GND - TYPICAL) MFG HT 72" AFF PROVIDE CLEAR, PLASTIC HINGED SAFETY COVER BOX ENVELOPING PUSHBUTTON STATION.
 - MOUNT RECEPTACLE 7'-0" AFF FROM FLEX CONDUIT THRU CEILING
 - TRANSFER LOADS FROM CKT'S 2,4,6 FROM EXISTING PANEL COMP-1 TO CKT'S 31,33,35 IN PANEL PP-1X

NOTE:
SEE SHEET E-21 FOR DRAWING NOTES

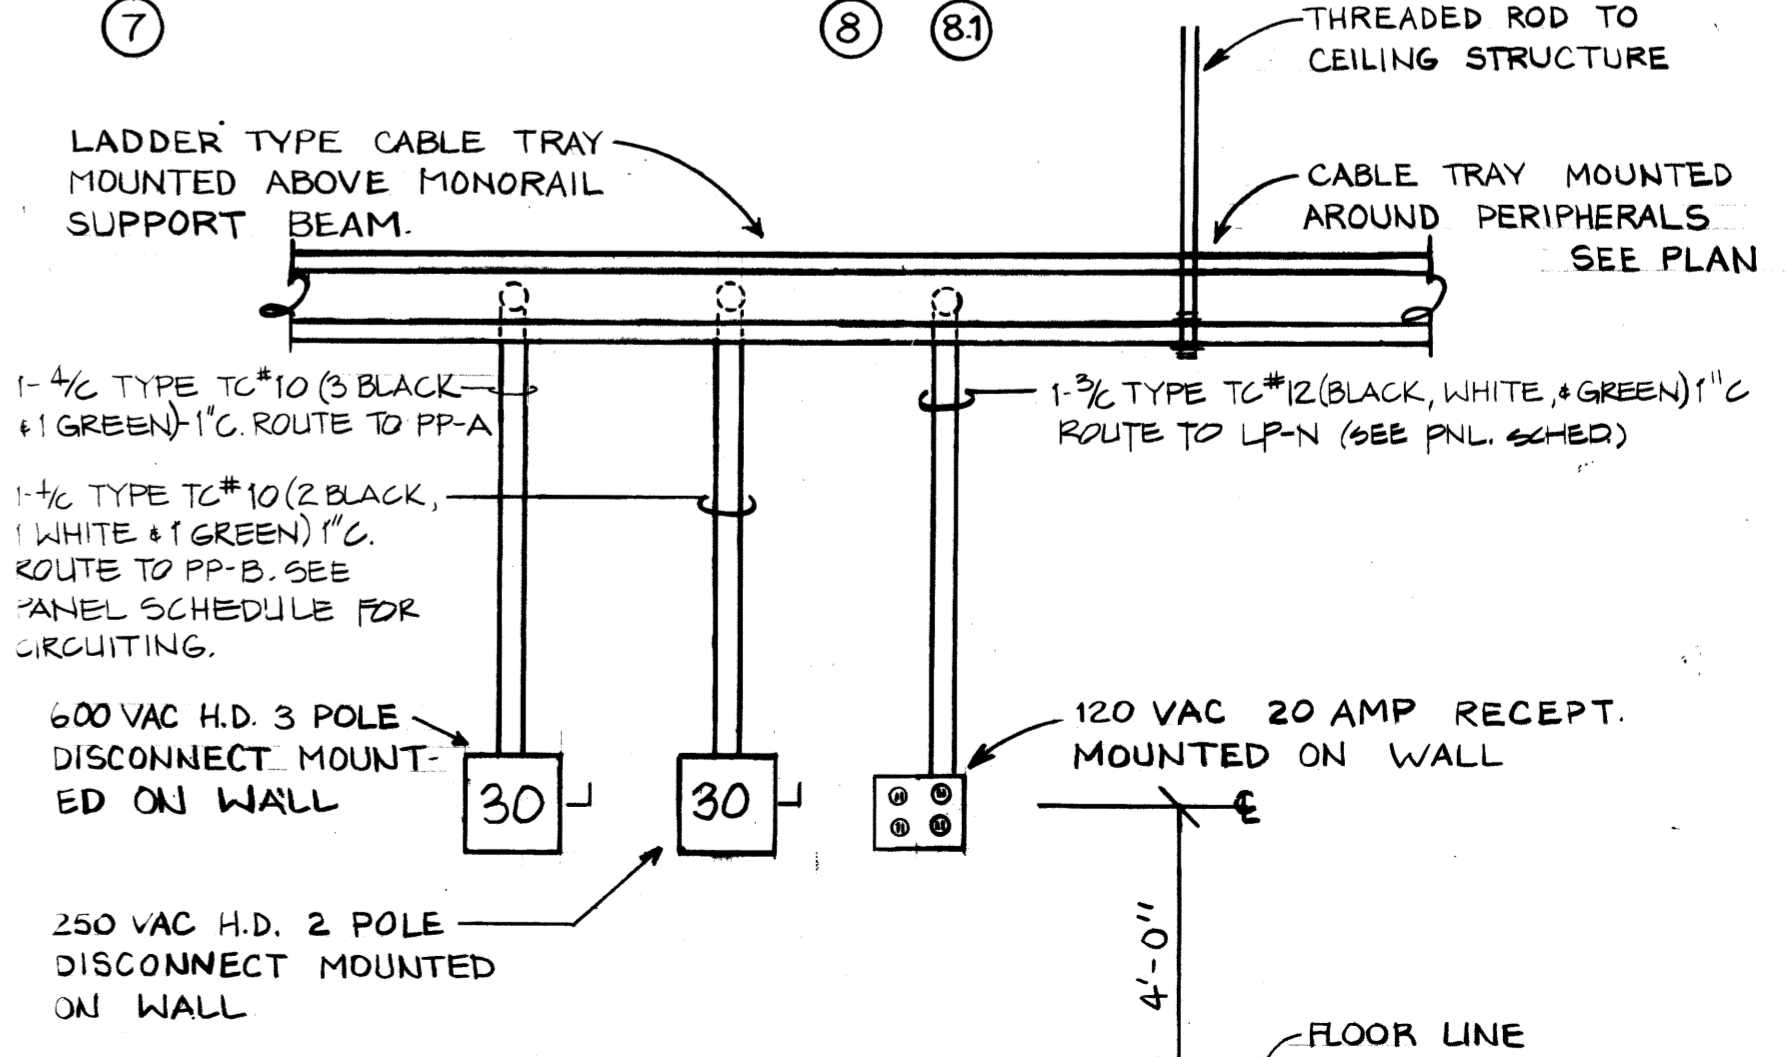

AS BUILT
BELCAN CORPORATION
10200 ANDERSON WAY
CINCINNATI, OHIO 45242
NUMBER: 4361-CE-002-4

"This seal and signature apply only to the unaltered document to which they are affixed. I expressly disclaim any responsibility for any and all changes made after the issue date, for other plans, specifications, estimates or reports or other documents or instruments relating to or intended to be used for any part or portion of the architectural or engineering project or survey."

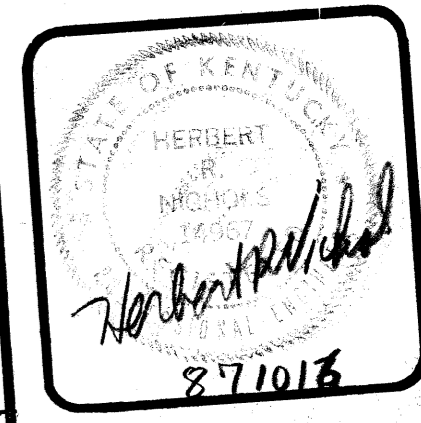

ROBOTICS FACILITY
LEXINGTON CAMPUS
UNIVERSITY OF KENTUCKY
LEXINGTON, KENTUCKY


University of Kentucky
Lexington, Kentucky
10-19-87
DATE

FIRST FLOOR LIGHTING PLAN
Sturman-Carter-Barnhart
ARCHITECTURE

JOB NO. 8706
DATE 9-30-87
DRAWN D. MEYER
CHECKED M. G...
IN FILE NO. 431C


REVISIONS
3-90% REVIEW
4- GENERAL
5- RENOVATION

SHEET
E.

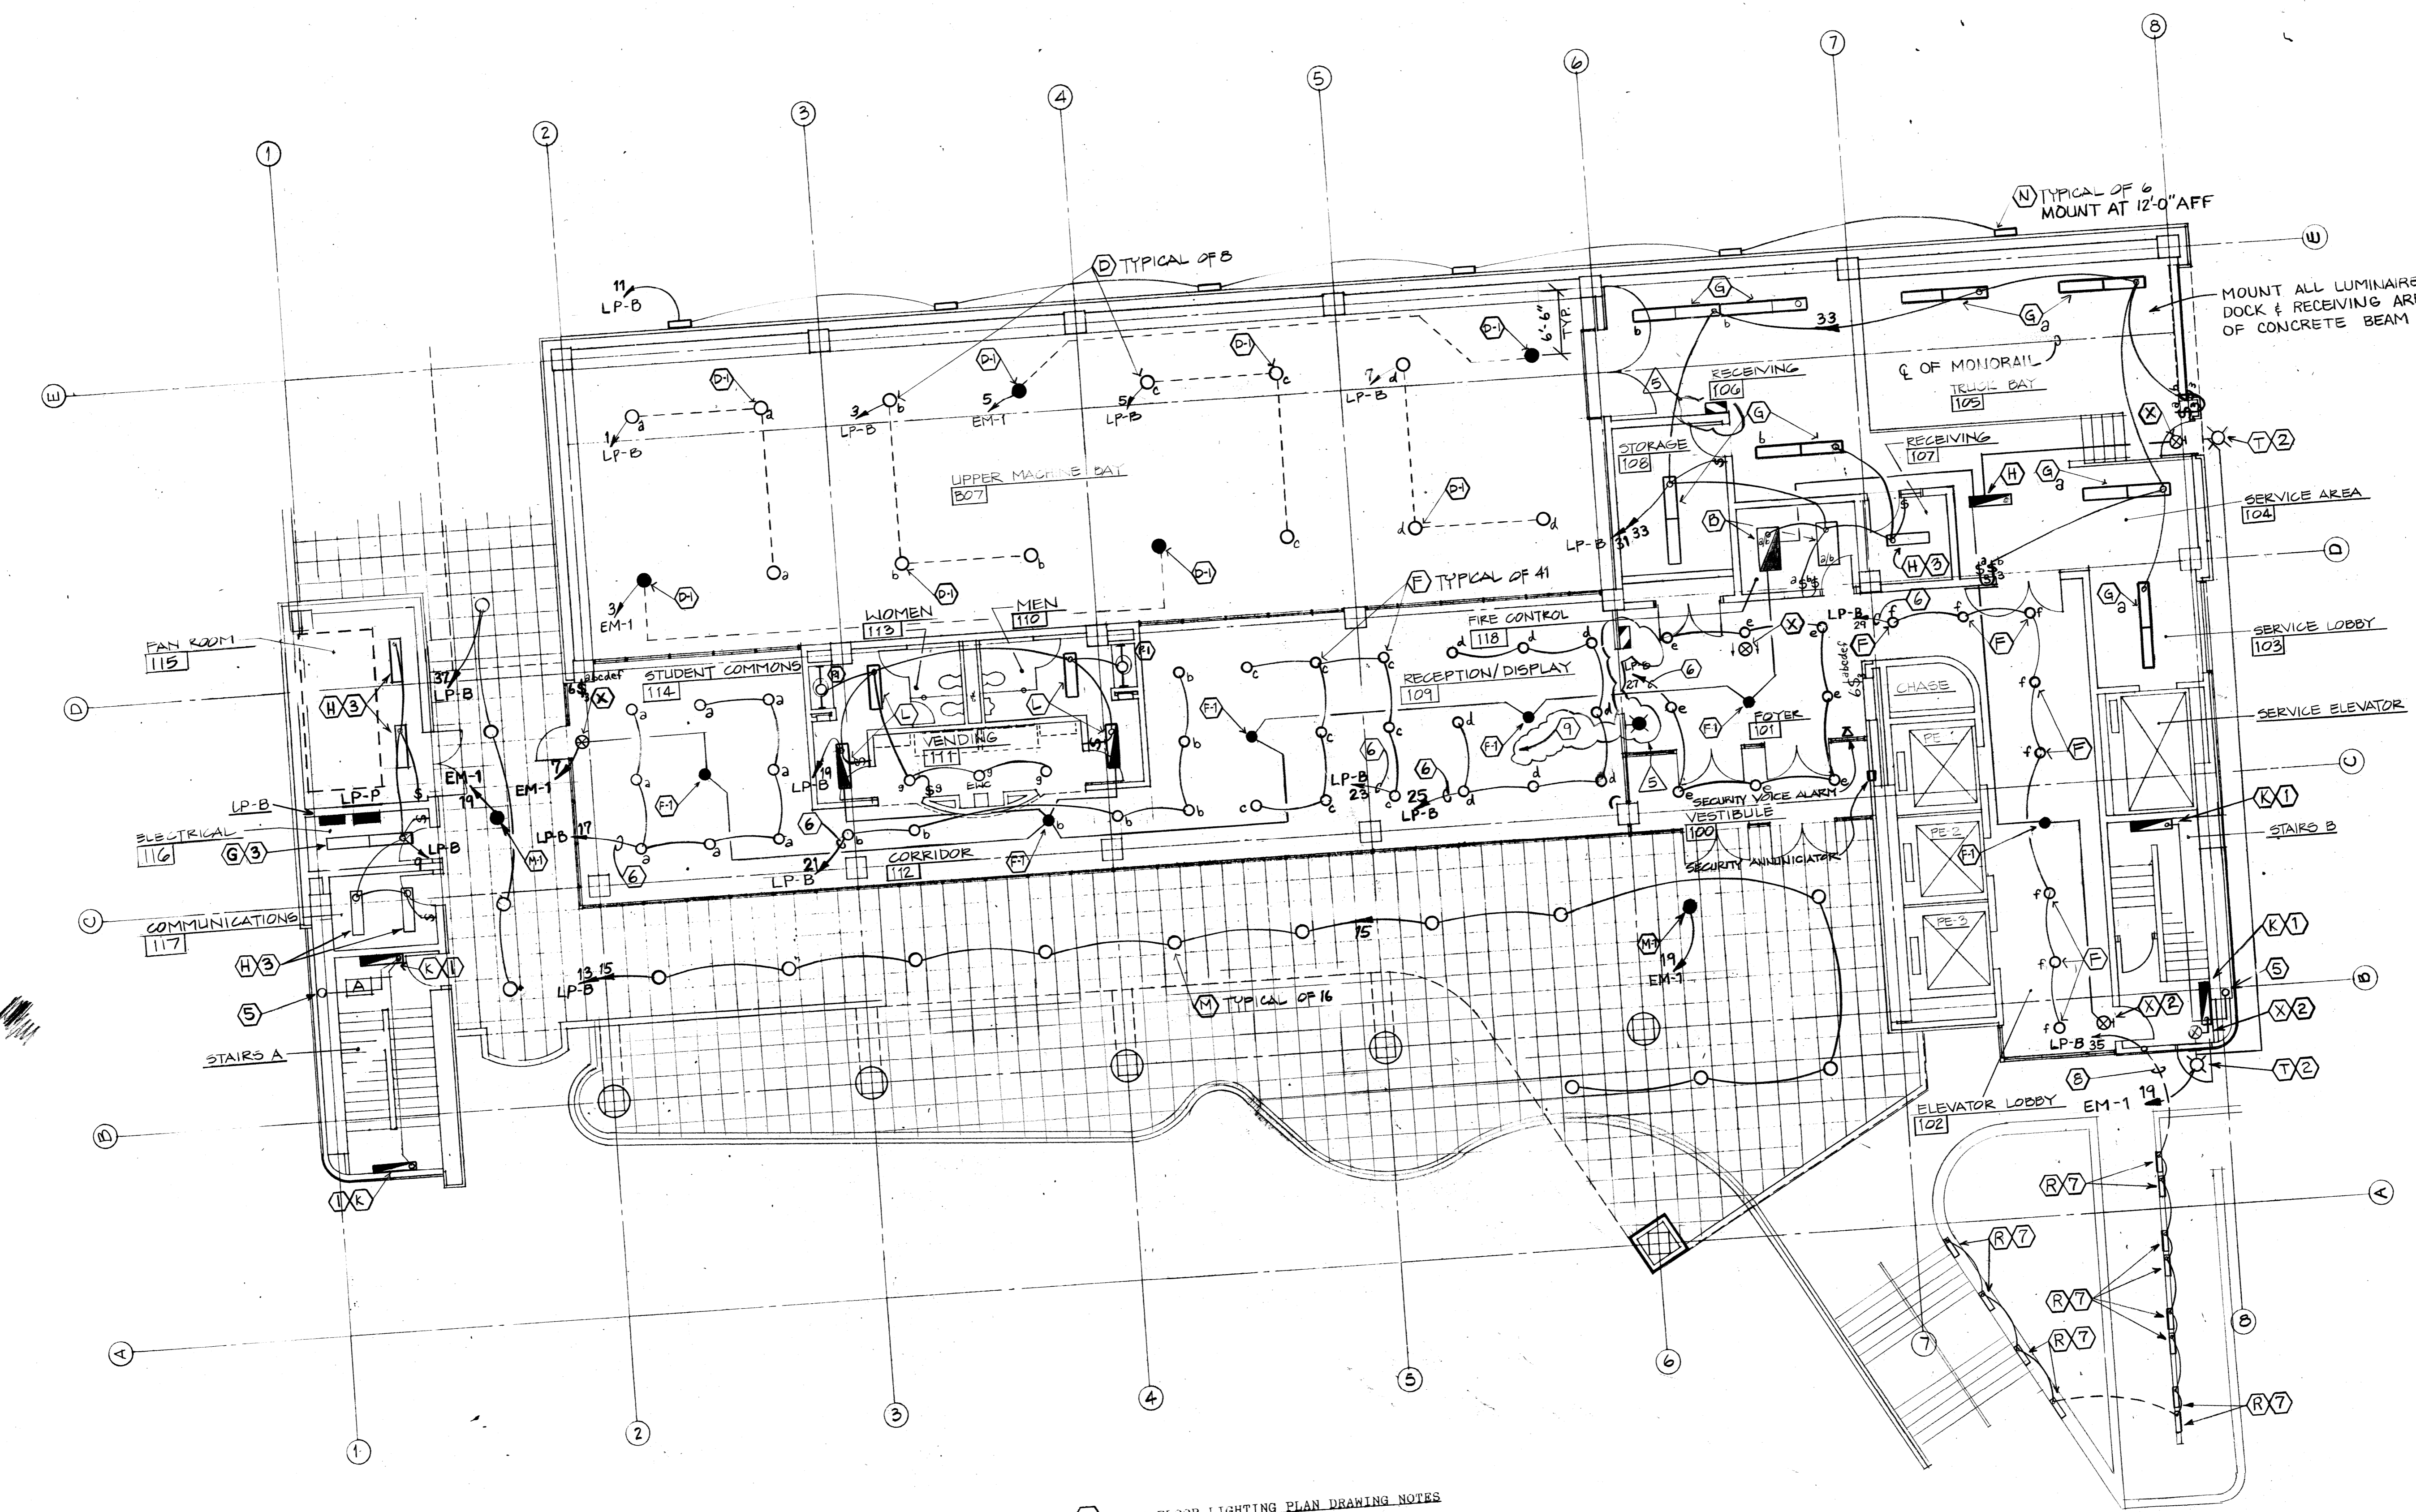


- FIRST FLOOR LIGHTING PLAN DRAWING NOTES**
- 1 MOUNT LUMINAIRE 7'-6" AFF
 - 2 MOUNT LUMINAIRE ABOVE DOOR WAY
 - 3 CHAIN SUSPEND LUMINAIRE FROM CEILING CONSTRUCTION TO 9'-0" AFF
 - 4 NOT USED
 - 5 STAIRWAY LIGHTING POWER RISER. ROUTE UP TO SECOND FLOOR. SEE SECOND FLOOR LIGHTING PLAN.
 - 6 ROUTE TO CIRCUIT INDICATED VIA SWITCHING BANK. CONNECT TO SWITCH INDICATED.
 - 7 MOUNT LUMINAIRE 2'-6" ABOVE CONCRETE.
 - 8 ROUTE FEEDER UNDER PAVED WALKWAY AND TURN UP IN WALL TO ABOVE CEILING SPACE FOR HOMERUN BACK TO PANEL.
 - 9 INSTALLER TO PROVIDE MOTION DETECTORS AS REQUIRED IN SECURED ROOM

FIRST FLOOR PLAN
SCALE: 1/8" = 1'-0"

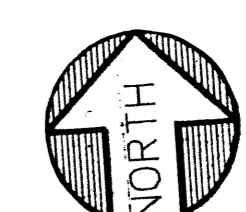

AS BUILT
3-1-91
BELCAN CORPORATION
10200 ANDERSON WAY
CINCINNATI, OHIO 45242
NUMBER: 436 CE-023-A

This seal and signature apply only to the unaltered document to which they are affixed. I expressly disclaim any responsibility for any and all changes made after the issue date, for other plans, specifications, estimates, reports or other documents or instruments relating to or intended to be used for any part or portion of the architectural or engineering project or survey.

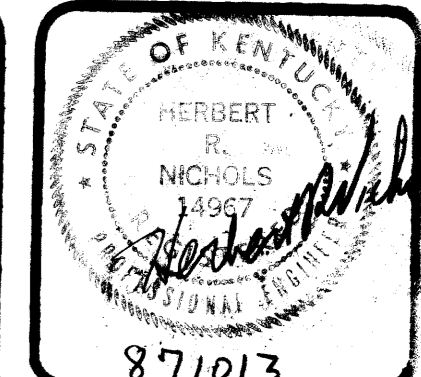

ROBOTICS FACILITY
LEXINGTON CAMPUS
UNIVERSITY OF KENTUCKY
LEXINGTON, KENTUCKY

University of Kentucky
Lexington, Kentucky
10-19-87
Walter B. Bunn
ARCHITECT


FIRST FLOOR POWER PLAN
Sherman Carter Barnhart
PARTNERS IN ARCHITECTURE
SUITE 1900 • 250 WEST MAIN STREET • LEXINGTON, KY 40507 • 505-254-1351

JOB NO. 8706
DATE 9-30-87
DRAWN D.M.E.Y.E.
CHECKED N.GOLDBERG
FILE NO. 4310

REVISIONS
3-90% REVIEW 10-14-87
4-GENERAL 7-18-88
5-REVISION 2-16-90

SHEET

E-4

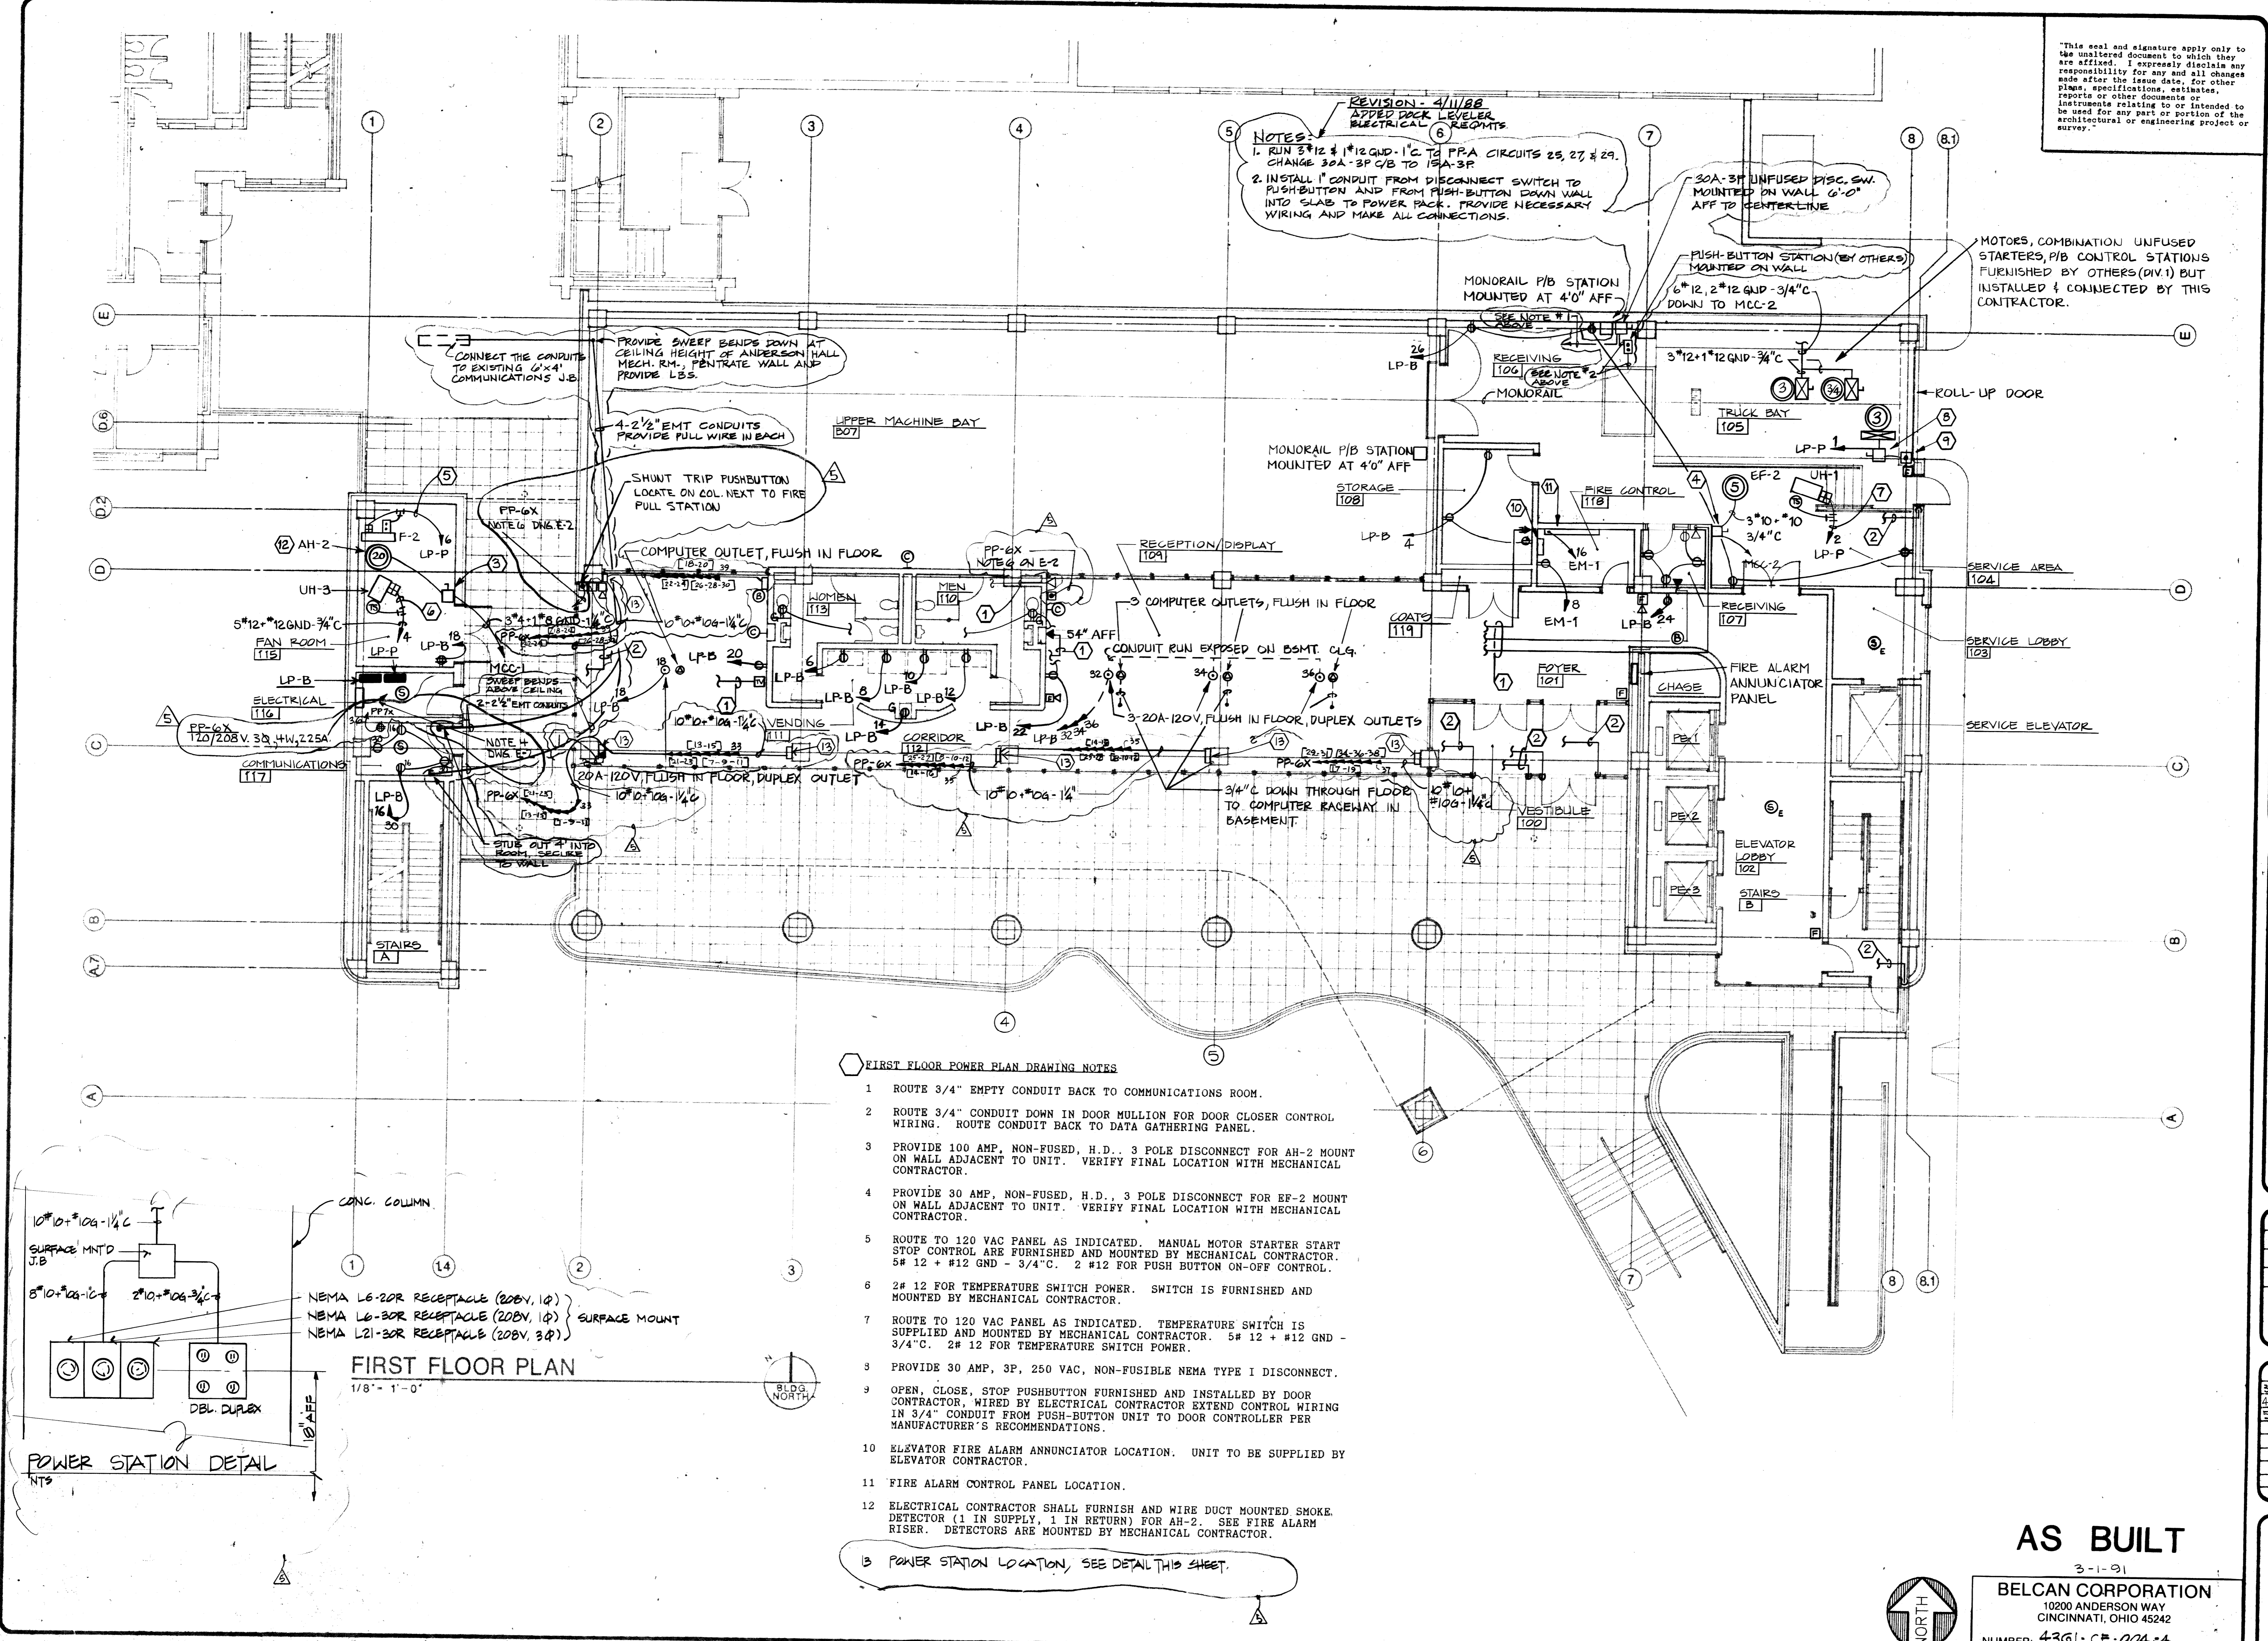

NOTES
REVISION - 4/11/88
ADDED DOOR CLOSER ELECTRICAL REQUIREMENTS
1. RUN 3/4" x 1/2" GND - 1/4" TO PPA CIRCUITS 25, 27, & 29. CHANGE 30A-3P C/B TO 15A-3P.
2. INSTALL 1" CONDUIT FROM DISCONNECT SWITCH TO PUSH-BUTTON AND FROM PUSH-BUTTON DOWN WALL INTO SLAB TO POWER PACK. PROVIDE NECESSARY WIRING AND MAKE ALL CONNECTIONS.

30A-3P UNFUSED DISC. SW. MOUNTED ON WALL 6'-0" AFF TO CENTERLINE

PUSH-BUTTON STATION (BY OTHERS) MOUNTED ON WALL 6'-0" DOWN TO MCC-2

MOTORS, COMBINATION UNFUSED STARTERS, P/B CONTROL STATIONS FURNISHED BY OTHERS (DIV.1) BUT INSTALLED & CONNECTED BY THIS CONTRACTOR.

CONNECT THE CONDUITS TO EXISTING 6"x4" COMMUNICATIONS J.B.
PROVIDE SWEEP BENDS DOWN AT CEILING HEIGHT OF ANDERSON HALL MECH. RM., PENETRATE WALL AND PROVIDE LBS.

4-2 1/2" EMT CONDUITS PROVIDE PULL WIRE IN EACH

SHUNT TRIP PUSHBUTTON LOCATE ON COL. NEXT TO FIRE PULL STATION

COMPUTER OUTLET, FLUSH IN FLOOR

RECEPTION/DISPLAY

MONORAIL P/B STATION MOUNTED AT 4'-0" AFF

RECEIVING 100 (SEE NOTE #2 ABOVE) MONORAIL

3" x 12" x 1/2" GND - 3/4" C

ROLL-UP DOOR

TRUCK BAY 105

LP-P 1

EF-2

UH-1

LP-P 2

LP-P 3

RECEIVING 107

EM-1

LP-B 24

FOYER 101

CHASE

PE-1

PE-2

PE-3

ELEVATOR LOBBY 102

STAIRS B

STAIRS C

STAIRS D

STAIRS E

STAIRS F

STAIRS G

STAIRS H

STAIRS I

STAIRS J

STAIRS K

STAIRS L

STAIRS M

STAIRS N

STAIRS O

STAIRS P

STAIRS Q

STAIRS R

STAIRS S

STAIRS T


STAIRS U

STAIRS V

FIRST FLOOR POWER PLAN DRAWING NOTES

- ROUTE 3/4" EMPTY CONDUIT BACK TO COMMUNICATIONS ROOM.
- ROUTE 3/4" CONDUIT DOWN IN DOOR MULLION FOR DOOR CLOSER CONTROL WIRING. ROUTE CONDUIT BACK TO DATA GATHERING PANEL.
- PROVIDE 100 AMP, NON-FUSED, H.D., 3 POLE DISCONNECT FOR AH-2 MOUNT ON WALL ADJACENT TO UNIT. VERIFY FINAL LOCATION WITH MECHANICAL CONTRACTOR.
- PROVIDE 30 AMP, NON-FUSED, H.D., 3 POLE DISCONNECT FOR EF-2 MOUNT ON WALL ADJACENT TO UNIT. VERIFY FINAL LOCATION WITH MECHANICAL CONTRACTOR.
- ROUTE TO 120 VAC PANEL AS INDICATED. MANUAL MOTOR STARTER START STOP CONTROL ARE FURNISHED AND MOUNTED BY MECHANICAL CONTRACTOR. 5# 12 + #12 GND - 3/4" C. 2 #12 FOR PUSH BUTTON ON-OFF CONTROL.
- 2# 12 FOR TEMPERATURE SWITCH POWER. SWITCH IS FURNISHED AND MOUNTED BY MECHANICAL CONTRACTOR.
- ROUTE TO 120 VAC PANEL AS INDICATED. TEMPERATURE SWITCH IS SUPPLIED AND MOUNTED BY MECHANICAL CONTRACTOR. 5# 12 + #12 GND - 3/4" C. 2# 12 FOR TEMPERATURE SWITCH POWER.
- PROVIDE 30 AMP, 3P, 250 VAC, NON-FUSIBLE NEMA TYPE I DISCONNECT.
- OPEN, CLOSE, STOP PUSHBUTTON FURNISHED AND INSTALLED BY DOOR CONTRACTOR, WIRED BY ELECTRICAL CONTRACTOR EXTEND CONTROL WIRING IN 3/4" CONDUIT FROM PUSH-BUTTON UNIT TO DOOR CONTROLLER PER MANUFACTURER'S RECOMMENDATIONS.
- ELEVATOR FIRE ALARM ANNUNCIATOR LOCATION. UNIT TO BE SUPPLIED BY ELEVATOR CONTRACTOR.
- FIRE ALARM CONTROL PANEL LOCATION.
- ELECTRICAL CONTRACTOR SHALL FURNISH AND WIRE DUCT MOUNTED SMOKE DETECTOR (1 IN SUPPLY, 1 IN RETURN) FOR AH-2. SEE FIRE ALARM RISER. DETECTORS ARE MOUNTED BY MECHANICAL CONTRACTOR.


B POWER STATION LOCATION, SEE DETAIL THIS SHEET.

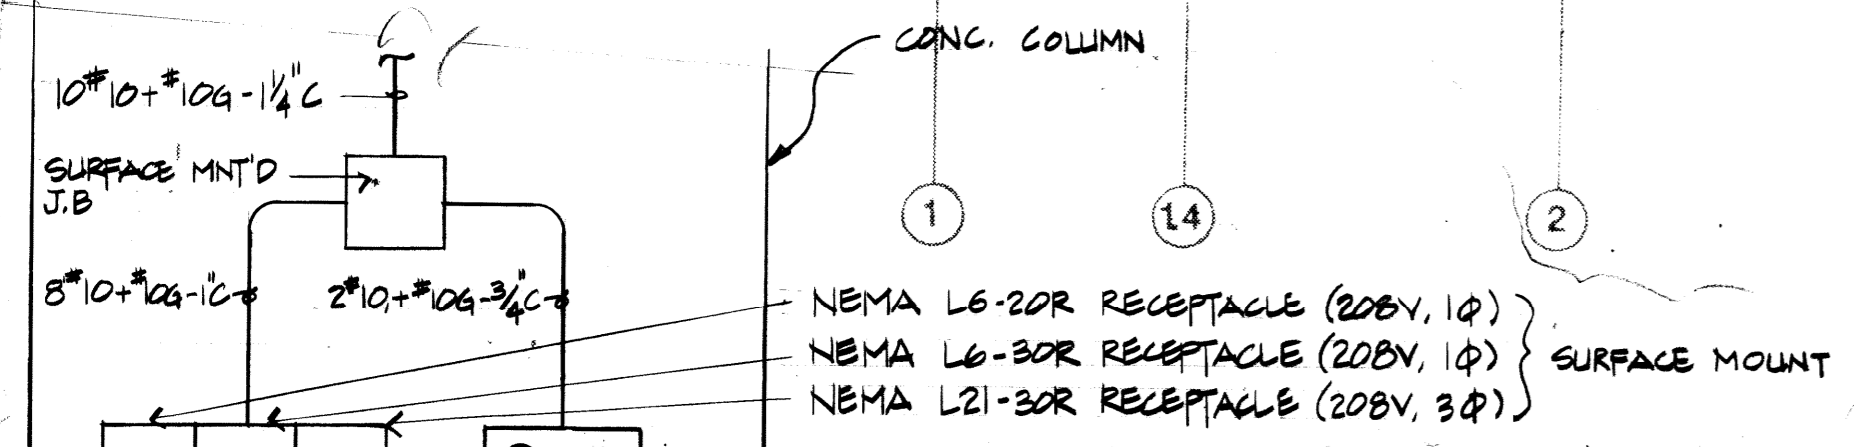

FIRST FLOOR PLAN
1/8" = 1'-0"




AS BUILT
3-1-91
BELCAN CORPORATION
10200 ANDERSON WAY
CINCINNATI, OHIO 45242
NUMBER: 4361-CE-004-4

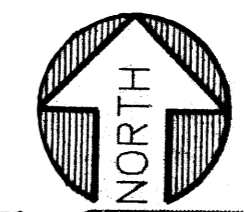

Sheet B-1 004970

"This seal and signature apply only to the unaltered document to which they are affixed. I expressly disclaim any responsibility for any and all changes made after the issue date, for other plans, specifications, estimates, reports or other documents or instruments relating to or intended to be used for any part, or portion of the architectural or engineering project or survey."

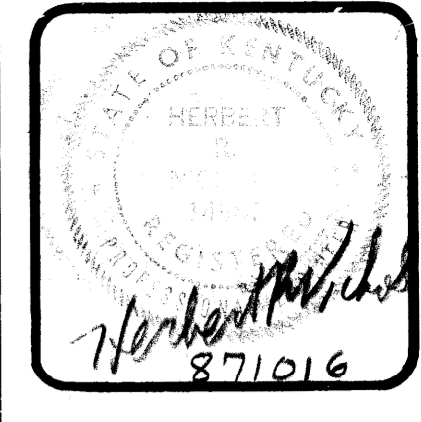

ROBOTICS FACILITY
LEXINGTON CAMPUS
UNIVERSITY OF KENTUCKY
LEXINGTON, KENTUCKY


University of Kentucky
Lexington, Kentucky
10-19-87
NORMAN BUNNING
director, design and construction division

2ND FLOOR LIGHTING PLAN
Sherman-Carter-Barnhart
PARTNERS IN ARCHITECTURE
SUITE 1900 • 250 WEST MAIN STREET • LEXINGTON, KY 40507 • 606-754-1351

JOB NO. 8706
DATE 9-30-87
DRAWN D. MEYER
CHECKED M. EPUBBERG
REV. FILE NO. 431.0

REVISIONS
3-78% REVIEW 10-16-87
4-GENERAL 7-18-88
5-RENOVATION 2-16-90

SHEET
E-5
83
004971

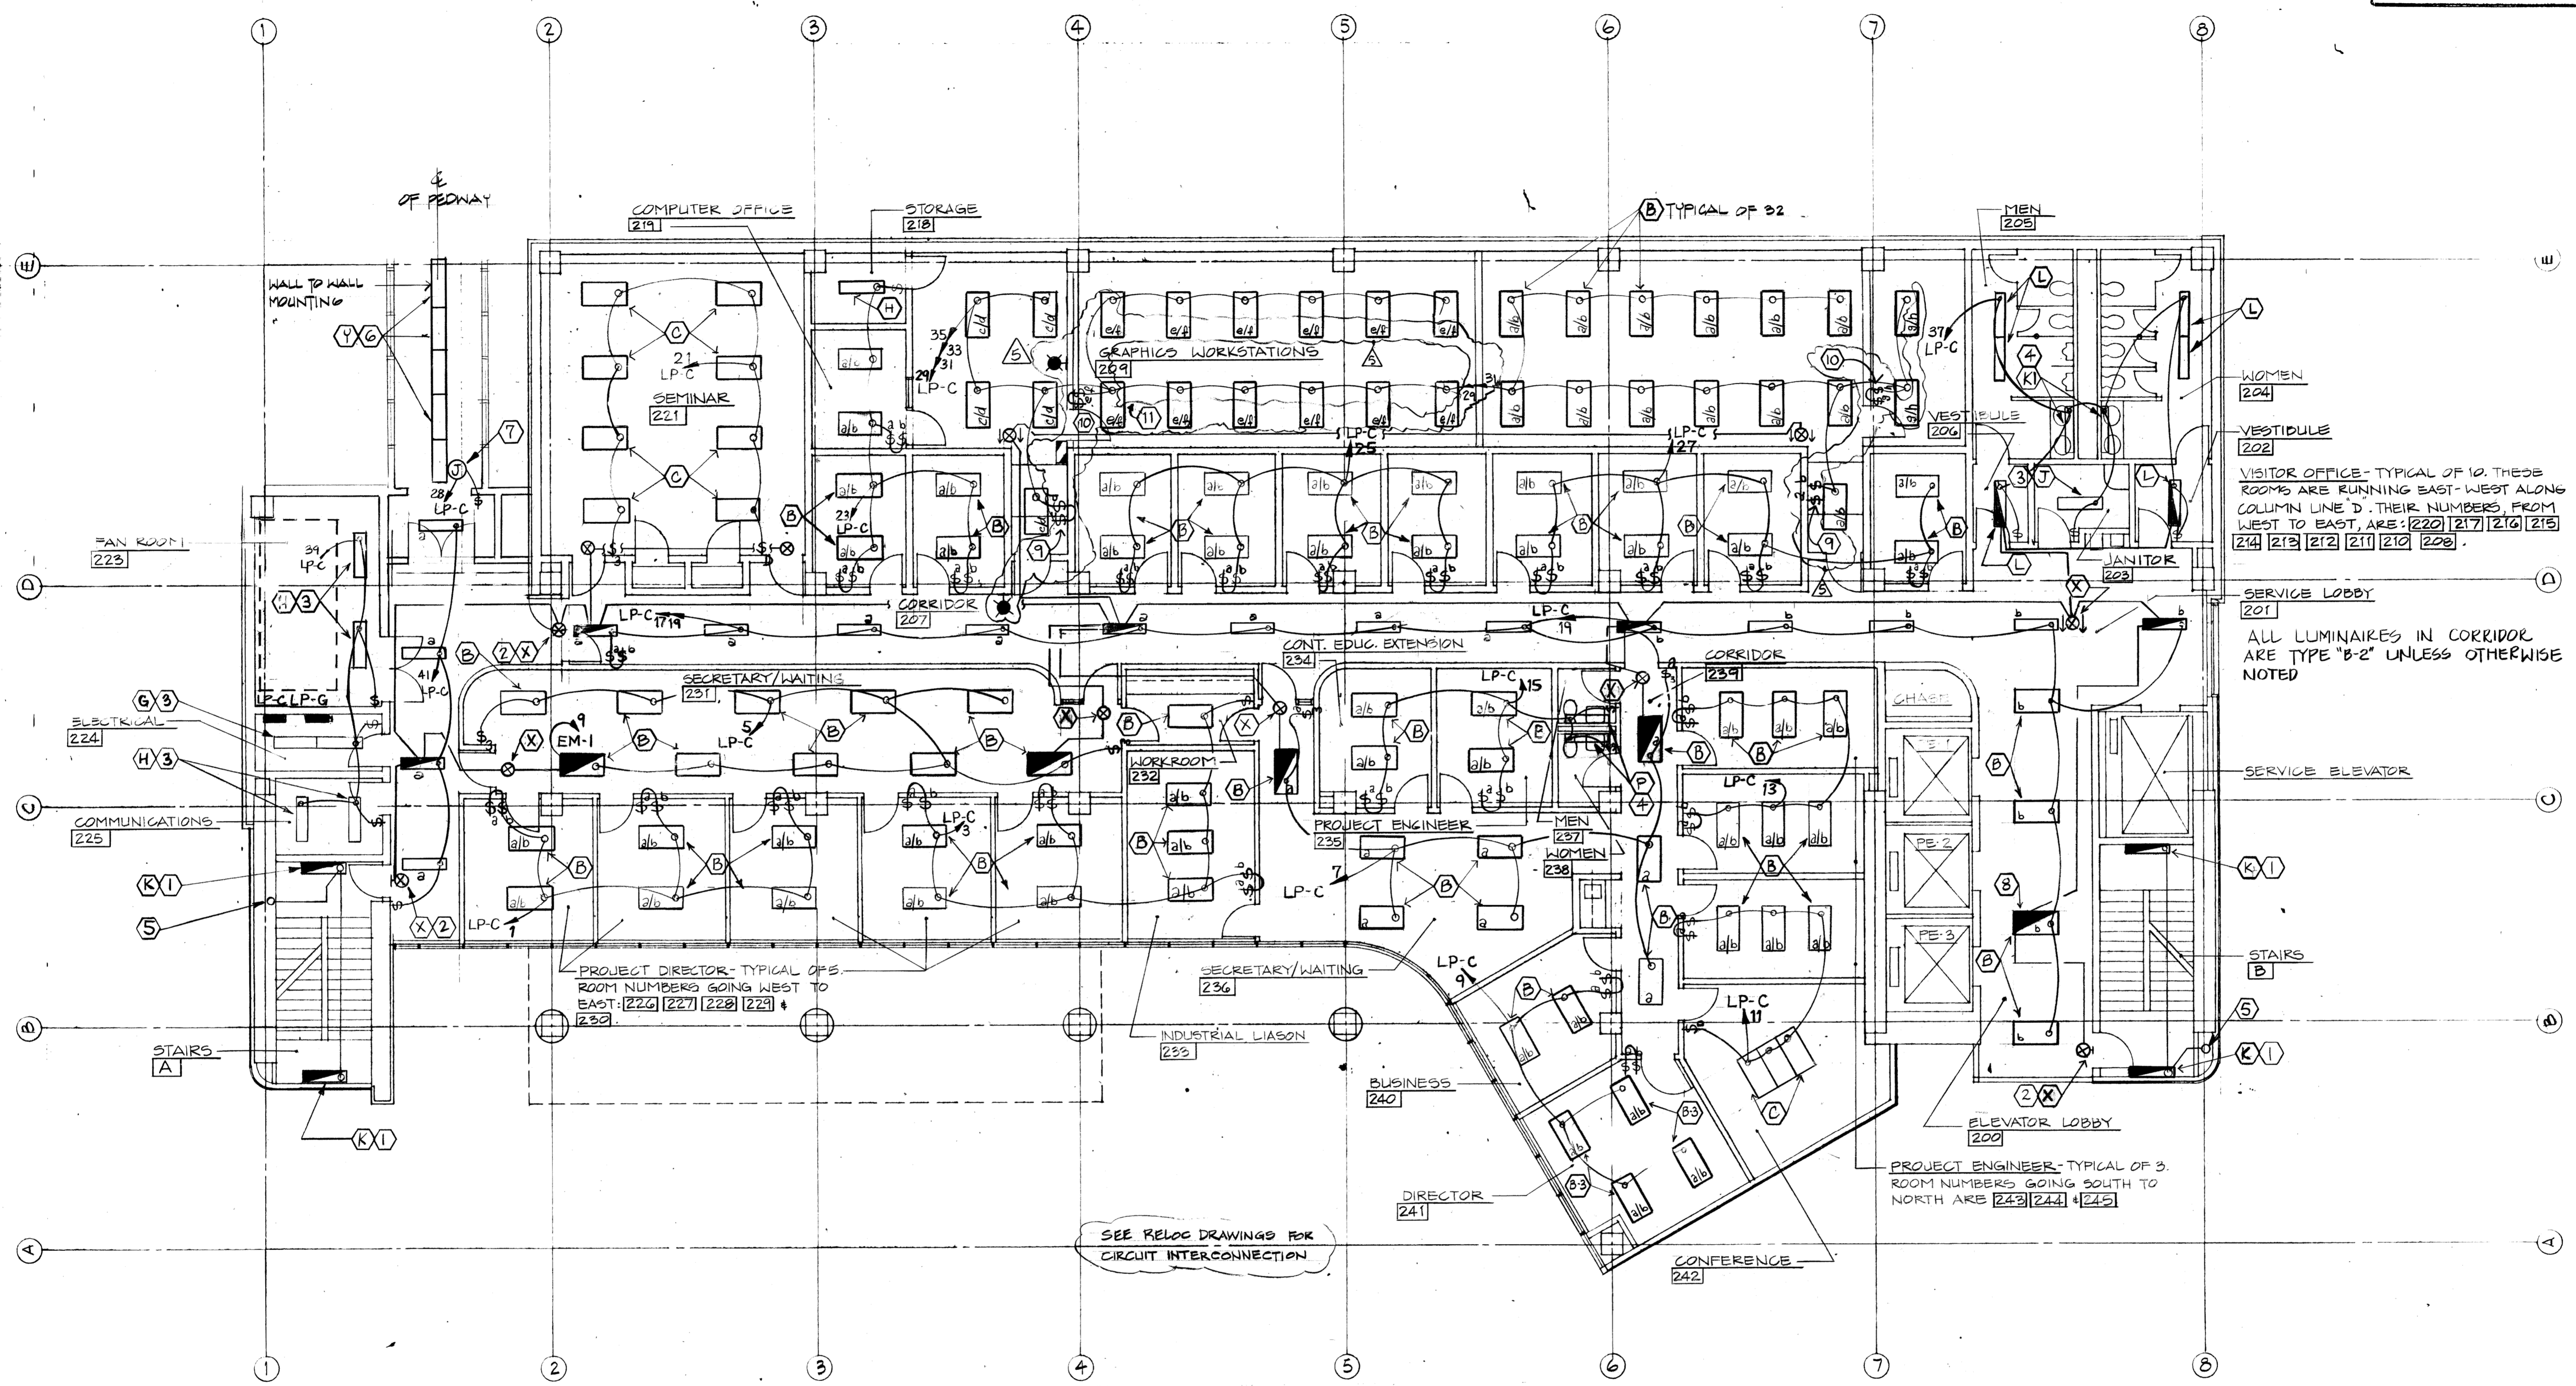



SECOND FLOOR PLAN
SCALE: 1/8" = 1'-0"

- SECOND FLOOR LIGHTING PLAN DRAWING NOTES**
- 1 MOUNT LUMINAIRE 7'-6" AFF.
 - 2 MOUNT LUMINAIRE ABOVE DOORWAY.
 - 3 CHAIN SUSPEND LUMINAIRE FROM CEILING CONSTRUCTION TO 9'-0" AFF.
 - 4 MOUNT LUMINAIRE DIRECTLY ABOVE MIRROR.
 - 5 STAIRWELL LIGHTING POWER RISER ROUTE UP TO THIRD FLOOR. SEE THIRD FLOOR LIGHTING PLAN.
 - 6 MOUNT AIRCRAFT CABLE HANGERS FROM CENTER MULLION FOR LUMINAIRE MOUNTING.
 - 7 DROP FEED FOR LUMINAIRES DOWN IN WALL AND FEED TO END OF LUMINAIRE FOR END FEED. PROVIDE JUNCTION BOX FOR END FEED. VERIFY MOUNTING HEIGHT OF LUMINAIRES PRIOR TO ROUGH-IN OF POWER.
 - 8 CONNECT EMERGENCY BALLAST MOUNTED IN LUMINAIRE TO LINE AHEAD OF ALL SWITCHING.
 - 9 REMOVE 4 EXISTING 3-WAY SWITCHES AND REPLACE WITH 2 NEW SINGLE POLE SWITCHES. REWIRE EXISTING LUMINAIRES FROM NEW SWITCHES TO PROVIDE SWITCHING SCHEME SHOWN.
 - 10 PROVIDE 2 NEW SINGLE POLE SWITCHES IN EXISTING LIGHTING CIRCUIT TO PROVIDE SWITCHING SCHEME AS SHOWN.

NOTES: (CONT.)
11 INSTALLER TO PROVIDE MOTION DETECTORS AS REQ'D. IN SECURED ROOM

AS BUILT
3-1-91
BELCAN CORPORATION
10200 ANDERSON WAY
CINCINNATI, OHIO 45242
NUMBER: 4301 CE-005-4

"This seal and signature apply only to the unaltered document to which they are affixed. I expressly disclaim any responsibility for any and all changes made after the issue date, for other plans, specifications, estimates, reports or other documents or instruments relating to or intended to be used for any part or portion of the architectural or engineering project or survey."

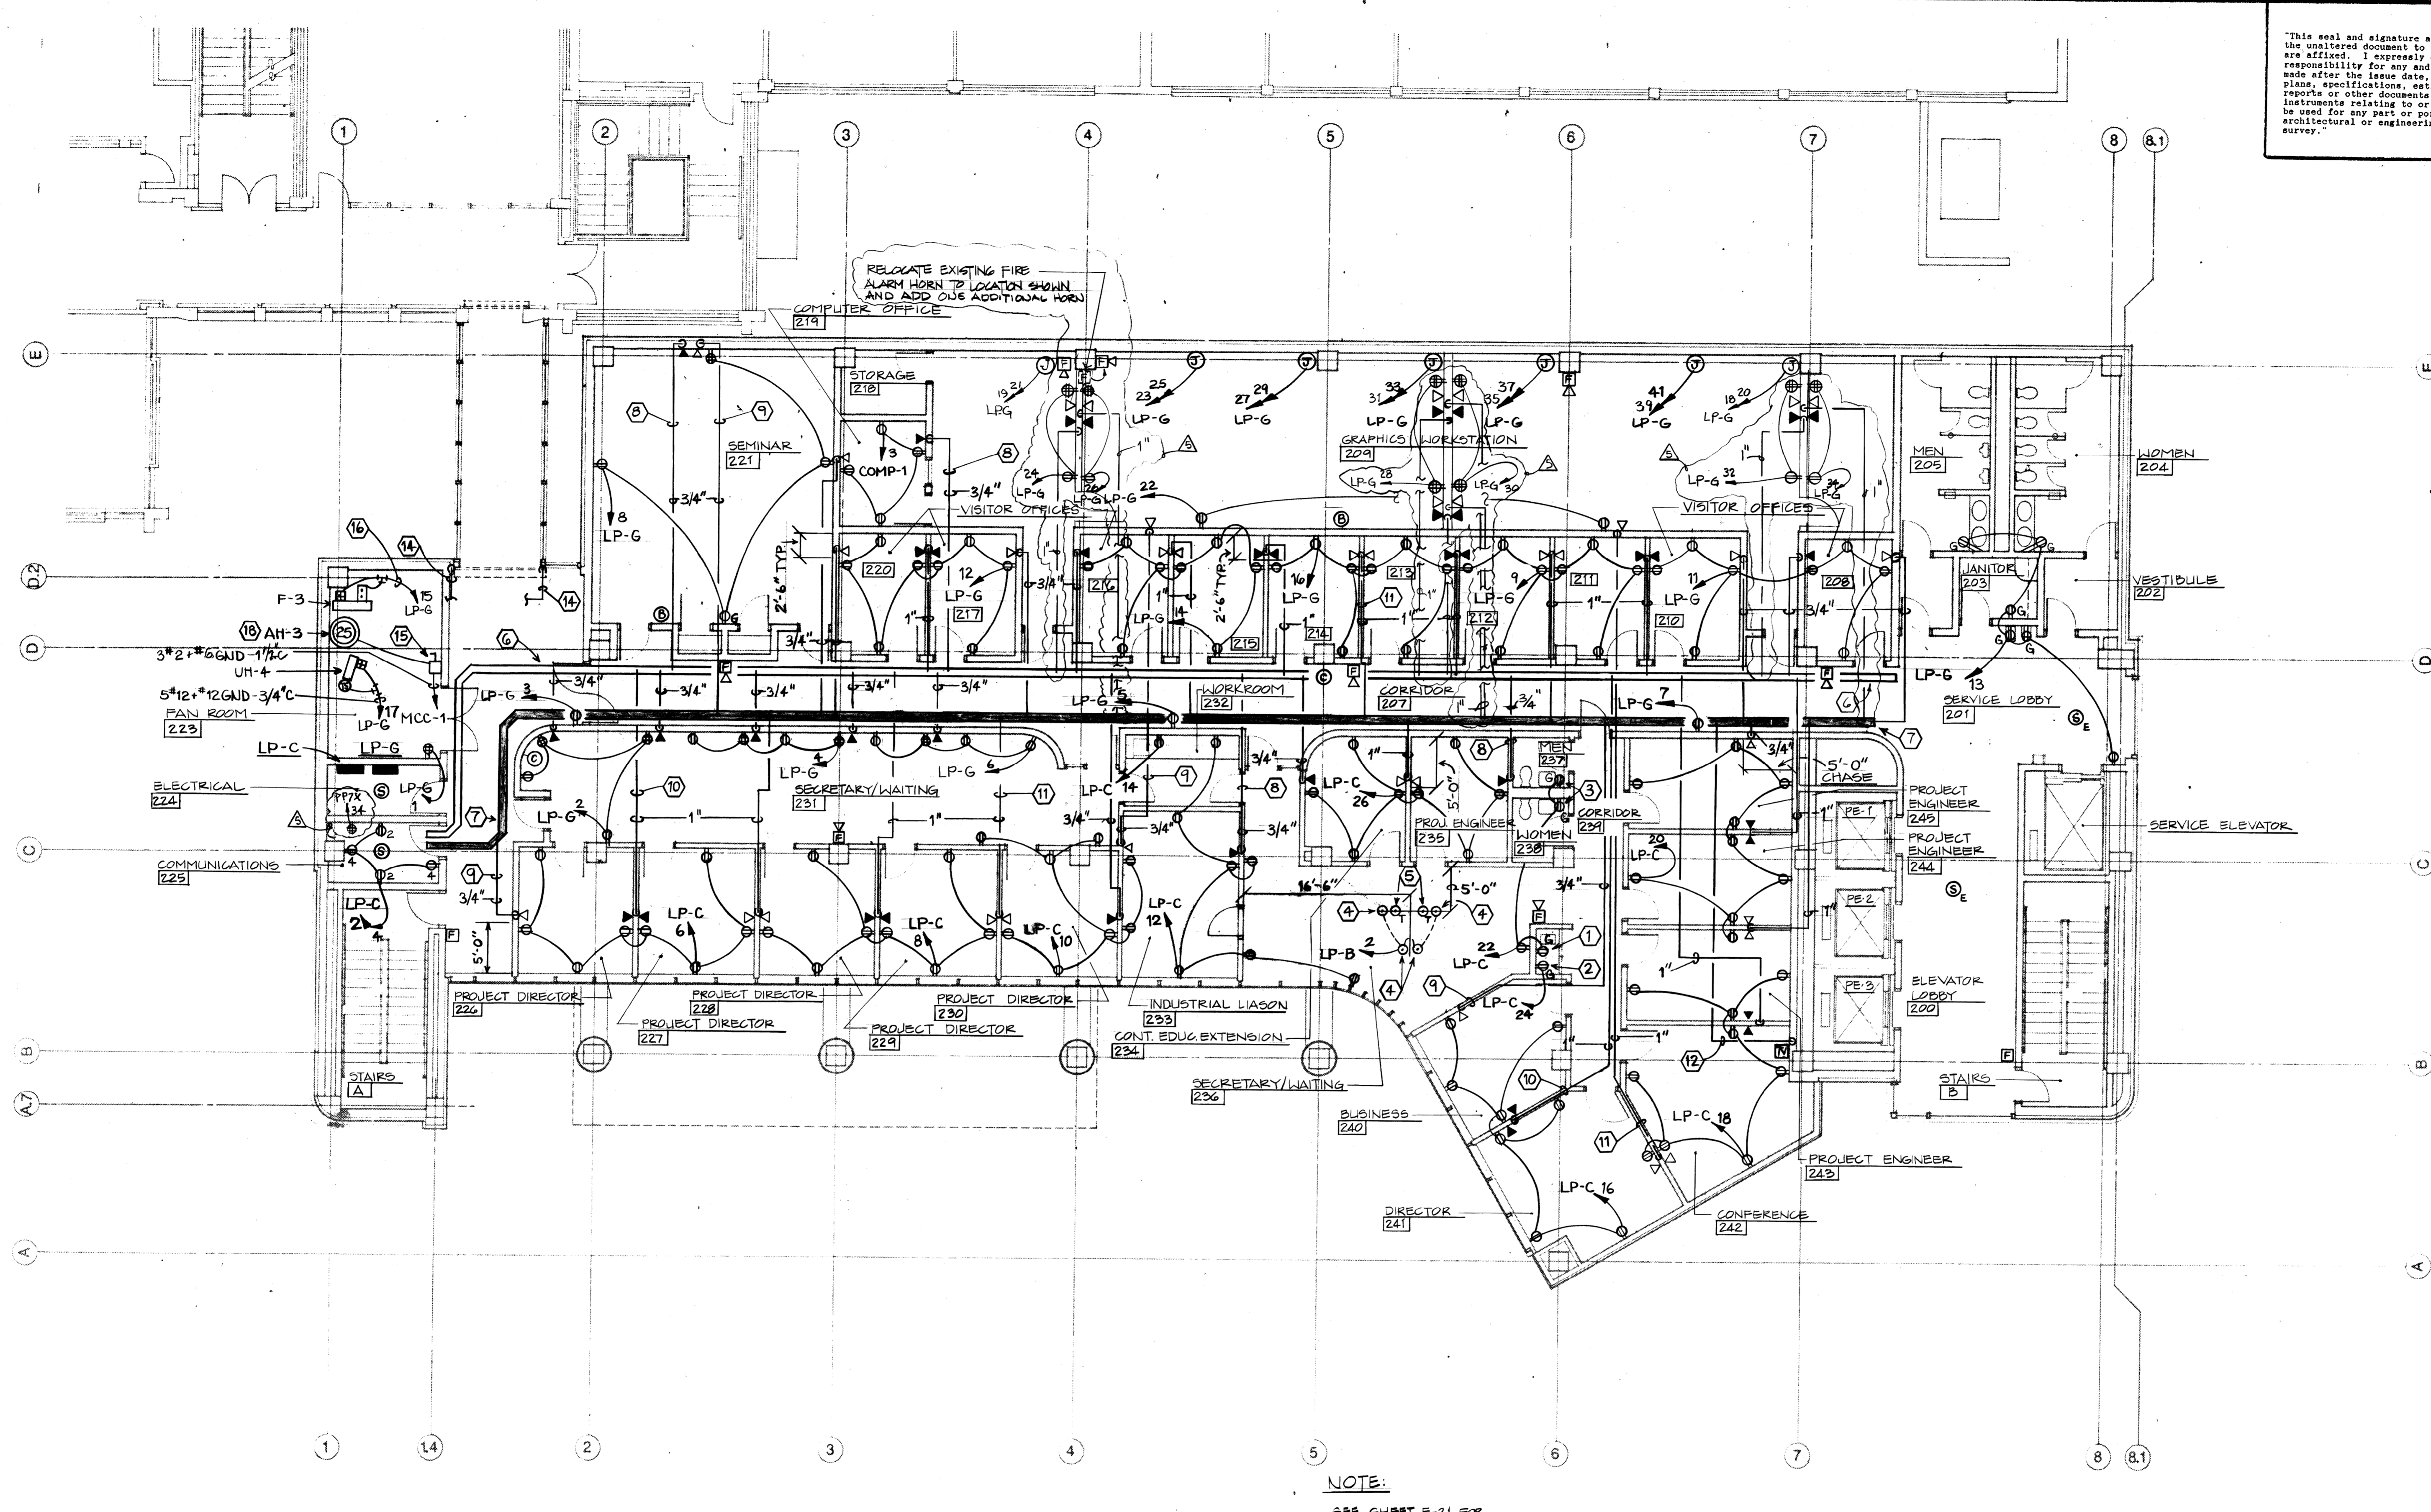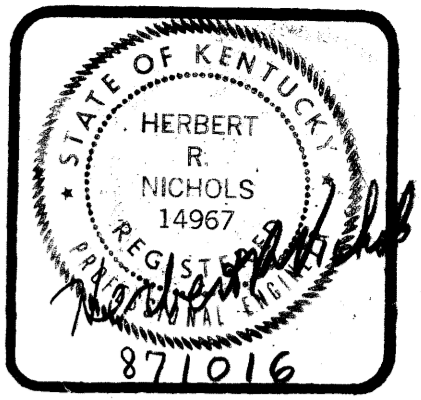

SECOND FLOOR PLAN
1/8" = 1'-0"
BLDG NORTH

NOTE:
SEE SHEET E-21 FOR DRAWING NOTES

ROBOTICS FACILITY
LEXINGTON CAMPUS
UNIVERSITY OF KENTUCKY
LEXINGTON, KENTUCKY

University of Kentucky
Lexington, Kentucky
10.19.87
Wendy Banning

2ND FLOOR POWER PLAN
Sherman Carter - Barnhart
PARTNERS IN ARCHITECTURE
SUITE 1900 • 250 WEST MAIN STREET • LEXINGTON, KY 40507 • 606.254.1351

JOB NO.	8706
DATE	9-30-87
DRAWN BY	D. MEYER
CHECKED BY	M. GOLDBERGER
FILE NO.	431.0


REVISIONS
3-90% REVIEW 10-16-87
4- GENERAL 7-18-88
5- RENOVATION 2-16-90

AS BUILT
3-1-91
BELCAN CORPORATION
10200 ANDERSON WAY
CINCINNATI, OHIO 45242
NUMBER: 4361-CE-006-4

SHEET
E-6

Cal# 83
Sht B-1
Document# 004972

"This seal and signature apply only to the unaltered document to which they are affixed. I expressly disclaim any responsibility for any and all changes made after the issue date, for other plans, specifications, estimates, reports or other documents or instruments relating to or intended to be used for any part or portion of the architectural or engineering project or survey."

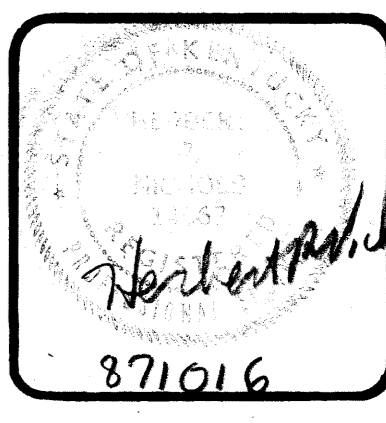

ROBOTICS FACILITY
LEXINGTON CAMPUS
UNIVERSITY OF KENTUCKY
LEXINGTON, KENTUCKY


University of Kentucky
Lexington, Kentucky
Approved by: *Walter Bunn*
Director, design and construction division

3RD FLOOR LIGHTING PLAN
Sherman Carter Barnhart
PARTNERS IN ARCHITECTURE
SUITE 1900 • 250 WEST MAIN STREET • LEXINGTON, KY 40507 • 606-251-1351

JOB NO. 8706
DATE 9-30-87
DRAWN D. MEYER
CHECKED M. GOLDBERG
VP FILE NO. 4310

REVISIONS
3-90% REVIEW 10-16-87
4- GENERAL 7-18-88
5- RENOVATIONS 2-16-89

SHEET
E-7
B-1
83

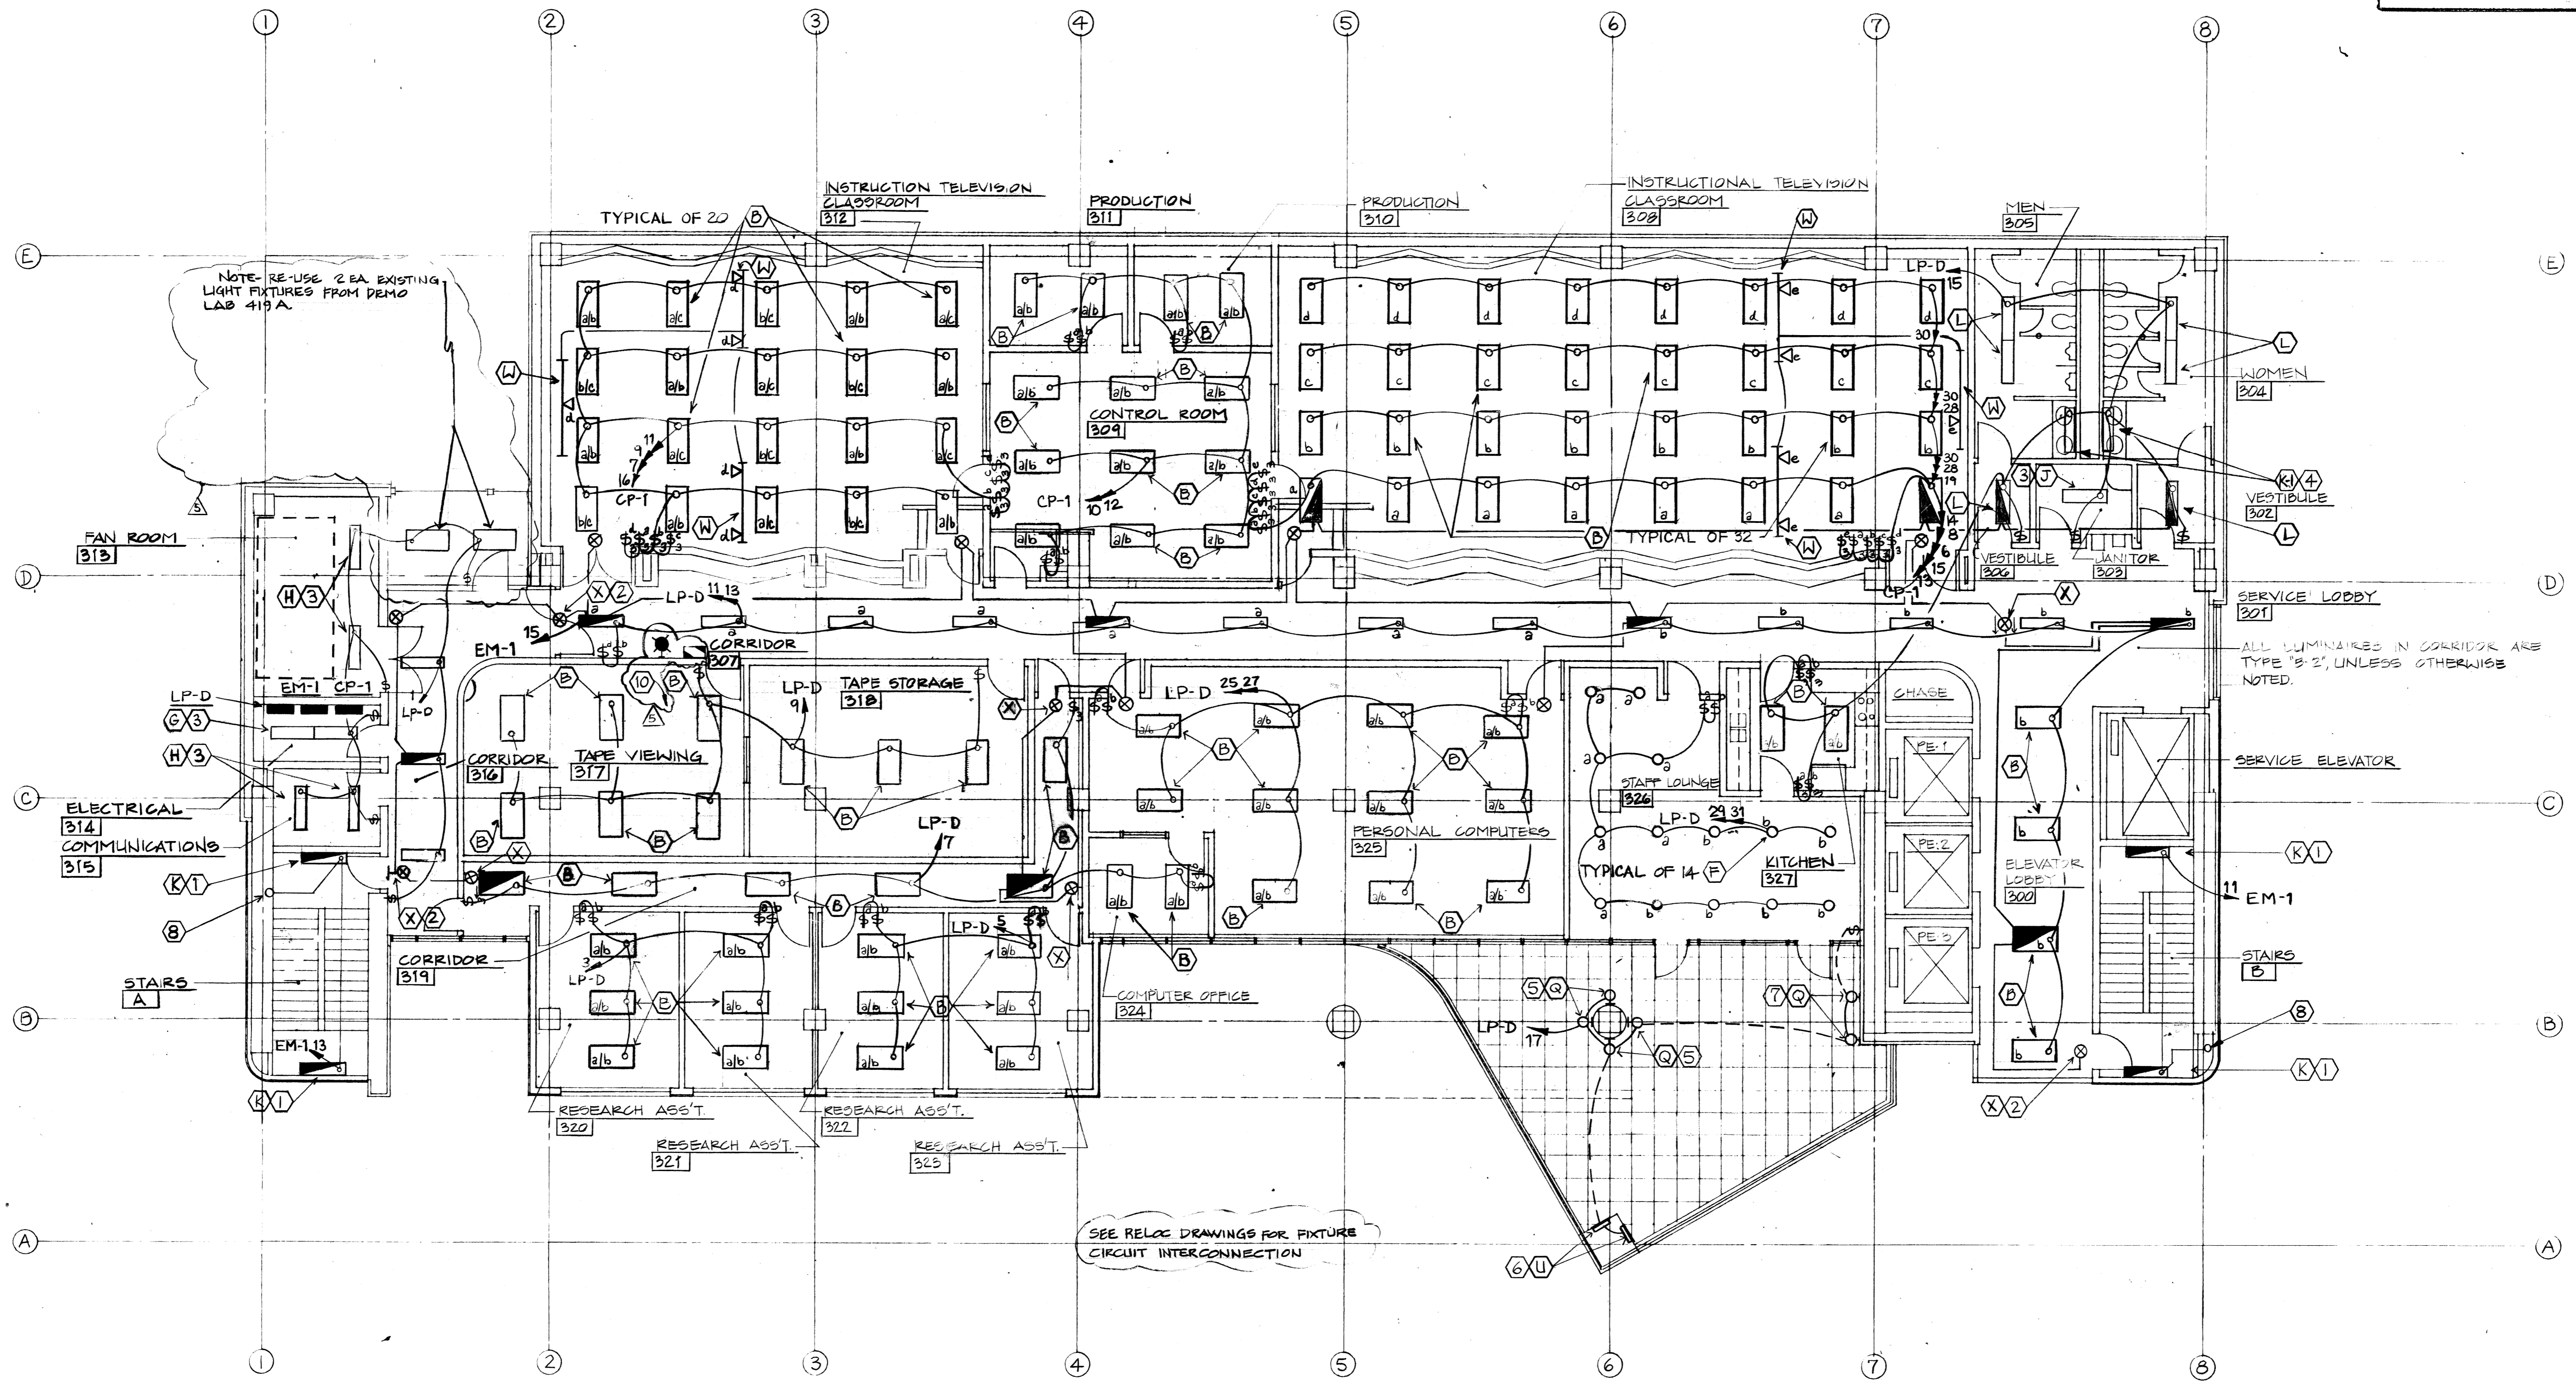


THIRD FLOOR PLAN

SCALE: 1/8" = 1'-0"


- THIRD FLOOR LIGHTING PLAN DRAWING NOTES
- 1 MOUNT LUMINAIRE 7'-6" AFF.
 - 2 MOUNT LUMINAIRE ABOVE DOORWAY.
 - 3 CHAIN SUSPEND LUMINAIRE FROM CEILING CONSTRUCTION TO 9'-0 AFF.
 - 4 MOUNT LUMINAIRE DIRECTLY ABOVE MIRROR.
 - 5 MOUNT LUMINAIRE ON COLUMN 6'-6" AFF.
 - 6 MOUNT LUMINAIRE 3'-0" AFF IN COLUMN.
 - 7 MOUNT LUMINAIRE 6'-6" AFF ON WALL.
 - 8 STAIRWELL LIGHTING POWER RISER. ROUTE UP TO FOURTH FLOOR STAIRS. SEE FOURTH FLOOR LIGHTING PLAN FOR CONTINUATION.
 - 9 CONNECT EMERGENCY BALLAST MOUNTED IN LUMINAIRE TO LINE AHEAD OF ALL SWITCHING.
 - 10 INSTALLER TO PROVIDE MOTION DETECTORS AS REQ'D IN SECURED ROOM

AS BUILT

3-1-91
BELCAN CORPORATION
10200 ANDERSON WAY
CINCINNATI, OHIO 45242
NUMBER: 4361 CE-007-4

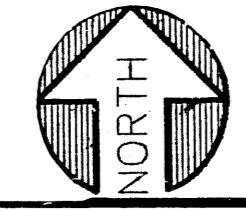

This seal and signature apply only to the unaltered document to which they are affixed. I expressly disclaim any responsibility for any and all changes made after the issue date, for other plans, specifications, estimates, reports or other documents or instruments relating to or intended to be used for any part or portion of the architectural or engineering project or survey.

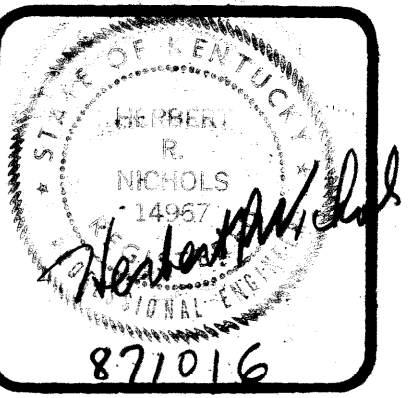

ROBOTICS FACILITY
LEXINGTON CAMPUS
UNIVERSITY OF KENTUCKY
LEXINGTON, KENTUCKY


University of Kentucky
Lexington, Kentucky
10-19-87
Norman J. Wynn
Professional Engineer

3RD FLOOR POWER PLAN
Stelman Carter Barnhart
PARTNERS IN ARCHITECTURE
SUITE 1900 • 250 WEST MAIN STREET • LEXINGTON KY 40507 • 606-254-1351

JOB NO. 8706
DATE 9-30-87
DRAWN D. MEYER
CHECKED M. GOLDBERG
FILE NO. 431-6

REVISIONS
1-90% REVIEW 10-16-87
4-GENERAL 7-18-88
5-RENOVATION 2-16-90

SHEET
E-8
Document # 004974
83

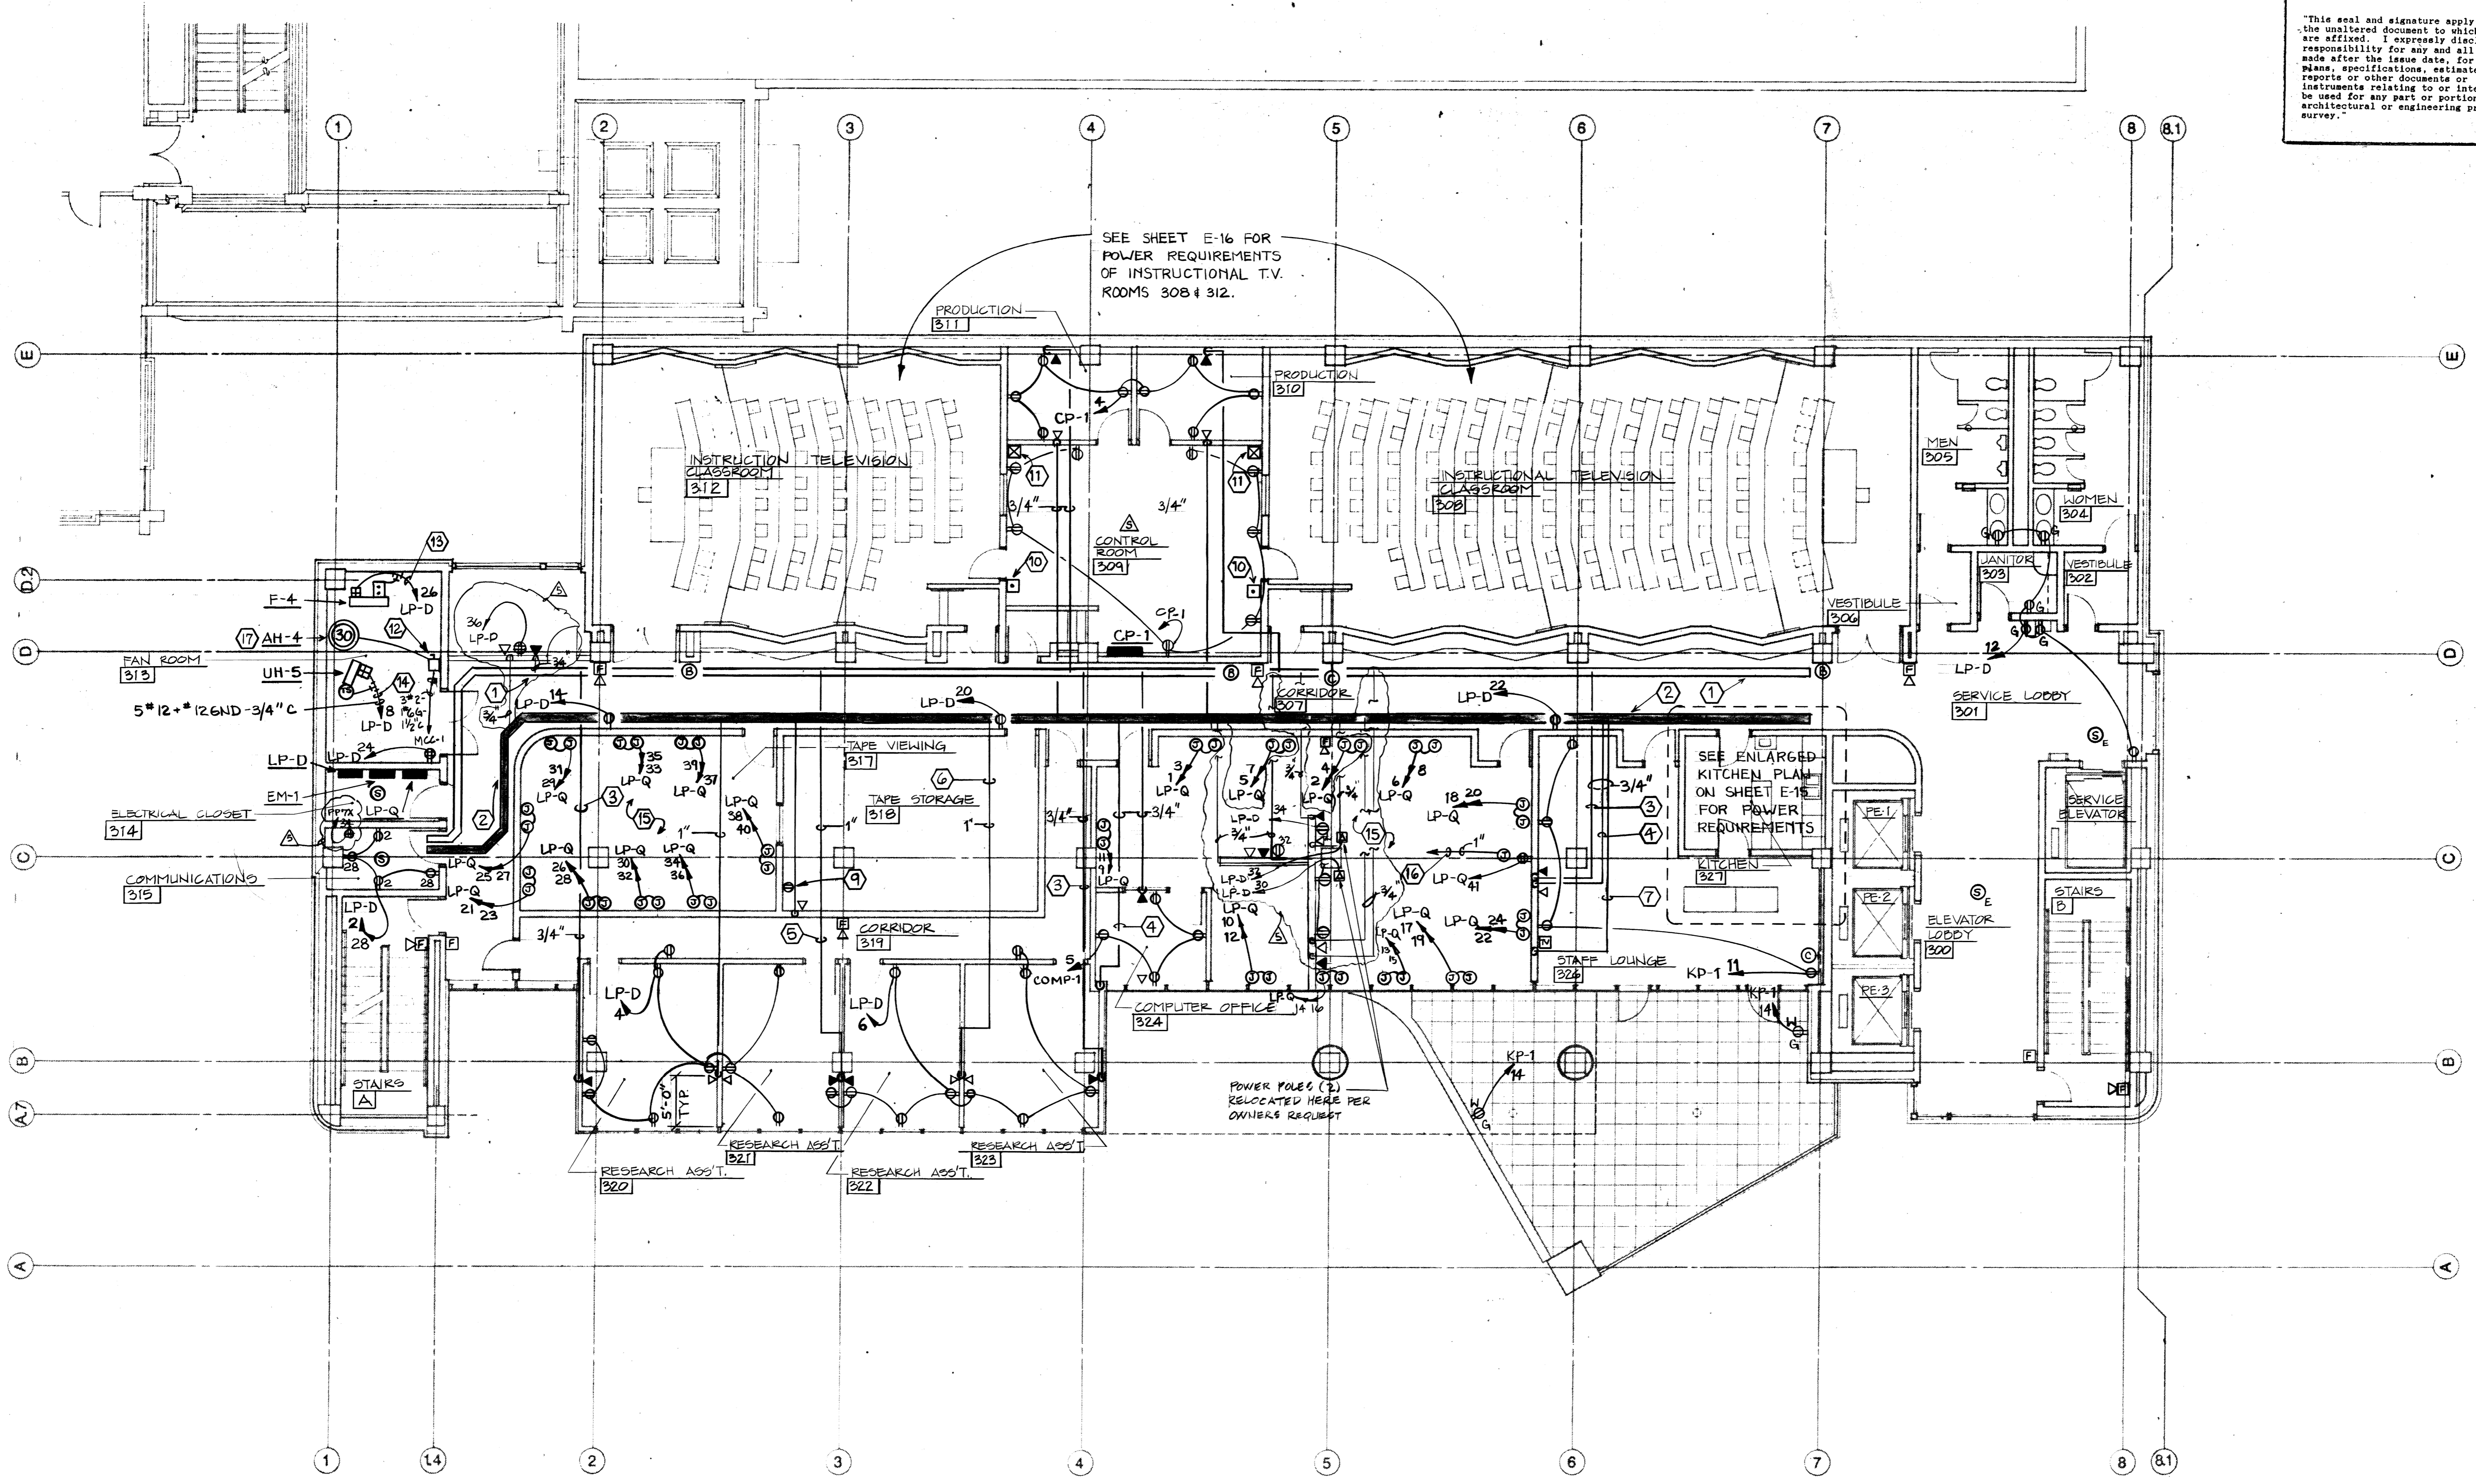

1. ROUTE ALL PROGRAMMED BELLS ON 3RD, 4TH, & 5TH FLOORS ON COMMON CIRCUIT TO C/B JUNCTION BOX LOCATED IN ELECTRICAL EQUIPMENT ROOM IN BASEMENT. ROUTE BELLS TO CIRCUIT LP-D-16.
2. ROUTE ALL CLOCKS ON 3RD, 4TH, & 5TH FLOORS ON COMMON CIRCUIT TO C/B JUNCTION BOX LOCATED IN ELECTRICAL EQUIPMENT ROOM IN BASEMENT. ROUTE CLOCKS TO CIRCUIT LP-D-18.

THIRD FLOOR PLAN
1/8" = 1'-0"
BLDG NORTH

NOTE:
SEE SHEET E-21 FOR DRAWING NOTES

AS BUILT
3-1-91
BELCAN CORPORATION
10200 ANDERSON WAY
CINCINNATI, OHIO 45242
NUMBER: 4361-CE-008-4

This seal and signature apply only to the unleased document to which they are affixed. I expressly disclaim any responsibility for any and all changes made after the issue date, for other plans, specifications, estimates, reports or other documents or instruments relating to or intended to be used for any part or portion of the architectural or engineering project or survey.



ROBOTICS FACILITY
LEXINGTON CAMPUS
UNIVERSITY OF KENTUCKY
LEXINGTON, KENTUCKY

University of Kentucky
Lexington, Kentucky
DATE: 10-19-87
DRAWN BY: W. ...


4TH FLOOR LIGHTING PLAN
SHERMAN-CARTER-BARNHART
PARTNERS IN ARCHITECTURE
SUITE 1900 • 250 WEST MAIN STREET • LEXINGTON, KY 40507 • 865-754-1351

JOB NO. 8706
DATE 9-30-87
DRAWN D. MEYER
CHECKED M. GOLDBERG
FILE NO. 4310


REVISIONS
3-90% REVIEW 10-16-87
4-GENERAL 7-18-88
5-RENOVATION 2-16-90

SHEET

E-9

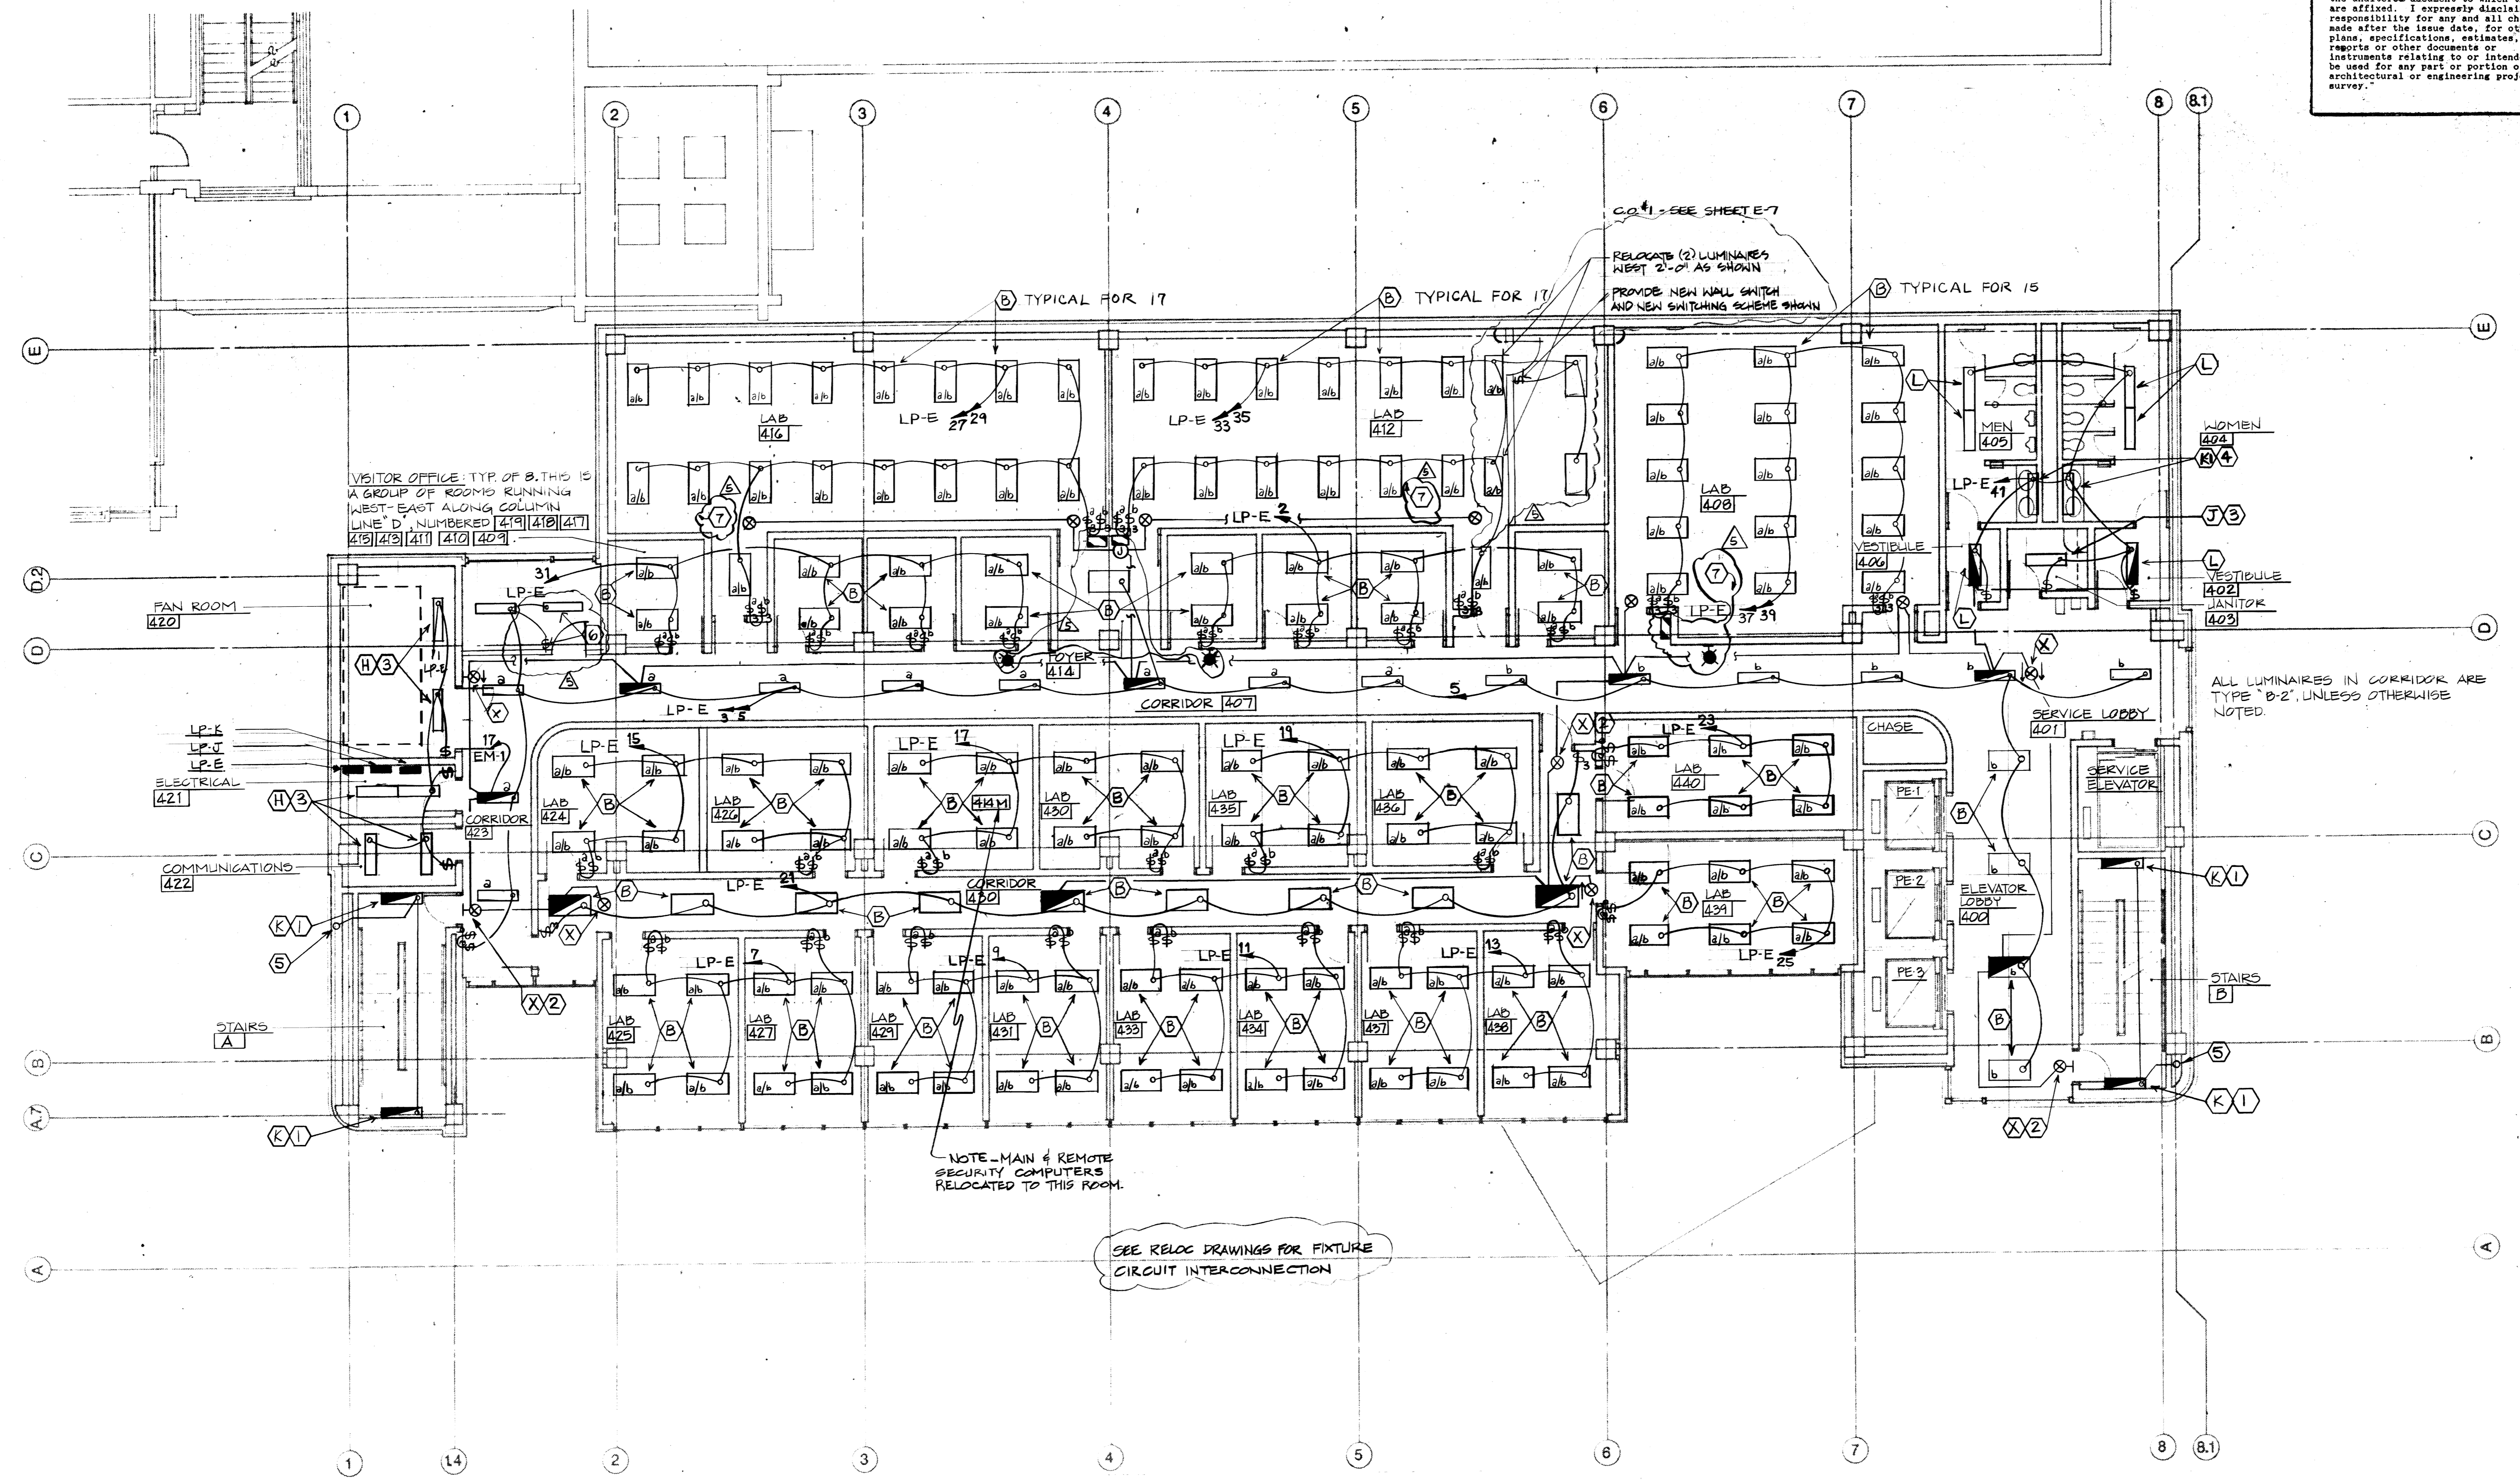

FOURTH FLOOR PLAN
1/8" = 1'-0"

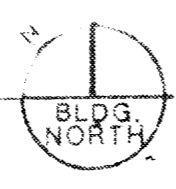

FOURTH FLOOR LIGHTING PLAN DRAWING NOTES

- 1 MOUNT LUMINAIRE 7'-6" AFF.
- 2 MOUNT LUMINAIRE ABOVE DOORWAY.
- 3 CHAIN SUSPEND LUMINAIRE FROM CEILING CONSTRUCTION TO 9'-0" AFF.
- 4 MOUNT LUMINAIRE DIRECTLY ABOVE MIRROR.
- 5 STAIRWELL LIGHTING POWER RISER. ROUTE UP TO FIFTH FLOOR. SEE FIFTH FLOOR LIGHTING PLAN FOR CONTINUATION.
- 6 RELOCATE EXISTING LUMINAIRE FROM 3RD FLOOR SAME AREA AND ADD NEW WALL SWITCH IN NEW WALL.
- 7 INSTALLER TO PROVIDE MOTION DETECTORS AS REQ'D IN SECURED ROOM.


AS BUILT
3-1-91



BELCAN CORPORATION
10200 ANDERSON WAY
CINCINNATI, OHIO 45242
NUMBER: 4361-CE-009.4

Scale # B-1
004975
83

"This seal and signature apply only to the unaltered document to which they are affixed. I expressly disclaim any responsibility for any and all changes made after the issue date, for other plans, specifications, estimates, reports or other documents or instruments relating to or intended to be used for any part or portion of the architectural or engineering project or survey."

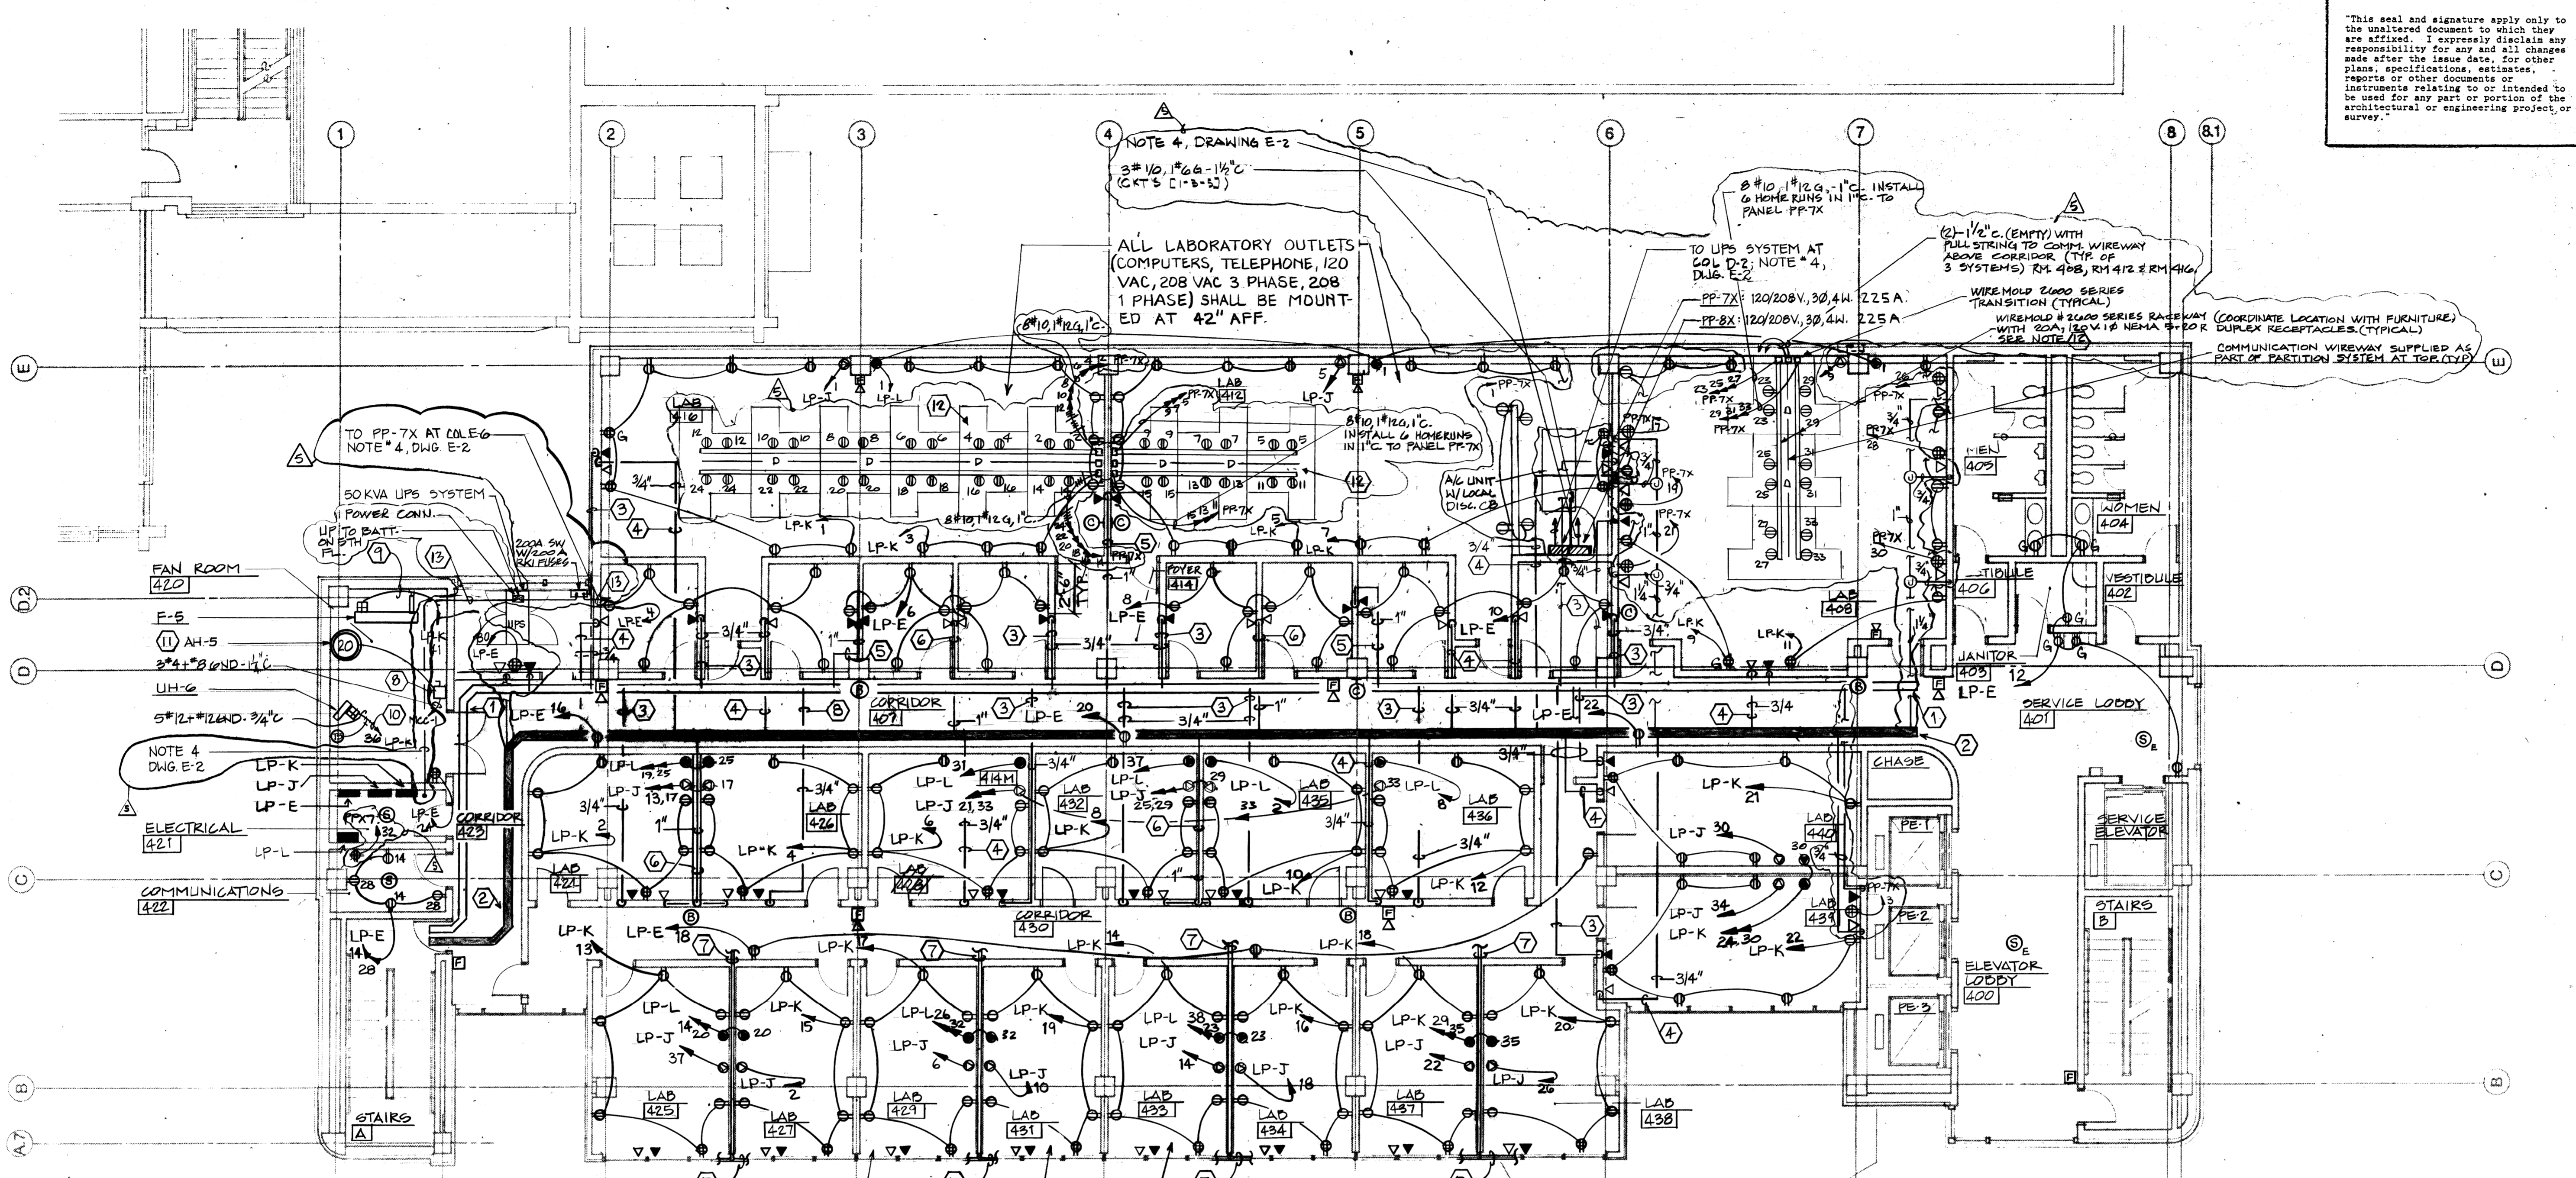

FOURTH FLOOR PLAN
1/8" = 1'-0"

FOURTH FLOOR POWER PLAN NOTES

- 8" X 8" WIREWAY MOUNTED ABOVE CEILING FOR TELEPHONE CABLING ONLY. RUN FROM TELEPHONE BOARD IN COMMUNICATIONS ROOM THROUGH CORRIDOR.
- 8" X 8" WIREWAY MOUNTED ABOVE CEILING FOR COMMUNICATIONS AND COMPUTER CABLING. RUN FROM COMMUNICATIONS ROOM THROUGH CORRIDOR.
- EXTEND 3/4" EMPTY CONDUIT (WITH PULLSTRING) FROM WIREWAY IN CORRIDOR TO TELEPHONE OUTLET. ROUTE CONDUIT ABOVE CEILING AND DOWN IN WALL. TYPICAL FOR SINGLE TELEPHONE OUTLET.
- EXTEND 3/4" EMPTY CONDUIT (WITH PULLSTRING) FROM WIREWAY IN CORRIDOR TO COMPUTER OUTLET. ROUTE CONDUIT ABOVE CEILING AND DOWN IN WALL. TYPICAL FOR SINGLE COMPUTER OUTLET.
- EXTEND 1" EMPTY CONDUIT (WITH PULLSTRING) FROM WIREWAY IN CORRIDOR TO (2) TELEPHONE OUTLETS. ROUTE CONDUIT ABOVE CEILING AND DOWN IN WALL TO OUTLETS. TYPICAL FOR DOUBLE TELEPHONE OUTLETS.
- EXTEND 1" EMPTY CONDUIT (WITH PULLSTRING) FROM WIREWAY IN CORRIDOR TO (2) COMPUTER OUTLETS. ROUTE CONDUIT ABOVE CEILING AND DOWN IN WALL TO OUTLETS. TYPICAL FOR DOUBLE COMPUTER OUTLETS.
- (2) 1" CONDUIT ((1) TELEPHONE; (1) COMPUTER) FROM WIREWAYS IN MAIN CORRIDOR ROUTED IN CEILING SPACE. TURN DOWN IN WALL AND ROUTE TO WINDOW WALL. ROUTE 18" ABOVE FINISHED FLOOR TO OUTLETS ON WINDOW WALL AS SHOWN.
- PROVIDE 250 VAC, 100 AMP, NON-FUSED, H.D., 3 POLE, DISCONNECT FOR AH-5. MOUNT DISCONNECT ON WALL ADJACENT TO UNIT. VERIFY FINAL LOCATION WITH MECHANICAL CONTRACTOR.
- ROUTE 5# 12 + #12 GND TO 120 VAC PANEL INDICATED FOR ROLL FILTER F-5. MANUAL MOTOR STARTER AND START-STOP BUTTON FURNISHED AND MOUNTED BY MECHANICAL CONTRACTOR. 2# 12 FOR START-STOP BUTTON POWER.
- 2# 12 TO BE FOR TEMPERATURE SWITCH POWER. TEMPERATURE SWITCH IS SUPPLIED AND MOUNTED BY MECHANICAL CONTRACTOR.
- ELECTRICAL CONTRACTOR SHALL FURNISH AND WIRE DUCT MOUNTED SMOKE DETECTOR (1 IN SUPPLY, 1 IN RETURN) FOR AH-5. SEE FIRE ALARM RISER DIAGRAM. DETECTORS ARE MOUNTED BY MECHANICAL CONTRACTOR.
- DO NOT WIRE RECEPTACLES IN PARTITION SYSTEM, TAPE AND TICK WIRES INSIDE PARTITION.
- SEE SINGLE LINE DIAGRAM, DWG. E-23 FOR SIZES OF CONDUIT AND WIRE.

ROBOTICS FACILITY
LEXINGTON CAMPUS
UNIVERSITY OF KENTUCKY
LEXINGTON, KENTUCKY


University of Kentucky
Lexington, Kentucky
APPROVED BY: *[Signature]*
DATE: 11-19-87

4TH FLOOR POWER PLAN
Sherman Carter Barnhart
PARTNERS IN ARCHITECTURE
SUITE 800 • 750 WEST MAIN STREET • LEXINGTON, KY 40507 • 606-354-1351

JOB NO. 8706
DATE 9-30-87
DRAWN D. MEYER
CHECKED M. GOLDBERG
FILE NO. 431.0

REVISIONS
3-90% REVIEW 10-16-87
4-GENERAL 7-18-88
5-REVISION 2-16-90

SHEET
E-10

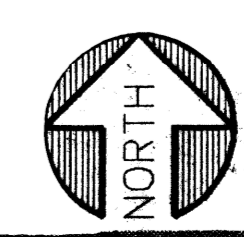

AS BUILT
3-1-91
BELCAN CORPORATION
10200 ANDERSON WAY
CINCINNATI, OHIO 45242
NUMBER: 4361-CE-D10-4

"This seal and signature apply only to the unaltered document to which they are affixed. I expressly disclaim any responsibility for any and all changes made after the issue date, for other plans, specifications, estimates, reports or other documents or instruments relating to or intended to be used for any part or portion of the architectural or engineering project or survey."

871016

ROBOTICS FACILITY
LEXINGTON CAMPUS
UNIVERSITY OF KENTUCKY
LEXINGTON, KENTUCKY

University of Kentucky
Lexington, Kentucky

5TH FLOOR LIGHTING PLAN
Sherman Carter Barnhart
PARTNERS IN ARCHITECTURE
SUITE 1800 • 250 WEST MAIN STREET • LEXINGTON, KY 40507 • 606-254-1351


JOB NO. 8706
DATE 9-30-87
DRAWN D. MEYER
CHECKED M. GOLDBERG
VP FILE NO 431.0

REVISIONS
3-20% REVIEW 10-16-87
4- GENERAL 7-18-88
5- RENOVATION 2-16-90

SHEET
Document #
004977


E-11

83 B-1

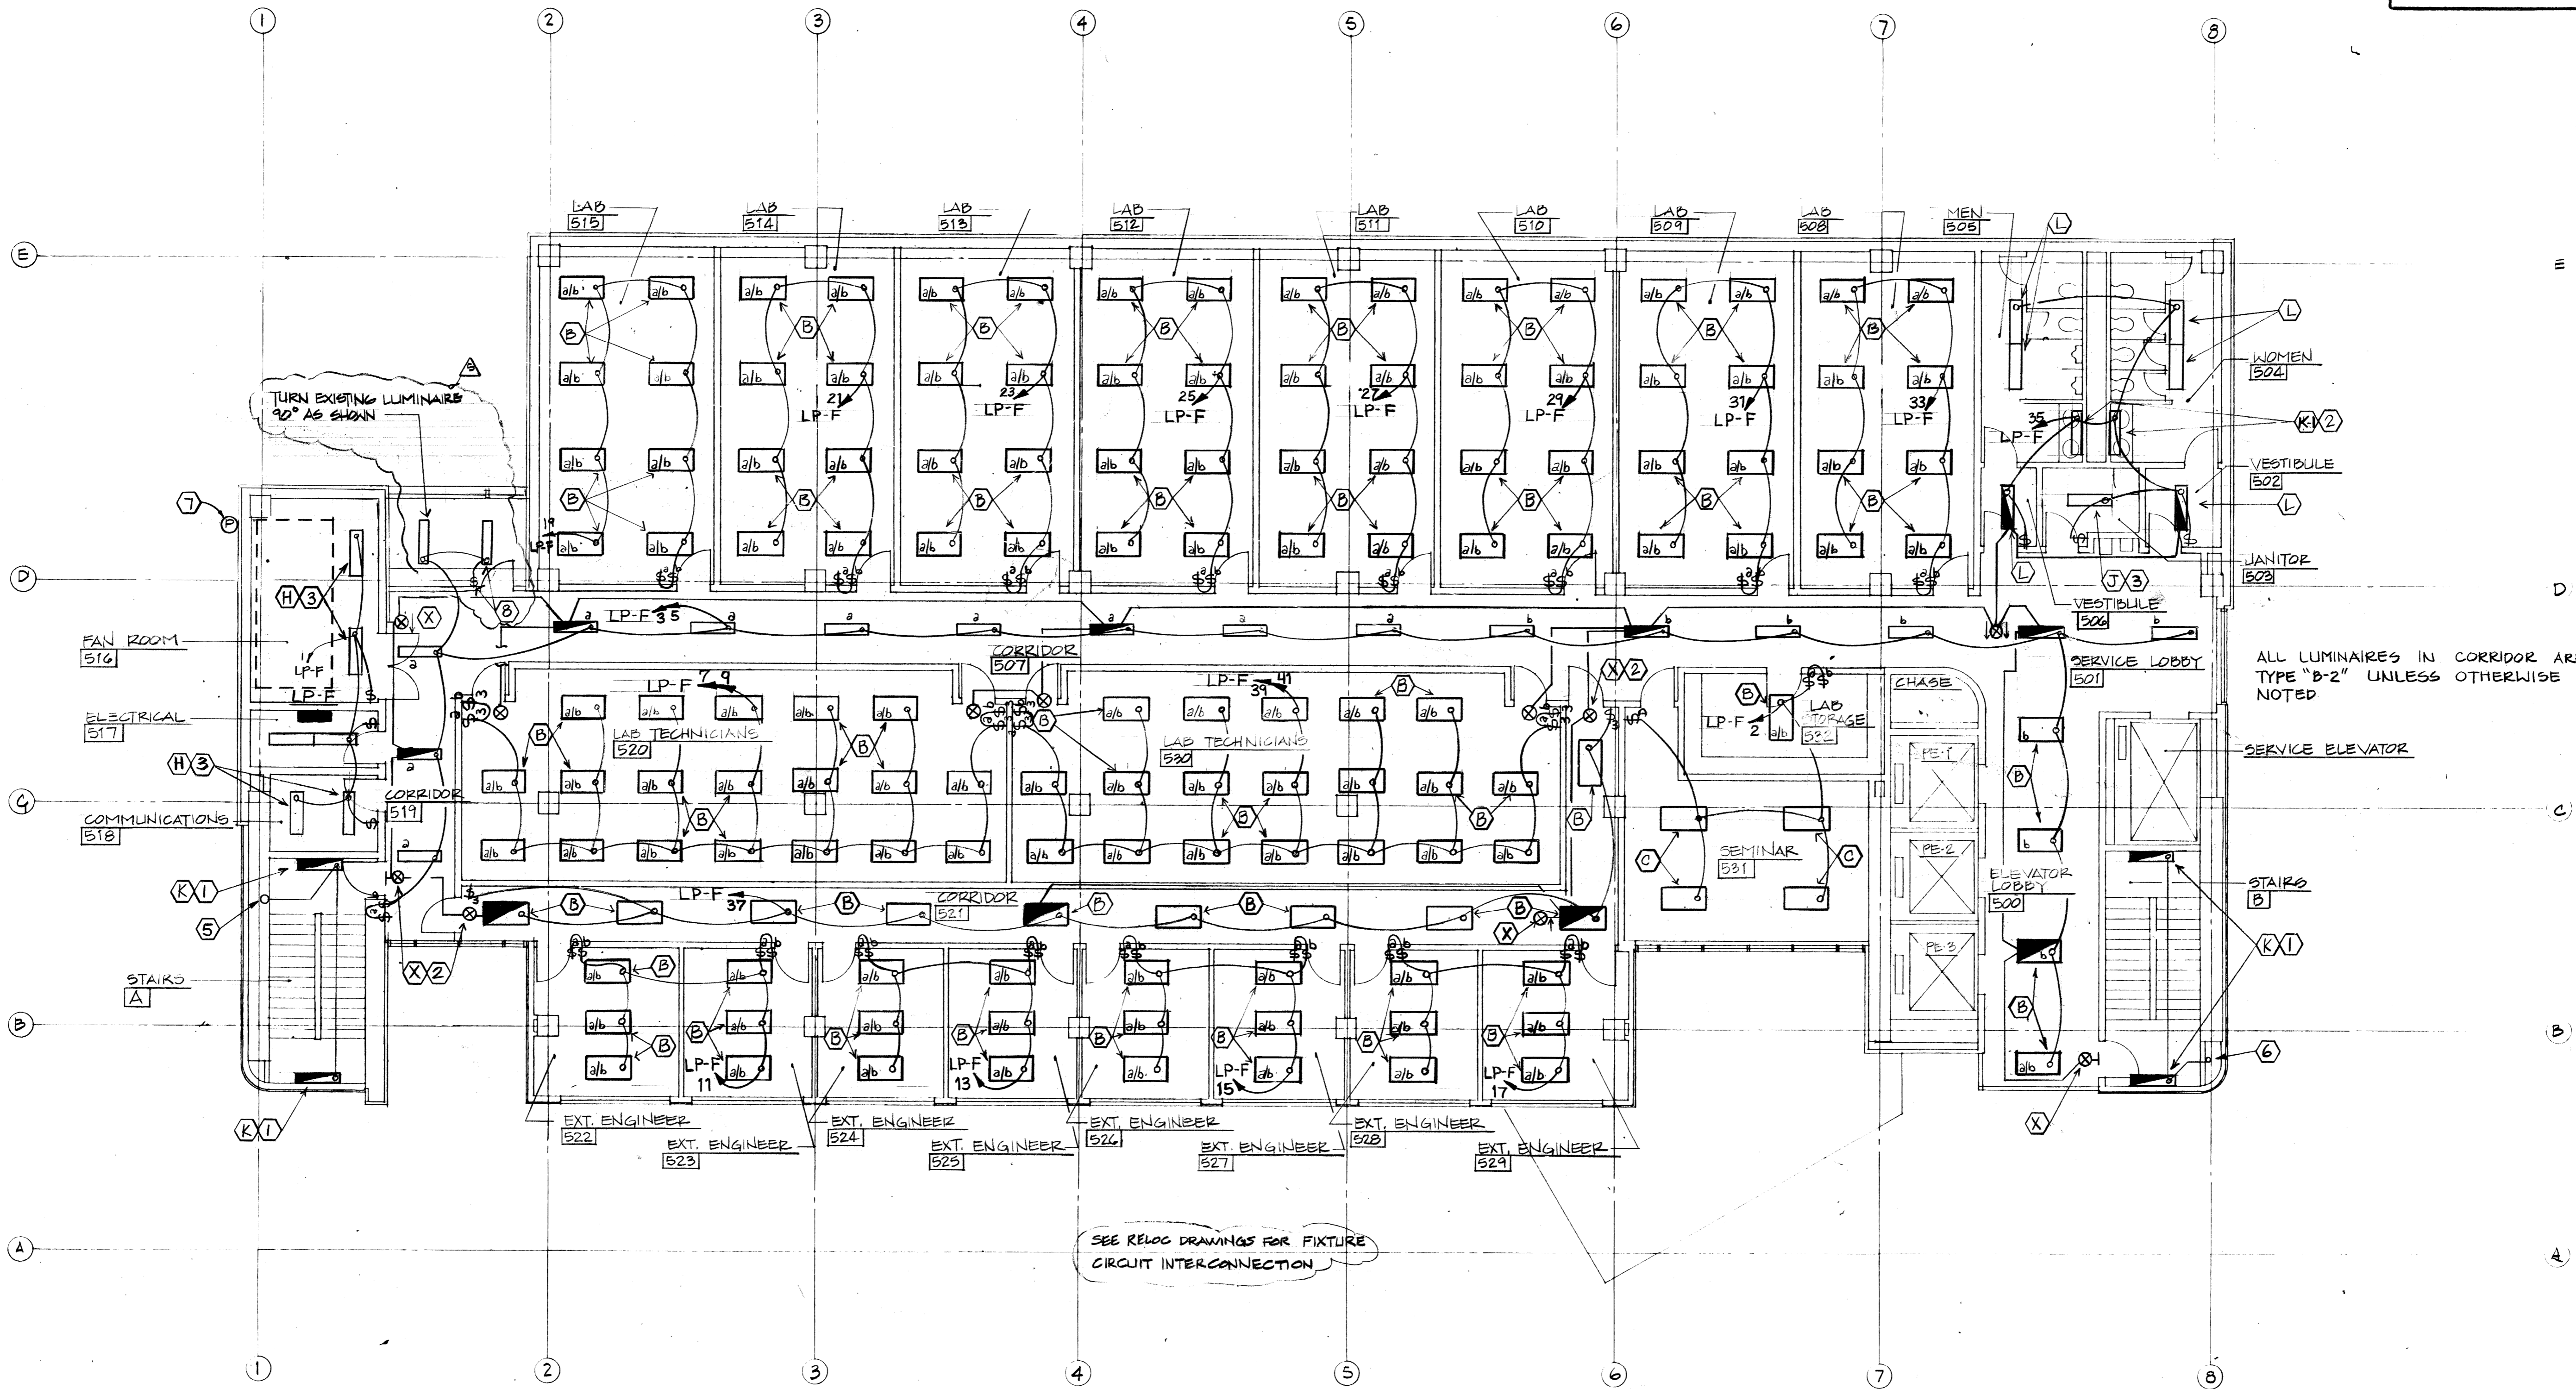

FIFTH FLOOR PLAN
SCALE: 1/8"=1'-0"

- FIFTH FLOOR LIGHTING PLAN NOTES**
- 1 MOUNT LUMINAIRE 7'-6" AFF.
 - 2 MOUNT LUMINAIRE ABOVE DOORWAY.
 - 3 CHAIN SUSPEND LUMINAIRE FROM CEILING CONSTRUCTION TO 9'-0" AFF.
 - 4 MOUNT LUMINAIRE DIRECTLY ABOVE MIRROR.
 - 5 STAIRWELL LIGHTING POWER RISER. ROUTE DOWN TO FOURTH FLOOR. SEE FOURTH FLOOR LIGHTING PLAN FOR CONTINUATION.
 - 6 STAIRWELL LIGHTING POWER RISER. ROUTE UP TO PENTHOUSE. SEE PENTHOUSE LIGHTING PLAN FOR CONTINUATION.
 - 7 MOUNT PHOTOCELL ON WEST FACE OF VAV ROOM. FOR CONTROL OF EMERGENCY LIGHTING CIRCUIT. SEE EXTERIOR EMERGENCY LIGHTING DIAGRAM.
 - 8 RELOCATE EXISTING LUMINAIRE FROM 3RD FLOOR, SAME AREA AND ADD NEW WALL SWITCH IN NEW WALL.

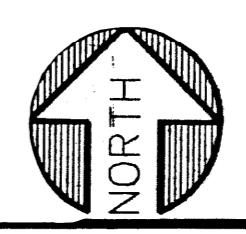

AS BUILT
3-1-91
BELCAN CORPORATION
10200 ANDERSON WAY
CINCINNATI, OHIO 45242
NUMBER 4361 CES211:4

"This seal and signature apply only to the unaltered document to which they are affixed. I expressly disclaim any responsibility for any and all changes made after the issue date, for other plans, specifications, estimates, reports or other documents or instruments relating to or intended to be used for any part or portion of the architectural or engineering project or survey."



ROBOTICS FACILITY
LEXINGTON CAMPUS
UNIVERSITY OF KENTUCKY
LEXINGTON, KENTUCKY


University of Kentucky
Lexington, Kentucky
10.19.87
Approved by: *William B. Bunn*
Architect, Design, and Construction Division

5TH FLOOR POWER PLAN
Sherman Carter Barnhart
PARTNERS IN ARCHITECTURE
SUITE 1900 • 550 WEST MAIN STREET • LEXINGTON KY 40501 • 606-254-0351

JOB NO. 8706
DATE 9-30-87
DRAWN D. MEYER
CHECKED M. GOLDBERG
FILE NO. 431.0

REVISIONS
3-90% REVIEW 10-14-87
4-GENERAL 7-18-88
5-RENOVATION 2-16-90

SHEET
E-12

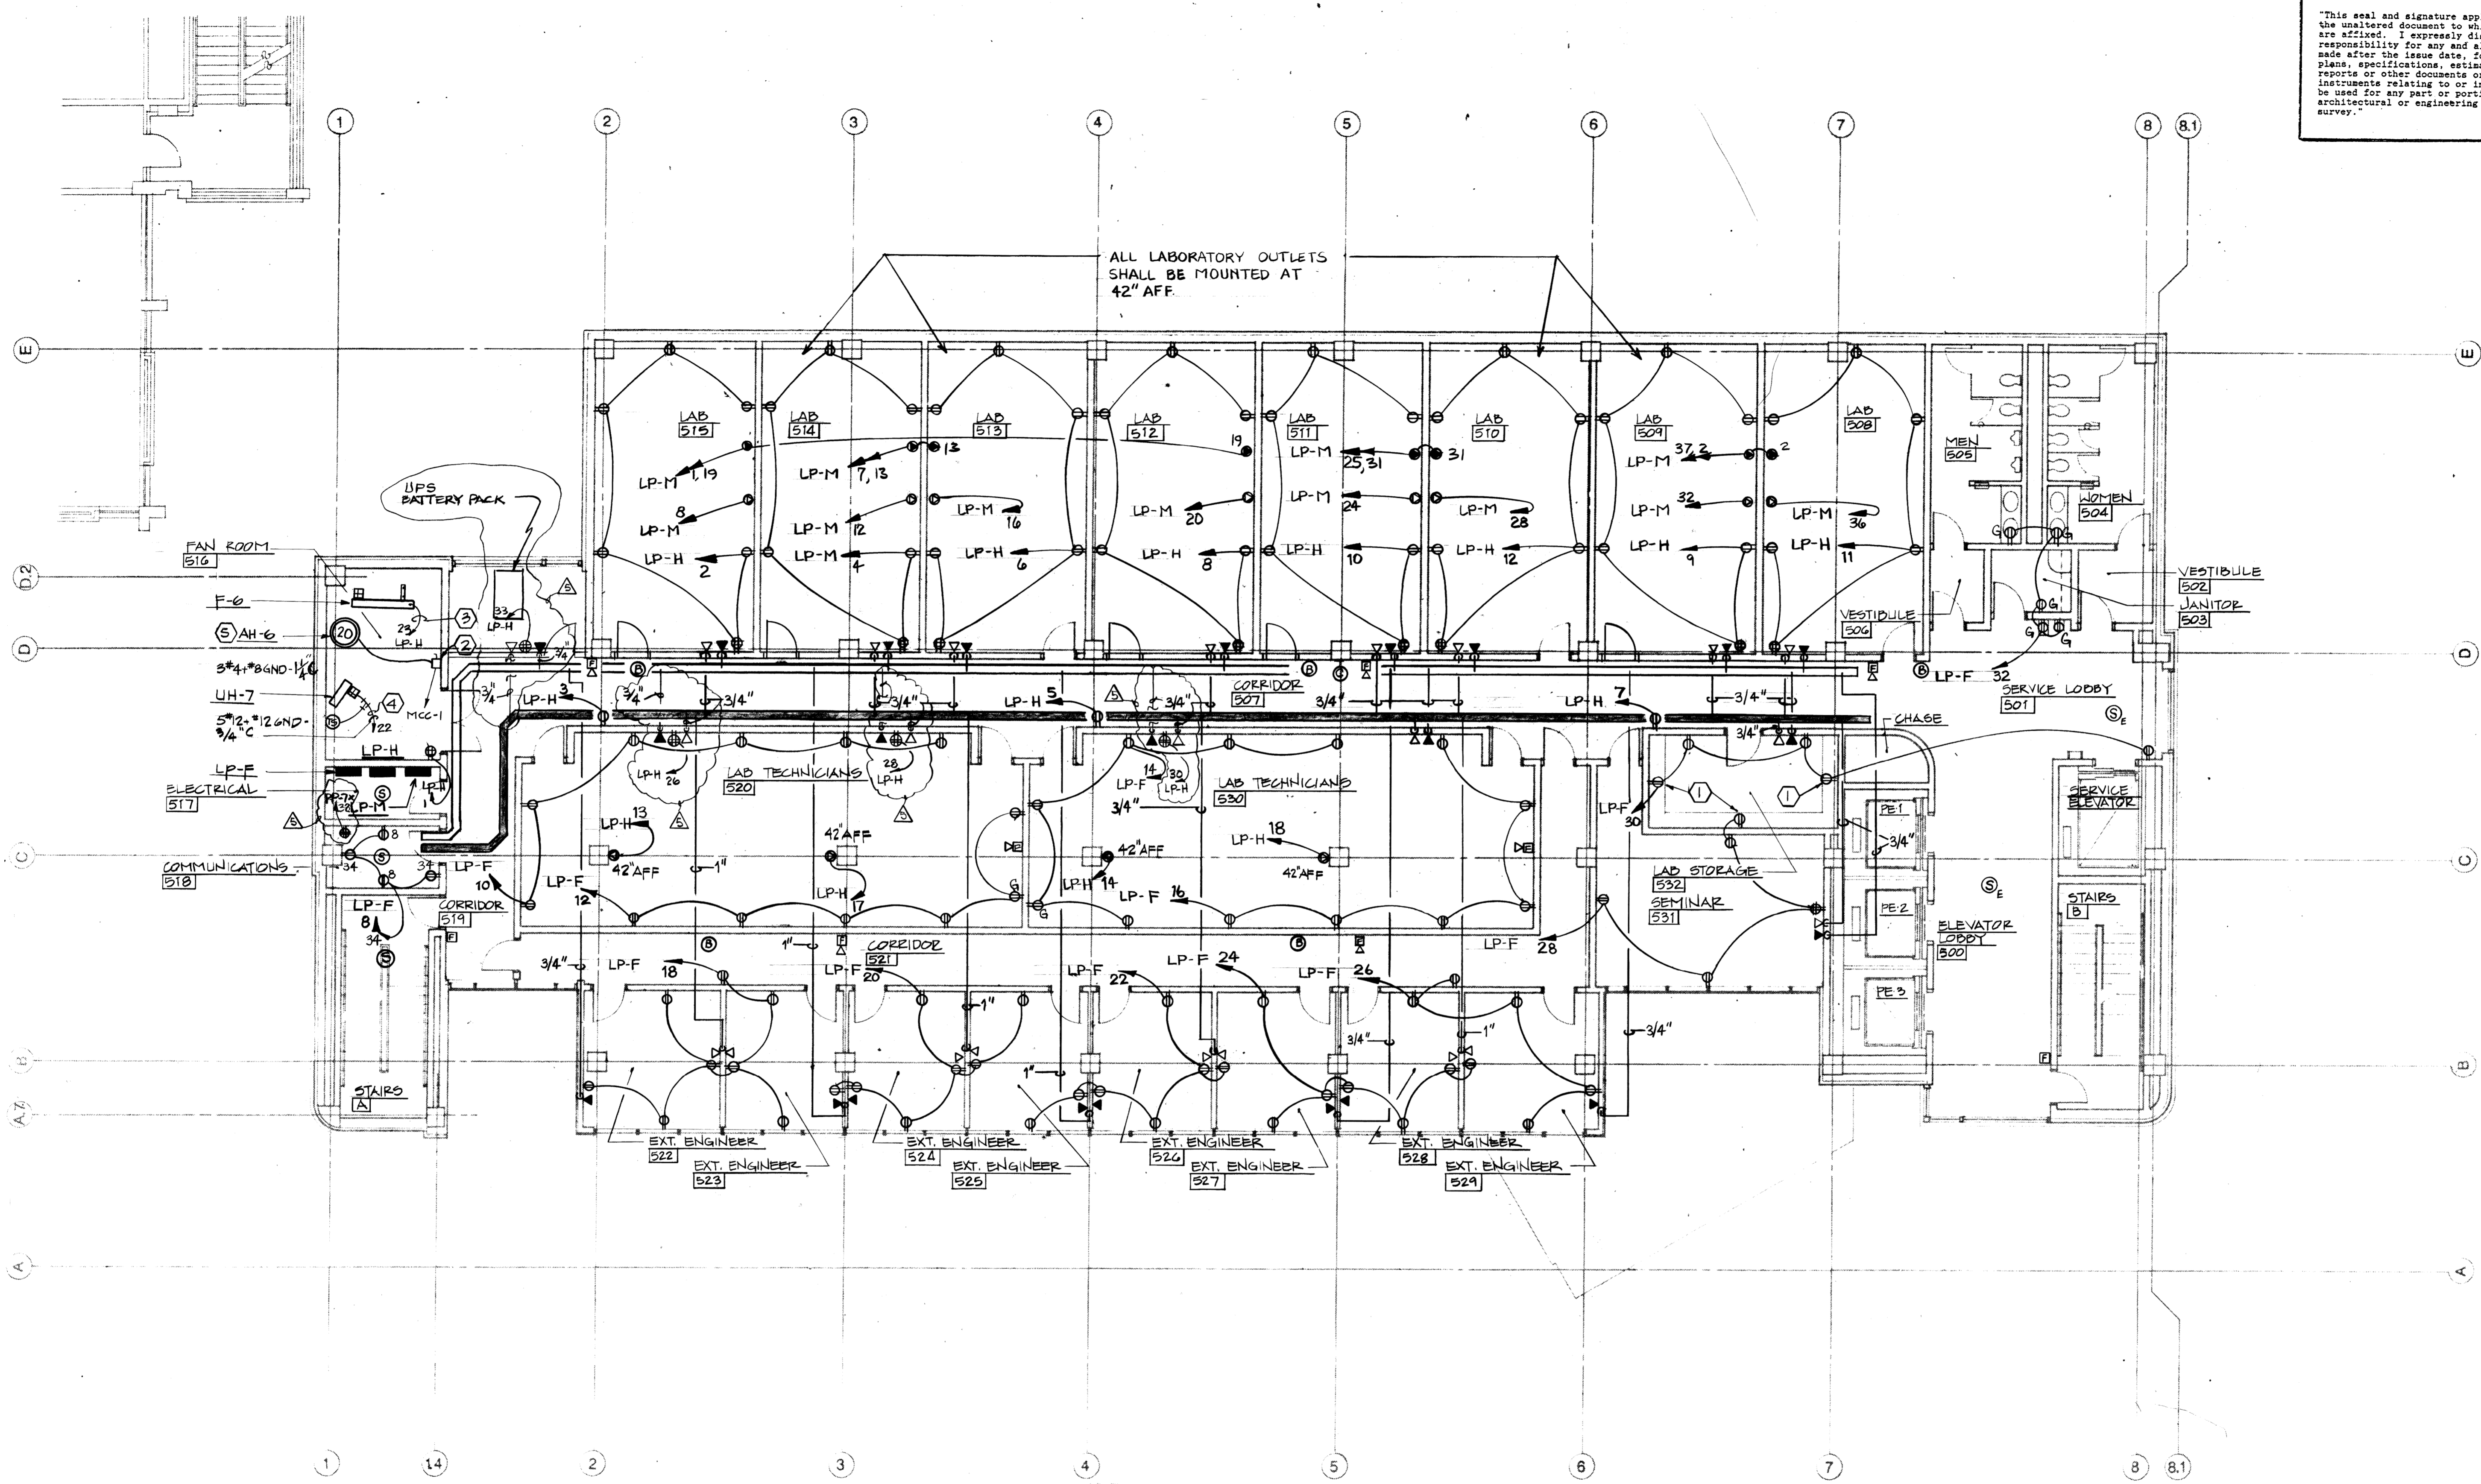


ALL LABORATORY OUTLETS SHALL BE MOUNTED AT 42" AFF.

FIFTH FLOOR PLAN
1/8" = 1'-0"

- FIFTH FLOOR POWER PLAN NOTES**
- 1 MOUNT RECEPTACLE 42" AFF. (ABOVE COUNTER)
 - 2 PROVIDE 250 VAC, 100 AMP, NON-FUSED, H.D. 3 POLE DISCONNECT FOR AH-6. MOUNT DISCONNECT ON WALL ADJACENT TO UNIT. VERIFY FINAL LOCATION WITH MECHANICAL CONTRACTOR.
 - 3 ROUTE 5# 12 + #12 GND - 3/4"C TO 120 VAC PANEL INDICATED FOR ROLL FILTER F-6. MANUAL MOTOR STARTER AND START-STOP BUTTON FURNISHED AND MOUNTED BY MECHANICAL CONTRACTOR. 2# 12 FOR START-STOP BUTTON POWER.
 - 4 ROUTE 2# 12 FOR TEMPERATURE SWITCH. TEMPERATURE SWITCH IS FURNISHED AND MOUNTED BY MECHANICAL CONTRACTOR.
 - 5 ELECTRICAL CONTRACTOR SHALL FURNISH AND WIRE DUCT MOUNTED SMOKE DETECTOR (1 IN SUPPLY, 1 IN RETURN) FOR AH-6 SEE FIRE ALARM RISER DIAGRAM. DETECTORS ARE MOUNTED BY MECHANICAL CONTRACTOR.

AS BUILT
3-1-91
BELCAN CORPORATION
10200 ANDERSON WAY
CINCINNATI, OHIO 45242
NUMBER: 4301-CE-012-4

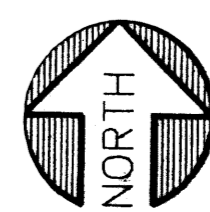

Sheet
B-1
004978
83

"This seal and signature apply only to the unaltered documents to which they are affixed. I expressly disclaim any responsibility for any and all changes made after the issue date, for other plans, specifications, estimates, reports or other documents or instruments relating to or intended to be used for any part or portion of the architectural or engineering project or survey."

871016

ROBOTICS FACILITY
LEXINGTON CAMPUS
UNIVERSITY OF KENTUCKY
LEXINGTON, KENTUCKY


University of Kentucky
Lexington, Kentucky
10.19.87
DATE

PENTHOUSE LIGHTING PLAN
Sherman Carter Barnhart
PARTNERS IN ARCHITECTURE
SUITE 1800 • 250 WEST MAIN STREET • LEXINGTON, KY 40501 • 606-254-1351

JOB NO. 8706
DATE 9-30-87
DRAWN D. MEYER
CHECKED M. GOLDBERG
UK FILE NO. 431.0

REVISIONS
3-90% REVIEW 10-16-87
4-GENERAL 7-18-88

SHEET
E-13
B-1
004979

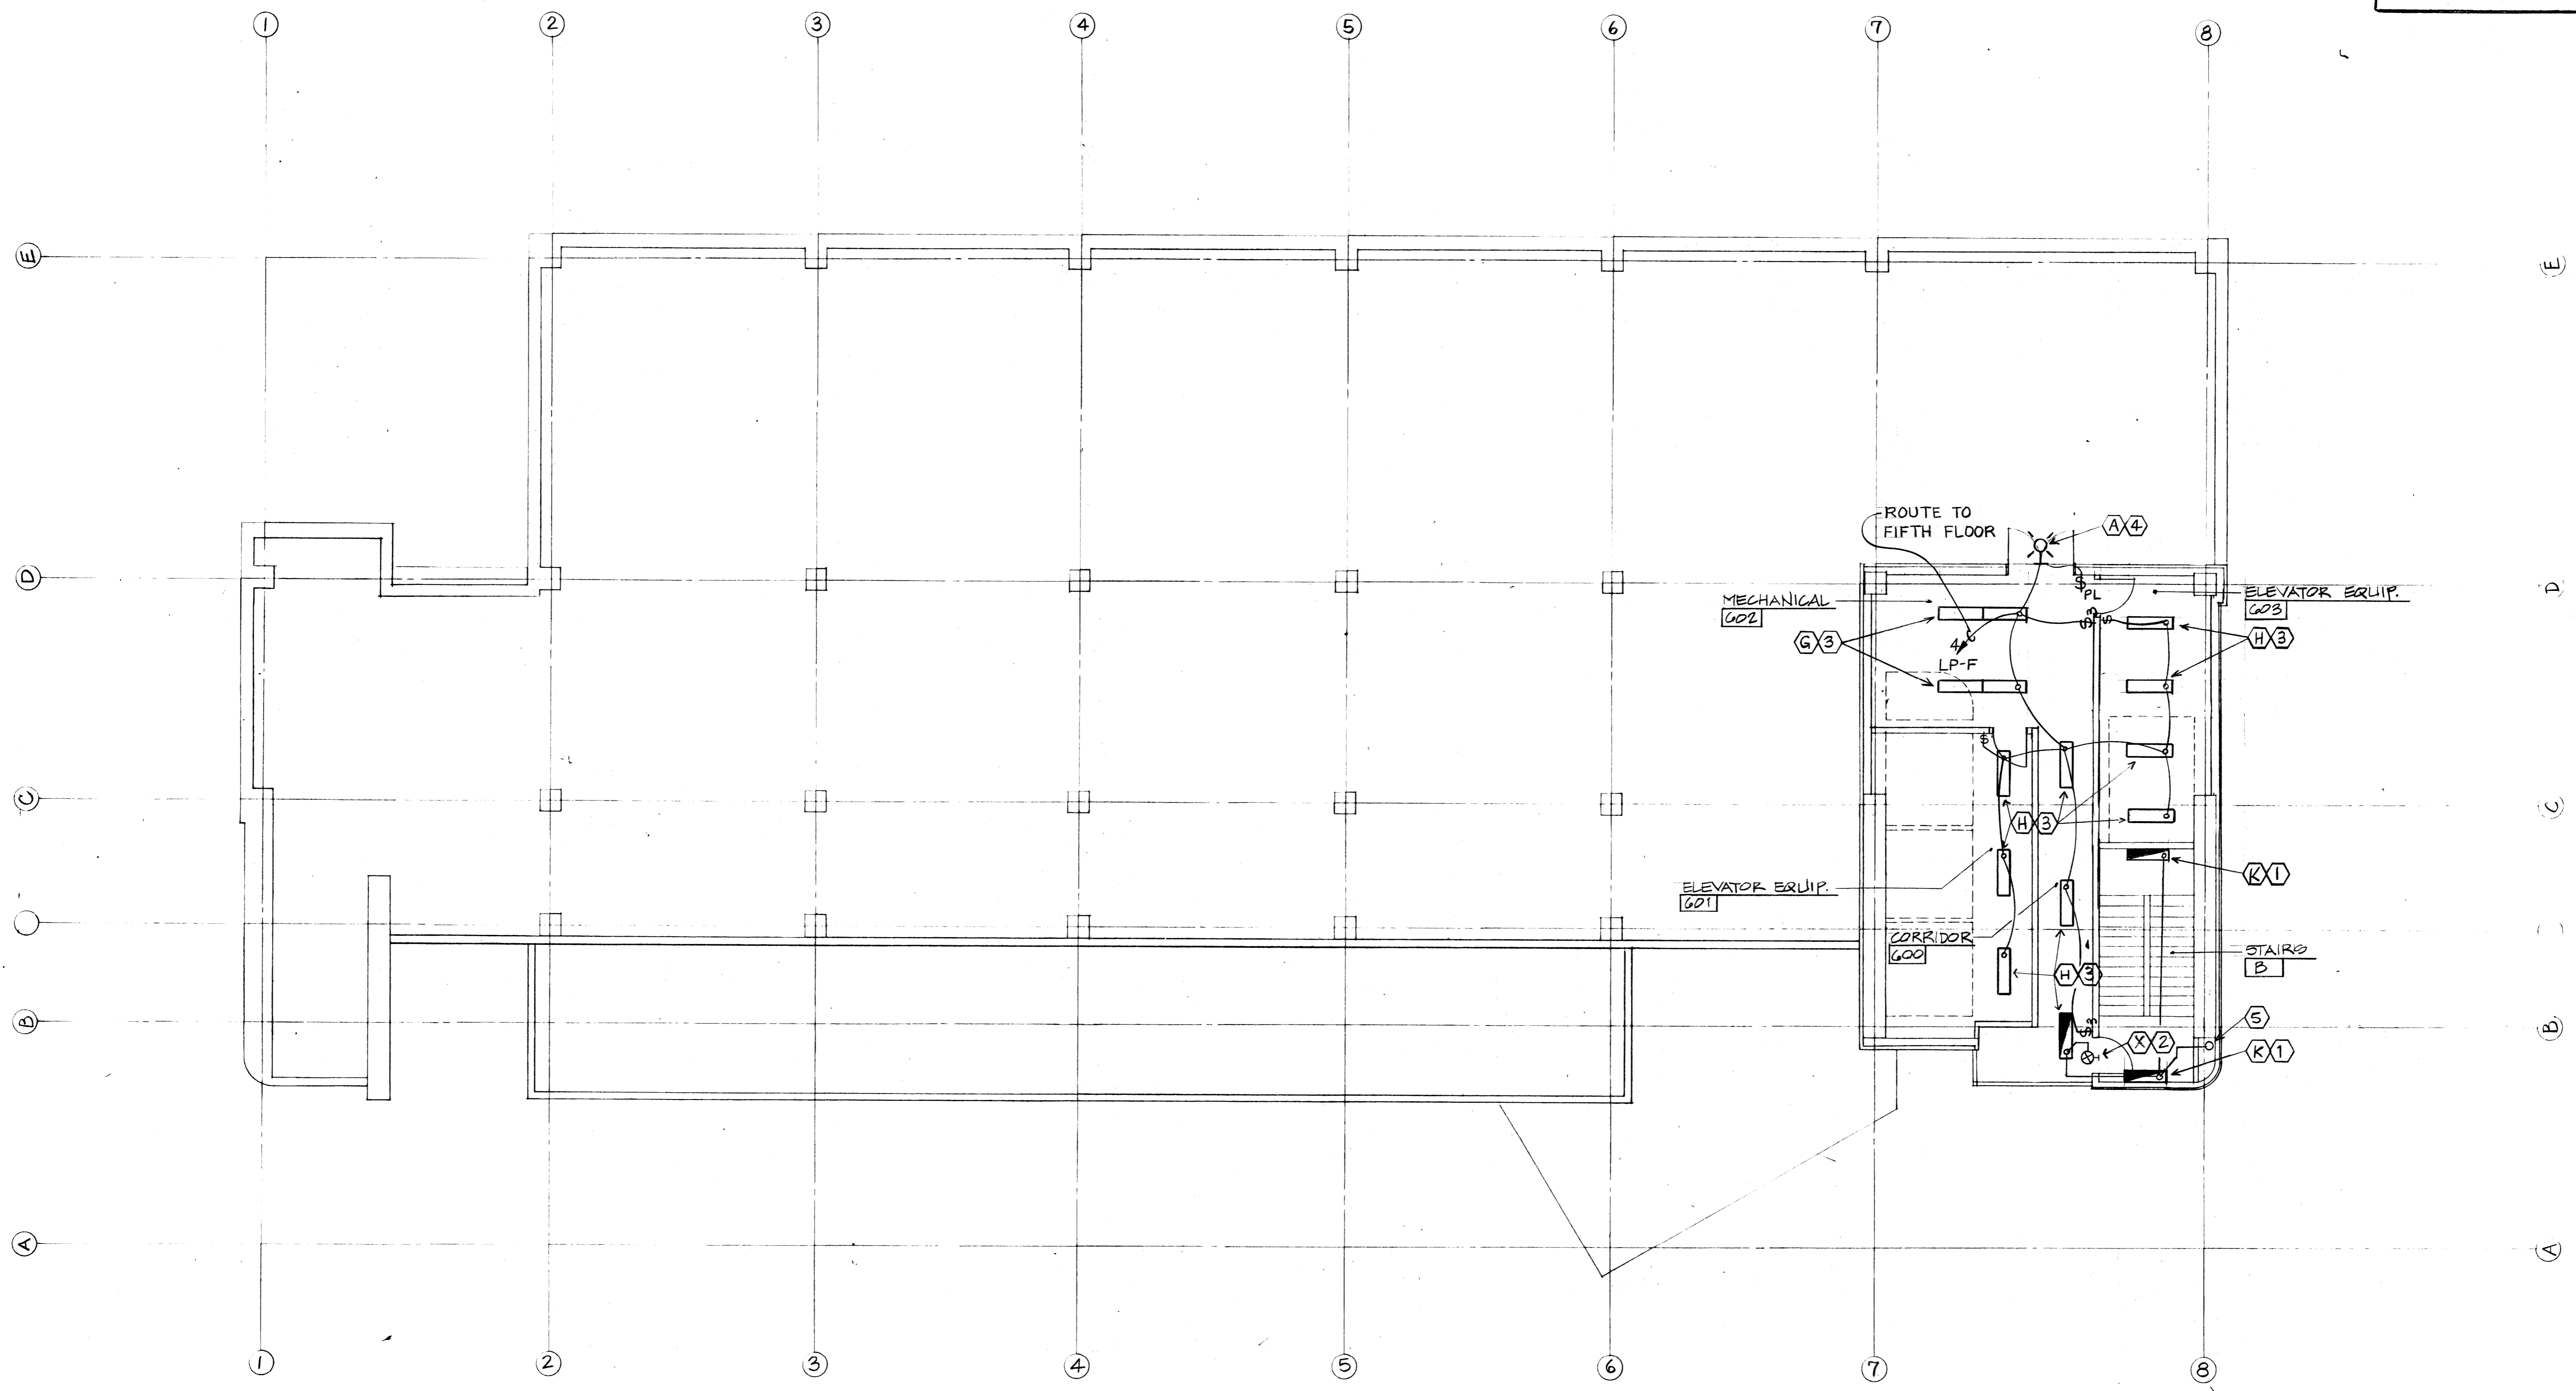

- PENTHOUSE LIGHTING PLAN DRAWING NOTES**
1. MOUNT LUMINAIRE 7'-6" AFF.
 2. MOUNT LUMINAIRE ABOVE DOORWAY.
 3. CHAIN SUSPEND LUMINAIRE TO 9'-0" AFF.
 4. MOUNT LUMINAIRE DIRECTLY ABOVE DOOR.
 5. STAIRWELL LIGHTING POWER RISER ROUTE DOWN TO FIFTH FLOOR. SEE FIFTH FLOOR LIGHTING PLAN.


PENTHOUSE PLAN
SCALE: 1/8"=1'-0"

AS BUILT
3-1-91

BELCAN CORPORATION
10200 ANDERSON WAY
CINCINNATI, OHIO 45242
NUMBER: 4301 CE-013.4

009579

"This seal and signature apply only to the unaltered document to which they are affixed. I expressly disclaim any responsibility for any and all changes made after the issue date, for other plans, specifications, estimates, reports or other documents or instruments relating to or intended to be used for any part or portion of the architectural or engineering project or survey."

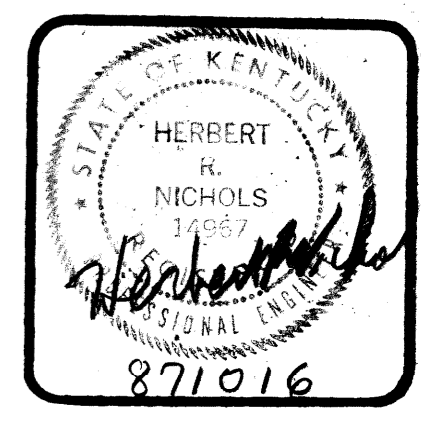

ROBOTICS FACILITY
LEXINGTON CAMPUS
UNIVERSITY OF KENTUCKY
LEXINGTON, KENTUCKY


University of Kentucky
Lexington, Kentucky
APPROVED: *Wendy Swamy*
DATE: 10-19-87
DIRECTOR, DESIGN AND CONSTRUCTION SERVICES

PENTHOUSE POWER PLAN
Sherman Carter Barnhart
PARTNERS IN ARCHITECTURE
SUITE, 1900 • 250 WEST MAIN STREET • LEXINGTON, KY 40507 • 606-754-0351

JOB NO. 8706
DATE 9-30-87
DRAWN D. MEYER
CHECKED M. GOLDBERG
FILE NO. 431-0

REVISIONS
3-90% REVIEW 10-16-87
4-GENERAL 7-15-88
5-RENOVATION 2-16-90

SHEET
E-14

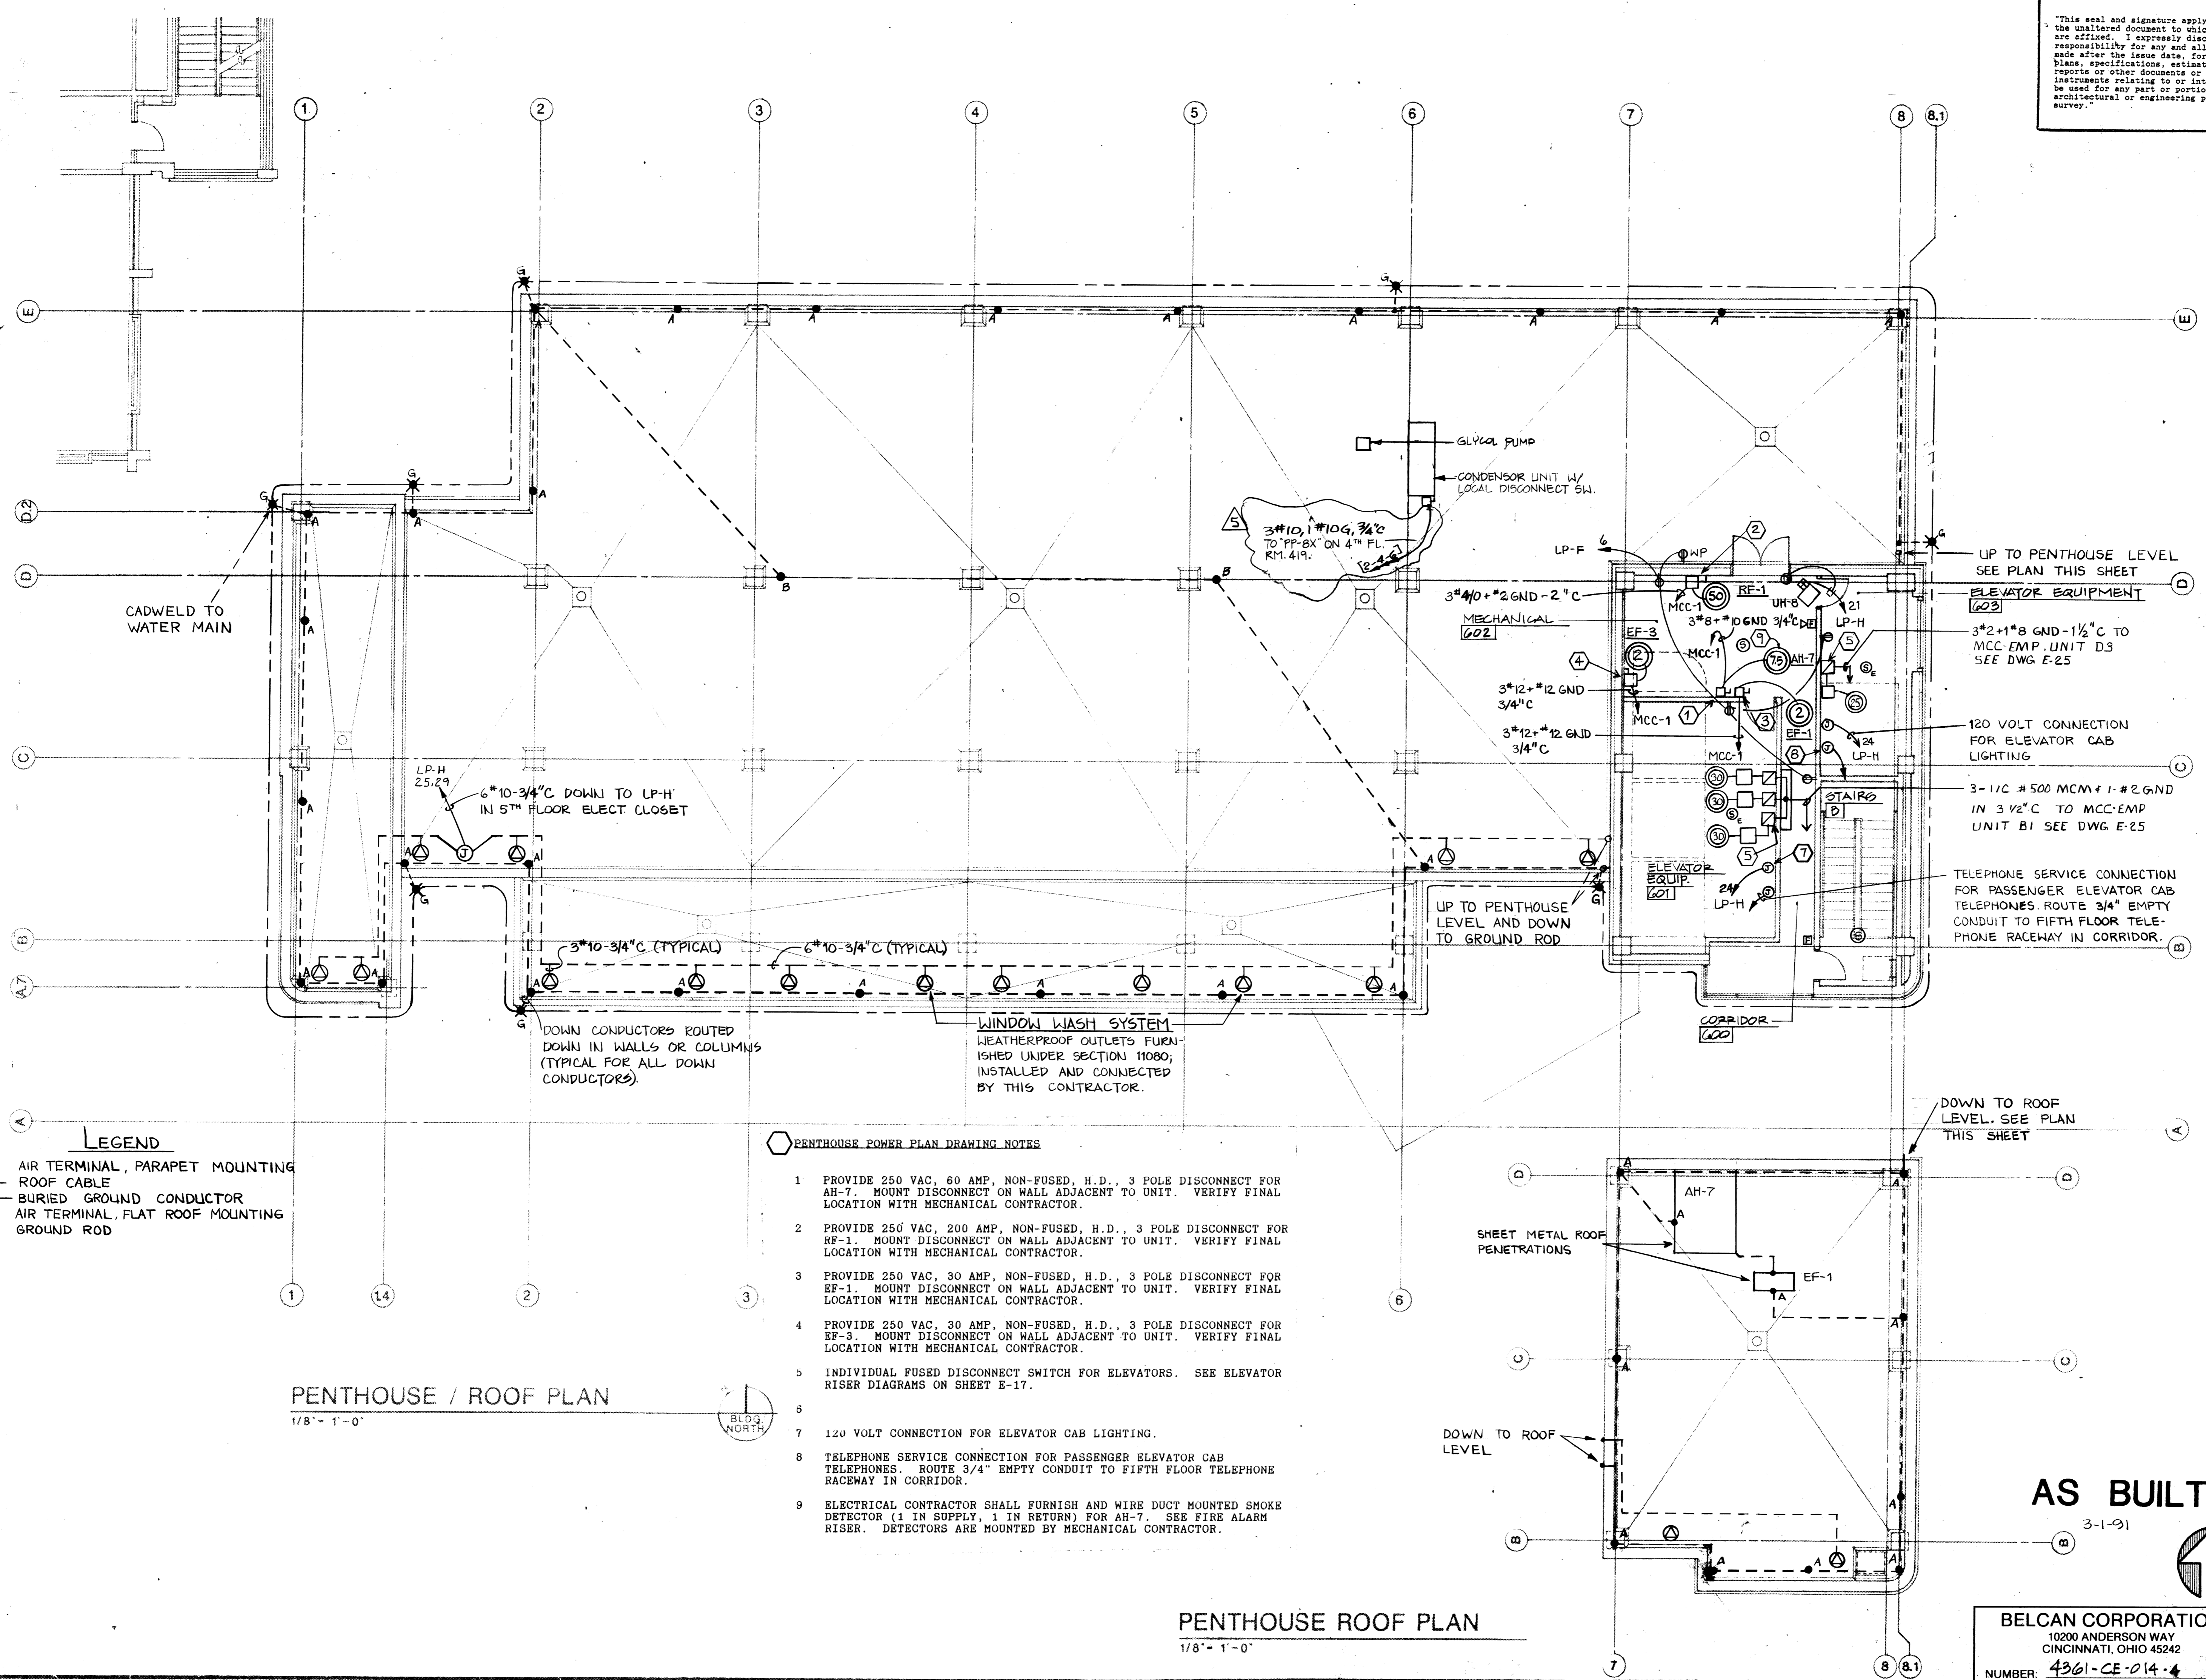

PENTHOUSE / ROOF PLAN
1/8" = 1'-0"

PENTHOUSE ROOF PLAN
1/8" = 1'-0"


AS BUILT
3-1-91

BELCAN CORPORATION
10200 ANDERSON WAY
CINCINNATI, OHIO 45242
NUMBER: 4361-CE-014-4


- PENTHOUSE POWER PLAN DRAWING NOTES**
- 1 PROVIDE 250 VAC, 60 AMP, NON-FUSED, H.D., 3 POLE DISCONNECT FOR AH-7. MOUNT DISCONNECT ON WALL ADJACENT TO UNIT. VERIFY FINAL LOCATION WITH MECHANICAL CONTRACTOR.
 - 2 PROVIDE 250 VAC, 200 AMP, NON-FUSED, H.D., 3 POLE DISCONNECT FOR RF-1. MOUNT DISCONNECT ON WALL ADJACENT TO UNIT. VERIFY FINAL LOCATION WITH MECHANICAL CONTRACTOR.
 - 3 PROVIDE 250 VAC, 30 AMP, NON-FUSED, H.D., 3 POLE DISCONNECT FOR EF-1. MOUNT DISCONNECT ON WALL ADJACENT TO UNIT. VERIFY FINAL LOCATION WITH MECHANICAL CONTRACTOR.
 - 4 PROVIDE 250 VAC, 30 AMP, NON-FUSED, H.D., 3 POLE DISCONNECT FOR EF-3. MOUNT DISCONNECT ON WALL ADJACENT TO UNIT. VERIFY FINAL LOCATION WITH MECHANICAL CONTRACTOR.
 - 5 INDIVIDUAL FUSED DISCONNECT SWITCH FOR ELEVATORS. SEE ELEVATOR RISER DIAGRAMS ON SHEET E-17.
 - 6
 - 7 120 VOLT CONNECTION FOR ELEVATOR CAB LIGHTING.
 - 8 TELEPHONE SERVICE CONNECTION FOR PASSENGER ELEVATOR CAB TELEPHONES. ROUTE 3/4" EMPTY CONDUIT TO FIFTH FLOOR TELEPHONE RACEWAY IN CORRIDOR.
 - 9 ELECTRICAL CONTRACTOR SHALL FURNISH AND WIRE DUCT MOUNTED SMOKE DETECTOR (1 IN SUPPLY, 1 IN RETURN) FOR AH-7. SEE FIRE ALARM RISER. DETECTORS ARE MOUNTED BY MECHANICAL CONTRACTOR.

- LEGEND**
- *A AIR TERMINAL, PARAPET MOUNTING
 - ROOF CABLE
 - BURIED GROUND CONDUCTOR
 - *B AIR TERMINAL, FLAT ROOF MOUNTING
 - *G GROUND ROD


ENLARGED ELECTRICAL ROOMS
SCALE: 1/4" = 1'-0"

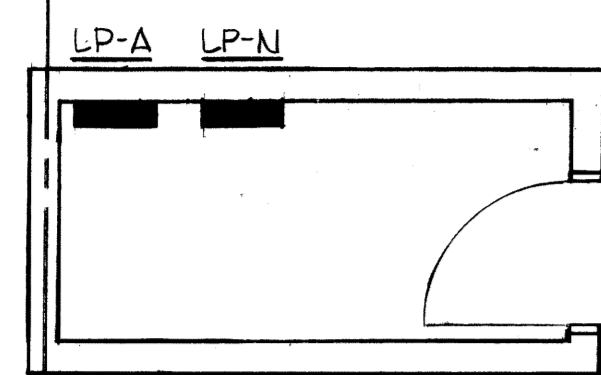


BASEMENT FLOOR

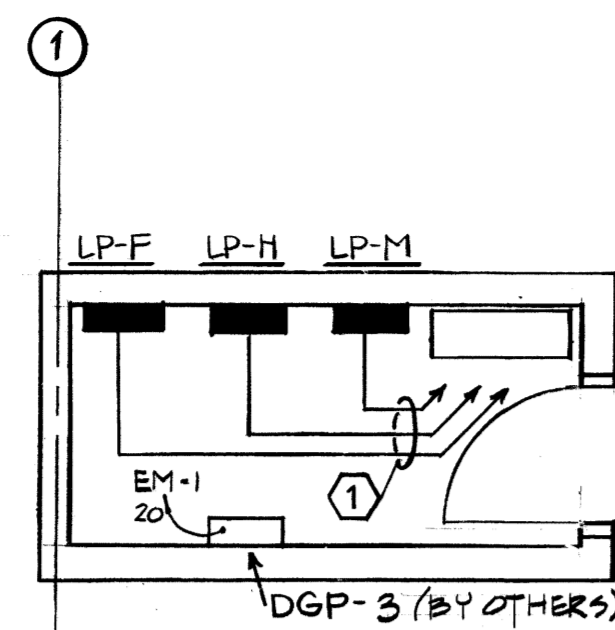


FIFTH FLOOR

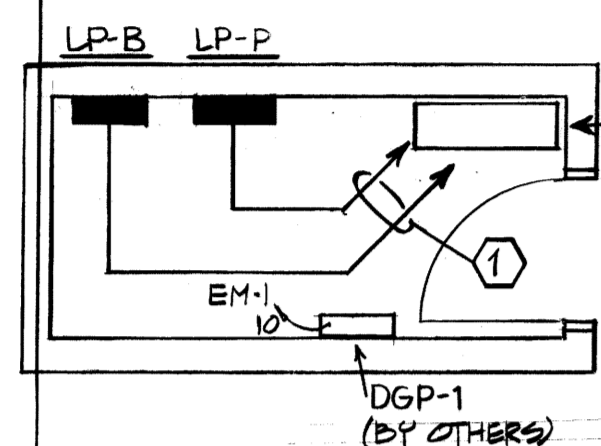


FIRST FLOOR

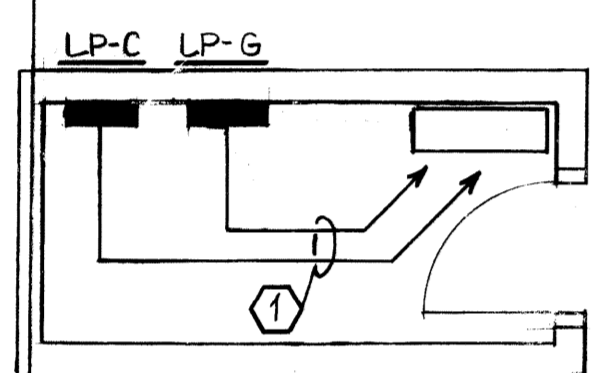

SECOND FLOOR

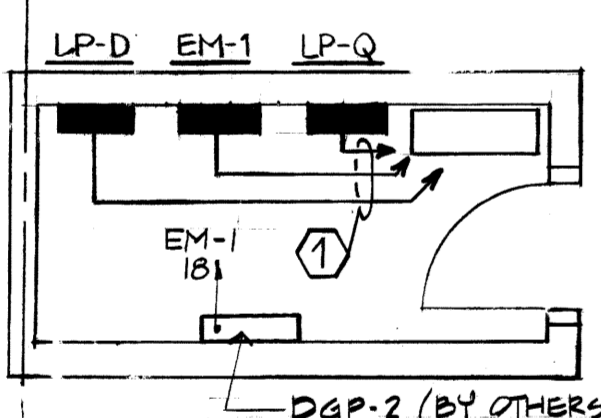


THIRD FLOOR

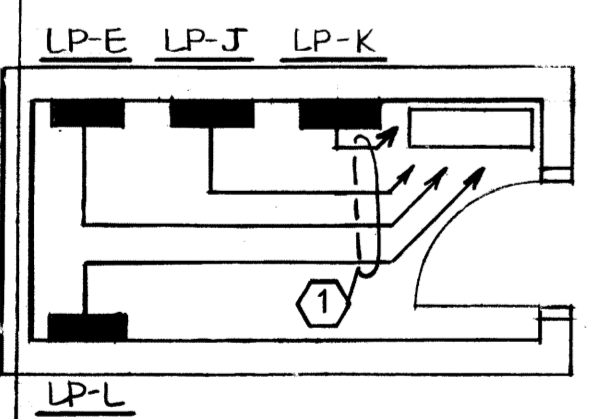

FOURTH FLOOR


12" W x 36" L RECTANGULAR METAL SLEEVE THROUGH FLOOR SLAB FOR PANEL FEEDER HOMERUN TO MAIN DISTRIBUTION IN BASEMENT. TYPICAL FOR FLOORS 1-5. FIRE SEAL REMAINING OPENING NOT USED BY CONDUIT.

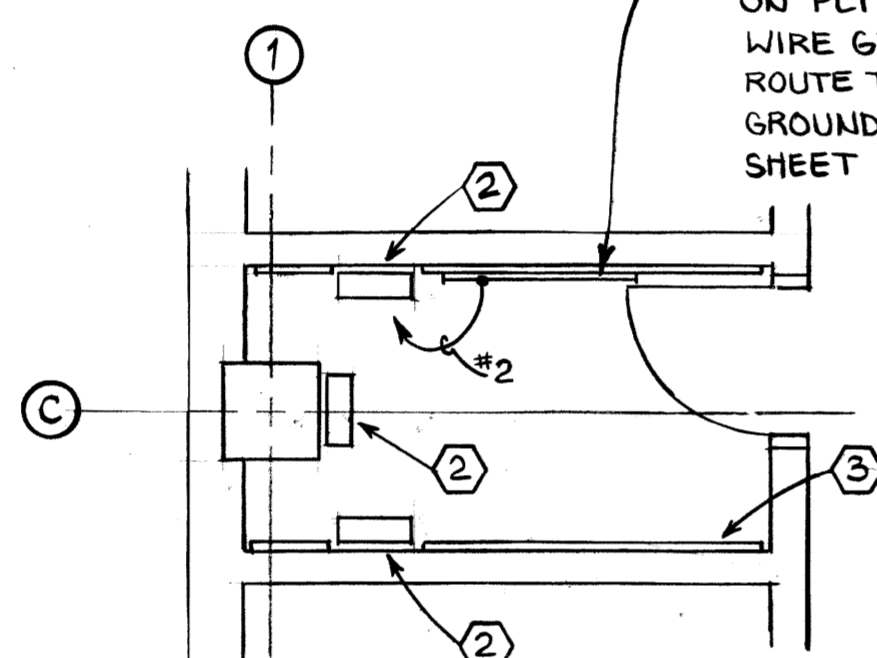

TYPICAL COMMUNICATIONS ROOM
BASEMENT THRU FIFTH FLOORS
SCALE: 1/4" = 1'-0"


- COMMUNICATIONS & ELECTRICAL ROOM NOTES**
- ROUTE PANEL BOARD FEEDERS THRU SLEEVE IN FLOOR DOWN TO MAIN DISTRIBUTION BOARD IN ELECTRICAL EQUIPMENT ROOM B-13. SEE SINGLE LINE FOR SIZE OF FEEDERS.
 - 4" W x 18" L RECTANGULAR METAL SLEEVE THROUGH FLOOR SLAB FOR COMMUNICATION CONDUIT.
 - 3/4" x 10'-0" HIGH EXTERIOR GRADE PLYWOOD MOUNTED 2'-0" ABOVE FLOOR.

1/4" THICK x 1" WIDE x 1'-0" LONG COPPER GROUND BAR MOUNTED 2'-6" AFF ON PLYWOOD. CAD WELD #2 GREEN WIRE GROUND-3/4" C TO BAR THEN ROUTE TO TRIAD AT EXTERIOR. SEE GROUNDING RISER DIAGRAM ON SHEET E-18.

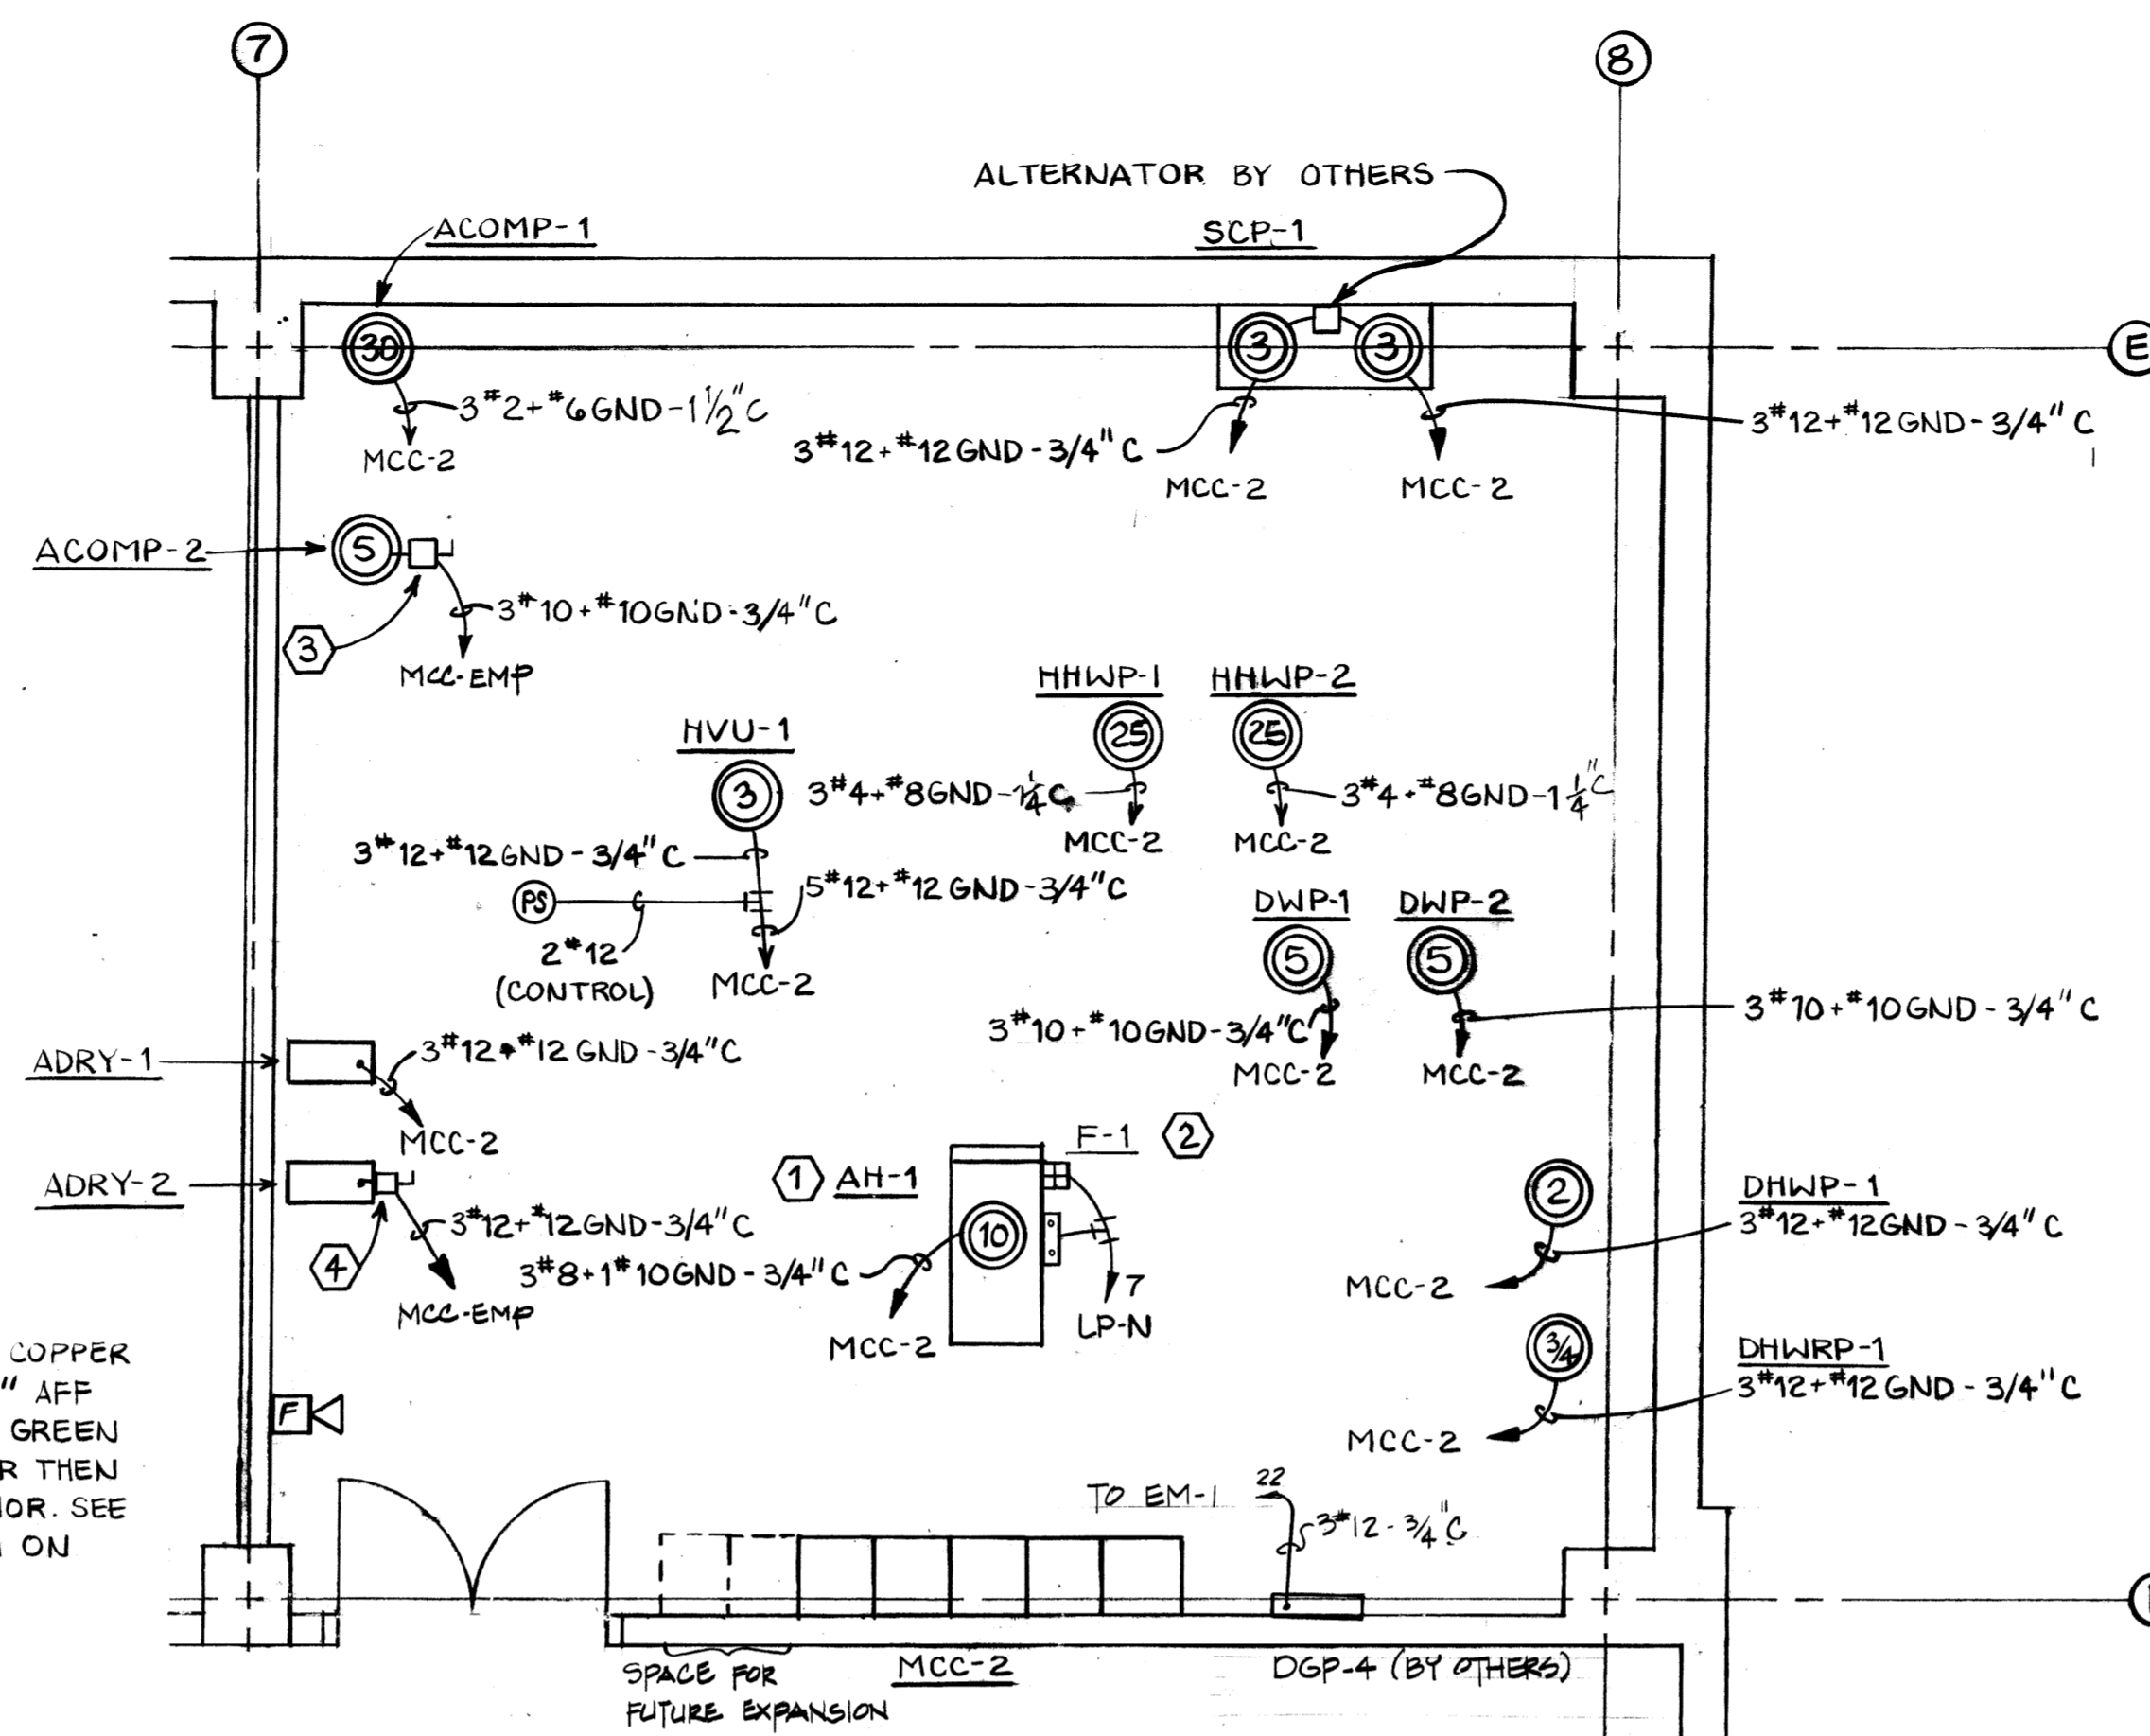

ENLARGED MECHANICAL PLAN

SCALE: 1/4" = 1'-0"

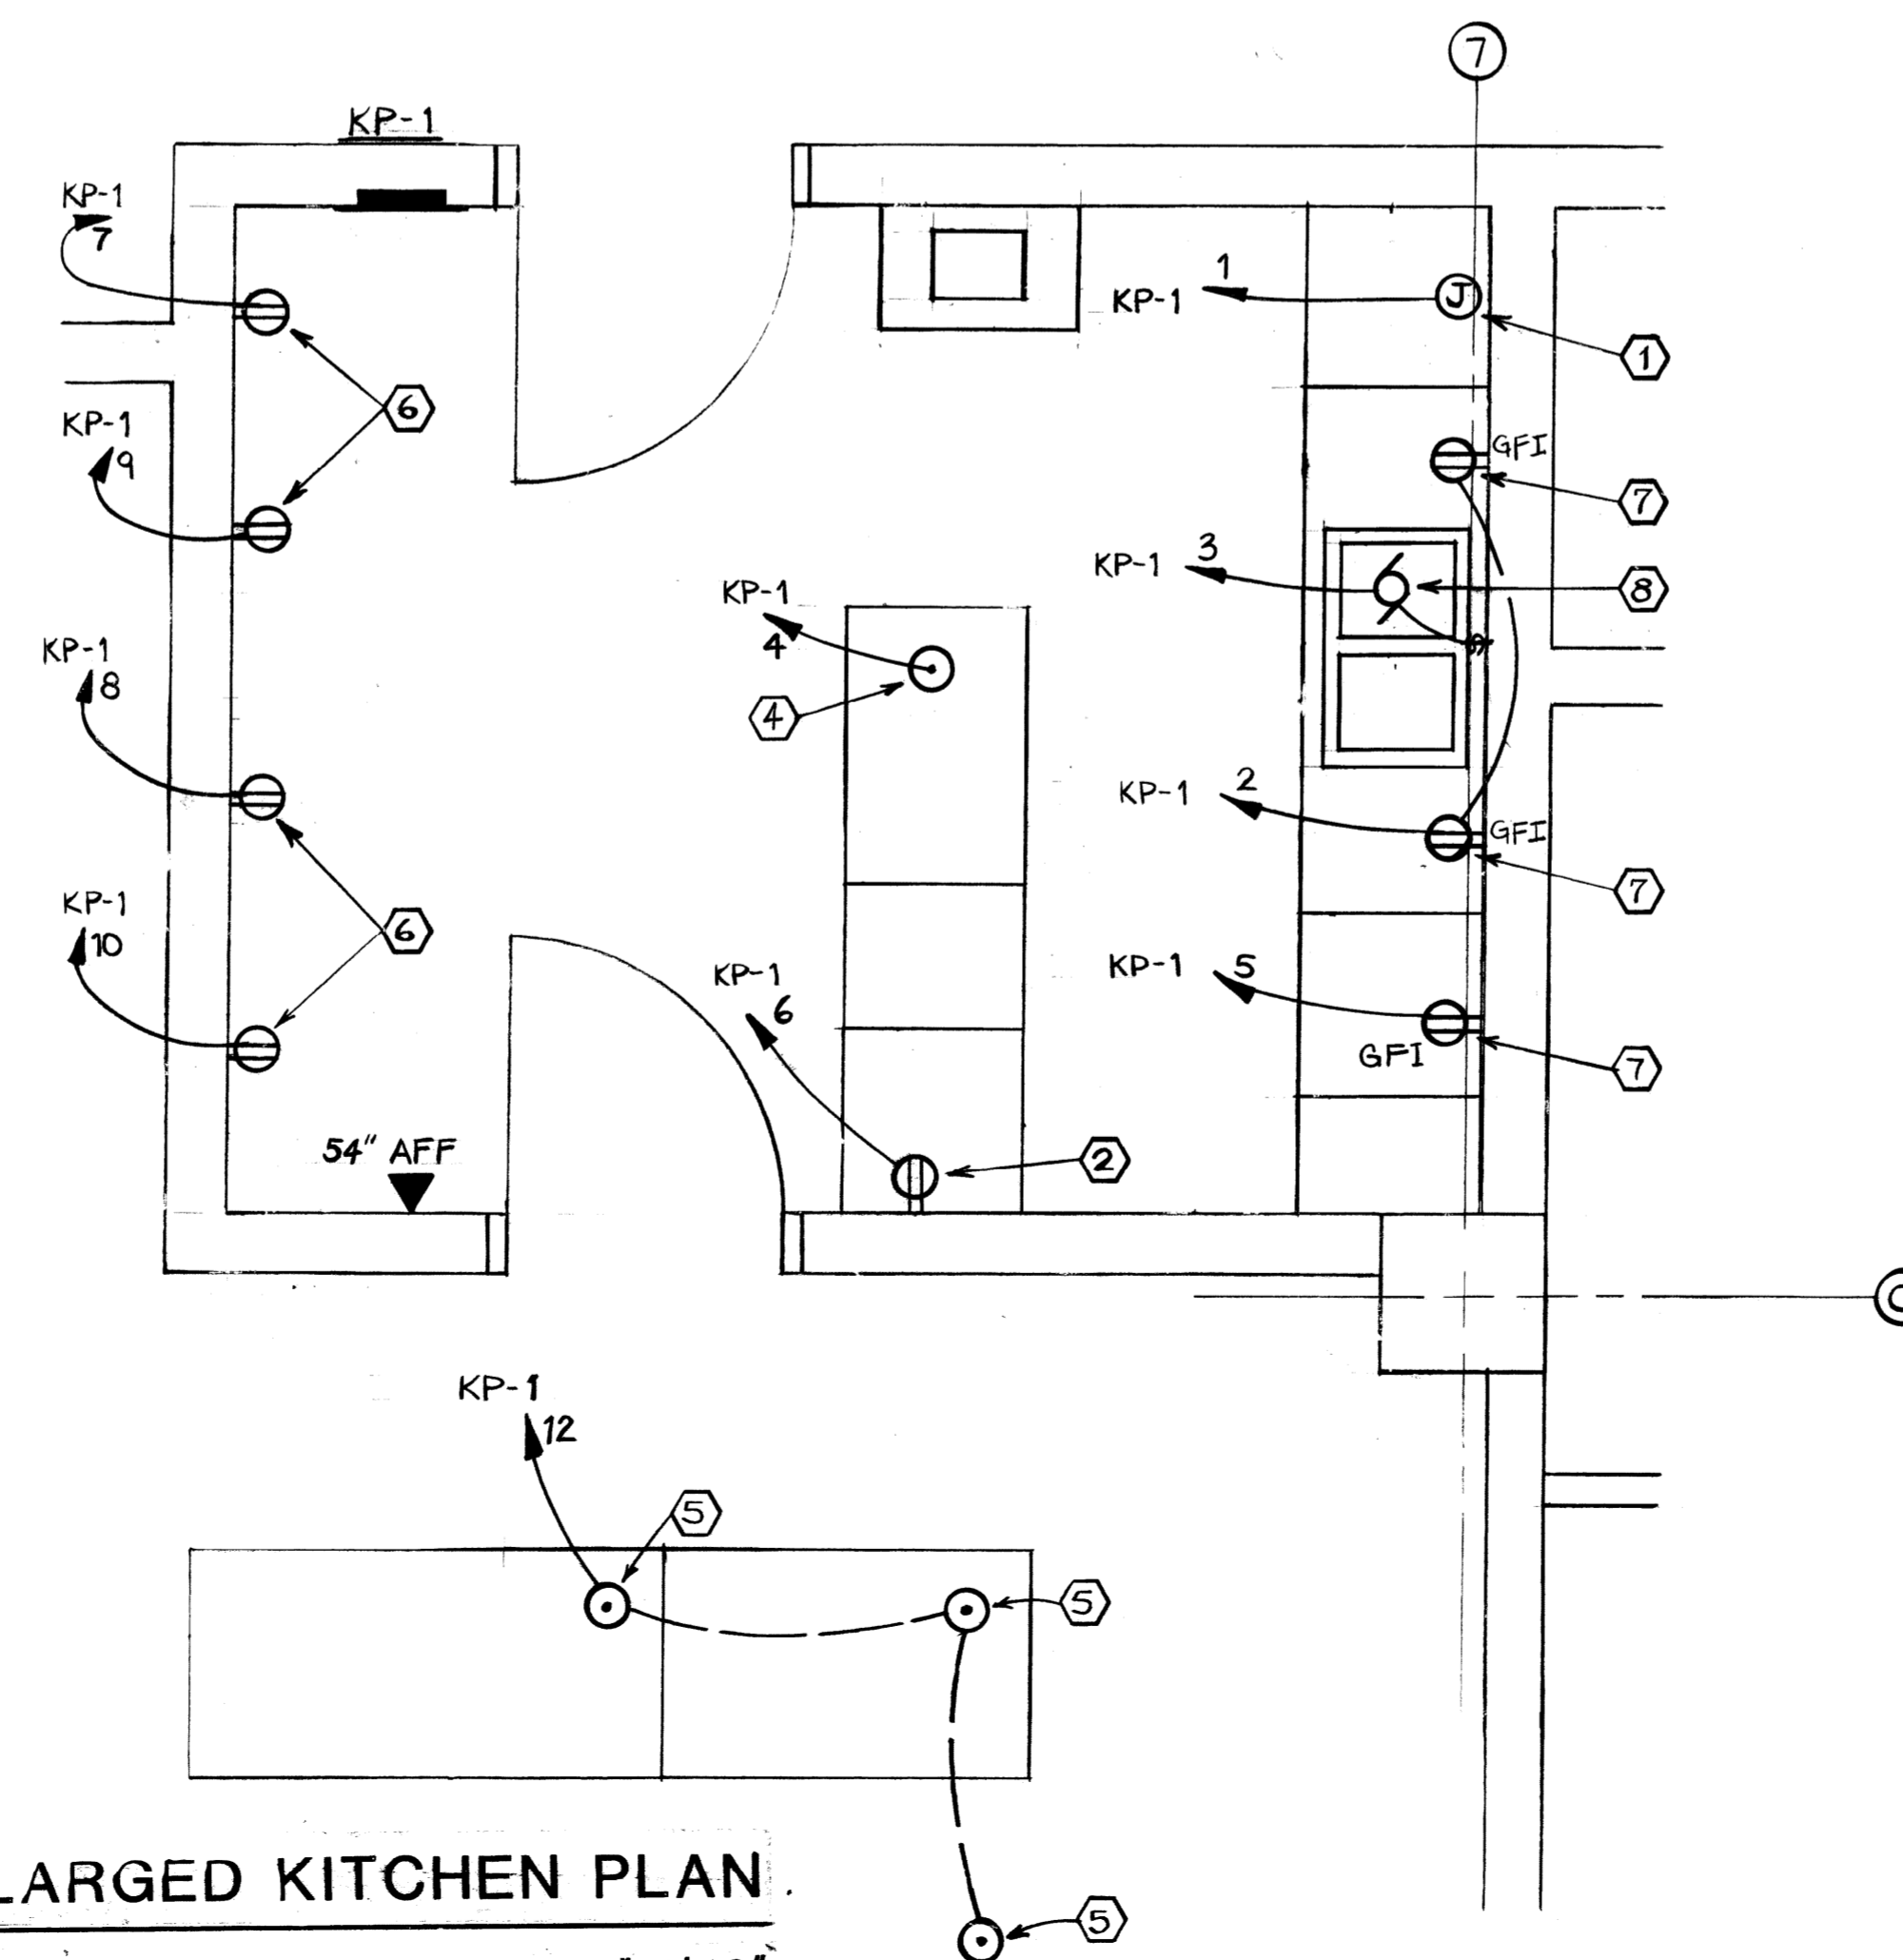

ENLARGED KITCHEN PLAN

SCALE: 1/2" = 1'-0"

NOTES

CONNECTIONS TO ALL MOTORS IN MECHANICAL ROOM SHALL BE IN SEAL TITE FLEXIBLE CABLE. LENGTH SHALL BE (2) TIMES THE DISTANCE TO MOTOR TERMINAL BOX.


ENLARGED MECHANICAL ROOM DRAWING NOTES

- ELECTRICAL CONTRACTOR SHALL FURNISH AND WIRE DUCT MOUNTED SMOKE DETECTOR (1 IN SUPPLY, 1 IN RETURN) FOR AH-1. SEE FIRE ALARM RISER. DETECTORS ARE MOUNTED BY MECHANICAL CONTRACTOR.
- ROUTE TO 120 VAC POWER FOR ROLLER FILTER F-1 AS INDICATED. MANUAL MOTOR STARTER AND START-STOP BUTTON FURNISHED AND INSTALLED BY MECHANICAL CONTRACTOR.
- PROVIDE 30 AMP, 250 VAC, H.D. 3 PHASE NON-FUSED DISCONNECT FOR A COMP-2. VERIFY MOUNTING LOCATION WITH MECHANICAL CONTRACTOR.
- PROVIDE 30 AMP, 250 VAC, H.D. 3 PHASE, NON-FUSED DISCONNECT FOR ADRY-2. VERIFY MOUNTING LOCATION WITH MECHANICAL CONTRACTOR.

ENLARGED KITCHEN POWER PLAN NOTES

- MOUNT JUNCTION BOX 48" AFF FOR DIRECT CONNECTION TO DISCONNECT. VERIFY FINAL CONNECTION WITH MANUFACTURER.
- MOUNT RECEPTACLE 26" AFF FOR REFRIGERATOR.
- MOUNT RECEPTACLE 42" AFF FOR COUNTERTOP MICROWAVE.
- CORE DRILL FLOOR SLAB FOR FLUSH TYPE FLOOR RECEPTACLE FOR ICE BIN. ROUTE TO CIRCUIT UNDER FLOOR SLAB AND UP TO PANEL. VERIFY FINAL LOCATION OF EQUIPMENT PRIOR TO INSTALLATION.
- CORE DRILL FLOOR SLAB FOR FLUSH TYPE FLOOR RECEPTACLE FOR FOOD UNITS. ROUTE FEED UNDER FLOOR AND UP TO PANEL. VERIFY FINAL LOCATION OF EQUIPMENT PRIOR TO INSTALLATION.
- EQUALLY SPACE RECEPTACLES ON WALL FOR FOOD WARMERS VERIFY TERMINATION REQUIREMENTS WITH MANUFACTURER PRIOR TO INSTALLATION.
- MOUNT GFI RECEPTACLES 42" AFF FOR ABOVE COUNTER RECEPTACLES. MOUNT RECEPTACLES HORIZONTALLY.
- PROVIDE CONNECTION TO DISPOSAL. MOUNT SWITCH ON WALL ADJACENT TO SINK FOR DISCONNECTING MEANS.

"This seal and signature apply only to the unaltered document to which they are affixed. I expressly disclaim any responsibility for any and all changes made after the issue date, for other plans, specifications, estimates, reports or other documents or instruments relating to or intended to be used for any part or portion of the architectural or engineering project or survey."

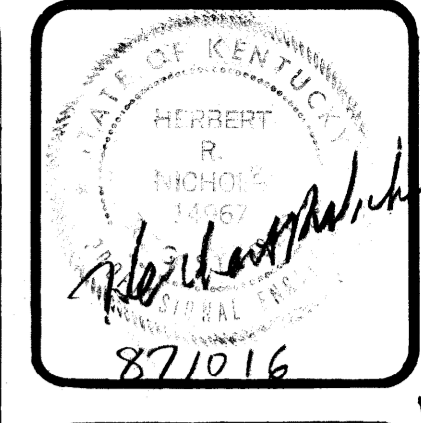

ROBOTICS FACILITY
LEXINGTON CAMPUS
UNIVERSITY OF KENTUCKY
LEXINGTON, KENTUCKY

University of Kentucky
Lexington, Kentucky
10.19.87
W. MEYER
Director - design and construction division

ELECTRICAL CLOSETS PLAN
SHERMAN CARTER BARNHART
PARTNERS IN ARCHITECTURE
SUITE 1800 • 250 WEST MAIN STREET • LEXINGTON, KY 40507 • 606.254.1851

JOB NO. 8706
DATE 9-30-87
DRAWN D. MEYER
CHECKED M. GOLDBERG
DATE FILED 431.0

REVISIONS
3-10% REVIEW 10-16-87
4-GENERAL 7-18-88


SHEET
E-15
Cah # 83
Sheet Document# 004981
B-2



AS BUILT


3-1-91

BELCAN CORPORATION
10200 ANDERSON WAY
CINCINNATI, OHIO 45242
NUMBER: 4361-CE-015-4

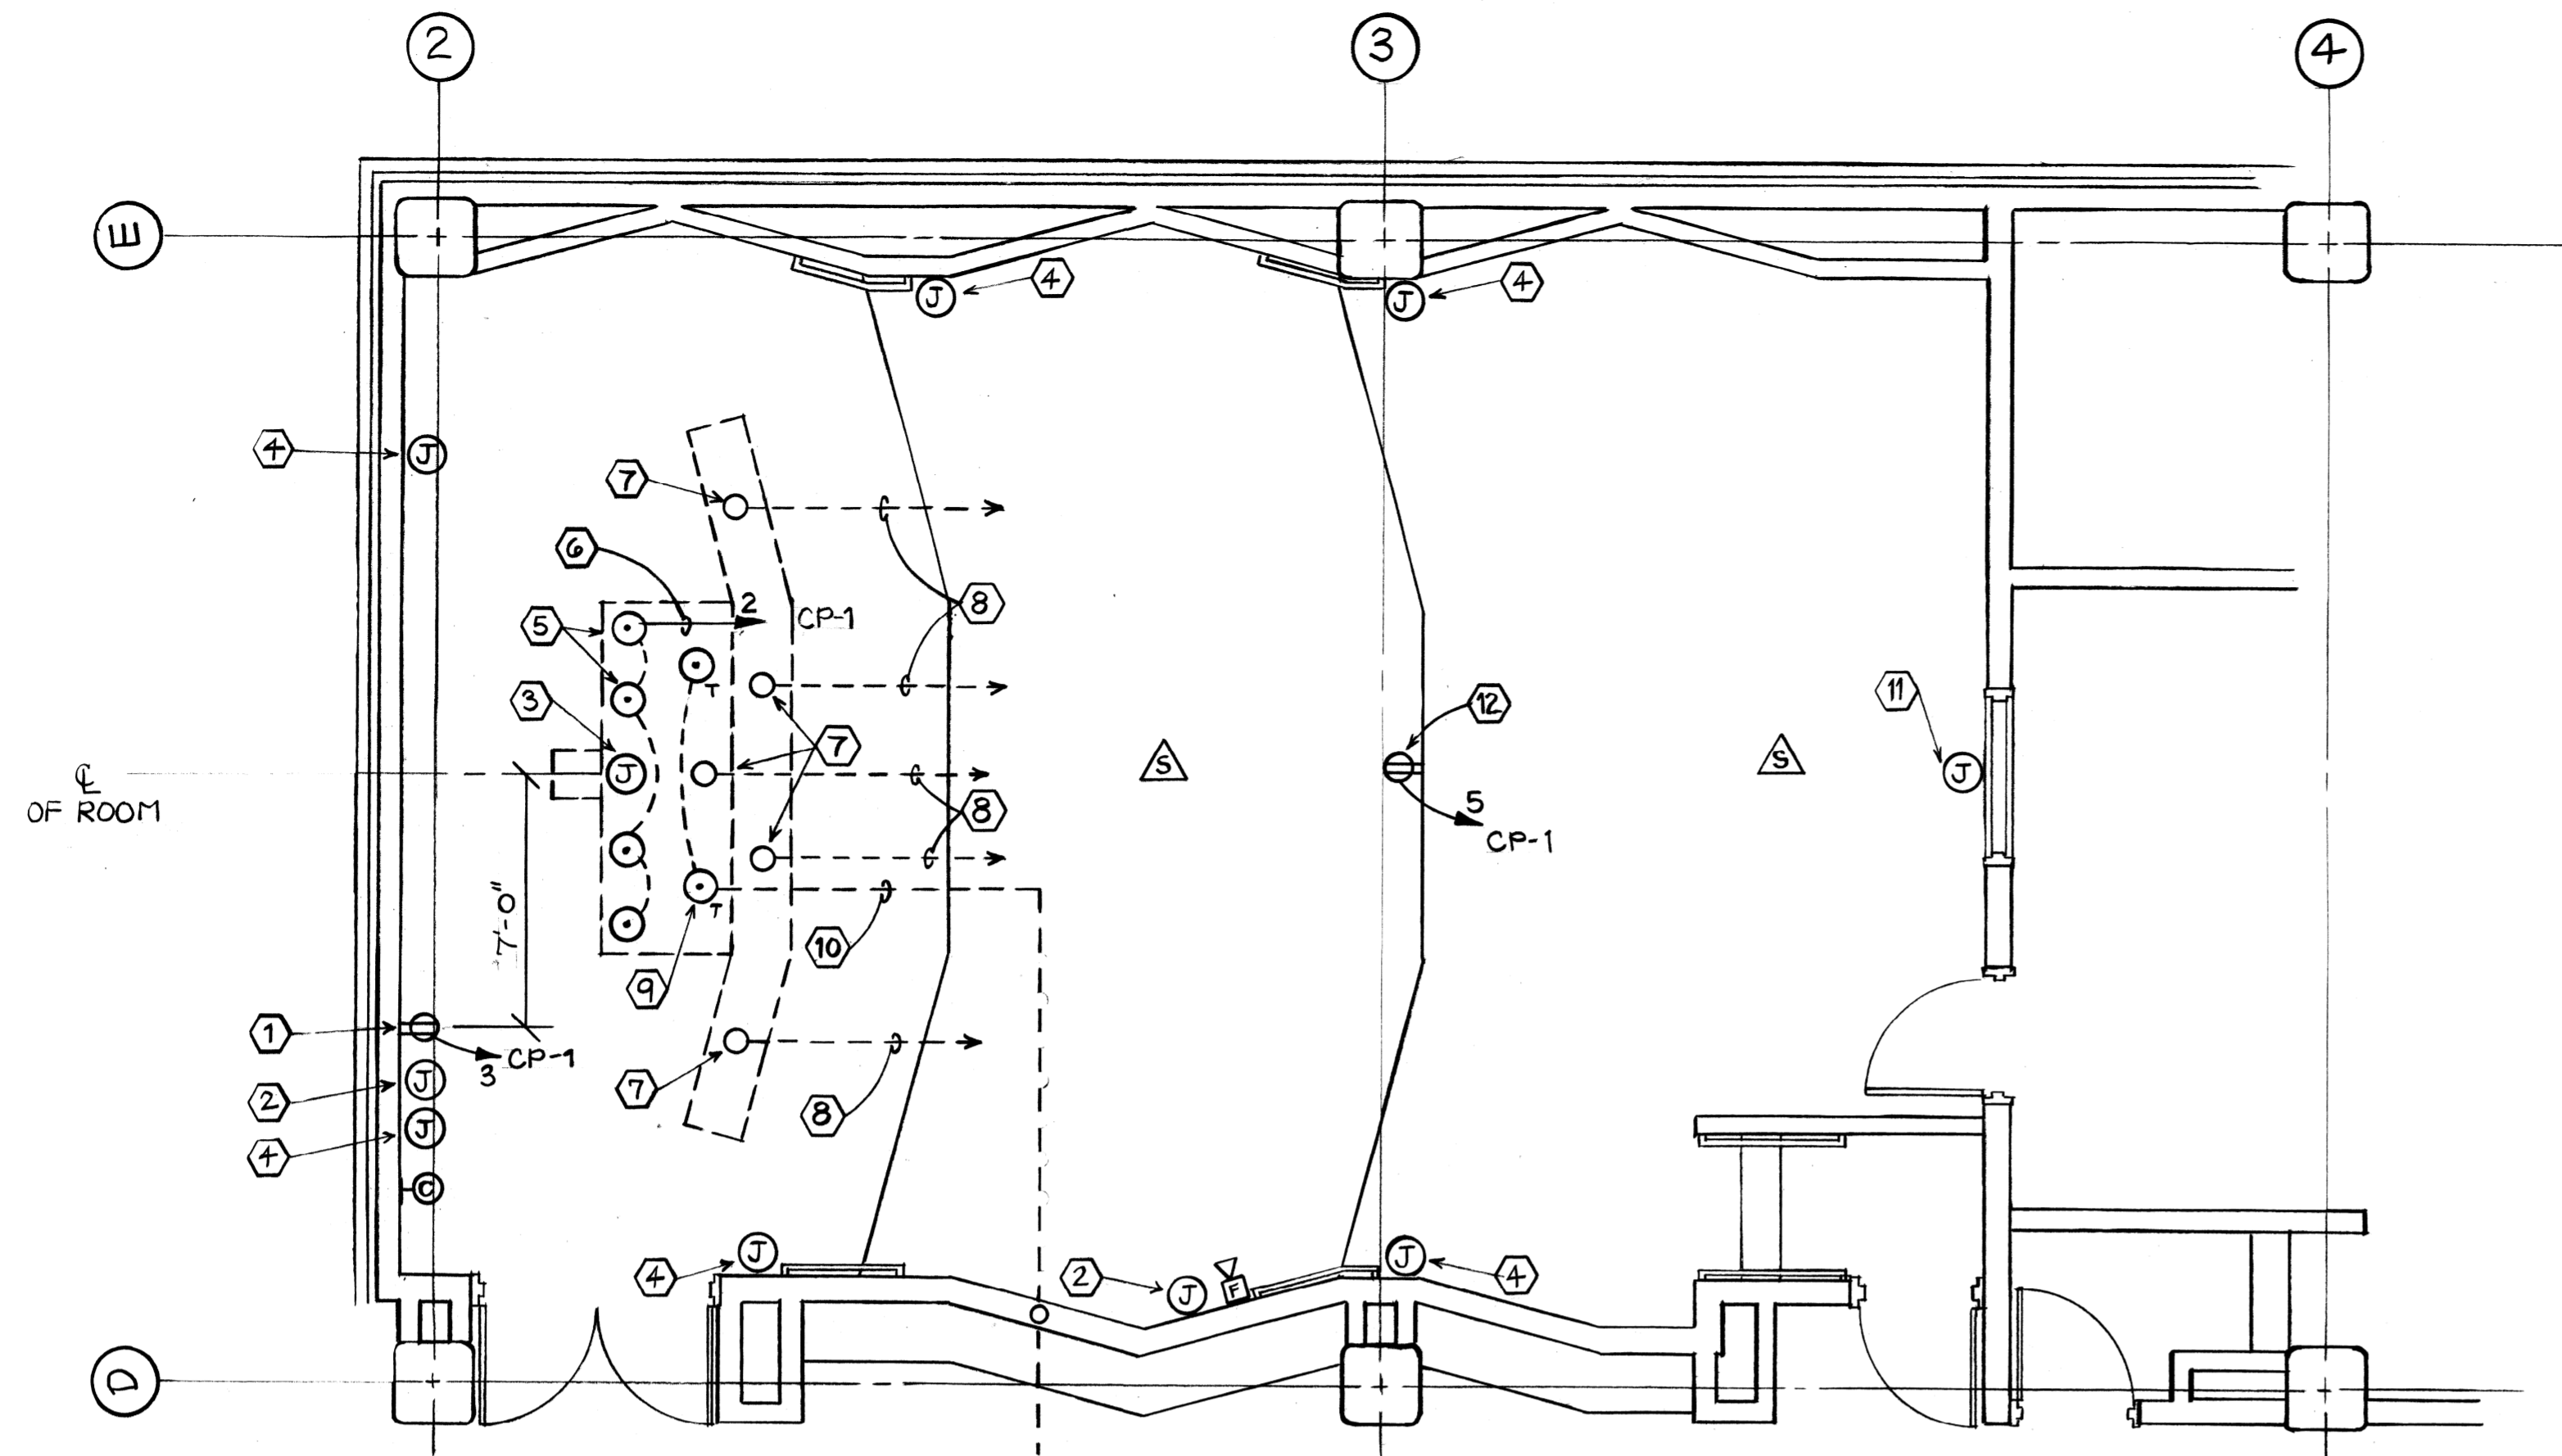

ENLARGED INSTRUCTIONAL
TELEVISION ROOM 312

SCALE: 1/4" = 1'-0"

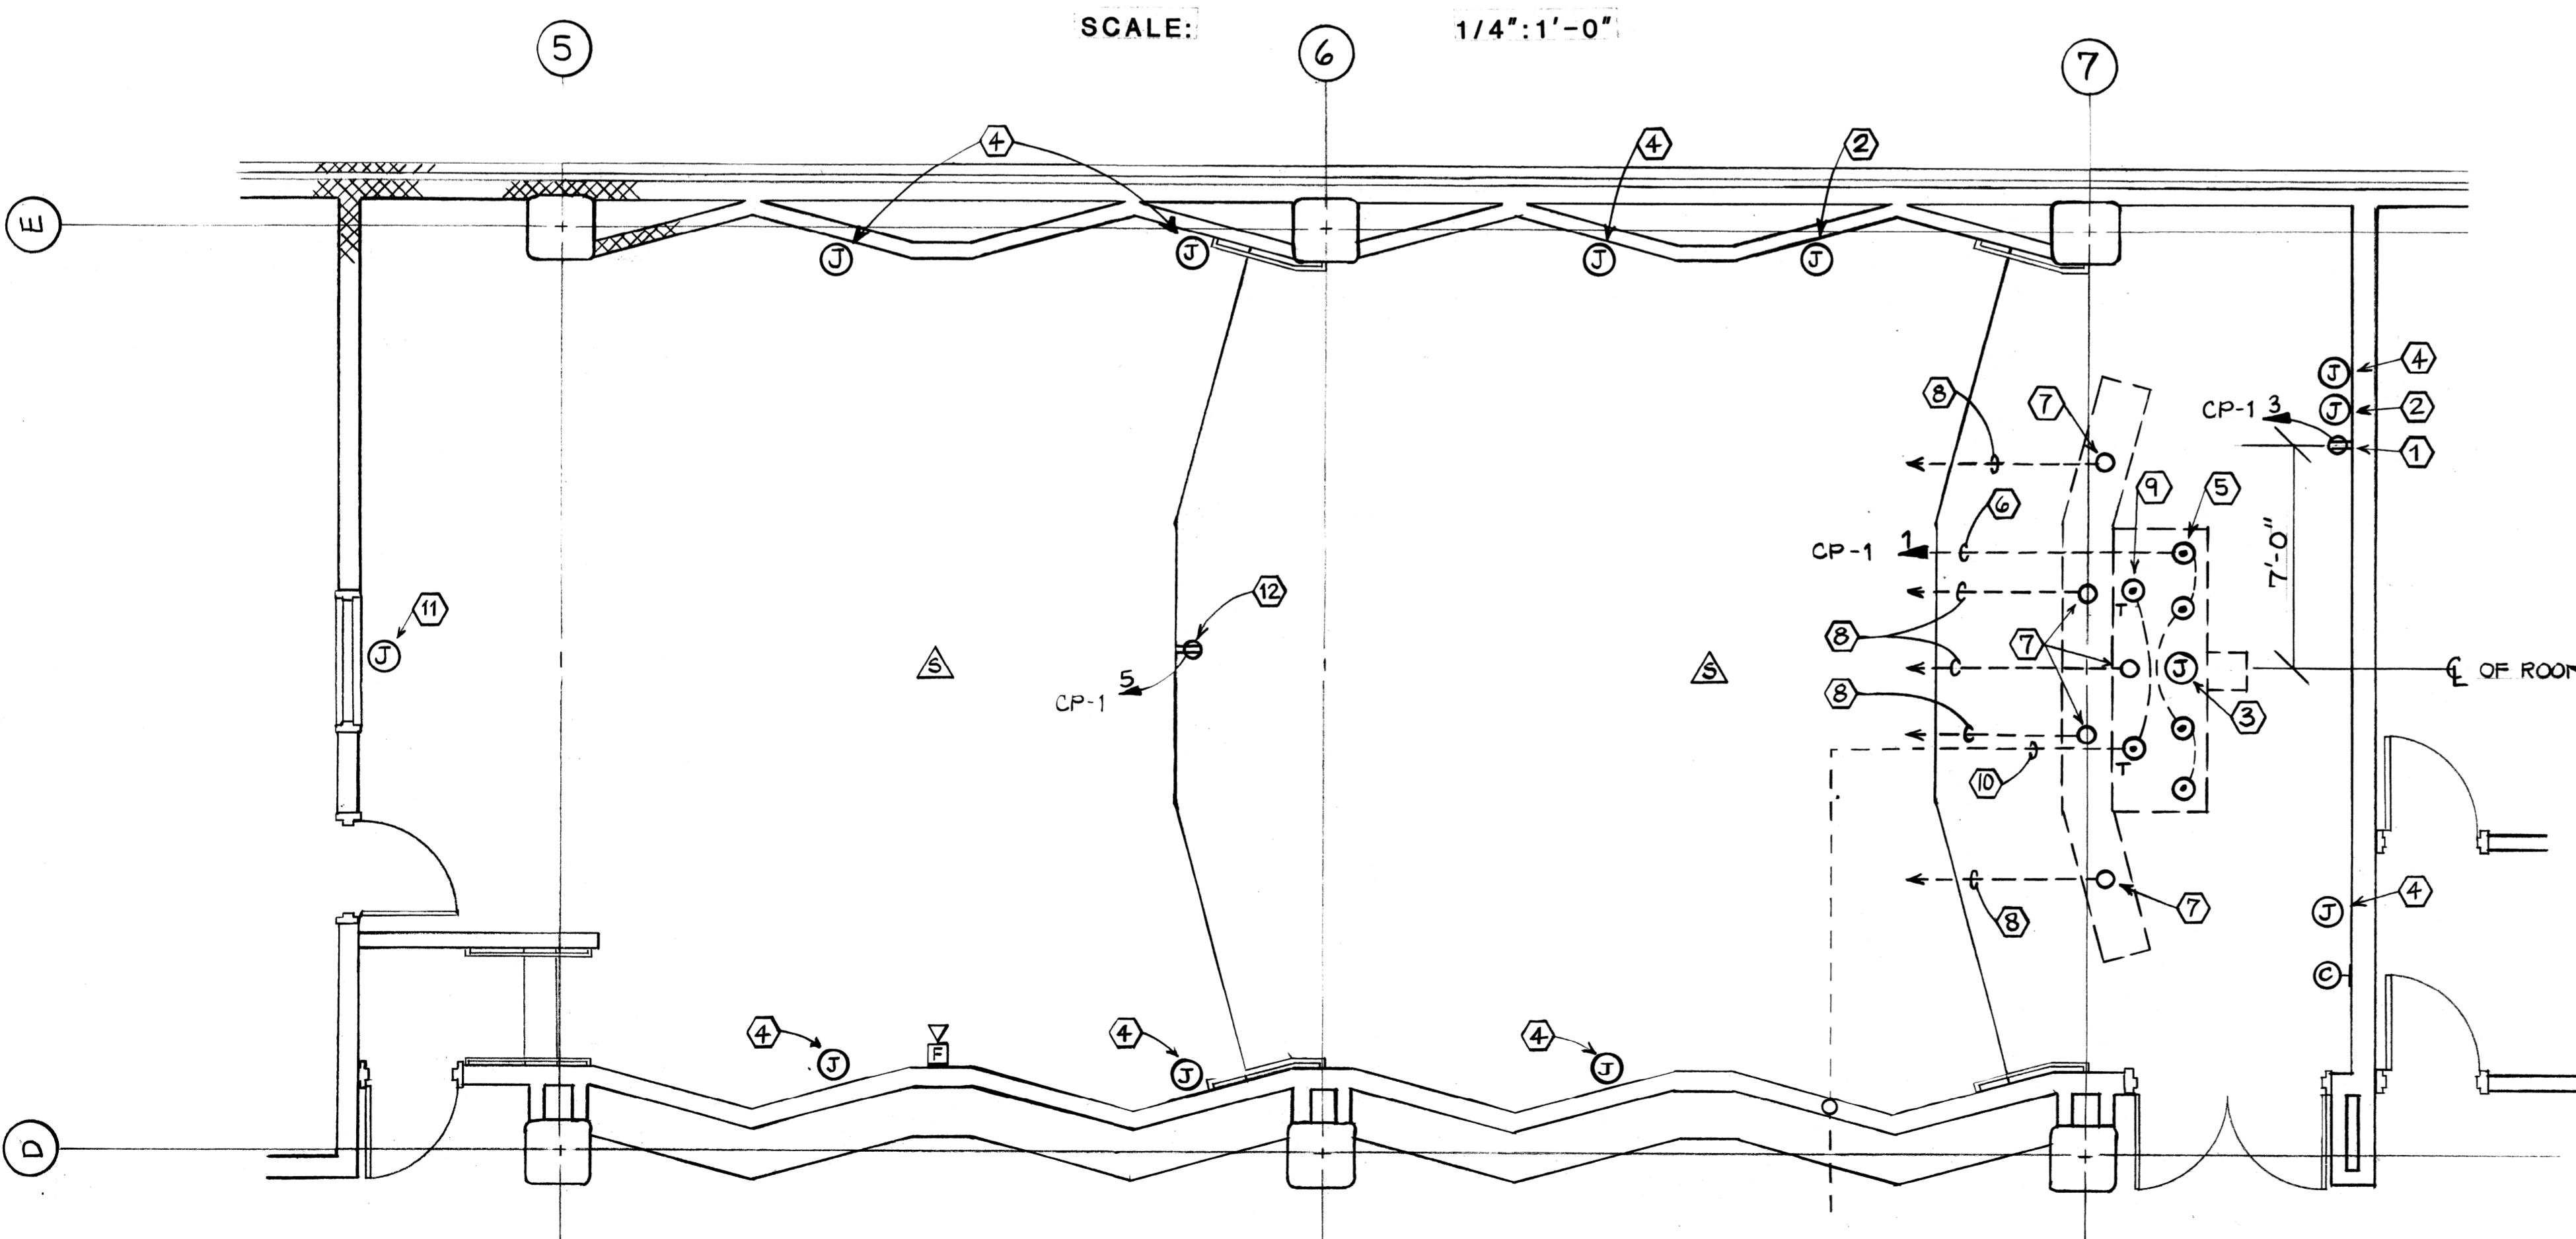


ENLARGED INSTRUCTIONAL
TELEVISION ROOM 308

SCALE: 1/4" = 1'-0"

ENLARGED ITV ROOMS DRAWING NOTES

- 1 MOUNT RECEPTACLE FOR MOTORIZED PROJECTION SCREEN IN WALL 8'-0" AFF. VERIFY RECEPTACLE TYPE WITH SCREEN MANUFACTURER. ROUTE FEED BACK TO CONTROL ROOM PANEL VIA PUSHBUTTON CONTROL DEVICE.
- 2 PROVIDE FLUSH MOUNTED JUNCTION BOX IN WALL 8'-0" AFF FOR T.V. CAMERA. ROUTE 1-1/2" EMPTY CONDUIT FROM JUNCTION BOX TO CONTROL ROOM PROVIDE GROMMETTED COVER PLATE.
- 3 PROVIDE FLUSH MOUNTED JUNCTION BOX IN CEILING FOR T.V. CAMERA. CENTER ABOVE DESK. ROUTE 1-1/2" EMPTY CONDUIT FROM JUNCTION BOX TO CONTROL ROOM. PROVIDE GROMMETTED COVER PLATE.
- 4 PROVIDE FLUSH MOUNTED JUNCTION BOX IN WALL 8'-0" AFF FOR T.V. UNIT. ROUTE EMPTY 3/4" CONDUIT FROM JUNCTION BOX TO CONTROL ROOM. PROVIDE GROMMETTED COVER PLATE.
- 5 CORE DRILL FLOOR FOR FLUSH MOUNTED DUPLEX RECEPTACLE UNDER DESK LOCATION.
- 6 ROUTE FEED FROM RECEPTACLE UNDER SLAB TO RAISED FLOOR LOCATION. ROUTE UP THRU SLAB TO CONTROL ROOM PANEL.
- 7 DRILL 1" OPENING IN FLOOR FOR MICROPHONE CABLE ROUTING. ROUTE CABLE BACK TO CONTROL ROOM.
- 8 ROUTE 1" CONDUIT FROM UNDER RAISED FLOOR TO MICROPHONE CABLE OPENING.
- 9 CORE DRILL FLOOR SLAB FOR FLUSH MOUNTED TELEPHONE OUTLET.
- 10 ROUTE TELEPHONE CONDUIT (1") UNDER SLAB FROM OUTLET TO UP IN WALL TO 8" X 8" TELEPHONE WIREWAY IN CORRIDOR.
- 11 PROVIDE FLUSH MOUNTED JUNCTION BOX IN WALL 8'-0" AFF FOR T.V. CAMERA. ROUTE 1-1/2" EMPTY CONDUIT FROM J.B. TO CONTROL ROOM. PROVIDE GROMMETTED COVER PLATE.
- 12 MOUNT DUPLEX RECEPTACLE IN FACE OF STEP.

"This seal and signature apply only to the unaltered document to which they are affixed. I expressly disclaim any responsibility for any and all changes made after the issue date, for other plans, specifications, estimates, reports or other documents or instruments relating to or intended to be used for any part or portion of the architectural or engineering project or survey."

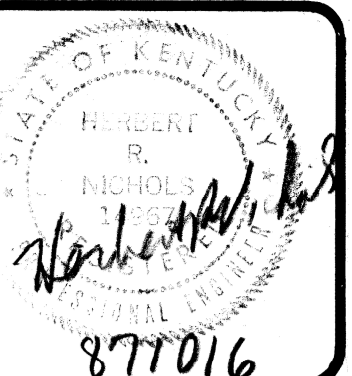

ROBOTICS FACILITY
LEXINGTON CAMPUS
UNIVERSITY OF KENTUCKY
LEXINGTON, KENTUCKY


University of Kentucky
Lexington, Kentucky
10-19-87
DATE
Walter Young
DIRECTOR, DESIGN AND CONSTRUCTION DIVISION

ITV ROOM'S PLAN
Sherman Carter Barnhart
PARTNERS IN ARCHITECTURE
SUITE 1800 • 250 WEST MAIN STREET • LEXINGTON, KY 40507 • (606) 251-1351

JOB NO 8706
DATE 9-30-87
DRAWN D. MEYER
CHECKED M. GOLDBERG
USE PAGE NO 431.0


REVISIONS
3-90% REVIEW 10-16-87
4-GENERAL 7-18-88

AS BUILT
3-1-01

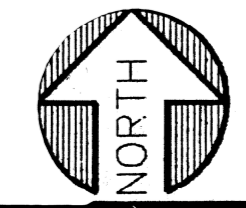


BELCAN CORPORATION
10200 ANDERSON WAY
CINCINNATI, OHIO 45242
NUMBER: 4361-CE-016-4

SHEET
E-16
04/982
B-2
83


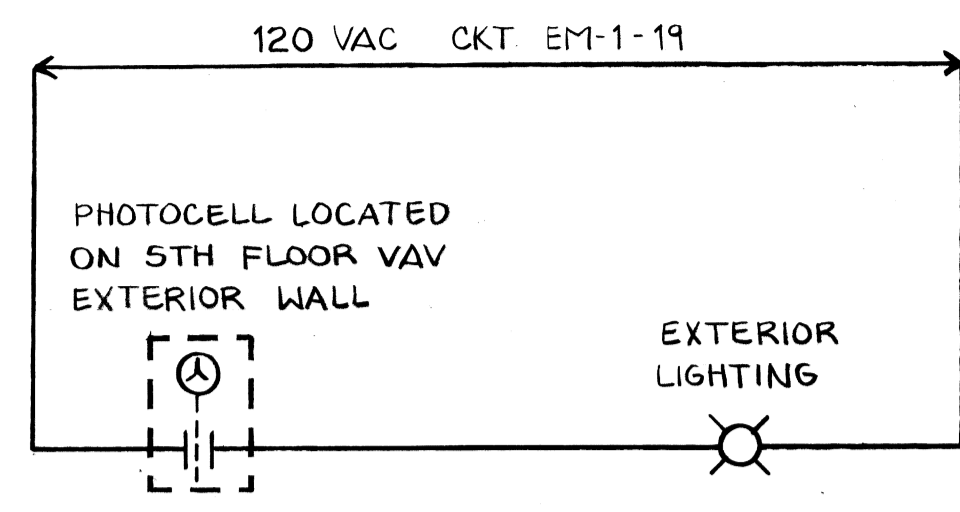


EXTERIOR EMERGENCY LIGHTING CONTROL DIAGRAM
NO SCALE

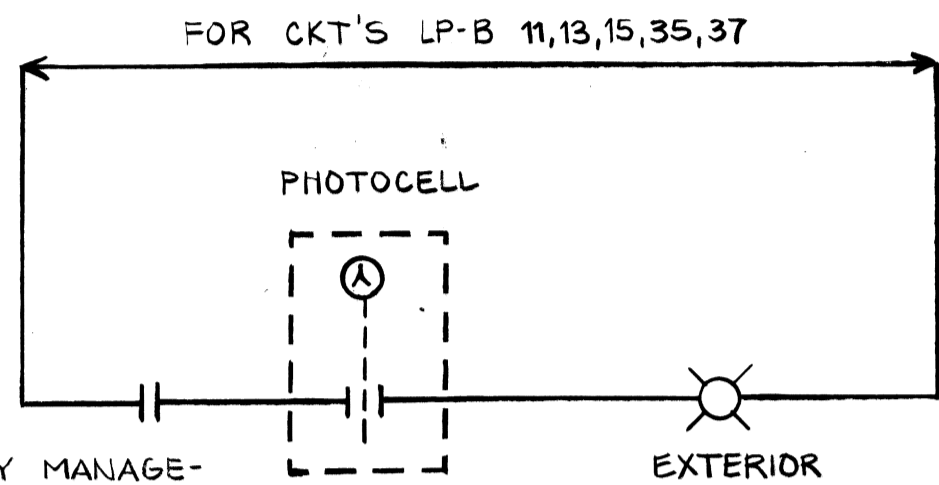

FACILITY MANAGEMENT SYSTEM CONTACTOR


EXTERIOR LIGHTING CONTROL DIAGRAM
NO SCALE

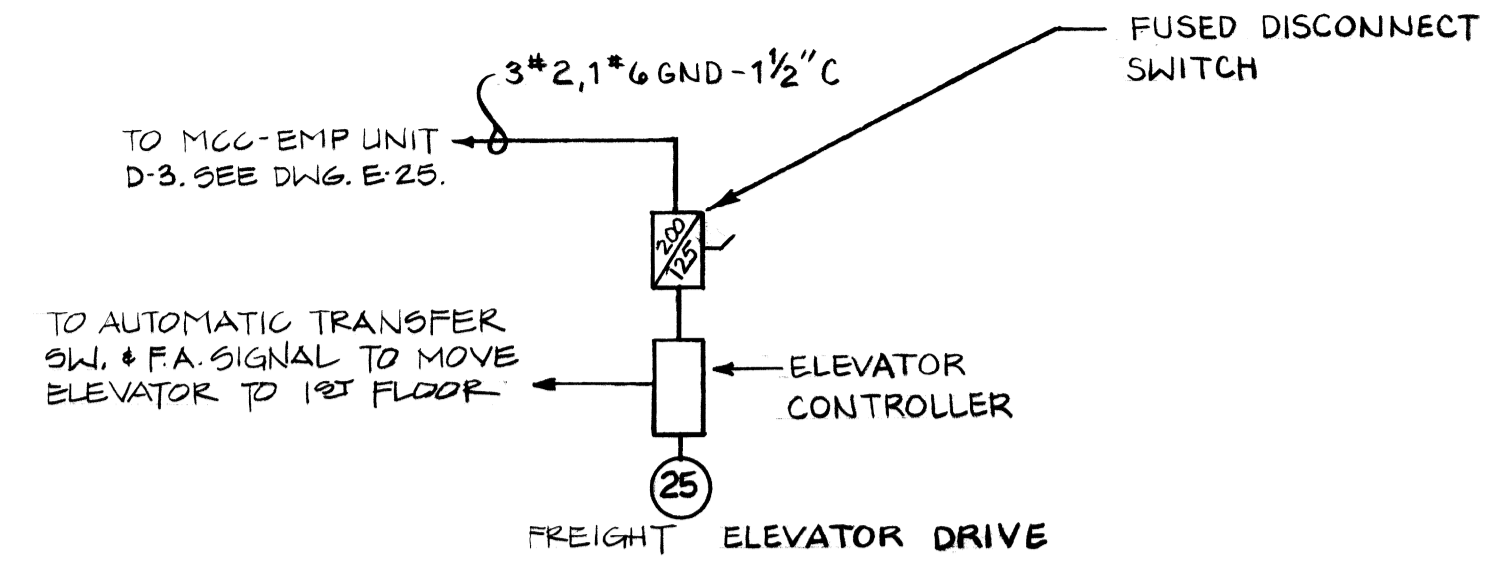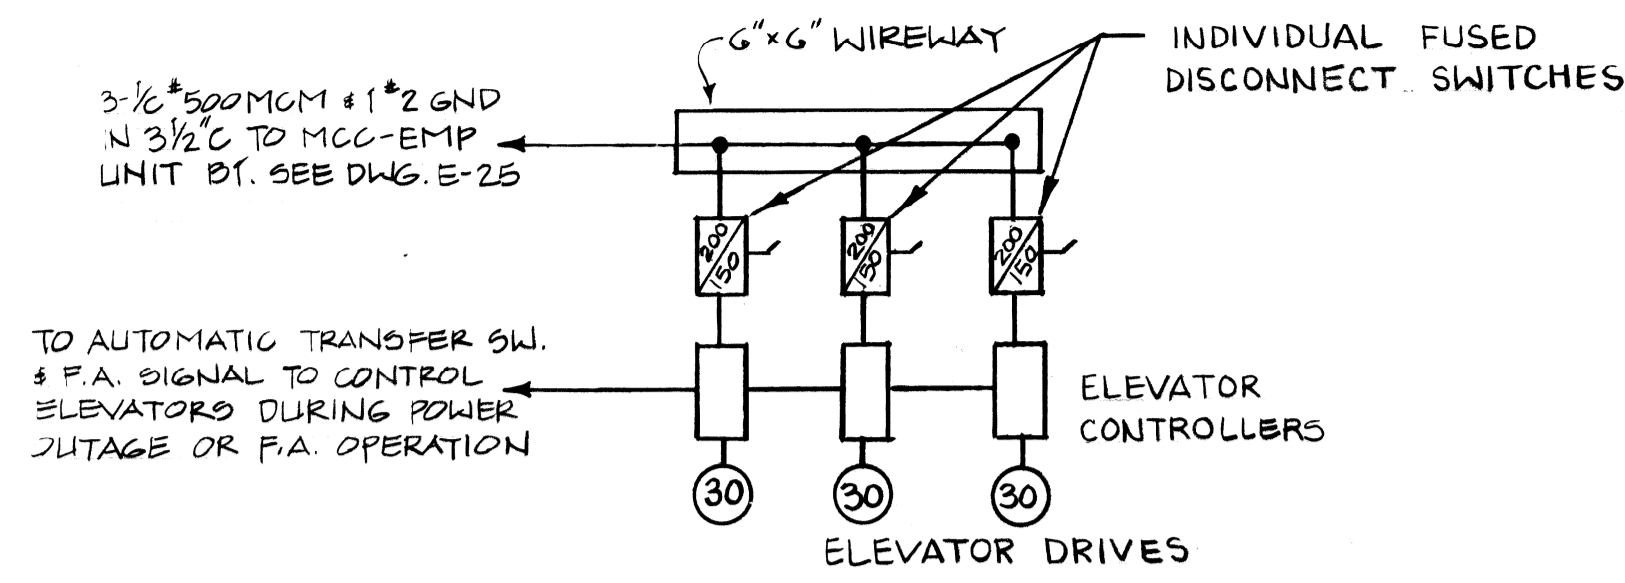

ELEVATOR RISER DIAGRAMS

NOTES FOR ELEVATOR RISER DIAGRAMS

- CONTACT "EO" IS CLOSED WHEN AUTOMATIC TRANSFER SWITCH IS IN THE NORMAL POWER POSITION AND OPEN WHEN SWITCH IS IN THE EMERGENCY POWER POSITION.
- CONTACT "NOX" CLOSSES 20 SECONDS PRIOR TO TRANSFER OF POWER IN EITHER DIRECTION, OPENS WHEN TRANSFER IS COMPLETE.
- TRANSFER SWITCH AND AUXILIARY CONTACTS ALONG WITH WIRING TO AND FROM THESE DEVICES IS TO BE FURNISHED BY THE ELECTRICAL CONTRACTOR.

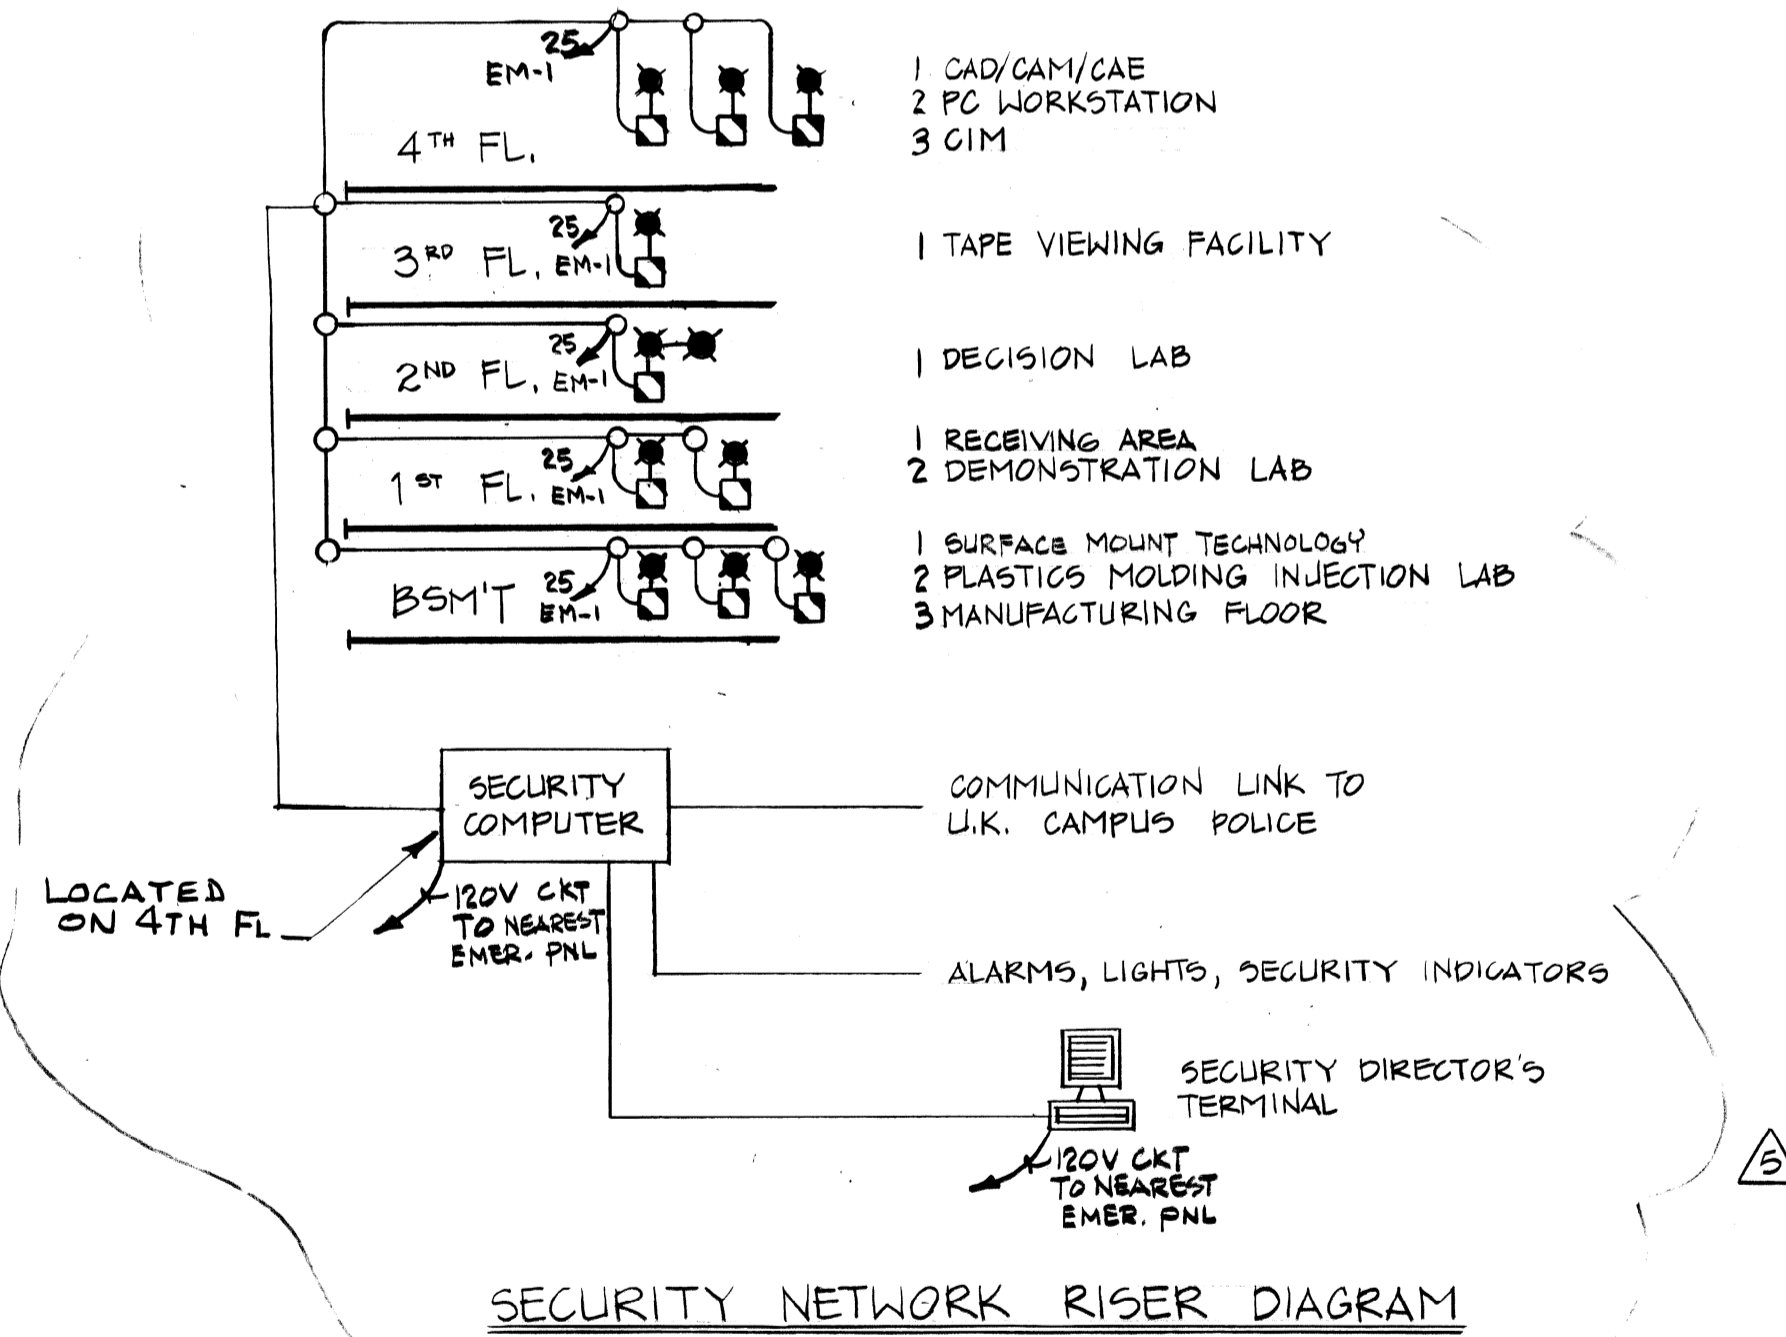

SECURITY NETWORK RISER DIAGRAM

"This seal and signature apply only to the unaltered document to which they are affixed. I expressly disclaim any responsibility for any and all changes made after the issue date, for other plans, specifications, estimates, reports or other documents or instruments relating to or intended to be used for any part or portion of the architectural or engineering project or survey."



ROBOTICS FACILITY
LEXINGTON CAMPUS
UNIVERSITY OF KENTUCKY
LEXINGTON, KENTUCKY

University of Kentucky
Lexington, Kentucky

10-19-87
D.M.
W. D. MEYER
director - design and construction division

ELECTRICAL DETAILS

Sherman Carter Barnhart
PARTNERS IN ARCHITECTURE
SUITE 1800 • 250 WEST MAIN STREET • LEXINGTON, KY 40507 • 606-254-0351

JOB NO 8706
DATE 9-30-87
DRAWN D MEYER
CHECKED M. GOLDBERG
UK FILE NO 431.0


REVISIONS
3-90% REVIEW 10-16-87
4-GENERAL 7-18-88
5-RENOVATION 2-16-90

AS BUILT

3-1-91

BELGAN CORPORATION
10200 ANDERSON WAY
CINCINNATI, OHIO 45242

NUMER. 4361-CE-017-4

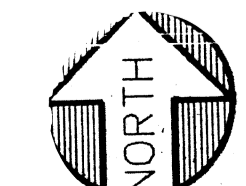

SHEET

E-17

Document # 004983
Sheet B-2
83



"This seal and signature apply only to the unaltered document to which they are affixed. I expressly disclaim any responsibility for any and all changes made after the issue date, for other plans, specifications, estimates, reports or other documents or instruments relating to or intended to be used for any part or portion of the architectural or engineering project or survey."

ROBOTICS FACILITY
 LEXINGTON CAMPUS
 UNIVERSITY OF KENTUCKY
 LEXINGTON, KENTUCKY


University of Kentucky
 Lexington, Kentucky
 10-19-87
 Director, design and construction control

GROUND RISER DIAGRAM
 Sherman Carter Barnhart
 PARTNERS IN ARCHITECTURE
 SUITE 800 • 250 WEST MAIN STREET • LEXINGTON, KY 40507 • 606.254.1357


JOB NO 8706
 DATE 9-30-87
 DRAWN O. MEYER
 CHECKED M. GOLDBERG
 UK FILE NO 431.0

REVISIONS
 3-90% REVIEW 10-16-87
 4-GENERAL 7-10-88


SHEET
 Document # 00-984
 B-2
E-18

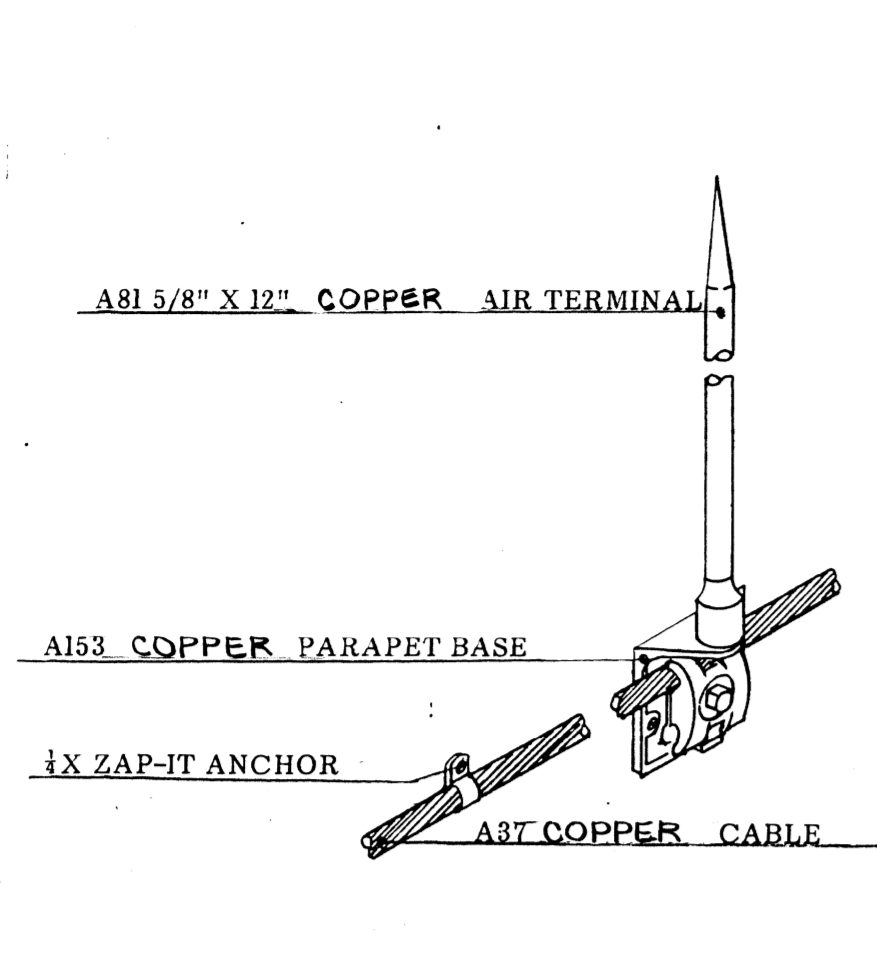


AIR TERMINAL DETAIL "A"

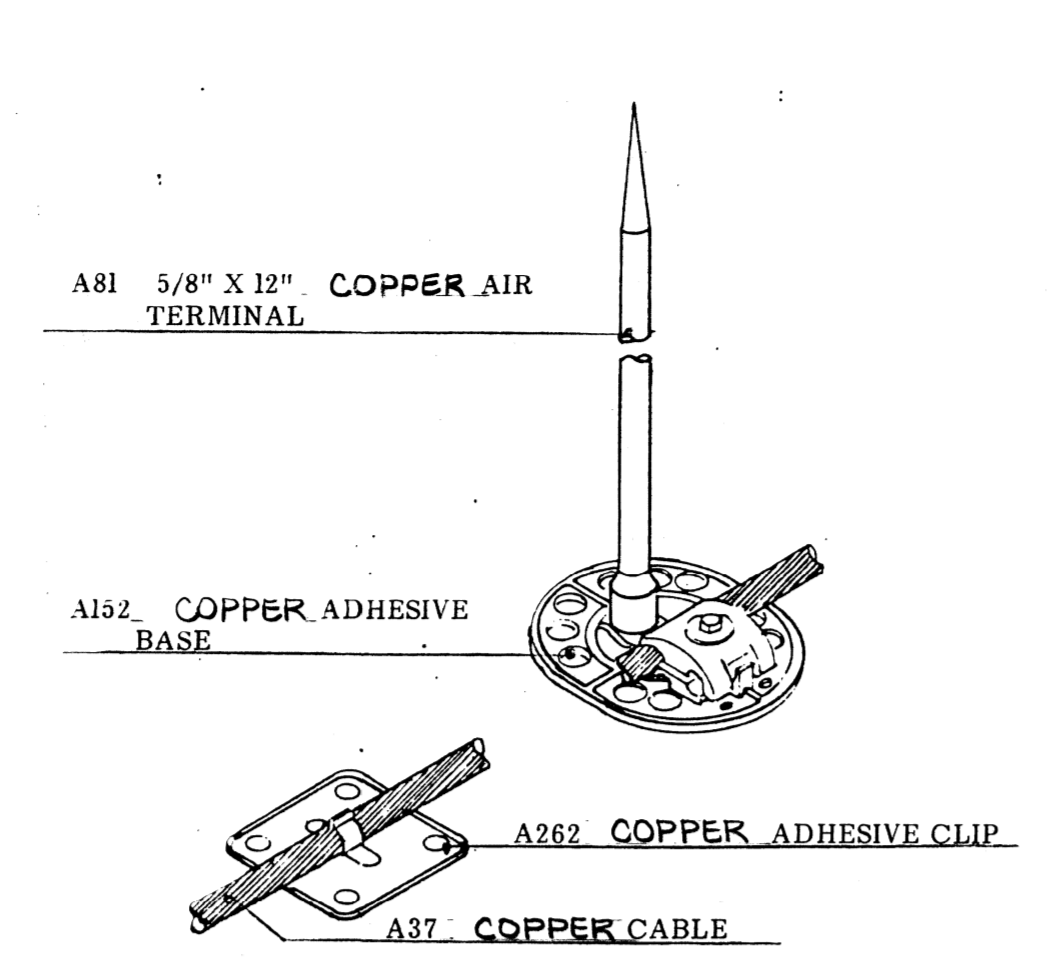


AIR TERMINAL DETAIL "B"

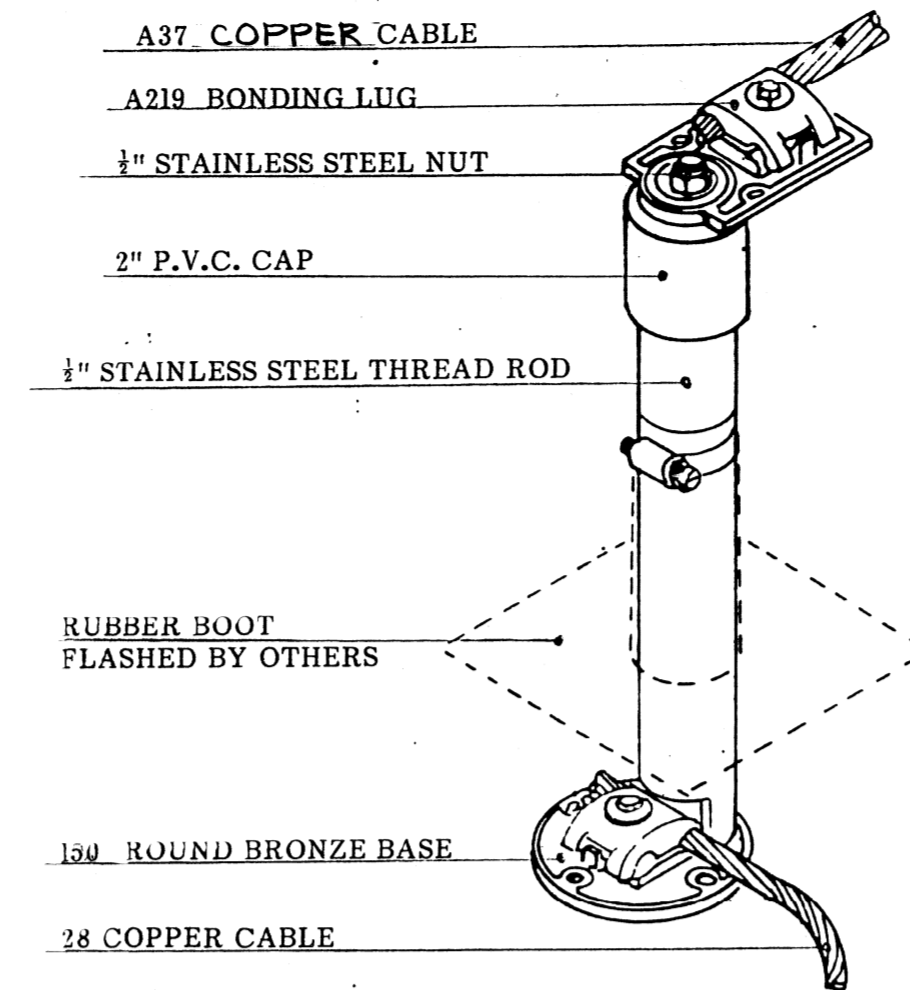


THRU-ROOF DETAIL

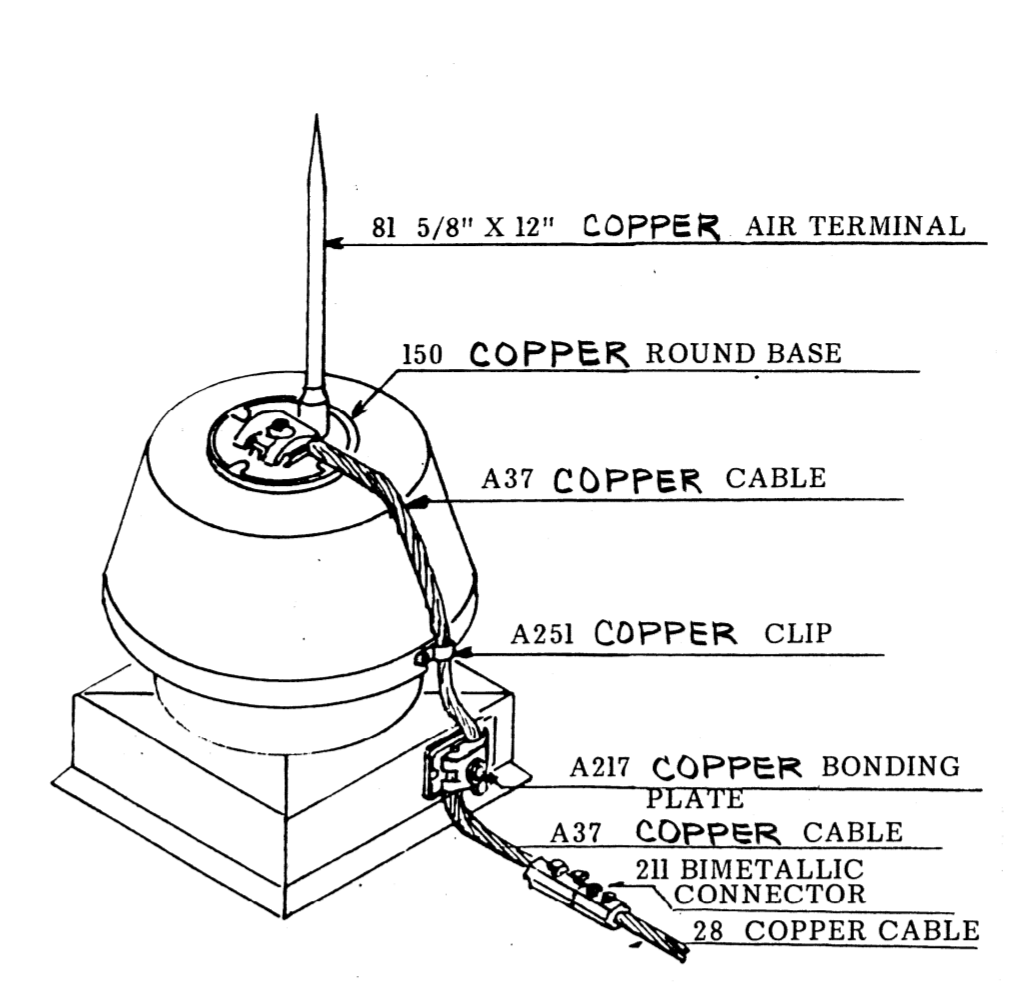

AIR TERMINAL DETAIL

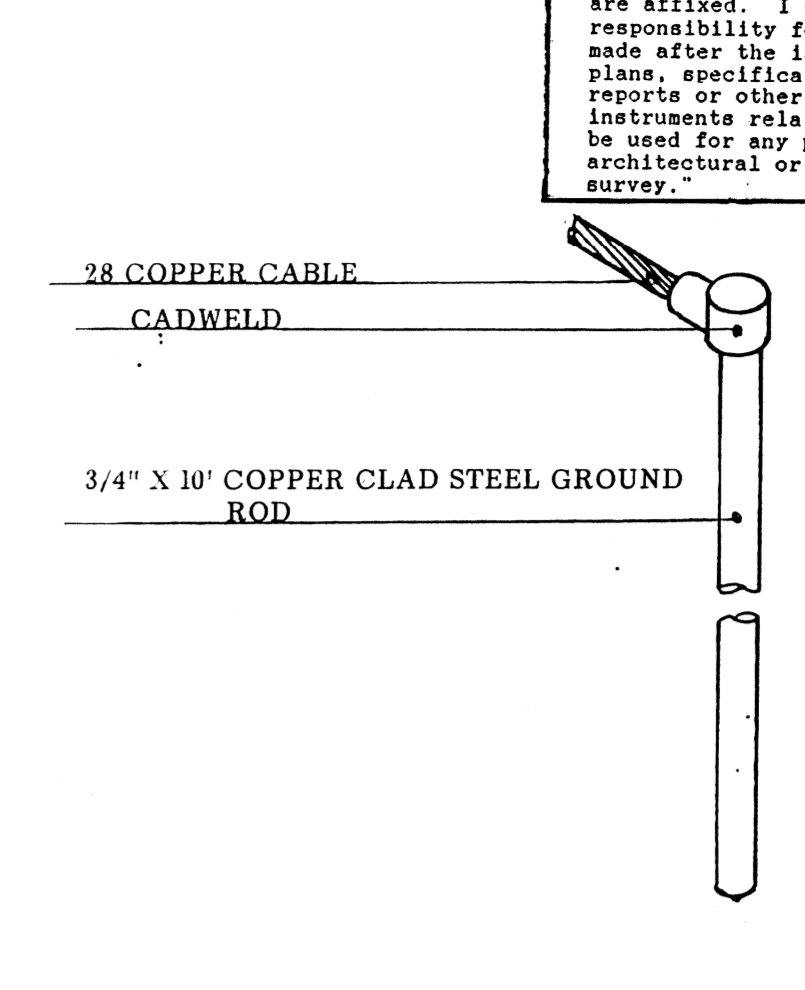


GROUNDING DETAIL

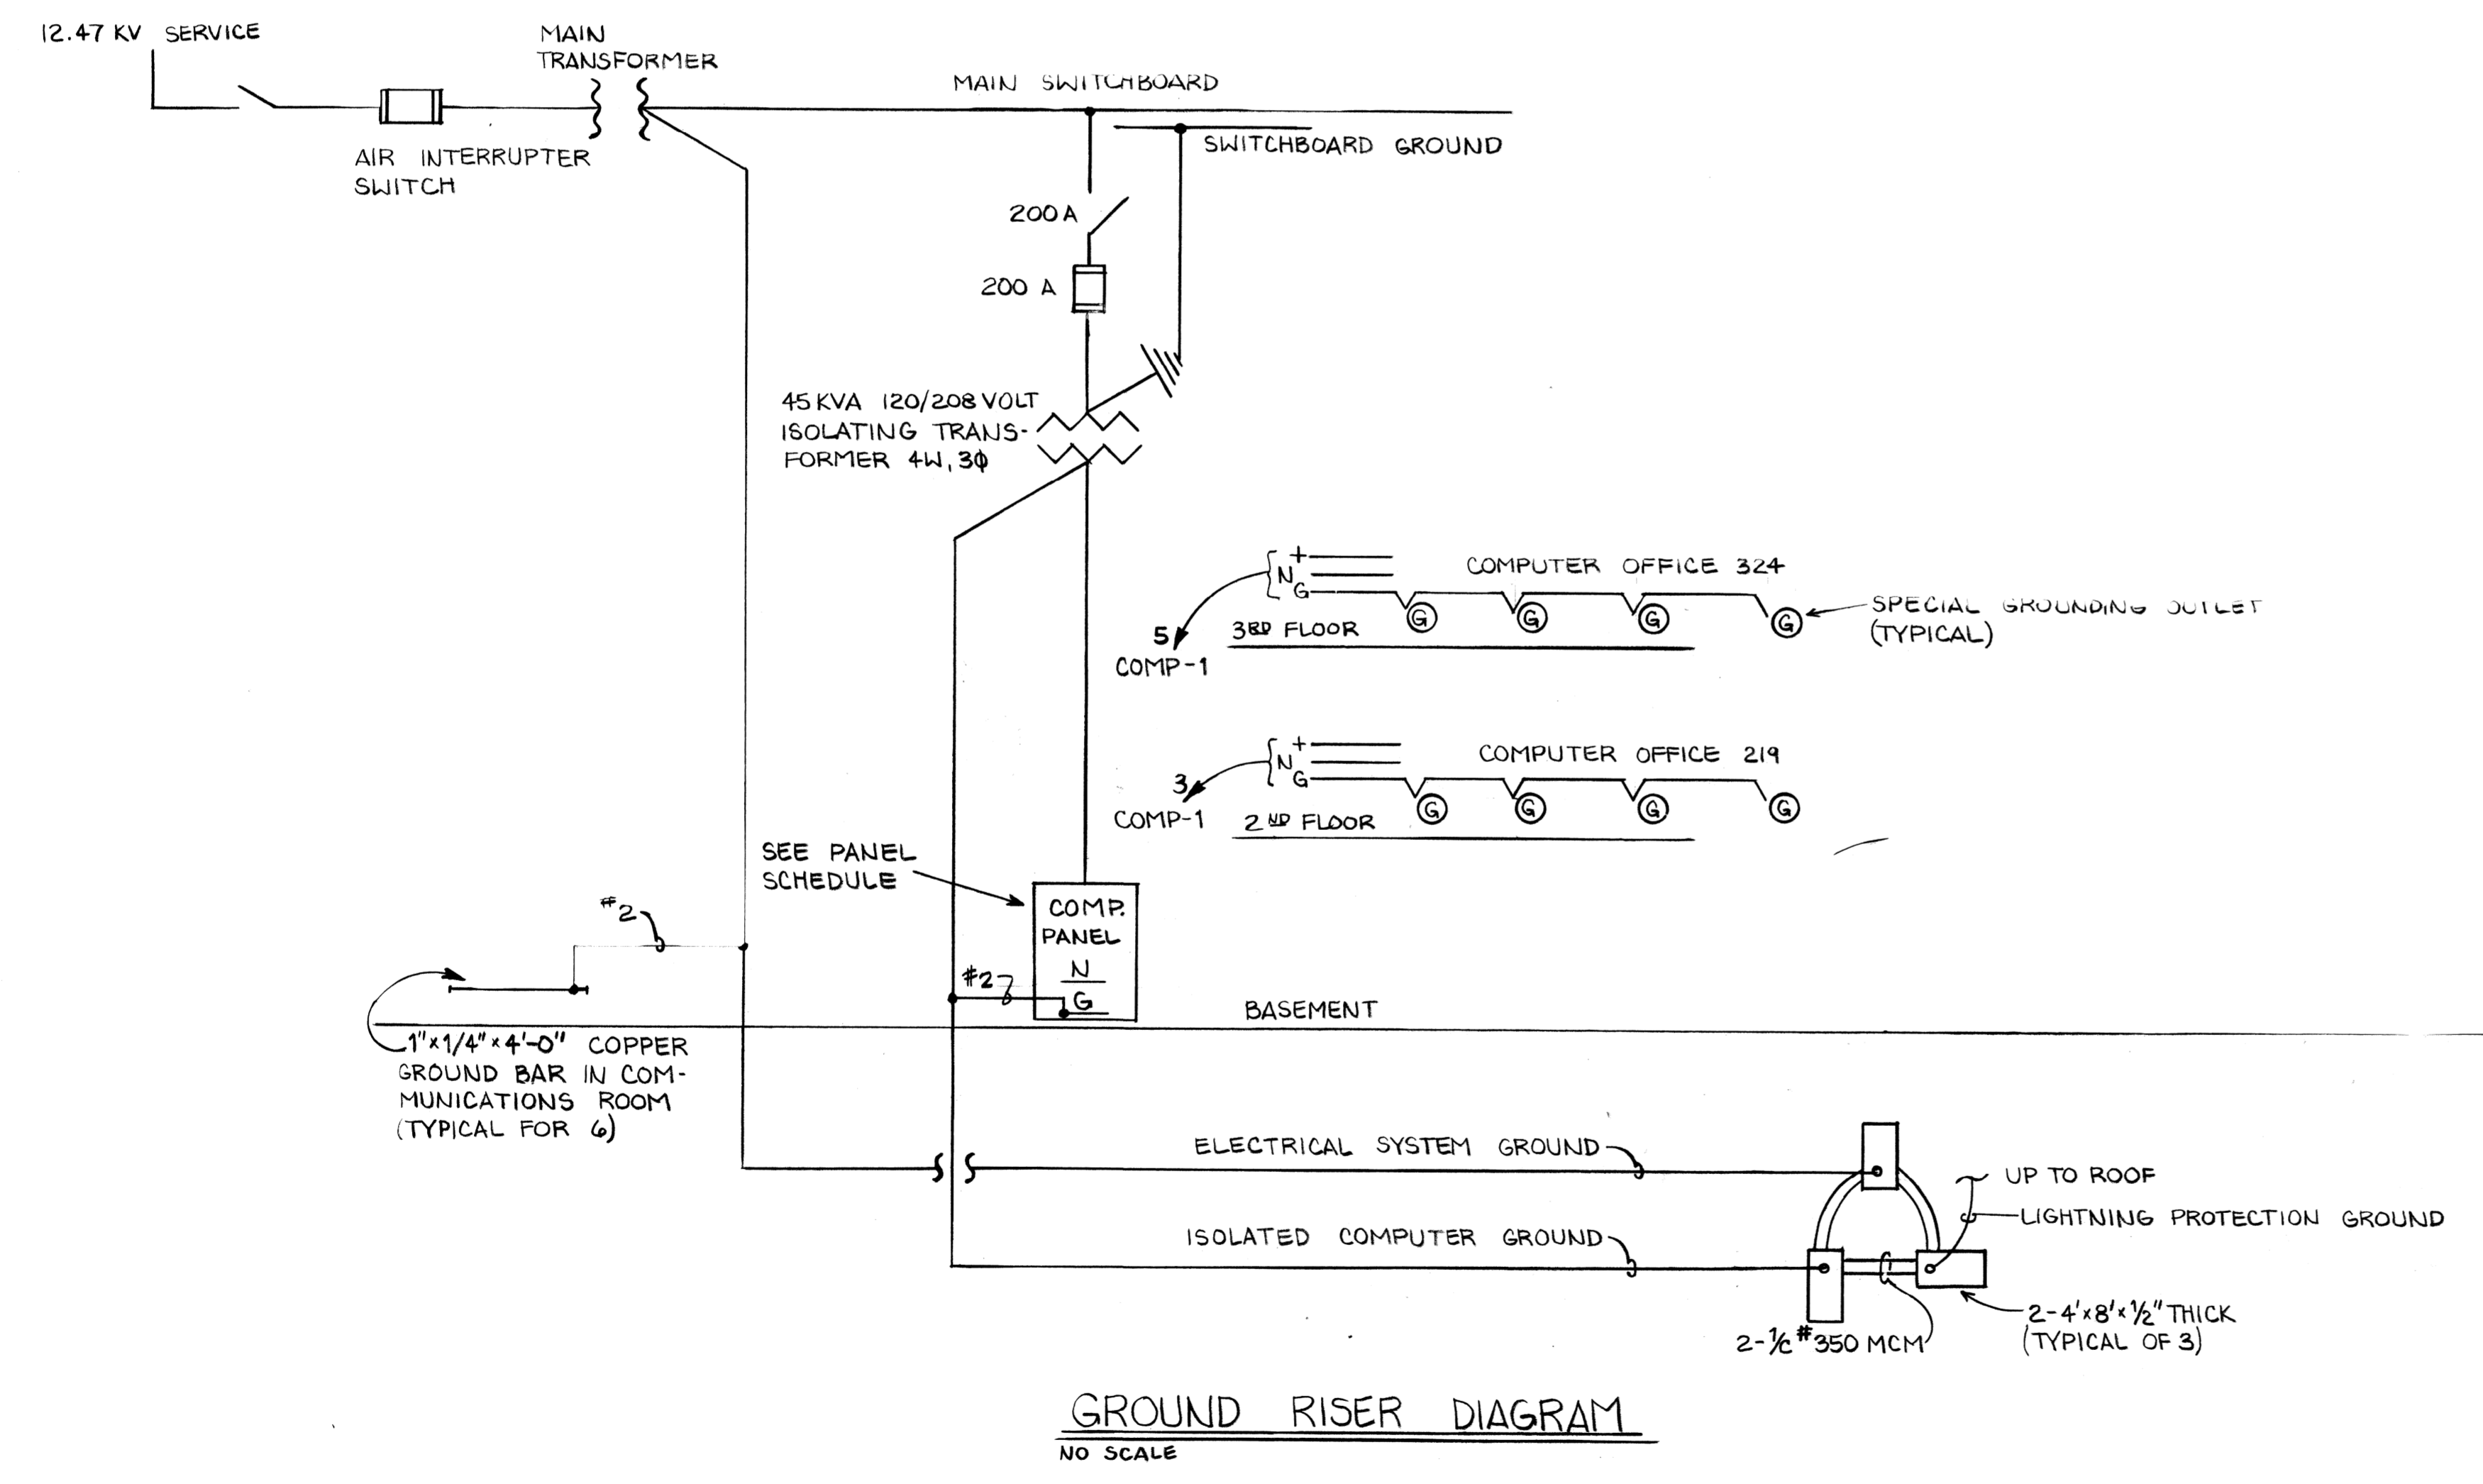

GROUND RISER DIAGRAM
 NO SCALE

AS BUILT
 3-1 31

BELCAN CORPORATION
 10200 ANDERSON WAY

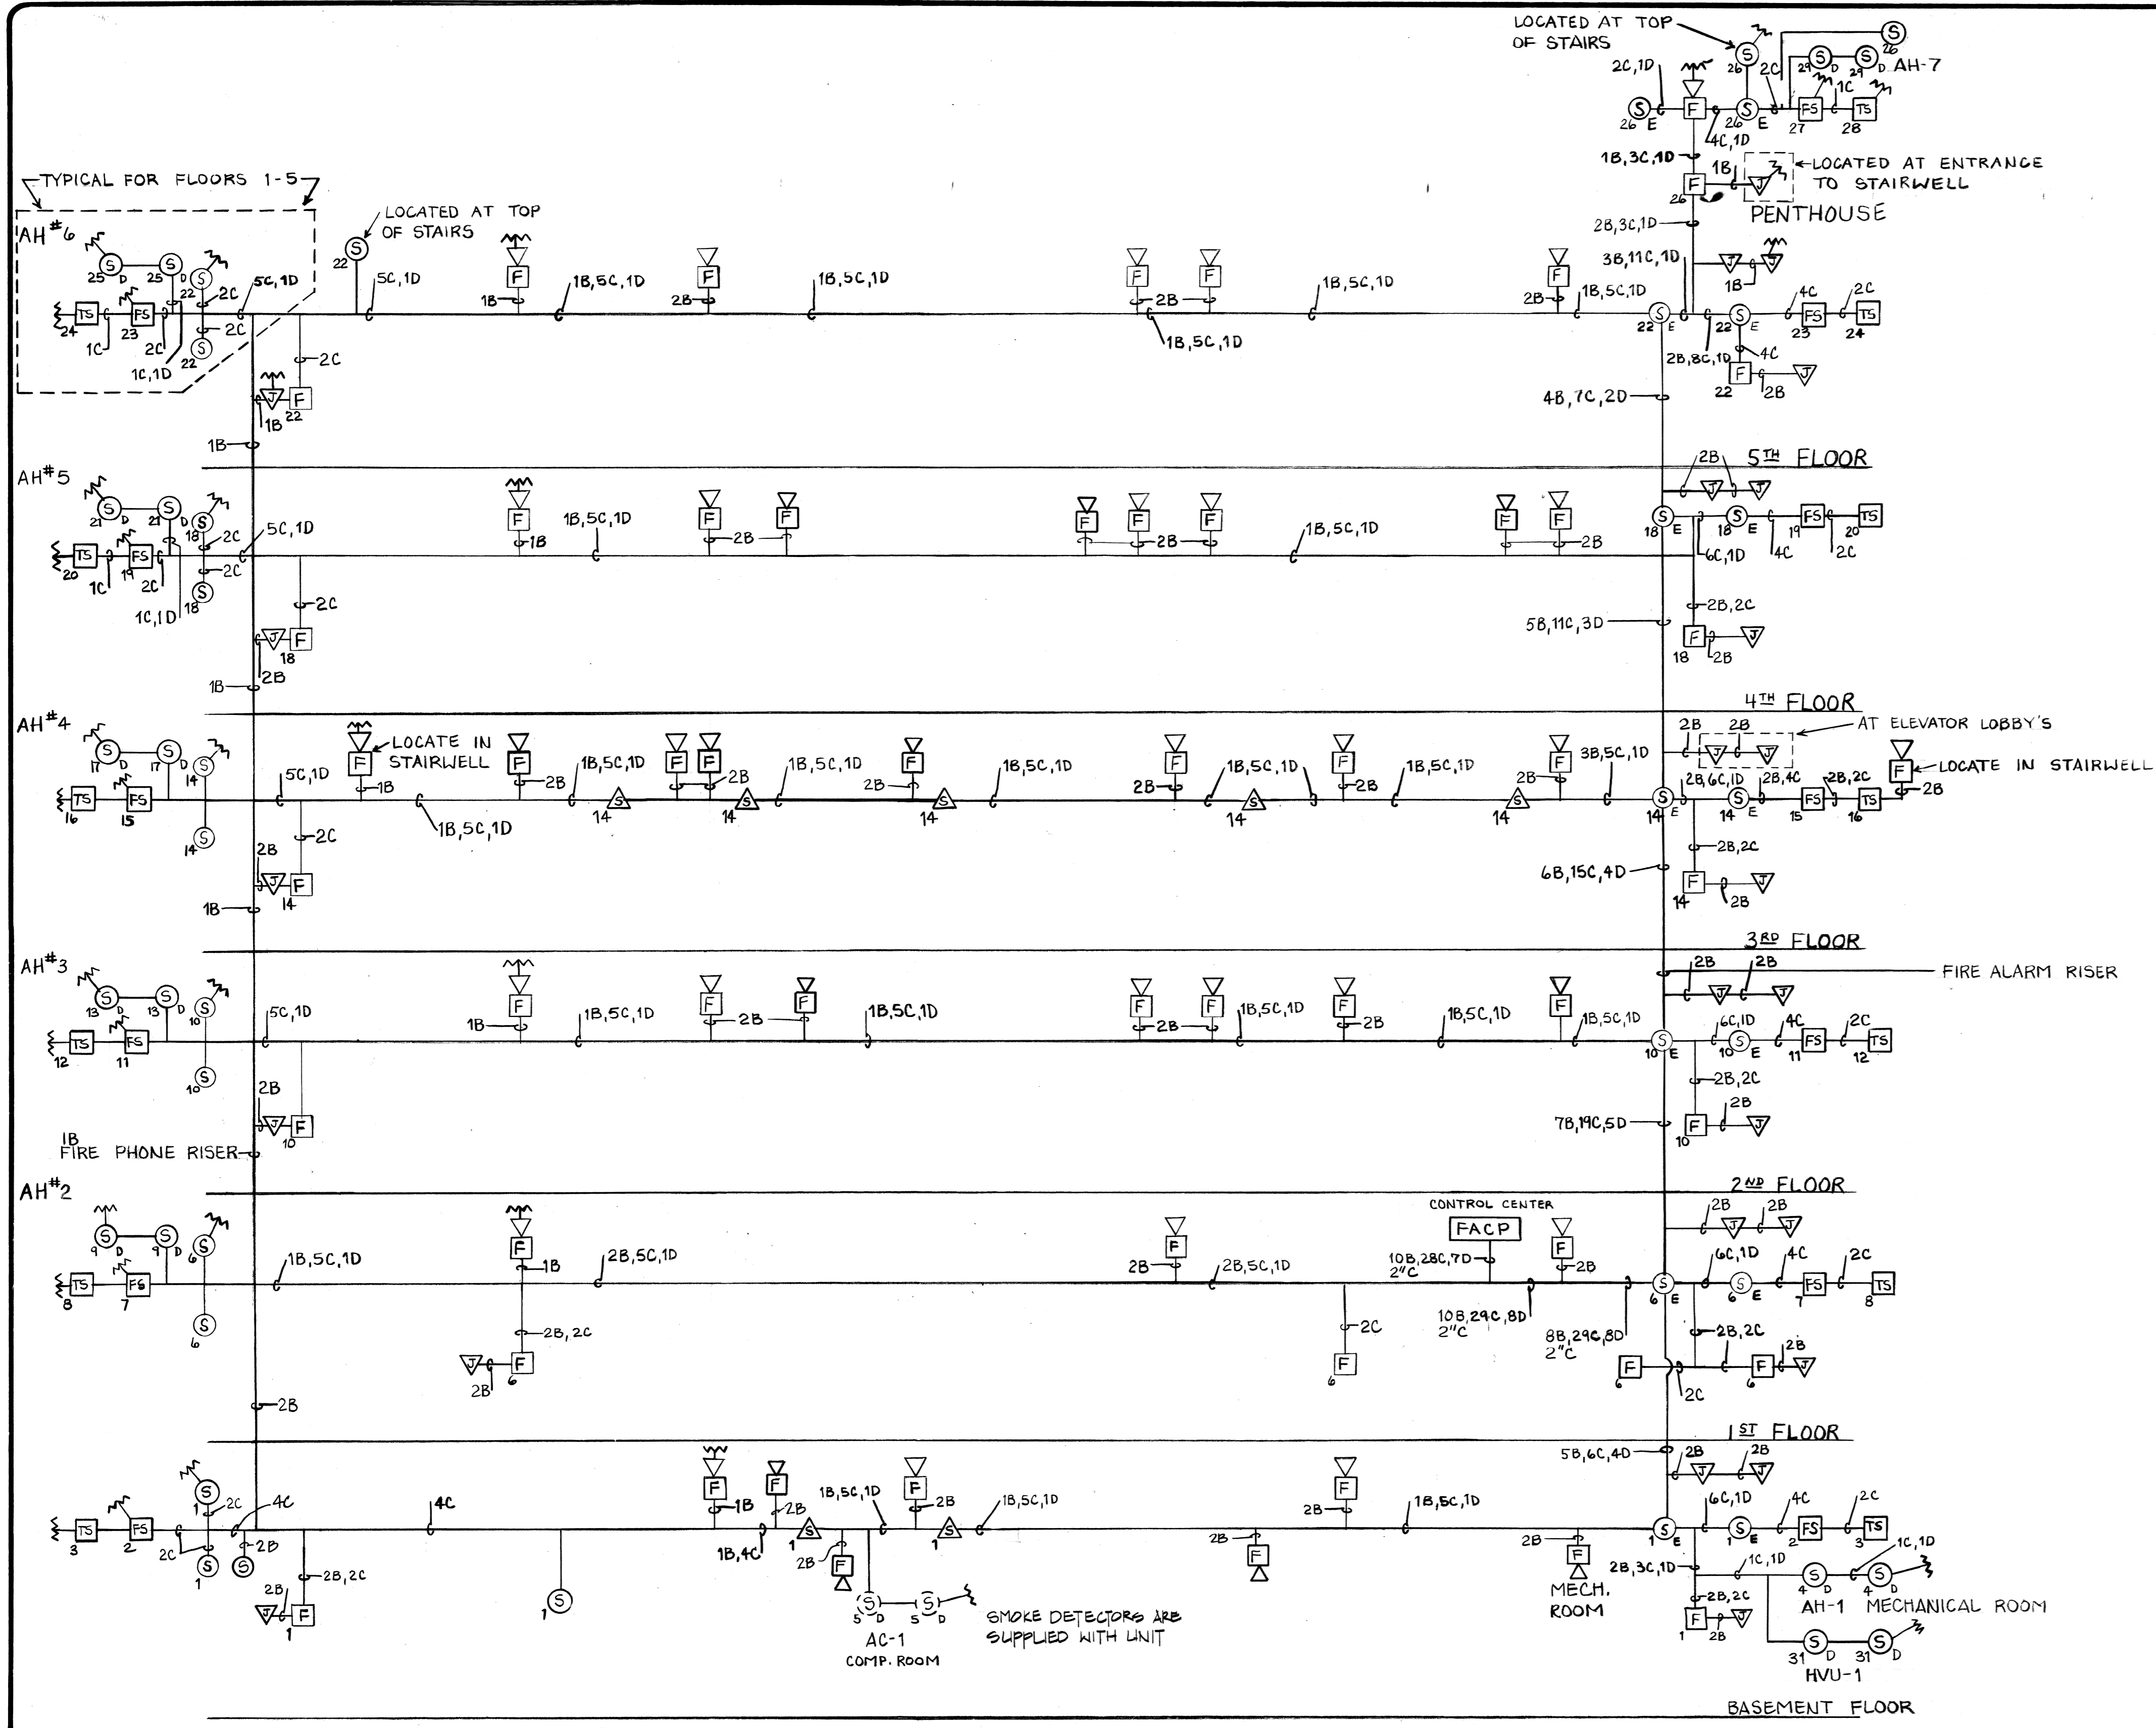

ZONE #	ZONE DESCRIPTION
1	BASEMENT AREA
2	BASEMENT FS
3	BASEMENT TS
4	BASEMENT MECHANICAL ROOM AH#1
5	BASEMENT COMPUTER ROOM AC-1
6	FIRST FLOOR AREA
7	FIRST FLOOR FS
8	FIRST FLOOR TS
9	FIRST FLOOR AH#2
10	SECOND FLOOR AREA
11	SECOND FLOOR FS
12	SECOND FLOOR TS
13	SECOND FLOOR AH#3
14	THIRD FLOOR AREA
15	THIRD FLOOR FS
16	THIRD FLOOR TS
17	THIRD FLOOR AH#4
18	FOURTH FLOOR AREA
19	FOURTH FLOOR FS
20	FOURTH FLOOR TS
21	FOURTH FLOOR AH#5
22	FIFTH FLOOR AREA
23	FIFTH FLOOR FS
24	FIFTH FLOOR TS
25	FIFTH FLOOR AH#6
26	PENTHOUSE AREA
27	PENTHOUSE FS
28	PENTHOUSE TS
29	PENTHOUSE AH#7
30	MAIN P.I.V.
31	HVU-1
32	SPARE
33	SPACE FOR 15 FUTURE ZONES (OR SPARES)

- FIRE ALARM RISER NOTES**
1. Fire phone in each elevator. Add 2B to Elevator Riser.
 2. Electrical Contractor shall provide 1 relay at each AH Motor Controller for shutdown. This relay will be picked by a FA Relay.
 3. Elevator control wires are not shown on riser. Take 2 # 14 from the first floor elevator lobby smoke detector to the Elevator Controller. Also, take 2 # 14 (looped together) from all other floors to the Elevator Controller. This must be done for each elevator.
 4. Provide 9 sets of contacts to Honeywell Panel for Floor Alarm tie in, plus 1 contact for common system trouble (wires not shown).
 5. One speaker circuit per floor.
 6. One speaker circuit for each elevator cab. (Wires not shown.)
 7. Fire Phone Riser Circuits.
Far end stair entrance
Elevator stair entrance
Elevator lobby
Passenger Elevator Cab 1,2,3
Freight Elevator Cab 4
Wires not shown
Coordinate with Elevator Contractor
 8. CONDUIT FOR EAST AND WEST VERTICAL RISERS SHALL BE 3/4" C. HORIZONTAL CONDUIT SIZED AS INDICATED OR REQUIRED BY NEC.

FIRE ALARM - RISER DIAGRAM

SYMBOL LIST

- | | |
|---|--|
| <ul style="list-style-type: none"> Ⓜ MANUAL PULL STATION (Z INDICATES ZONE #) Ⓢ SPEAKER A/V LIGHT UNIT Ⓢ SMOKE DETECTOR Ⓢ SMOKE DETECTOR UNDER RAISED FLOOR Ⓢ SMOKE DETECTOR IN ELEVATOR LOBBY Ⓢ END OF LINE RESISTOR Ⓢ DUCT SMOKE DETECTOR Ⓢ WATER FLOW SWITCH (FURNISHED BY OTHERS) | <ul style="list-style-type: none"> Ⓢ TAMPER SWITCH (FURNISHED BY OTHERS) Ⓢ FIRE PHONE JACK Ⓢ PIV (FURNISHED BY OTHERS) B = TWISTED SHIELDED #14 PAIR (SPEAKER & PHONE CKTS.) C = 2 # 14 (ZONE WIRING) D = 2 # 14 (POWER OR CONTROL WIRES) Ⓢ SMOKE DETECTOR W/ AUXILIARY RELAY |
|---|--|

"This seal and signature apply only to the unaltered document to which they are affixed. I expressly disclaim any responsibility for any and all changes made after the issue date, for other plans, specifications, estimates, reports or other documents or instruments relating to or intended to be used for any part or portion of the architectural or engineering project or survey."



ROBOTICS FACILITY
LEXINGTON CAMPUS
UNIVERSITY OF KENTUCKY
LEXINGTON, KENTUCKY

University of Kentucky
Lexington, Kentucky
Approved by: **Wendy Bunn** 10-19-87
Project Manager and Construction Division

FIRE ALARM RISER DIAGRAM
Sherman Carter Barnhart
PARTNERS IN ARCHITECTURE
SUITE 1800 • 200 WEST MAIN STREET • LEXINGTON, KY 40507 • 606-254-1351

JOB NO. 5706
DATE 9-30-87
DRAWN D. MEYER
CHECKED M. GOLDBERG
UK FILE NO.

REVISIONS
3-90% REVIEW 10-16-87
4- GENERAL 7-18-88

AS BUILT


10200 ANDERSON WAY
CINCINNATI, OHIO 45242
NUMBER: 4361-CE-019-4



SHEET
E-19
B-2
004985

"This seal and signature apply only to the unaltered document to which they are affixed. I expressly disclaim any responsibility for any and all changes made after the issue date, for other plans, specifications, estimates, reports or other documents or instruments relating to or intended to be used for any part or portion of the architectural or engineering project or survey."


Robert M. ...
871016

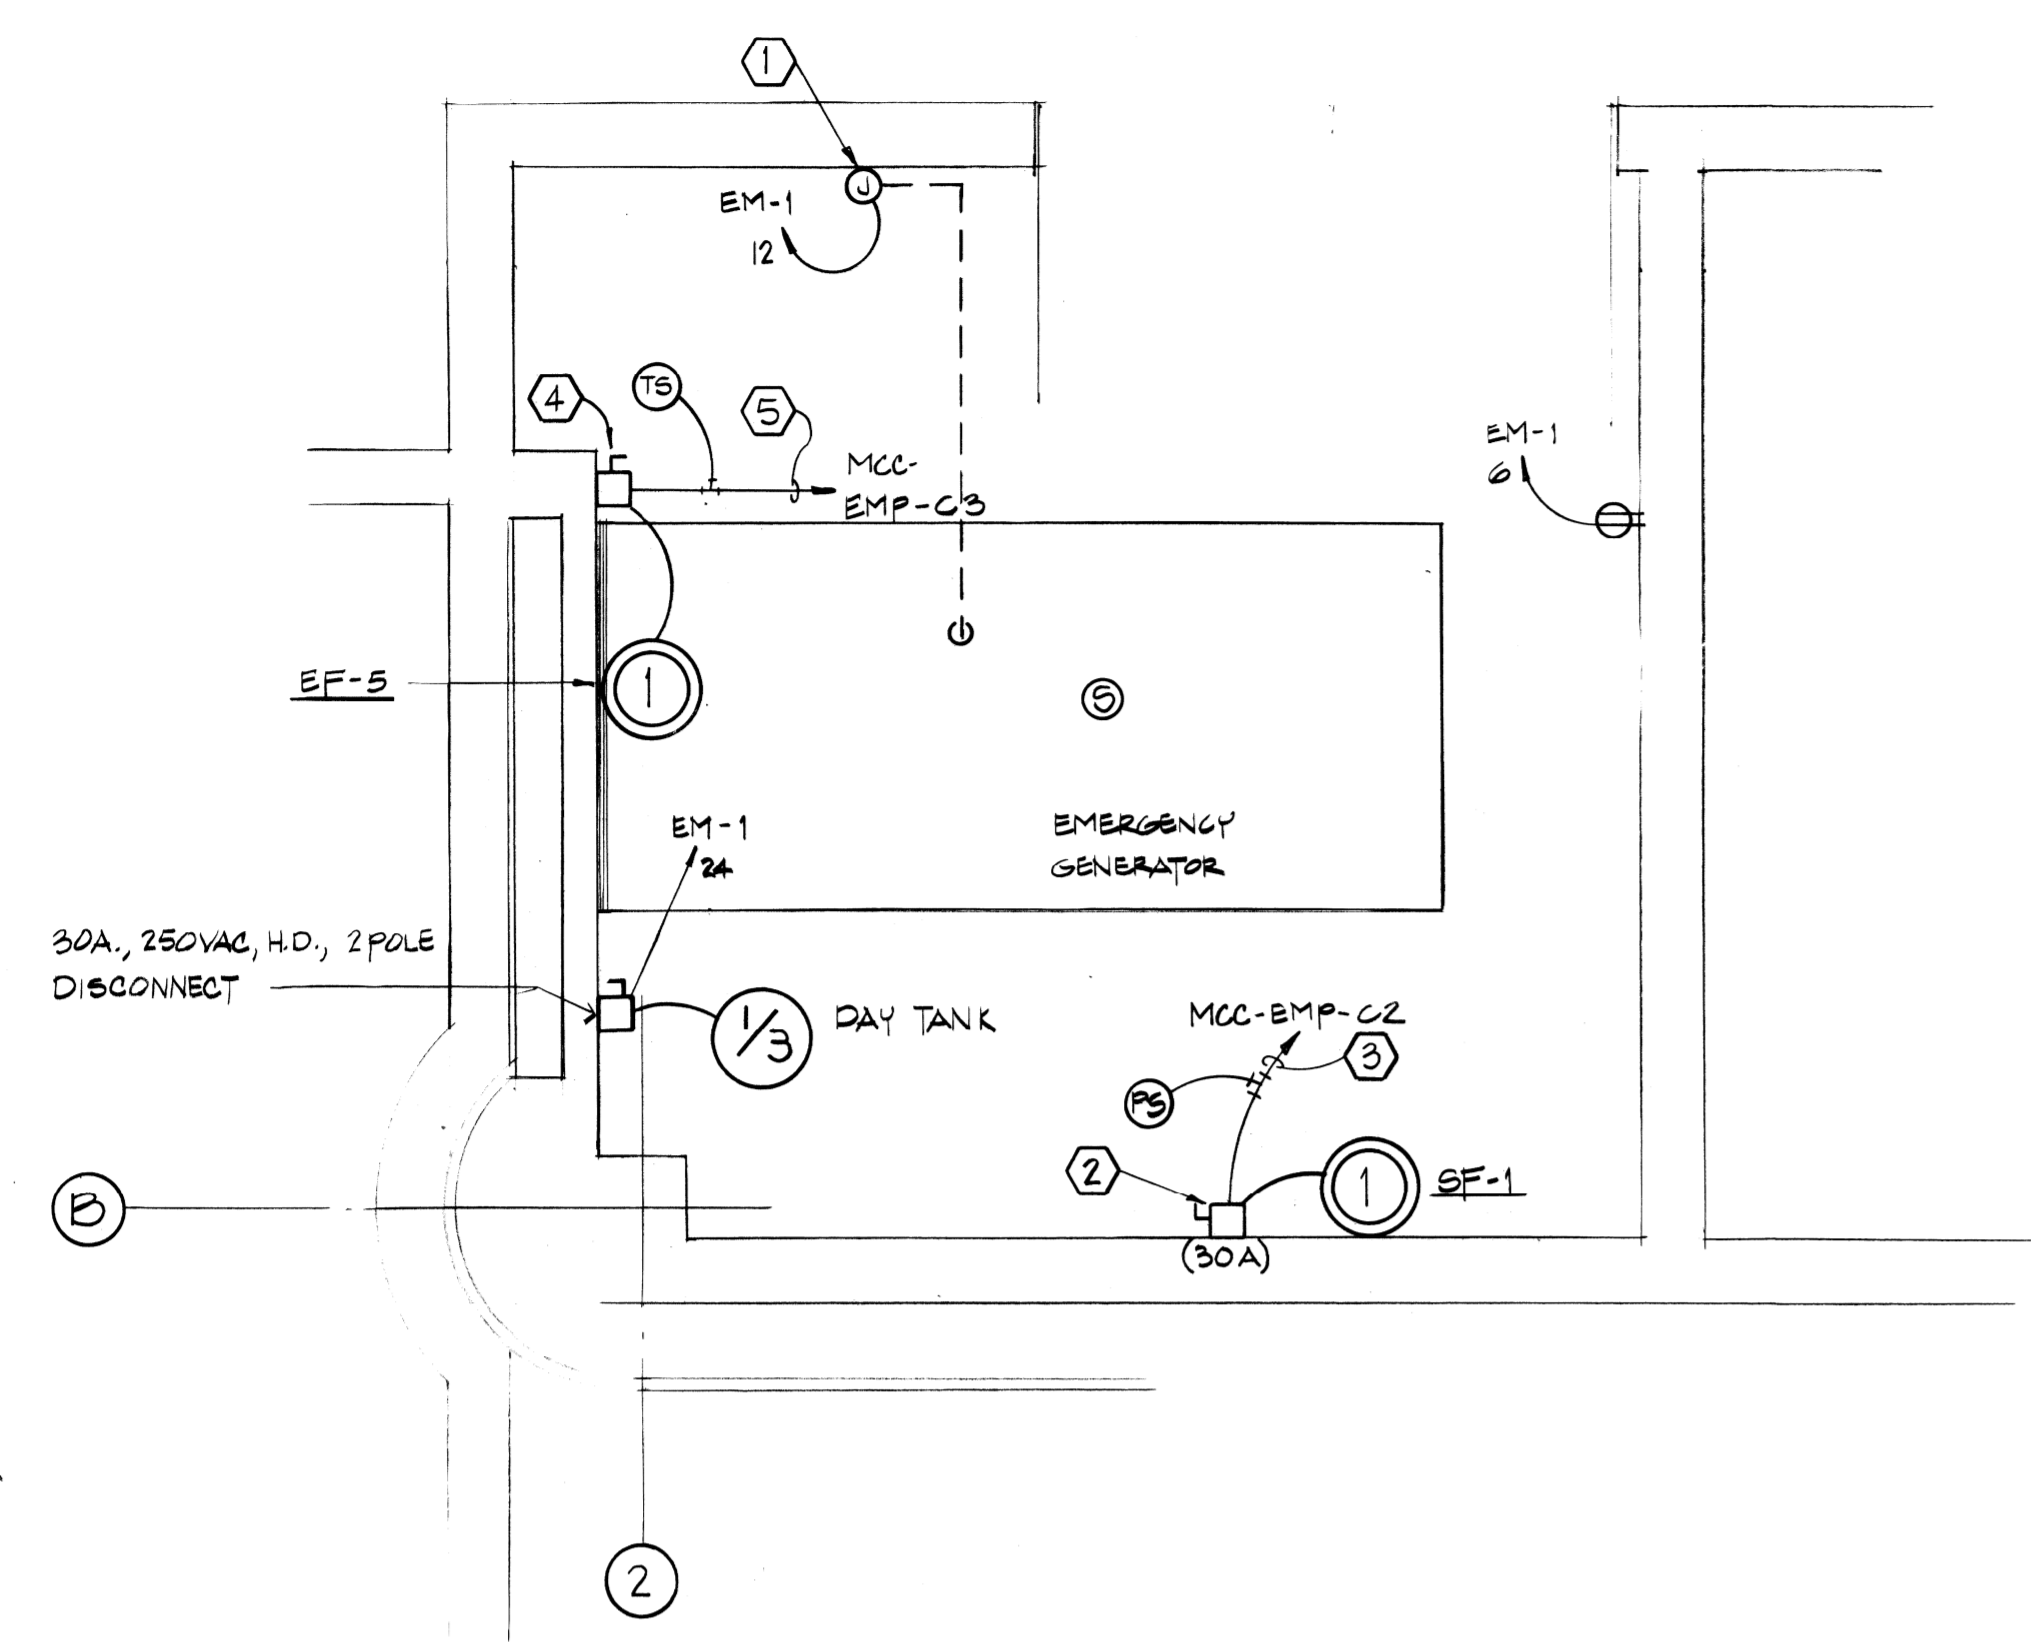

ENLARGED EMERGENCY GENERATOR RM. B14
SCALE 1/2"=1'-0"


ENLARGED EMERGENCY GENERATOR ROOM

- 1 PROVIDE 208 VOLT RECEPTACLE FOR ENGINE JACKET HEATER. VERIFY WITH MANUFACTURER TERMINATION TYPE. ROUTE FEED TO GENERATOR. VERIFY LOCATION OF HEATER JACKET PRIOR TO INSTALLATION.
- 2 PROVIDE 250 VAC, 3 POLE, NON FUSED, H.D. DISCONNECT FOR SF-1. MOUNT DISCONNECT ON WALL ADJACENT TO MOTOR.
- 3 ROUTE 5 #12 + #12 GND - 3/4" C TO MCC-EMP. 2 #12 TO BE CONNECTED TO PRESSURE SWITCH FOR CONTROL OF SF-1, (SUPPLIED AND INSTALLED BY MECHANICAL CONTRACTOR) WIRE BY ELECTRICAL CONTRACTOR.
- 4 PROVIDE 30 AMP, NON-FUSED, H.D., 3 POLE DISCONNECT MOUNTED ON WALL ADJACENT TO EF-5.
- 5 ROUTE 5 #12 + #12 GND - 3/4" C MCC-EMP. 2 #12 TO BE CONNECTED TO TEMPERATURE SWITCH FOR CONTROL OF EF-5. TEMPERATURE SWITCH IS SUPPLIED AND MOUNTED BY MECHANICAL CONTRACTOR, WIRED BY ELECTRICAL CONTRACTOR.

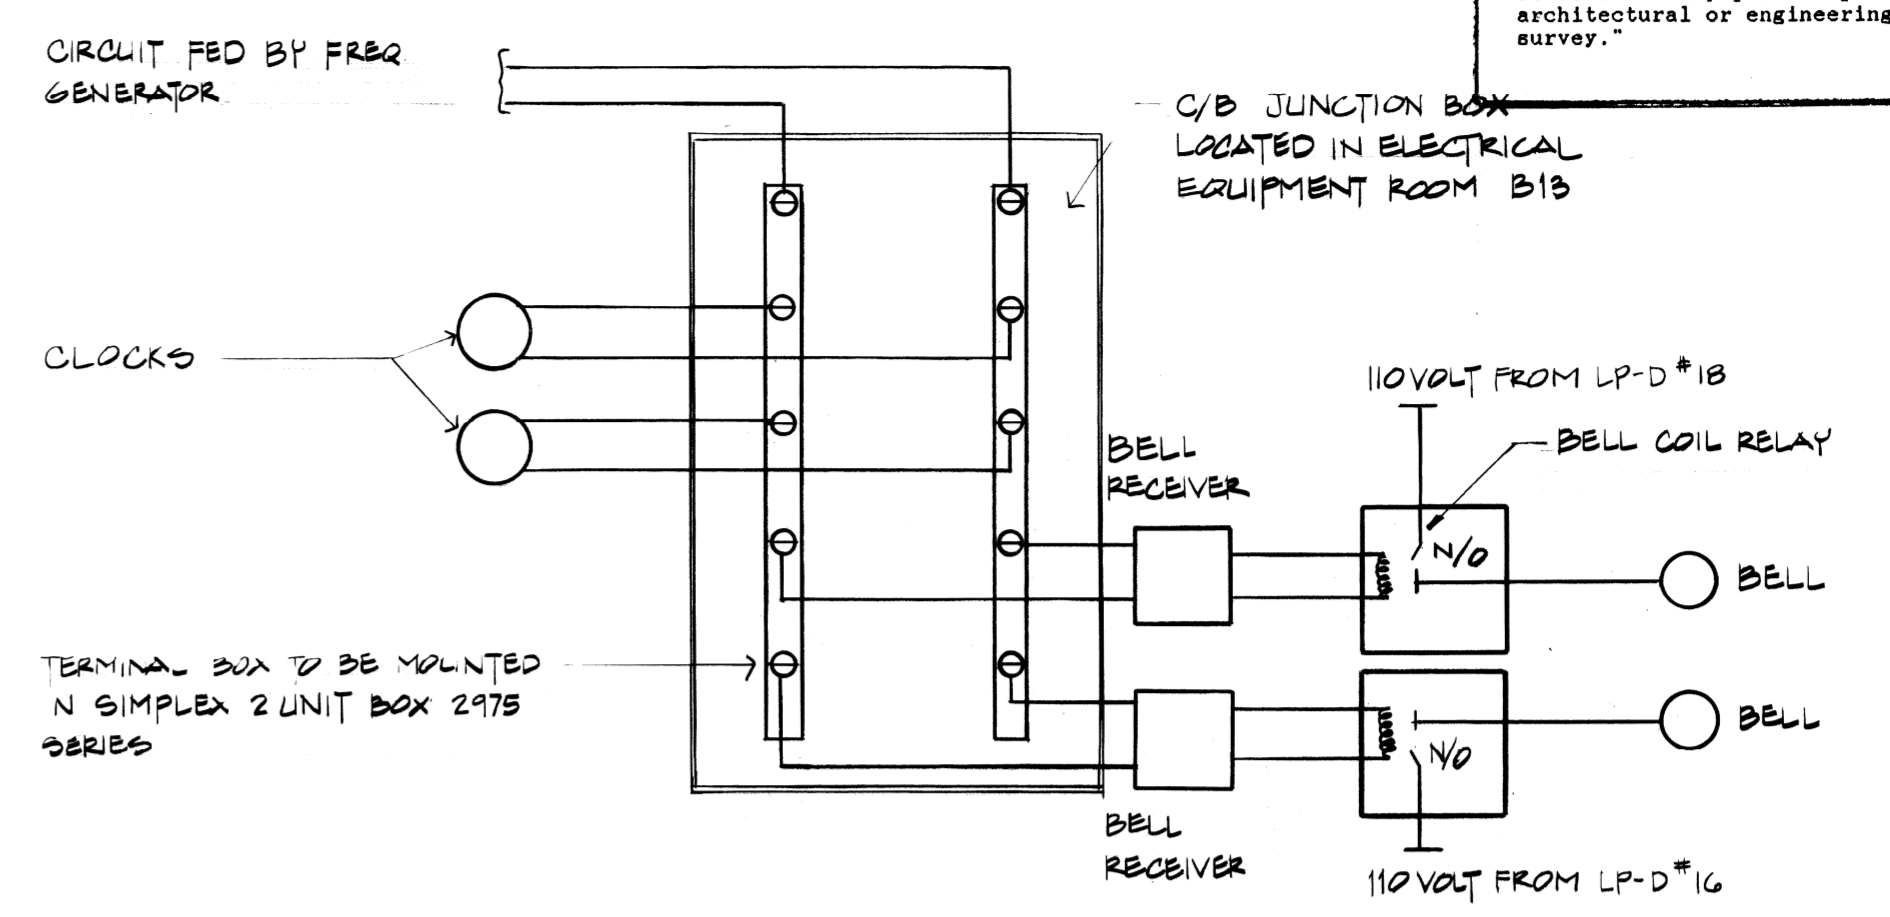

NOTE:
THE CLOCK CORRECTION FREQUENCY AS WELL AS THE BELL FREQUENCY IS PUT INTO 110V. LINES GOING TO CLOCKS AND BELL RECEIVERS.

CLOCK & BELL SYSTEM DIAGRAM
SCALE

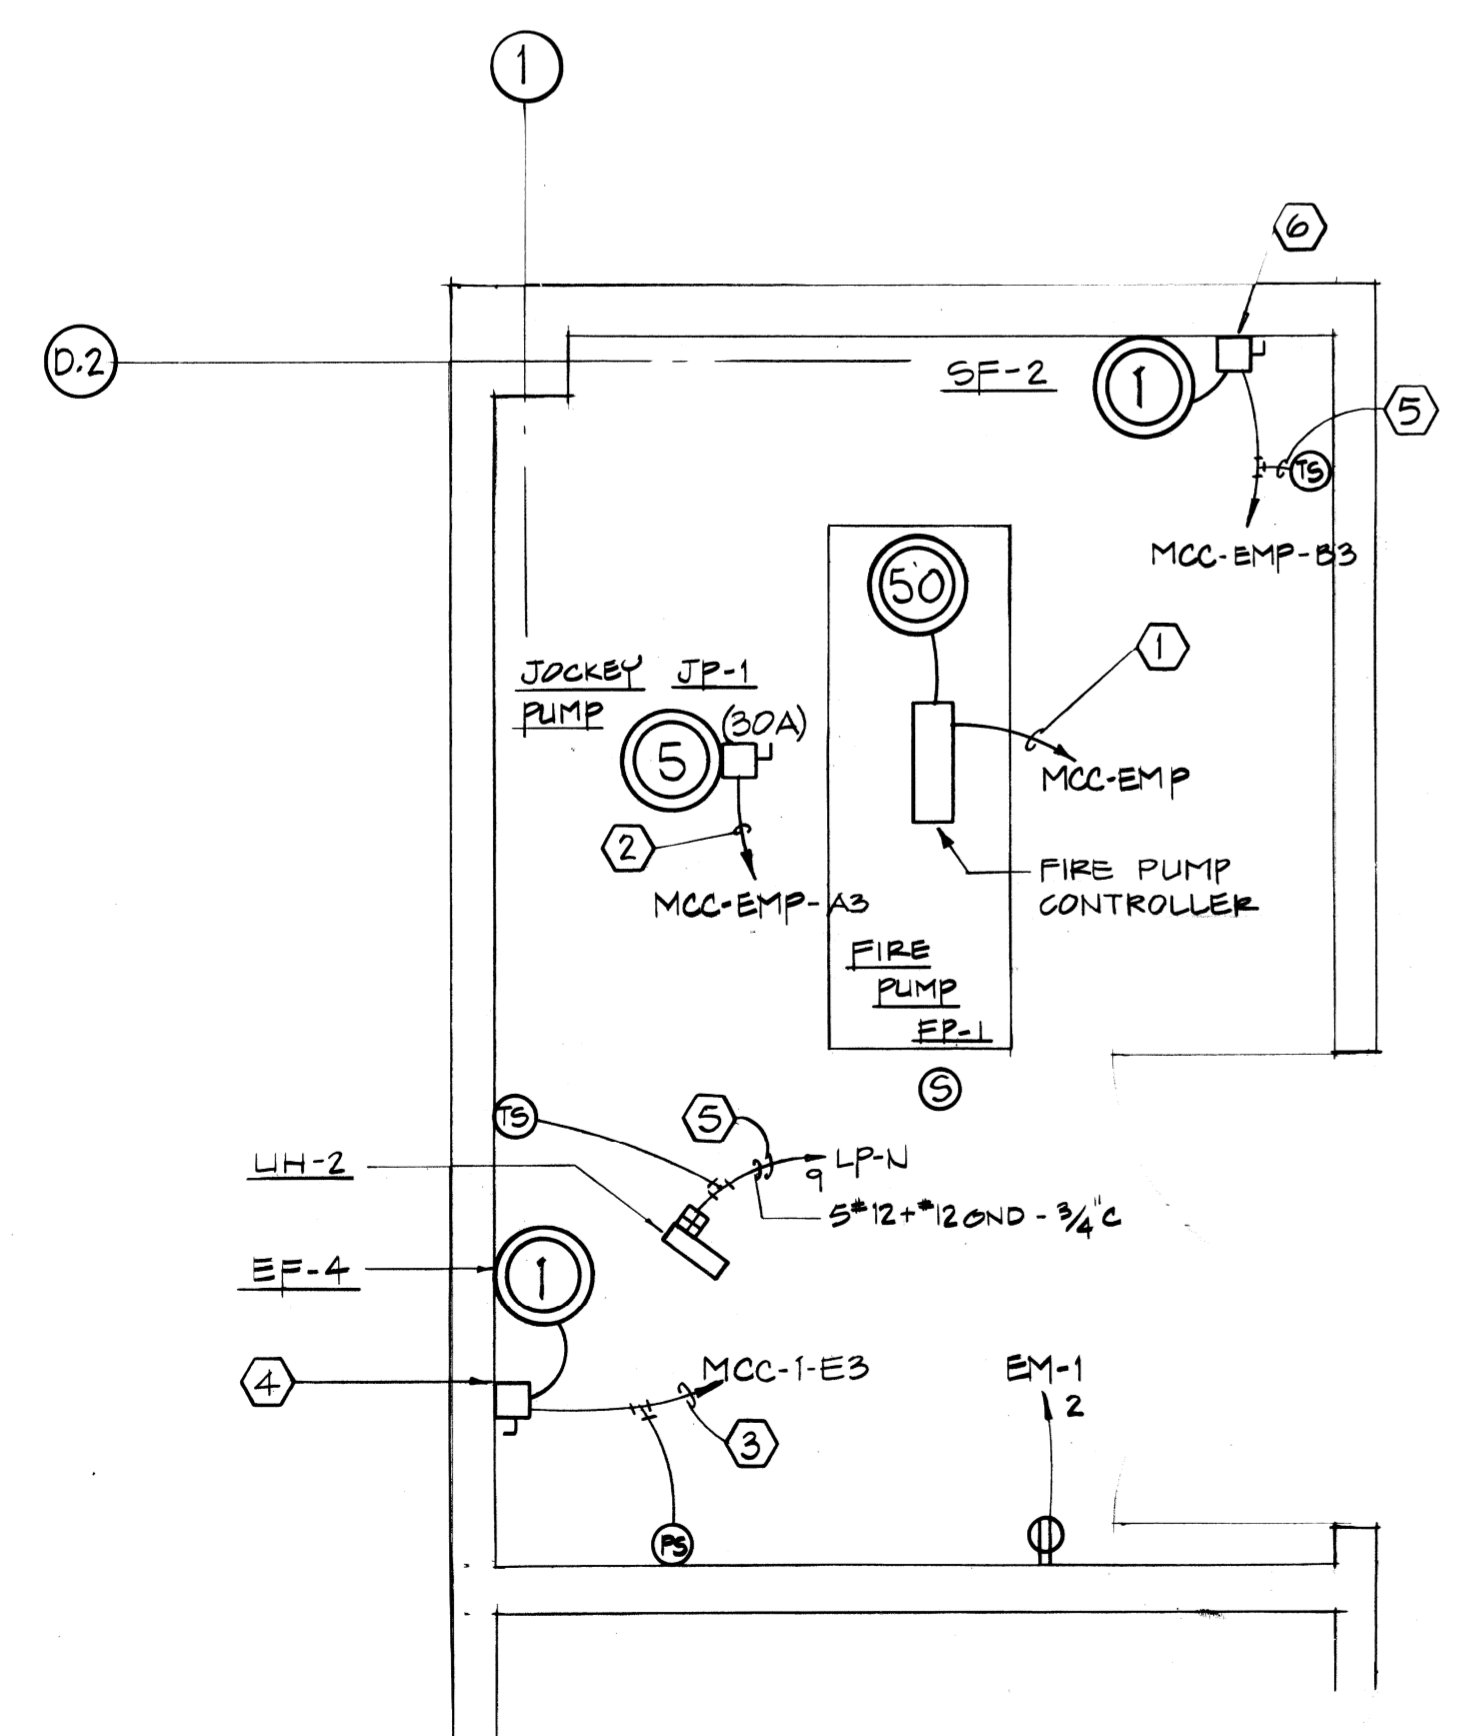

ENLARGED FIRE PUMP ROOM B09
SCALE 3/8"=1'-0"

ENLARGED FIRE PUMP ROOM NOTES

- 1 ROUTE FEEDER FOR FIRE PUMP (FP-1) UNDER SLAB, ENCASED IN CONCRETE, (MINIMUM OF 2" AROUND CONDUIT), AND STAB UP IN EMERGENCY GENERATOR ROOM. DISCONNECT FOR FIRE PUMP IS SUPPLIED BY OTHERS. FEEDER SIZE TO BE 4# 4/0 + #6 GND-2 1/2" CONDUIT VERIFY STUB UP LOCATION IN EMERGENCY GENERATOR ROOM PRIOR TO INSTALLATION.
- 2 ROUTE FEEDER FOR JOCKEY PUMP (JP-1) UNDER SLAB. ENCASED IN CONCRETE (MINIMUM OF 2" AROUND CONDUIT), AND STUB UP IN EMERGENCY GENERATOR ROOM. DISCONNECT FOR JOCKEY PUMP IS SUPPLIED BY OTHERS. FEED SIZE IS 3# 10 + #10 GND - 3/4" C. VERIFY STUB UP LOCATION IN EMERGENCY GENERATOR ROOM PRIOR TO INSTALLATION.
- 3 ROUTE 5#12 + #12 GND - 3/4" C BACK TO MCC-1. WIRE 2# 12 TO PRESSURE SWITCH LOCATED AND INSTALLED BY MECHANICAL CONTRACTOR, WIRED BY ELECTRICAL CONTRACTOR.
- 4 PROVIDE 30 AMP DISCONNECT, NON-FUSED, 250 VAC, WEATHERPROOF, 3 POLE DISCONNECT FOR EF-4, MOUNT DISCONNECT ON WALL ADJACENT TO UNIT.
- 5 2# 12 FOR TEMPERATURE SWITCH POWER. SWITCH IS FURNISHED AND MOUNTED BY MECHANICAL CONTRACTOR.
- 6 PROVIDE 250 VAC, 30 AMP, NON-FUSED, H.D. DISCONNECT FOR SF-2. MOUNT ON WALL ADJACENT TO FAN.

ROBOTICS FACILITY
LEXINGTON CAMPUS
UNIVERSITY OF KENTUCKY
LEXINGTON, KENTUCKY

University of Kentucky
Lexington, Kentucky
APPROVED BY: *Wendy ...*
DIRECTOR - DESIGN AND CONSTRUCTION DIVISION

ELECTRICAL DETAILS
Sherman Carter Barnhart
PARTNERS IN ARCHITECTURE
SUITE 1800 • 250 WEST MAIN STREET • LEXINGTON, KY 40501 • 606/254-1351

JOB NO. 8706
DATE 9-30-87
DRAWN D. MEYER
CHECKED M. GOLDBERG
IN FILE NO. 431.0

REVISIONS
3-10% REVIEW 10-16-87
4-GENERAL 7-18-88

AS BUILT

3-1-11

BELCAN CORPORATION
10200 ANDERSON WAY
CINCINNATI, OHIO 45242

NUMBER 4301 CE-020-4

SHEET
E-2C
Call # 604986
83

BASEMENT POWER PLAN DRAWING NOTES

- 1 ROUTE CONDUIT DOWN FACE OF WALL TO ELECTRICAL EQUIPMENT FROM LADDER CABLE TRAY. SEE DETAIL THIS SHEET.
- 2 MOUNT POWER PANEL PP-A ON WALL. ROUTE CONDUIT SURFACE MOUNTED DOWN FACE OF WALL.
- 3 MOUNT POWER PANEL PP-B ON WALL. ROUTE CONDUIT SURFACE MOUNTED DOWN FACE OF WALL.
- 4 3" X 8" WIREWAY MOUNTED ABOVE CEILING FOR TELEPHONE CABLING ONLY. RUN FROM TELEPHONE BOARD IN COMMUNICATIONS ROOM THROUGH CORRIDOR.
- 5 8" X 8" WIREWAY MOUNTED ABOVE CEILING FOR COMMUNICATIONS AND COMPUTER CABLING. RUN FROM COMMUNICATIONS ROOM THROUGH CORRIDOR.
- 6 EXTEND 3/4" EMPTY CONDUIT (WITH PULLSTRING) FROM WIREWAY IN CORRIDOR TO TELEPHONE OUTLET. ROUTE CONDUIT ABOVE CEILING AND DOWN IN WALL. TYPICAL FOR SINGLE TELEPHONE OUTLET.
- 7 EXTEND 1" EMPTY CONDUIT (WITH PULLSTRING) FROM WIREWAY IN CORRIDOR TO (2) TELEPHONE OUTLETS. ROUTE CONDUIT ABOVE CEILING AND DOWN IN WALL TO OUTLETS. TYPICAL FOR DOUBLE TELEPHONE OUTLETS.
- 8 EXTEND 1" EMPTY CONDUIT (WITH PULLSTRING) FROM WIREWAY IN CORRIDOR TO (2) COMPUTER OUTLETS. ROUTE CONDUIT ABOVE CEILING AND DOWN IN WALL TO OUTLETS. TYPICAL FOR DOUBLE COMPUTER OUTLETS.
- 9 MOUNT 208 VAC 1 PHASE OUTLET 18" AFF.
- 10 8" X 8" WIREWAY MOUNTED ABOVE CEILING FOR 120 VOLT POWER TO CABLE TRAY IN MACHINE BAY.
- 11 NOT USED
- 12 ROUTE EMPTY 3/4" CONDUIT DOWN IN WALL FOR DOOR CLOSER CONTROL WIRING. ROUTE CONDUIT BACK TO DATA GATHERING PANEL.
- 17 NOT USED
- 18 NOT USED
- 19 NOT USED
- 20 NOT USED
- 21 DOOR CONTRACTOR TO PROVIDE 30 AMP, 3P, 250 VAC NON-FUSIBLE NEMA TYPE 1 DISCONNECT.
- 22 OPEN, CLOSE, STOP PUSHBUTTON FURNISHED AND INSTALLED BY DOOR CONTRACTOR WIRED BY ELECTRICAL CONTRACTOR EXTEND CONTROL WIRING IN 3/4" CONDUIT FROM PUSH-BUTTON UNIT TO DOOR CONTROLLER PER MANUFACTURERS RECOMMENDATIONS. STARTER AND CONTROLS BY DOOR CONTRACTOR.
- 23 PROVIDE 60 AMP DROP (480 VOLT 3 PHASE) FROM CABLE TRAY FOR WELDING OUTLET.
- 24 PROVIDE 30 AMP, NON-FUSED, H.D., 3 POLE DISCONNECT MOUNTED ON WALL FOR EF-6. VERIFY FINAL LOCATION OF EF-6 PRIOR TO INSTALLATION.
- 25 MOUNT START STOP BUTTON ADJACENT TO EF-6 FOR CONTROL. START STOP BUTTON IS FURNISHED, INSTALLED, AND WIRED BY ELECTRICAL CONTRACTOR.
- 26 PROVIDE 30 AMP, NON-FUSED HEAVY DUTY 3 POLE DISCONNECT MOUNTED ON WALL FOR CONTROLLER UNIT. 5
- 27 PROVIDE 60 AMP NON-FUSED HEAVY DUTY 3 POLE DISCONNECT MOUNTED ON WALL FOR WELDER UNIT.

SECOND FLOOR POWER PLAN NOTES

- 1 MOUNT GFI RECEPTACLE 42" AFF. (ABOVE COUNTER) ROTATE RECEPTACLE 90 DEGREES SO RECEPTACLE IS MOUNTED HORIZONTALLY.
- 2 PROVIDE RECEPTACLE FOR UNDER COUNTER REFRIGERATOR.
- 3 PROVIDE GFI RECEPTACLE MOUNTED 42" AFF.
- 4 CORE DRILL FLOOR SLAB FOR FLUSH TYPE RECEPTACLE. ROUTE FEEDER BACK TO 1ST FLOOR PANEL AS INDICATED. VERIFY FINAL LOCATION PRIOR TO ROUGH-IN.
- 5 CORE DRILL FLOOR SLAB FOR FLUSH TYPE TELEPHONE OUTLET. ROUTE 3/4" CONDUIT FROM EACH OUTLET TO TELEPHONE RACEWAY ON 1ST FLOOR.
- 6 3" X 8" WIREWAY MOUNTED ABOVE CEILING FOR TELEPHONE CABLING ONLY. RUN FROM TELEPHONE BOARD IN COMMUNICATIONS ROOM THROUGH CORRIDOR.
- 7 3" X 8" WIREWAY MOUNTED ABOVE CEILING FOR COMMUNICATIONS AND COMPUTER CABLING. RUN FROM COMMUNICATIONS ROOM THROUGH CORRIDOR.
- 8 EXTEND 3/4" EMPTY CONDUIT (WITH PULLSTRING) FROM WIREWAY IN CORRIDOR TO TELEPHONE OUTLET. ROUTE CONDUIT ABOVE CEILING AND DOWN IN WALL. TYPICAL FOR SINGLE TELEPHONE OUTLET.
- 9 EXTEND 3/4" EMPTY CONDUIT (WITH PULLSTRING) FROM WIREWAY IN CORRIDOR TO COMPUTER OUTLET. ROUTE CONDUIT ABOVE CEILING AND DOWN IN WALL. TYPICAL FOR SINGLE COMPUTER OUTLET.
- 10 EXTEND 1" EMPTY CONDUIT (WITH PULLSTRING) FROM WIREWAY IN CORRIDOR TO (2) TELEPHONE OUTLETS. ROUTE CONDUIT ABOVE CEILING AND DOWN IN WALL TO OUTLETS. TYPICAL FOR DOUBLE TELEPHONE OUTLETS.
- 11 EXTEND 1" EMPTY CONDUIT (WITH PULLSTRING) FROM WIREWAY IN CORRIDOR TO (2) COMPUTER OUTLETS. ROUTE CONDUIT ABOVE CEILING AND DOWN IN WALL TO OUTLETS. TYPICAL FOR DOUBLE COMPUTER OUTLETS.
- 12 EXTEND 3/4" CONDUIT (WITH PULLSTRING) FROM WIREWAY IN CORRIDOR TO TELEVISION OUTLET. ROUTE CONDUIT ABOVE CEILING AND DOWN IN WALL TO OUTLET.
- 13 MOUNT JUNCTION BOX 24" AFF FOR FUTURE CONNECTION TO WORKSTATION UNITS. VERIFY LOCATION PRIOR TO INSTALLATION.
- 14 ROUTE EMPTY 3/4" CONDUIT DOWN IN WALL FOR DOOR CLOSER CONTROL WIRING. ROUTE CONDUIT BACK TO DATA GATHERING PANEL.
- 15 PROVIDE 100 AMP, NON-FUSED, H.D., 250 VAC DISCONNECT FOR AH-3 MOUNT ON WALL ADJACENT TO UNIT. VERIFY FINAL LOCATION WITH MECHANICAL CONTRACTOR.
- 16 ROUTE 5# 12 + #12 GND - 3/4"C TO 120 VAC PANEL INDICATED FOR ROLL FILTER F-3. MOTOR STARTER AND START-STOP BUTTON FURNISHED AND MOUNTED BY MECHANICAL CONTRACTOR. 2# 12 FOR START-STOP CONTROL.
- 17 ROUTE 5# 12 + #12 GND - 3/4"C TO 120 VAC PANEL INDICATED. TEMPERATURE SWITCH IS FURNISHED AND MOUNTED BY MECHANICAL CONTRACTOR. 2# 12 IS FOR TEMPERATURE SWITCH POWER.
- 18 ELECTRICAL CONTRACTOR SHALL FURNISH AND WIRE DUCT MOUNTED SMOKE DETECTOR (1 IN SUPPLY, 1 IN RETURN) FOR AH-3 SEE FIRE ALARM RISER DIAGRAM. DETECTORS ARE MOUNTED BY MECHANICAL CONTRACTOR.

THIRD FLOOR POWER PLAN NOTES

- 1 3" X 8" WIREWAY MOUNTED ABOVE CEILING FOR TELEPHONE CABLING ONLY. RUN FROM TELEPHONE BOARD IN COMMUNICATIONS ROOM THROUGH CORRIDOR.
- 2 8" X 8" WIREWAY MOUNTED ABOVE CEILING FOR COMMUNICATIONS AND COMPUTER CABLING. RUN FROM COMMUNICATIONS ROOM THROUGH CORRIDOR.
- 3 EXTEND 3/4" EMPTY CONDUIT (WITH PULLSTRING) FROM WIREWAY IN CORRIDOR TO TELEPHONE OUTLET. ROUTE CONDUIT ABOVE CEILING AND DOWN IN WALL. TYPICAL FOR SINGLE TELEPHONE OUTLET.
- 4 EXTEND 3/4" EMPTY CONDUIT (WITH PULLSTRING) FROM WIREWAY IN CORRIDOR TO COMPUTER OUTLET. ROUTE CONDUIT ABOVE CEILING AND DOWN IN WALL. TYPICAL FOR SINGLE COMPUTER OUTLET.
- 5 EXTEND 1" EMPTY CONDUIT (WITH PULLSTRING) FROM WIREWAY IN CORRIDOR TO (2) TELEPHONE OUTLETS. ROUTE CONDUIT ABOVE CEILING AND DOWN IN WALL TO OUTLETS. TYPICAL FOR DOUBLE TELEPHONE OUTLETS.
- 6 EXTEND 1" EMPTY CONDUIT (WITH PULLSTRING) FROM WIREWAY IN CORRIDOR TO (2) COMPUTER OUTLETS. ROUTE CONDUIT ABOVE CEILING AND DOWN IN WALL TO OUTLETS. TYPICAL FOR DOUBLE COMPUTER OUTLETS.
- 7 EXTEND 3/4" EMPTY CONDUIT (WITH PULLSTRING) FROM WIREWAY IN CORRIDOR TO TELEVISION OUTLET. ROUTE CONDUIT ABOVE CEILING AND DOWN IN WALL TO OUTLETS.
- 8 NOT USED
- 9 PROVIDE DUPLEX OUTLET FOR INVENTORY CONTROL COMPUTER.
- 10 PROVIDE FLUSH MOUNTED PUSH BUTTON STATION FOR MOTORIZED PROJECTION SCREEN OPERATION CONTROL. ROUTE CONTROL WIRES TO PROJECTION SCREEN'S CONTROLLER.
- 11 PROVIDE 4" X 4" SURFACE MOUNTED DUCT FOR SPEAKER AND CAMERA CABLING TO EXTEND BELOW RAISED FLOOR TO ABOVE ACOUSTICAL CEILING.
- 12 PROVIDE 250 VAC, 200 AMP, NON-FUSED, H.D., 3 POLE DISCONNECT FOR AH-4. MOUNT DISCONNECT ON WALL ADJACENT TO UNIT. VERIFY FINAL LOCATION WITH MECHANICAL CONTRACTOR.
- 13 ROUTE 5# 12 + #12 GND - 3/4"C TO 120 VAC PANEL AS INDICATED FOR ROLL FILTER F-4. MANUAL MOTOR STARTER AND START-STOP BUTTON FURNISHED AND MOUNTED BY MECHANICAL CONTRACTOR. 2# 12 FOR START-STOP BUTTON POWER.
- 14 2# 12 IS FOR TEMPERATURE SWITCH POWER. TEMPERATURE SWITCH IS SUPPLIED AND MOUNTED BY MECHANICAL CONTRACTOR.
- 15 MOUNT JUNCTION BOX IN WALL AT 18" AFF FOR FUTURE CONNECTION TO WORKSTATIONS. MOUNT JUNCTION BOXES 6'-0" O.C. ALONG WALLS.
- 16 PROVIDE JUNCTION BOX MOUNTED ABOVE CEILING WITH 1" EMPTY CONDUIT ROUTED BACK TO ELECTRICAL EQUIPMENT ROOM.
- 17 ELECTRICAL CONTRACTOR SHALL FURNISH AND WIRE DUCT MOUNTED SMOKE DETECTOR (1 IN SUPPLY, 1 IN RETURN) FOR AH-4. SEE FIRE ALARM RISER DIAGRAM. DETECTORS ARE MOUNTED BY MECHANICAL CONTRACTOR.

RELOCATION NOTES - AC GENERATOR

- Contractor must inspect the site & existing installation.
- Relocate existing 30KW AC Generator and all associated equipment to this location.
- Mount associated equipment on west retaining wall.
- Architect to design & furnish enclosure. Clear height in enclosure to be 9'-0" AFF.
- Reconnect relocated AC Generator to Anderson Hall existing emergency circuits.
- Routing of conduits to be a field condition. University approval must be obtained before installation of any conduit or equipment.
- Install 1 Type "H" TYPE H-1 RLM lighting fixtures. Chain mounted 8'-0" AFF with wall switch at door. FIXTURE TO HAVE LOW TEMP BALLAST.
- Connect new 20A-1P, 120V, GFI receptacle to emergency panelboard in MCC-EMP.


NOTES: DC GENERATOR

- Contractor must inspect the site and existing conditions.
- Relocate existing DC Generator and all associated equipment to location in the Anderson Hall basement Mechanical Room. The exact location will be indicated during site inspection.
- Construct a "Unistrut Type" support frame to mount associated equipment. Locate frame adjacent to generator.
- Provide drip shield to under side of piping above generator to prevent dripping on generator.
- Reconnect relocated DC Generator to existing circuits.
- Routing of conduits to be a field condition. University approval must be obtained before installation of any conduit or equipment.

NOTES: COMMUNICATION CONDUIT

- Others will install 4-4" conduits and stub up along north face of south wall of Anderson Hall basement Mechanical Room. See Drawing E-2 for approximate location of stub-ups.
- This contractor to extend 4-4" conduit (with fishwire) exposed through Mechanical Room to Communication Room No. 89. Terminate bused conduits in Room.
- Exact routing of conduit to be determined in field. University approval must be obtained before installation of conduit.

"This seal and signature apply only to the unaltered document to which they are affixed. I expressly disclaim any responsibility for any and all changes made after the issue date, for other plans, specifications, estimates, reports or other documents or instruments relating to or intended to be used for any part or portion of the architectural or engineering project or survey."

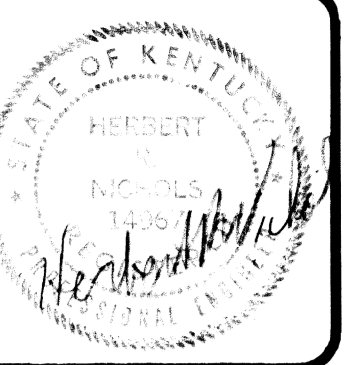

ROBOTICS FACILITY
LEXINGTON CAMPUS
UNIVERSITY OF KENTUCKY
LEXINGTON, KENTUCKY

University of Kentucky
Lexington, Kentucky
Approved by: *Robert W. Carter*
Director, Design and Construction Division

ELECTRICAL DRAWING NOTES

Sherman Carter Barnhart
PARTNERS IN ARCHITECTURE
SUITE 1900 • 750 WEST MAIN STREET • LEXINGTON, KY 40501 • 606-254-1351

JOB NO. 8706
DATE 9-30-87
DRAWN D. MEYER
CHECKED M. GOLDBERG

REVISIONS
3-10% REVIEW 10-16-87
4- GENERAL 7-18-87
5- RENOVATION 2-16-90

AS BUILT

3-1-9.

BELCAN CORPORATION
10200 ANDERSON WAY
CINCINNATI, OHIO 45242

NUMBER: 4361-CE-021-4

SHEET

E-21

Document # 041987
Sheet E-2

LUMINAIRE SCHEDULE

TYPE	DESCRIPTION	LAMP	MFR. NO.				
A	WALL MOUNTED VAPORTIGHT INCANDESCENT WITH CAST ALUMINUM HOUSING & GUARD, TEMPERED GLASS GLOBE U.L. WET LABEL	1-150W A-21	HUBBELL VM-151 EQUALS BY GE OR ARROW HART	N	WALL MOUNTED H.I.D. WITH BRONZE FINISH DIECAST ALUMINUM HOUSING WITH HIGH IMPACT ACRYLIC LENS	1-175 WATT METAL HALIDE	DAYRITE WL17MHDT EQUALS BY GENERAL ELECTRIC HUBBELL
B	2X4 FLUORESCENT TROFFER MOUNTING IN 2X2 CEILING BAKED WHITE ENAMEL FINISH. ALUMINUM DOOR WITH MITERED CORNERS. ENERGY SAVING BALLAST. .125" MINIMAL LENS THICKNESS.	4-FT12CW 40W	DAYRITE CG244-CFA2D-ESB-120 EQUALS BY COLUMBIA BENJAMIN	P	24" WALL MOUNTED FLUORESCENT WITH UP AND DOWN LIGHT. 125 VIRGIN ACRYLIC LENS, WHITE EXTERIOR FINISH	2-FT12CW 20 WATT	BENJAMIN C2W 2E22-2 OR EQUAL BY KEENE
B-1	SAME AS TYPE "B" BUT W/ EMERGENCY BALLAST	4 FT12CW 40W	DUAL-LITE UFO-2X EQUAL BY CHLORIDE	Q	10" WALL MOUNTED INCANDESCENT GLOBE. GLOBE TO BE BRONZE GLASS WITH BLACK HOUSING	1-100W A-19	HADCO B-4461-R PRESCOLITE SPAULDING
C	SAME AS TYPE "B" BUT WITH DIMMING BALLAST	4-FT12CW 40W	DAYRITE CG244-CFA 12D DIMMING-120 EQUALS COLUMBIA, BENJAMIN	R	SEMI-RECESSED WALL MOUNTED H.I.D. 12" SQ. CAST ALUMINUM HOUSING DARK BRONZE FINISH TEMPERED GLASS	1-100W MERCURY VAPOR	MOLDCAST MDL-2-02-11 -12-TPH OR EQUAL BY KIM
C-1	SAME AS TYPE "C" BUT WITH EMERGENCY BALLAST	4-FT12CW 40W	DUAL - LITE UFO-2X EQUAL BY CHLORIDE	S	2X4 FLUORESCENT TROFFER WITH ACTUAL .125 ACRYLIC LENS AND LOW TEMPERATURE BALLAST	4-FT12CW 40 WATT	DAYRITE CG244-CFA 12D-120-LT EQUALS BY COLUMBIA BENJAMIN
D	PENDANT MOUNTED H.I.D. WITH DIE CAST BALLAST HOUSING, WITH HEAVY GAUGE ALUMINUM REFLECTOR WITH SEMI-SPECULAR FINISH WITH POWER HOOK MOUNTING ASSEMBLY	1-400W METAL HALIDE	DAYRITE HB40MH-120 -S16 EQUALS BY GE HUBBELL	T	WALL MOUNTED FLUORESCENT DARK BRONZE FINISH POLYCARBONATE LENS	2-PLT 7 WATT TWIN TUBES	FAIL SAFE FB144-120
D-1	SAME AS TYPE D BUT WITH QUARTZ RESTRIKE	1-400 WATT METAL HALIDE 1-QUARTZ MANF. STANDARD	DAYRITE HB40MH-120-S16 - QZ EQUALS BY GE HUBBELL	U	SAME AS TYPE "R" BUT WITH DIFFERENT DISTRIBUTION	1-100W MERCURY VAPOR	MOLDCAST MDL-3-02-11 12-PTH OR EQUAL BY KIM
E	NOT USED.			V	SURFACE MOUNTED H.I.D. WITH DIE CAST ALUMINUM HOUSING AND GASKETED LENS WET LABEL	1-175W METAL HALIDE	PRESCOLITE HV13C06 EQUALS BY ALKCO MCPHILBEN
F	RECESSED INCANDESCENT WITH GOLD ALZAK REFLECTOR WITH TRIM RING 6-3/4" APERTURE	1-200W A-23	MARCO D302203 EQUALS BY PRESCOLITE KURT VERSEN	V-1	SAME AS TYPE V BUT WITH QUARTZ RESTRIKE	1-175W METAL HALIDE	HV13C06-MM EQUALS BY ALKCO MCPHILBEN
F-1	SAME AS TYPE "F" BUT DIFFERENT LAMP	1-200W A-23 130VOLT	MARCO D302203 EQUAL BY KURT VERSEN, PRESCOLITE	W	RECESSED 8'-0 TRACK SINGLE CIRCUIT WITH WHITE FINISH. TO BE RECESSED IN SUSPENDED CEILING WITH HEADS BLACK FINISH AND BARN DOORS NO. OF HEADS AS INDICATED ON DRWGS.	1-150W R-40	PRESCOLITE T114-BL-T64 EQUALS BY MARCO
G	CHAIN SUSPENDED FLUORESCENT INDUSTRIAL WITH HIGH REFLECTANCE FINISH 25% UPLIGHT. 96" LONG WITH END PLATES AND ENERGY SAVING BALLAST	4-FT12CW 40W	DAYRITE R-41252W-8 EQUAL BY KEYSTON BENJAMIN	X	UNIVERSAL MOUNTED EXIT SIGN (CEILING, WALL, END) WITH RED LETTERS, BRUSHED ALUMINUM HOUSING AND FLUORESCENT LAMPS. DIRECTIONAL ARROWS AS SHOWN ON DRAWINGS	MANF. STD.	DUAL-LITE 6HRNN-FL EQUALS BY PRESCOLITE
G-1	SAME AS TYPE "G" BUT WITH EMERGENCY BALLAST	4-FT12CW 40W	DUAL-LITE UFO-2X EQUALS BY CHLORIDE	Y	SINGLE LAMP FLUORESCENT PENDANT MOUNTED 6" X 6" SQUARE SYMMETRICAL REFLECTOR. END TO END CONTINUOUS MOUNTING. WALL TO WALL INSTALLATION FACTORY WIRE. SUSPENDED BY AIRCRAFT CABLE. NON-ILLUMINATING TELESCOPING MEMBERS. 1/2" X 1/2" X 1/2" GOLD PARACUBE LENS. HOUSING TO BE STEEL AND FINISH BY ARCHITECT. START FEED TO, THRU END.	1-FT12CW 40W	COLUMBIA S8-12-31 EQUALS BY PEERLESS & LITE CONTROL
H	SAME AS TYPE G BUT 48" LONG	2-FT12 CW 40 W	DAYRITE R-41252W-4 EQUALS BY KEYSTONE BENJAMIN	B-2	SAME AS TYPE "B" EXCEPT TO BE 1 X 4	2-FT12CW 40W	DAYRITE CG142-CO2A-120 EQUALS BY COLUMBIA BENJAMIN
H-1	SAME AS TYPE H BUT WITH EMERGENCY BALLAST	2FT12CW 40W	DUAL-LITE UFO-2X EQUAL BY CHLORIDE	B-3	SAME AS TYPE "B" EXCEPT TO HAVE PARABOLIC LENS	4-FT12CW 40W	DAYRITE CG244-CO2A-120 EQUALS BY COLUMBIA BENJAMIN
J	CHAIN SUSPENDED 48" LONG FLUORESCENT CHANNEL	2-FT12CW 40W	DAYRITE C-240 OR EQUAL BY KEYSTONE BENJAMIN				
K	WALL MOUNTED FLUORESCENT WITH UP AND DOWN LIGHT. 48" LONG, 7-1/8" DEEP. 125 VIRGIN ACRYLIC LENS, WHITE EXTERIOR FINISH	2-FT12CW 40 W	BENJAMIN C2X-2324-4 OR EQUAL BY KEENE				
K-1	TYPE "K-1" C240-ES-120 W/F40CW						
L	1X4 RECESSED FLUORESCENT TROFFER MOUNTING IN 2X2 CEILING ALUMINUM DOOR WITH MITERED CORNERS AND ENERGY SAVING BALLAST. .125 ACTUAL LENS THICKNESS	2-FT12CW 40 W	DAYRITE SG142-SFA 12A-ESB EQUALS BY COLUMBIA BENJAMIN				
M	12" ROUND 8" HIGH RECESSED H.I.D. WITH FLAT FRESNEL LENS INNER GRAY TRIM OUTER WHITE TRIM	1-175 WATT METAL HALIDE	MARCO LRS11742-GP EQUALS BY PRESCOLITE KURT VERSEN				
M-1	SAME AS TYPE "M" BUT WITH QUARTZ RESTRIKE	1-175 WATT METAL HALIDE 1-QUARTZ RESTRIKE	MARCO LS616850-KP/11 EQUALS BY PRESCOLITE KURT VERSEN				

- SYMBOL LEGEND**
- 2X4 FLUORESCENT LUMINAIRE. a/b DENOTES EACH BALLAST CONTROLLED BY SEPERATE SWITCH
 - ▣ 2X4 FLUORESCENT LUMINAIRE WITH ONE BALLAST CONNECTED TO EMERGENCY PANEL
 - ⊗ EXIT SIGN (CONNECT TO EMERGENCY PANEL)
 - Ⓐ LUMINAIRE TYPE (SEE LUMINAIRE SCHEDULE)
 - ② SEE DRAWING NOTE 2
 - Ⓛ DUPLEX RECEPTACLE MOUNTED 18" AFF. UNLESS OTHERWISE NOTED
 - Ⓜ HOMERUN DESIGNATION. LP-A DESIGNATES PANEL, 5 DESIGNATES CIRCUIT
 - Ⓞ JUNCTION OR OUTLET BOX
 - RACEWAY CONCEALED IN WALL OR CEILING
 - RACEWAY EXPOSED
 - ▼ TELEPHONE OUTLET MOUNTED 18" AFF UNLESS OTHERWISE NOTED
 - WALL MOUNTED LUMINAIRE
 - ⊙ SMOKE DETECTOR
 - ⊙ SMOKE DETECTOR FOR ELEVATOR LOBBY
 - △ SMOKE DETECTOR MOUNTED UNDER FLOOR
 - Ⓛ MANUAL PULL STATION
 - Ⓛ FIRE ALARM SPEAKER
 - Ⓞ 208 VAC, 3 PHASE, 30 AMP OUTLET. #10 + #10 GND TO OUTLET. VERIFY TERMINATION CONFIGURATION.
 - Ⓞ 208 VAC, 1 PHASE, 30 AMP OUTLET. 2 #10 + #10 GND TO OUTLET VERIFY TERMINATION CONFIGURATION.
 - Ⓞ FLUSH FLOOR OUTLET
 - Ⓞ PHOTOCELL
 - Ⓞ 8" X 8" TELEPHONE WIREWAY
 - Ⓞ 8" X 8" COMMUNICATIONS WIREWAY
 - ▼ COMPUTER OUTLET WITH GROMMETTED FACE PLATE MOUNTED 18" AFF
 - Ⓞ CLOCK OUTLET
 - CONDUIT TURNING DOWN
 - Ⓞ TELEVISION OUTLET WITH GROMMETTED FACE PLATE MOUNTED 18" AFF
 - Ⓞ DOUBLE DUPLEX RECEPTACLE
 - Ⓞ GROUNDING OUTLET MOUNTED UNDER RAISED FLOOR.
 - Ⓞ DUPLEX RECEPTACLE: -G INDICATES GFI -W INDICATES WEATHERPROOF
 - Ⓞ BELL
 - Ⓞ SINGLE POLE WALL SWITCH; Q DENOTES LOAD SWITCHED. * 3=3WAY; 4=4WAY; D=DIMMER SWITCH; PL=PILOT LIGHT. ALL SWITCHES MOUNTED 48" AFF.
 - NON-FUSED DISC SWITCH, NEMA 1- UNLESS NOTED OTHERWISE.
 - Ⓞ MAGNETIC MOTOR STARTER
 - Ⓞ PUSH-BUTTON STATION

Ⓞ HOMERUN W/3Ø CONDUCTORS, 1 NEUTRAL & 1 GROUND CONDUCTOR, ALL #12 IN 3/4" C., UNLESS MARKED OTHERWISE

Ⓞ JUNCTION BOX ABOVE CEILING W/VERTICAL FLEXIBLE CONDUIT DROP INCLUDING CONDUCTORS. INSTALL LENGTH TO FLOOR PLUS 3 FEET. COIL & PROTECT.


Ⓞ POWER PALS WITH POWER RECEPT'S & COMPUTER OUTLET

Ⓞ KEYPAD & DOORLOCK MECHANISM

Ⓞ ALARM INDICATOR LIGHT & SIREN

Ⓞ INFAKER MOTION DETECTOR

"This seal and signature apply only to the unaltered document to which they are affixed. I expressly disclaim any responsibility for any and all changes made after the issue date, for other plans, specifications, estimates, reports or other documents or instruments relating to or intended to be used for any part or portion of the architectural or engineering project or survey."

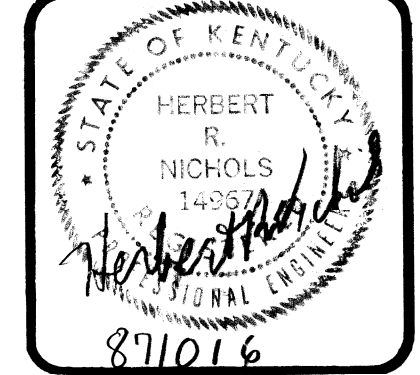

ROBOTICS FACILITY
LEXINGTON CAMPUS
UNIVERSITY OF KENTUCKY
LEXINGTON, KENTUCKY

University of Kentucky
Lexington, Kentucky

Approved by: *Walter B. Bunn* 10.19.87
Director, design and construction division

LUMINAIRE SCHED. & SYMBOLS

Sterman Carter Barnhart
PARTNERS IN ARCHITECTURE
SUITE 1910 • 230 WEST MAIN STREET • LEXINGTON, KY 40507 • 606-254-1351

JOB NO. 8706
DATE 9-30-87
DRAWN D. MEYER
CHECKED M. GOLDBERG
JOB NO. 431.0

REVISIONS
3-10-87 REVIEW 10-16-87
4-GENERAL 7-18-88
5-REVISIONS 2-16-90

AS BUILT
3-1-31

BELCAN CORPORATION
10200 ANDERSON WAY
CINCINNATI, OHIO 45242
NUMBER: 4261-CE-022-4

SHEET
E-22
Sheet
064988
B-2

This seal and signature apply only to the unaltered document to which they are affixed. I expressly disclaim any responsibility for any and all changes made after the issue date, for other plans, specifications, estimates, reports or other documents or instruments relating to or intended to be used for any part or portion of the architectural or engineering project survey.



ROBOTICS FACILITY
LEXINGTON CAMPUS
UNIVERSITY OF KENTUCKY
LEXINGTON, KENTUCKY

University of Kentucky
Lexington, Kentucky
Approved by: *Wendy Swann*
Director - design and construction division
10-18-87


SINGLE LINE DIAGRAM
Stelman Carter, Barnhart
PARTNERS IN ARCHITECTURE
SUITE 1900 • 250 WEST MAIN STREET • LEXINGTON, KY 40507 • 606-254-1931

JOB NO. **8706**
DATE **9-30-87**
DRAWN **D. MEYER**
CHECKED **M. GOLDBERG**
DK FILE NO. **431.0**

REVISIONS
3-90% REVIEW 10-16-87
4-GENERAL 7-18-88
5-RENOVATION 2-16-90

SHEET
E-23
Cub.# Sit. B-2
Document# 014189

AS BUILT
3-1-91
BELCAN CORPORATION
10200 ANDERSON WAY
CINCINNATI, OHIO 45242
NUMBER: 4361-CE-023-4

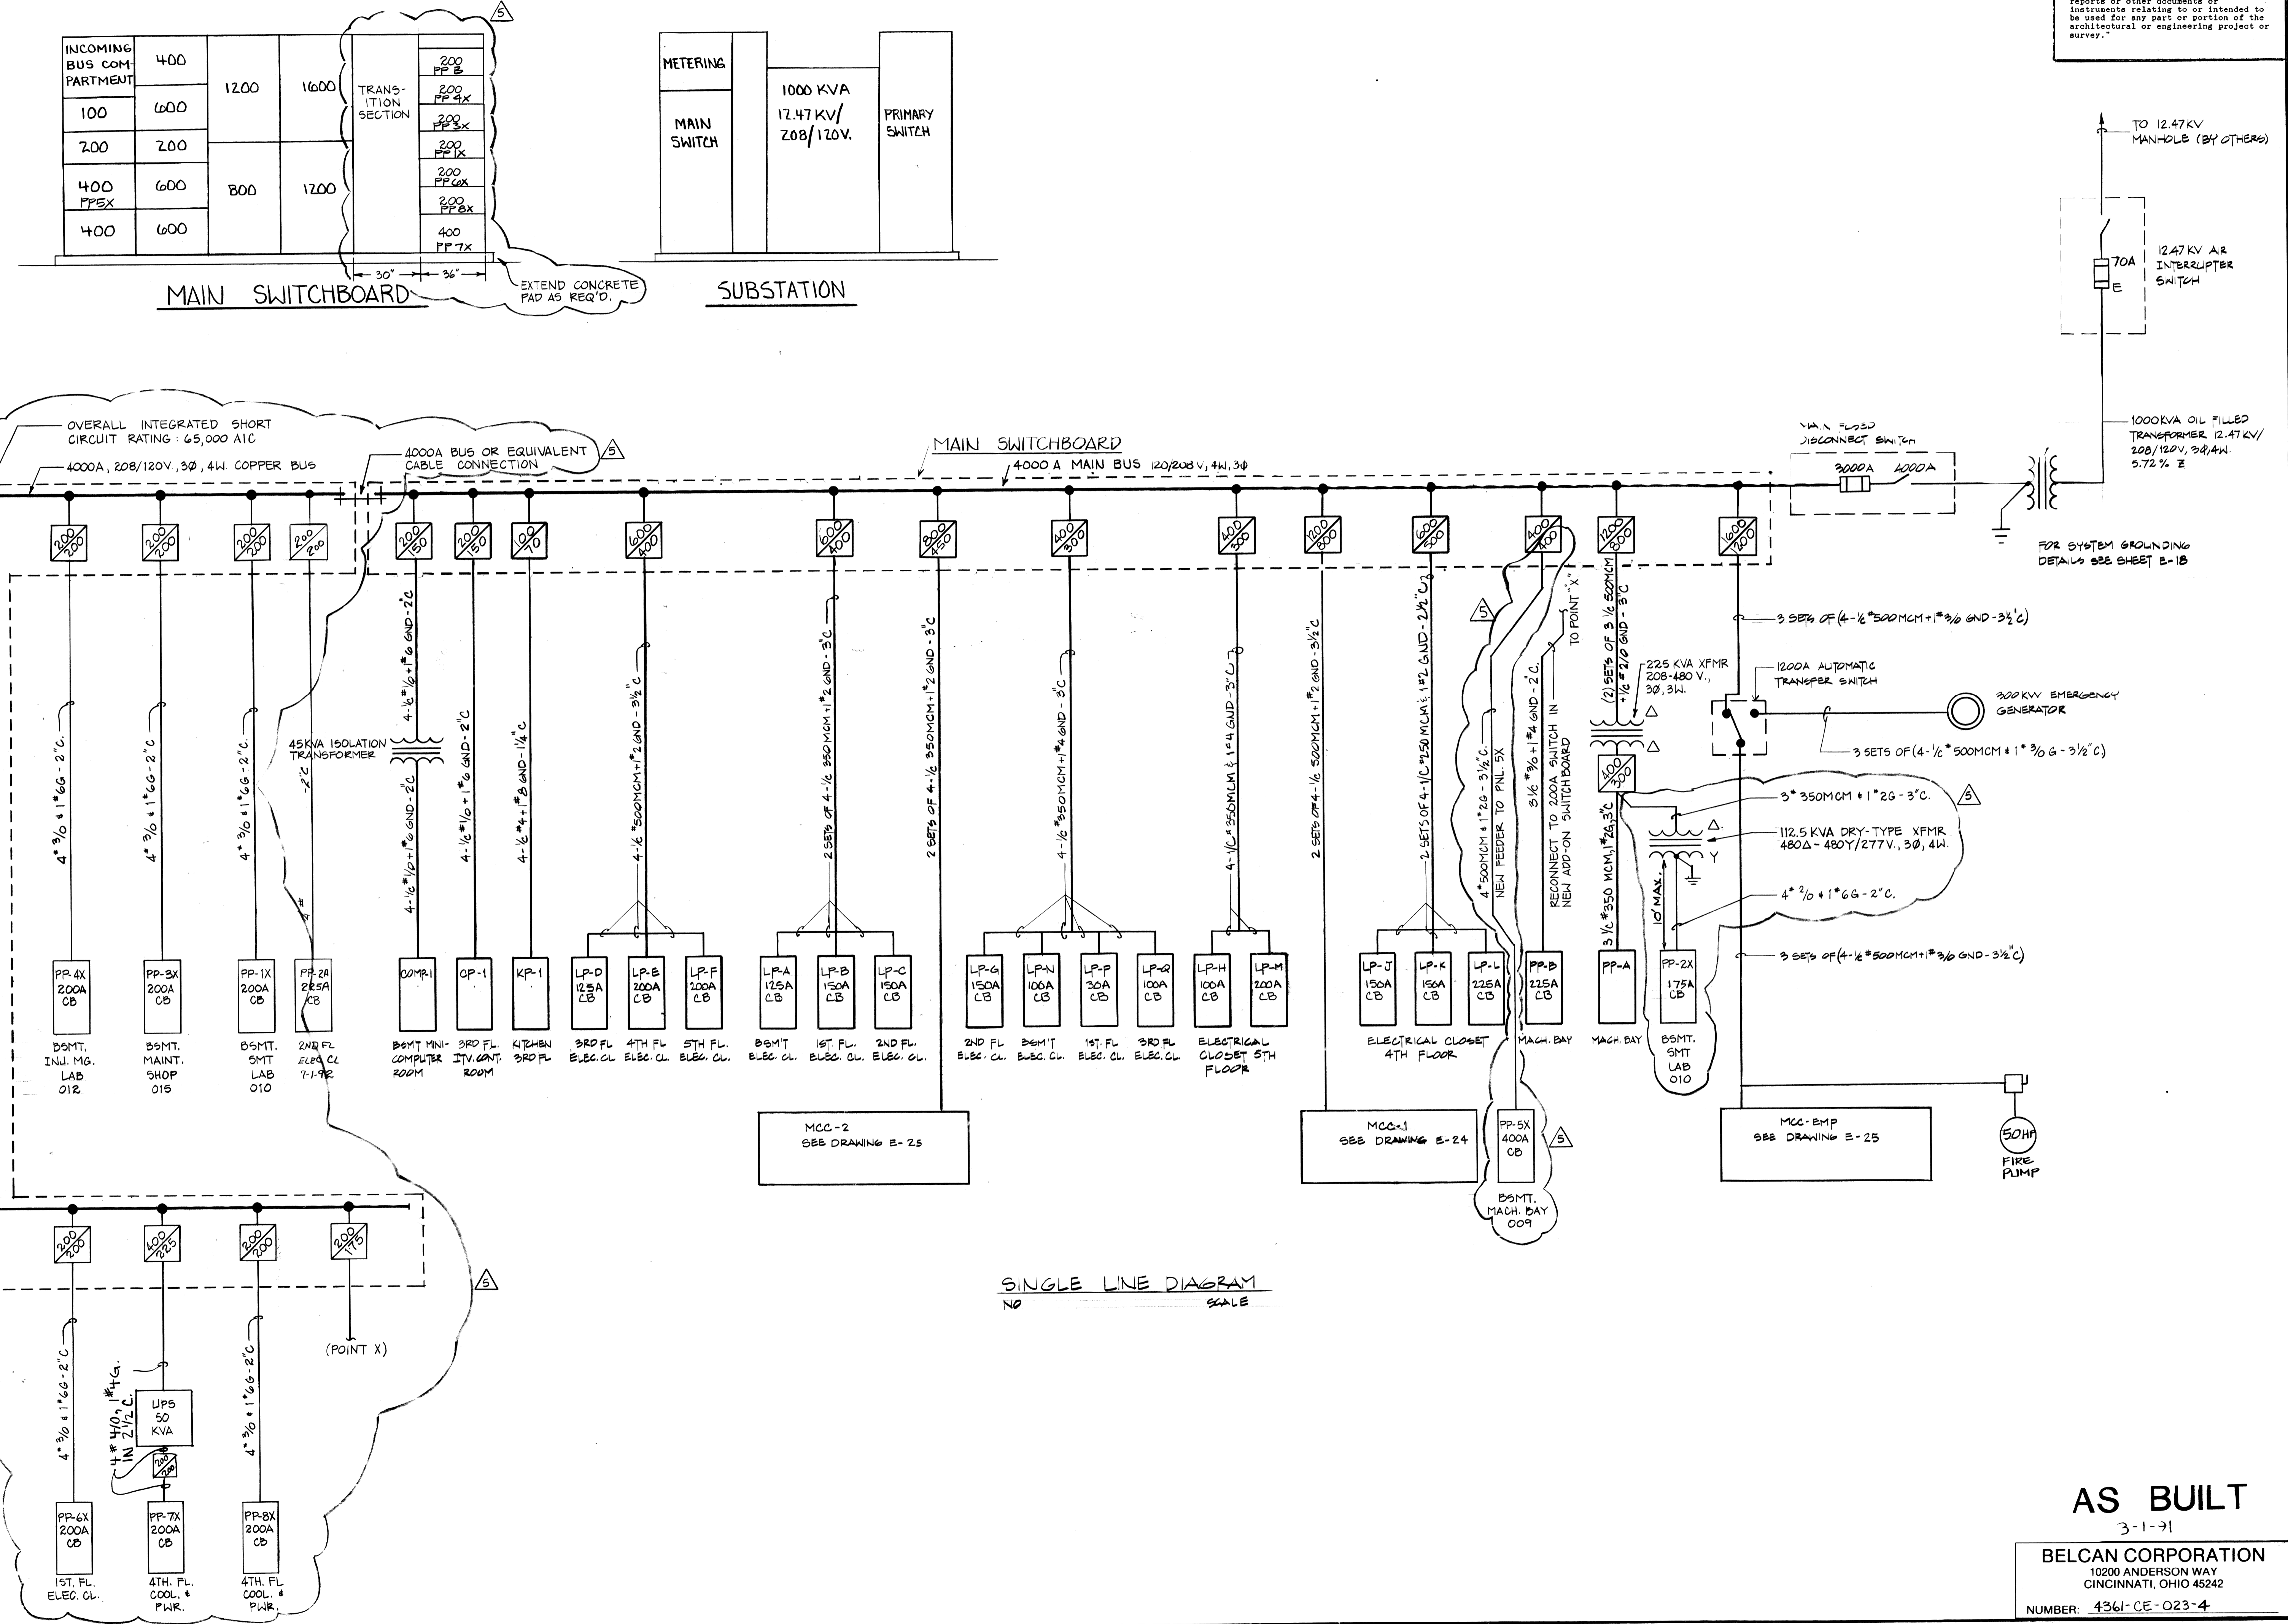

"This seal and signature apply only to the unaltered document to which they are affixed. I expressly disclaim any responsibility for any and all changes made after the issue date, for other plans, specifications, estimates, reports or other documents or instruments relating to or intended to be used for any part or portion of the architectural or engineering project or survey."




SECTION A	SECTION B	SECTION C	SECTION D	SECTION E	SECTION F
MAIN SWITCH 1200	AH-2 20 HP SIZE 3	AH-5 20 HP SIZE 3	AH-7 7 1/2 HP SIZE 1	EF-1 2 HP SIZE 1	SPACE SIZE 3
	RF-1 50 HP SIZE 5	AH-4 30 HP SIZE 4	SPARE SIZE 1	EF-3 2 HP SIZE 1	SPACE SIZE 1
		SPARE 200/ F/D SW	AH-6 20 HP SIZE 3	EF-4 1/2 HP SIZE 1	SPACE SIZE 2
	AH-3 25 HP SIZE 3		EF-6 1 HP SIZE 1	SPACE SIZE 3	

FRONT ELEVATION MCC-1

Unit Location	Circuit Designation (Name Plate Details)	Unit Type	NEMA Size	HP	C/B Trip Fuse Clip Size (inches)	Space	UNIT FEATURES
A-1	Main Disconnect Switch				1200		
B-1	AH-2	FVNR	3	20	100/400A		H-O-A
B-2	RF-1	FVNR	3	50	400/225A		H-O-A
C-1	AH-5	FVNR	3	20	100/100A		H-O-A
C-2	AH-4	FVNR	4	30	200/150A		H-O-A
C-3	SPARE	F-D			200/		
D-1	AH-7	FVNR	1	7.5	60/40A		H-O-A
D-2	SPARE	FVNR	1		60/		
D-3	AH-6	FVNR	3	20	100/100A		H-O-A
D-4	AH-3	FVNR	3	25	200/125A		H-O-A
E-1	EF-1	FVNR	1	2	30/15A		H-O-A
E-2	EF-3	FVNR	1	2	30/15A		H-O-A
E-3	EF-4	FVNR	1	1/2	30/10A		H-O-A
E-4	EF-6	FVNR	1	1	30/10A		H-O-A
E-5	SPARE	FVNR	3		200/		
F-1	Space						
F-2	Space						
F-3	Space						
F-4	Space						

MCC-1 SCHEDULE

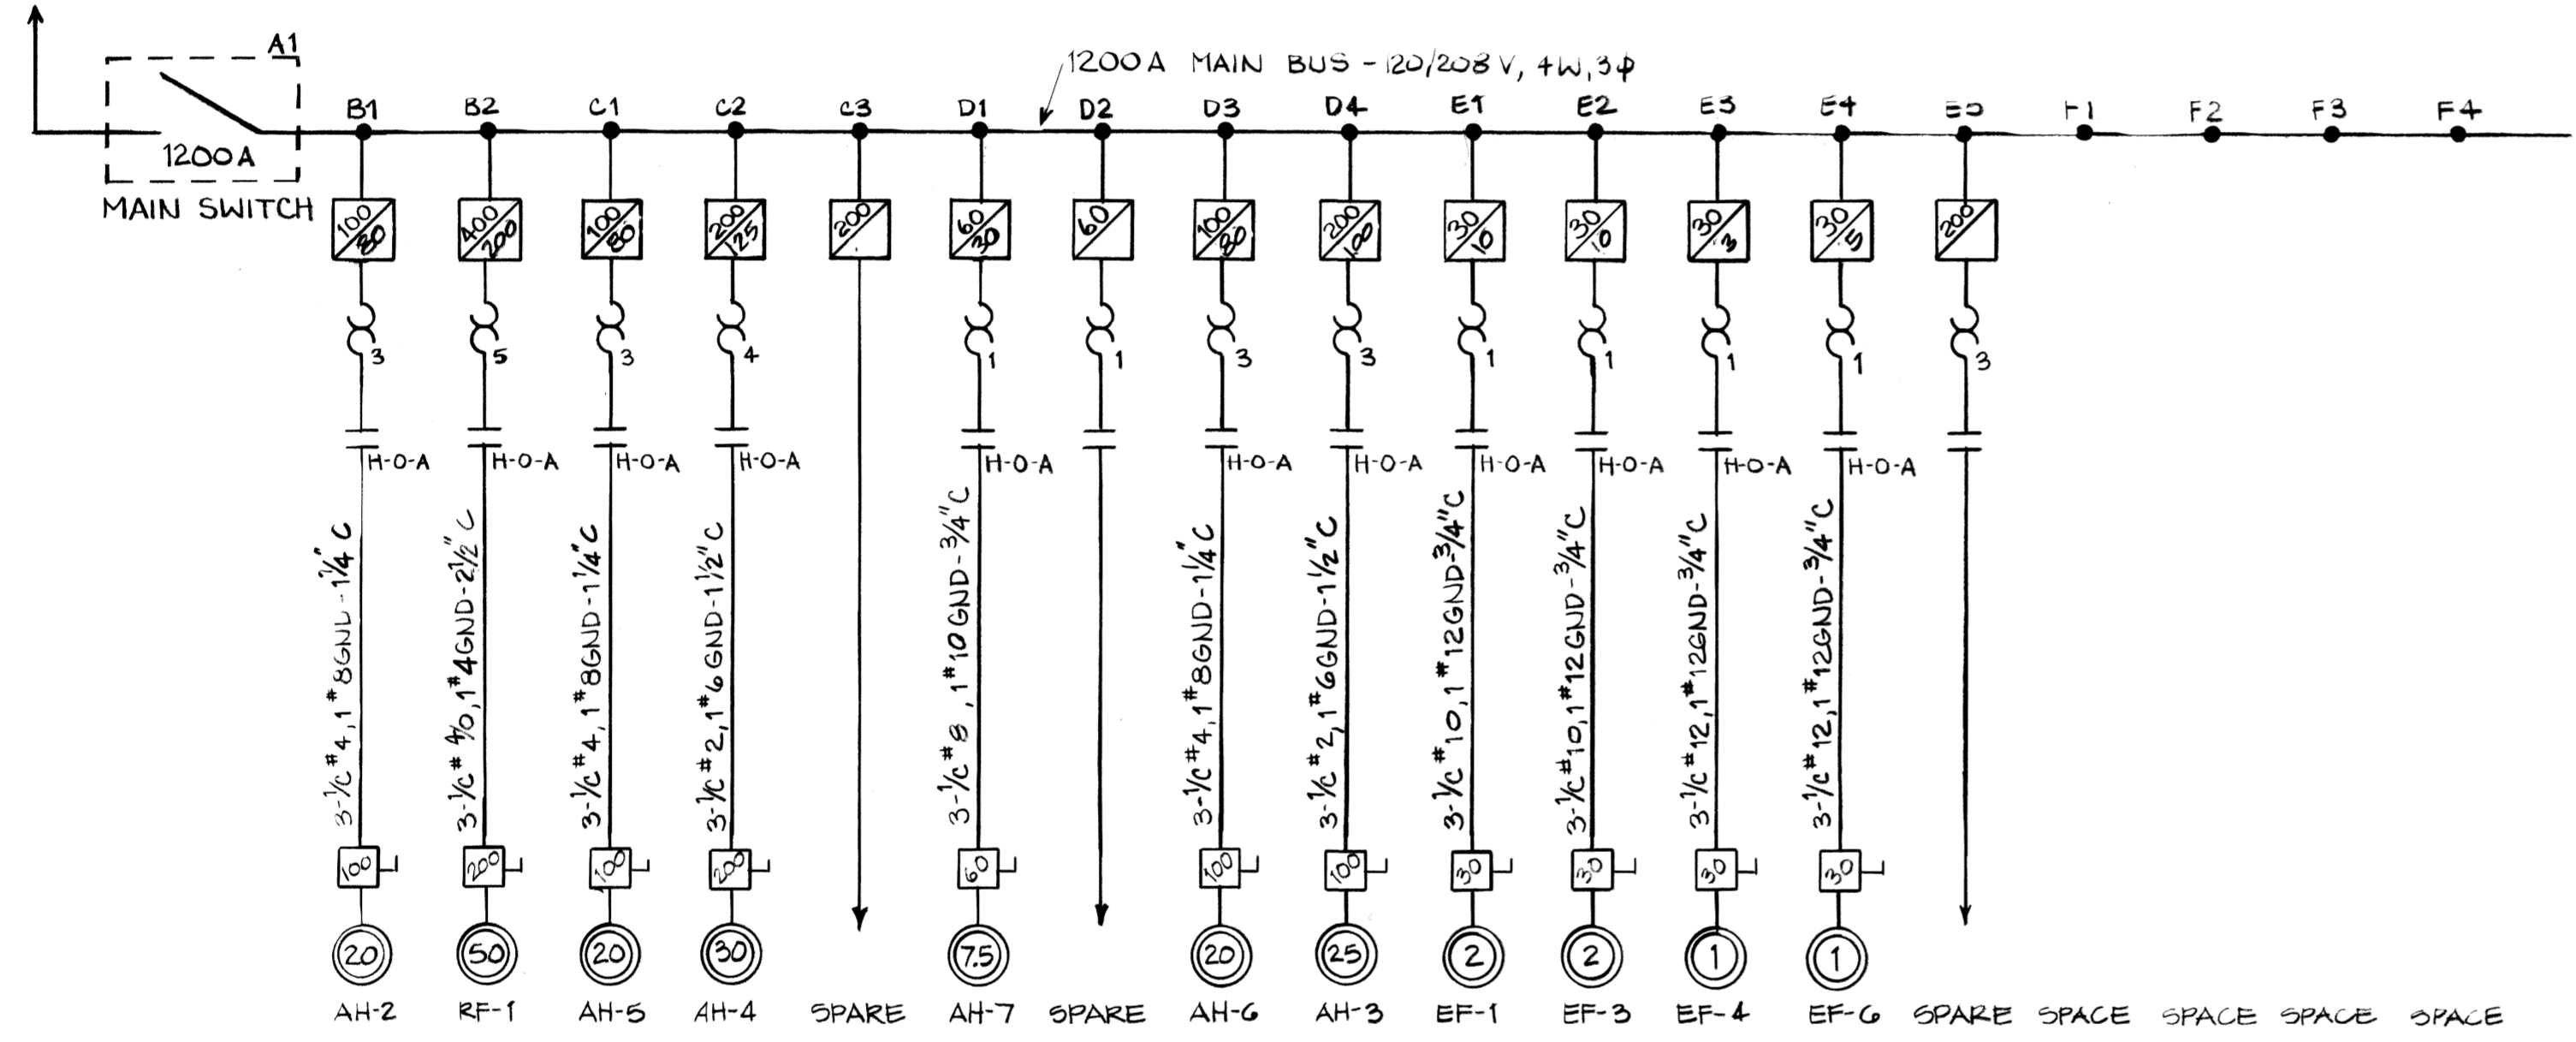

MCC-1 SINGLE LINE DIAGRAM

ROBOTICS FACILITY
LEXINGTON CAMPUS
UNIVERSITY OF KENTUCKY
LEXINGTON, KENTUCKY

University of Kentucky
Lexington, Kentucky
Approved by: *Wendy Bunn*
Director, design and construction division

MCC RISER & DIAGRAM
Sherman Carter Barnhart
PARTNERS IN ARCHITECTURE
1000 W. MAIN ST., SUITE 100, LEXINGTON, KY 40507 • 606-254-1351

JOB NO. 8706
DATE 9-30-87
DRAWN D. MEYER
CHECKED M. GOLDBERG


REVISIONS
3-30% REVIEW 10-16-87
4-GENERAL 7-18-88

AS BUILT
3-1--1

BELCAN CORPORATION
10200 ANDERSON WAY
CINCINNATI, OHIO 45242
NUMBER: 4361-CE-024-4

SHEET
E-24
83

This seal and signature apply only to the unaltered document to which they are affixed. I expressly disclaim any responsibility for any and all changes made after the issue date. For other plans, specifications, estimates, reports or other documents or instruments relating to or intended to be used for any part or portion of the architectural or engineering project or survey.

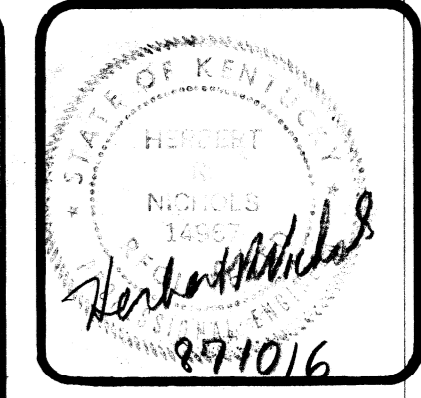

SECTION A	SECTION B	SECTION C	SECTION D	SECTION E
MAIN SWITCH 800/450	AH-1 10 HP SIZE 2 ₁	SCP-1 3 HP SIZE 1 ₁	ADRY-1 3 KW 30A F/SW	DHWP-1 2 HP SIZE 1 ₁
	SPARE SIZE 1 ₂	SCP-2 3 HP SIZE 1 ₂	DWP-1 5 HP SIZE 1 ₂	DHWRP-1 3/4 HP SIZE 1 ₂
	SPACE SIZE 3	SPARE SIZE 1 ₃	DWP-2 5 HP SIZE 1 ₃	EF-2 5 HP SIZE 1 ₃
	ACOMP-1 30 HP SIZE 4	HHWP-1 20 HP SIZE 3	SPARE SIZE 1 ₄	HVU-1 3 HP SIZE 1 ₄
		HHWP-2 20 HP SIZE 3	SPARE SIZE 1 ₅	SPACE SIZE 1 ₅

FRONT ELEVATION MCC-2

Unit Location	Circuit Designation (Name Plate Details)	Unit Type	NEMA Size	HP	C/B Trip Fuse Clip Size (Inches)	Space	UNIT FEATURES
A-1	Main Disconnect Switch				800		
B-1	AH-1	FVNR	2	10	60/50A		H-O-A
B-2	SPARE	FVNR	1		30		
B-3	SPACE						
B-4	ACOMP-1	F/D	3	30	200/150A		
C-1	SCP-1	F/D	3	30	30/20A		
C-2	SCP-2	F/D	3	30	30/20A		
C-3	SPARE	FVNR	1		30/		
C-4	HHWP-1	FVNR	3	20	100/100A		H-O-A
C-5	HHWP-2	FVNR	3	20	100/100A		H-O-A
D-1	ADRY-1	F/D	3KW	30/15A			Start-Stop
D-2	DWP-1	F/D	5	30/30A			Start-Stop
D-3	DWP-2	F/D	5	30/30A			Start-Stop
D-4	SPARE	FVNR	1		30/		
D-5	SPARE	FVNR	1		30/		
D-6	SPARE	FVNR	2		60/		
E-1	DHWP-1	FVNR	1	2	30/15A		Start-Stop
E-2	DHWRP-1	FVNR	1	3/4	30/4A		Start-Stop
E-3	EF-2	FVNR	1	5	30/30A		H-O-A
E-4	HVU-1	FVNR	1	3	30/15A		H-O-A
E-5	MONORAIL	F/D	3/4	30/15A			
E-6	MONORAIL HOIST	F/D	3	30/20A			


MCC-2 SCHEDULE

SECTION A	SECTION B	SECTION C	SECTION D
PASSENGER ELEVATORS	SPARE	PANEL BOARD 30-20A-1P	ACOMP-2 F/D 30/25A
F/D 400/400	FREIGHT ELEV. F/D 200/125A	TYPE NQOB EM-1	ADRY-2 F/D 30/15A
ANDERSON HALL F/D 100/60A	SPARE SIZE 1	SF-1 1HP SIZE 1 ₂	SPARE SIZE 2
JP-1 5 HP F/D 30/30A	SF-2 1/2 HP SIZE 1 ₃	EF-5 1HP SIZE 1 ₃	SPARE SIZE 1
BLANK	SPARE SIZE 1	EF-4 1/2 HP SIZE 1 ₄	SPARE SIZE 2
		BLANK	


FRONT ELEVATION MCC-EMP

Unit Location	Circuit Designation (Name Plate Details)	Unit Type	NEMA Size	HP	C/B Trip Fuse Clip Size (Inches)	Space	UNIT FEATURES
A-1	PASSENGER ELEVATORS	F/D		3-30	400/400A		
A-2	Anderson Hall Emerg.	F/D		18KW	100/60A		
A-3	Jockey Pump JP-1	F/D		5	30/30A		
B-1	SPARE	F/D		30	200/		
B-2	Freight Elev.	F/D		25	200/125A		
B-3	SF-2	FVNR	1	1	30/10A		
B-4	EF-4	FVNR	1	1	30/10A		
C-1	Emergency Panelboard EM-1						100A-3P Main C/B
C-2	SF-1	FVNR	1	1	30/10A		H-O-A
C-3	EF-5	FVNR	1	1	30/10A		H-O-A
C-4	SPARE	FVNR	1		30/		H-O-A
D-1	ACOMP-2	F/D		5	30/30A		
D-2	ADRY-2	F/D		1KW	30/15A		
D-3	SPARE	FVNR	1		30/		
D-4	SPARE	FVNR	2		60/		
D-5	SPARE	FVNR	1		30/		
D-6	SPARE	FVNR	2		60/		

MCC-EMP SCHEDULE

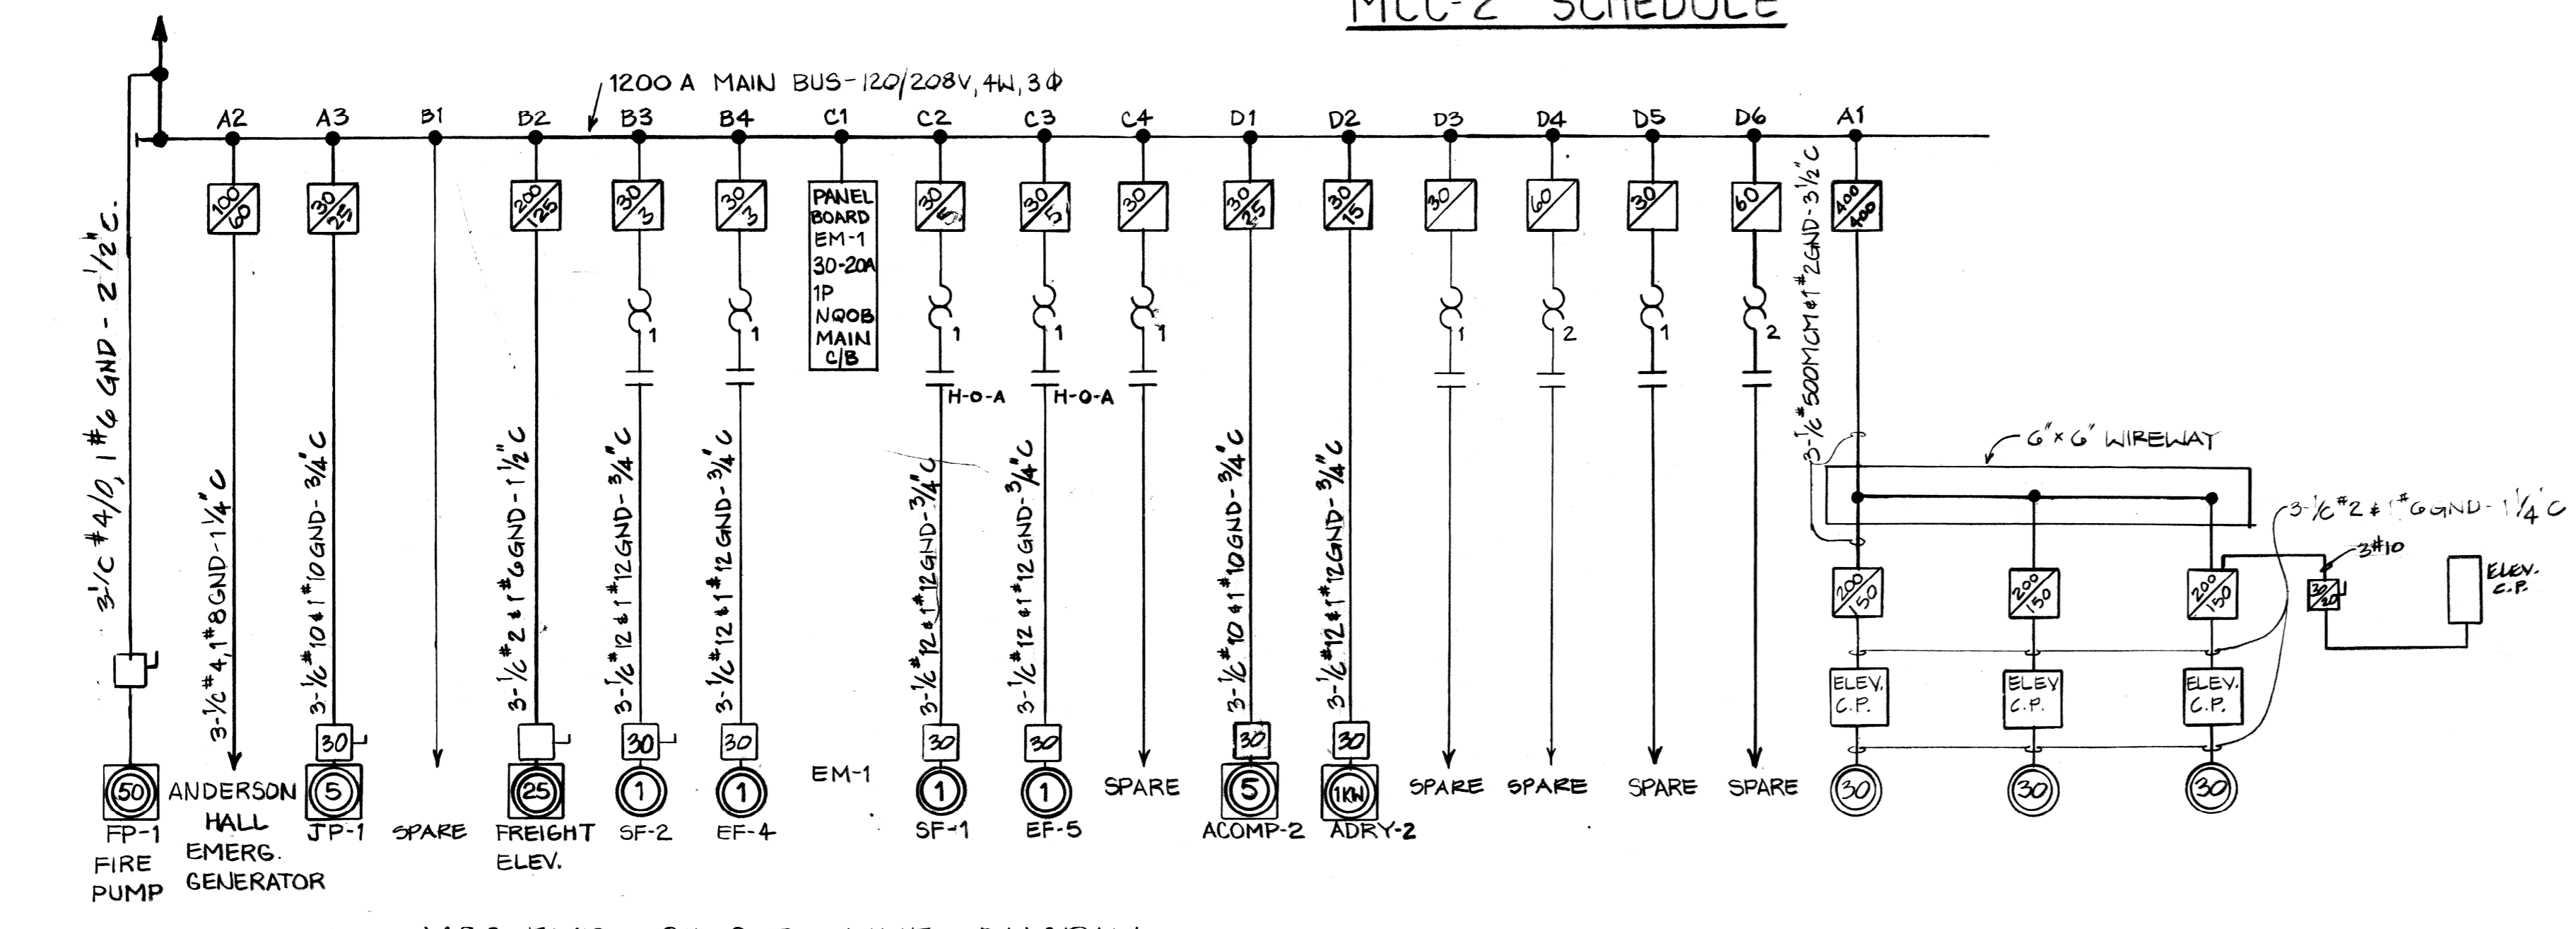

MCC-EMP SINGLE LINE DIAGRAM

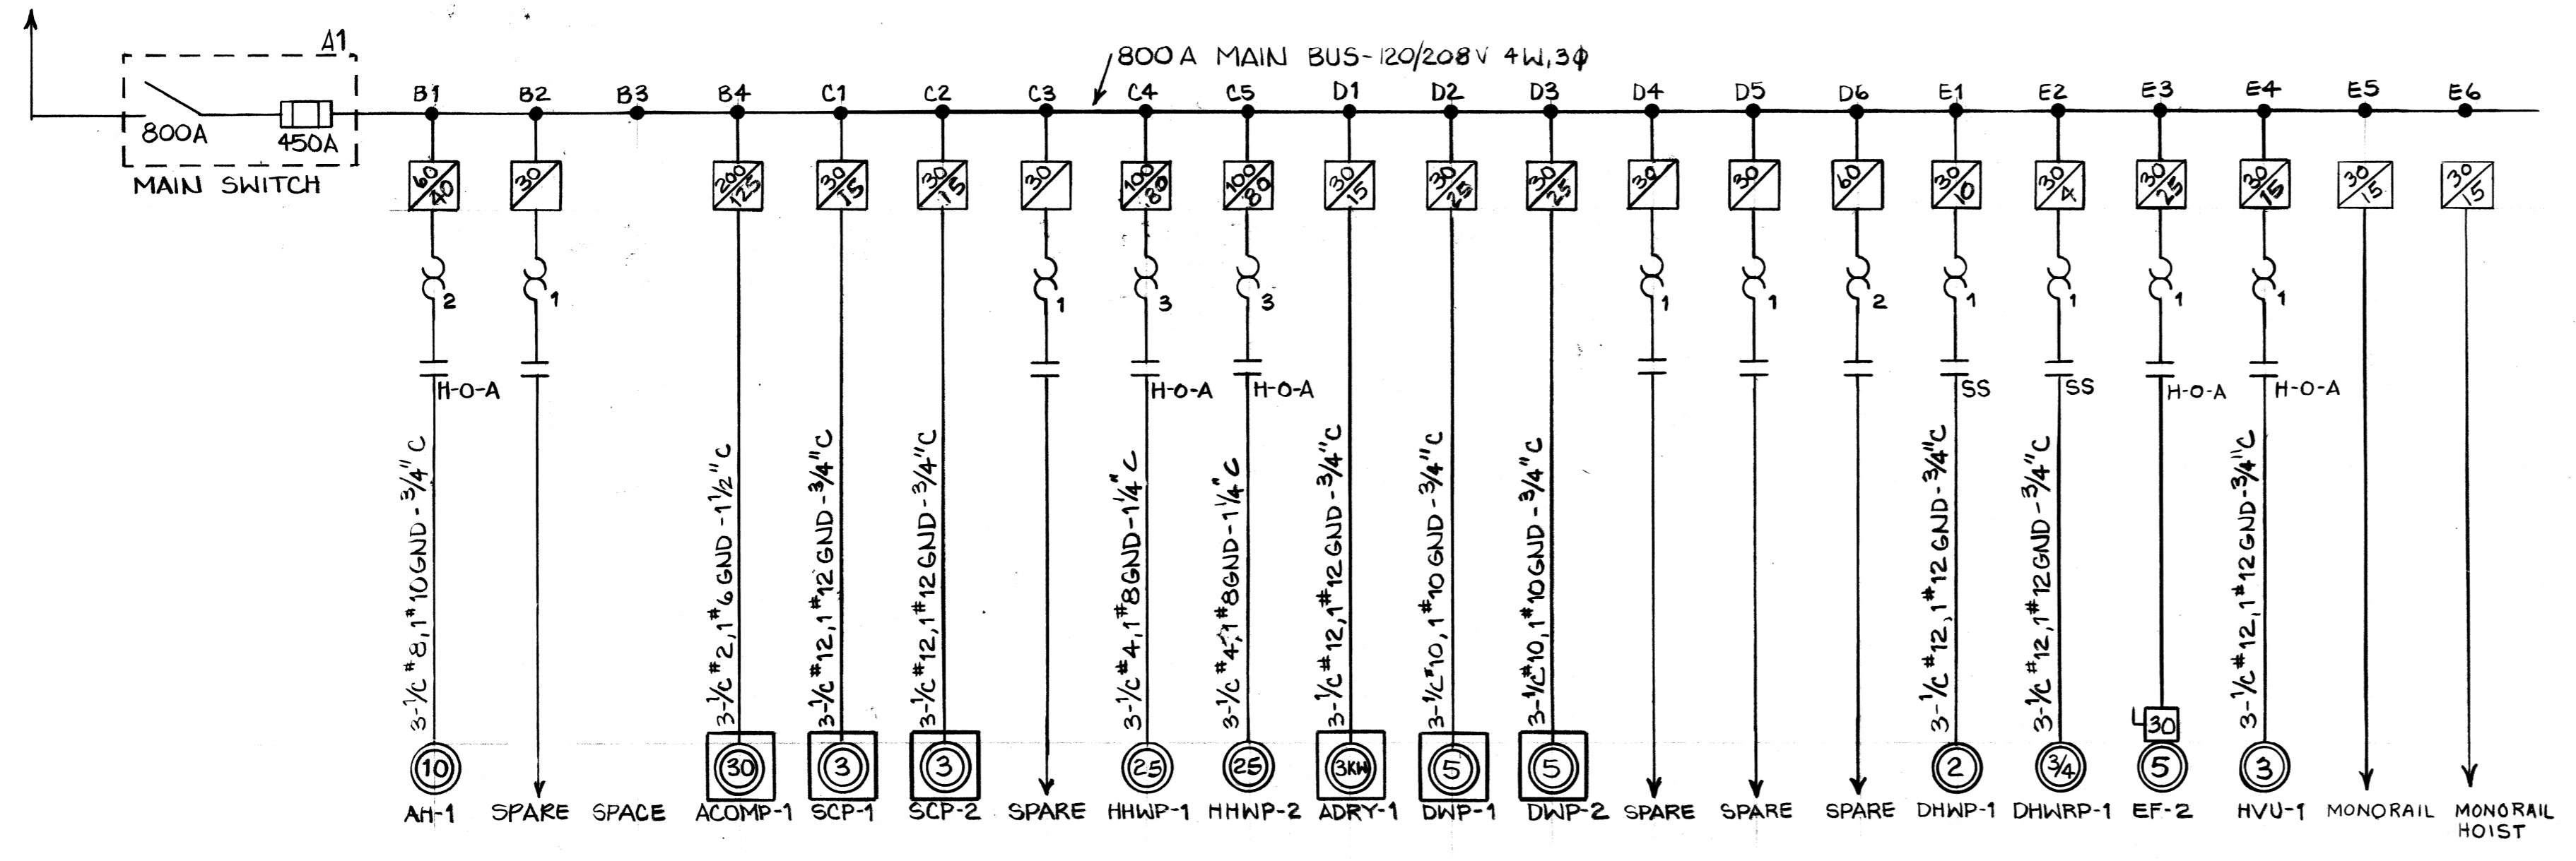

MCC-2 SINGLE LINE DIAGRAM

- SYMBOLS:**
- FUSED DISCONNECT SWITCH
 - STARTER-NUMBER INDICATES STARTER SIZE
 - CONTACT IN STARTER
 - H-O-A = TYPE OF CONTROL

ROBOTICS FACILITY
LEXINGTON CAMPUS
UNIVERSITY OF KENTUCKY
LEXINGTON, KENTUCKY

University of Kentucky
Lexington, Kentucky
Approved by: *Debra J. Bunn*
DIRECTOR, DESIGN AND CONSTRUCTION SERVICES
10-19-87

MCC RISERS & DIAGRAMS
Sherman Carter Barnhart
PARTNERS IN ARCHITECTURE
SUITE 1900 • 750 WEST MAIN STREET • LEXINGTON, KY 40507 • 502/254-1351

JOB NO. 8706
DATE 9-30-87
DRAWN D. MEYER
CHECKED M. GOLDBERG
BY FILE NO. 431.0

REVISIONS
3-93% REVIEW 10-16-87
4-GENERAL 7-18-88

AS BUILT
3-1-91

BELCAN CORPORATION
10200 ANDERSON WAY
CINCINNATI, OHIO 45242
NUMBER: 4361-CE-025-4

SHEET
E-25
Cub.# Star Document# 044991 B-2

LP-A PANELBOARD SCHEDULE BASEMENT											
LOAD DESCRIPTION	CKT. NO.	CKT. BKR.	CONNECTED KVA						CKT. NO.	LOAD DESCRIPTION	
			A	B	C	A	B	C			
LGTS RMS 209, B10, B11, B12	1	20	.85			1.5		20	2	RECEPTS RMS 805, 806	
LGTS RM 808 (WEST)	3	20	.7			.7		20	4	RECEPTS RMS 803, 804	
LGTS RM 808 (EAST)	5	20		1.1			.8	20	6	COMPUTER OFFICE	
LGTS RMS B13, B14	7	20	1.1			.8		20	8	STORAGE	
LGTS RM B17 (WEST)	9	20		1.0			.8	20	10	RECEPTS ROOM B20	
LGTS ROOM B18	11	20			1.0		.9	20	12	RECEPTS RMS B22, B23, B25	
LGTS ROOM B18	13	20	1.0			3.6		20	14	RECEPTS RM B11	
LGTS ROOM B02	15	20		1.2			.5	20	16	BELL CIRCUIT	
LGTS RMS 803, 804, 805, 806	17	20			1.7		.5	20	18	CLOCK CIRCUIT	
LGTS RMS B20 B22 - B25	19	20	1.1			.2		20	20	RECEPTS ROOM B01	
LGTS & RECEPTS ELEV. PITS	21	20		1.3			.2	20	22	RECEPTS CORRIDOR RM 808	
LAB ROOM B17 (EAST)	23	20			1.6		.2	20	24	RECEPTS CORRIDOR RM 808	
SPARE	25	20				.15		20	26	30KW GEN ROOM	
RECEPTS ROOM B18 (EAST)	27	20		1.5			.4	20	28	RECEPTS ROOM B11	
COMMUNICATION RM REC	29	20				.36		20	30	SPARE	
SPARE	31	20						20	32		
	33	20						20	34		
	35	20						20	36		
	37	20						20	38		
	39	20						20	40		
	41	20						20	42		
Φ KW TOTALS			10.3	8.9	7.8						

VOLTAGE: 120/208 VAC, 3Φ, 4W
 MAIN LUGS:
 MAIN BREAKER 125A

TOTAL KW. CONNECTED: 27
 TOTAL KW. DEMAND: 27
 76A

FEEDER SIZE: SEE DWG. E-23
 FED FROM: MAIN SW. BD

LP-B PANELBOARD SCHEDULE FIRST FLOOR											
LOAD DESCRIPTION	CKT. NO.	CKT. BKR.	CONNECTED KVA						CKT. NO.	LOAD DESCRIPTION	
			A	B	C	A	B	C			
MACHINE BAY LTG B07	1	20	1.4			.72		20	2	2ND FLR SECTRY. RECEPT RM 236	
MACHINE BAY LTG B07	3	20		1.4			.72	20	4	BLDG. STORAGE RECEPT RM 108	
MACHINE BAY LTG B07	5	20			1.4		.2	20	6	RECEPT VENDING ROOM 111	
MACHINE BAY LTG B07	7	20	1.4			.2		20	8		
LGTS RMS 113, 116, 117	9	20			.8		.2	20	10		
SERVICE CONNECTOR (EXTERIOR)	11	20			1.2		.2	20	12		
CANOPY LTG	13	20		1.2			.2	20	14	WATER COOLER RM 111	
CANOPY LTG	15	20			1.2		.72	20	16	COMM. RM 117 RECEPTS	
STUDENT COMM. LTG. RM 114	17	20			1.6		.4	20	18	RECEPT ROOM 114	
STUD. COMM. LTG. RMS 111, 113, 119	20	20	1.0			.2		20	20	RECEPT ROOM 114	
LTG. ROOMS 109, 112	21	20			1.2		.72	20	22	RECEPT ROOM 109	
LTG. RECEPTION RM 109	23	20			1.6		.9	20	24	RECEPT ROOM 101	
LTG. RECEPTION RM 109	25	20	1.6			.7		20	26	RECEIVING AREA 104, 106 RECEPTS	
LTG. RECEPTION RM 101	27	20			1.6			20	28	SPARE	
LTG. ROOMS 101, 102	29	20			1.6		.72	20	30	COMM. ROOM 117 RECEPTS	
LTG. ROOMS 106, 107, 108	31	20	1.6			.2		20	32	STUD. COMM. RM 109 RECEPT	
LTG. ROOMS 103, 104, 105, 100	33	20			1.6		.2	20	34		
EXTERIOR STAIR LTG	35	20			1.5		.2	20	36		
CANOPY LIGHTING	37	20		.8		.36		20	38	COMMUNICATION RM REC	
SPARE	39	20						20	40	SPARE	
	41	20						20	42	SPARE	
Φ KW TOTALS			11.22	10.34	11.52						

VOLTAGE: 120/208 VAC, 3Φ, 4W
 MAIN LUGS:
 MAIN BREAKER 150A

TOTAL KW. CONNECTED: 93.1
 TOTAL KW. DEMAND: 93.1
 93A

FEEDER SIZE: SEE DWG E-23
 FED FROM: MAIN SW. BD.

LP-C PANELBOARD SCHEDULE SECOND FLOOR											
LOAD DESCRIPTION	CKT. NO.	CKT. BKR.	CONNECTED KVA						CKT. NO.	LOAD DESCRIPTION	
			A	B	C	A	B	C			
DIR. OFF. LTG. RMS 226, 227, 228	1	20	1.2			.4		20	2	COMMUNICATION RECEPT.	
LTG. RMS 230, 232, 233	3	20		1.6			.4	20	4	COMMUNICATION RECEPT.	
SECTRY. WAITING LTG. RM. 231	5	20			1.8		1.5	20	6	DIRECTOR RECEPTACLES	
LTG. ROOM 236	7	20	1.4			1.5		20	8	DIRECTOR RECEPTACLES	
DIR. & BUS. LTG. RMS 240, 241	9	20		1.2		1.5		20	10	DIRECTOR RECEPTACLES	
CONF. ENGR. OFF. LTG. RMS 242, 243	11	20			1.2		1.3	20	12	LIASON RECEPTACLES	
PROJ. ENGR. LTG. RMS 244, 245	13	20	1.2			.2		20	14	COPIER	
LTG. RM 234, 235, 237, 238	15	20		.9		1.5		20	16	DIRECTOR RECEPTACLES	
CORRIDOR LTG RM 207	17	20			.7		1.7	20	18	CONFERENCE RECEPT.	
CORRIDOR LTG RM 207	19	20	1.1			1.7		20	20	ENGINEER RECEPTACLES	
SEMINAR LTG RM 221	21	20		1.6		.72		20	22	COUNTER RECEPTACLES	
LTG. RMS 217, 218, 219, 220	23	20			1.3		.2	20	24	REFRIGERATOR	
VISITOR LTG RMS 213, 214, 215, 216	25	20	1.6			1.5		20	26	CONT. ED RECEPTACLES	
VISITOR LTG. RMS 208, 210, 211, 212	27	20		1.6		.25		20	28	PEDESTAL LIGHTING	
GRAPHICS WK. STA. LTG. RM 209	29	20			1.6		.36	20	30	COMMUNICATION RM REC	
GRAPHICS WK. STA. LTG. RM 209	31	20	1.6					20	32	SPARE	
GRAPHICS WK. STA. LTG. RM 209	33	20		1.6				20	34		
GRAPHICS WK. STA. LTG. RM 209	35	20			1.6			20	36		
TOILET LTG. RMS 202 THRU 206	37	20	.9					20	38		
ELECT. RM LTG. RMS 223, 224, 225	39	20		.8				20	40		
WEST CORRIDOR LTG	41	20			.4			20	42		
Φ KW TOTALS			14.3	13.47	13.3						

VOLTAGE: 120/208 VAC, 3Φ, 4W
 MAIN LUGS:
 MAIN BREAKER 150A

TOTAL KW. CONNECTED: 41.3
 TOTAL KW. DEMAND: 41.3
 116A

FEEDER SIZE: SEE DWG. E-23
 FED FROM: MAIN SW. BD.

This seal and signature apply only to the unaltered document to which they are affixed. I expressly disclaim any responsibility for any and all changes made after the issue date, for other plans, specifications, estimates, reports or other documents or instruments relating to or intended to be used for any part or portion of the architectural or engineering project or survey.



ROBOTICS FACILITY
 LEXINGTON CAMPUS
 UNIVERSITY OF KENTUCKY
 LEXINGTON, KENTUCKY

University of Kentucky
 Lexington, Kentucky

10.19.82
 DONALD SWANN
 Director, design and construction division

PANEL SCHEDULES

Sherman Carter Barnhart
 PARTNERS IN ARCHITECTURE

SUITE 1800 • 250 WEST MAIN STREET • LEXINGTON, KY 40507 • 806.254.1951

JOB NO. 8706
 DATE 9-30-87
 DRAWN D. MEYER
 CHECKED M. GOLDBERG
 IN FILE NO. 431.0

REVISIONS
 3-70% REVIEW 10-16-87
 4-GEN. REVISIONS 7-18-88
 5-RENOVATIONS 2-16-90

SHEET
 Document #
 064992
 83

LP-D PANELBOARD SCHEDULE THIRD FLOOR											
LOAD DESCRIPTION	CKT. NO.	CKT. BKR.	CONNECTED KVA						CKT. NO.	LOAD DESCRIPTION	
			A	B	C	A	B	C			
LTG. RMS 313, 314, 315, 316	1	20	1.2			.36		20	2	RECEPTS RM 315	
LTG. RMS 320, 321	3	20		1.2		1.7		20	4	RECEPTS RMS 320, 321 RESEARCH	
LTG. RMS 322, 323	5	20			1.2		1.8	20	6	RESEARCH RECEPTS RMS 322, 323	
CORRIDOR LTG. RM 319	7	20	1.4			.2		20	8	W/INT. UHS RECEPT RM 313	
LTG. RM 317, 318	9	20		1.8				20	10	SPARE	
CORRIDOR LIGHTING RM 307	11	20			.7		1.1	20	12	ELECT. WTR. CLR. RECEPT RM 303	
CORRIDOR LIGHTING RM 307	13	20	1.1			.2		20	14	CORRIDOR RECEPT NEAR 317	
LTG. RMS 302-306, 327	15	20		1.3		.5		20	16	BELL CIRCUIT	
BALCONY LIGHTING	17	20			.85		.5	20	18	CLOCK CIRCUIT	
COMMUNICATION RM REC	19	20			.2			20	20	CORRIDOR RECEPT NEAR RM 318	
SPARE	21	20				.2		20	22	CORRIDOR RECEPT NEAR RM 315	
PERSONAL COMP. RM 325 LTG	23	20				.36		20	24	RECEPT ROOM 313	
PERSONAL COMP. RM 325 LTG	25	20	1.1			.2		20	26	ROLL FILTER F-4 ROOM 313	
FACULTY LMG. LTG. RM 316	27	20		1.1		.36		20	28	COMM. ROOM RECEPT RM 315	
FACULTY LMG. LTG. RM 316	29	20			1.4		1.0	20	30	POWER POLE COL C-5	
FACULTY LMG. LTG. RM 316	31	20	1.4			1.0		20	32	POWER POLE COL C-5	
SPARE	33	20				.72		20	34	RECEPTS COL C-5	
	35	20				.54		20	36	RECEPTS COL D-2	
	37	20						20	38		
	39	20						20	40		
	41	20						20	42		
Φ KW TOTALS			7.36	8.16	7.91						

VOLTAGE: 120/208 VAC, 3Φ, 4W
 MAIN LUGS:
 MAIN BREAKER 125A

TOTAL KW. CONNECTED: 23.43
 TOTAL KW. DEMAND: 23.43
 67A

FEEDER SIZE: SEE DWG. E-23
 FED FROM: MAIN SW. BD.

LP-E PANELBOARD SCHEDULE FOURTH FLOOR											
LOAD DESCRIPTION	CKT. NO.	CKT. BKR.	CONNECTED KVA						CKT. NO.	LOAD DESCRIPTION	
			A	B	C	A	B	C			
ELECT. RM LTG. RMS 420, 421, 422	1	20	.6			1.6		20	2	VISITOR LTG. RMS 401, 410, 411, 413	
CORRIDOR LTG. RM 407	3	20		1.5		1.3		20	4	VISITOR RECEPTS RMS 418, 419	
CORRIDOR LTG. RM 407	5	20			1.1		1.6	20	6	VISITOR RECEPTS RMS 415, 417, 418	
LAB LIGHTING RM 425, 427	7	20	1.6			1.5		20	8	VISITOR RECEPTS RMS 410, 411, 413	
LAB LIGHTING RM 429, 431	9	20		1.6		1.5		20	10	VISITOR RECEPTS RMS 409, 410	
LAB LIGHTING RM 433, 434	11	20			1.6		1.1	20	12	ELECT. WTR. CLR. RECEPT. RM 403	
LAB LIGHTING RM 437, 438	13	20	1.6			.4		20	14	COMM. ROOM 422 RECEPT	
LAB LIGHTING RM 424, 426	15	20		1.6		.2		20	16	CORRIDOR RECEPT. RM 407	
LAB LIGHTING RM 428, 432	17	20			1.6		.6	20	18	CORRIDOR RECEPT. RM 430	
LAB LIGHTING RM 435, 436	19	20	1.6			.2		20	20	CORRIDOR RECEPT. RM 407	
CORRIDOR LTG. RM 430	21	20		1.7		.2		20	22	CORRIDOR RECEPT. RM 407	
LAB LTG. RM 440	23	20			1.2		.4	20	24	FAN ROOM 420 RECEPT.	
LAB LTG. RM 439	25	20	1.2					20	26	SPARE	
LAB LIGHTING RM 416	27	20		1.7		.4		20	28	COMM. ROOM 422 RECEPT.	
LAB LIGHTING RM 416	29	20			1.7		.36	20	30	RECEPTACLES COL D-2	
VISITOR LTG. RMS 415, 417, 418, 419	31	20	1.6			.36		20	32	COMMUNICATION RM REC	
LAB LIGHTING RM 412	33	20		1.7				20	34	SPARE	
LAB LIGHTING RM 412	35	20			1.7			20	36		
LAB LIGHTING RM 408	37	20	1.5					20	38		
LAB LIGHTING RM 408	39	20		1.5				20	40		
TOILET & RMS 402-406	41	20			.9			20	42		
Φ KW TOTALS			8.4	14.9	13.5						

VOLTAGE: 120/208 VAC, 3Φ, 4W
 MAIN LUGS:
 MAIN BREAKER 200A

TOTAL KW. CONNECTED: 41.8
 TOTAL KW. DEMAND: 41.8
 117A

FEEDER SIZE: SEE DWG E-23
 FED FROM: MAIN SW. BD.

LP-F PANELBOARD SCHEDULE FIFTH FLOOR											
LOAD DESCRIPTION	CKT. NO.	CKT. BKR.	CONNECTED KVA						CKT. NO.	LOAD DESCRIPTION	
			A	B	C	A	B	C			
ELECT. RMS 516, 517, 518 LTG	1	20	.6			1.0		20	2	LTG. RMS 531, 532	
CORRIDOR LTG. RM 507	3	20		1.1		1.4		20	4	PENTHOUSE LTG. RMS 600-603	
CORRIDOR LTG. RM 507	5	20			1.1		.9	20	6	PENTHOUSE RECEPTS RMS 600-603	
LAB TECH. LTG. RM 520	7	20	1.9			.4		20	8	COMM. RECEPTS RM 518	
LAB TECH. LTG. RM 520	9	20		1.9		1.1		20	10	LAB RECEPTACLES RM 520	
EXT. ENGR. LTG. RMS 522, 5											

COMP-1 PANELBOARD SCHEDULE BASEMENT										LP-P PANELBOARD SCHEDULE FIRST FLOOR										LP-Q PANELBOARD SCHEDULE THIRD FLOOR														
LOAD DESCRIPTION	CKT. N°	CKT. BKR	CONNECTED KVA						CKT. N°	CKT. BKR	LOAD DESCRIPTION	CKT. N°	CKT. BKR	CONNECTED KVA						CKT. N°	CKT. BKR	LOAD DESCRIPTION	CKT. N°	CKT. BKR	CONNECTED KVA									
			A	B	C	A	B	C						A	B	C	A	B	C						A	B	C	A	B	C				
SPARE	1	20							20	2	SPARE	1	20	1.4		.2				20	2	UH-1 ROOM #104	1	20	1.5			1.5				20	2	PERSONAL COMP. OUTLETS
	3	20							20	4				1.4		.2				20	4	UH-3 ROOM #115	3	20	1.5			1.5				20	4	PERSONAL COMP. OUTLETS
	5	20							20	6				1.4		.2				20	6	ROLL-FILTER(F2)RM115	5	20	1.5			1.5			1.5	20	6	ROOM #325
	7	20							20	8	SPARE	7	20							20	8	SPARE	7	20	1.5			1.5			1.5	20	8	ROOM #325
	9	20							20	10		9	20							20	10		9	20	1.5			1.5			1.5	20	10	ROOM #325
	11	20							20	12		11	20							20	12		11	20	1.5			1.5			1.5	20	12	ROOM #325
	13	20							20	14		13	20							20	14		13	20	1.5			1.5			1.5	20	14	ROOM #325
	15	20							20	16		15	20							20	16		15	20	1.5			1.5			1.5	20	16	ROOM #325
	17	20							20	18		17	20							20	18		17	20	1.5			1.5			1.5	20	18	ROOM #325
	19	20							20	20		19	20							20	20		19	20	1.5			1.5			1.5	20	20	ROOM #325
	21	20							20	22		21	20							20	22		21	20	1.5			1.5			1.5	20	22	ROOM #325
	23	20							20	24		23	20							20	24		23	20	1.5			1.5			1.5	20	24	ROOM #325
	25								20	26		25	20							20	26		25	20	1.5			1.5			1.5	20	26	ROOM #325
	27								20	28		27	20							20	28		27	20	1.5			1.5			1.5	20	28	ROOM #325
	29								20	30		29	20							20	30		29	20	1.5			1.5			1.5	20	30	ROOM #325
	31								20	32		31	20							20	32		31	20	1.5			1.5			1.5	20	32	ROOM #325
	33								20	34		33	20							20	34		33	20	1.5			1.5			1.5	20	34	ROOM #325
	35								20	36		35	20							20	36		35	20	1.5			1.5			1.5	20	36	ROOM #325
	37								20	38		37	20							20	38		37	20	1.5			1.5			1.5	20	38	ROOM #325
	39								20	40		39	20							20	40		39	20	1.5			1.5			1.5	20	40	ROOM #325
	41								20	42		41	20							20	42		41	20	1.5			1.5			1.5	20	42	ROOM #325
Φ KW TOTALS			1.3	1.3	1.3				Φ KW TOTALS			1.6	1.6	1.6				Φ KW TOTALS			21.0	21.0	21.4											
VOLTAGE: 120/208 VAC, 3Φ, 4W MAIN LUGS: 225 AMPS MAIN BREAKER/FUSE:			TOTAL KW. CONNECTED: 3.9 TOTAL KW. DEMAND: 2 5.6 AMPS			FEEDER SIZE: 4-1/2" * 1/2" * 1" G GND. FED FROM: MAIN SW. BOARD			VOLTAGE: 120/208 VAC, 3Φ, 4W MAIN LUGS: MAIN BREAKER 30 A			TOTAL KW. CONNECTED: 4.8 TOTAL KW. DEMAND: 2.5 7 AMPS			FEEDER SIZE: SEE DWG. * E-23 FED FROM: MAIN SW. BD.			VOLTAGE: 120/208 VAC, 3Φ, 4W MAIN LUGS: MAIN BREAKER 100 A			TOTAL KW. CONNECTED: 61.4 TOTAL KW. DEMAND: 31.0 87 AMPS			FEEDER SIZE: SEE DWG. * E-23 86.1 AMPS FED FROM: MAIN SW. BD.										

RELOCATE LAB RECEPT. RM.#010
TO NEW POWER PANEL PP-1X

"This seal and signature apply only to the unaltered document to which they are affixed. I expressly disclaim any responsibility for any and all changes made after the issue date. For other plans, specifications, estimates, reports or other documents or instruments relating to or intended to be used for any part or portion of the architectural or engineering project or survey."



ROBOTICS FACILITY
LEXINGTON CAMPUS
UNIVERSITY OF KENTUCKY
LEXINGTON, KENTUCKY

University of Kentucky
Lexington, Kentucky
Approved by: *W. B. Bunn*
Director, design and construction division

PANEL SCHEDULES
Sherman Carter Barnhart
PARTNERS IN ARCHITECTURE
SUITE 1800 • 250 WEST MAIN STREET • LEXINGTON, KY 40507 • 606-254-1351



JOB NO. 8706
DATE 9-30-87
DRAWN D. MEYER
CHECKED M. GOLDBERG
UK FILE NO 431.0

REVISIONS
3-90% REVIEW 10-6-87
4-GENERAL 7-18-88
5-RENOVATION 2-16-90

AS BUILT
3-1-31
BELCAN CORPORATION
10200 ANDERSON WAY
CINCINNATI, OHIO 45242
NUMBER: 4261-CE-028-4

SHEET
E-28
83

"This seal and signature apply only to the unaltered document to which they are affixed. I expressly disclaim any responsibility for any and all changes made after the issue date, for other plans, specifications, estimates, reports or other documents or instruments relating to or intended to be used for any part or portion of the architectural or engineering project or survey."

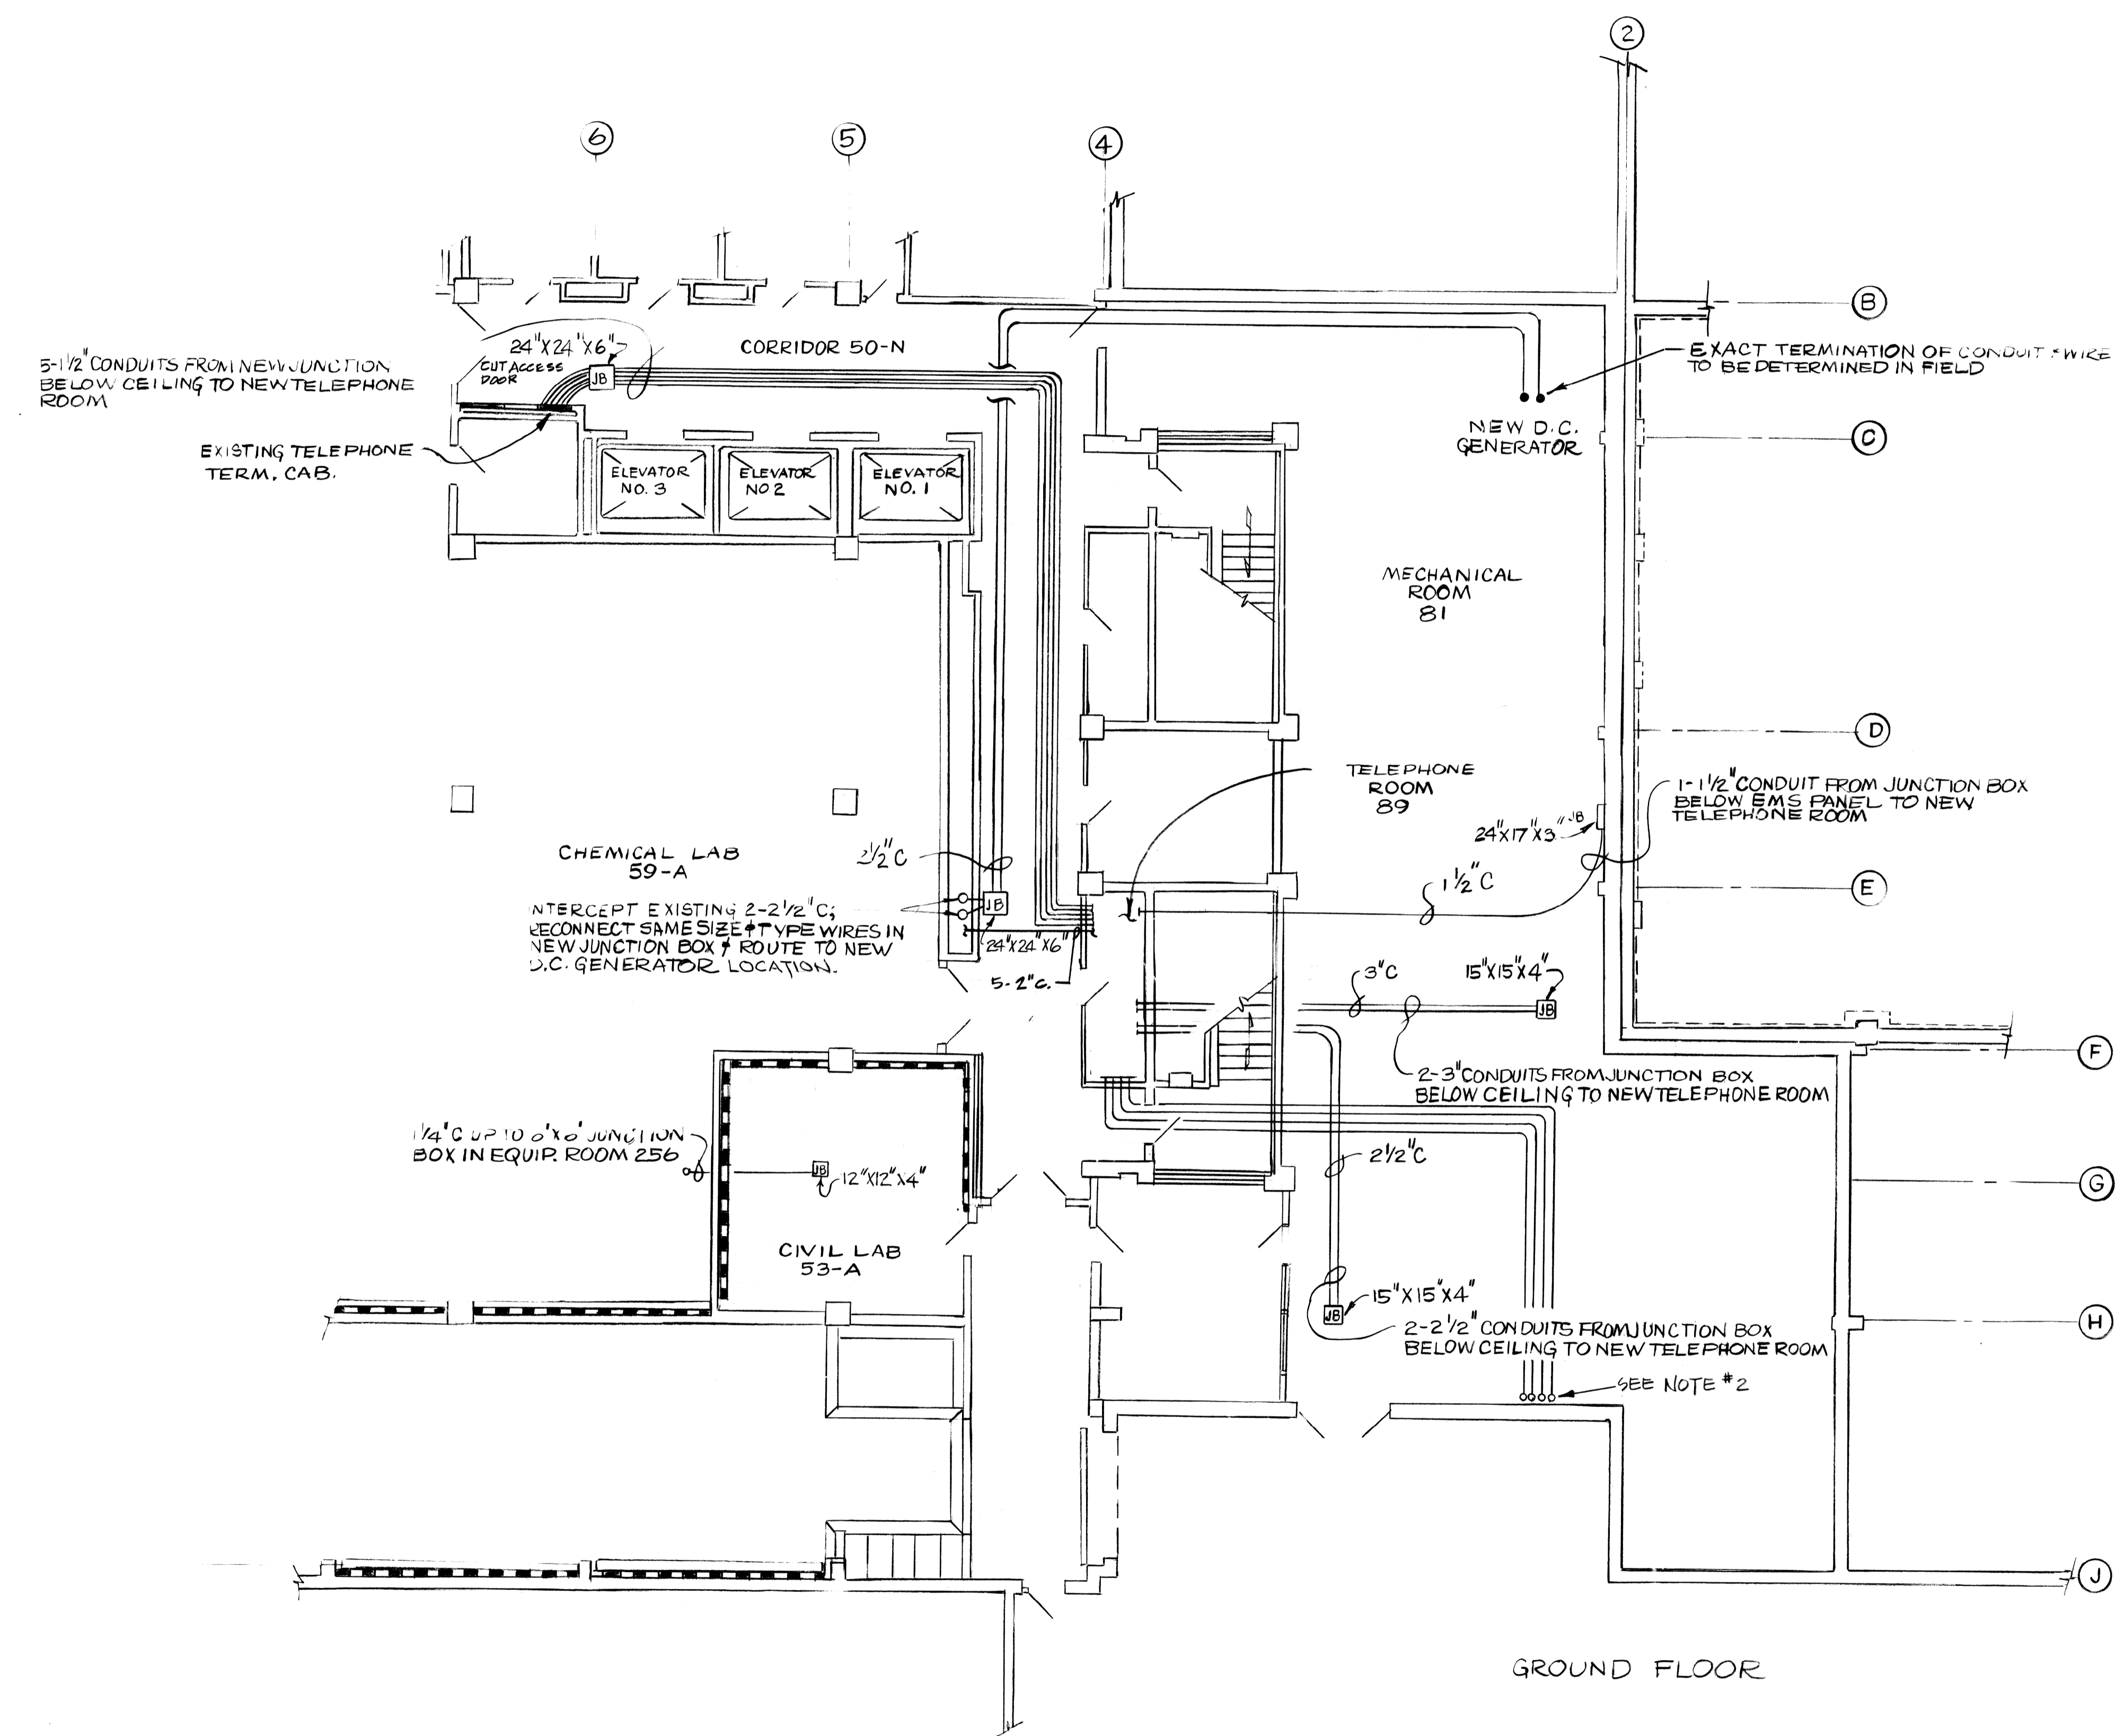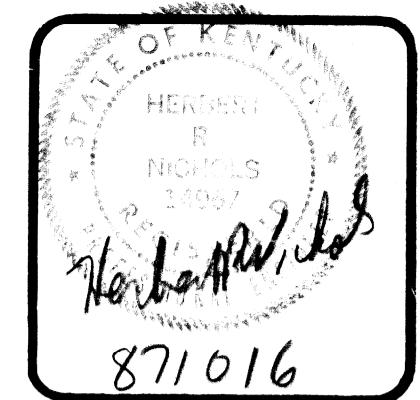

NOTE 1
 1. CONDUIT ROUTING & JUNCTION BOX LOCATIONS ARE DIAGRAMATIC. CONTRACTOR MUST INSPECT SITE TO CONFIRM EXACT LOCATIONS AND ROUTINGS.
 2. + 4" STUBBED UP UNDER DIVISION 2 WORK THIS CONTRACTOR TO EXTEND 4-4" TO NEW TELEPHONE ROOM #89.

AT THE REQUEST OF THE ELECTRICAL INSPECTOR IT IS NECESSARY TO ADD A DISCONNECT SWITCH AND A SAFETY GUARD TO THE D.C. GENERATOR SET.

- 1) 200AMP, 250V, 3 PHASE, INDOOR SAFETY SWITCH, RELOCATE THE CONTACTOR, RUN 2" CONDUIT BETWEEN THE TWO UNITS AND PULL 3/0 COPPER WIRE THROUGH CONDUIT AND RECONNECT.
- 2) FURNISH AND INSTALL AN EXPANDED METAL, REINFORCED GUARD, IN A HALF ROUND SHAPE OVER THE D.C. GENERATOR UNIT.


ROBOTICS FACILITY
 LEXINGTON CAMPUS
 UNIVERSITY OF KENTUCKY
 LEXINGTON, KENTUCKY

University of Kentucky
 Lexington, Kentucky
 APPROVED BY: *Wendy Swamy*
 DIRECTOR: CAMPUS AND CONSTRUCTION SERVICES

TELEPHONE RENOVATION
 ANDERSON HALL
Sterman Carter Barnhart
 PARTNERS IN ARCHITECTURE
 1000 W. MAIN STREET • LEXINGTON, KY 40507 • 606-254-1951

JOB NO. 8706
 DATE 9-30-87
 DRAWN H. BALDWIN
 CHECKED M. GOLDBERG
 SHEET NO. 431.0

REVISIONS
 3-90% REVIEW 10-16-87
 4-GENERAL 7-16-88

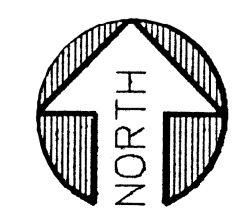

AS BUILT
 3-1-91

BELCAN CORPORATION
 10200 ANDERSON WAY
 CINCINNATI, OHIO 45242

NUMBER: 4361 CE-029-4

SHEET
E-29
 SHEET NO. B-2

