


- NOTES TO CONTRACTOR:
- CONTROL JOINTS IN CONCRETE SLAB SHALL BE PLACED AT A MAXIMUM SPACING OF 20'-0" IN EACH DIRECTION IN ADDITION TO THOSE NOTED ON PLANS (UNLESS NOTED OTHERWISE).
 - DATUM ELEVATION 975.65 FT. EQUALS ASSUMED ELEVATION 100'-0".
 - INTERIOR T.O. FTG. EL.=99'-4"(U.N.O.)
 - EXTERIOR T.O. FTG. EL.=98'-0"(U.N.O.)
 - SEE ARCH. FOR WALL DIMENSIONS NOT SHOWN ON PLAN.
 - ALL FOOTING EXCAVATIONS SHALL BE PERFORMED ACCORDING TO GEOTECHNICAL REPORT.

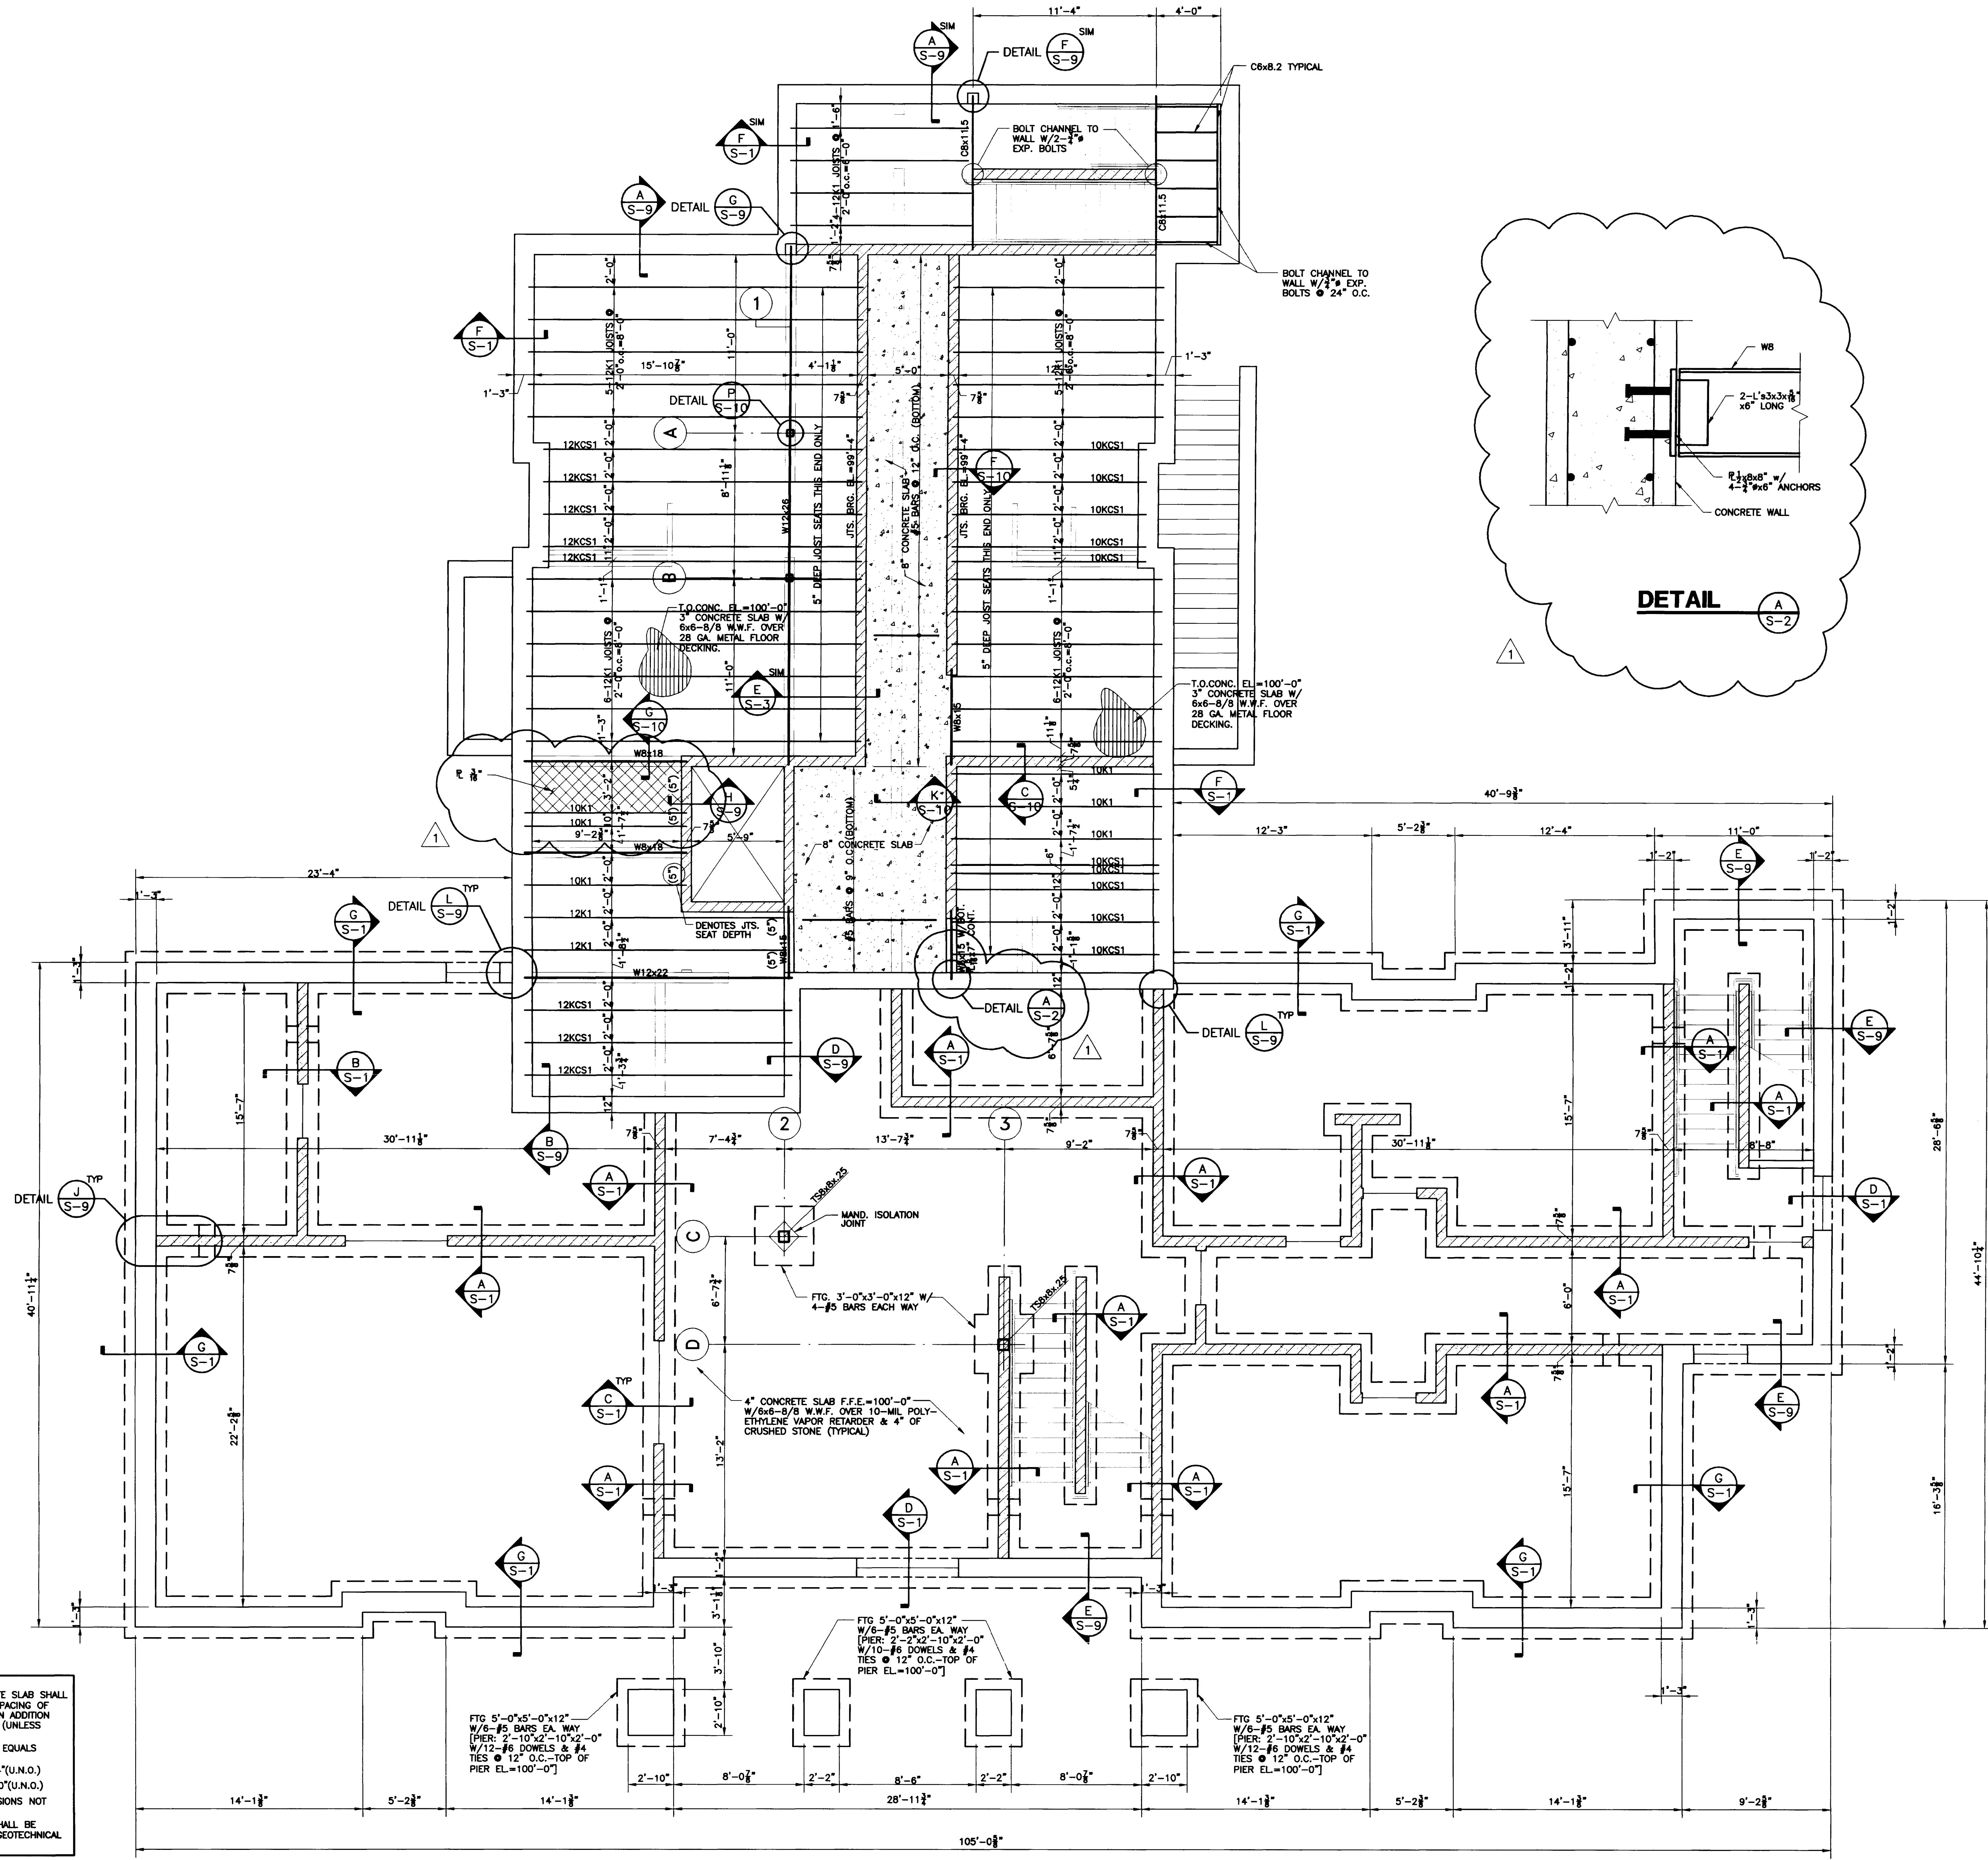

FIRST FLOOR FRAMING & PARTIAL FOUNDATION PLAN - BUILDING 0504

These Record Drawings have been prepared based on information provided by others. The Design Professional has not verified the accuracy and/or the completeness of this information and shall not be responsible for any errors or omissions which may be incorporated therein as a result.



Job No: OM14818 Date: Aug. 2000 Drawn By: BCT Revisions: 1 RECORD DRAWINGS 5-29-02

Omni Architects

Architecture, Architecture
Civil Engineering
Interior

212 North Upper St. Street
Lexington, Kentucky 40507
(606) 252-6664 Fax: (606) 253-2358

POAGE ENGINEERS & ASSOCIATES, INC.
LEXINGTON, KENTUCKY 40507
408 EAST UPPER ST. STREET
LEXINGTON, KENTUCKY 40507
TEL: 606-252-6664
FAX: 606-253-2358

