


**SECOND FLOOR FRAMING PLAN - BUILDING 0505**

(NOTE: ALL JOISTS THIS SHEET SHALL HAVE 5" DEEP BEARING SEATS U.N.O.) (JOISTS BEARING EL.=112'-0")

These Record Drawings have been prepared based on information provided by others. The Design Engineer and Architect shall not be responsible for any errors or omissions which may be incorporated herein as a result.


FRATERNITY HOUSE REPLACEMENT - PROJECT 1747.0 UNIVERSITY OF KENTUCKY LEXINGTON, KENTUCKY

SECOND FLOOR FRAMING PLAN - BUILDING 0505 Job No. Omni1419 Date: Aug - 2000 Drawn By: BCT Revisions: 1 RECORD DRAWINGS 5-28-02 Checked: csk

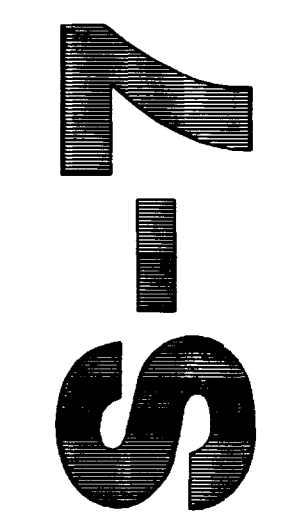


Z-c 9187

**Omni Architects**

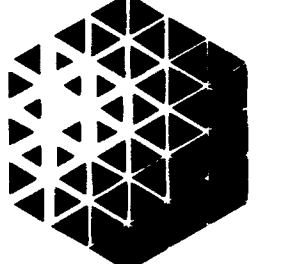

Architecture  
Architecture  
Civil Engineering  
Interiors  
212 North Upper Street  
Lexington, KY 40502  
(606) 252-6664 Fax: (606) 253-2358

**POAGE ENGINEERS & ASSOCIATES, INC.**  
448 EAST MAIN STREET  
LEXINGTON, KENTUCKY 40507  
PHONE: (606) 252-0004  
FAX: (606) 252-1000

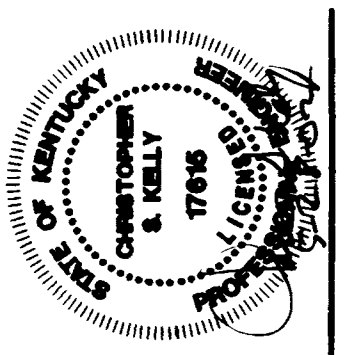

This Drawing and Design shown herein are the property of Omni Architects. The reproduction, copying or other use of this Drawing without the written consent of Omni Architects is prohibited.