


These Record Drawings have been prepared based on information provided by others. The Design Professional has not verified the accuracy and/or the completeness of this information and shall not be responsible for any errors or omissions which may be incorporated herein as a result.

TYPICAL FLOOR DECK ATTACHMENT

REINFORCING REQUIRED AT ALL CONCENTRATED LOADS

TYPICAL BEAM BRG. @ C.M.U. WALL
NOT TO SCALE

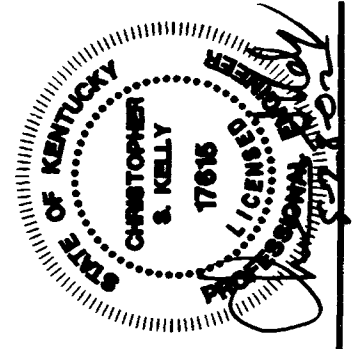

LEXINGTON, KENTUCKY

UNIVERSITY OF KENTUCKY

FRATERNITY HOUSE REPLACEMENT - PROJECT 1747.0

POAGE ENGINEERS & ASSOCIATES, INC.
448 EAST HIGH STREET
LEXINGTON, KENTUCKY 40502
PHONE: (606) 253-2358
FAX: (606) 253-2359

Checked: csk
Revisions: 1 RECORD DRAWINGS 5-28-02
Drawn By: BCT

Job No: Omnidrafts
Date: Aug. 2000

Architects
Landscape Architecture
Civil Engineering
Interiors
212 North Upper Street
Lexington, KY 40502
(606) 252-6664 Fax: (606) 253-2358

Omni Architects

SECTIONS AND DETAILS

S-10 20990