




TRUSS T-1

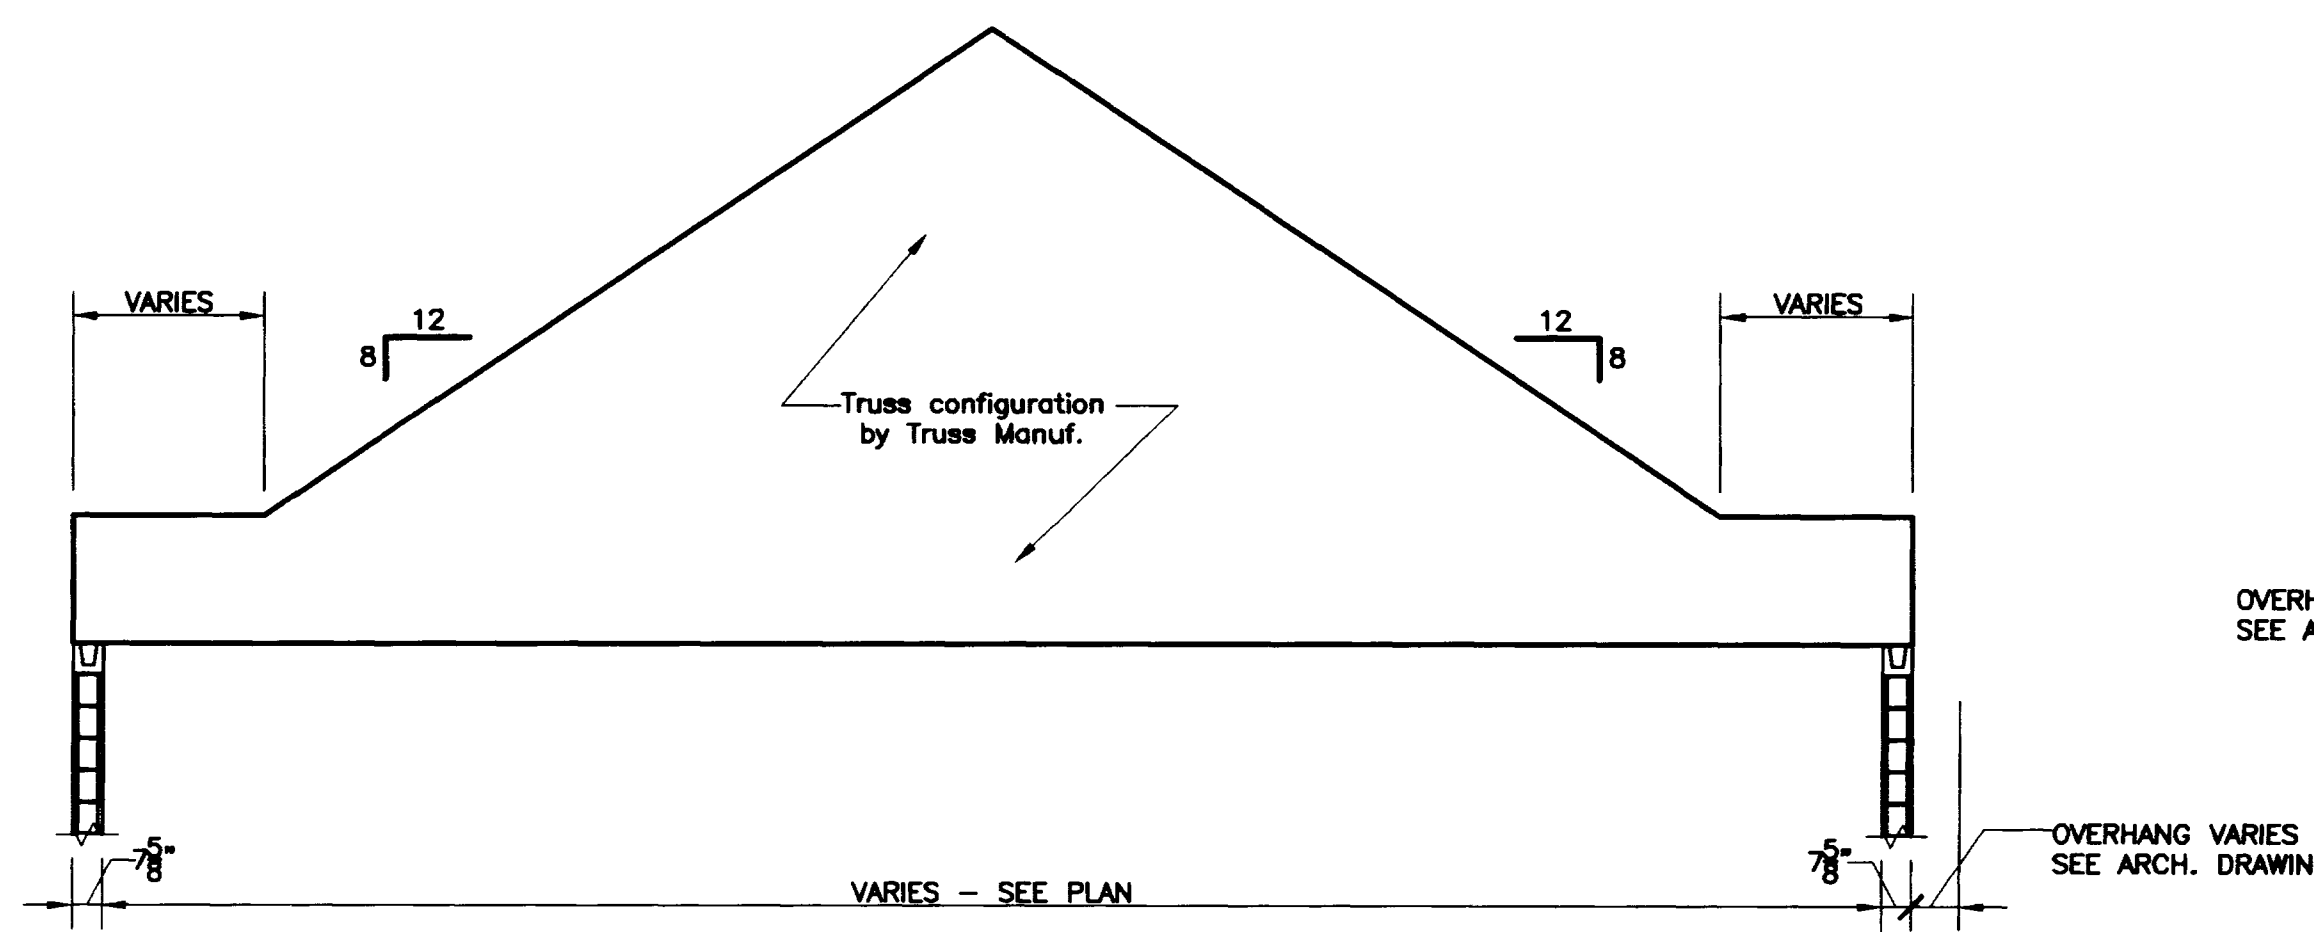


TRUSS T-5

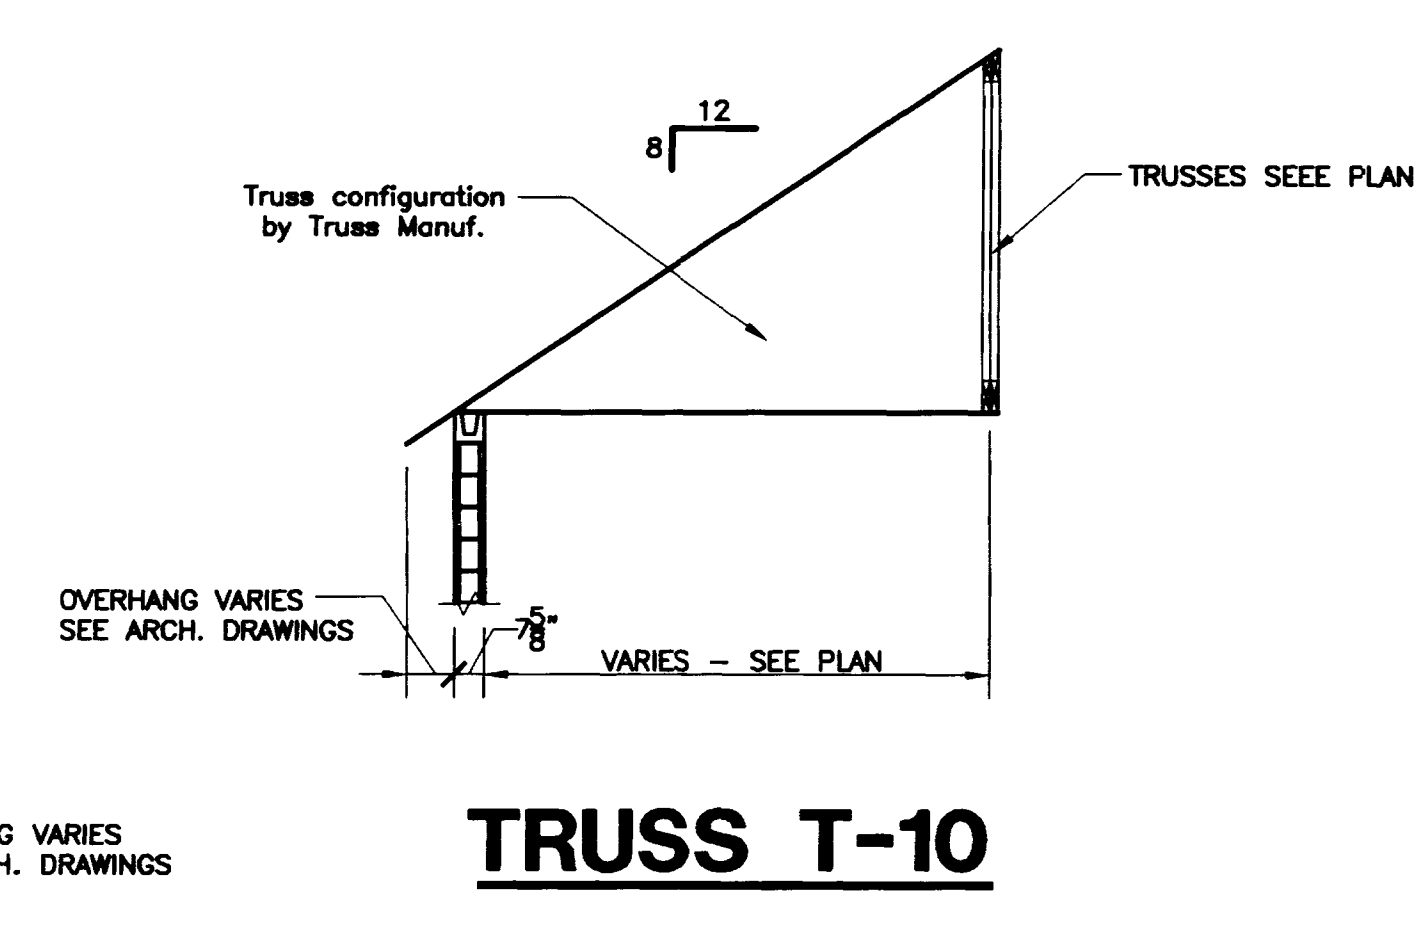


TRUSS T-10

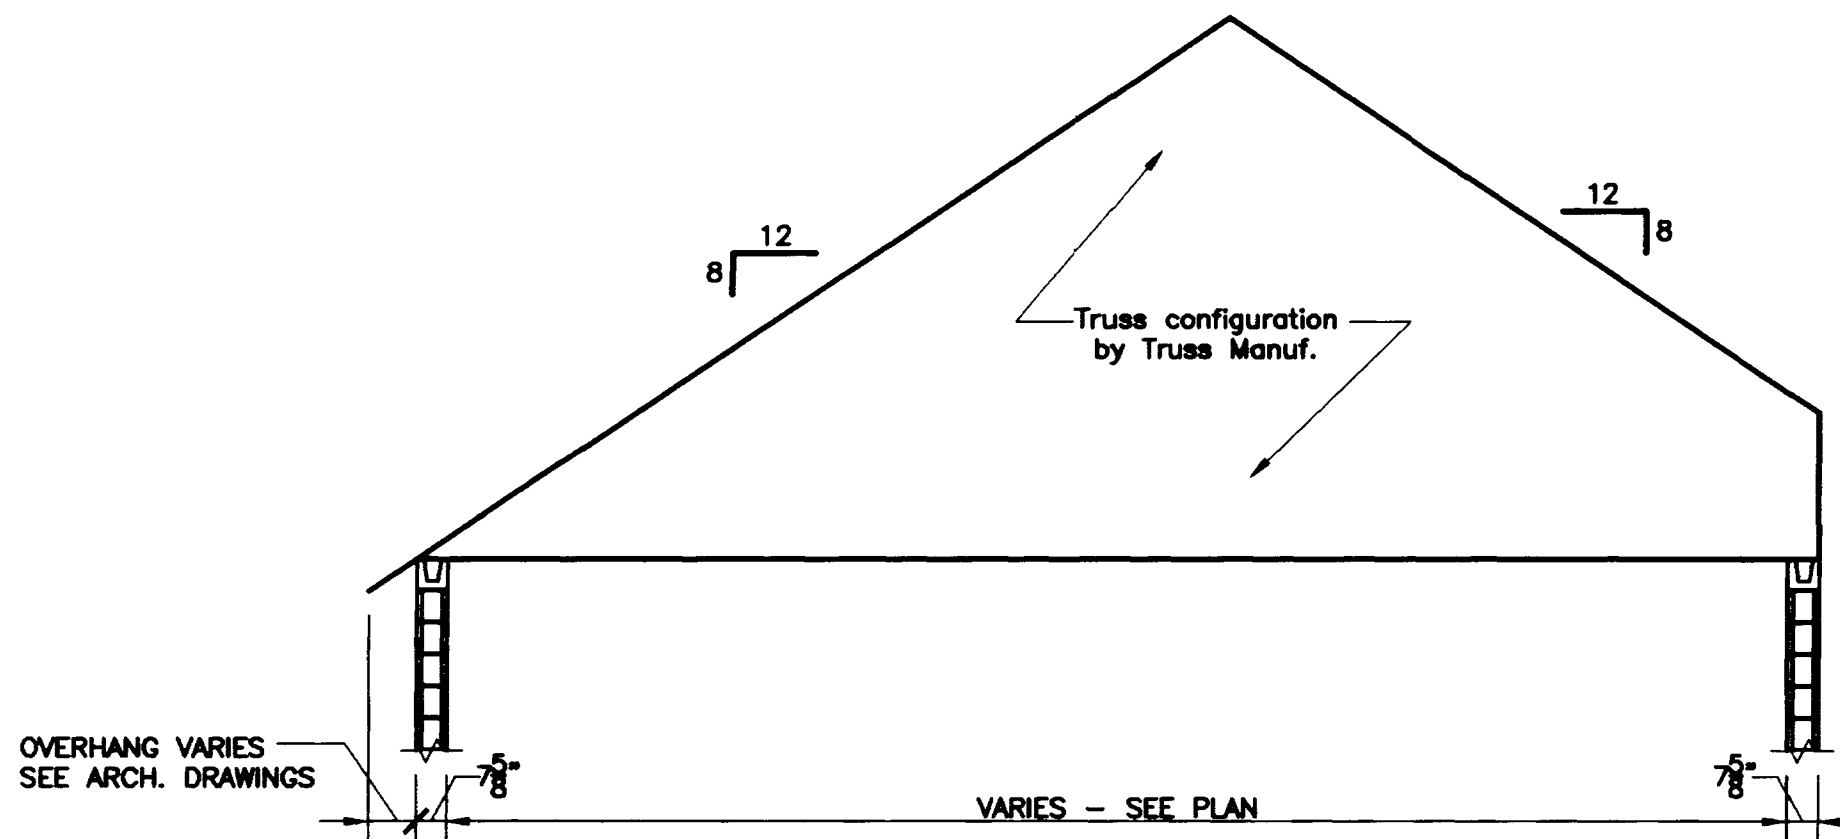


TRUSS T-2

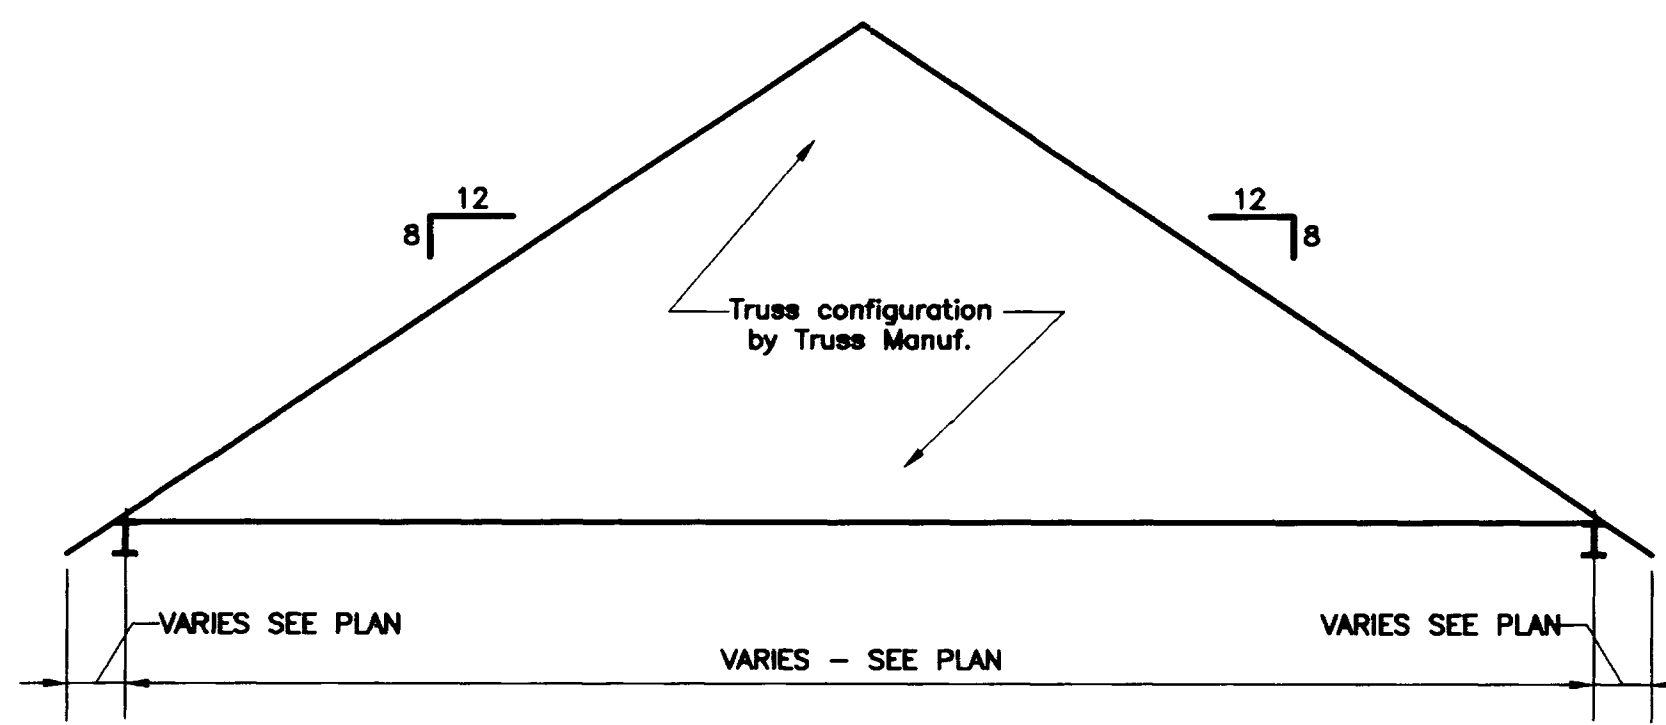


TRUSS T-6

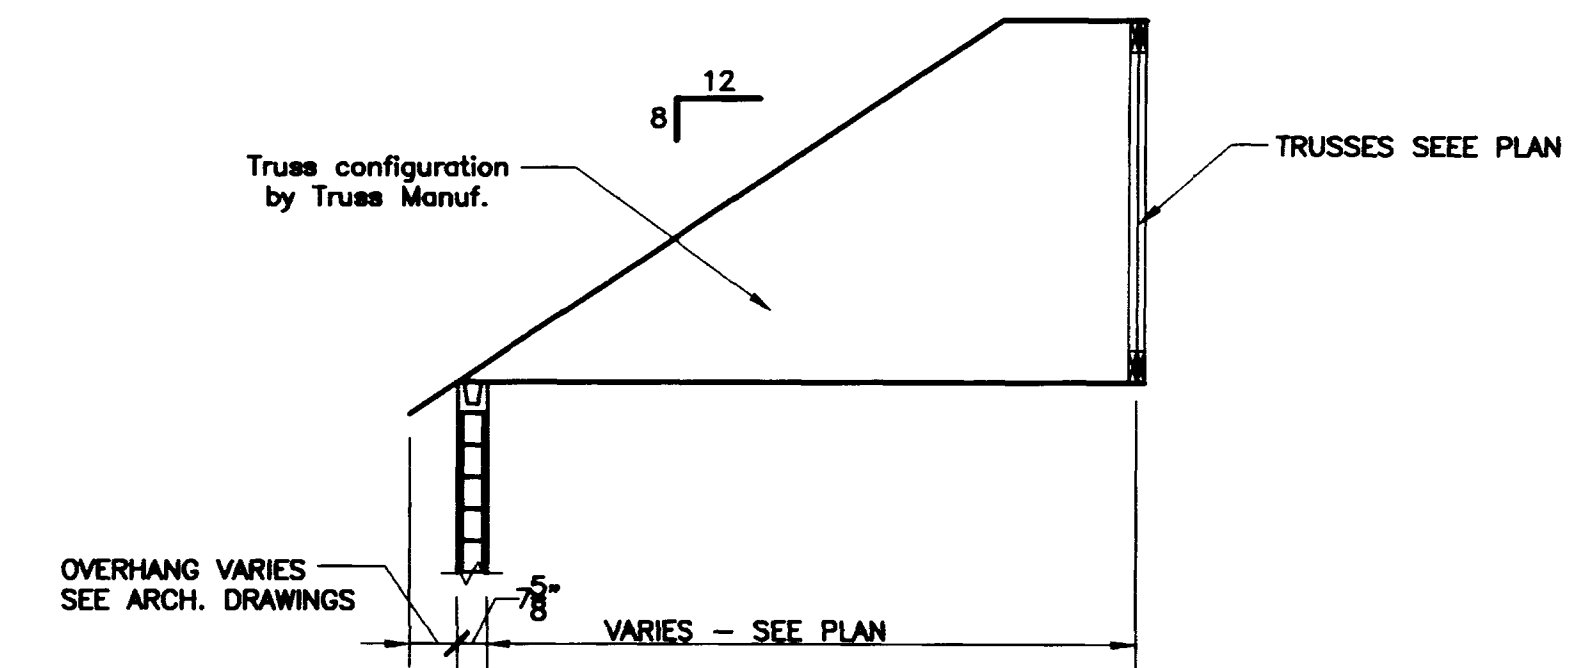


TRUSS T-11

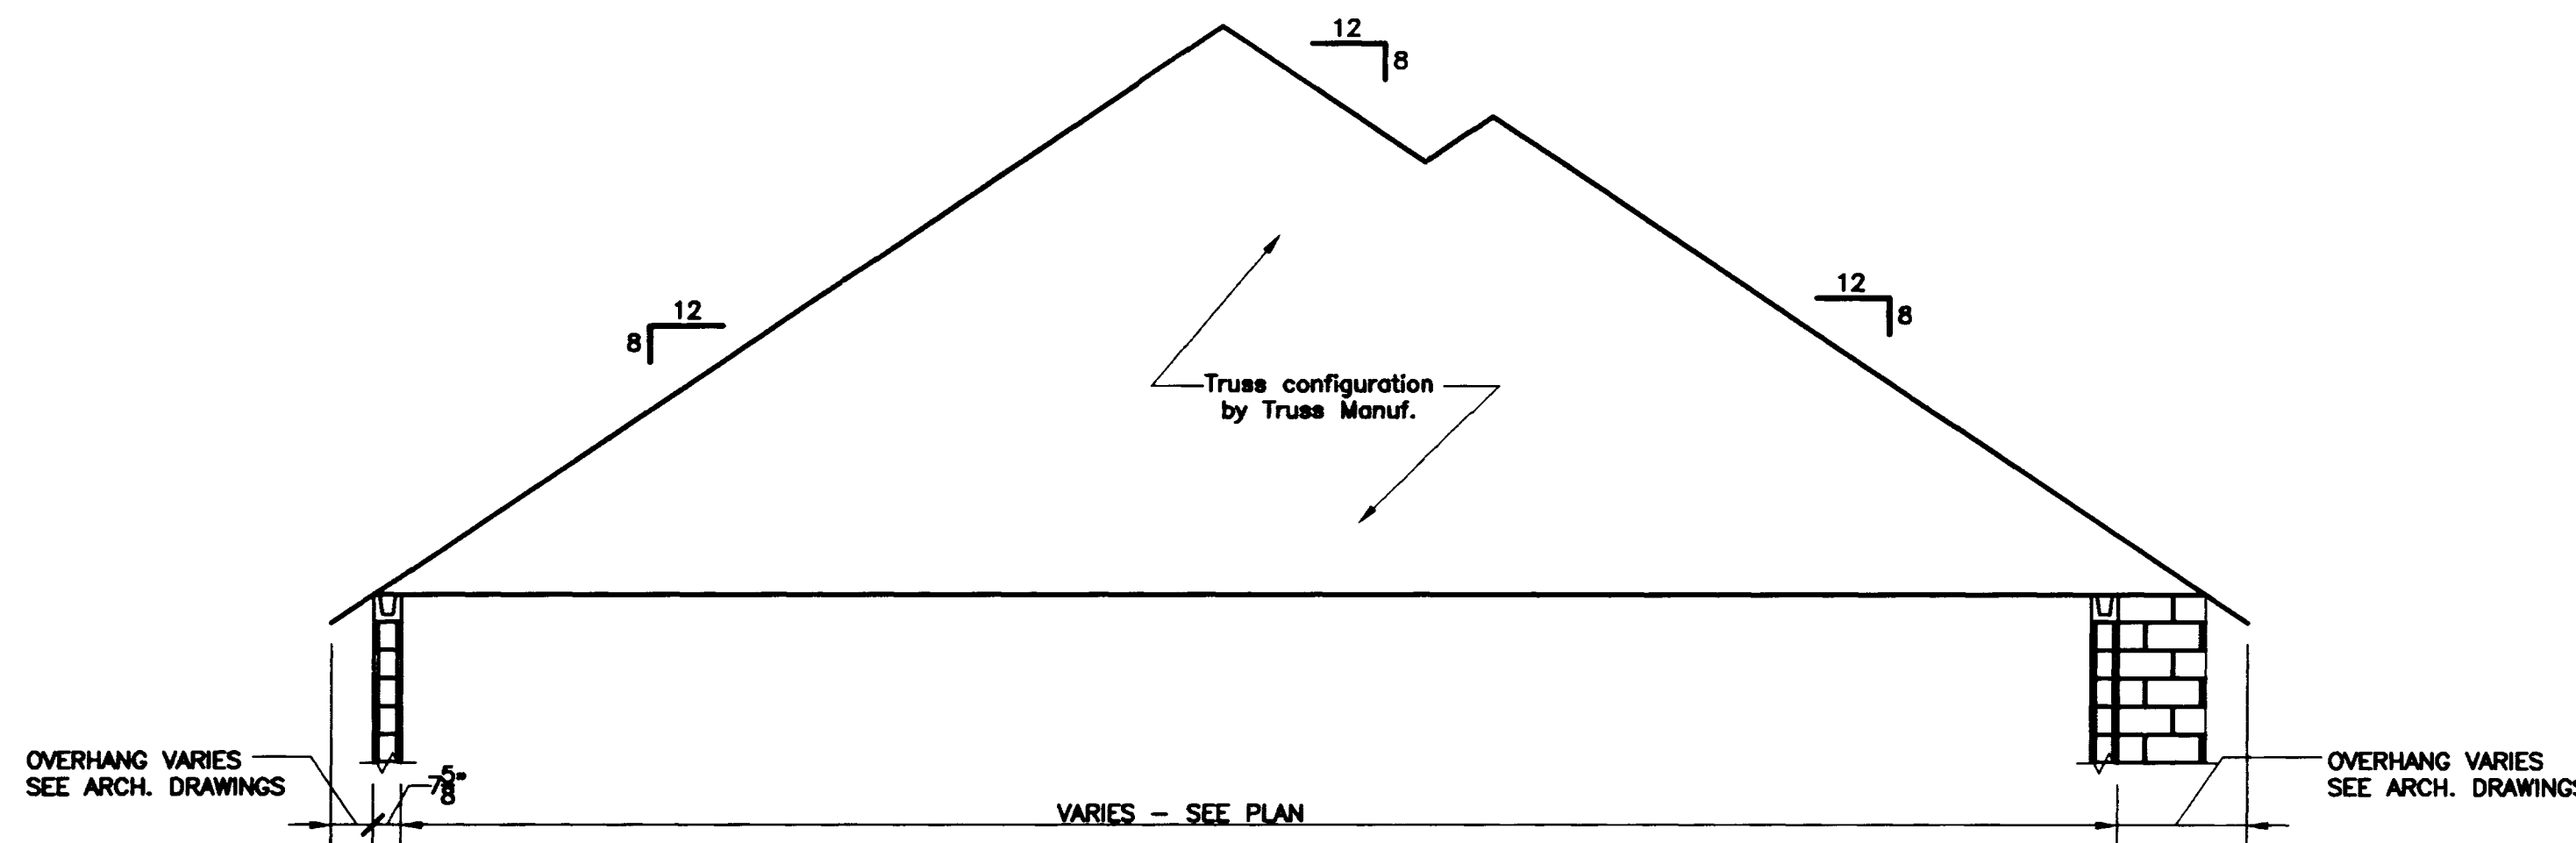


TRUSS T-3

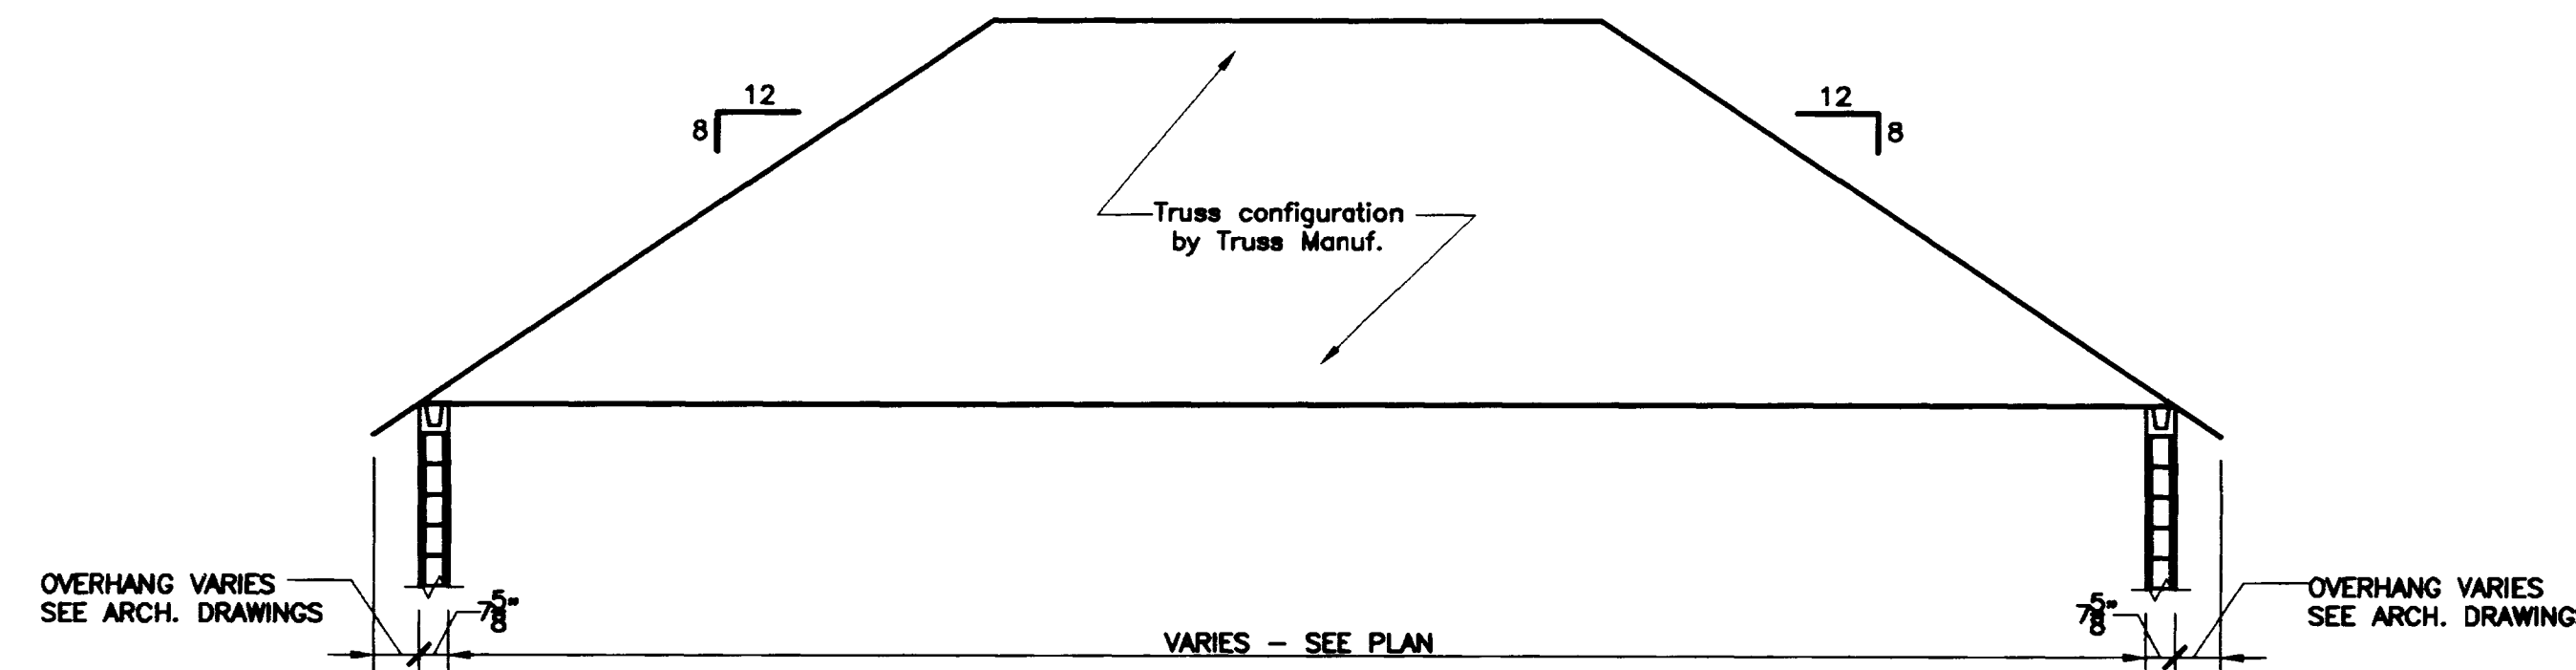


TRUSS T-7

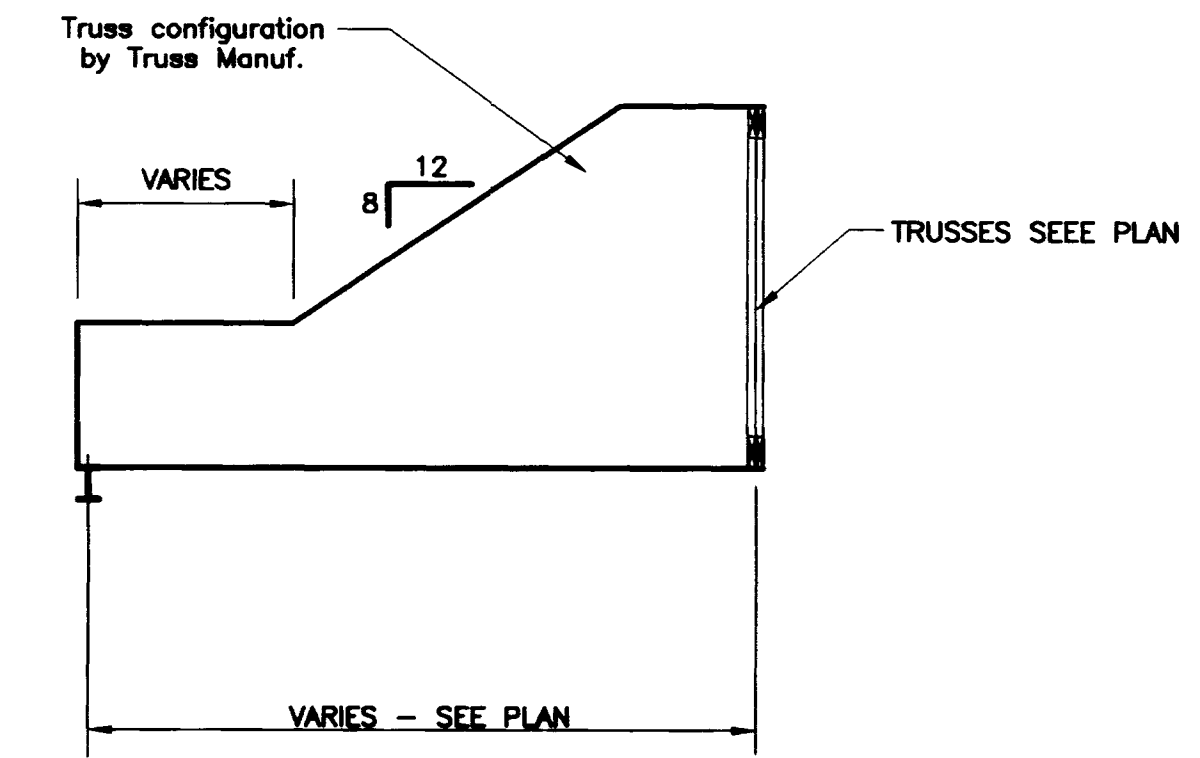


TRUSS T-12

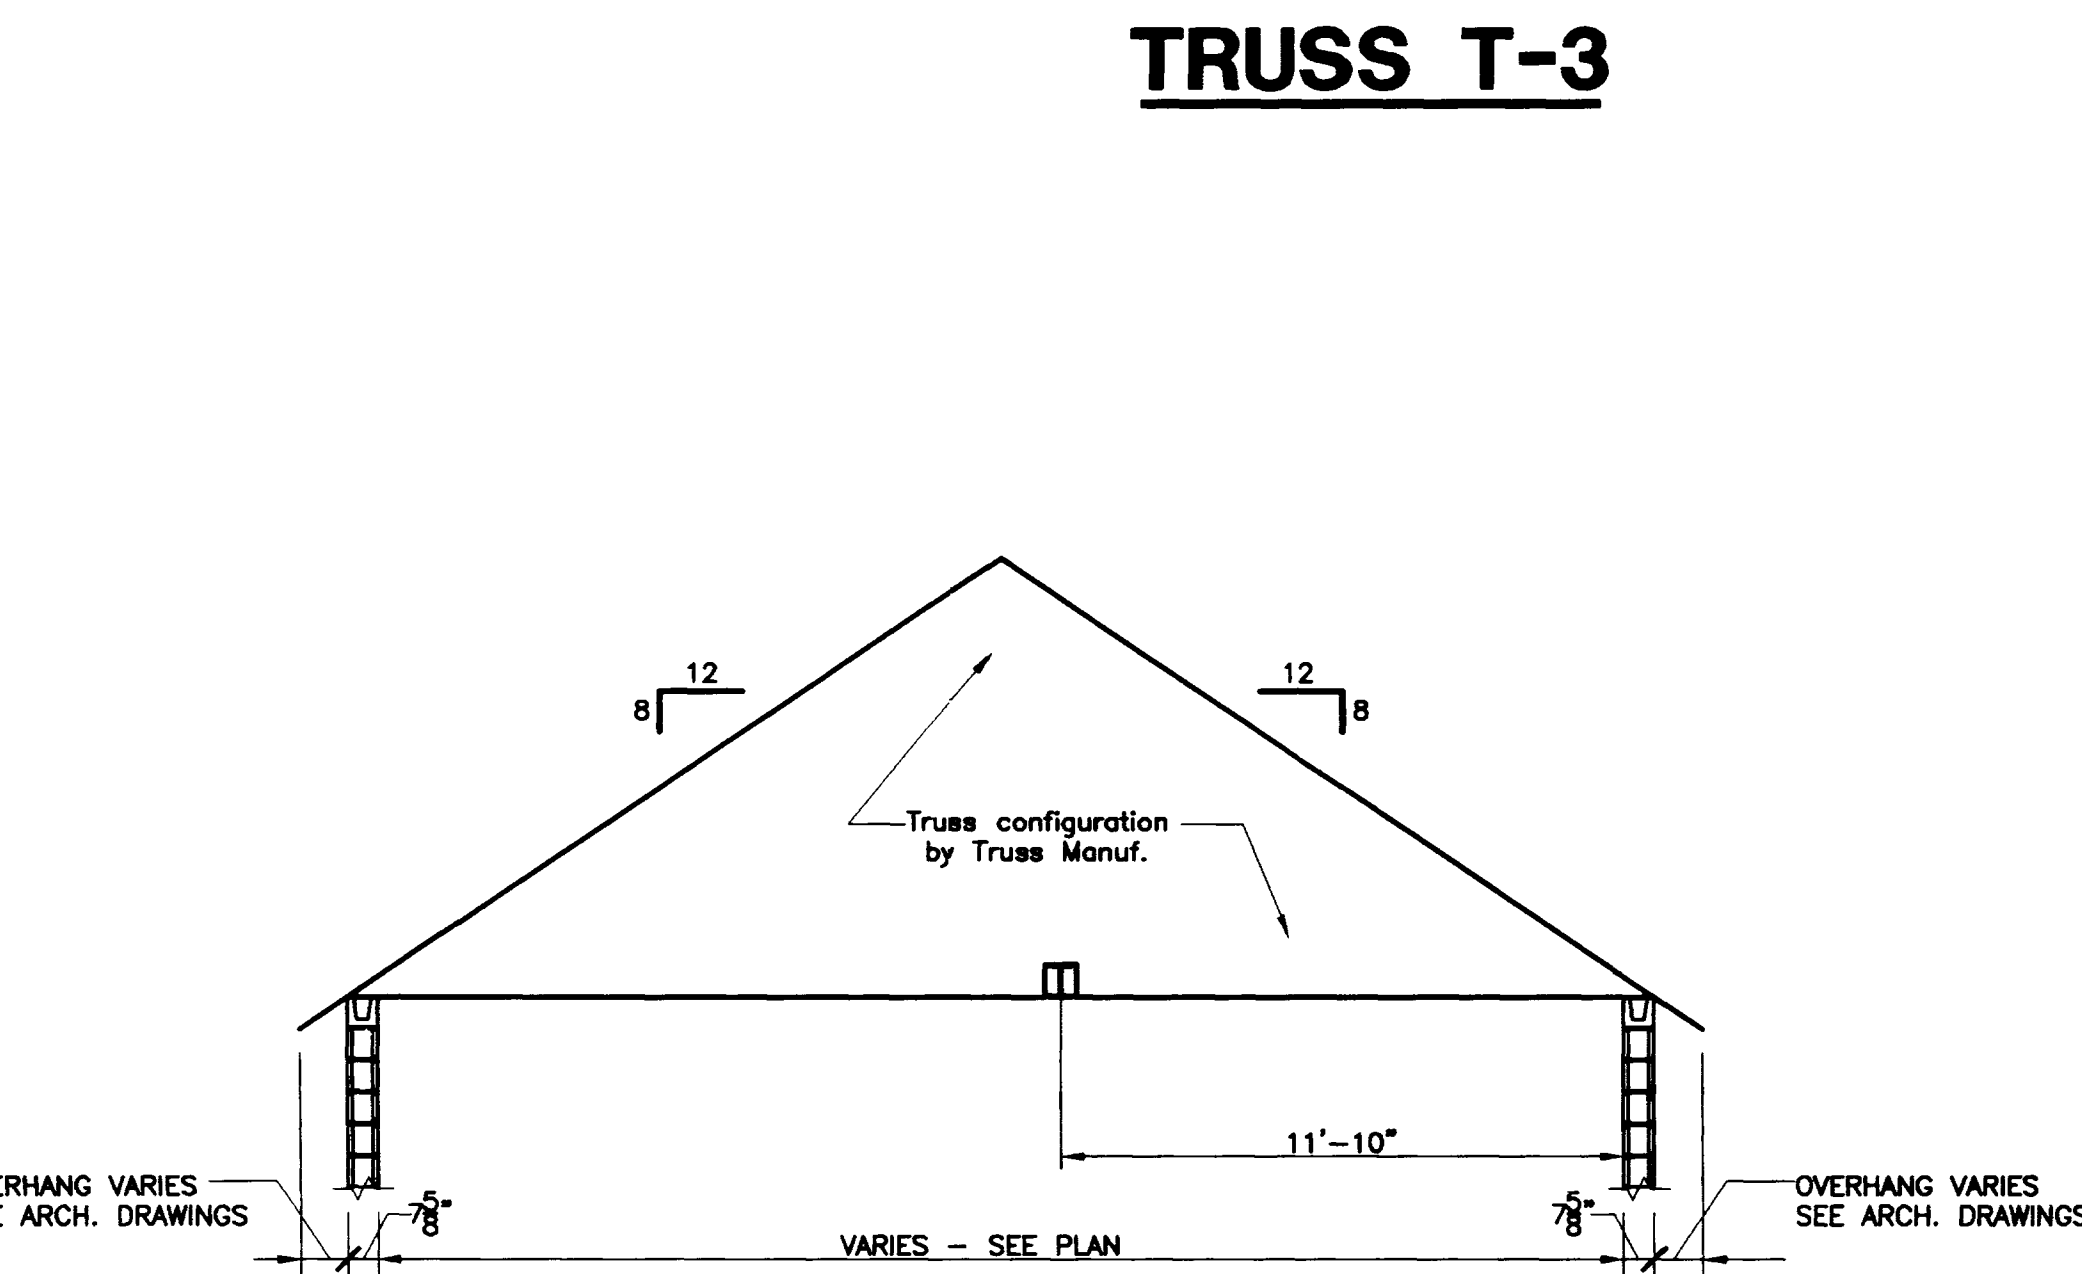


TRUSS T-4

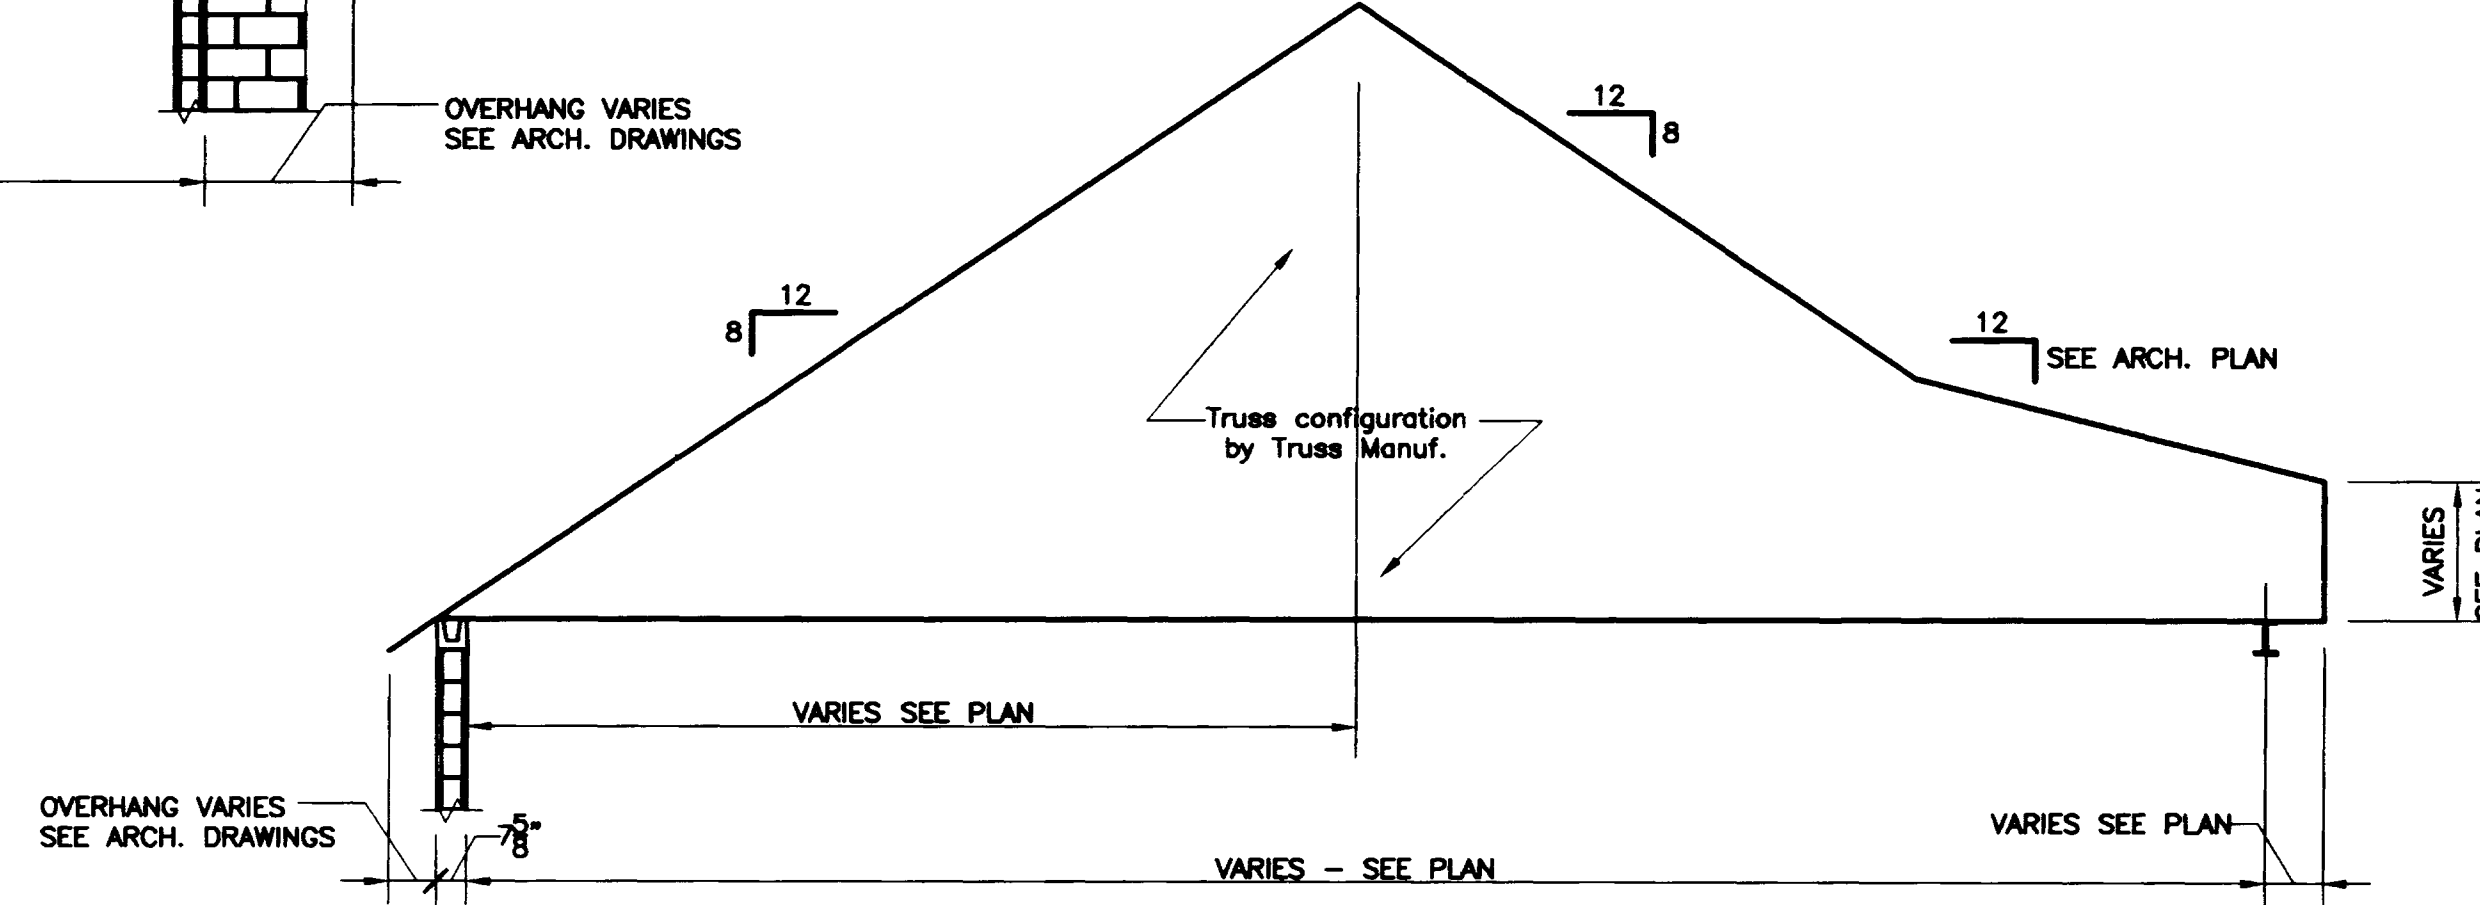


TRUSS T-8

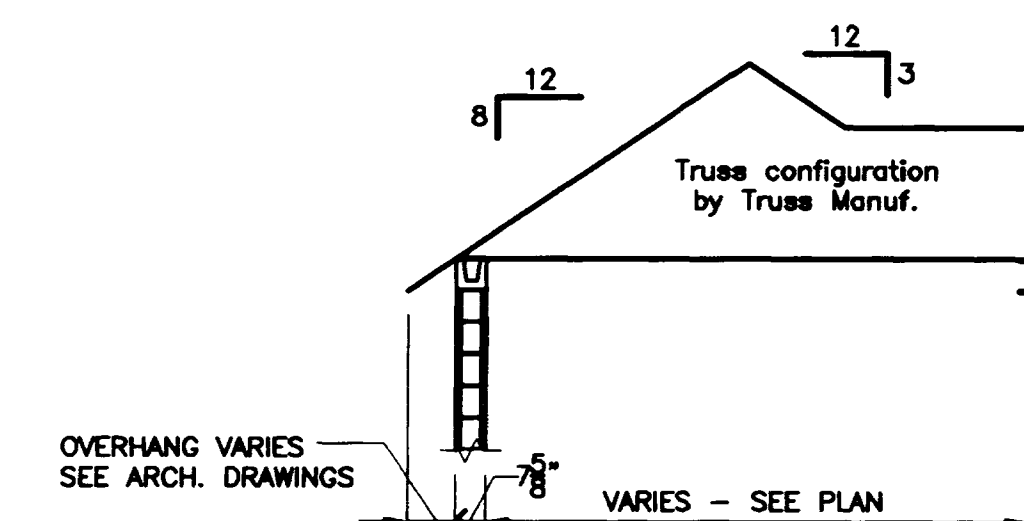


TRUSS T-13

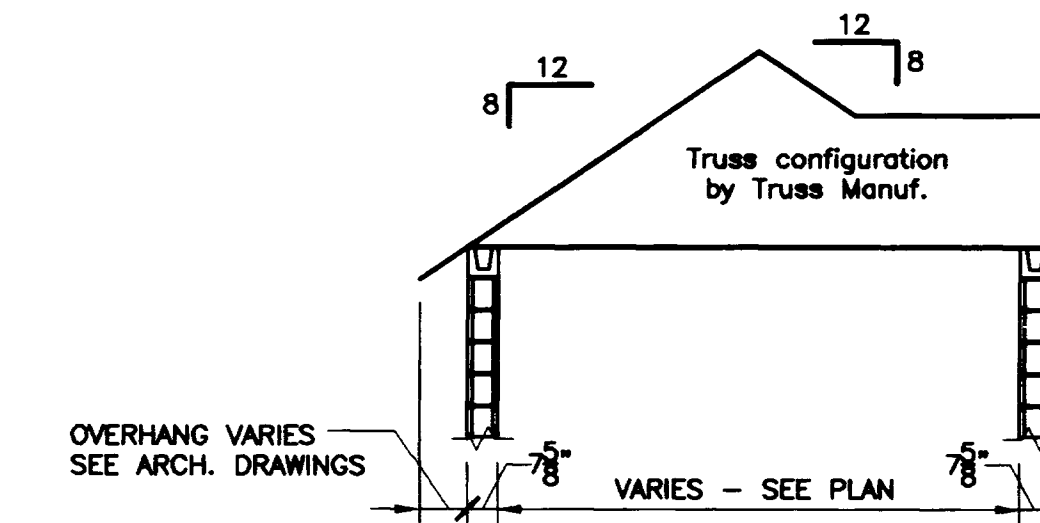

TRUSS T-14

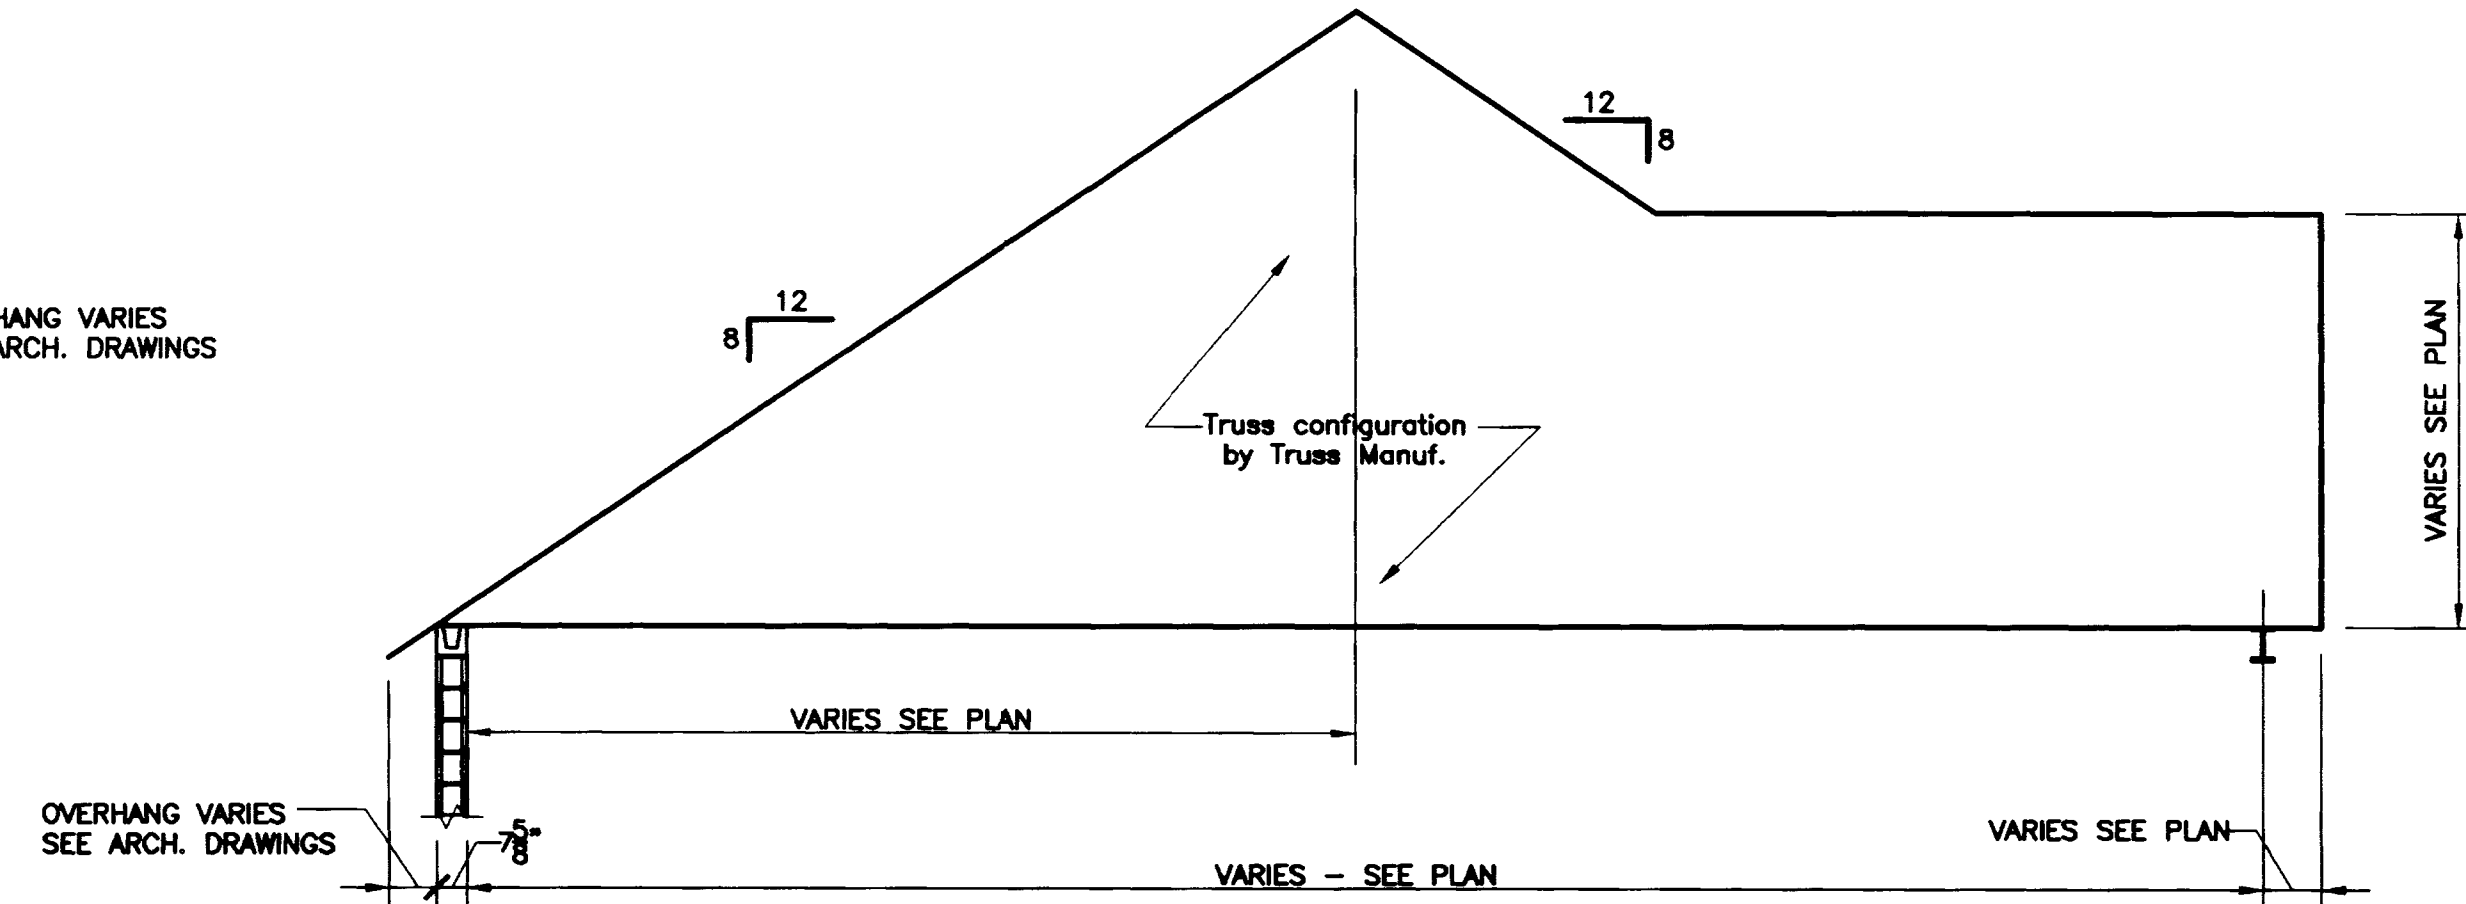

TRUSS T-9

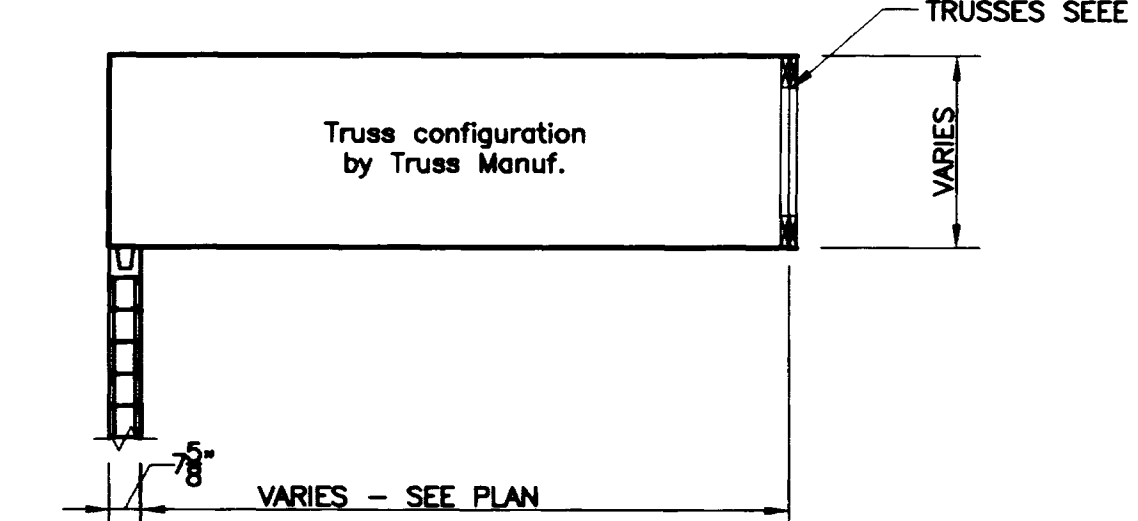

TRUSS T-15

These Record Drawings have been prepared based on information provided by others. The Design Professional has not verified the information and shall not be responsible for any errors or omissions which may be incorporated herein as a result.

