

ABBREVIATIONS

ADJ. AFF. ALT. ALUM. ANCH. APPR. APPROX.	A	ADJUSTABLE ADJUSTED FLOOR ALTERNATE ALUMINUM ANCHOR APPROXIMATELY
BD BLDG. BLK. BM. BOT. BRG. BU.	B	BOARD BUILDING BLOCK BENCH MARK BOTTOM BEARING BUILT UP
CAB. C.F.C. C.F.M. C.P. C.J. C.L. C.F.T. C.G. C.M.U. C.O. C.O.L. C.O.N. C.O.N.C. C.O.N.S.T. C.O.N.T. C.O.N.T.R. C.O.N.T.R. C.P.T. C.T. C.V.	C	CABINET CENTER TO CENTER CUBIC FOOT PER MINUTE CONTROL JOINT CONTROL LINE CERAMIC FLOOR TILE CEILING CLOSURE CONCRETE MASONRY UNIT CLEANOUT COLUMN CONCRETE CONSTRUCTION CONTINUOUS CONTRACTOR CORRUGATED CARPET CERAMIC TILE CUBIC
DEPT. DET. DIA. DIM. DSP. DR. DS. DWG.	D	DEPARTMENT DETAIL DIAMETER DIMENSION DISPENSER DRAWING DOWNSPOUT DRAWING
E.A. E.I.F.S. E.J. ELEC. ELEV. EQ. EQPT. EXIST. EXP. E.W.C.	E	EACH EXTERIOR INSULATION FINISH SYSTEM EXPANSION JOINT ELECTRIC ELEVATOR / ELEVATOR EQUAL EQUIPMENT EXISTING EXPOSED ELECTRIC WATER COOLER
F.E.B. F.E.C. F.O. F.D. F.F. F.N. F.V. F.L. F.T.	F	FIRE EXTINGUISHER / BRACKET FIRE EXTINGUISHER CABINET FLOOR DRAIN FOUNDATION FIRE EXTINGUISHER FINISH FUTURE FLOOR FOOT / FEET
GA. GALV. G.B. GL. GLZ. GYP. BO.	G	GAUGE GALVANIZED GRAB BAR / GYPSUM BOARD GLASS / GLAZING GYPSUM BOARD
HWIR. HM. HORZ. HT. HT.	H	HARDWARE HOLLOW METAL HORIZONTAL HOUR HEIGHT
INSUL. INT.	I	INSULATION INTERIOR
JAN. JNT.	J	JANITOR JOINT
LAB. LAMB. LAV. L.H.	L	LABORATORY LAMB LAVATORY LEFT HAND
MATL. MAX. MECH. MEMB. MFR. MNL. MISC. M.O. MET. MULL.	M	MATERIAL MAXIMUM MECHANICAL MEMBRANE MANUFACTURER MINIMUM MISCELLANEOUS MASONRY OPENING METAL MULLION
N.I.C. NO. NOM. N.T.S.	N	NOT IN CONTRACT NUMBER NOMINAL NOT TO SCALE
O.C. O.P. OZ.	O	ON CENTER OWNER FURNISHED, OWNER INSTALLED OUNCE
PART. PL. PLAS. PLYWD. PROT. P.T. P.T.D. P.T.S.	P	PARTITION PLATE PLASTIC PLYWOOD PROTECTIVE PRESSURE TREATED PAPER TOWEL DISPENSER PNEUMATIC TUBE STATION
Q.T.	Q	QUARRY TILE
R. R.D. REF. REINF. RECO. R.H. R.M.	R	RADIUS ROOF DRAIN REFRIGERATOR REINFORCEMENT REQUIRED RIGHT HAND ROOM
SECT. SCHED. SIM. SIN.D. SQ. SPEC. SERV. S.S. STD. STOR. STRUCT. SUSP.	S	SECTION SCHEDULE SIMILAR SANITARY NAPKIN DISPENSER SQUARE SPECIFICATION STAINLESS STEEL STANDARD STORAGE STRUCTURAL SUSPENDED
T&G. TEL. TEL. THRES. T.O.S. T.P.H. TYP.	T	TONGUE & GROOVE TEMPERATURE / TEMPORARY TELEPHONE THRESHOLD TOP OF STEEL TOILET PAPER HOLDER TYPICAL
U.N.O. UR.	U	UNLESS NOTED OTHERWISE URNAL
VAC. V.C.T. VENT. VEST. VERT.	V	VACUUM VINYL COMPOSITE TILE VENTILATOR VESTIBULE VERTICAL
W. W.C. WD. W.D.W. W.H. WID. WIF. WWF.	W	WATER CLOSET WATER WINDOW WATER HEATER WITHOUT WEIGHT WELDED WIRE FABRIC
YD.	Y	YARD

GENERAL NOTES

- ALL DIMENSIONS SHOWN ON PLANS ARE TO CENTER LINE OF COLUMN, FACE OF MASONRY OR WOOD STUD AND DO NOT INCLUDE THICKNESS OF DRYWALL UNLESS OTHERWISE NOTED.
- ALL DIMENSIONS ON ROOM ELEVATIONS ARE TO FACE OF FINISH UNLESS OTHERWISE NOTED.
- CONTRACTOR SHALL NOT SCALE DRAWINGS FOR DIMENSIONS.
- CONTRACTOR AND SUBCONTRACTORS SHALL VERIFY ALL DIMENSIONS IN THE FIELD PRIOR TO BEGINNING CONSTRUCTION OR ORDERING ANY MATERIALS.
- REFER TO ENLARGED FLOOR PLANS FOR ADDITIONAL DIMENSIONS AS INDICATED ON REFERENCE SHEETS.
- DRYWALL CONTRACTOR TO PROVIDE WOOD BLOCKING FOR CASEWORK AND ACCESSORIES WHERE REQUIRED. PROVIDE BLOCKING FOR OWNER FURNISHED / CONTRACTOR INSTALLED ITEMS. PROVIDE BLOCKING FOR FUTURE GRAB BAR INSTALLATION AS INDICATED ON INTERIOR ELEVATIONS.
- ALL EXTERIOR WINDOW TYPES TO RECEIVE WINDOW BLINDS.
- CONFIRM ACTUAL ROOM NUMBERS WITH OWNERS REPRESENTATIVE FOR SIGNAGE. ROOM NUMBERS ON DRAWINGS ARE FOR CONSTRUCTION PURPOSES ONLY.
- REFER TO REFLECTED CEILING PLANS FOR RATED WALLS. ALL RATED ASSEMBLIES TO BE INSTALLED SMOKE TIGHT AND / OR FIRE TIGHT TO UNDERSIDE OF DECK.
- CONTRACTOR SHALL NOT SCALE DRAWINGS FOR DIMENSIONS.
- REFER TO MECHANICAL AND ELECTRICAL SHEETS FOR FULL EXTENT OF ACCESS PANELS.
- REFER TO LINTEL SCHEDULES FOR MASONRY OPENINGS. PROVIDE STEEL LINTELS FOR ALL MECHANICAL PENETRATIONS.
- PROVIDE WATER RESISTANT GYPSUM BOARD IN ALL RESTROOMS AND BEHIND ALL CERAMIC TILE.
- REFER TO MECHANICAL SPECS. FOR REQUIREMENTS OF NEW EXTERIOR LOUVERS. COLOR OF LOUVERS AS SELECTED BY ARCHITECT.
- ALL SAFETY GLASS & TEMPERED GLASS SHALL BE PER KENTUCKY BUILDING CODE.

LEGEND

FLOOR DRAIN	
KEY NOTE	
WALL TYPE INDICATOR	
ELEVATION MARK	
SECTION MARK	
MATCHLINE INDICATOR	
NEW DOOR	
(H/C) ELECTRIC WATER COOLER	
WINDOW INDICATOR	
DETAIL INDICATOR	
CEILING HEIGHT INDICATOR	
GYPSUM BOARD	
2 X 2 LAY-IN ACOUSTICAL TILE	
2X4 FLUORESCENT FIXTURE	
1X4 FLUORESCENT FIXTURE	
RECESSED CAN LIGHT	
RECESSED CAN LIGHT (WALL WASHER)	
EXIT LIGHT	
SUPPLY DIFFUSER	
RETURN AIR GRILLE	
ACCESS DOOR	
2 HOUR RATING	
1 HOUR RATING	
SMOKE TIGHT	
EARTH	
CRUSHED STONE OR GRAVEL	
CONCRETE	
BRICK	
CONCRETE BLOCK	
CONCRETE BLOCK SLUSHED SOLID	
STEEL	
BENCH MARK OR FLOOR ELEVATION	
WOOD-ROUGH	
WOOD-FINISH	
RIGID INSULATION	
BATT INSULATION	
PLYWOOD	


WALL TYPES

WALL TYPE	DETAIL	DESCRIPTION	DESIGN NUMBER
1		CONSTRUCTION TYPE: BRICK VENEER, RIGID INSULATION, CONCRETE MASONRY UNIT 4" NOMINAL BRICK VENEER WITH 1 1/2" RIGID INSULATION OVER 8" NOMINAL CONCRETE MASONRY UNIT WITH TRUSS TYPE HORIZONTAL REINFORCING WITH ADJUSTABLE MASONRY ANCHORS (EYE AND PANTL) EVERY 16" VERTICALLY. PROVIDE INST. ALL VERTICAL REINFORCING BARS IN CORES OF CONCRETE MASONRY UNITS PER STRUCTURAL DRAWINGS.	N.A.
2		CONSTRUCTION TYPE: CUT STONE CLADDING PANEL, RIGID INSULATION, CONCRETE MASONRY UNIT DIMENSIONAL STONE CLADDING PANEL VENEER WITH 1 1/2" RIGID INSULATION OVER 8" NOMINAL CONCRETE MASONRY UNIT WITH TRUSS TYPE HORIZONTAL REINFORCING EVERY 16" VERTICALLY. PROVIDE INST. ALL VERTICAL REINFORCING BARS IN CORES OF CONCRETE MASONRY UNITS PER STRUCTURAL DRAWINGS.	N.A.
3		CONSTRUCTION TYPE: CONCRETE MASONRY UNIT 8" NOMINAL CONCRETE MASONRY UNIT WITH LADDER TYPE HORIZONTAL REINFORCING @ 16" O.C. VERTICALLY AND VERTICAL REINFORCING BARS PER STRUCTURAL DRAWINGS. GROUT CORES SOLID @ VERTICAL REINFORCING BAR LOCATIONS.	ONE OR TWO HOUR U-905
4		CONSTRUCTION TYPE: CONCRETE MASONRY UNIT 4" NOMINAL CONCRETE MASONRY UNIT WITH LADDER TYPE HORIZONTAL REINFORCING @ 16" ON CENTER VERTICALLY	N.A.
5		CONSTRUCTION TYPE: CONCRETE MASONRY UNIT 4" NOMINAL CONCRETE MASONRY UNIT WITH LADDER TYPE HORIZONTAL REINFORCING @ 16" ON CENTER VERTICALLY	N.A.
6		CONSTRUCTION TYPE: GYPSUM BOARD, METAL STUDS ONE LAYER 5/8" GYPSUM BOARD APPLIED @ RIGHT ANGLES OR PARALLEL TO 2 1/2" METAL STUDS @ 16" O.C. WITH 1" TYPE S DRYWALL SCREWS @ O.C. TO VERTICAL EDGES AND TOP AND BOTTOM RUNNERS AND 12" O.C. TO INTERMEDIATE STUDS. STAGGER ALL VERTICAL AND HORIZONTAL JOINTS. 24" O.C.	ONE HOUR
7		CONSTRUCTION TYPE: GYPSUM BOARD, METAL STUDS ONE LAYER 5/8" GYPSUM BOARD APPLIED @ RIGHT ANGLES OR PARALLEL TO 2 1/2" METAL STUDS @ 16" O.C. WITH 1" TYPE S DRYWALL SCREWS @ O.C. TO VERTICAL EDGES AND TOP AND BOTTOM RUNNERS AND 12" O.C. TO INTERMEDIATE STUDS. STAGGER ALL VERTICAL AND HORIZONTAL JOINTS. 24" O.C.	N.A.
8		CONSTRUCTION TYPE: POURED CONCRETE	N.A.

NOTES:

- SEE PLAN SHEETS FOR LOCATIONS.
- RUN ALL RATED WALLS TIGHT TO UNDERSIDE OF FLOOR OR ROOF DECK. REFER TO REFLECTED CEILING PLAN.
- ALL EXPOSED TO VIEW DRYWALL IS TO RECEIVE A "LEVEL 5" FINISH.


PROJECT SIGN

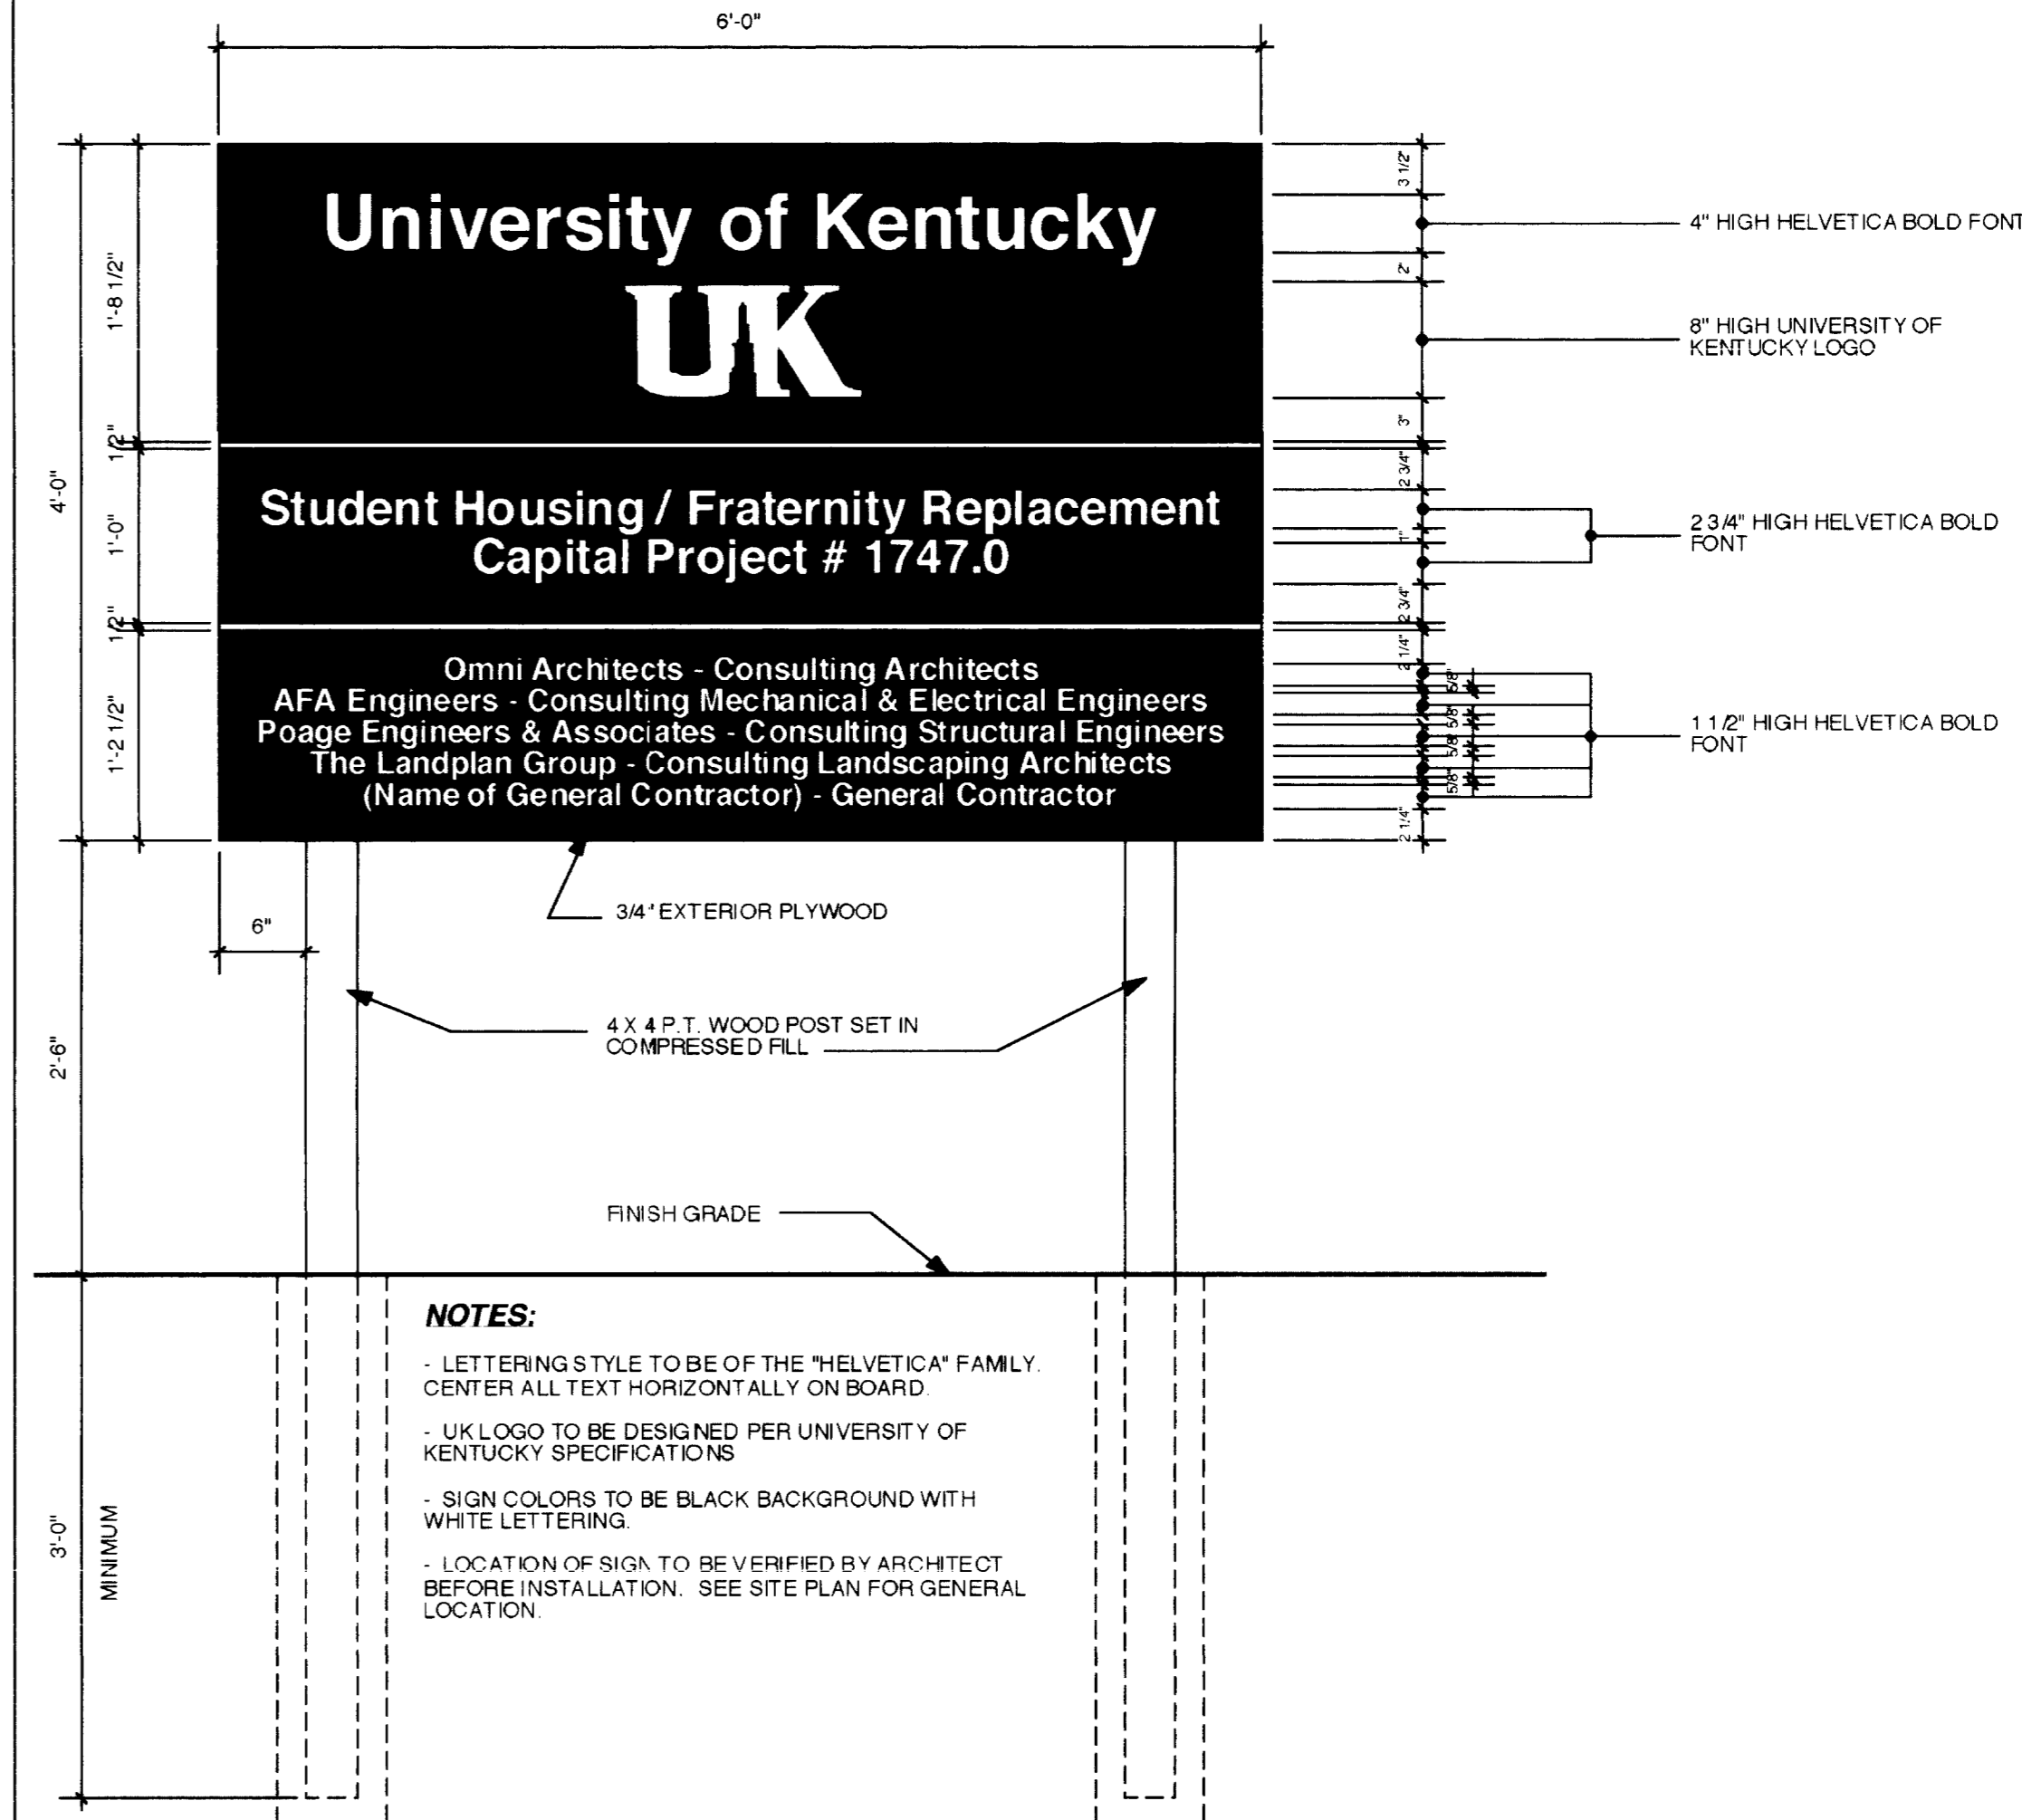

BUILDING STATISTICS

Use Group: R-2 (Multi-family Residential)
Construction Type: Type 2C (Noncombustible, Type 2, Unprotected)
Fire Protection: 100% sprinklered per KBC 906.2.1
Area Increase allowed: per KBC 506.3
Fire Resistance Ratings:
Exterior Walls: 0 hr
Fire Walls: 2 hr
Fire Stairs: 1 hr (per KBC 1014.11)
Shafts: 1 hr
Corridors: 1/2 hr (per KBC table 1011.4)
Dwelling Unit Separation: 1/2 hr
Interior Loadbearing Walls: 0 hr
Structural Members Supporting Walls: 0 hr
Floor / Ceiling: 1/2 hr @ dwelling unit sep. - 0 hr. otherwise
Roof: 0 hr
Height: Two stories above grade w/ partial basement)

Gross Areas:
Building 0504:
Basement - 2,300 sf
1st floor - 6,186 sf
2nd floor - 5,804 sf
Total - 14,290 sf
Building 0505:
Basement - 2,296 sf
1st floor - 6,010 sf
2nd floor - 5,569 sf
Total - 13,875 sf

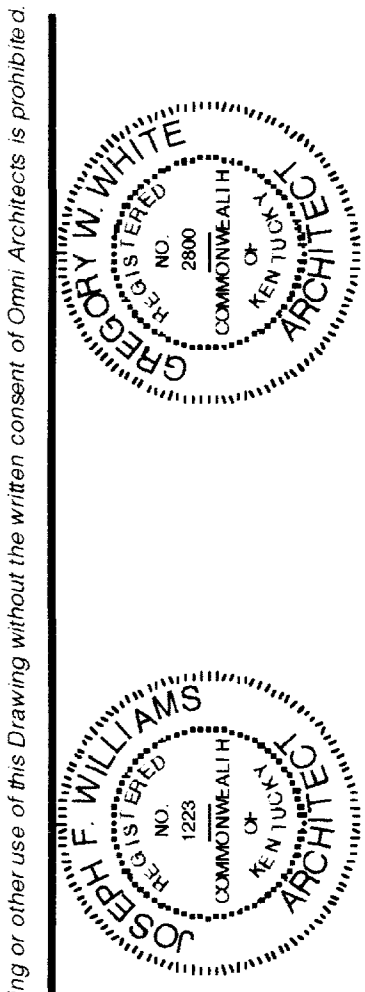

Omni Architects
AFA Engineers
Poage Engineers & Associates
The Landplan Group

Omni Architects
AFA Engineers
Poage Engineers & Associates
The Landplan Group

RECORD DRAWINGS
This record drawing has been prepared, printed, and submitted to the appropriate authority for recording. It is the responsibility of the user to verify the accuracy of the information contained herein. The user of this drawing is advised that it is not to be used for any other project without the written consent of the architect.
DATE: 6-21-02
DRAWN BY: [Signature]
CHECKED BY: [Signature]

A-0.1
Sheet Document