

**BASEMENT PLAN - Building 0504**

1/4" = 1'-0"


**RECORD DRAWINGS**  
 These record drawings have been prepared, in accordance with the provisions of the Kentucky Building Code, and are intended for use as a permanent record of the building as constructed. The architect and engineer shall be responsible for the accuracy of the information shown on these drawings.

**A-1-1.1**



Architecture  
 Landscape Architecture  
 Civil Engineering  
 Planning  
 Interiors  
 212 North Upper Street  
 Lexington, KY 40502  
 (606) 252-8884 Fax: (606) 252-2358

Job No: 9013.00 Date: August, 2000 Drawn By: THB Checked: FWQWV Revisions:

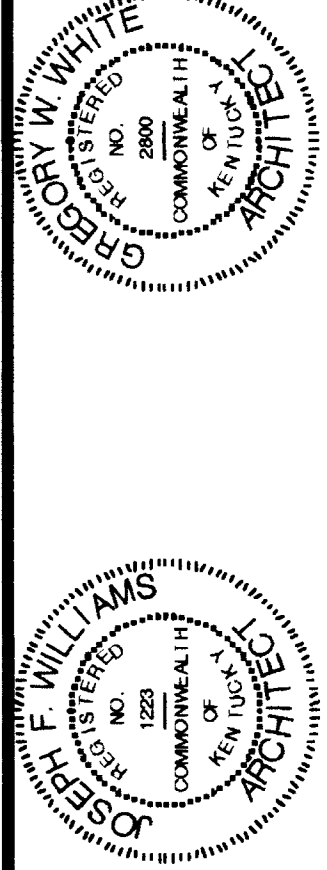

The Drawing and Design shown herein are the property of Omni Architects ©. The reproduction, copying or other use of this drawing without the written consent of Omni Architects is prohibited.

7/2/13