


**SECOND FLOOR PLAN - Building 0504**  
 1/4" = 1'-0"

Job No.: 9913.00    Date: August, 2000    Drawn By: THB    Checked: JFW/GMW    Revisors:  
 Architecture: Architecture  
 Civil Engineering: Civil Engineering  
 Mechanical: Mechanical  
 Electrical: Electrical  
 219 North Upper Street  
 Lexington, KY 40507  
 (606) 252-8864 Fax: (606) 252-2268

**Omni Architects**  
 ARCHITECTS

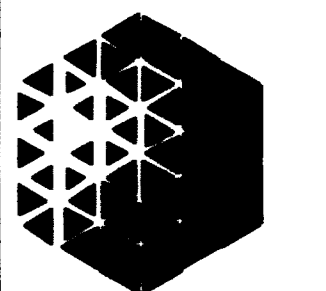

**RECORD DRAWINGS**  
 THE OFFICE SHALL BE RESPONSIBLE FOR THE ACCURACY OF THE INFORMATION CONTAINED HEREIN. THE USER SHALL BE RESPONSIBLE FOR VERIFYING THE INFORMATION CONTAINED HEREIN IS ACCURATE AND COMPLETE. THE USER SHALL BE RESPONSIBLE FOR ANY CHANGES TO THIS DOCUMENT AS A RESULT OF REVISIONS.  
 DATE: \_\_\_\_\_

**A-1.3R**

Professional Engineer Seal: GEORGE W. WHITE, LICENSE NO. 1224, COMMERCIAL, KY, EXPIRES 12/31/00