

FIRST FLOOR PLAN - Building 0505


1/8" = 1'-0"

FRATERNITY HOUSE REPLACEMENT - PROJECT 1747.0

FIRST FLOOR PLAN - BUILDING 0505

A-1.5R

RECORD DRAWINGS
This drawing is to be used for record purposes only. It is not to be used for construction. The architect is not responsible for any errors or omissions which have been incorporated into this document as a result of changes made to the original design.
DATE: 8-21-02
ARCHITECTS: Omni Architects

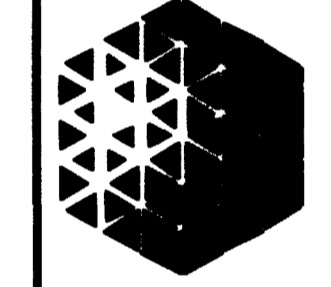

Omni
Architects



Architecture
Interior Architecture
Civil Engineering
Interior Design
212 North Upper Street
Lexington, KY 40502
(606) 252-6861 Fax: (606) 253-2260

Job No. 011620 Date August, 2000 Drawn By: THB Checked: JFW Revisions:

UNIVERSITY OF KENTUCKY

LEXINGTON, KENTUCKY

This Drawing and Design show fixtures as the property of Omni Architects. The reproduction, copying or other use of this Drawing without the written consent of Omni Architects is prohibited.

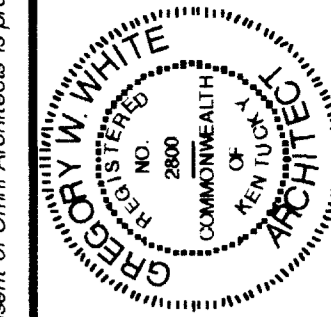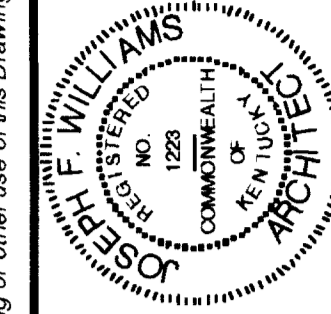

20 997