


**1 BUILDING 0504 ROOF PLAN**  
A-1.7 1/8"=1'-0"

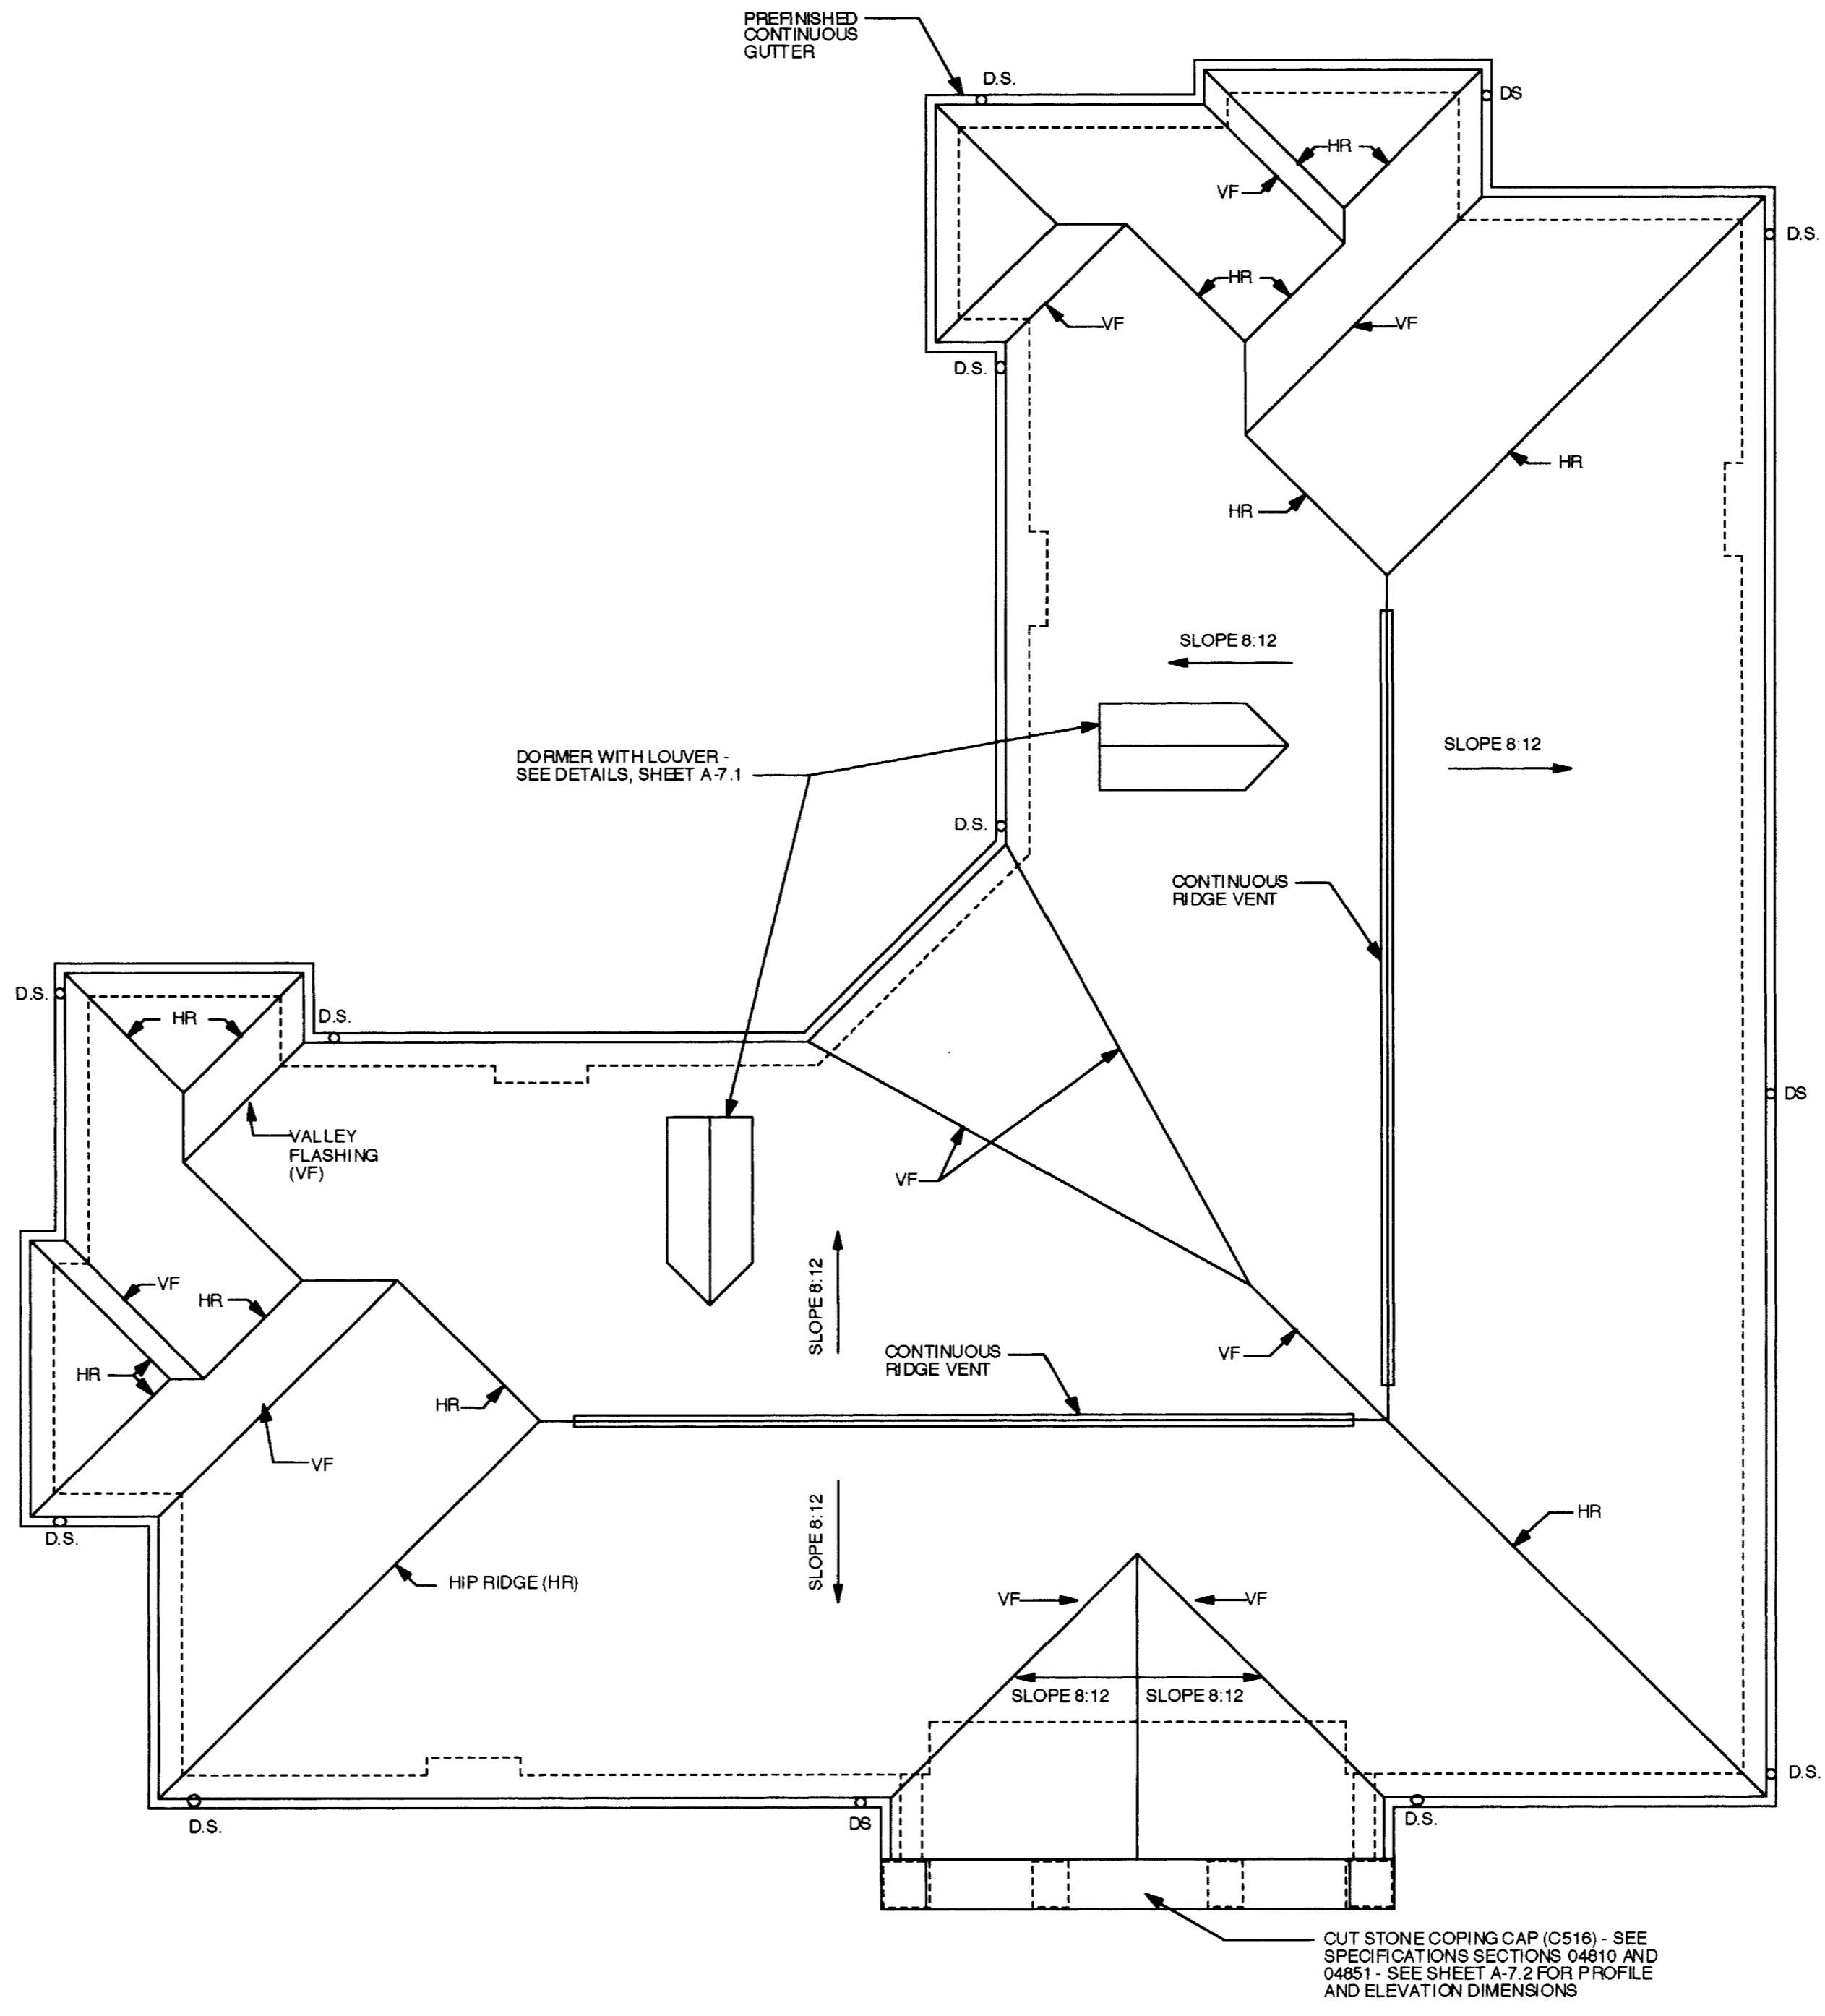

**2 BUILDING 0505 ROOF PLAN**  
A-1.7 1/8"=1'-0"

**RECORD DRAWINGS**  
These record drawings have been prepared, in accordance with the contract documents, and are the property of Omni Architects. The Architect will not be responsible for any errors or omissions. These drawings have been incorporated into this document as a record.

DATE: 8-21-02



Architecture  
Landscape Architecture  
Planning  
Interior  
212 North Lupton Street  
Lexington, KY 40504  
(606) 253-2268

JOB No. 9913.00 Date: August, 2000 Drawn By: Checked: Revisions:

This Drawing and Design shown hereon are the property of Omni Architects ©. The reproduction, copying or other use of this Drawing without the written consent of Omni Architects is prohibited.

