


1 WALL SECTION
3/4" = 1'-0"

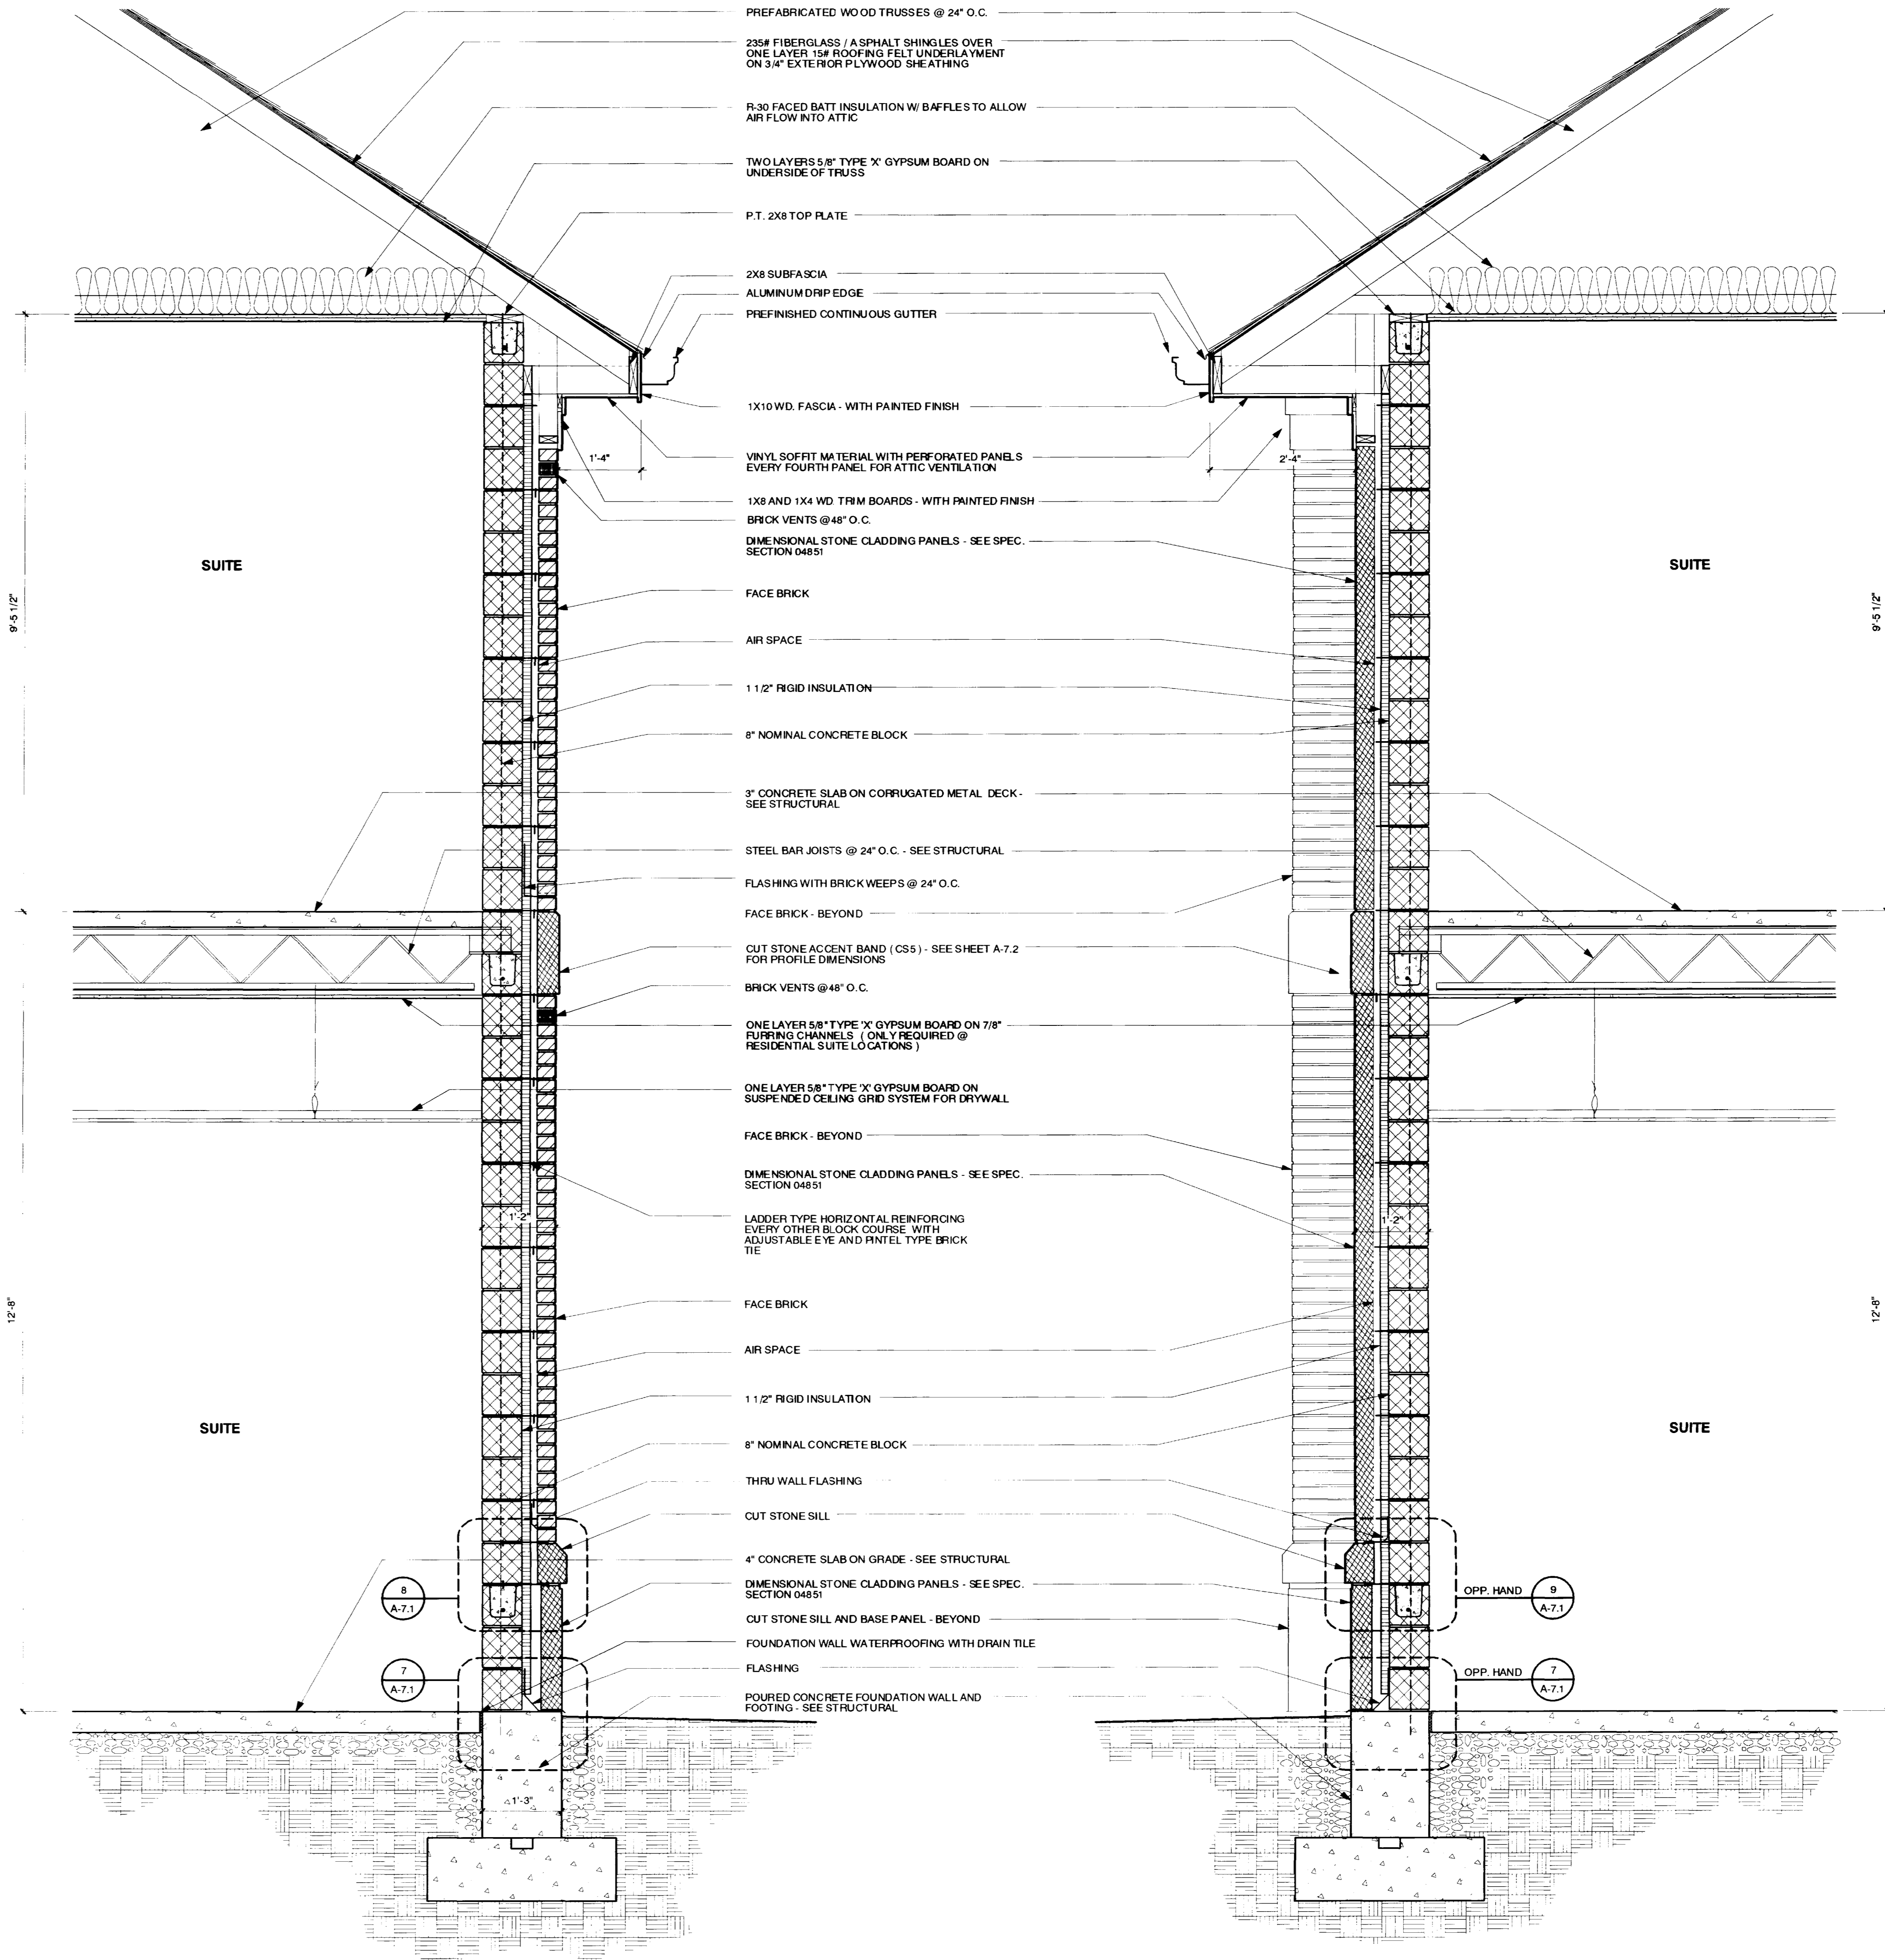

2 WALL SECTION
3/4" = 1'-0"

3 WALL SECTION
3/4" = 1'-0"

FRATERNITY HOUSE REPLACEMENT - PROJECT 1747.0 **UNIVERSITY OF KENTUCKY** **LEXINGTON, KENTUCKY**

WALL SECTIONS

Job No: 1913.00 Date: August, 2000
 Drawn By: CWW Checked: JTW
 Revisions:

Omni Architects
 Architects
 Landscape Architecture
 Civil Engineering
 Planning
 Interiors
 212 North Upper Street
 Lexington, KY 40507
 (609) 253-2568 Fax: (609) 253-2568

RECORD DRAWINGS
 This drawing is to be used as a guide only. It is not to be used for construction without the approval of the architect. The architect is not responsible for any errors or omissions which may appear hereon. The architect's office is not responsible for any errors or omissions which may appear hereon.
 6-2-02
 DATE

A-4.1
 43 C-3 21003
 3/4" = 1'-0" Document #

