

NOTE:
SEE WALL SECTIONS FOR TYPICAL
NOTES REGARDING ROOF, TRUSS,
OVERHANG, AND WALL CONSTRUCTION

ROOF TRUSS BEARING

TWO LAYERS 5/8\" TYPE \"C\" GYPSUM
BOARD ON WOOD TRUSSES

STAIR #1
200

212

OPP
HAND
L
S-10

SECOND FLOOR

1 1/4\" STD. STEEL PIPE HANDRAIL
WITH BRACKETS (TYP) - SEE
SPEC. SECTION 05511

4'-0"

10 TREADS @ 11 7/8\"

STAIR #1
100

11 RISERS @ 6 9/16\" = 6'-4"

113A


11\"

1'-0"


FIRST FLOOR

1
A-4.7
STAIR "#1" SECTION @ BUILDING 0505
3/4" = 1'-0"

STAIR / WALL SECTION Job No: 991310 Date: August, 2000 Drawn By: XND Checked: JFW/GWW Revisors: The Drawing and Design shown hereon are the property of Omni Architects ©. The reproduction, copying or other use of this Drawing without the written consent of Omni Architects is prohibited.

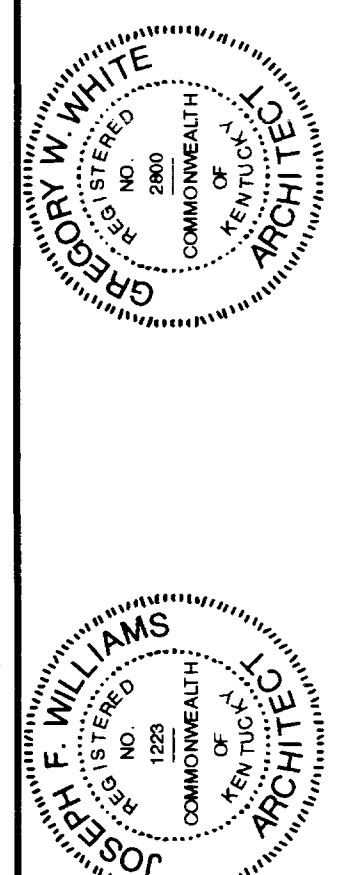

Omni Architects
Architects
Landscape Architecture
Civil Engineering
Planning
Interiors
212 North Upper Street
Lexington, KY 40507
(609) 232-1666 Fax: (609) 233-2358

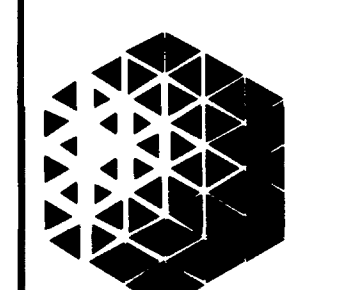

Omni Architects

RECORD DRAWINGS
This drawing is to be used as a guide only. It is not to be used for construction without the written consent of Omni Architects. No responsibility is assumed for any errors or omissions which have been incorporated into this document as a result.
DATE: 8-21-02

A-4.7
43 C-3 21009
Cub # Slot Document # DATE