



See below for typical suite toilet plan

1 TYPICAL SUITE HANDICAP TOILET PLAN
A-5.1 1/4" = 1'-0"

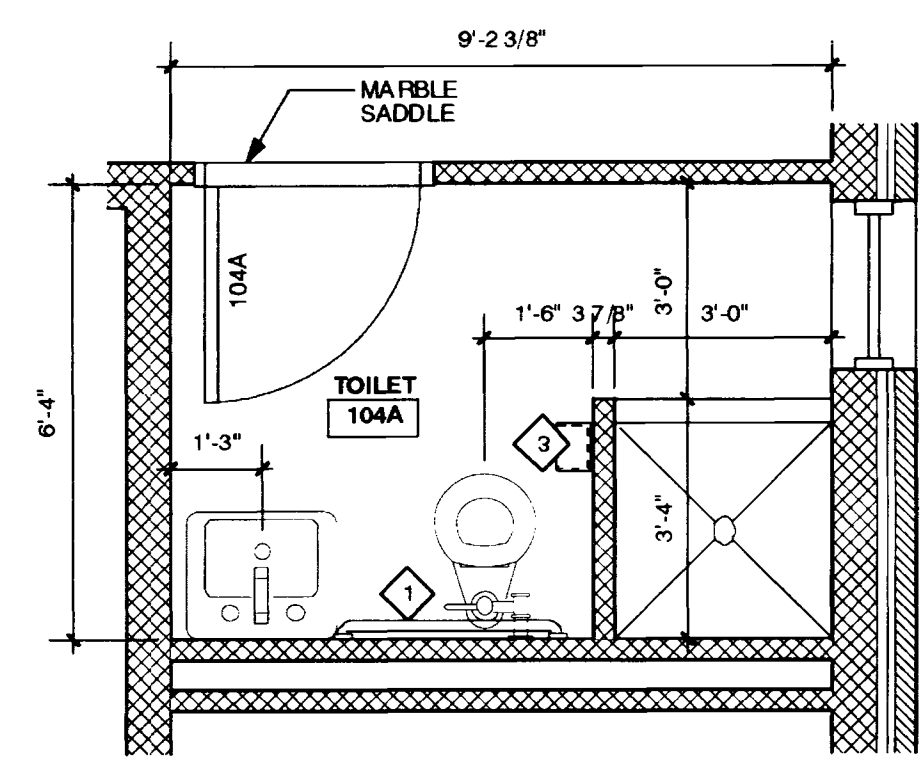


2 PLAN @ ROOM 104A (Building 0505)
A-5.1 1/4" = 1'-0"

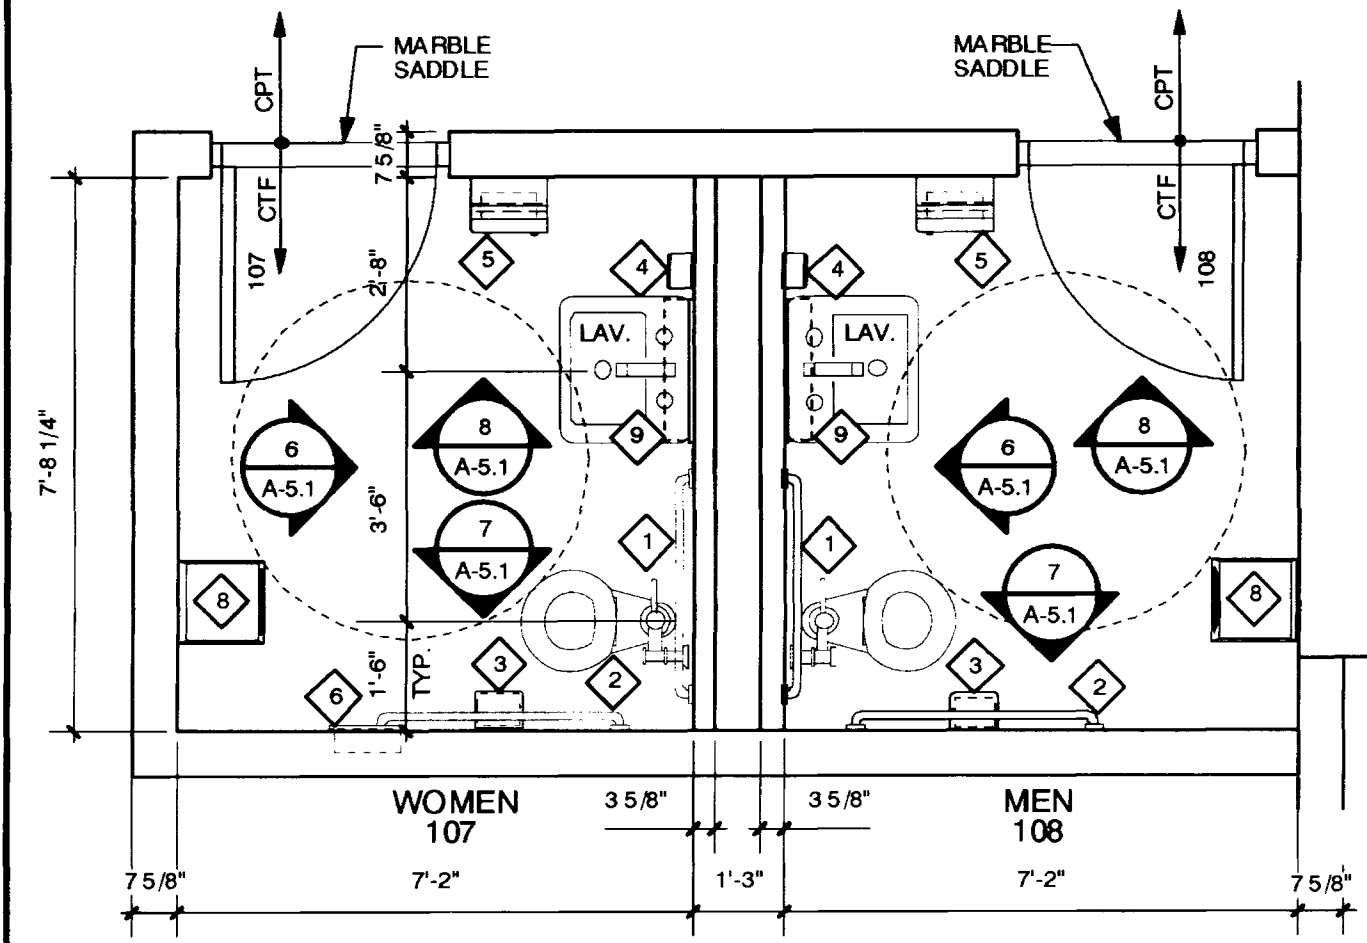

PUBLIC TOILET ROOMS

3 PLAN @ WOMEN 107 / MEN 108 (Building 0504)
A-5.1 1/4" = 1'-0"

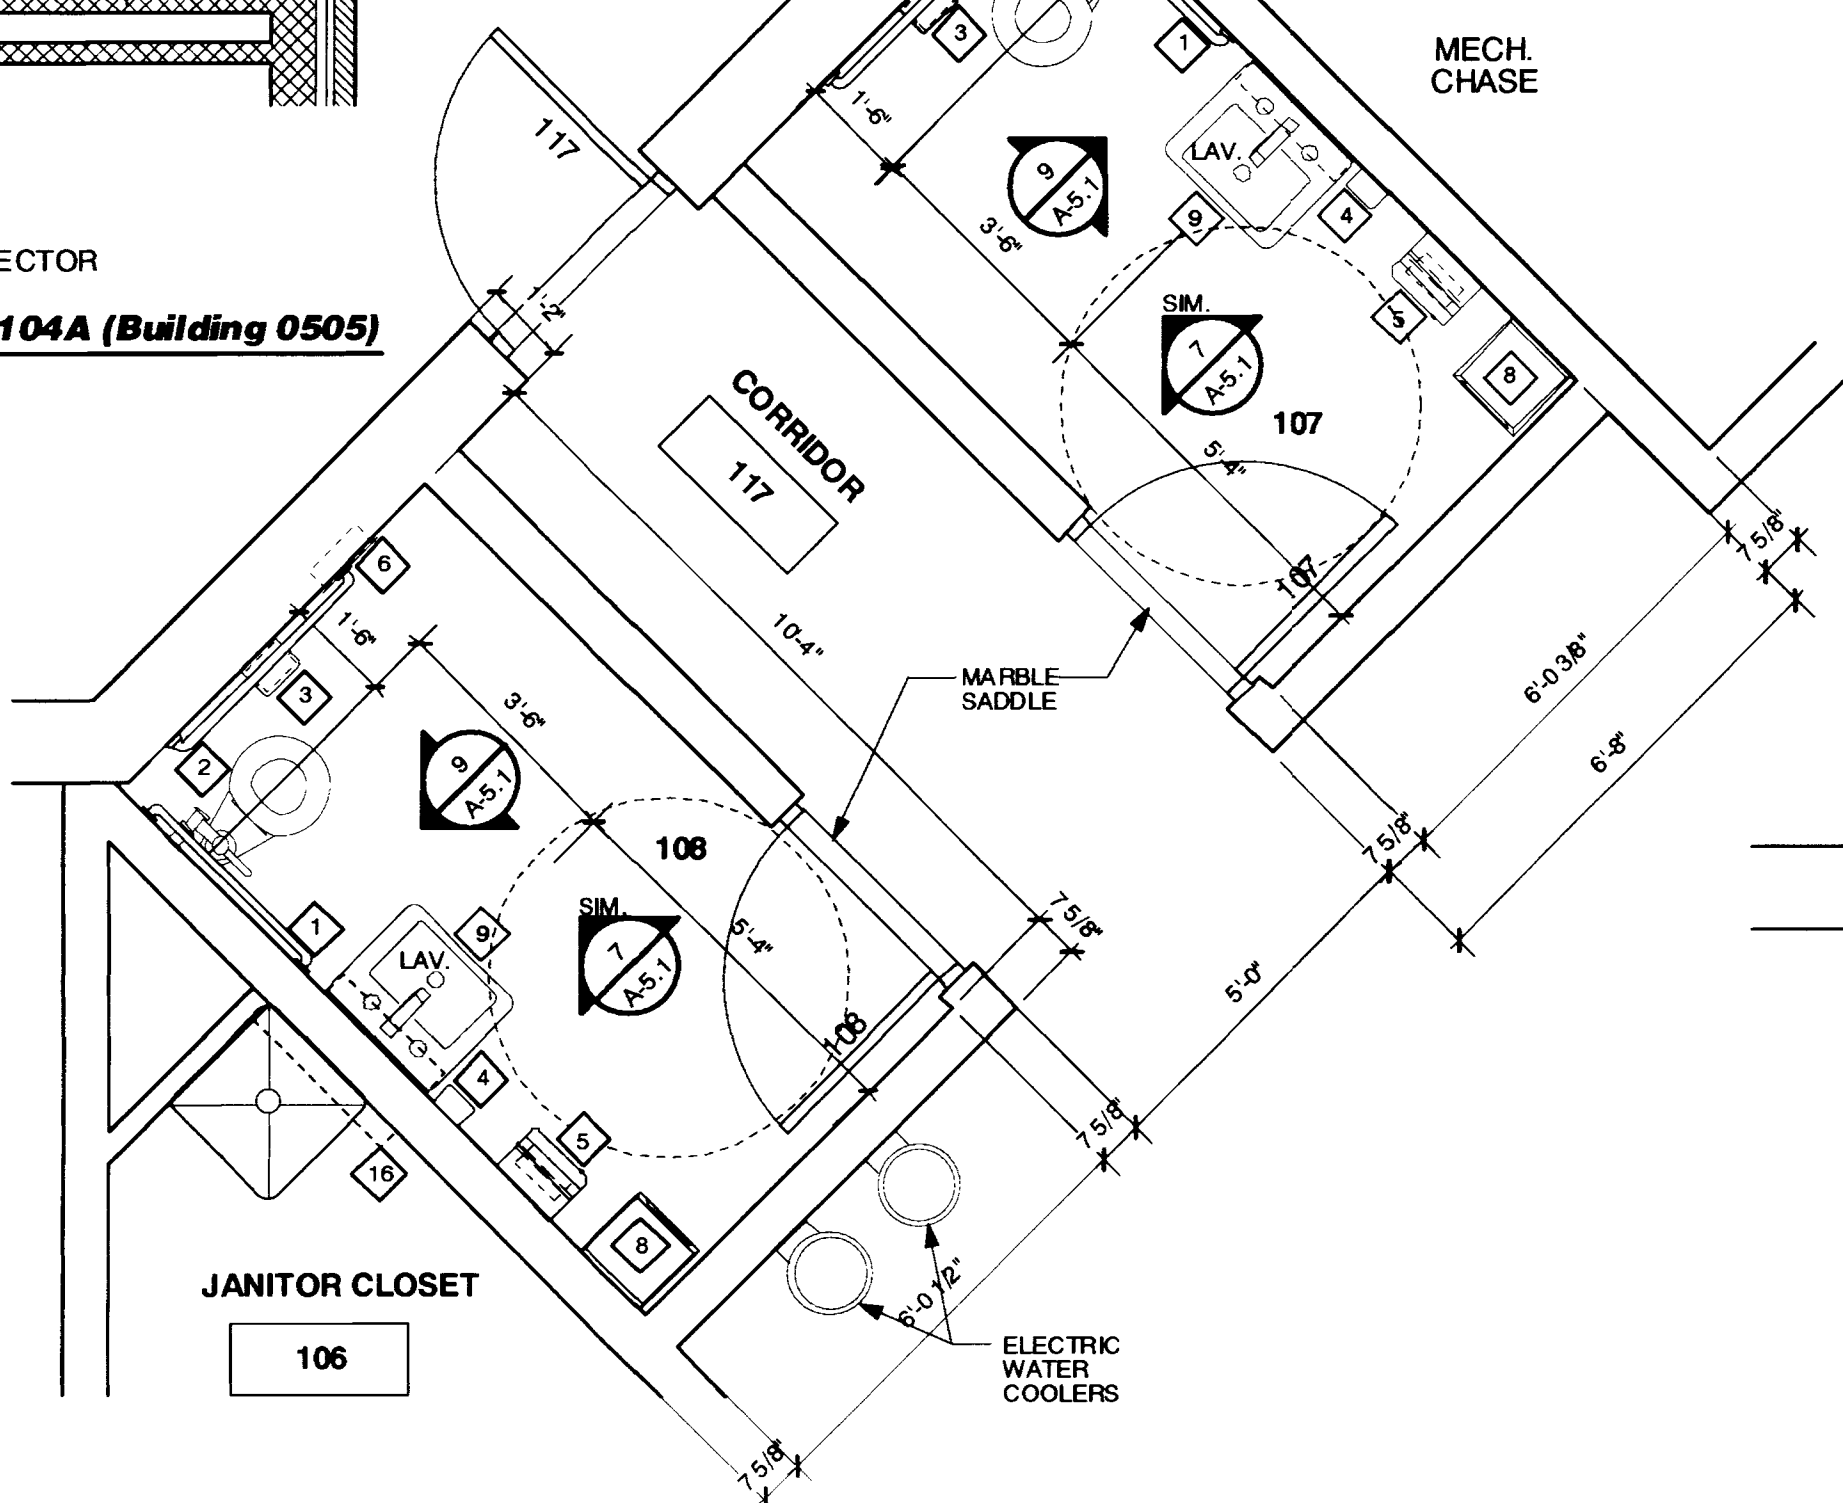


RESIDENCE HALL DIRECTOR


4 PLAN @ WOMEN 107 / MEN 108 (Building 0505)
A-5.1 3/8" = 1'-0"

5 PLAN @ SUITE 206 (Building 0505)
A-5.1 3/8" = 1'-0"


6 ELEVATION @ WOMEN'S 107 / MEN'S 108 (SIM.) BLDG. 0504
A-5.1 3/8" = 1'-0"

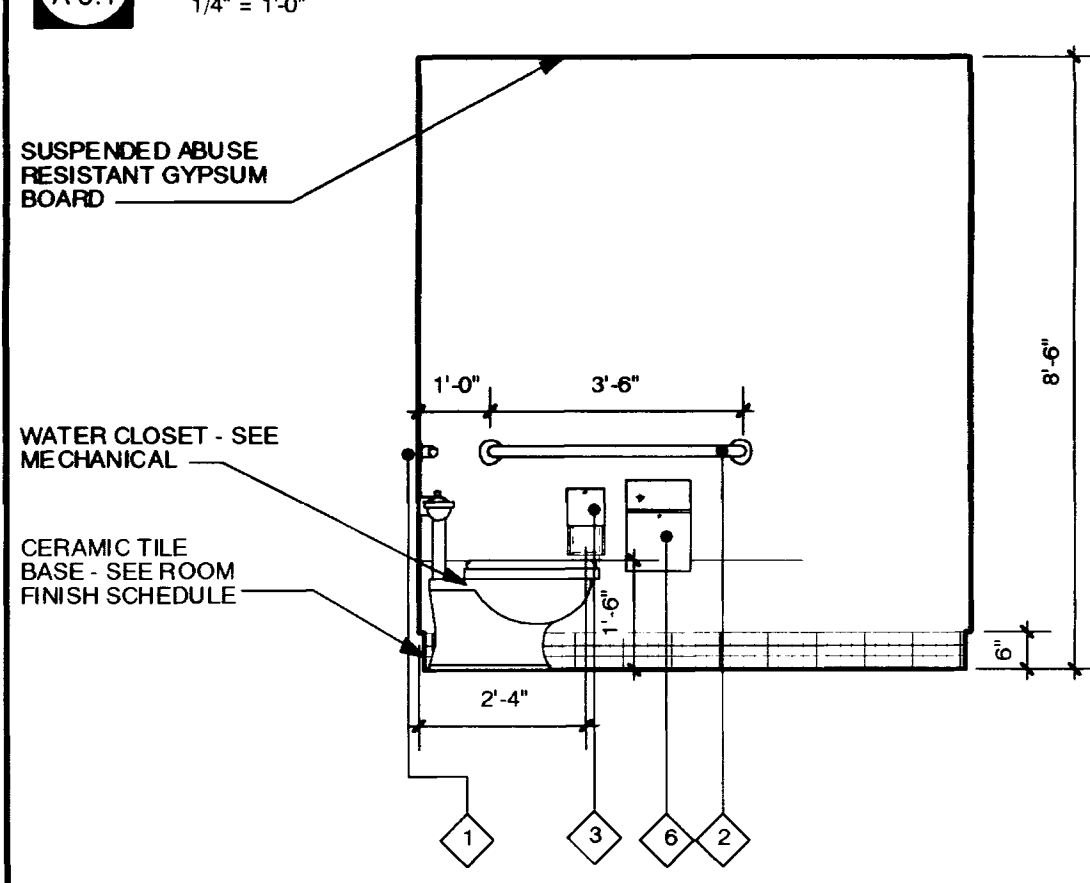


7 ELEVATION @ WOMEN'S 107 / MEN'S 108 (SIM.)
A-5.1 3/8" = 1'-0"

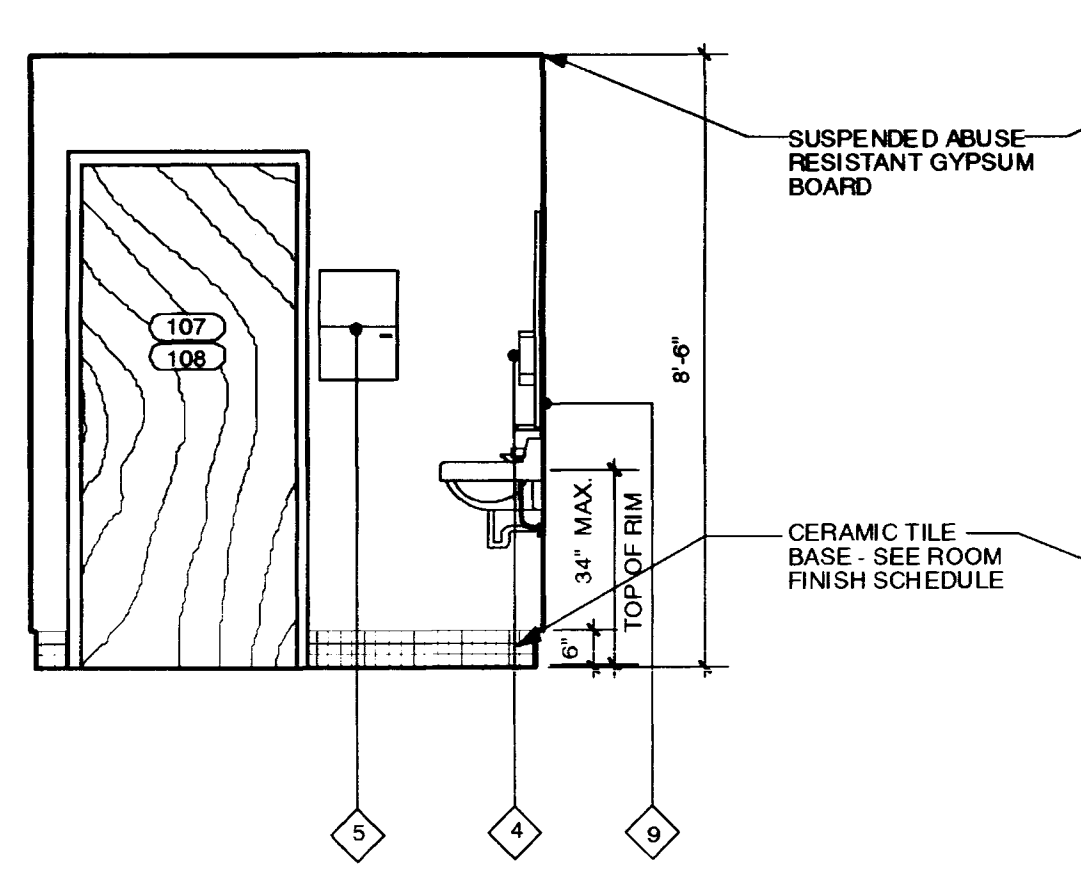


8 ELEVATION @ WOMEN'S 107 / MEN'S 108 (SIM.)
A-5.1 3/8" = 1'-0"

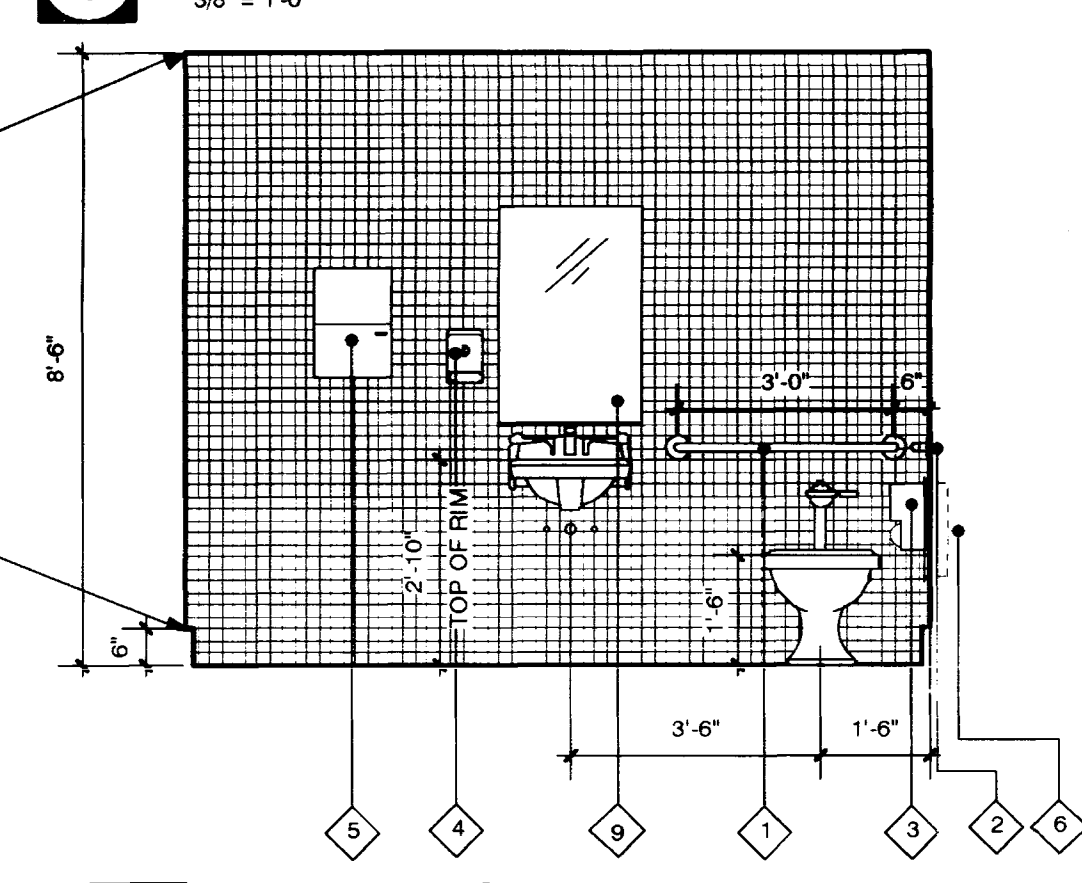


9 ELEVATION @ WOMEN'S 107 / MEN'S 108 (SIM.) BLDG. 0505
A-5.1 3/8" = 1'-0"

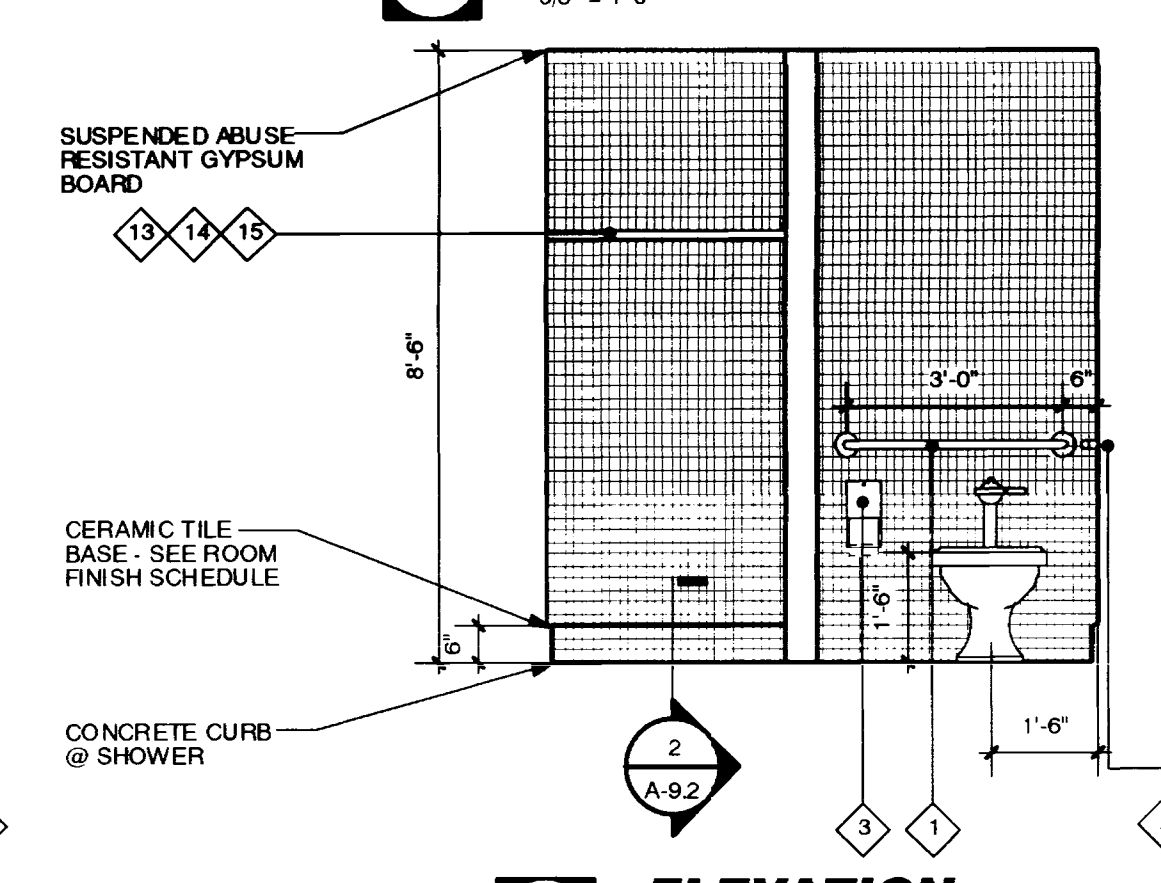



10 ELEVATION
A-5.1 3/8" = 1'-0"

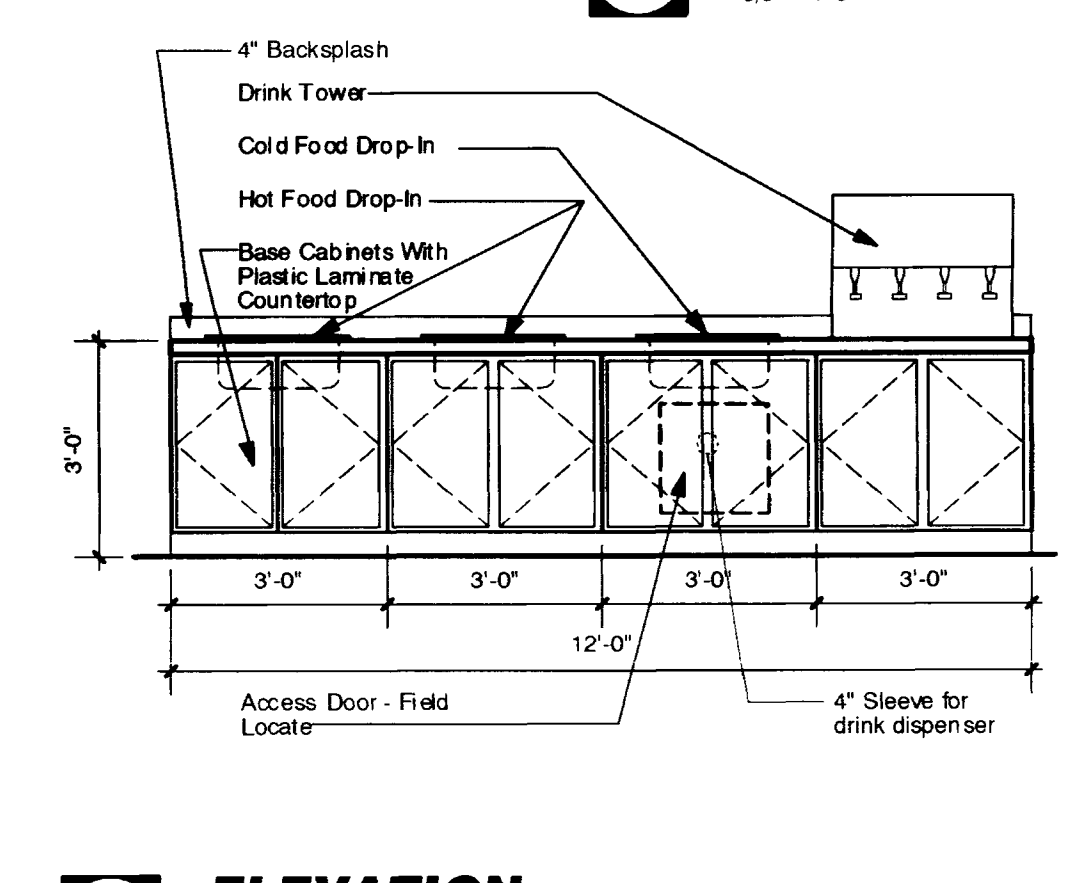


12 ELEVATION
A-5.1 3/8" = 1'-0"

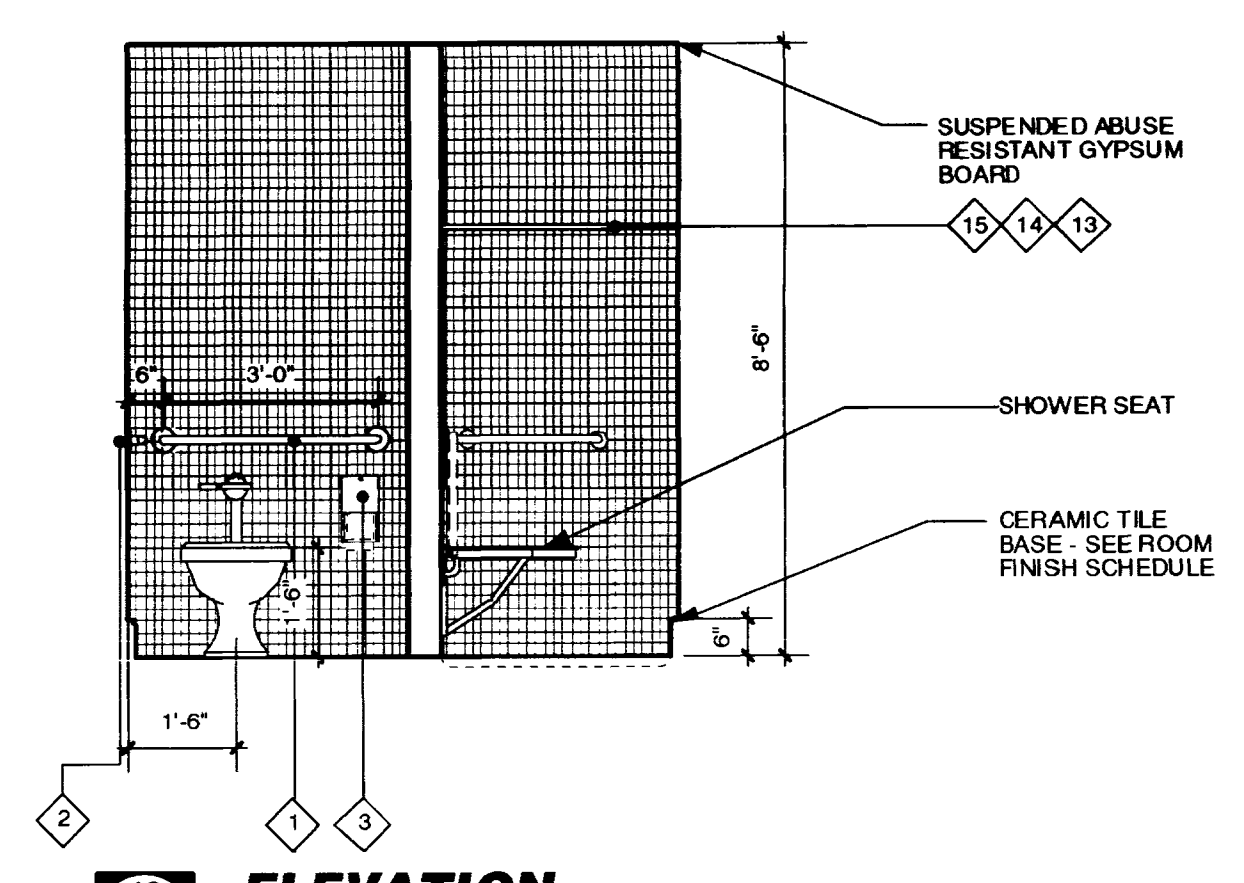


13 ELEVATION
A-5.1 3/8" = 1'-0"

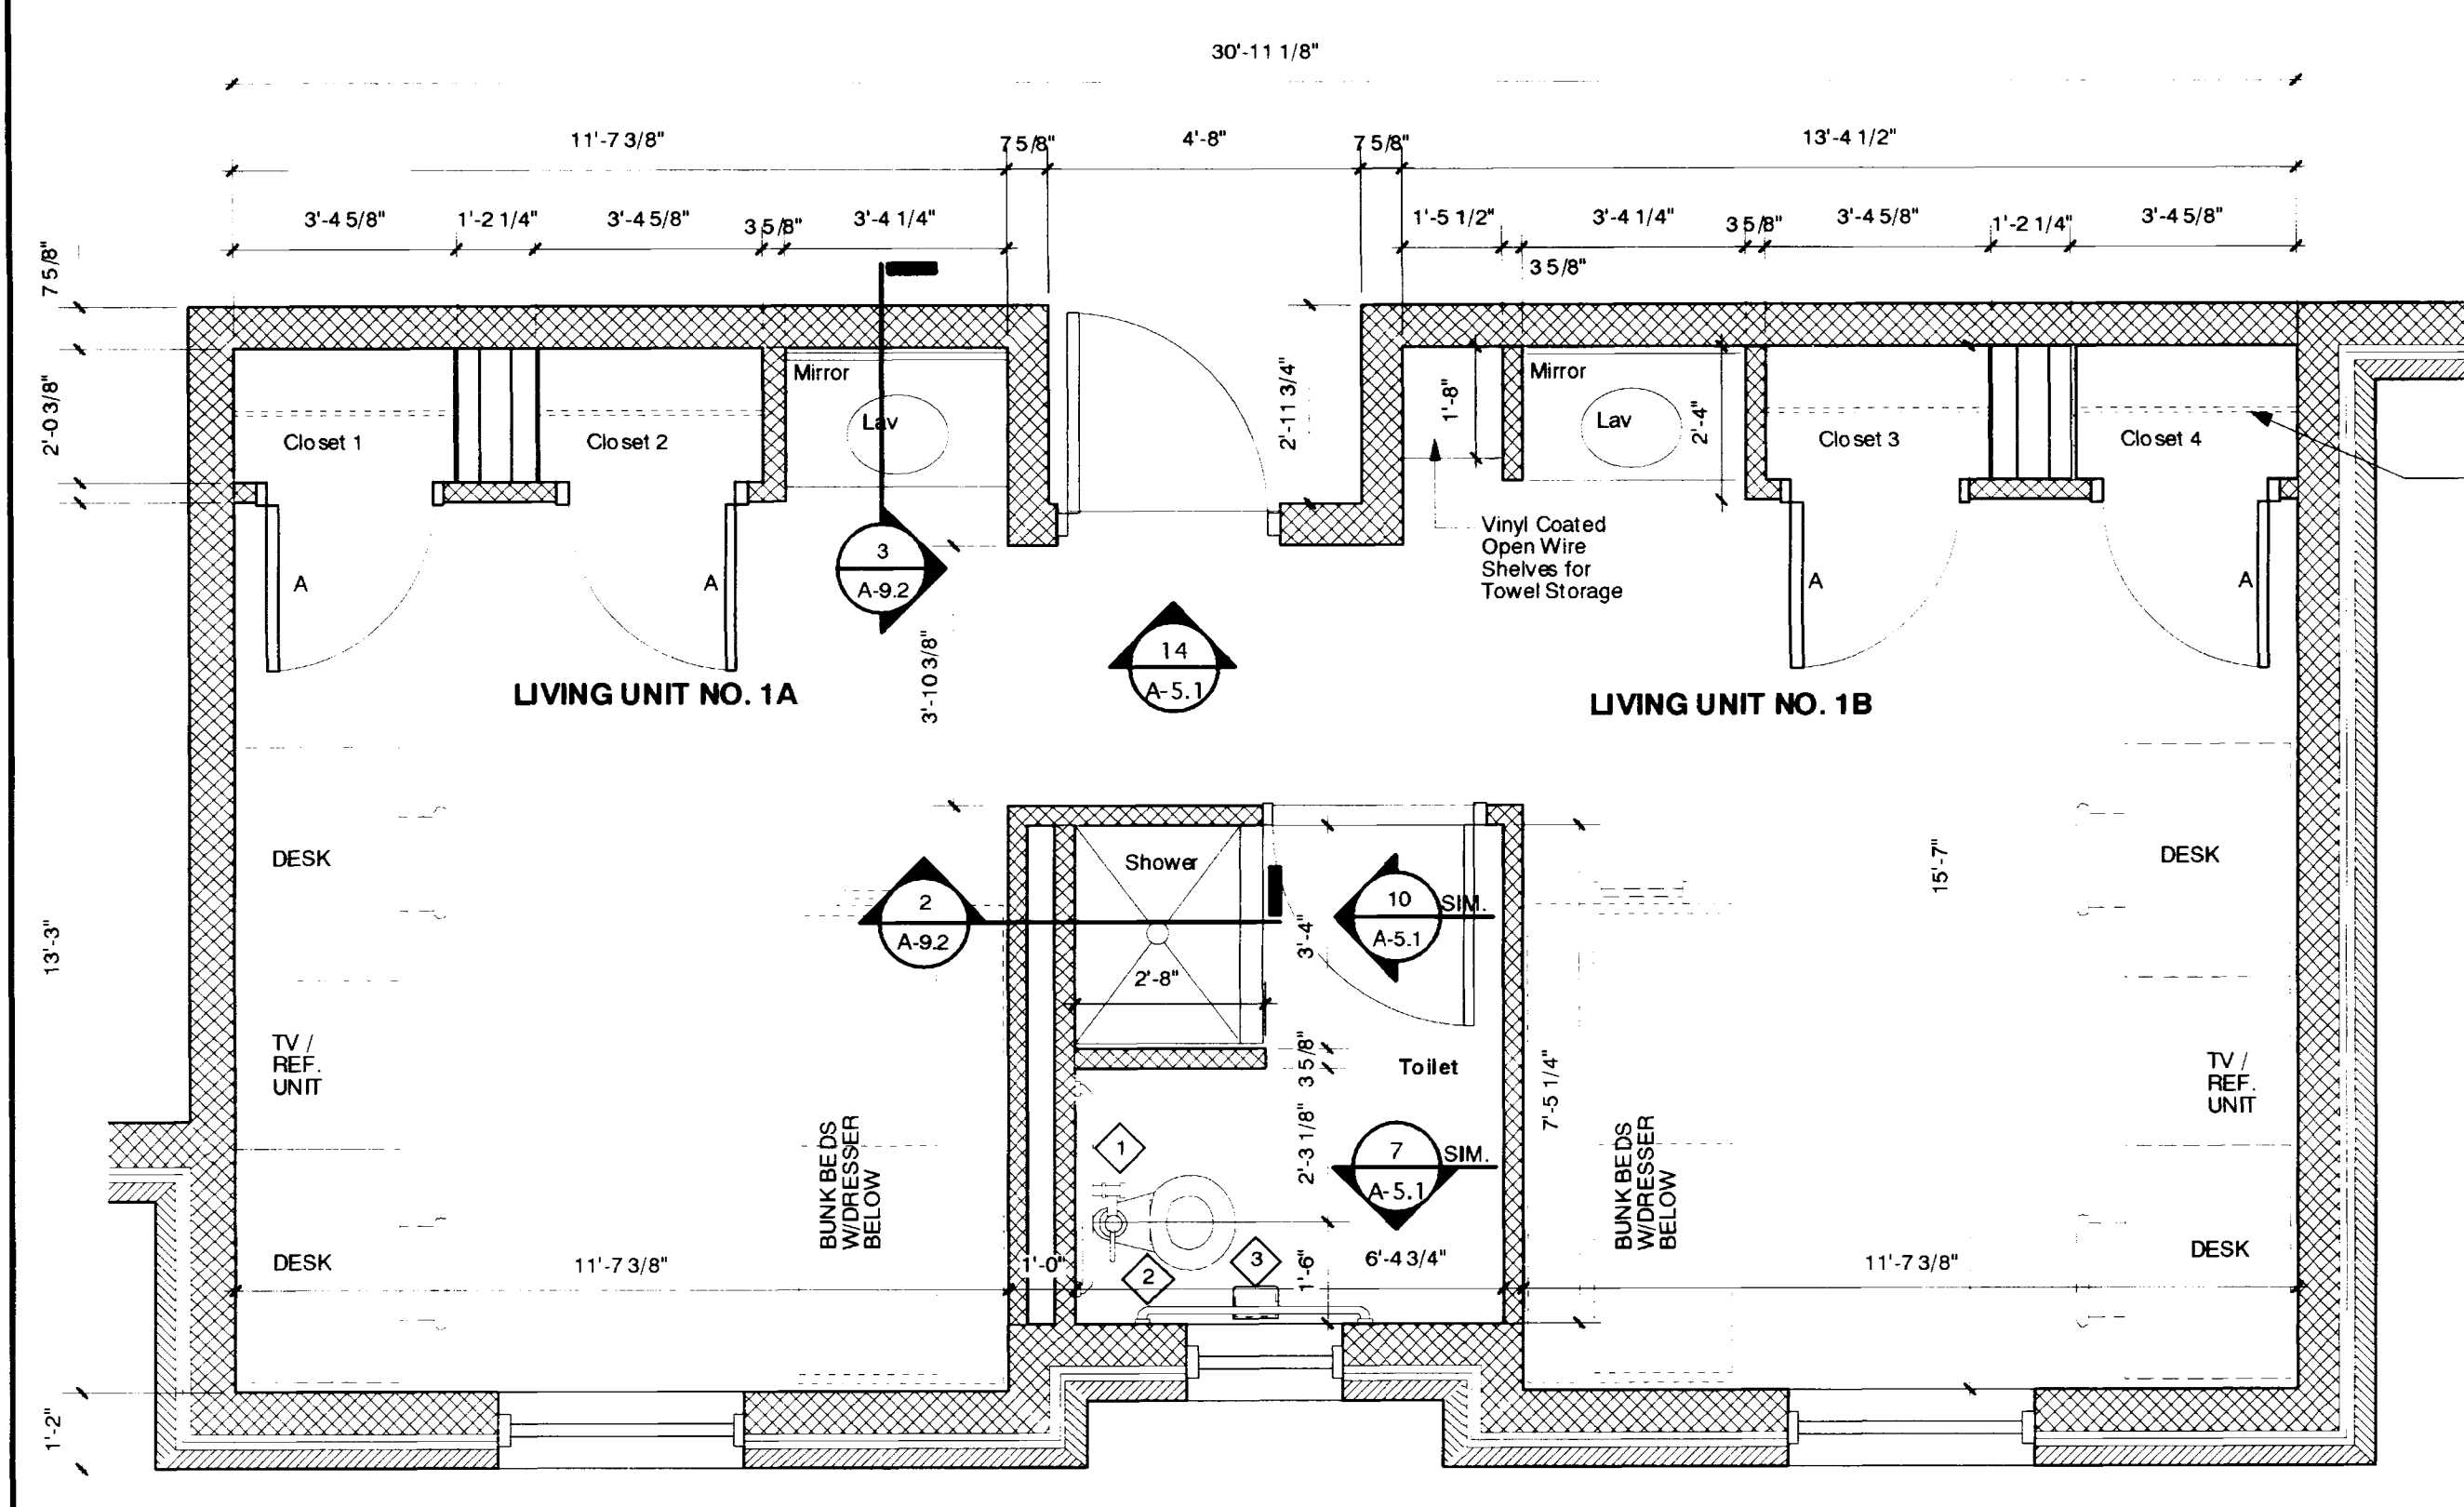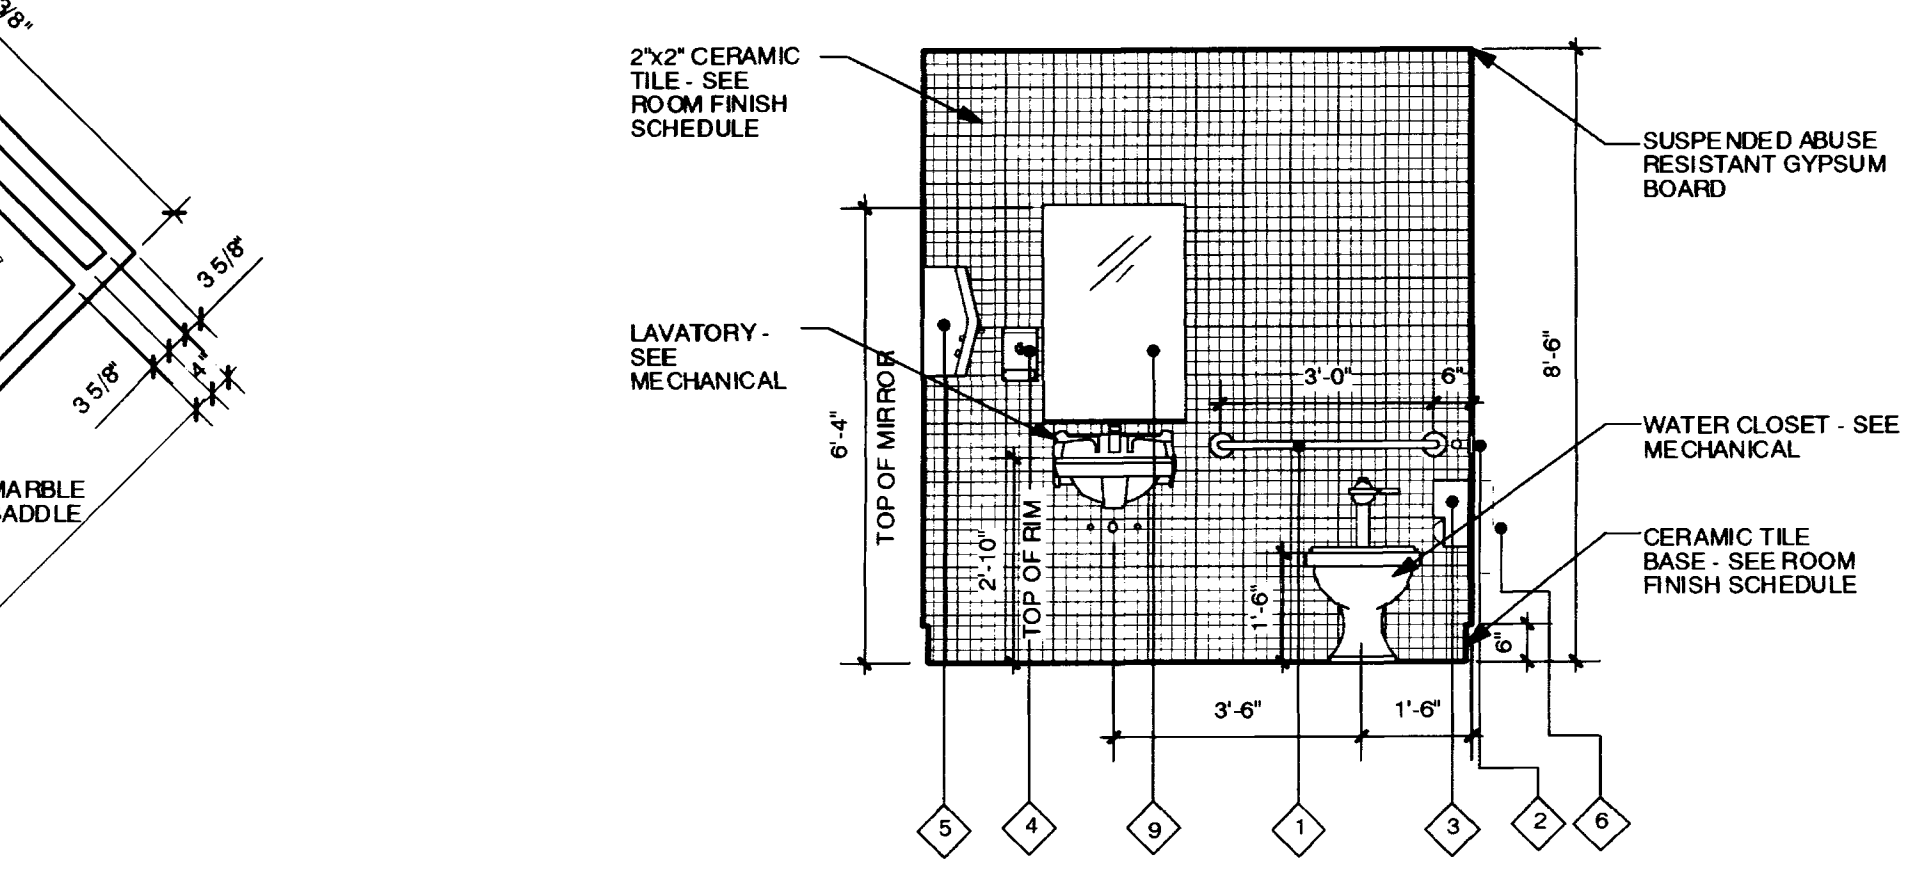

11 TYPICAL SUITE PLAN - Buildings 0504 and 0505
A-5.1 3/8" = 1'-0"

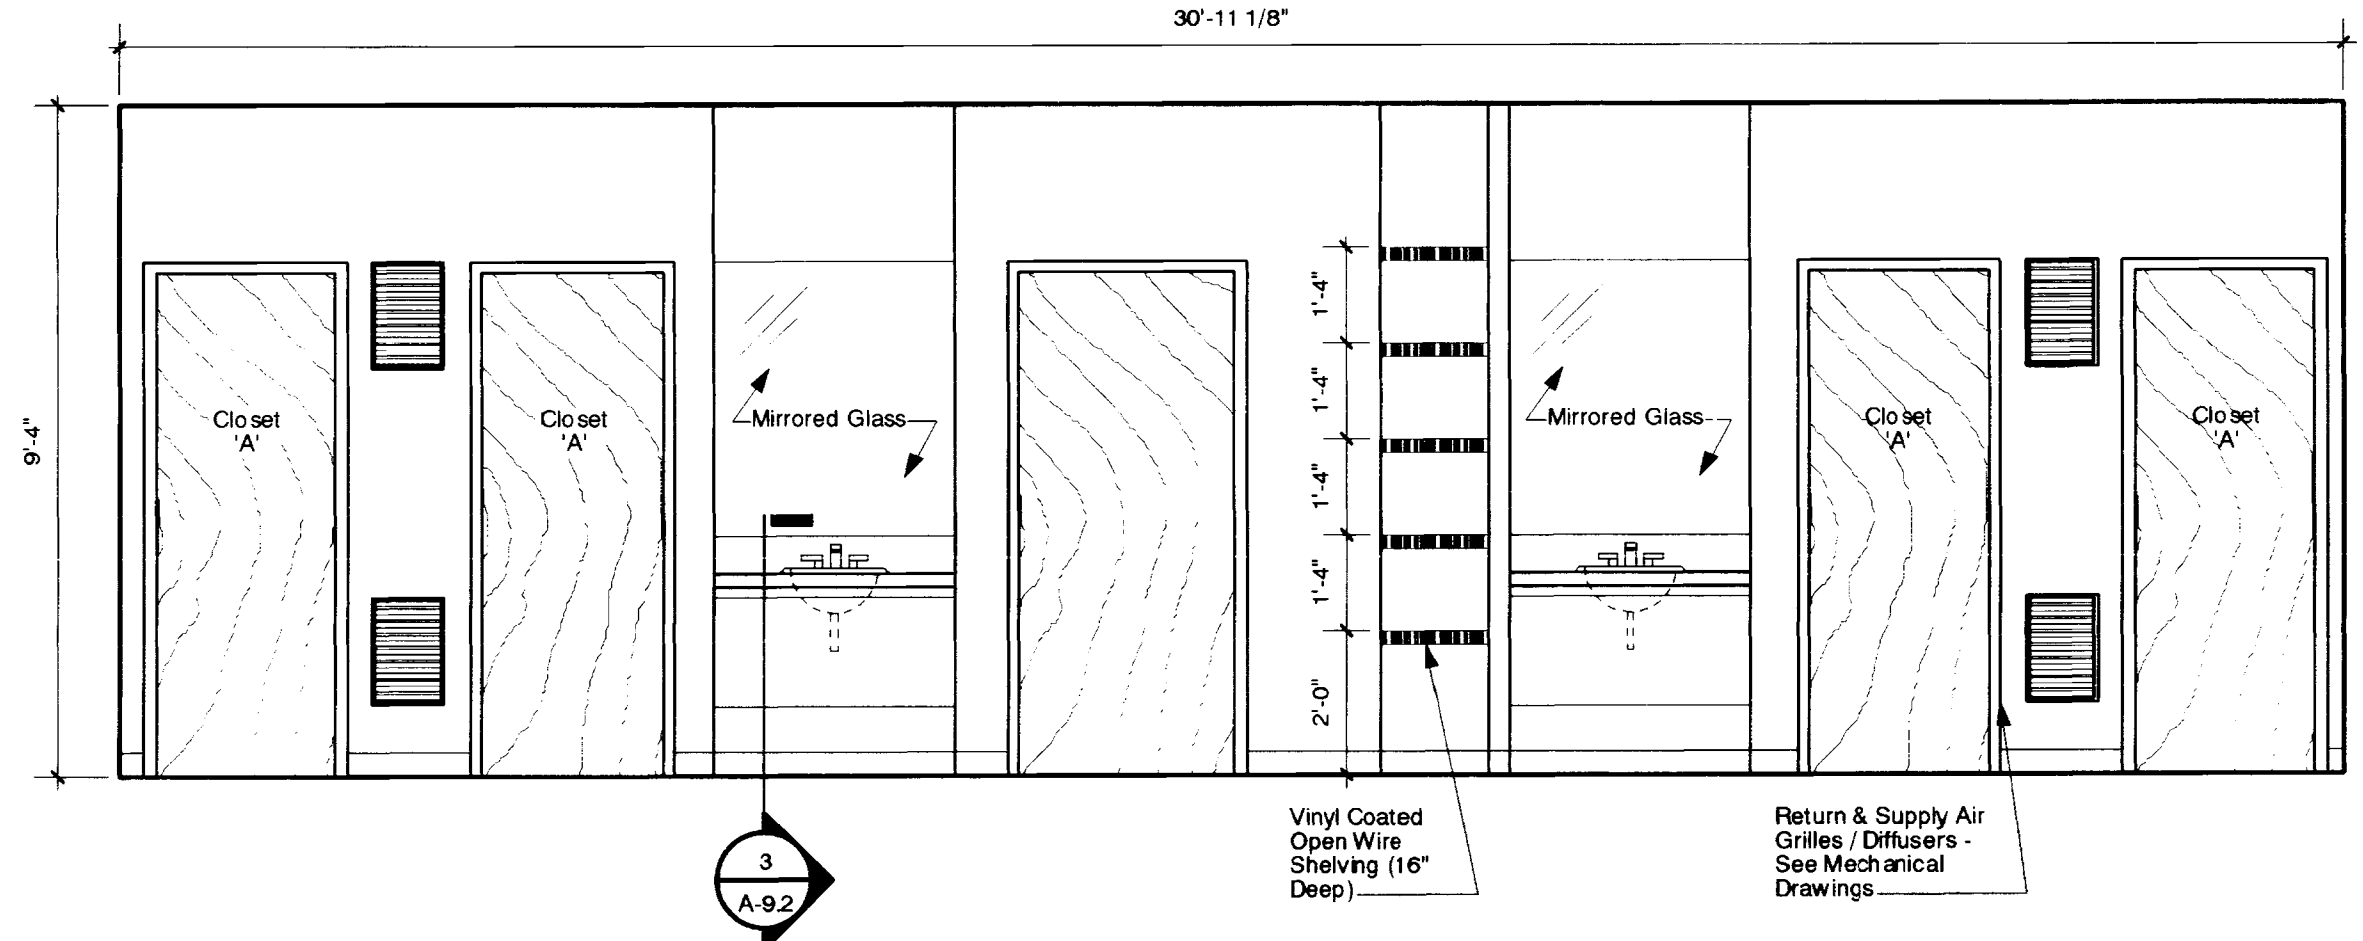

14 ELEVATION
A-5.1 3/8" = 1'-0"

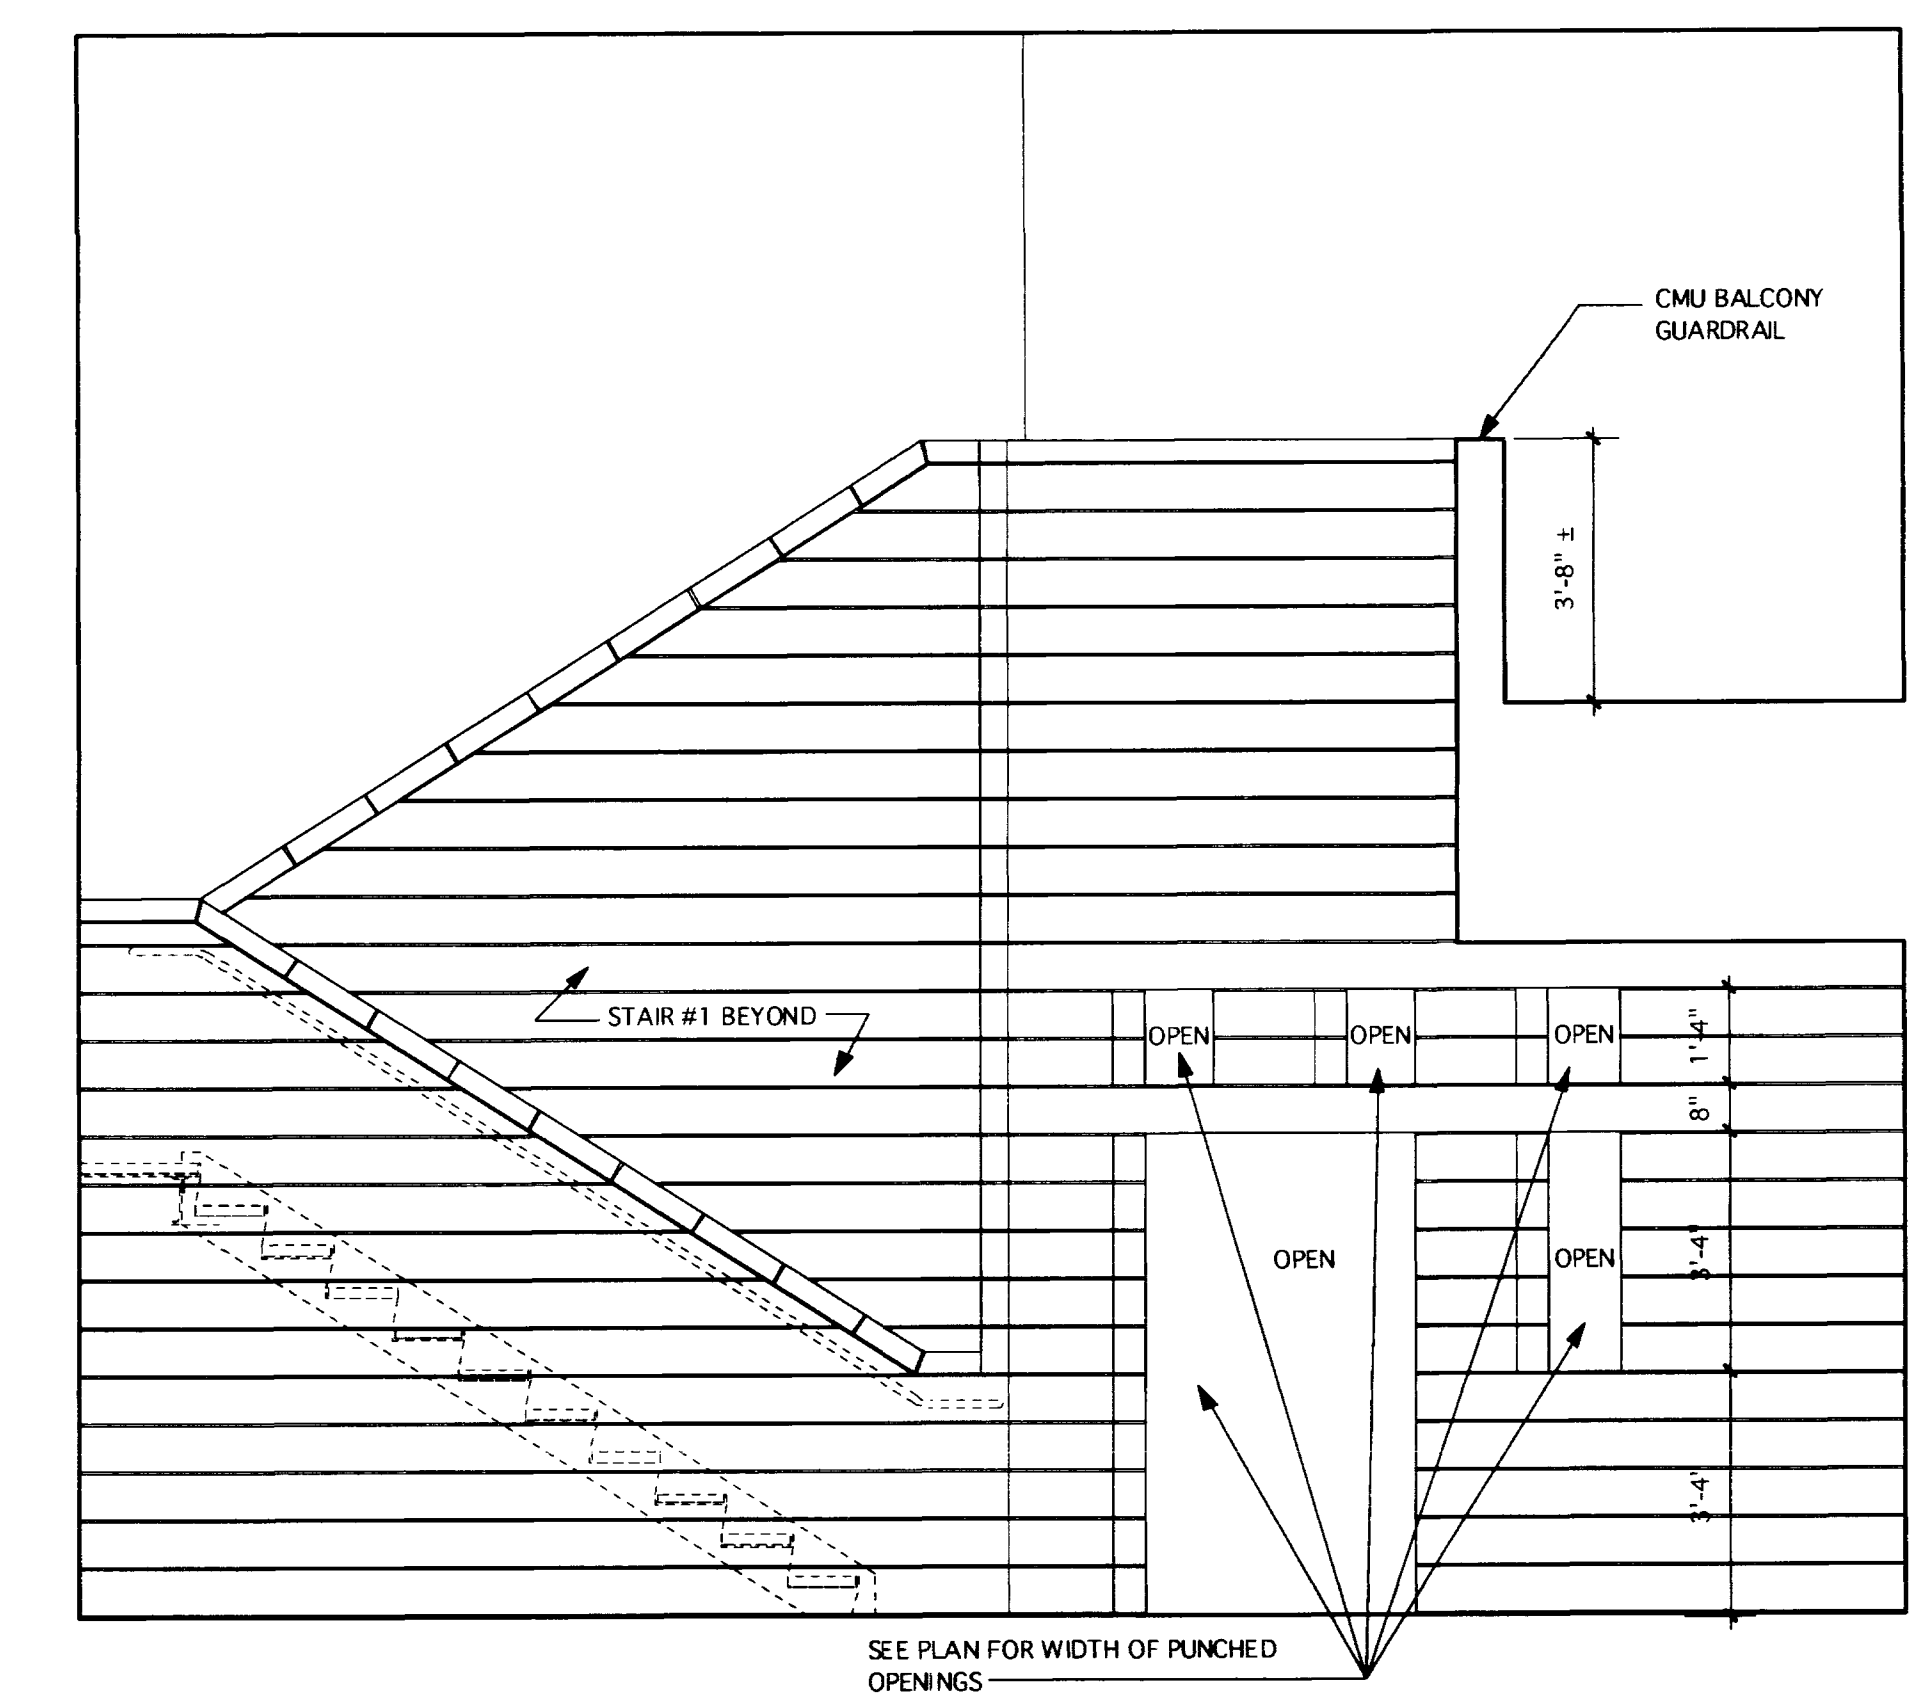

14 ELEVATION
A-5.1 3/8" = 1'-0"

#	ITEM	MFR.	MODEL	MOUNTING HEIGHT	REMARKS
1	36" GRAB BAR	BOBRICK	B6206X36	CL @ 34"	
2	42" GRAB BAR	BOBRICK	B6206X42	CL @ 34"	
3	TOILET PAPER HOLDER	BOBRICK	B-2740	CL @ 2'-10"	
4	SOAP DISPENSER	BY OWNER	-	-	N.I.C. (OFO)
5	PAPER TOWEL DISPENSER	BY OWNER	-	-	N.I.C. (OFO)
6	SANITARY NAPKIN DISPOSAL	BY OWNER	-	-	N.I.C. (OFO)
7	SANITARY NAPKIN VENDOR	BY OWNER	-	-	N.I.C. (OFO)
8	TRASH CAN	BY OWNER	-	-	N.I.C. (OFO)
9	24"x36" MIRROR W/SHELF	BOBRICK	B-166 2436	BOTTOM @ 3'-4"	
10	TOWEL BAR	BOBRICK	B-6737X24	LOWER CL @ 2'-6" / UPPER CL @ 5'-0"	
11	HOOK & BUMPER	BOBRICK	B-212	CL @ 5'-0"	
12	SHOWER SEAT	BOBRICK	B-517	TOP OF SEAT @ 1'-6"	B-518 (LEFT HANDED)
13	SHOWER CURTAIN ROD	BOBRICK	B-207	CL @ 6'-0"	
14	SHOWER CURTAIN RINGS	BOBRICK	B-204-1	NA	
15	SHOWER CURTAIN	BOBRICK	B-204-2	NA	
16	MOP & BROOM HOLDER / SHELF	BOBRICK	B-239X34	TOP OF SHELF @ 5'-0"	

***GENERAL NOTES:**
- CAULK PERIMETER OF ALL FIXTURES.
- SEE ACCESSORY SCHEDULE FOR ALL MOUNTING HEIGHTS.

Architectural Recordings
These record drawings have been prepared in part on the basis of the information provided by the client. The architect assumes no responsibility for the accuracy of the information provided by the client. The client is responsible for the accuracy of the information provided.

Architect: Omni Architects
112 North Upson Street
Lexington, KY 40502
(606) 252-9864 Fax: (606) 253-2398

Checked: JWG/WHW
Drawn By: JTB
Date: August 2000

Project: Fraternity House Replacement - Project 1747.0
Sheet: A-5.1
Scale: 3/8" = 1'-0"