



REFER TO SHEET A-0.1 FOR LEGEND OF
FIXTURE SYMBOLS
*FIELD VERIFY ALL ACCESS DOOR
LOCATIONS

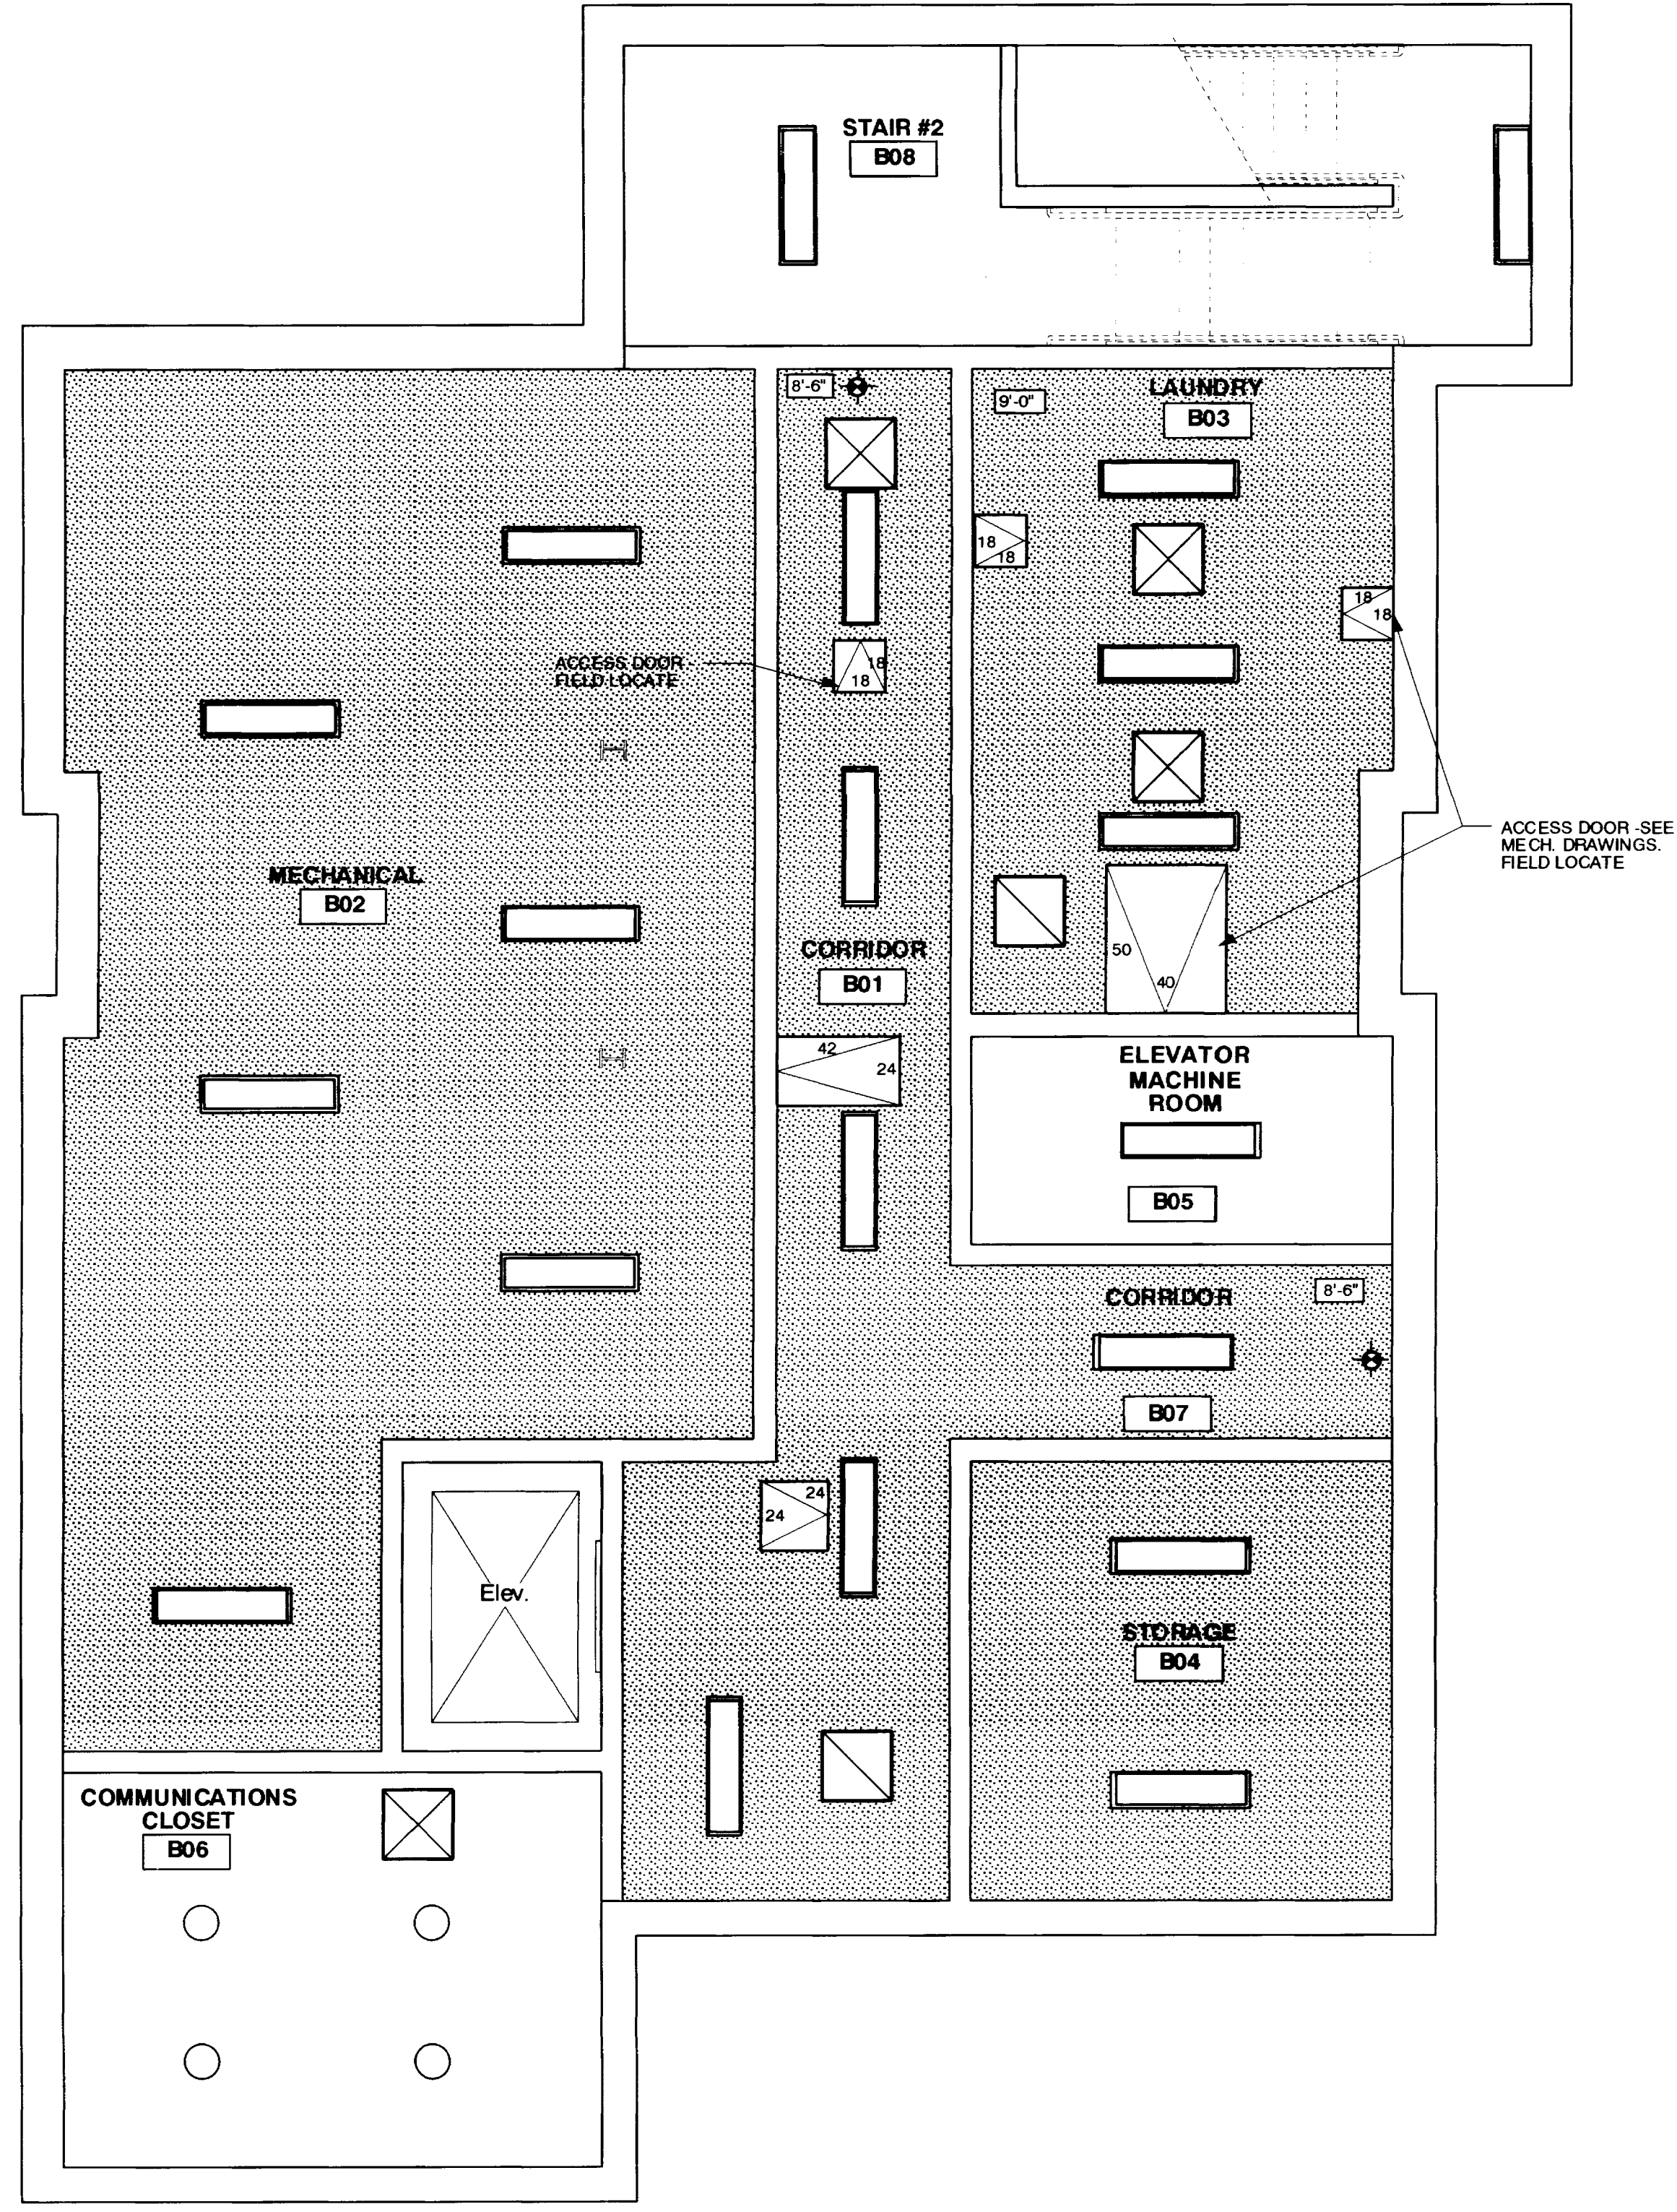

BASEMENT PLAN - Building 0504
1/4" = 1'-0"

RECORD DRAWINGS
These record drawings have been prepared, in accordance with the contract documents, and submitted to the client for their review and approval. The Architect will not be responsible for any errors or omissions in these drawings unless they have been specifically noted in writing on this document as a result of the Architect's review.
DATE: 6-21-02
Architect: _____

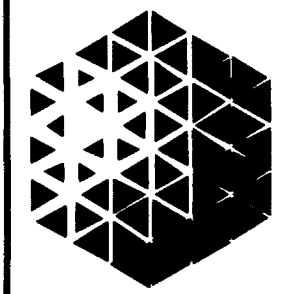

Architecture
Civil/Structural
Mechanical
Planning
212 North Upper Street
Lexington, KY 40502
(606) 252-8604 Fax: (606) 253-2039

