


SECOND FLOOR REFLECTED CEILING PLAN - Building 0505
1/4" = 1'-0"



REFER TO SHEET A-6.1 FOR LEGEND OF
FIXTURE SYMBOLS
*FIELD VERIFY ALL ACCESS DOOR
LOCATIONS

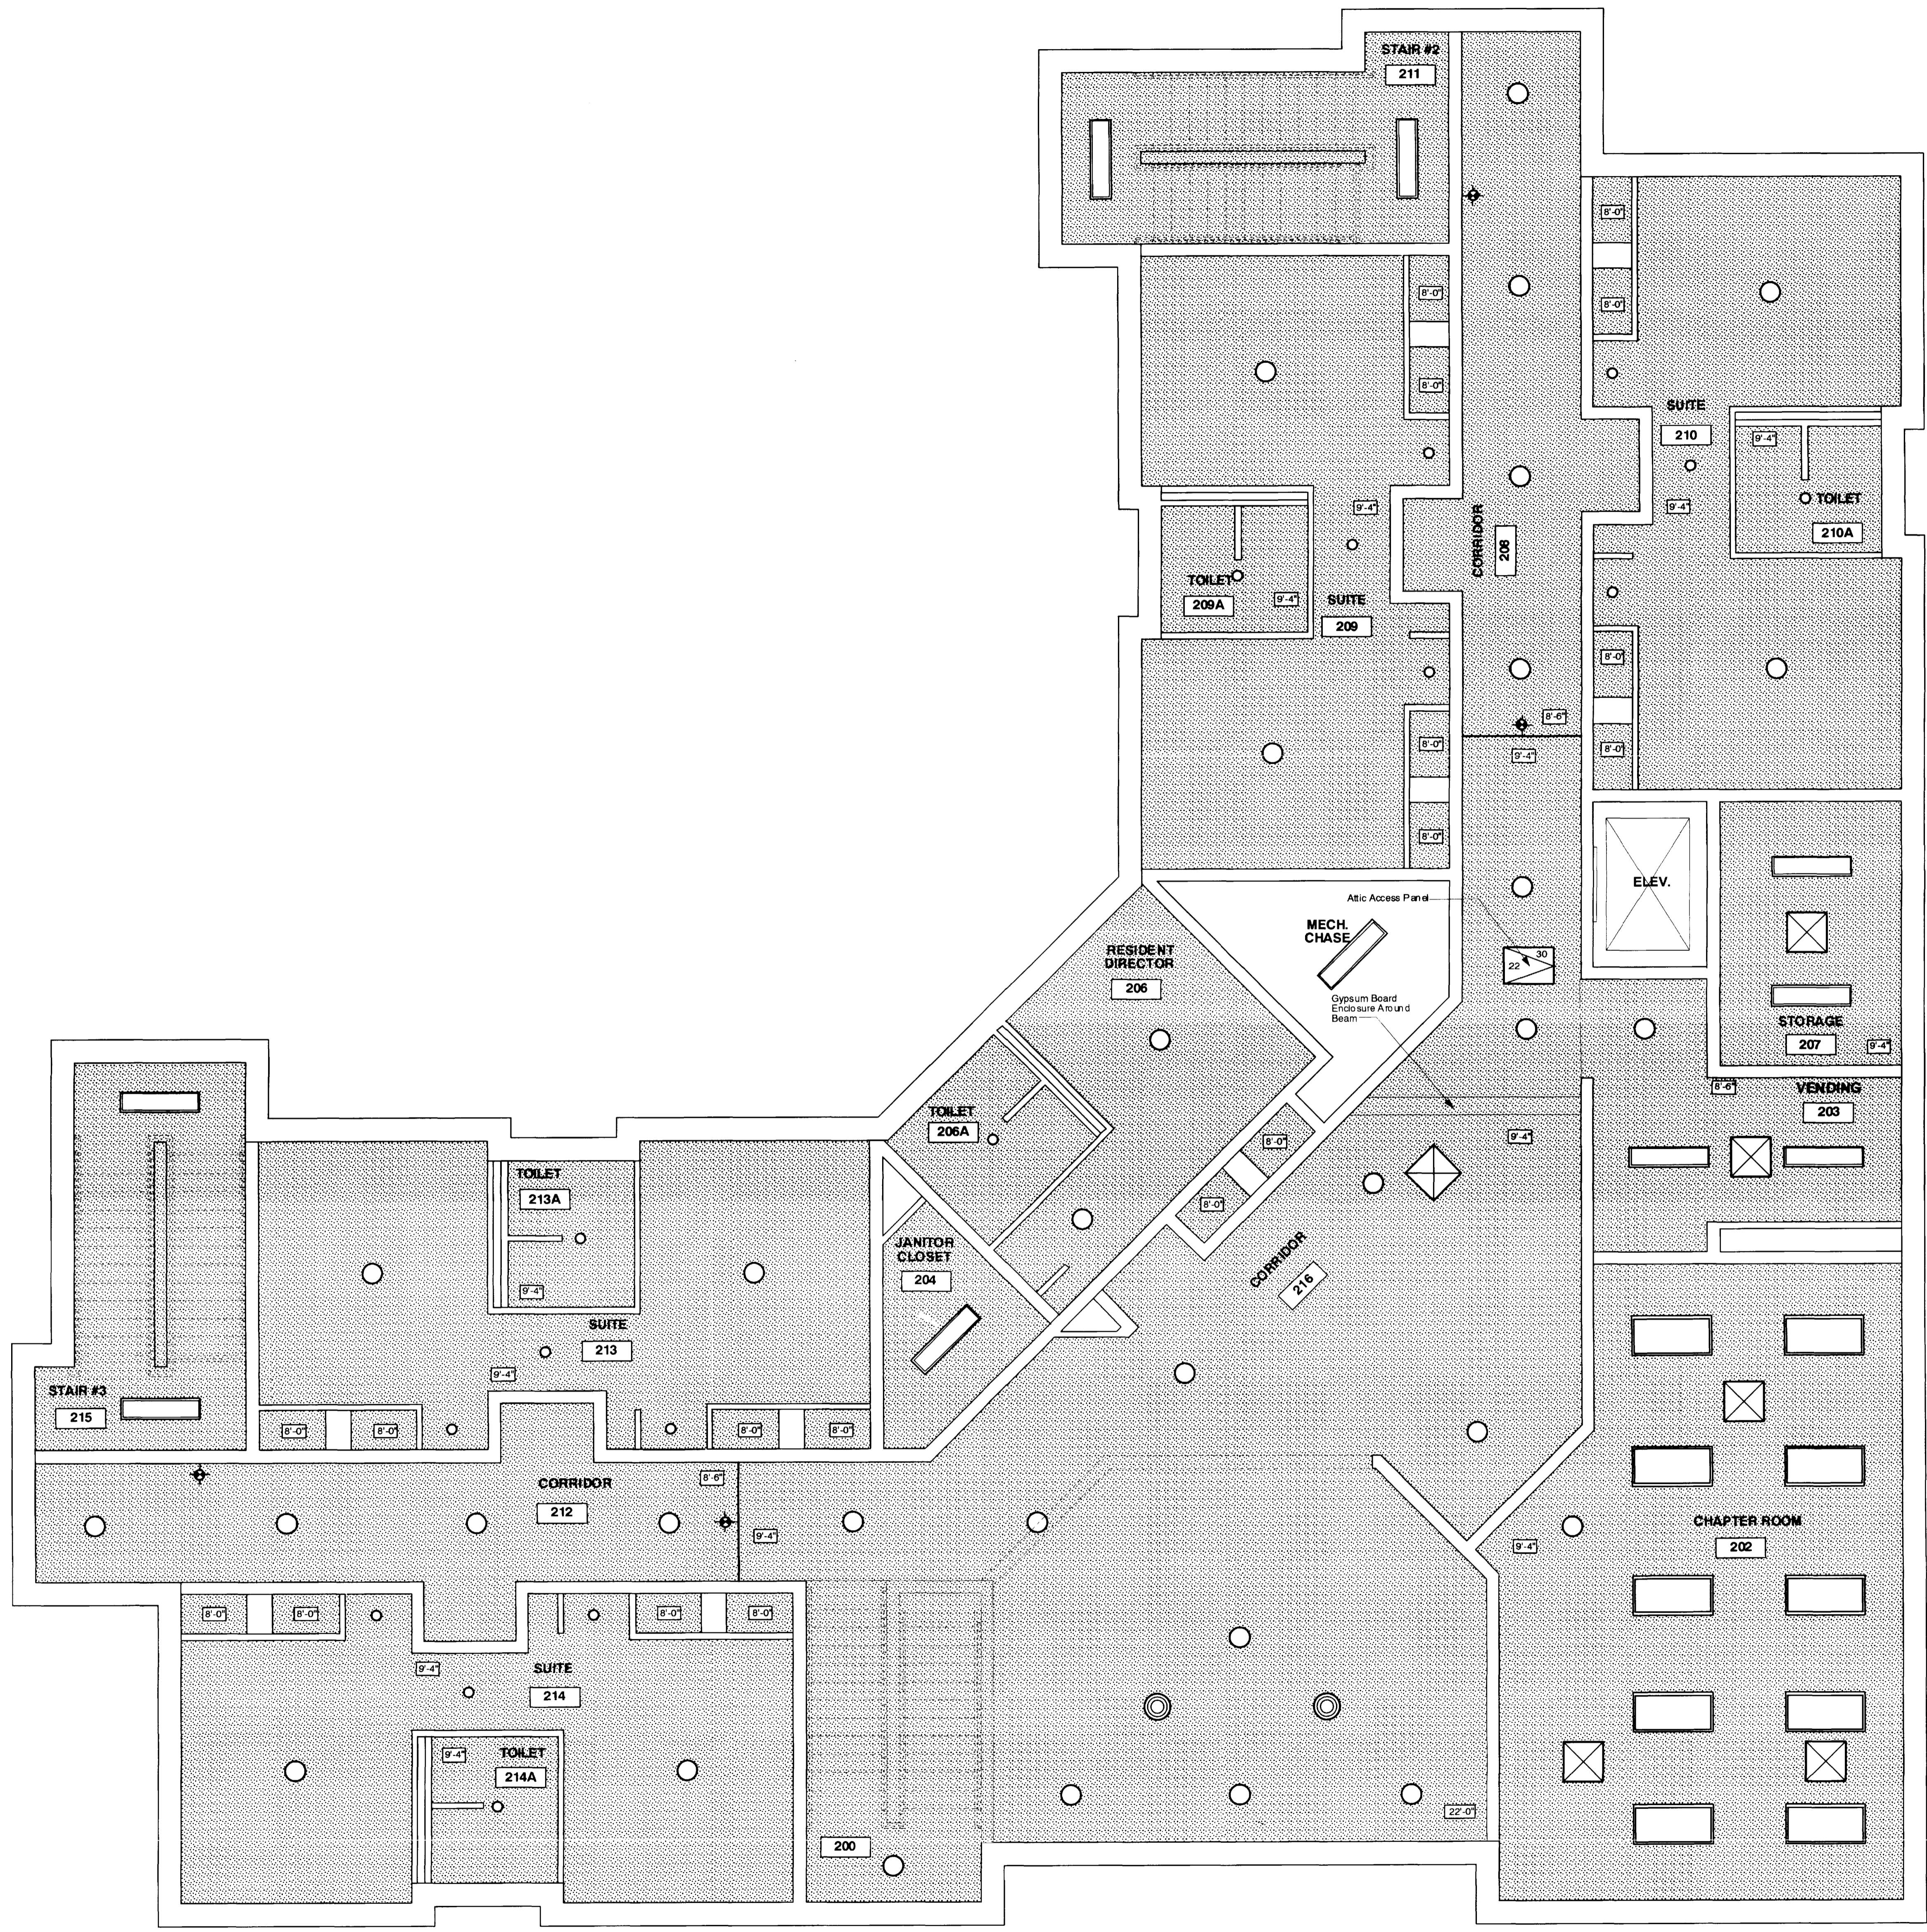

FRATERNITY HOUSE REPLACEMENT - PROJECT 1747.0

UNIVERSITY OF KENTUCKY

LEXINGTON, KENTUCKY

SECOND FLOOR REFLECTED CEILING PLAN - BUILDING 0505

This Drawing and Design shall be used as the property of Omni Architects, Inc. The reproduction, copying or other use of this Drawing without the written consent of Omni Architects is prohibited.

RECORD DRAWINGS
These record drawings have been prepared, in
accordance with the contract documents, and
submitted to the University of Kentucky for
approval. The Architect will not be held
responsible for any errors or omissions that
may be incorporated into the documents as a result
of the University's review.
Omni Architects
6-21-02
DATE

A-6.6
Cab # Slot Document #
43 C-1 21019



Architectural, Mechanical,
Civil Engineering
Interior Design
210 North Upper Street
Lexington, KY 40507
(606) 252-6864 Fax (606) 253-7268

