

SCALE  $\frac{3}{16}'' = 1'$



FOUNDATION PLAN  
 HALL OF  
 NATURAL HISTORY  
 KENTUCKY STATE COLLEGE  
 LEXINGTON KY  
 BY F.P. ANDERSON

T.S. HAMILTON, DEL.

50

Doc # 012809

012810

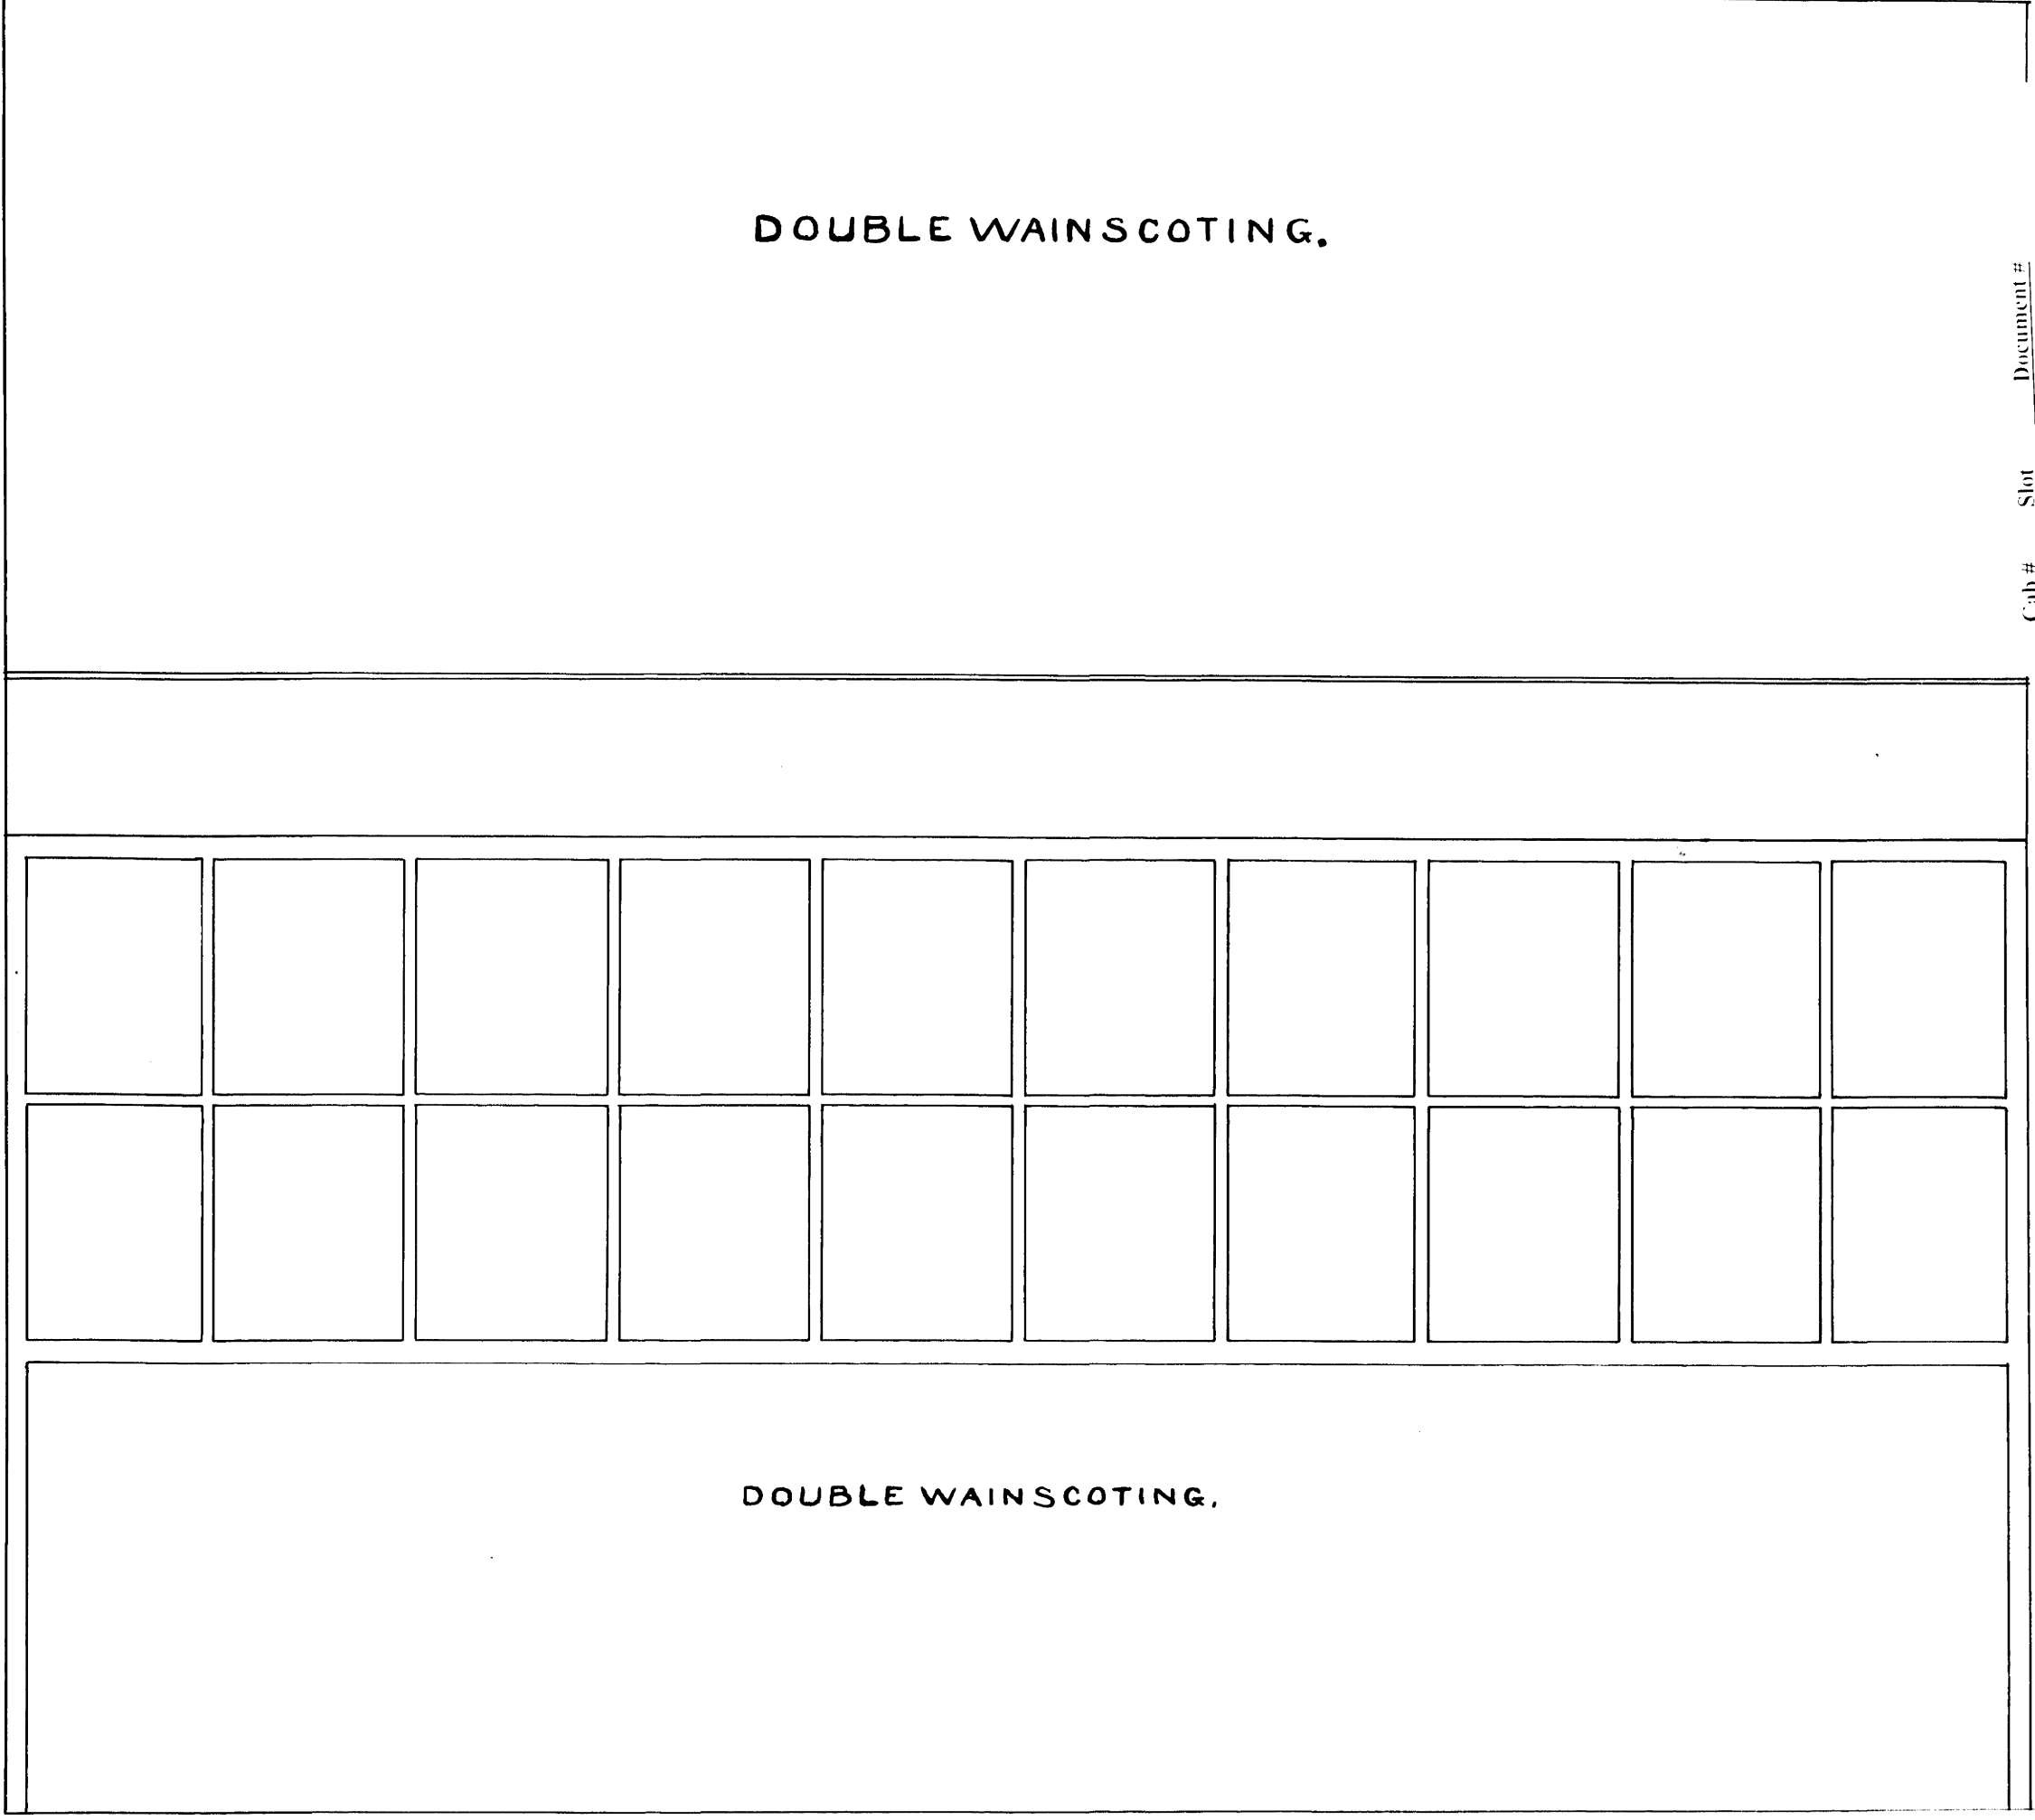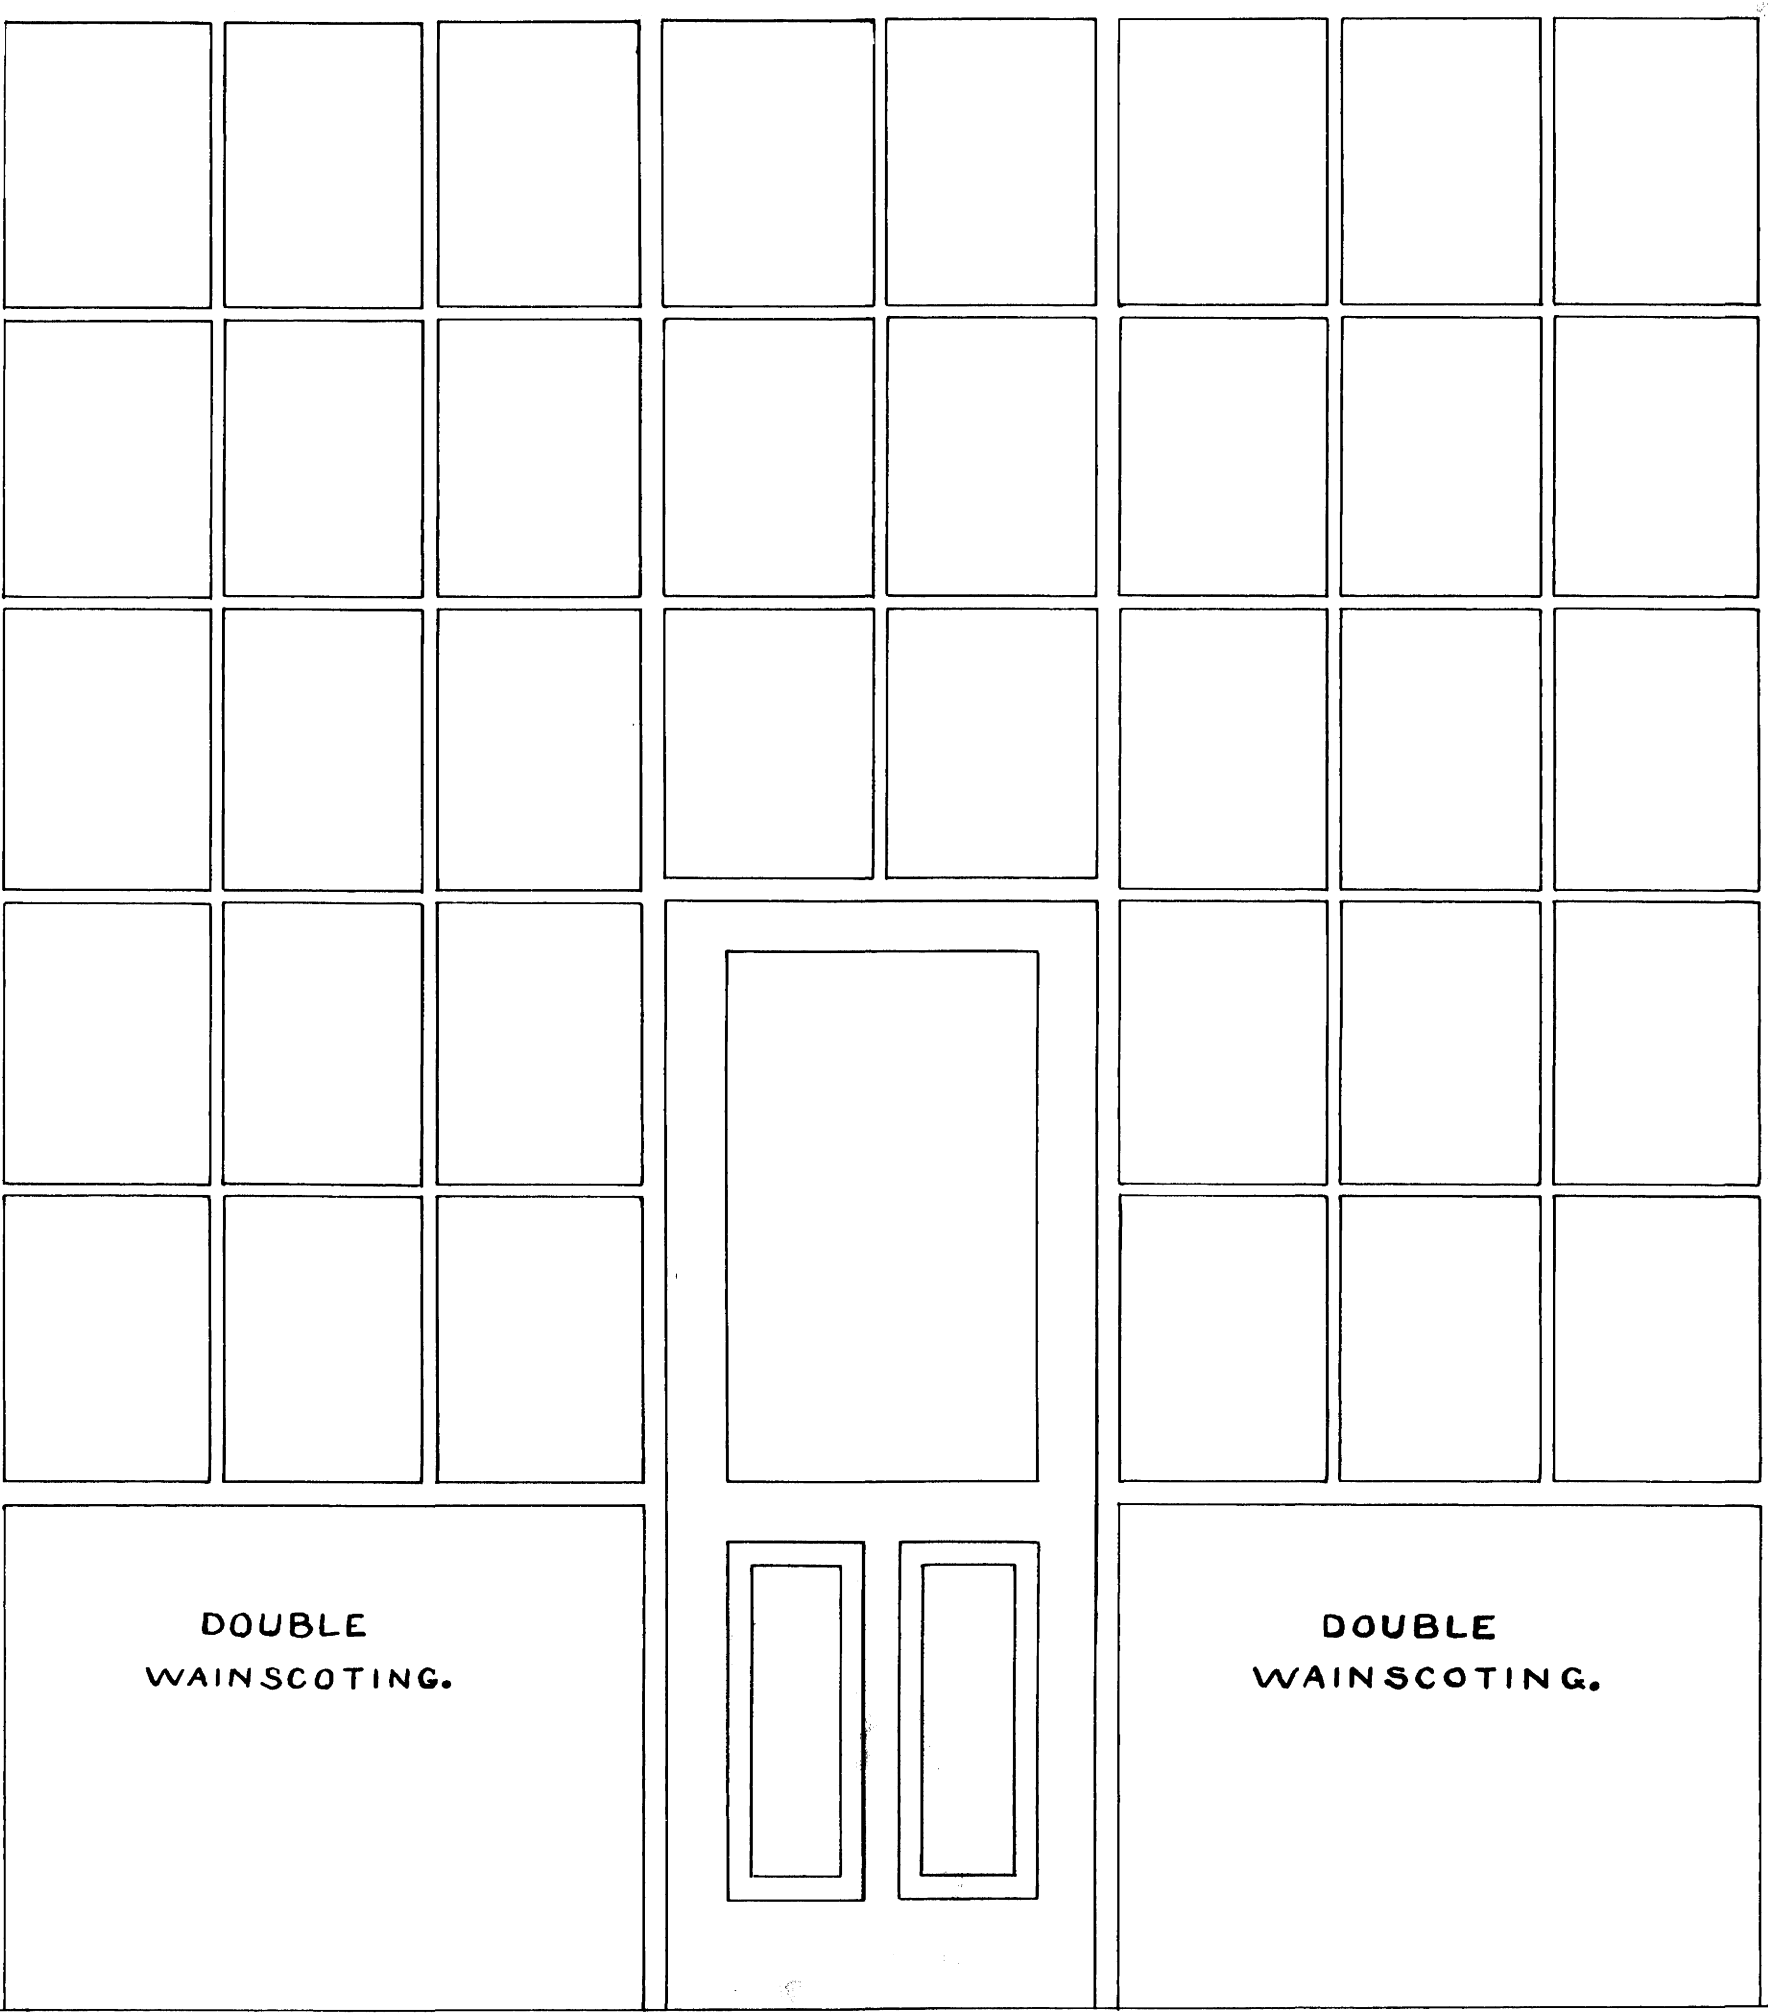


FRONT PARTITION SECOND FLOOR.


ALL GLASS TO BE FROSTED.

REAR PARTITION SECOND FLOOR.

SCALE  $\frac{3}{4}'' = 1'$

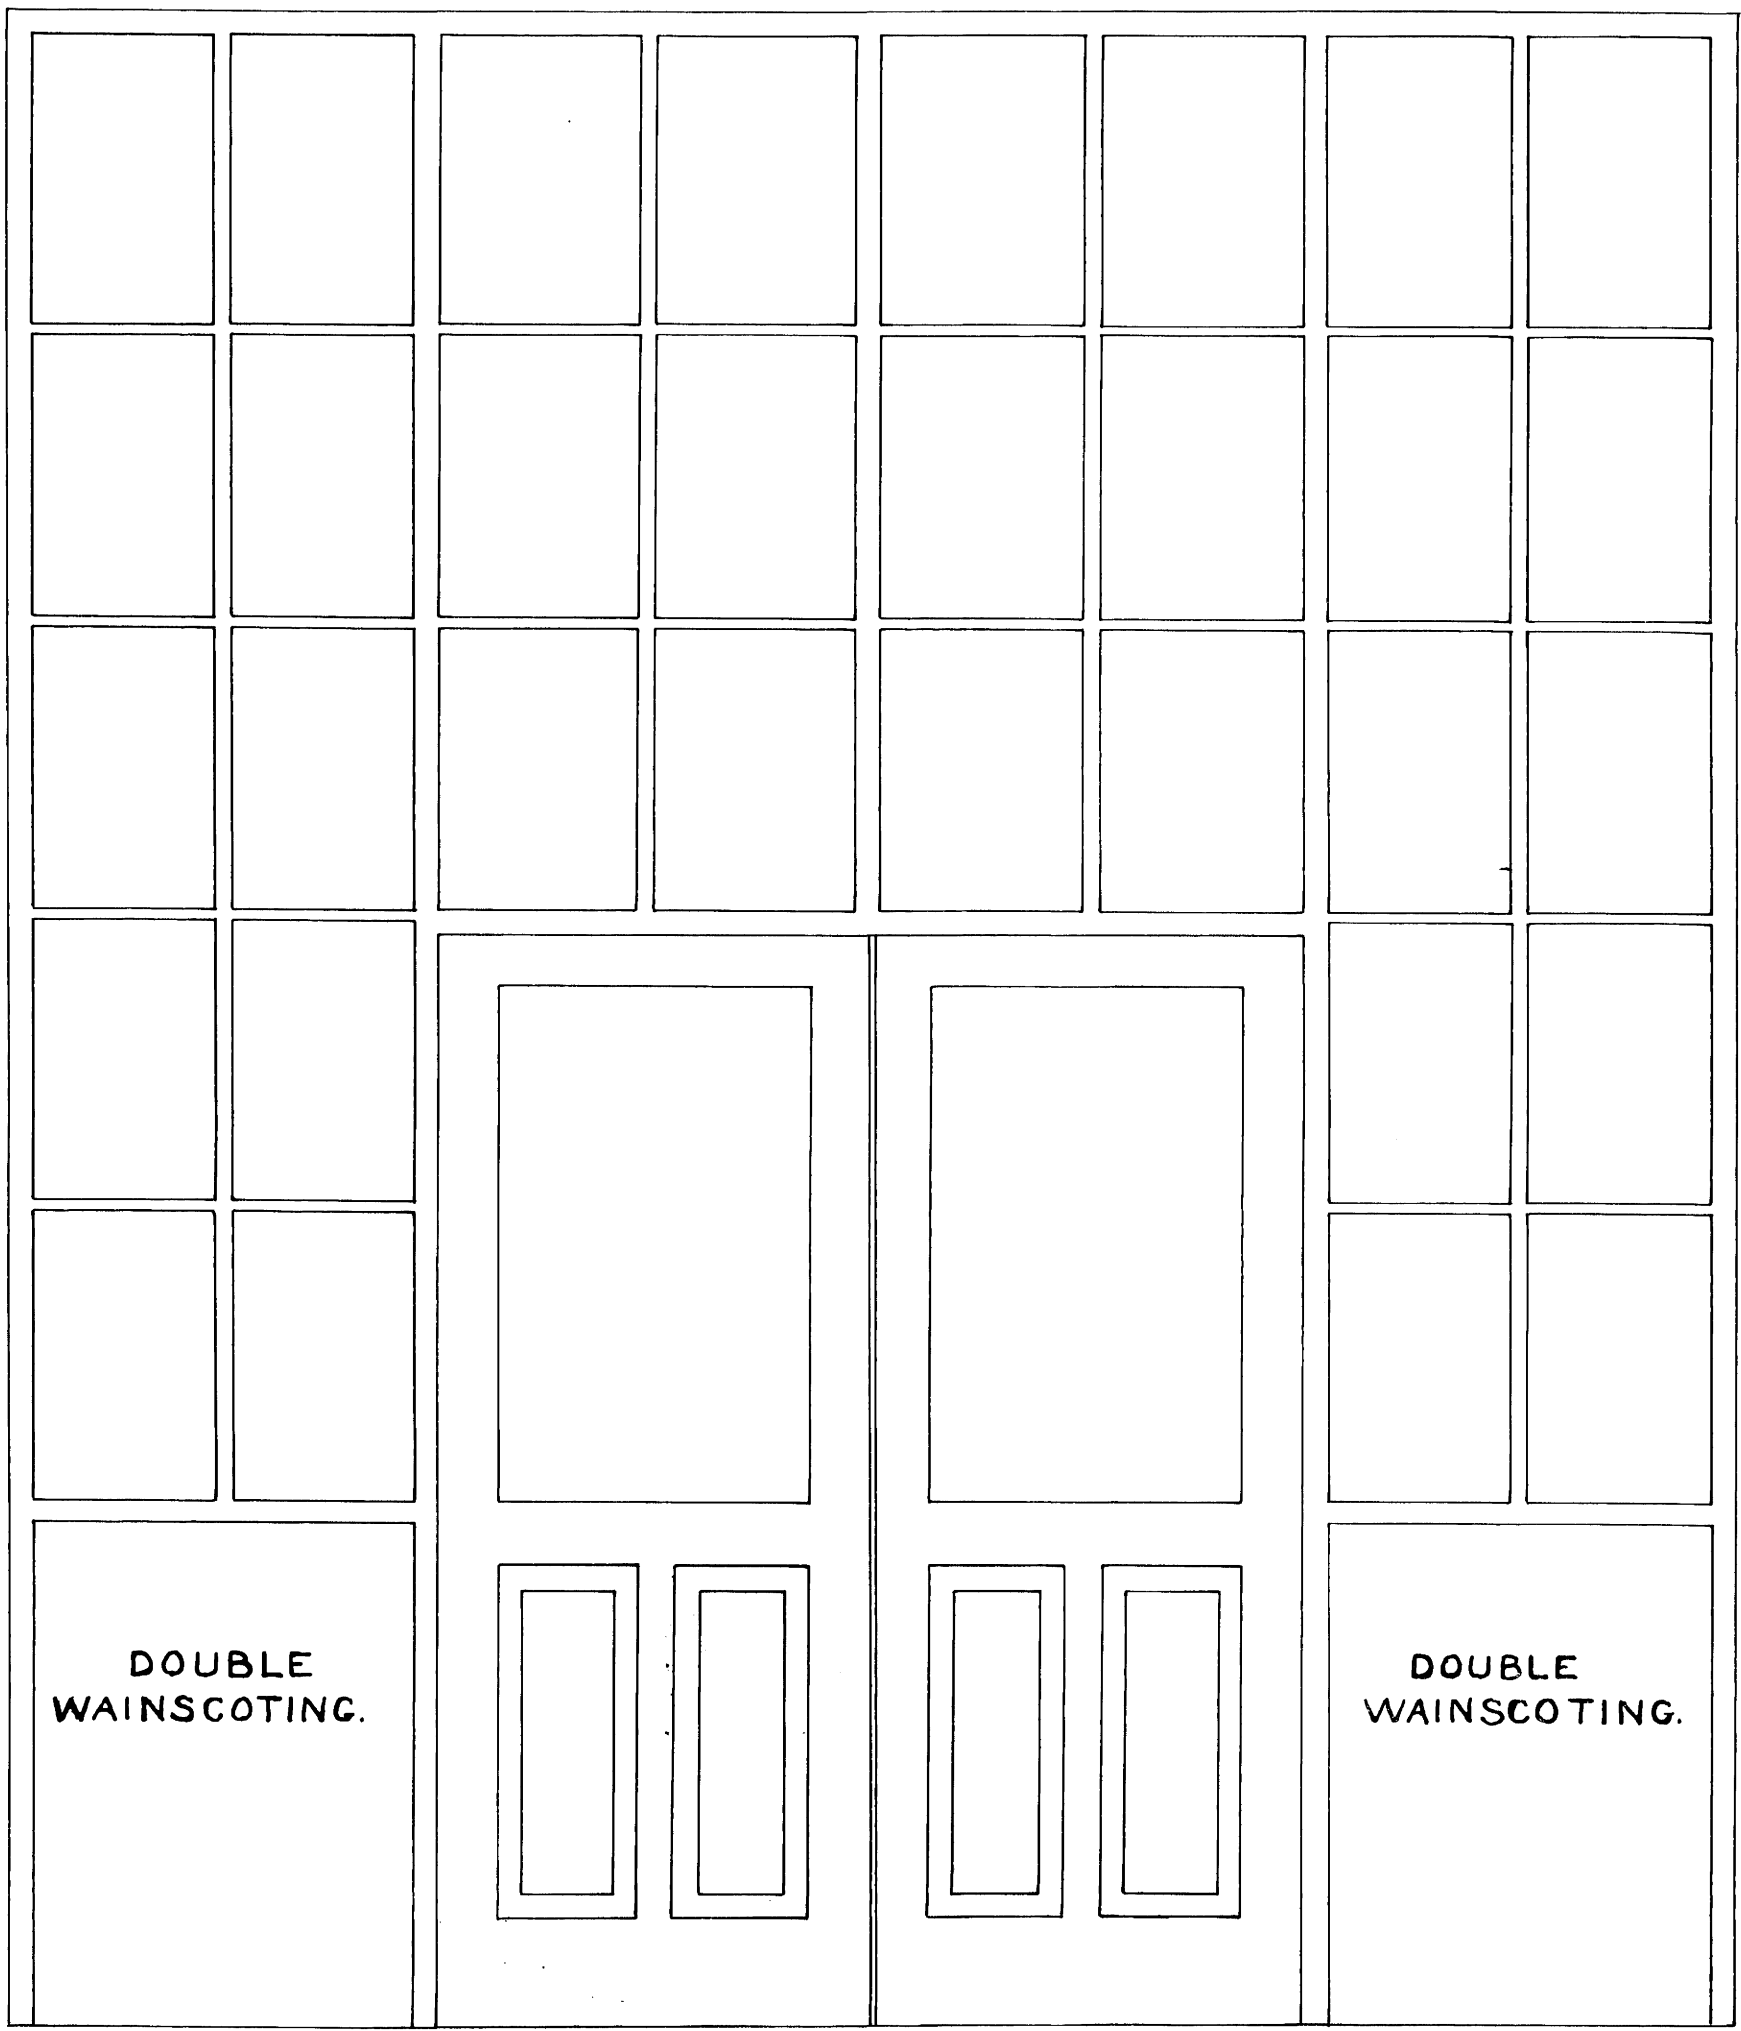


VESTIBULE PARTITION.

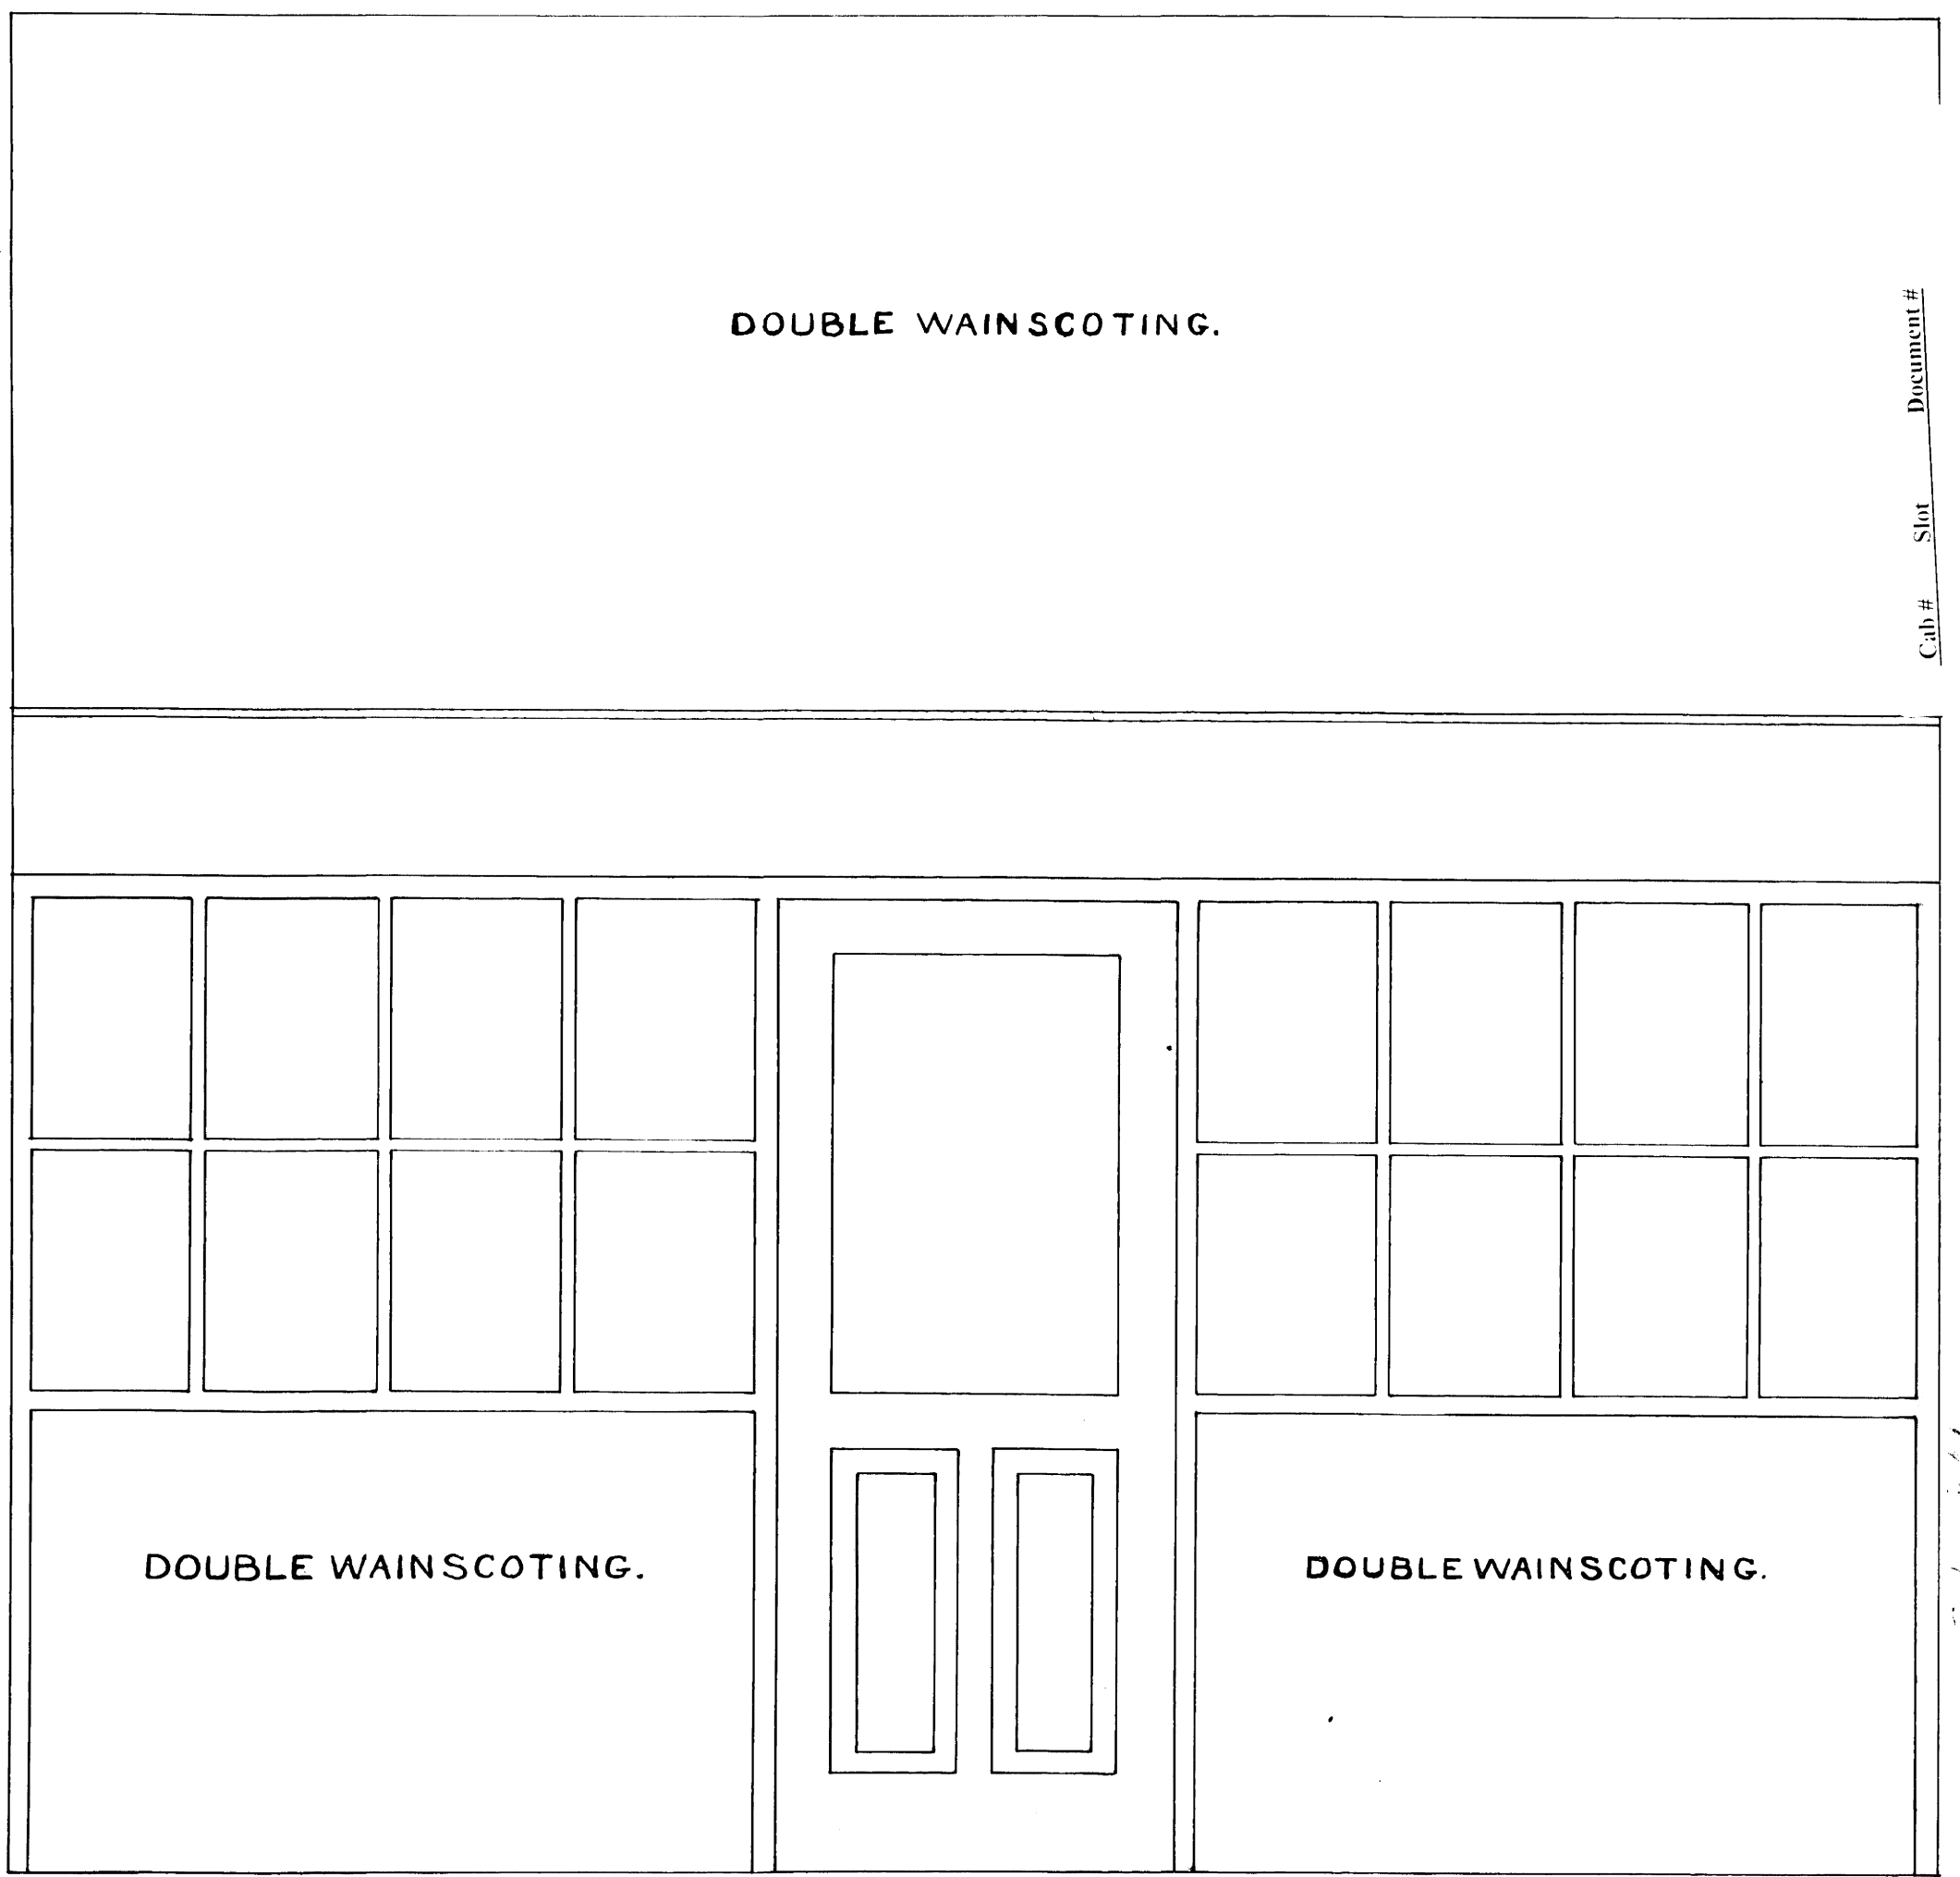


REAR PARTITION FIRST FLOOR


ALL GLASS TO BE FROSTED.

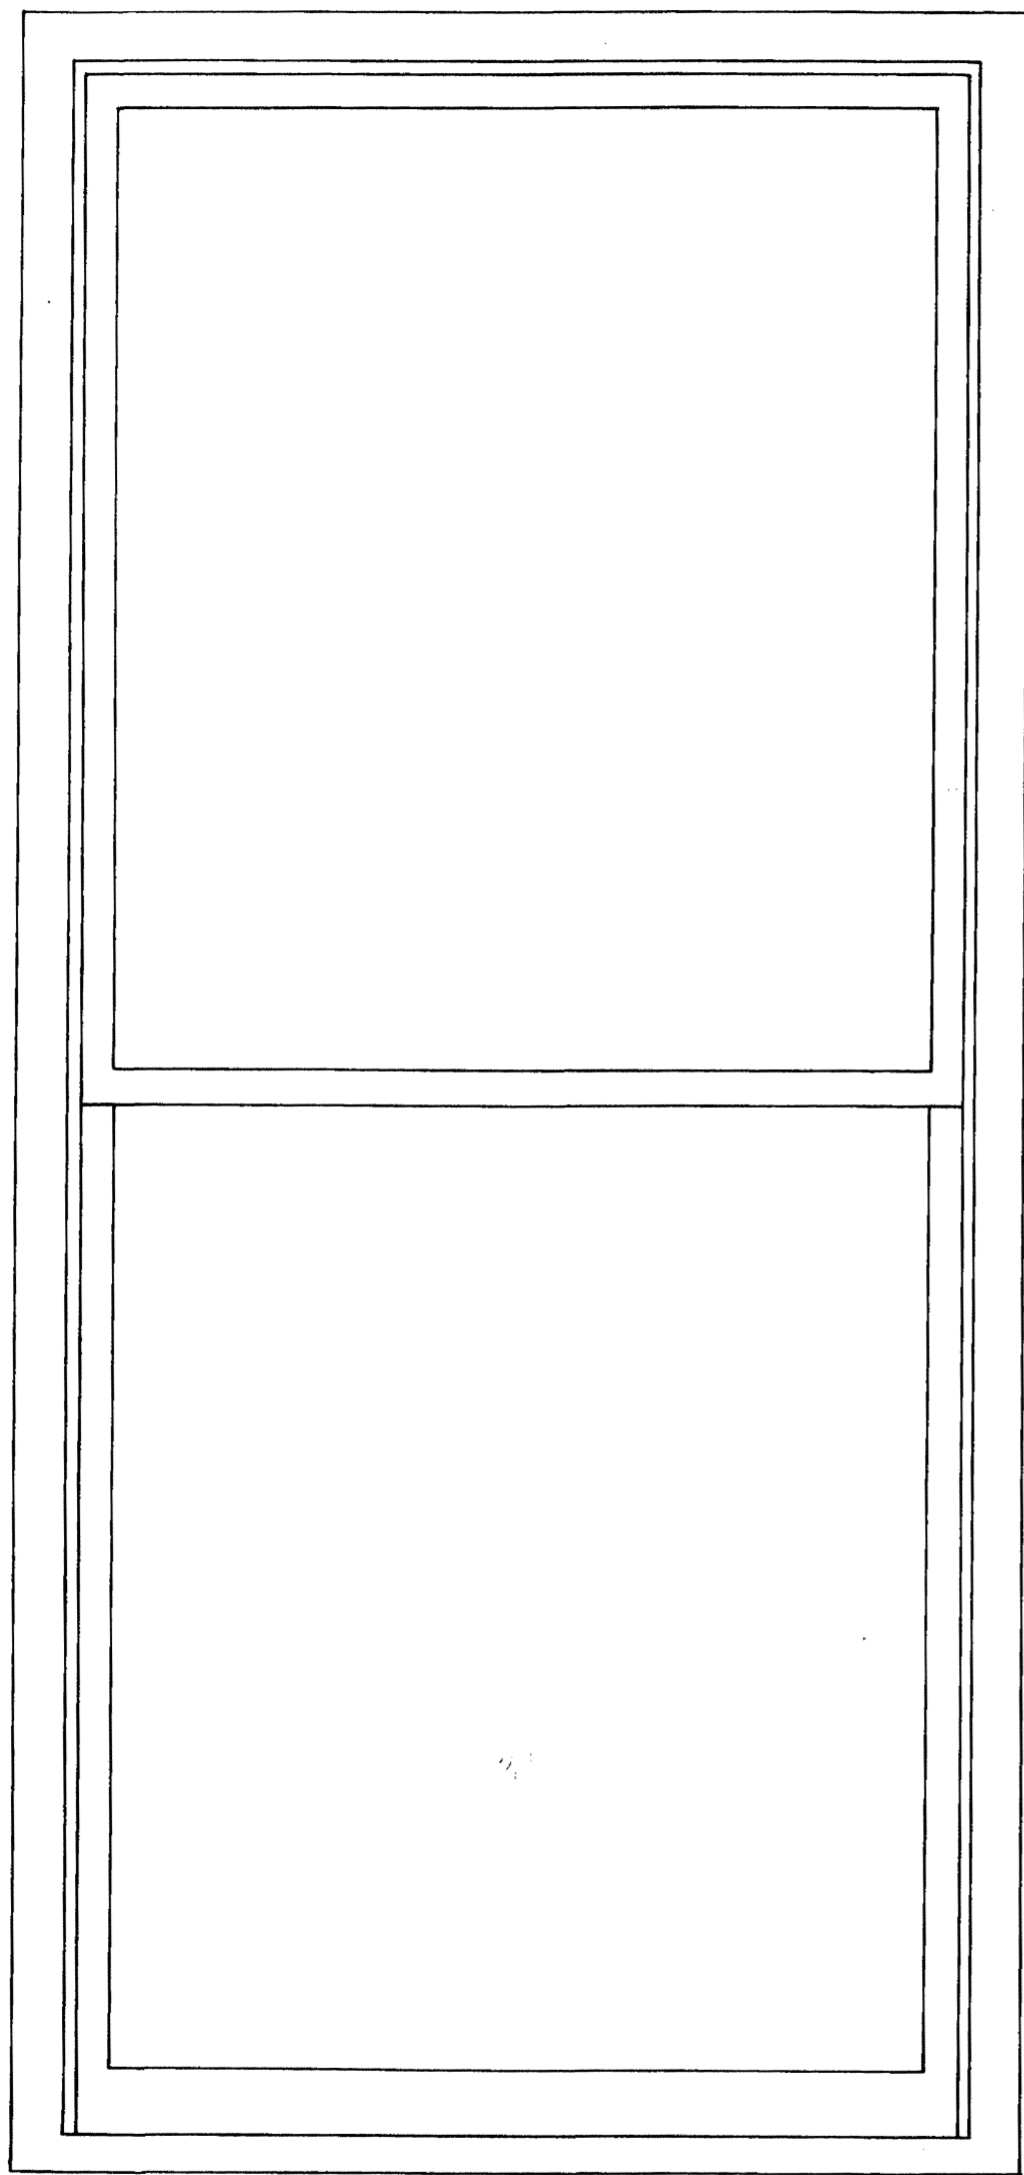

DETAIL OF WINDOW.

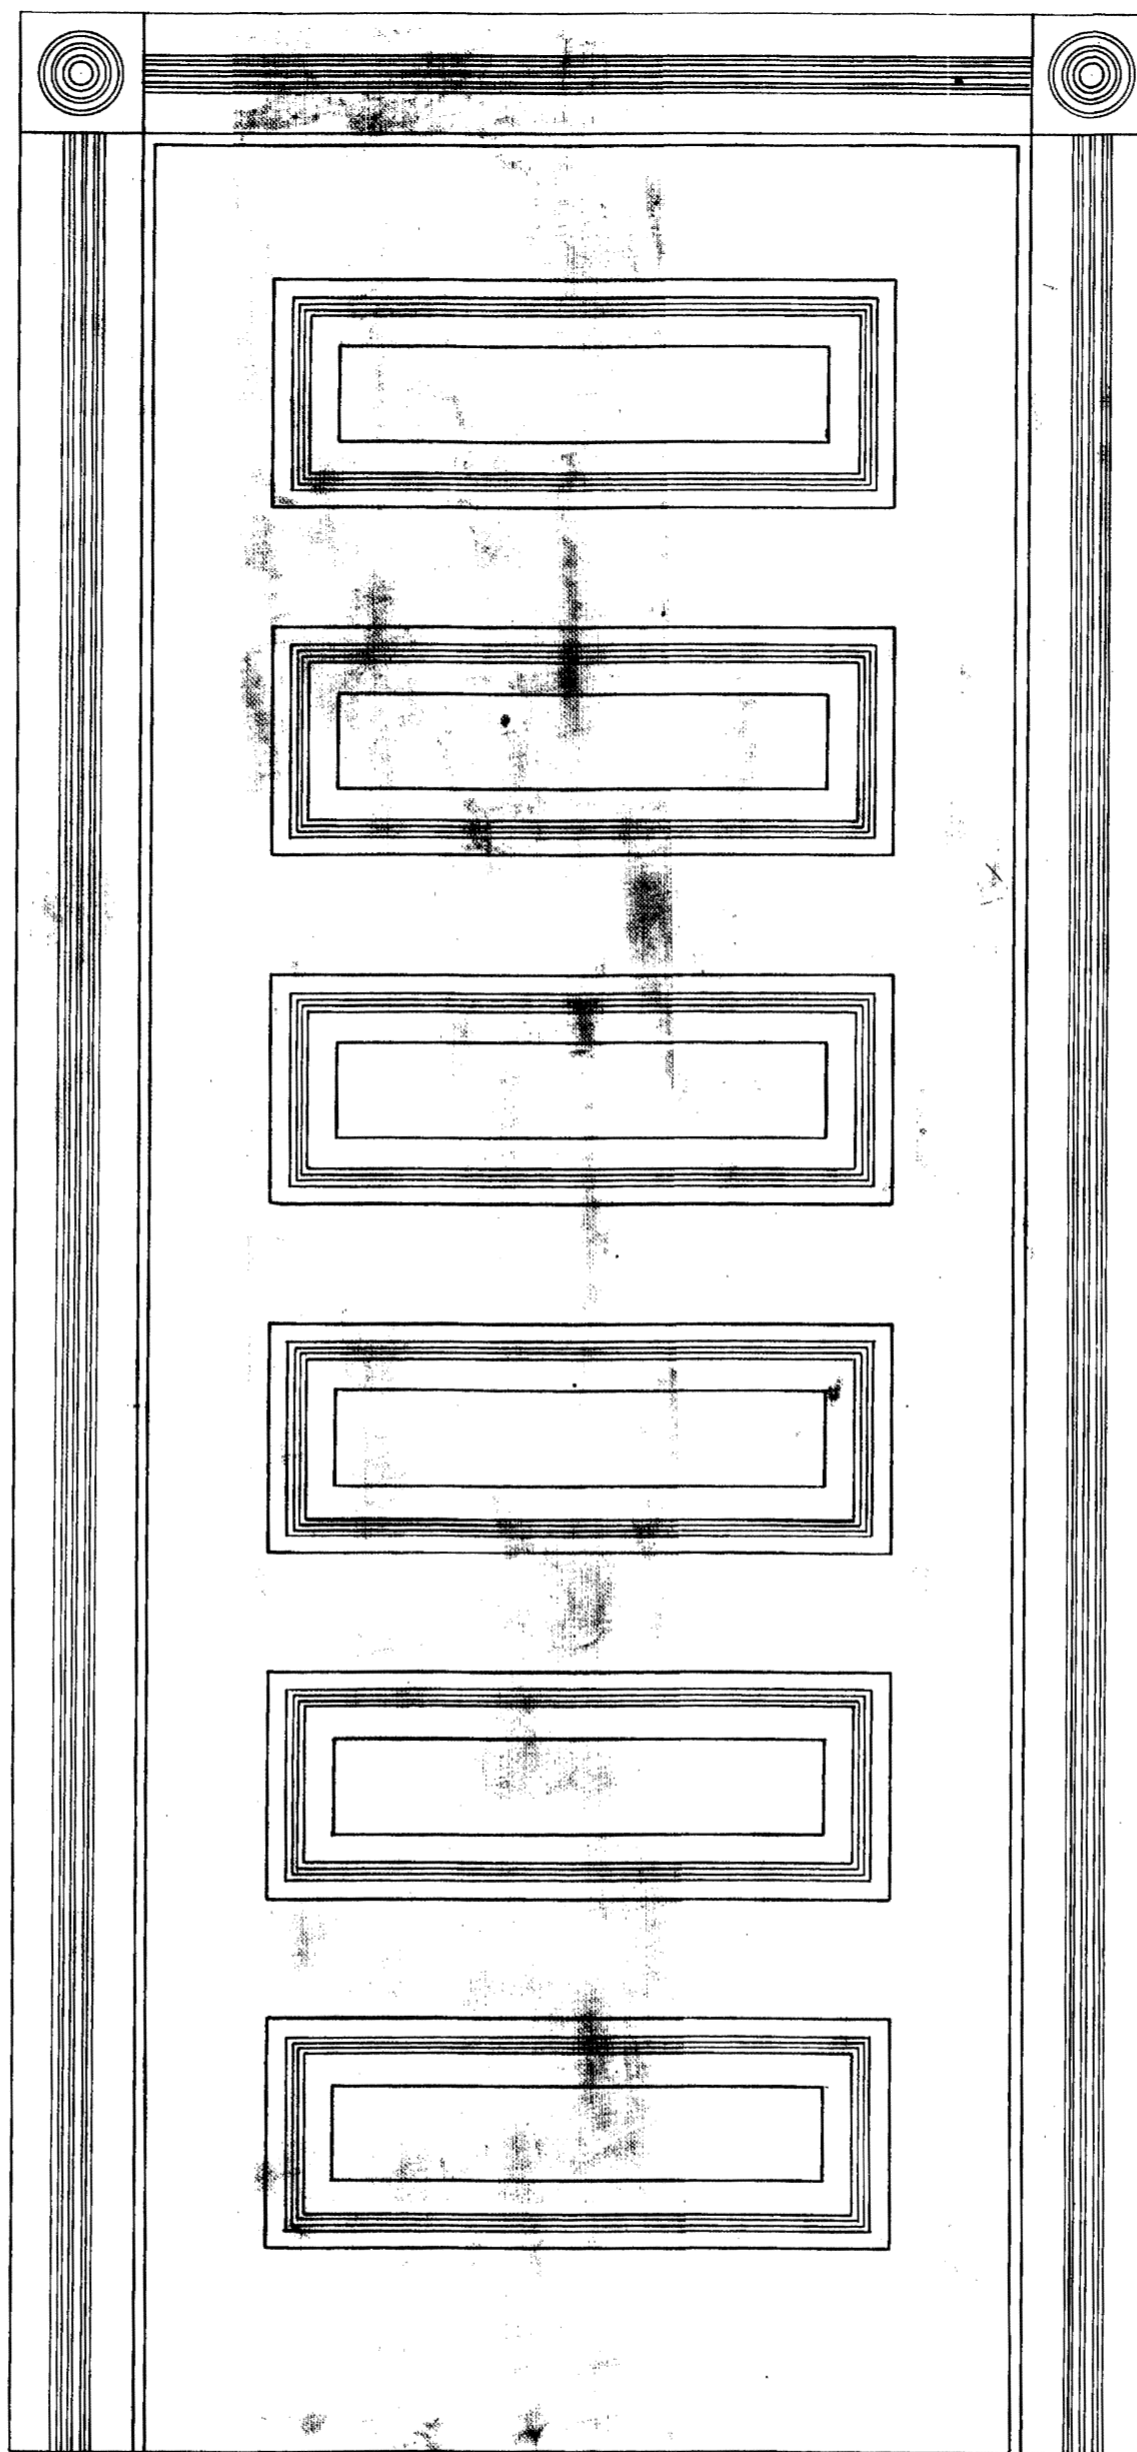


DETAIL OF DOOR.

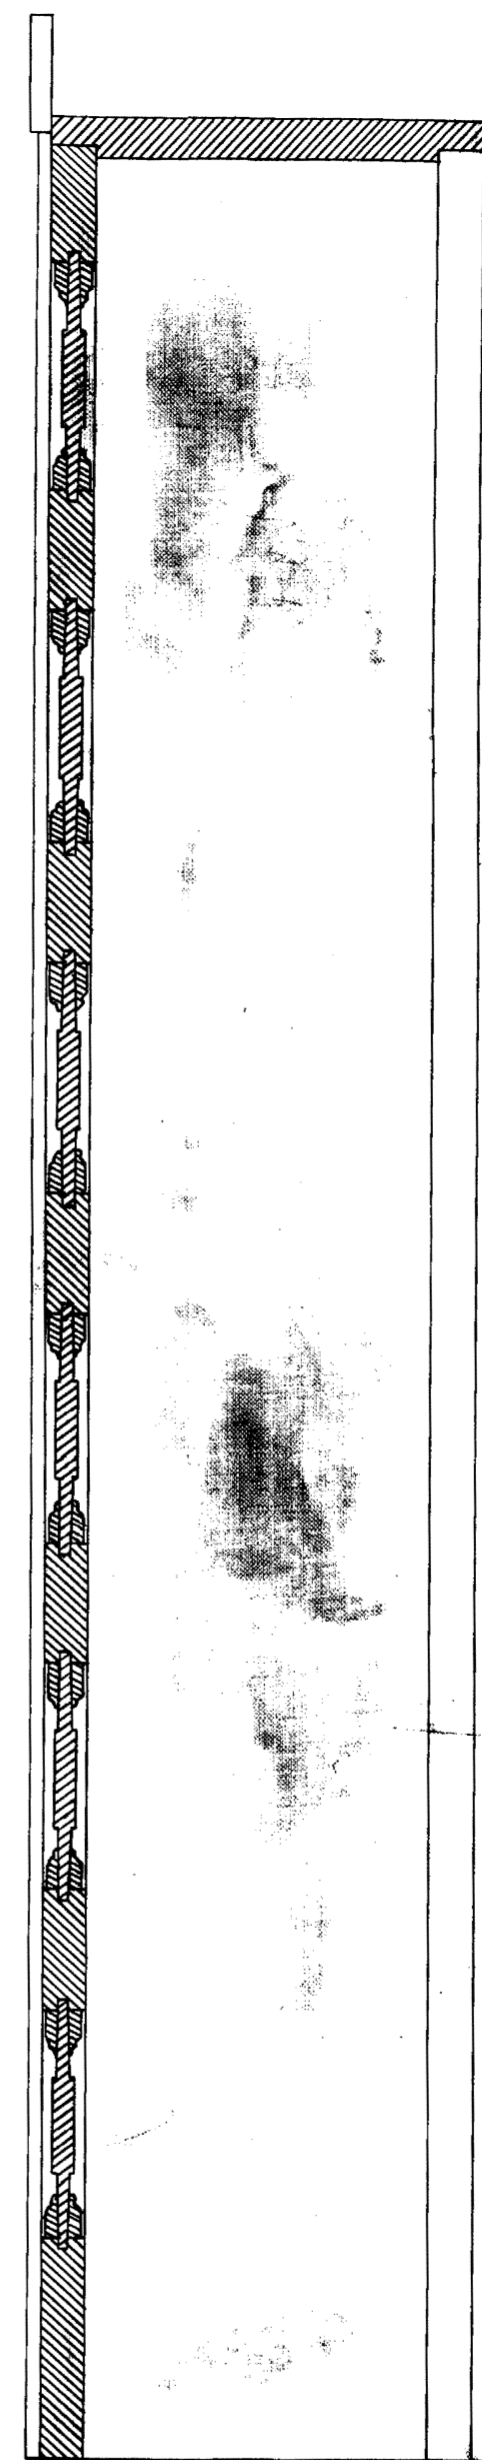


SCALE  $1\frac{1}{2}'' = 1'$



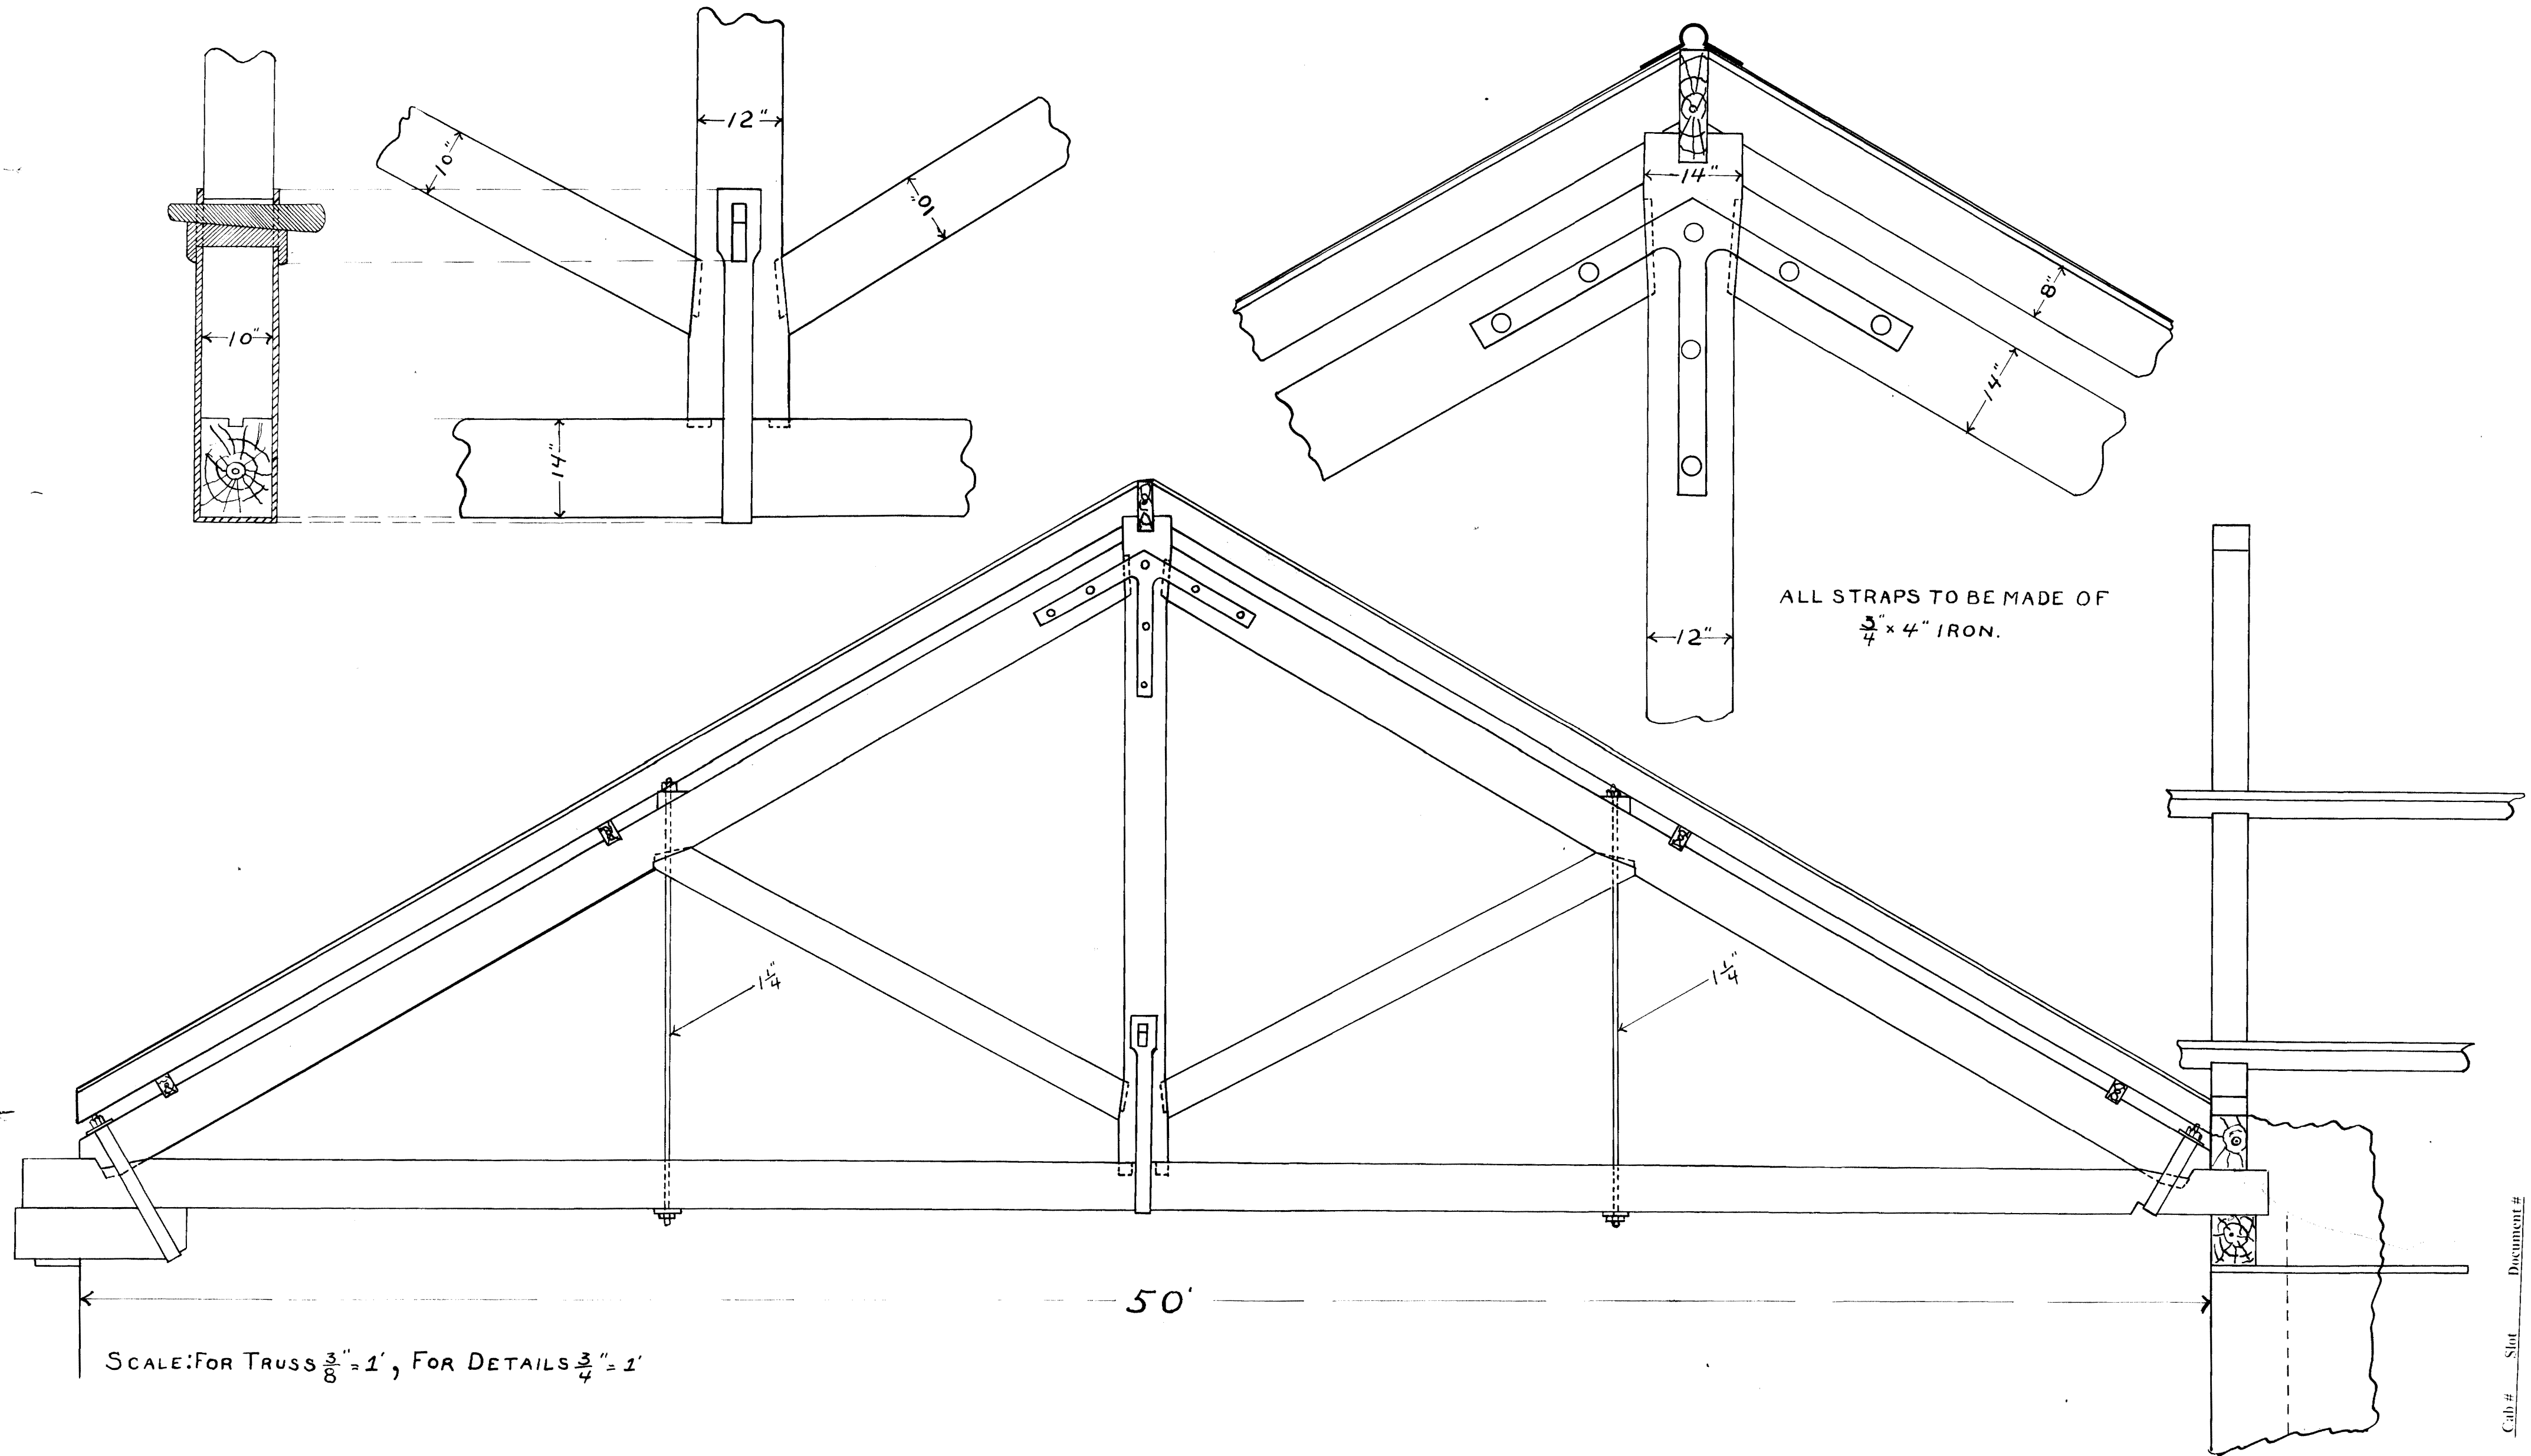




DETAIL OF FRONT DOOR  $\frac{3}{4}'' = 1'$

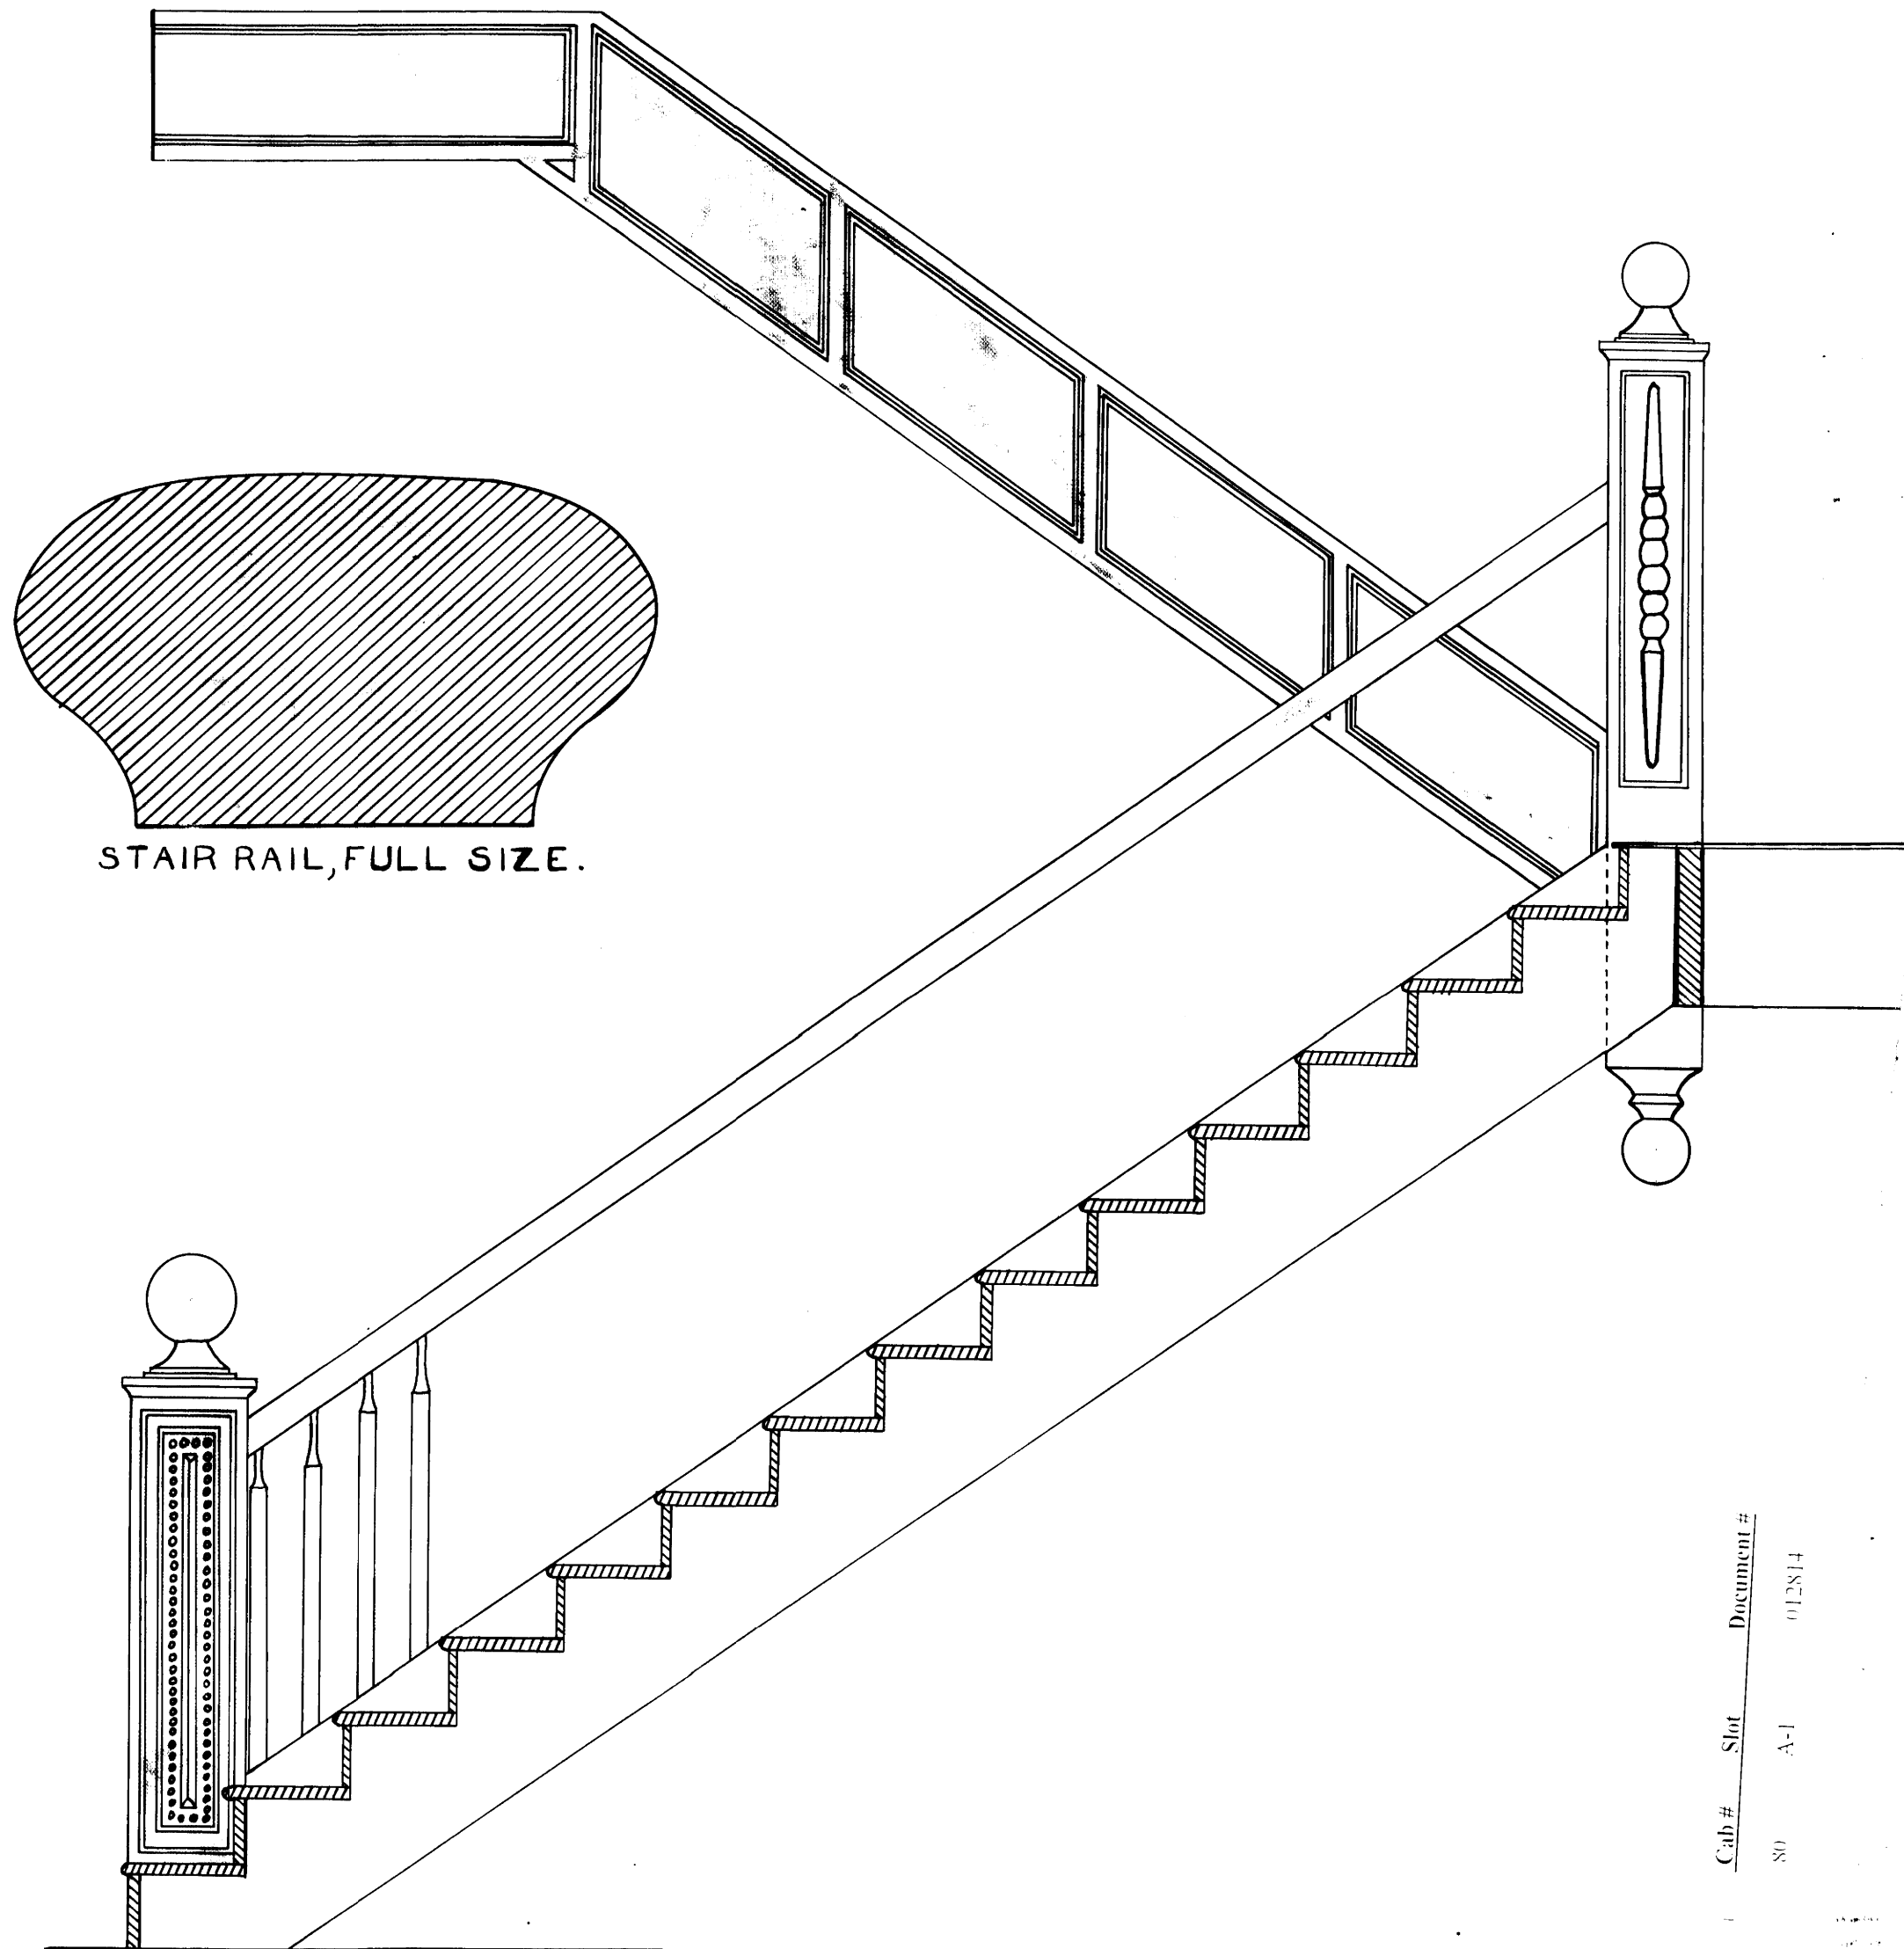


STAIR RAIL, FULL SIZE.


STAIRWAY  $\frac{3}{4}'' = 1'$

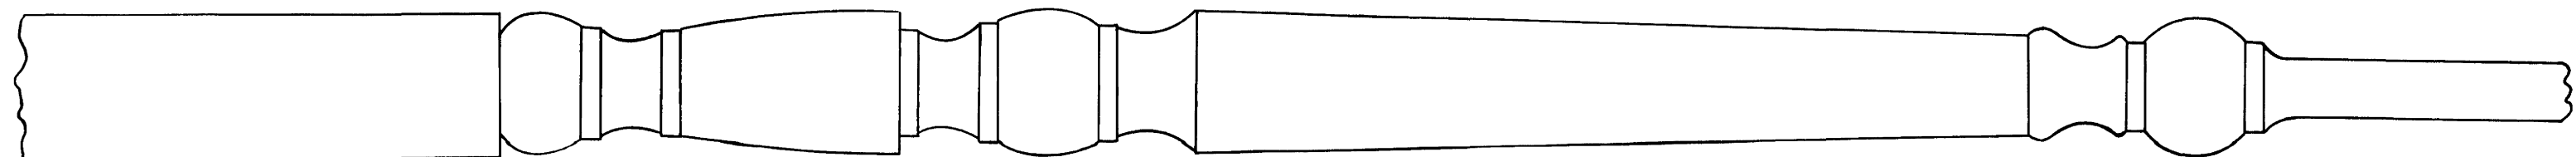


DETAIL OF BALUSTER, HALF SIZE.


Cab # Slot Document #  
80 A-1 012814

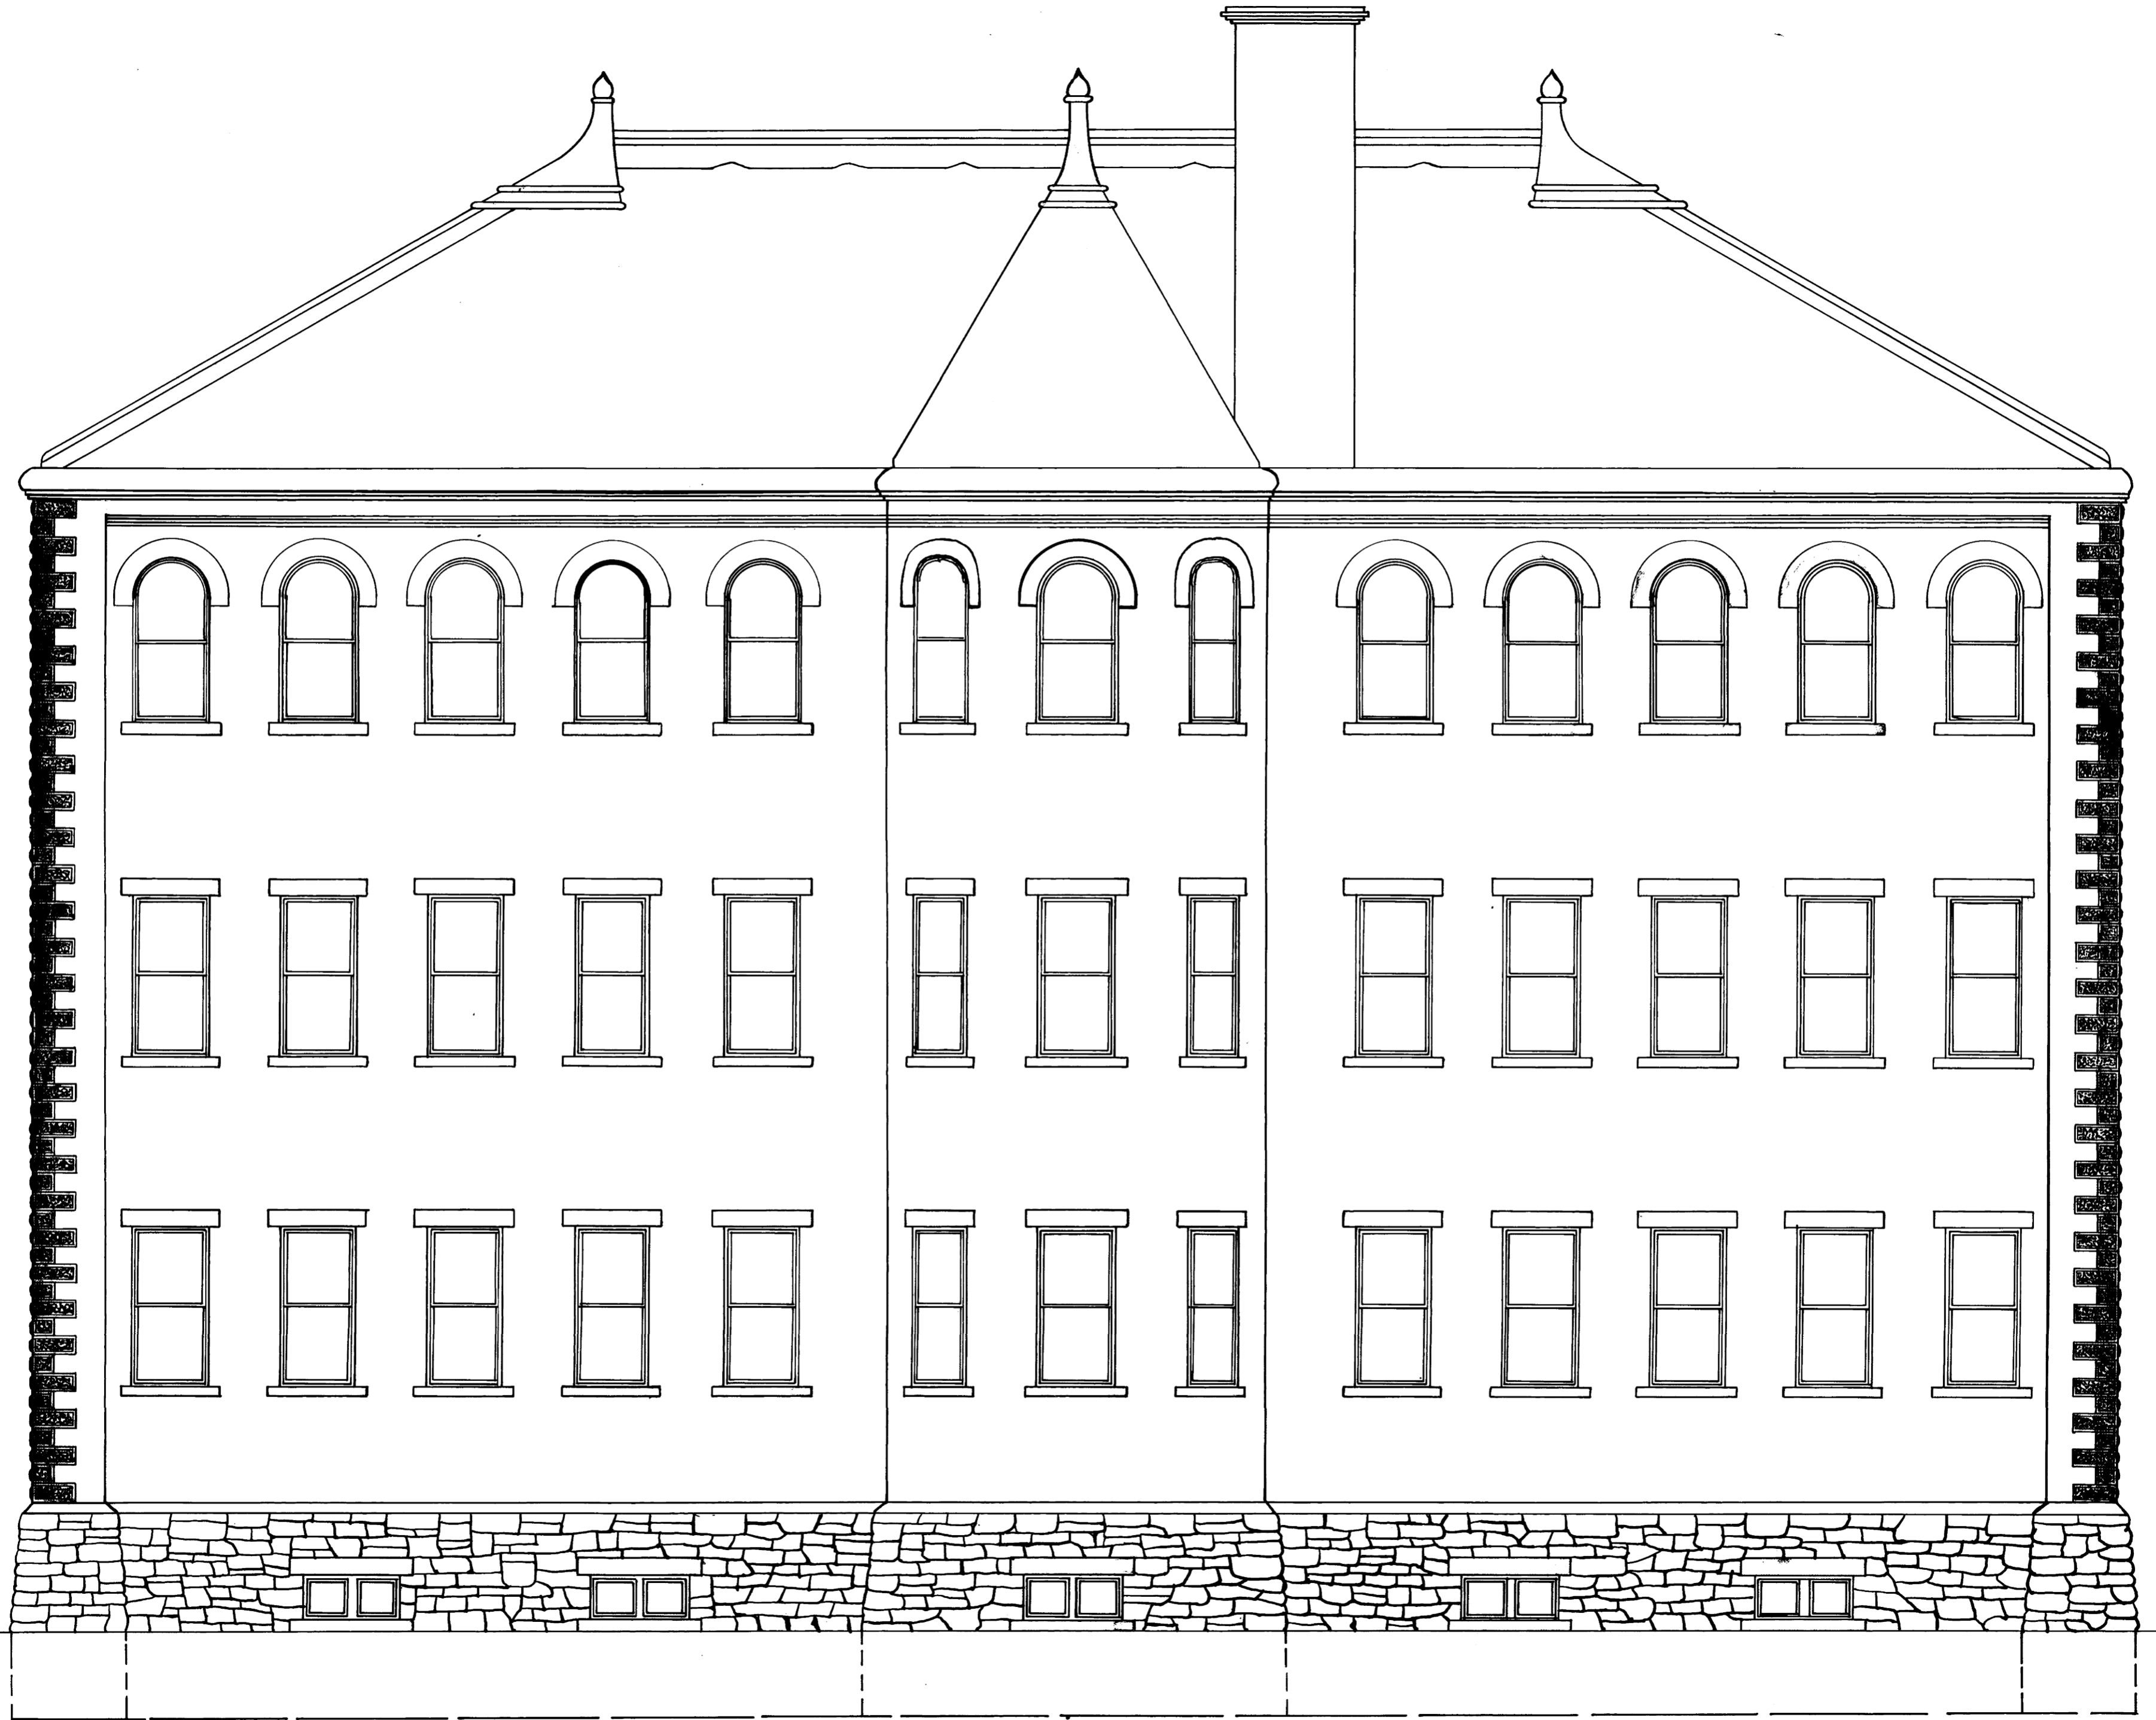

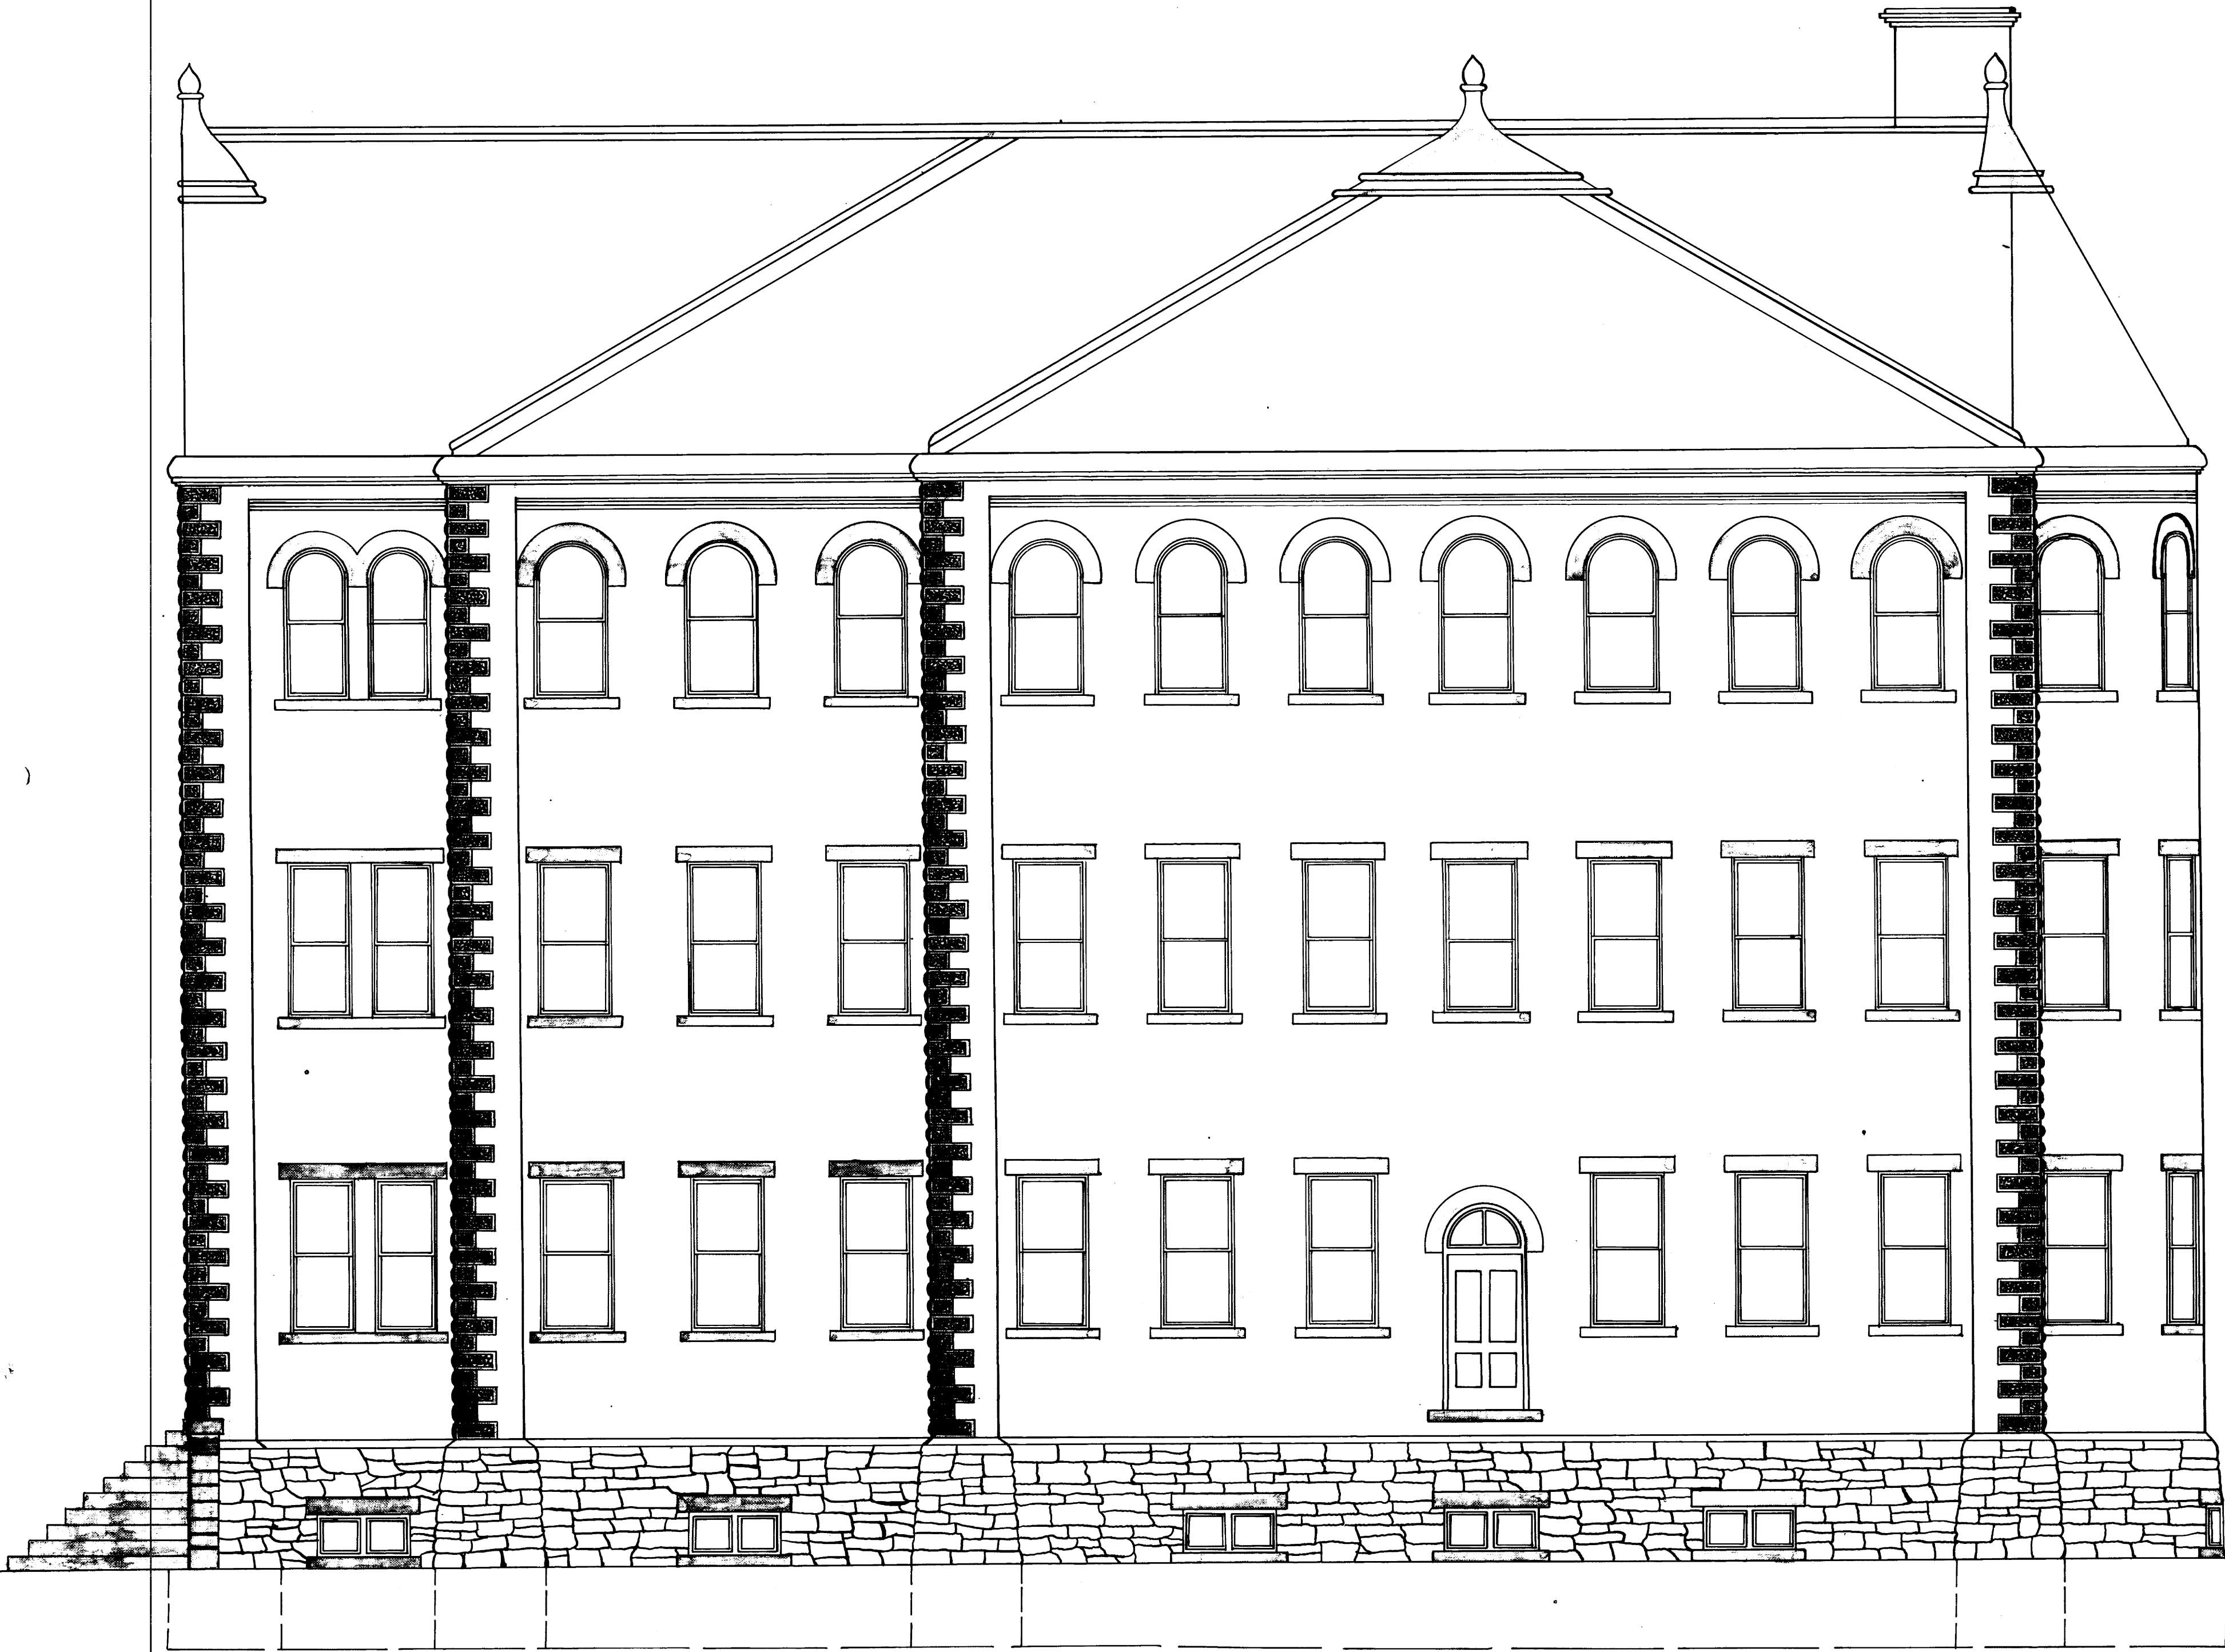

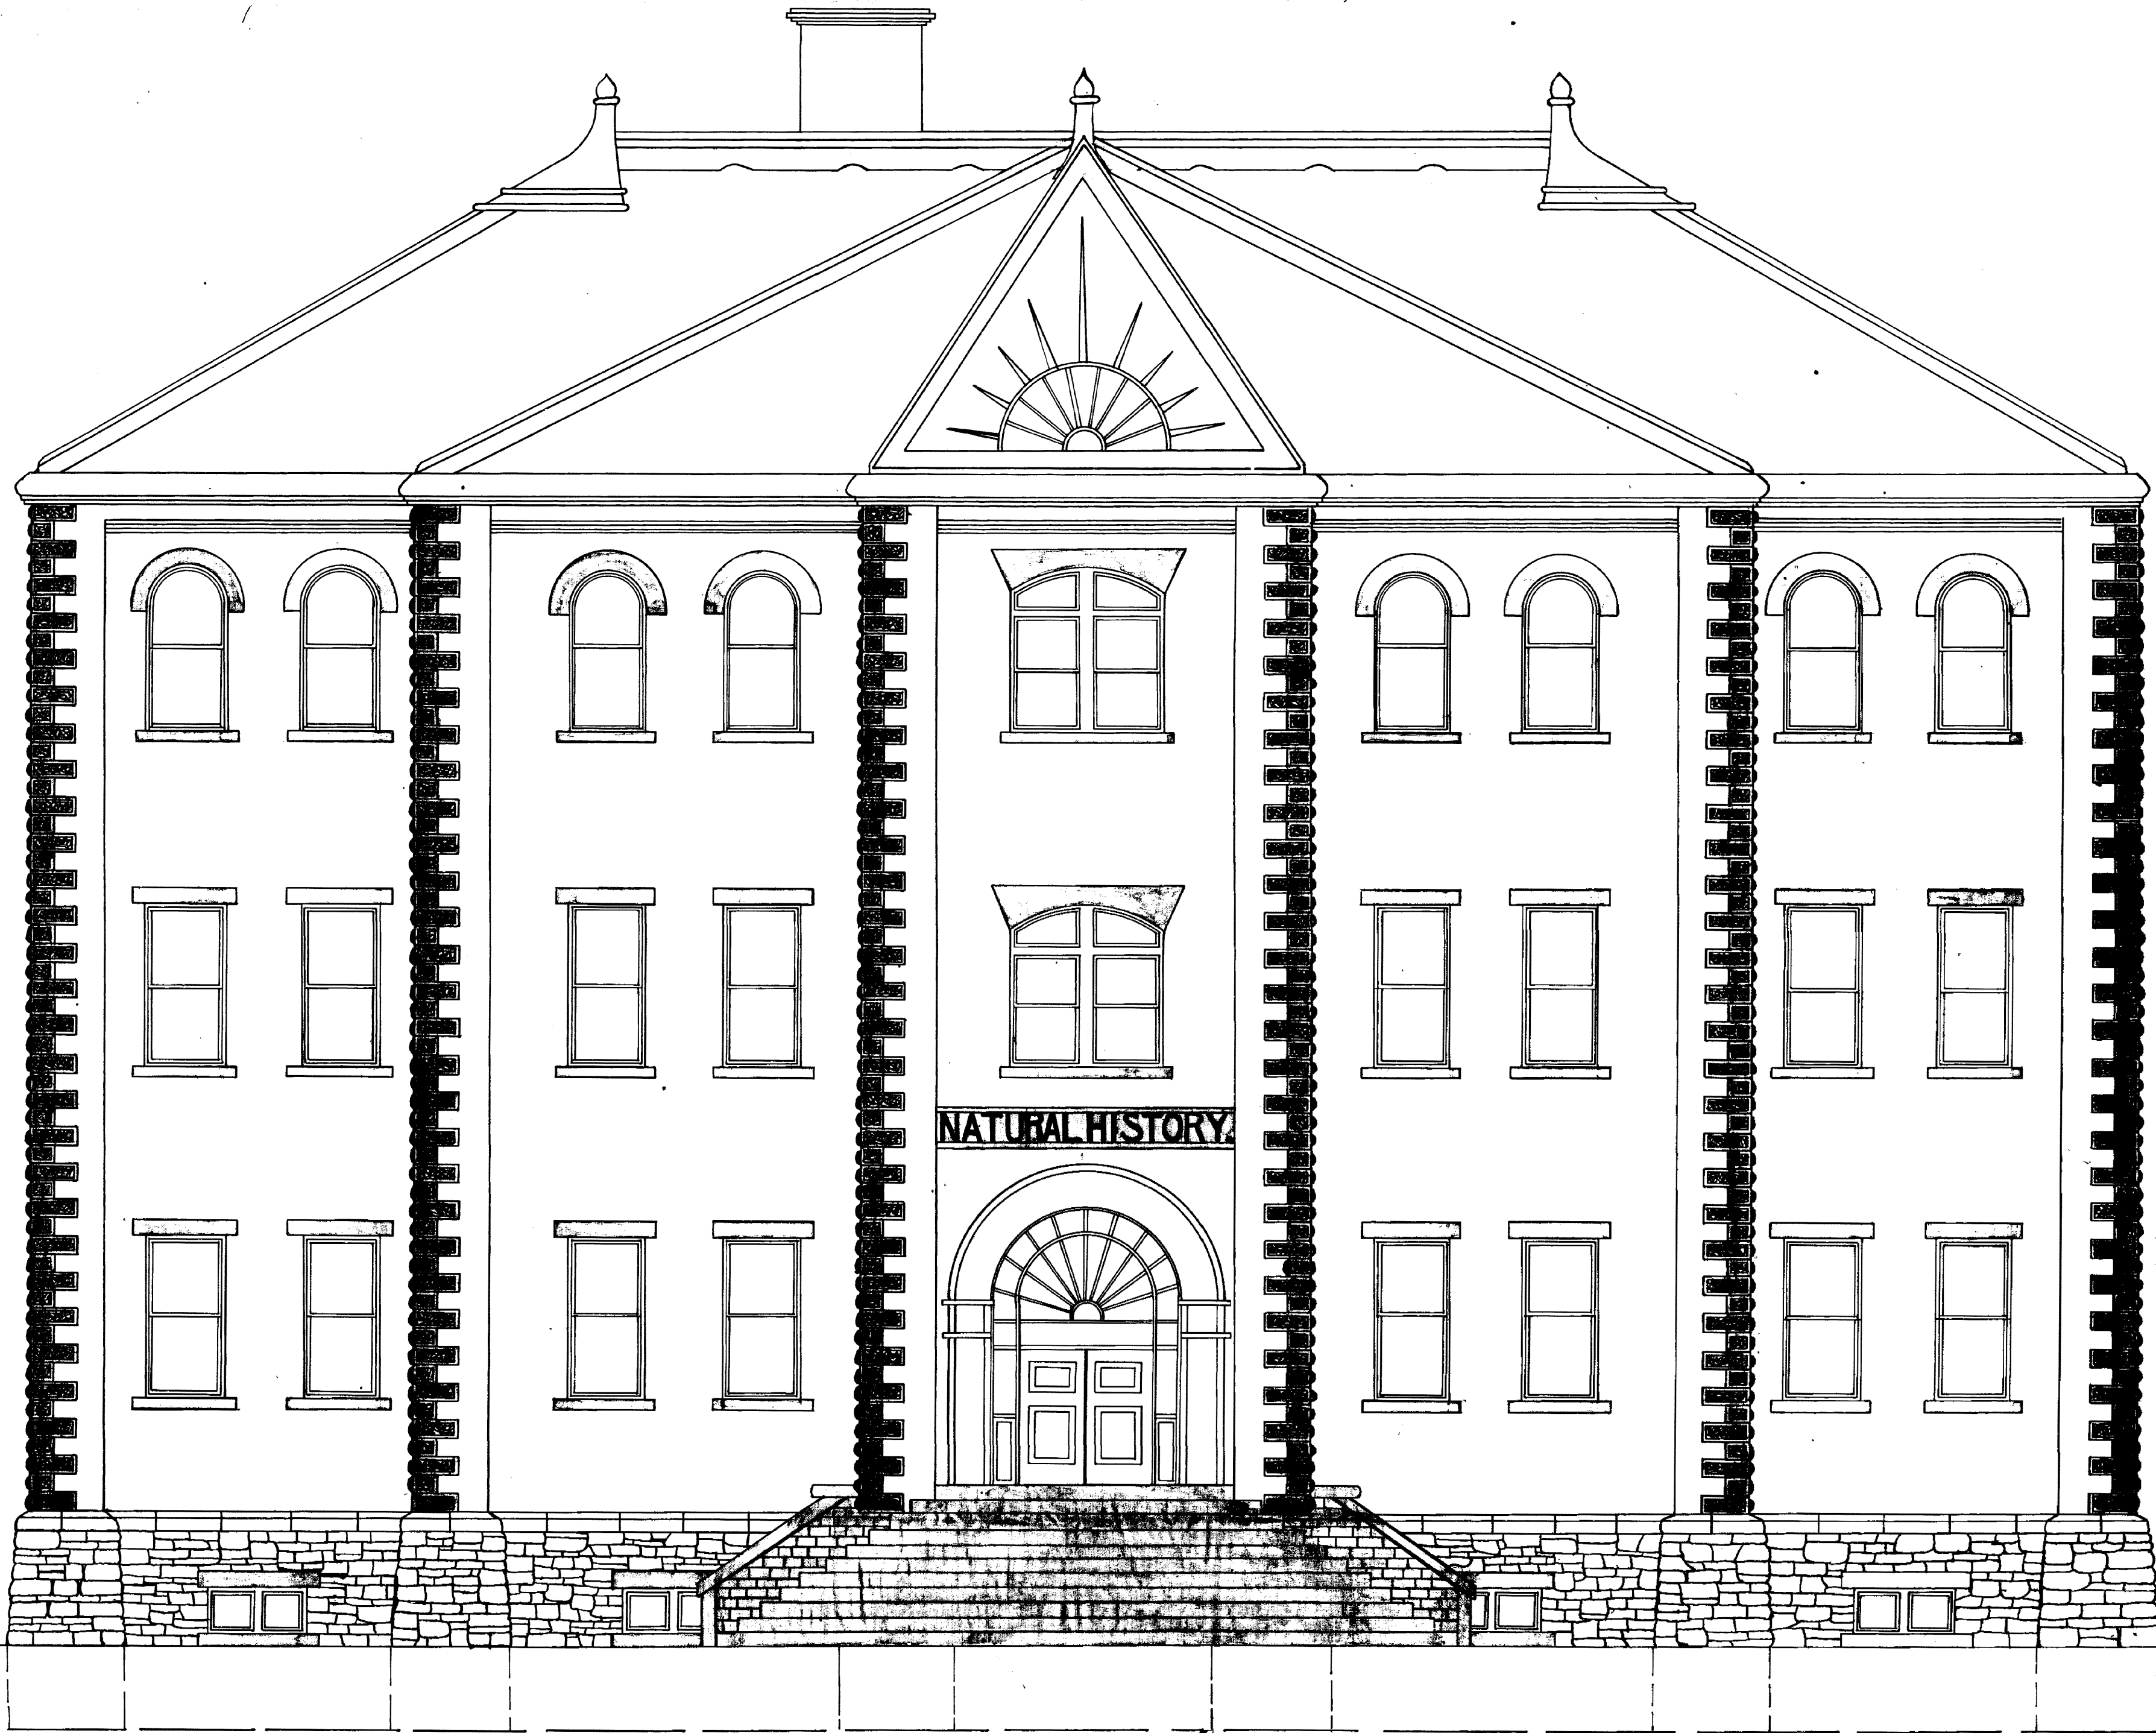


NATURAL HISTORY

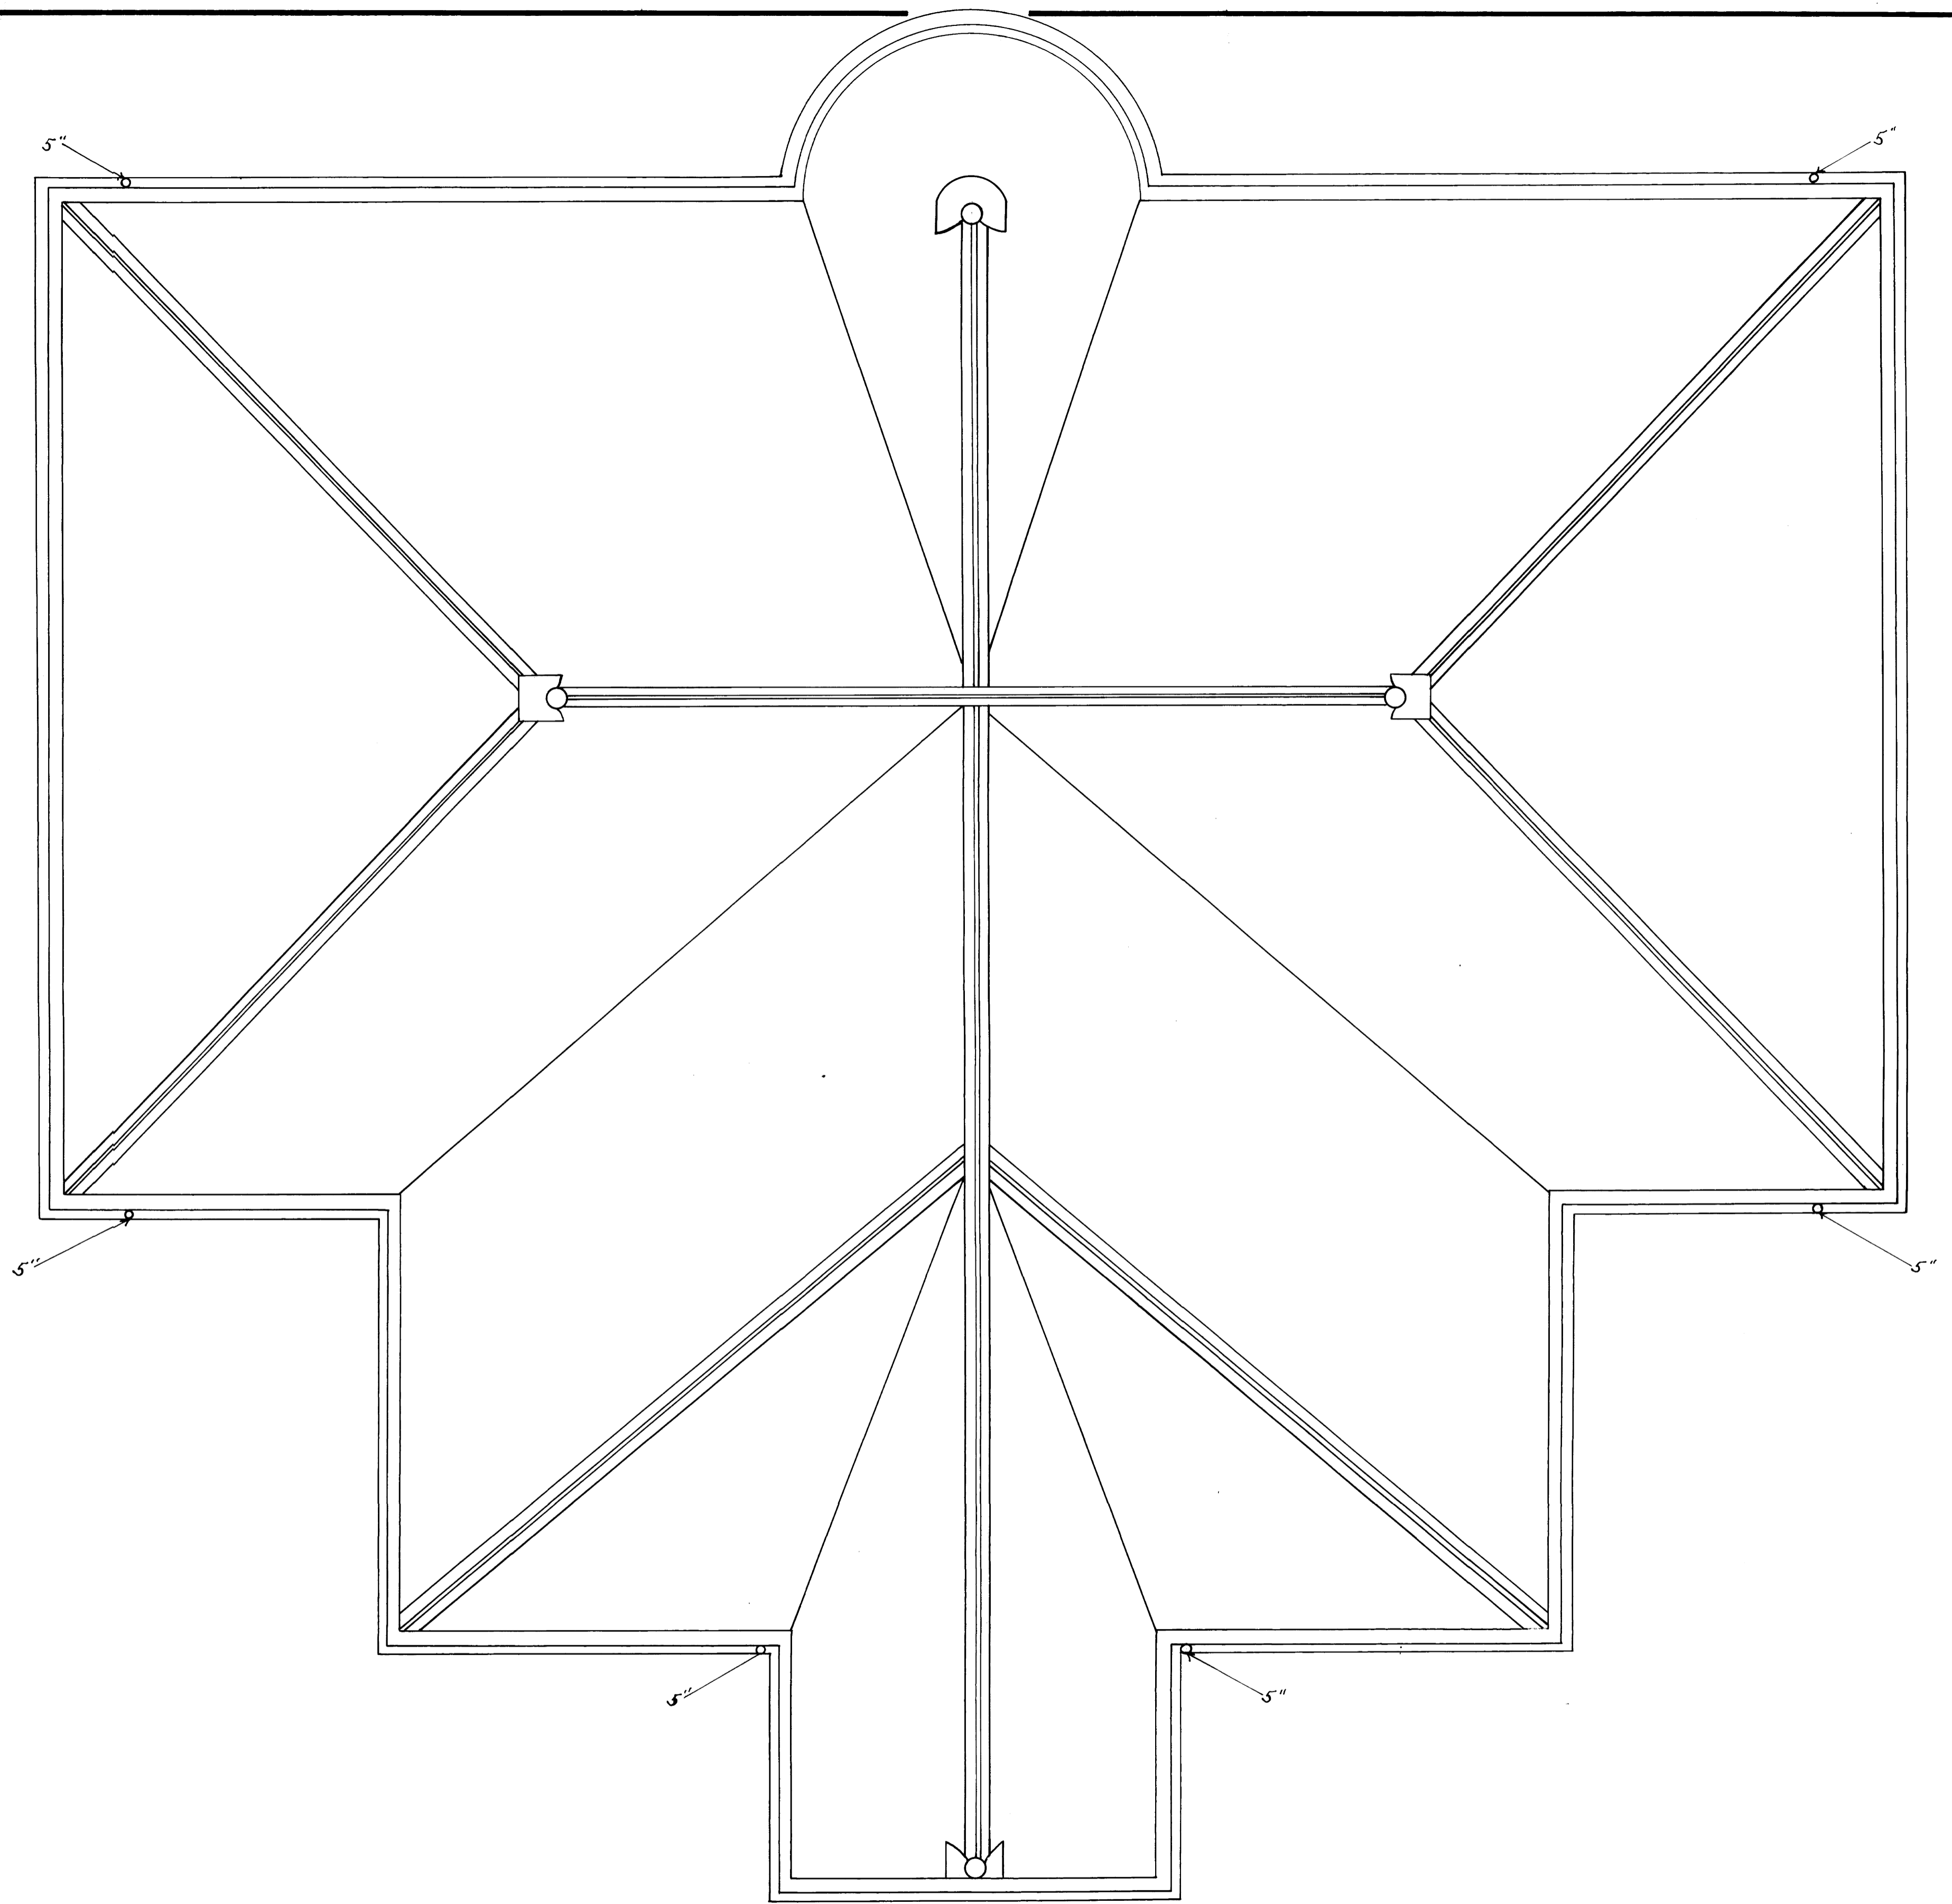

U-213011



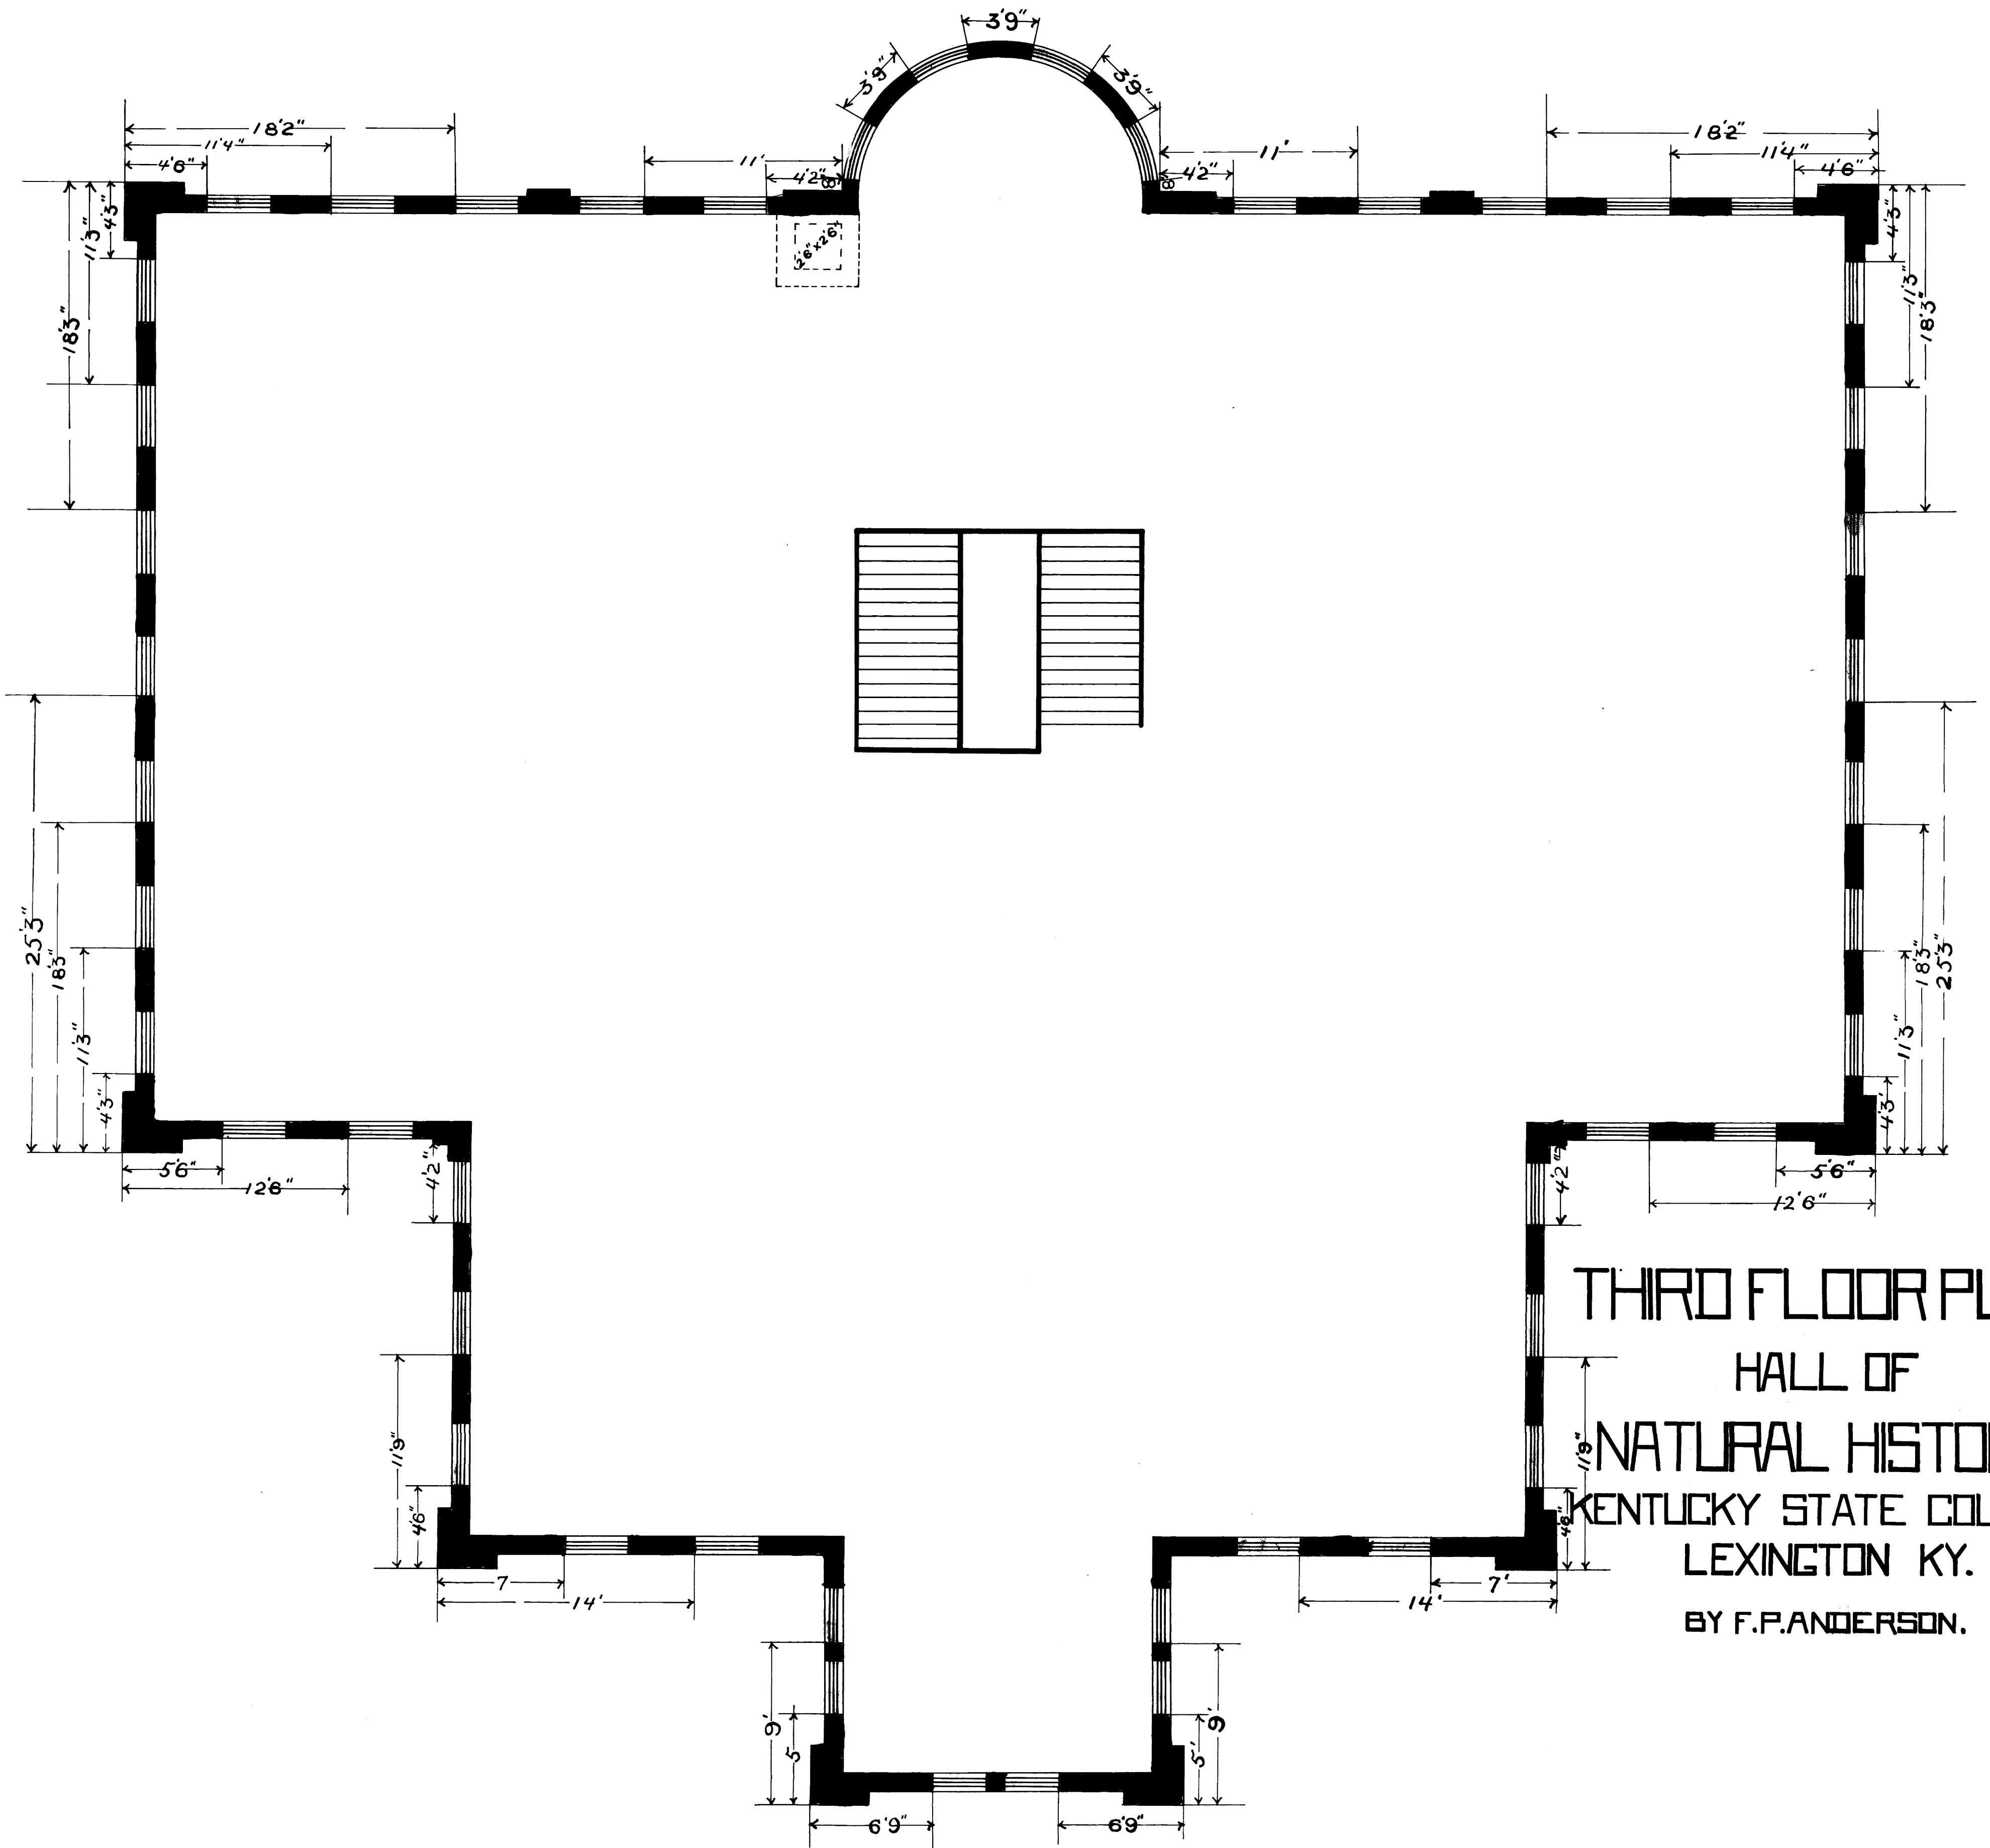


THIRD FLOOR PLAN  
 HALL OF  
 NATURAL HISTORY  
 KENTUCKY STATE COLLEGE  
 LEXINGTON KY.  
 BY F.P.ANDERSON.

SCALE  $\frac{3}{16}$ " = 1'

T. SHAMILTON, DEL.

Cab # Slot Document #

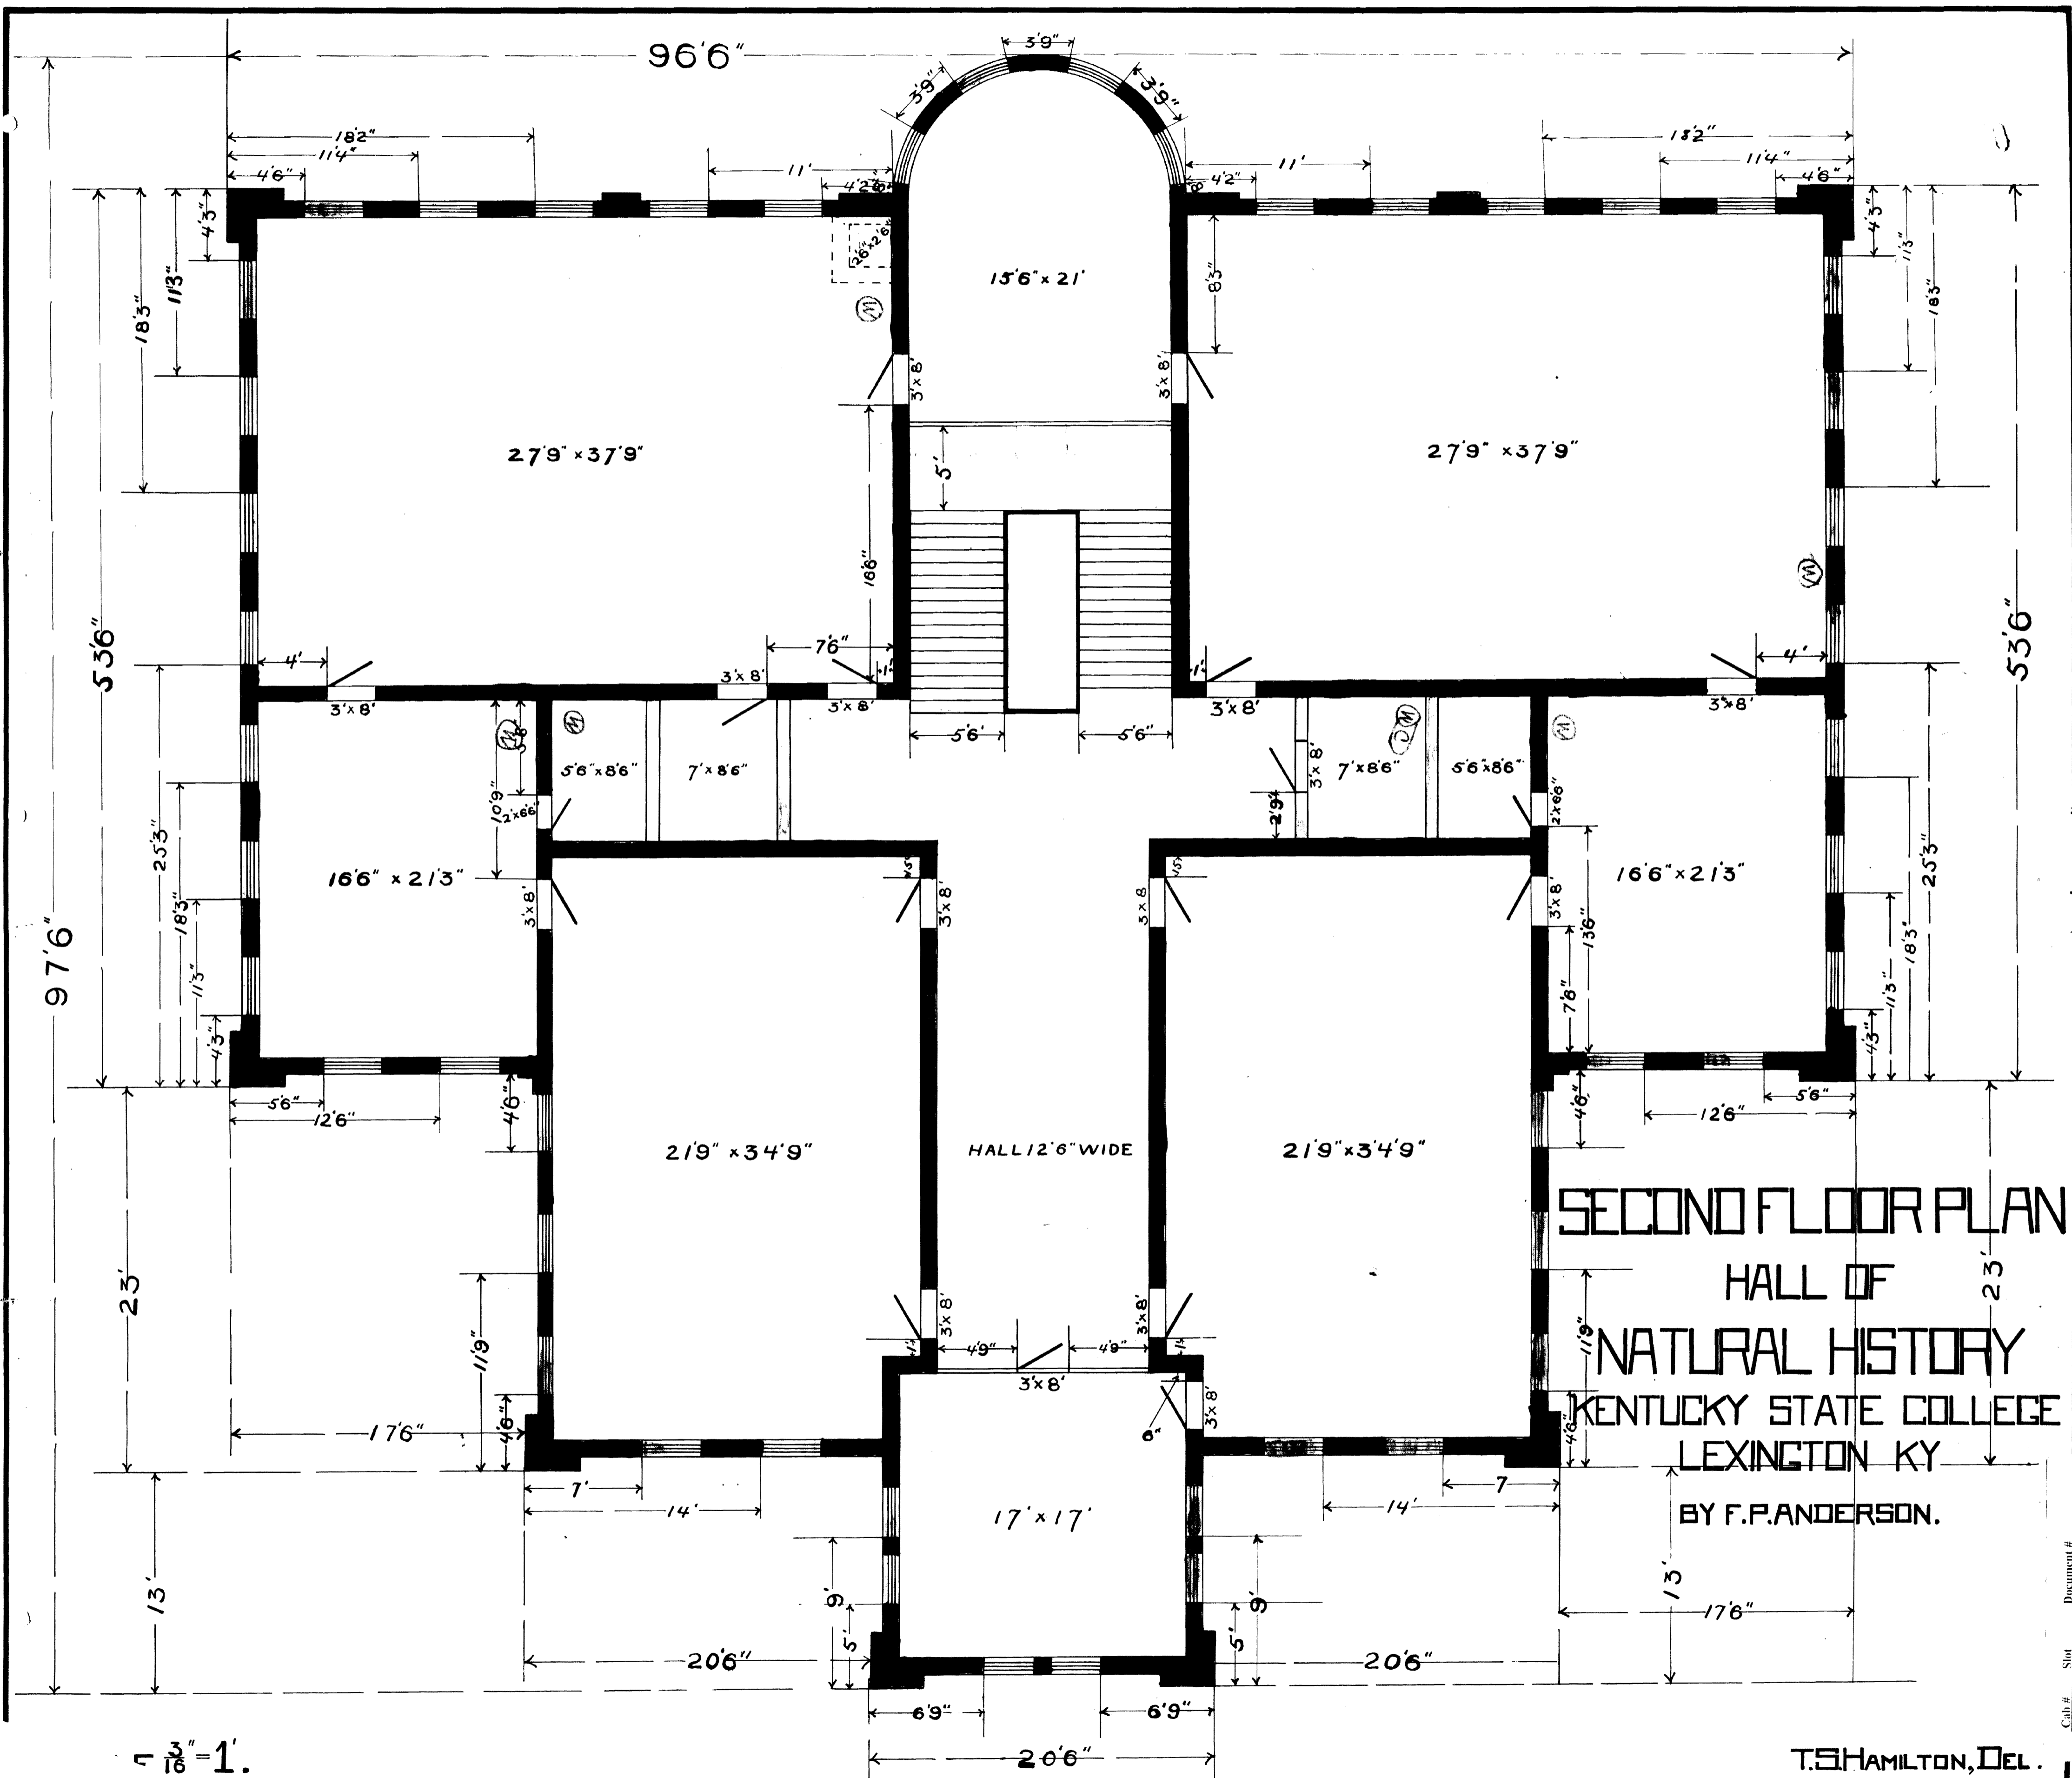


SECOND FLOOR PLAN  
 HALL OF  
 NATURAL HISTORY  
 KENTUCKY STATE COLLEGE  
 LEXINGTON KY  
 BY F.P. ANDERSON.

$\frac{1}{16}'' = 1'$

T.S. HAMILTON, DEL.

Cab # 80  
 Sheet A-1  
 Document # 012820

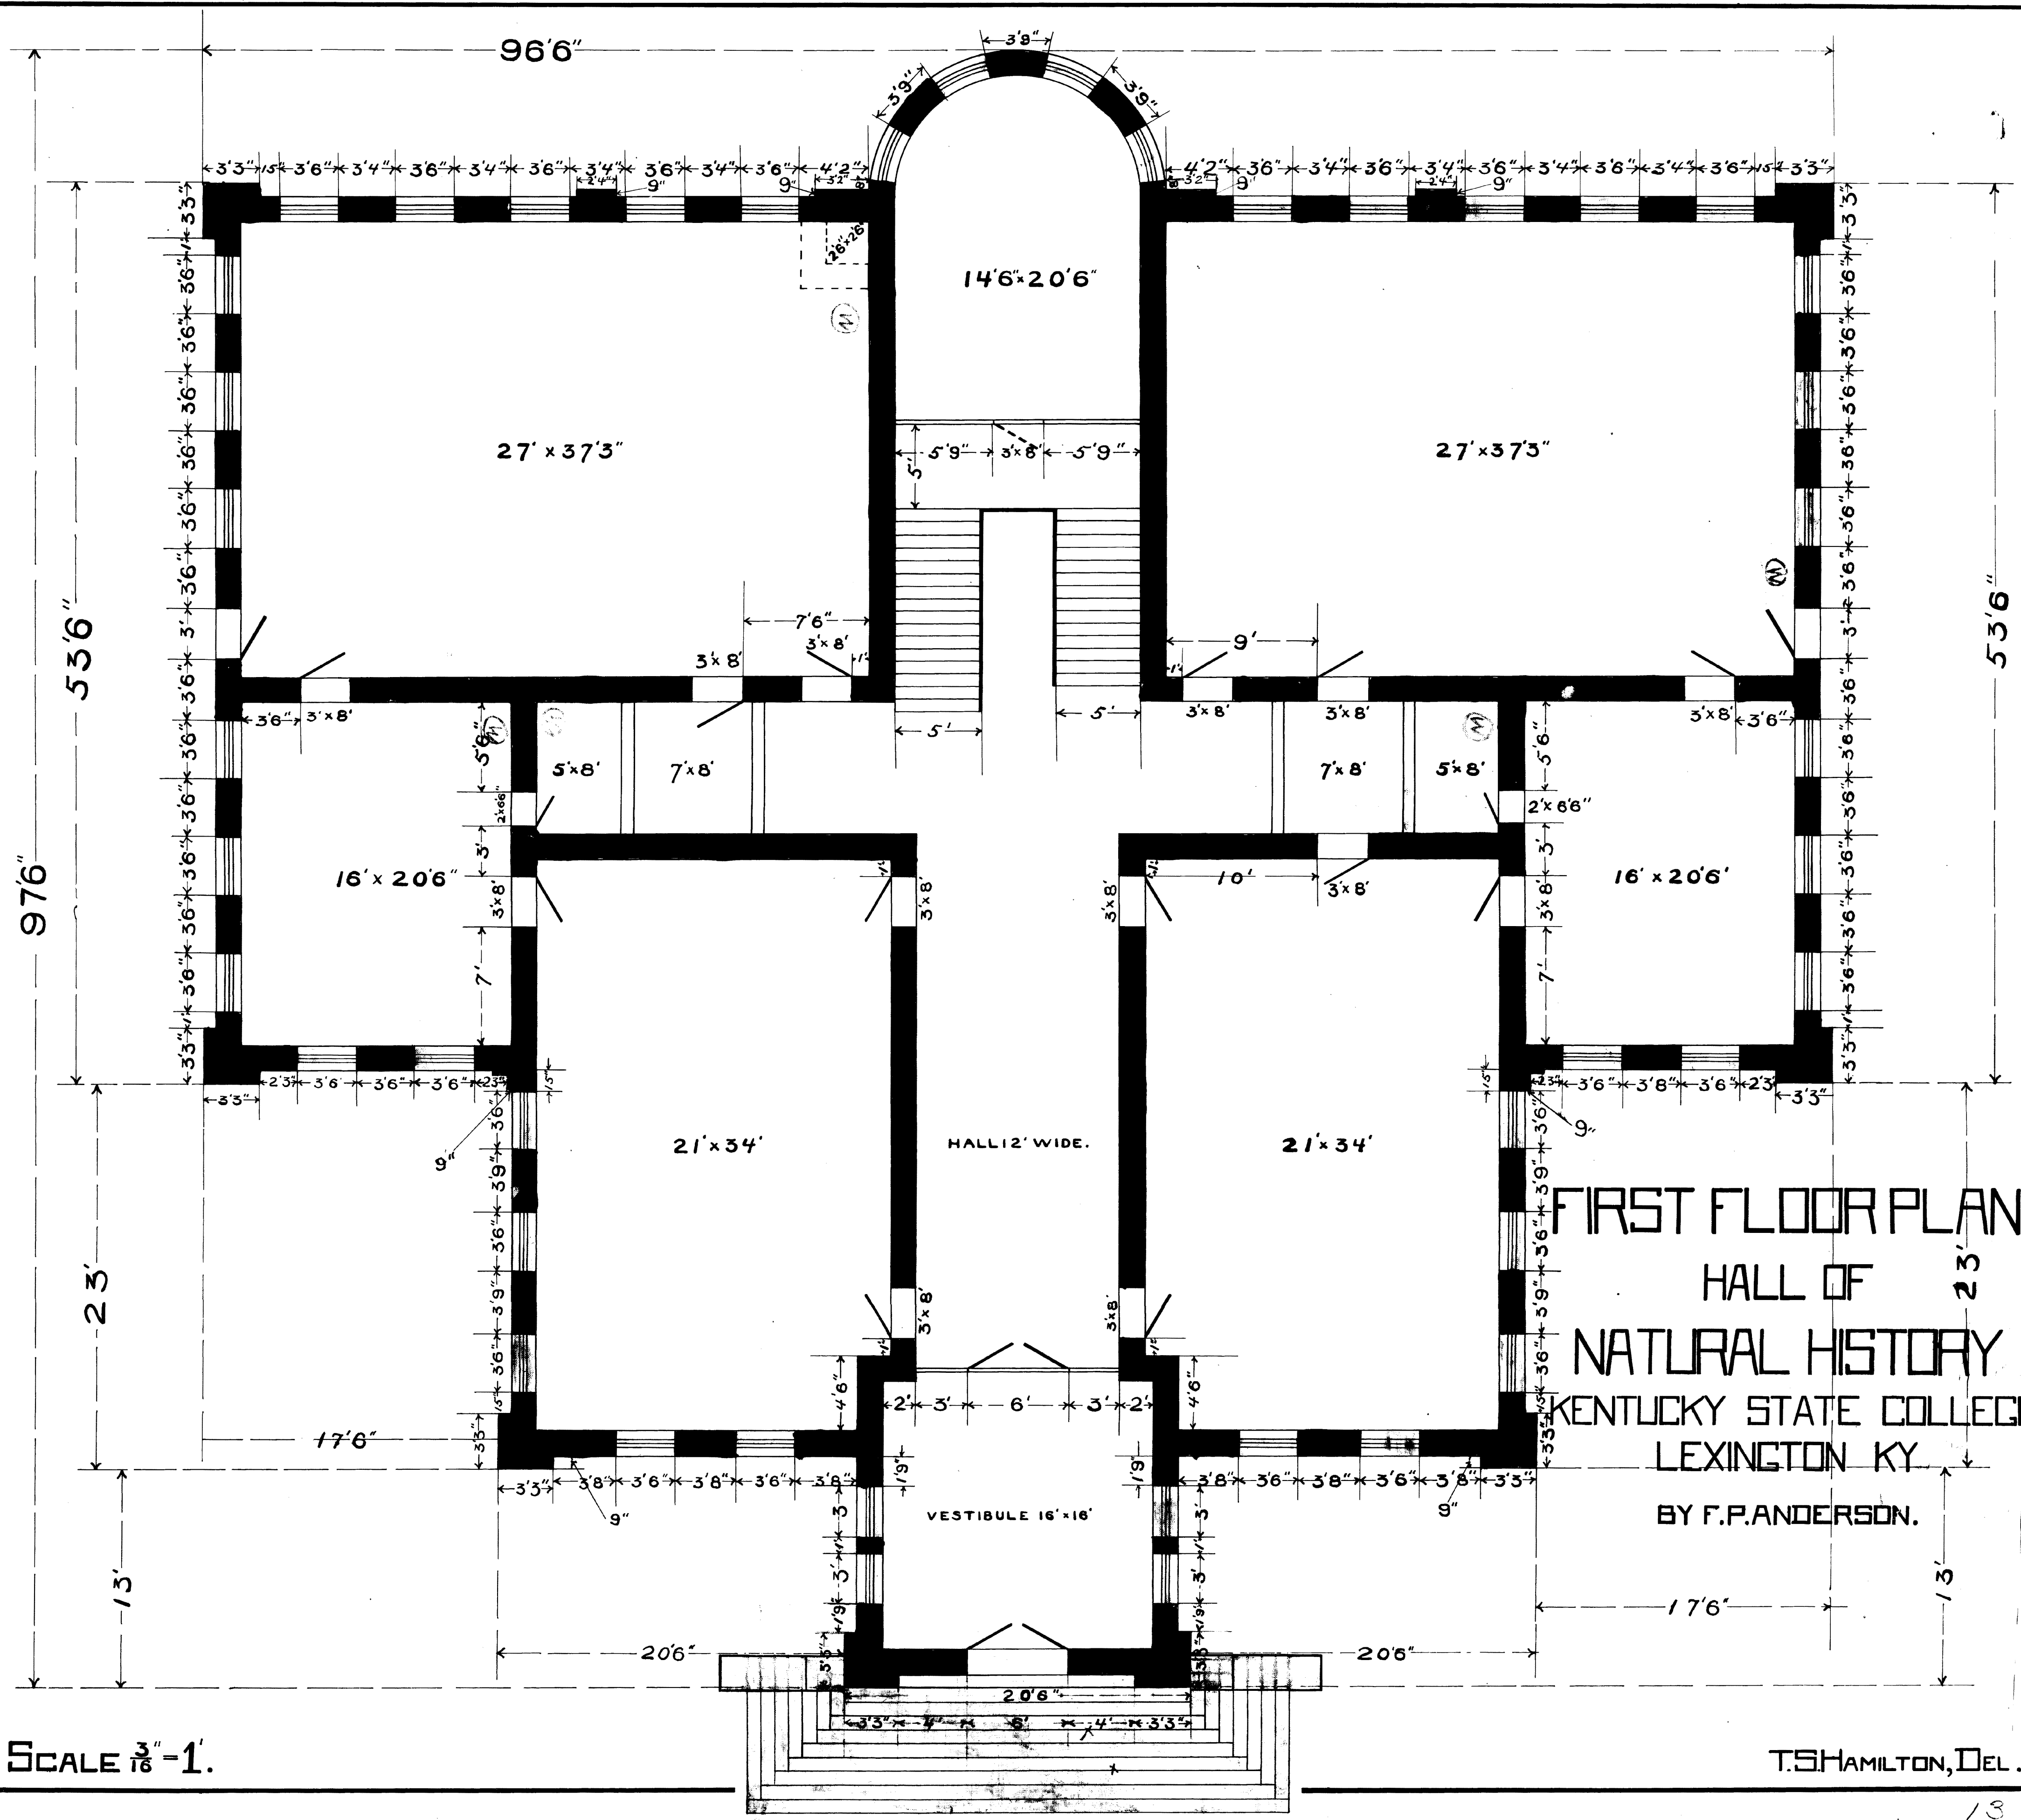


FIRST FLOOR PLAN  
 HALL OF  
 NATURAL HISTORY  
 KENTUCKY STATE COLLEGE  
 LEXINGTON KY  
 BY F.P. ANDERSON.

SCALE  $\frac{3}{16}'' = 1'$

T.S. HAMILTON, DEL.


Doc. # 012821  
 Sheet A-1  
 80

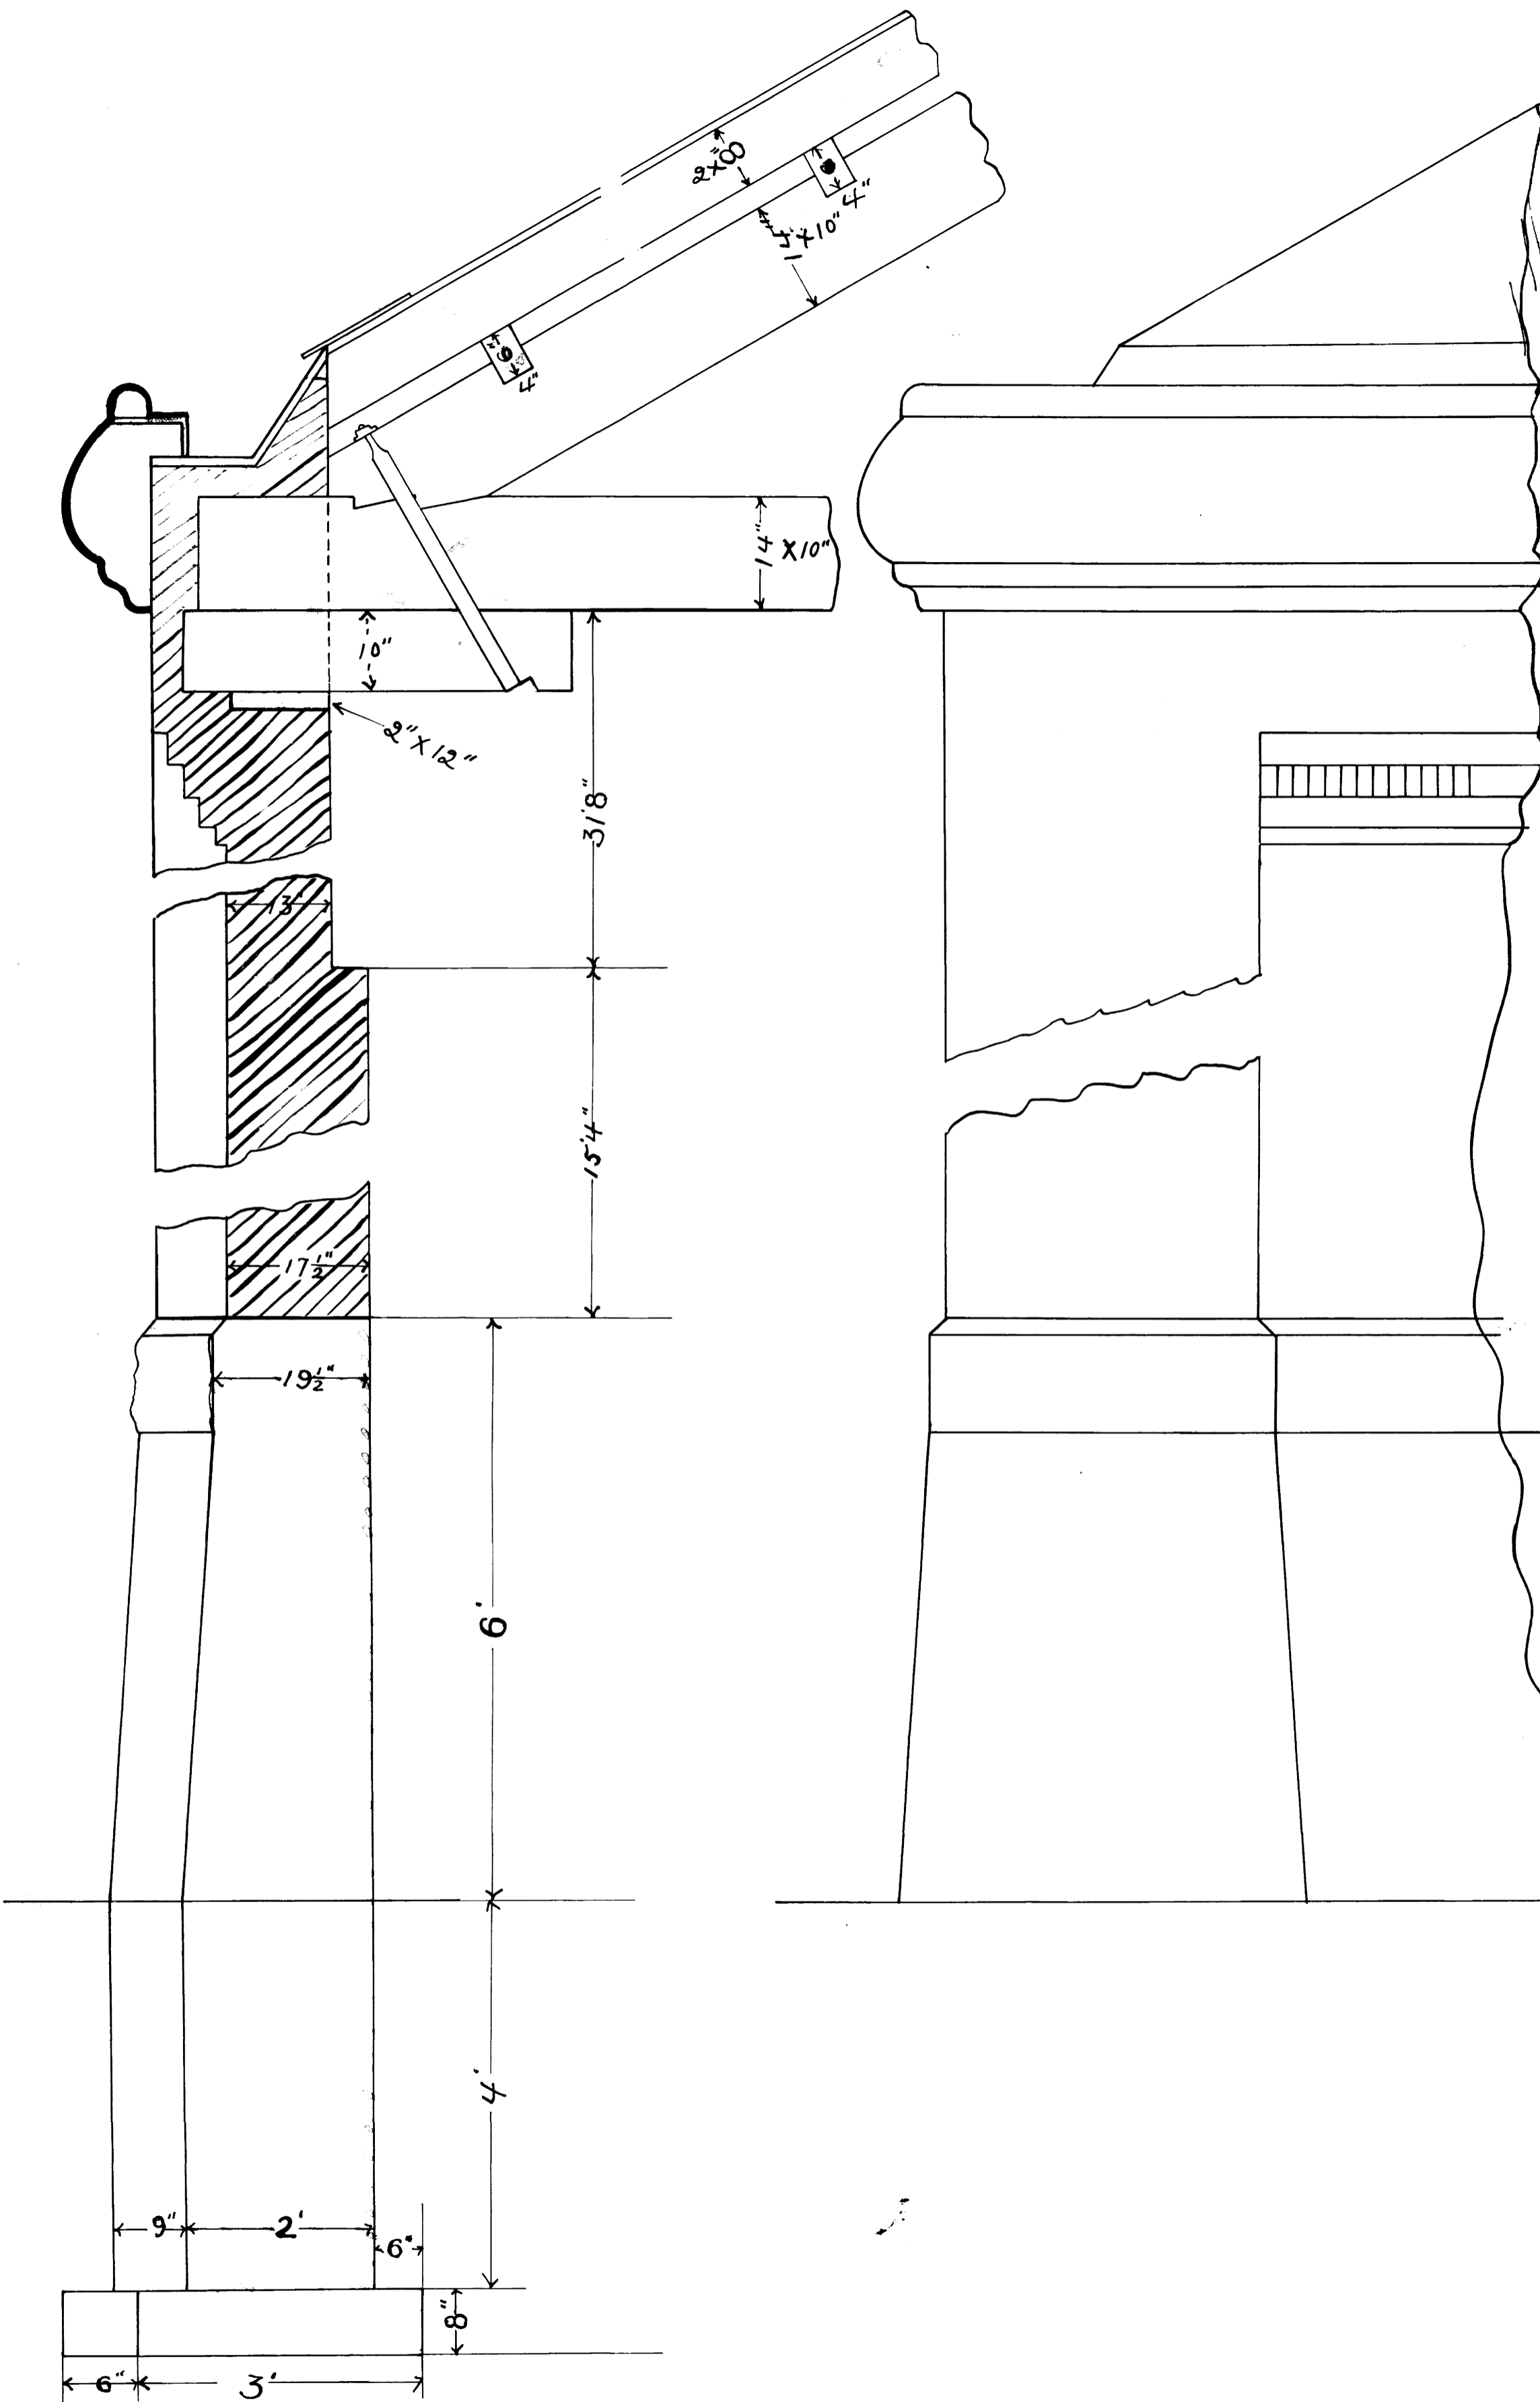

Scale  $\frac{3}{4}$

Cab #	Slot	Document #
80	A-1	012822

26/51

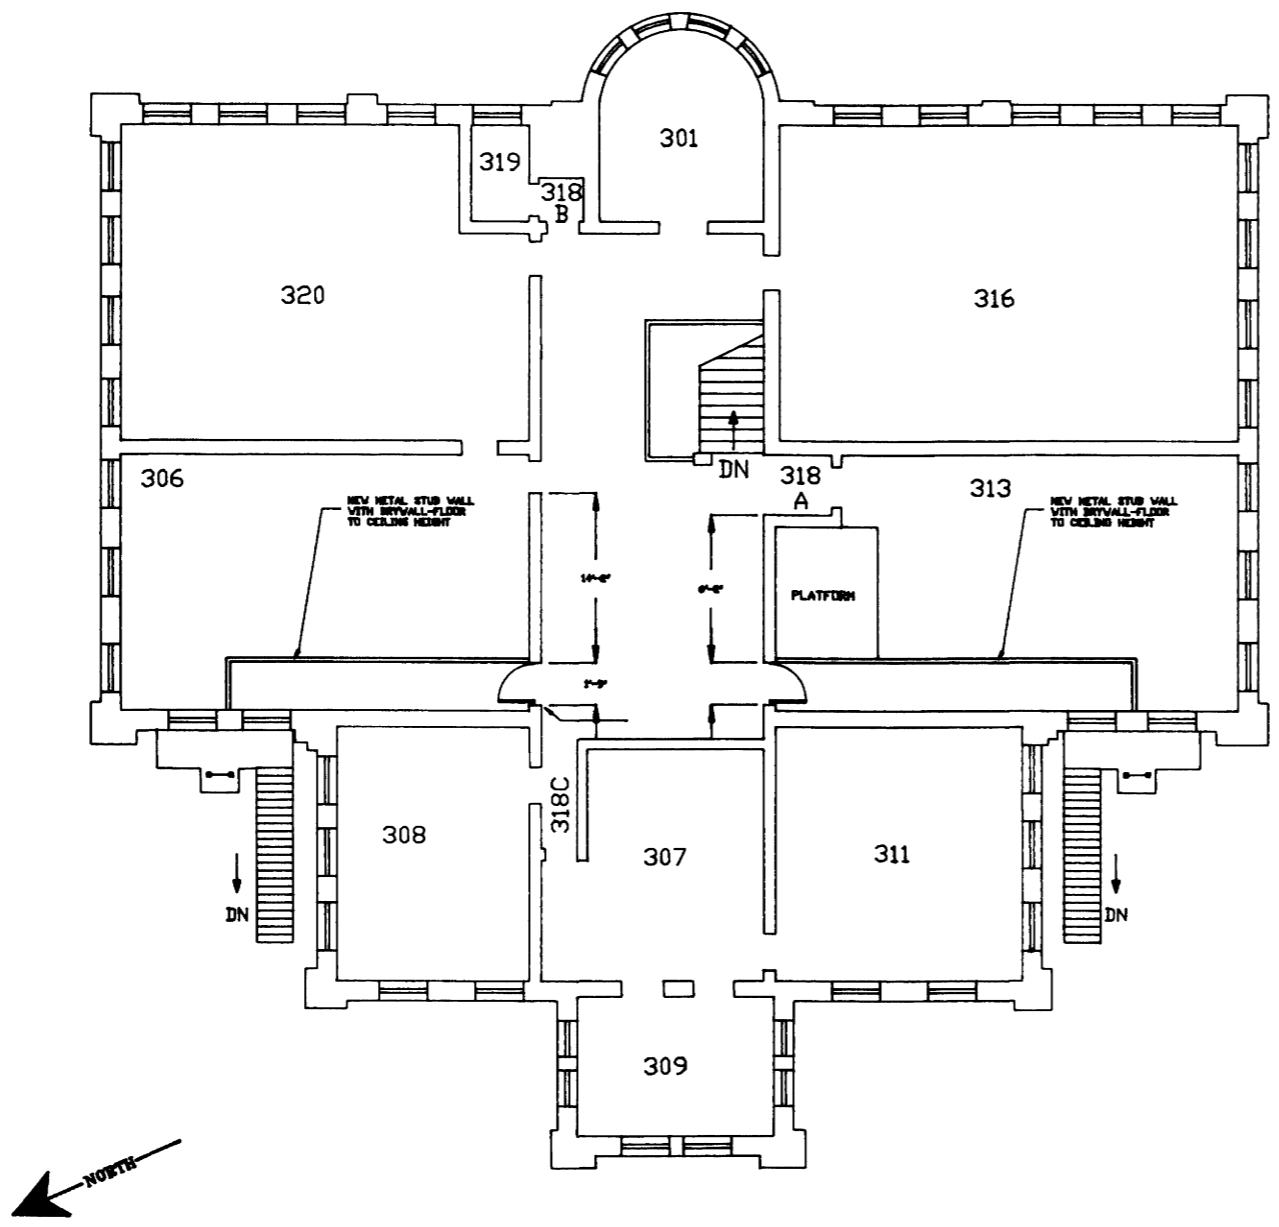

THIRD FLOOR PLAN  
 SCALE: 1/16"=1'-0"

DATE  
 5/14/90  
 REVISIONS BY  
 ASM


BLDG #  
 0035  
 MILLER HALL  
 EGRESS RENOVATION

PHYSICAL  
 PLANT  
 DIVISION  
**UK**

SHEET  
 1 OF 4

Cab # Slot Document #

201 D-1 28925

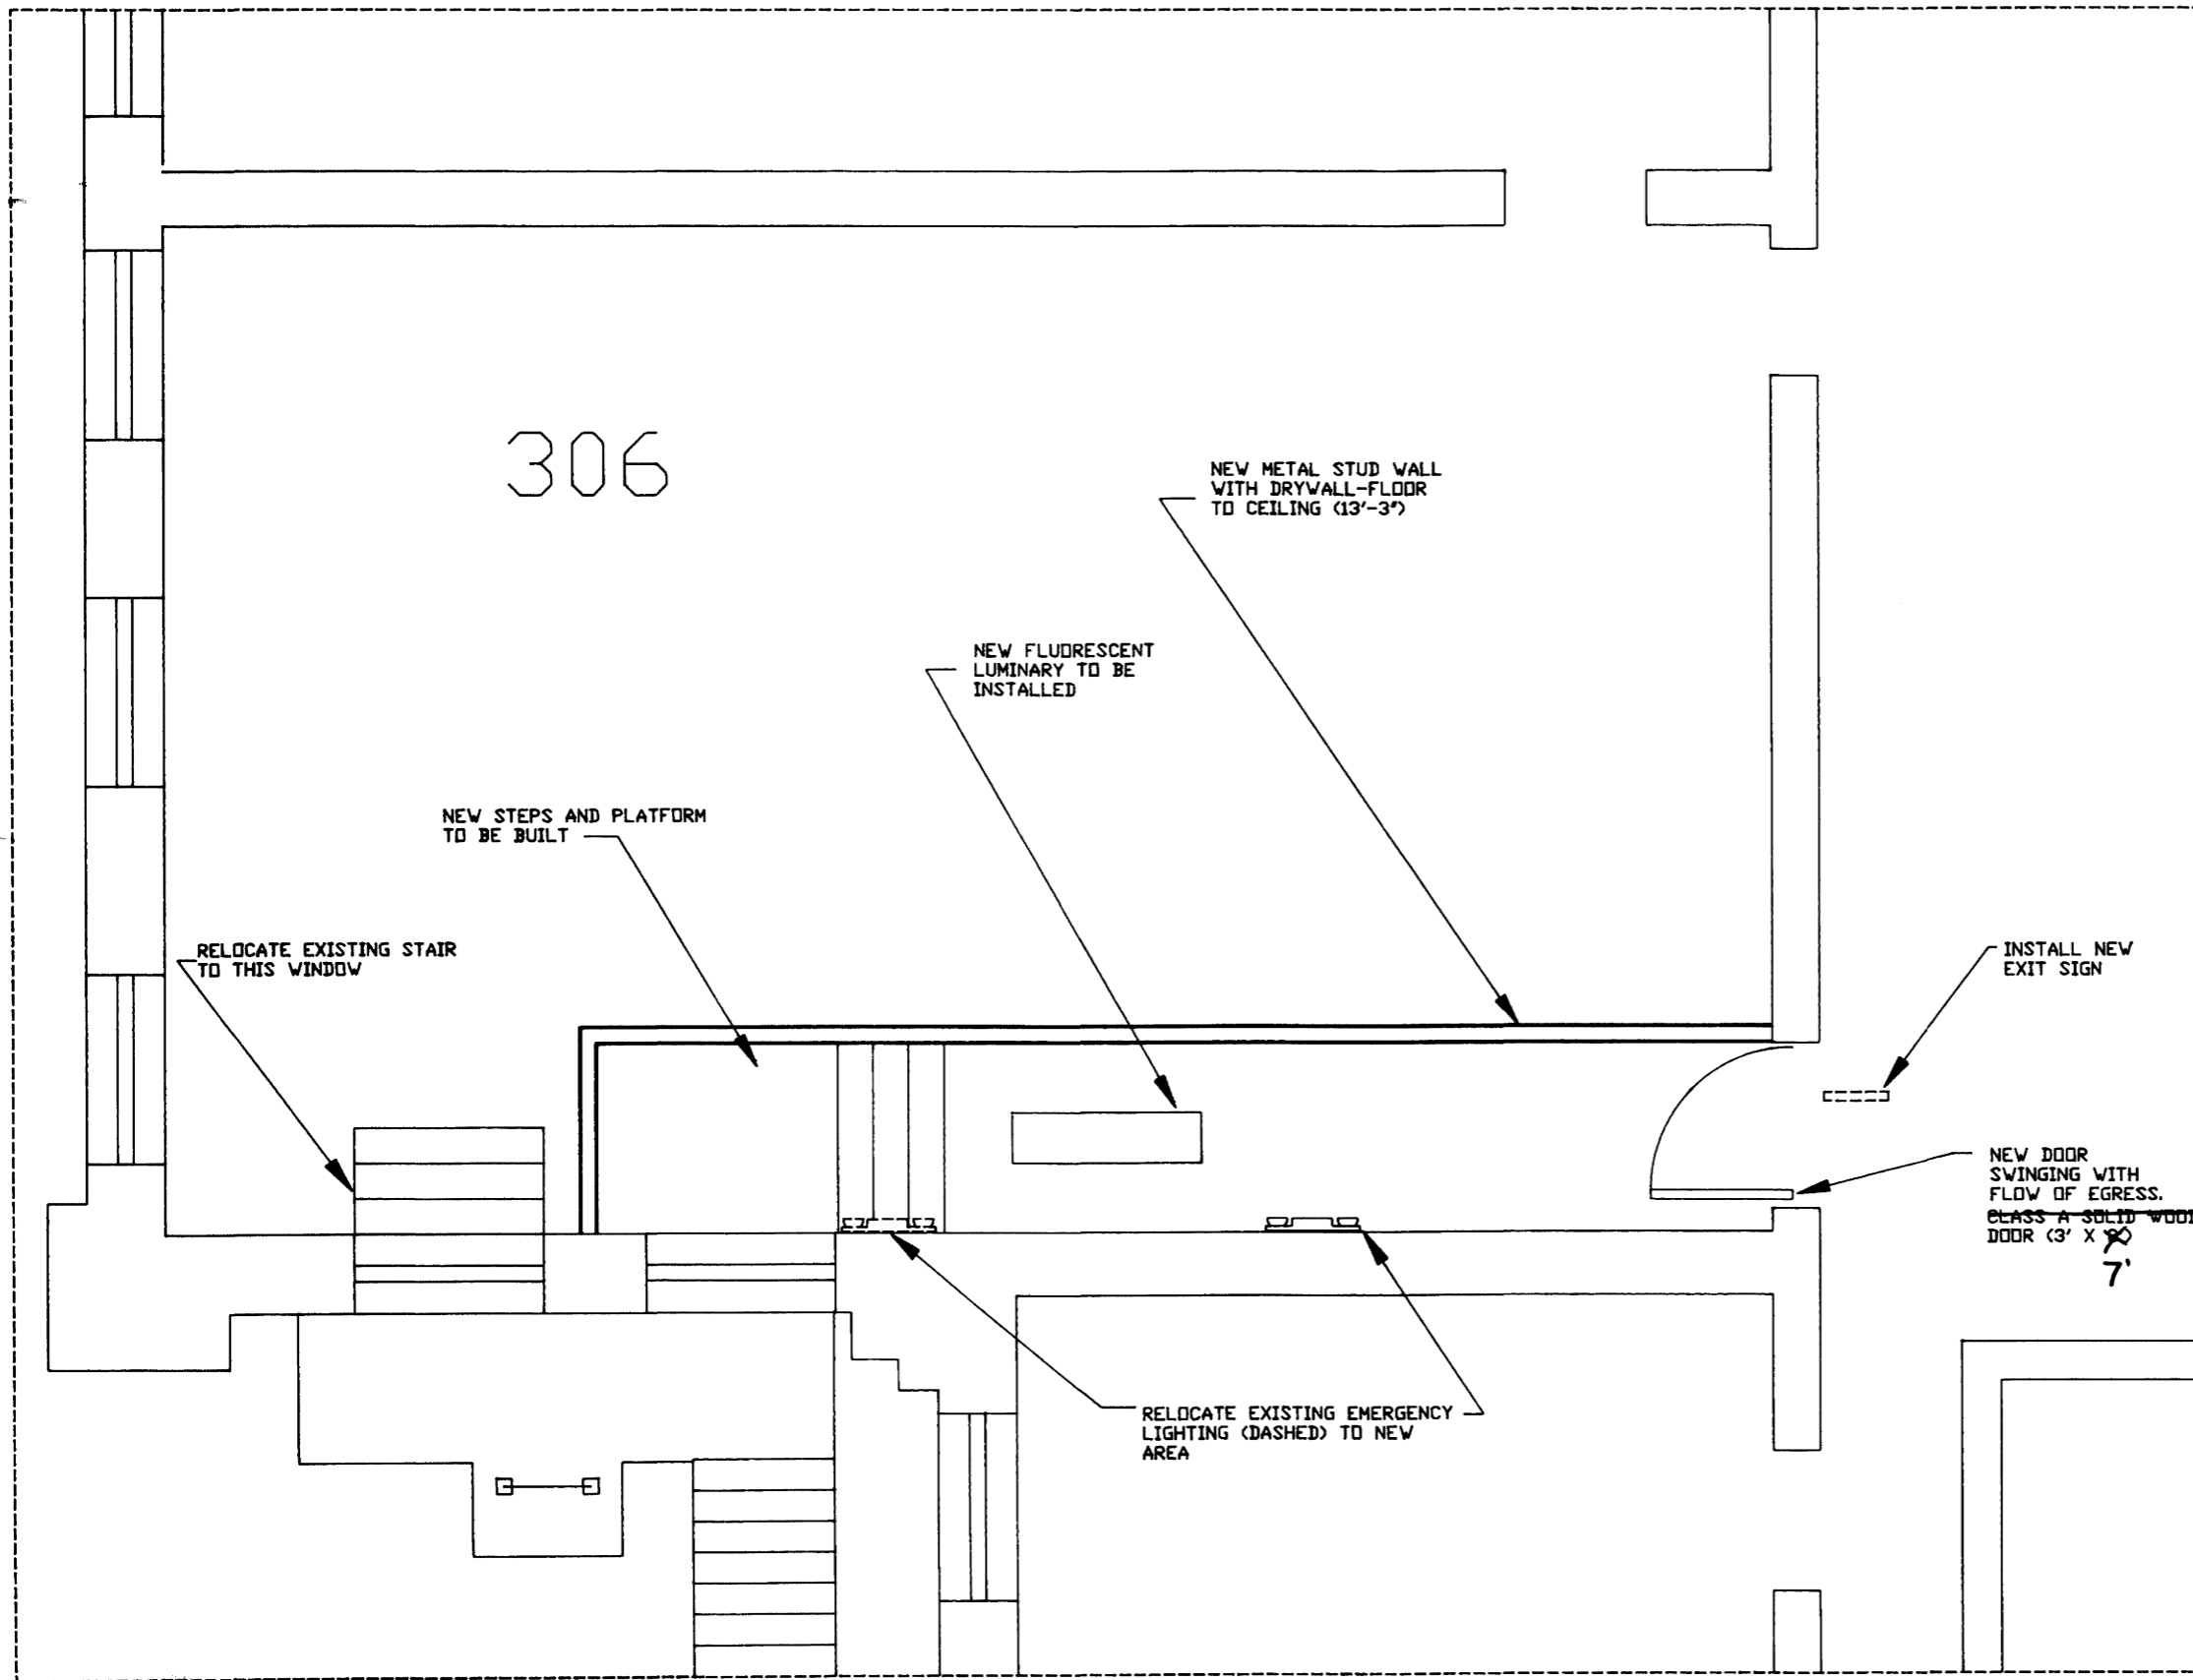

306

RELOCATE EXISTING STAIR TO THIS WINDOW

NEW STEPS AND PLATFORM TO BE BUILT

NEW FLUORESCENT LUMINARY TO BE INSTALLED


NEW METAL STUD WALL WITH DRYWALL-FLOOR TO CEILING (13'-3")

INSTALL NEW EXIT SIGN

NEW DOOR SWINGING WITH FLOW OF EGRESS. CLASS A SOLID WOOD DOOR (3' X 7')

RELOCATE EXISTING EMERGENCY LIGHTING (DASHED) TO NEW AREA

SCALE  
1/4"=1'-0"

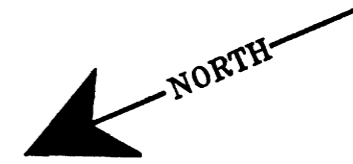


DATE  
5/14/90  
REVISED BY  
ASM

BLDG #  
0035  
MILLER HALL  
EGRESS RENOVATION

PHYSICAL PLANT DIVISION #  
**UK**  
Slot Document #

SHEET  
2 OF 4



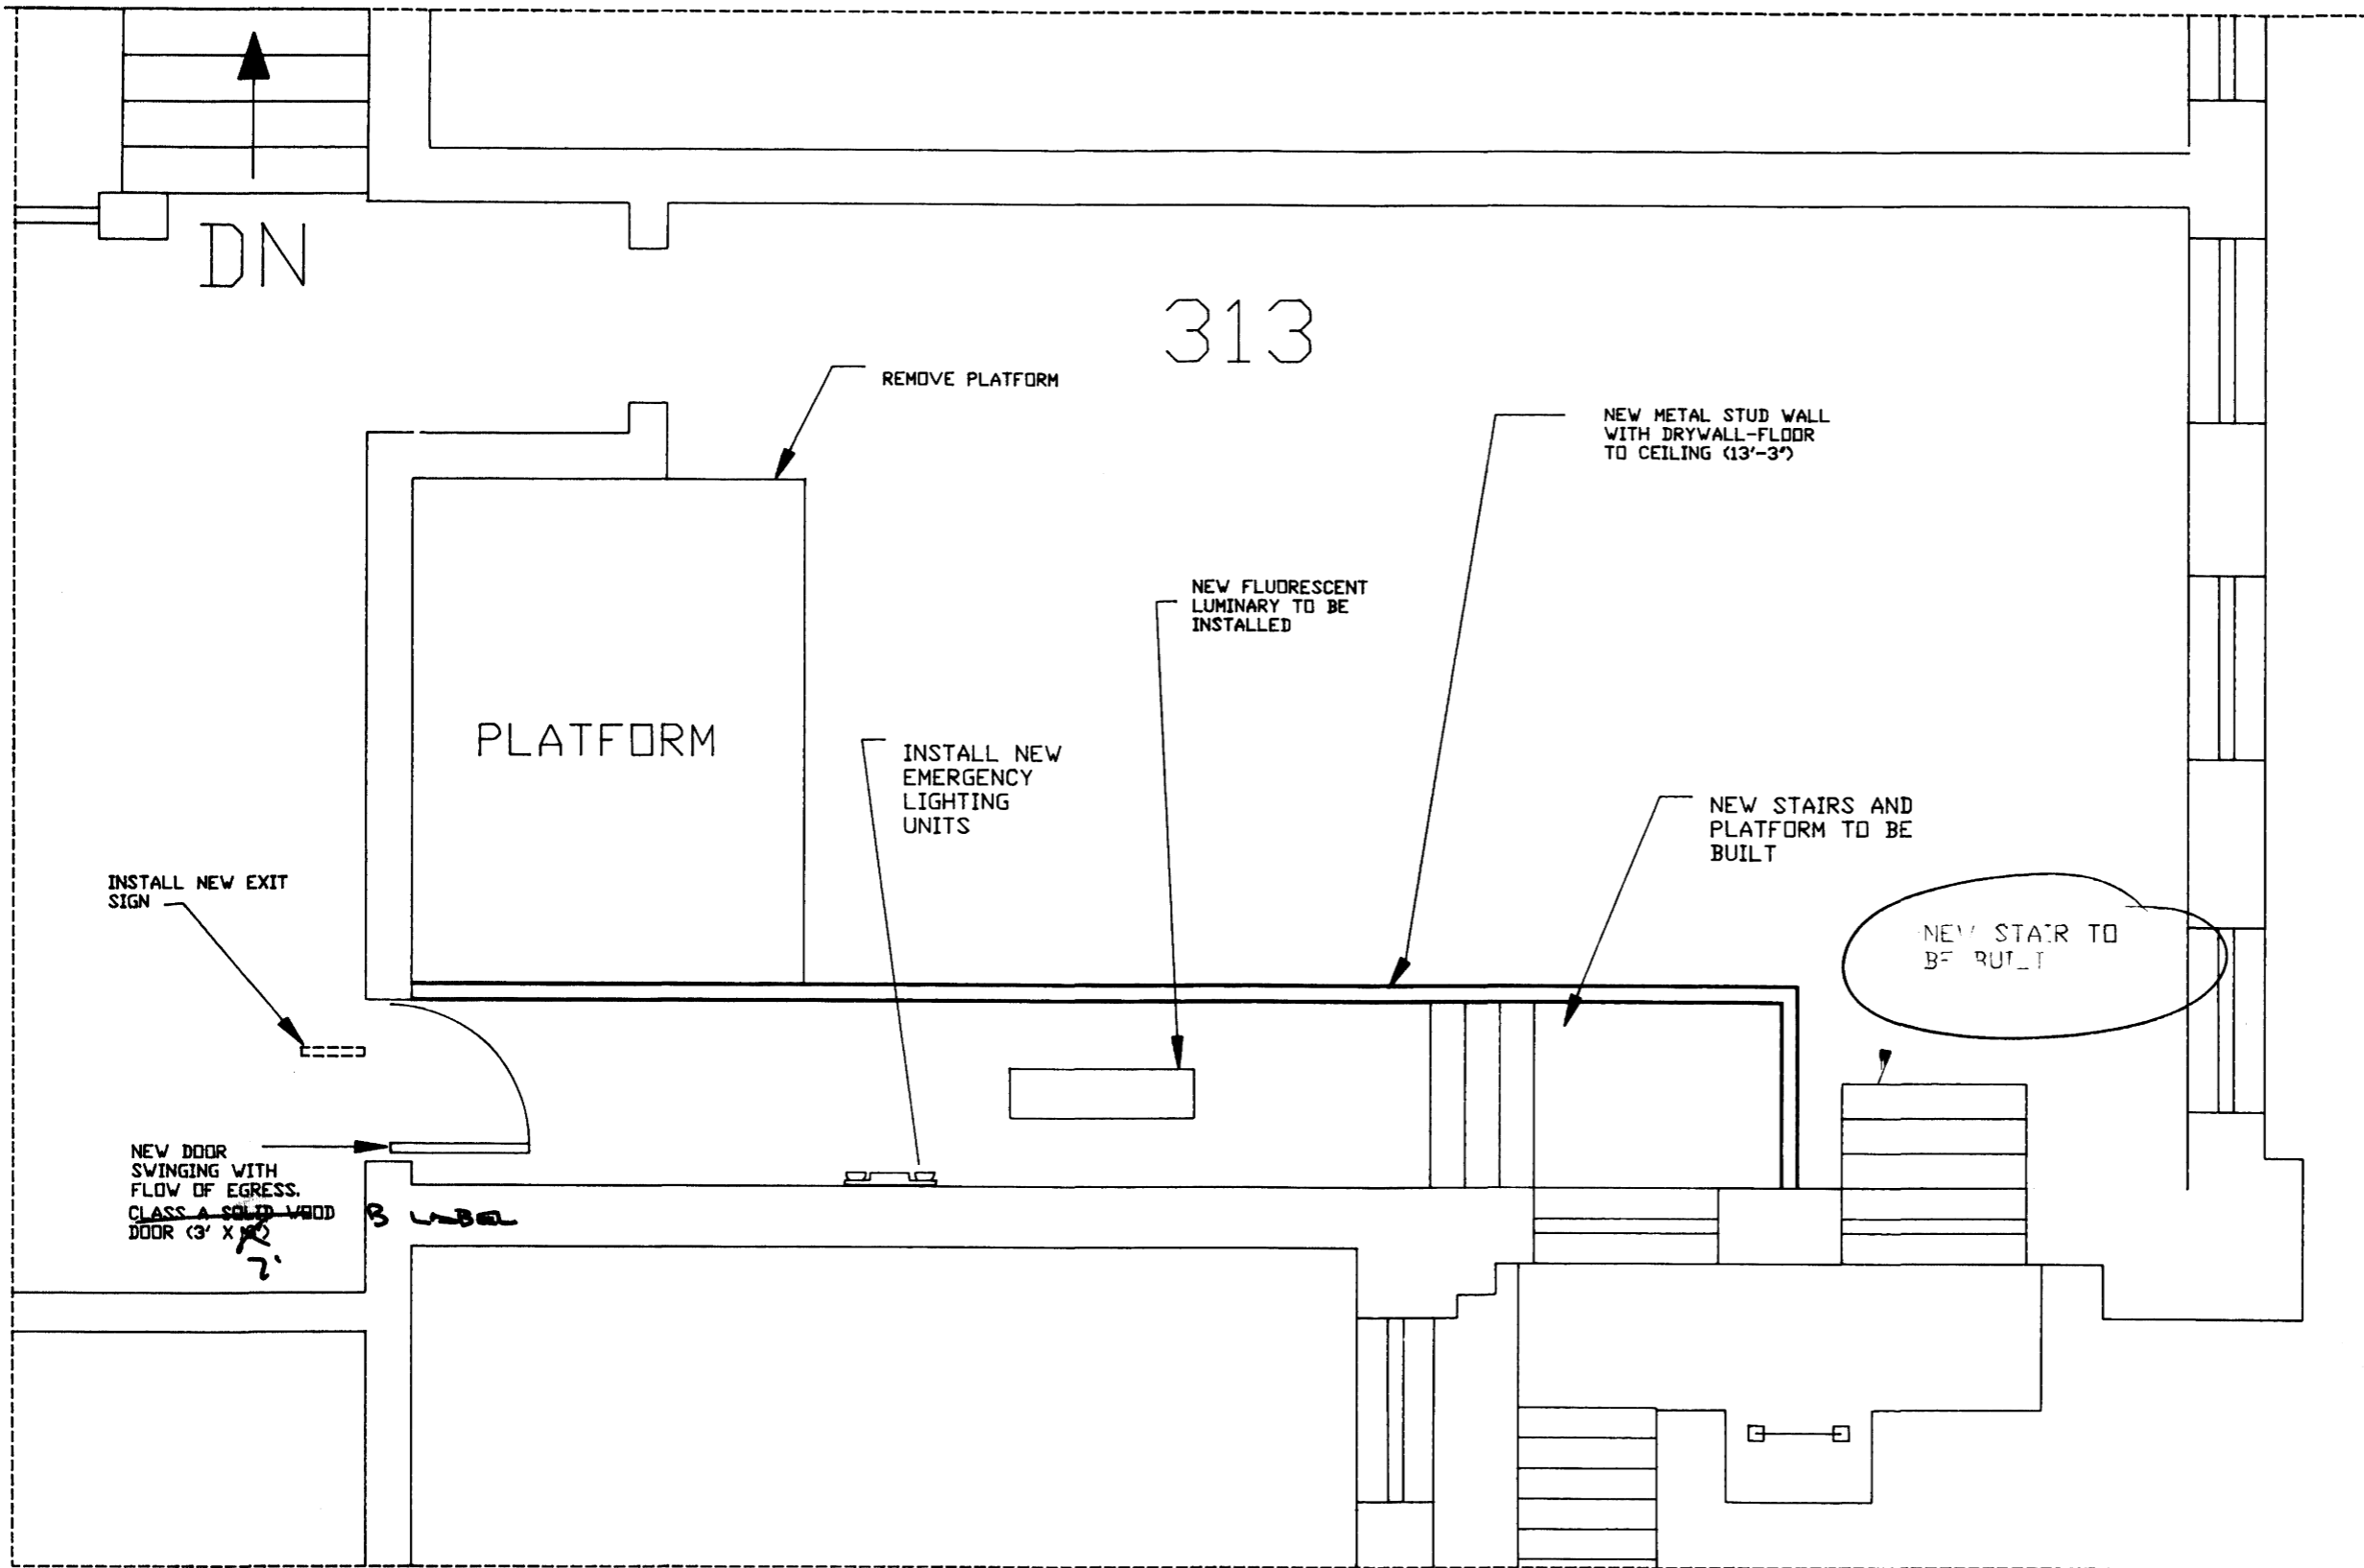

SCALE: 1/4" = 1'-0"

DATE  
5/14/90  
REVISED BY  
ASM

BLDG #  
0035

MILLER HALL  
EGRESS RENOVATION


PHYSICAL  
PLANT  
DIVISION



SHEET  
3 OF 4

Cab # Slot Document #

201 D-1 28927

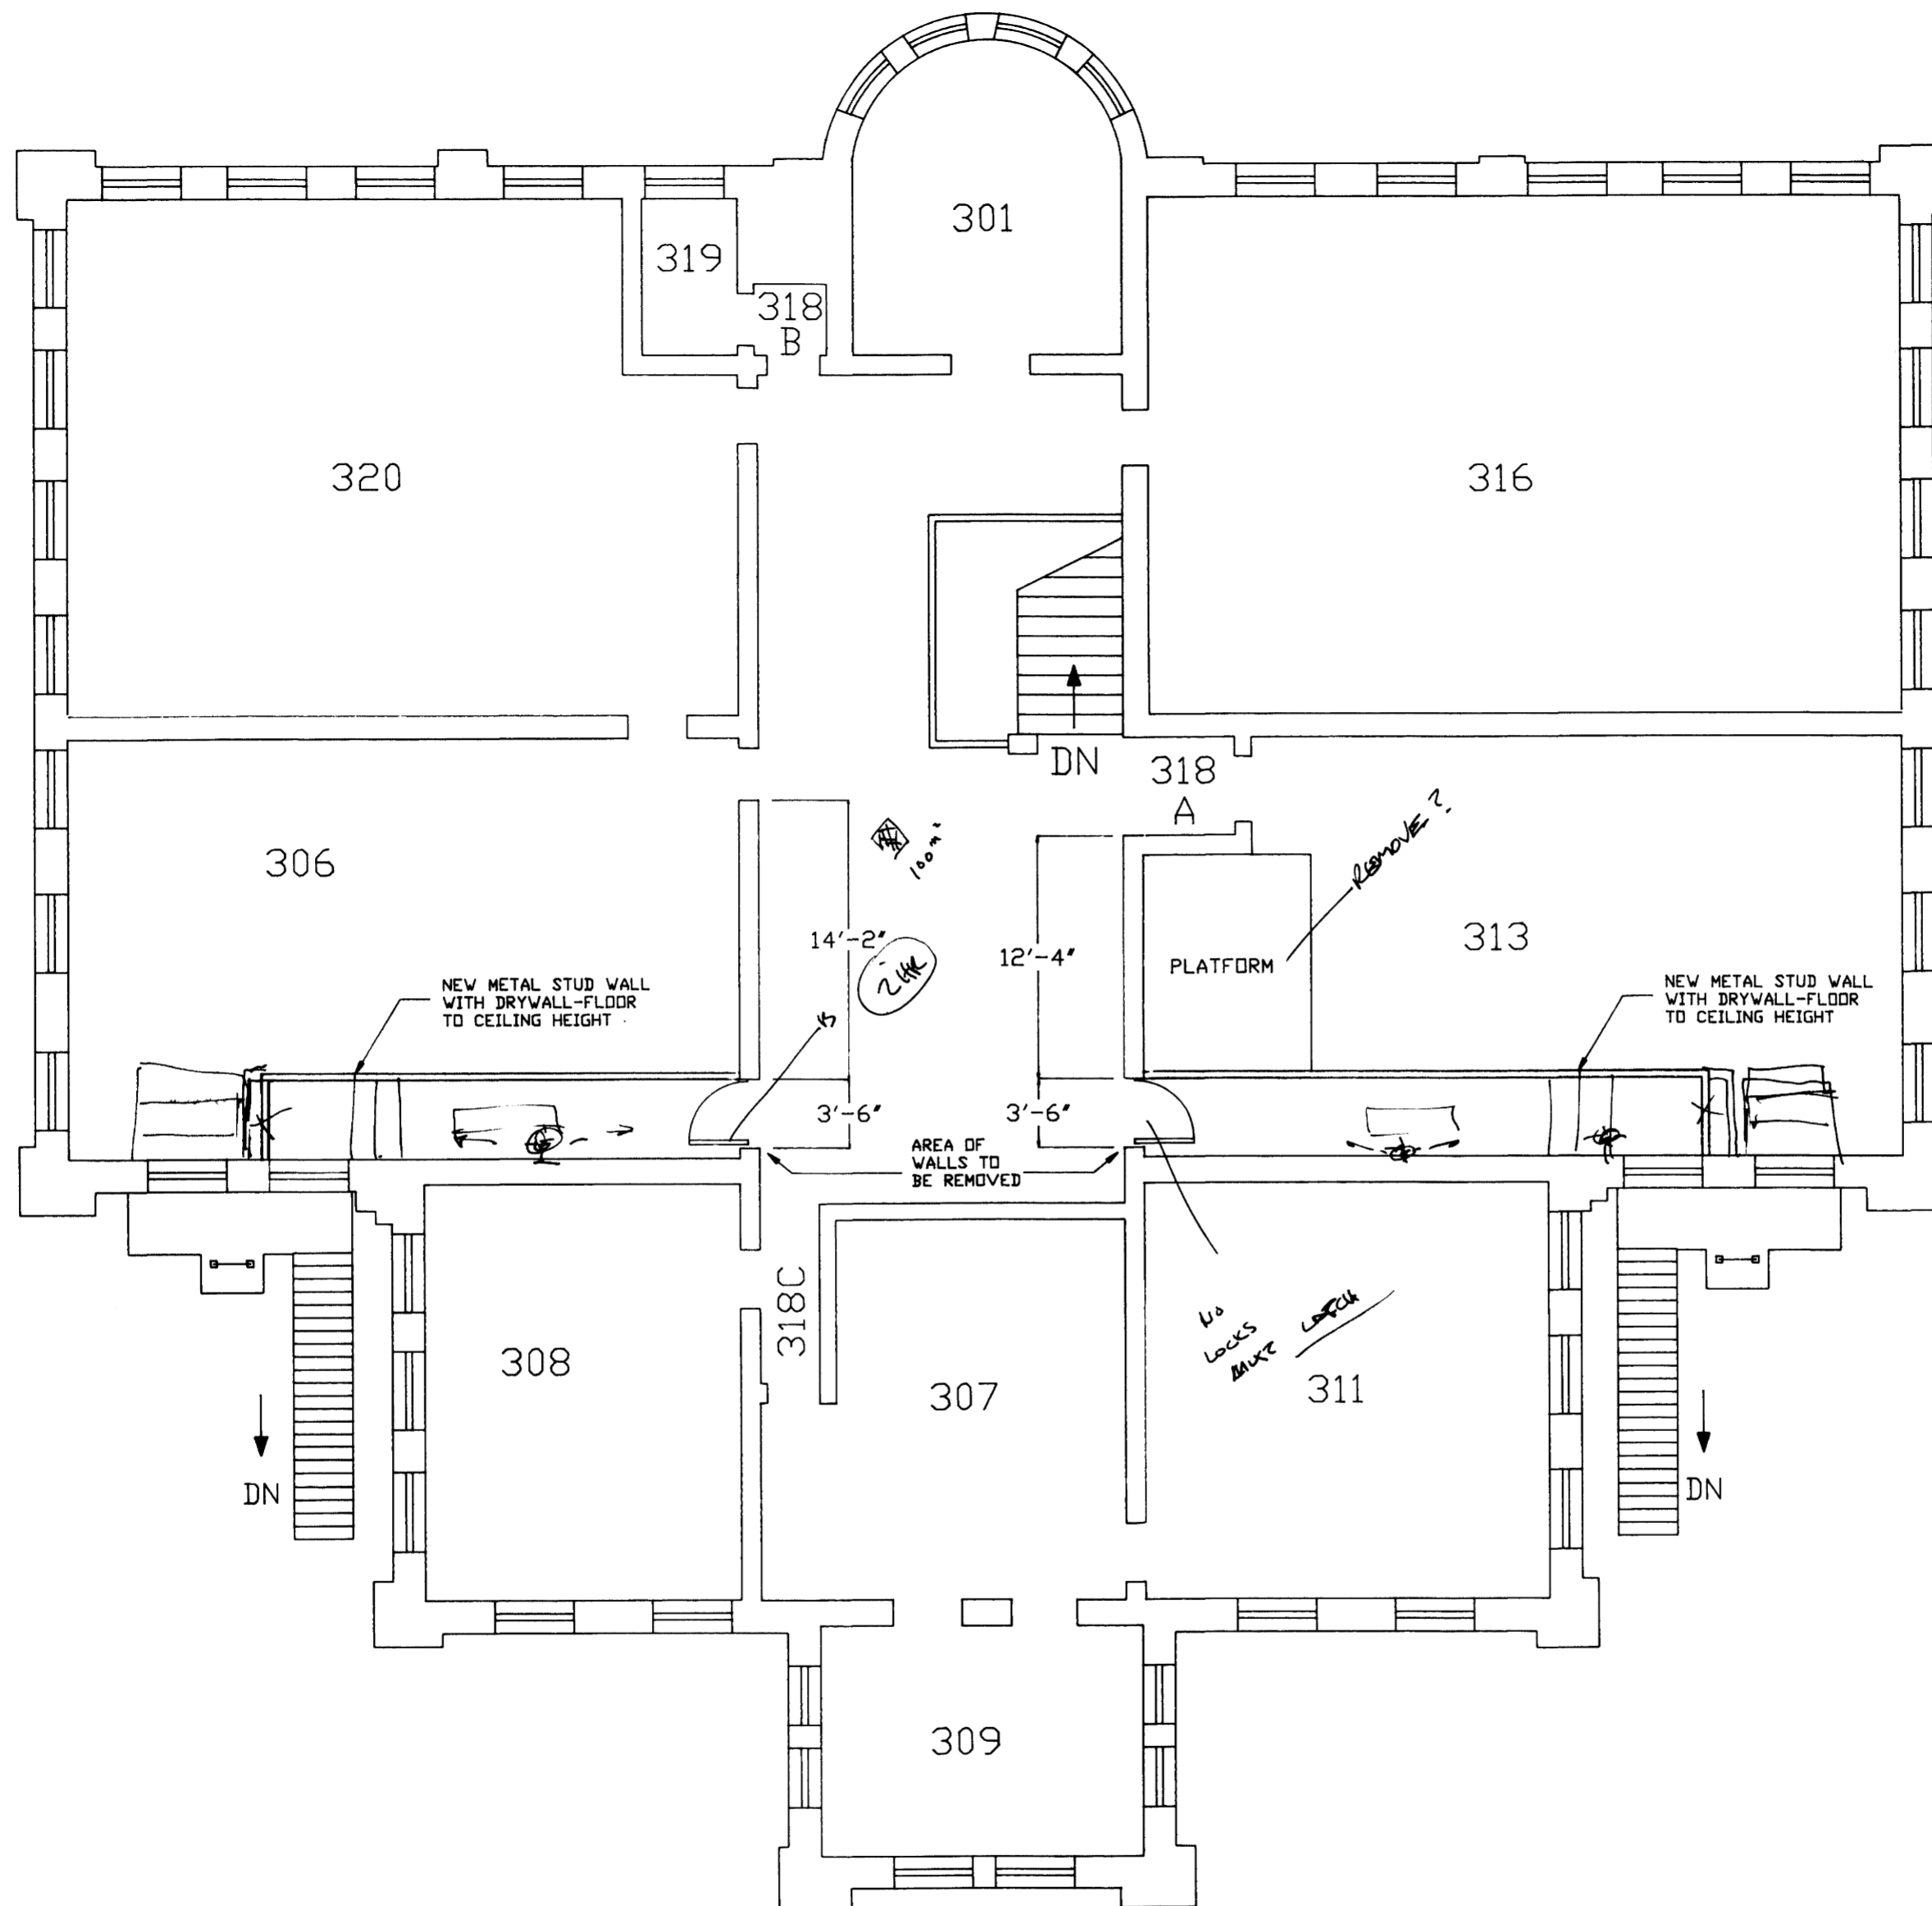

THIRD FLOOR PLAN


SCALE: 1/8" = 1'-0"

DATE  
7-17-90  
REVISD BY  
ASM

BLDG #  
0035  
MILLER HALL  
EGRESS RENOVATION

PHYSICAL  
PLANT  
DIVISION  
**UK**

SHEET  
4 OF 4

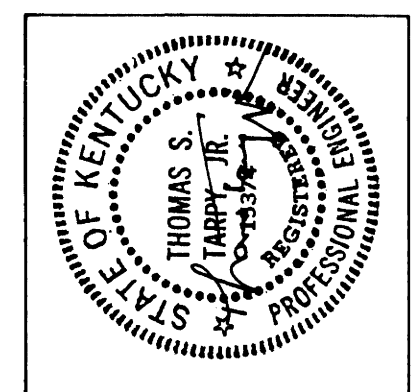


**Stanley D. Lindsey & Associates, Ltd.**  
 STRUCTURAL ENGINEERS  
 2244 Metrocenter Blvd., Suite 208  
 Nashville, Tennessee 37228-1920  
 (615) 244-2211 Fax: (615) 244-0387  
 Project Number: 83-1440

University of Kentucky  
 Lexington, Kentucky  
 OFFICIAL BID DOCUMENT  
 PROJECT: MILLER HALL RENOVATION


**BASEMENT AND FIRST FLOOR PLANS**  
**MILLER HALL RENOVATION**  
 Lexington Campus Sector  
 University of Kentucky

project no. 1465.0  
 date 20 AUGUST 93  
 file no.  
 dr. by A.W.M.  
 ck. by C.B.

revisions
2.2

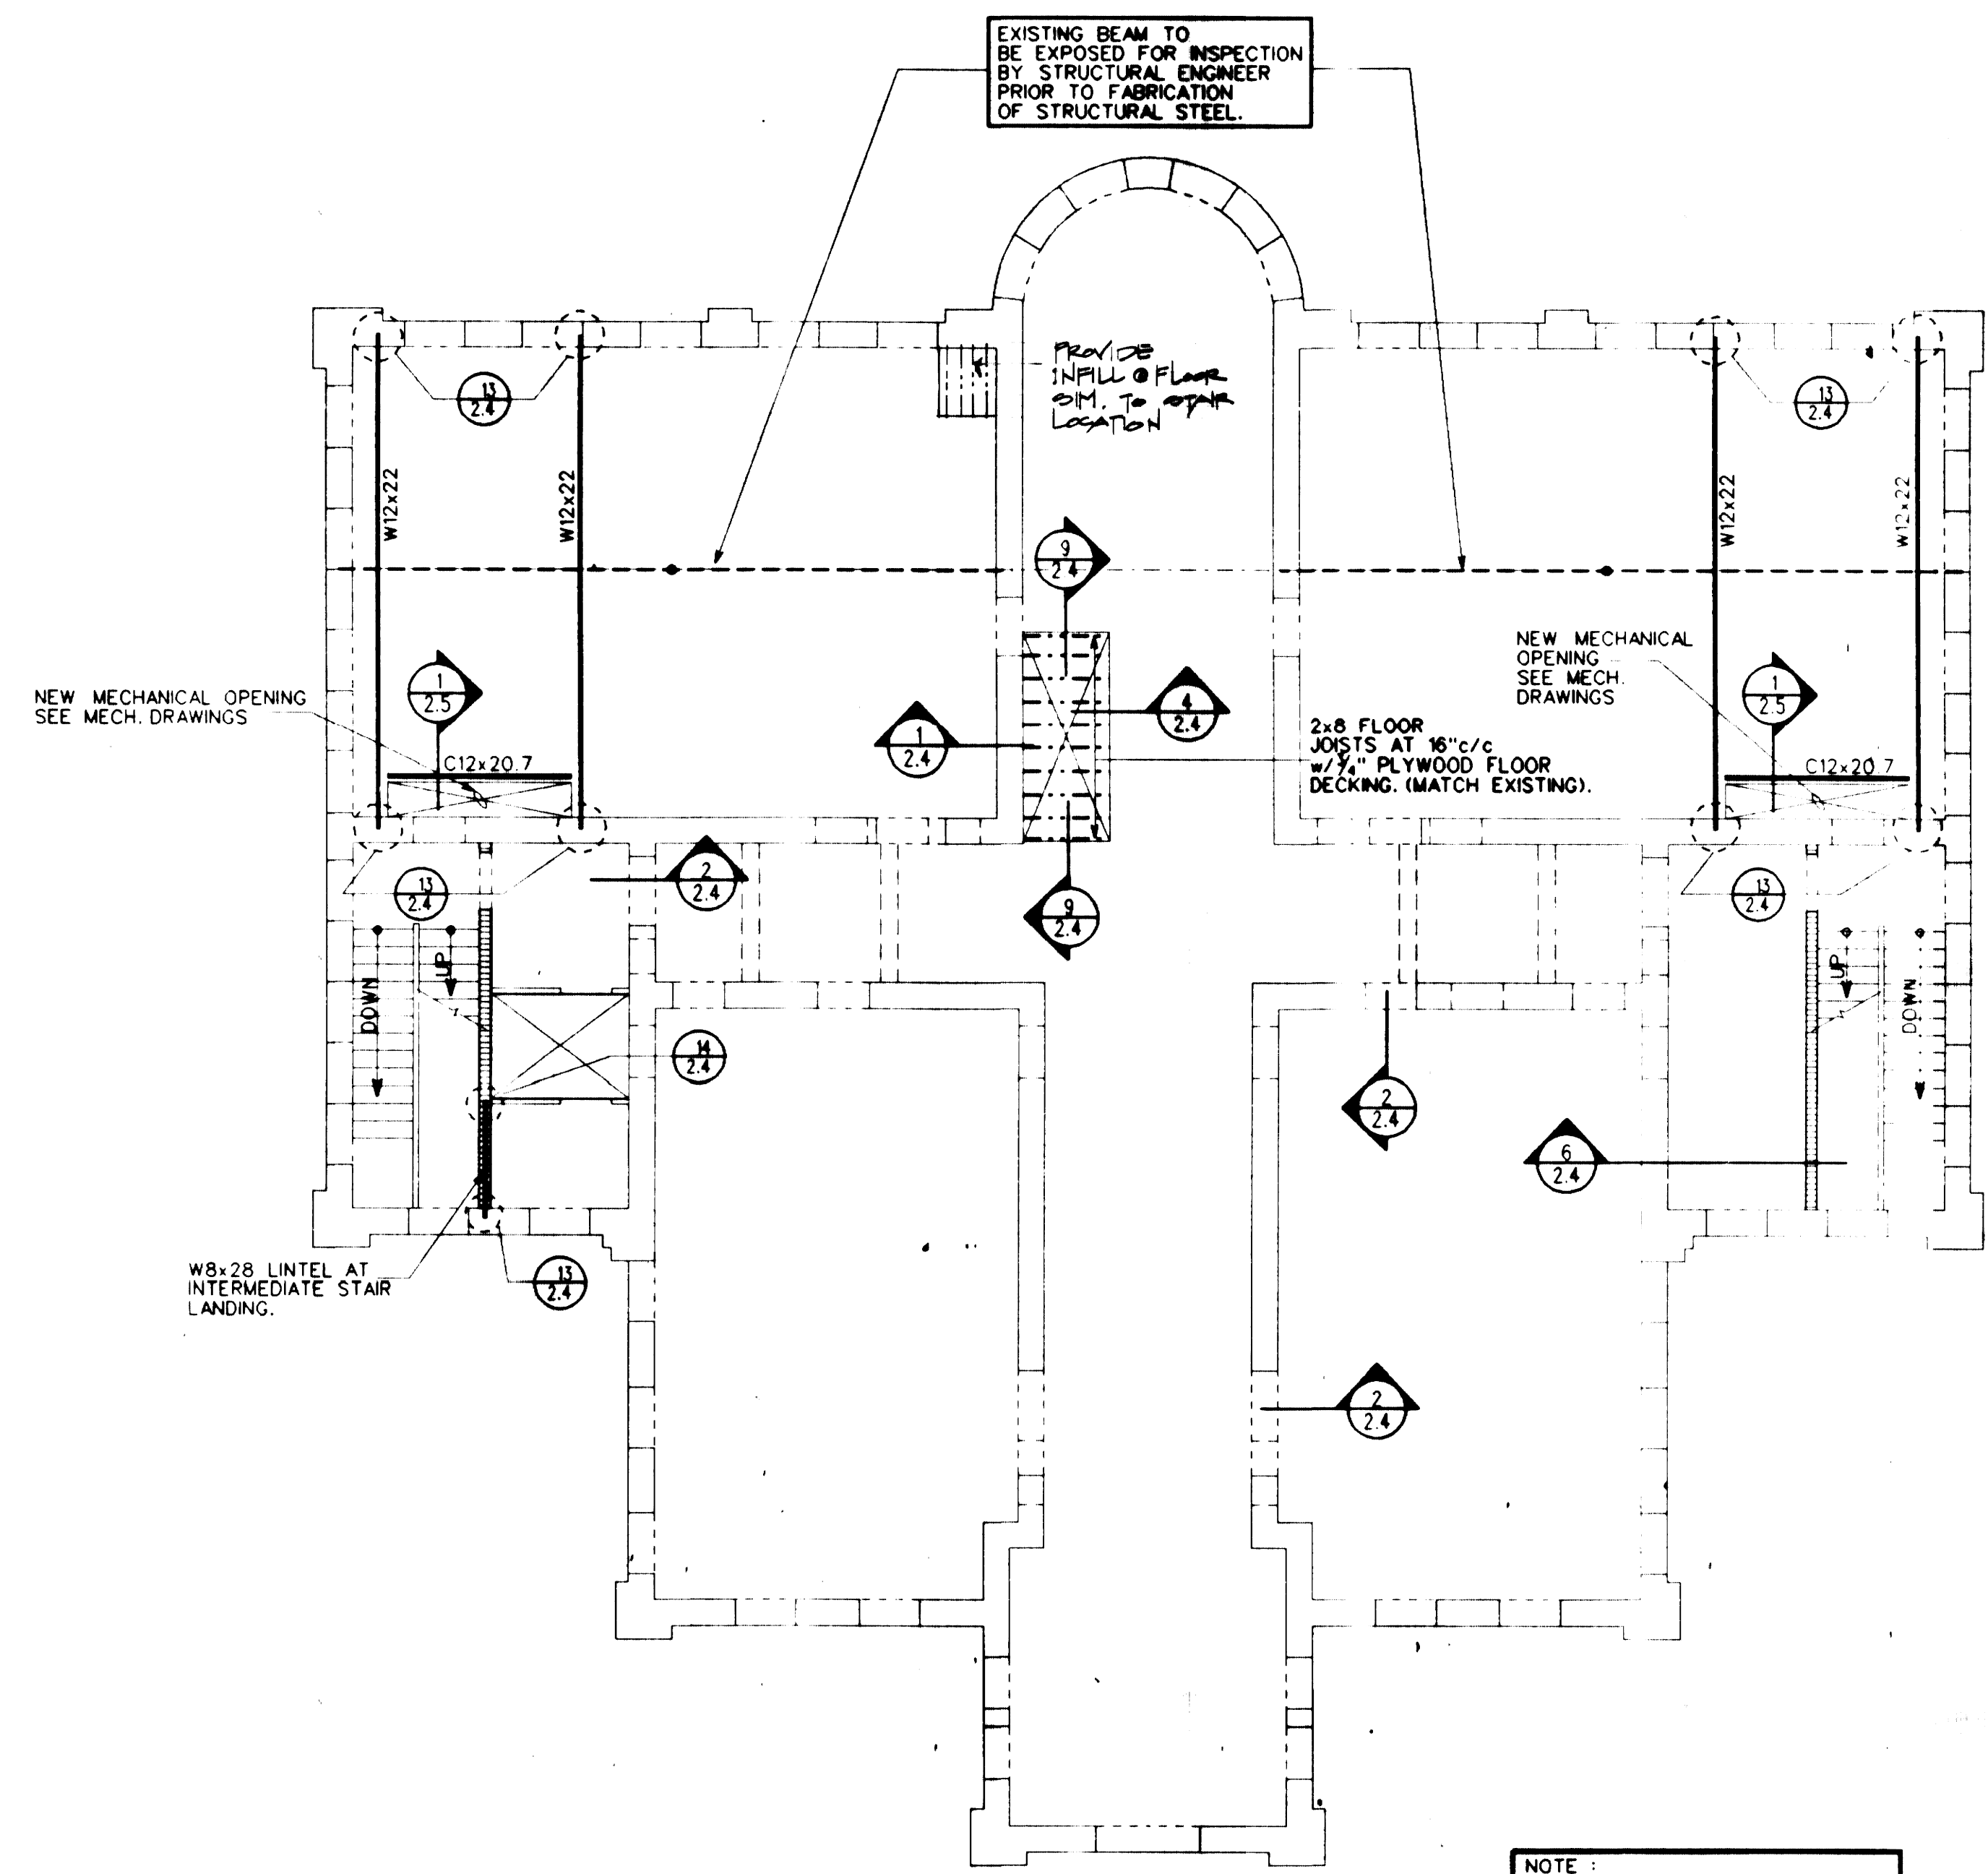


**FIRST FLOOR PLAN**  
 SCALE 3/8" = 1'-0"  
 NOTE: SEE DETAIL 3/2.4 FOR NEW MECHANICAL DUCT PASSAGE THROUGH EXISTING BEARING WALLS. SEE MECHANICAL DRAWINGS FOR LOCATIONS.

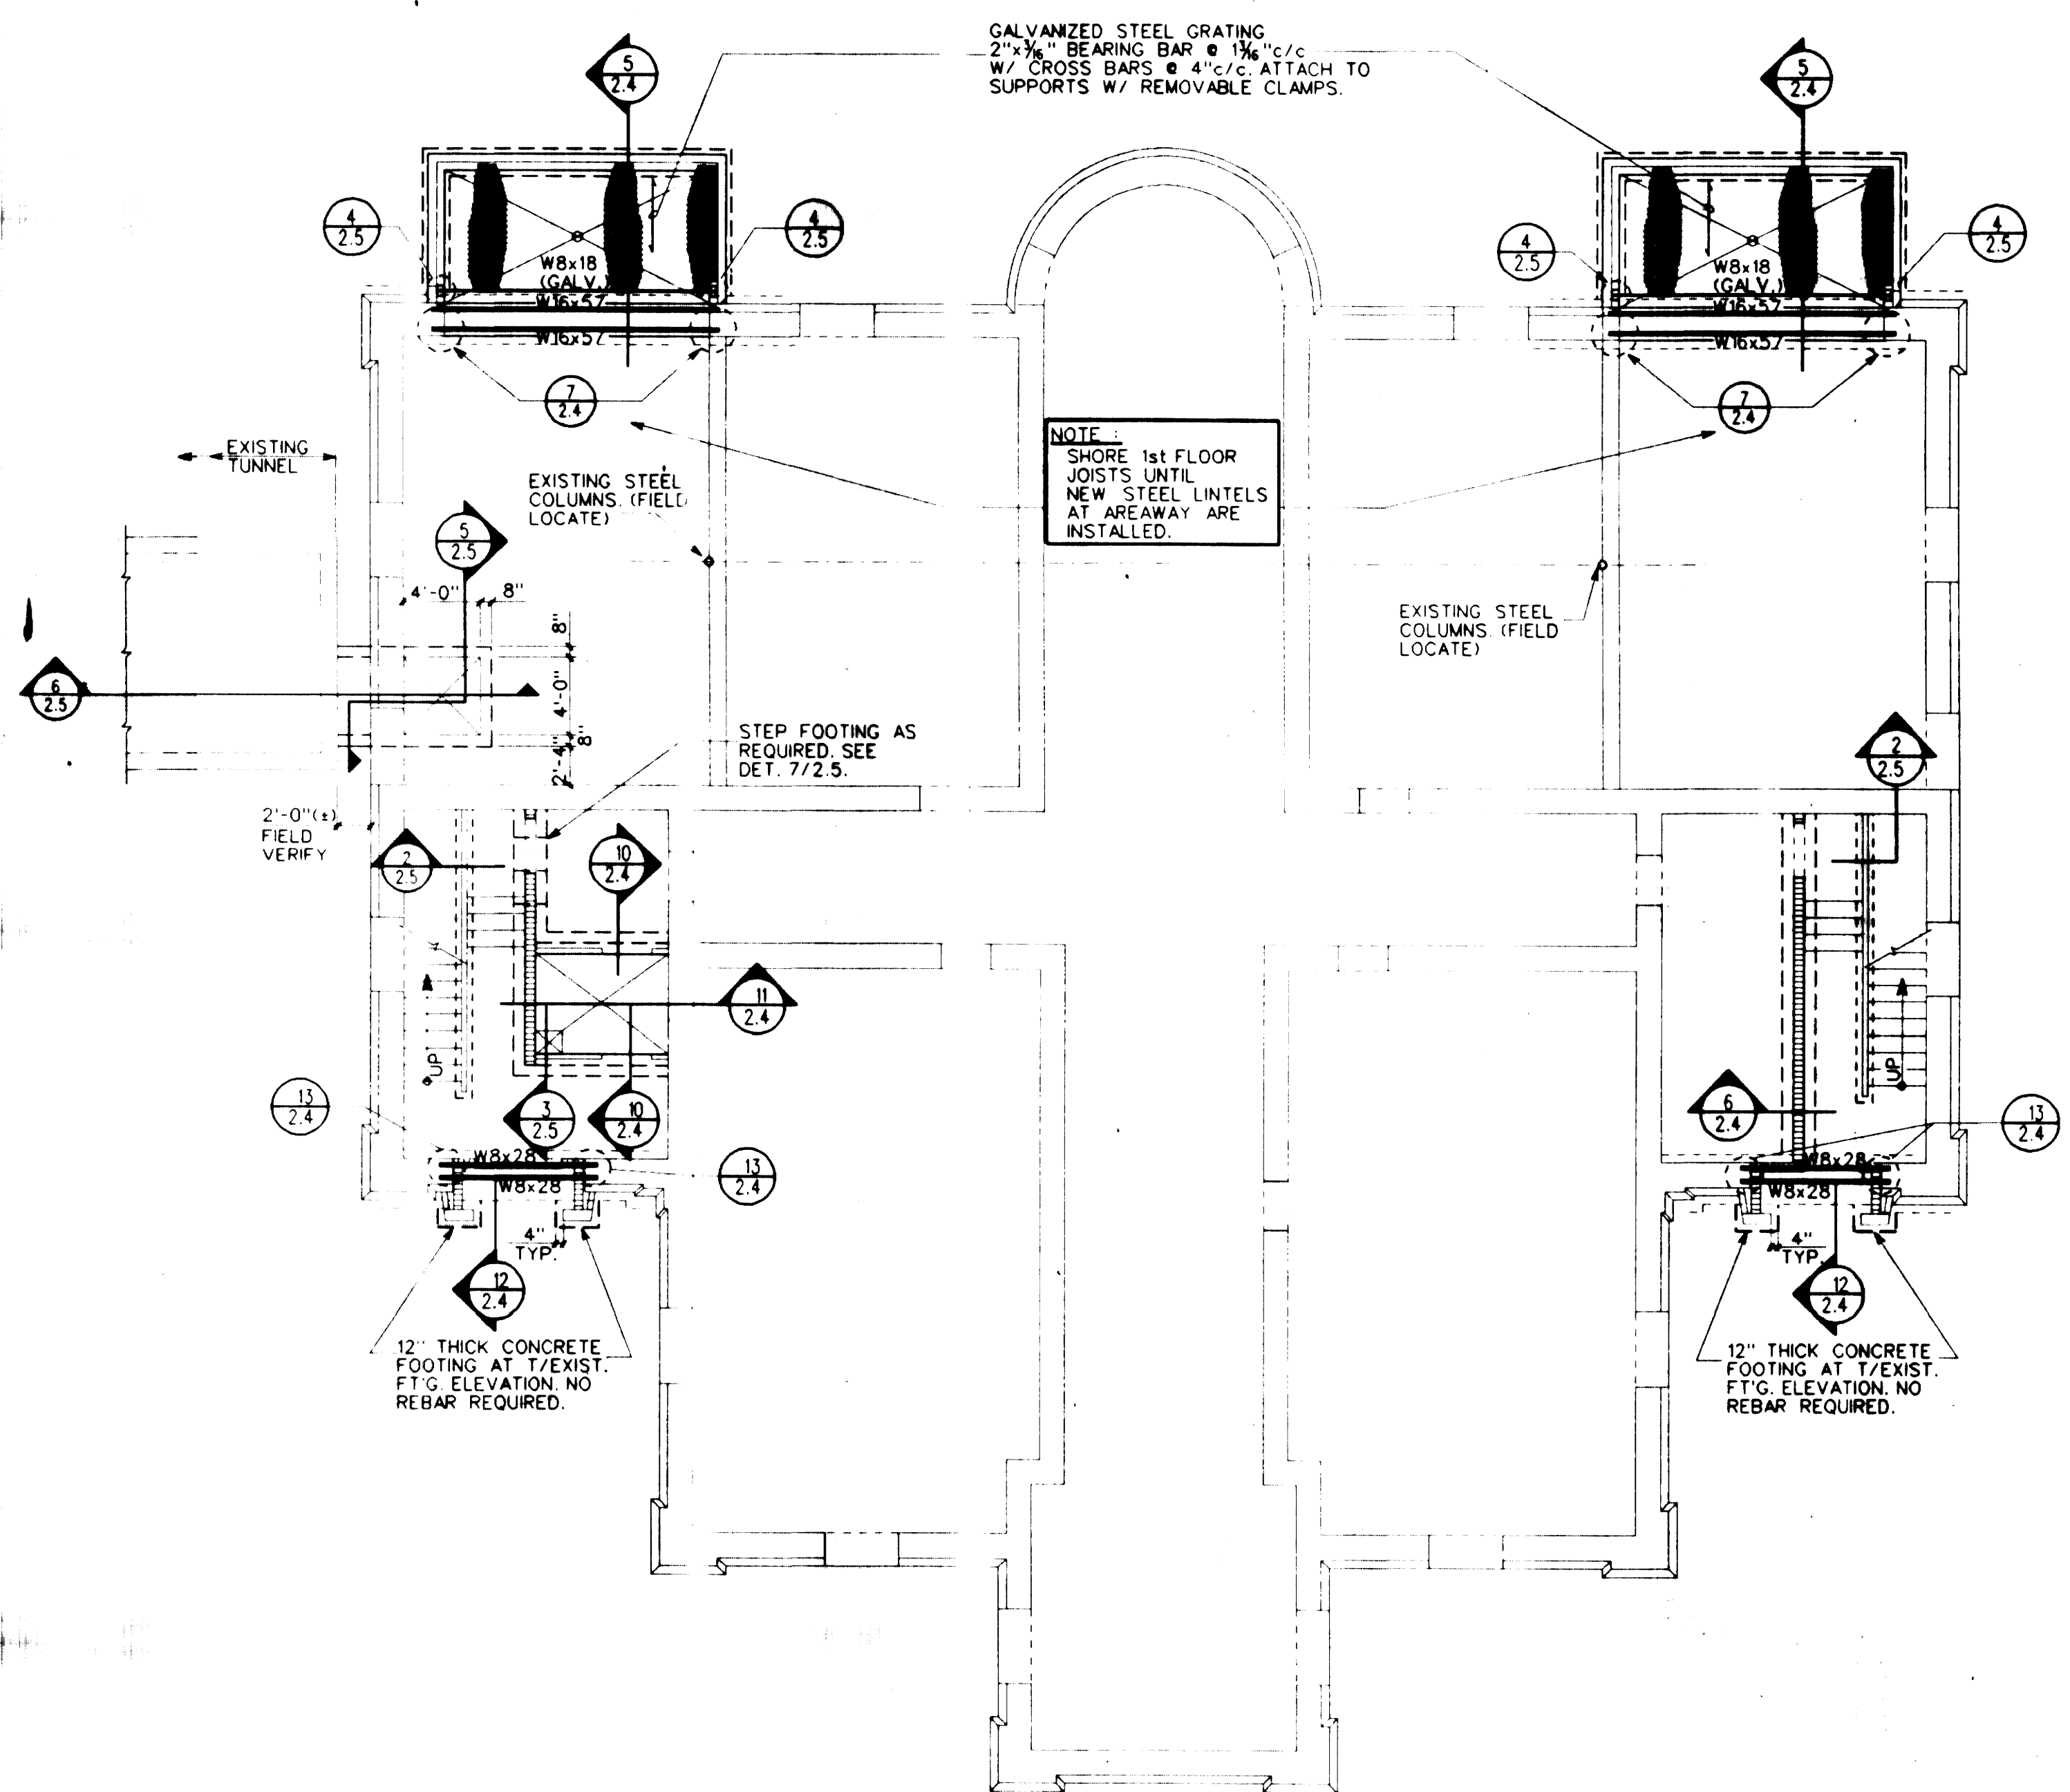

**BASEMENT FLOOR PLAN**  
 SCALE 3/8" = 1'-0"  
 NOTE: SEE ARCHITECTURAL DRAWINGS FOR DIMENSIONS NOT SHOWN.

2077 99

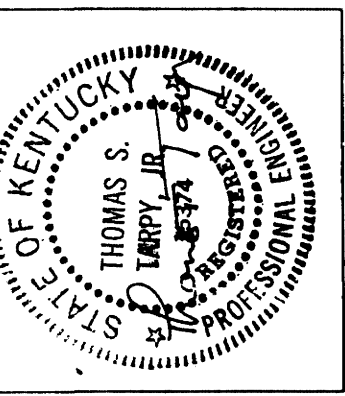

Stanley D. Lindsey  
& Associates, Ltd.  
STRUCTURAL ENGINEERS  
2244 Manchester Blvd., Suite 208  
Nashville, Tennessee 37228-1920  
(615) 244-2211 Fax: (615) 244-0387  
Project Number: 82-1440


University of Kentucky  
Lexington, Kentucky  
OFFICIAL BID DOCUMENT  
REVISED 10/20/91 BY 10/20/91

2nd AND 3rd FLOOR PLANS  
MILLER HALL RENOVATION  
Lexington Campus Sector  
University of Kentucky

project no. 1465.0  
date 20 AUGUST 93  
file no.  
dr. by A.W.M.  
ck'd by C.B.


revisions

2.3	Sheet	001500
-----	-------	--------

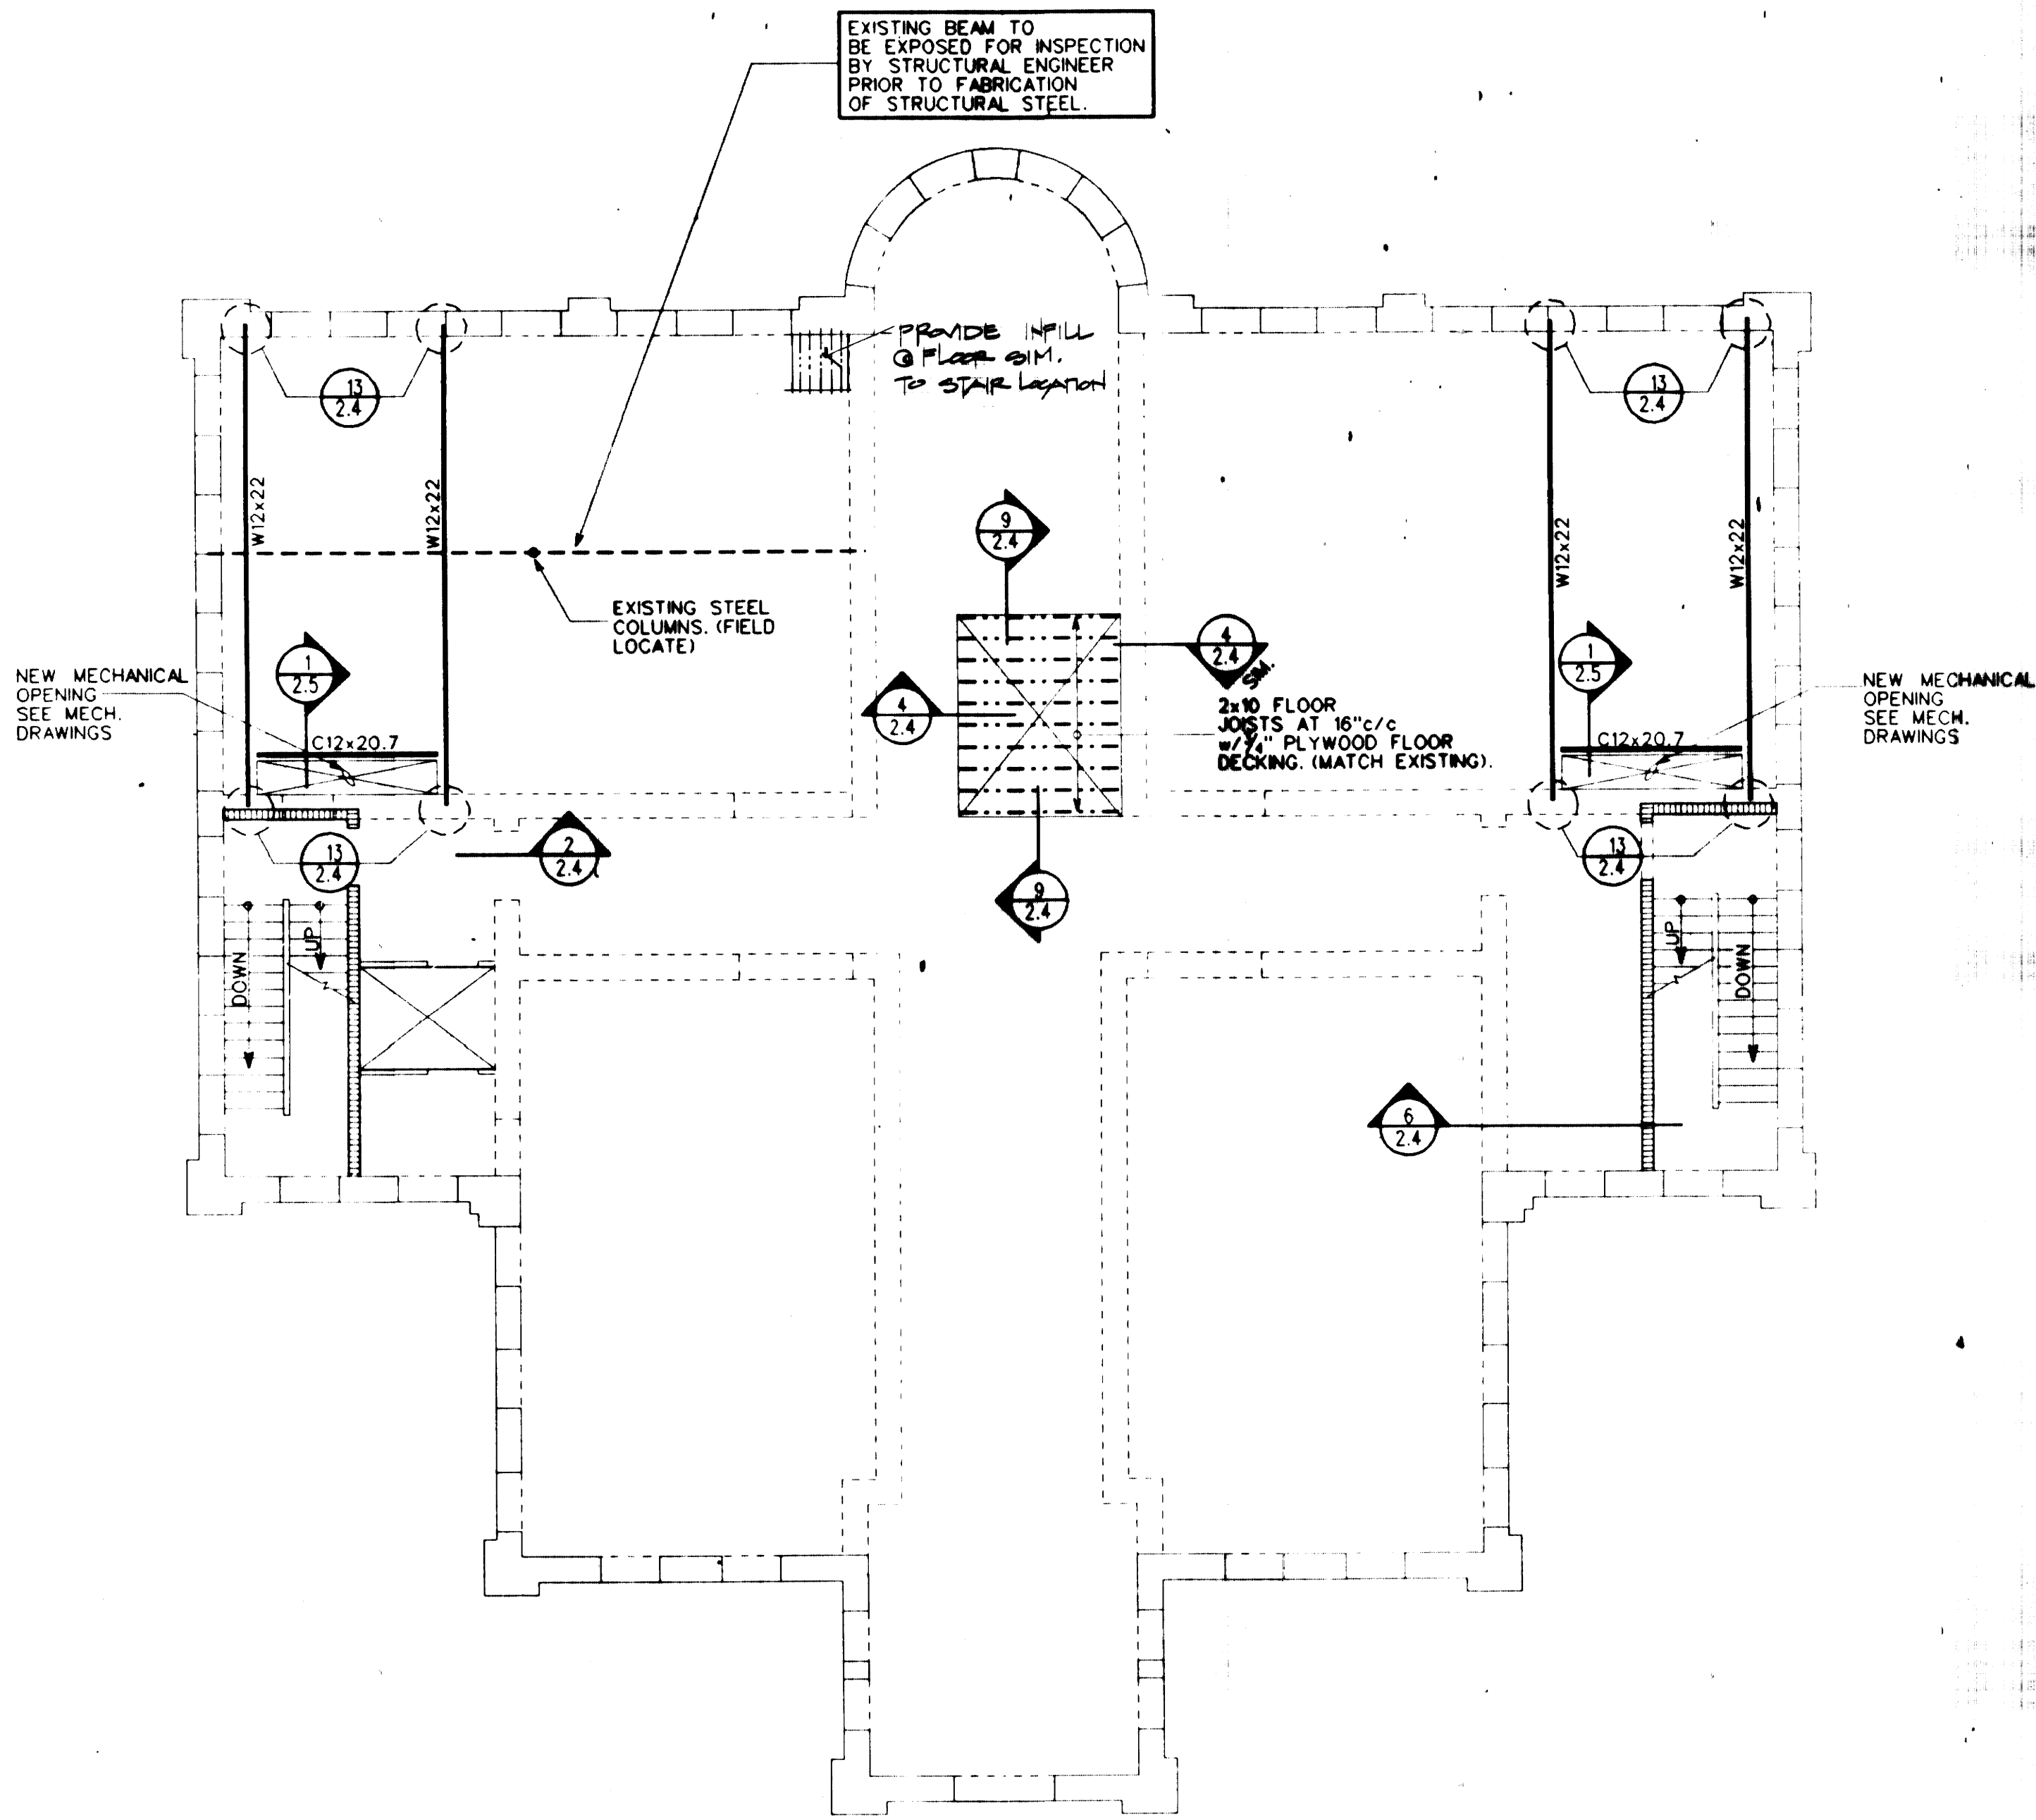

**3rd FLOOR PLAN**  
SCALE 3/8" = 1'-0"

NOTE:  
SEE DETAIL 3/2.4 FOR NEW MECHANICAL DUCT PASSAGE THROUGH EXISTING BEARING WALLS. SEE MECHANICAL DRAWINGS FOR LOCATIONS.

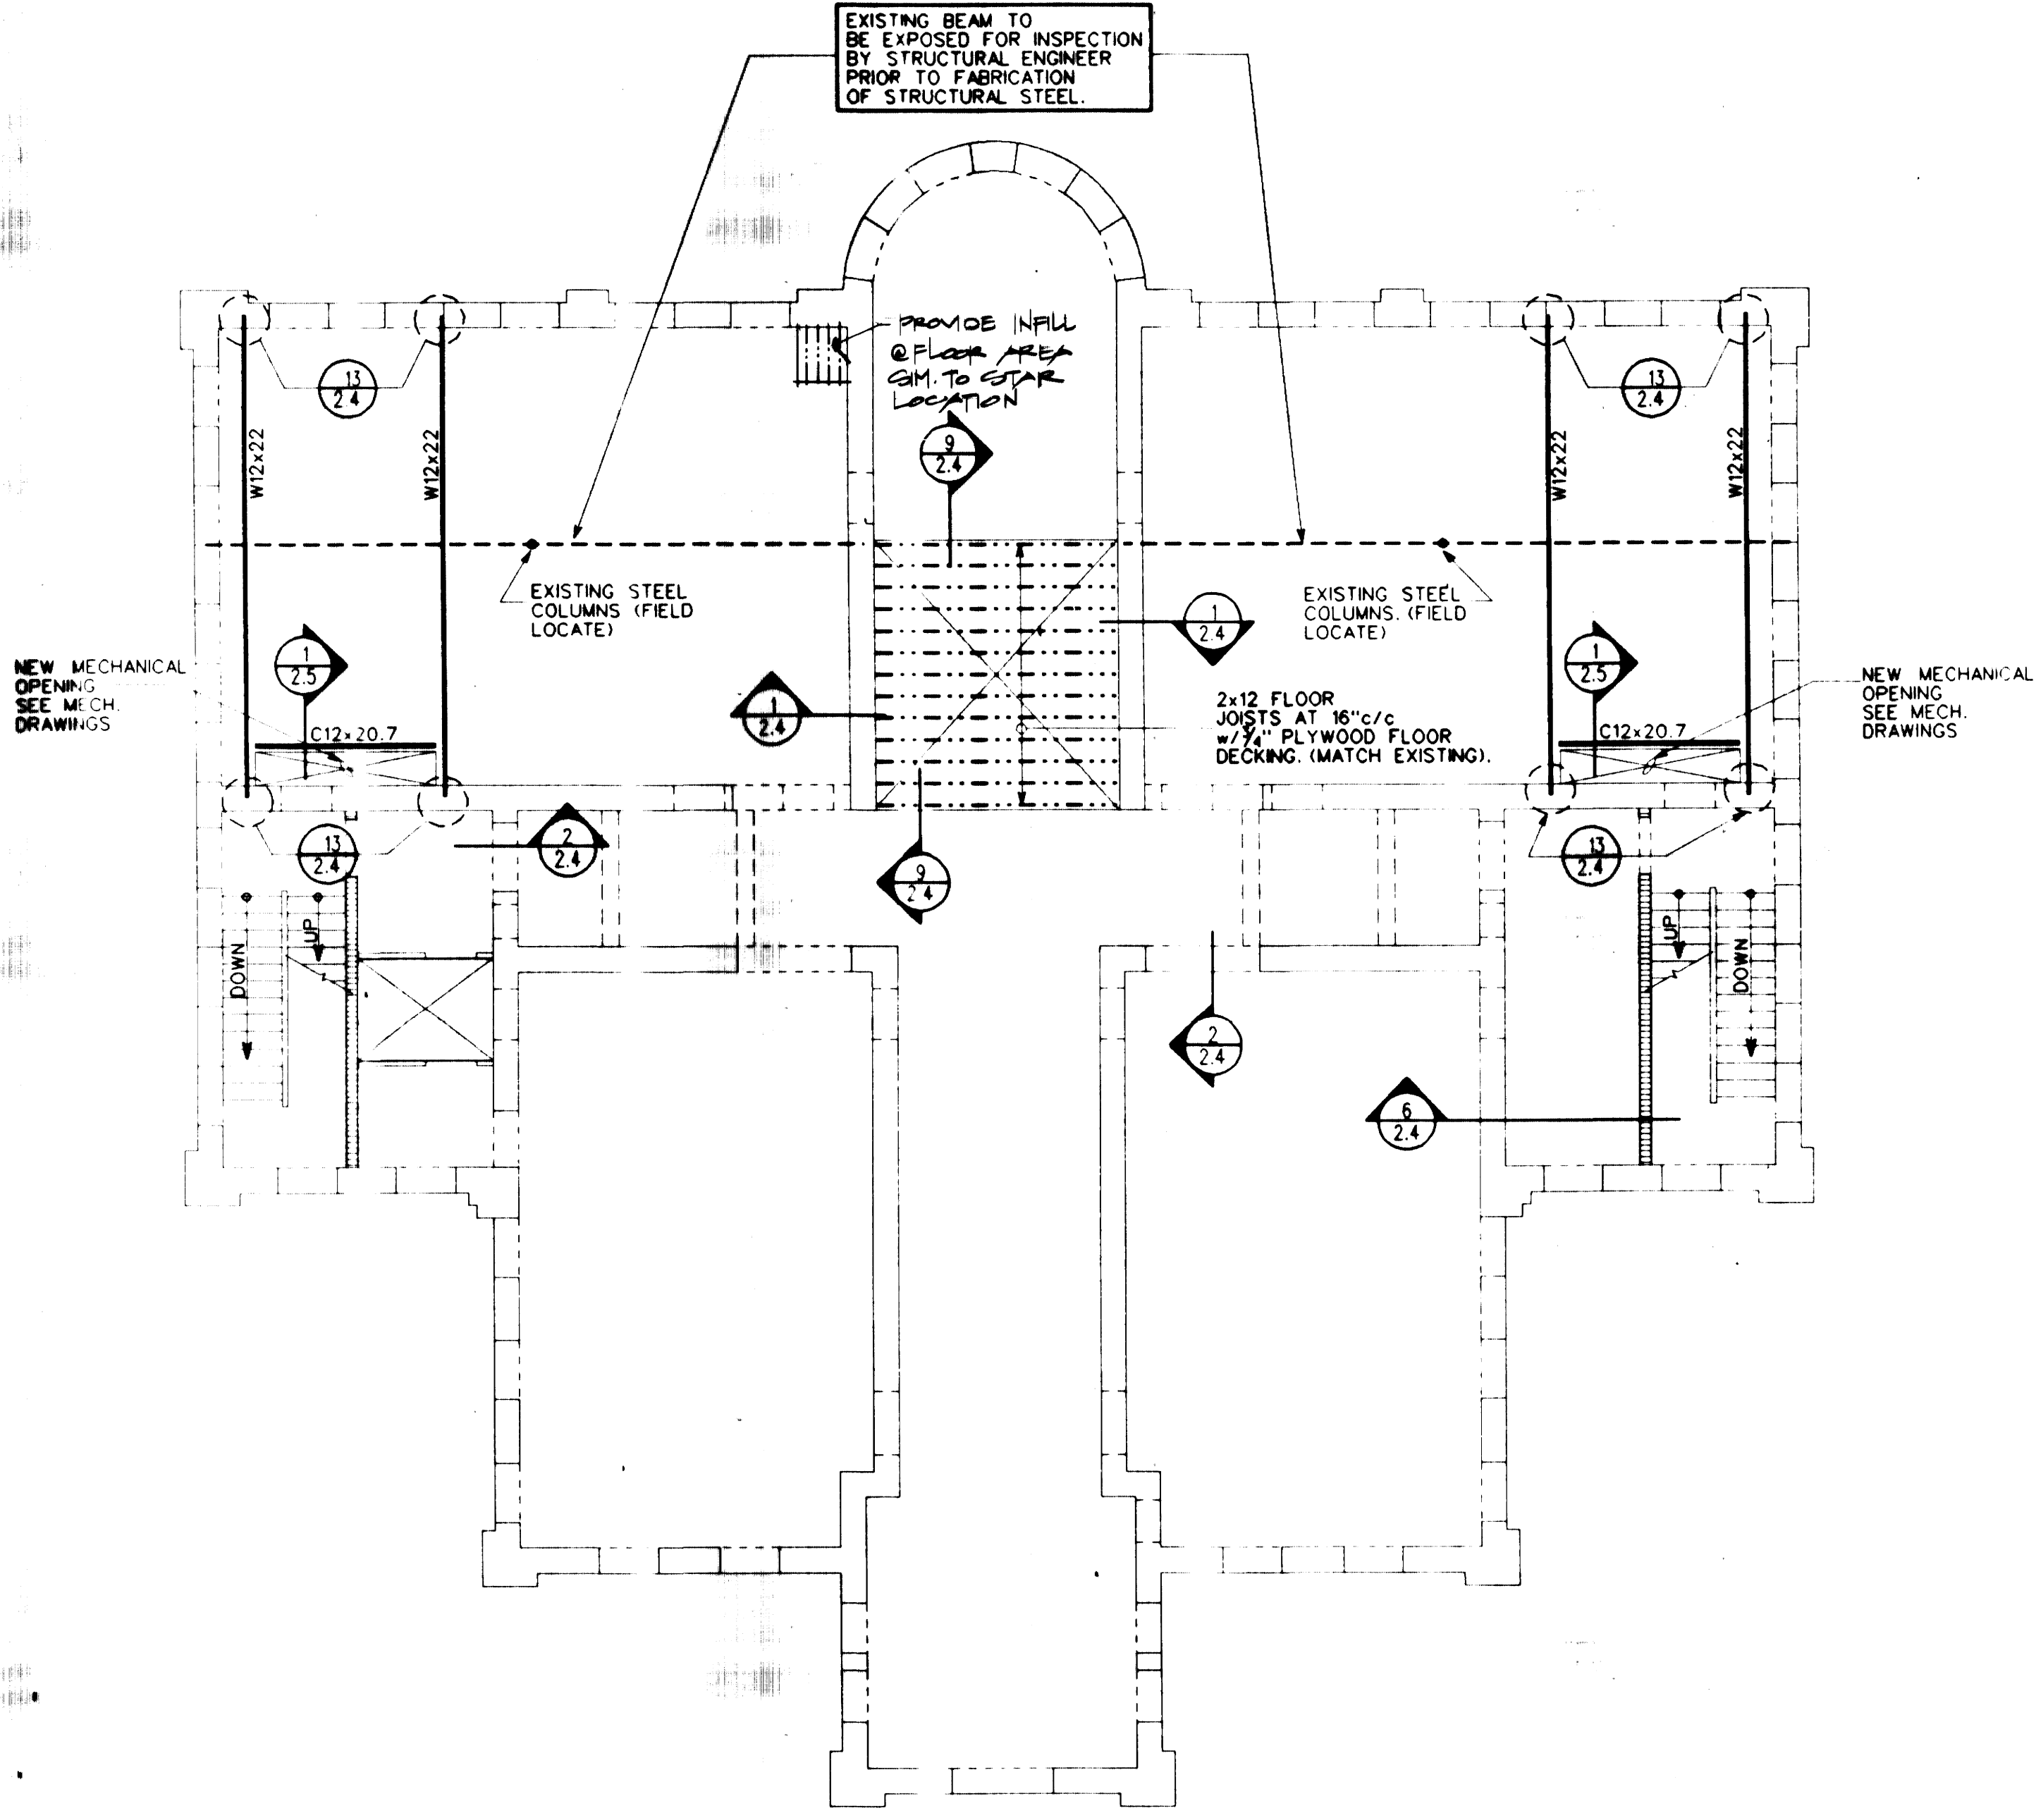


**2nd FLOOR PLAN**  
SCALE 3/8" = 1'-0"

NOTE:  
SEE DETAIL 3/2.4 FOR NEW MECHANICAL DUCT PASSAGE THROUGH EXISTING BEARING WALLS. SEE MECHANICAL DRAWINGS FOR LOCATIONS.

001500



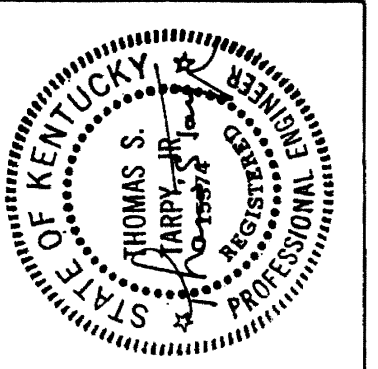










**Stanley D. Lindsey & Associates, Ltd.**  
 STRUCTURAL ENGINEERS  
 2144 Metrocenter Blvd., Suite 208  
 Nashville, Tennessee 37228-1320  
 (615) 244-2211 Fax (615) 244-0877  
 Project Number 93-1440

University of Kentucky  
 Lexington, Kentucky  
 OFFICIAL BID DOCUMENT

SECTIONS AND DETAILS  
**MILLER HALL RENOVATION**  
 Lexington Campus Sector  
 University of Kentucky

project no. 1465.0  
 date 20 AUGUST 93  
 file no.  
 dr. by A.W.M.  
 ck. by C.B.




revisions  
 2.4

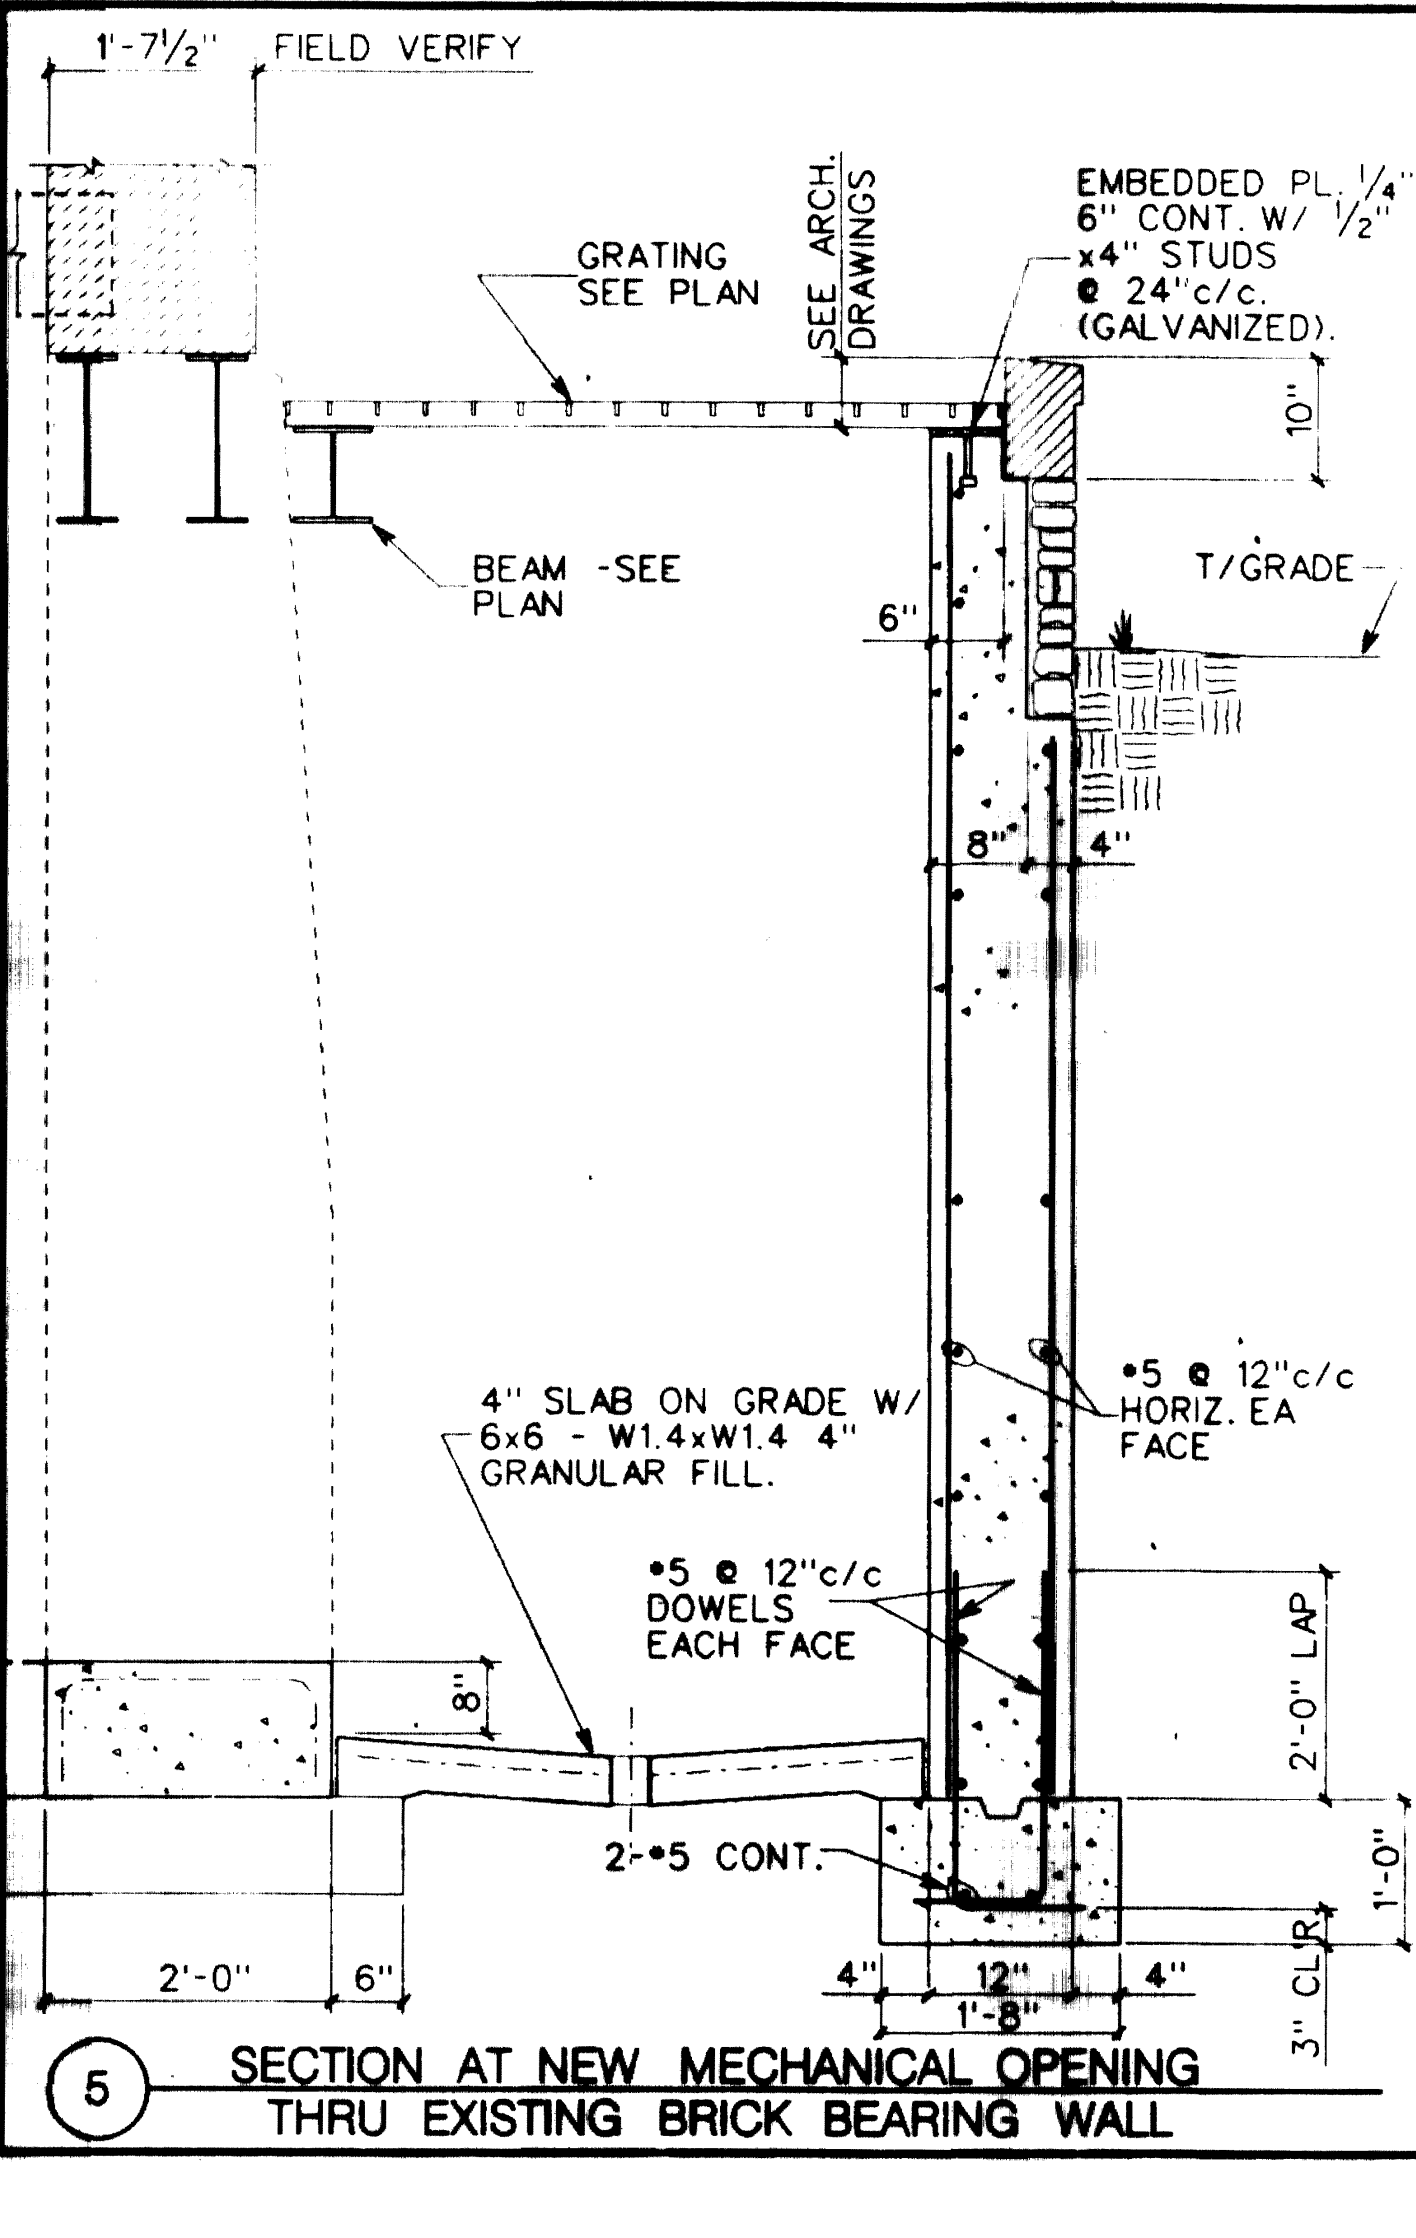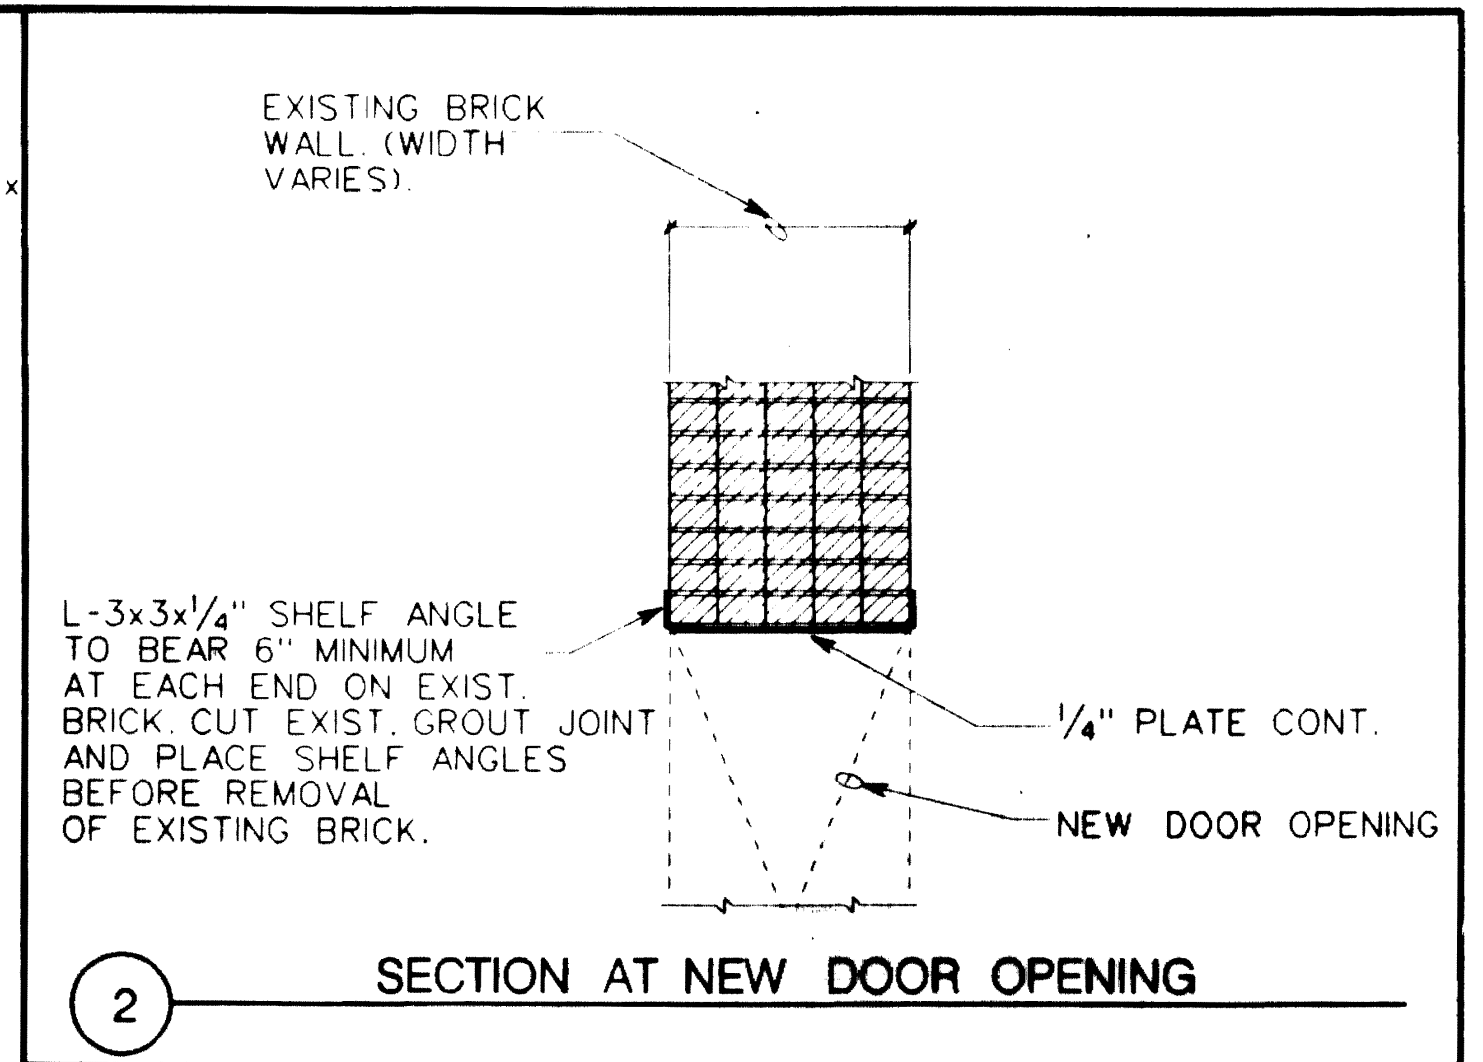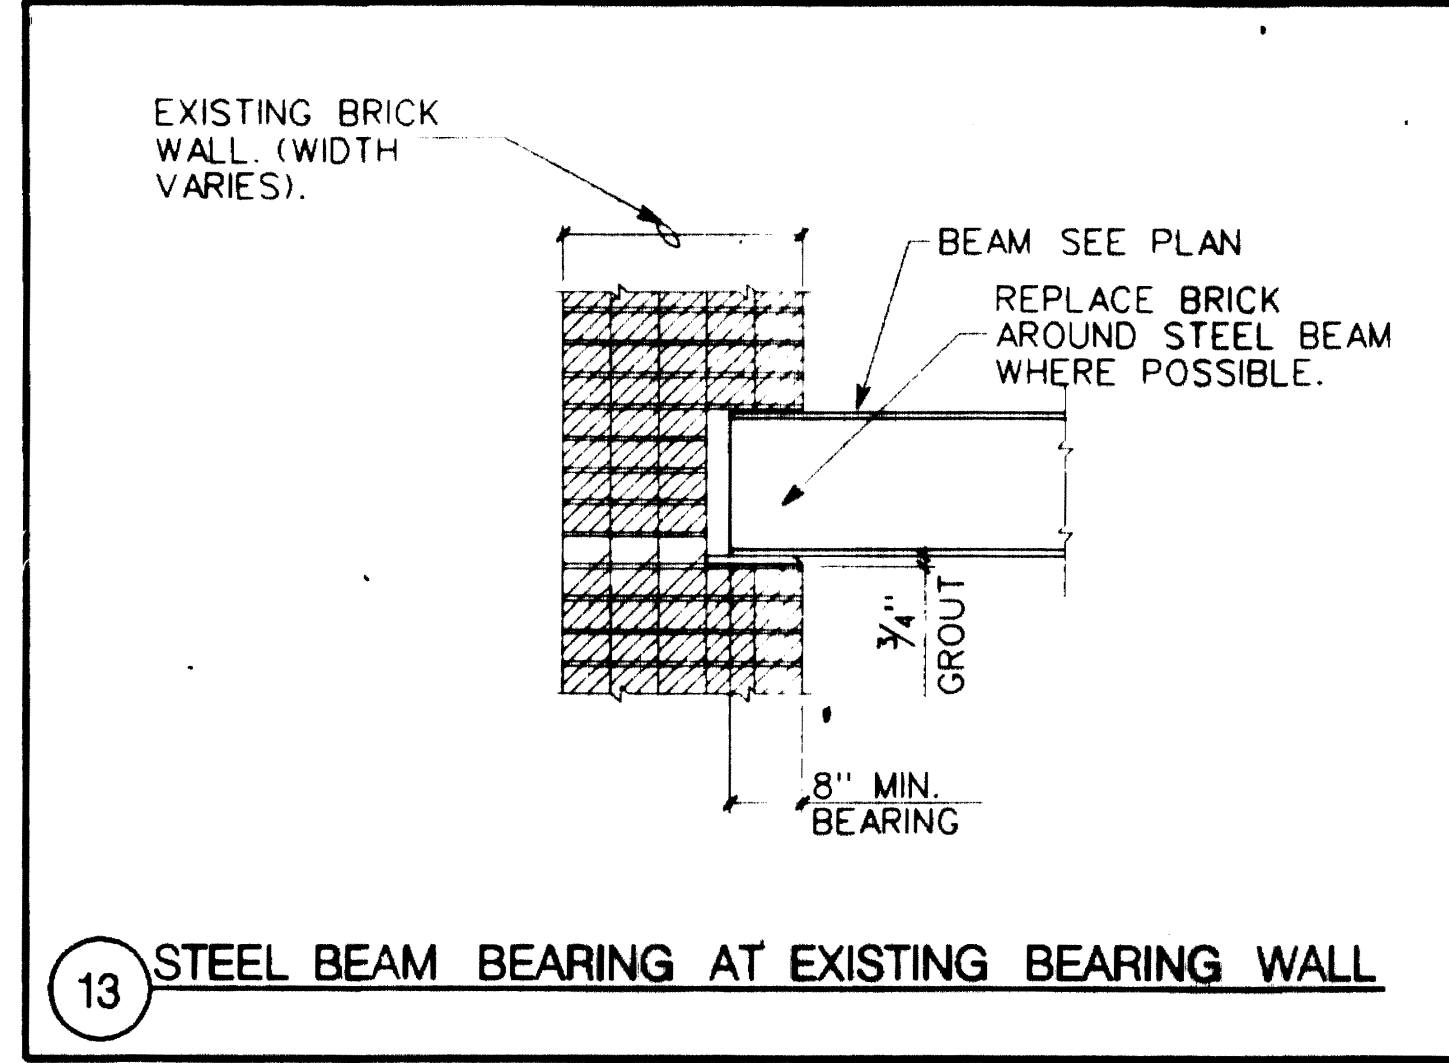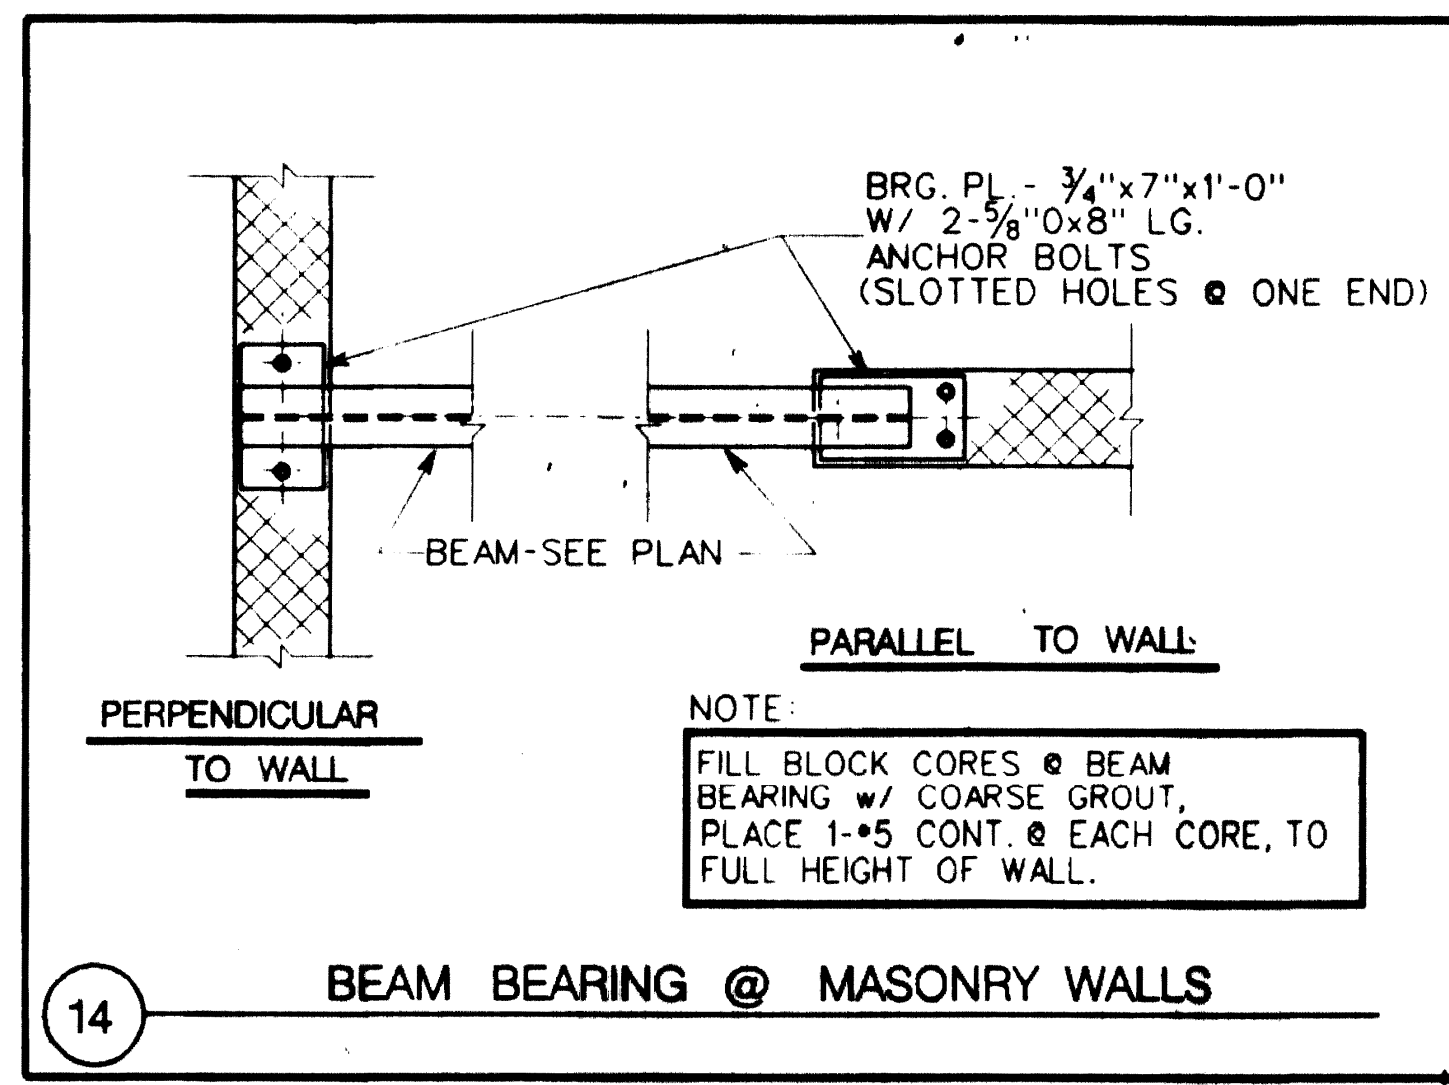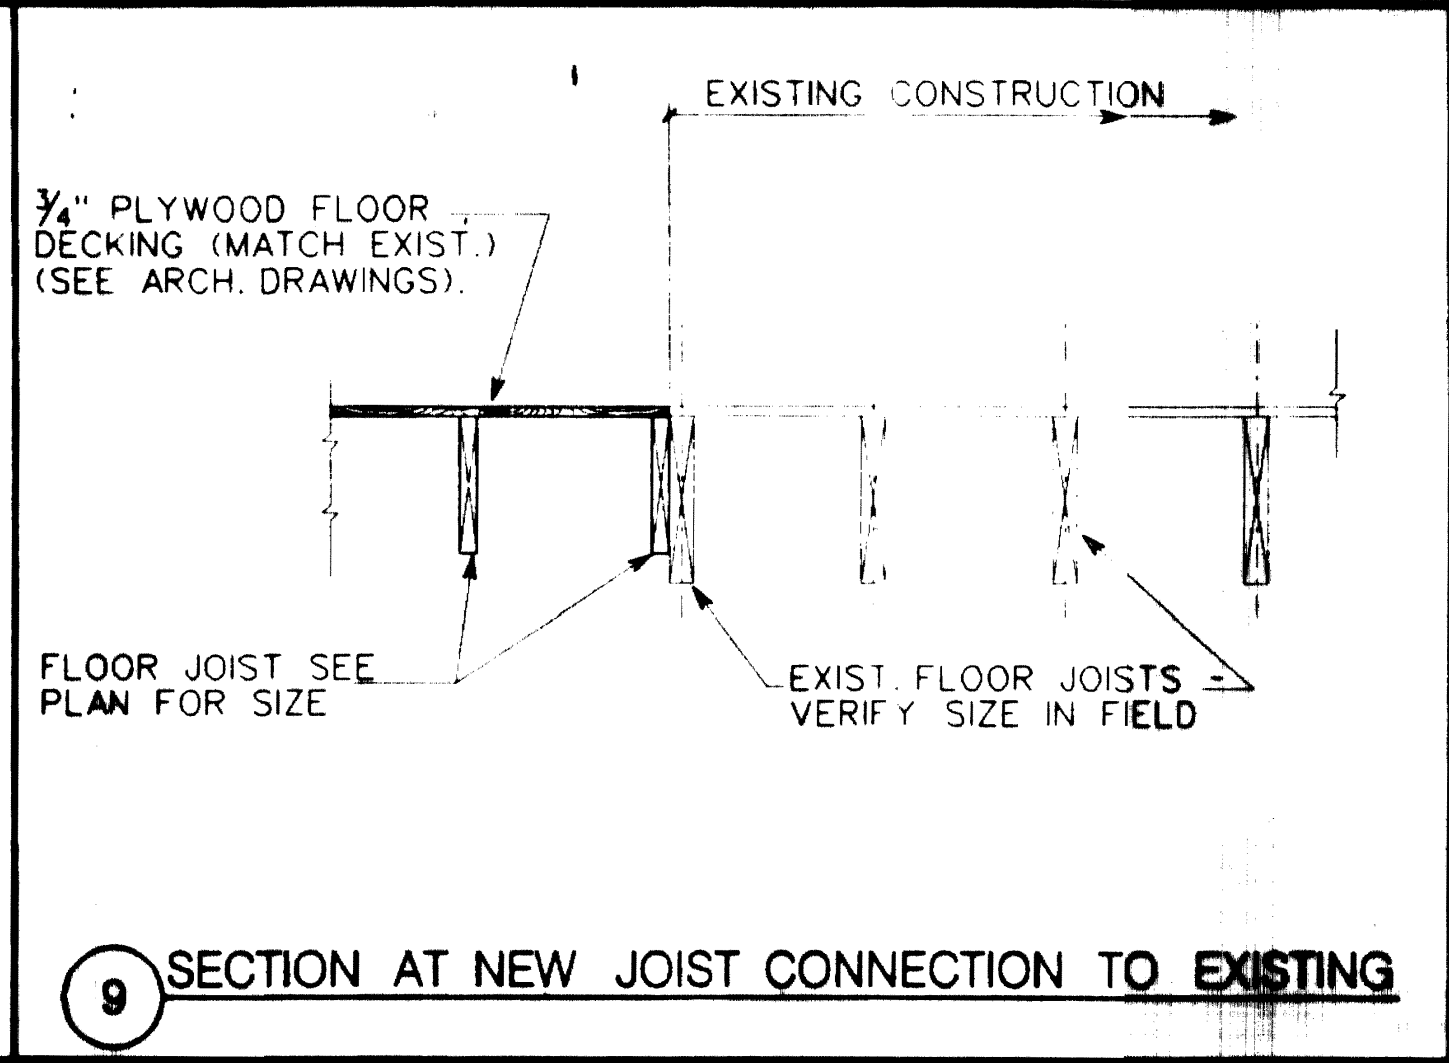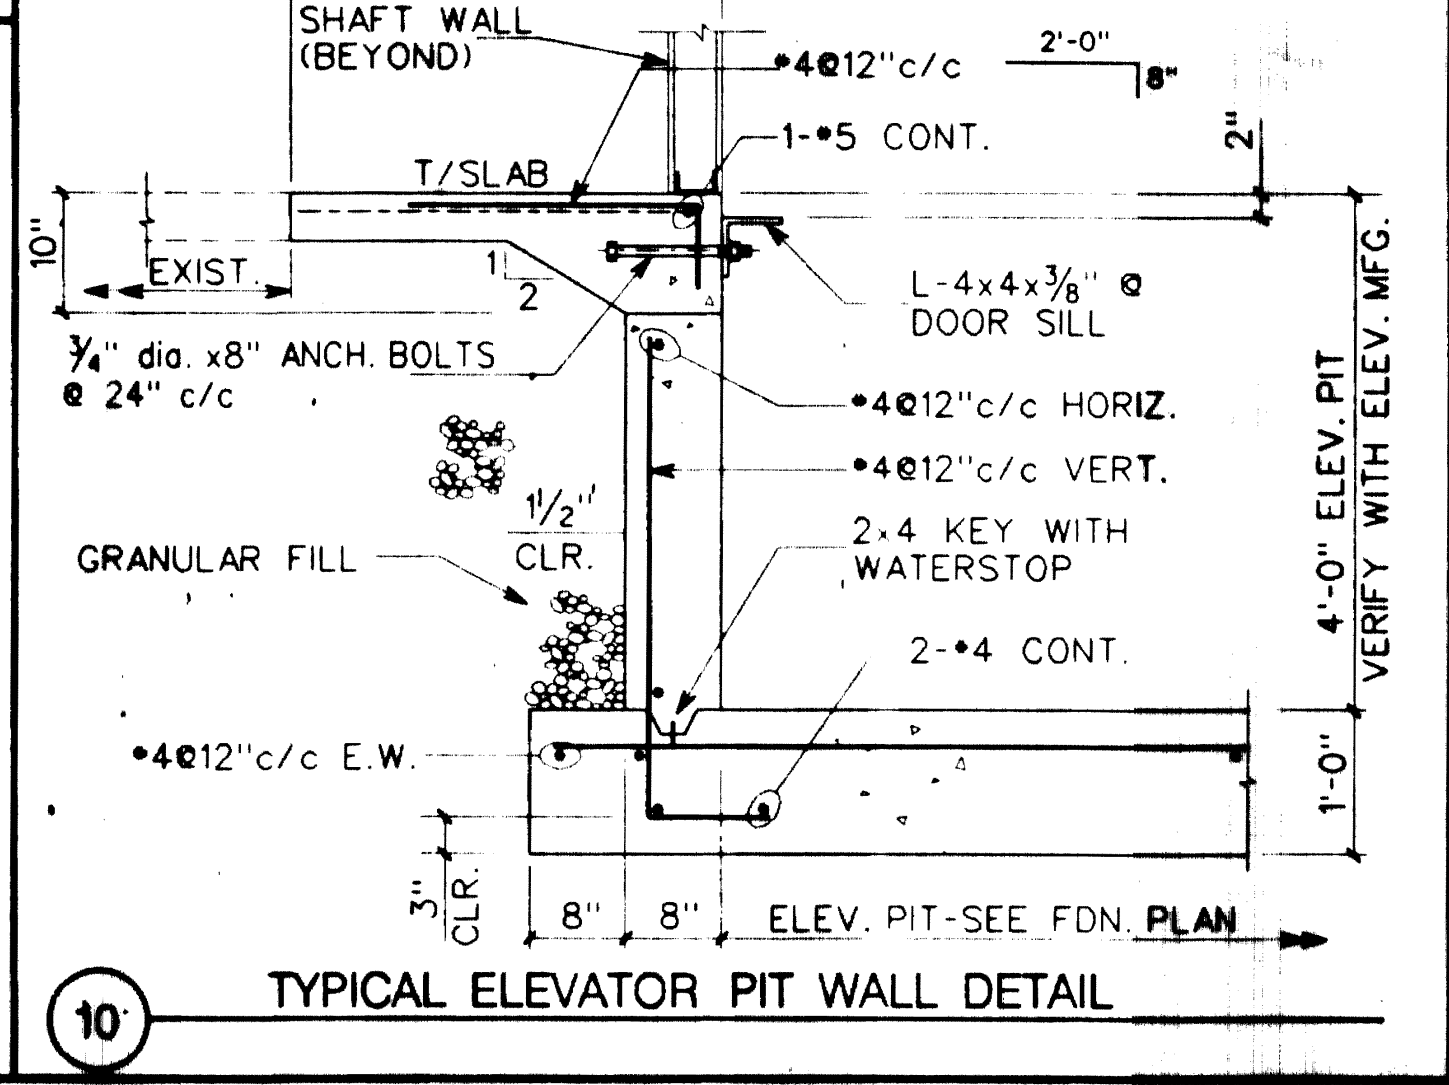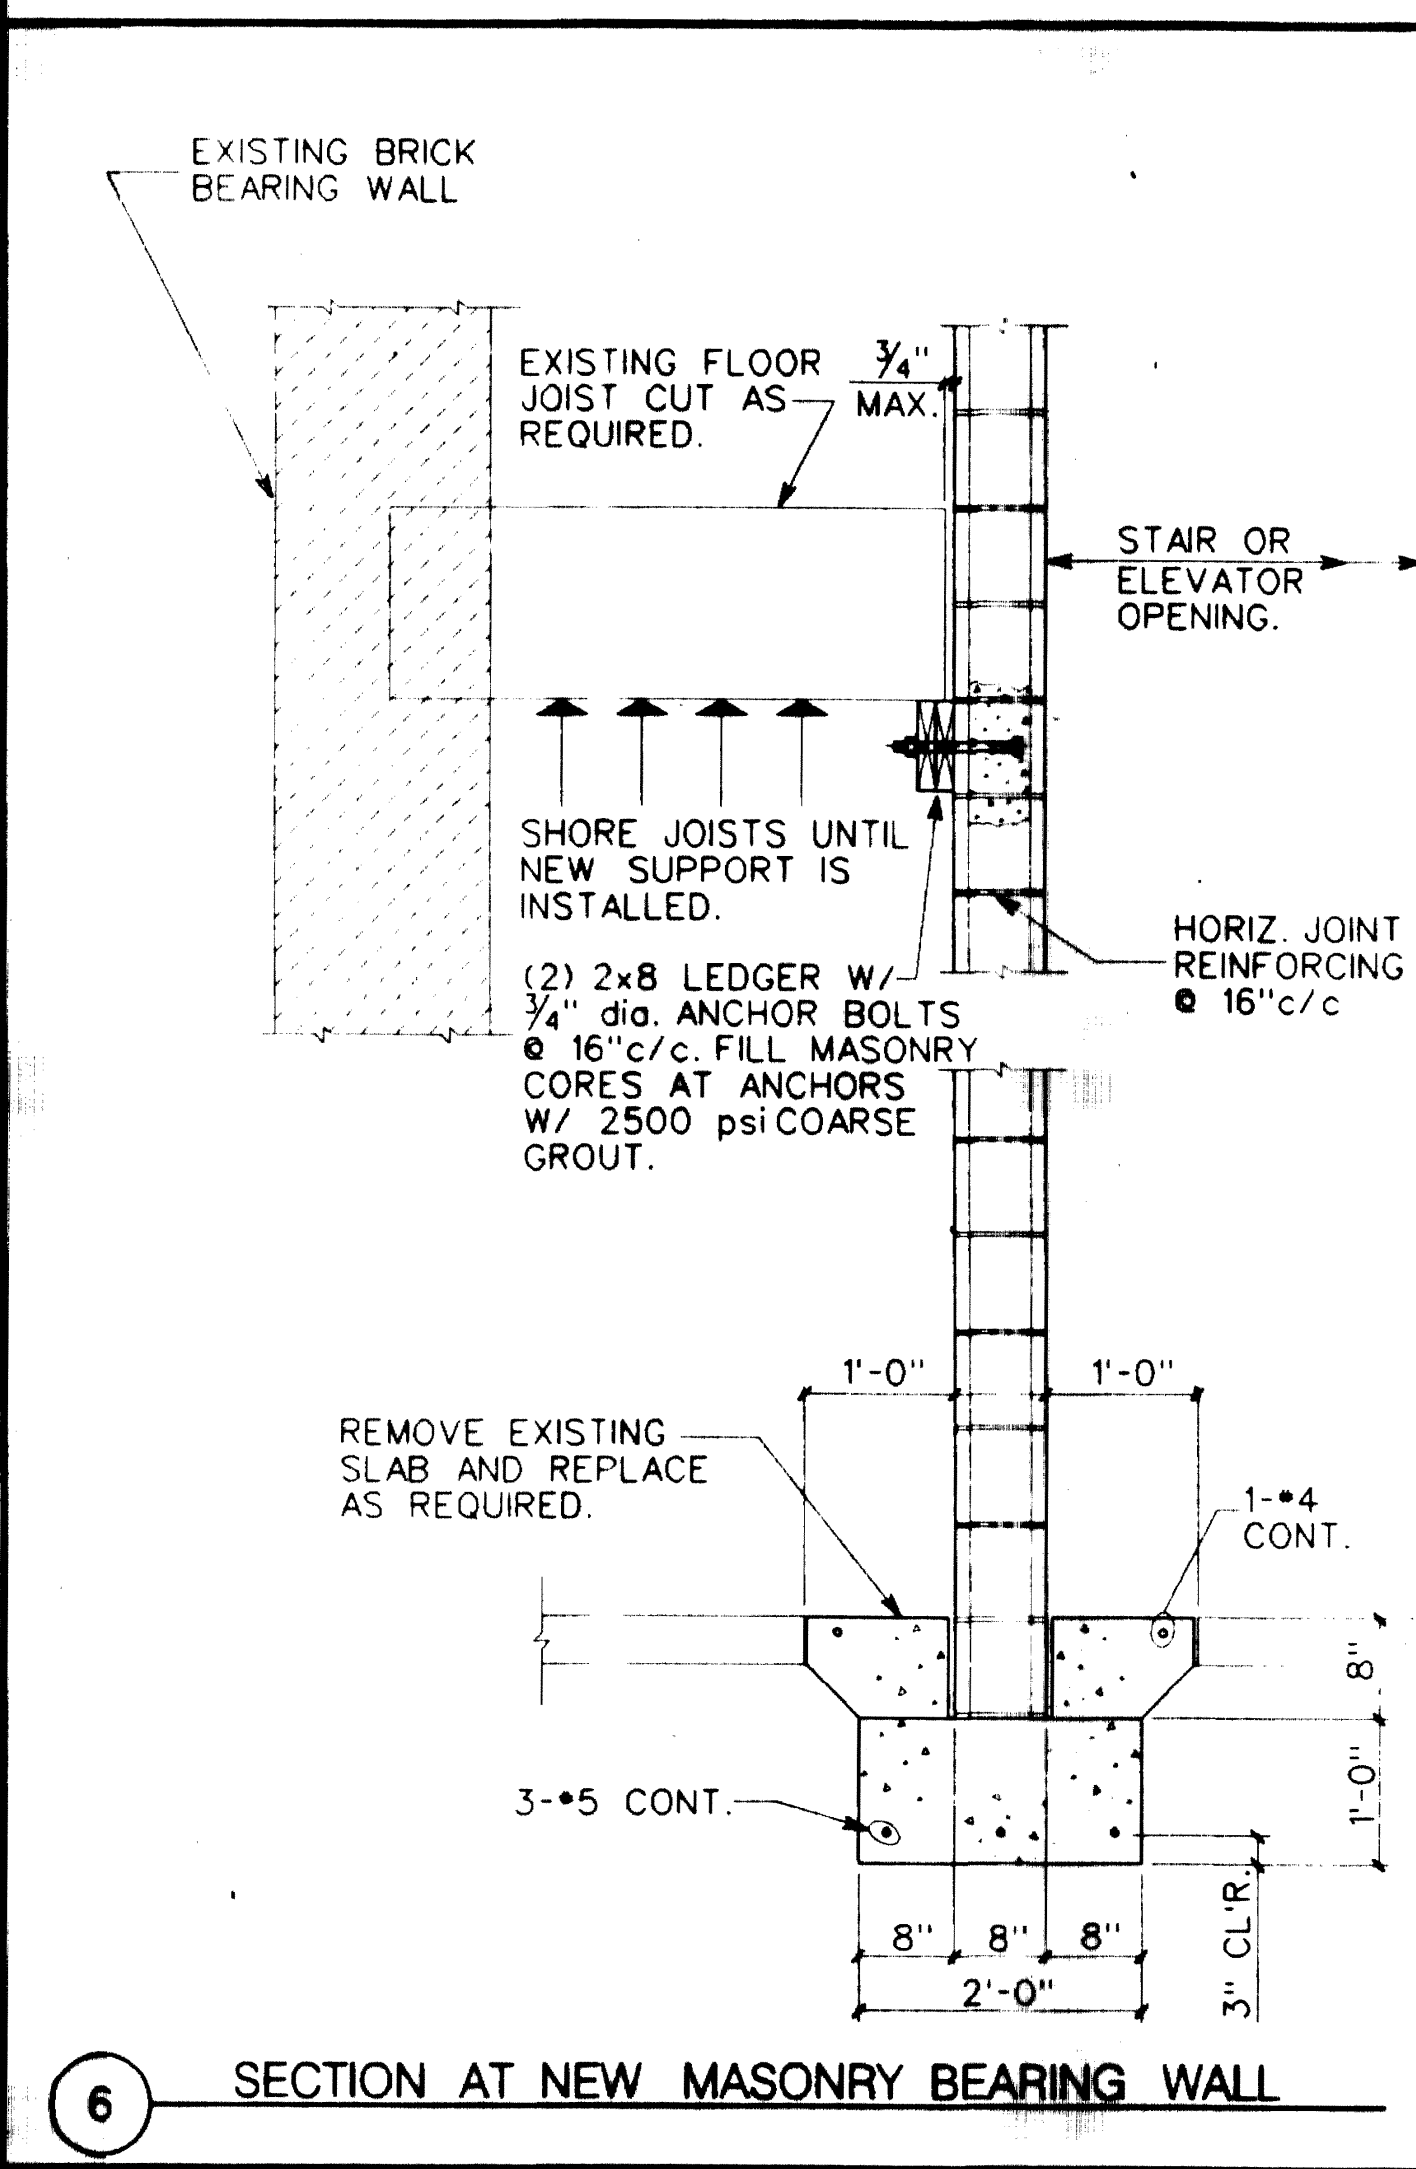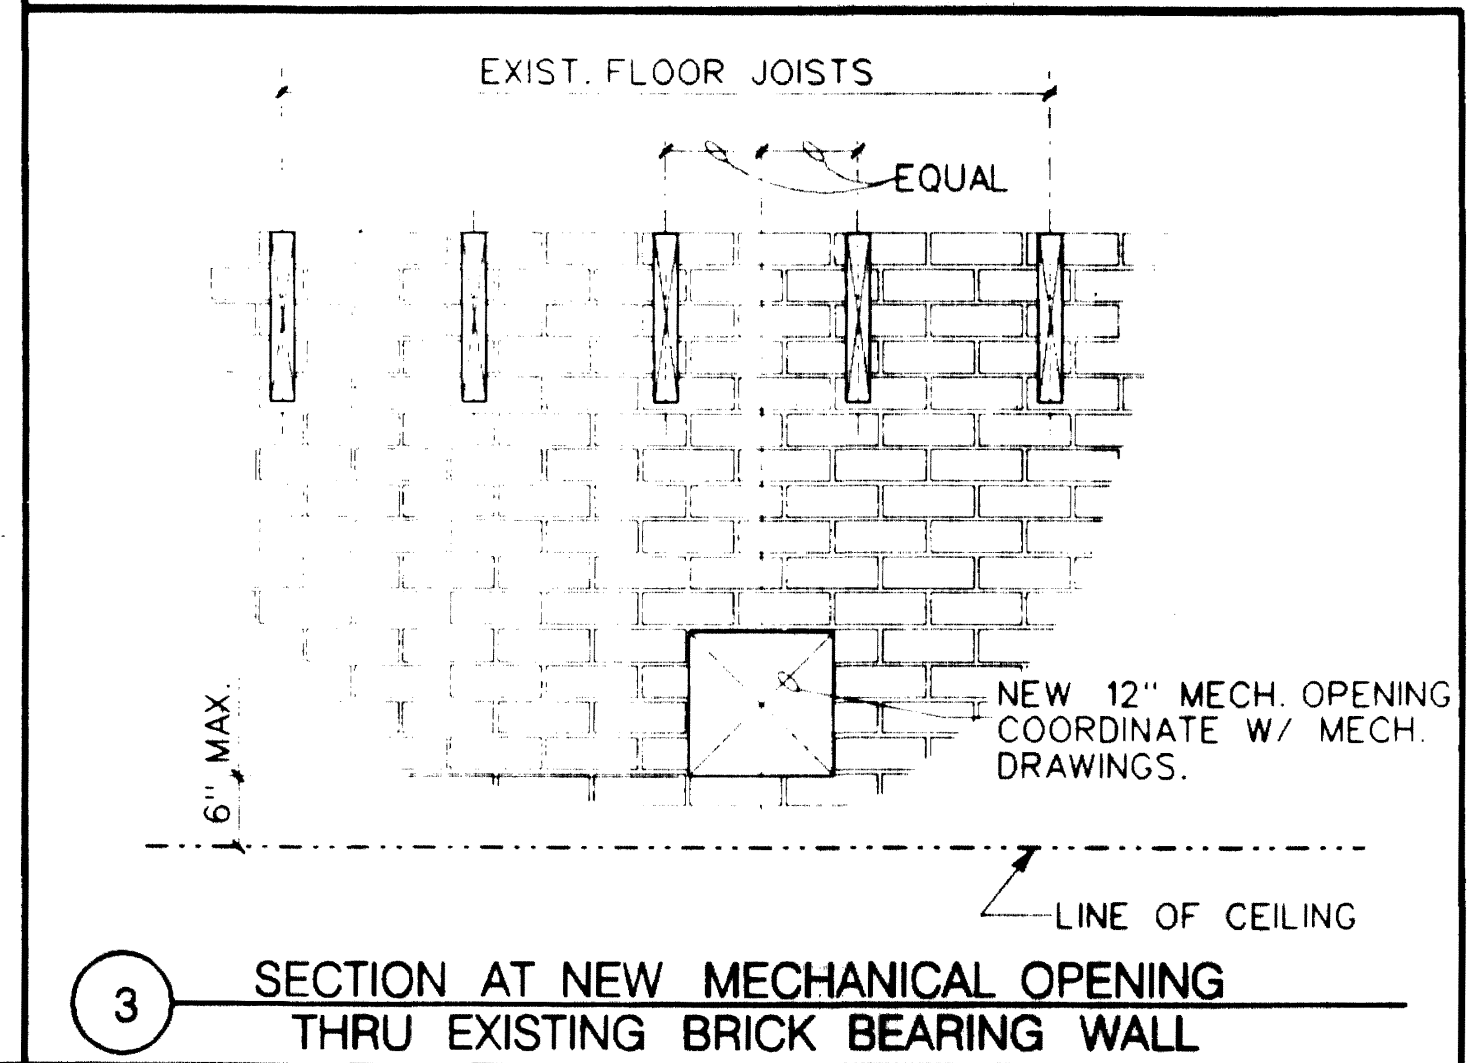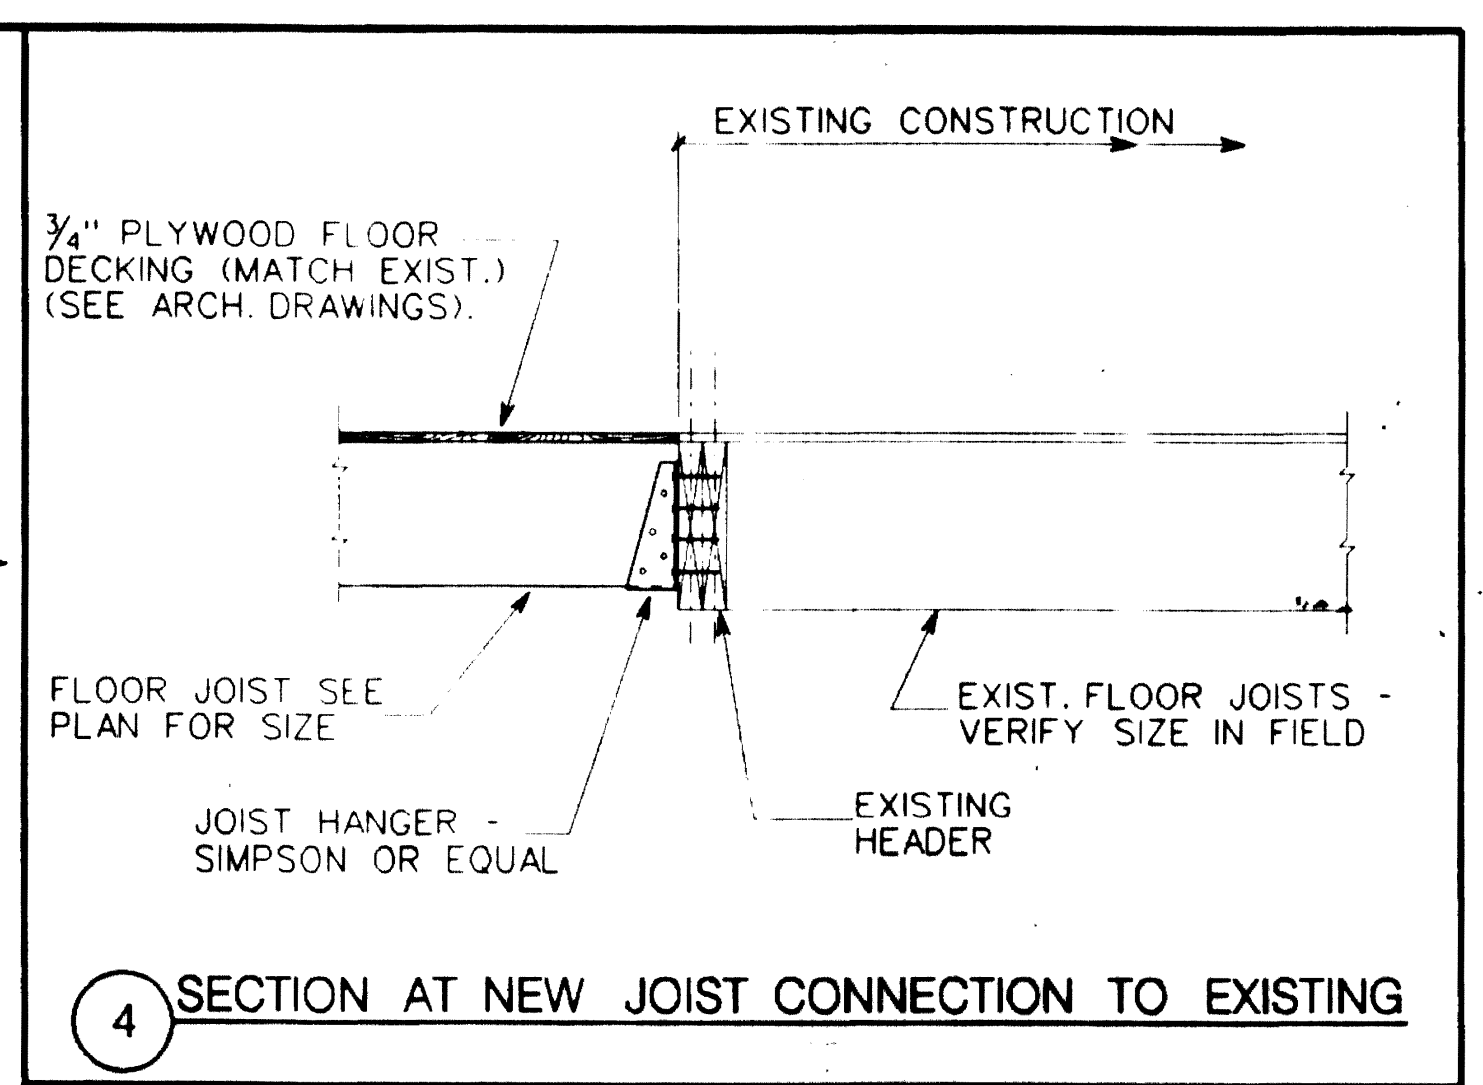

**BOND BEAM LINTEL SCHEDULE**

WALL OPENING	LINTEL DEPTH	REINFORCING
UP TO 4'-0"	8"	2-#4 BOTTOM
4'-0" TO 6'-0"	8"	2-#5 BOTTOM
6'-0" TO 8'-0"	16"	2-#5 BOTTOM
8'-0" TO 10'-0"	16"	2-#6 BOTTOM


BOND BEAM LINTELS TO HAVE A MINIMUM OF 8" BEARING AT EACH END.

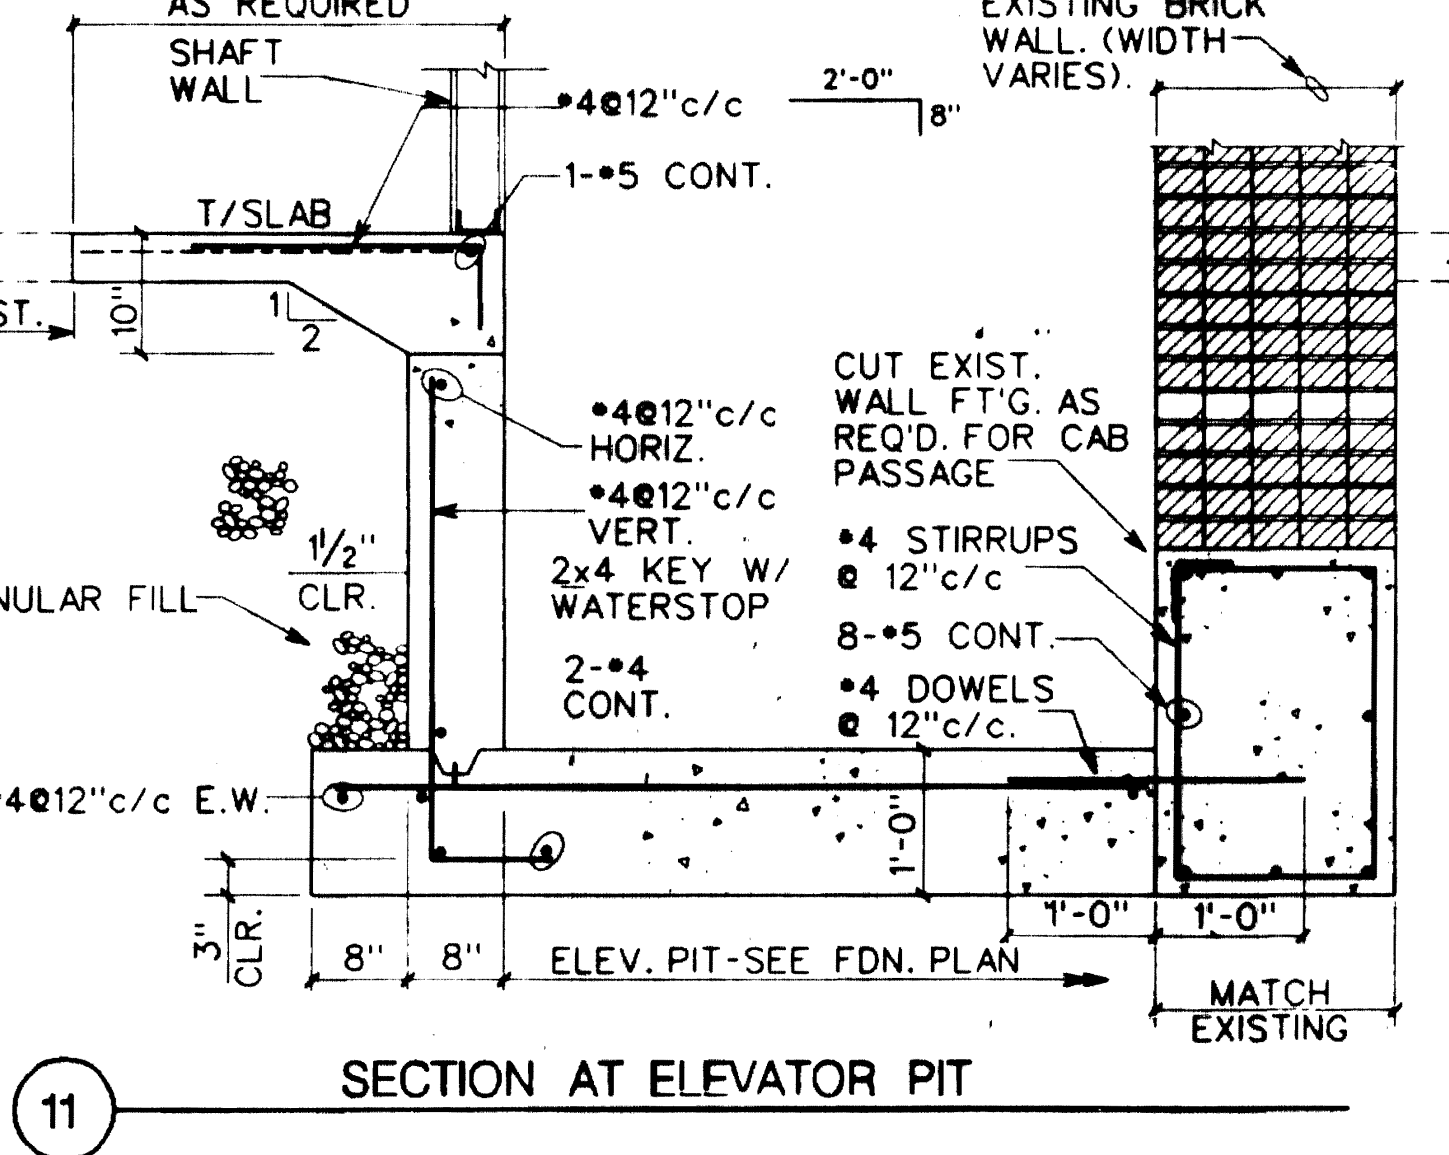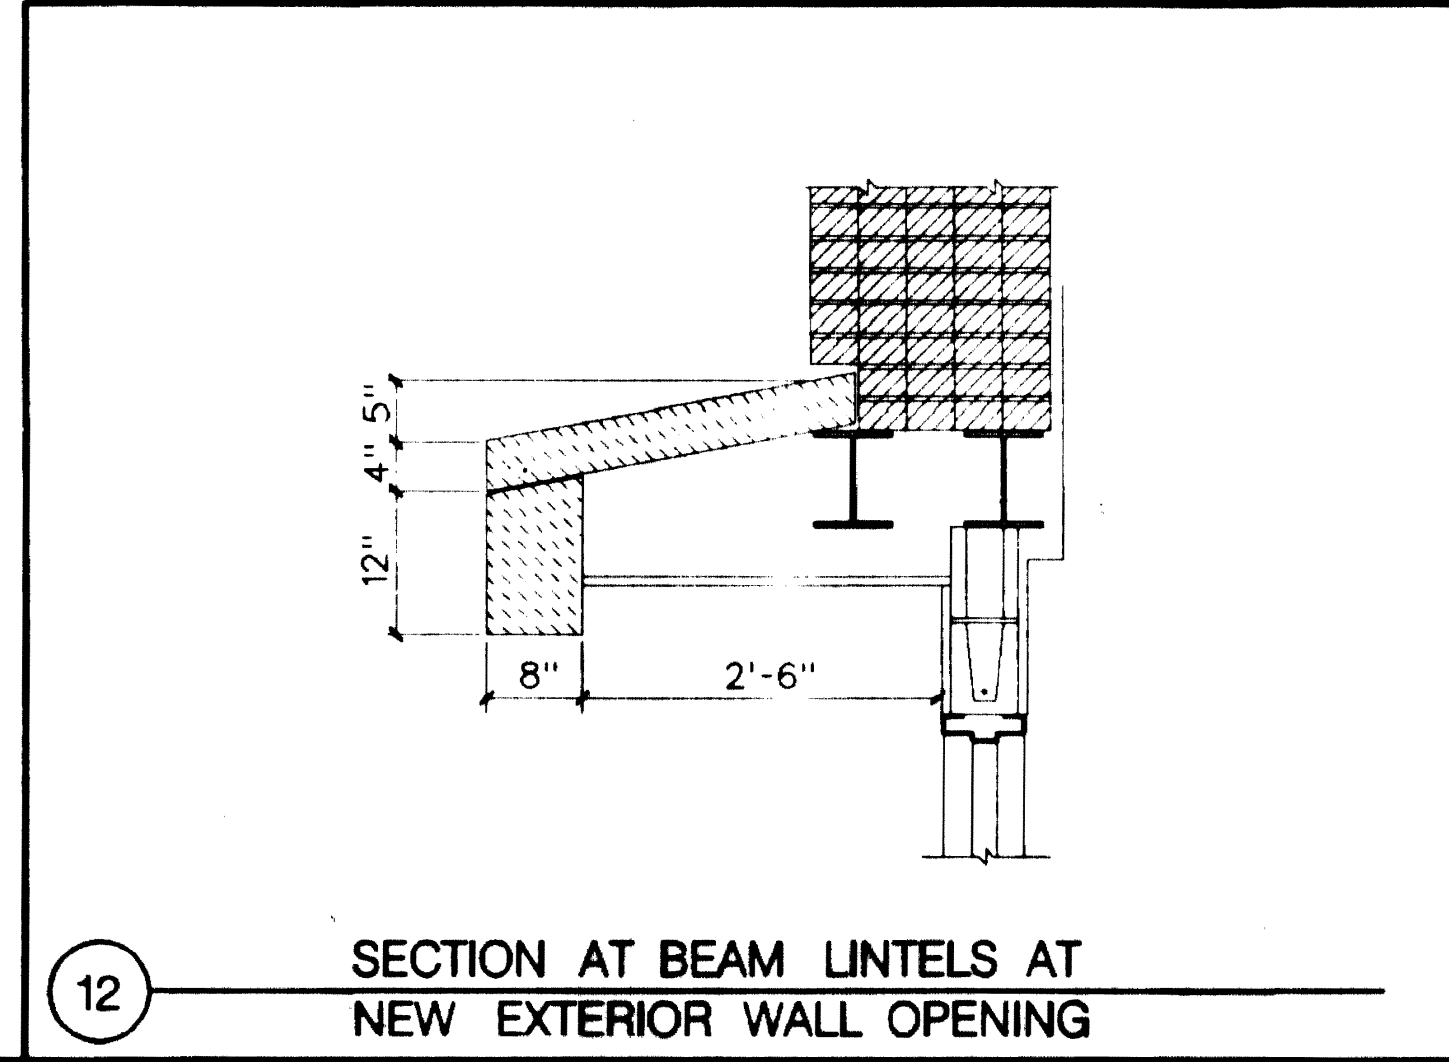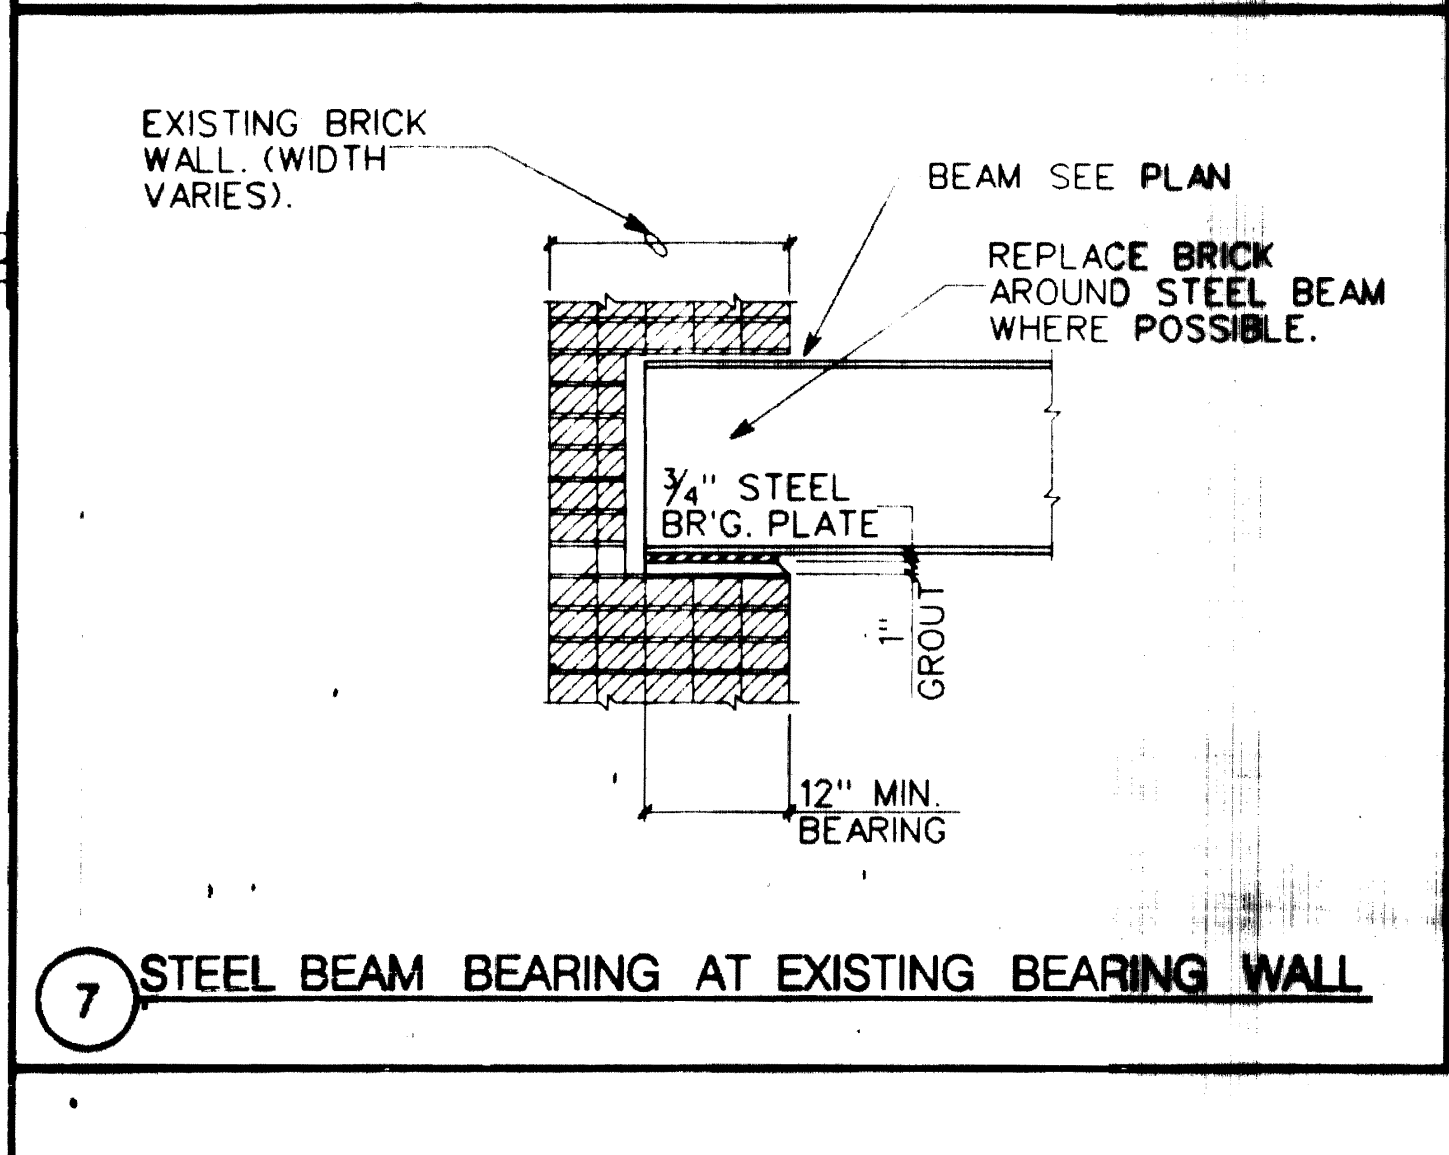

00 7504

43 B-1 08/25/11



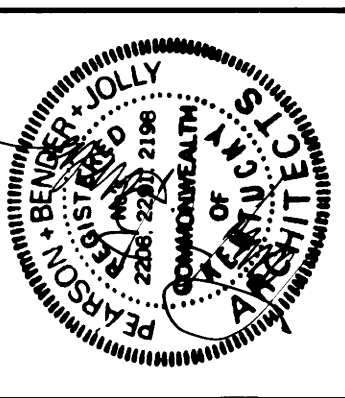

These record drawings have been prepared in part on the basis of information furnished by others. The Architect will not be responsible for any errors or omissions which may have been incorporated into this document as a result.

Pearson + Bender + Jolly  
DATE: 05/24/94

University of Kentucky  
Lexington, Kentucky

**FLOOR PLANS**

**MILLER HALL RENOVATION**  
Lexington Campus Sector  
University of Kentucky


Pearson + Bender + Jolly  
231 Kentucky Ave.  
Lexington, Ky. 40502  
606-253-1215  
FAX 253-1215

project no. 14620  
date 10/18/93


file no.  
dr. by M.L.J.  
ck. by L.B.

revisions


3.3

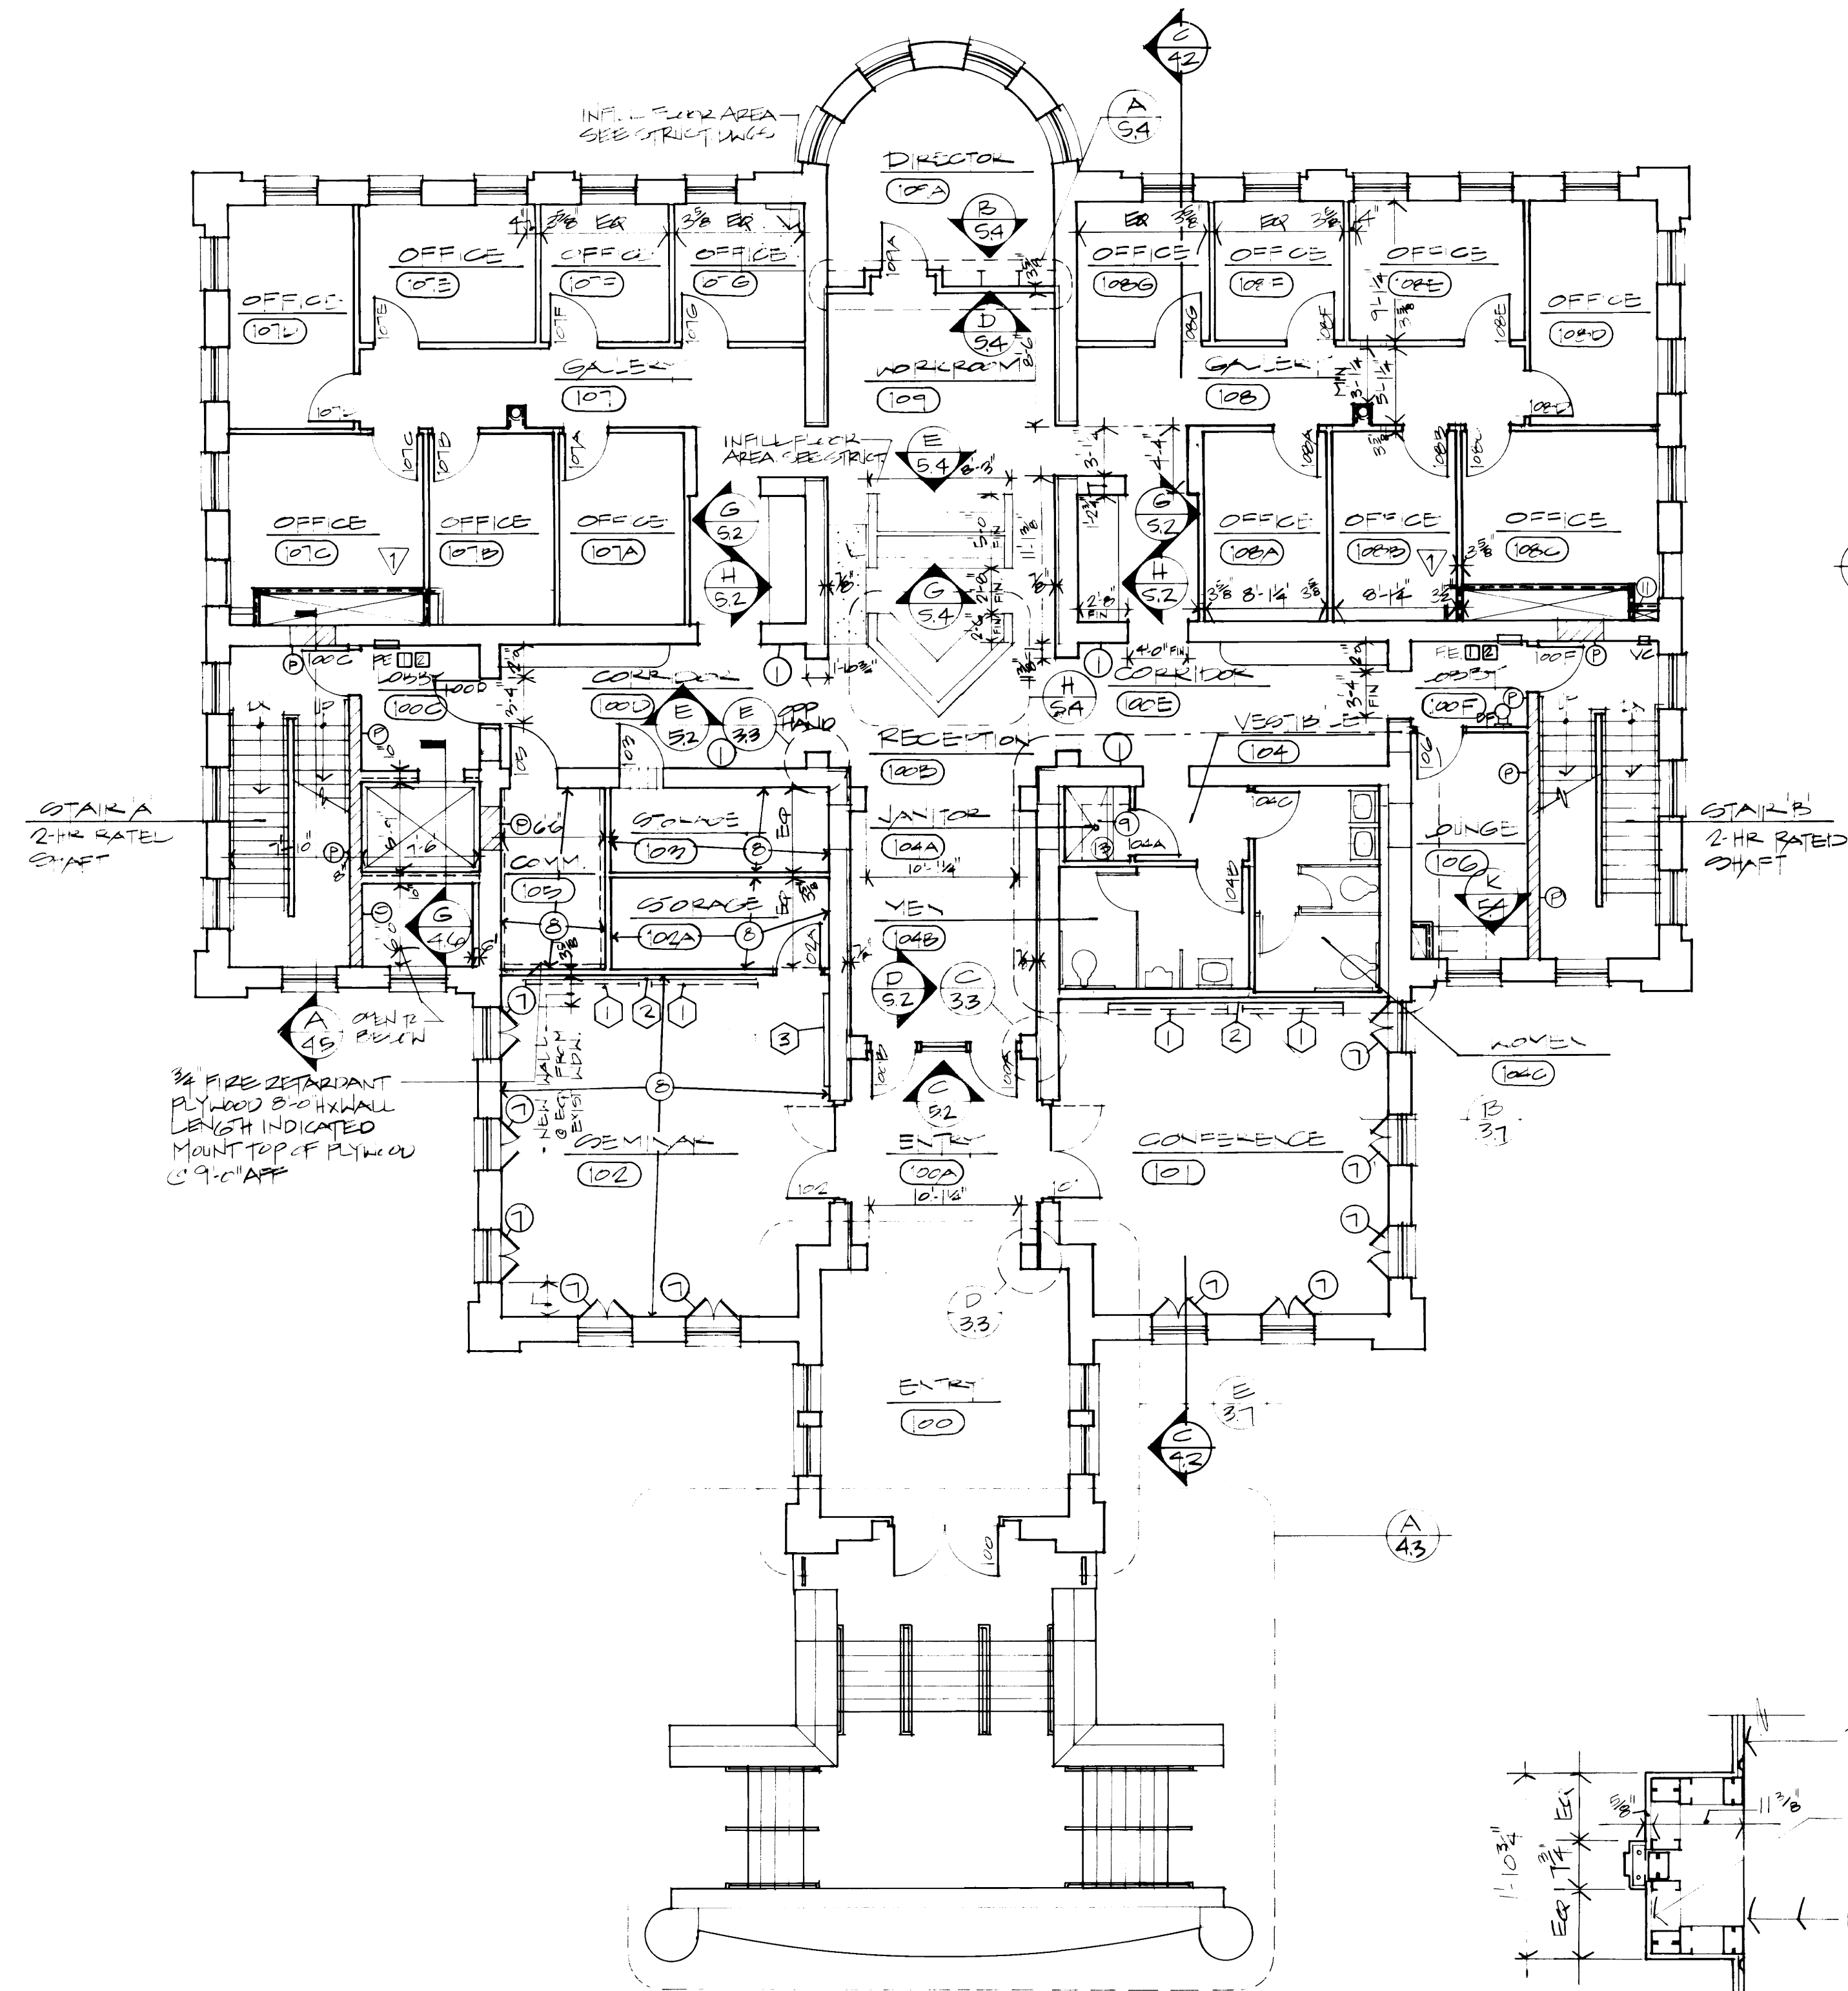


**12** FIRST FLOOR PLAN  
SC: 1/8" = 1'-0"

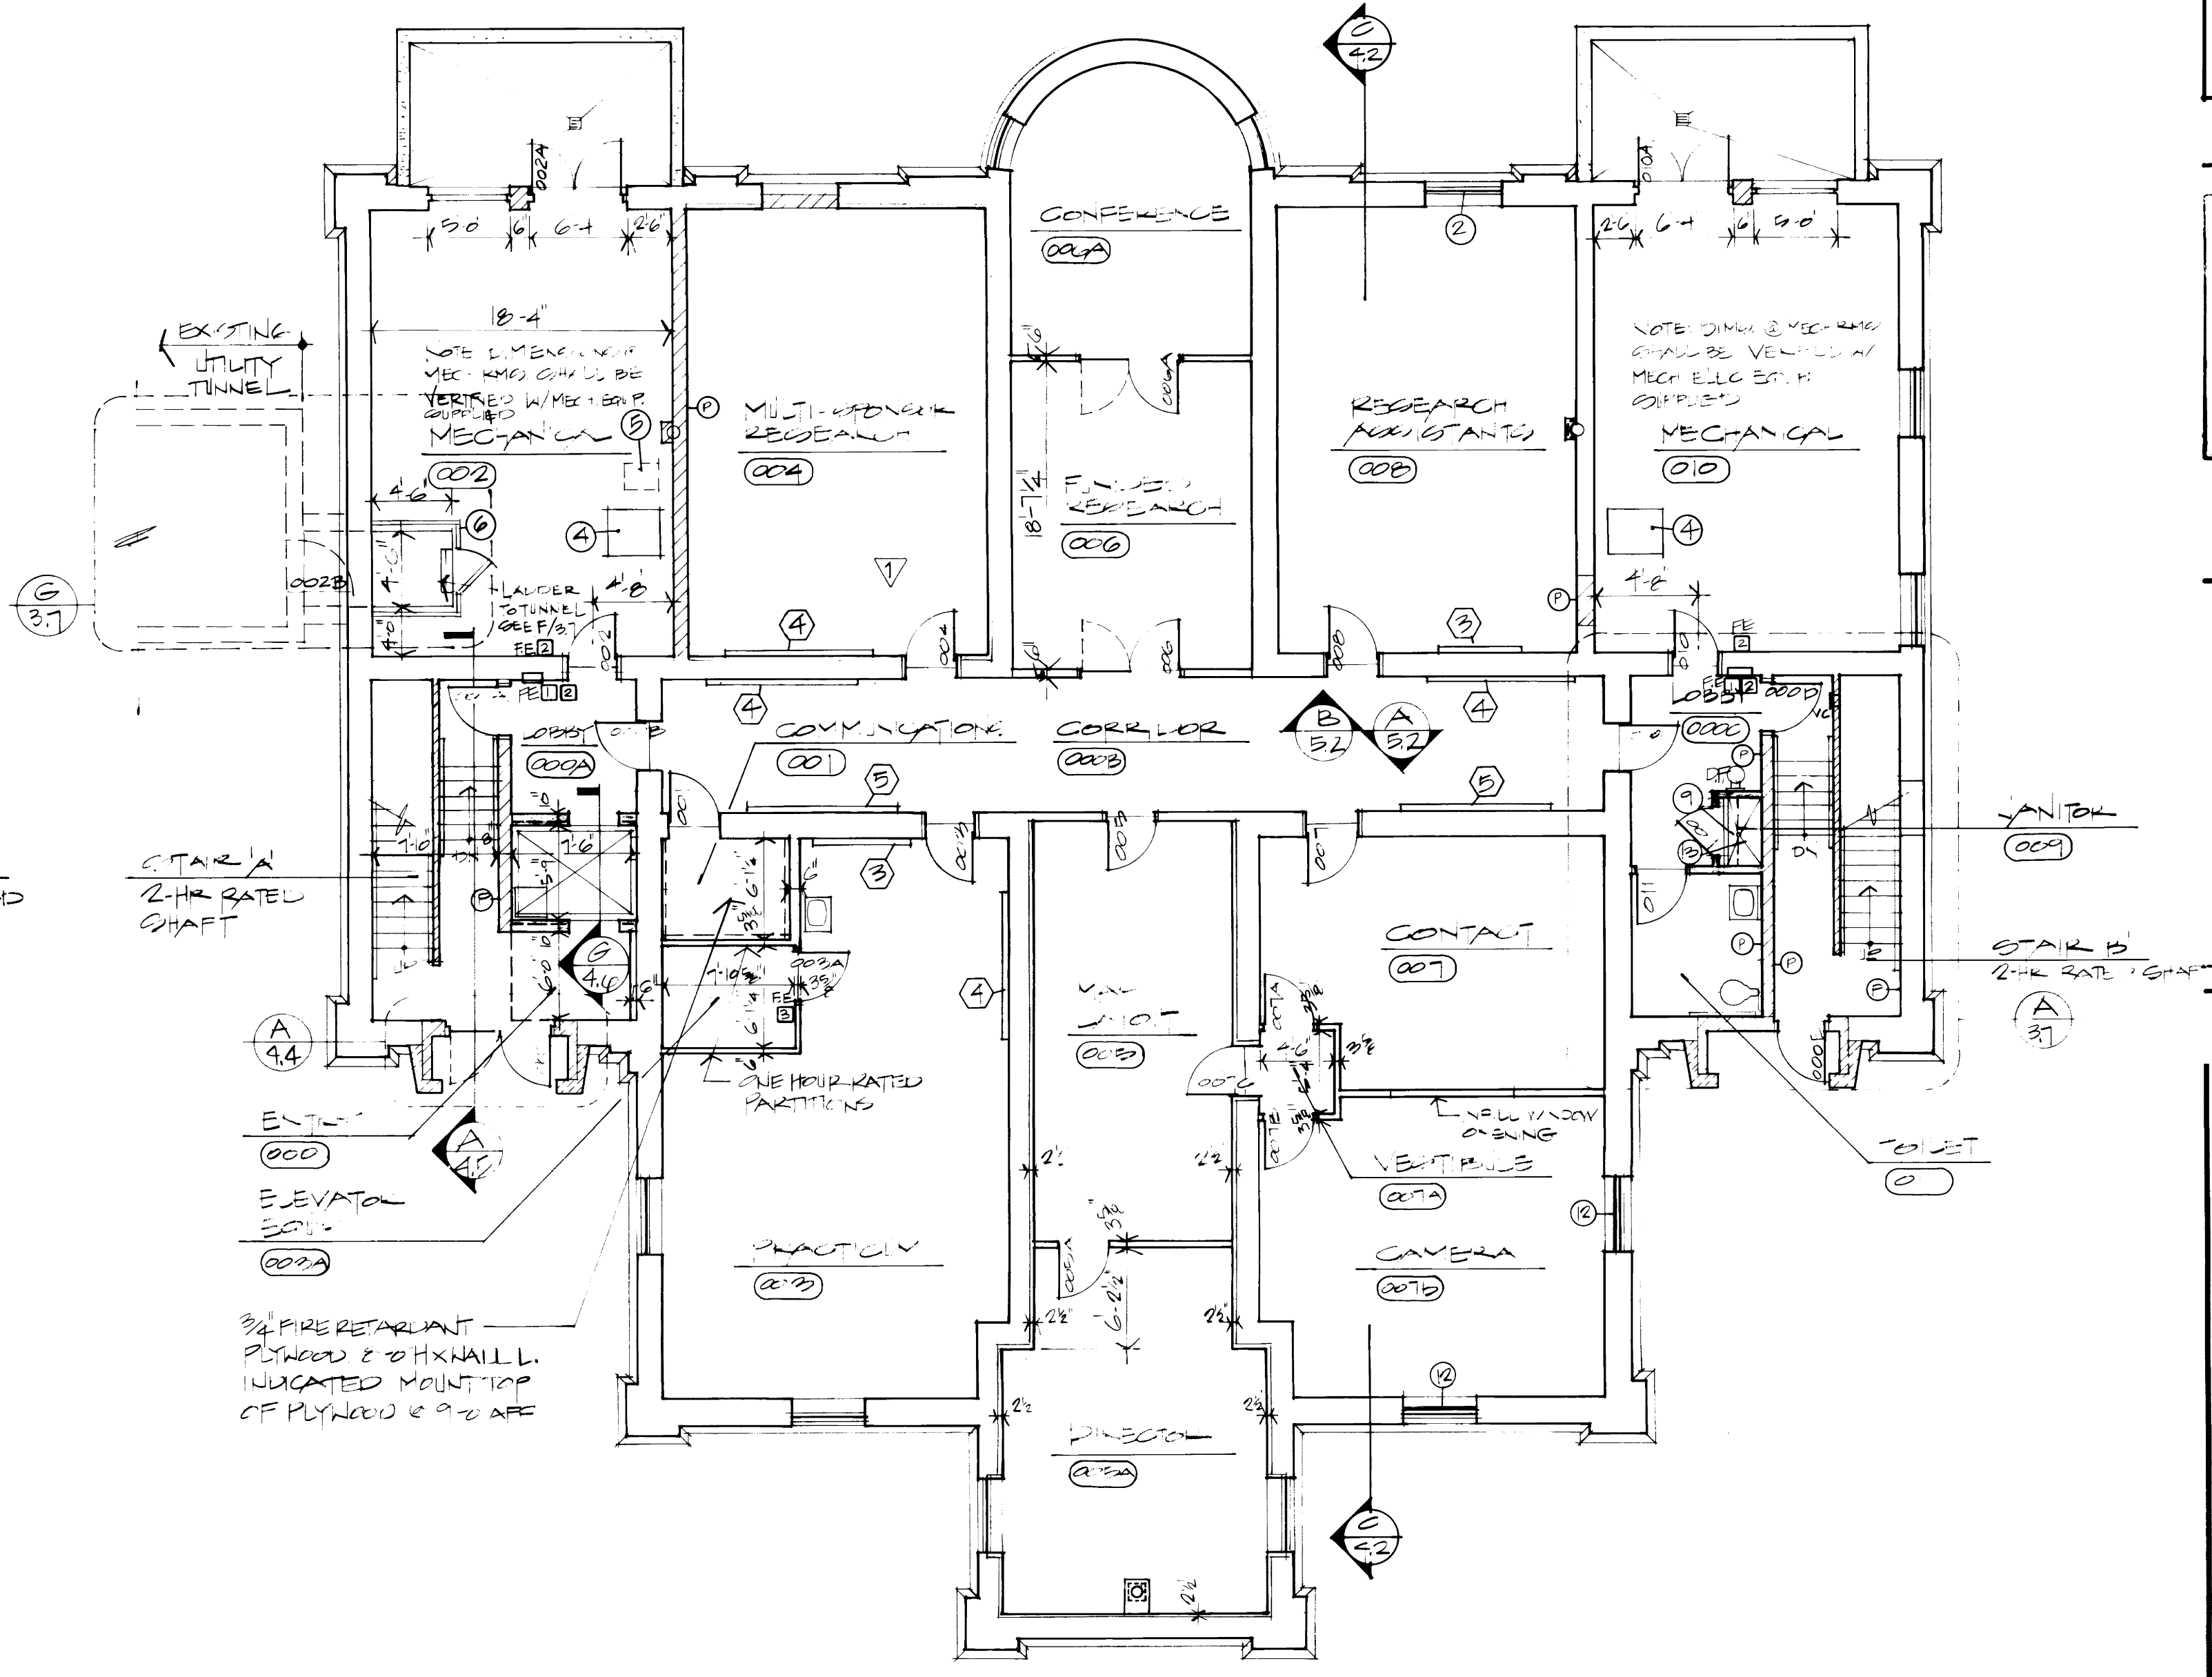


**33** BASEMENT FLOOR PLAN  
SC: 1/8" = 1'-0"

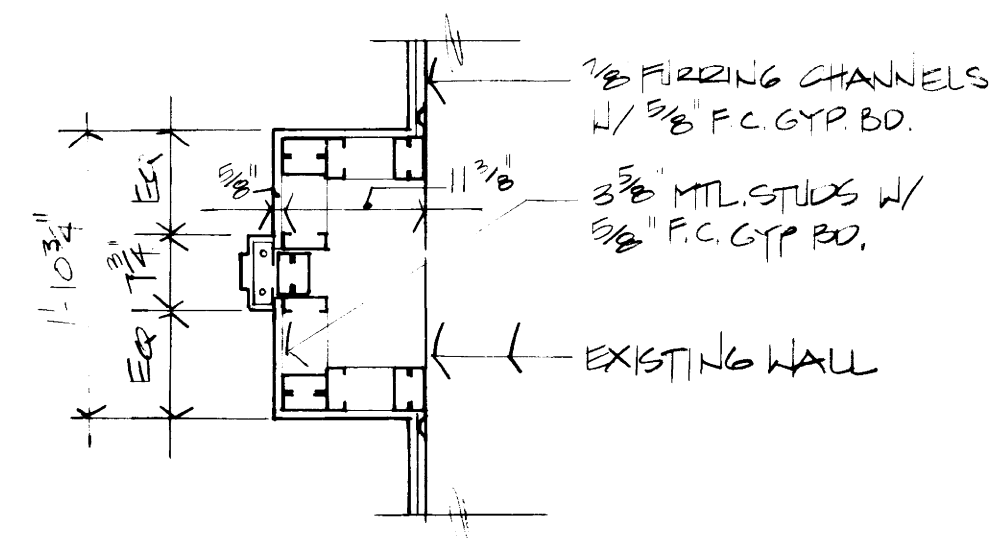


**33** PARTITION DETAIL  
SC: 3/4" = 1'-0"

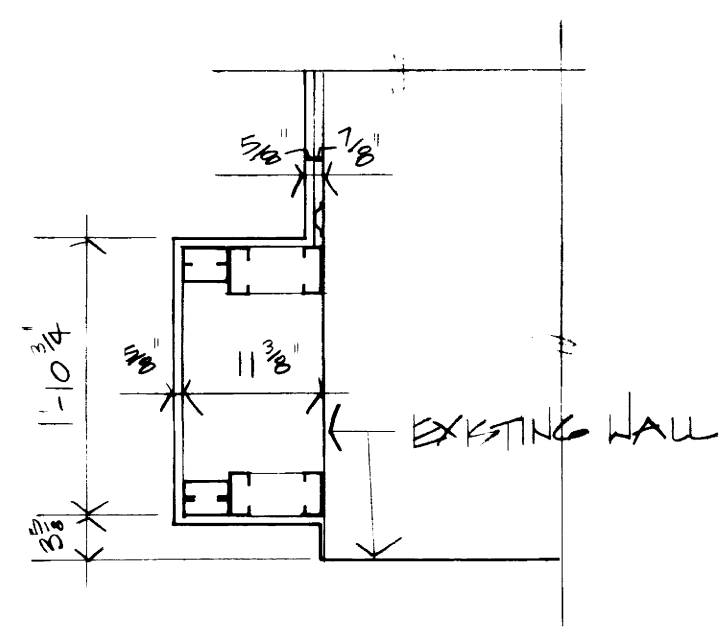

**33** PARTITION DETAIL  
SC: 3/4" = 1'-0"

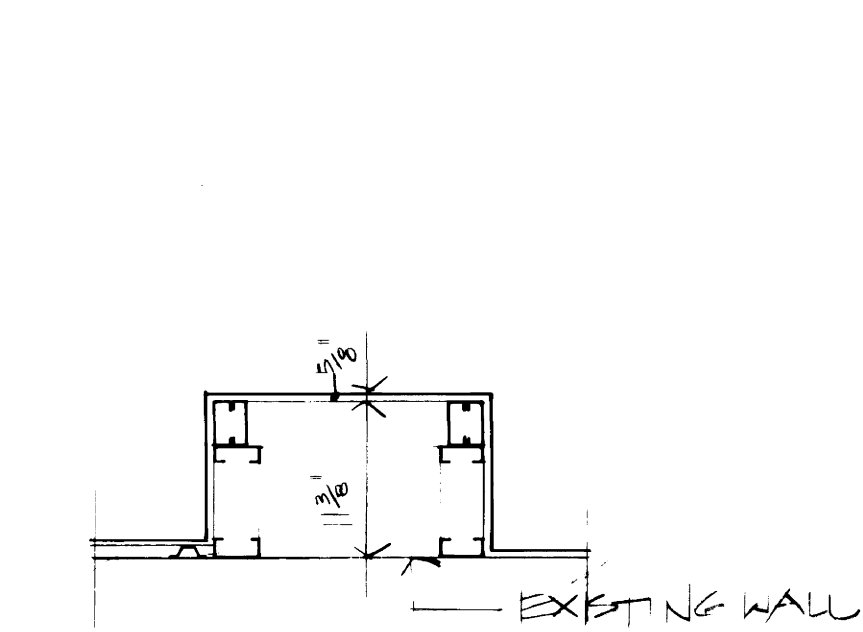


**33** PARTITION DETAIL  
SC: 3/4" = 1'-0"

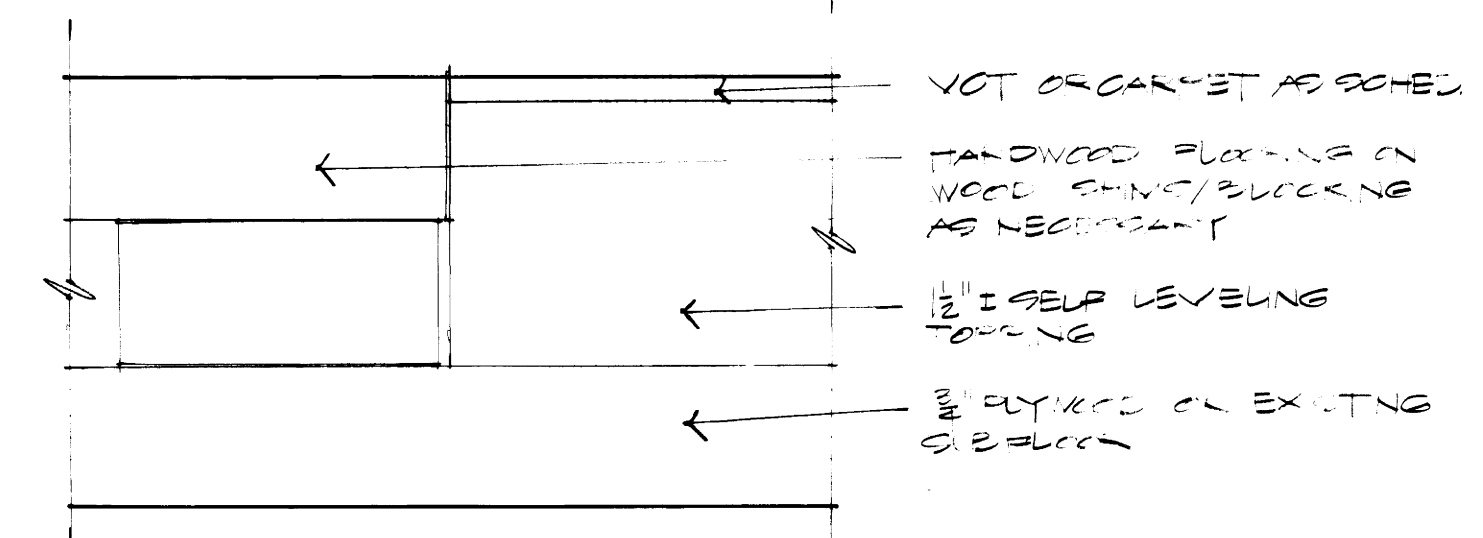

**33** TRANSITION DETAIL  
SC: 3/4" = 1'-0"

PARTITION LEGEND	
	EXISTING WALL
	CONCRETE BLOCK WALL, DIMENSION AS SHOWN
	1/2" F.C. GYP BD. EA. SIDE 3/8" MTL. STUDS (UNLESS NOTED OTHERWISE) @ 16" O.C. 1/2" SOLID ATTENUATION BLANKETS, ONE-HOUR RATED WHERE INDICATED
	(2) LAYERS 1/2" F.C. GYP BD. 1" SHAFT WALL LINER PANEL ON 2 1/2" C.H. STUDS @ 24" O.C. PARTITION TO UNDERGRADE OF DECK. TWO-HOUR RATED UNLESS NOTED OTHERWISE
	EXISTING HALL WITH PLASTER FINISH ONE SIDE
	CONCRETE BLOCK WALL W/ PLASTER FINISH ONE SIDE



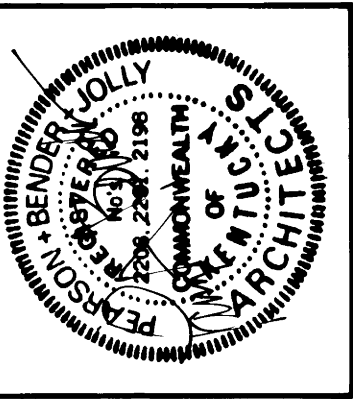

These revised drawings have been prepared as part of the design process and are not to be used for construction. The Architect will not be responsible for any errors or omissions. This document is not to be interpreted into any other document or contract.

Pearson + Bender + Jolly  
Nov 14

University of Kentucky  
Lexington, Kentucky

prepared by: UNIVERSITY OF KENTUCKY  
ARCHITECTURAL DEPARTMENT

FLOOR PLANS

# MILLER HALL RENOVATION


Lexington Campus Sector  
University of Kentucky



project no. 1469.0  
date 20 AUGUST 98  
file no.  
dr. by V.  
ck. by LB


revisions

3.4

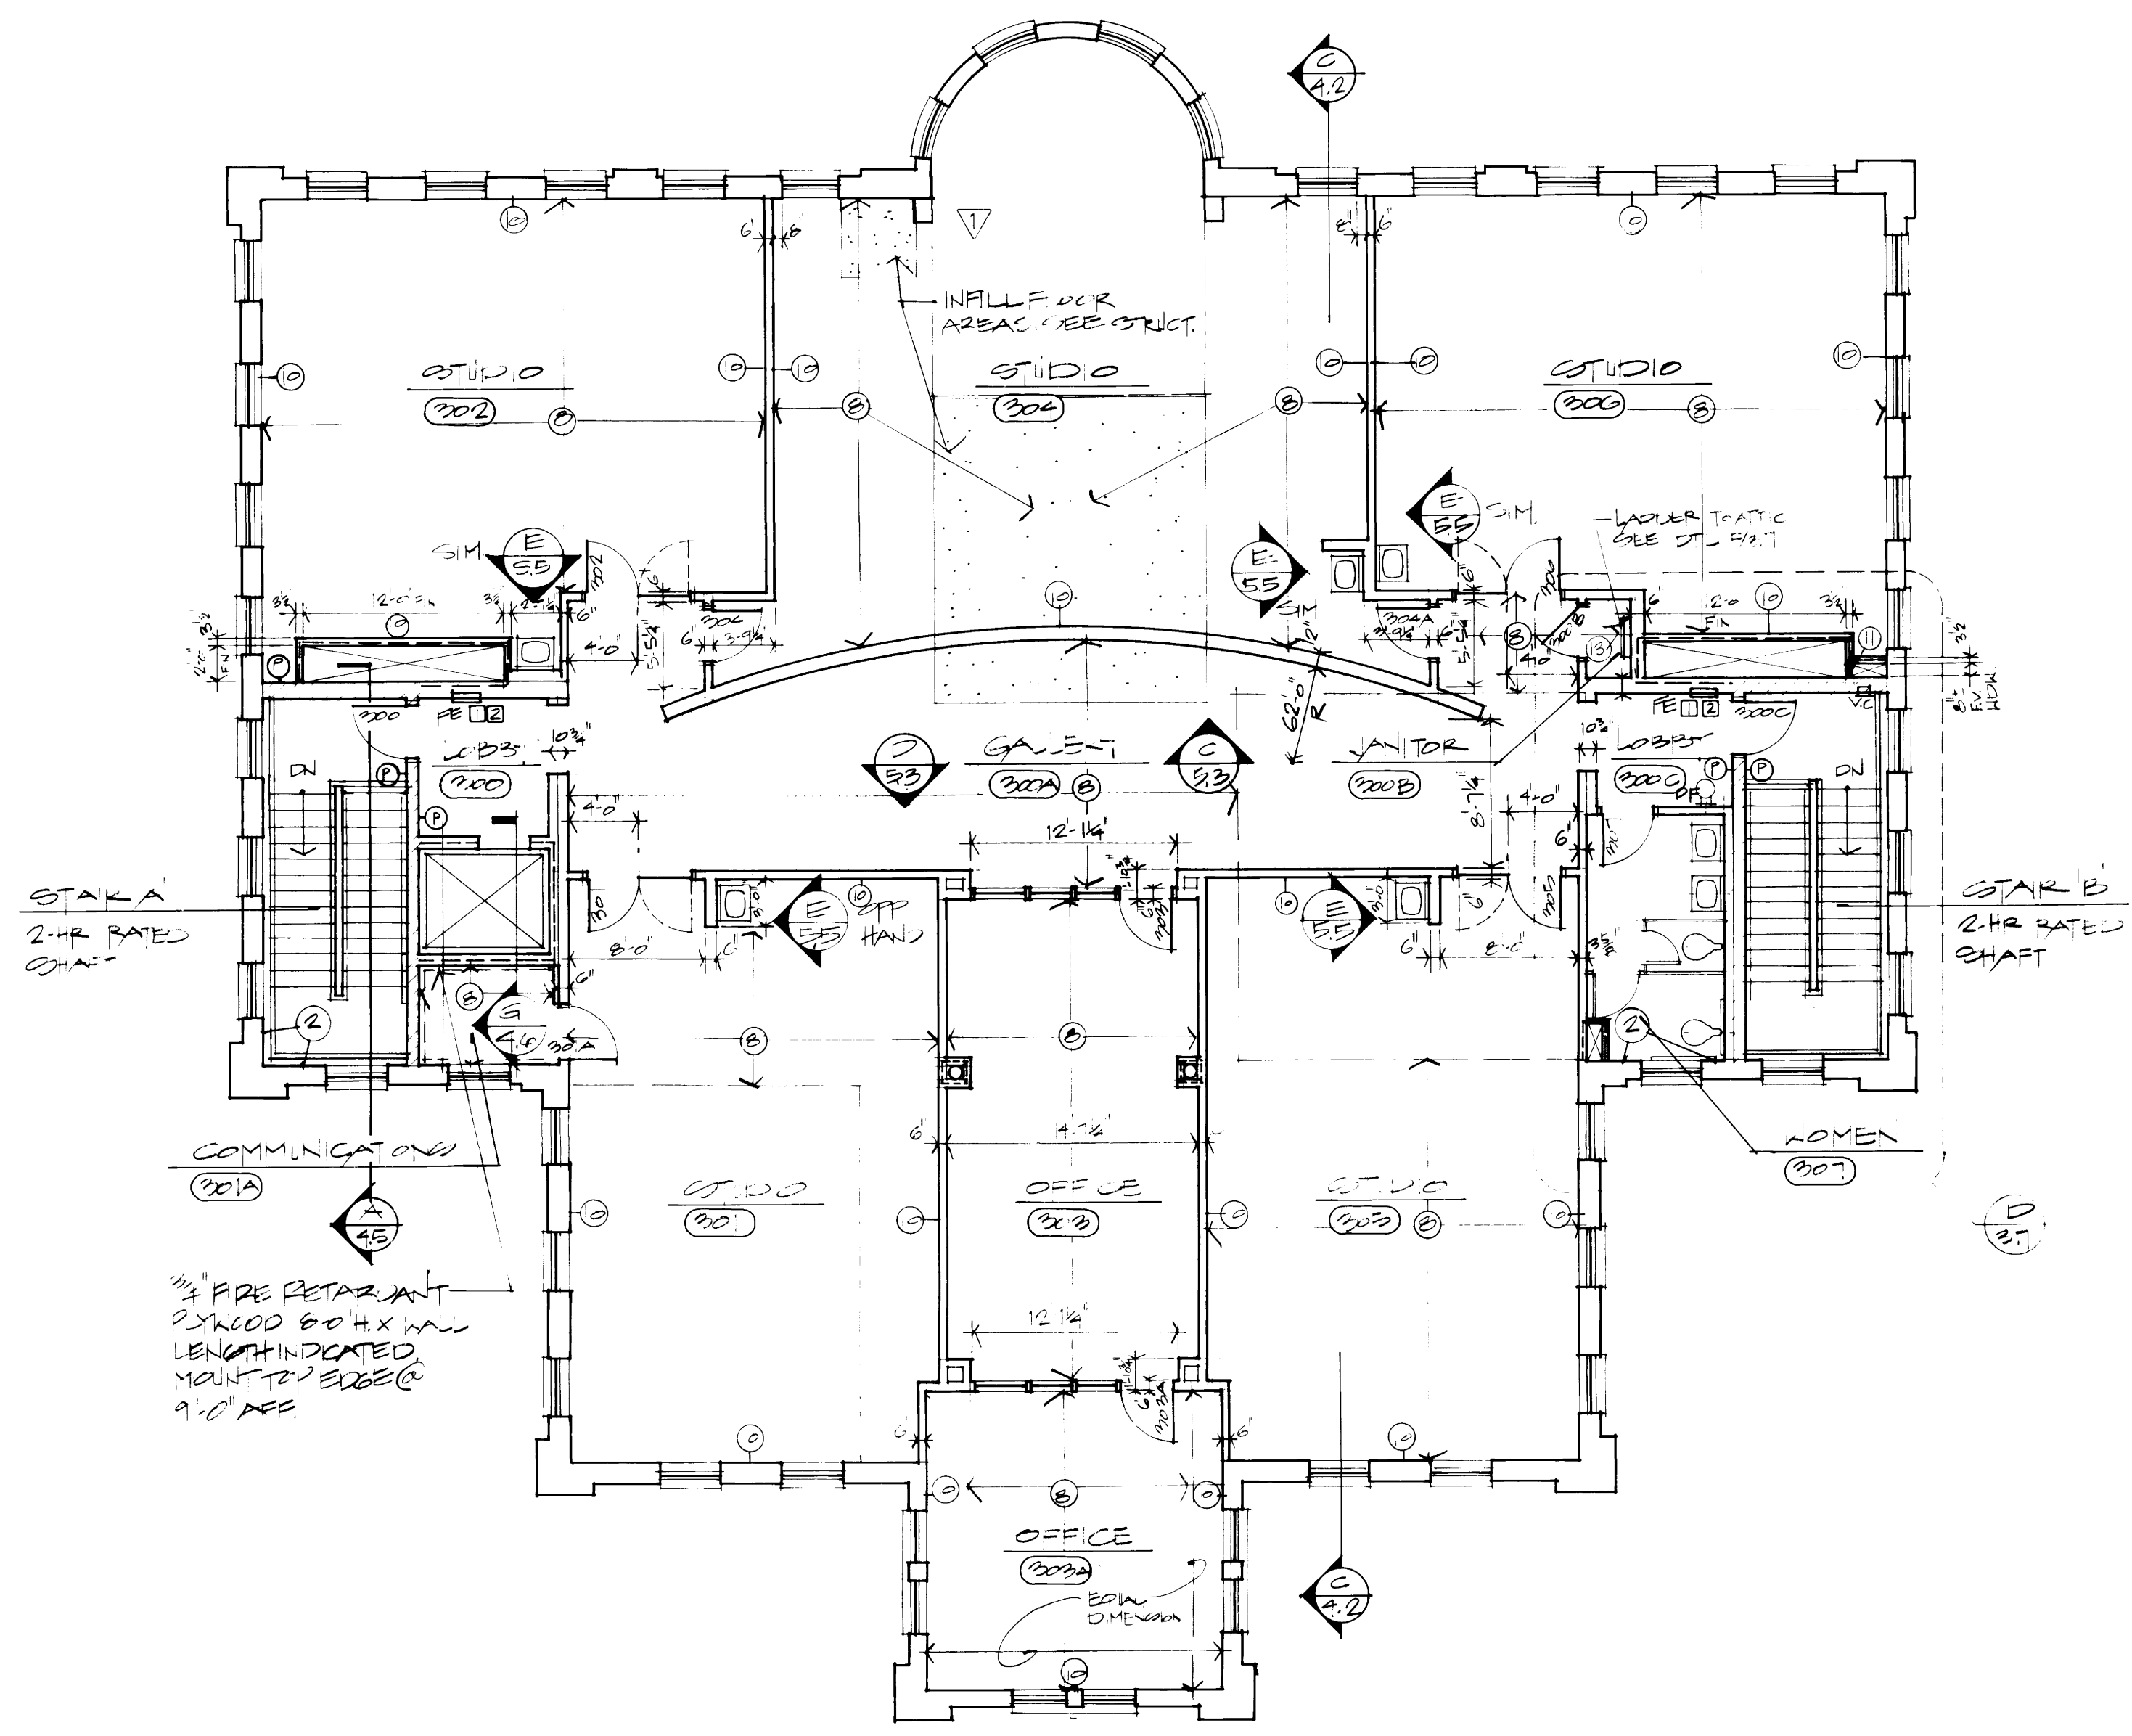


PLAN NORTH

**③ THIRD FLOOR PLAN**  
SCALE: 1/8" = 1'-0"  
SEE SHEET 2.3 FOR PARTITION LEGEND

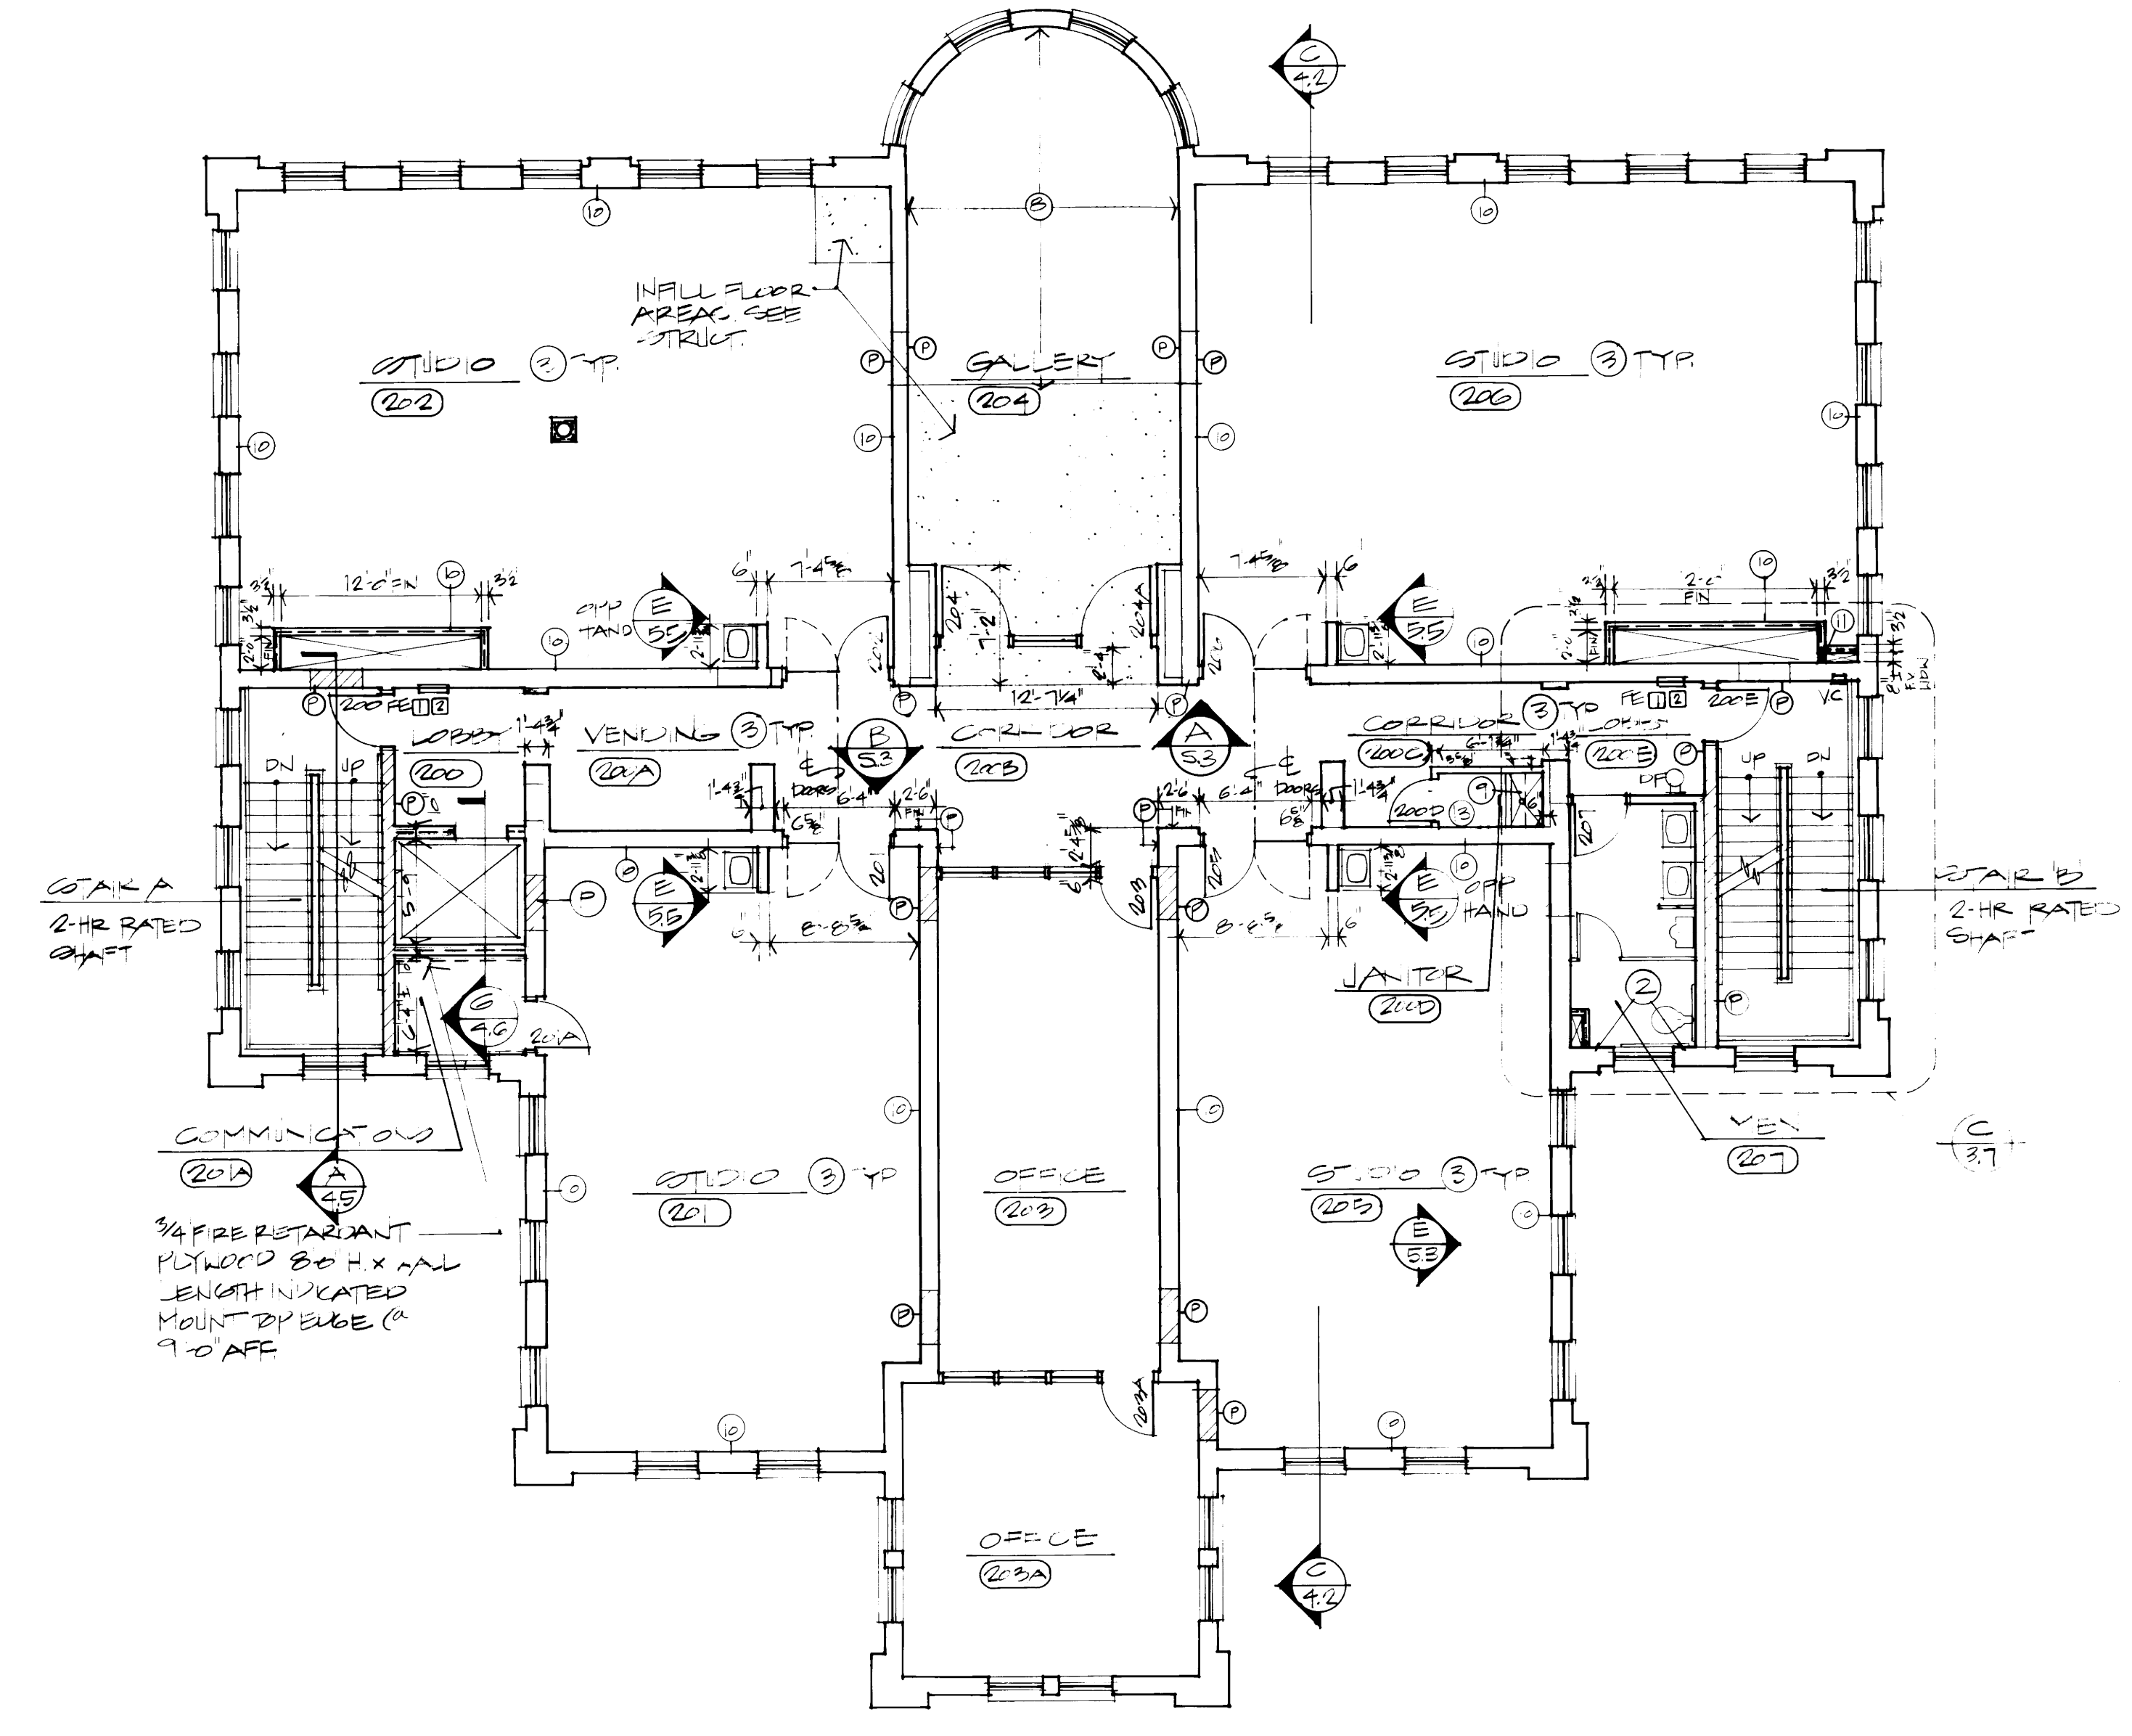

PLAN NORTH

**② SECOND FLOOR PLAN**  
SCALE: 1/8" = 1'-0"  
SEE SHEET 2.3 FOR PARTITION LEGEND

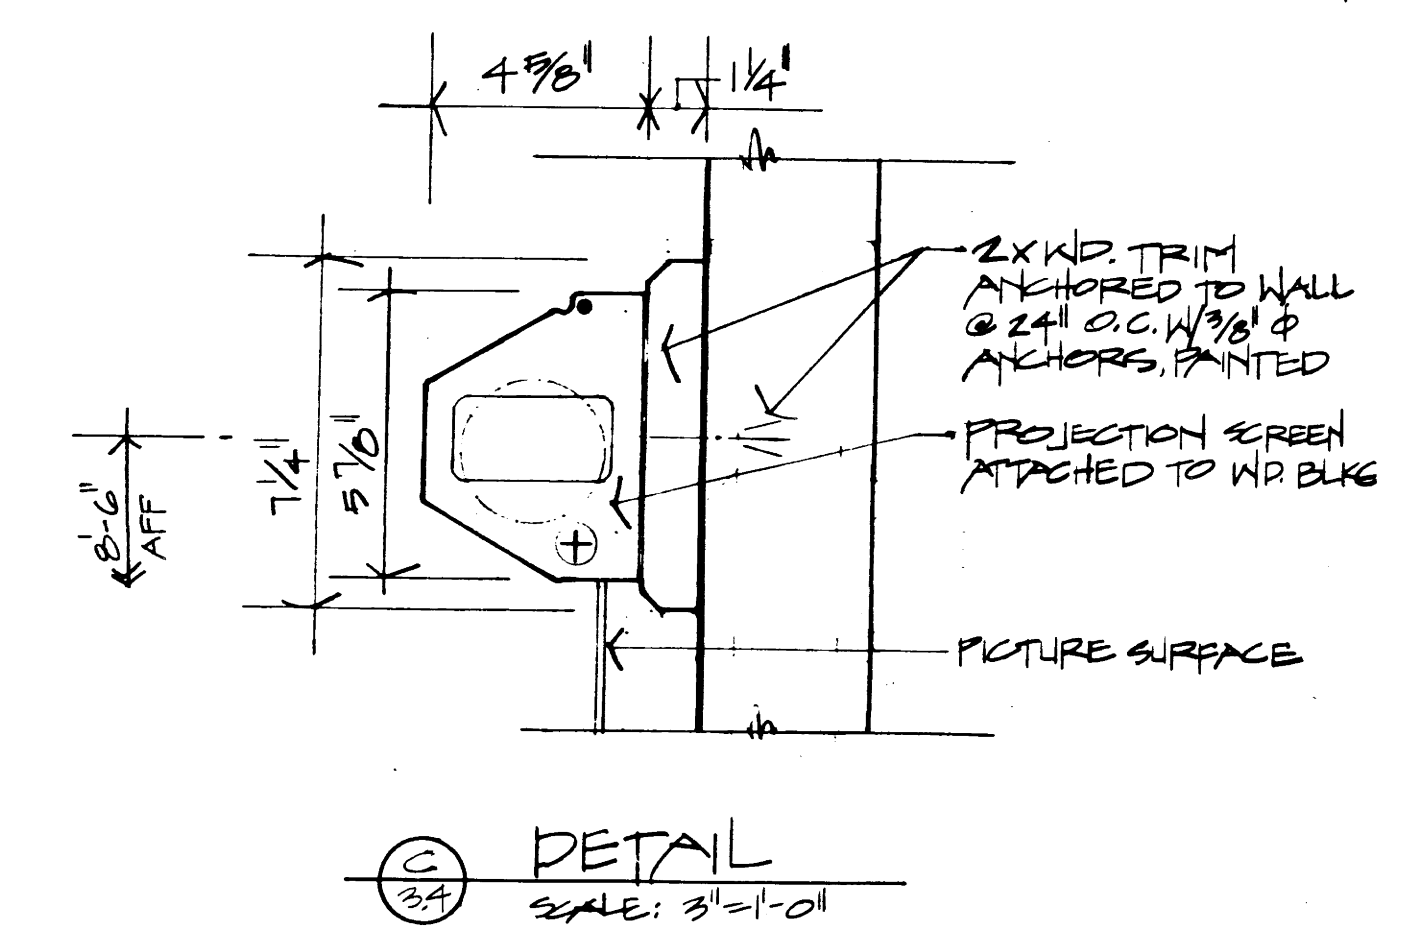

### FLOOR PLAN CONSTRUCTION NOTES


- GENERAL:**
- PROVIDE SELF-LEVELING FLOOR TOPPING AN AVERAGE OF 1" AT ALL FLOOR AREAS OF THE FIRST, SECOND AND THIRD FLOORS NOT SCHEDULED TO RECEIVE WOOD FLOORING. SEE DETAIL F2.3.
  - ALL EXISTING PLASTER WALLS SHALL RECEIVE NEW PLASTER COAT PER SPECIFICATIONS.
- APPLY PLASTER TO EXISTING BRICK WALL TO FLUSH WITH REMAINING PLASTER WALL.
  - REPAIR DAMAGED PLASTER, PREPARE FOR PAINT FINISH.
  - APPLY BASE PLASTER COAT ON MASONRY AT WAINSCOT REMOVAL. APPLY FINISH PLASTER COAT OVER ENTIRE WALL SURFACE, TYPICAL. REFER TO DEMOLITION PLANS FOR ADDITIONAL INFORMATION OF WAINSCOT REMOVAL LOCATIONS.
  - PROVIDE RADON PIT: 2'-0" X 2'-0" X 2'-0" FILL WITH GRAVEL AND PVC 6" PIPE TO ATTIC THROUGH MECH SHAFT. REFER TO MECHANICAL DRAWINGS FOR FAN INFORMATION. GAP WITH 4" CONCRETE.
  - FILL EXISTING MANHOLE WITH GRAVEL, SEAL WITH 4" CONCRETE.
  - TUNNEL ACCESS: PROVIDE FLOOR OPENING FOR TUNNEL ACCESS WITH GUARD RAIL AND GATE AS SHOWN. SEE DETAIL G3.7.
- PROVIDE WOOD SHUTTER AT WINDOW. SEE DETAIL I,J/5.2.
  - PROVIDE NEW 3/4" PLYWOOD DECK.
  - JANITOR'S CLOSET: PROVIDE TILE SHOWER FLOOR W/FLOOR DRAIN PER PLUMBING DRAWINGS, AND LEAD SHOWER PAN W/8" TURN-UP TYPICAL AT PERIMETER. 6" CONCRETE BLOCK THRESHOLD. QUARRY TILE FINISH ON MUDSET BED W/REIN.
  - PROVIDE 3/8" GYP BD WITH WOOD TRIM PER DETAIL E5.2; E/5/3 (ADD+1)
  - ENCLOSE NEW STEEL BEAM WITH SHAFT WALL TO MAINTAIN 2-HR RATING.
  - PROVIDE 1" FIBERBOARD PANEL WITH 2" HARDWOOD TRIM AT INTERIOR. PAINT FINISH.
  - JANITOR'S CLOSET: PROVIDE WALL MOUNTED 3/4" PLYWOOD SHELVING AS INDICATED AND PROVIDE WALL MOUNTED MOP RACK, (1) RACK PER CLOSET. B-223 x 24" BT BOBRICK (ADD+1)

### FIRE EXTINGUISHER AND VALVE CABINET LEGEND

VC	VALVE CABINET; RECESSED WITH BREAKGLASS FACE.
FE ①	FIRE EXTINGUISHER CABINET; SEMI-RECESSED.
FE ②	10 LB. ABC.
FE ③	5 LB. CO <sup>2</sup>

### VISUAL DISPLAY BOARDS LEGEND

①	PROJECTION SCREEN	70" H x 70" W	SPEC SECTION 10100 C/34
②	CHALKBOARD	4' x 16" TYPICAL	SPEC SECTION 10100
③	MARKER CHALKBOARD	4' x 5" TYPICAL	SPEC SECTION 10100
④	TACKBOARD	4' x 8" TYPICAL	SPEC SECTION 10100
⑤	DISPLAY BOARD	3' x 8" TYPICAL	SPEC SECTION 10100
(ADD+1)	NON-ILLUMINATED DIRECTORY		

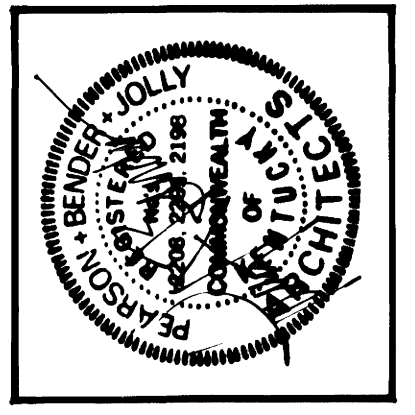

These record drawings have been prepared in part on information furnished by others. The Architect, Engineer, and other professionals will not be responsible for errors or omissions which result from reliance on this information unless it is shown on this document as a result of their professional review.

Pearson + Bender + Jolly  
DATE: 4 NOV 14


University of Kentucky  
Lexington, Kentucky

OFFICIAL BID DOCUMENT

ENLARGED FLOOR PLAN

# MILLER HALL RENOVATION









Lexington Campus Sector  
University of Kentucky

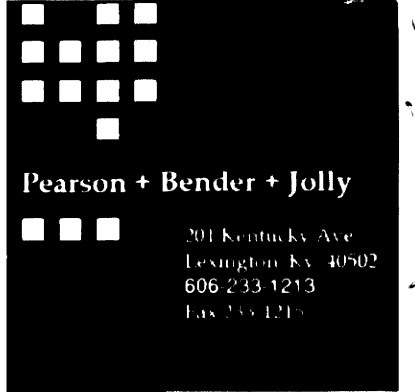


project no. 14050.0  
date 10 AUG 14  
file no.  
dr. by WJ, MP  
ck. by MP

revisions

3.7

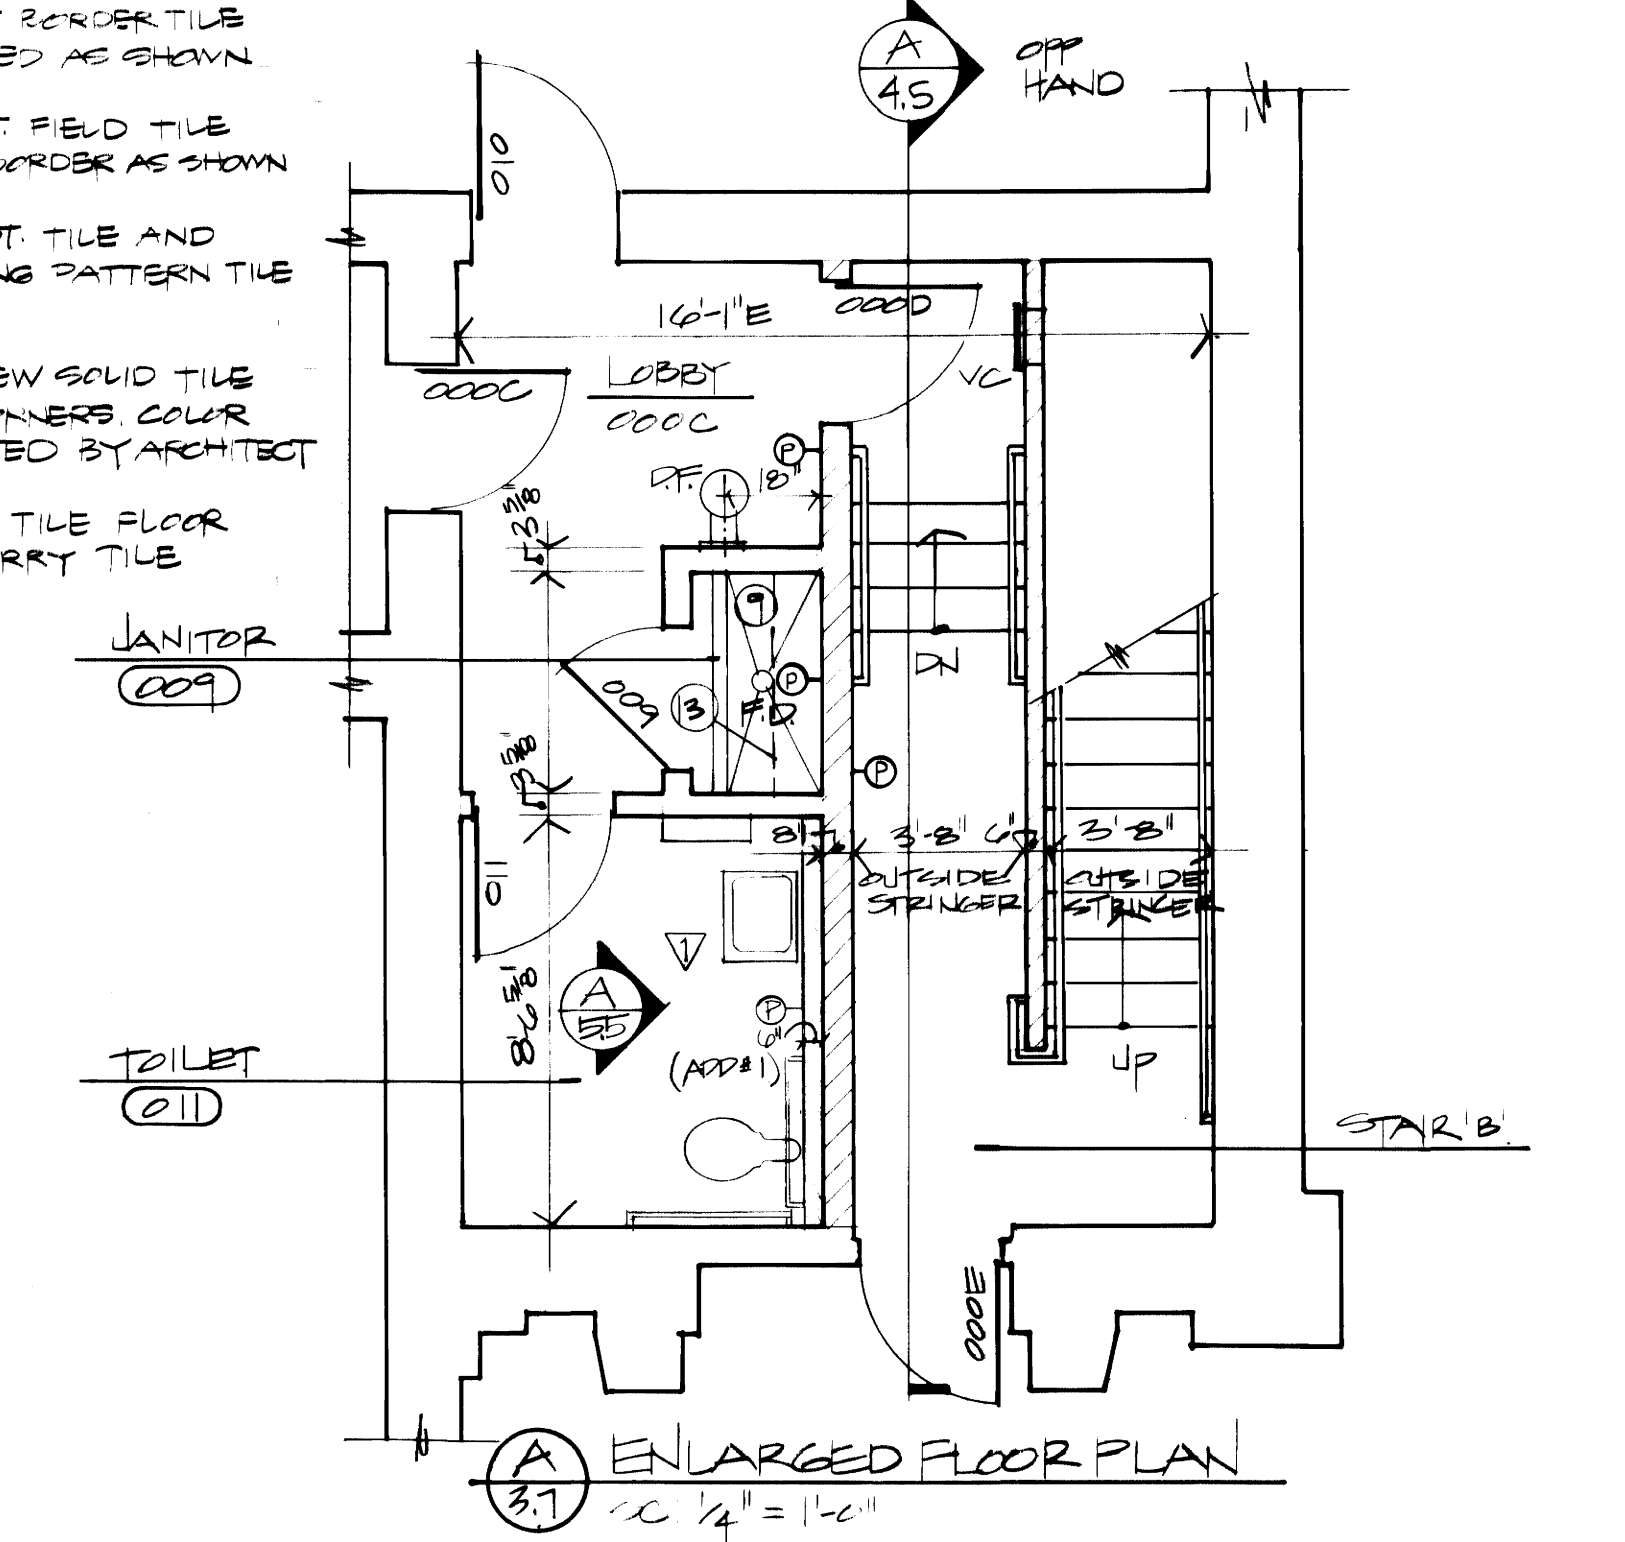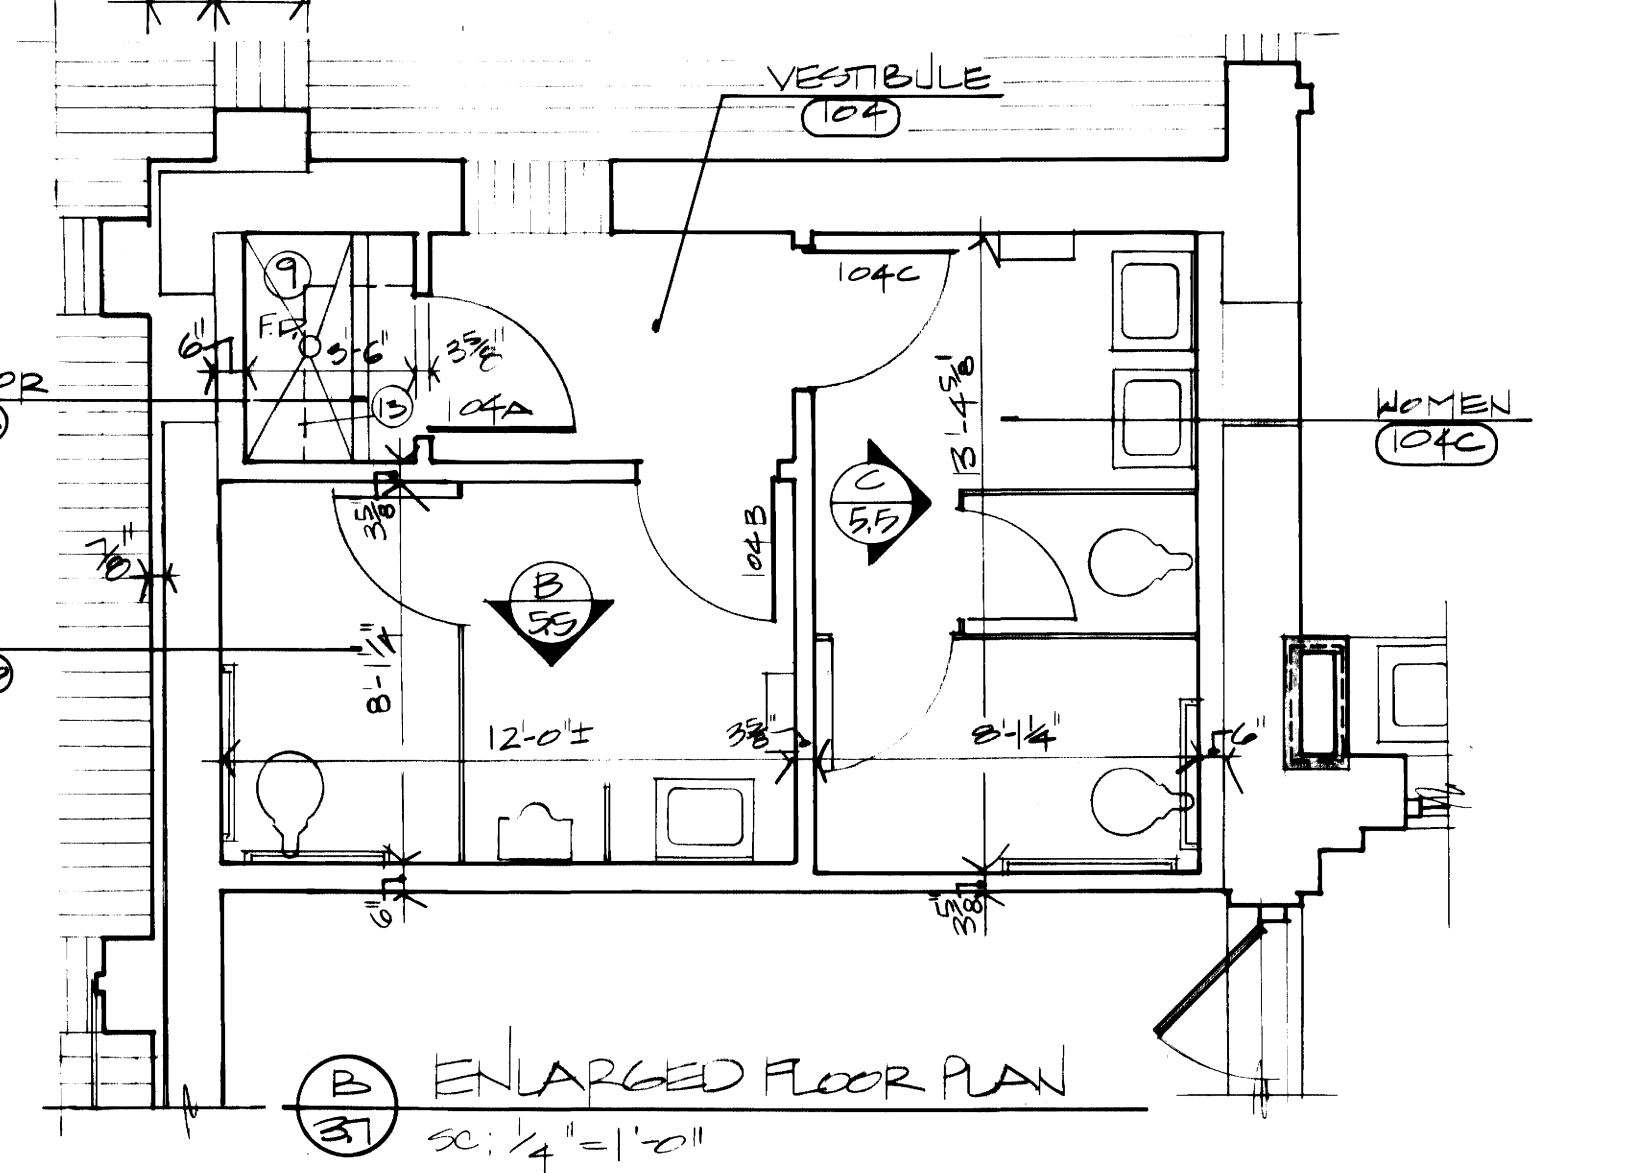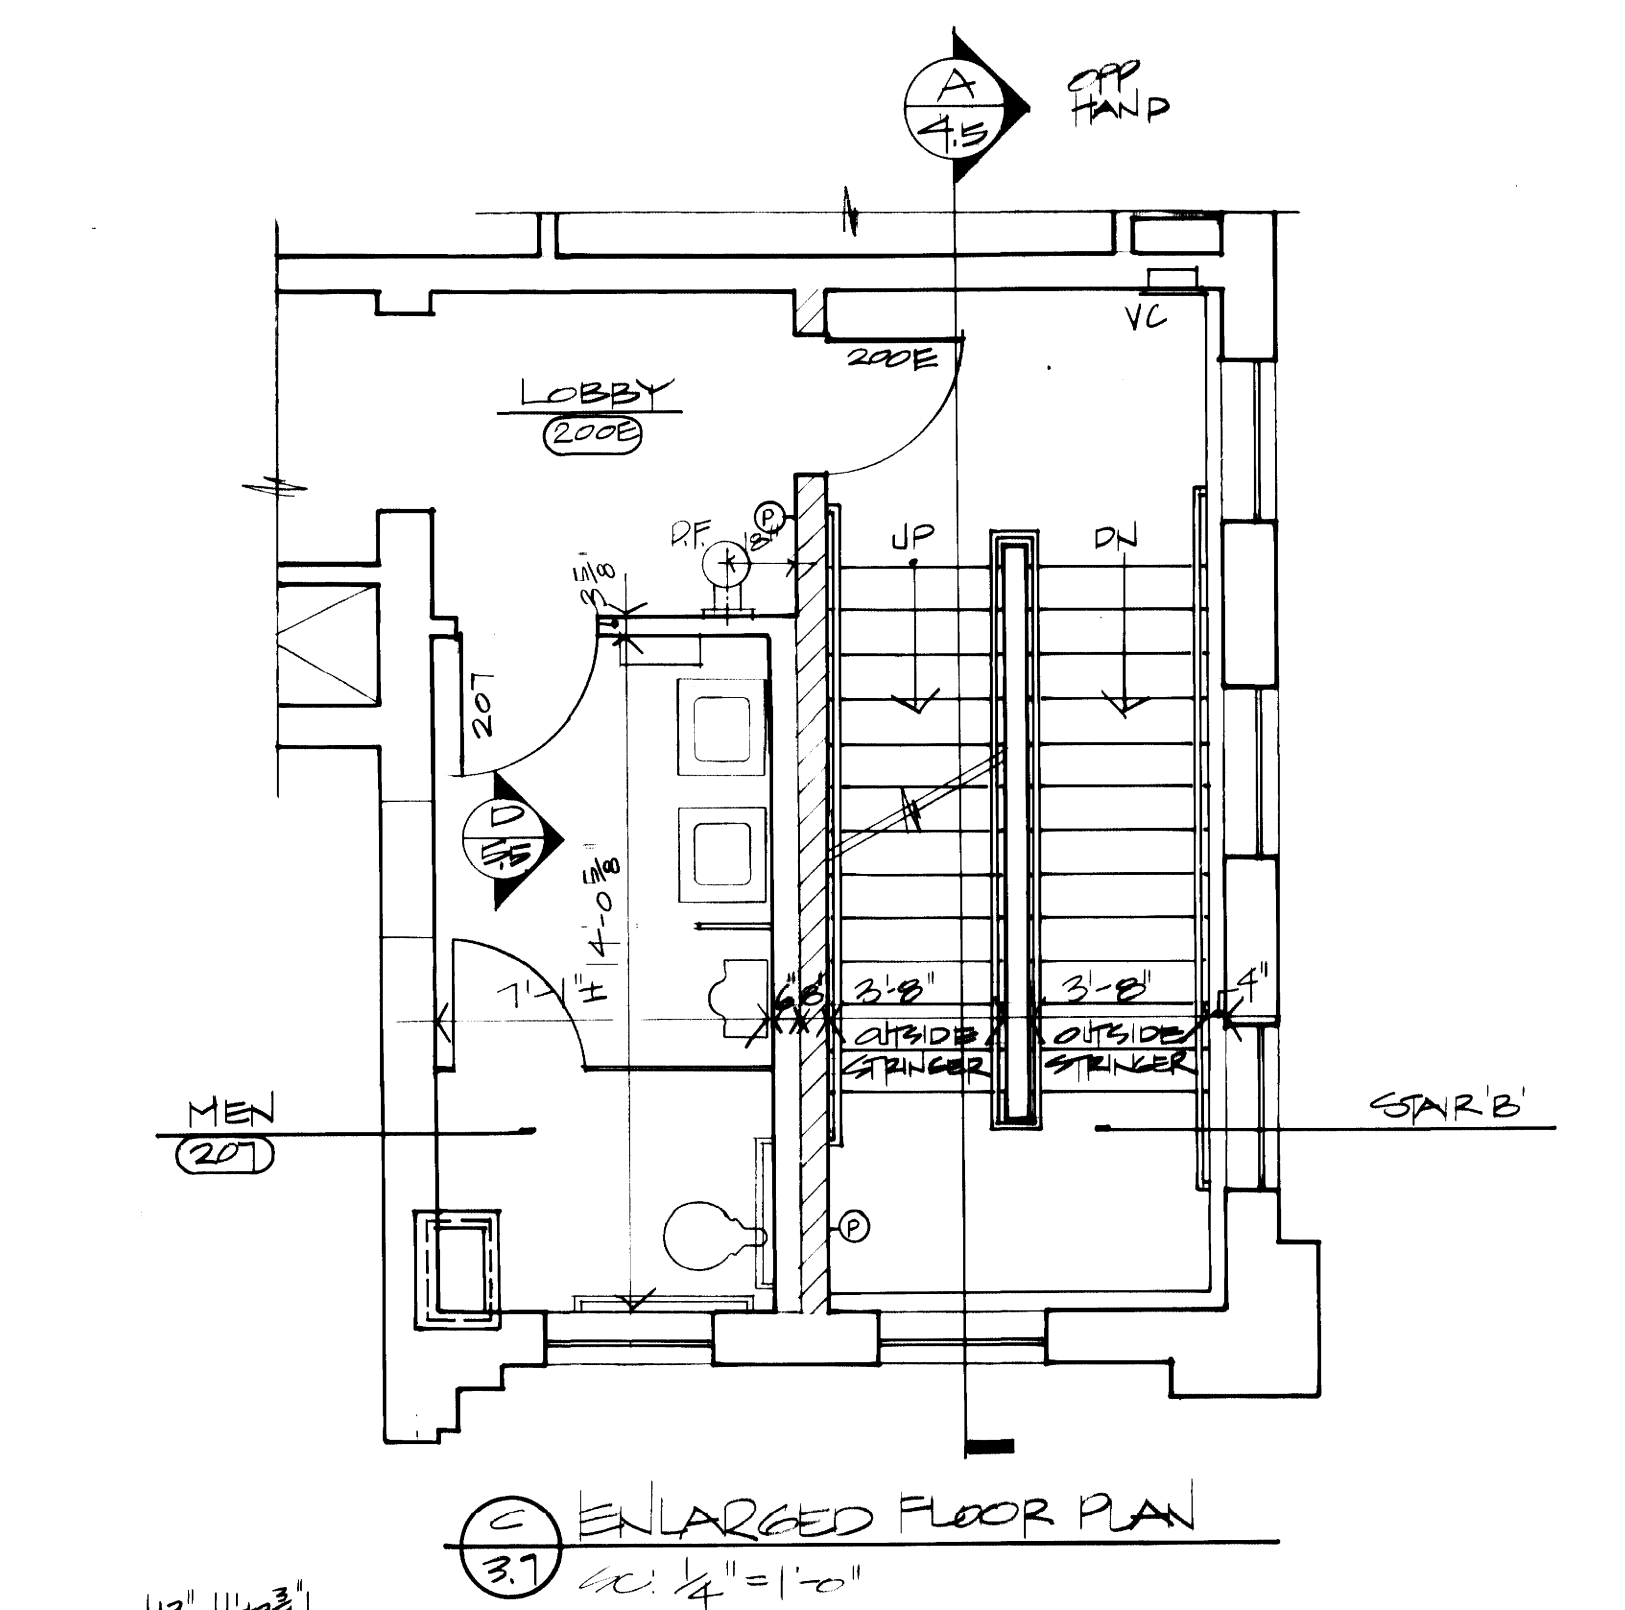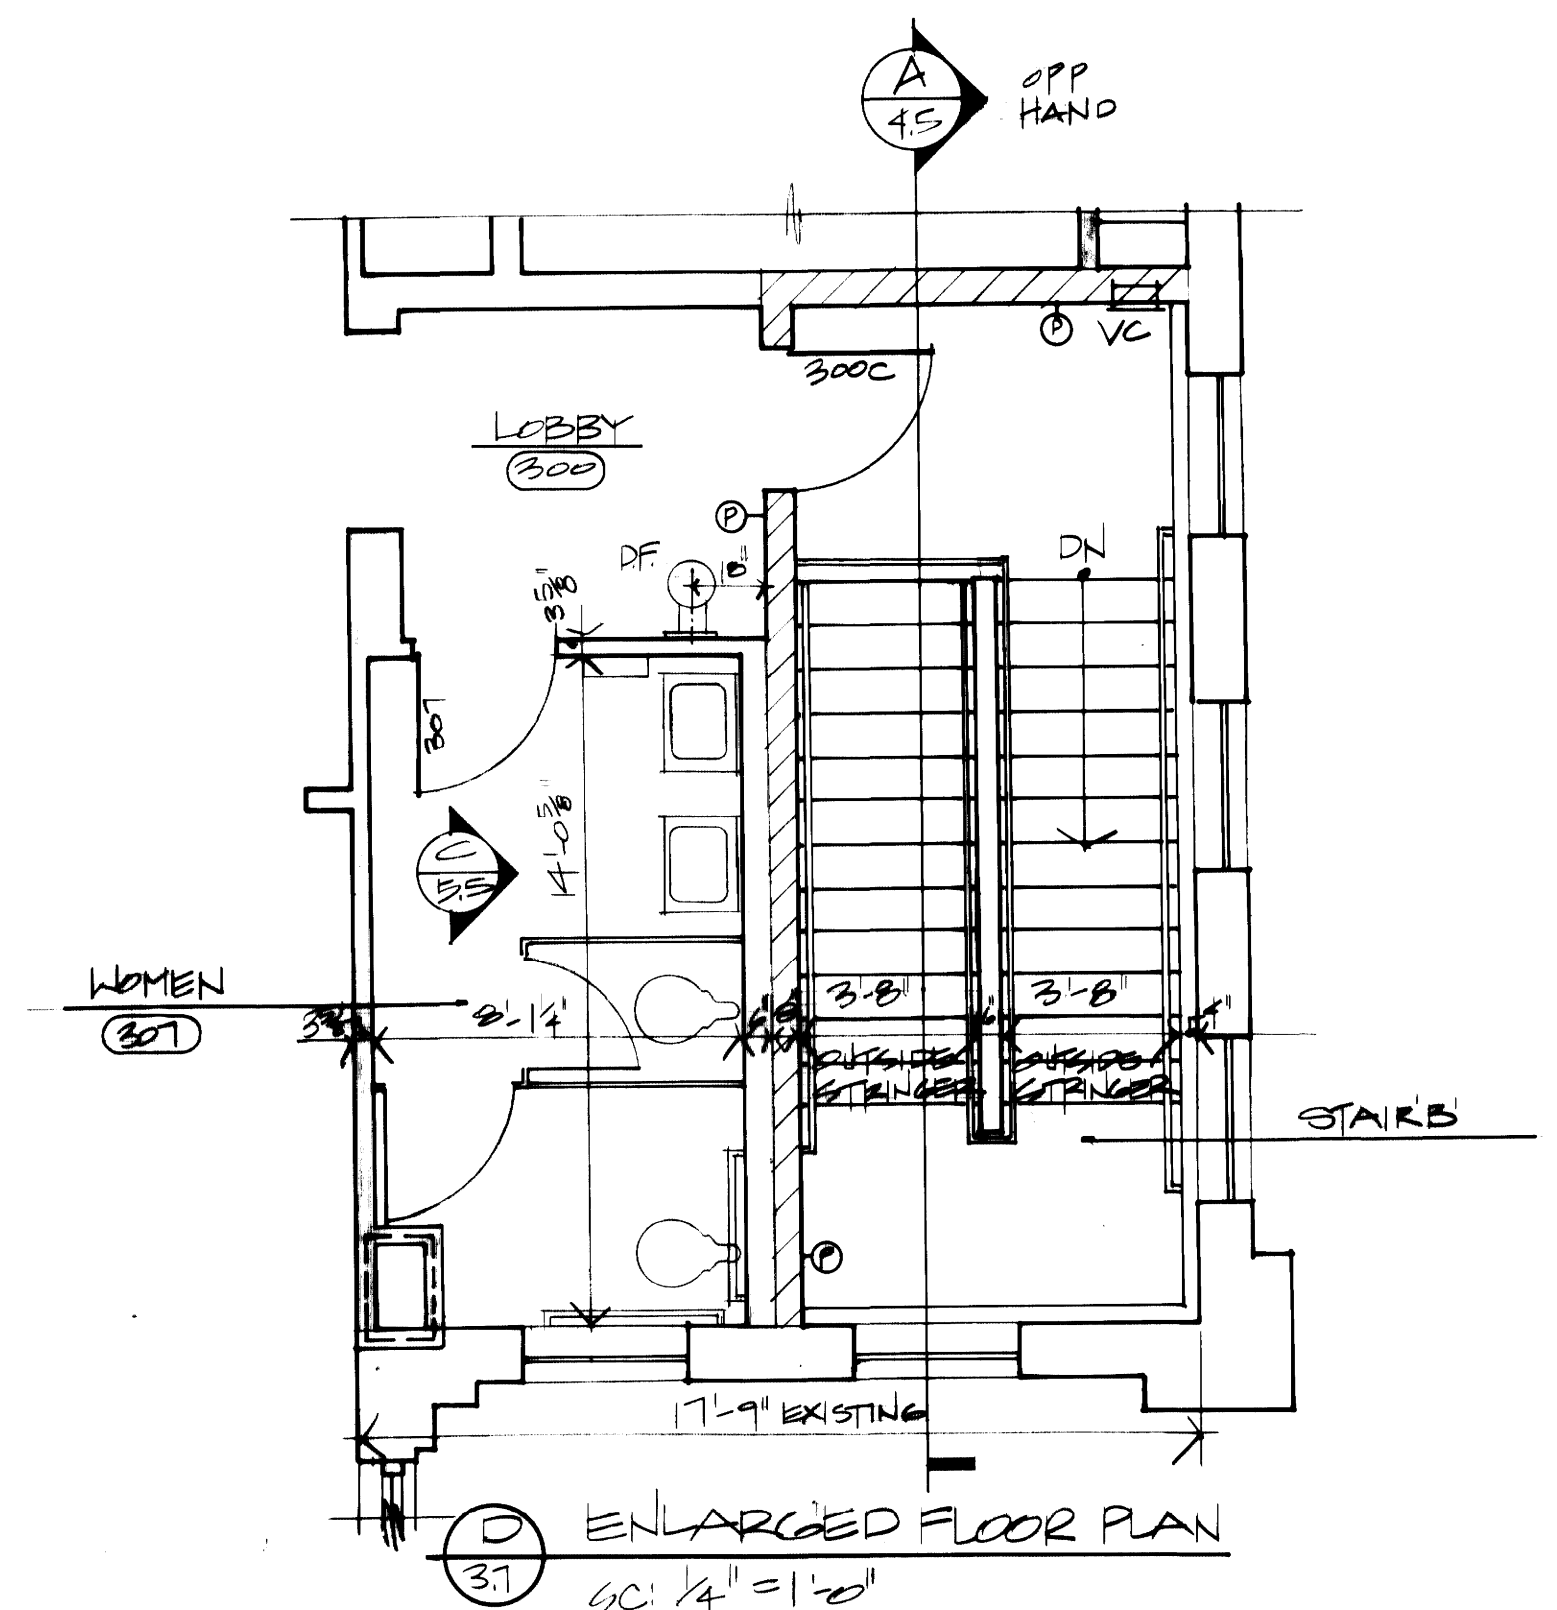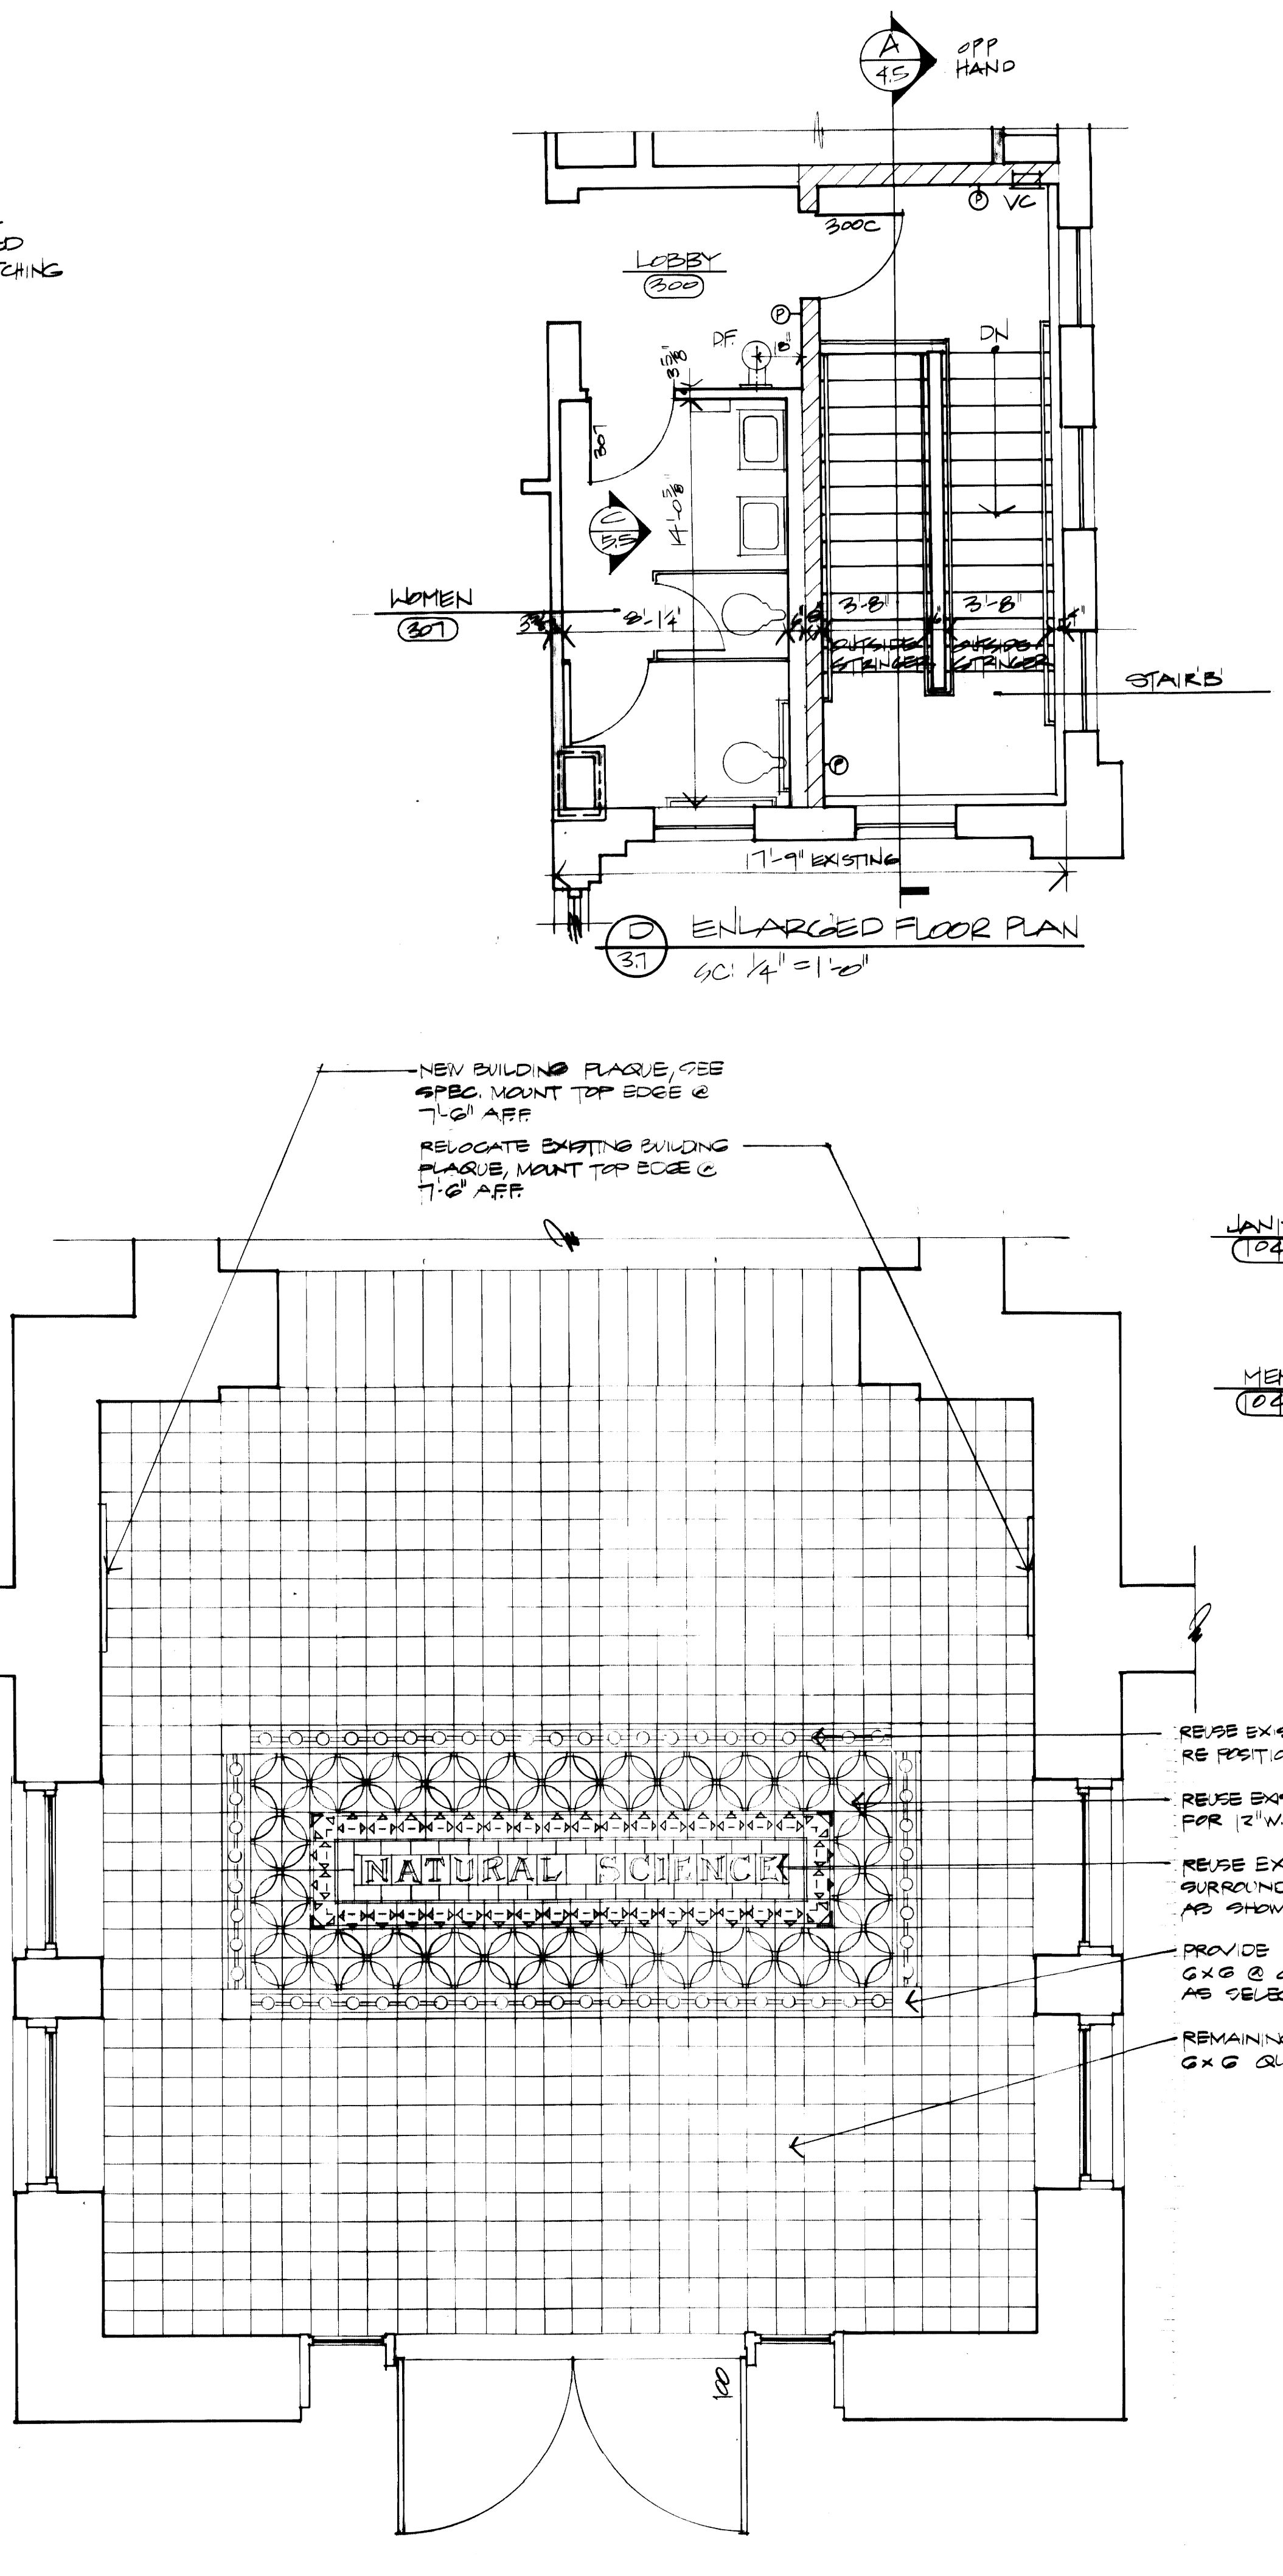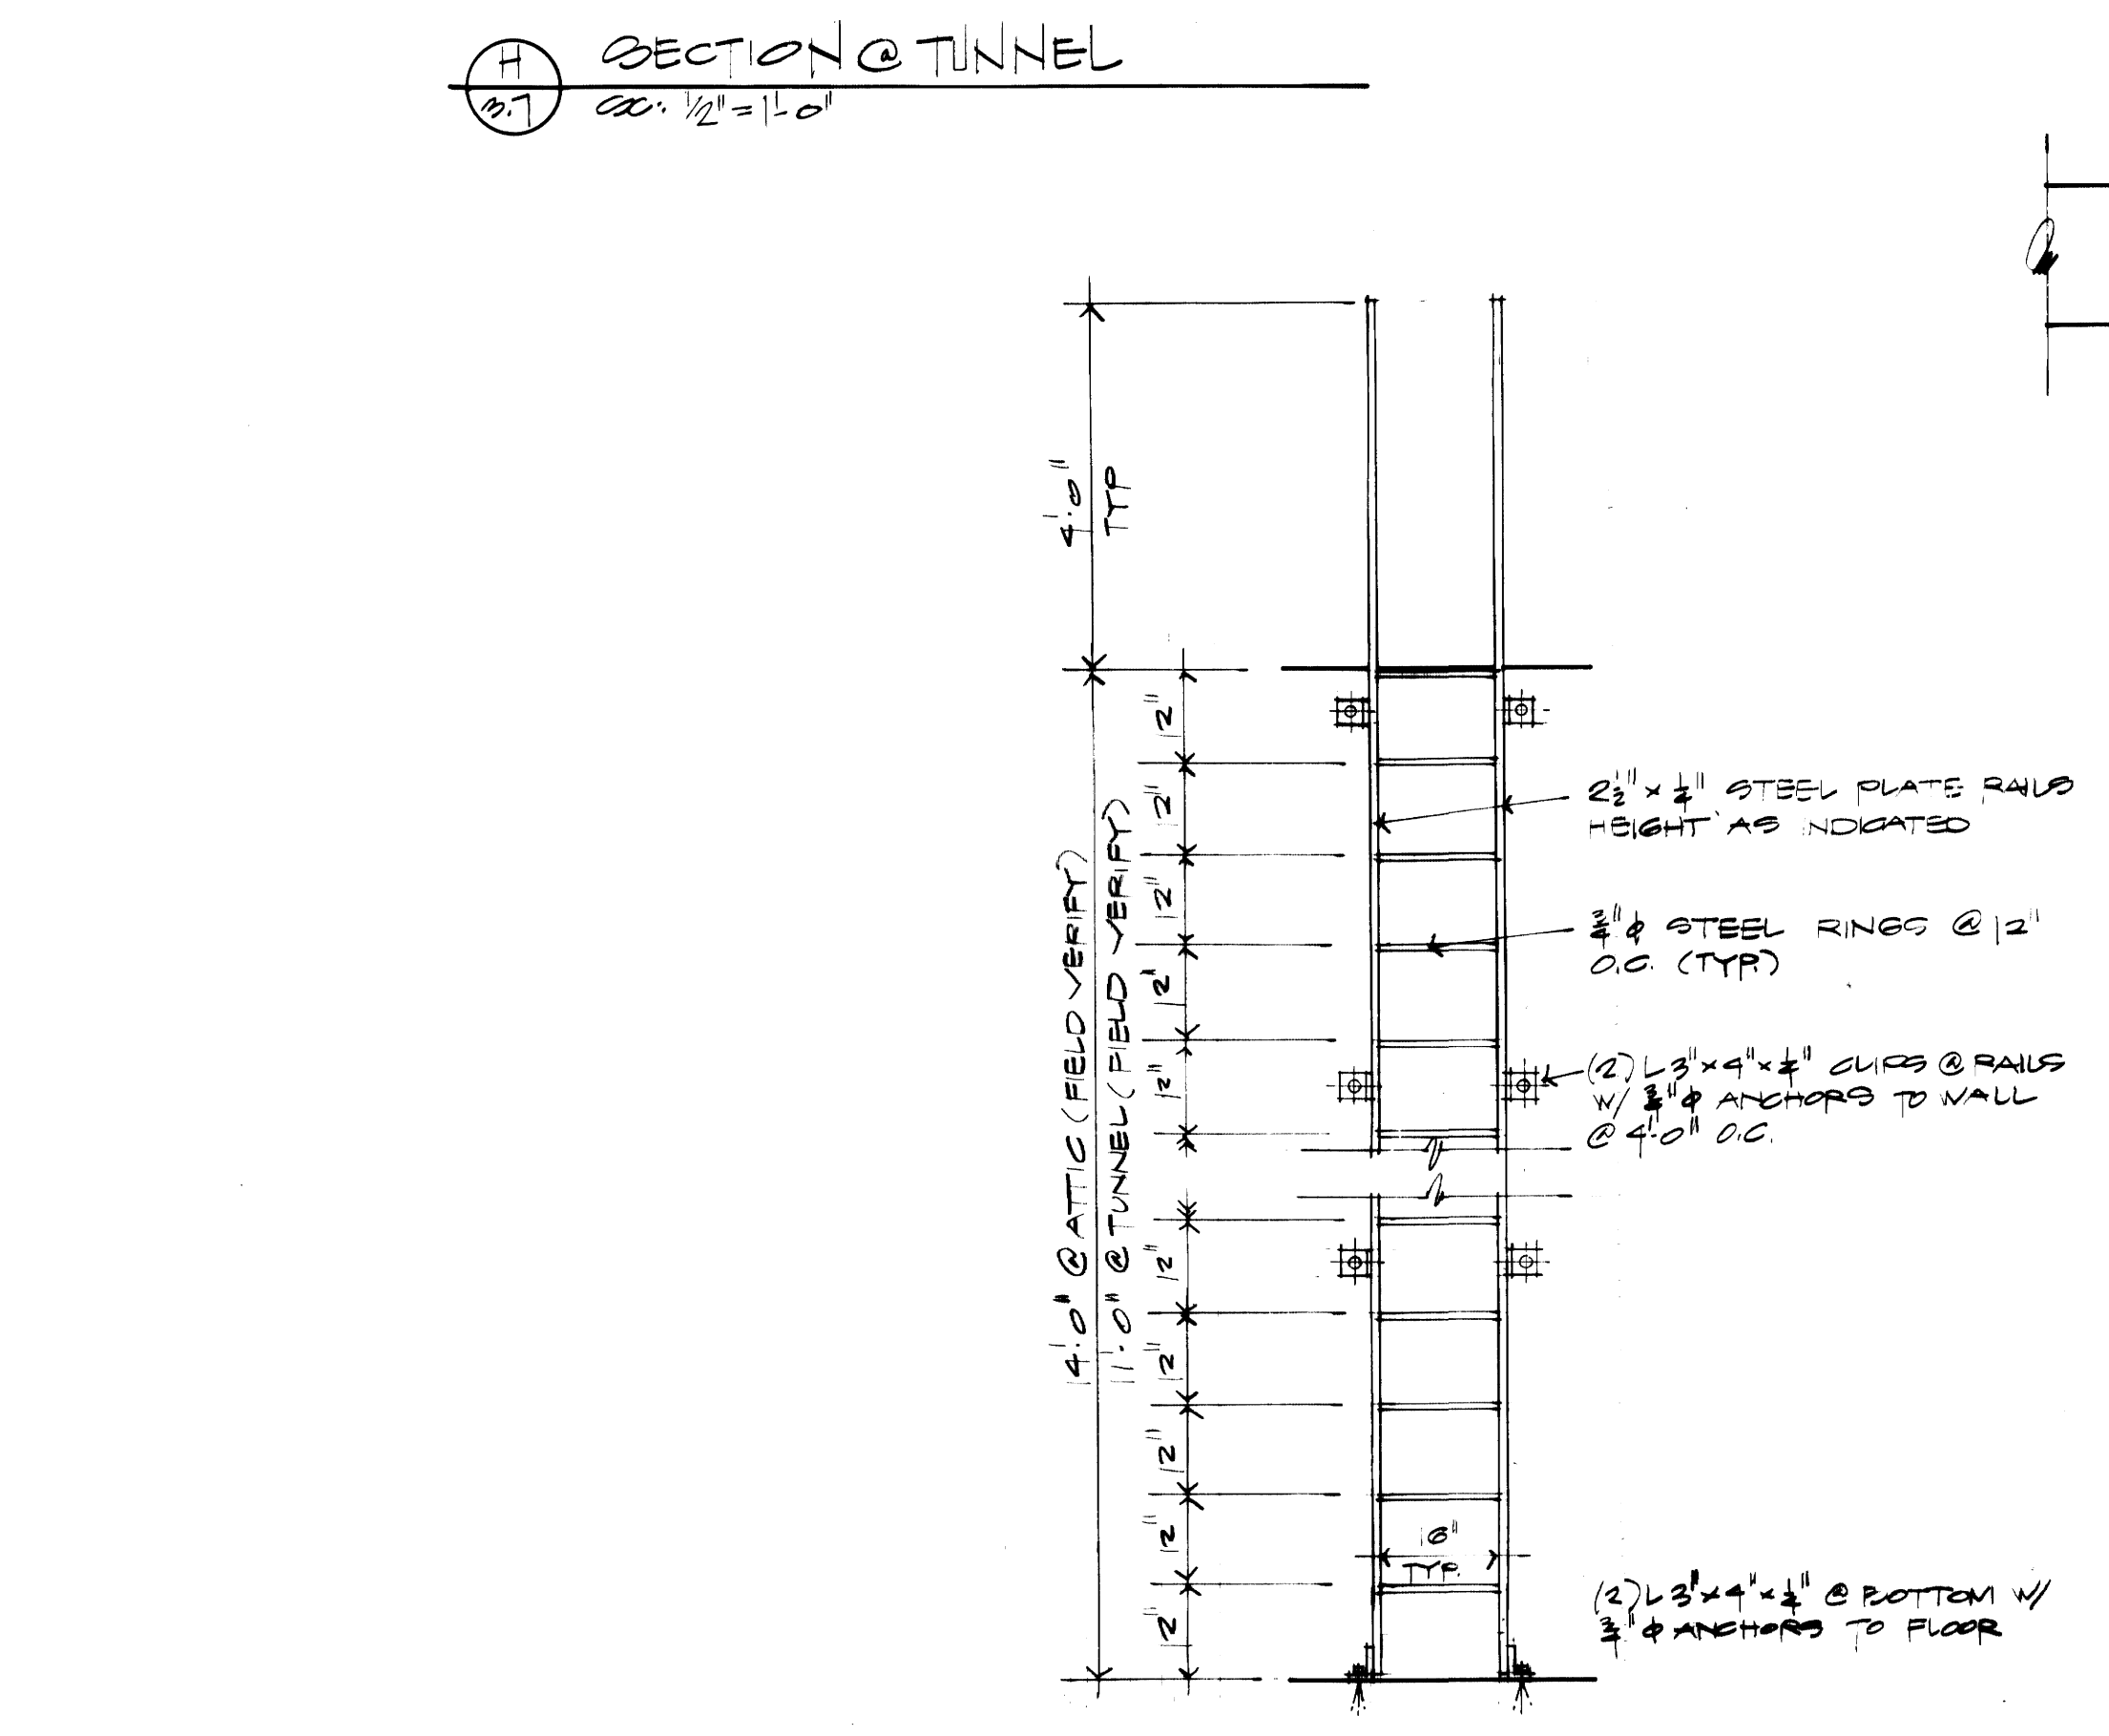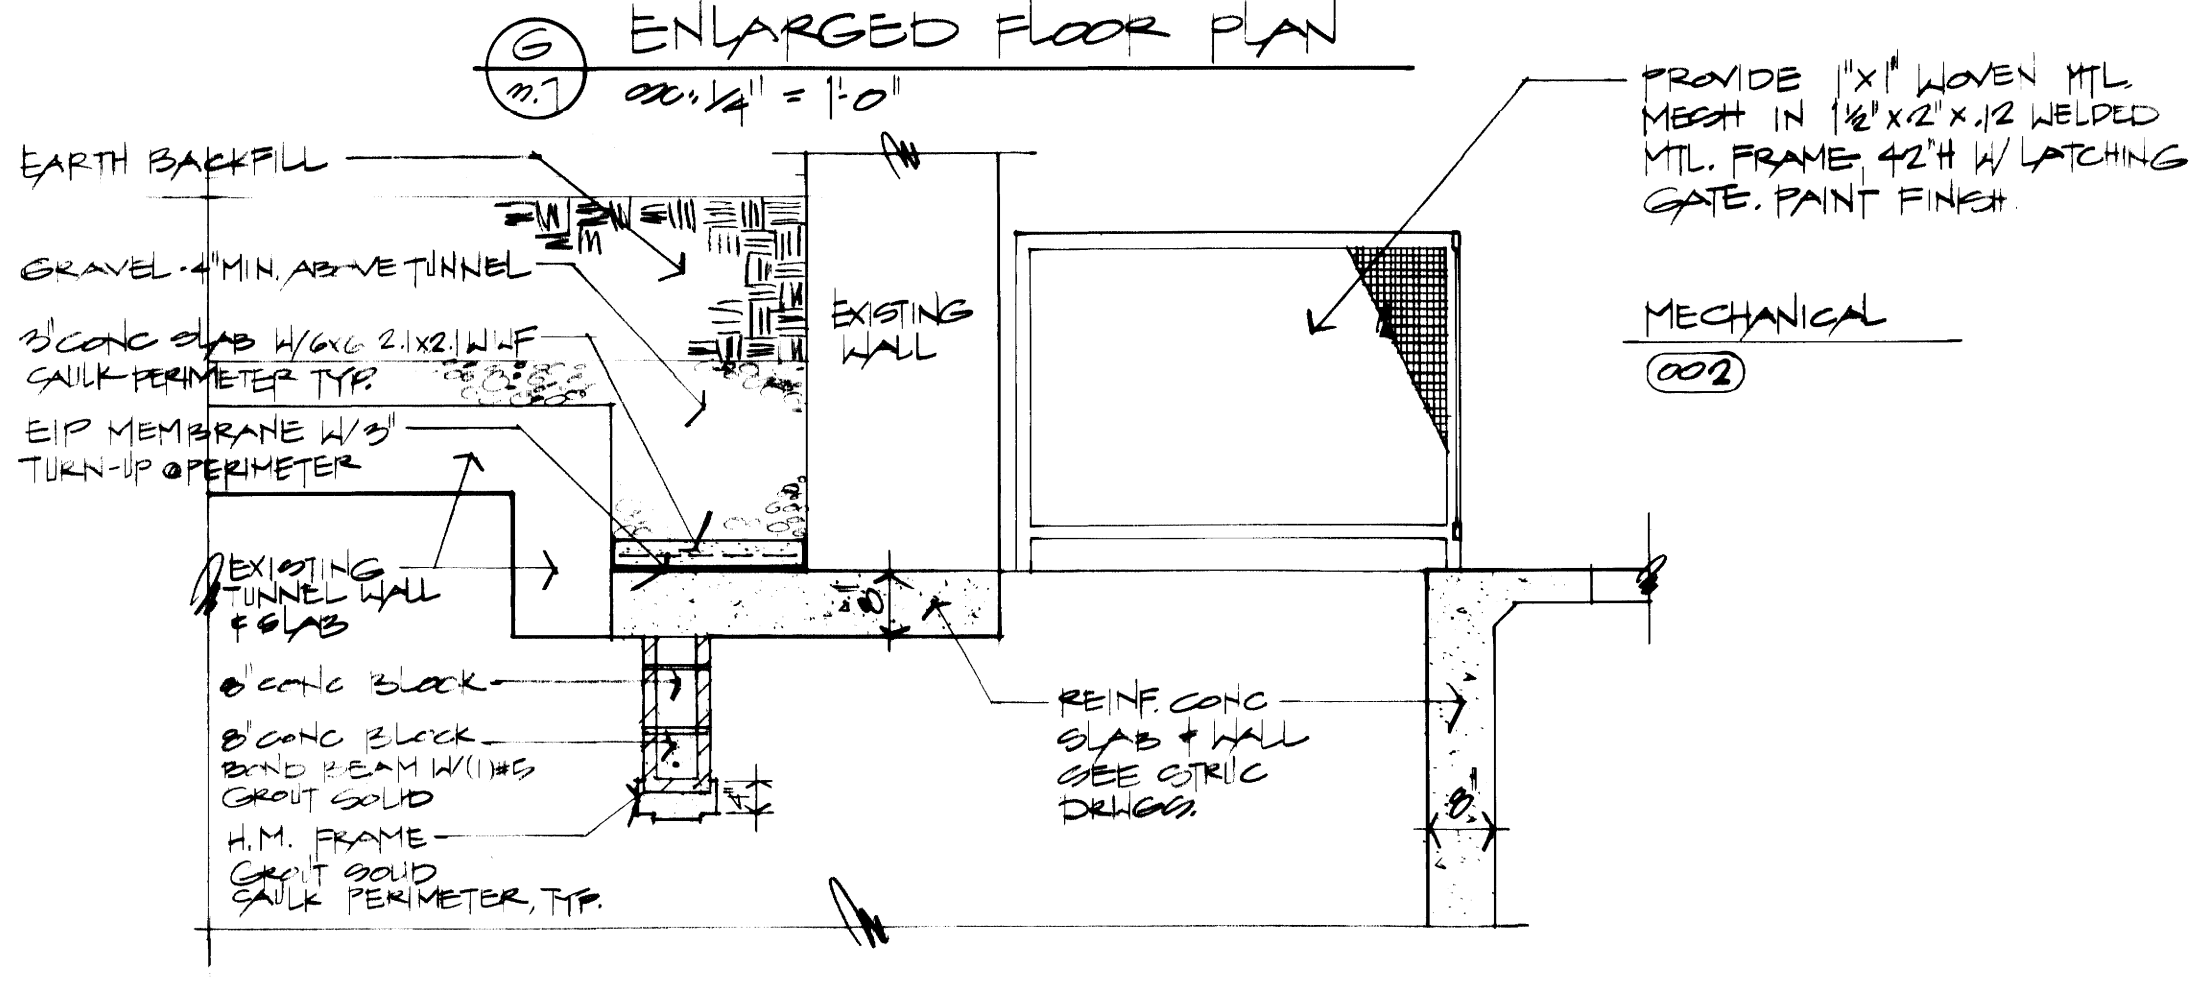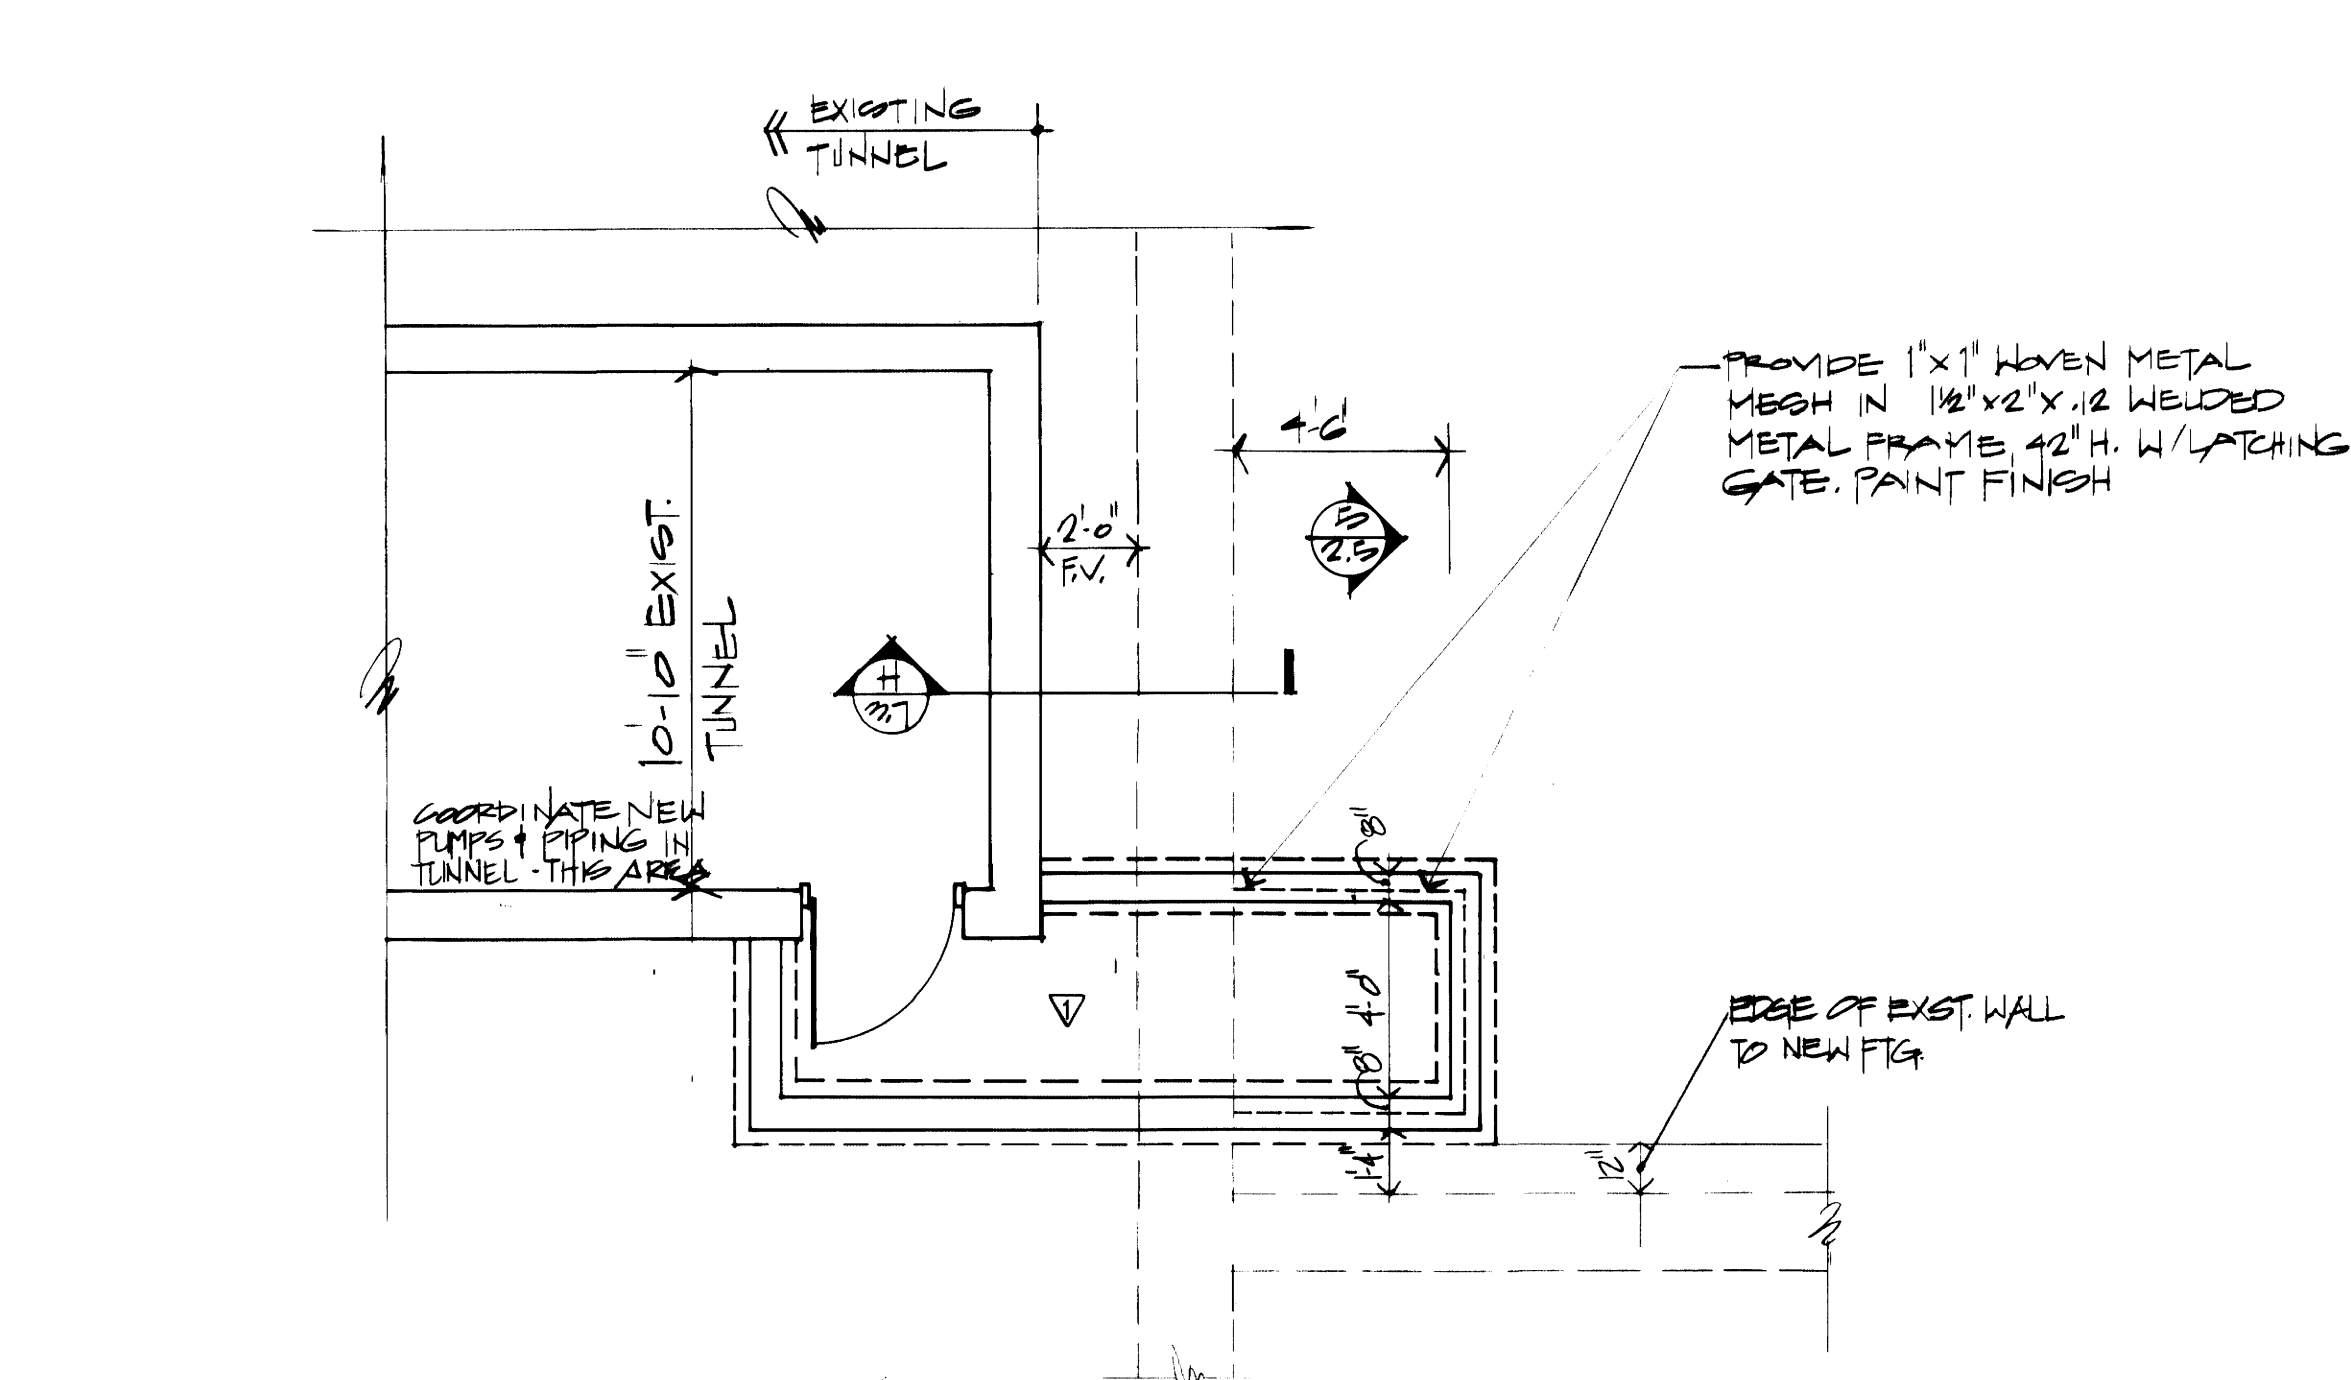



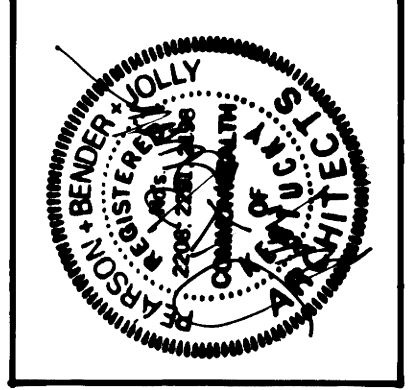

These second drawings have been prepared, in part, on the basis of information furnished by others. The architect will be responsible for any errors or omissions which have not been incorporated into this document as a result of a field check.


Pearson + Bender + Jolly  
DATE: 11/04/13

University of Kentucky  
Lexington, Kentucky

PEARSON + BENDER + JOLLY ARCHITECTS  
1000 UNIVERSITY AVENUE  
LEXINGTON, KY 40506  
TEL: 254-2331  
FAX: 254-2331

ROOF PLAN, DETAILS, ATTIC PLAN


**MILLER HALL RENOVATION**  
Lexington Campus Sector  
University of Kentucky

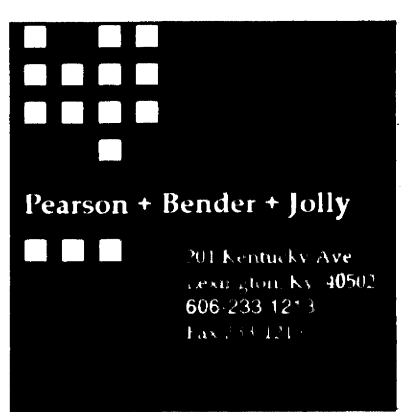


project no. 1425.0  
date 20 AUGUST 13

file no.  
dr. by CM  
ck. by LB


revisions

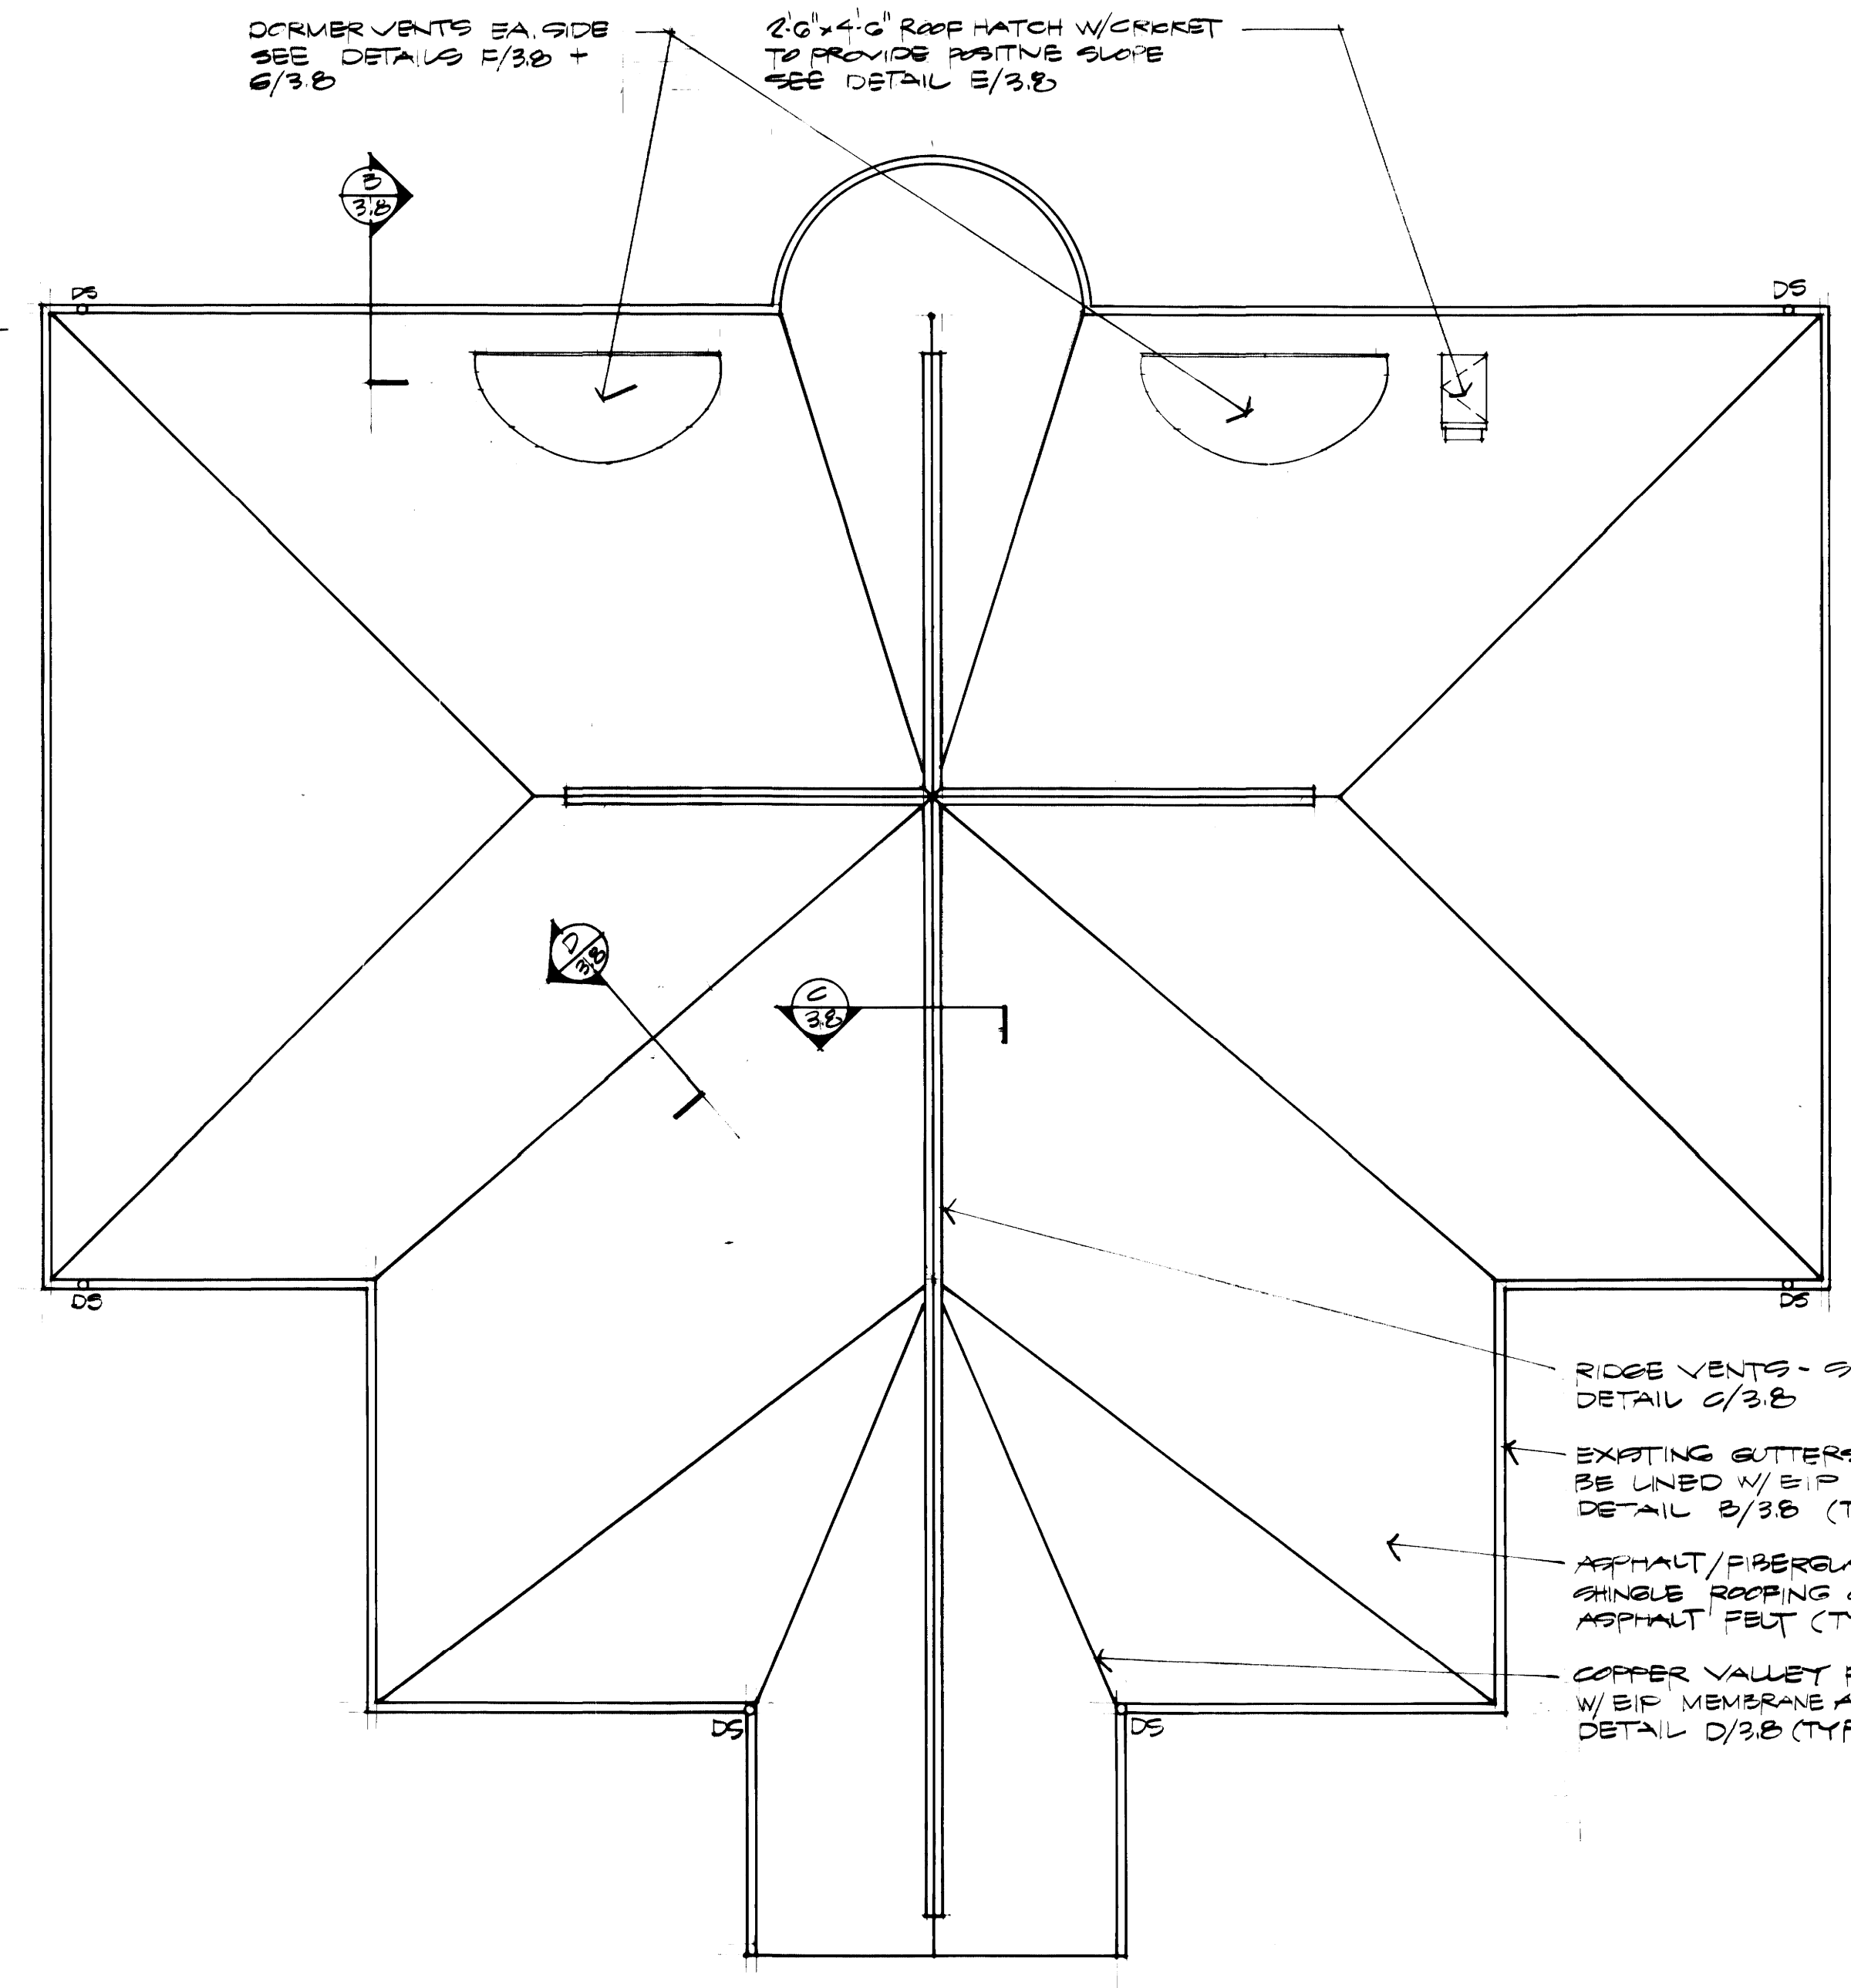


**A ROOF PLAN**  
3/8 00: 1/8" = 1'-0"

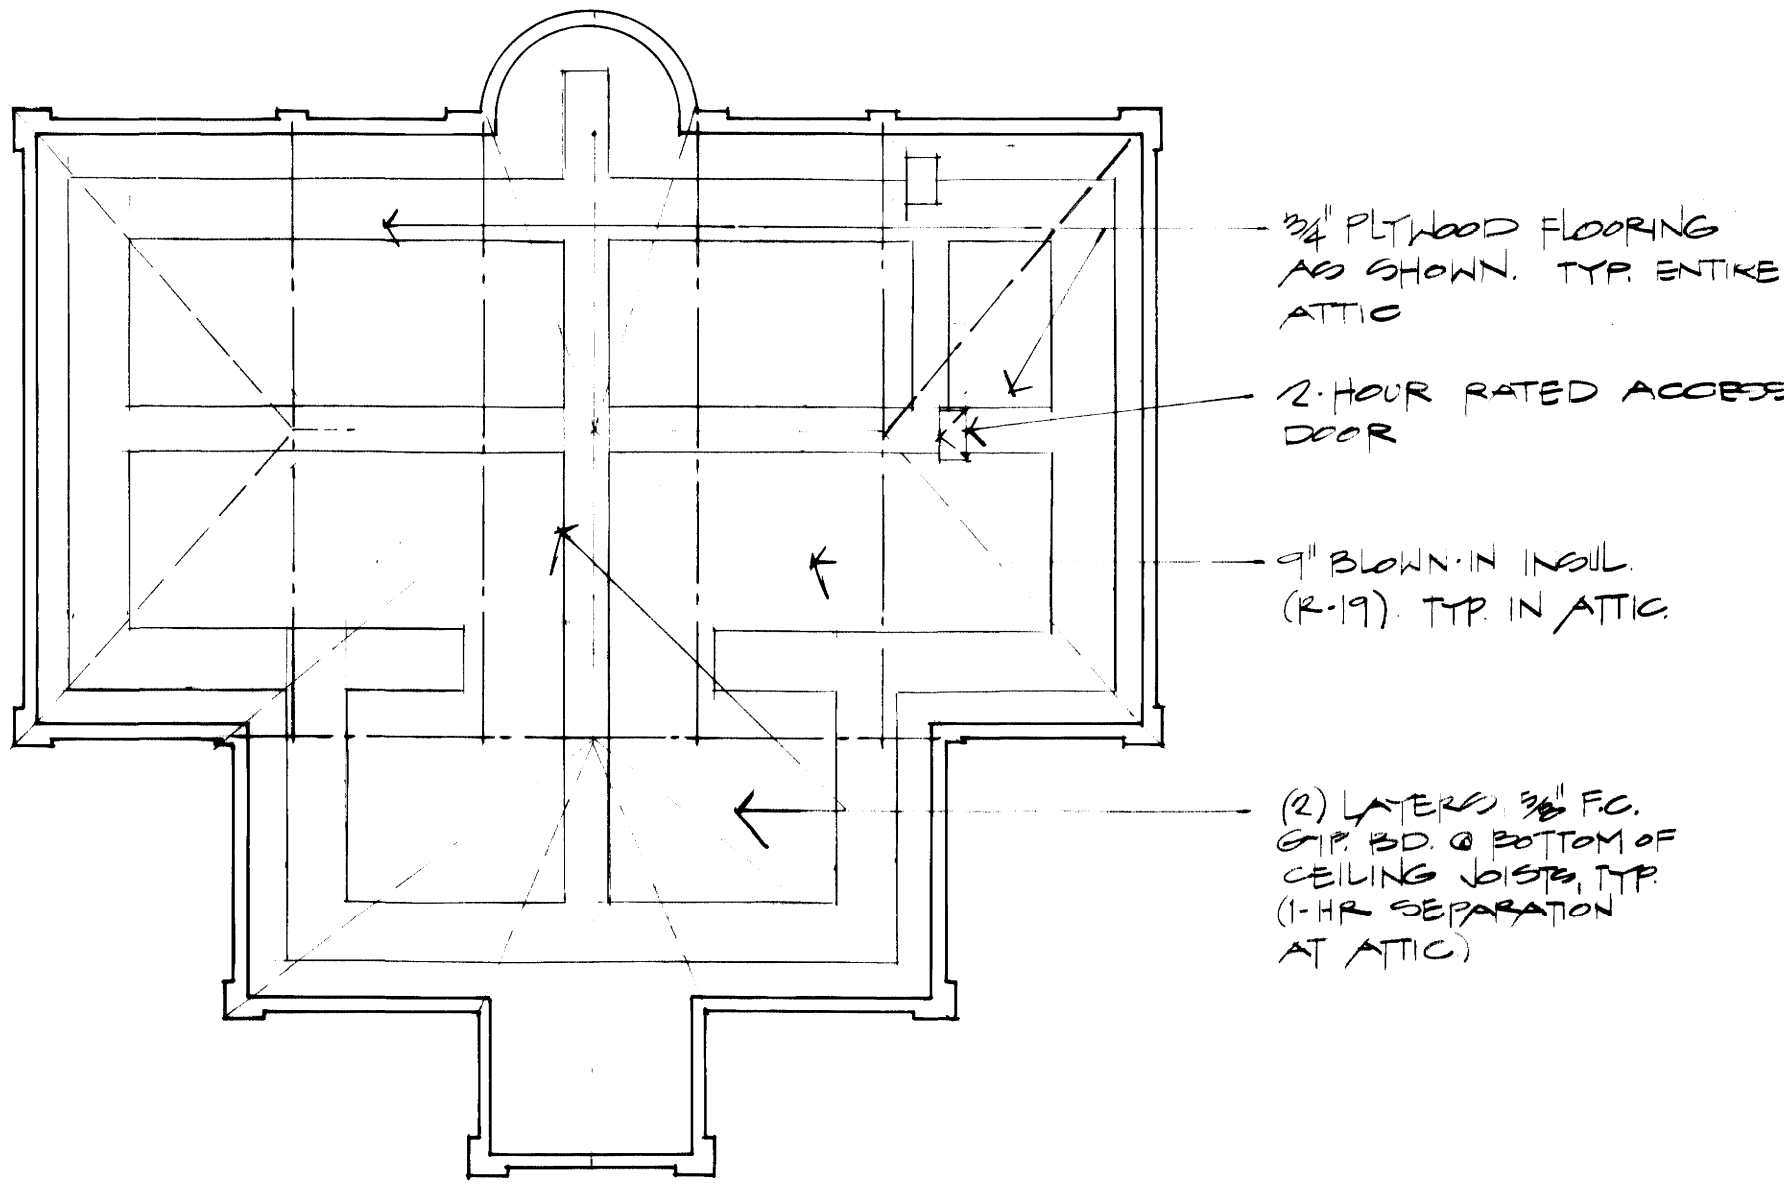


**H ATTIC PLAN**  
3/8 00: 1/8" = 1'-0"

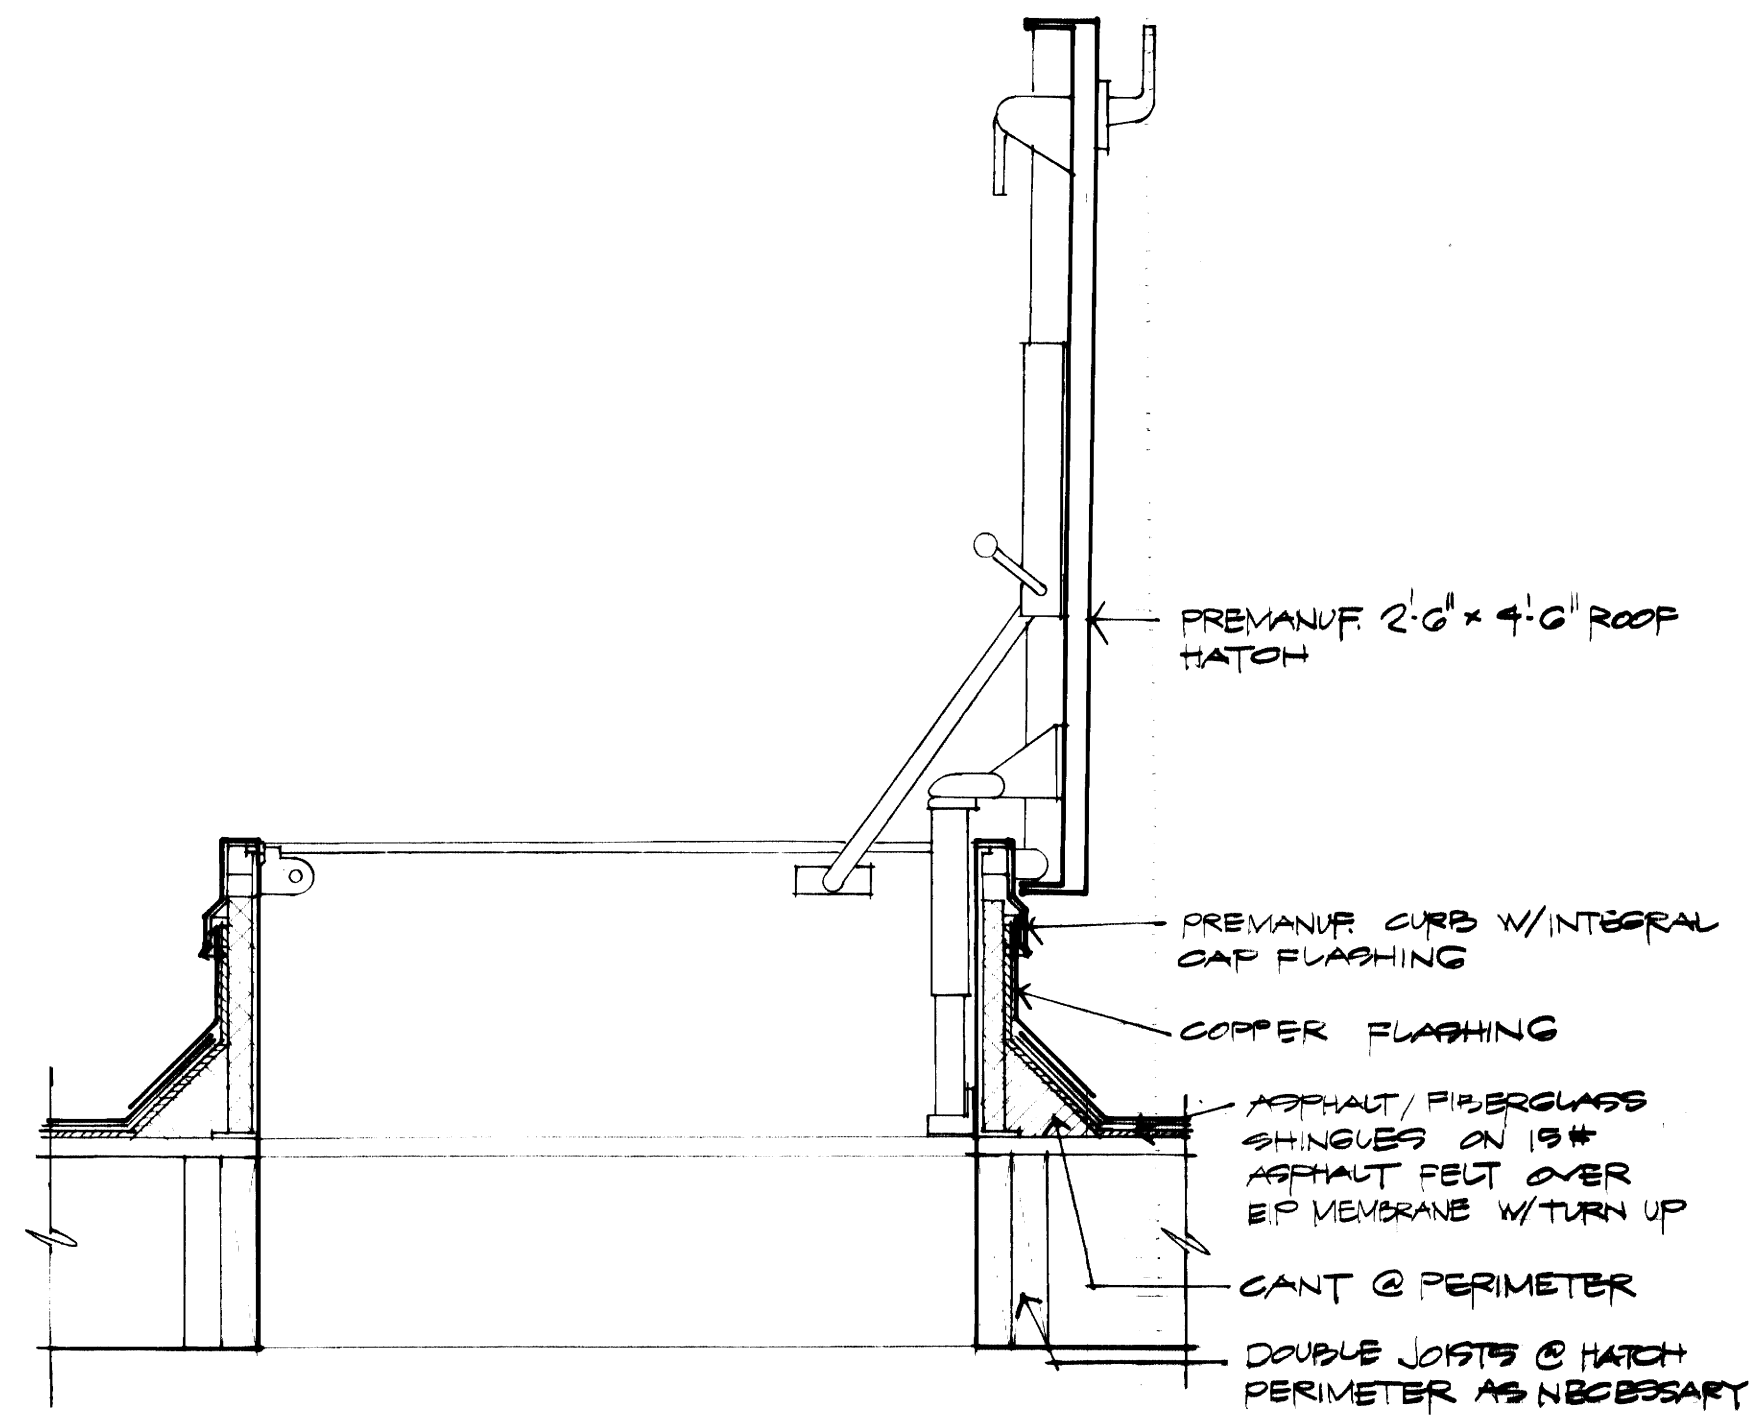


**E ROOF HATCH DETAIL**  
3/8 1/2" = 1'-0"

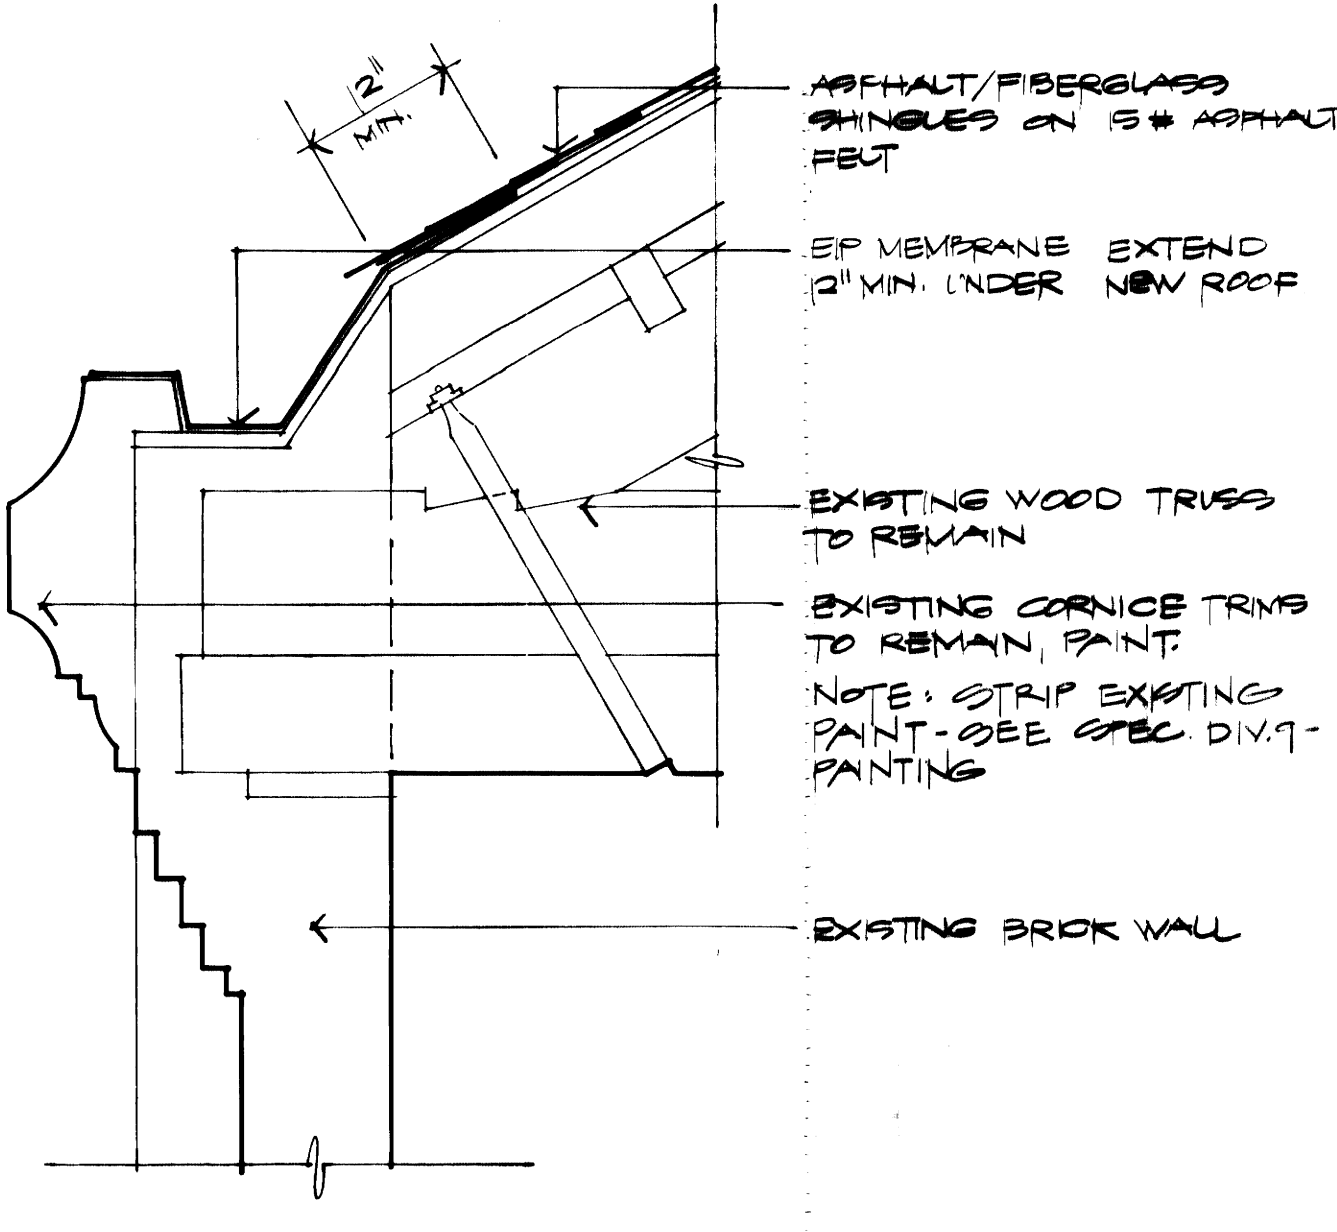


**D GUTTER DETAIL**  
3/8 1/2" = 1'-0"

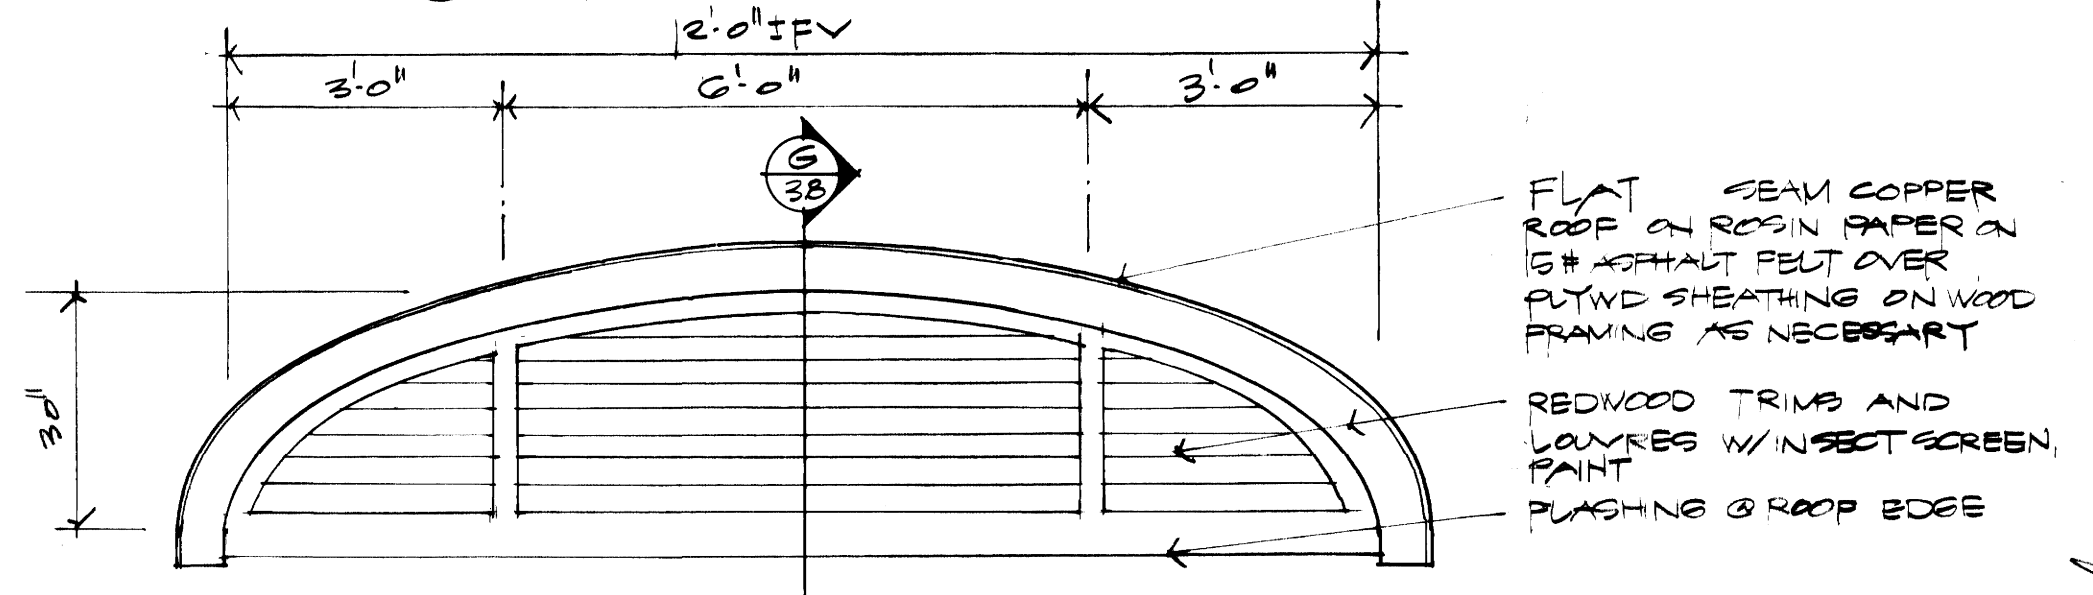


**F DORMER ELEVATION**  
3/8 1/2" = 1'-0"

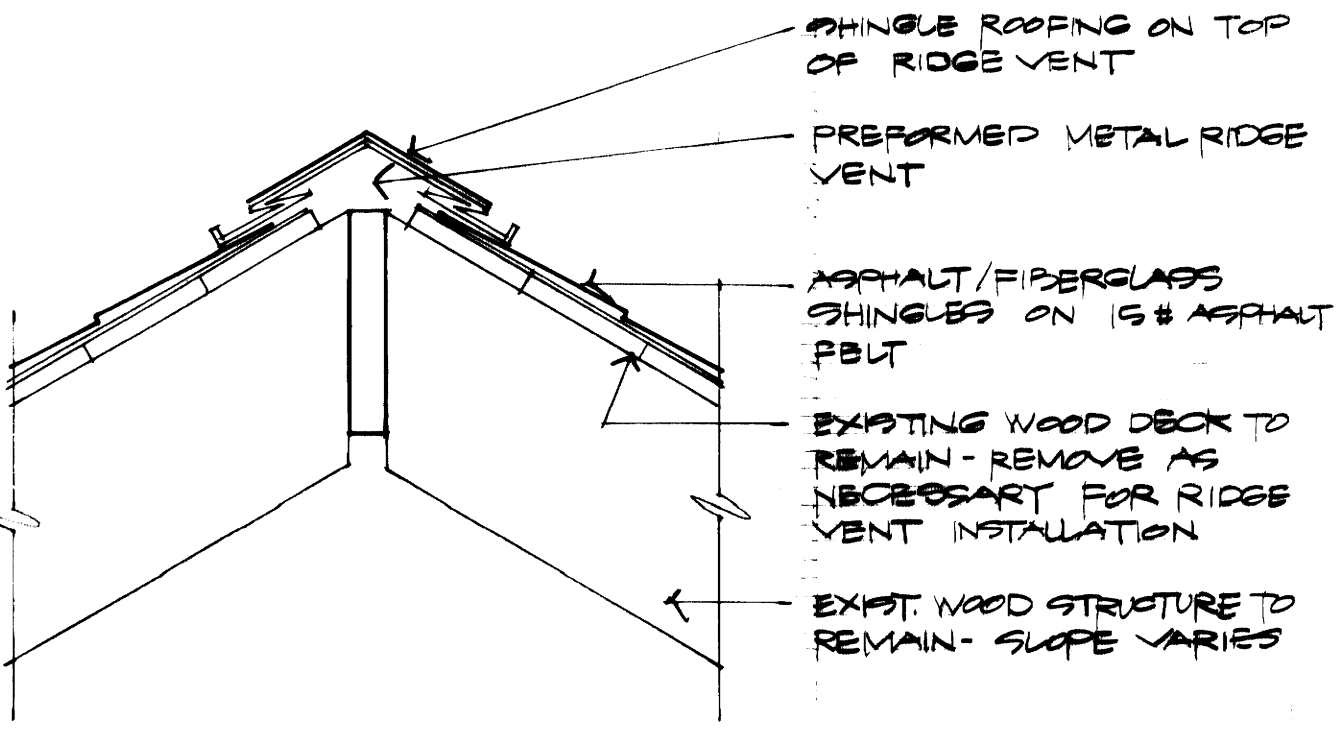


**C RIDGE VENT**  
3/8 1/2" = 1'-0"

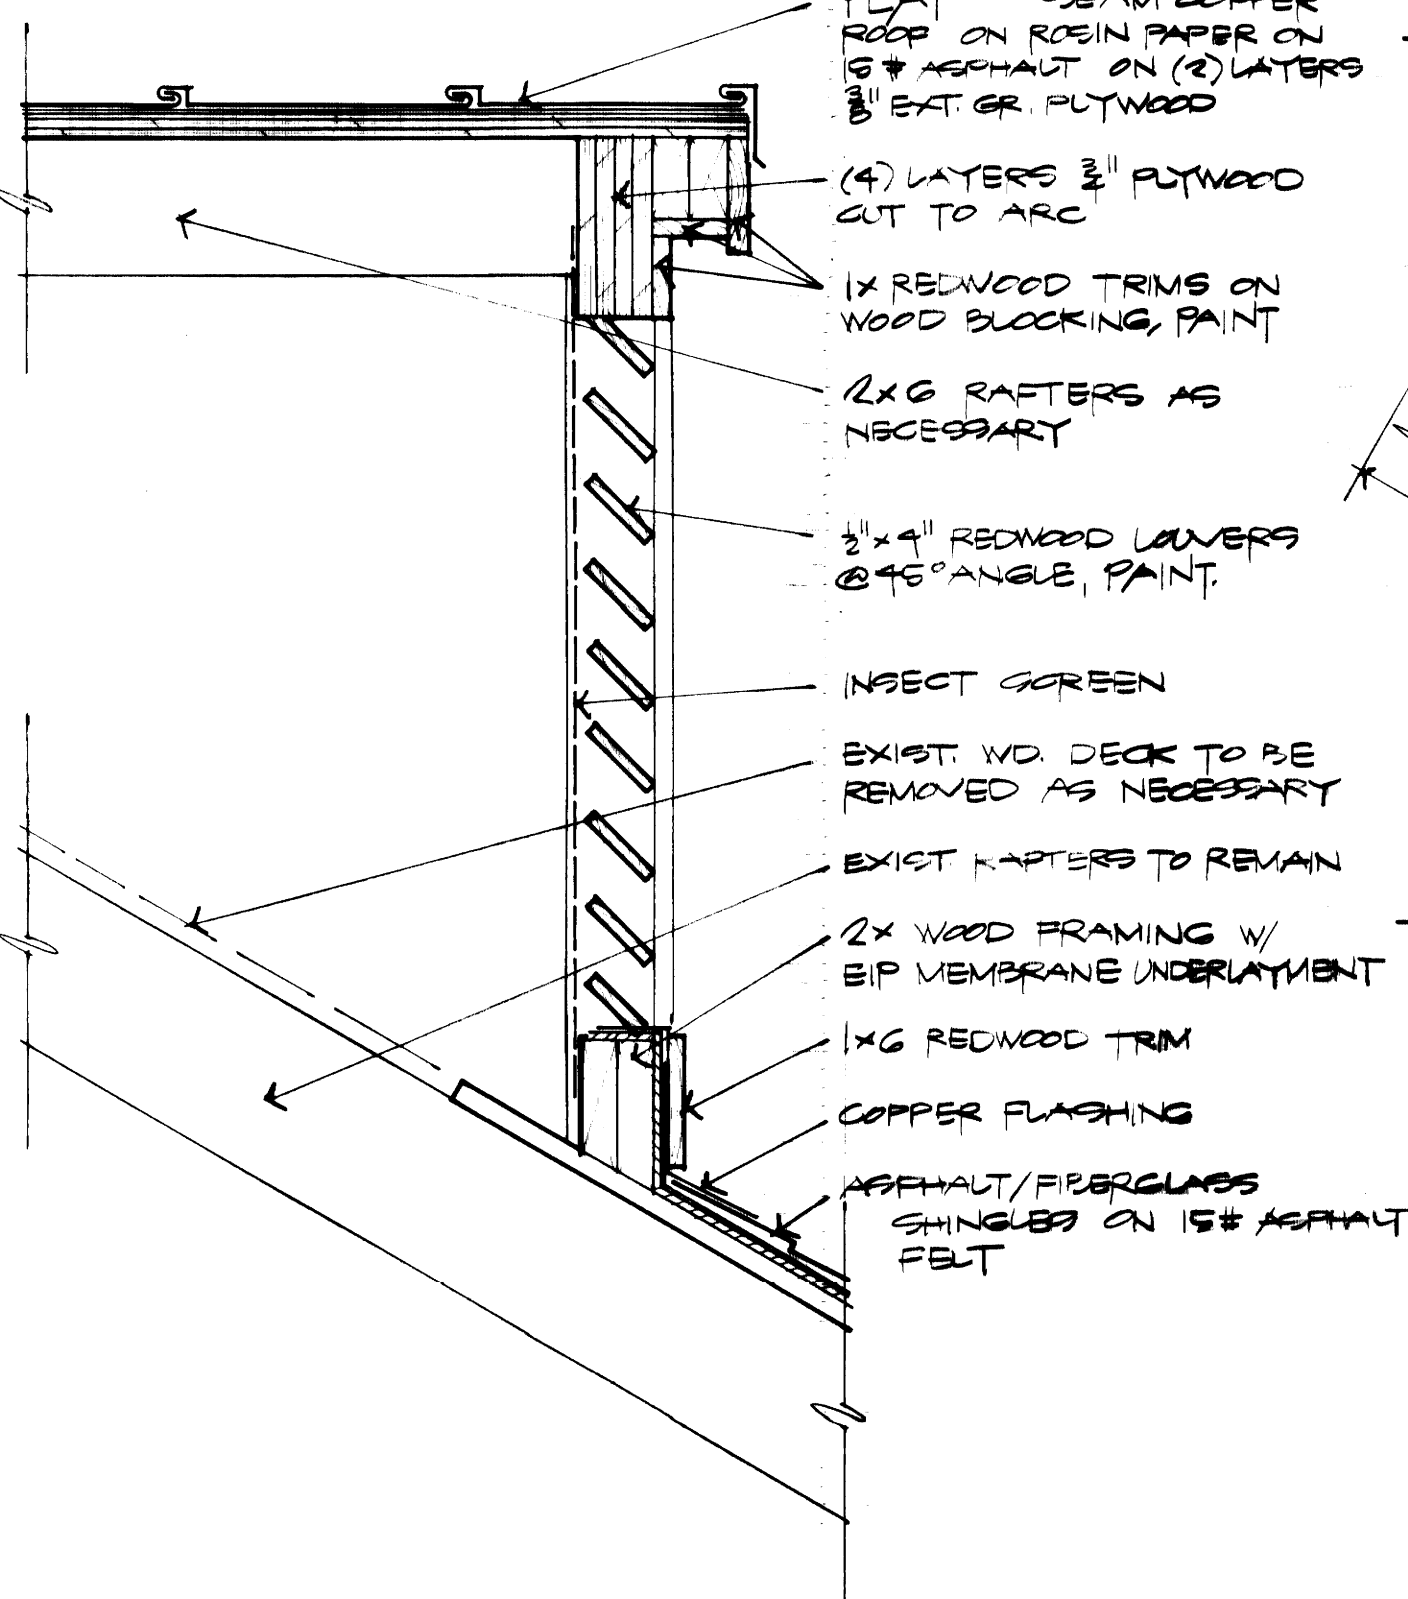

**G DORMER SECTION**  
3/8 1/2" = 1'-0"

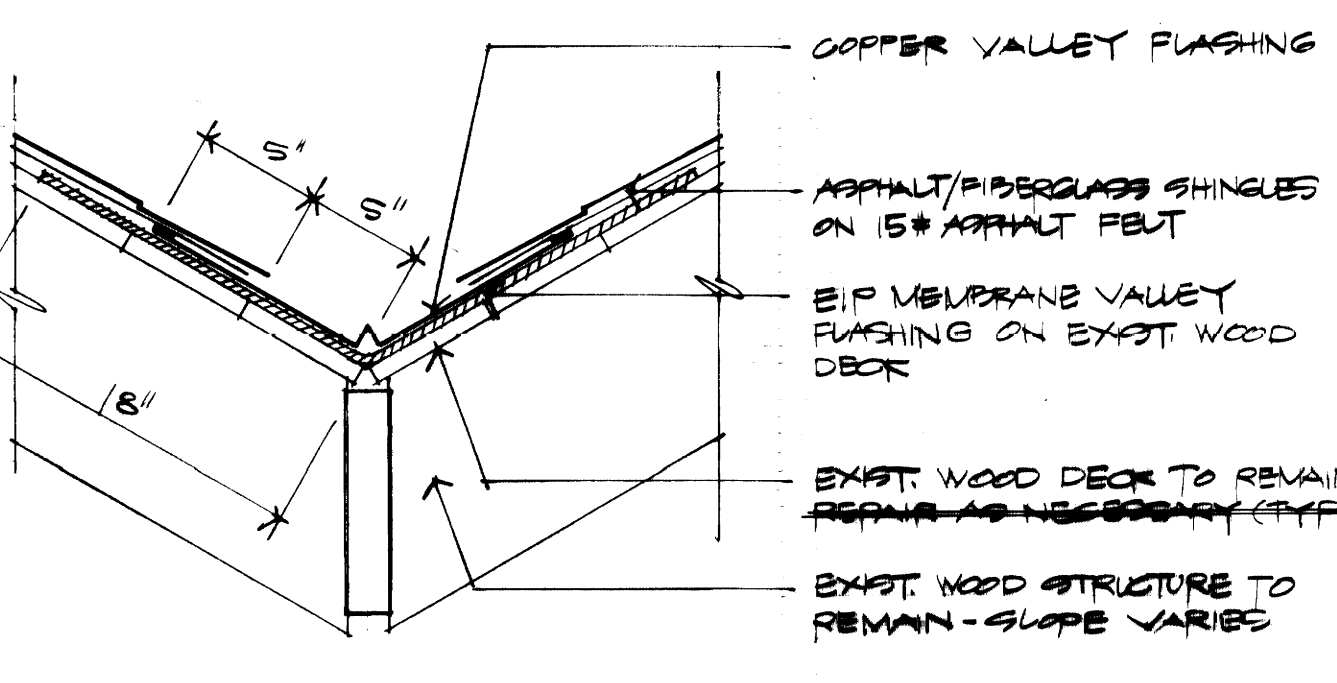

**D VALLEY DETAIL**  
3/8 1/2" = 1'-0"

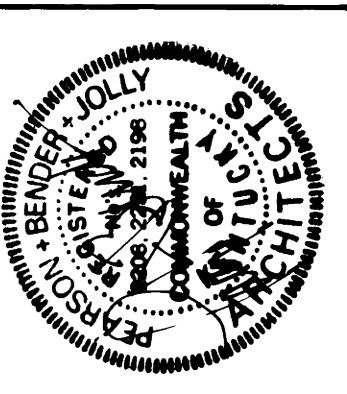

This contract documents have been prepared in part, on the basis of information furnished by others. The Architect will not be responsible for the accuracy of information which has been incorporated into this document as a result.

Pearson + Bender + Jolly  
DATE: 12/01/14

University of Kentucky  
Lexington, Kentucky

supported by  
OFFICE OF FACILITIES MANAGEMENT  
UNIVERSITY OF KENTUCKY

BUILDING ELEVATIONS


**MILLER HALL RENOVATION**  
Lexington Campus Sector  
University of Kentucky



project no. 1609.0  
date 20 AUG 13  
file no.  
dr. by CM  
ck. by MO

revisions

4.1

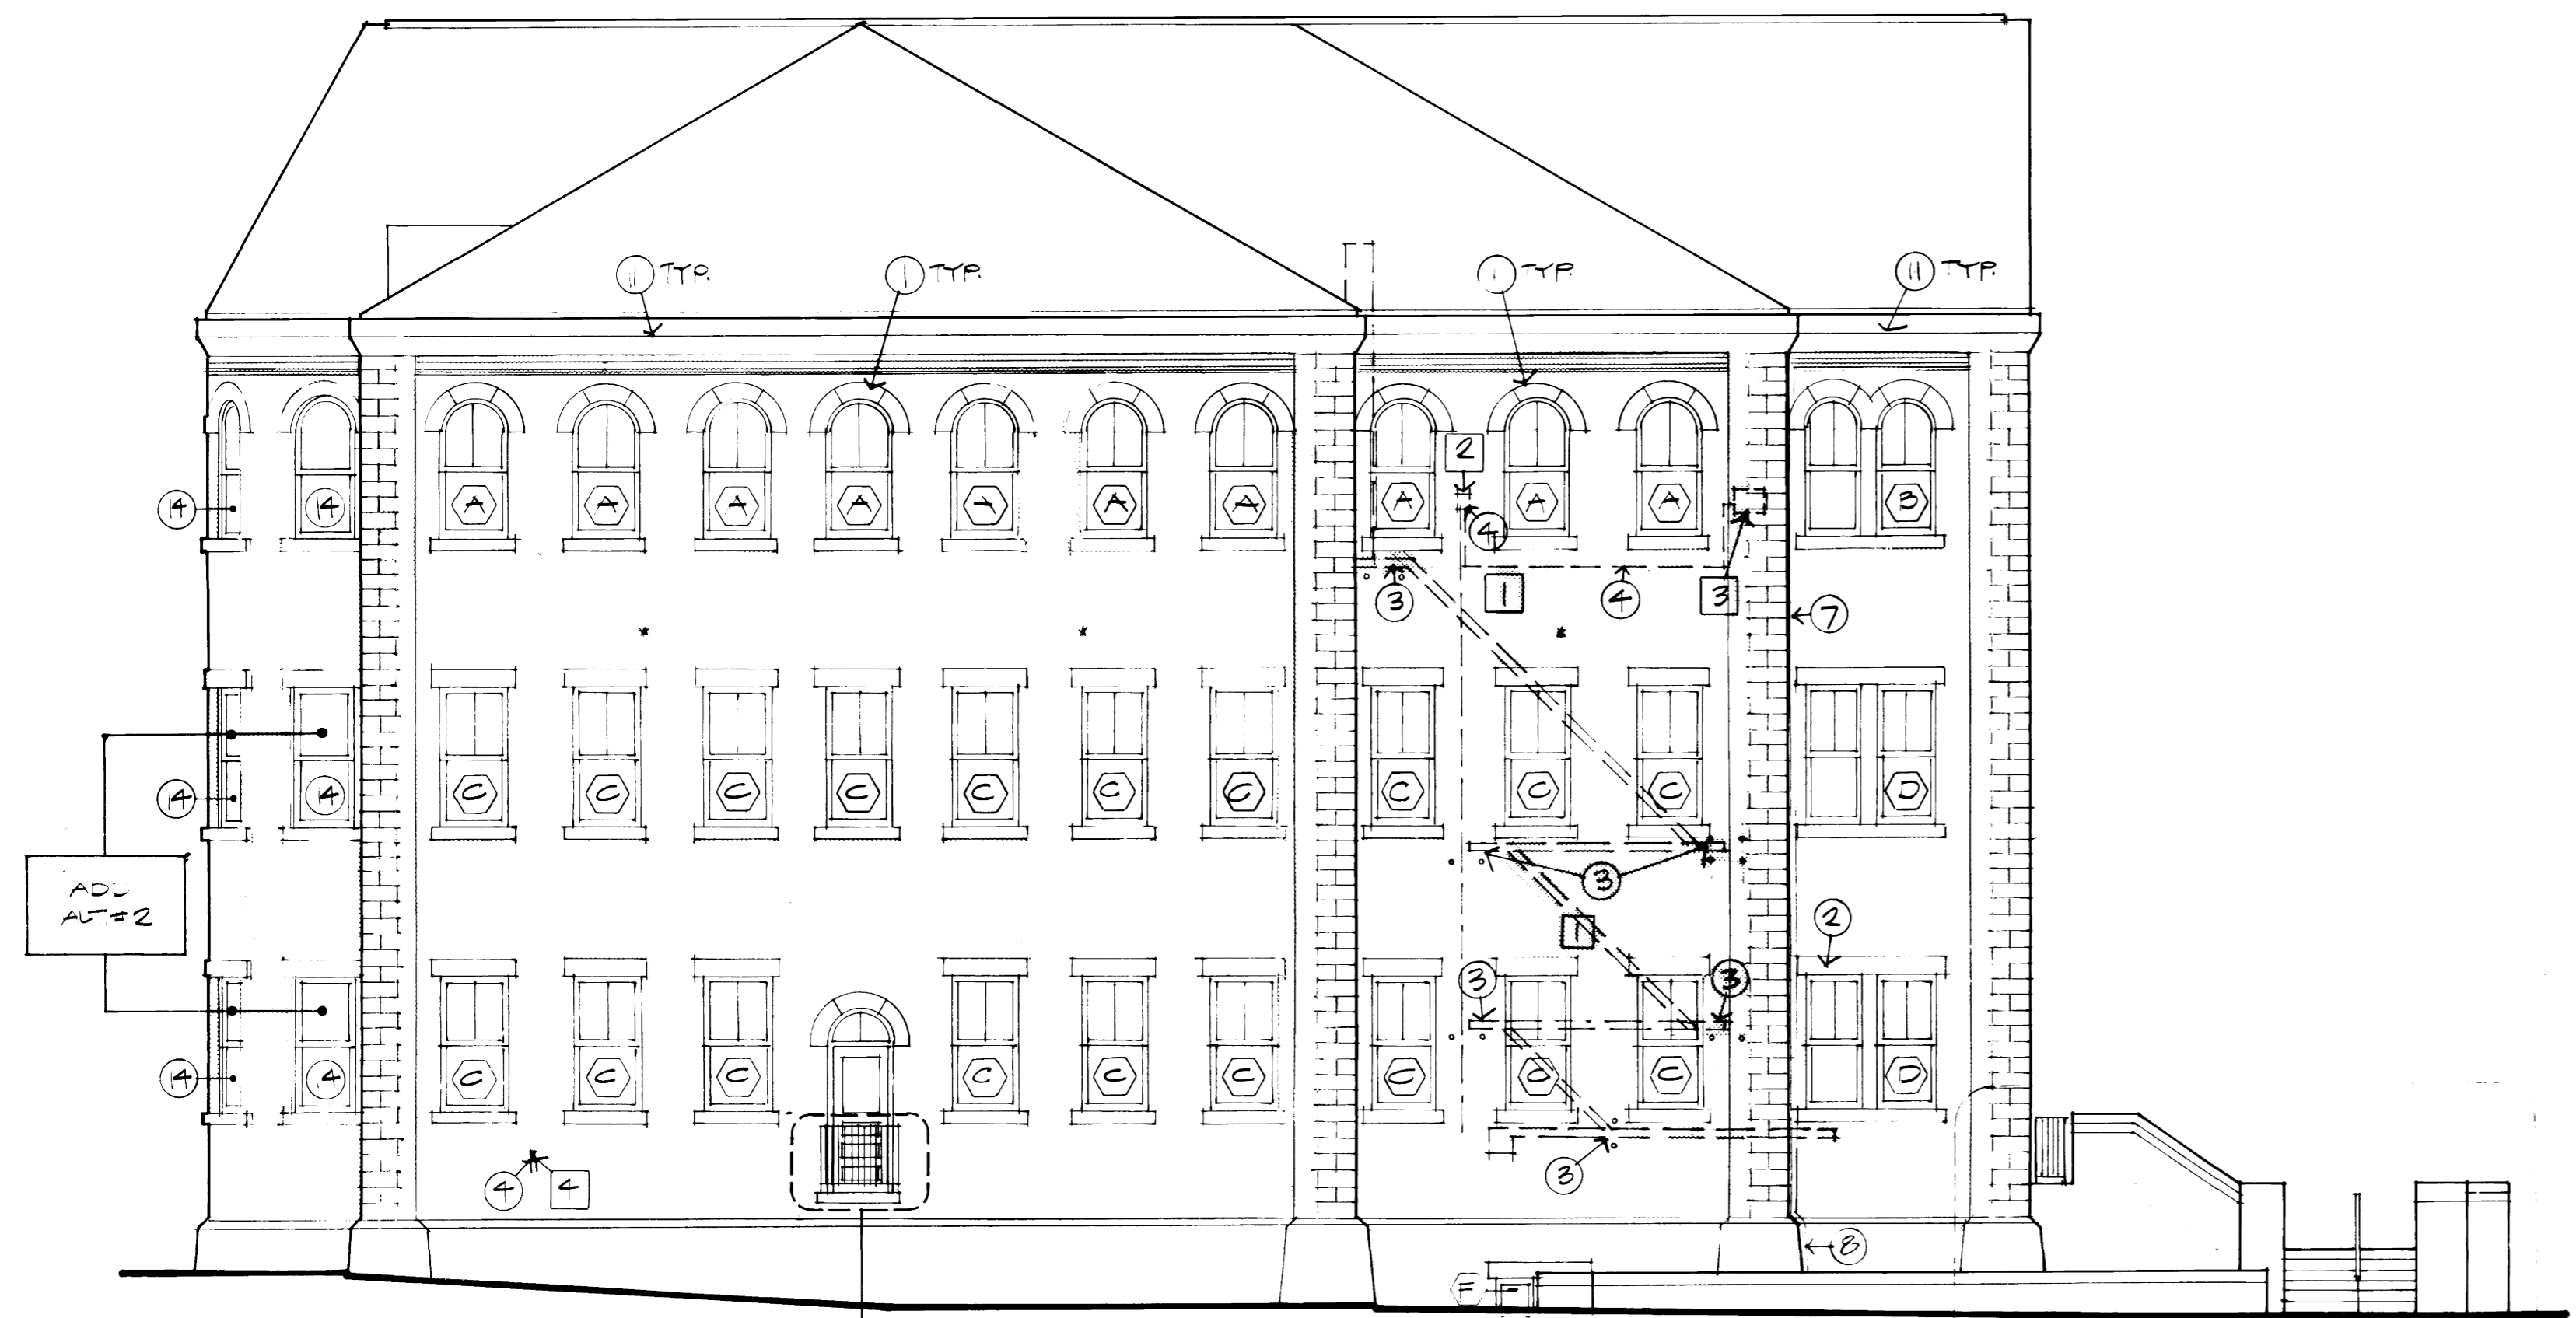


**10 NORTH ELEVATION**  
1/8" = 1'-0"


5. 10: REFER TO 1.1, 4.1 & 4.2 FOR  
MASONRY REPAIRS AND  
DETAILS



**11 WEST ELEVATION**  
1/8" = 1'-0"

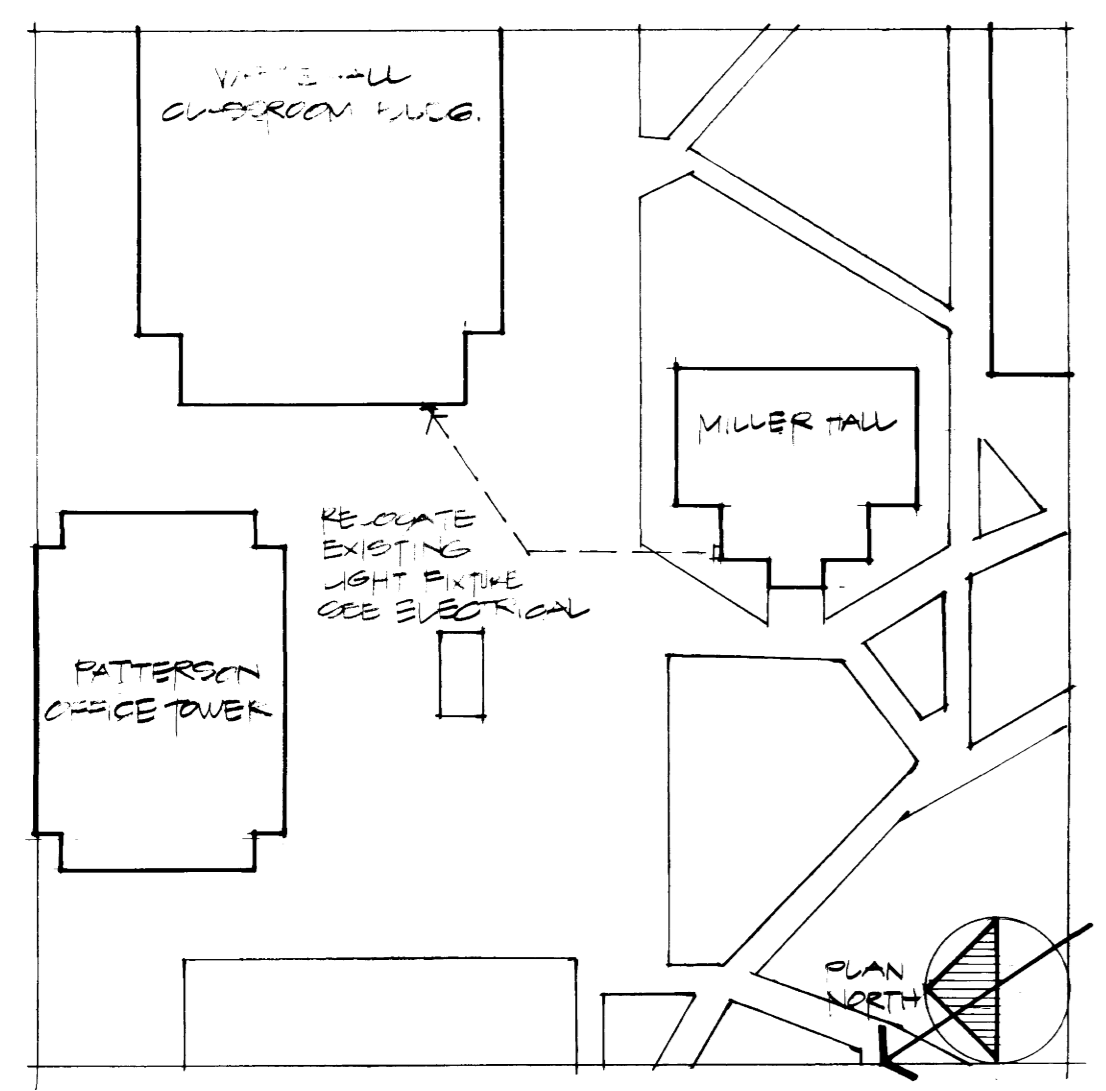

**12 KEY PLAN**  
NOT TO SCALE

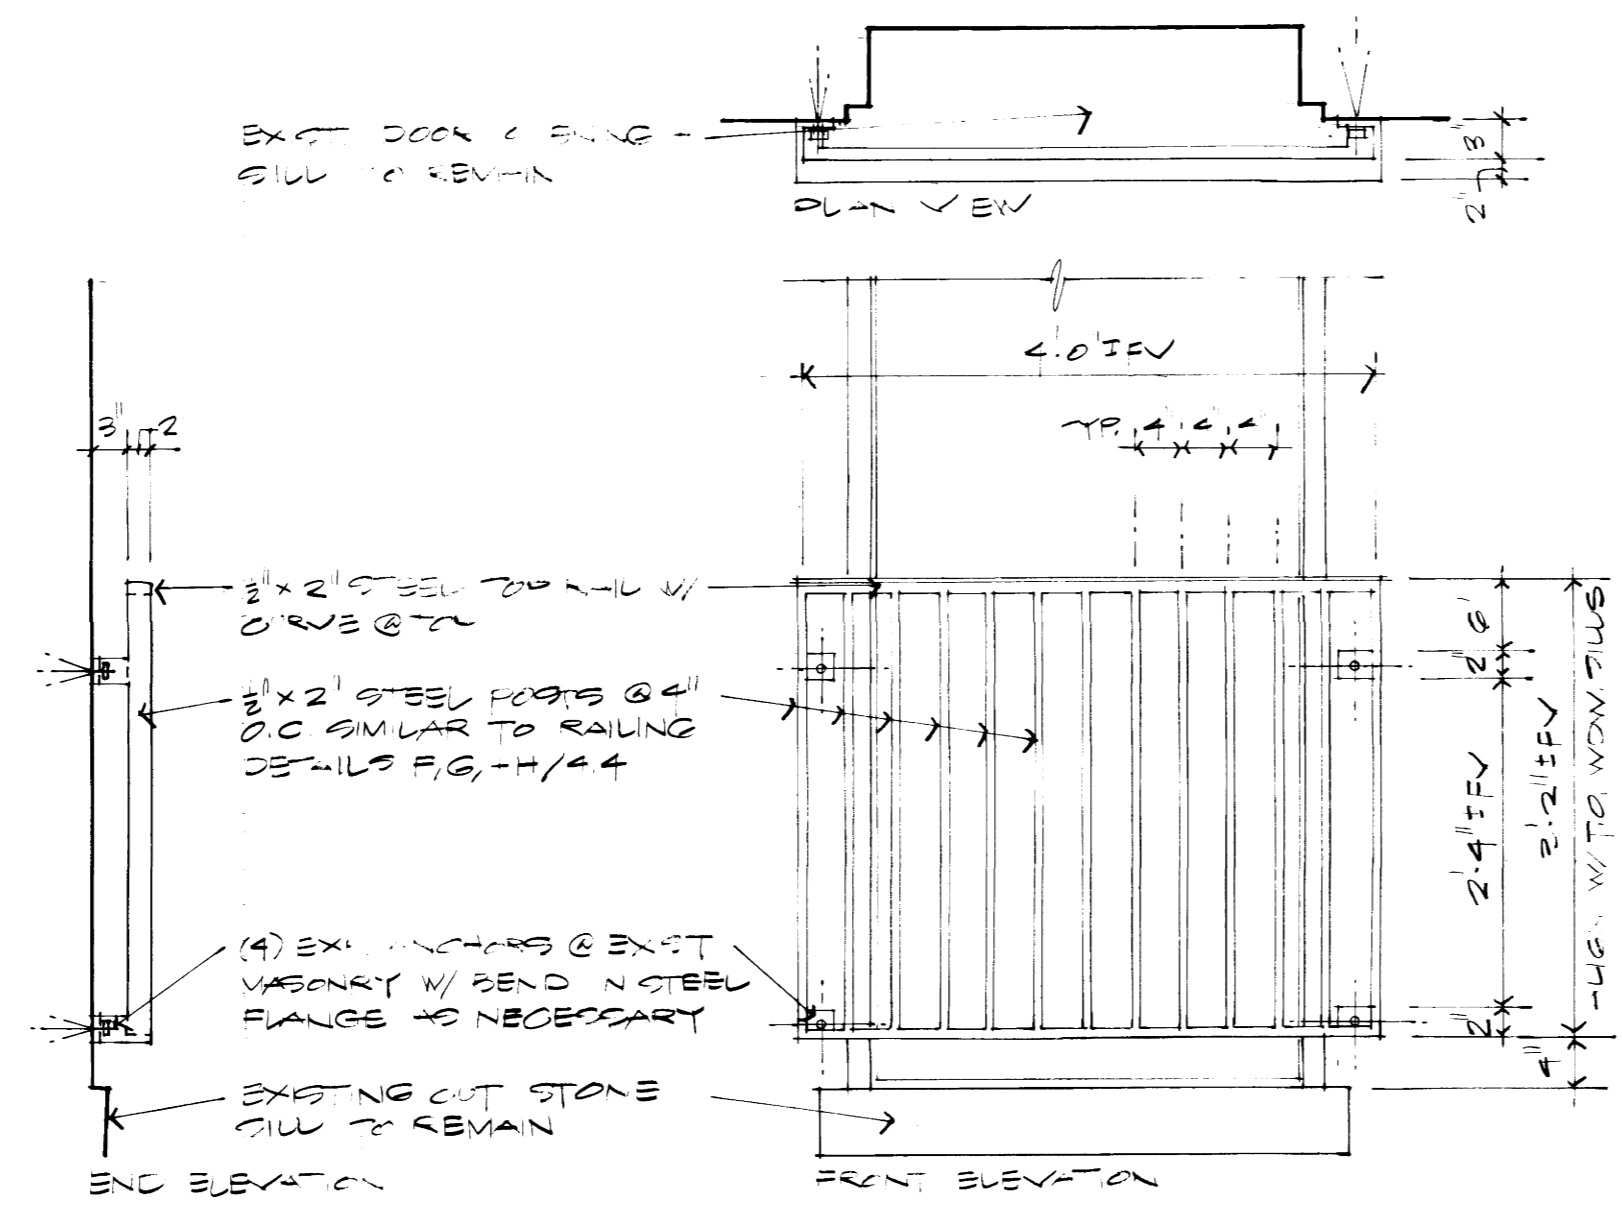

**13 RAILING DETAILS**  
1/8" = 1'-0"

**DEMOLITION NOTES**

- 1 REMOVE EXISTING FIRE ESCAPE AND ALL ASSOCIATED MOUNTING BRACKETS, PLATES AND BOLTS.
- 2 REMOVE WALL MOUNTED LIGHT FIXTURE AND ALL ASSOCIATED EXPOSED CONDUIT.
- 3 REMOVE WALL MOUNTED LIGHT FIXTURE AND SALVAGE FOR REUSE. REFER TO DETAILS SHEET 4.1 AND ELECTRICAL DRAWINGS FOR ADDITIONAL INFORMATION.
- 4 REMOVE EXPOSED CONDUIT.
- 5 REMOVE EXISTING CUT STONE LINTEL AND SILL. REFER TO STRUCTURAL DEMOLITION NOTES FOR ADDITIONAL INFORMATION.
- 6 REMOVE EXHAUST DUCT TO ROOF.

**ADDITIVE ALTERNATE NUMBER ONE**

- REPOINT ALL EXISTING CLAY MASONRY AND LIMESTONE UNITS, INCLUDING CUT AND ROCKFACE UNITS. THIS WORK IS IN ADDITION TO THE PARTIAL RE-POINTING SHOWN ON SHEETS 4.1 AND 4.2.

**ADDITIVE ALTERNATE NUMBER TWO**

- PROVIDE AND INSTALL NEW CURVED GLASS WOOD WINDOWS AT 1ST, 2ND, AND 3RD FLOORS SIMILAR TO NEW WOOD WINDOWS IN REMAINDER OF BUILDING AS SHOWN ON SHEETS 4.1 AND 4.2.

**CONSTRUCTION NOTES**


- GENERAL:**
- CLEAN ALL CLAY MASONRY SURFACES WITH RESTORATION CLEANER IN ACCORDANCE WITH SPECIFICATIONS SECTION 04525.
  - CLEAN ALL LIMESTONE SURFACES: FOUNDATIONS, QUOINS, SILLS, & LINTELS WITH RESTORATION CLEANER IN ACCORDANCE WITH SPECIFICATIONS SECTION 04525.
  - SEAL ALL LIMESTONE SURFACES (CUT AND ROCKFACE) IN ACCORDANCE WITH SPECIFICATIONS SECTION 07180.
  - SEAL ALL BRICK MASONRY IN ACCORDANCE WITH SPECIFICATIONS SECTION 07180.
- SHADED AREAS INDICATE LIMITS OF MASONRY RE-POINTING.

- 1  PROVIDE NEW 5" DIA. COPPER DOWNSPOUTS AT EXISTING DOWNSPOUT LOCATIONS.
- 2  PROVIDE NEW DOWNSPOUT SHOE: CAST IRON (PAINT). TIE INTO EXISTING BOOT.
- 3  NEW DORMER VENTS, SEE DETAILS SHEET 3.8.
- 10  NEW ROOF HATCH, SEE DETAILS SHEET 3.8.
- 11  EXISTING CORNICE TRIM AND GUTTER FACE, PAINT. TYPICAL. NOTE: STRIP EXISTING PAINT (SEE SPEC DIV. 9-PAINTING)
- 12  PAINT EXISTING TRIM AT GABLE FACE. STRIP EXISTING PAINT (SEE SPEC DIV. 9-PAINTING)
- 13  CURVED WINDOWS: EXISTING WINDOWS TO BE REUSED. STRIP PAINT (SEE SPEC DIV. 9-PAINTING). REPLACE DAMAGED WOOD MEMBERS AND RE-BUILD TO PROVIDE PROPER OPERATION. REUSE GLASS WHERE POSSIBLE, REPLACE BROKEN PANE WITH CURVED PLATE GLASS TO MATCH EXISTING.
- 14  ENLARGE EXISTING OPENING TO WINDOW WIDTH.
- 15  REMOVE STEEL PLATE, PATCH MASONRY.
- 16  EXISTING DOOR TO BE REUSED. REMOVE UPPER PANELS AND INSTALL 1/4" TEMPERED GLASS AS SHOWN. REPLACE TRIM AS REQUIRED. REFER TO DOOR AT SIMILAR LOCATION AT NORTH ELEVATION.

- 1 LIMESTONE LINTELS: REMOVE MORTAR, REPOINT JOINTS OF ALL LINTELS. TYPICAL.
- 2 CRACKED LIMESTONE: REMOVE LOOSE MATERIAL, PATCH WITH LIMESTONE PATCH FILLER.
- 3 PATCH MASONRY AT REMOVAL OF FIRE ESCAPE ANCHORS AND WALL BRACKETS.
- 4 PATCH MASONRY AT REMOVAL OF LIGHT FIXTURE AND/OR CONDUITS.
- 5 CLEAN PAINT FROM EXISTING BRICK.
- 6  CLEAN PAINT FROM EXISTING BRICK.
- 7  PATCH MASONRY AT REMOVAL OF EXHAUST DUCT.


(ADD)



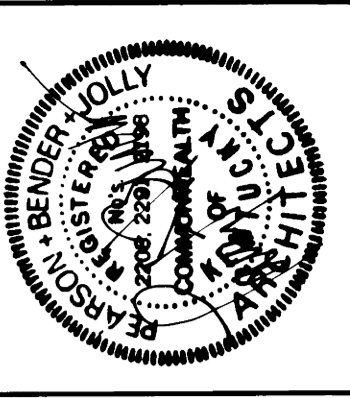

University of Kentucky  
Lexington, Kentucky

Approved By: [Signature] Director, Capital Program Management

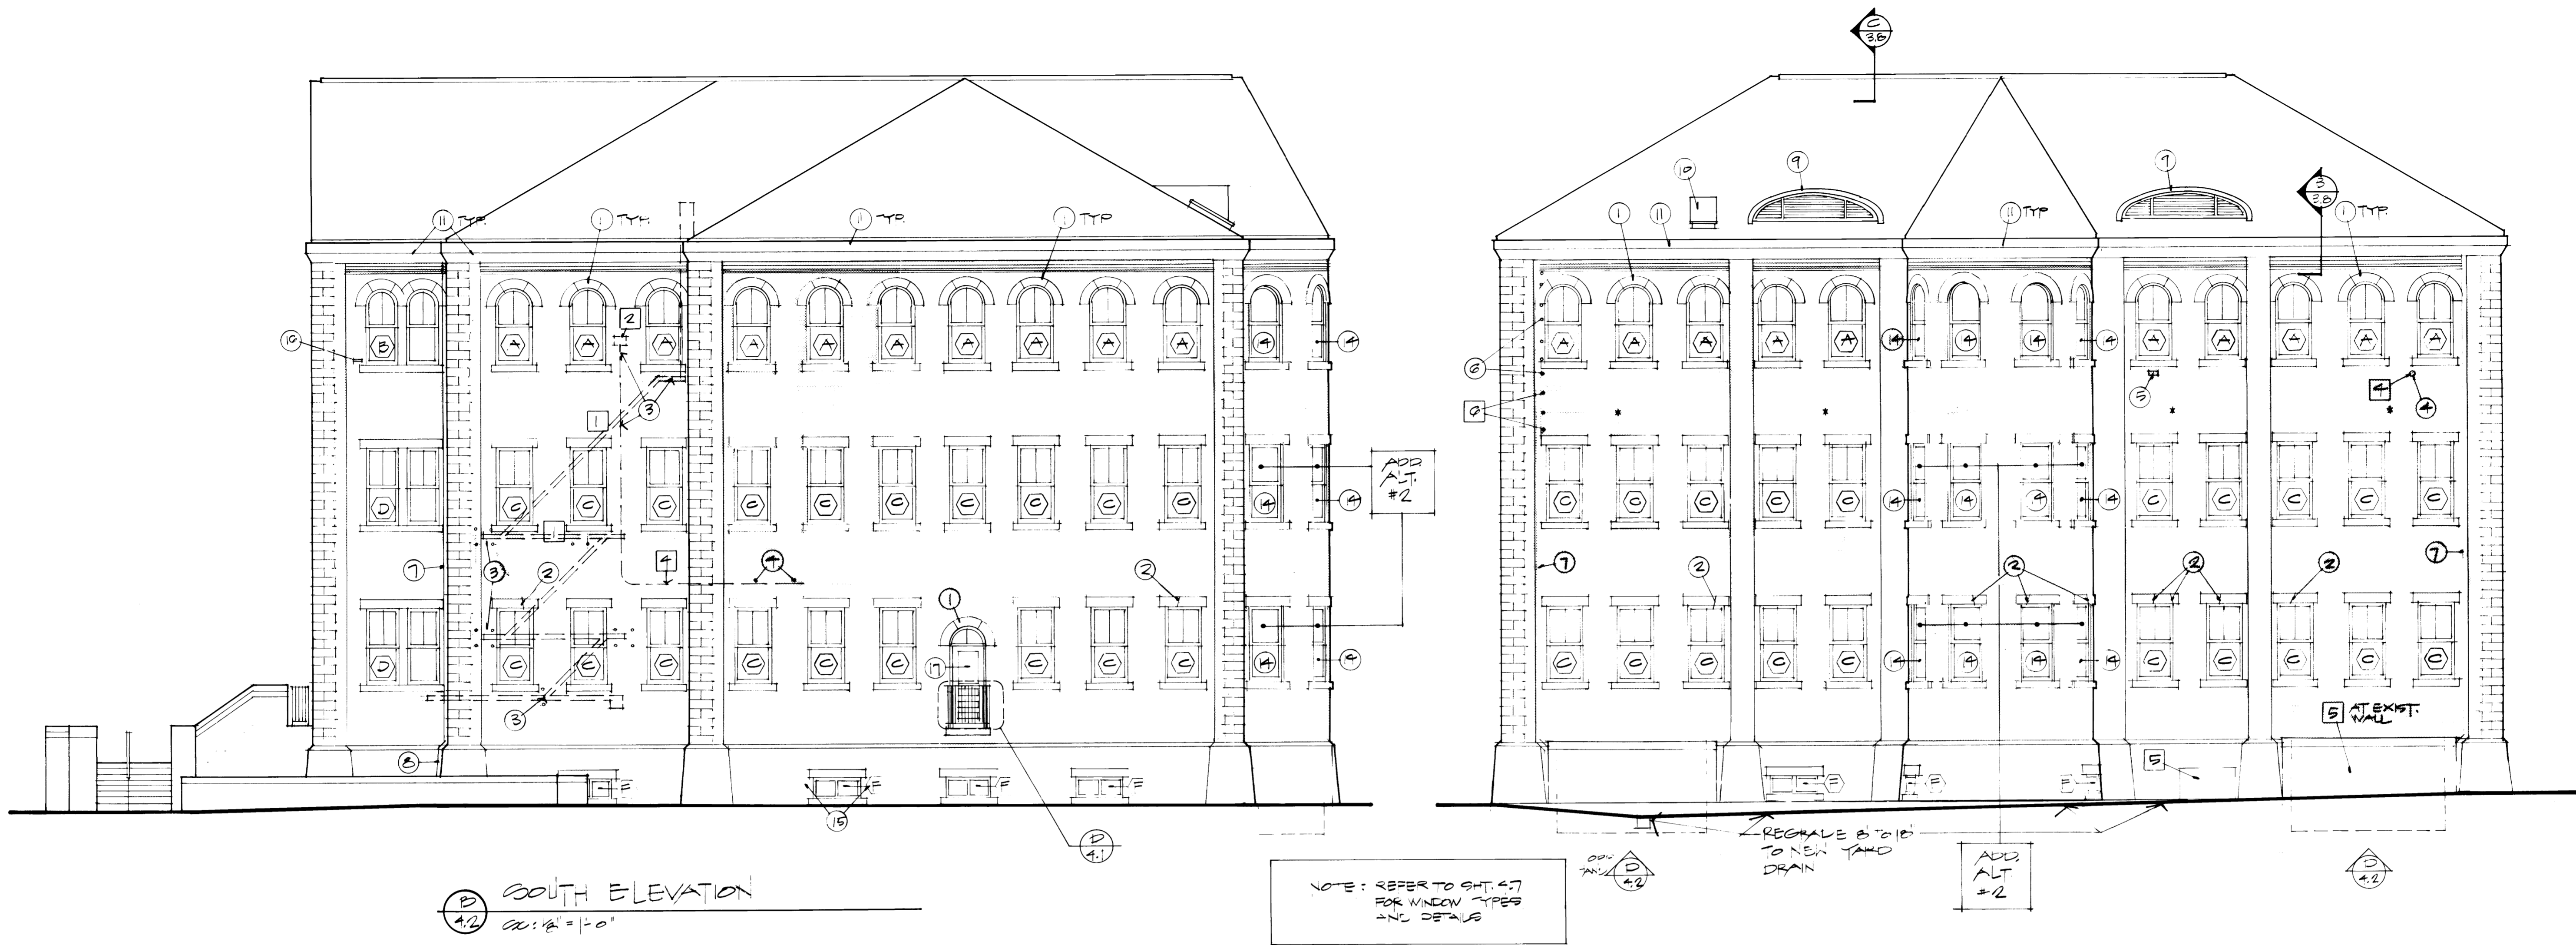

**(D) SOUTH ELEVATION**  
Scale: 1/8" = 1'-0"


NOTE: REFER TO SH. 4.7 FOR WINDOW TYPES AND DETAILS

**(A) EAST ELEVATION**  
Scale: 1/8" = 1'-0"



**(C) BUILDING SECTION**  
Scale: 1/8" = 1'-0"

- 1-HR RATED  
(1) LATER BR FC, GYP PL  
(2) EXIST'G CEILING  
(3) EXIST'G CEILING  
TYP ENTIRE CEILING
- SELF-LEVELING FLOOR  
TOPPING - SEE PLANS  
FOR LIMITS
- 1-HR RATED  
(1) LATER BR FC, GYP PL  
(2) EXIST'G CEILING  
TYP ENTIRE CEILING
- SELF-LEVELING FLOOR  
TOPPING - SEE PLANS  
FOR LIMITS
- 1-HR RATED  
(1) LATER BR FC, GYP PL  
(2) EXIST'G CEILING  
TYP ENTIRE CEILING
- SELF-LEVELING FLOOR  
TOPPING - SEE PLANS  
FOR LIMITS
- 1-HR RATED  
(1) LATER BR FC, GYP PL  
(2) EXIST'G CEILING  
(3) EXIST'G CEILING  
TYP ENTIRE CEILING

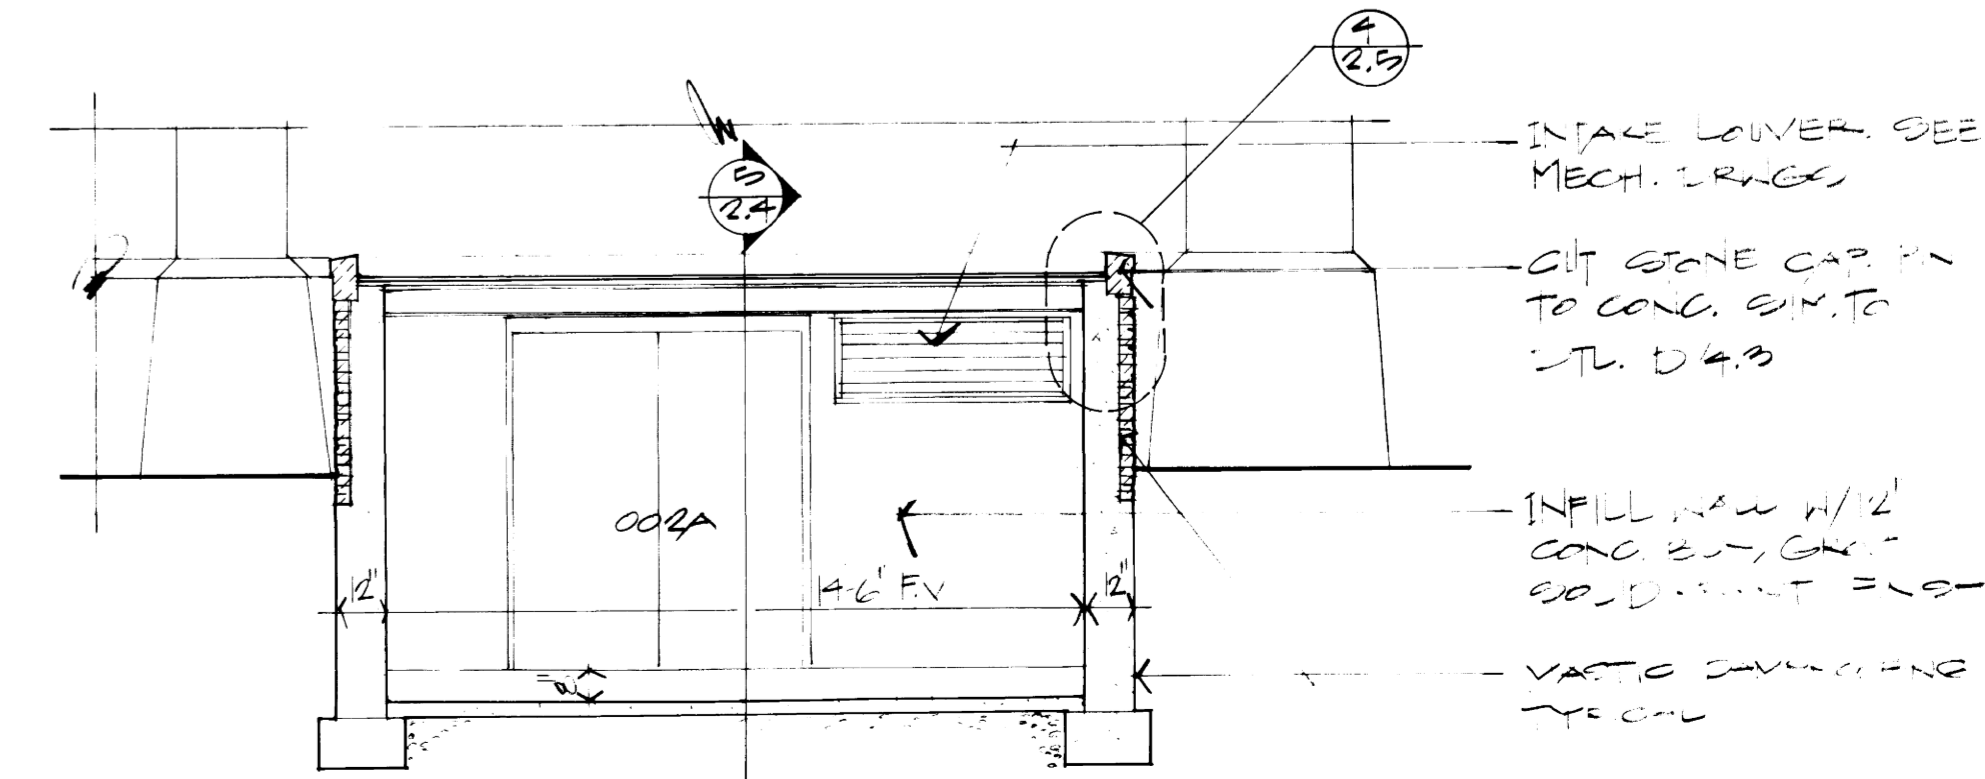

**(E) ELEVATION AREA**  
Scale: 1/4" = 1'-0"

BUILDING ELEVATIONS



**MILLER HALL RENOVATION**  
Lexington Campus Sector  
University of Kentucky

**Pearson + Bender + Jolly**  
201 Kentucky Ave  
Lexington, KY 40502  
606-253-1213  
10.2.11


project no. 1469.0  
date 10 AUGUST 09  
file no.  
dr. by CM  
ck. by MP

revisions



**4.2**

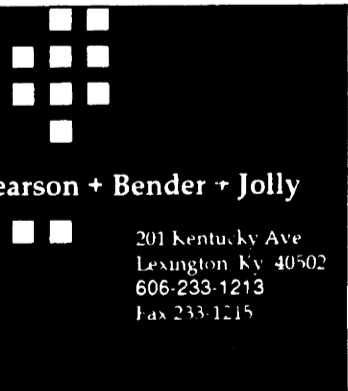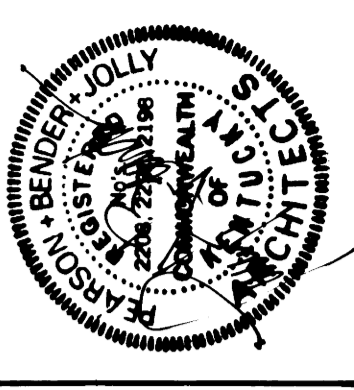


project no. 14650  
date 20-08-93  
file no.  
dr. by CBJ  
ck. by JS  
revisions

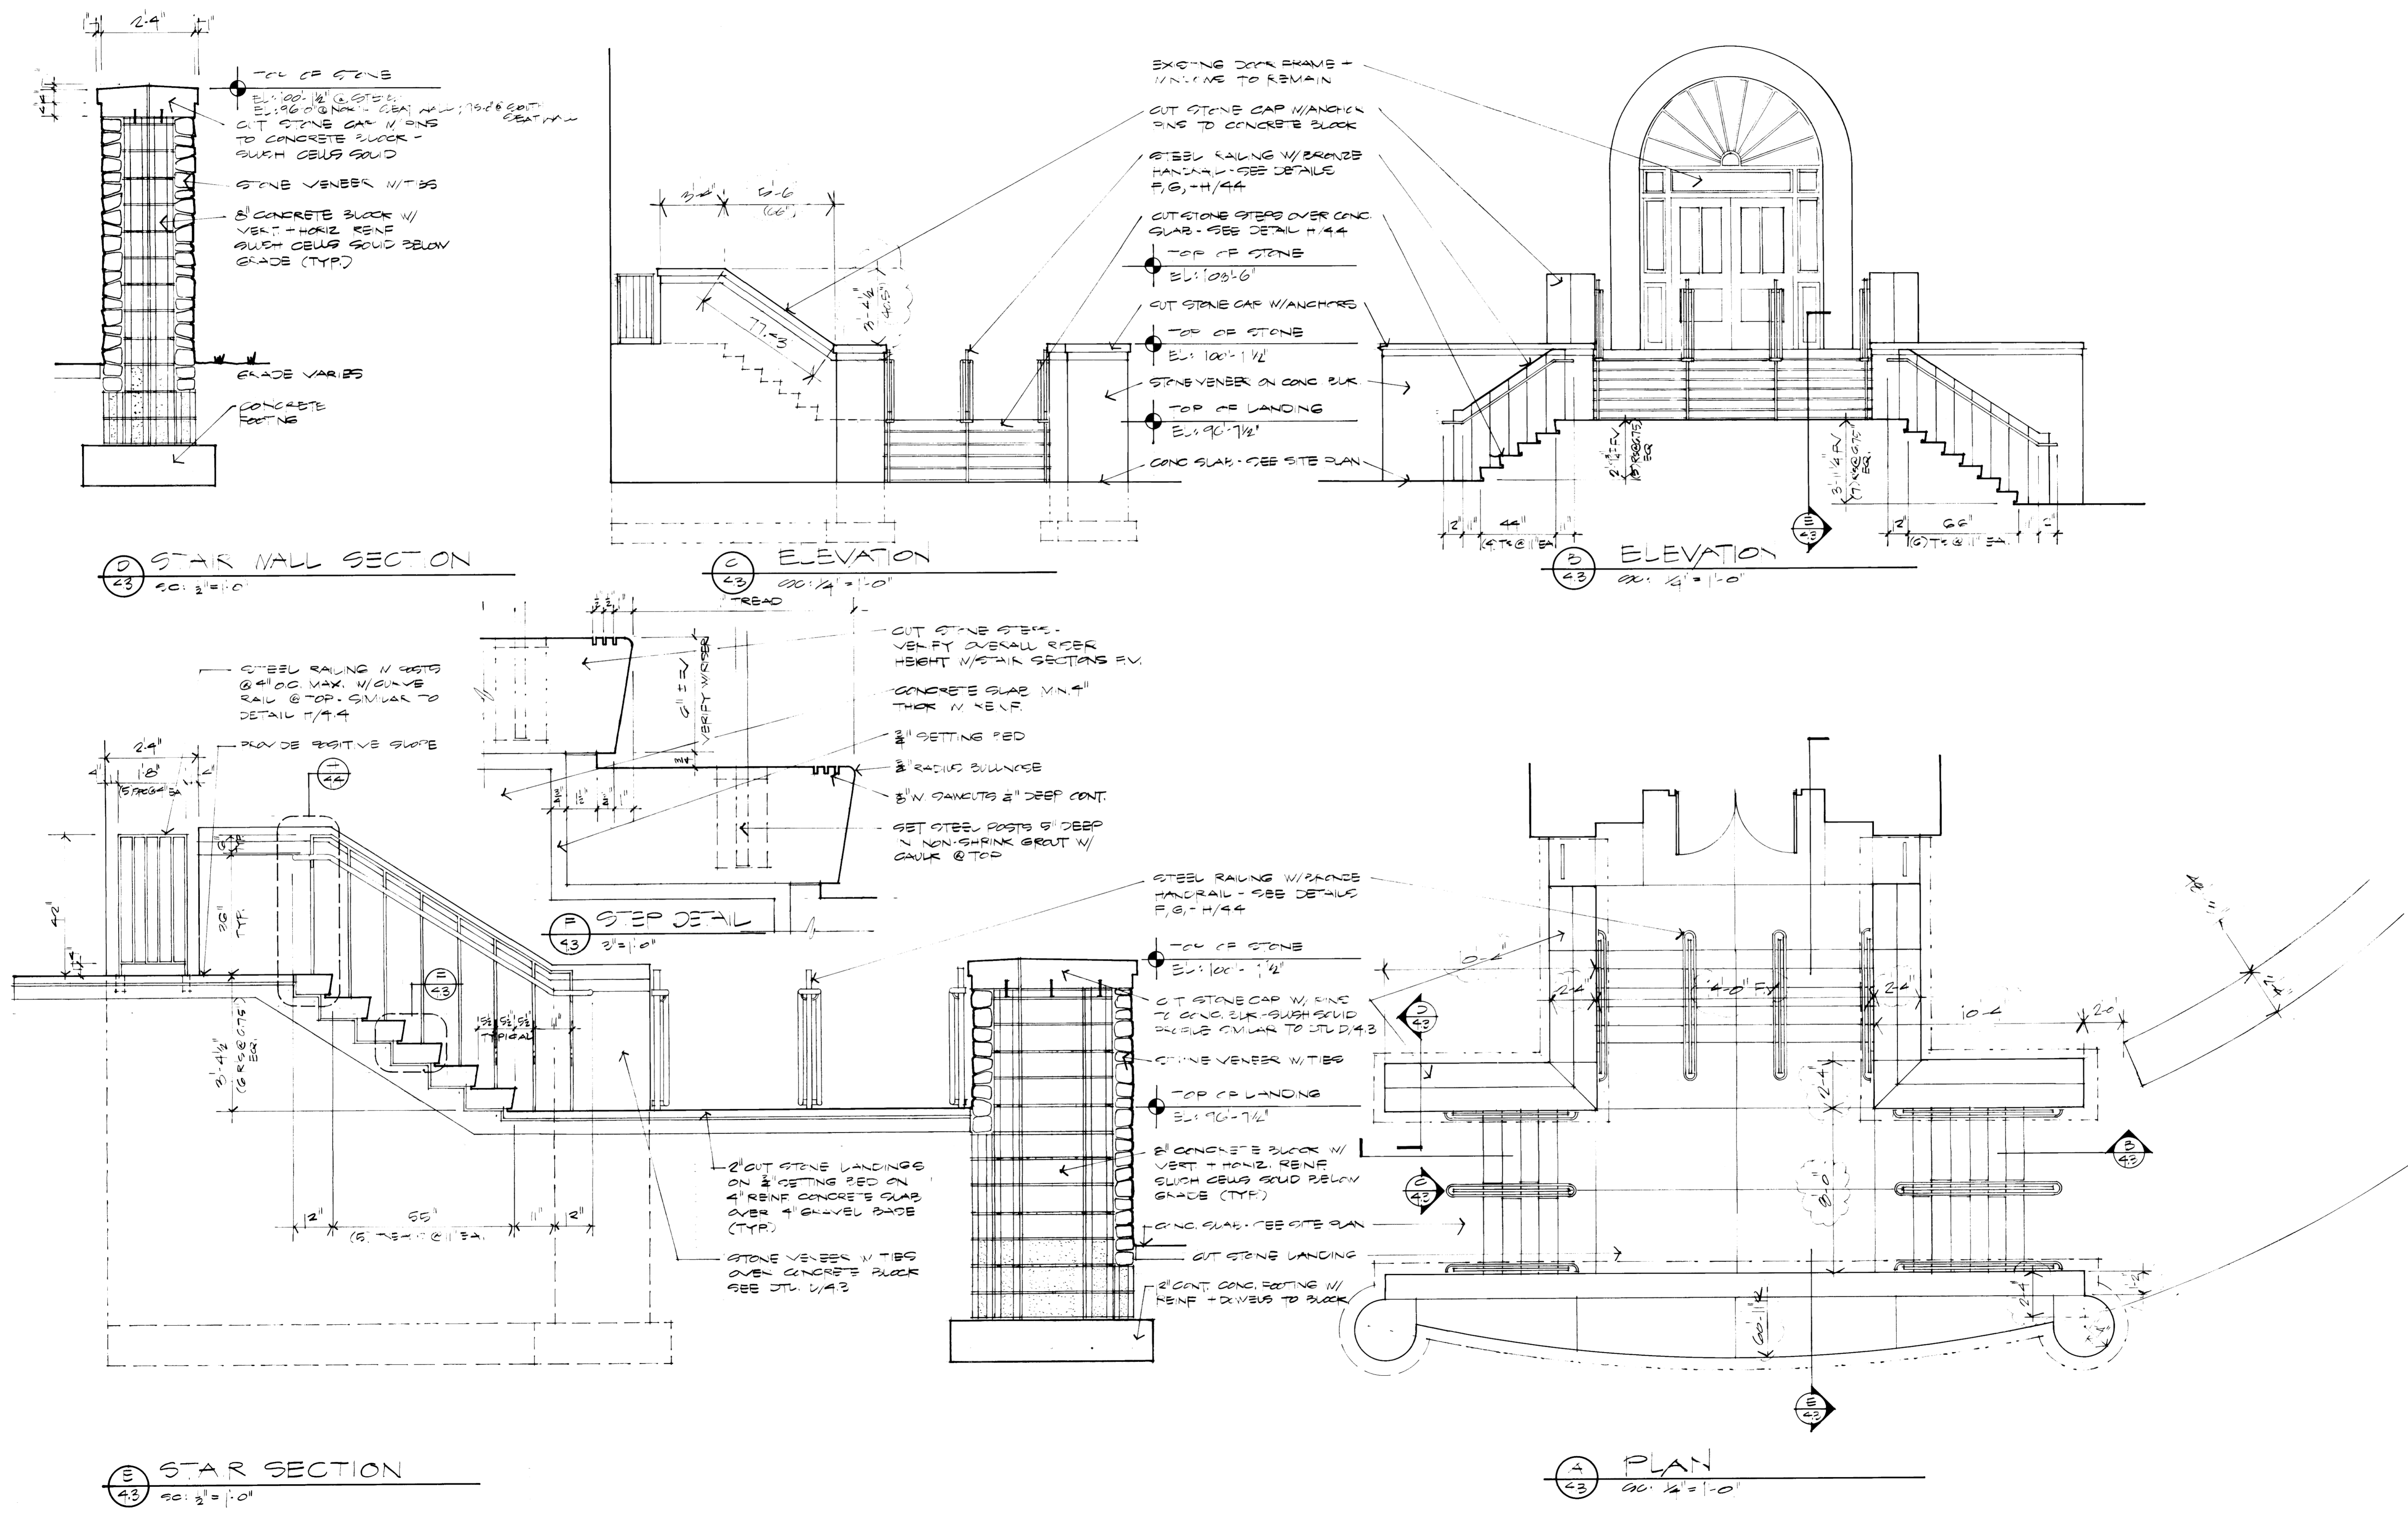




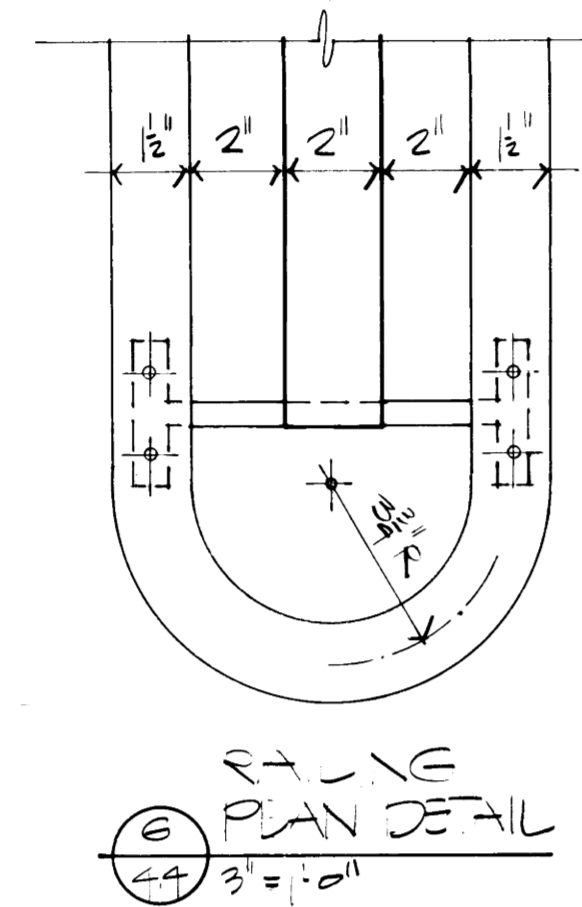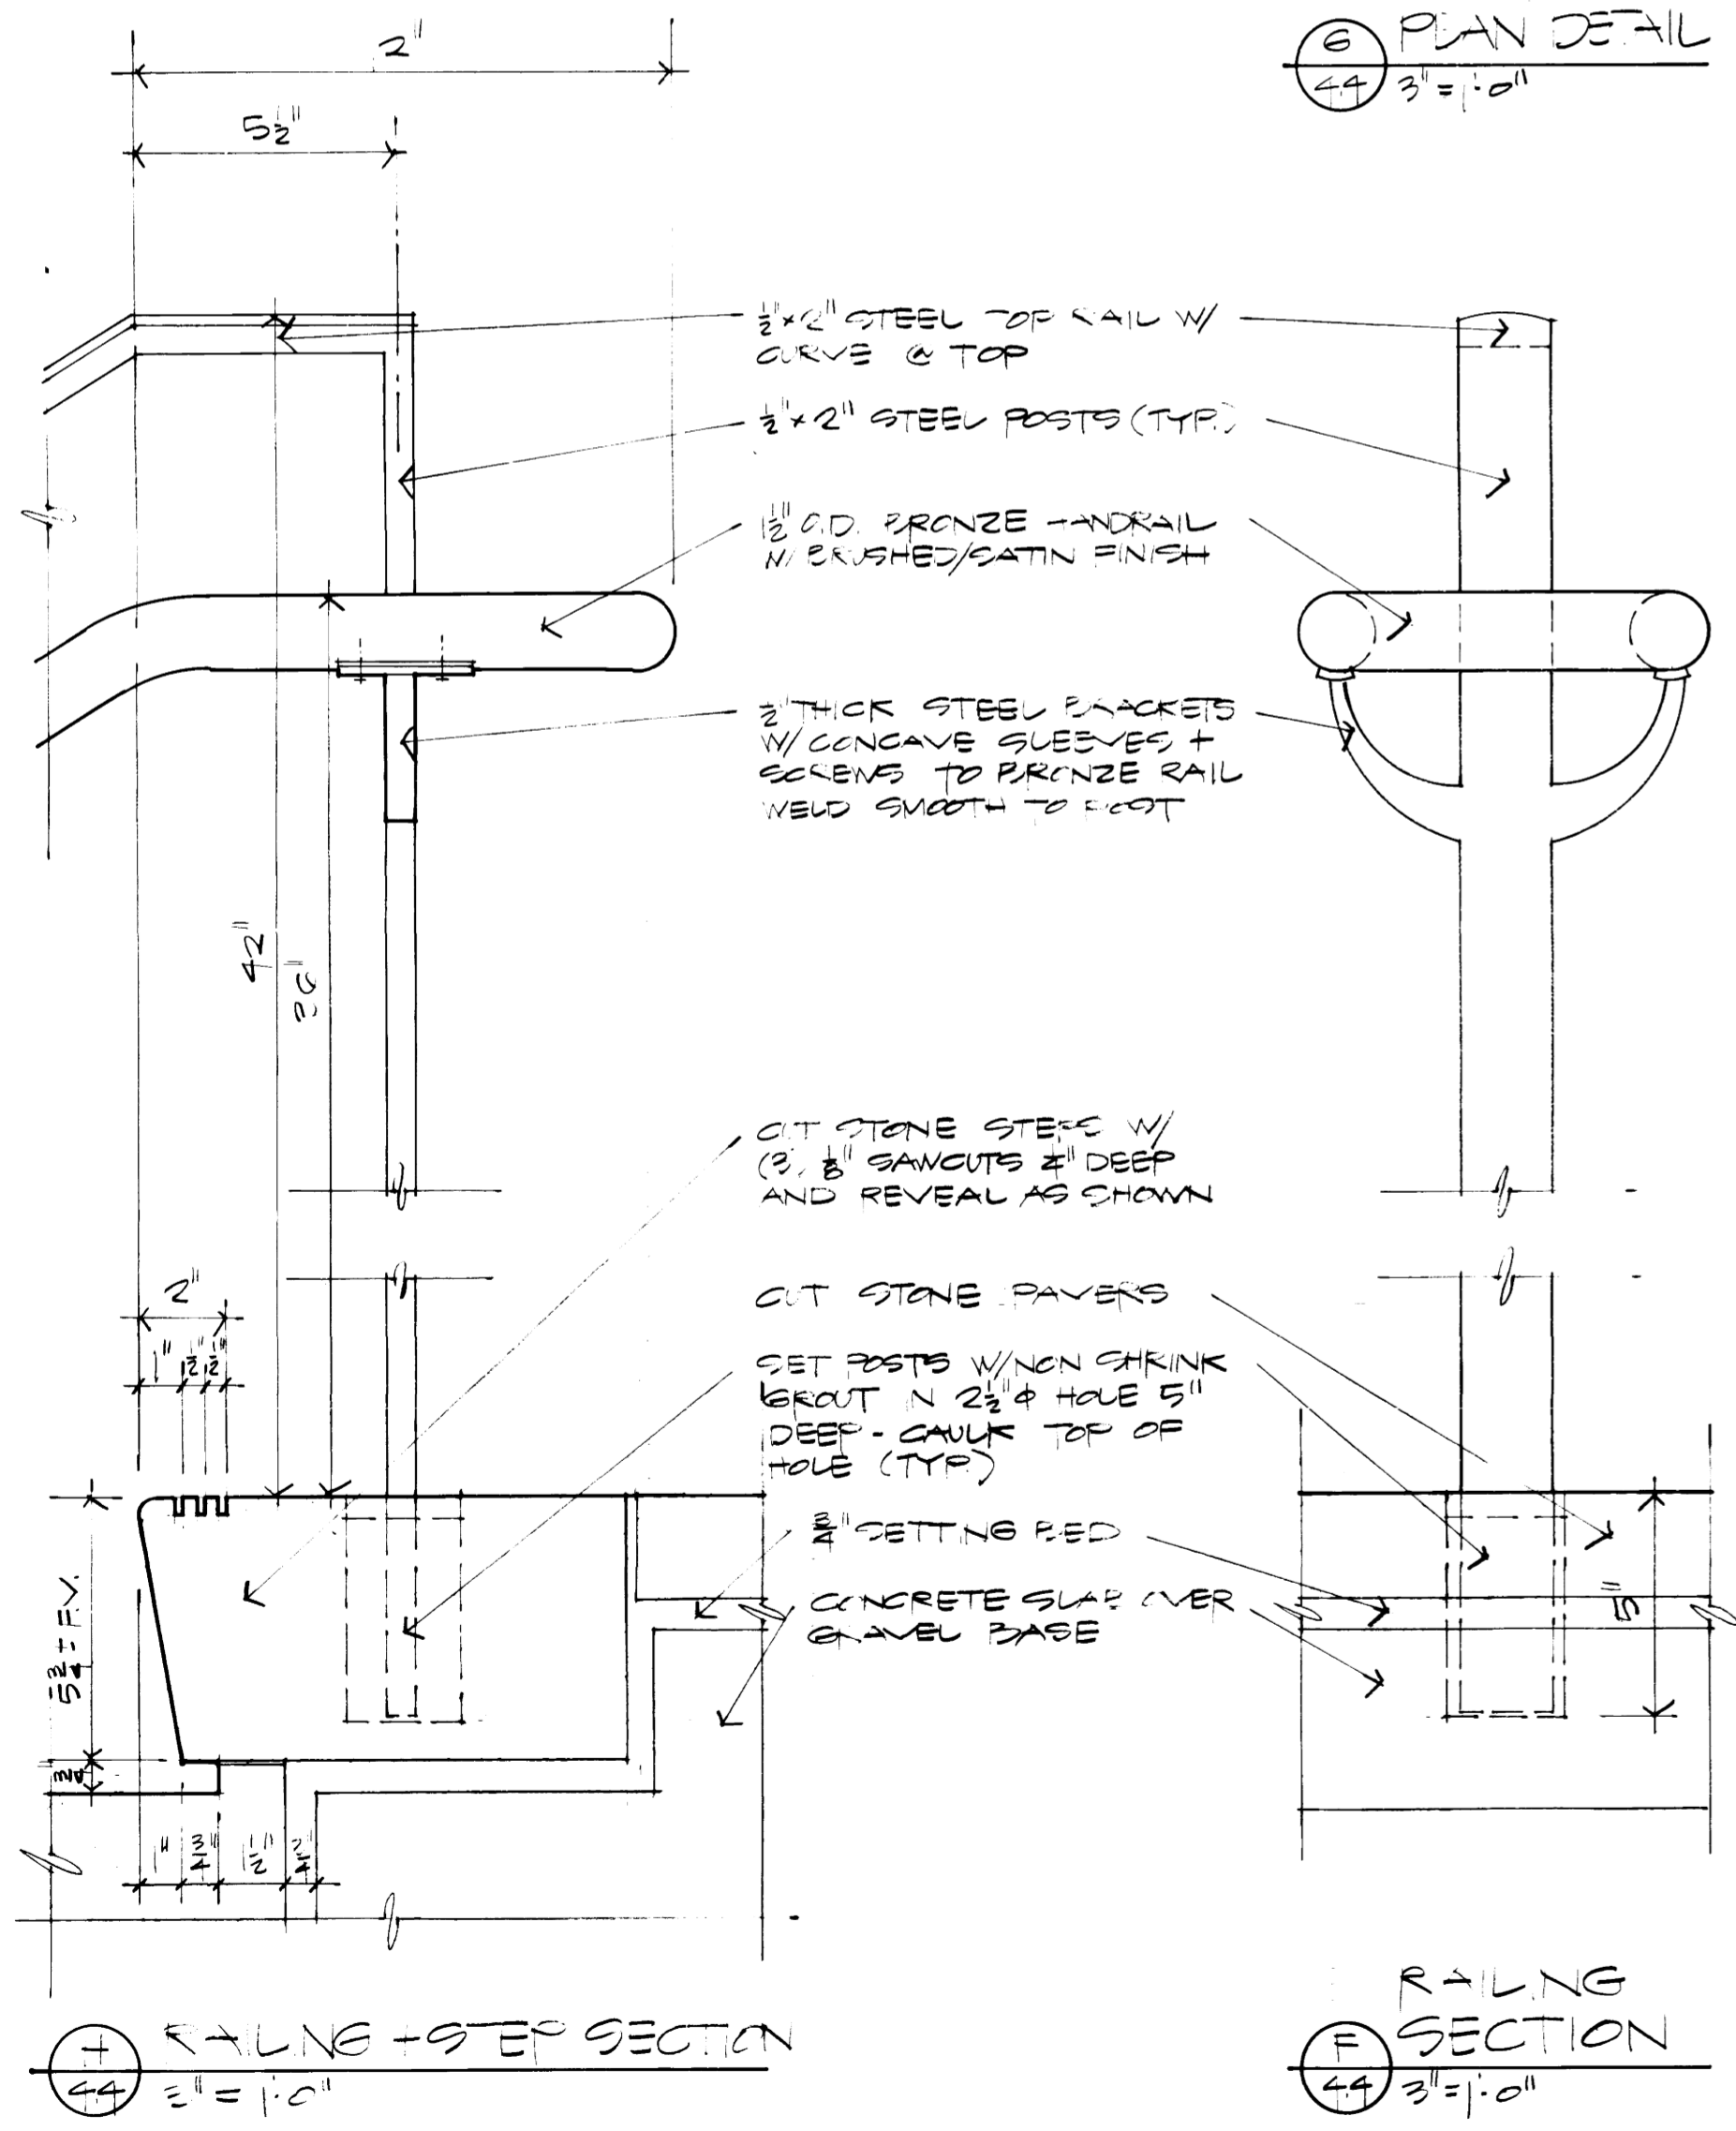


**RAILING SECTION**  
 3/4" = 1'-0"

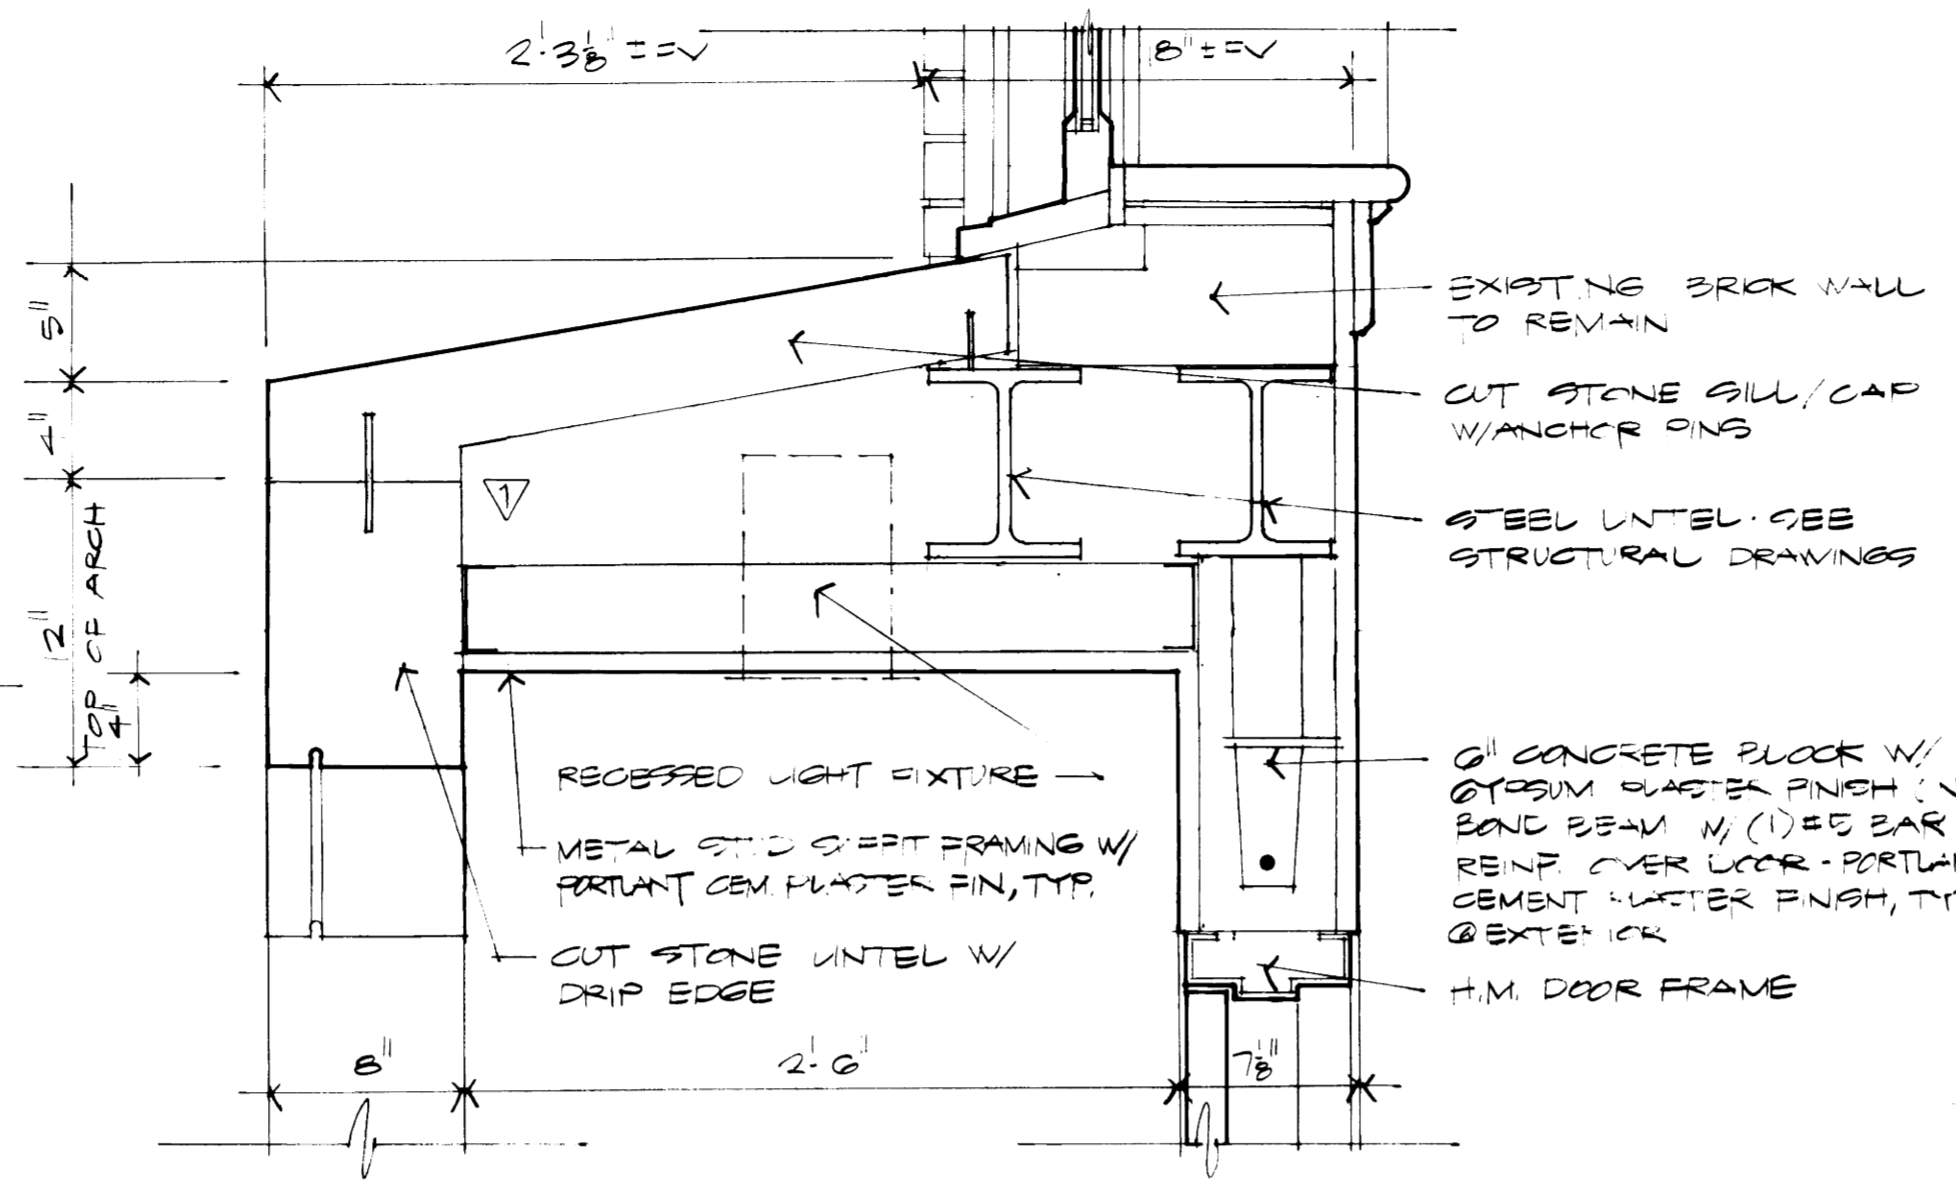


**SECTION**  
 1/2" = 1'-0"

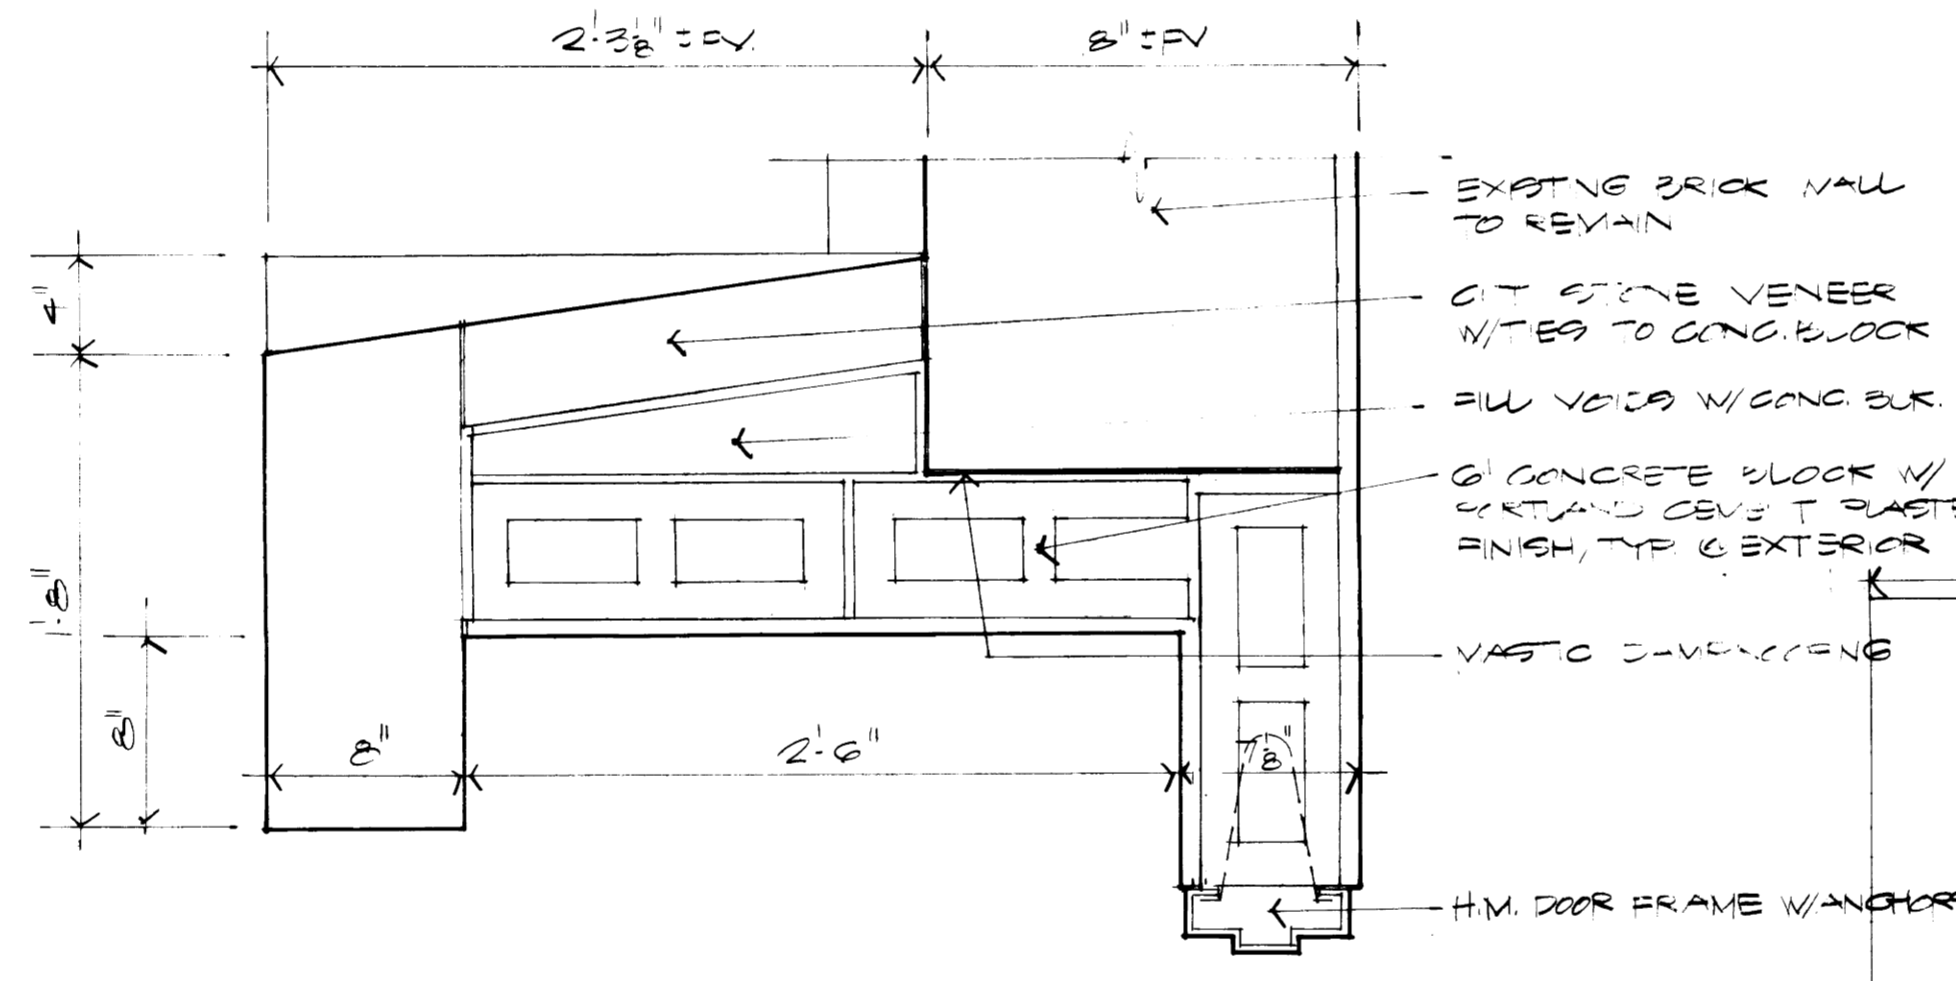


**CLEAN DETAIL**  
 1/2" = 1'-0"

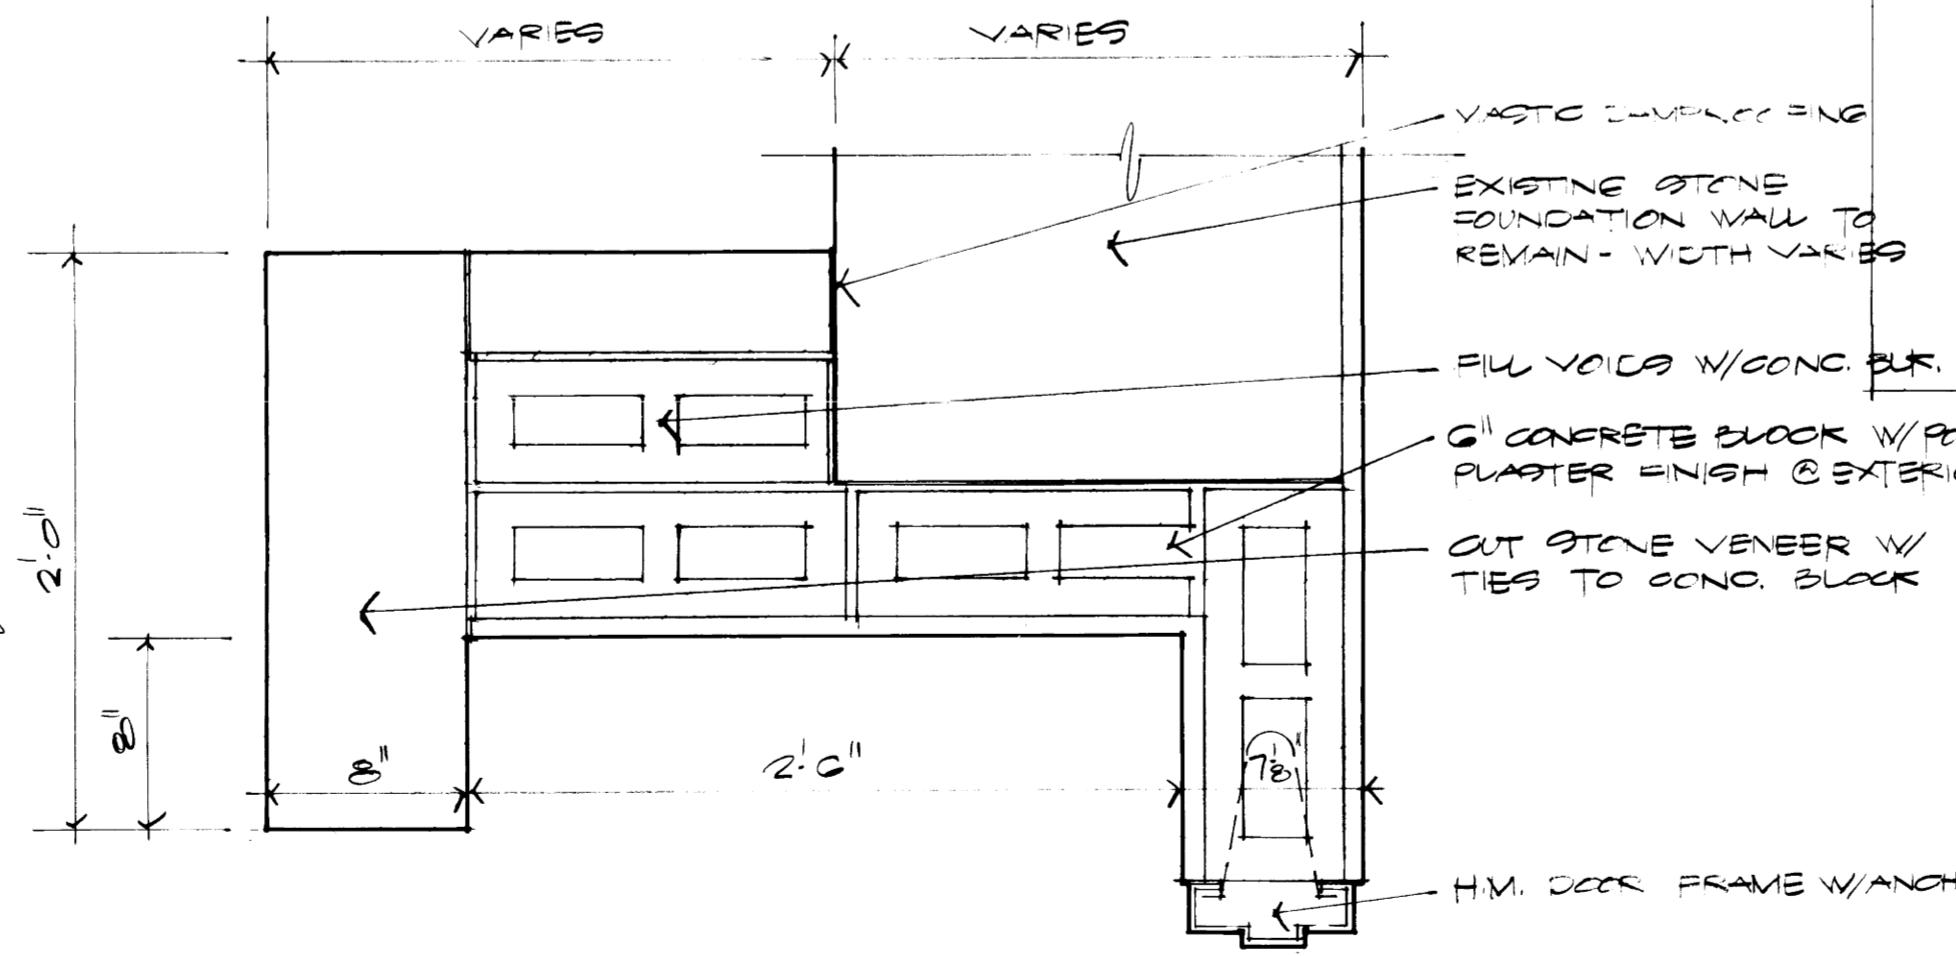


**PLAN DETAIL**  
 1/2" = 1'-0"

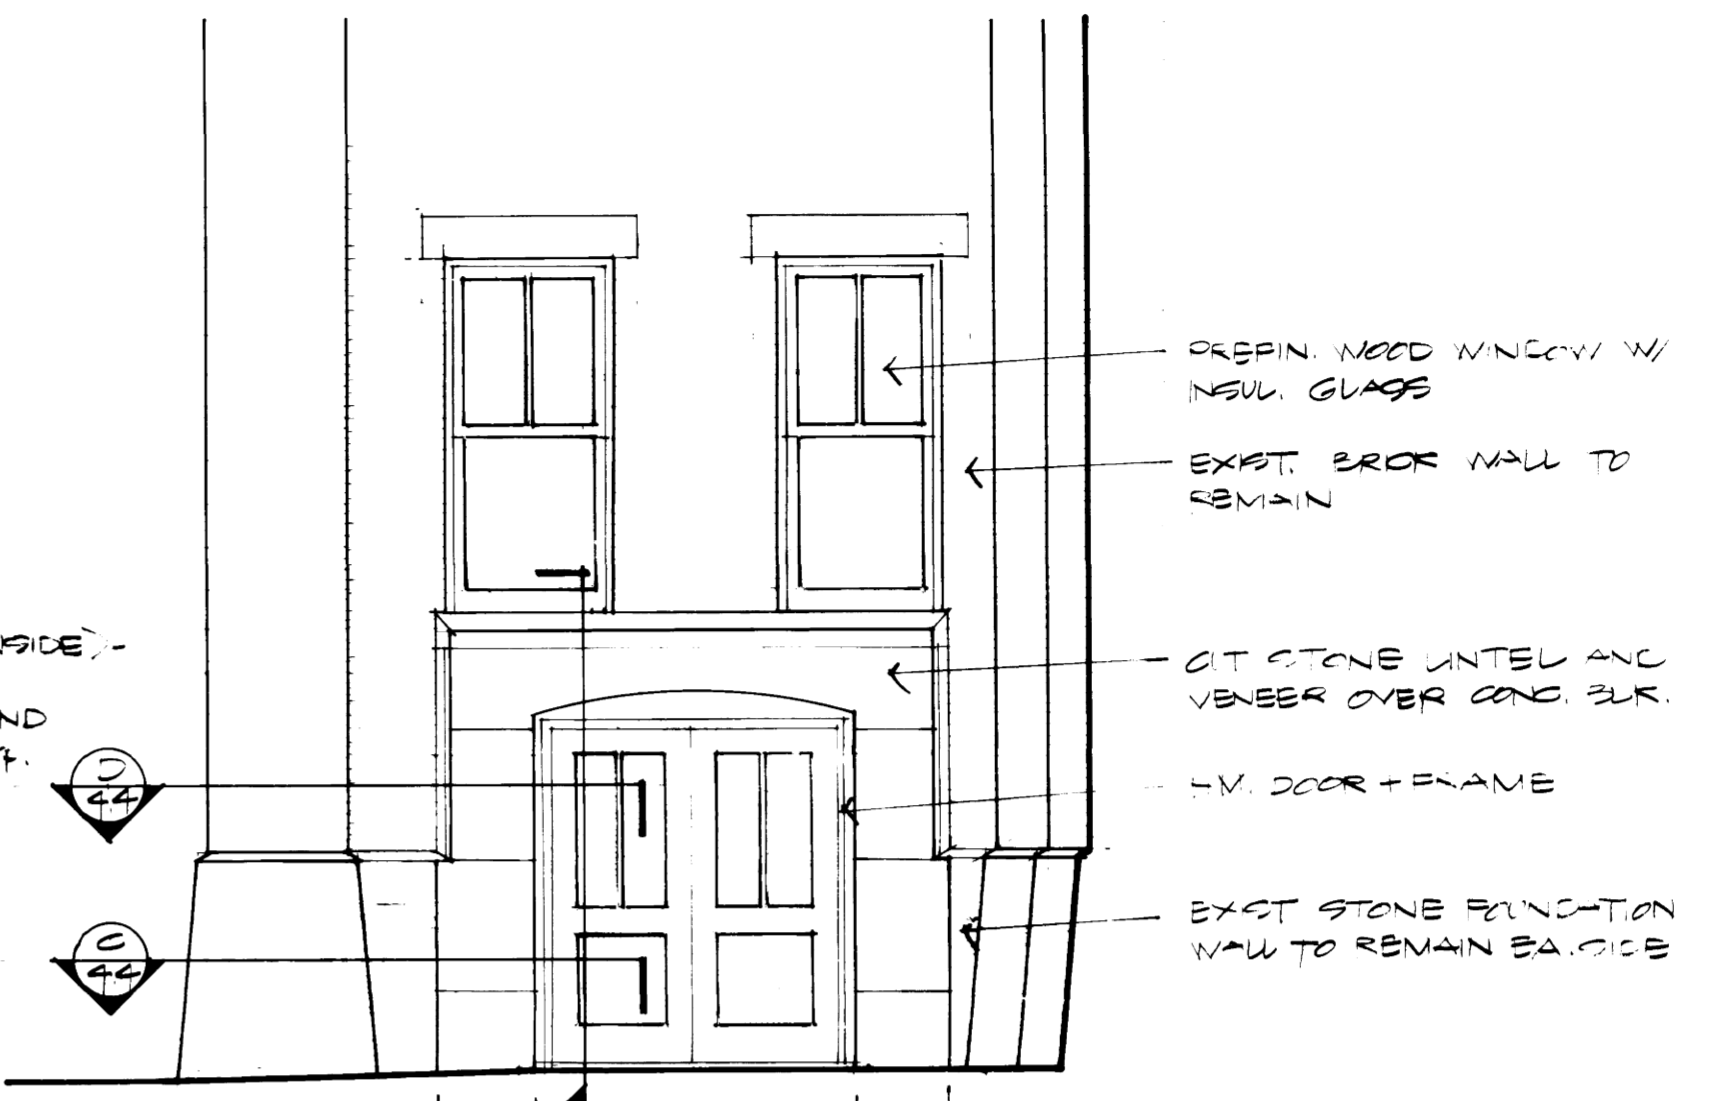


**ELEVATION**  
 1/4" = 1'-0"

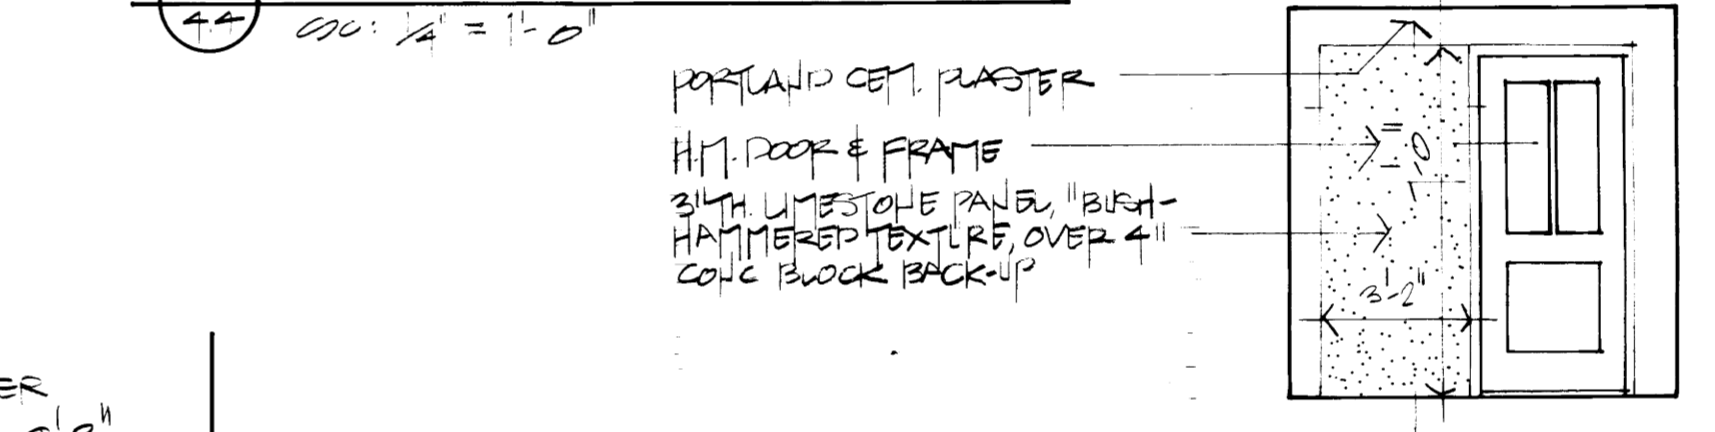


**ELEVATION (DOOR)**  
 1/4" = 1'-0"

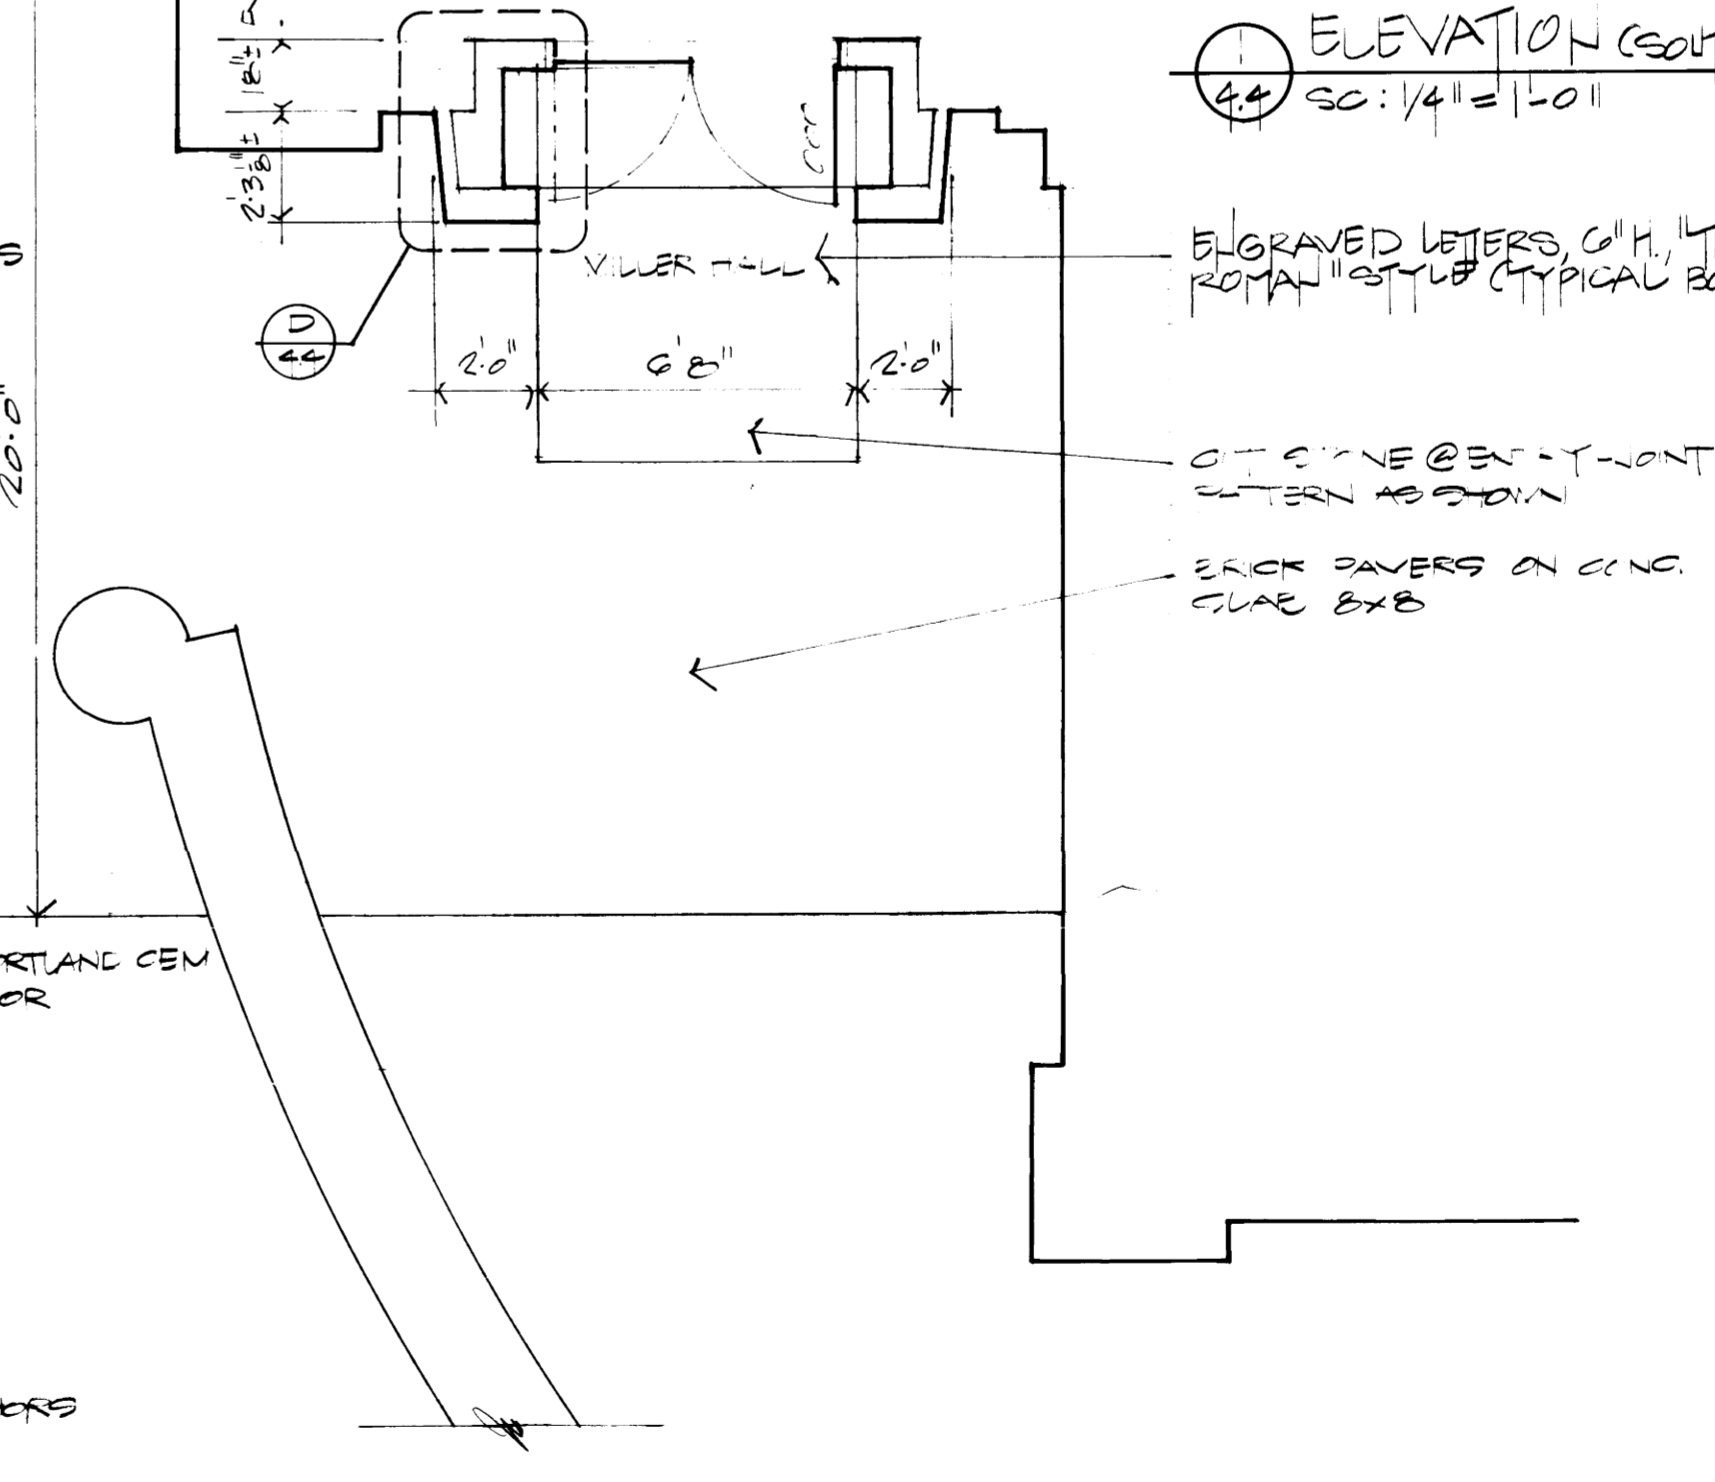

**PLAN**  
 1/4" = 1'-0"

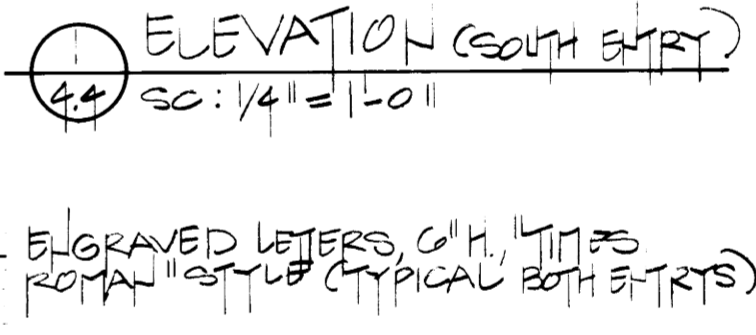

**ELEVATION (SOUTH ENTRY)**  
 1/4" = 1'-0"

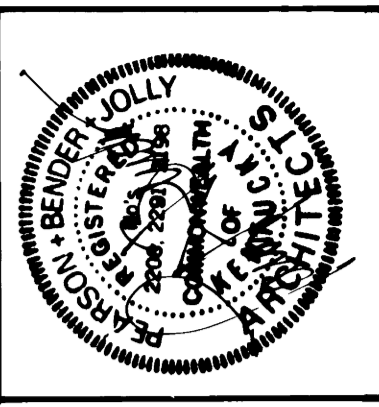

These record drawings have been prepared and furnished by Pearson + Bender + Jolly, Inc. on the basis of information compiled and furnished by the client. Pearson + Bender + Jolly, Inc. is not responsible for any errors or omissions in this record. Pearson + Bender + Jolly, Inc. is not responsible for any errors or omissions in this record. Pearson + Bender + Jolly, Inc. is not responsible for any errors or omissions in this record.

Pearson + Bender + Jolly  
 DATE: 11 NOV 94


University of Kentucky  
 Lexington, Kentucky

SIDE ENTRY + HANDRAIL DETAILS  
**MILLER HALL RENOVATION**  
 Lexington Campus Sector  
 University of Kentucky

Pearson + Bender + Jolly  
 201 Kentucky Ave  
 Lexington, KY 40502  
 606-253-1213  
 Fax: 606-253-1215

project no. 146820  
 date 20 October 1993  
 file no.  
 dr. by CM  
 ck. by LE


revisions  
**4.4**

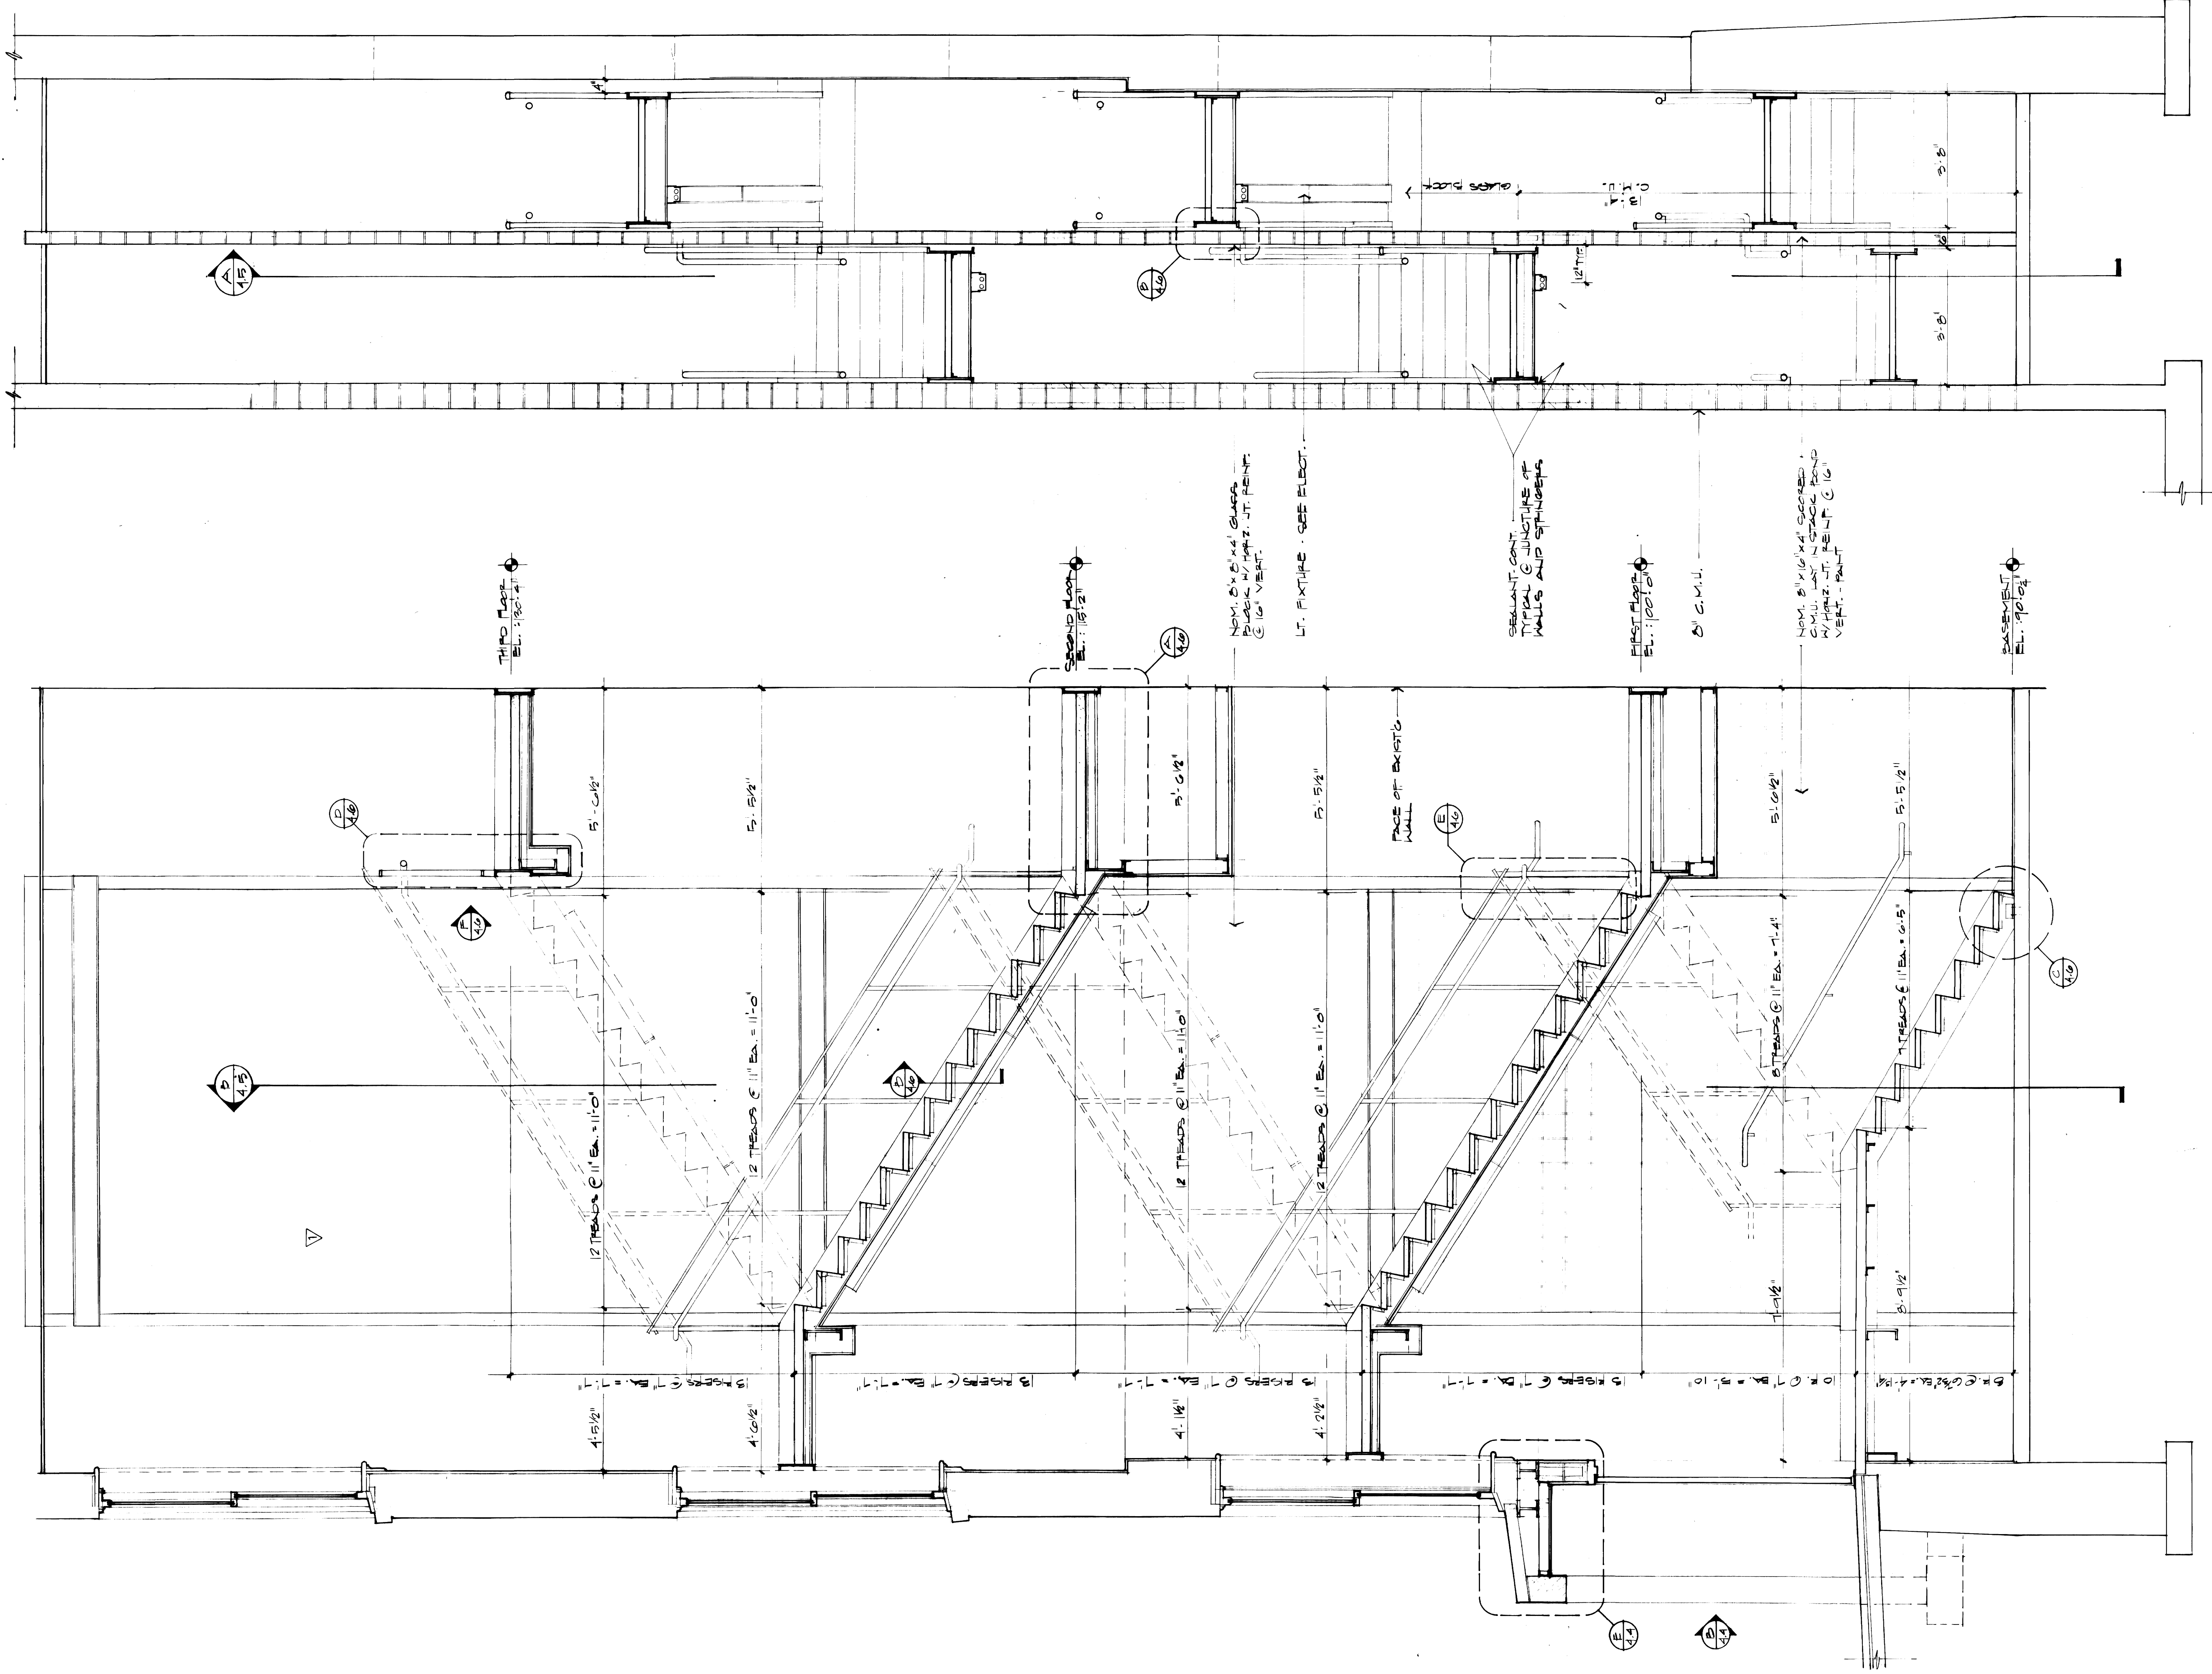

(A) STAIR SECTION  
 4/5 CC: 1/2" = 1'-0"

(B) STAIR SECTION  
 4/5 SC: 1/2" = 1'-0"

4.5  
 Sheet C-1  
 Document # 007517

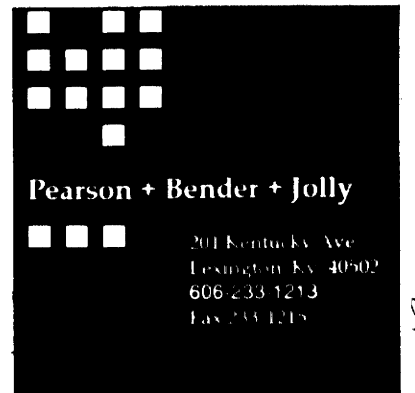

project no. 1405.0  
 date 20 AUGUST 13  
 file no.  
 dr. by YH  
 ck. by YP

revisions

STAIR SECTIONS  
**MILLER HALL RENOVATION**  
 Lexington Campus Sector  
 University of Kentucky



University of Kentucky  
 Lexington, Kentucky  
 prepared by UNIVERSITY OF KENTUCKY ARCHITECTURE  
 Pearson + Bender + Jolly  
 DATE: NOV 14

These sealed drawings have been prepared, in part, on the basis of information furnished by others. The architect will not be responsible for errors or omissions which have been incorporated into this document as a result.

PEARSON + BENDER + JOLLY  
 ARCHITECTS  
 201 KENTUCKY AVE.  
 LEXINGTON, KY 40502  
 606.255.7273  
 FAX 606.255.7113



WINDOW TYPES FIELD VERIFY ALL DIMENSIONS

HORIZONTAL BLINDS & WINDOWS, TYPICAL

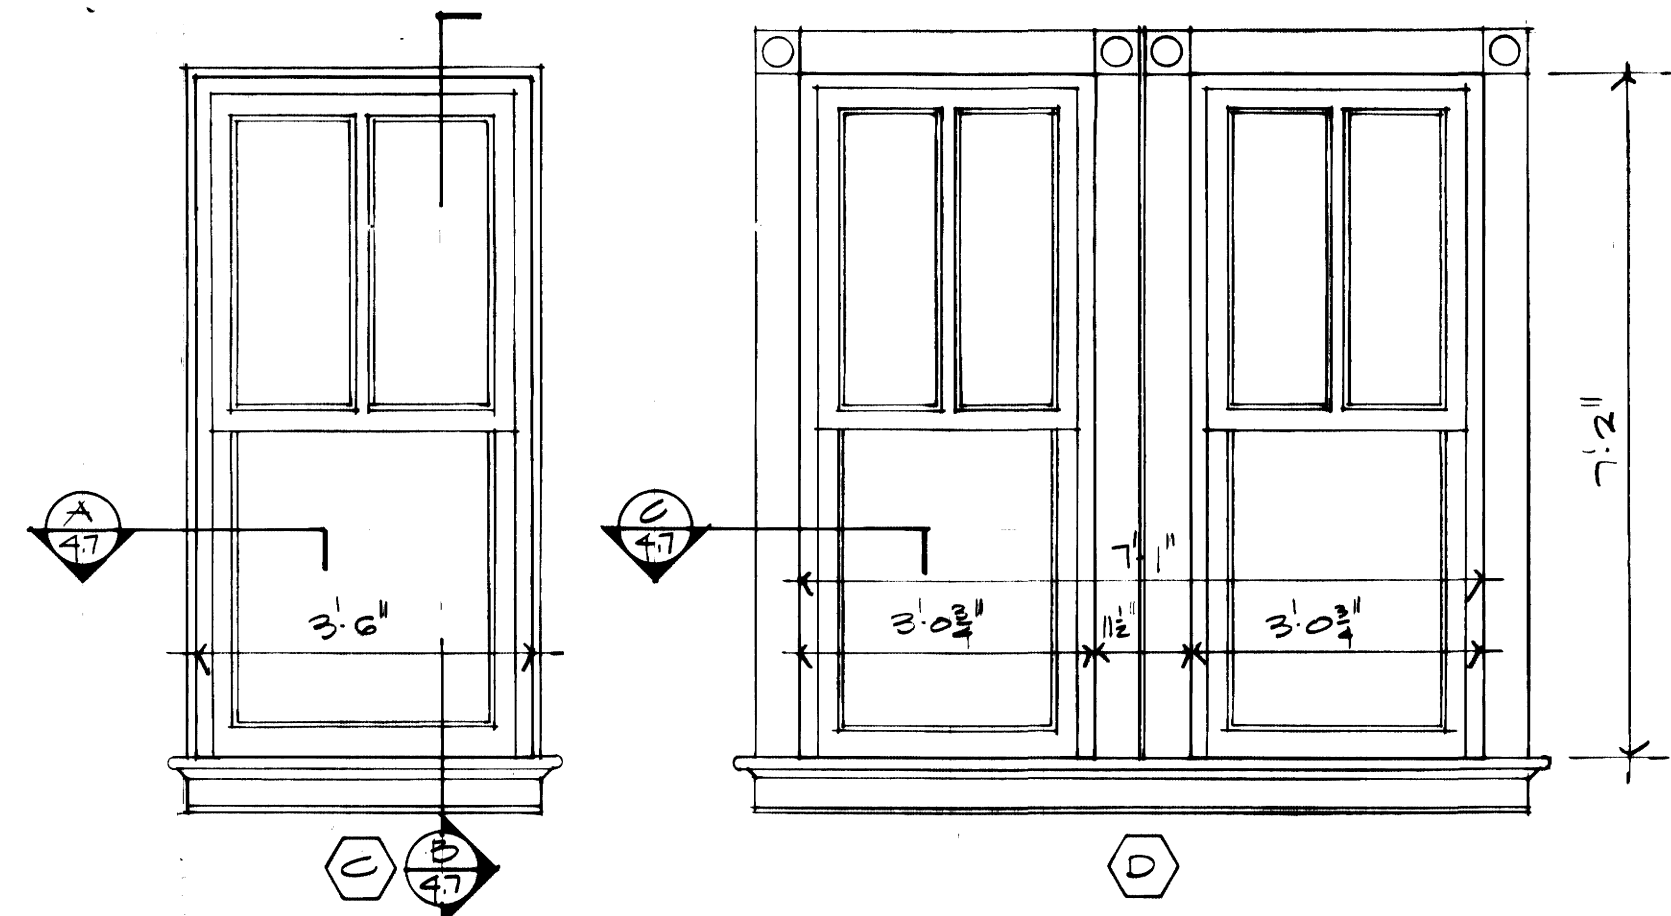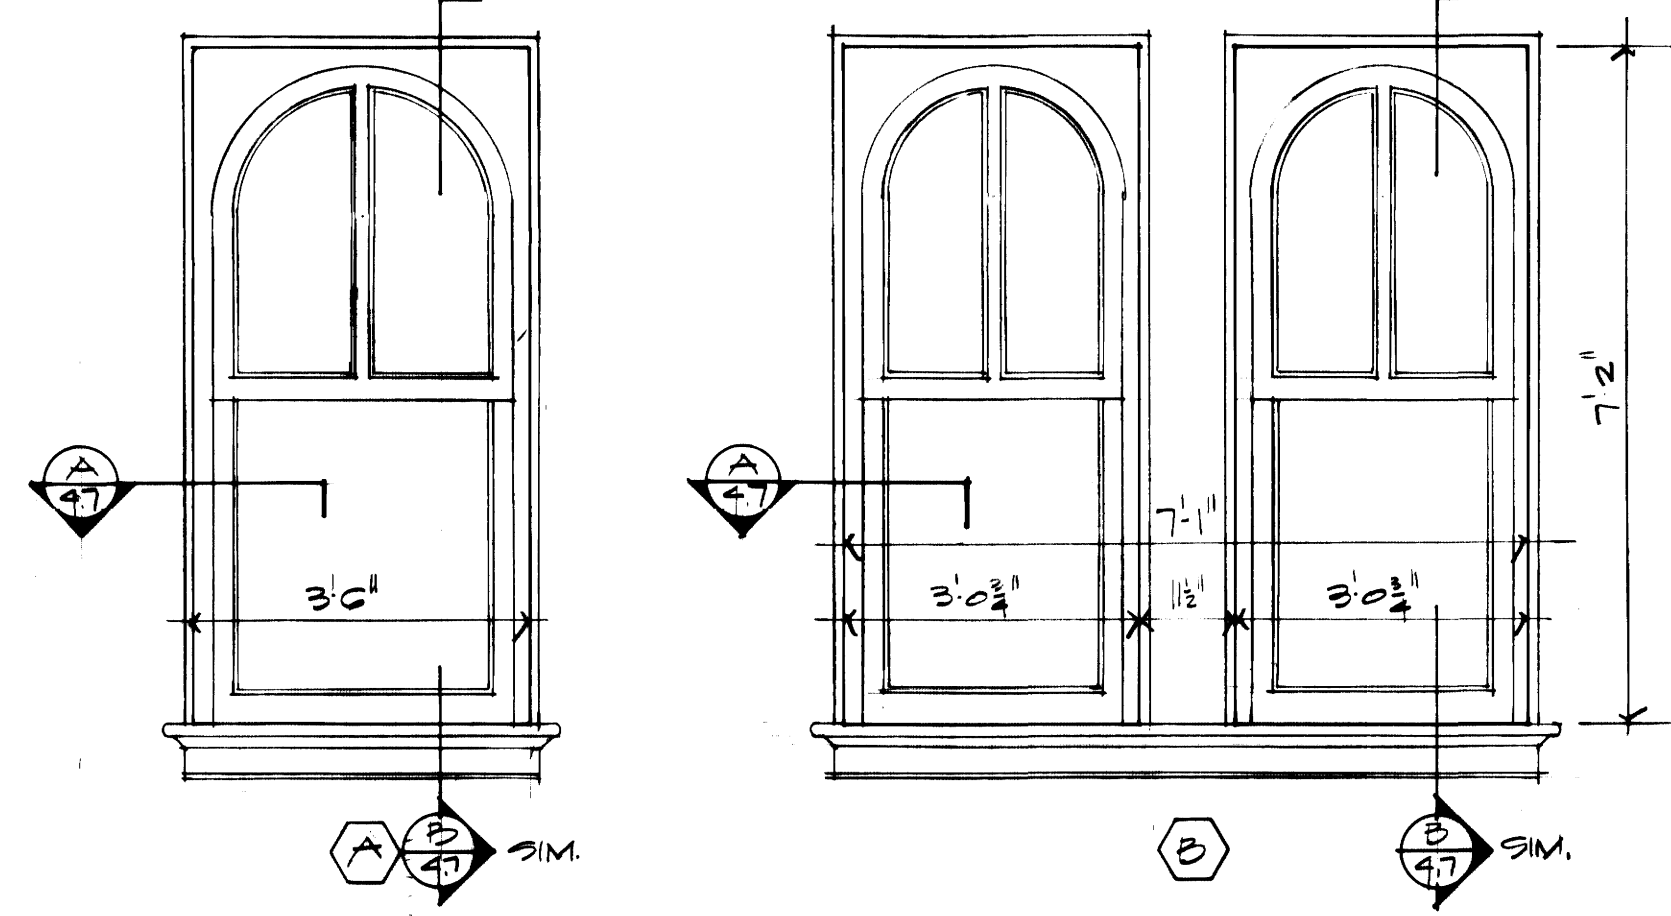


SECOND FLOOR TRIMS SHOWN - EXISTING TO BE REUSED

THIRD FLOOR TRIMS TO BE SIMILAR TO DETAILS A/47 + B/47

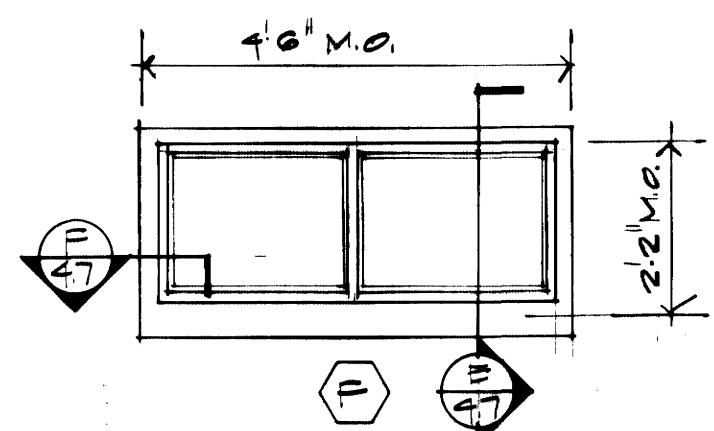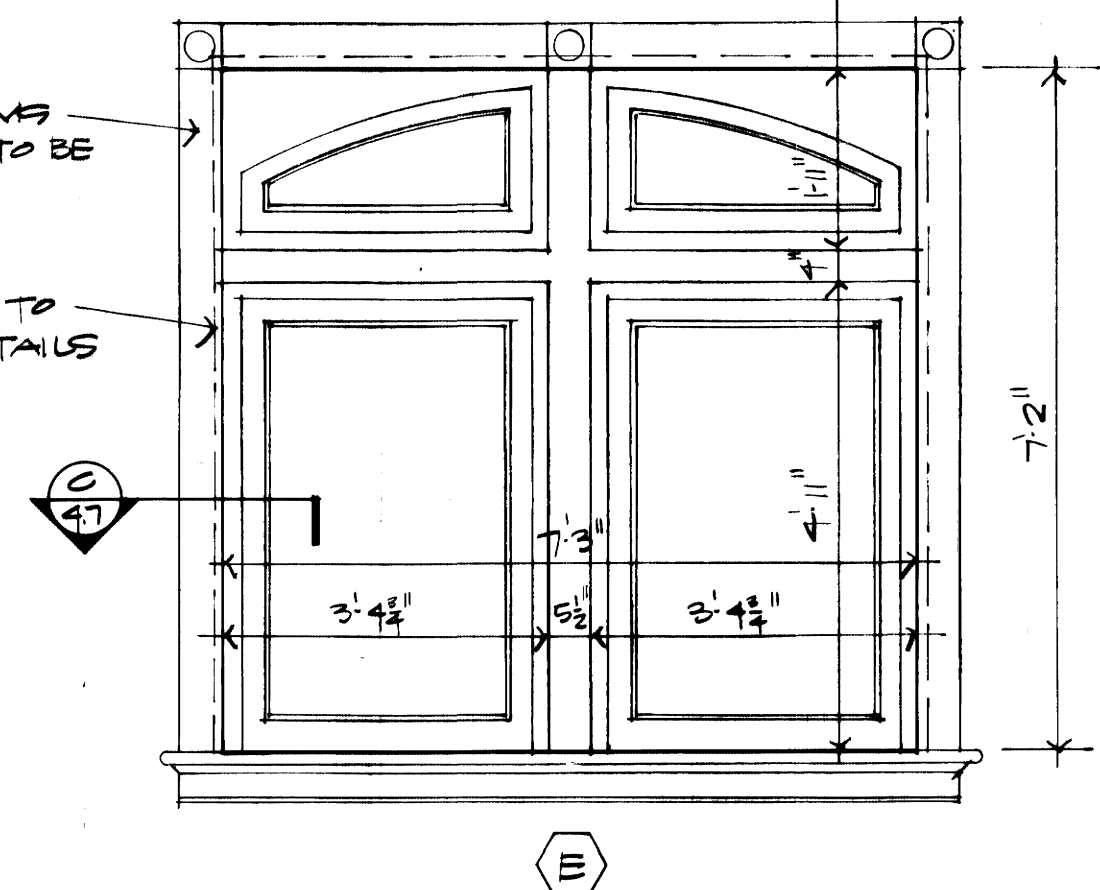


NOTE: PROVIDE CURVED LINTEL @ RM 0004.

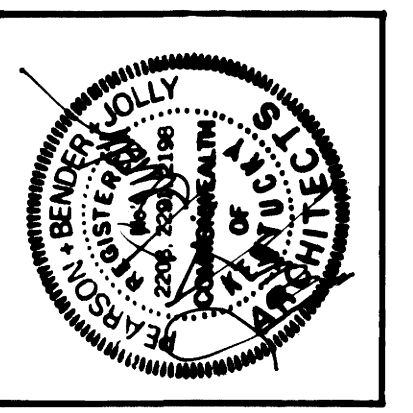


University of Kentucky  
Lexington, Kentucky  
ISSUED BY: OFFICIAL BIDDING DOCUMENT

WINDOW DETAILS  
**MILLER HALL RENOVATION**  
Lexington Campus Sector  
University of Kentucky

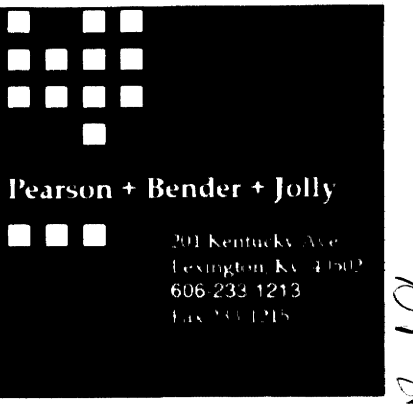

project no. 1465.0  
date 20 AUGUST 93  
file no.  
dr. by CM  
ck. by LB


revisions  
**4.7**

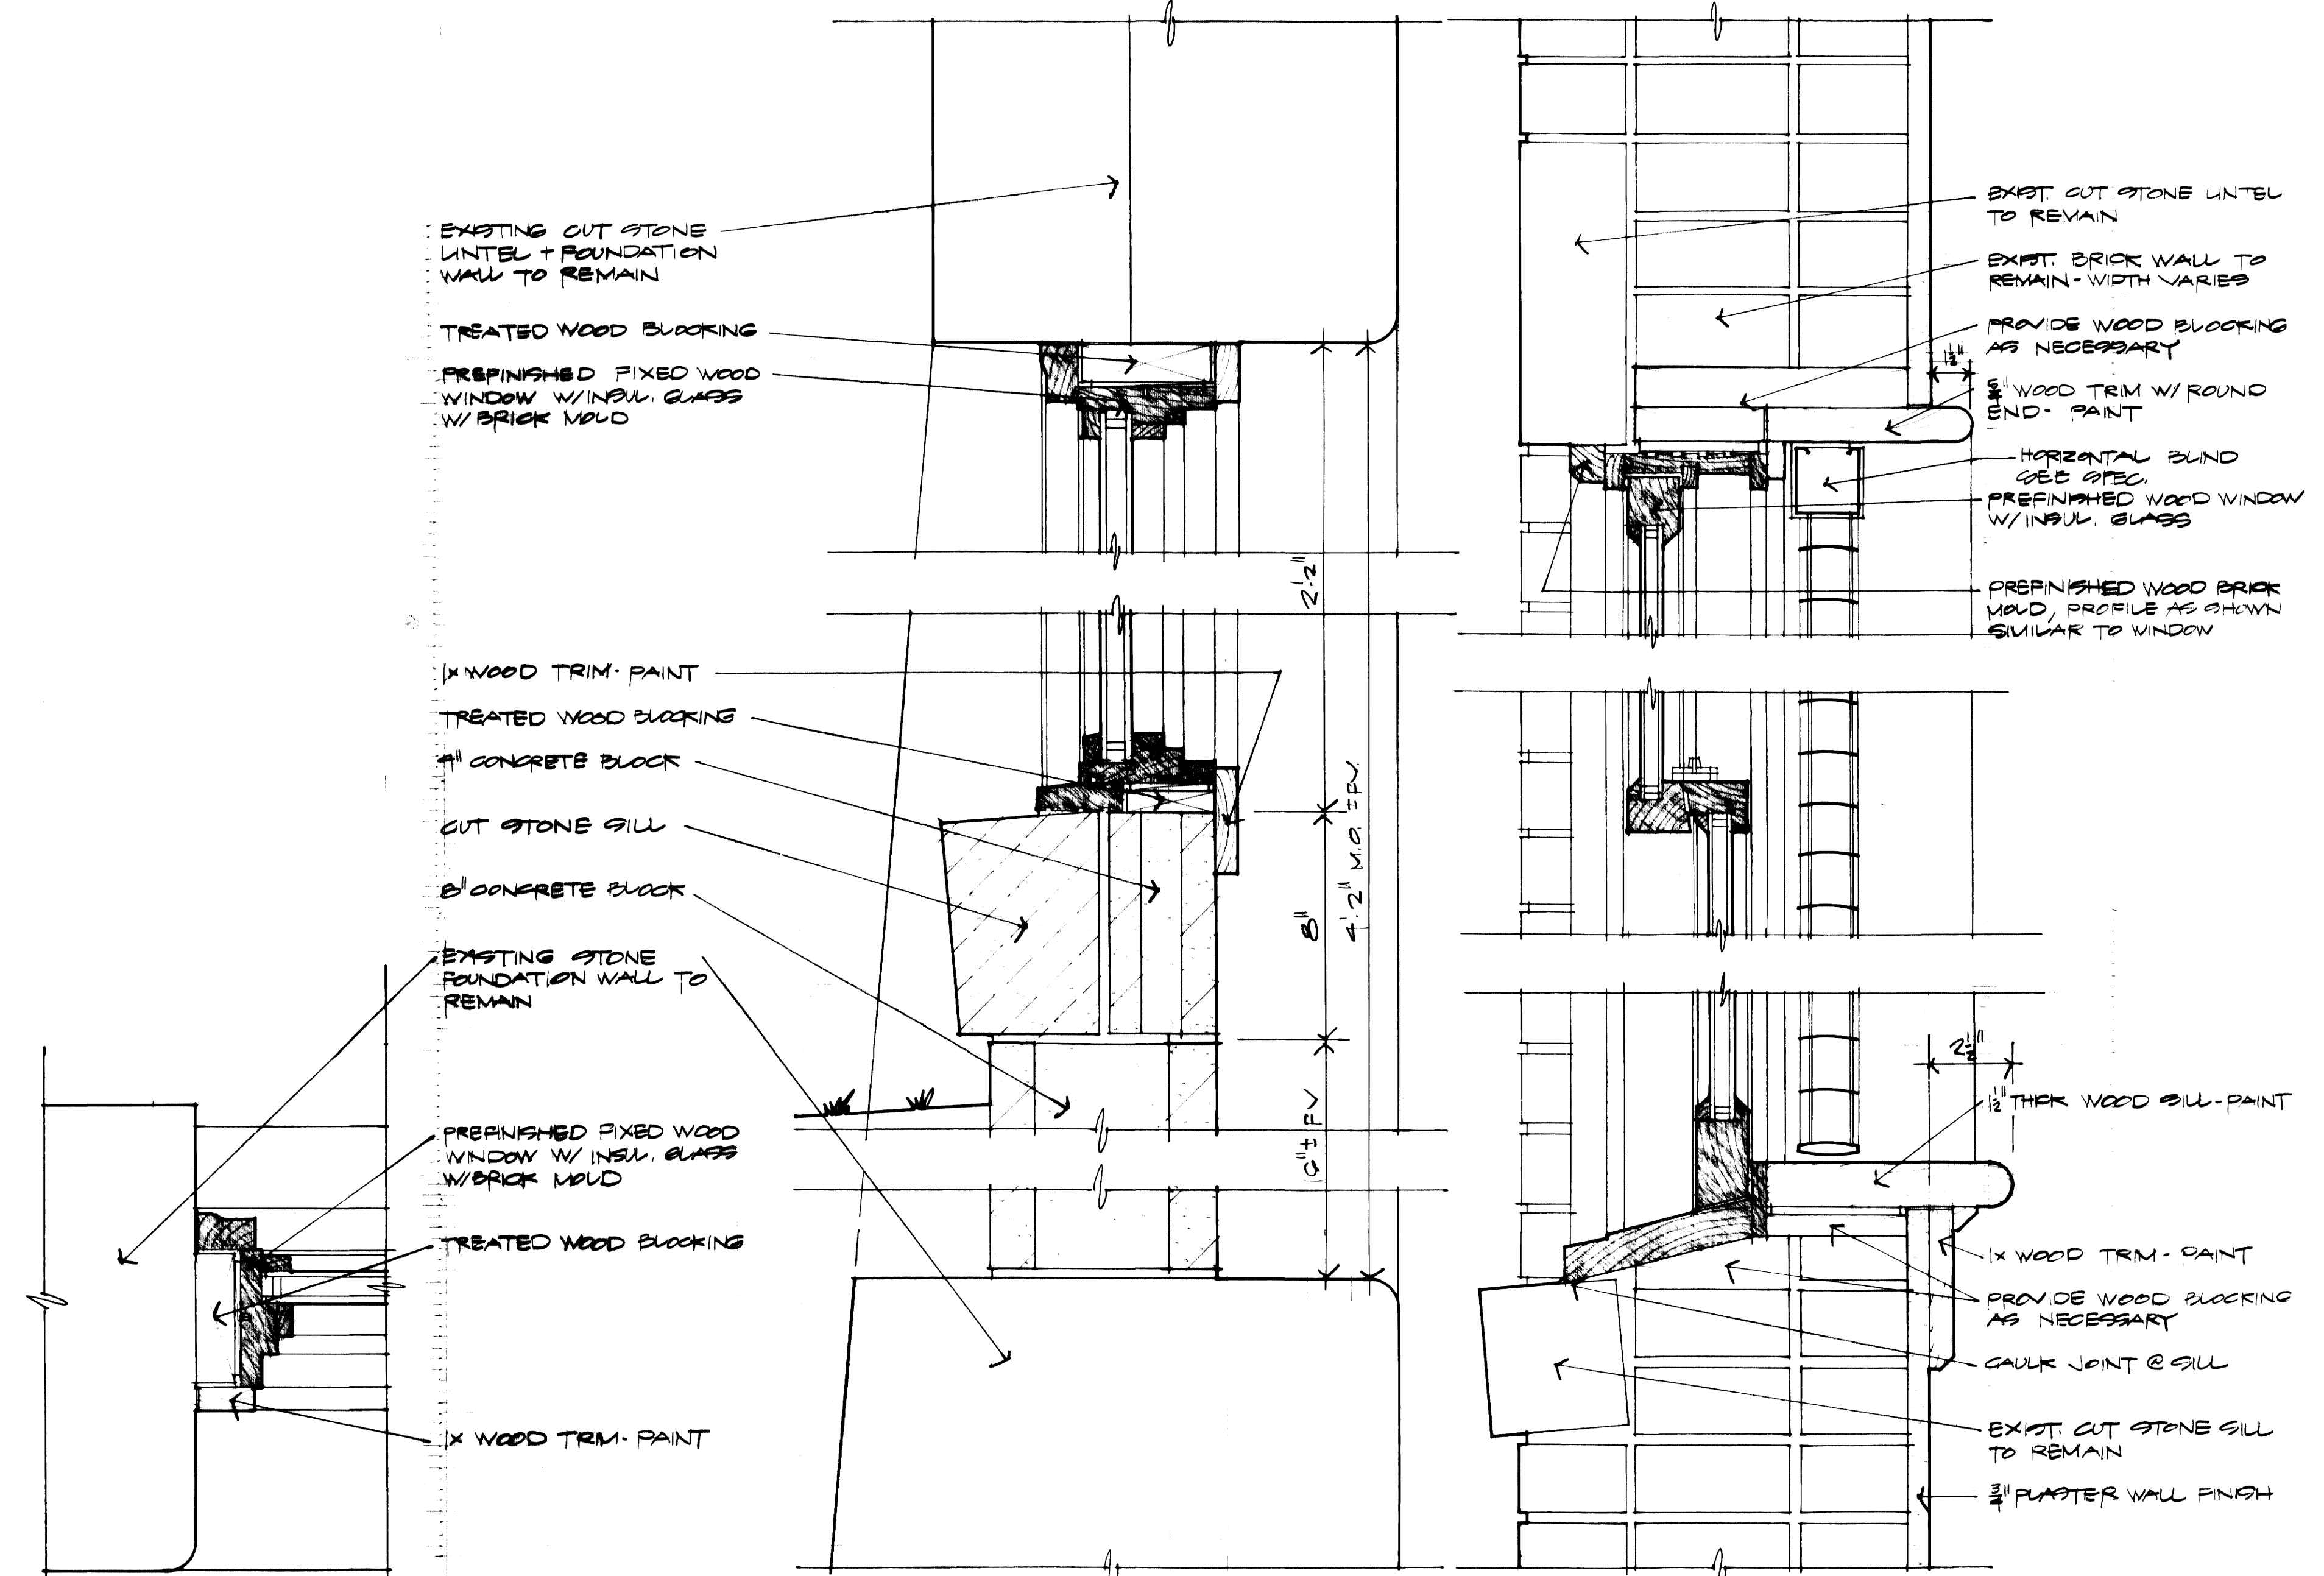


**F JAMB**  
47 3' = 1'-0"

**B HEAD + SILL**  
47 3' = 1'-0"


**B HEAD + SILL**  
47 3' = 1'-0"

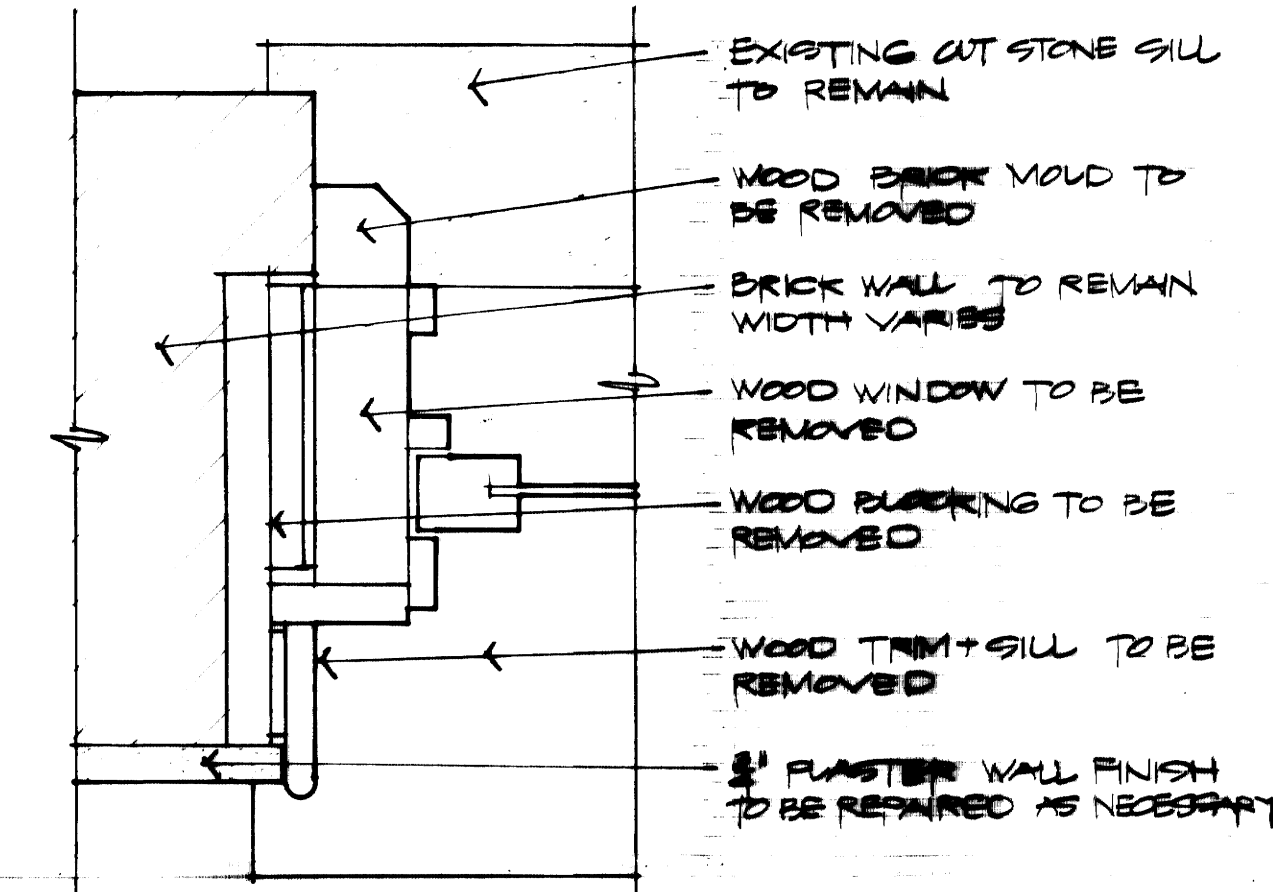

**D DEMOLITION DETAIL EXISTING JAMB**  
47 3' = 1'-0"

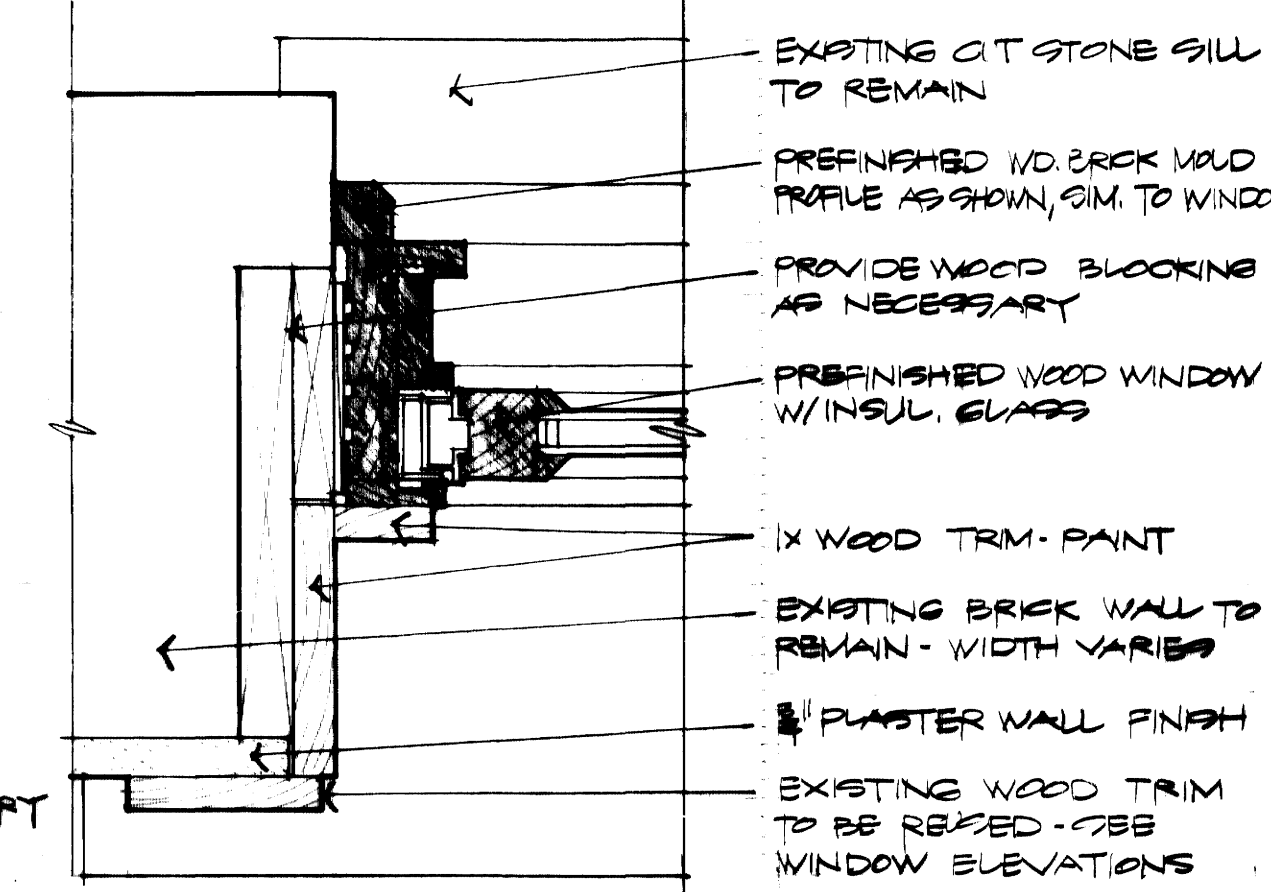


**C JAMB**  
47 3' = 1'-0"

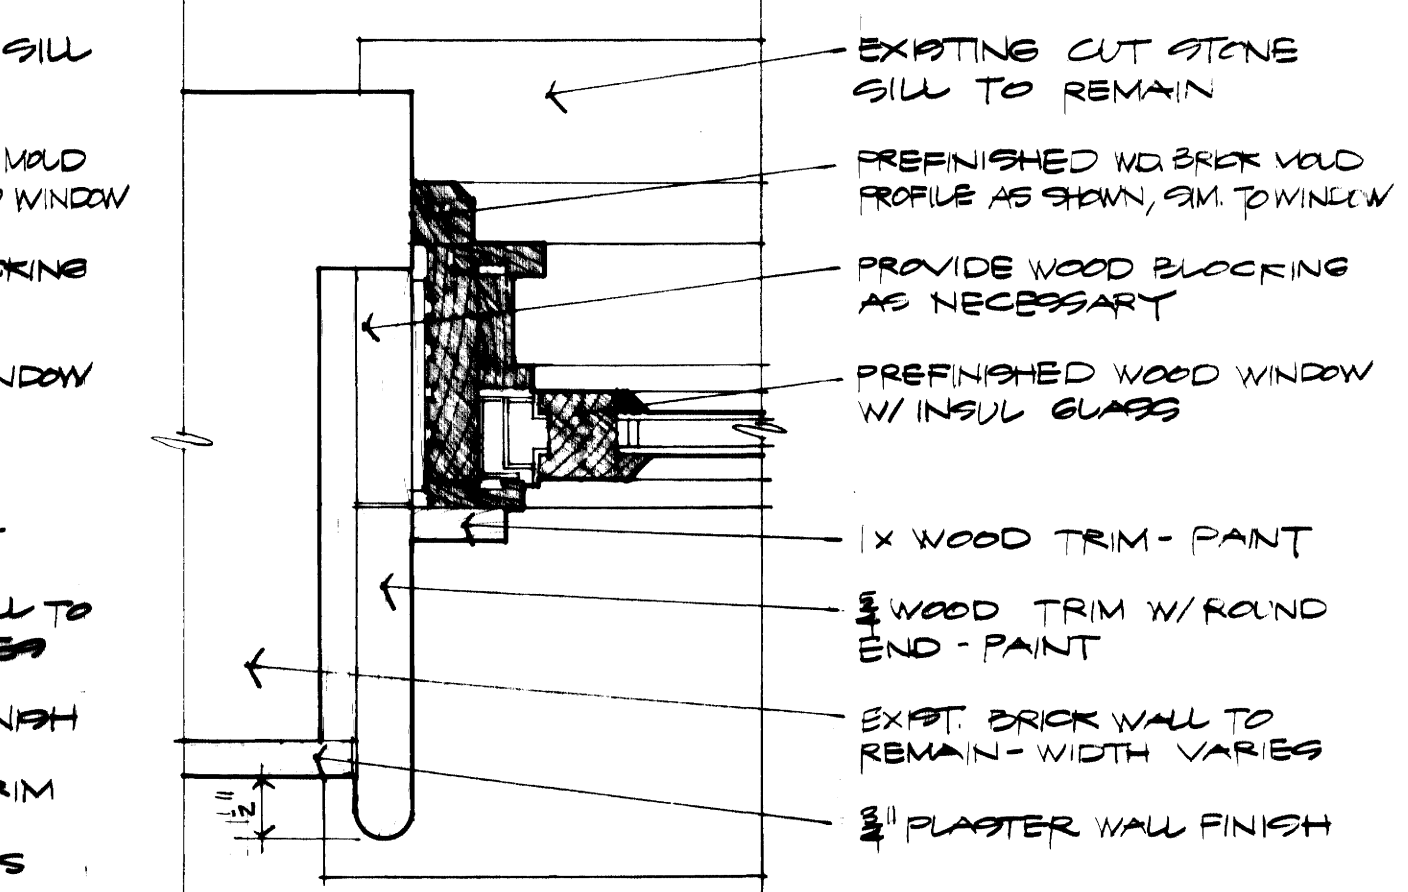


**A JAMB**  
47 3' = 1'-0"

00 13 19  
007319  
C-1



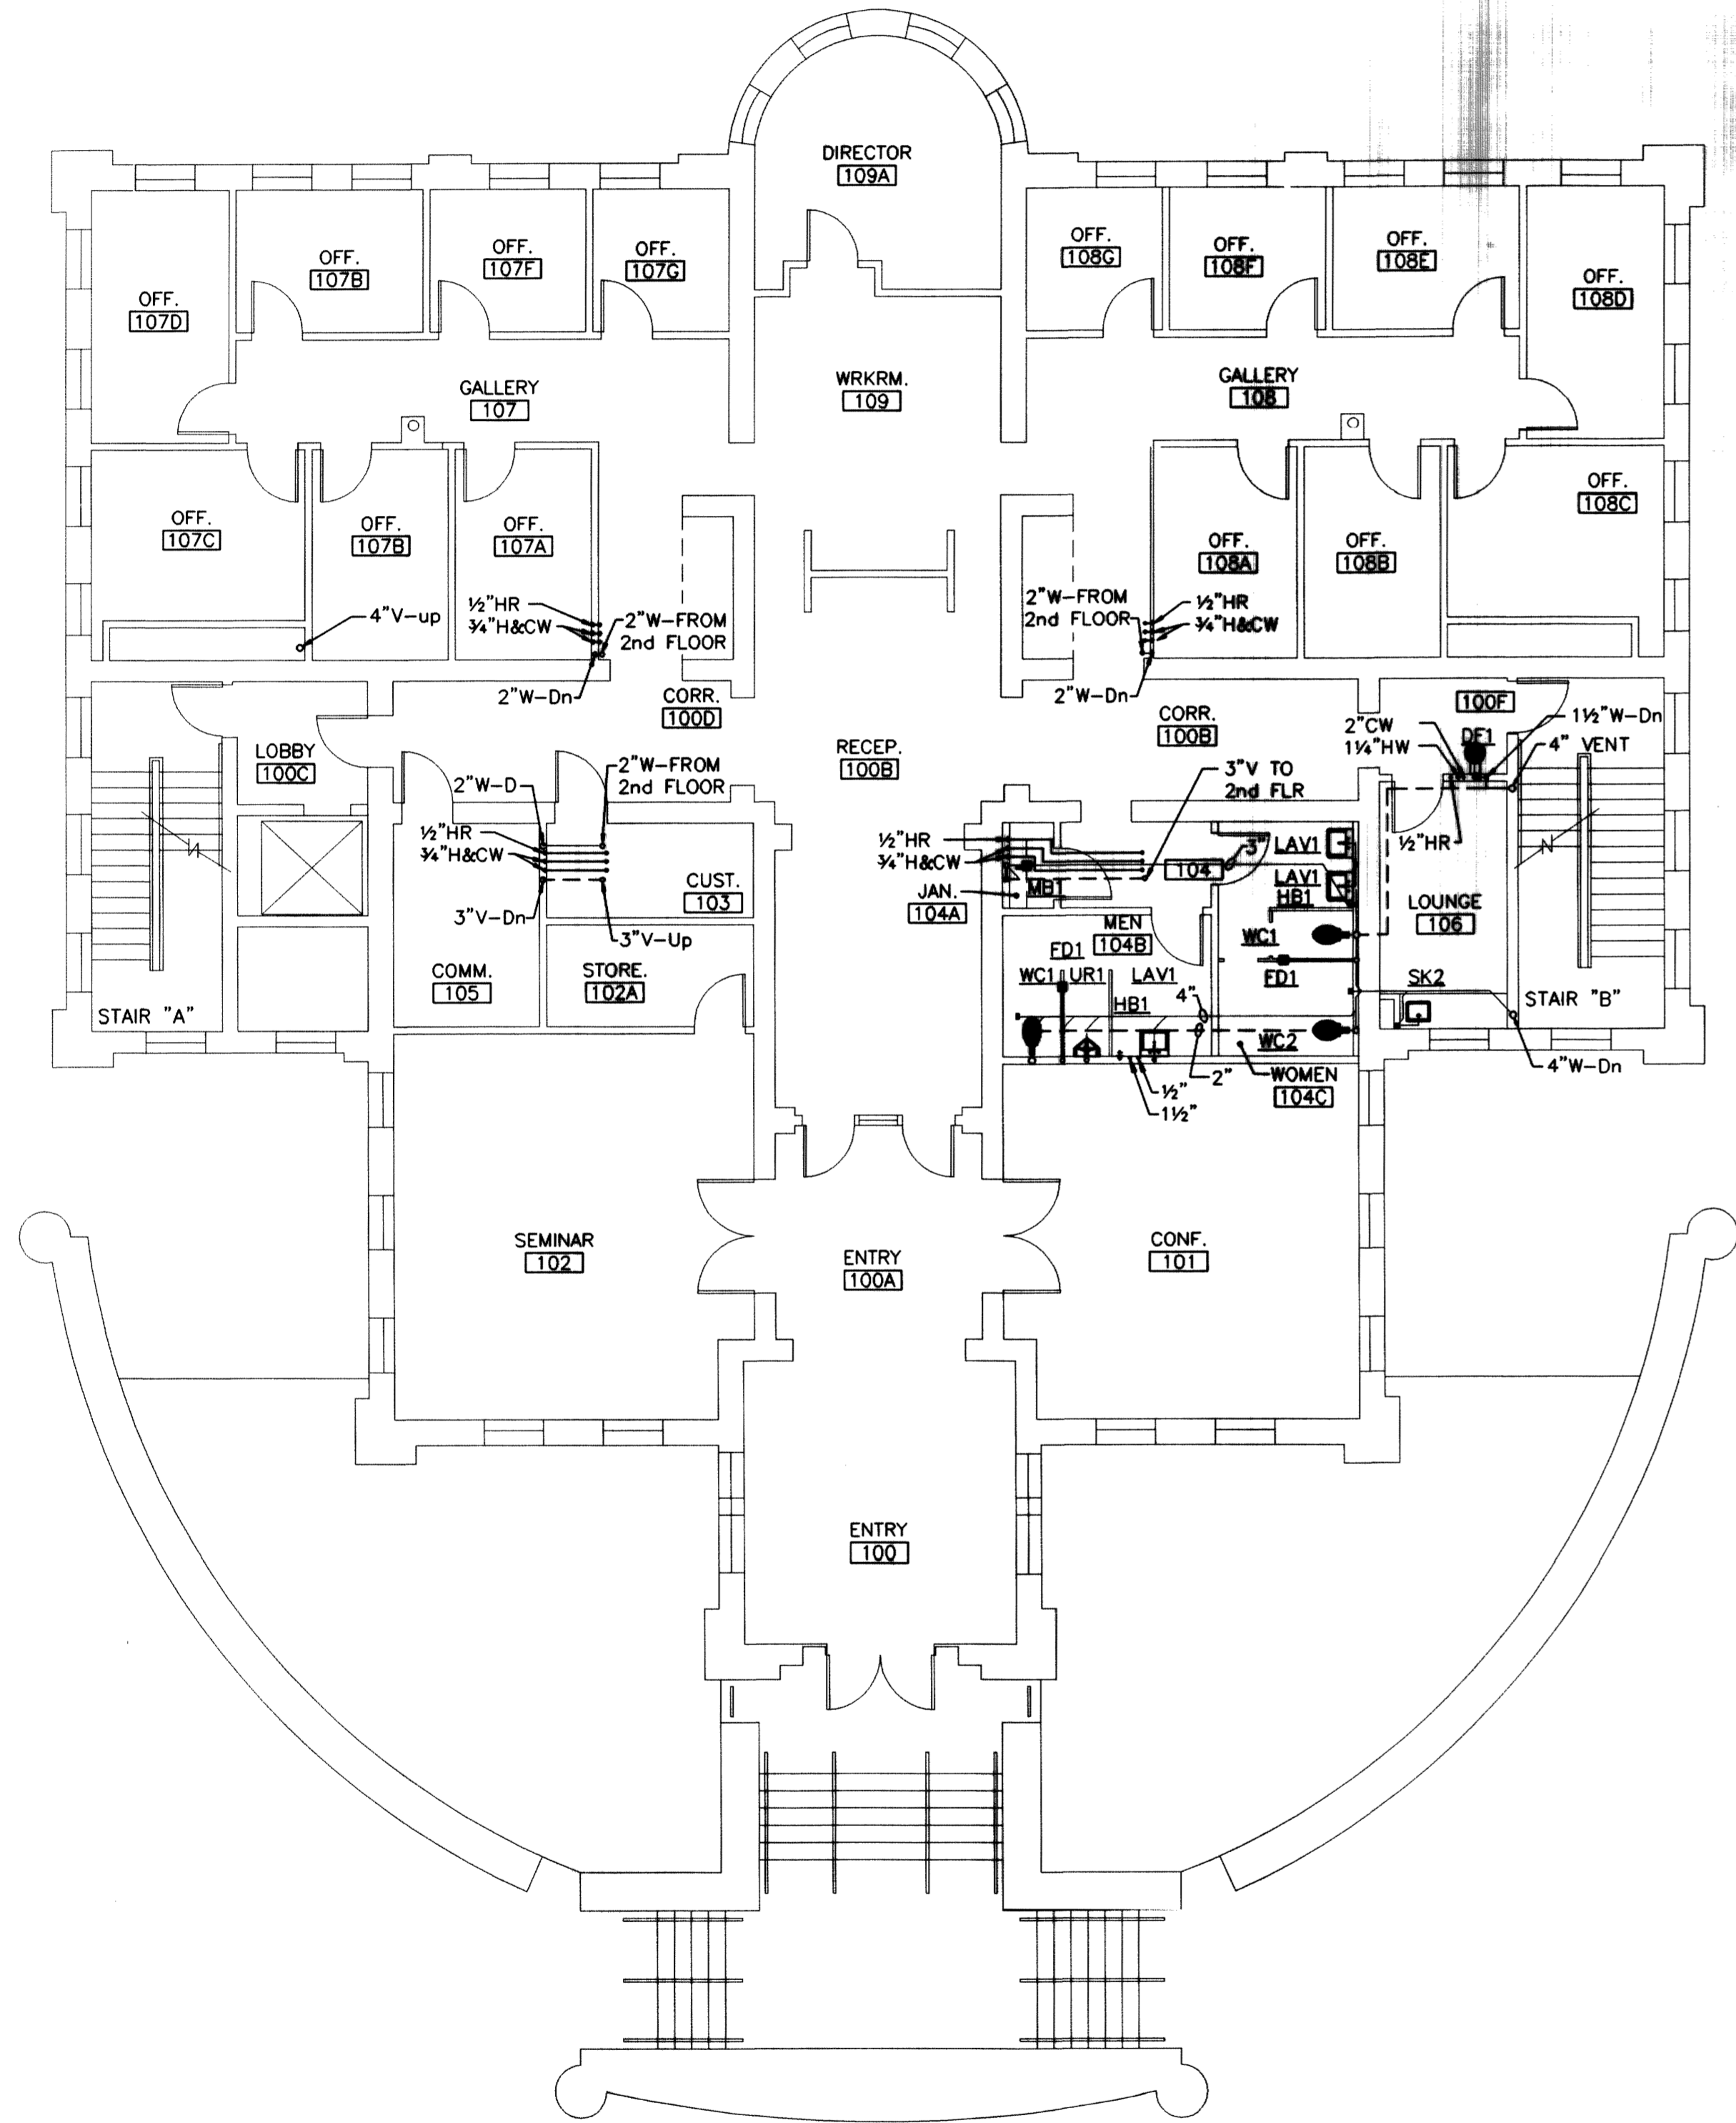

FIRST FLOOR PLUMBING PLAN  
SCALE: 1/8"=1'-0"

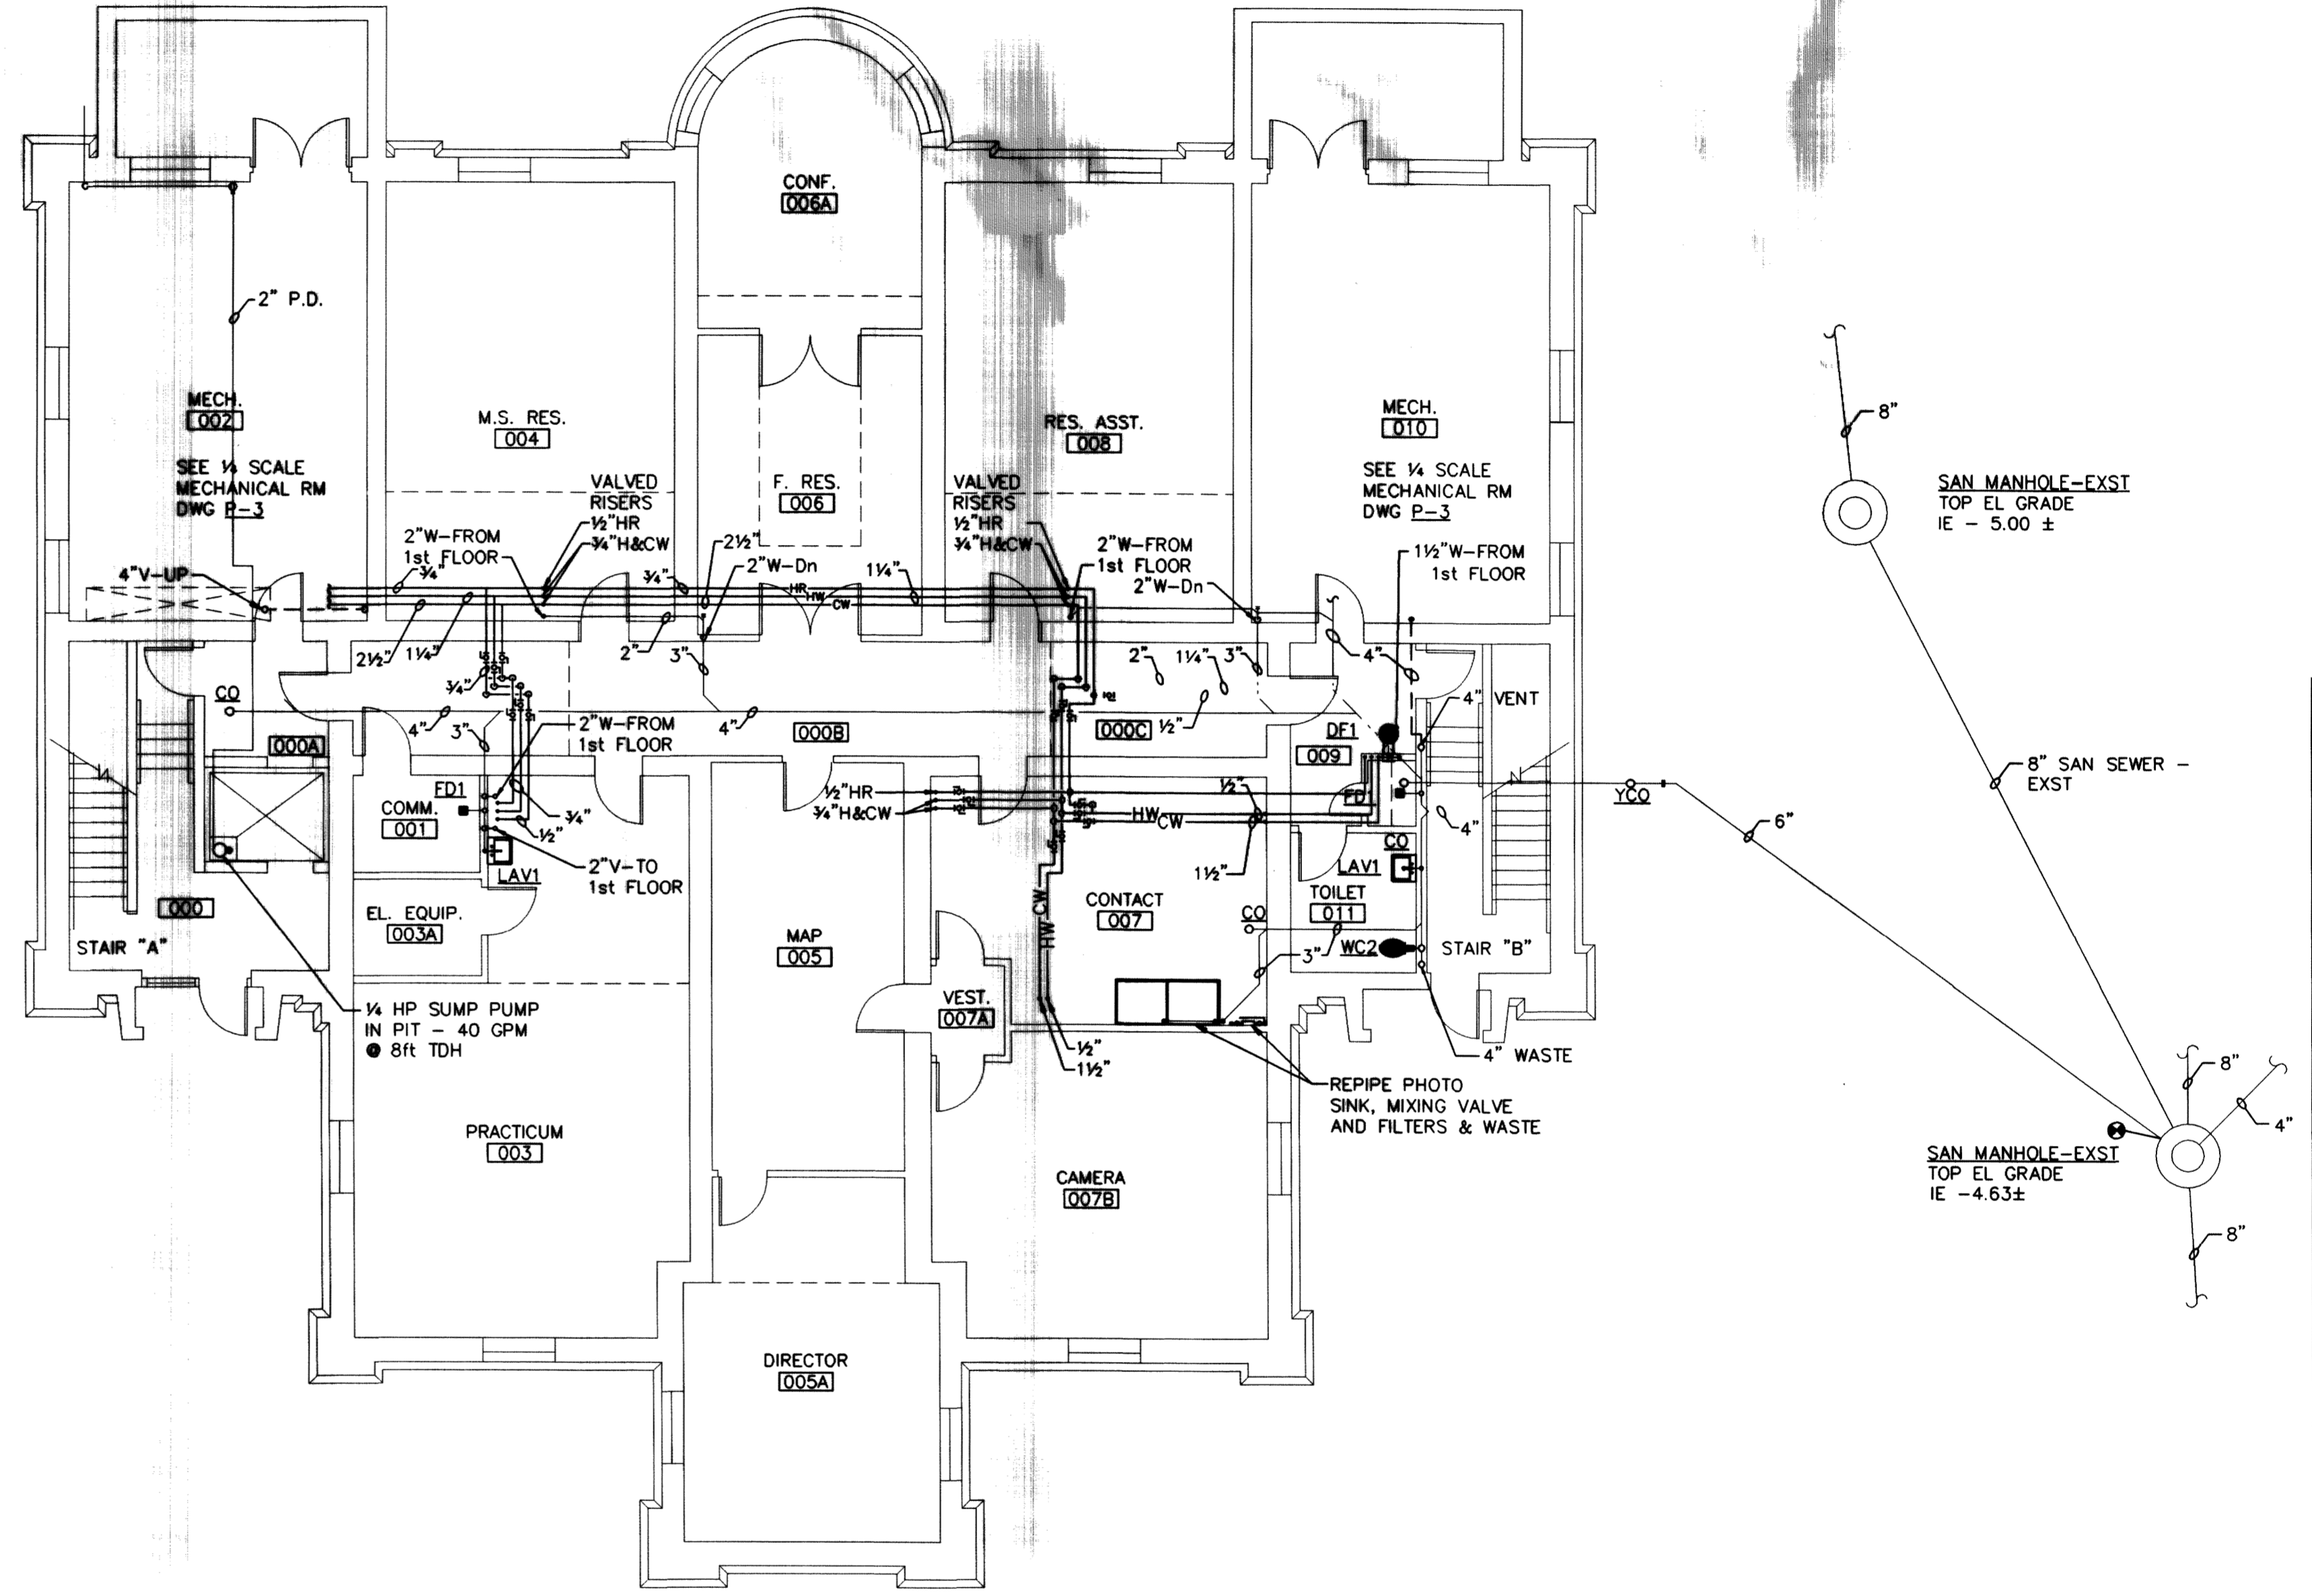

BASEMENT PLUMBING PLAN  
SCALE: 1/8"=1'-0"

NOTE:  
COORDINATE INSTALLATION OF ALL SYSTEMS WITH MECHANICAL (HVAC) SYSTEMS. CEILING CAVITY SPACE IS RESTRICTED AND INSTALLATION OF DUCTWORK SHALL TAKE PRIORITY OVER ALL TRADES. NO EXTRA COMPENSATION WILL BE ALLOWED TO COVER COST OF RELOCATING SYSTEMS FOUND ENCRoACHING ON SPACE REQUIRED BY MECHANICAL, (HVAC) SYSTEMS.

**AS BUILT**  
DATE 4-15-95

Biagi, Chance, Cummins,  
London, Titzer, Inc.  
Consulting Engineers  
423 Main St.  
Shelbyville, Kentucky 40065


University of Kentucky  
Lexington, Kentucky  
approved by \_\_\_\_\_ date \_\_\_\_\_  
Director - capital projects management

BASEMENT & FIRST FLOOR PLUMBING PLANS  
**MILLER HALL RENOVATION**  
Lexington Campus Sector  
University of Kentucky


Project #	1465
Date	20 AUGUST 93
File no.	93502P01
Dr. by	JWR/HWD
Ck. by	CGG/JKL
Revisions	

Sheet	C-1
Document #	007538

P-1

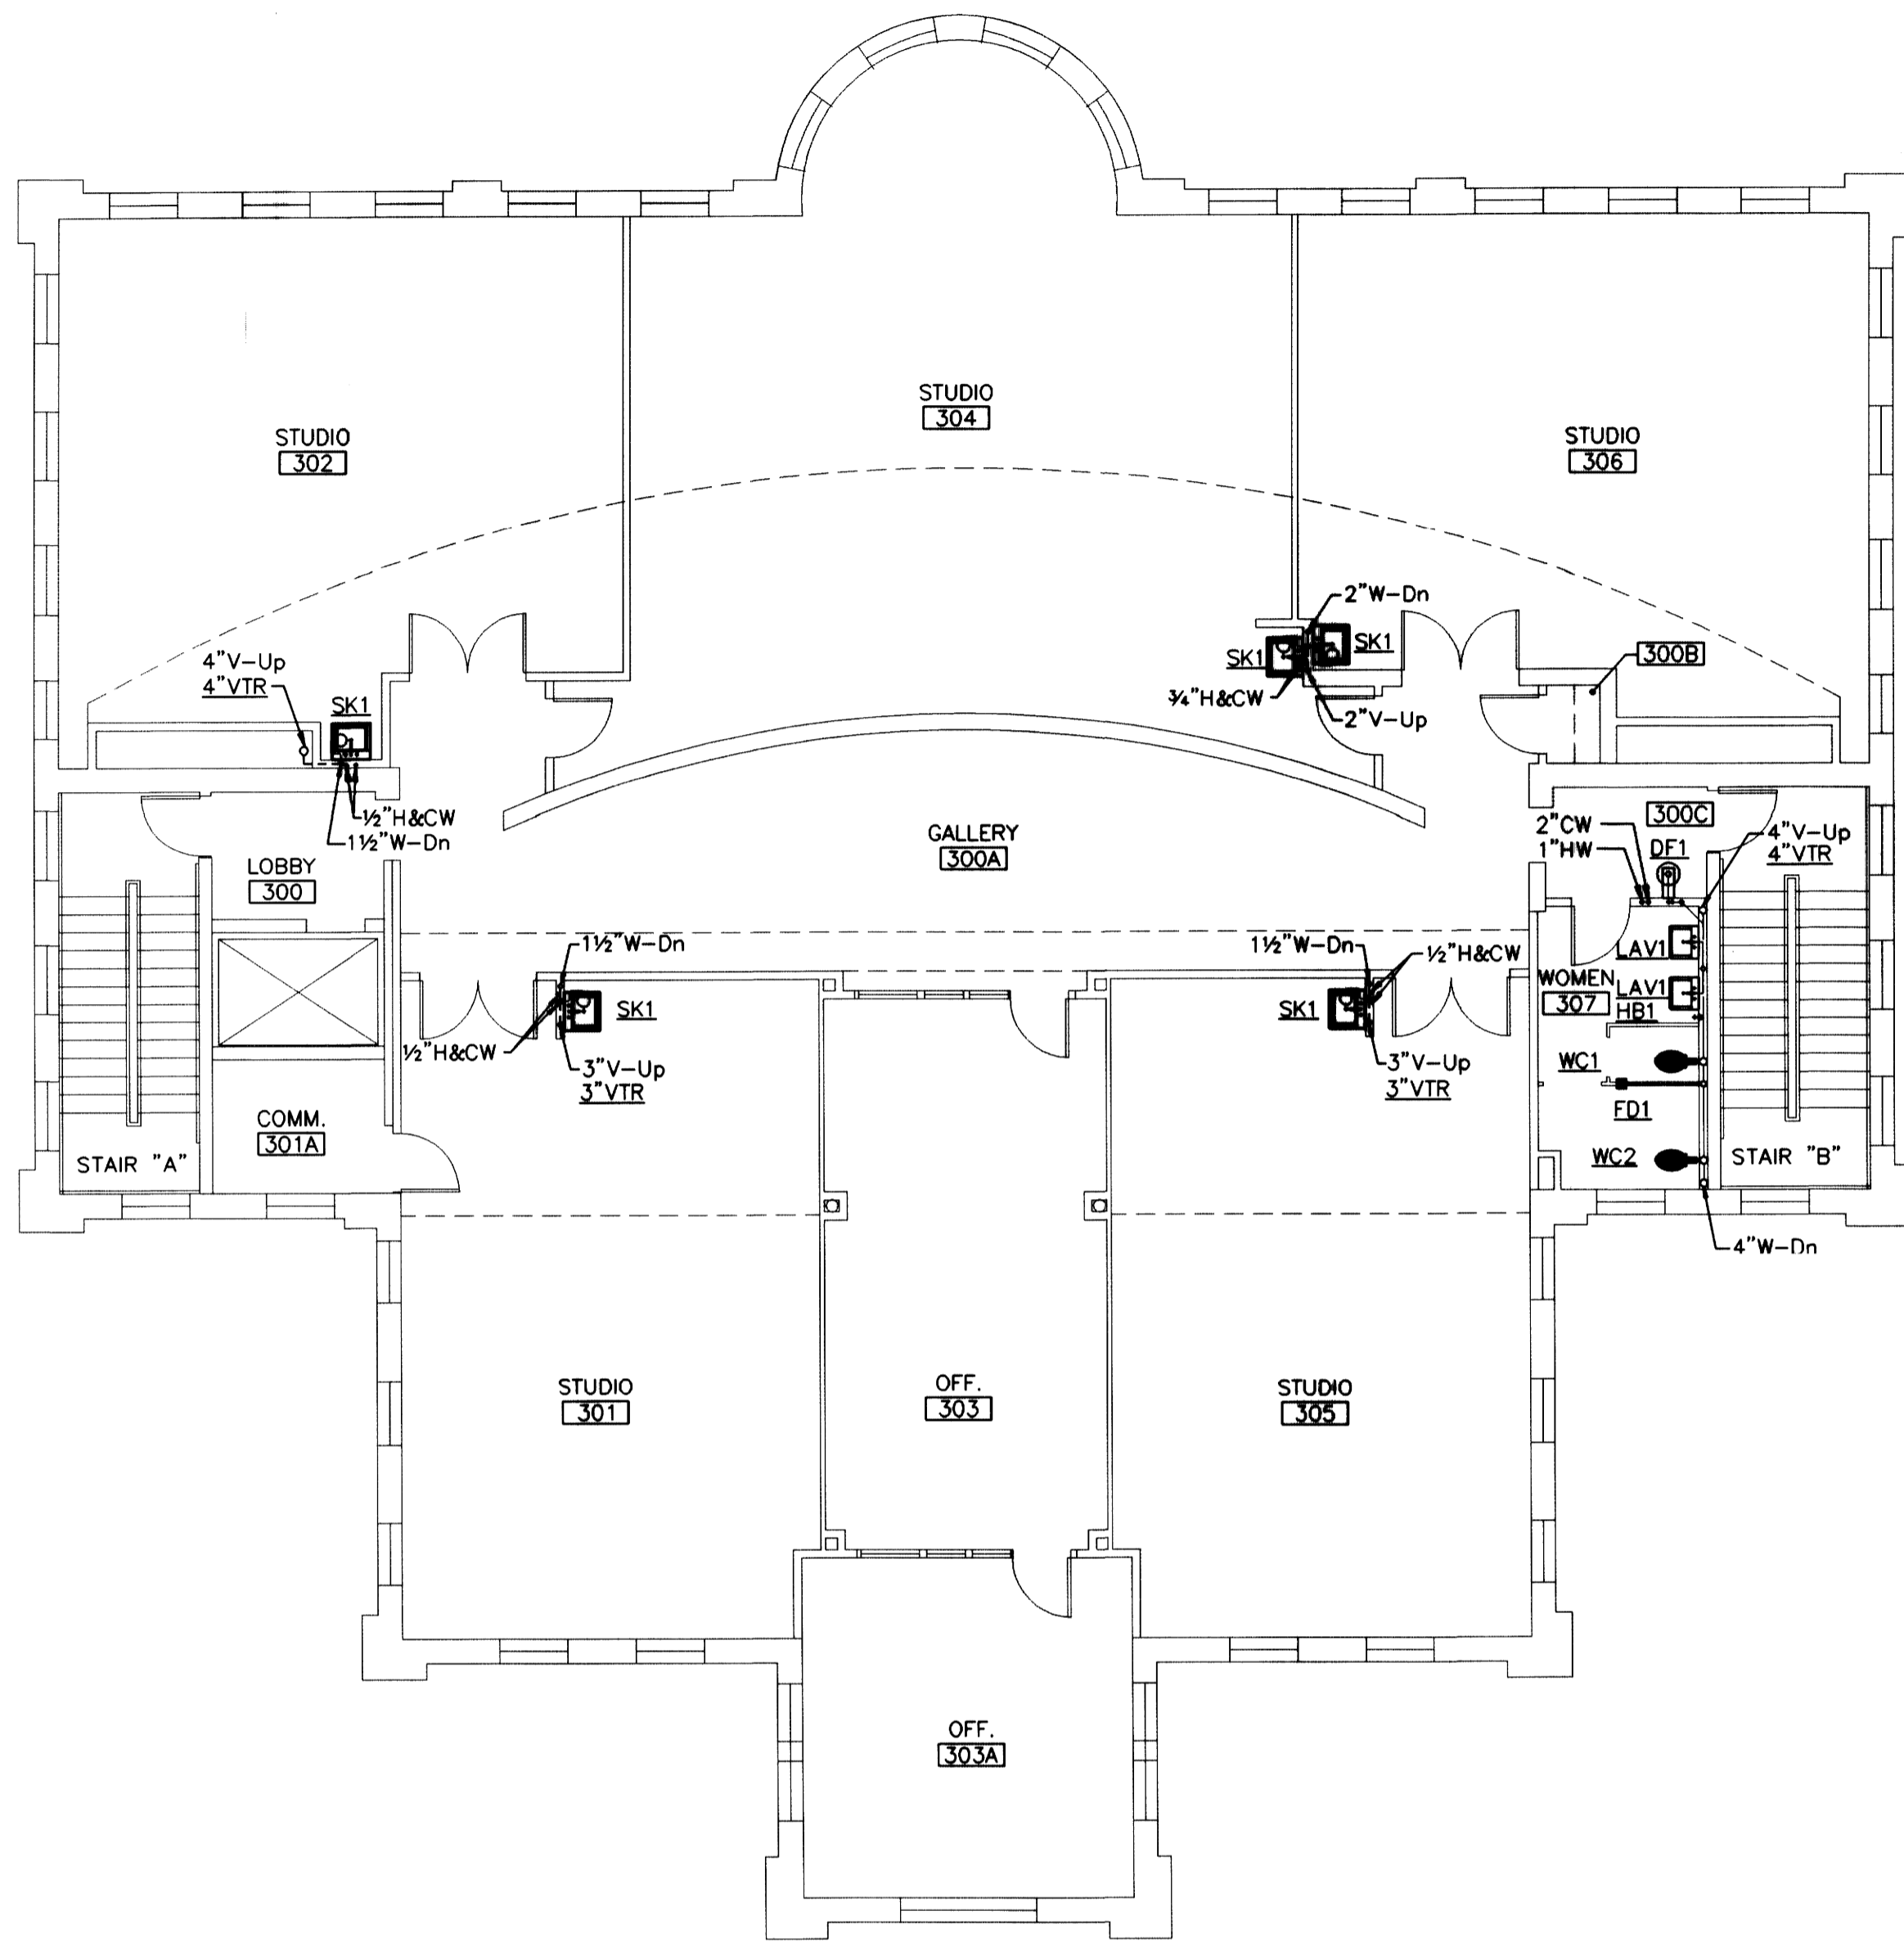

THIRD FLOOR PLUMBING PLAN  
SCALE: 1/8"=1'-0"

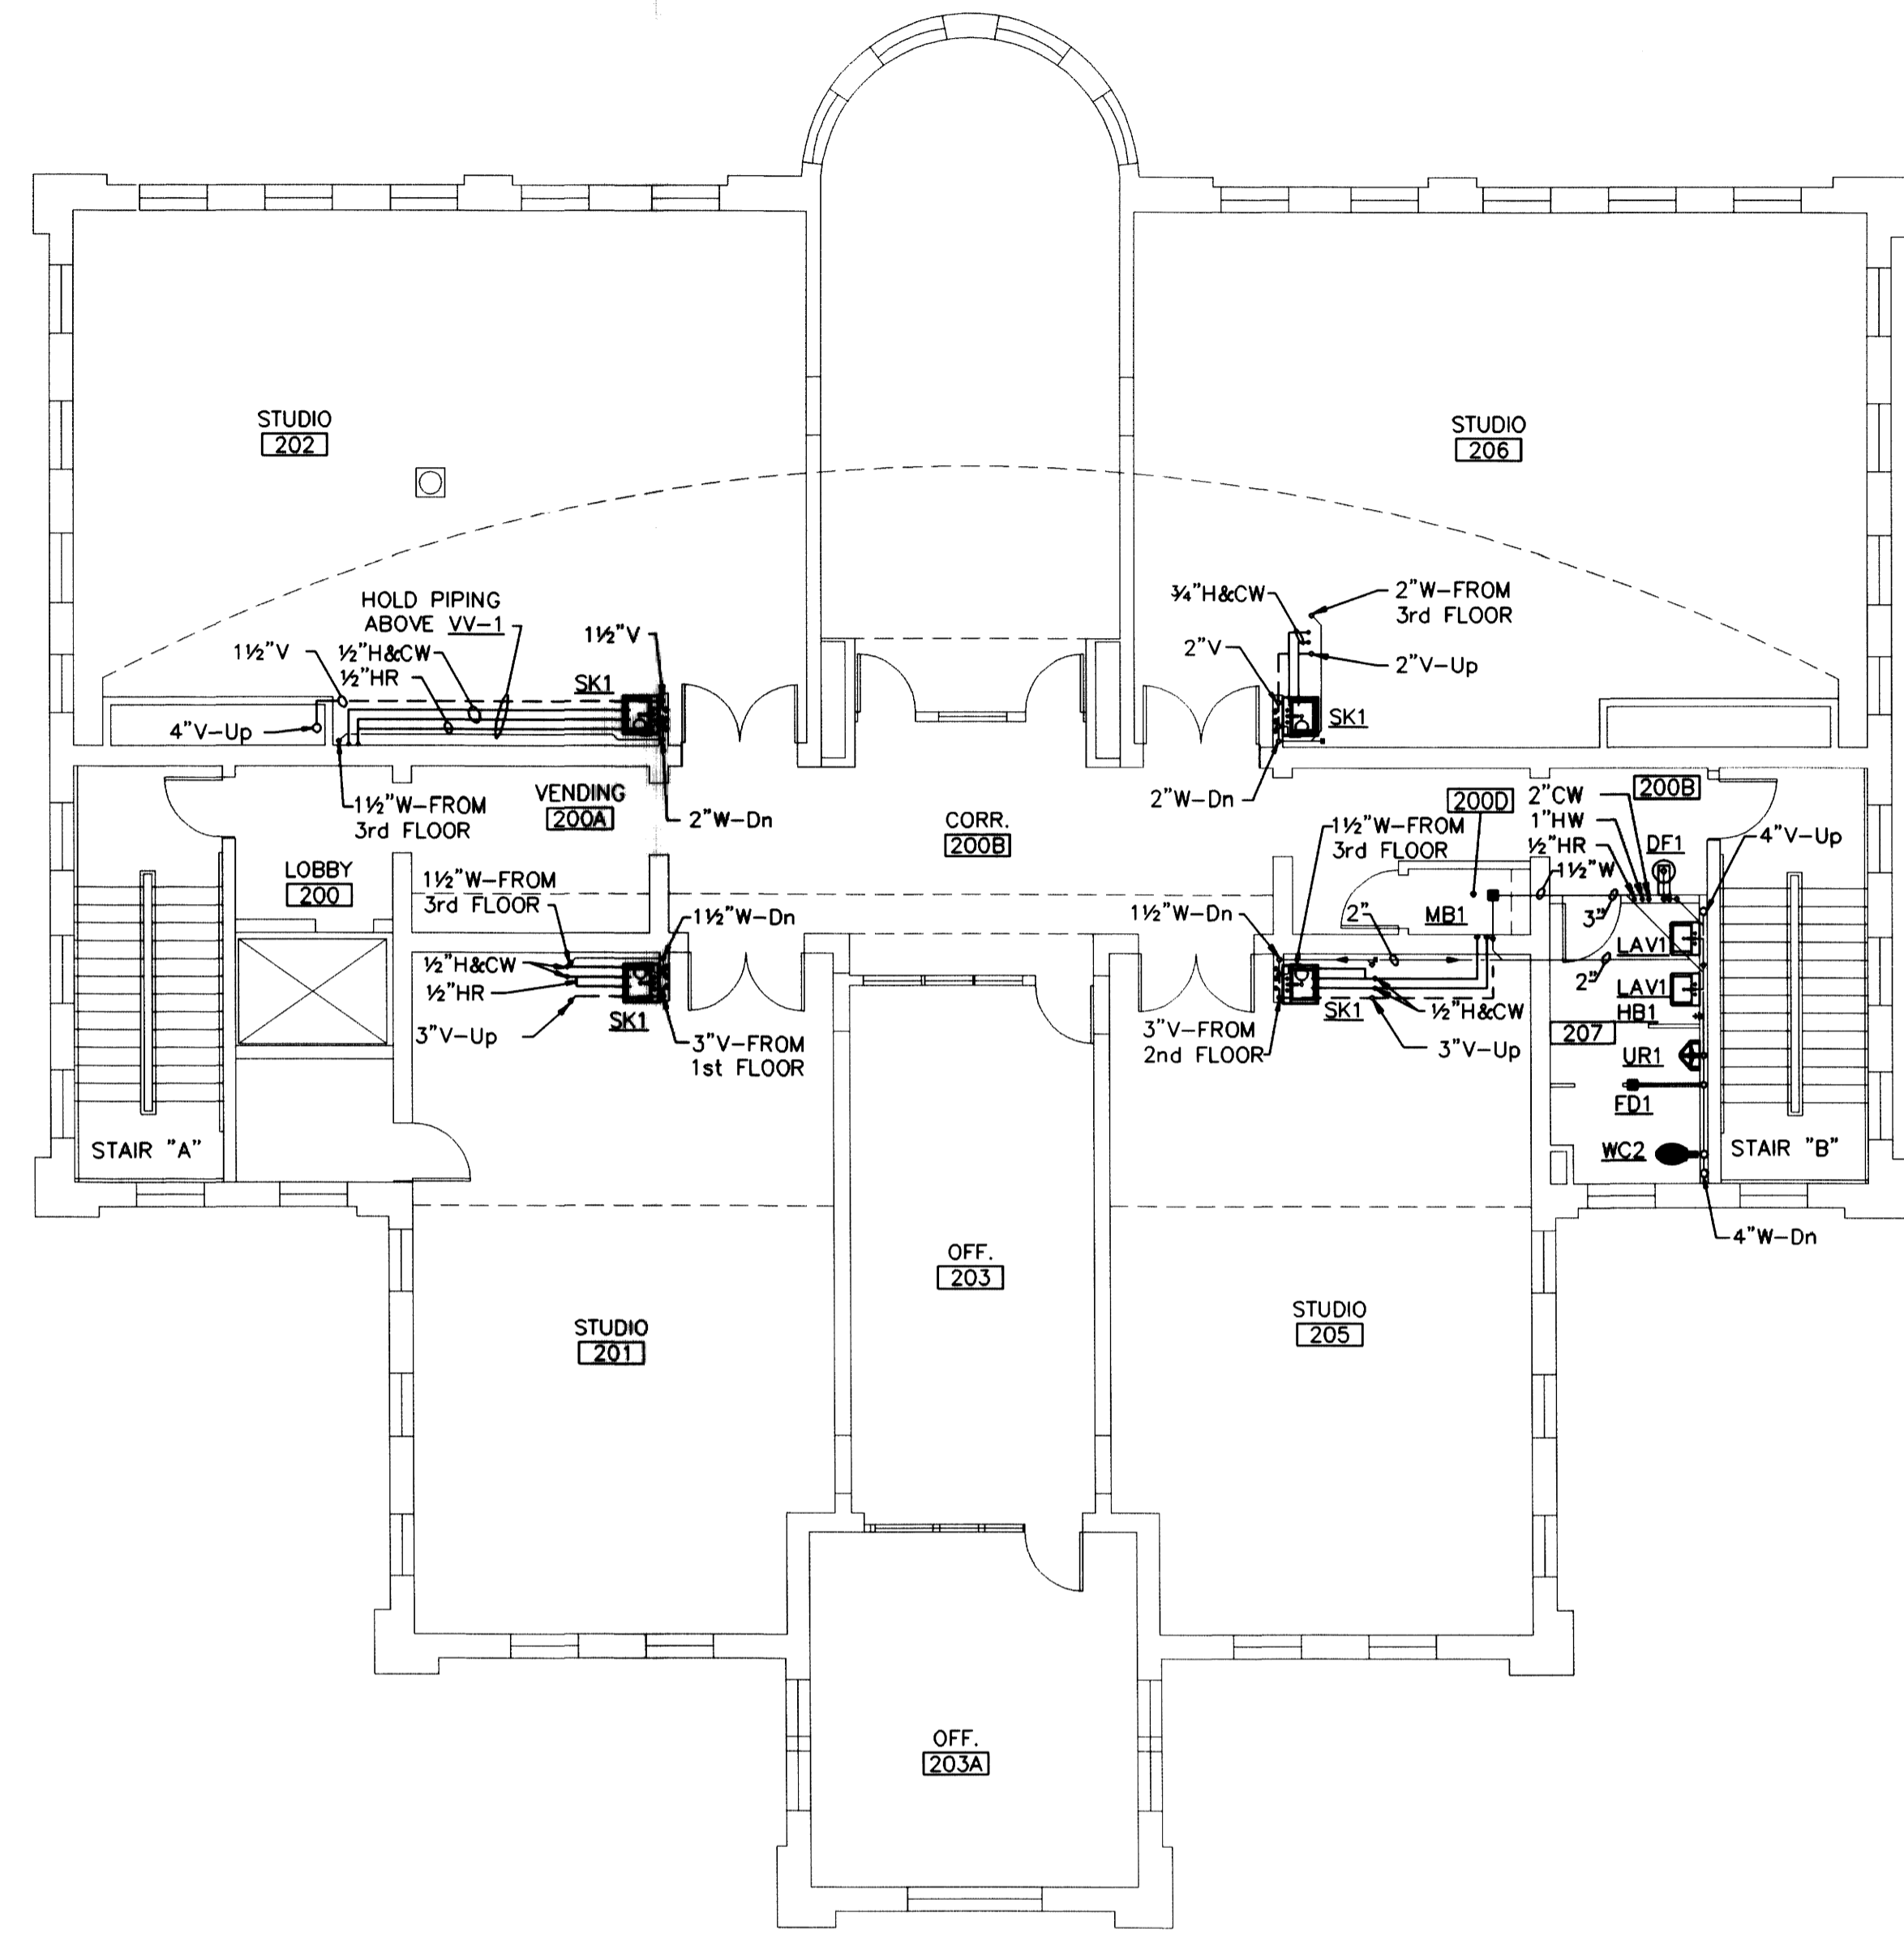

SECOND FLOOR PLUMBING PLAN  
SCALE: 1/8"=1'-0"

NOTE:  
COORDINATE INSTALLATION OF ALL SYSTEMS WITH MECHANICAL (HVAC) SYSTEMS. CEILING CAVITY SPACE IS RESTRICTED AND INSTALLATION OF DUCTWORK SHALL TAKE PRIORITY OVER ALL TRADES. NO EXTRA COMPENSATION WILL BE ALLOWED TO COVER COST OF RELOCATING SYSTEMS FOUND ENCRoACHING ON SPACE REQUIRED BY MECHANICAL, (HVAC) SYSTEMS.

**AS BUILT**  
DATE 4-15-95

SECOND & THIRD FLOOR PLUMBING PLANS  
**MILLER HALL RENOVATION**  
Lexington Campus Sector  
University of Kentucky

University of Kentucky  
Lexington, Kentucky  
approved by \_\_\_\_\_ date \_\_\_\_\_  
director - capital projects management

Biagi, Chance, Cummins,  
London, Titzer, Inc.  
Consulting Engineers  
123 Main St.  
Shelbyville, Kentucky, 40065

project no. 1465  
date 20 AUGUST 93  
file no. 93502P01  
dr. by JWR/HWD  
ck. by CGG/JKL

revisions

P-2