




PROJECT N° 1474.0

Omni Architects

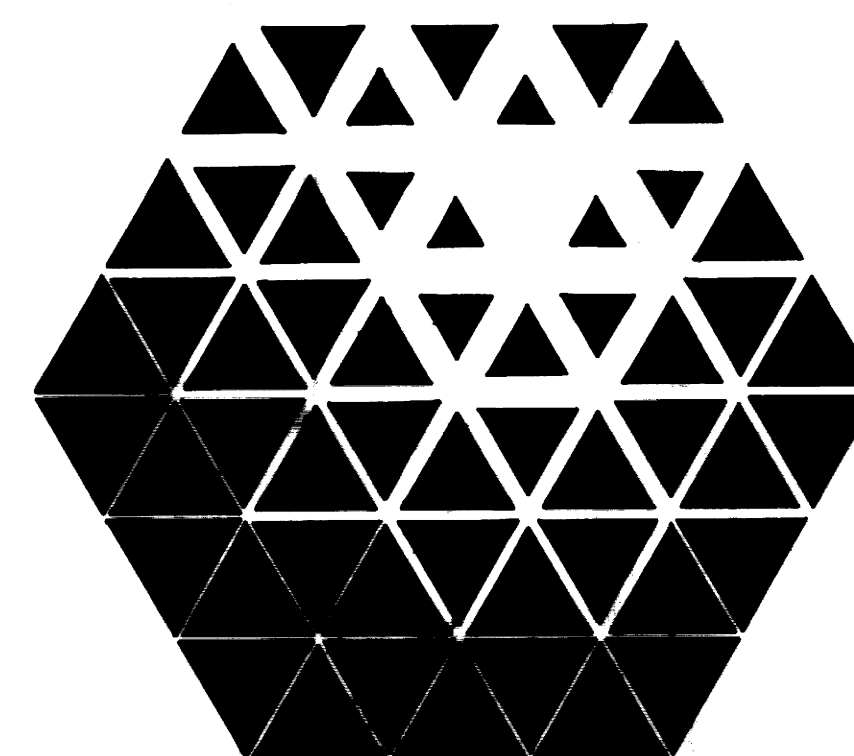

STAGGS + FISHER

WHITE, WALKER & McREYNOLDS

CONSULTING ENGINEERS

STRUCTURAL ENGINEERS


- B-1 **Site Survey**
- B-2 **Geotechnical Exploration**
- L-1 **Site Development Plan**
- L-2 **Planting Plan / Details**
- S-1 **Foundation Plan / First Floor Structural Framing Plan**
- S-2 **Second Floor / Roof Structural Framing Plans**
- S-3 **Column Schedule / Details**
- A-0 **Information / Partition Types**
- A-1 **Basement Demolition Plan**
- A-2 **First Floor Demolition Plan**
- A-3 **Second Floor Demolition Plan**
- A-4 **Roof Demolition Plan**
- A-5 **Basement Floor Plan & Room Finish Schedule**
- A-6 **First Floor Plan & Room Finish Schedule**
- A-7 **Second Floor Plan & Room Finish Schedule**
- A-8 **Basement Reflected Ceiling**
- A-9 **First Floor Reflected Ceiling**
- A-10 **Second Floor Reflected Ceiling**
- A-11 **Roof Plan**
- A-11.1 **Roof Details**
- A-12 **Building Elevations**
- A-13 **Building Elevations**
- A-14 **Building Sections**
- A-15 **Wall Sections**
- A-16 **Door & Window Schedule Details**
- A-17 **Elevator Plan / Section**
- A-18 **Building Section**
- A-19 **Interior Elevations**
- A-20 **Miscellaneous Details**
- A-21 **Miscellaneous Details**
- FR-1 **Basement Furniture Plan (For Info. Only)**
- FR-2 **First Floor Furniture Plan (For Info. Only)**
- FR-3 **Second Floor Furniture Plan (For Info. Only)**
- U-1 **Site Utility Plan**
- P-1 **Plumbing Plan - Basement**
- P-2 **Plumbing Plan - First Floor**
- P-3 **Plumbing Plan - Second Floor**
- P-4 **Plumbing Plan - Basement Demolition**
- P-5 **Plumbing Plan - First Floor Demolition**
- P-6 **Plumbing Plan - Second Floor Demolition**
- P-7 **Plumbing Risers, Legends, and Details**
- H-1 **HVAC Plan - Basement Demolition**
- H-2 **HVAC Plan - First Floor Demolition**
- H-3 **HVAC Plan - Second Floor Demolition**
- H-4 **HVAC Plan - Basement**
- H-5 **HVAC Plan - First Floor**
- H-6 **HVAC Plan - Second Floor**
- H-7 **Hydronic Piping - Basement**
- H-8 **Hydronic Piping - First Floor**
- H-9 **Hydronic Piping - Second Floor**
- H-10 **HVAC Details**
- H-11 **HVAC Details**
- H-12 **HVAC Flow Diagram**
- H-13 **HVAC Schedules**
- E-1 **Lighting Plan - Basement**
- E-2 **Power Plan - Basement**
- E-3 **Low Voltage Plan - Basement**
- E-4 **Lighting Plan - First Floor**
- E-5 **Power Plan - First Floor**
- E-6 **Low Voltage Plan - First Floor**
- E-7 **Lighting Plan - Second Floor**
- E-8 **Power Plan - Second Floor**
- E-9 **Low Voltage Plan - Second Floor**
- E-10 **Distribution Riser and General Notes**


Set Number:

AS-BUILT AUG. 10, 1995

FINAL DOCUMENTS

Date: July 1994

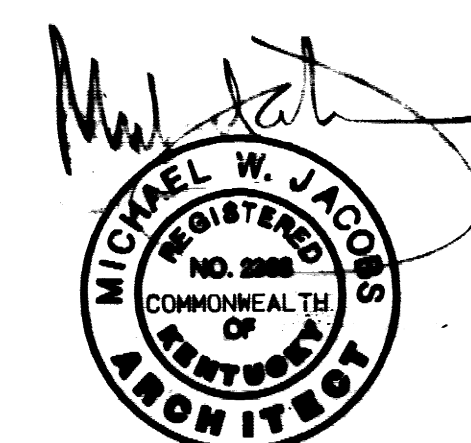

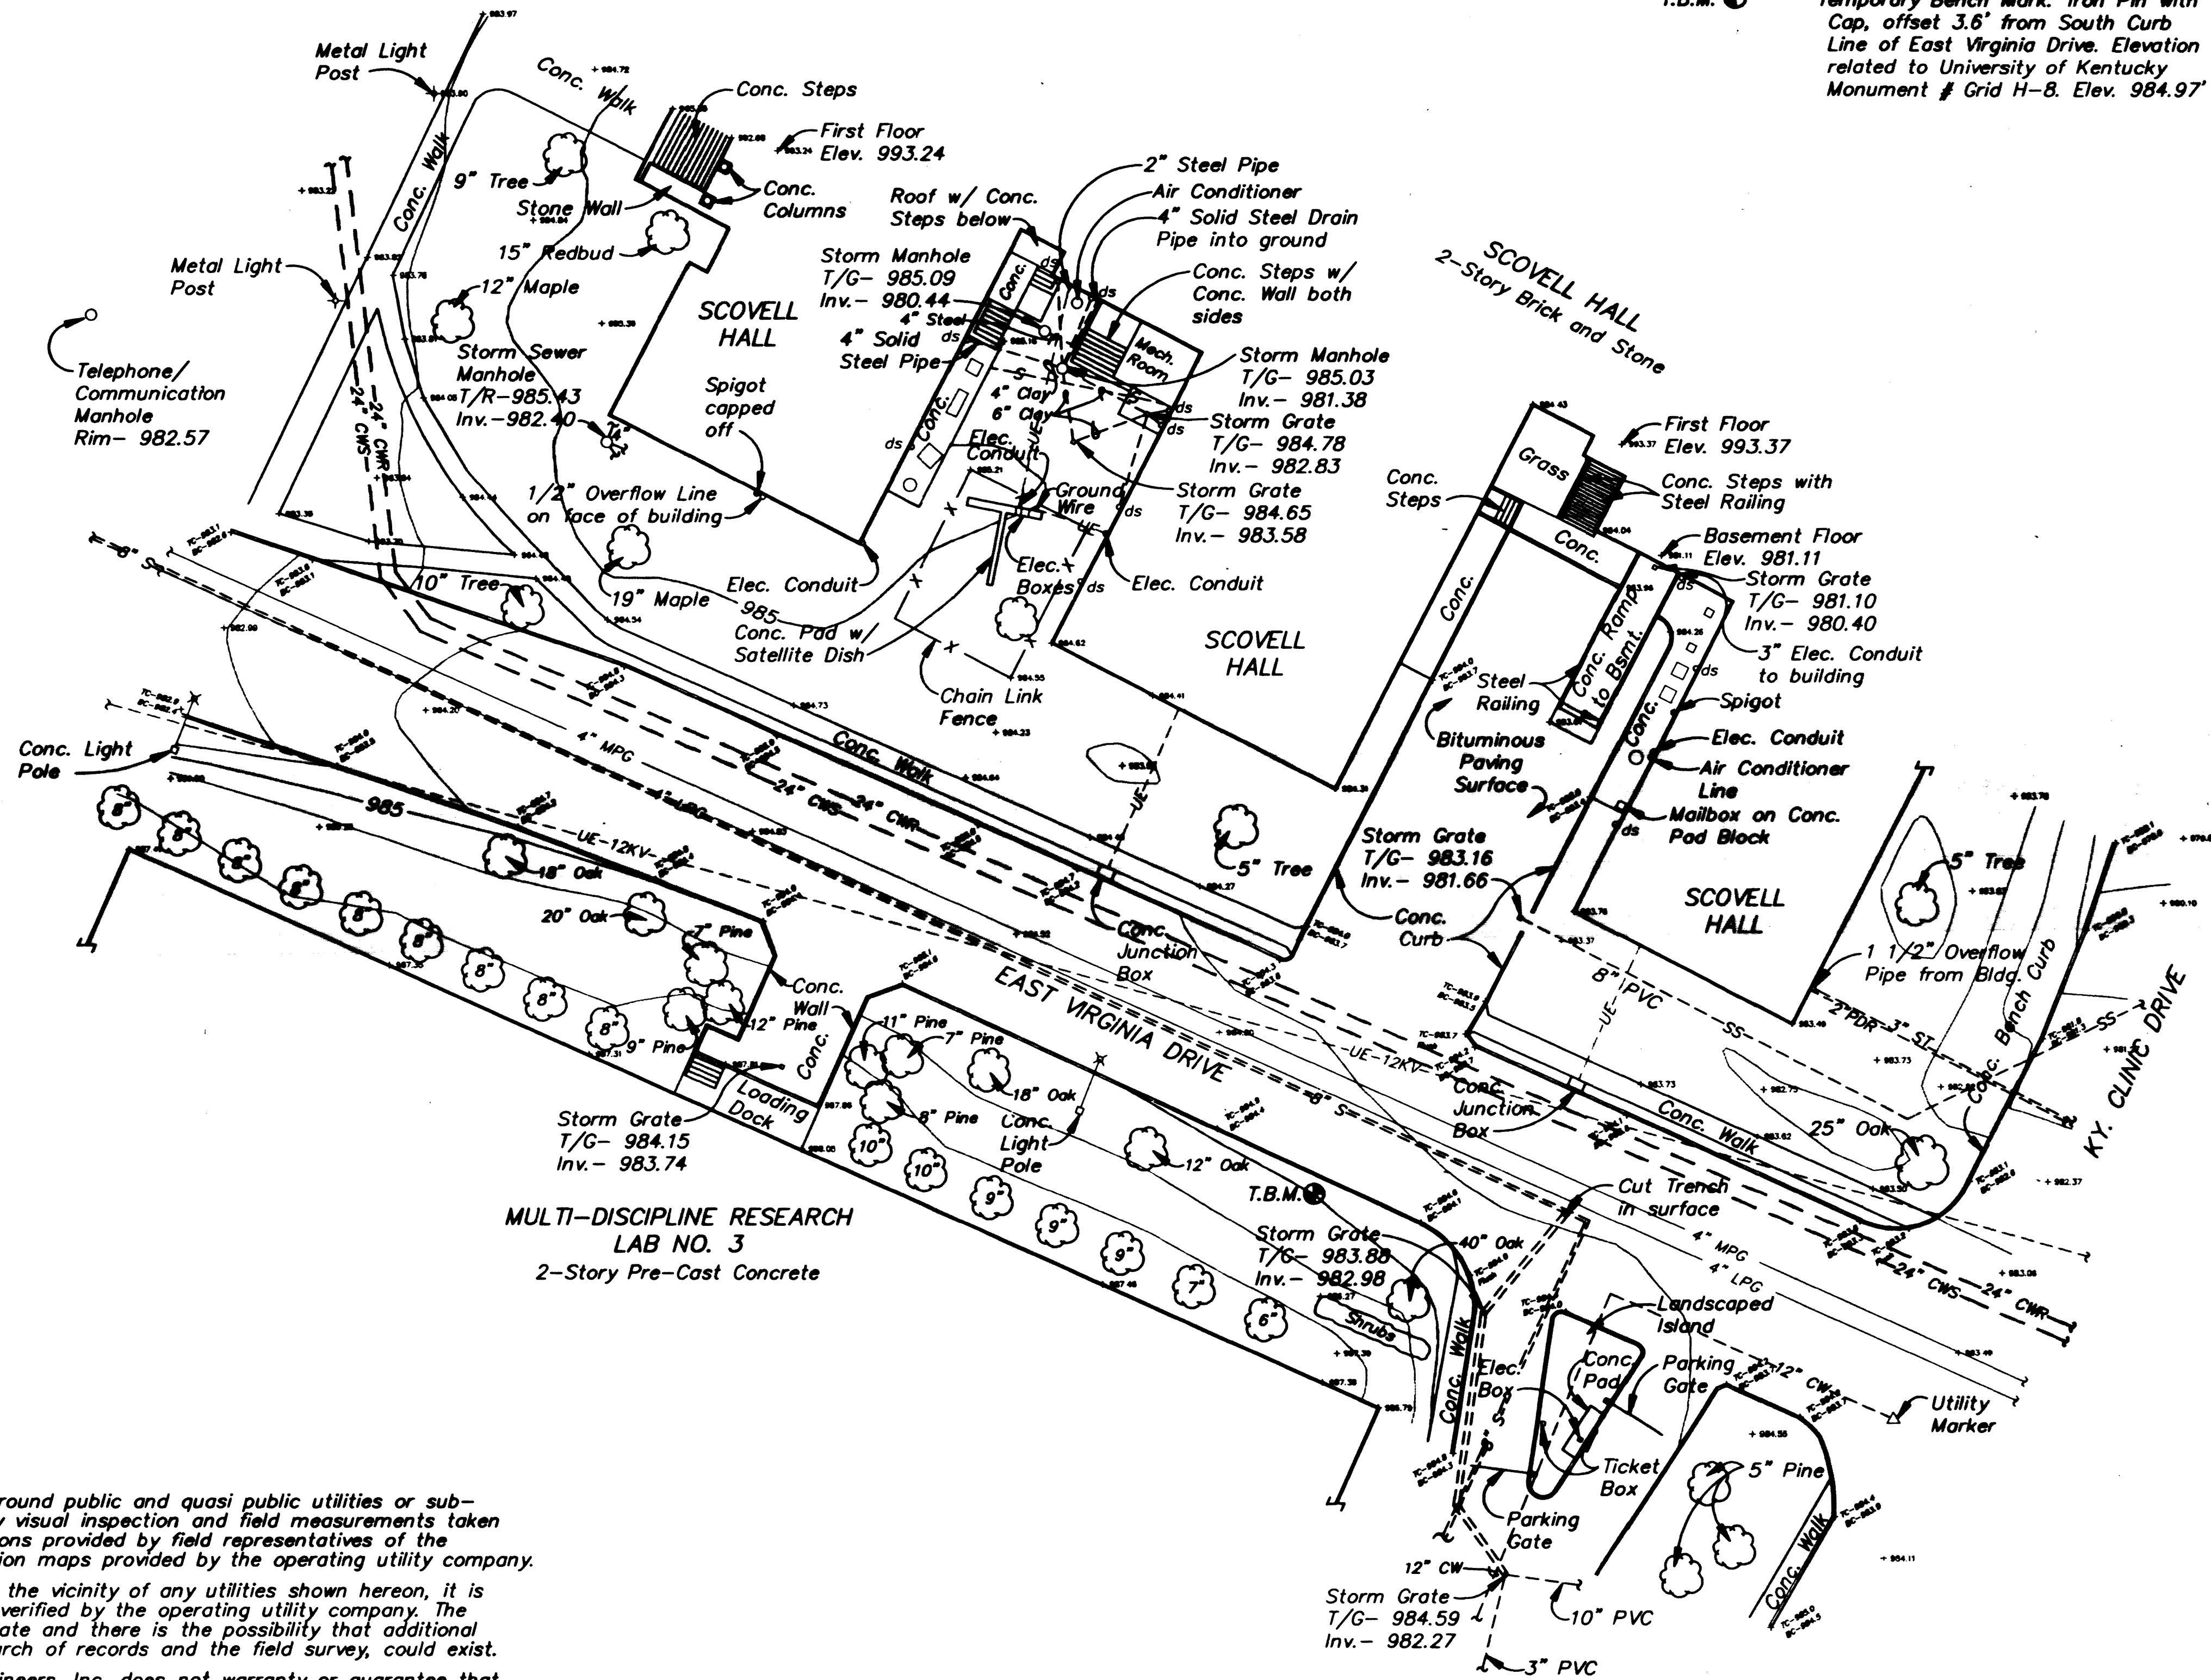

UNDERGROUND UTILITY NOTE

The locations, sizes and types of underground public and quasi public utilities or sub-structures shown hereon were obtained by visual inspection and field measurements taken at the time of the survey; physical locations provided by field representatives of the operating utility company and utility location maps provided by the operating utility company.

Prior to any design or construction in the vicinity of any utilities shown hereon, it is recommended that the locations be field verified by the operating utility company. The locations shown hereon are only approximate and there is the possibility that additional utility lines, not discovered during the search of records and the field survey, could exist.


Fuller, Mossbarger, Scott and May Engineers, Inc. does not warranty or guarantee that the underground utility information shown hereon is accurate or complete.

Any contractor, owner or designer using the information shown hereon is hereby forewarned that any excavation upon this site may result in the discovery of additional underground utilities not shown hereon.

GRAPHIC SCALE: 1" = 20'
CONTOUR INTERVAL = 1'



Fuller Mossbarger Scott and May Engineers, Inc.
1400 N. FORD BL.
LEXINGTON, KENTUCKY 40511-2011
606-253-5271

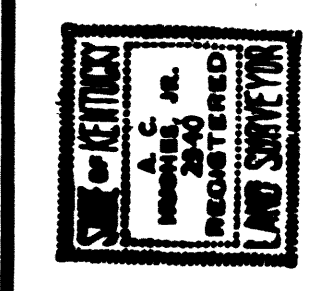

TOPOGRAPHIC SURVEY
SCOVELL HALL, UNIVERSITY OF KENTUCKY CAMPUS
LEXINGTON, FAYETTE COUNTY, KENTUCKY
PREPARED FOR:
OMNI ARCHITECTS
212 NORTH UPPER STREET
LEXINGTON, KENTUCKY 40507

PROJECT NO.	93298
DATE	NOV. 1993
DRAWN BY	TDS/BFS
CHECKED BY	ACH
SCALE	AS SHOWN
REVISIONS	
1	
2	
3	
4	
5	
6	
7	
8	
9	
10	

SHEET


SCOVELL HALL RENOVATION

SITE SURVEY 00 2/01


UNIVERSITY OF KENTUCKY

AS-BUILT AUG. 10, 1995

Architecture
Landscape Architecture
Interior Design
Planning
Surveying

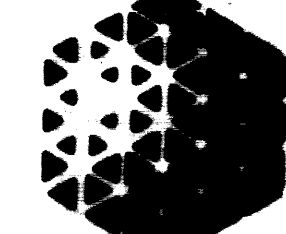

Omni
Architects

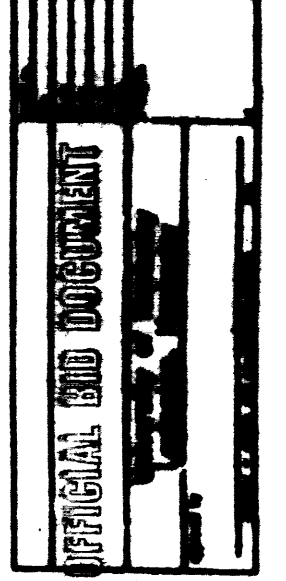


University of Kentucky
Department of Planning and Construction
Division of Planning and Construction
1100 N. FORD BL.
LEXINGTON, KY 40511-2011
(606) 253-5271



NOTE:

The boring logs and related information shown on this drawing depict approximate subsurface conditions only at the specific boring locations noted and at the time of drilling. Conditions at other locations may differ from those occurring at the boring locations. Also, the passage of time may result in a change in the subsurface conditions at the boring locations. Any correlations shown between borings are generally based on straight line interpolation. Actual conditions between borings are unknown and may differ from those shown.

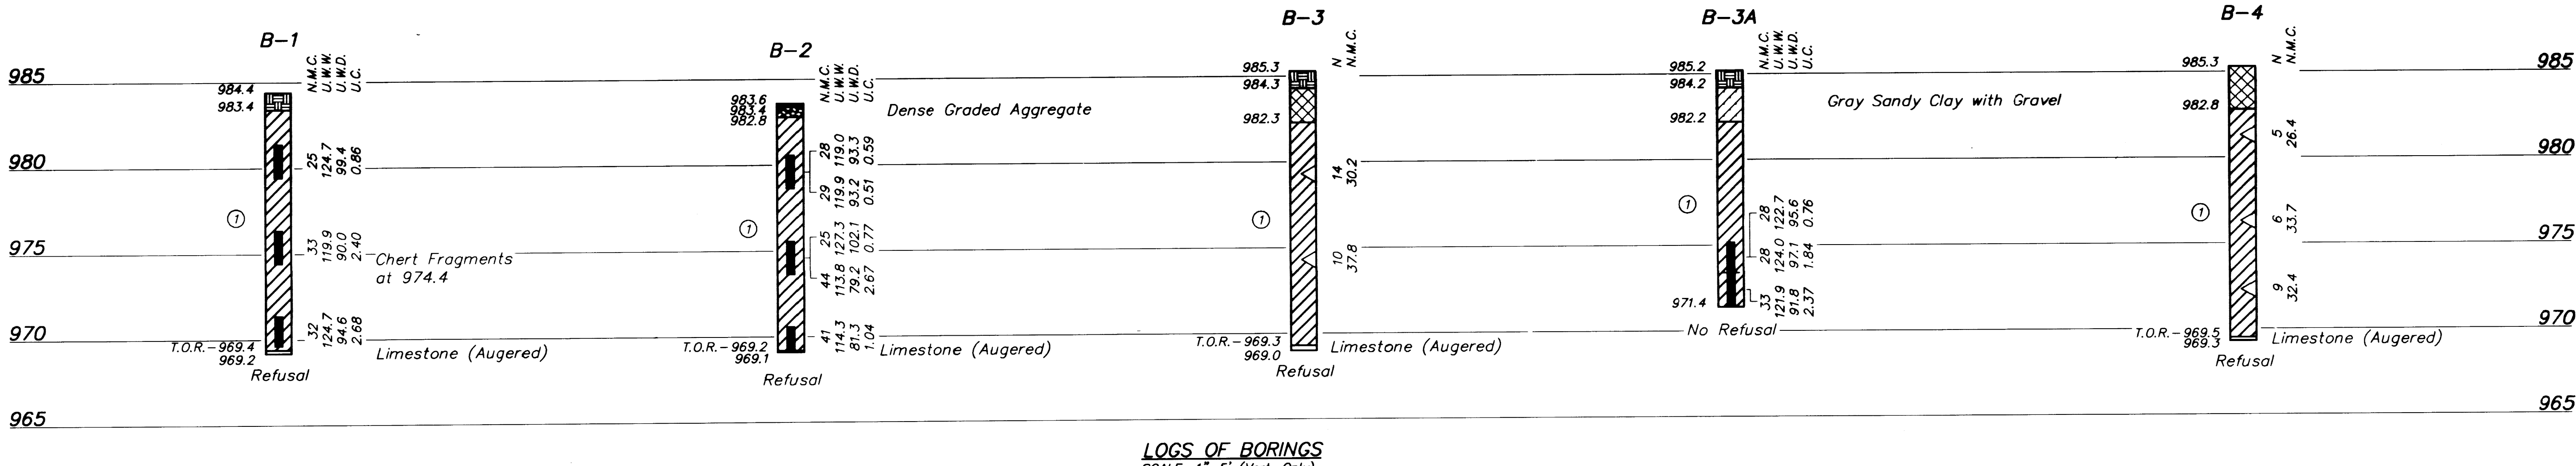

LEGEND

- Soil Boring with Undisturbed (Shelby) Tube Samples and/or Standard Penetration Tests
- Topsoil
- Asphalt Concrete
- Lean Clay, gray brown, with gravel and rock fragments
- Fat Clay, brown, with manganese concretions, moist, soft to stiff
- Undisturbed Thin-Walled (Shelby) Tube Sample
- Standard Penetration Test Interval
- Standard Penetration Test Blow Count (blows/ft.)
- Natural Moisture Content (%)
- Unit Weight Wet (lbs./cu.ft.)
- Unit Weight Dry (lbs./cu.ft.)
- Unconfined Compressive Strength (tons/sq. ft.)
- Top of Rock (Indicates the beginning of rock-like resistance to the advancement of the augers. This may indicate the beginning of weathered bedrock, boulders or rock remnants. An exact determination cannot be made without performing rock coring.)
- Auger Refusal using a carbide-tipped tooth auger bit
- No Refusal Encountered
- Temporary Bench Mark: Iron Pin with Cap, offset 3.6' from South Curb Line of East Virginia Drive. Elevation related to University of Kentucky Monument Grid H-8. Elev. 984.97'

SOIL SUMMARY

SAMPLE NO.	1
STATION	-
DATE	Composite
Composition of Total Sample	GRAVEL (-3" + No. 4)
	SAND (-No. 4 + No. 200)
	SILT (-No. 200 + 0.005mm)
	CLAY (-0.005mm)
LIQUID LIMIT	55
PLASTIC LIMIT	24
PLASTICITY INDEX	31
ACTIVITY INDEX	0.7
SPECIFIC GRAVITY	2.78
ASTM CLASSIFICATION	A-7-6(32)
UNIFIED CLASSIFICATION	CH
CALC. BEARING RATIO	-
MAXIMUM DRY DENSITY (pcf)	-
OPTIMUM MOISTURE (%)	-

GEOTECHNICAL EXPLORATION

SCOVELL HALL, UNIVERSITY OF KENTUCKY CAMPUS
LEXINGTON, FAYETTE COUNTY, KENTUCKY

PREPARED FOR:
OMNI ARCHITECTS
221 PALMER SERVICE BUILDING
LEXINGTON, KENTUCKY 40507

PROJECT NO.	93298
DATE	MARCH, 1994
DRAWN BY	TDS
CHECKED BY	LMR
SCALE	AS SHOWN
REVISION	
1	
2	
3	
4	
5	
6	
7	
8	

SHEET


SCOVELL HALL RENOVATION

GEOTECHNICAL EXPLORATION



University of Kentucky
Design and Construction
Division
221 Palmer Service Building
Lexington, Kentucky 40507

Omni
Architects

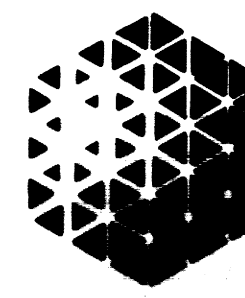

Architecture
Landscape Architecture
Interior Design
Planning
Engineers
212 North Upper Street
Lexington, Kentucky 40507
(606) 252-6664

UNIVERSITY OF KENTUCKY

AS-BUILT AUG. 10, 1995

This drawing and design shown herein are the property of Omni Architects, Inc. The reproduction, copying or other use of this drawing without the written consent of Omni Architects, Inc. is prohibited.

SITE ABBREVIATIONS

[illegible]

STANDARD GRADING NOTES

1. SEE SHEET 1-2 FOR ALL CONSTRUCTION DETAILS.
2. ALL ELEVATIONS SHOWN ARE FINISH GRADES. ADJUST SUBGRADES UNDER WALKS AS NECESSARY TO MEET FINISH GRADES SHOWN ON THE DRAWINGS.
3. SEE SITE SURVEY FOR LOCATION OF ALL UNDERGROUND UTILITIES. THE CONTRACTOR IS HEREBY NOTIFIED OF THE EXISTENCE OF EXISTING UNDERGROUND AND OVERHEAD UTILITIES AND SHOULD USE EXTREME CAUTION IN GRADING OPERATIONS.
4. SEE MECHANICAL AND ELECTRICAL DRAWINGS FOR RELOCATION OF WATER, GAS, SANITARY AND ELECTRICAL UTILITIES.
5. FOR SIMPLICITY, FINISH GRADE ELEVATIONS HAVE THE 900 PREFIX DELETED, I.E. 961.5 IS SHOWN 61.5.
6. TOPOGRAPHIC AND UTILITY INFORMATION IS BASED ON A TOPOGRAPHIC SURVEY PROVIDED BY THE COUNTY ENGINEERS DATED: 11/88. SEE REFERENCE SITE SURVEY (R-1).

SITE LAYOUT NOTES

1. SEE R SHEETS FOR SUBSURFACE INFORMATION AND SITE SURVEY.
2. SEE MECHANICAL AND ELECTRICAL DRAWING SHEET FOR DISTRIBUTION OF ALL SITE UTILITIES.
3. ASPHALT PAVEMENT IN THE PARKING AREA SHALL BE 1" BITUMINOUS CONCRETE SURFACE WITH 1-1/2" BITUMINOUS CONCRETE BASE OVER 6" OF COMPACTED D. .A.
4. PROVIDE 4" PAINTED STRIPES FOR ALL AREAS INDICATED ON SHEET L-1.
5. UNLESS OTHERWISE INDICATED ALL DIMENSIONS ARE REFERENCED AT 90 DEGREE ANGLES.
6. FOR BUILDING DIMENSIONS SEE ARCHITECTURAL PLANS.
7. FLOOR ELEVATIONS ARE GIVEN TO THE TOP OF FLOOR SLAB.
8. DIMENSIONS GIVEN IN RELATIONSHIP TO BUILDINGS ARE MEASURED PERPENDICULAR TO FACE OF BRICK

DEMOLITION NOTES

- 1 REMOVE EXISTING CURB.
- 2 SAWCUT EXISTING PAVEMENT & MATCH GRADE WITH NEW PAVEMENT.
- 3 EXISTING CURBS TO REMAIN.
- 4 EXISTING CONCRETE RAMP TO REMAIN. MATCH ELEVATION
ATTEND OF RAMP WITH NEW PAVEMENT.
- 5 REMOVE EXISTING SECTION OF CURB.
- 6 REMOVE EXISTING SECTION OF SIDEWALK.
- 7 RELOCATE EXISTING 6" MAPLE.
- 8 REMOVE EXISTING CONCRETE SATELITE FOUNDATION.
& SATELITE DISH HARDWARE & EQUIPMENT.
- 9 REMOVE EXISTING CHAINLINK FENCE.
- 10 REMOVE EXISTING 6" DOGWOOD TREE.



KEY

○ FUTURE PARKING LOT LIGHTS (SEE SHEET U-1 FOR ELECTRICAL RUGH-IN STEPS)

SEED, SOD, AND MULCH ARE IN THE BASE BID

SITE PLAN

SCALE: 1" = 10'

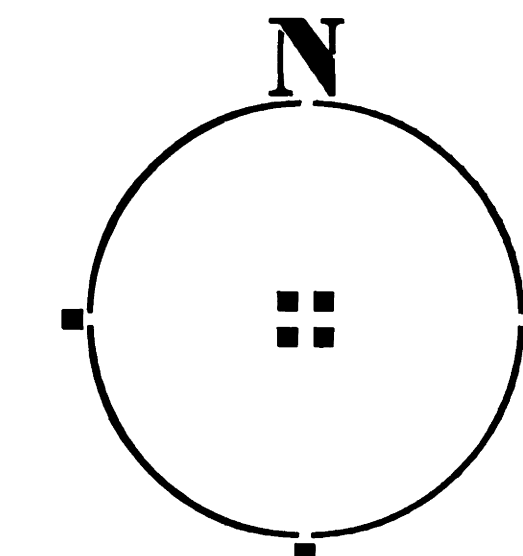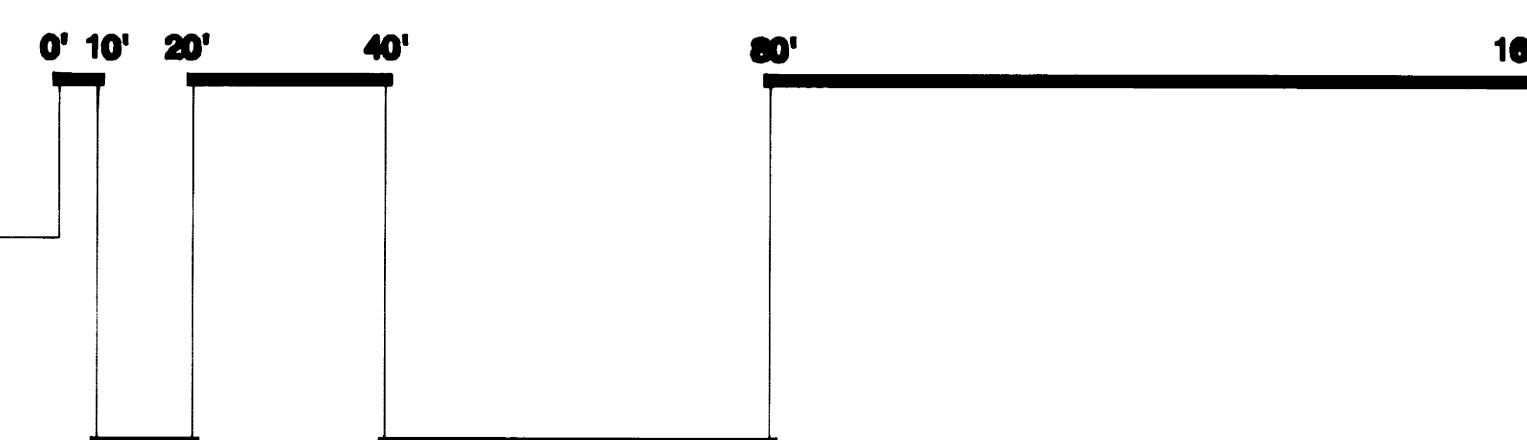

UNIVERSITY OF KENTUCKY

SCOVELL HALL RENOVATION

AS-BUILT AUG. 10, 1995


Fax: 7/29/94
 Architecture
 Landscape Architecture
 Civil Engineering
 Planning
 Interiors
 212 North Upper Street
 Lexington, KY 40507
 (606) 253-9994 Fax: (606) 253-2938

Omni
Architects

1	2	3	466
---	---	---	---	---	---	---	---	---	----	----	-----	-----	
University of Kentucky
Design and Construction
Division
Attn: _____
991 Museum Services Building

002103

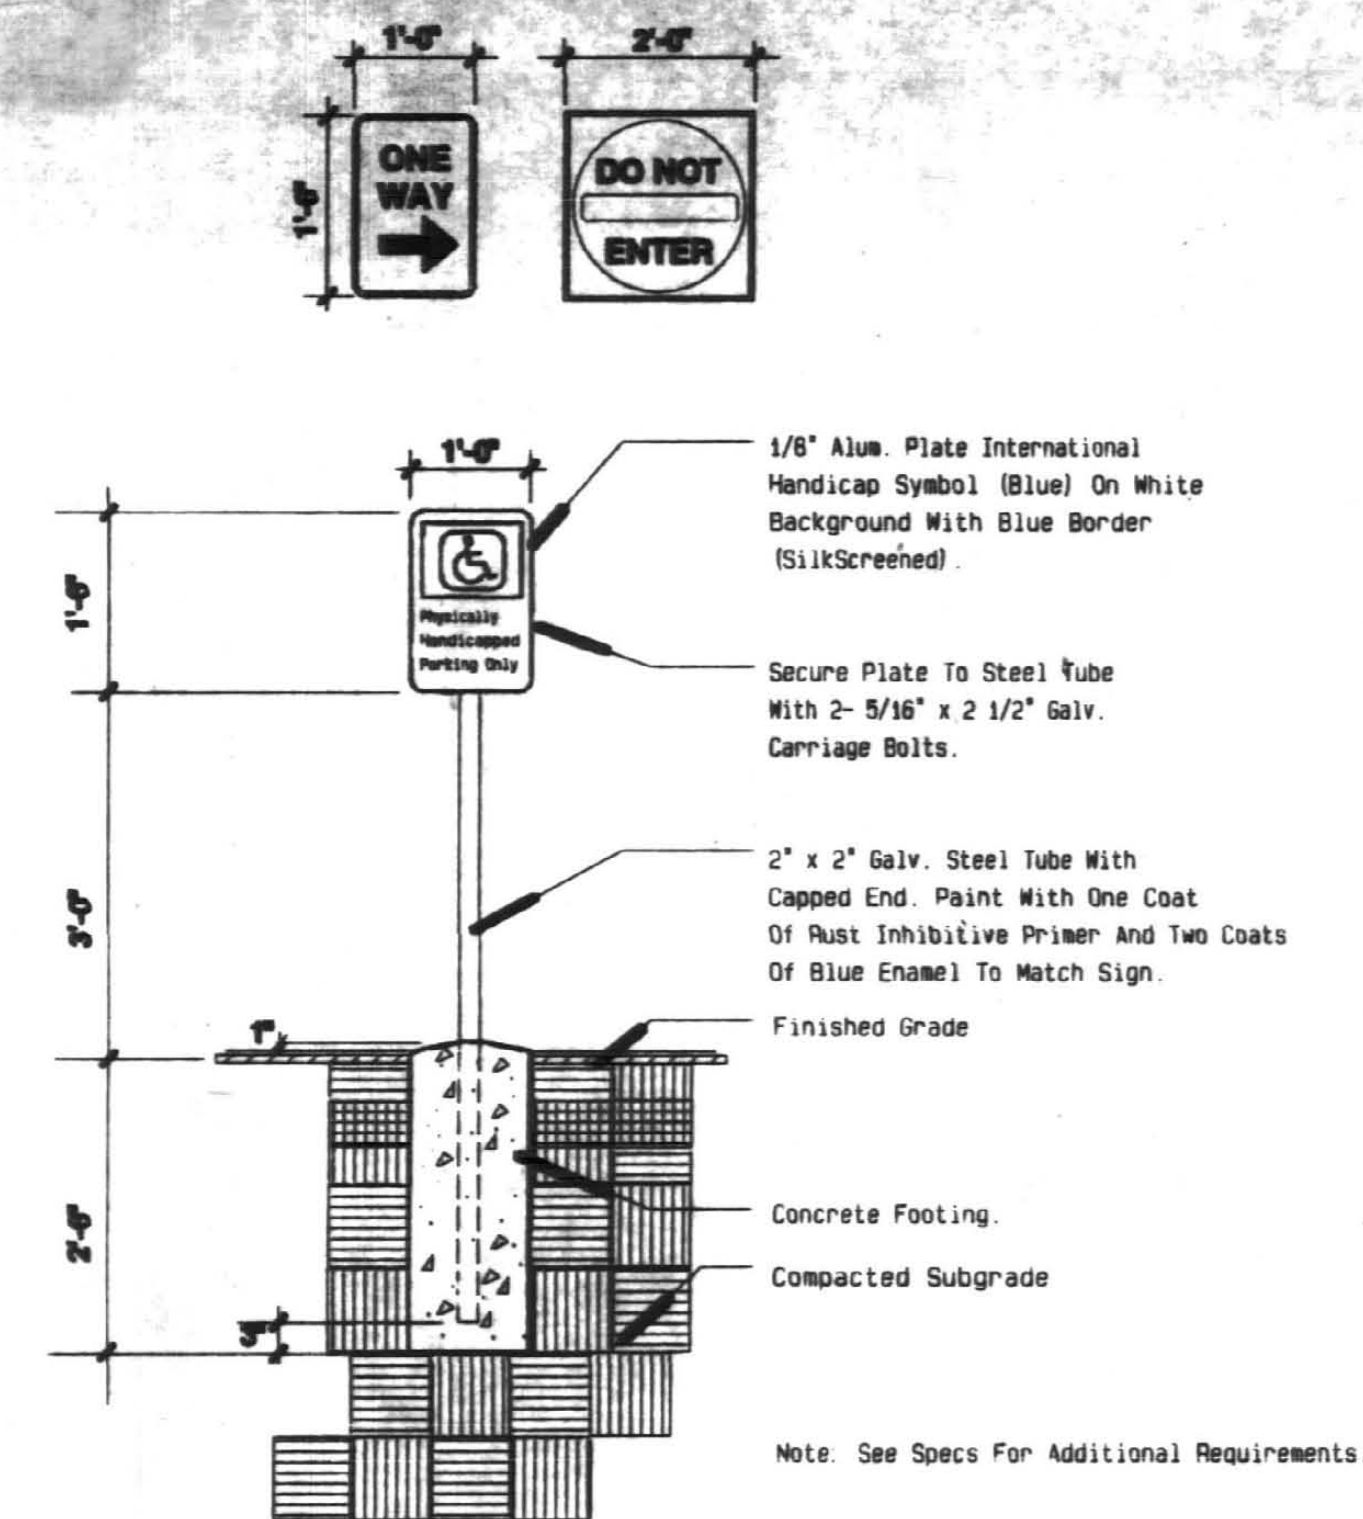


Handicap Parking Sign Detail

Scale: 1-1/2" = 1'-0"

(SIGN BY OWNER)


A
L-2

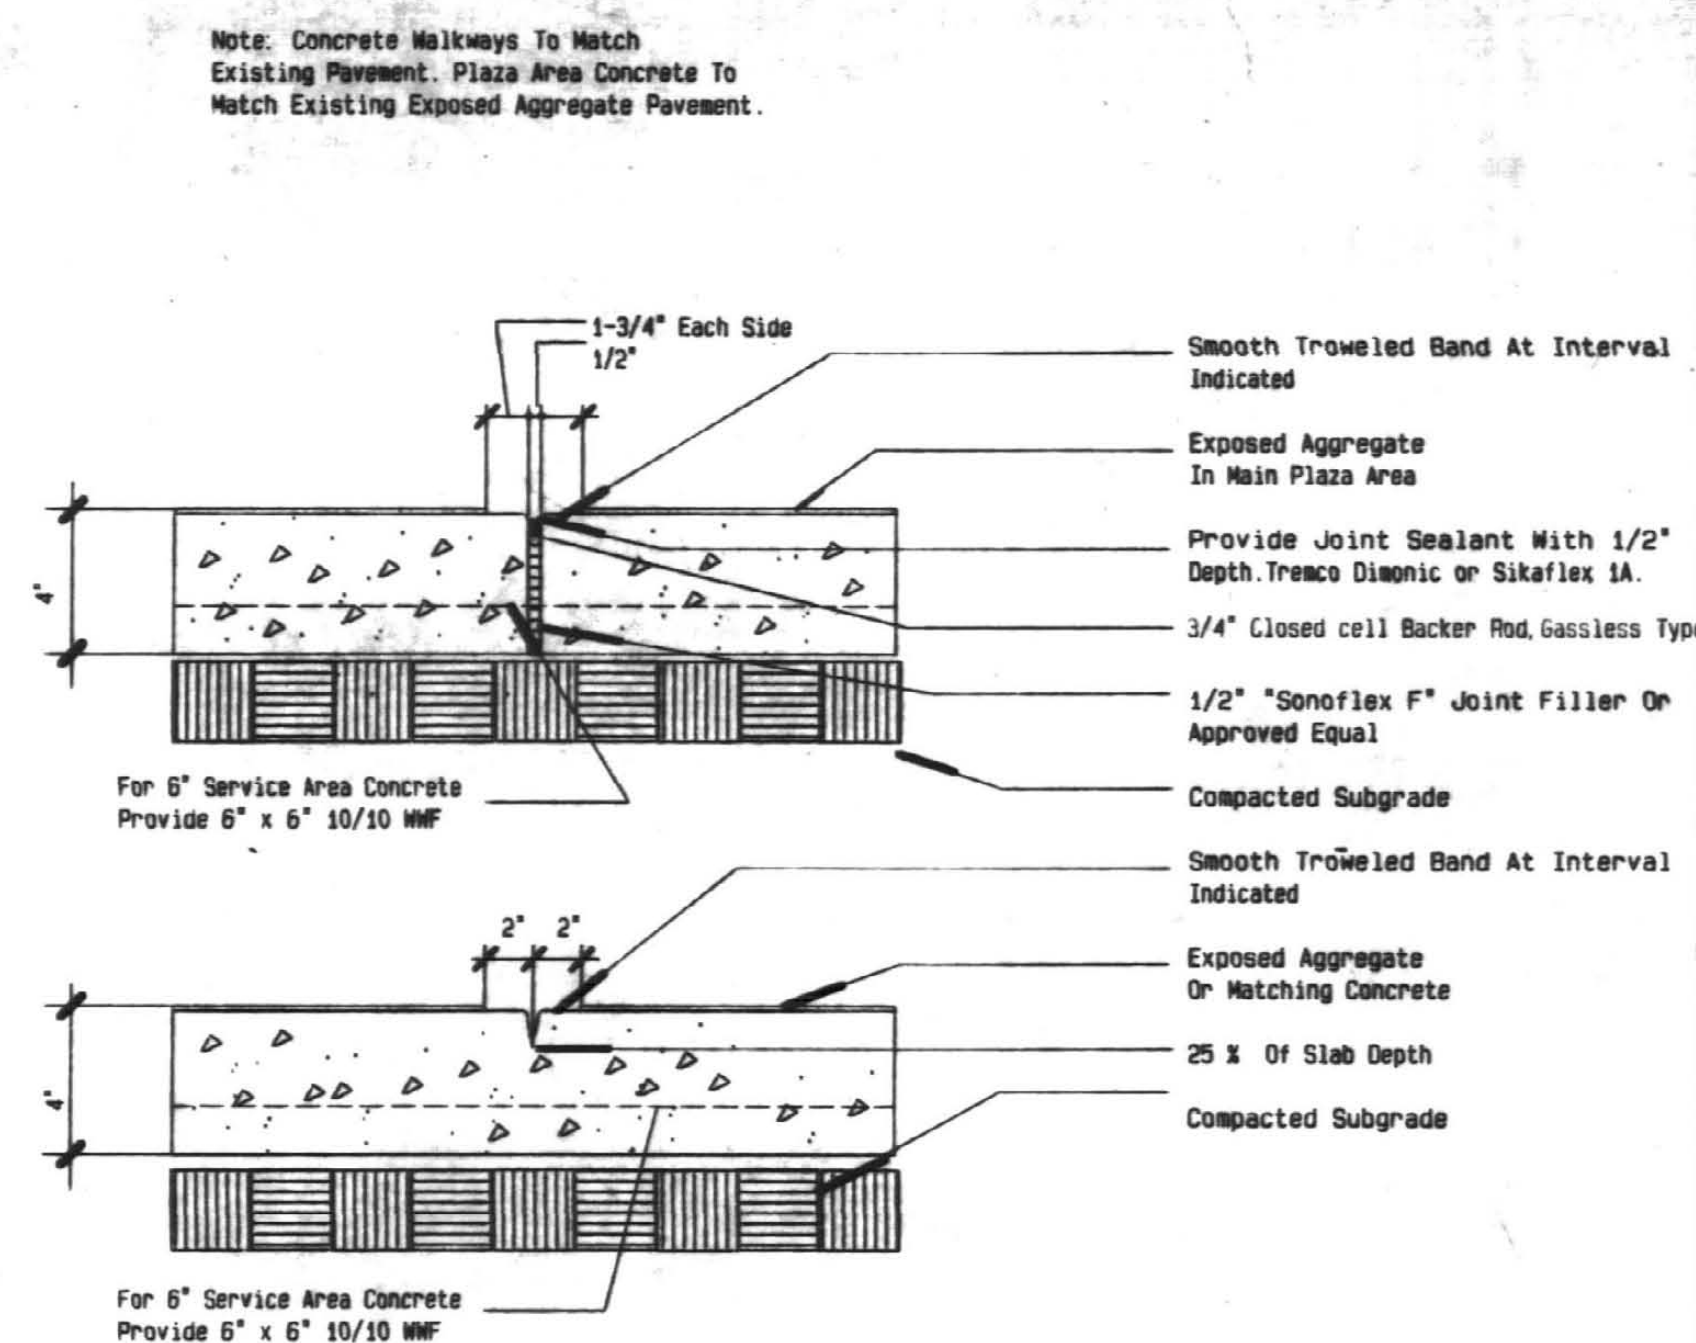

Concrete Pavement / Joint

Scale: 1-1/2" = 1'-0"


B
L-2

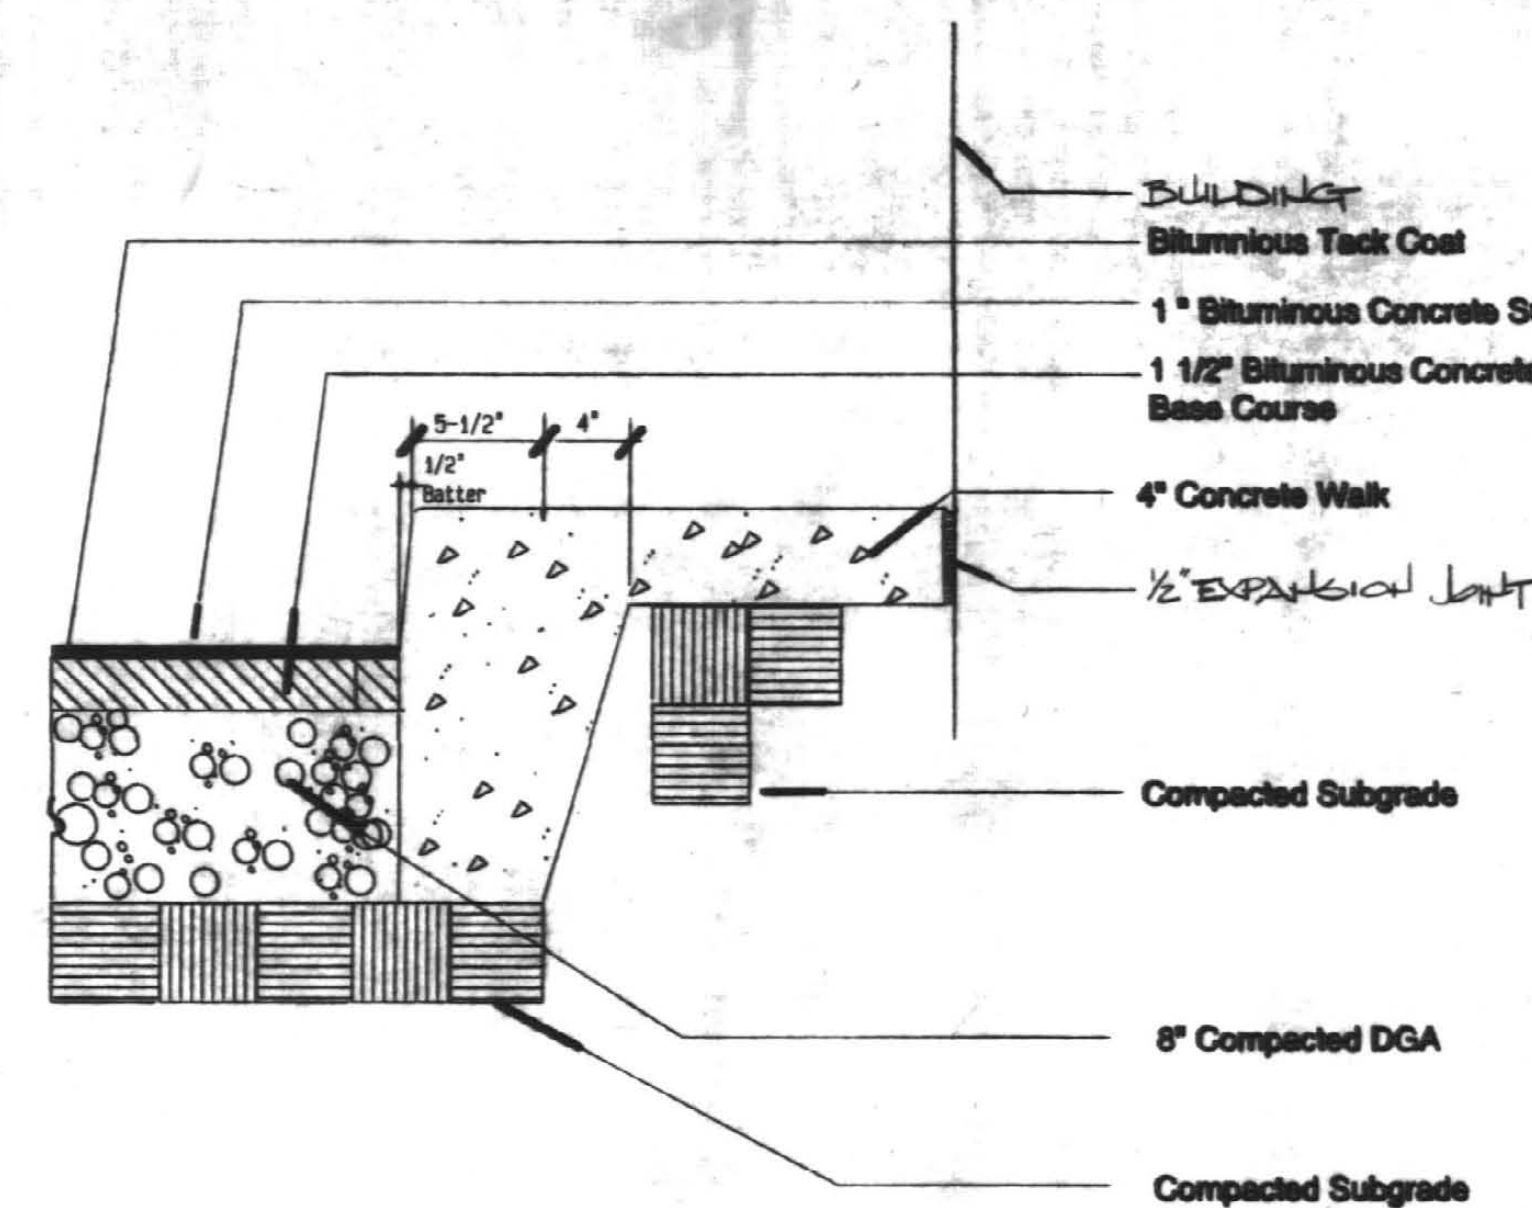

Integral Curb/Walk Detail

SCALE: 1 1/2" = 1'-0"


C
L-2

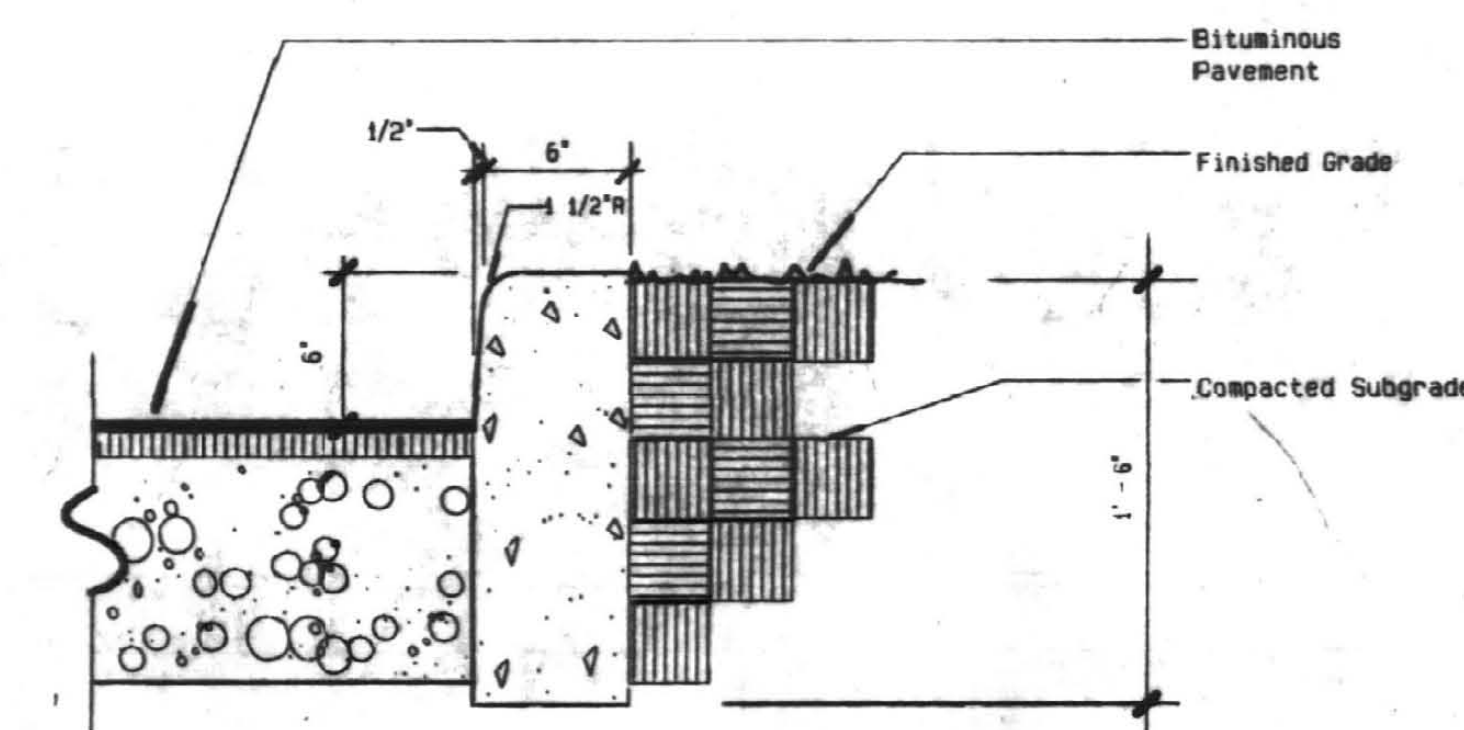

Free Standing Curb

N.T.S.


D
L-2

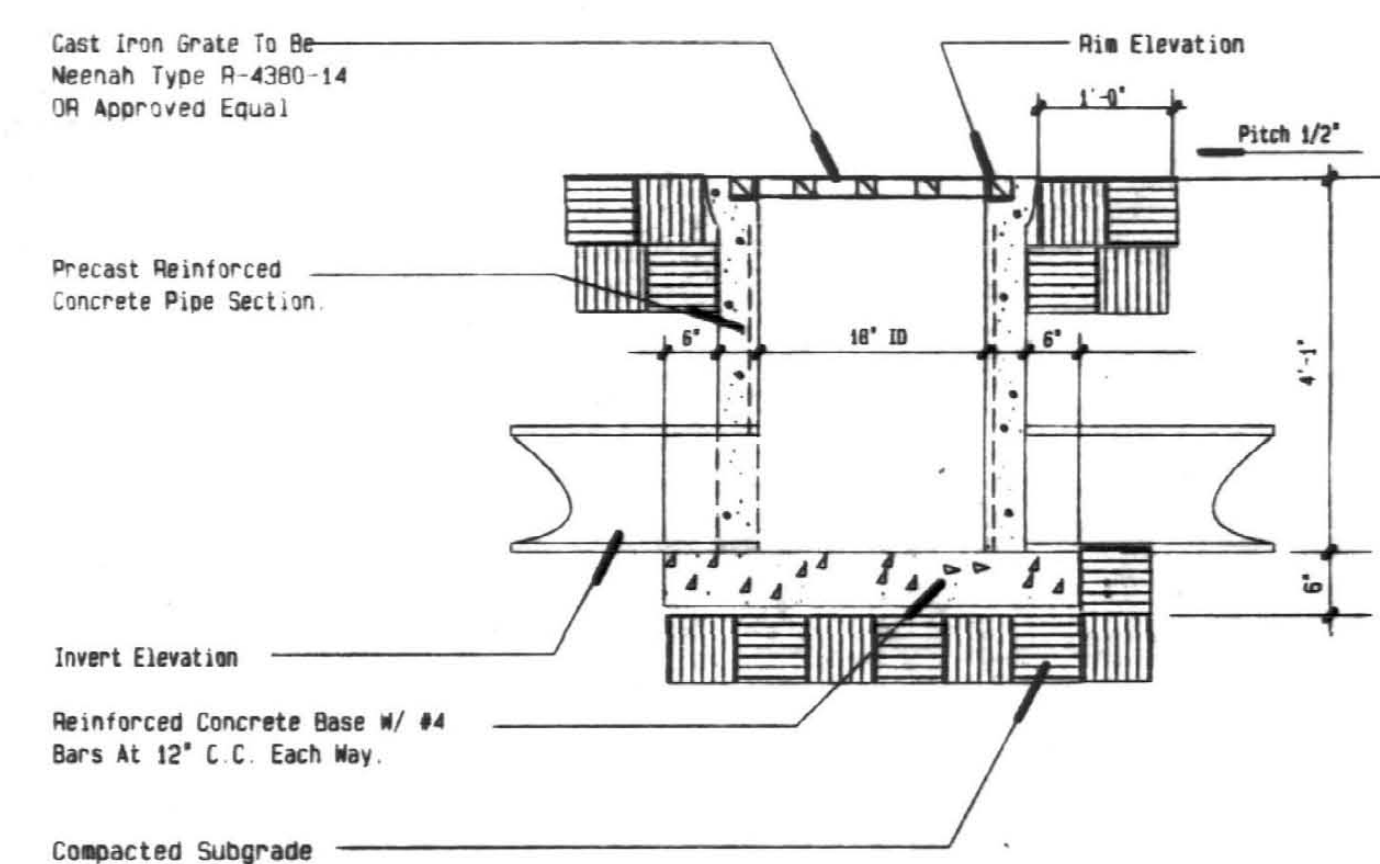

Type "A" Inlet

N.T.S.


E
L-2

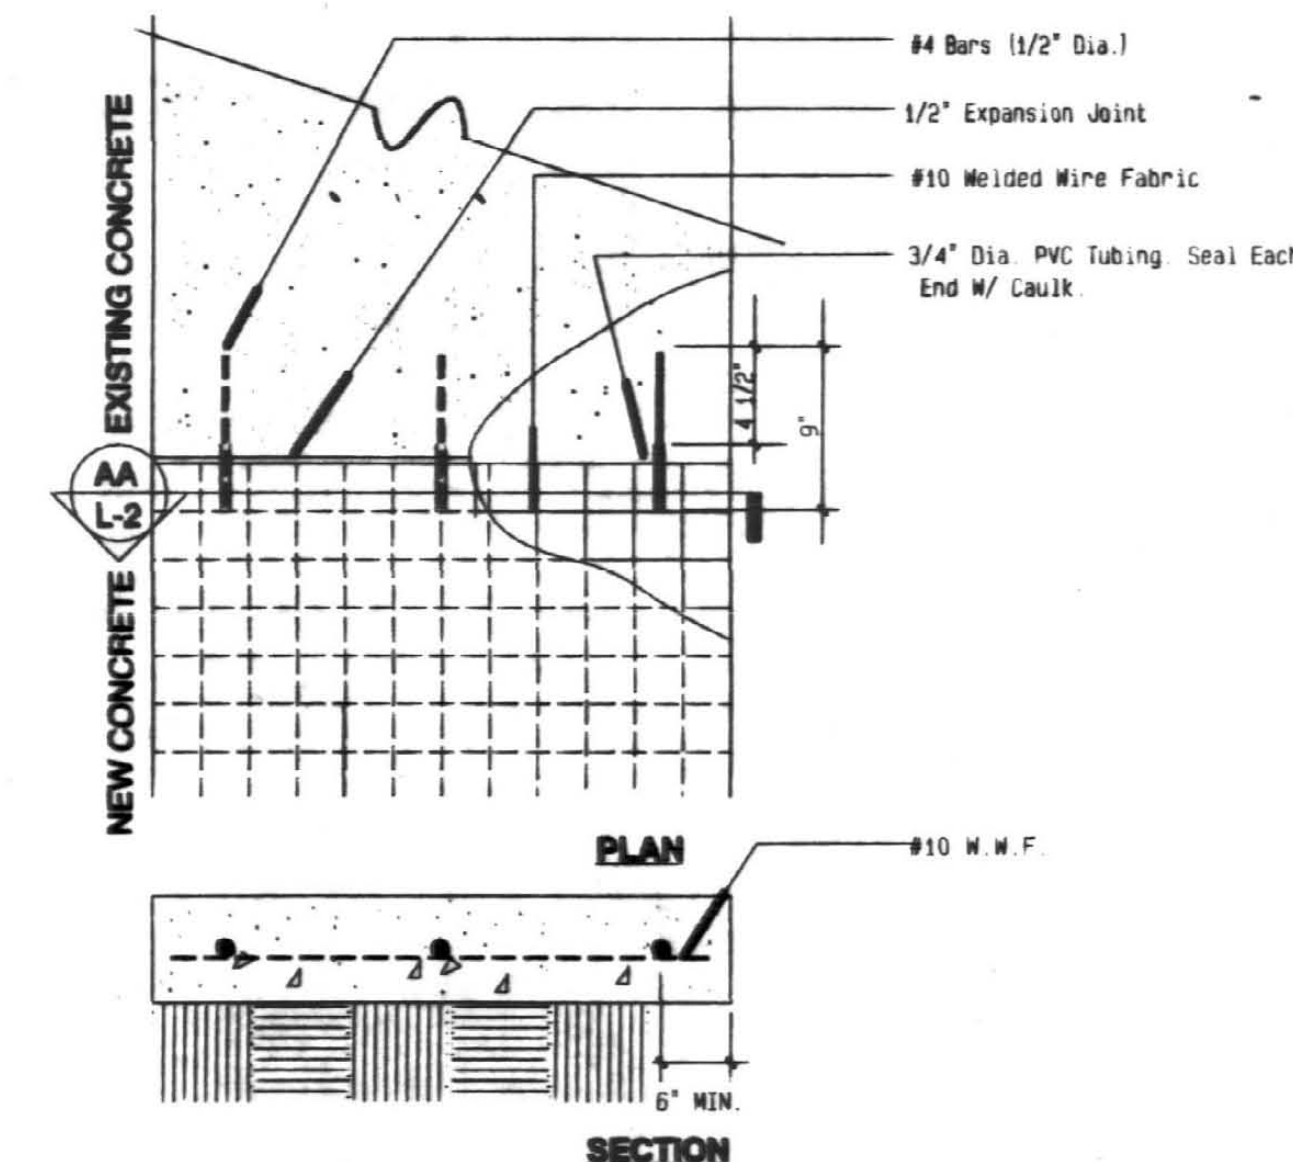

Concrete Pinning

N.T.S.


F
L-2

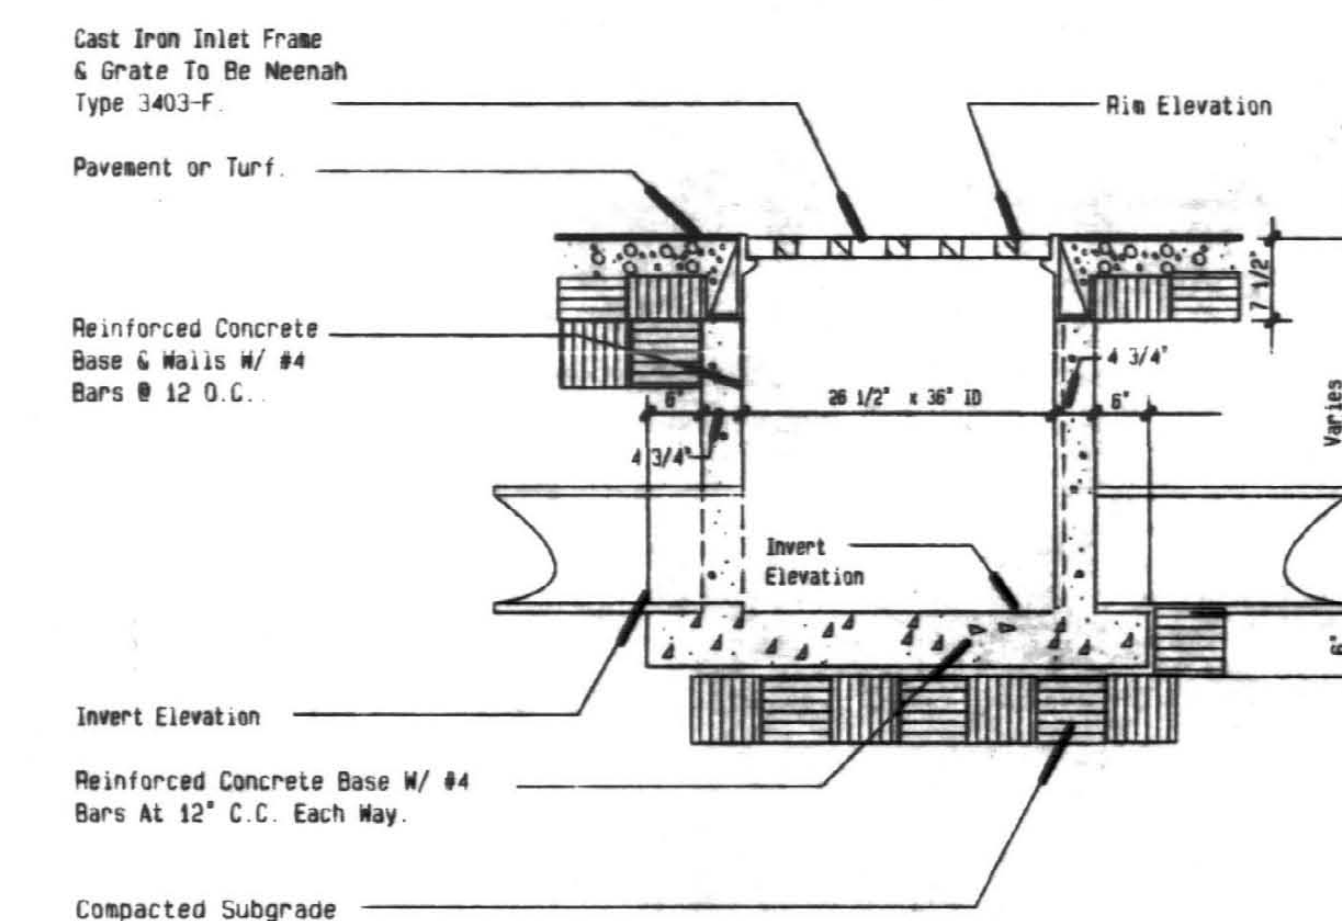

Type "B" Inlet

N.T.S.

G
L-2

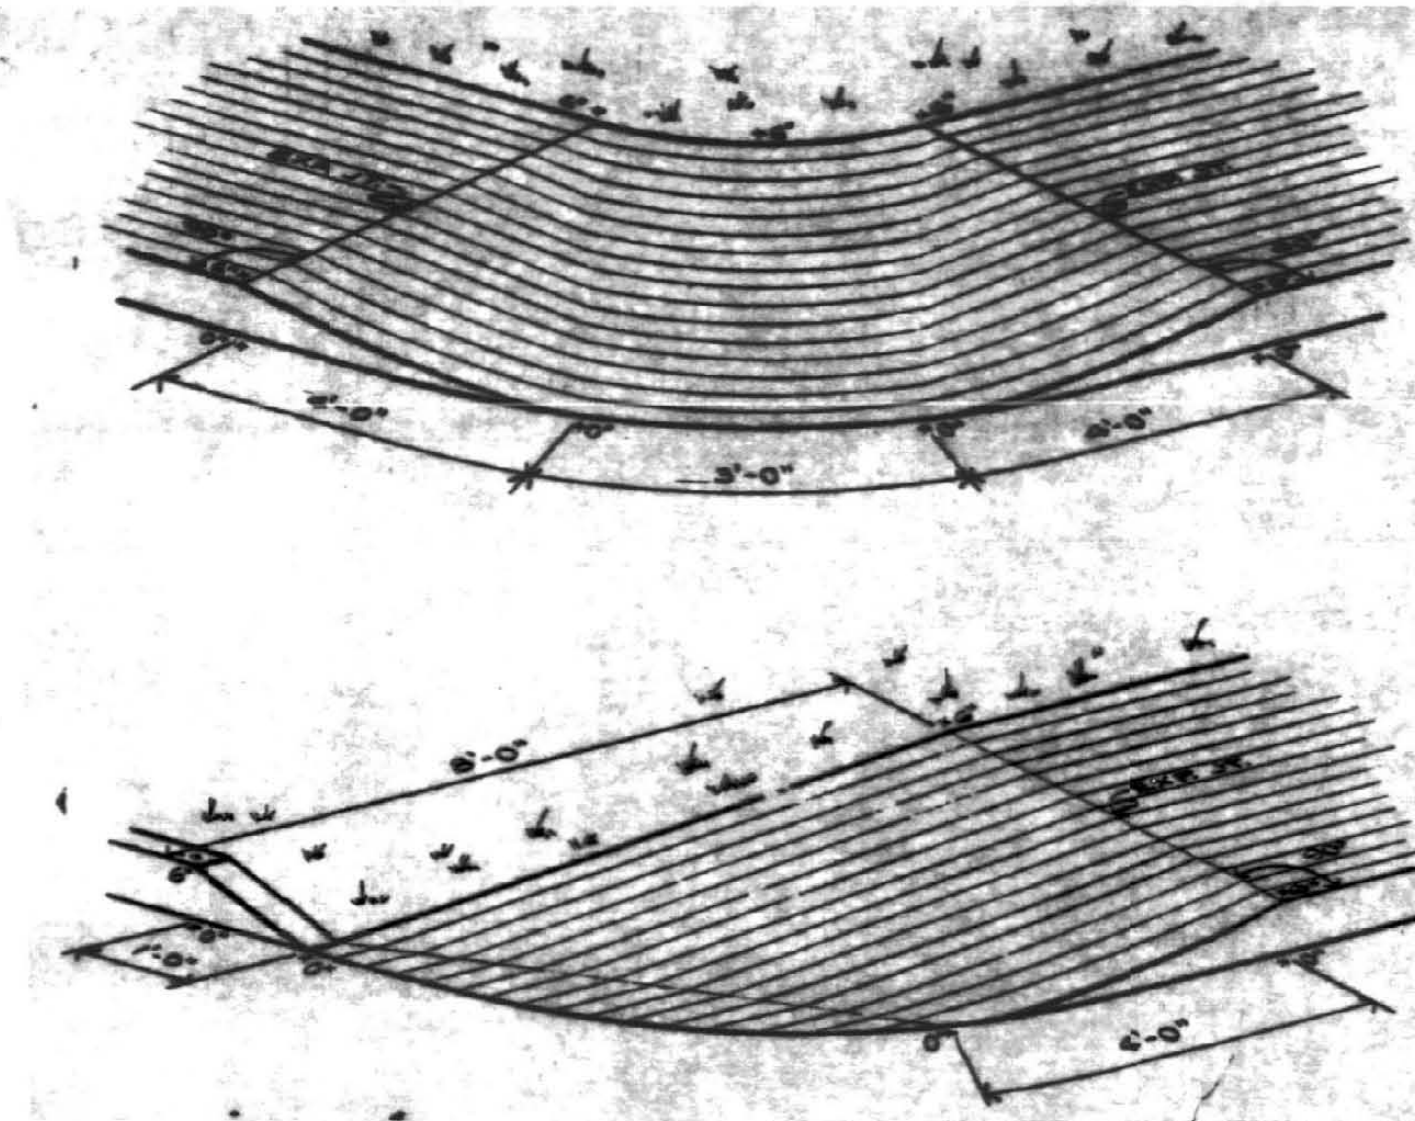


Curb Ramp

Scale: 1" = 1'-0"

H
L-2

NOTE: SEED, SOD, AND MULCH ARE IN THE BASE BID.

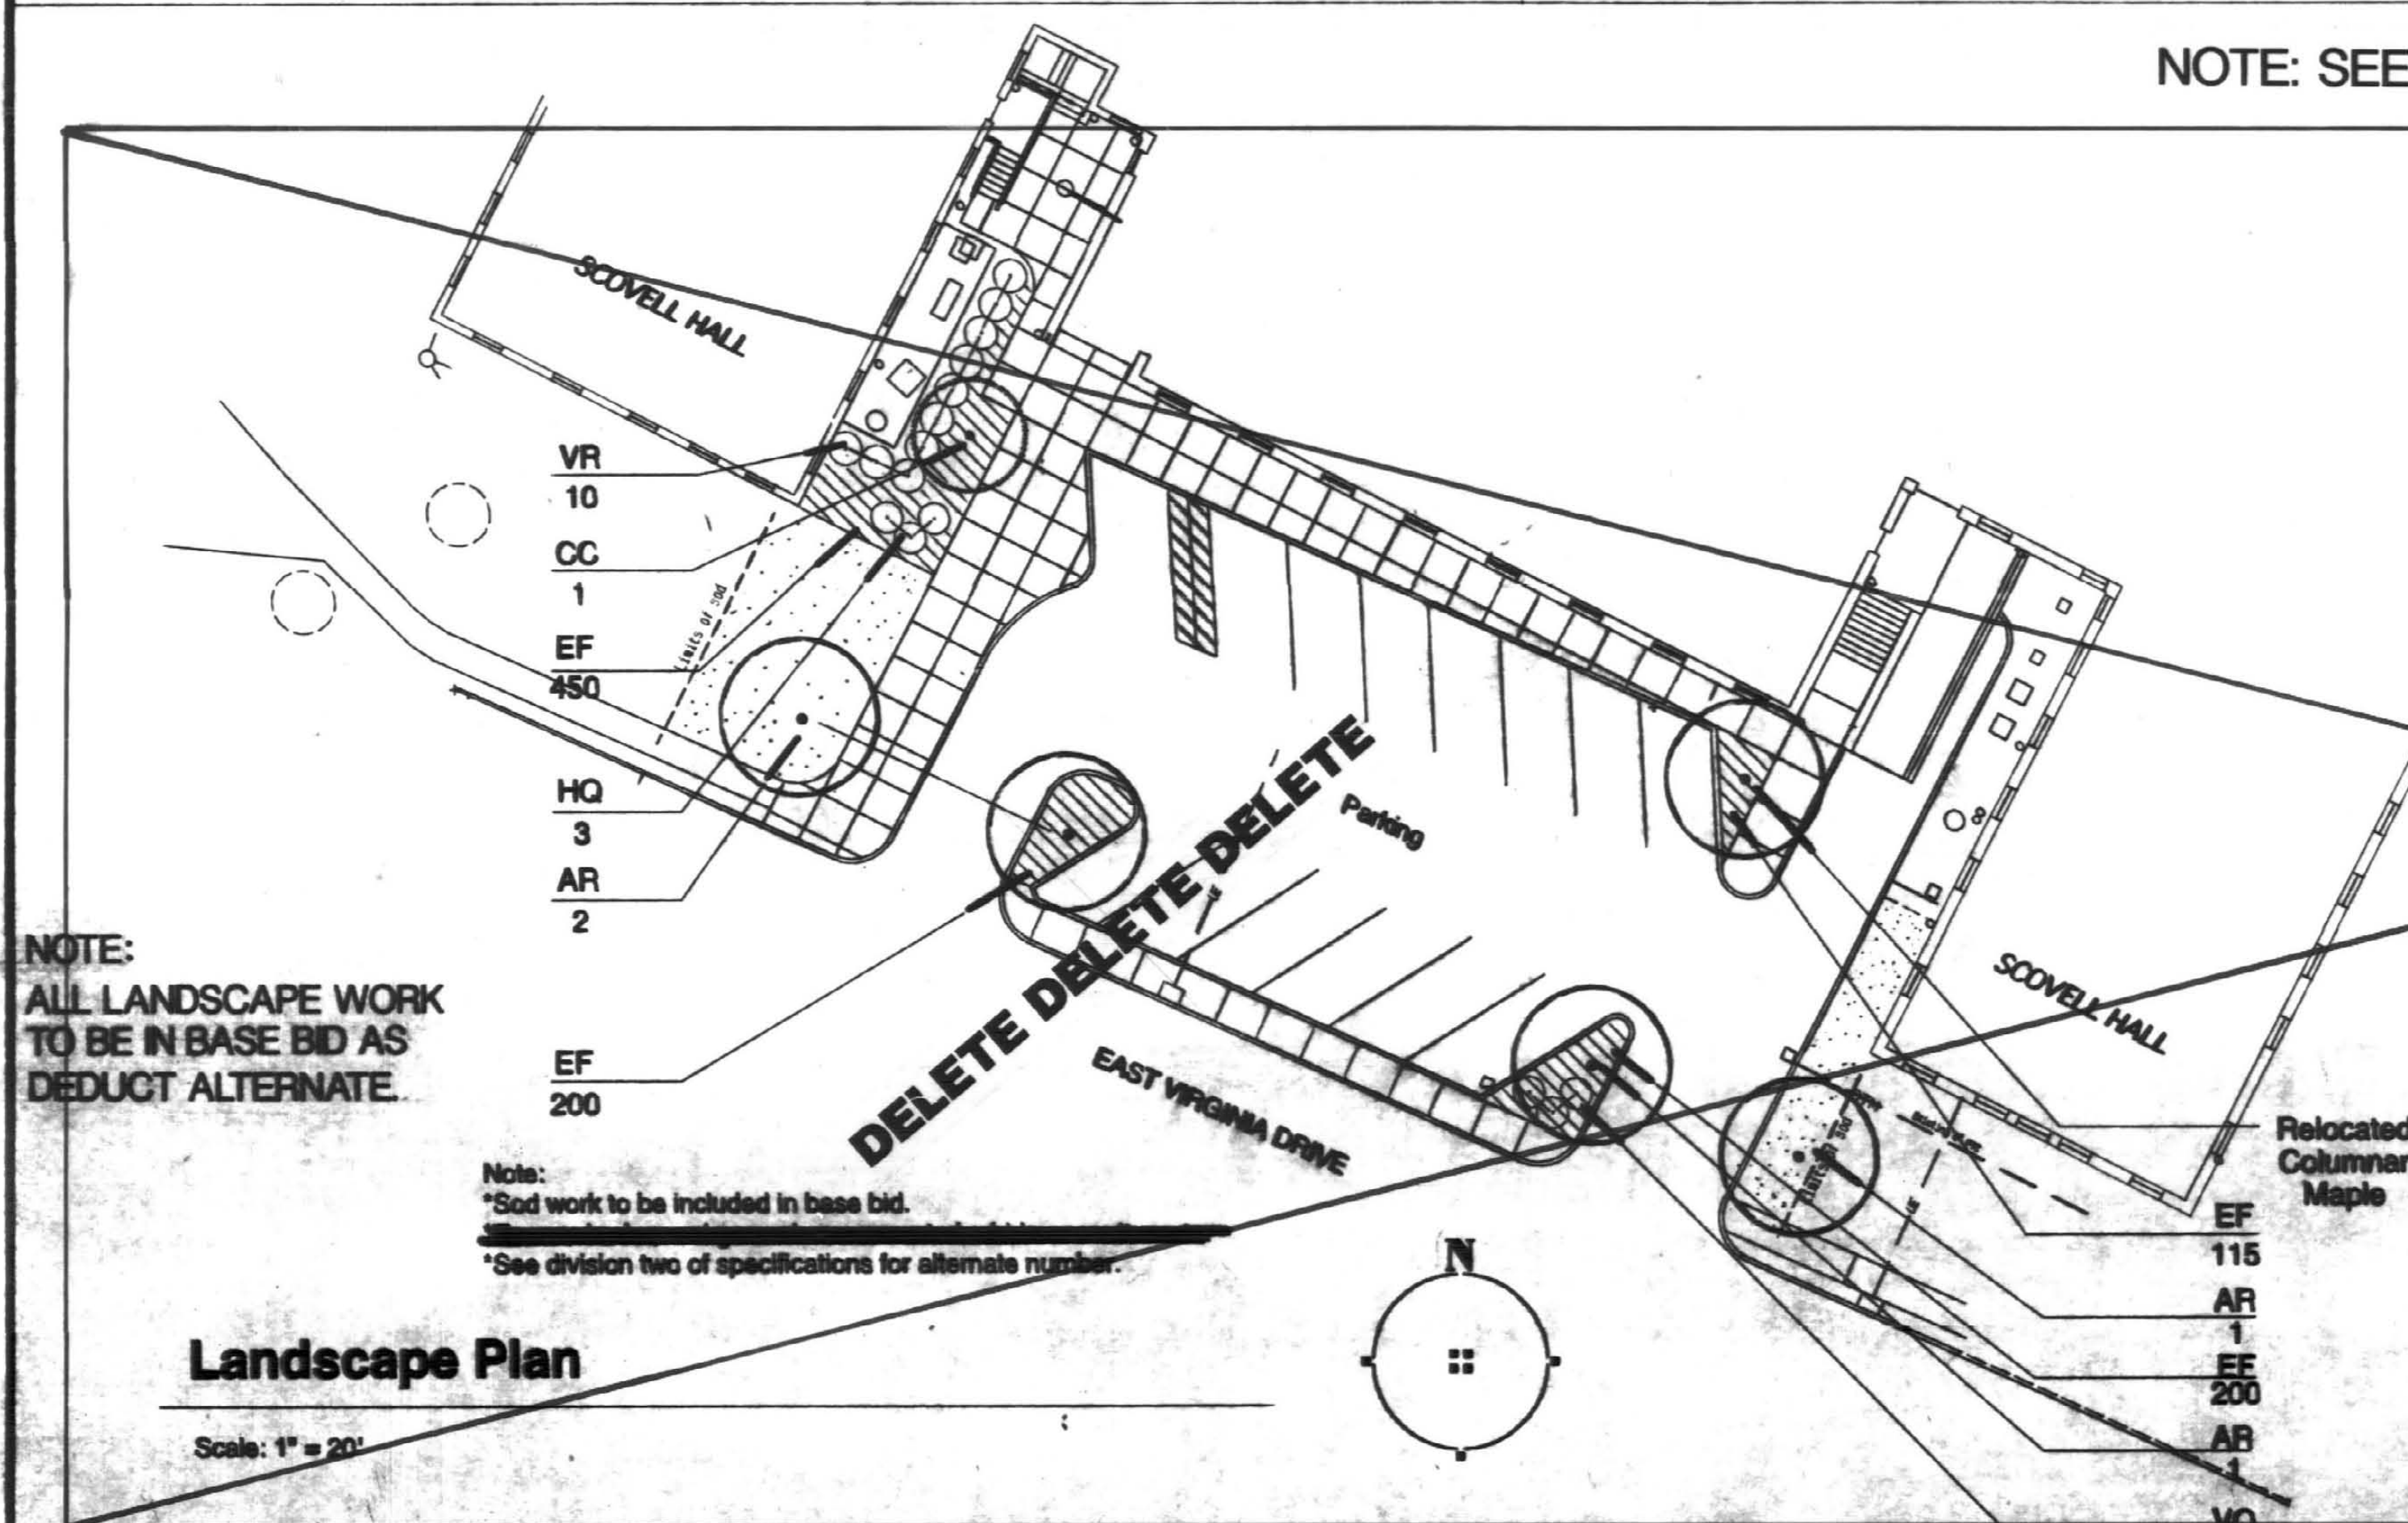

Landscape Plan


Scale: 1" = 20'

PLANT LIST

KEY	BOTANICAL NAME	COMMON NAME	CALIPER	HEIGHT	SPREAD	BALL DIA
AR	Acer rubrum 'October Glory'	October Glory Red Maple	2-1/2"	15'		24"
CC	Cercis canadensis	Redbud	2-1/2"	15'		24"
VR	Viburnum acerifolium 'Allegany'	Allegheny Viburnum	4"	3'	15'	
HQ	Hydrangea quercifolia	Oakleaf Hydrangea	3-4"	24"	15'	
VO	Viburnum opulus 'Compactum'	Compact European Cranberrybush	18" - 24"			2 1/4" Pots
EF	Eunymia fortunei 'Colorata'	Purpleleaf Wintercreeper				

PLANTING NOTES:

1. THE CONTRACTOR WILL BE RESPONSIBLE FOR STAKING AND LAYOUT OF THE PLANTINGS ON THIS PROJECT.
2. UNLESS OTHERWISE SPECIFIED, ALL PLANTS TO BE FURNISHED BALLED AND BURLAPPED OR CONTAINER GROWN.
3. ALL TREES ARE TO HAVE A WELL-FORMED HEAD WITH A MINIMUM HEIGHT AND SPREAD OF THE BRANCHES AS SHOWN ON THE PLANT KEY. THIS DIMENSION ALONG WITH CALIPER SHALL BE CAREFULLY CHECKED.
4. ALL TREES PLANTED IN THE FALL OR EARLY WINTER ARE TO BE WRAPPED IMMEDIATELY AFTER PLANTING.
5. THE CONTRACTOR IS HEREBY NOTIFIED OF THE EXISTENCE OF UNDERGROUND UTILITIES FOR HIS OWN PROTECTION HE SHOULD VERIFY THE EXACT LOCATION OF ALL UTILITIES PRIOR TO COMMENCEMENT OF DIGGING OPERATIONS.
6. UNLESS OTHERWISE INDICATED, SHREDDED BARK-MULCH SHALL BE USED IN ALL SHRUB AND/OR GROUND COVER BEDS AND A ROUND ALL TREES PLANTED WITHIN OR BEYOND THE CONFINES OF THE PLANTING BED.
7. THE CONTRACTOR SHALL PREPARE A CULTIVATED BED AROUND EACH GROUP OF SHRUBS AND/OR GROUND COVER BEDS, THE SAME SHAPE AND SIZE AS SHOWN ON THE PLAN. THE BED SHALL BE TREATED WITH A HERBICIDE AND ROLLED. A CRISP WELL DEFINED EDGE SHALL BE DEVELOPED BETWEEN ANY SHRUB AND/OR GROUND COVER BED AND THE ADJOINING LAWN.
8. ONLY NURSERY GROWN PLANT MATERIAL SHALL BE USED. COLLECTED PLANT MATERIAL IS NOT ACCEPTABLE.
9. THE CONTRACTOR SHALL BE RESPONSIBLE FOR THE COMPLETE REMOVAL OF ALL BINDING CORDS AND ROPES FROM THE TRUNKS OF ALL SHADE AND ORNAMENTAL TREES IMMEDIATELY AFTER PLANTING. IDENTIFICATION TAGS AND RIBBONS SHALL BE REMOVED FROM ALL PLANT MATERIAL AT THE TIME OF PLANTING.
10. UNLESS OTHERWISE AUTHORIZED BY THE ARCHITECT, MEDIUM SPREADING SHRUBS SHALL BE PLANTED NO CLOSER THAN 30' TO ANY ADJOINING WALL OR PAVED AREA. LARGE SPREADING SHRUBS SHALL BE NO CLOSER THAN 36' TO ANY ADJOINING WALL OR PAVED AREA. ESPALIERED SHRUBS SHALL NOT BE PLANTED MORE THAN 12" FROM ANY WALL.
11. ALL LAWN AREAS DISTURBED BY CONSTRUCTION ARE TO BE SOODED UNLESS OTHERWISE INDICATED. SEE PLAN FOR LOCATION OF SOD/DEED.
12. UNLESS OTHERWISE AUTHORIZED OR SPECIFIED ALL PLANT MATERIAL SHALL MEET THE CURRENT MINIMUM STANDARDS SET BY THE AMERICAN ASSOCIATION OF NURSERYMEN AS SPECIFIED IN THE AMERICAN STANDARD FOR NURSERY 260.1.

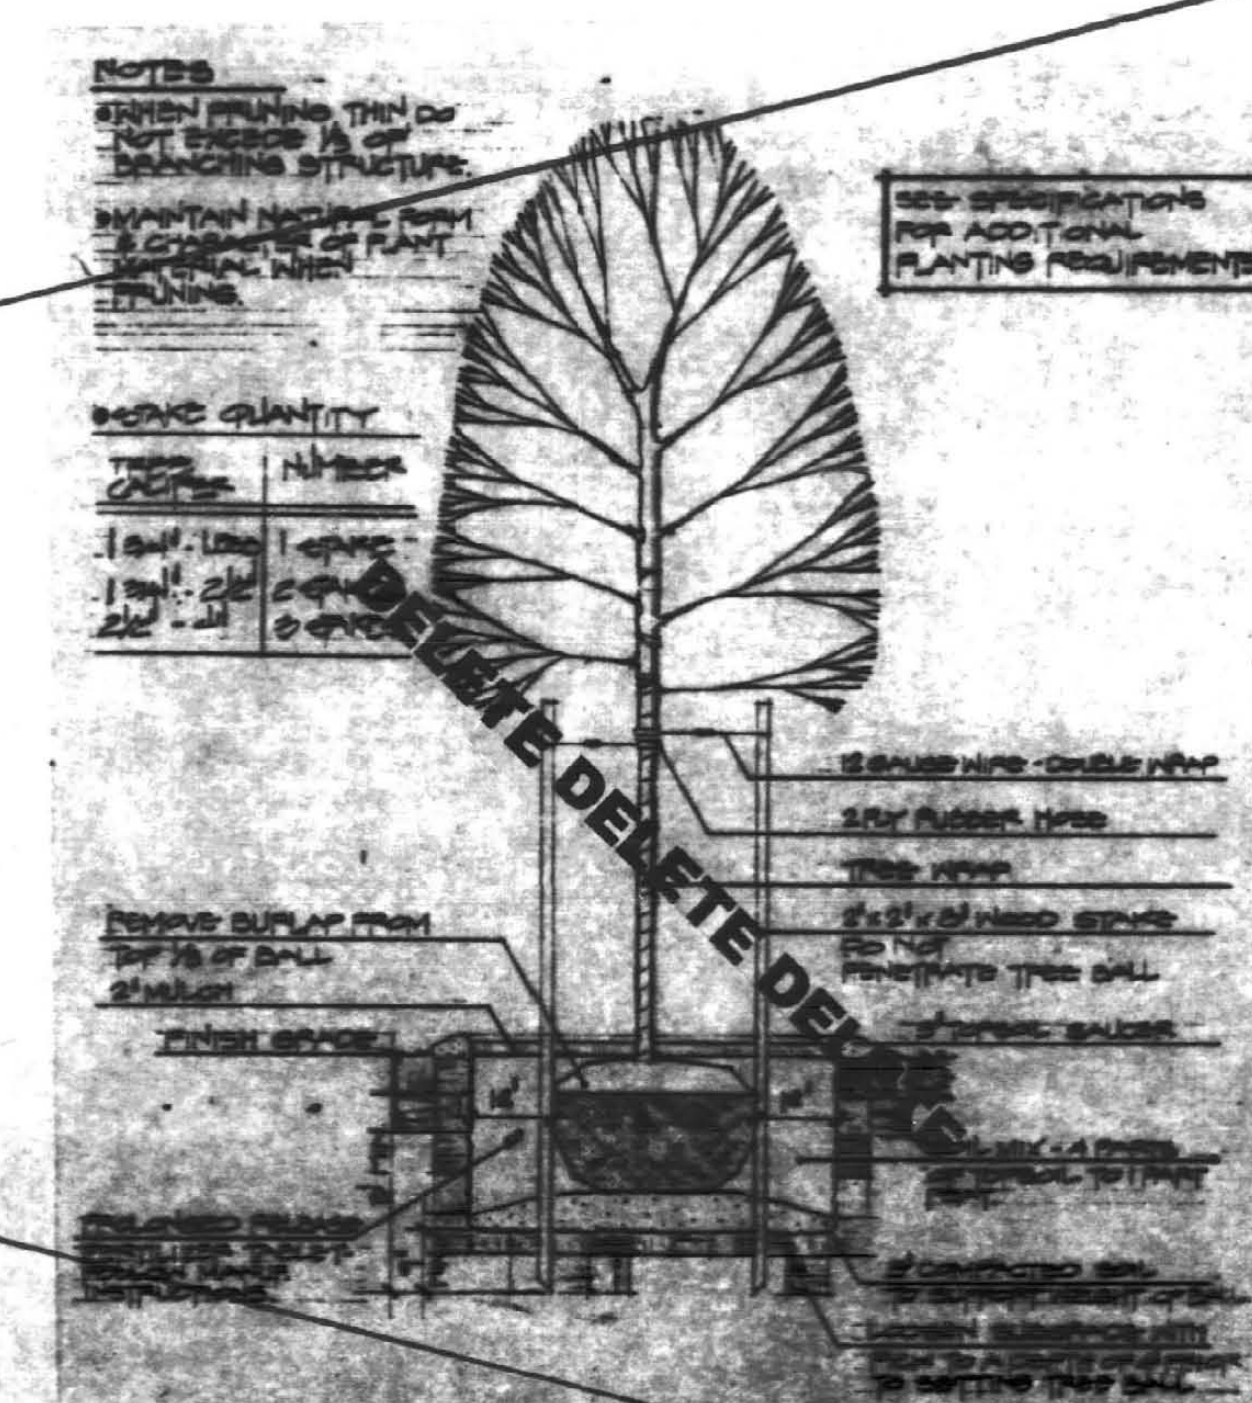

Tree Guying & Staking

N.T.S.

G
L-2

SCOVELL HALL RENOVATION

LANDSCAPE PLAN / DETAILS

UNIVERSITY OF KENTUCKY

AS-BUILT AUG. 10, 1995

Architects
Landscape Architecture
Civil Engineering
Interior Design
210 North Upper Street
Lexington, KY 40502
(606) 258-6884 Fax (606) 258-2592







Omni
Architects



University of Kentucky
Design and Construction
Division
UNIVERSITY OF KENTUCKY
LEXINGTON, KENTUCKY
Cable: 258-6884
Fax: 258-2592

002104

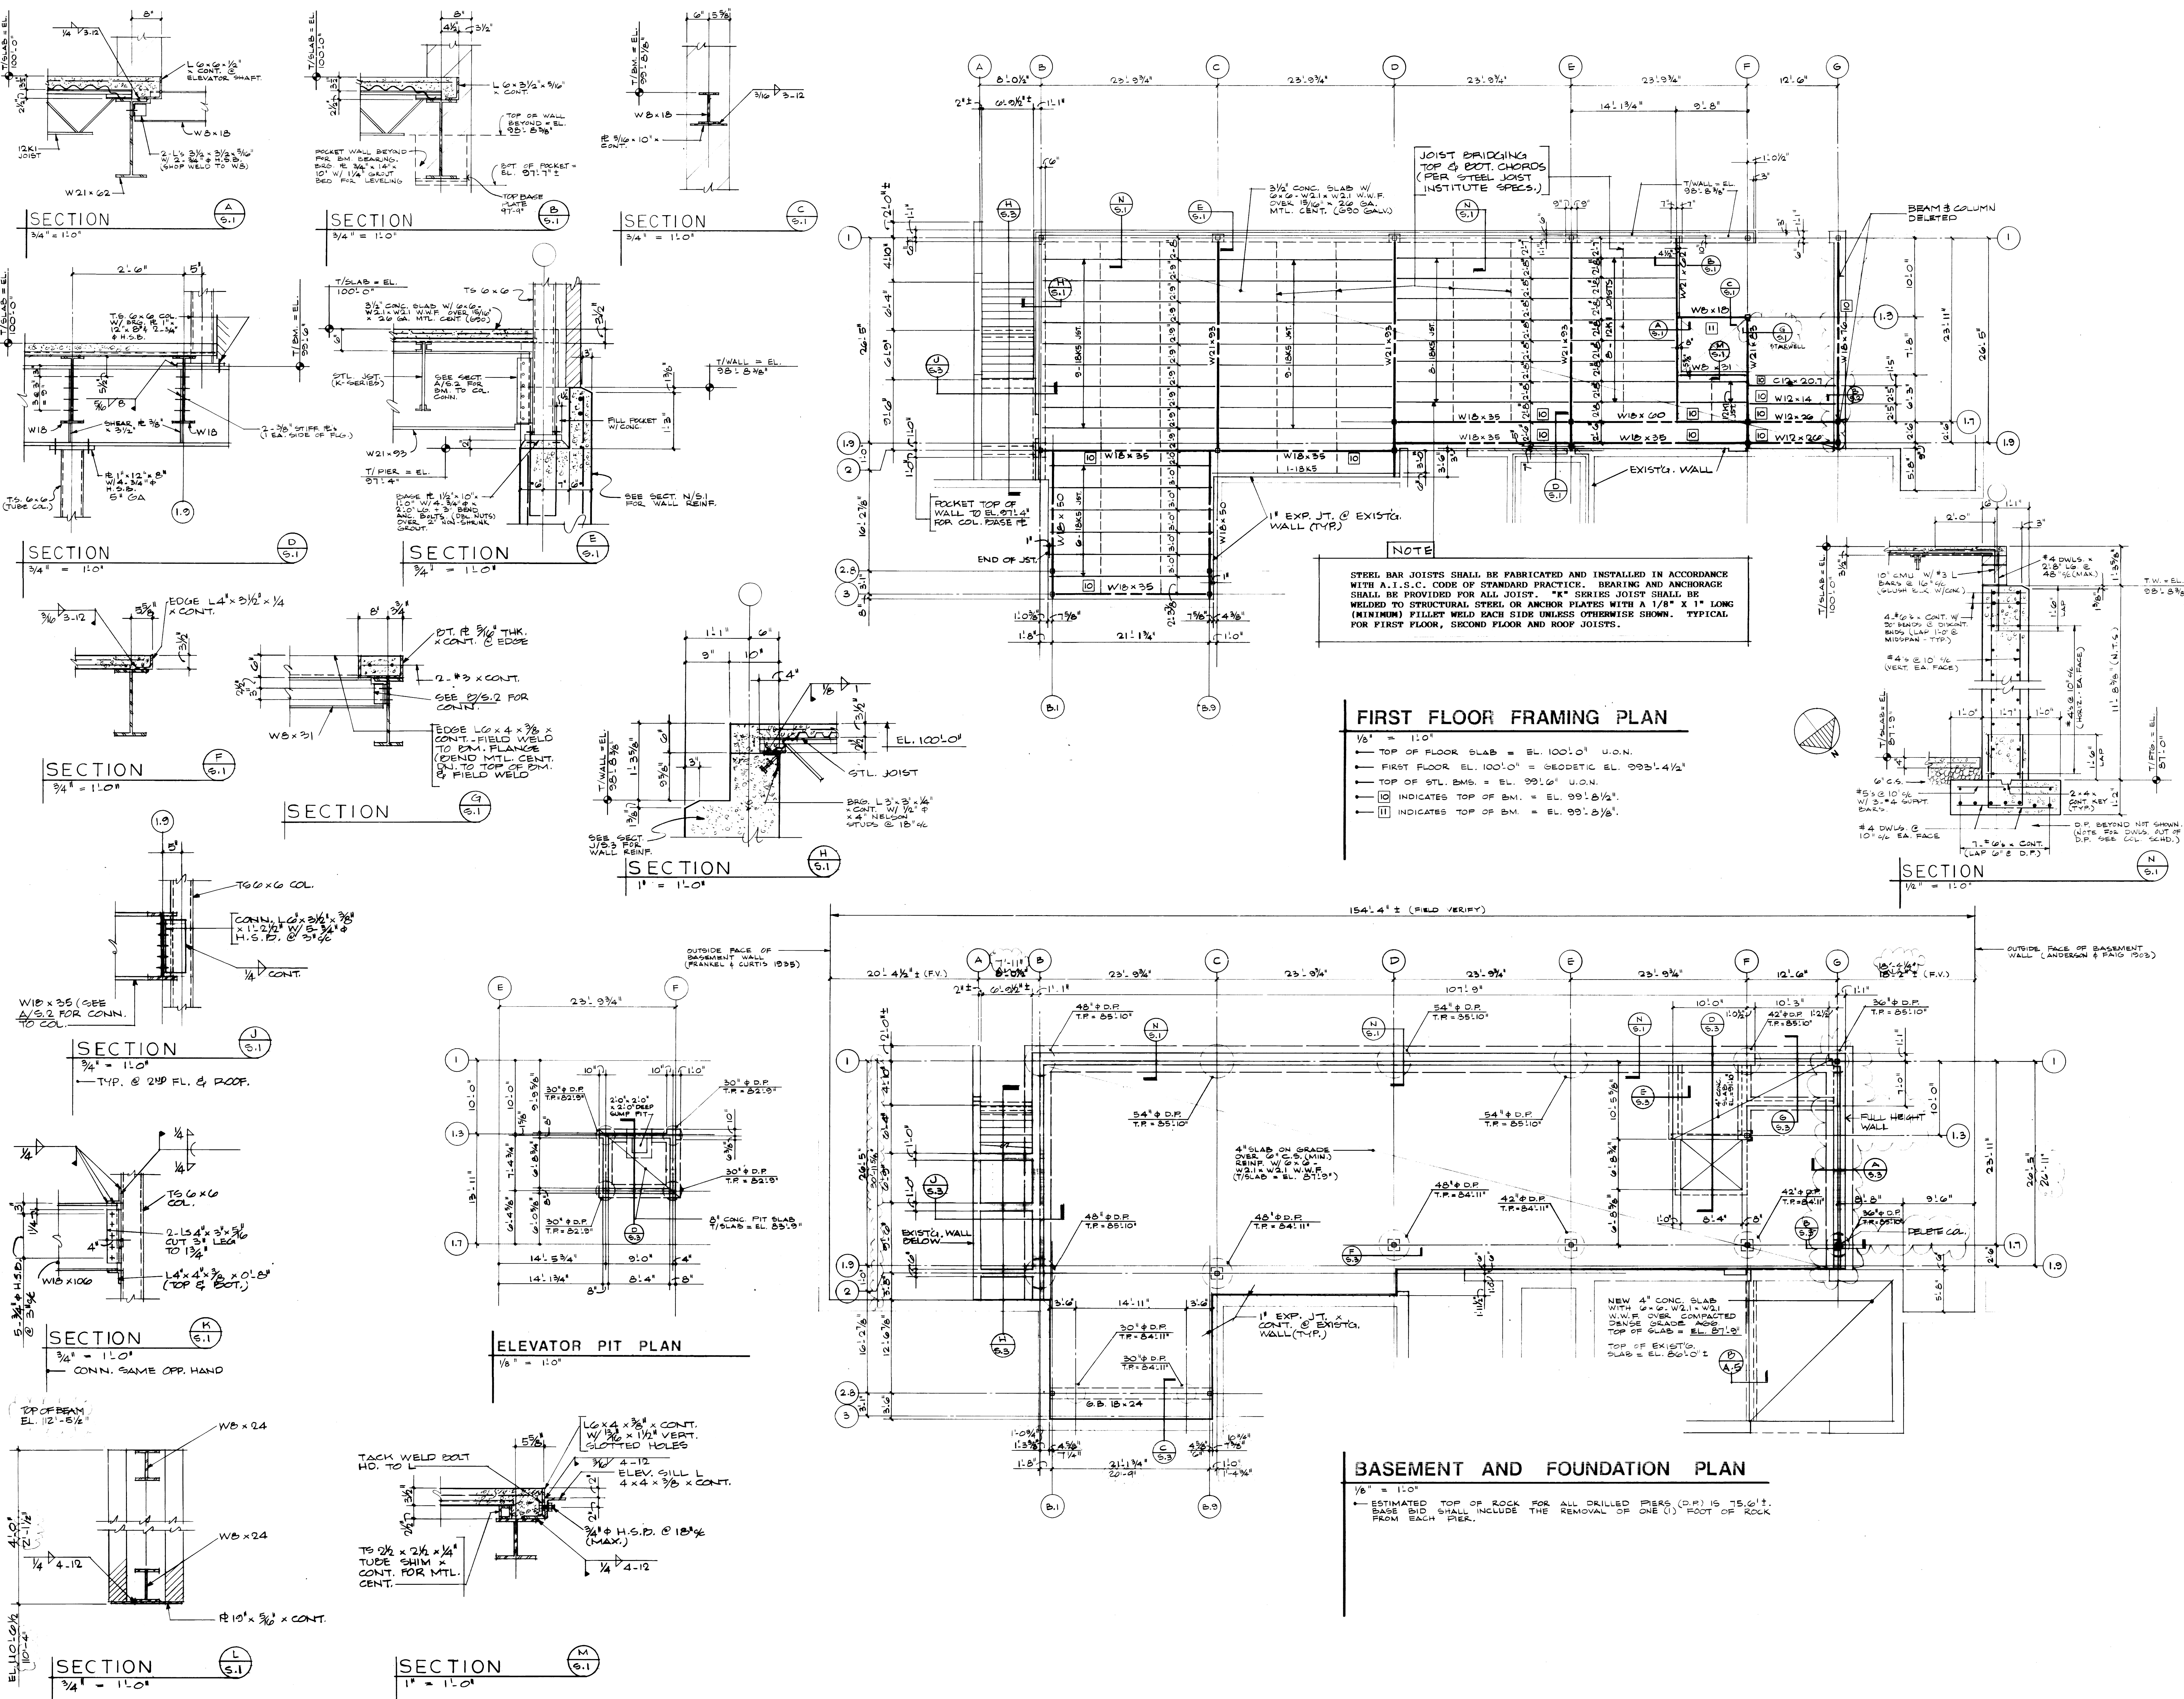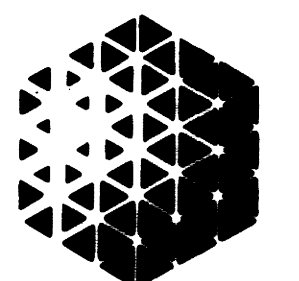


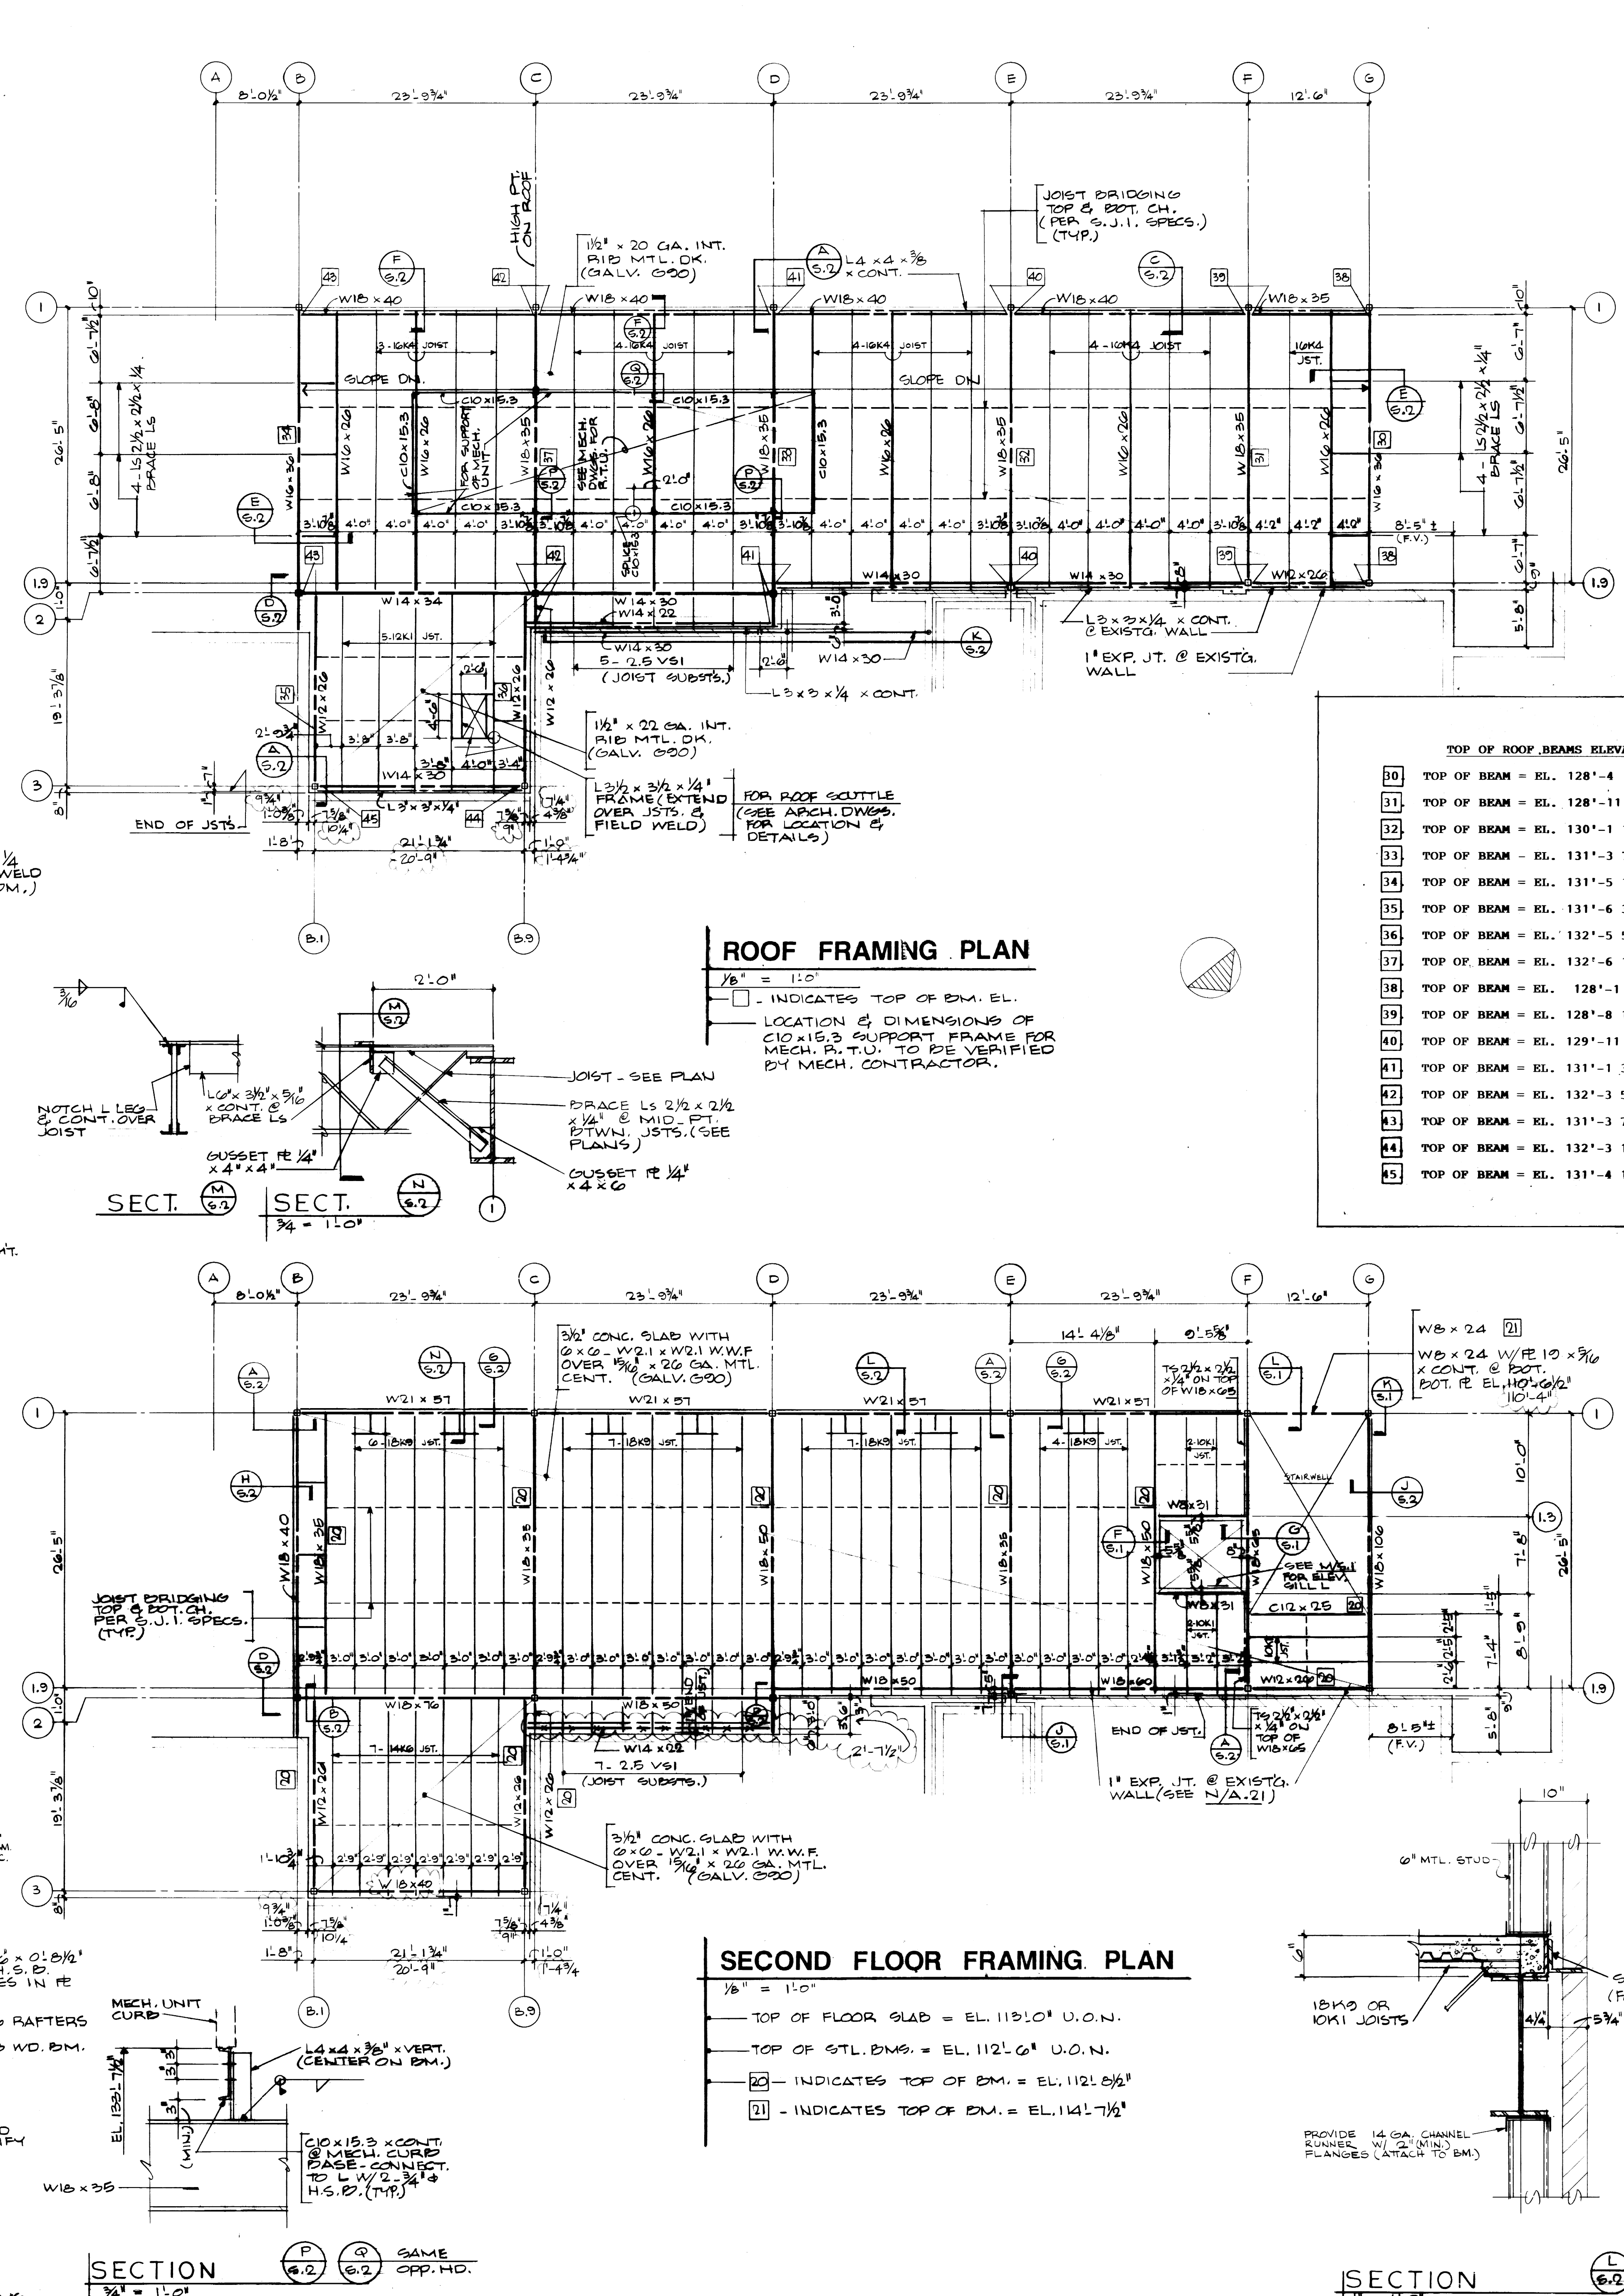
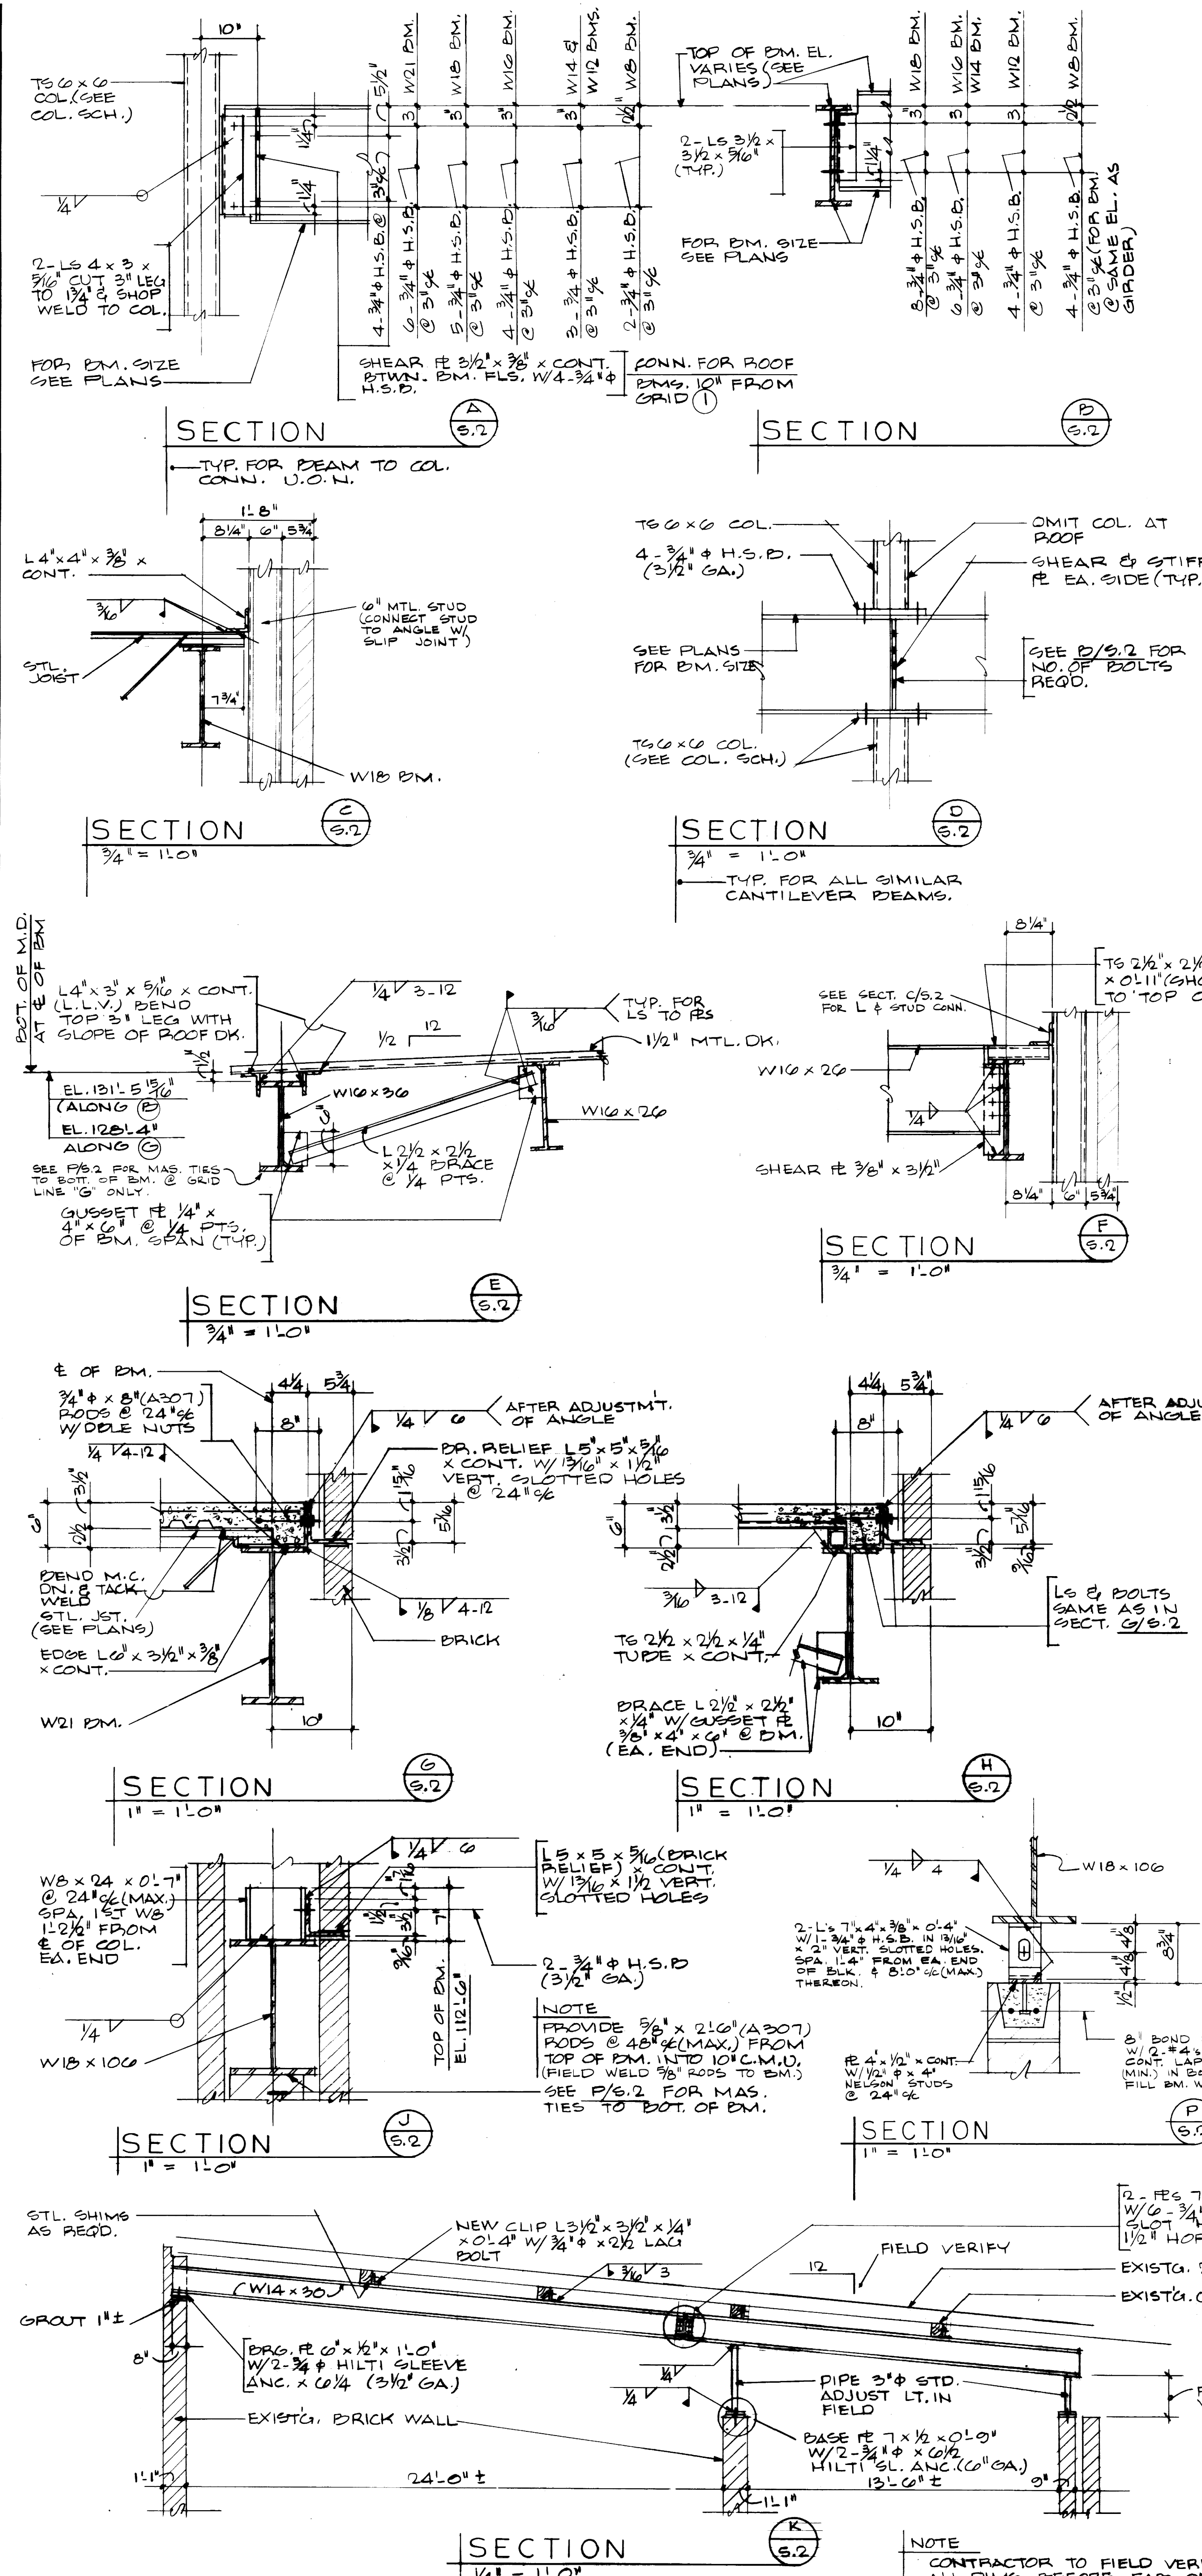


TOP OF ROOF BEAMS ELEVATIONS	
10	TOP OF BEAM = EL. 128'-4"
11	TOP OF BEAM = EL. 128'-11 7/16"
12	TOP OF BEAM = EL. 130'-1 11/16"
13	TOP OF BEAM = EL. 131'-3 7/8"
14	TOP OF BEAM = EL. 131'-5 15/16"
15	TOP OF BEAM = EL. 131'-6 3/4"
16	TOP OF BEAM = EL. 132'-5 5/8"
17	TOP OF BEAM = EL. 132'-6 1/8"
18	TOP OF BEAM = EL. 128'-1 1/2"
19	TOP OF BEAM = EL. 128'-8 15/16"
20	TOP OF BEAM = EL. 129'-11 3/16"
21	TOP OF BEAM = EL. 131'-1 3/8"
22	TOP OF BEAM = EL. 132'-3 5/8"
23	TOP OF BEAM = EL. 131'-3 7/16"
24	TOP OF BEAM = EL. 132'-3 1/8"
25	TOP OF BEAM = EL. 131'-4 1/4"



ROOF FRAMING PLAN
1/8" = 1'-0"
- INDICATES TOP OF BM. EL.
- LOCATION & DIMENSIONS OF
MECH. P.T.U. TO BE VERIFIED
BY MECH. CONTRACTOR.

SECOND FLOOR FRAMING PLAN
1/8" = 1'-0"
- TOP OF FLOOR SLAB = EL. 115'-0" U.O.N.
- TOP OF STL. BM. = EL. 112'-6" U.O.N.
- [Symbol] - INDICATES TOP OF BM. = EL. 112'-6 1/2"
- [Symbol] - INDICATES TOP OF BM. = EL. 114'-7 1/2"

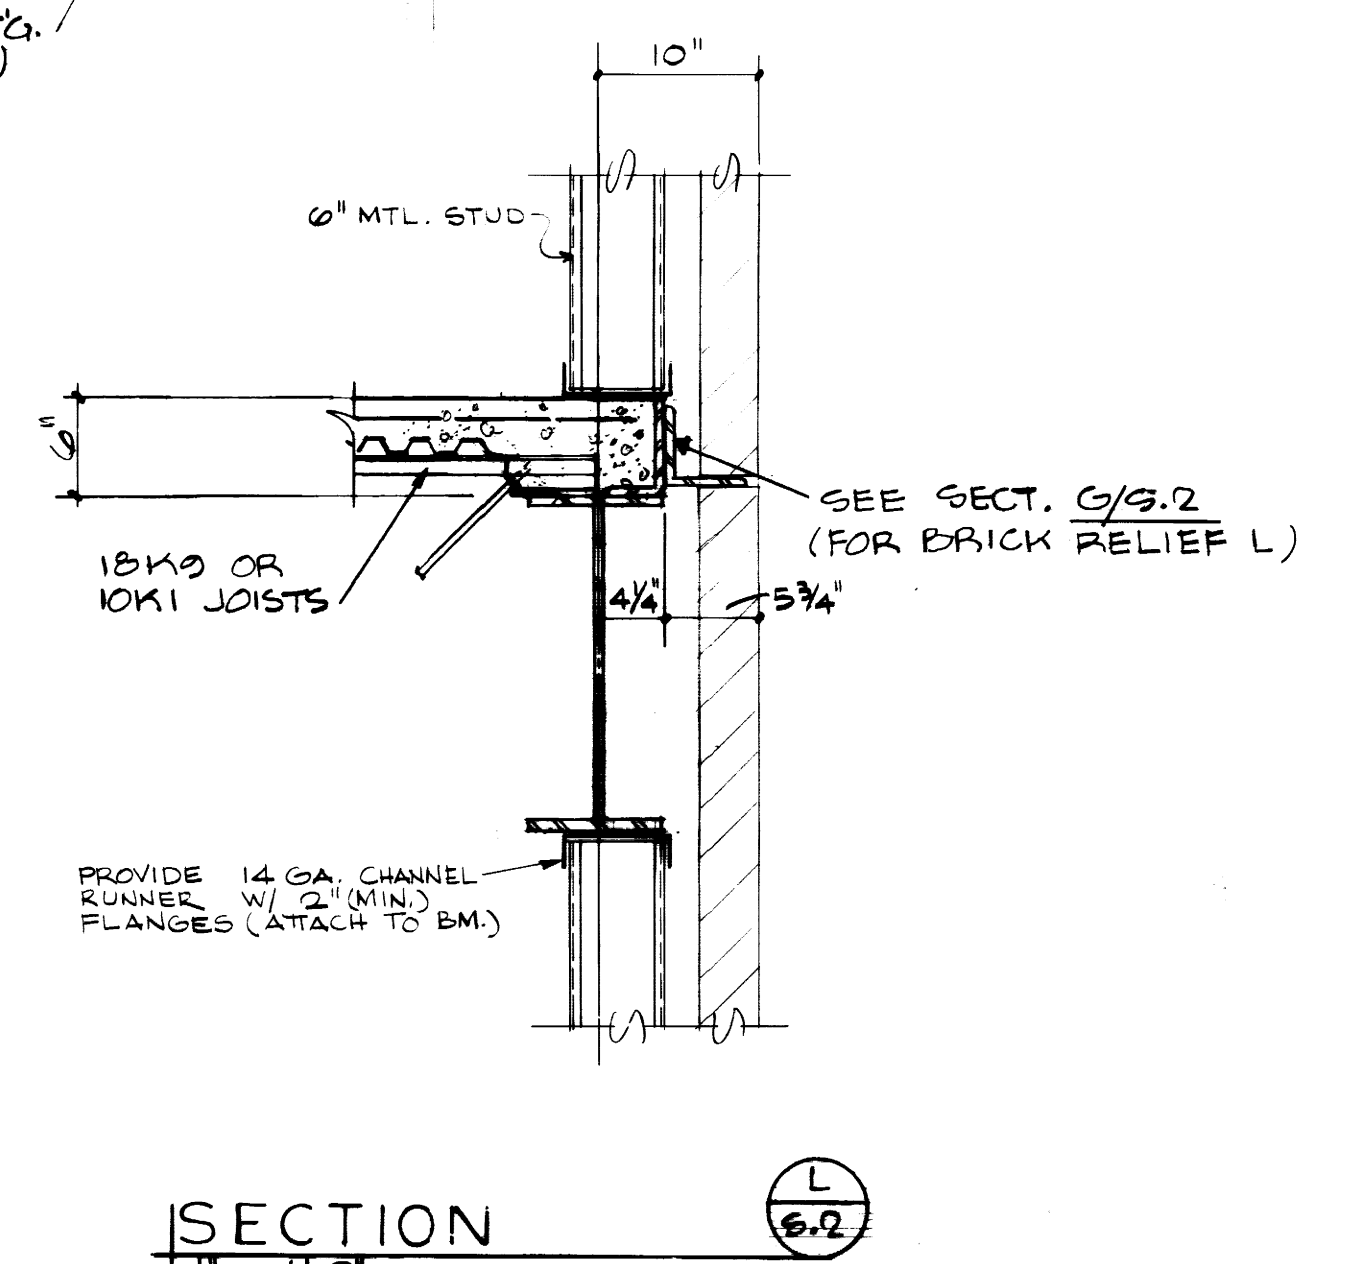


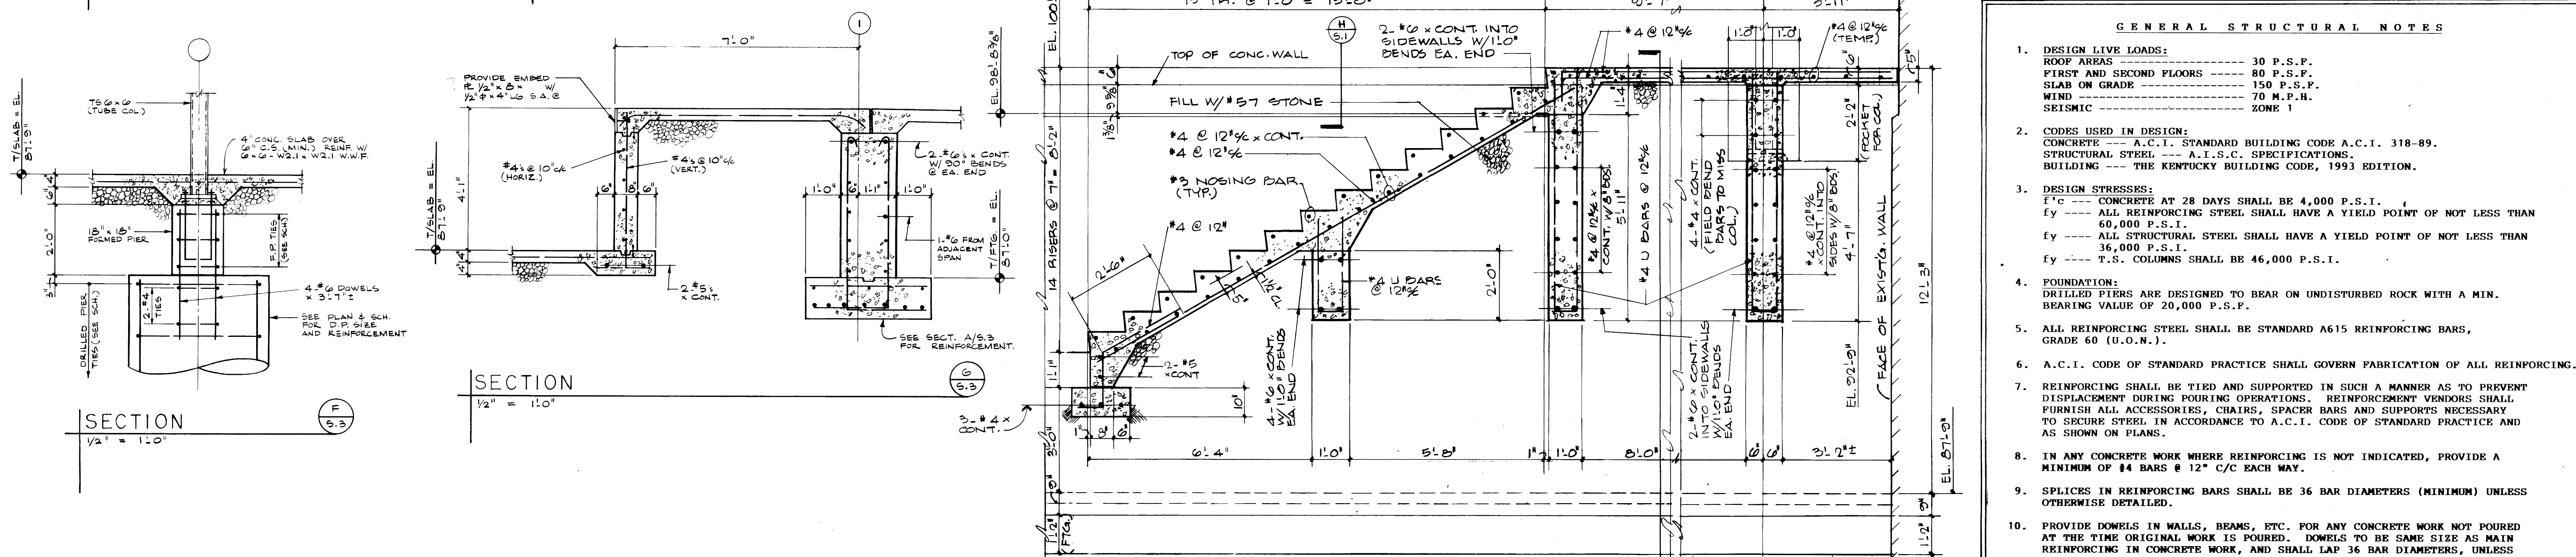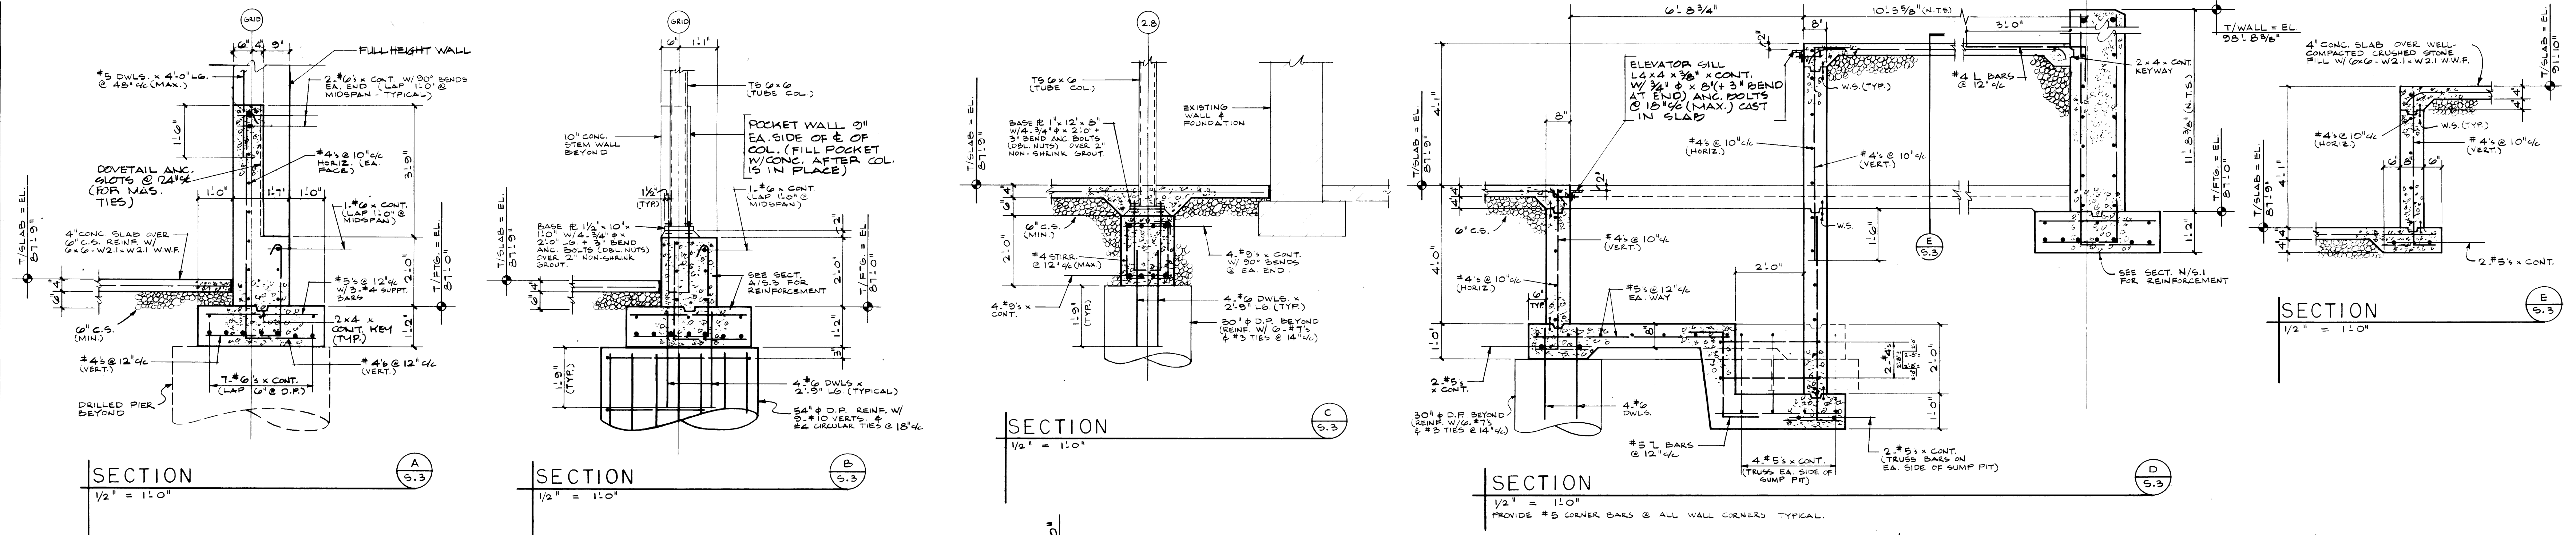


Column Number	B-1	B-2	B-1.2.8	B-1.3	B-2.8	B-3.3	C-1	C-2	D-1	D-1.7	D-2	E-1	E-1.7	E-2	F-1	F-1.3	F-1.7	F-1.9	G-1	G-1.7	G-1.9
TOP OF COL. ELEV.	131.5	130.2	98.1	131.6	98.1	132.5	132.6	132.6	131.3	97.8	129.1	130.1	97.8	130.1	128.1	99.1	97.8	128.1	128.1	98.2	128.1
ROOF ELEV.																					
VARIES																					
SECOND FLOOR																					
Elev. = 113.0																					
FIRST FLOOR																					
Elev. = 100.0																					
BASEMENT																					
Elev. = 87.9																					
BASE # SIZE	1/2"x12"	1/2"x12"	1"x12"	1"x12"	1"x12"	1"x12"	1/2"x12"	1/2"x12"	1/2"x12"	1/2"x12"	1/2"x12"	1/2"x12"	1/2"x12"	1/2"x12"	1/2"x12"	1/2"x12"	1/2"x12"	1/2"x12"	1/2"x12"	1/2"x12"	1/2"x12"
BOTT. # ELEV.	98.1	97.1	97.1	99.1	97.1	99.1	97.1	97.1	97.1	97.1	97.1	97.1	97.1	97.1	97.1	97.1	97.1	97.1	97.1	97.1	97.1
BASE DETAIL	(A)	(A)	(B)	(B)	(B)	(B)	(A)	(A)	(C)	(C)	(C)	(A)	(C)	(C)	(A)	(A)	(A)	(A)	(A)	(A)	(A)
POWER PIER																					
SIZE	19" x 19"	19" x 19"	VERT. REIN.	4 # 8	4 # 8	4 # 8	4 # 8	4 # 8	4 # 8	4 # 8	4 # 8	4 # 8	4 # 8	4 # 8	4 # 8	4 # 8	4 # 8	4 # 8	4 # 8	4 # 8	4 # 8	4 # 8	4 # 8	4 # 8
TIES	#3 @ 12"	#3 @ 12"	#3 @ 12"	#3 @ 12"	#3 @ 12"	#3 @ 12"	#3 @ 12"	#3 @ 12"	#3 @ 12"	#3 @ 12"	#3 @ 12"	#3 @ 12"	#3 @ 12"	#3 @ 12"	#3 @ 12"	#3 @ 12"	#3 @ 12"	#3 @ 12"	#3 @ 12"	#3 @ 12"	#3 @ 12"
DRILLED PIER																					
SIZE	48" x 48"	48" x 48"	30" x 30"	30" x 30"	30" x 30"	30" x 30"	30" x 30"	30" x 30"	30" x 30"	30" x 30"	30" x 30"	30" x 30"	30" x 30"	30" x 30"	30" x 30"	30" x 30"	30" x 30"	30" x 30"	30" x 30"	30" x 30"	30" x 30"
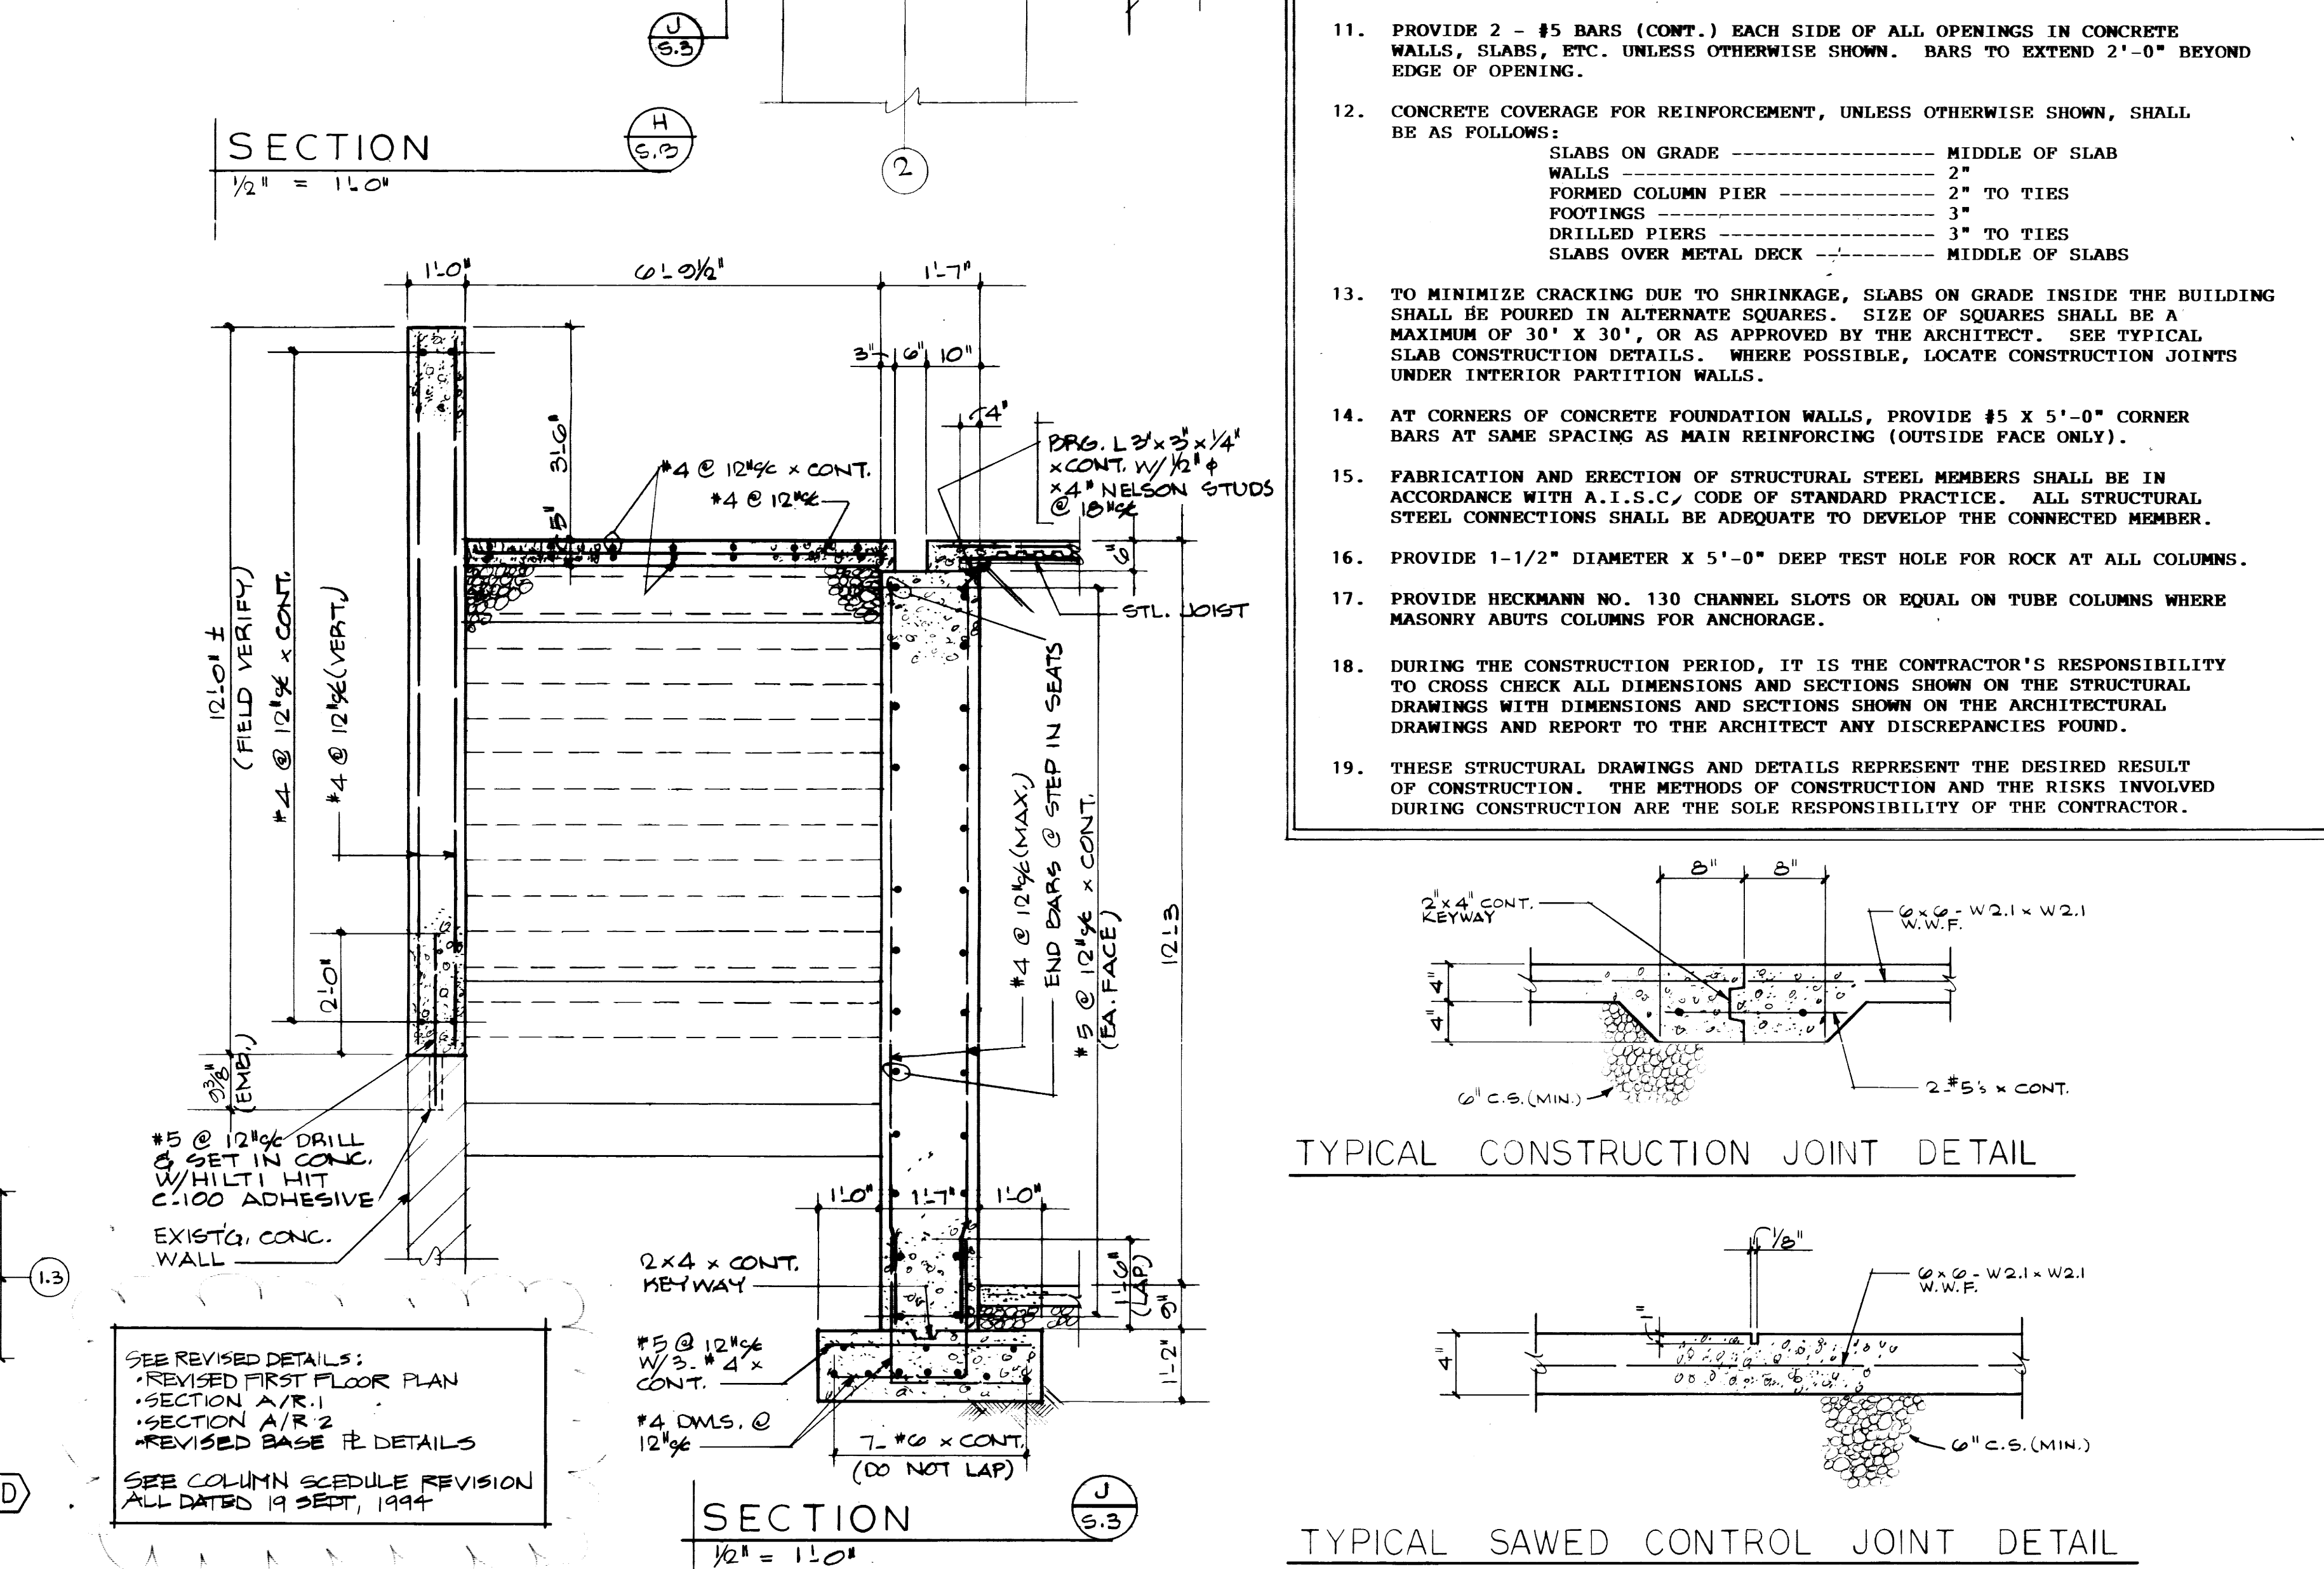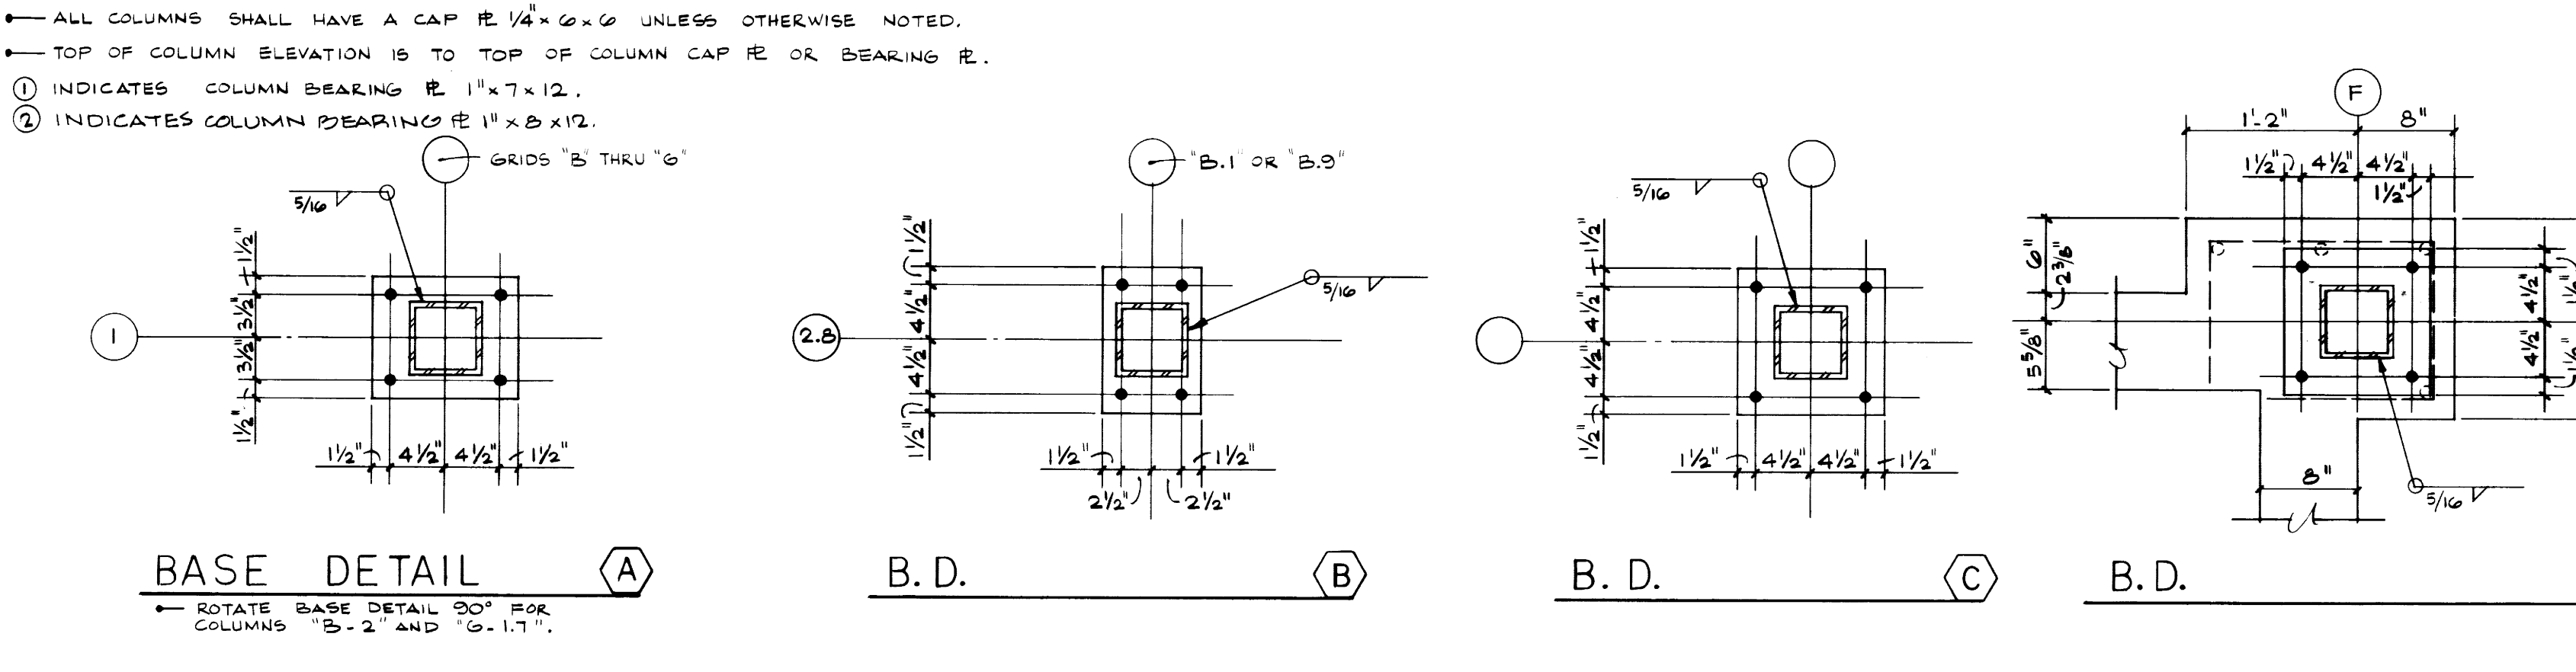



- ### GENERAL STRUCTURAL NOTES
- DESIGN LIVE LOADS:
ROOF AREAS ----- 30 P.S.F.
FIRST AND SECOND FLOORS ----- 80 P.S.F.
SLAB ON GRADE ----- 150 P.S.F.
WIND ----- 70 M.P.H.
SEISMIC ----- ZONE 1
 - CODES USED IN DESIGN:
CONCRETE ----- A.C.I. STANDARD BUILDING CODE A.C.I. 318-89.
STRUCTURAL STEEL ----- A.I.S.C. SPECIFICATIONS.
BUILDING ----- THE KENTUCKY BUILDING CODE, 1993 EDITION.
 - DESIGN STRESSES:
F'c ----- CONCRETE AT 28 DAYS SHALL BE 4,000 P.S.I.
fy ----- ALL REINFORCING STEEL SHALL HAVE A YIELD POINT OF NOT LESS THAN 60,000 P.S.I.
fy ----- ALL STRUCTURAL STEEL SHALL HAVE A YIELD POINT OF NOT LESS THAN 36,000 P.S.I.
fy ----- T.S. COLUMNS SHALL BE 46,000 P.S.I.
 - FOUNDATION:
DRILLED PIERS ARE DESIGNED TO BEAR ON UNDISTURBED ROCK WITH A MIN. BEARING VALUE OF 20,000 P.S.F.
 - ALL REINFORCING STEEL SHALL BE STANDARD A615 REINFORCING BARS, GRADE 60 (U.O.N.).
 - A.C.I. CODE OF STANDARD PRACTICE SHALL GOVERN FABRICATION OF ALL REINFORCING.
 - REINFORCING SHALL BE TIED AND SUPPORTED IN SUCH A MANNER AS TO PREVENT DISPLACEMENT DURING POURING OPERATIONS. REINFORCEMENT VENDORS SHALL FURNISH ALL ACCESSORIES, CHAIRS, SPACER BARS AND SUPPORTS NECESSARY TO SECURE STEEL IN ACCORDANCE TO A.C.I. CODE OF STANDARD PRACTICE AND AS SHOWN ON PLANS.
 - IN ANY CONCRETE WORK WHERE REINFORCING IS NOT INDICATED, PROVIDE A MINIMUM OF #4 BARS @ 12" C/C EACH WAY.
 - SPLICES IN REINFORCING BARS SHALL BE 36 BAR DIAMETERS (MINIMUM) UNLESS OTHERWISE DETAILED.
 - PROVIDE DOWELS IN WALLS, BEAMS, ETC. FOR ANY CONCRETE WORK NOT POURED AT THE TIME THE ORIGINAL WORK IS POURED. DOWELS TO BE SAME SIZE AS MAIN REINFORCING IN CONCRETE WORK, AND SHALL LAP 36 BAR DIAMETERS, UNLESS OTHERWISE DETAILED.
 - PROVIDE 2 - #5 BARS (CONT.) EACH SIDE OF ALL OPENINGS IN CONCRETE WALLS, SLABS, ETC. UNLESS OTHERWISE SHOWN. BARS TO EXTEND 2'-0" BEYOND EDGE OF OPENING.
 - CONCRETE COVERAGE FOR REINFORCEMENT, UNLESS OTHERWISE SHOWN, SHALL BE AS FOLLOWS:
SLABS ON GRADE ----- MIDDLE OF SLAB
WALLS ----- 2" TO TIES
FOOTINGS ----- 3"
DRILLED PIERS ----- 3" TO TIES
SLABS OVER METAL DECK ----- MIDDLE OF SLABS
 - TO MINIMIZE CRACKING DUE TO SHRINKAGE, SLABS ON GRADE INSIDE THE BUILDING SHALL BE POURED IN ALTERNATE SQUARES. SIZE OF SQUARES SHALL BE A MAXIMUM OF 30' X 30', OR AS APPROVED BY THE ARCHITECT. SEE TYPICAL SLAB CONSTRUCTION DETAILS. WHERE POSSIBLE, LOCATE CONSTRUCTION JOINTS UNDER INTERIOR PARTITION WALLS.
 - AT CORNERS OF CONCRETE FOUNDATION WALLS, PROVIDE #5 X 5'-0" CORNER BARS AT SAME SPACING AS MAIN REINFORCING (OUTSIDE FACE ONLY).
 - FABRICATION AND ERECTION OF STRUCTURAL STEEL MEMBERS SHALL BE IN ACCORDANCE WITH A.I.S.C. CODE OF STANDARD PRACTICE. ALL STRUCTURAL STEEL CONNECTIONS SHALL BE ADEQUATE TO DEVELOP THE CONNECTED MEMBER.
 - PROVIDE 1-1/2" DIAMETER X 5'-0" DEEP TEST HOLE FOR ROCK AT ALL COLUMNS.
 - PROVIDE HECKMANN NO. 130 CHANNEL SLOTS OR EQUAL ON TUBE COLUMNS WHERE MASONRY ABUTS COLUMNS FOR ANCHORAGE.
 - DURING THE CONSTRUCTION PERIOD, IT IS THE CONTRACTOR'S RESPONSIBILITY TO CROSS CHECK ALL DIMENSIONS AND SECTIONS SHOWN ON THE STRUCTURAL DRAWINGS WITH DIMENSIONS AND SECTIONS SHOWN ON THE ARCHITECTURAL DRAWINGS AND REPORT TO THE ARCHITECT ANY DISCREPANCIES FOUND.
 - THESE STRUCTURAL DRAWINGS AND DETAILS REPRESENT THE DESIRED RESULT OF CONSTRUCTION. THE METHODS OF CONSTRUCTION AND THE RISKS INVOLVED DURING CONSTRUCTION ARE THE SOLE RESPONSIBILITY OF THE CONTRACTOR.

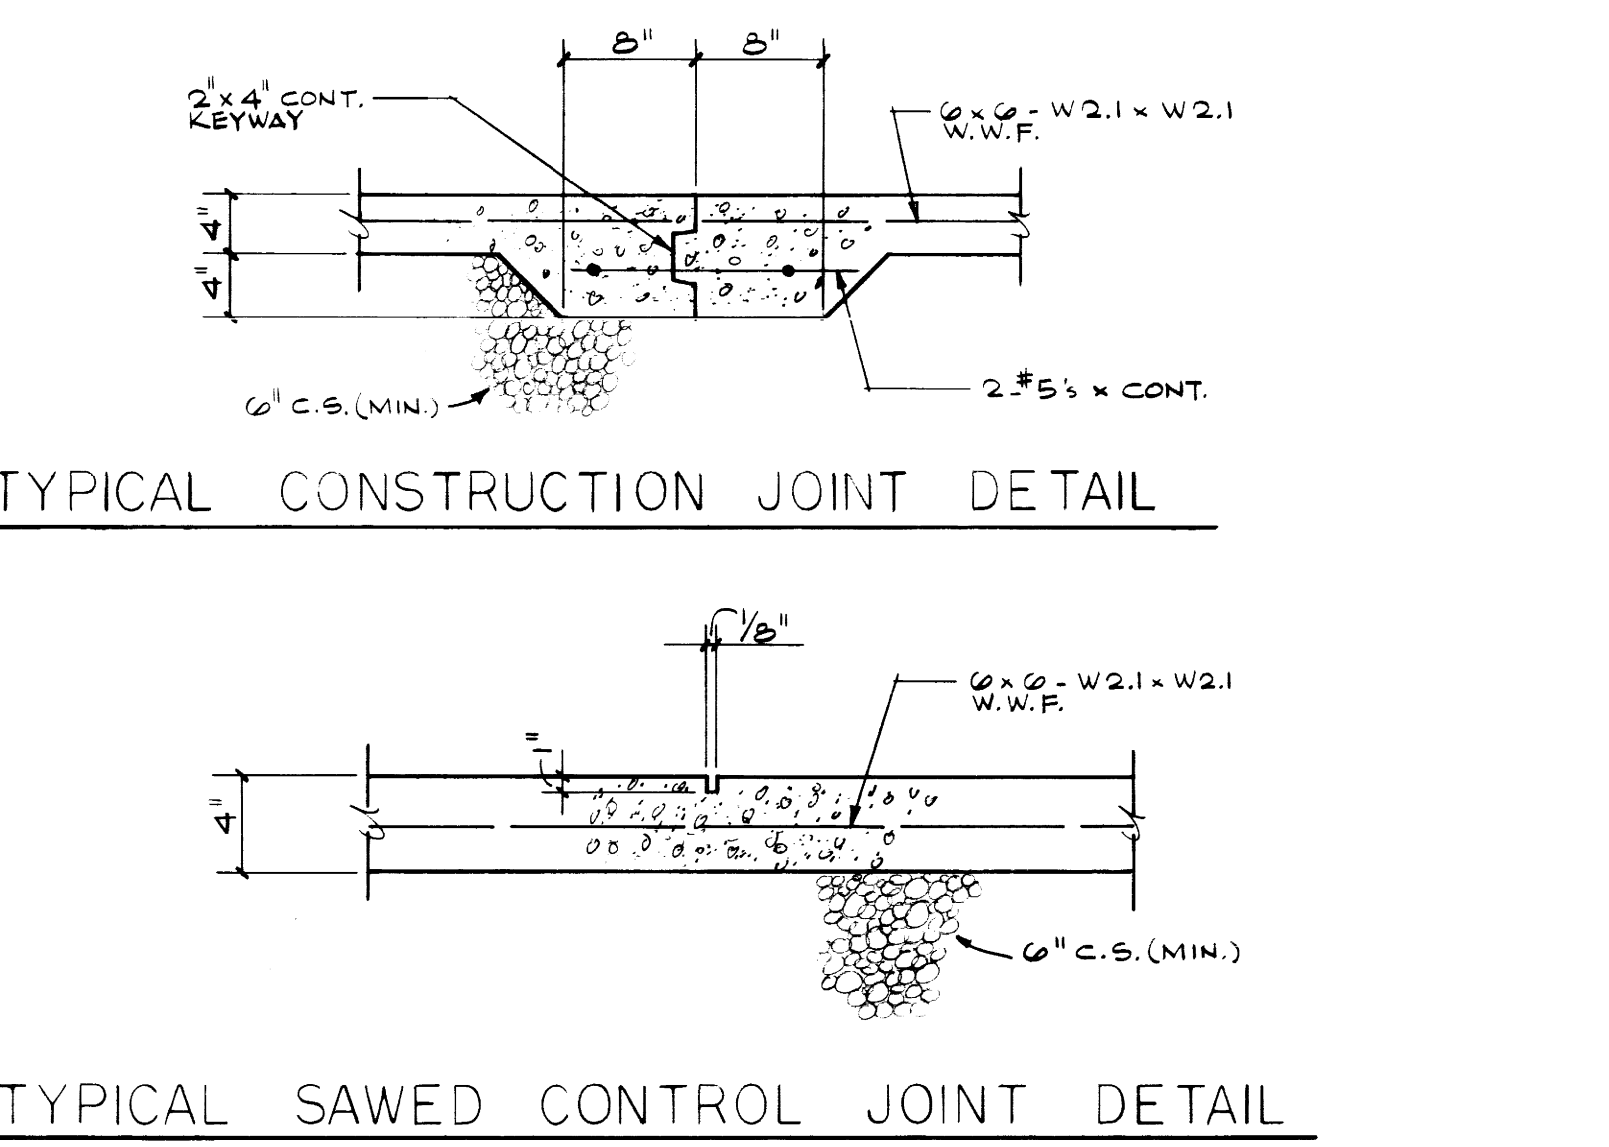

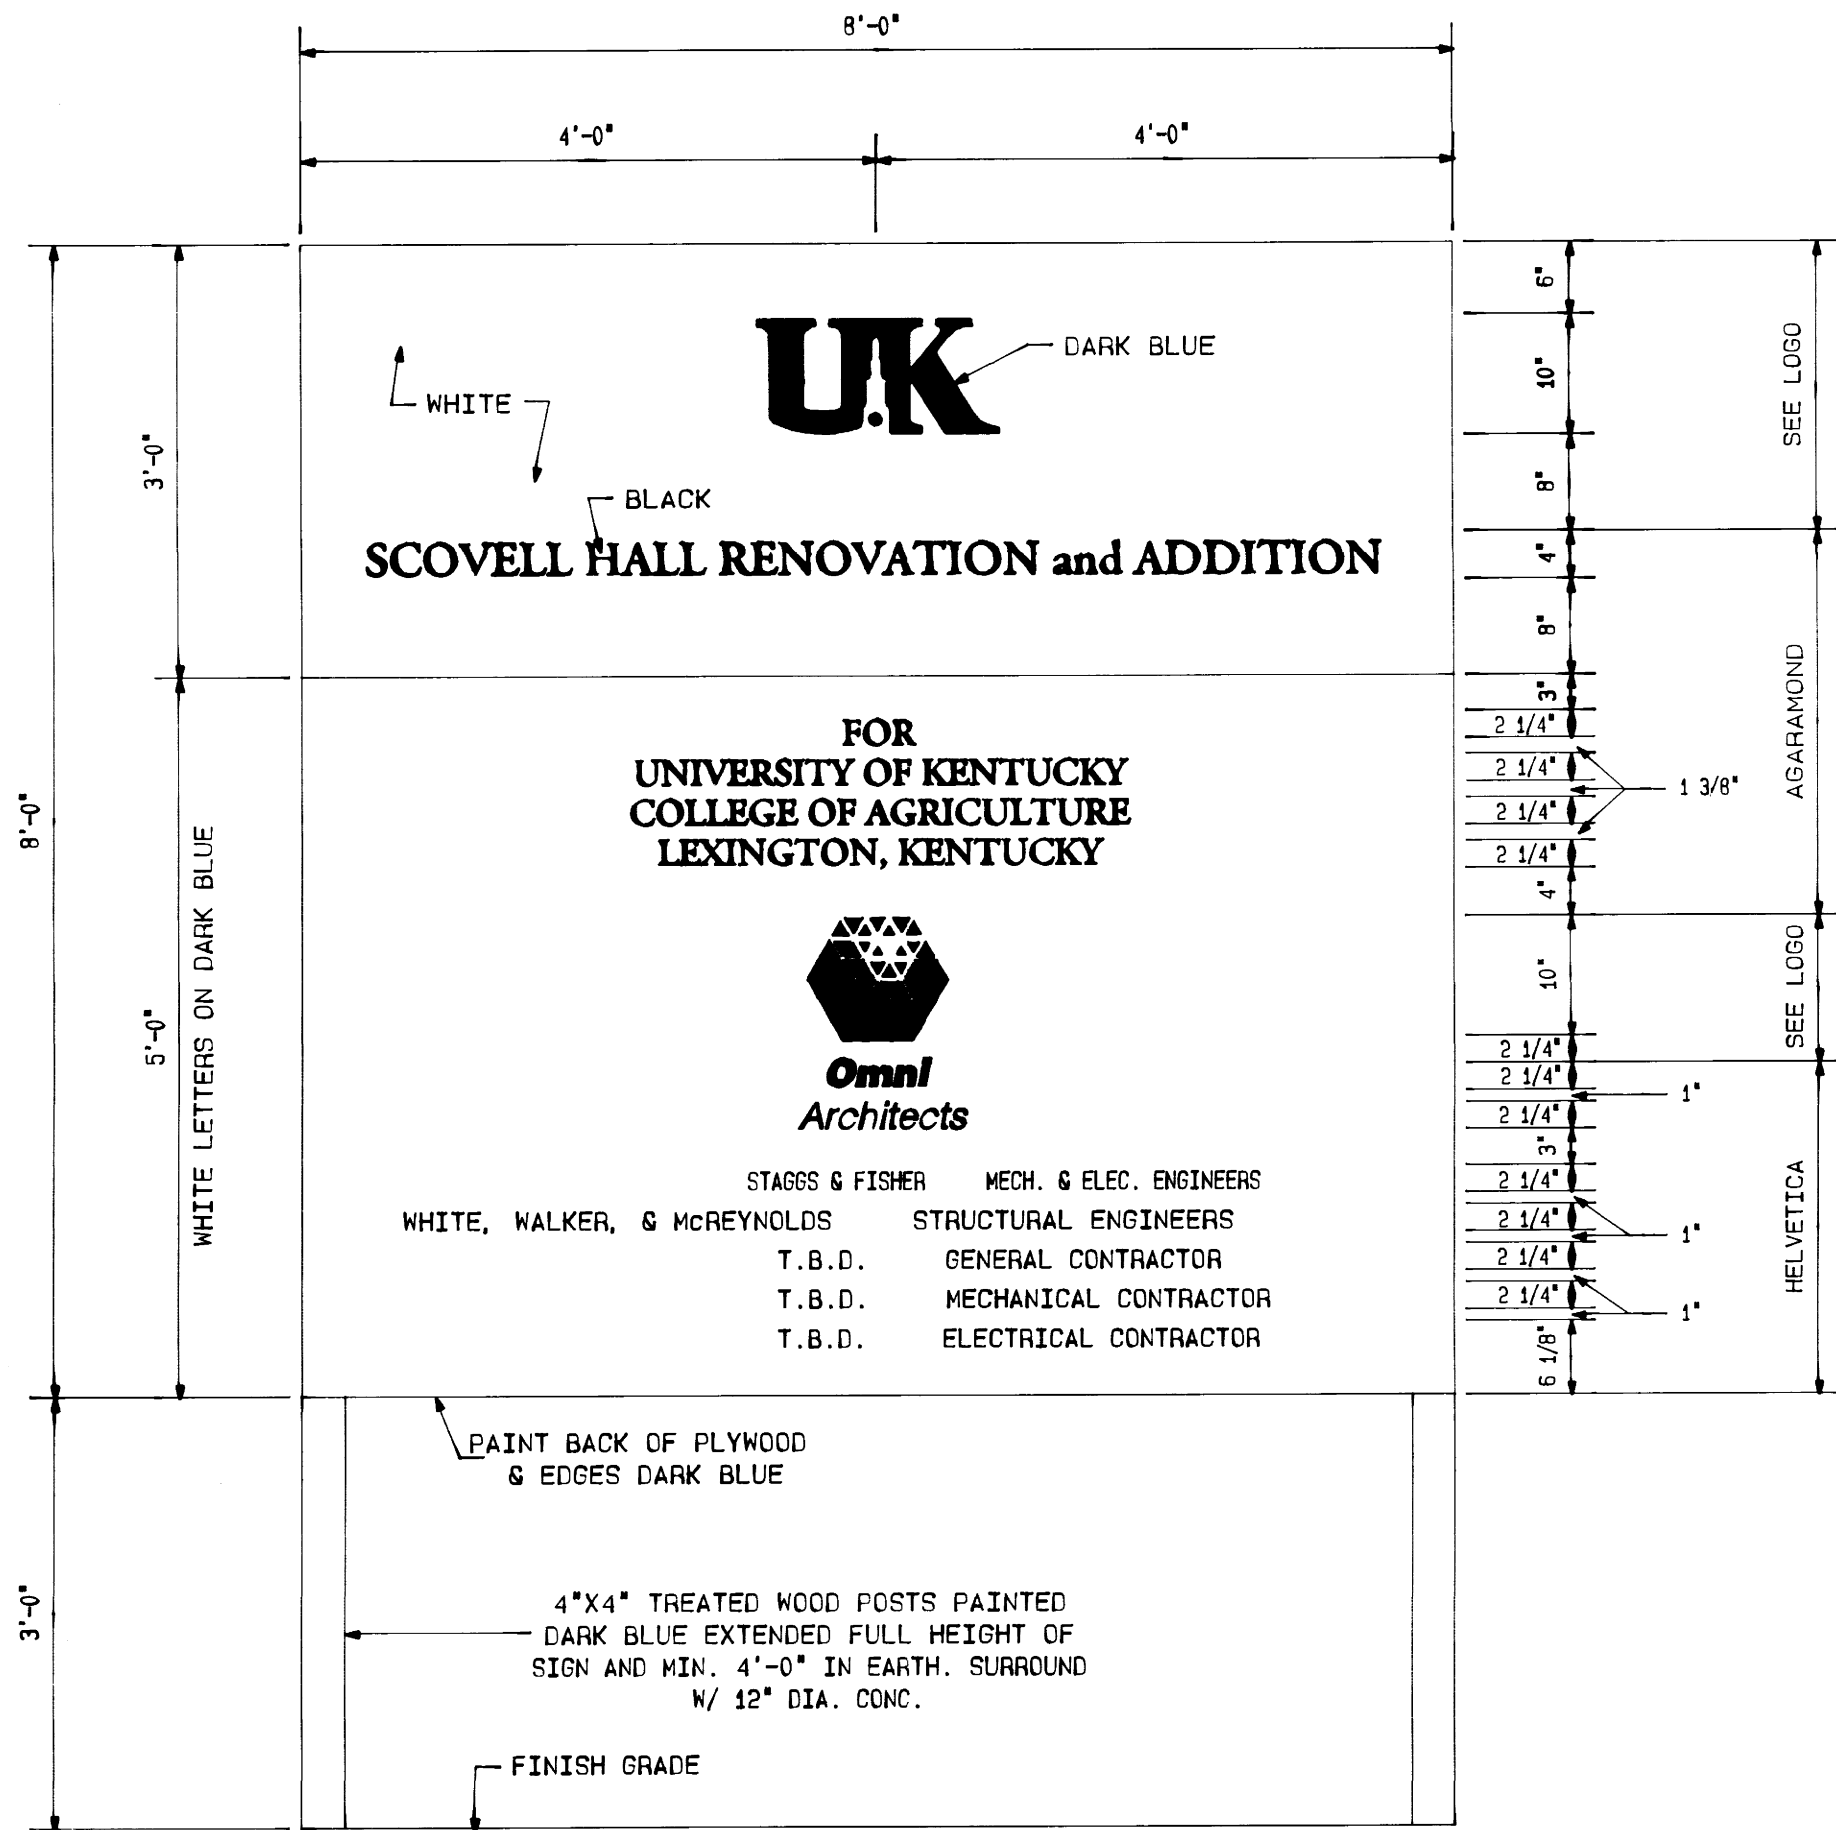


PROJECT CONSTRUCTION SIGN

SCALE: 3/4"=1'-0"

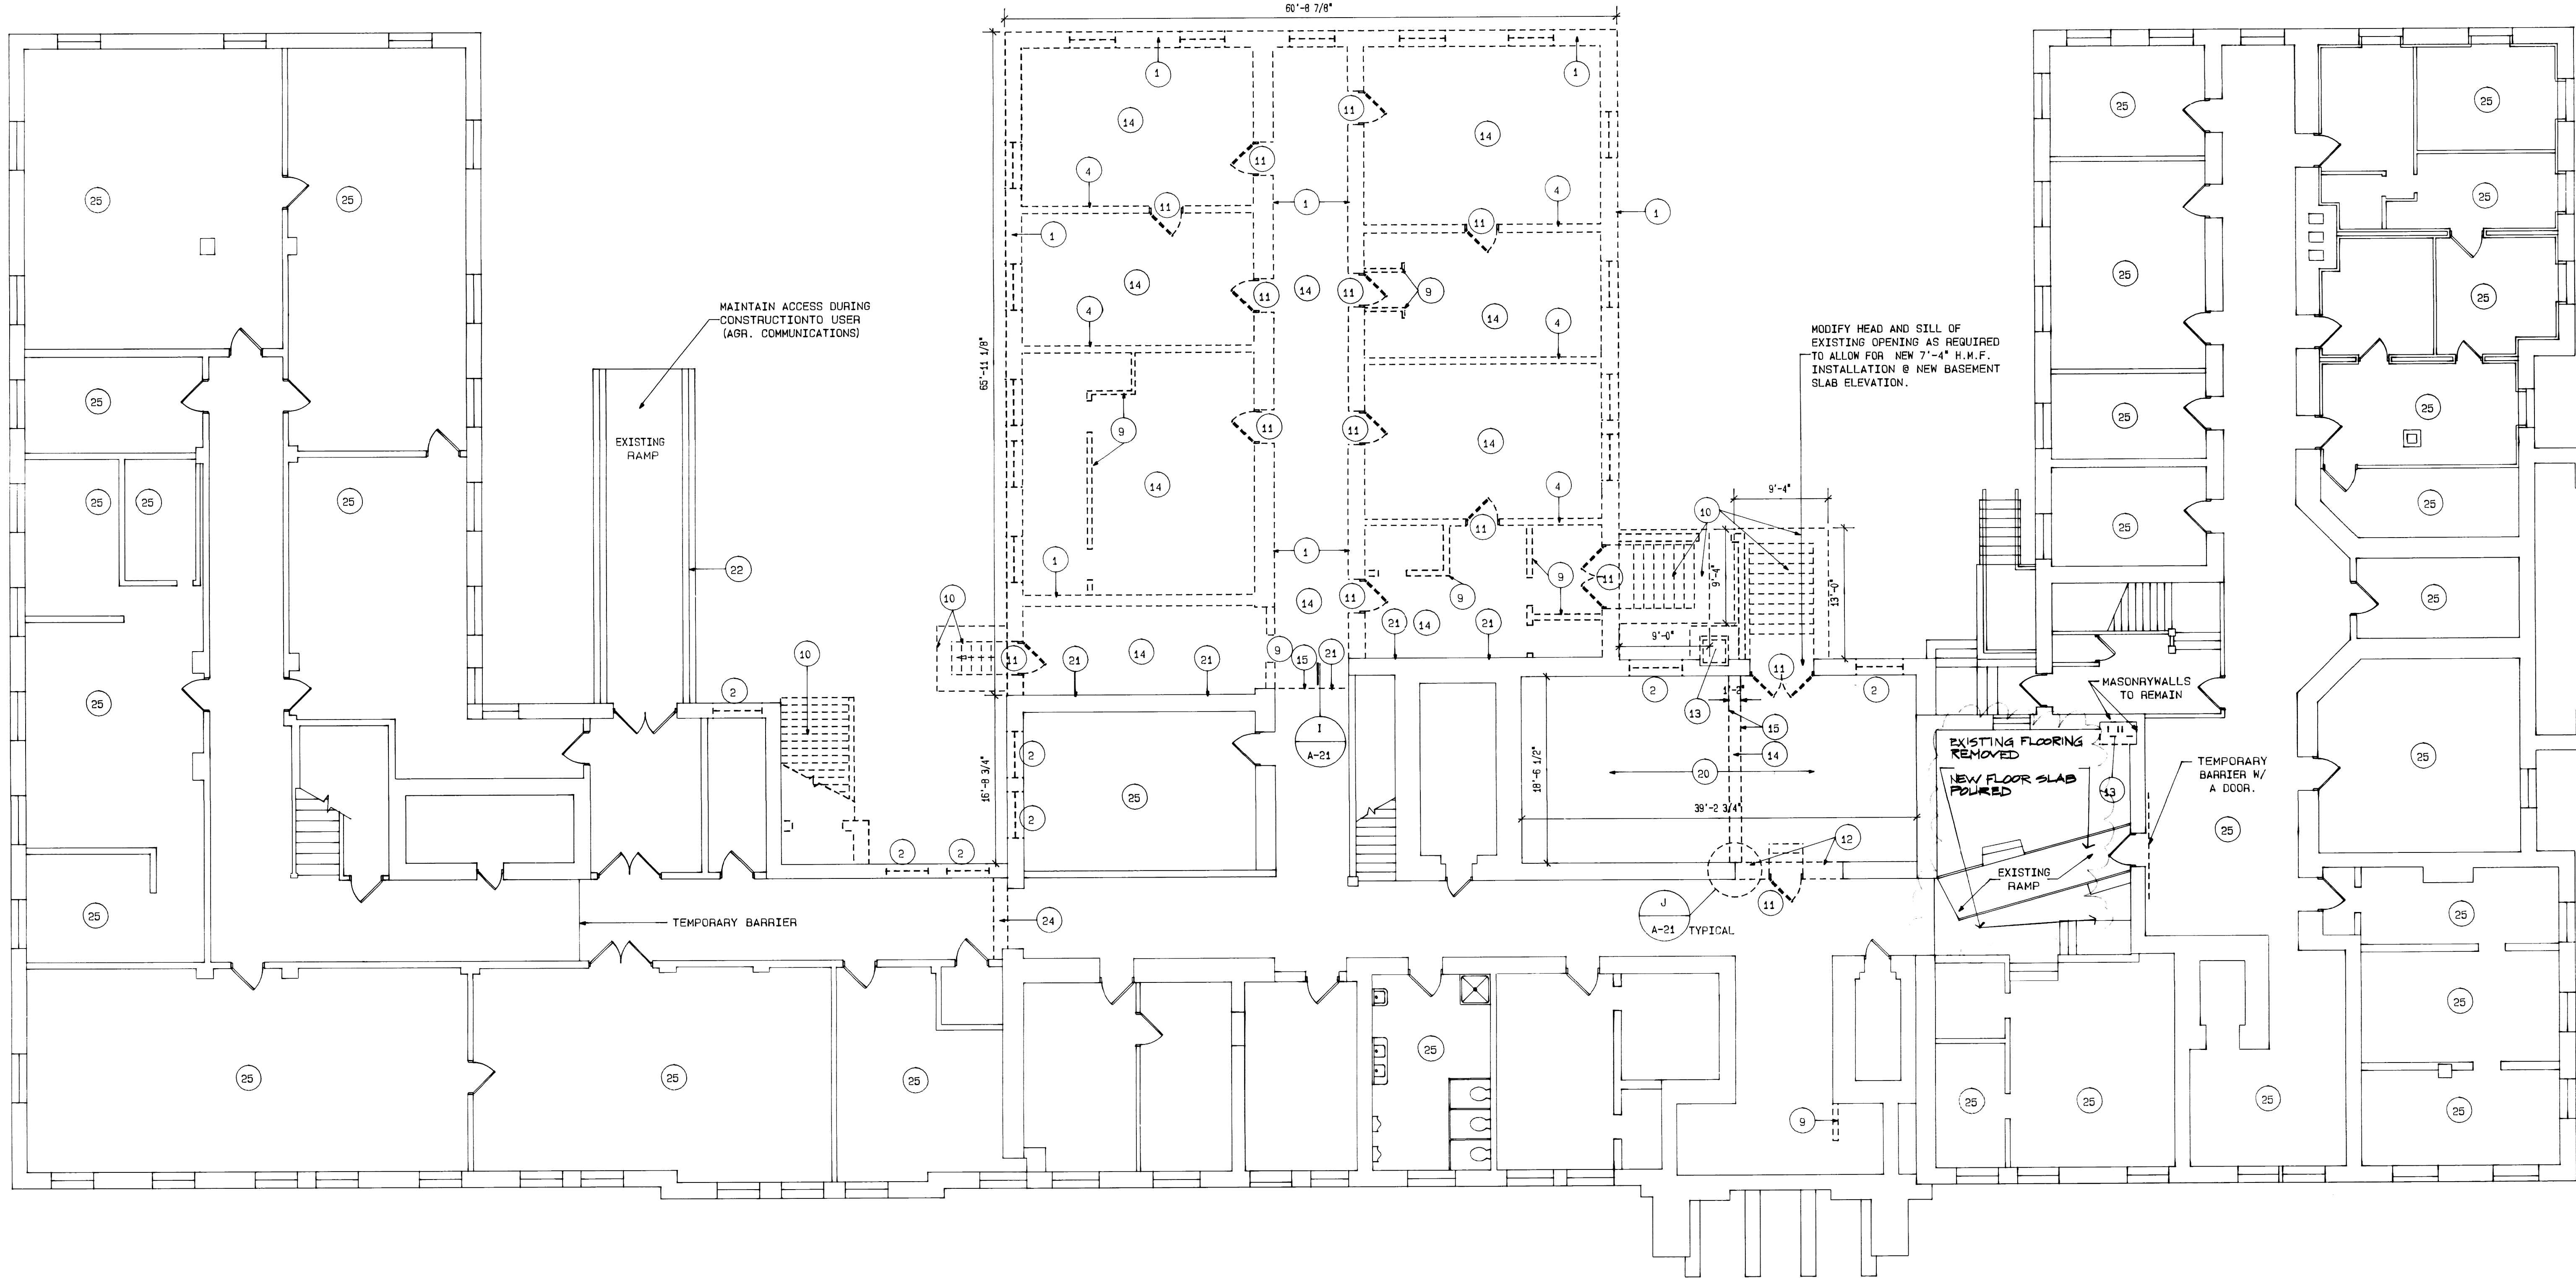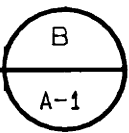

DEMOLITION PLAN • BASEMENT

SCALE: 1/8" = 1'-0"

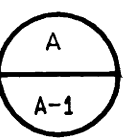

GENERAL DEMOLITION NOTES:

1. Contractor shall notify Architect of any discrepancies in concealed areas/conditions that differ from descriptions noted herein.
2. Contractor shall patch and repair walls and ceilings accessed to install mechanical piping, ductwork or conduit and in areas outside renovation work. Patching shall also include finishing and painting of walls and replacement of ceiling tiles/suspension grid to match existing.
3. All existing dimensions indicated are for demolition estimates and are to be field verified.
4. All existing areas, where new ceiling/flooring is specified, shall require the removal of the existing finish with patching, repairing and preparation (as required) of the existing structure/substrate to receive the new finish.
5. General Contractor shall verify with Owner all equipment to be relocated.
6. See M & E sheets for additional demolition requirements.
7. Shore and brace areas as required.
8. Refer to site sheets for site demolition.
9. Refer to repair notes for minor demolition and repair work.
10. Refer to cutting and patching specification for full requirements.
11. Patch floor to match existing where partitions are removed.

DEMOLITION KEY NOTES:

1. REMOVE MASONRY BEARING WALL, FOUNDATION WALL, AND FOOTING.
2. REMOVE WINDOW AND FRAME TO MASONRY OPENING.
3. REMOVE INTERIOR WALL OF 4" STRUCTURAL GLAZED TILES.
4. REMOVE FLOOR SYSTEM OF 3 X 14 JOISTS @ 16" O.C.
5. REMOVE FLOOR SYSTEM OF 2 X 14 JOISTS @ 16" O.C.
6. REMOVE FLOOR OF CERAMIC TILE ON 1 X.
7. REMOVE FLOOR OF V.C.T. ON 1 X.
8. REMOVE BUILT UP FLOOR OF 2 X JOISTS.
9. REMOVE INTERIOR WALL OF WOOD STUDS AND PLASTER.
10. REMOVE CONCRETE STEPS AND CONCRETE FOOTING/FOUNDATION.
11. REMOVE DOOR AND FRAME.
12. SAWCUT AND REMOVE EXISTING MASONRY WALL PROVIDE TEMPORARY SUPPORT WITH STEEL LINTEL AS NECESSARY, PATCH FLOORLINE FLUSH. REFER TO K/A-21.
13. REMOVE MASONRY CHIMNEY.
14. REMOVE CONCRETE FLOOR SLAB.
15. SAWCUT CONCRETE SLAB.
16. REMOVE V.C.T. TILE.
17. REMOVE WOOD ROOF AND WALL FRAMING.
18. MAKE OPENING IN WALL FOR NEW DOOR.
19. N.A.
20. REMOVE BUILT-UP FLOOR.
21. PROVIDE COMPLETE SHORING AND BRACING AT INTERFACE BETWEEN EXISTING AND NEW TO BE REMOVED. PROVIDE PERMANENT WOOD FRAMING TO STABILIZE EXISTING FLOORING WITH HEADERS ETC.
22. REMOVE STEEL PIPE RAILING, THIS SIDE ONLY.
23. REFER TO FURNITURE PLANS FOR LOCATION OF USER GROUPS.
24. REMOVE ROLLING SHUTTER WALL, PAINT AND PATCH.
25. NO ARCHITECTURAL WORK THIS ROOM.


UNIVERSITY OF KENTUCKY

AS-BUILT AUG. 10, 1995

This drawing and design above thereon are the property of Omni Architects, C. The reproduction, copying or other use of this drawing without the written consent of Omni Architects is prohibited.

Job No. 9385-00 Date: 5 / 1994 Drawn By: SMC Checked: MMJ Revisions: 7/29/94


Omni Architects
Landscape Architecture
Civil Engineering
Mechanical Engineering
Interior Design
125 North Limestone Street
Lexington, KY 40502
(606) 253-6654 Fax: (606) 253-2368

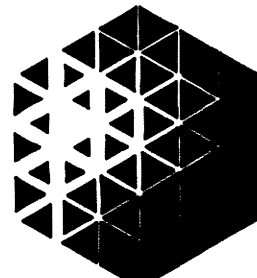

Omni Architects


SCOVELL HALL RENOVATION

Basement Demolition Plan

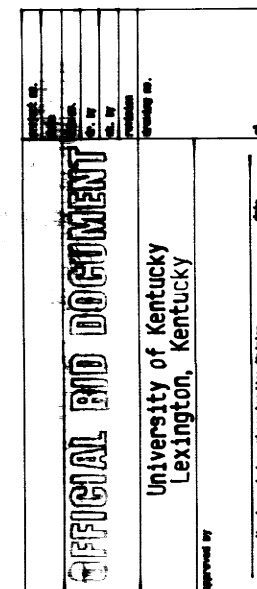

University of Kentucky
College of Architecture
Division
125 North Limestone Street
Lexington, KY 40502
Document # 0007109
Sheet A-3

0007109
A • 1

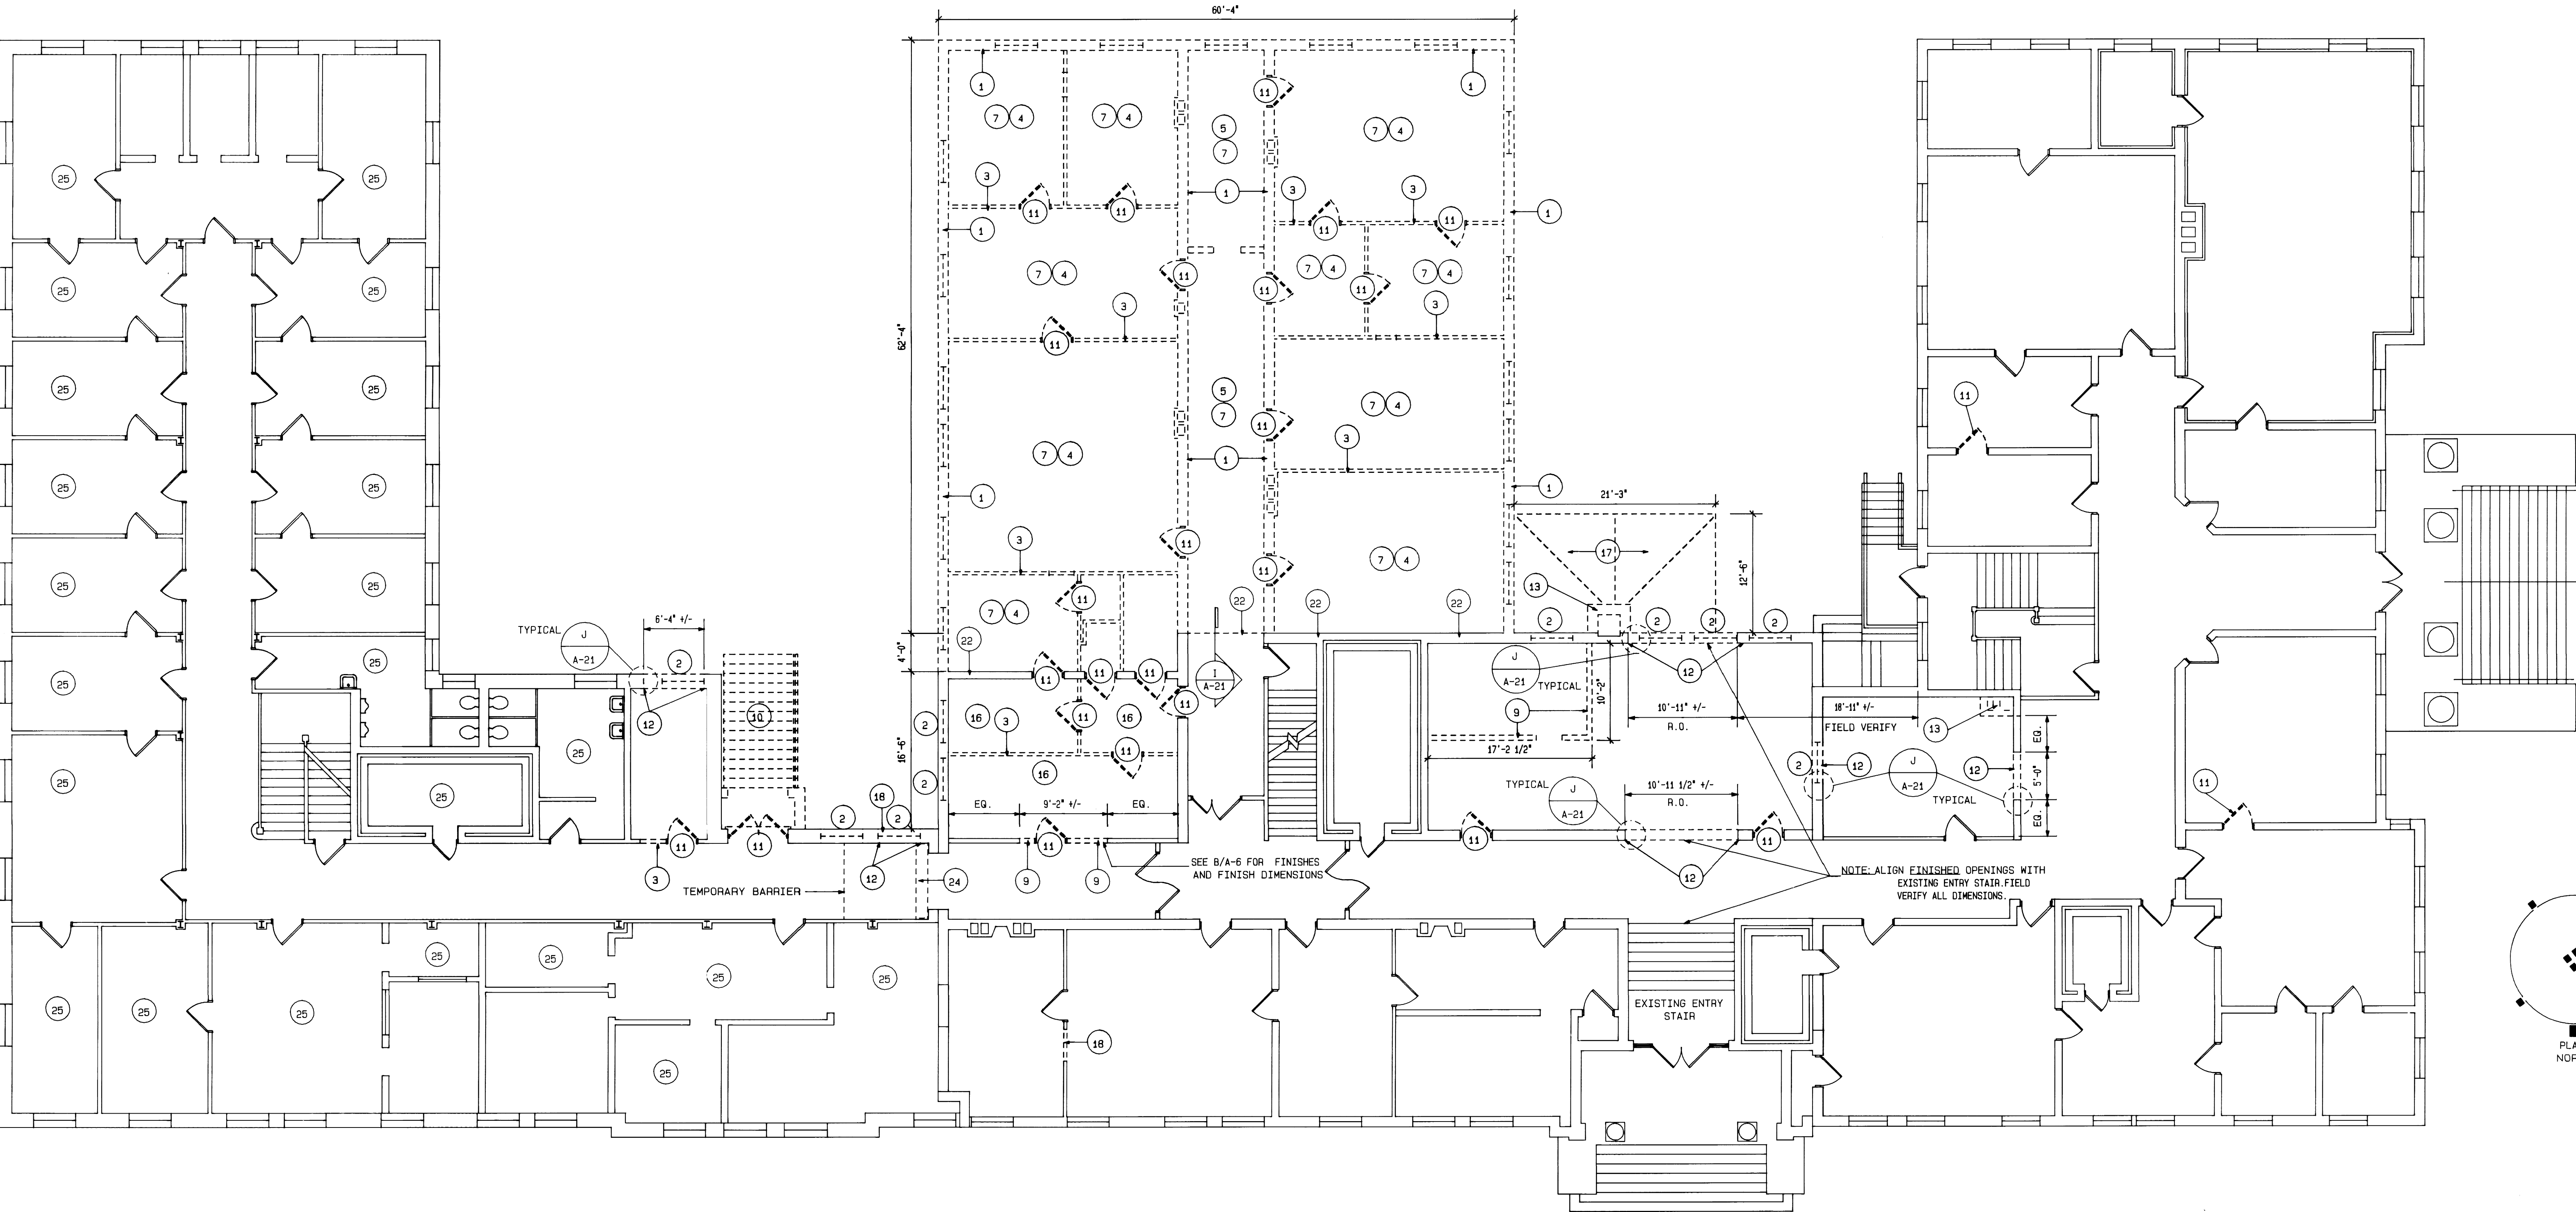

DEMOLITION PLAN • FIRST FLOOR
SCALE: 1/8" = 1'-0"


GENERAL DEMOLITION NOTES:

1. Contractor shall notify Architect of any discrepancies in concealed areas/conditions that differ from descriptions noted herein.
2. Contractor shall patch and repair walls and ceilings accessed to install mechanical piping, ductwork or conduit and in areas outside renovation work. Patching shall also include finishing and painting of walls and replacement of ceiling tiles/suspension grid to match existing.
3. All existing dimensions indicated are for demolition estimates and are to be field verified.
4. All existing areas, where new ceiling/flooring is specified, shall require the removal of the existing finish with patching, repairing and preparation (as required) of the existing structure/substrate to receive the new finish.
5. General Contractor shall verify with Owner all equipment to be relocated.
6. See M & E sheets for additional demolition requirements.
7. Shore and brace areas as required.
8. Refer to site sheets for site demolition.
9. Refer to repair notes for minor demolition and repair work.
10. Refer to cutting and patching specification for full requirements.
11. Patch floor to match existing where partitions are removed.

DEMOLITION KEY NOTES:

1. REMOVE MASONRY BEARING WALL, FOUNDATION WALL, AND FOOTINGS.
2. REMOVE WINDOW AND FRAME TO MASONRY OPENING.
3. REMOVE INTERIOR WALL OF 4" STRUCTURAL GLAZED TILES.
4. REMOVE FLOOR SYSTEM OF 3 X 14 JOISTS @ 16" O.C.
5. REMOVE FLOOR SYSTEM OF 2 X 14 JOISTS @ 16" O.C.
6. REMOVE FLOOR OF CERAMIC TILE ON 1 X.
7. REMOVE FLOOR OF V.C.T. ON 1 X.
8. REMOVE BUILT UP FLOOR OF 2 X JOISTS.
9. REMOVE INTERIOR WALL OF WOOD STUDS AND PLASTER.
10. REMOVE CONCRETE STEPS AND CONCRETE FOOTING/FOUNDATION.
11. REMOVE DOOR AND FRAME.
12. SAWCUT AND REMOVE EXISTING MASONRY WALL. PROVIDE TEMPORARY SUPPORT WITH STEEL LINTEL AS NECESSARY. PATCH FLOORLINE FLUSH. REFER TO K/A-21.
13. REMOVE MASONRY CHIMNEY. PROVIDE 2X HEADER ON ALL 4 SIDES.
14. REMOVE CONCRETE FLOOR SLAB.
15. SAWCUT CONCRETE SLAB.
16. REMOVE V.C.T. TILE.
17. REMOVE WOOD ROOF AND WALL FRAMING.
18. MAKE OPENING IN WALL FOR NEW DOOR.
19. N.A.
20. REMOVE BUILT-UP FLOOR.
21. PROVIDE COMPLETE SHORING AND BRACING AT INTERFACE BETWEEN EXISTING AND WING TO BE REMOVED. PROVIDE PERMANENT WOOD FRAMING TO STABILIZE EXISTING FLOORING WITH HEADERS ETC.
22. REMOVE STEEL PIPE RAILING, THIS SIDE ONLY.
23. REFER TO FURNITURE PLANS FOR LOCATION OF USER GROUPS.
24. REMOVE ROLLING SHUTTER WALL, PAINT AND PATCH.
25. NO ARCHITECTURAL WORK THIS ROOM.


SCOVELL

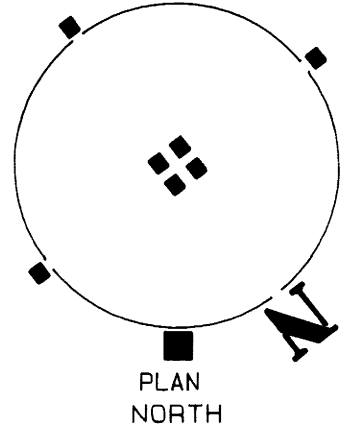

SCOVELL HALL RENOVATION


First Floor Demolition Plan

0002110

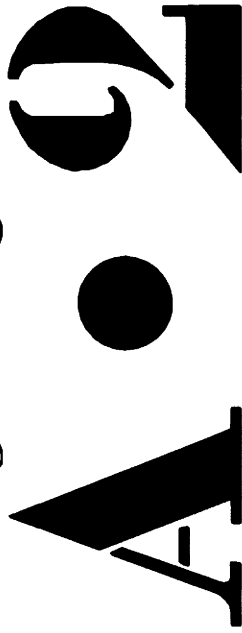


University of Kentucky Design and Construction	Project Name	Document #
University of Kentucky Lexington, Kentucky	Scovell Hall Renovation	0002110
Scale: 1/8" = 1'-0"	Sheet	A-3

Omni Architects

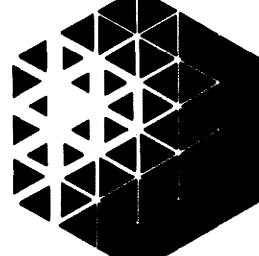

Architecture
Landscape Architecture
Civil Engineering
Planning
Interiors
212 North Upper Street
Lexington, KY 40501
(606) 253-2388

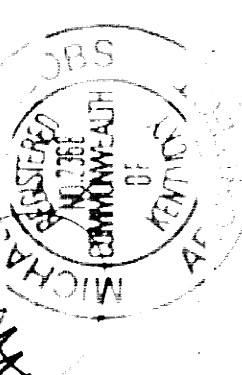


AS-BUILT AUG. 10, 1995

UNIVERSITY OF KENTUCKY


OK

This Drawing and Design shown thereon are the property of Omni Architects C. The reproduction, copying or other use of this Drawing without the written consent of Omni Architects is prohibited.

S C A L E: 1/8" = 1'-0"

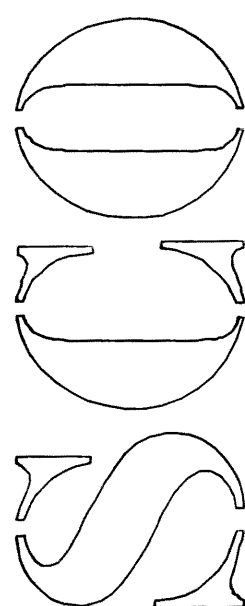


111200

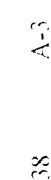


University of Kentucky
Design and Construction
Division

document

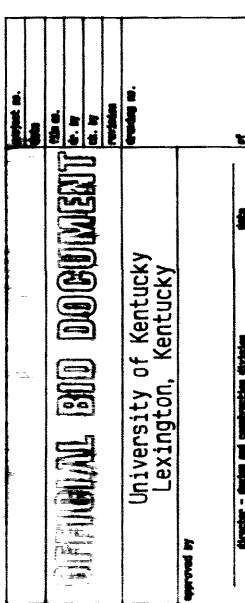

Omni
Architects

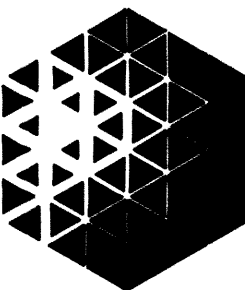

Architecture
Landscape Architecture
Civil Engineering
Planning
Interiors

212 North Upper Street
Lexington, KY 40507
(606) 252-6654 Fax: (606) 253-2363


Lexington, KY 40507
(506) 252-6664 Fax: (506) 253-2358


1. CONTRACTOR SHALL NOTIFY ARCHITECT OF ANY DISCREPANCIES IN CONCEALED AREAS/CONDITIONS THAT DIFFER FROM DESCRIPTIONS NOTED HEREIN.
2. CONTRACTOR SHALL PATCH AND REPAIR WALLS AND CEILING'S ACCESSED TO INSTALL MECHANICAL PIPING, DUCTWORK OR CONDUIT AND IN AREAS OUTSIDE RENOVATION WORK. PATCHING SHALL ALSO INCLUDE FINISHING AND PAINTING OF WALLS AND REPLACEMENT OF CEILING TILES/SUSPENSION GRID TO MATCH EXISTING
3. ALL EXISTING DIMENSIONS INDICATED ARE FOR DEMOLITION ESTIMATES AND ARE TO BE FIELD VERIFIED.
4. ALL EXISTING AREAS, WHERE NEW CEILING/FLOORING IS SPECIFIED, SHALL REQUIRE THE REMOVAL OF THE EXISTING FINISH WITH PATCHING, REPAIRING AND PREPARATION (AS REQUIRED) OF THE EXISTING STRUCTURE/SUBSTRATE TO RECEIVE THE NEW FINISH.
5. GENERAL CONTRACTOR SHALL VERIFY WITH OWNER ALL EQUIPMENT TO BE RELOCATED.
6. SEE M & E SHEETS FOR ADDITIONAL DEMOLITION REQUIREMENTS.
7. SHORE AND BRACE AREAS AS REQUIRED.
8. REFER TO SITE SHEETS FOR SITE DEMOLITION.
9. REFER TO REPAIR NOTES FOR MINOR DEMOLITION AND REPAIR WORK.
10. REFER TO CUTTING AND PATCHING SPECIFICATION FOR FULL REQUIREMENTS.
11. PATCH FLOOR TO MATCH EXISTING WHERE PARTITIONS ARE REMOVED.

1. REMOVE MASONRY BEARING WALL, FOUNDATION WALL, AND FOOTING.
2. REMOVE WINDOW AND FRAME TO MASONRY OPENING.
3. REMOVE INTERIOR WALL OF 4" STRUCTURAL GLAZEDTILES.
4. REMOVE FLOOR SYSTEM OF 3 X 14 JOISTS @ 16" O.C.
5. REMOVE FLOOR SYSTEM OF 2 X 14 JOISTS @ 16" O.C.
6. REMOVE FLOOR OF CERAMIC TILE ON 1 X.
7. REMOVE FLOOR OF V.C.T. ON 1 X.
8. REMOVE BUILT UP FLOOR OF 2 X JOISTS .
9. REMOVE INTERIOR WALL OF WOOD STUDS AND PLASTER.
10. REMOVE CONCRETE STEPS AND CONCRETE FOOTING/FOUNDATION.
11. REMOVE DOOR AND FRAME.
12. SANCUT AND REMOVE EXISTING MASONRY WALL. PROVIDE TEMPORARY SUPPORT WITH STEEL LINTEL AS NECESSARY. PATCH FLOORLINE FLUSH. REFER TO K/A-21
13. REMOVE MASONRY CHIMNEY. PROVIDE 2X HEADER ON ALL 4 SIDES.
14. REMOVE CONCRETE FLOOR SLAB.
15. SANCUT CONCRETE SLAB.
16. REMOVE V.C.T. TILE.
17. REMOVE WOOD ROOF AND WALL FRAMING.
18. MAKE OPENING IN WALL FOR NEW DOOR.
19. N.A.
20. REMOVE BUILT-UP FLOOR .
21. PROVIDE COMPLETE SHORING AND BRACING AT INTERFACE BETWEEN EXISTING AND WING TO BE REMOVED. PROVIDE PERMANENT WOOD FRAMING TO STABILIZE EXISTING FLOORING WITH HEADERS ETC.
22. REMOVE STEEL PIPE RAILING. THIS SIDE ONLY.
23. REFER TO FURNITURE PLANS FOR LOCATION OF USER GROUPS.
24. REMOVE EXISTING ROLLING SHUTTER WALL, PAINT AND PATCH.
25. NO ARCHITECTURAL WORK THIS ROOM.


UNIVERSITY OF KENTUCKY

AS-BUILT AUG. 10, 1995

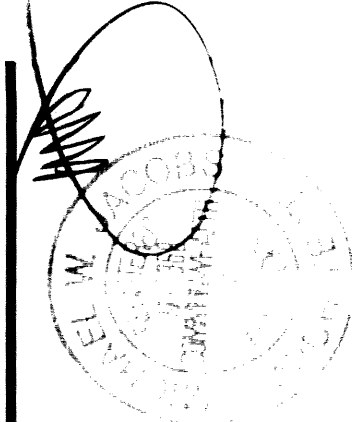

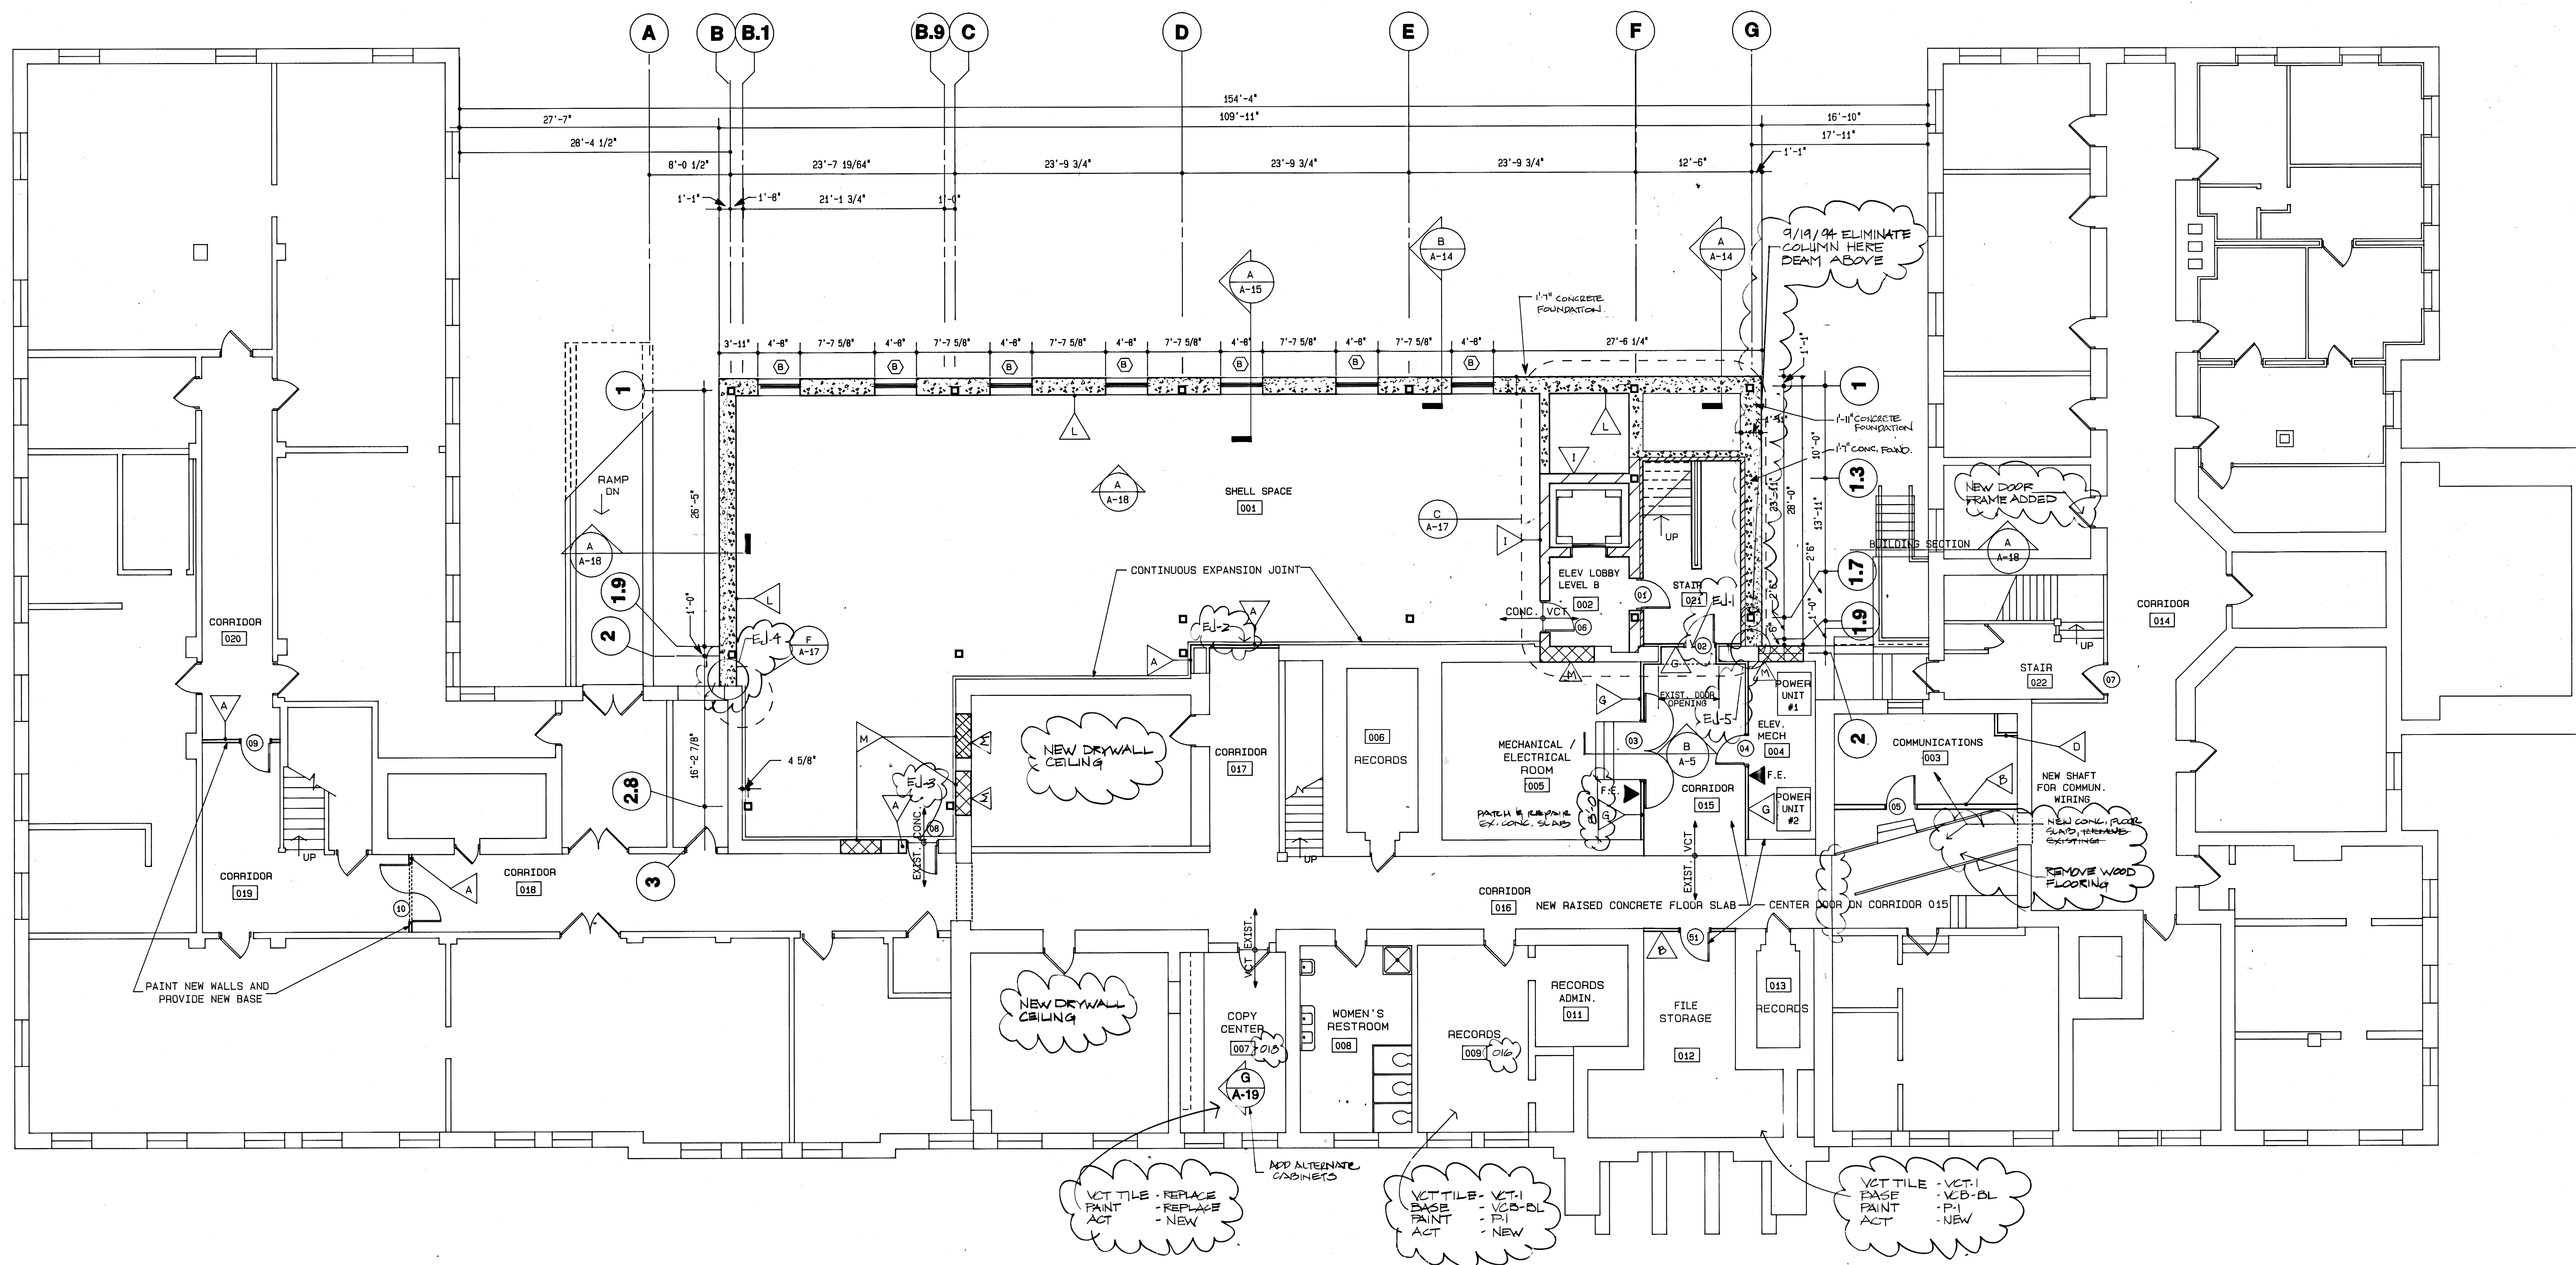

BASEMENT FLOOR PLAN • ADDITION & RENOVATION
SCALE 1/8" = 1'-0"

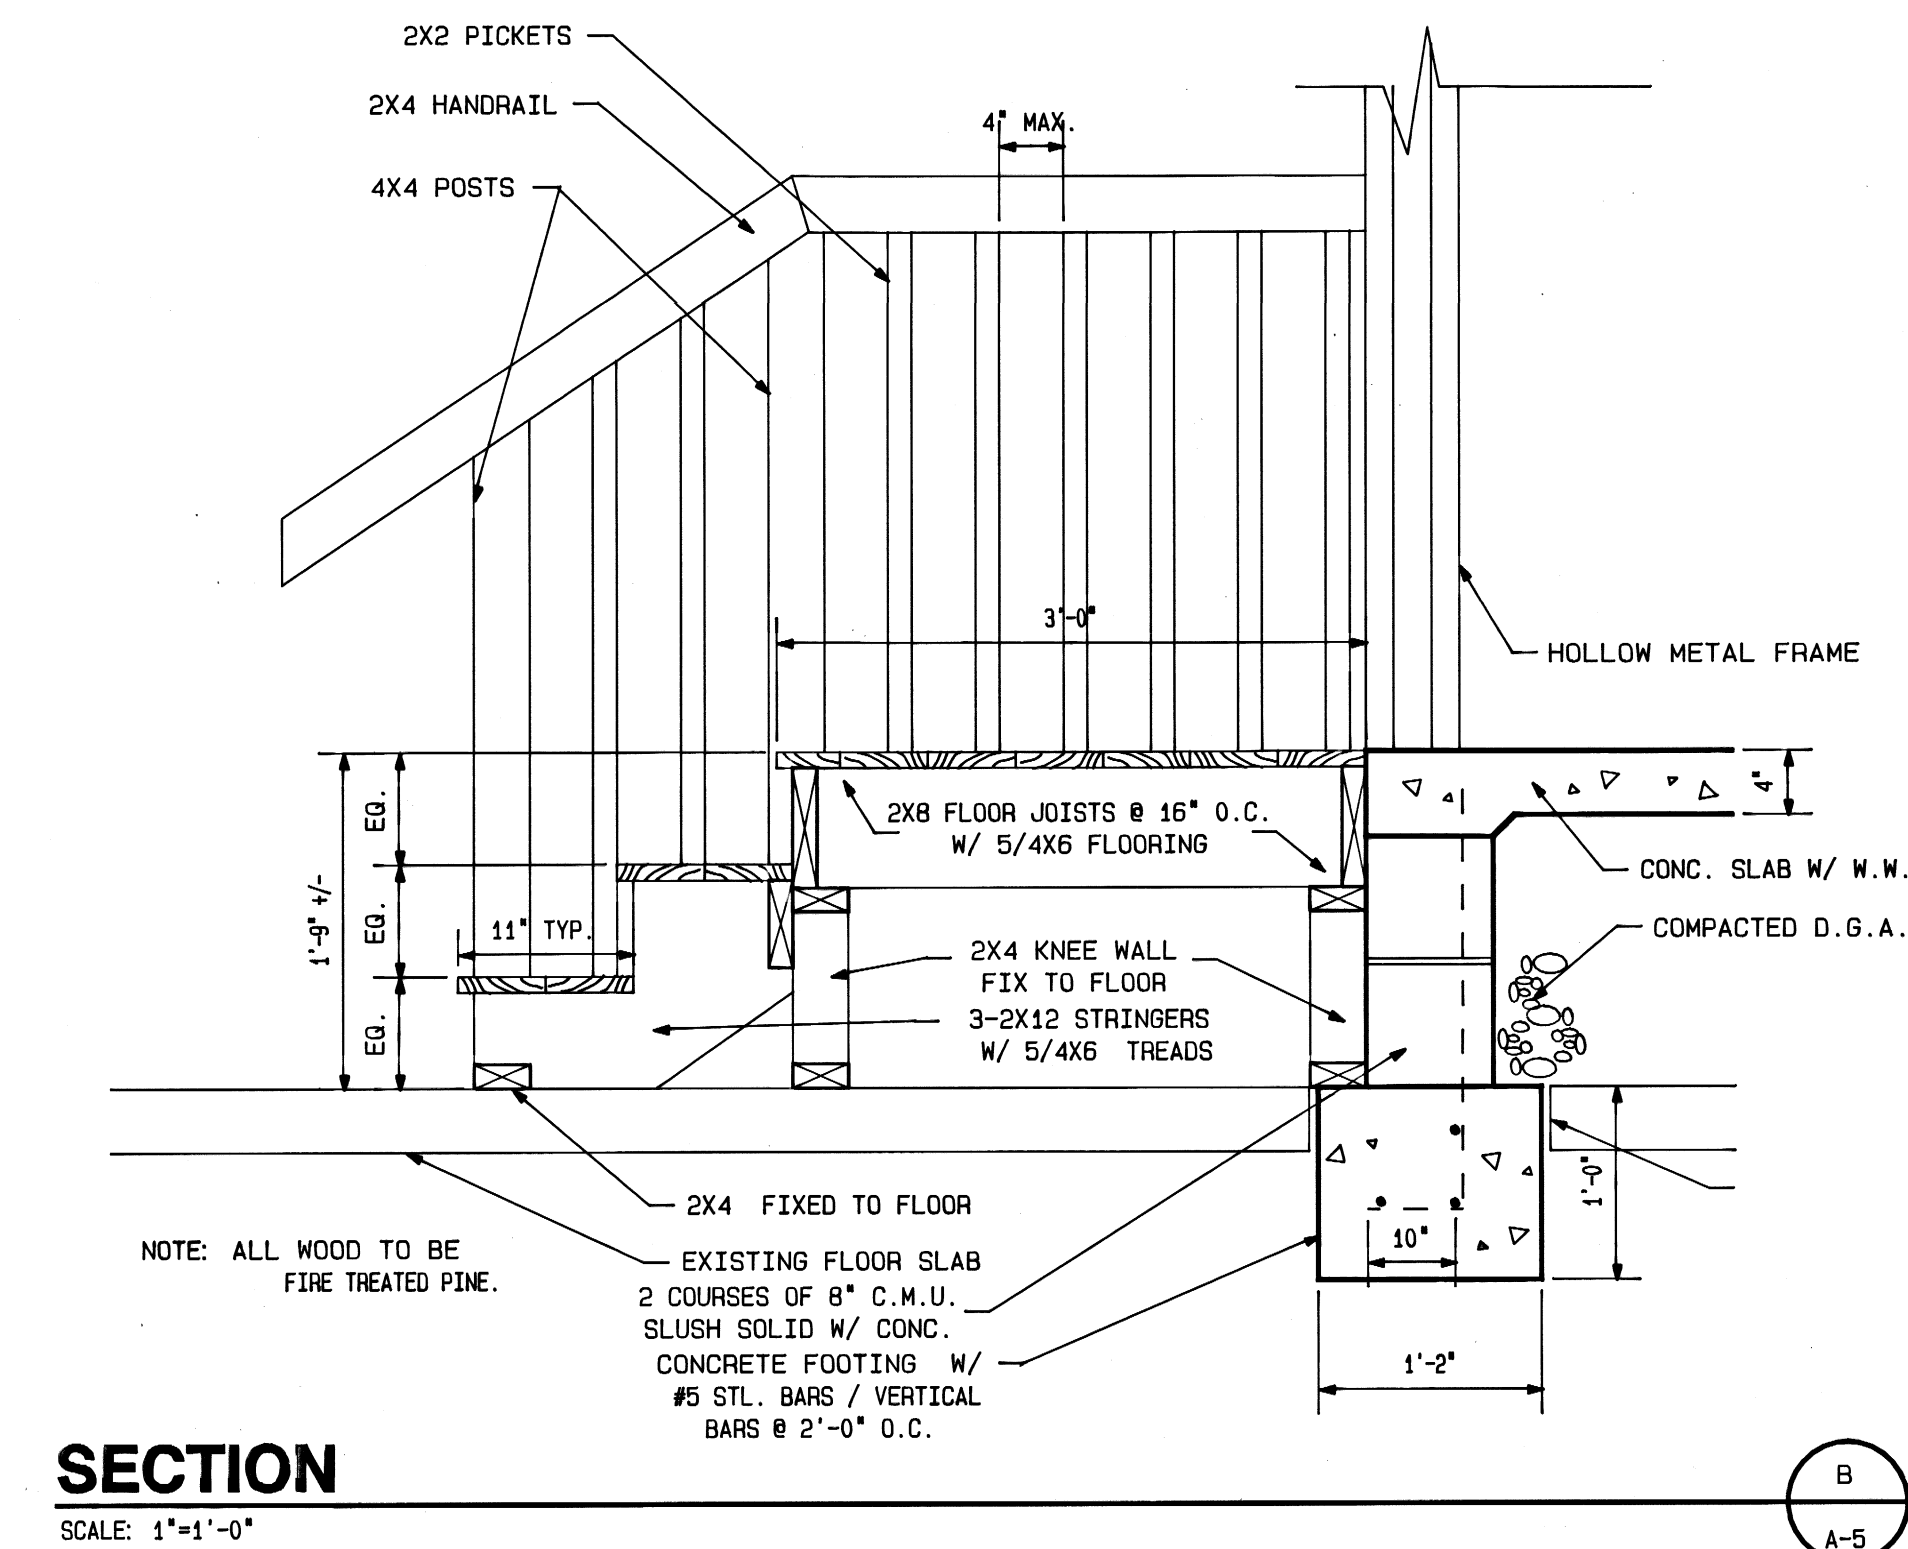

SECTION
SCALE 1/4" = 1'-0"


LEGEND


OPT-1	CARPET
VCT-1	VINYL COMPOSITION TILE
VCT-2	VINYL COMPOSITION TILE
C.F.T.	CERAMIC FLOOR TILE
EW	ENTRY MAT
VCB	VINYL COVE BASE
CTB	CERAMIC TILE BASE
PT-1	PAINT (WALLS)
PT-2	PAINT (TRIM)
PT-3	PAINT (CEILING)
CWT-1	CERAMIC WALL TILE
ACT-1	ACoustical CEILING TILE
EXIST.	EXISTING
CMU	CONCRETE MASONRY UNIT
BRICK	BRICK
GB	GYPsum BOARD
GLASS	GLASS
P.C.	POURED CONCRETE
VNC	VINYL WALL COVERING

ROOM FINISH SCHEDULE • BASEMENT

Nº	Room Name	Floor Mat'l	Base Mat'l	North	South	East	West	Ceiling Mat'l	Door Frame	Remarks
001	SHELL SPACE	P.C.	-	PLAS/CON/BRICK	CONCRETE	CONC/BRICK	CMU/PT-1	ACT-1	-	-
002	ELEV. LOBBY LEVEL B	VCT-2	VCB	BRICK	CMU/PT-1	CMU/PT-1	CMU/PT-1	ACT-1	-	-
003	COMMUNICATIONS	P.C.	-	GB/PT-1	BRICK/PT-1	BRICK/PT-1	BRICK/PT-1	ACT-1	-	-
004	ELEV. MECHANICAL	P.C.	-	BRICK/PT-1	BRICK/PT-1	BRICK/PT-1	BRICK/PT-1	ACT-1	-	-
005	MECH./ELEC. ROOM	EXIST.	EXIST.	BRICK/PT-1	BRICK/PT-1	BRICK/PT-1	BRICK/PT-1	ACT-1	-	-
006	RECORDS	EXIST.	EXIST.	EXIST.	EXIST.	EXIST.	EXIST.	ACT-1	-	-
007	COPY CENTER	VCT-1	VCB	PT-1	PT-1	PT-1	PT-1	ACT-1	-	-
008	WOMEN'S RESTROOM	EXIST.	EXIST.	EXIST.	EXIST.	EXIST.	EXIST.	ACT-1	-	-
009	RECORDS	EXIST.	EXIST.	EXIST.	EXIST.	EXIST.	EXIST.	ACT-1	-	-
010	TRAINING STOR. CLOSET	EXIST.	EXIST.	EXIST.	EXIST.	EXIST.	EXIST.	ACT-1	-	-
011	RECORDS ADMIN.	EXIST.	EXIST.	EXIST.	EXIST.	EXIST.	EXIST.	ACT-1	-	-
012	RECORDS	EXIST.	EXIST.	EXIST.	EXIST.	EXIST.	EXIST.	ACT-1	-	-
013	RECORDS	EXIST.	EXIST.	EXIST.	EXIST.	EXIST.	EXIST.	ACT-1	-	-
014	CORRIDOR	EXIST.	EXIST.	EXIST.	EXIST.	EXIST.	EXIST.	ACT-1	-	-
015	CORRIDOR	VCT-2	VCB	PT-1	PT-1	PT-1	PT-1	ACT-1	-	-
016	CORRIDOR	EXIST.	EXIST.	PT-1	PT-1	PT-1	PT-1	ACT-1	-	-
017	CORRIDOR	EXIST.	EXIST.	EXIST.	EXIST.	EXIST.	EXIST.	ACT-1	-	-
018	CORRIDOR	EXIST.	EXIST.	EXIST.	EXIST.	EXIST.	EXIST.	ACT-1	-	-
019	CORRIDOR	EXIST.	EXIST.	EXIST.	EXIST.	EXIST.	EXIST.	ACT-1	-	-
020	CORRIDOR	EXIST.	EXIST.	EXIST.	EXIST.	EXIST.	EXIST.	ACT-1	-	-
021	STAIR	VCT-2	VCB	GB/PT-1	CMU/PT-1	BRICK	BRICK	ACT-1	PT-2	-
022	STAIR	EXIST.	EXIST.	EXIST.	EXIST.	EXIST.	EXIST.	ACT-1	PT-2	-


NOTE: 1. PARTIAL CEILINGS UNDER LANDINGS.
2. SEE SPECIFICATIONS FOR STORAGE SCHEDULE.
3. REPAIR EX. SLAB AND INSTALL NEW 4" CONC. SLAB.
4. REMOVE EX. WOOD FLOOR, PATCH & REPAIR EX. CONC. SLAB.

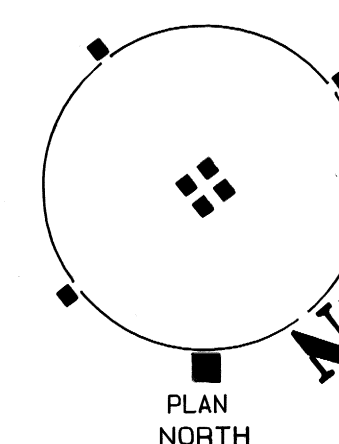

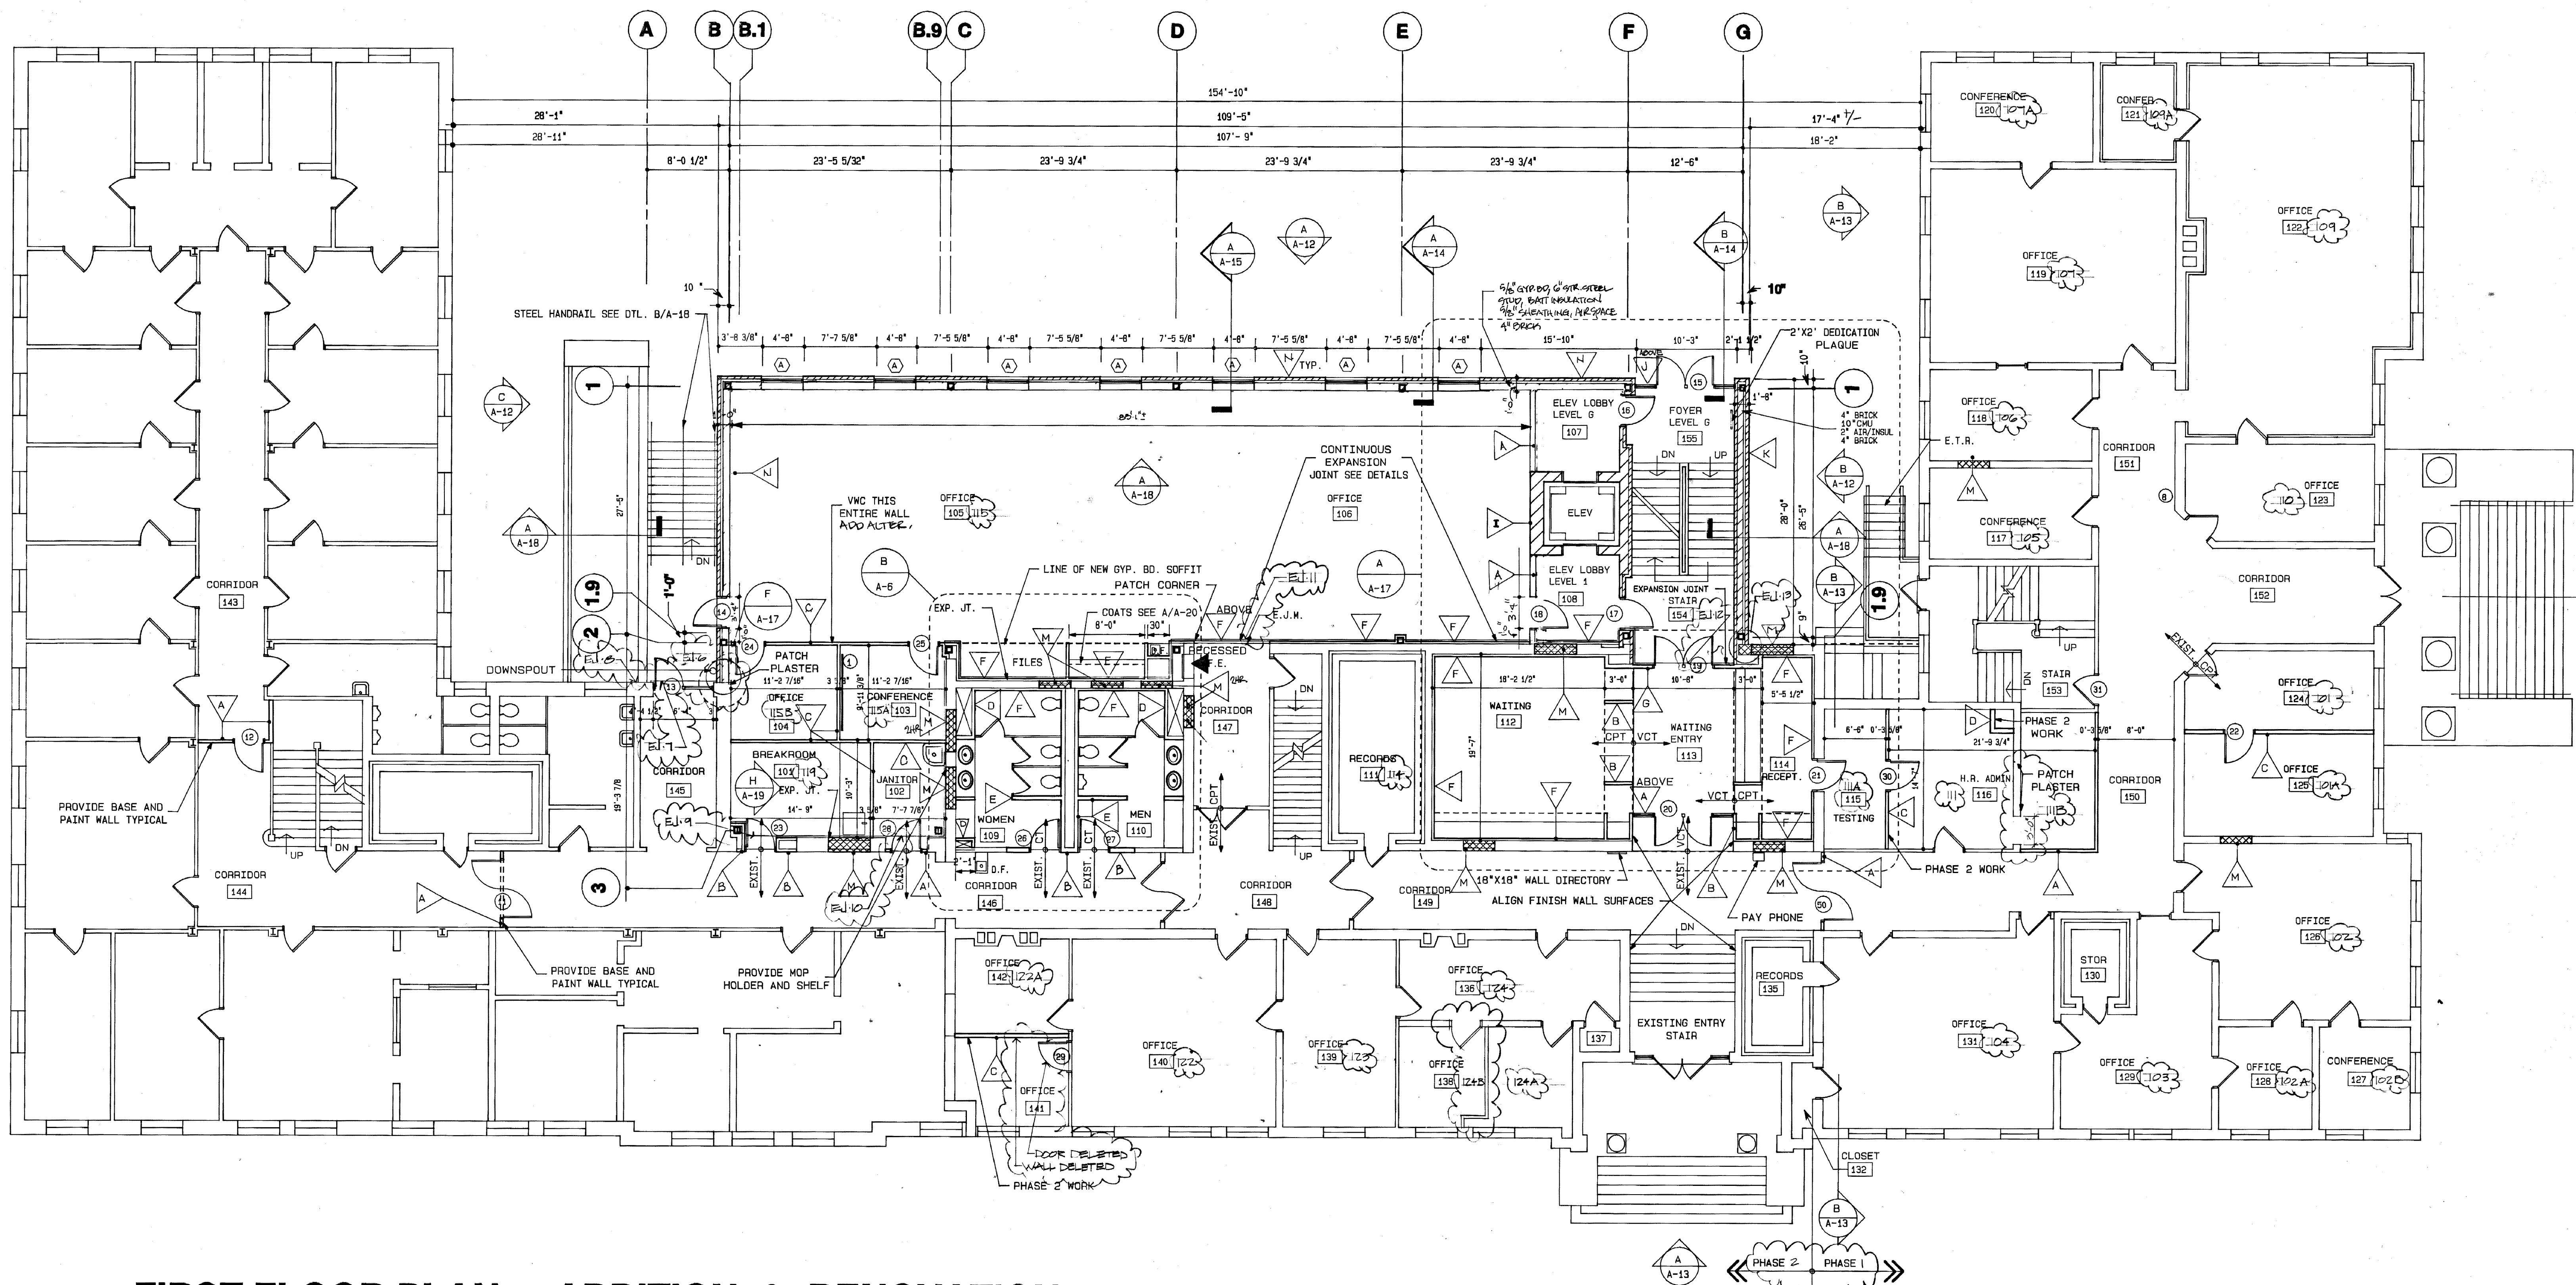

FIRST FLOOR PLAN • ADDITION & RENOVATION

SCALE 1/8" = 1'-0"

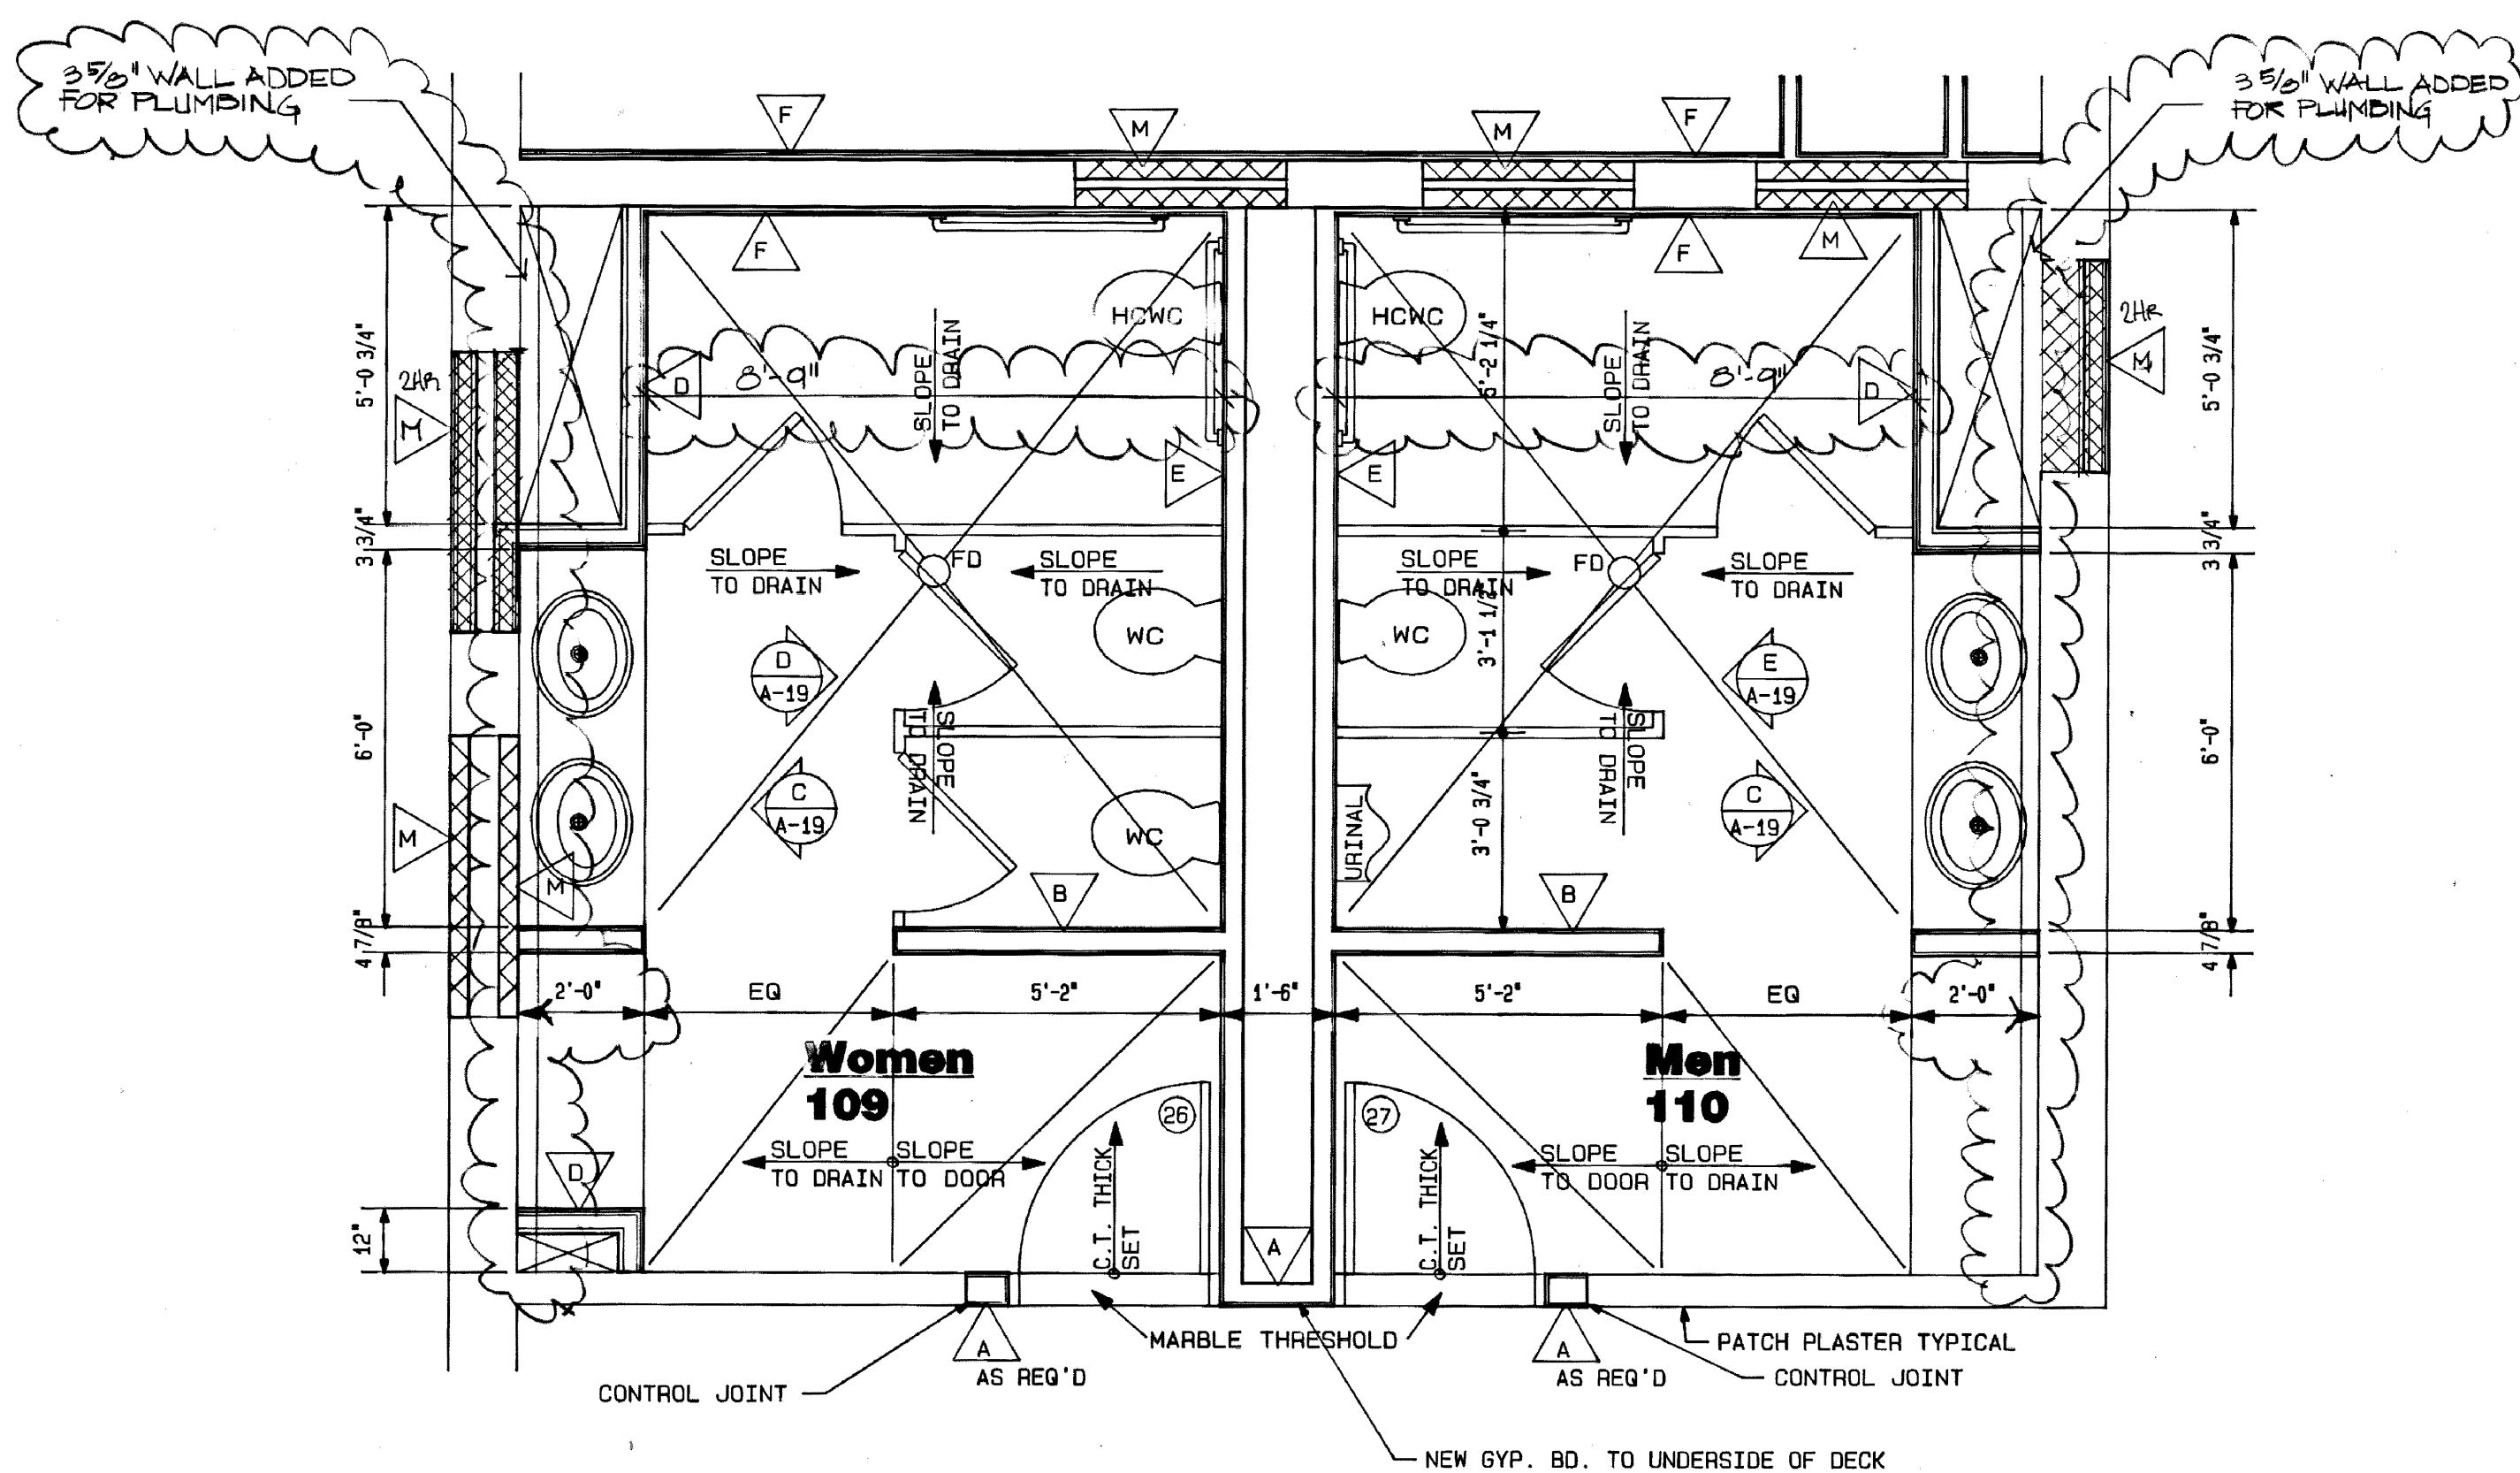

Enlarged Plan
SCALE 3/8" = 1'-0"


LEGEND

- CPT-1 CARPET
- VCT-1 VINYL COMPOSITION TILE
- C.F.T. CERAMIC FLOOR TILE
- EW ENTRY MAT
- VCB VINYL COVE BASE
- PT-1 PAINT (WALLS)
- PT-2 PAINT (TRIM)
- PT-3 PAINT (CEILING)
- CMT-1 CERAMIC WALL TILE
- ACT-1 ACoustICAL CEILING TILE
- EXIST. EXISTING
- CMU CONCRETE MASONRY UNIT
- BRICK BRICK
- GB GYPSUM BOARD
- P.C. POURED CONCRETE
- GB GYPSUM BOARD
- VNC VINYL WALL COVERING
- ALL VNC IS ADD ALTERNATE

ROOM FINISH SCHEDULE • FIRST FLOOR

Nº	Room Name	Floor	Base	North	South	East	West	Ceiling	Door	Remarks
101	BREAKROOM	VCT-1	VCB	BRICK	GB/PT-1	GB/PT-1	GB/PT-1	ACT-1	PT-2	
102	JANITOR	VCT-1	VCB	BRICK	GB/PT-1	GB/PT-1	GB/PT-1	ACT-1	PT-2	
103	CONFERENCE	CPT-1	VVCB	BRICK	GB/PT-1	GB/PT-1	GB/PT-1	ACT-1	PT-2	
104	OFFICE	CPT-1	VCB	BRICK	GB/PT-1	GB/PT-1	GB/PT-1	ACT-1	PT-2	
105	OFFICE	CPT-1	VCB	BRICK	GB/PT-1	GB/PT-1	GB/PT-1	ACT-1	PT-2	
106	OFFICE	CPT-1	VCB	BRICK	GB/PT-1	GB/PT-1	GB/PT-1	ACT-1	PT-2	
107	ELEV. LOBBY LEVEL G	VCT-2	VCB	BRICK	GB/PT-1	GB/PT-1	GB/PT-1	ACT-1	PT-2	
108	ELEV. LOBBY LEVEL 1	VCT-2	VCB	BRICK	GB/PT-1	GB/PT-1	GB/PT-1	ACT-1	PT-2	
109	WOMEN	C.F.T.	CTB	PT-1	PT-1	PT-1	PT-1	ACT-1	PT-3	
110	MEN	C.F.T.	CTB	PT-1	PT-1	PT-1	PT-1	ACT-1	PT-3	
111	RECORDS	EXIST.	EXIST.	EXIST.	EXIST.	EXIST.	EXIST.	EXIST.	EXIST.	
112	WAITING ENTRY	VCT-2	VCB	BRICK	GB/PT-1	GB/PT-1	GB/PT-1	ACT-1	PT-2	Patch Existing Floor
113	RECEPTION	CPT-1	VCB	BRICK	GB/PT-1	GB/PT-1	GB/PT-1	ACT-1	PT-3	
114	TESTING	CPT-1	VCB	BRICK	GB/PT-1	GB/PT-1	GB/PT-1	ACT-1	PT-3	
115	H.R. ADMINISTRATION	CPT-1	VCB	BRICK	GB/PT-1	GB/PT-1	GB/PT-1	ACT-1	PT-3	
116	CONFERENCE	EXIST.	EXIST.	EXIST.	EXIST.	EXIST.	EXIST.	EXIST.	EXIST.	Patch Existing Wall
117	OFFICE	EXIST.	EXIST.	EXIST.	EXIST.	EXIST.	EXIST.	EXIST.	EXIST.	Patch Existing Wall
118	CONFERENCE	EXIST.	EXIST.	EXIST.	EXIST.	EXIST.	EXIST.	EXIST.	EXIST.	Patch Existing Wall
119	OFFICE	EXIST.	EXIST.	EXIST.	EXIST.	EXIST.	EXIST.	EXIST.	EXIST.	Patch Existing Wall
120	CONFERENCE	EXIST.	EXIST.	EXIST.	EXIST.	EXIST.	EXIST.	EXIST.	EXIST.	Patch Existing Wall
121	CONFERENCE	EXIST.	EXIST.	EXIST.	EXIST.	EXIST.	EXIST.	EXIST.	EXIST.	Patch Existing Wall
122	OFFICE	EXIST.	EXIST.	EXIST.	EXIST.	EXIST.	EXIST.	EXIST.	EXIST.	Patch Existing Wall
123	OFFICE	EXIST.	EXIST.	EXIST.	EXIST.	EXIST.	EXIST.	EXIST.	EXIST.	Patch Existing Wall
124	OFFICE	EXIST.	EXIST.	EXIST.	EXIST.	EXIST.	EXIST.	EXIST.	EXIST.	Patch Existing Wall
125	OFFICE	EXIST.	EXIST.	EXIST.	EXIST.	EXIST.	EXIST.	EXIST.	EXIST.	Patch Existing Wall
126	OFFICE	EXIST.	EXIST.	EXIST.	EXIST.	EXIST.	EXIST.	EXIST.	EXIST.	Patch Existing Wall
NOTE: 1. SEE SPECIFICATIONS FOR SIGNAGE SCHEDULE.
2. ADD ALTERNATE: ADD VMC TO ROOMS 105, 106, 124, 125
BASE BID TO INCLUDE 1 PLUMB & 2 FINISH COATS OF PAINT

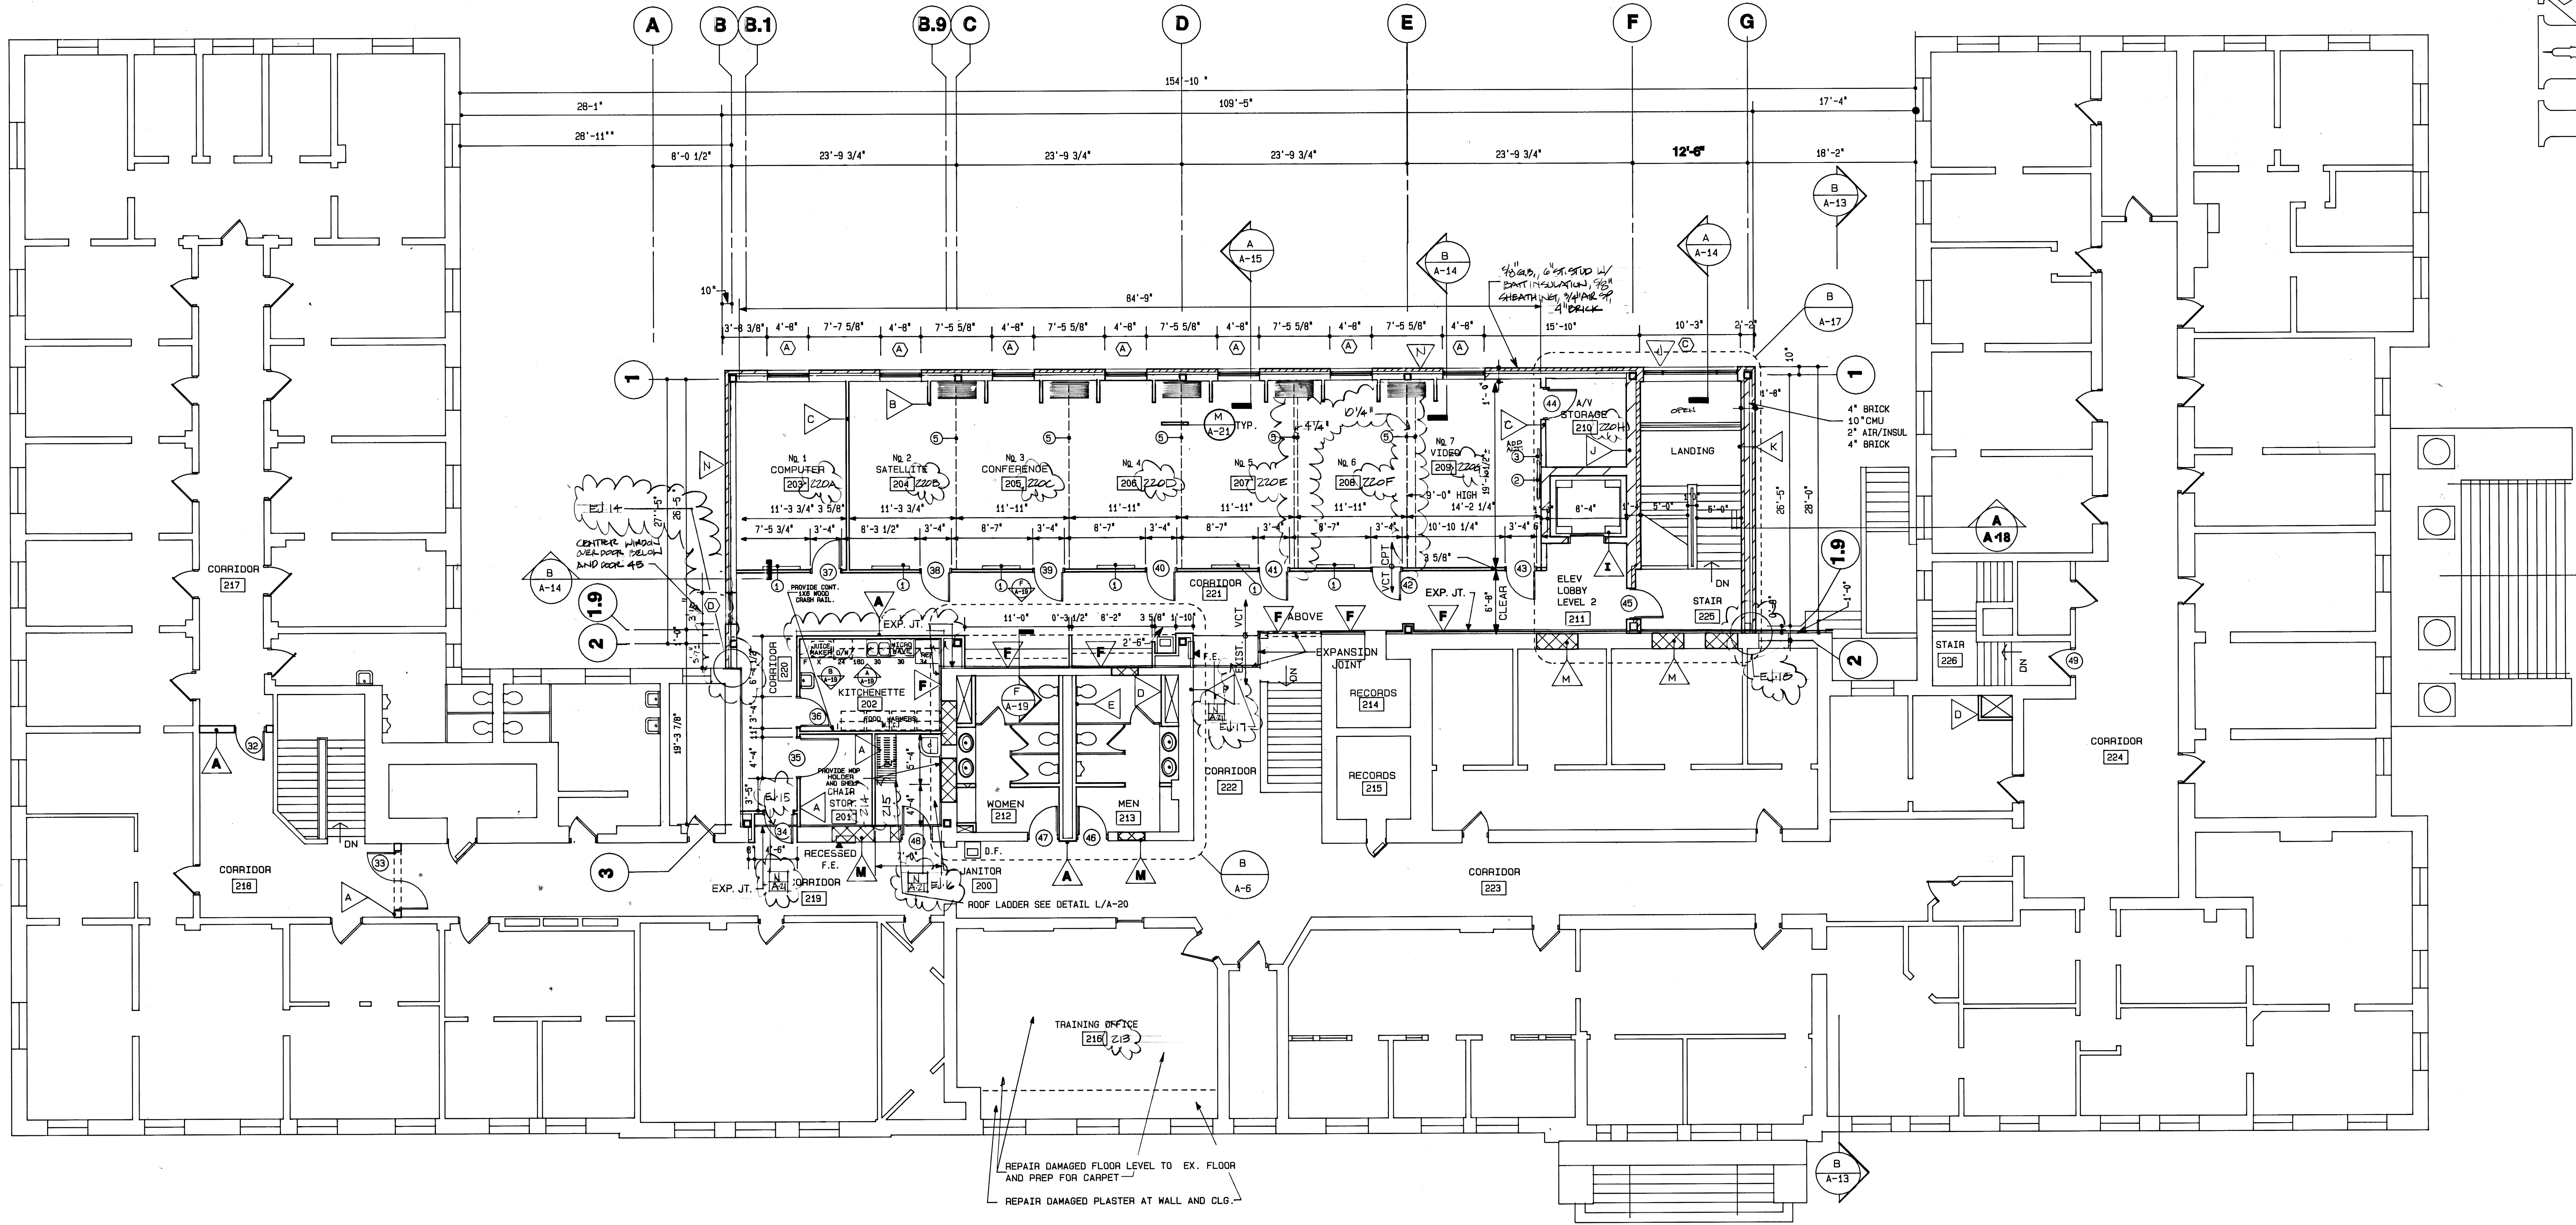

SECOND FLOOR PLAN • ADDITION & RENOVATION

SCALE 1/8" = 1'-0"

LEGEND

CPT-1 CARPET
VCT-1 VINYL COMPOSITION TILE
VCT-2 VINYL COMPOSITION TILE
C.F.T. CERAMIC FLOOR TILE
EM ENTRY MAT
VCB VINYL COMB BASE
CTB CERAMIC TILE BASE
PT-1 PAINT (WALLS)
PT-2 PAINT (TRIM)
PT-3 PAINT (CEILING)
CMT-1 CERAMIC MOUNT TILE
ACT-1 ACUSTICAL CEILING TILE
EXIST. EXISTING
CMU CONCRETE MASONRY UNIT
BRICK BRICK
GYP GYPSUM BOARD
GLASS GLASS
P.C. POURED CONCRETE
VNC VINYL WALL COVERING

ROOM FINISH SCHEDULE • SECOND FLOOR

No.	Room Name	Floor	Base	Walls				Ceiling	Door	Remarks
				North	South	East	West			
200	JANITOR	VCT-1	VCB	BRICK	GB/PT-1	GB/PT-1	BRICK	ACT-1	PT-2	
201	CHAIR STORAGE	VCT-1	VCB	BRICK	GB/PT-1	GB/PT-1	GB/PT-1	ACT-1	PT-2	
202	KITCHENETTE	VCT-1	VCB	GB/PT-1	GB/PT-1	GB/PT-1	BRICK	ACT-1	PT-2	
203	COMPUTER NO. 1	OPT-1	VCB	GB / VMC	GB / PT-1	CMU/PT-1	GB / VMC	ACT-1	PT-2	5
204	SATELLITE NO. 2	OPT-1	VCB	GB / VMC	GB / PT-1	GB / VMC	GB / PT-1	ACT-1	PT-2	5
205	CONFERENCE NO. 3	OPT-1	VCB	GB / VMC	GB / PT-1	GB / PT-1	GB / PT-1	ACT-1	PT-2	5
206	TRAINING CENTER NO. 4	OPT-1	VCB	GB / VMC	GB / PT-1	GB / PT-1	GB / PT-1	ACT-1	PT-2	5
207	TRAINING CENTER NO. 5	OPT-1	VCB	GB / VMC	GB / PT-1	GB / PT-1	GB / PT-1	ACT-1	PT-2	5
208	NO. 6	OPT-1	VCB	GB / VMC	GB / PT-1	GB / PT-1	GB / PT-1	ACT-1	PT-2	5
209	VIDEO NO. 7	OPT-1	VCB	GB / VMC	GB / PT-1	GB / PT-1	GB / PT-1	ACT-1	PT-2	5
210	A/V STORAGE	OPT-1	VCB	CMU/PT-1	GB/PT-1	GB/PT-1	CMU/PT-1	ACT-1	PT-2	
211	ELEV. LOBBY LEVEL 2	VCT-2	VCB	GB/PT-1	CMU/PT-1	GB/PT-1	CMU/PT-1	ACT-1	PT-2	
212	WOMEN	C.F.T.	CTB	PT-1	PT-1	PT-1	PT-1	ACT-1	PT-2	
213	MEN	C.F.T.	CTB	PT-1	PT-1	PT-1	PT-1	ACT-1	PT-2	
214	RECORDS	EXIST.	EXIST.	EXIST.	EXIST.	EXIST.	EXIST.	EXIST.	EXIST.	
215	RECORDS	EXIST.	EXIST.	EXIST.	EXIST.	EXIST.	EXIST.	EXIST.	EXIST.	
216	TRAINING OFFICE	OPT-1	VCB	PLAS/PT-1	PLAS/PT-1	PLAS/PT-1	PLAS/PT-1	ACT-1	PT-2	SEE NOTES 2, 3, 4
217	CORRIDOR	EXIST.	EXIST.	PLAS/PT-1	EXIST.	EXIST.	EXIST.	EXIST.	EXIST.	
218	CORRIDOR	EXIST.	EXIST.	EXIST.	PLAS/PT-1	EXIST.	PLAS/PT-1	EXIST.	EXIST.	
219	CORRIDOR	EXIST.	EXIST.	PLAS/PT-1	PLAS/PT-1	PLAS/PT-1	EXIST.	EXIST.	EXIST.	Patch Existing Wall
220	CORRIDOR	VCT-1	VCB	GB / VMC	GB / VMC	BRICK	GB/PT-1	ACT-1	PT-2	5
221	CORRIDOR	VCT-1	VCB	GB / VMC	GB / VMC	CMU/PT-1	GB/PT-1	ACT-1	PT-2	5
222	CORRIDOR	EXIST.	EXIST.	EXIST.	EXIST.	EXIST.	EXIST.	EXIST.	EXIST.	
223	CORRIDOR	EXIST.	EXIST.	EXIST.	EXIST.	EXIST.	EXIST.	EXIST.	EXIST.	
224	CORRIDOR	EXIST.	EXIST.	EXIST.	EXIST.	EXIST.	EXIST.	EXIST.	EXIST.	
225	STAIR	VCT-2	VCB	BRICK	BRICK	BRICK	BRICK	ACT-1	PT-2	
226	STAIR	EXIST.	EXIST.	EXIST.	EXIST.	EXIST.	EXIST.	EXIST.	EXIST.	

NOTE: 1. SEE SPECIFICATIONS FOR SIGNAGE SCHEDULE.
2. REPAIR DAMAGED PLASTER ON WALLS. SEAL ALL HOLES TO ATTIC WITH GYP. BD. PRIOR TO INSTALLING CEILING.
3. OVER LAY FLOOR WITH 1/8" MASONITE IN PREPARATION FOR CARPET ON FLOOR.
4. PATCH HOLE IN FLOOR. REMOVE DAMAGED FRAMING AND FLOORING. SISTER NEW WOOD JOISTS. LEVEL FLOOR WITH ADJACENT FLOOR.

5. ALL VMC IS ADD ALTERNATE, IN BASE BID PROVIDE PREP., PAINTING PRIME + 2 FINISH COATS PAINT

UNIVERSITY OF KENTUCKY


SCOVELL HALL RENOVATION

SECOND FLOOR PLAN / FINISH SCHEDULE

00 2115

A 0 7


Omni Architects

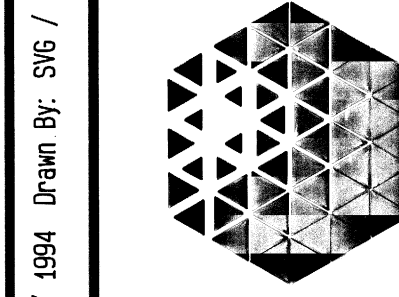

Architects
Civil Engineering
Interior Design
212 North Limestone Street
Lexington, Kentucky 40502
(606) 253-6664 Fax: (606) 253-2388

AS-BUILT AUG. 10, 1995

This drawing and design shall remain the property of Omni Architects. No reproduction or other use of this drawing without the written consent of Omni Architects is permitted.

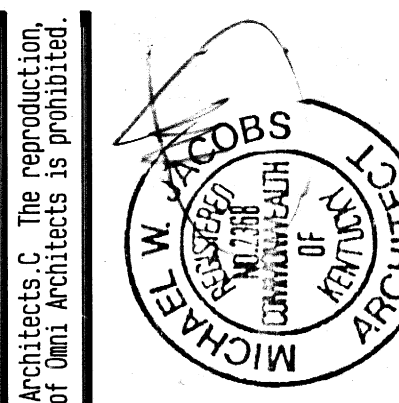

REFLECTED CEILING PLAN • BASEMENT

SCALE 1/8" = 1'-0"

NOTES:
1. REFER TO MISCELLANEOUS CEILING TRANSITION DETAILS ON SHEET A-20



SCD

UK

SCOVELL HALL RENOVATION

UNIVERSITY OF KENTUCKY

Reflected Ceiling Plan • Basement


Job No. 2386 (0) Date: 5 / 1994 Drawn By: S.G. Checked: G.F. Revisions: 1/2, 1/4, 4

This drawing and design shown herein are the property of Omni Architects, Inc. The reproduction, copying or other use of this drawing without the written consent of Omni Architects is prohibited.

002116
A • B

University of Kentucky Design Construction Division	Sheet	58	AS	002116
University of Kentucky Landscape Architecture Planning Interior	Document #			

Omni
Architects

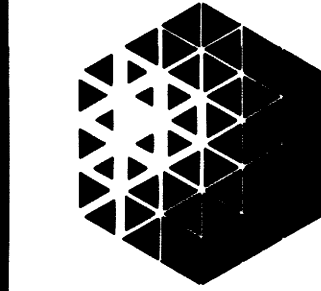


Architecture
Landscape Architecture
Planning
Interior
212 North Upper Street
Lexington, KY 40507
(606) 252-2884 Fax: (606) 252-2888

AS-BUILT AUG. 10, 1995



REFLECTED CEILING PLAN • FIRST FLOOR

SCALE 1/8" = 1'-0"

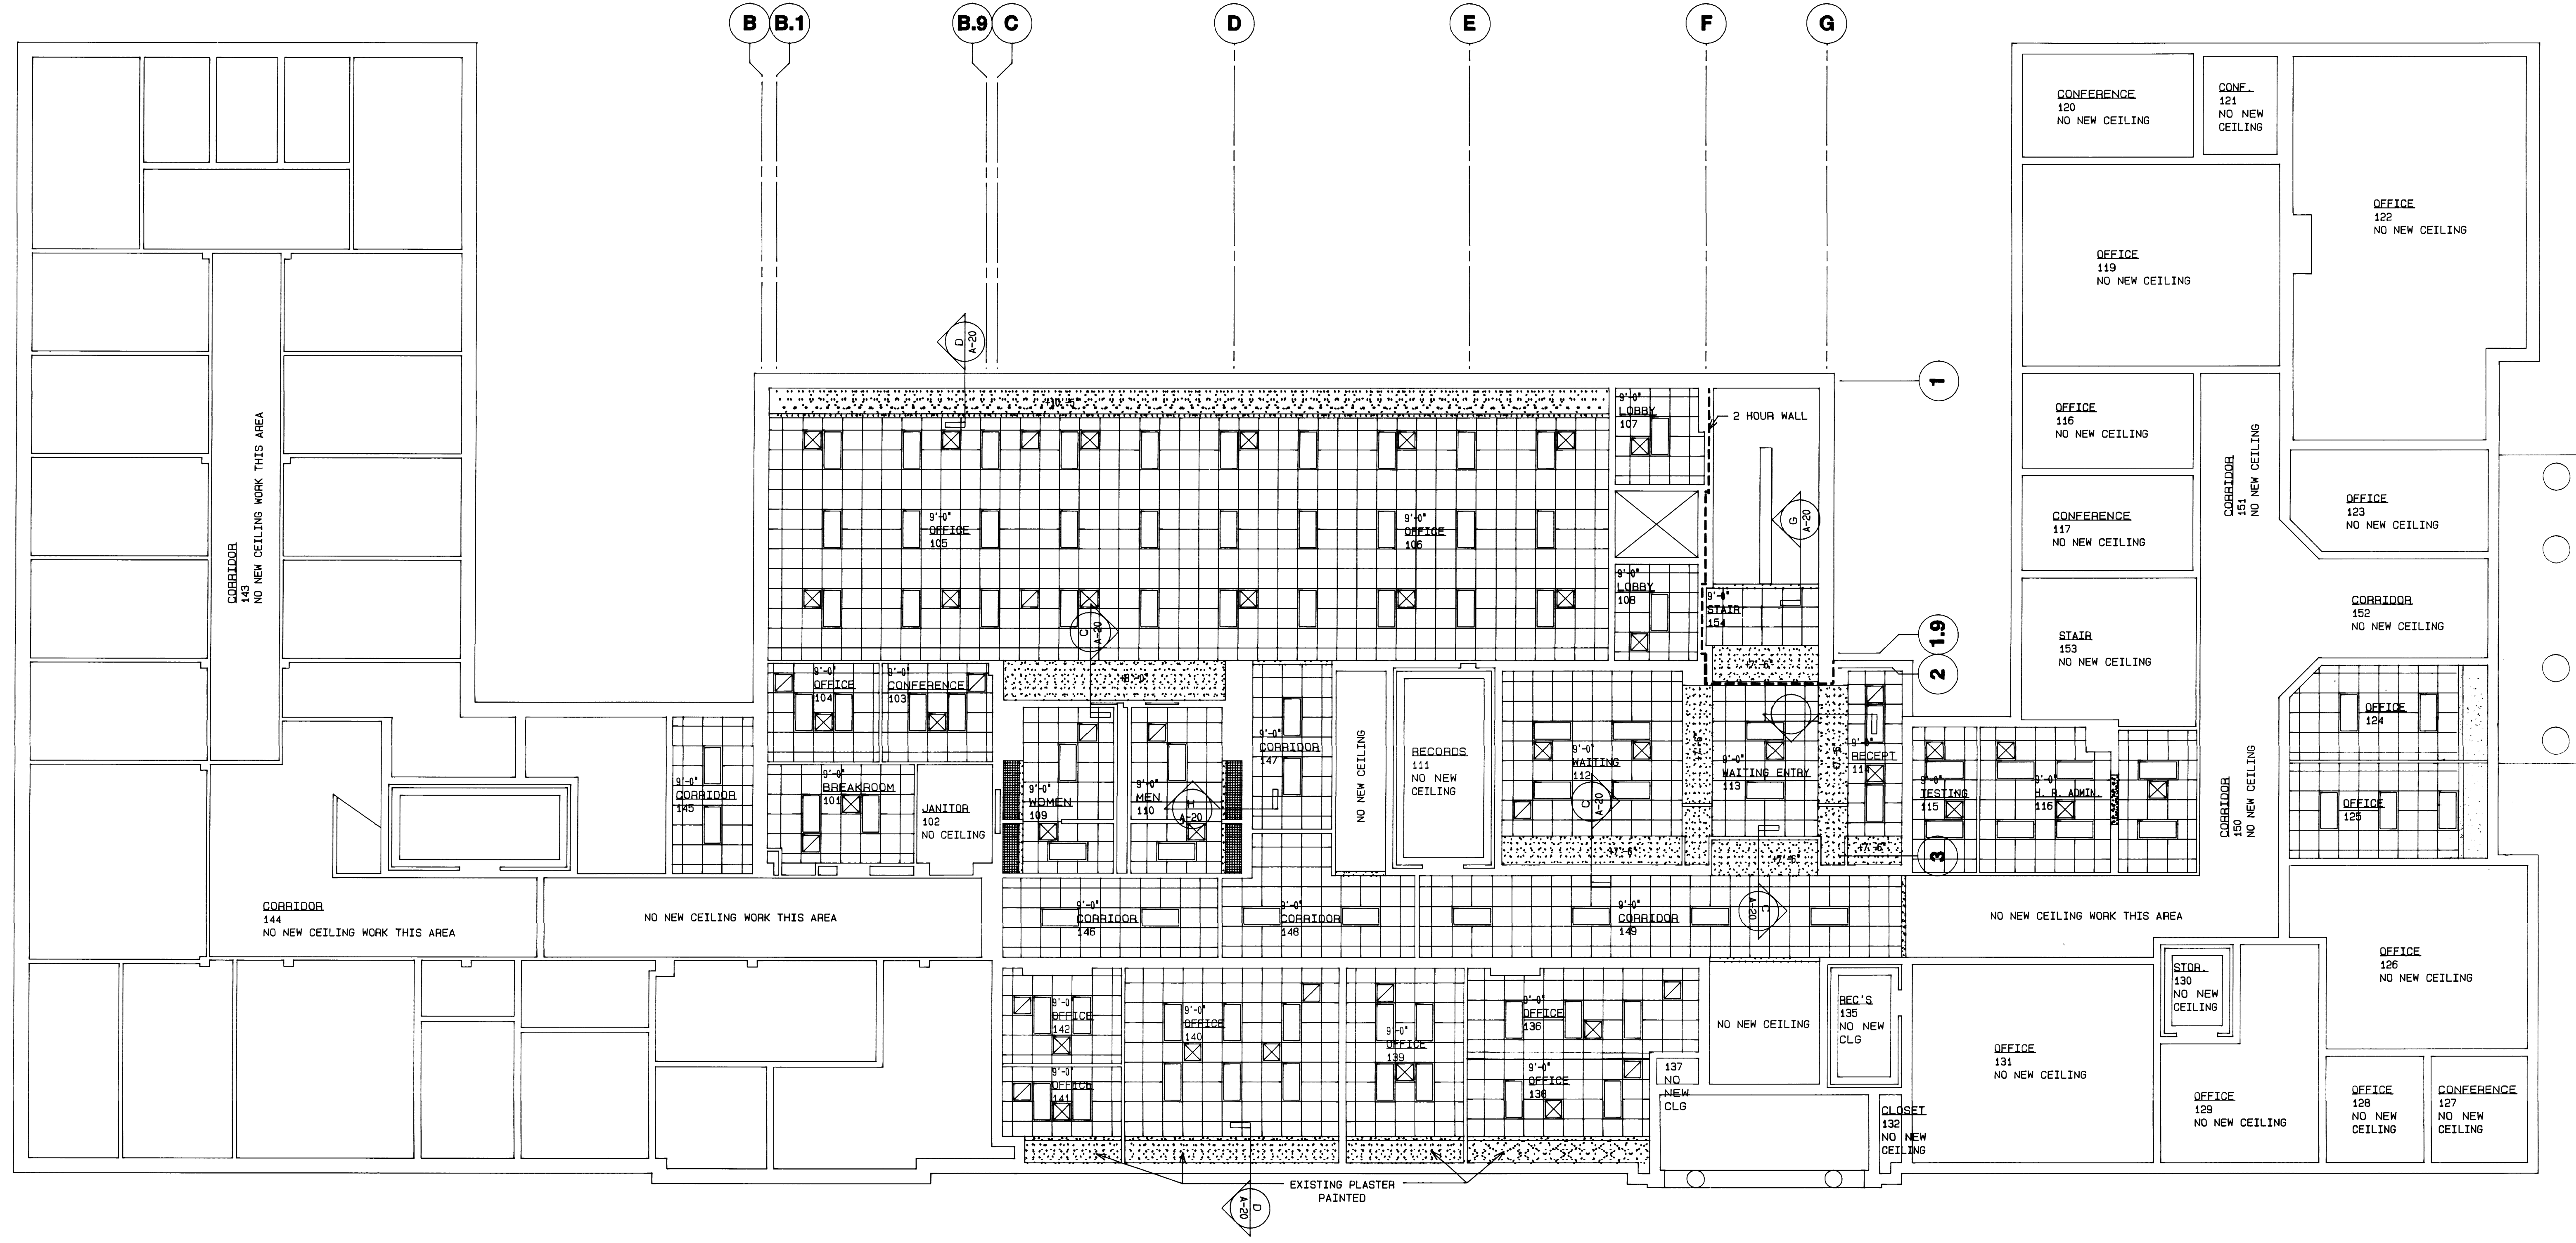

SCD


UK

SCOVELL HALL RENOVATION

UNIVERSITY OF KENTUCKY


Reflected Ceiling Plan • First Floor

Job No. 5965.00 Date: 5 / 1994 Drawn By: SNG / JD Checked: MM Revisions: 7/24/94

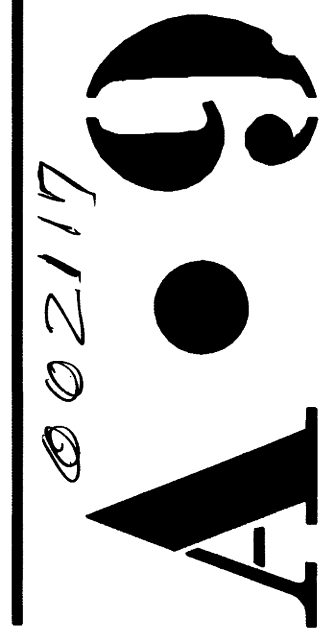


University of Kentucky
Department of Architecture
200 Natural Science Building
Lexington, KY 40507
Phone: 252-5564 Fax: 252-2596

Omni
Architects

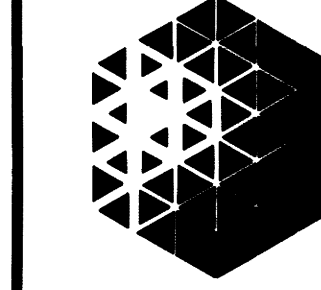


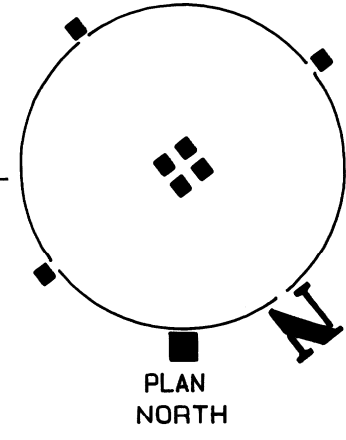
Architecture
Landscape Architecture
Civil Engineering
Interior Design
200 North Upper Street
Lexington, KY 40507
(606) 252-5564 Fax (606) 252-2596

AS-BUILT AUG. 10, 1995

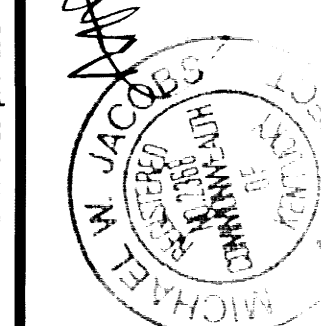

This drawing and design shown herein are the property of Omni Architects. The reproduction or copying in other use of this drawing without the written consent of Omni Architects is prohibited.

SCALE: 1/8" = 1'-0"




UNIVERSITY OF KENTUCKY

This Drawing and Design shown thereon are the property of Omni Architects.C. The reproduction, copying or other use of this Drawing without the written consent of Omni Architects is prohibited.

[illegible]


Cab #	Slot	Document #
38	A-3	002118

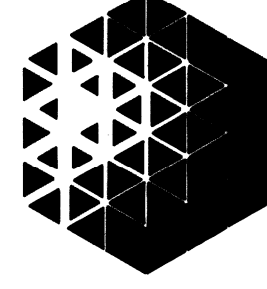
Omni
Architects

Architecture
Landscape Architecture
Civil Engineering
Planning
Interiors

212 North Upper Street
Lexington, KY 40507
(606) 252-5864 Fax: (606) 253-2


AS-BUILT AUG. 10, 1995

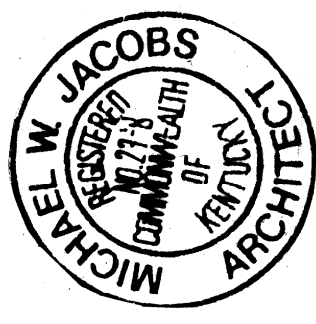



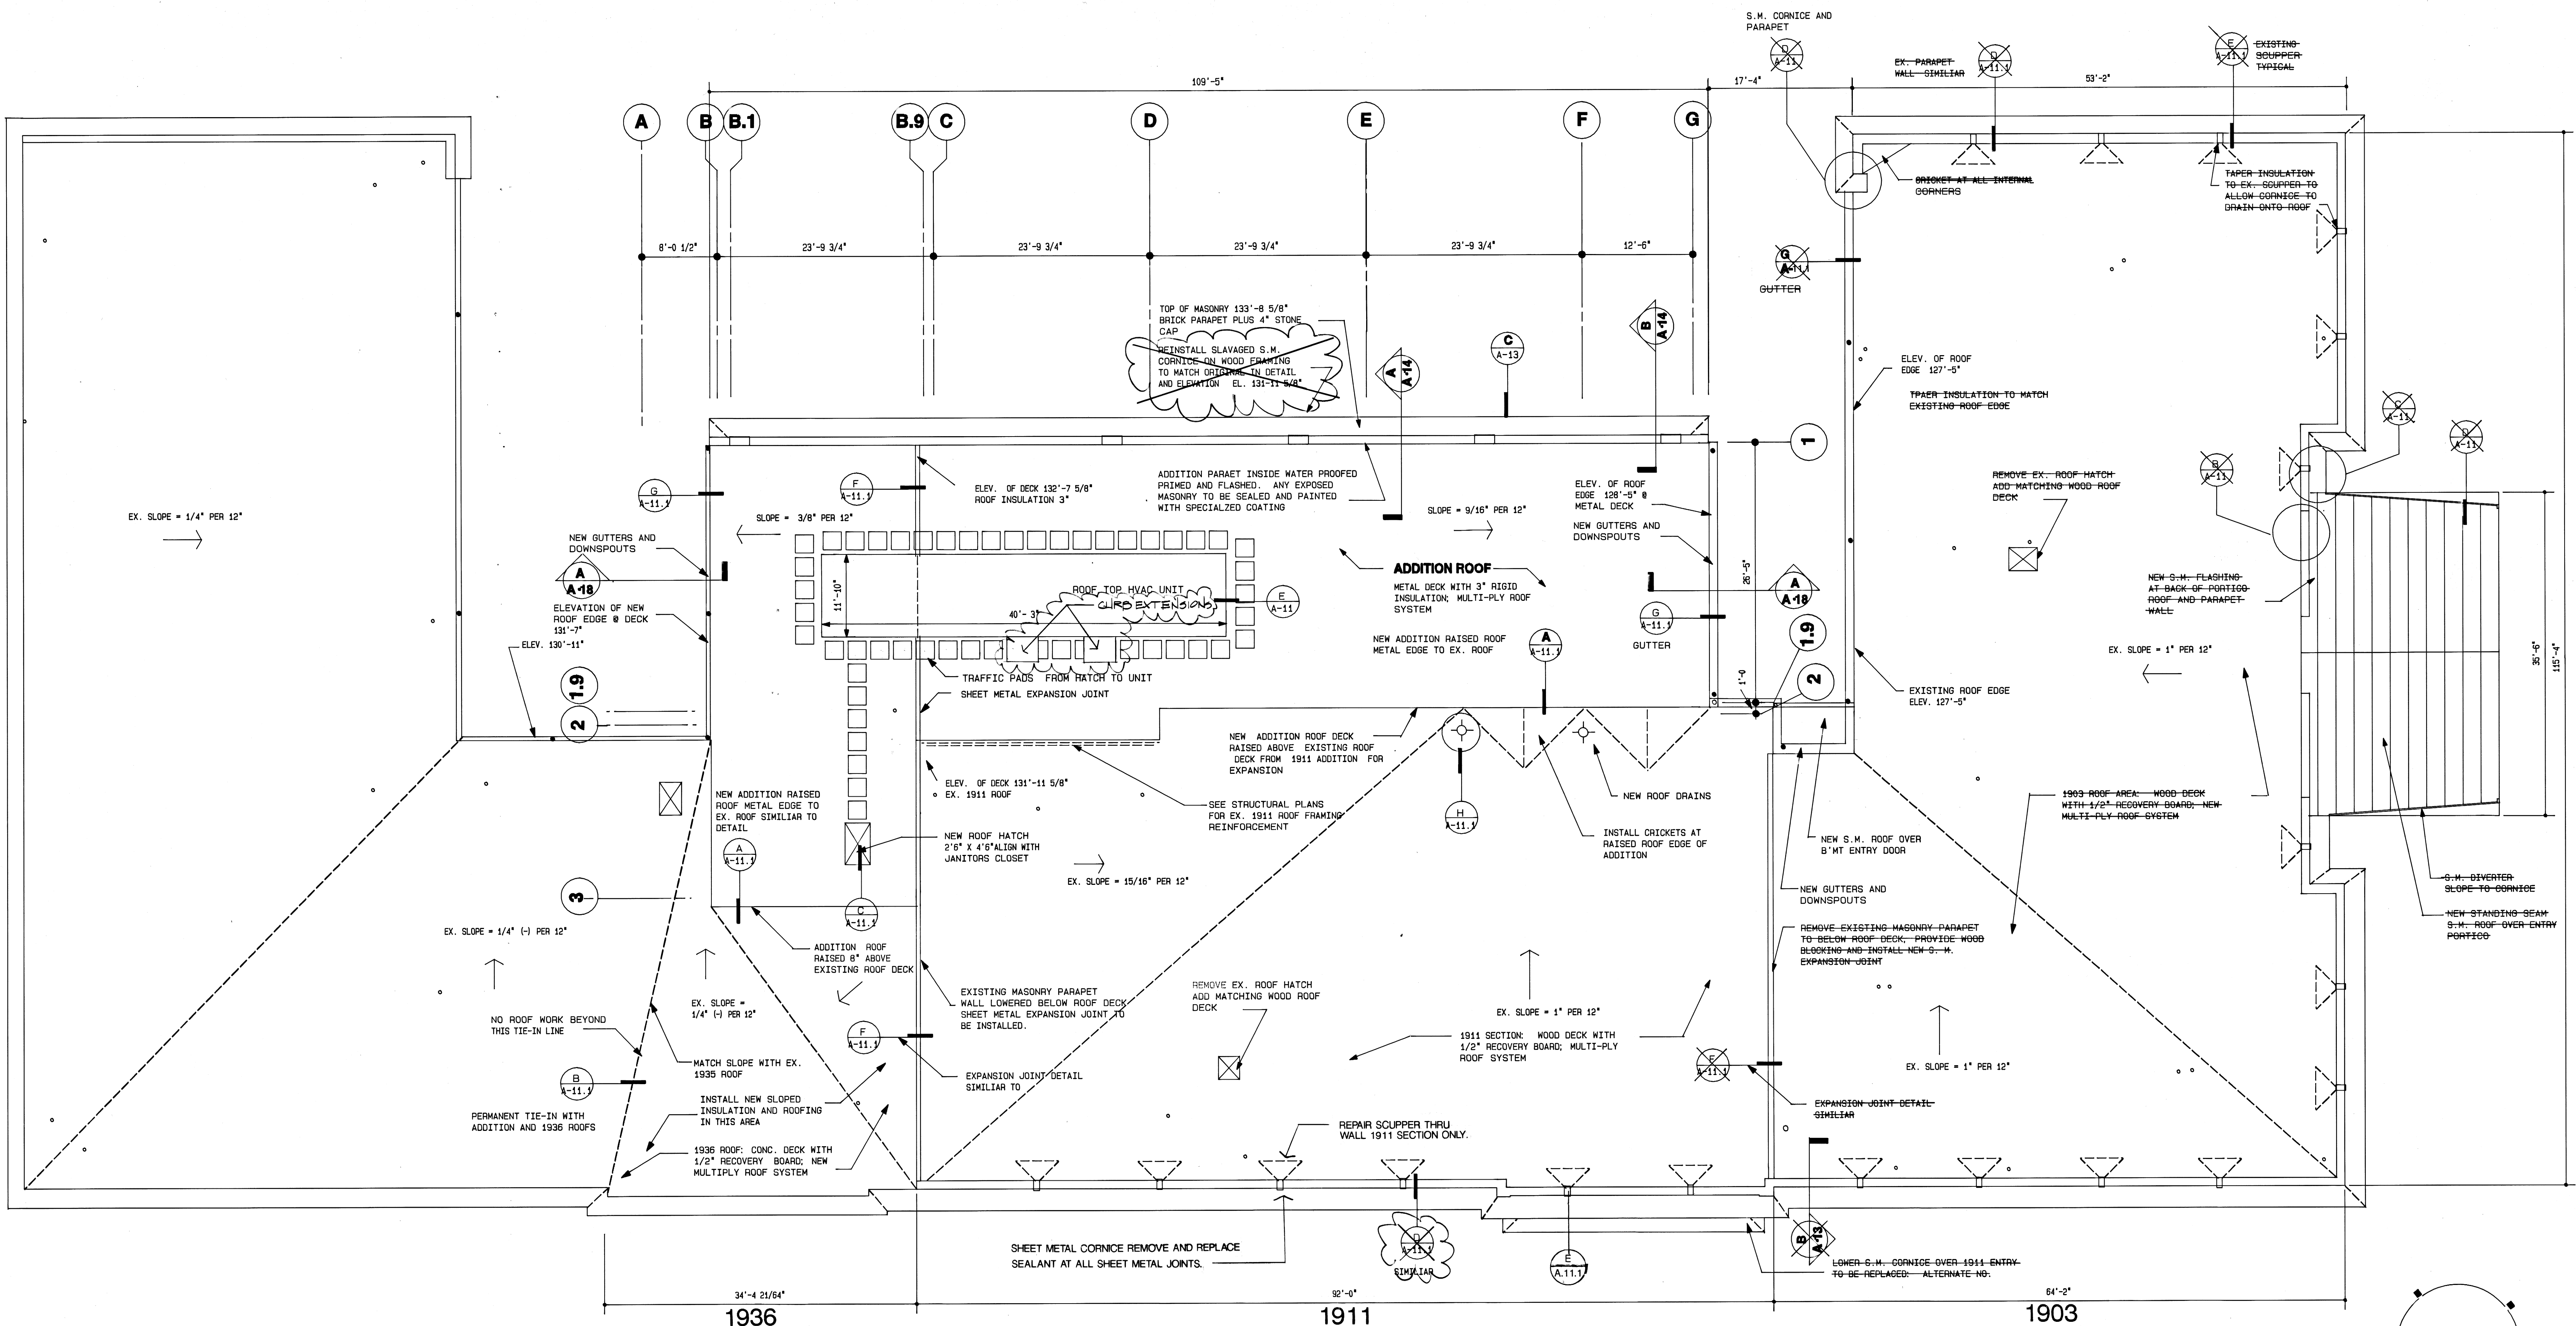


ROOF FLOOR PLAN • ADDITION & RENOVATION
SCALE 1/8" = 1'-0"

- 1) ROOF TOP UNIT TO BE LOCATED AND COORDINATED WITH STRUCTURAL SUPPORTS. ROOF TOP UNIT MUST BE CONFIGURED WITH INTERNAL STRUCTURE TO BE ABLE TO BE SUPPORTED ON ADDITION STEEL FRAME. SHOP DRAWINGS ARE TO INDICATE ALL DETAILS FOR STRUCTURE AND SUPPORTS.
- 2) ROOF TOP UNIT MUST HAVE INTEGRAL CURB WHICH FITS OVER SITE BUILT MECH. EQUIP. CURB AS DETAILLED.
- 3) GENERAL CONTRACTOR TO VERIFY DIMENSIONS AND LOCATIONS FOR STRUCTURE, HVAC DUCTWORK, ROOF DECK OPENING AND ROOF TOP UNIT.
- 4) ROOF TOP UNIT TO BE PAINTED WITH COLOR AS SELECTED BY THE ARCHITECT. PAINT TO BE FACTORY APPLIED SPECIALIZED COATING AS EPOXY-ESTER OR URETHANE TYPES.
- 5) ARCHITECT TO REVIEW SHOP DRAWINGS FOR LAYOUT OF DOORS, LOUVERS, GRILLES, ETC. PRIOR TO FABRICATION.

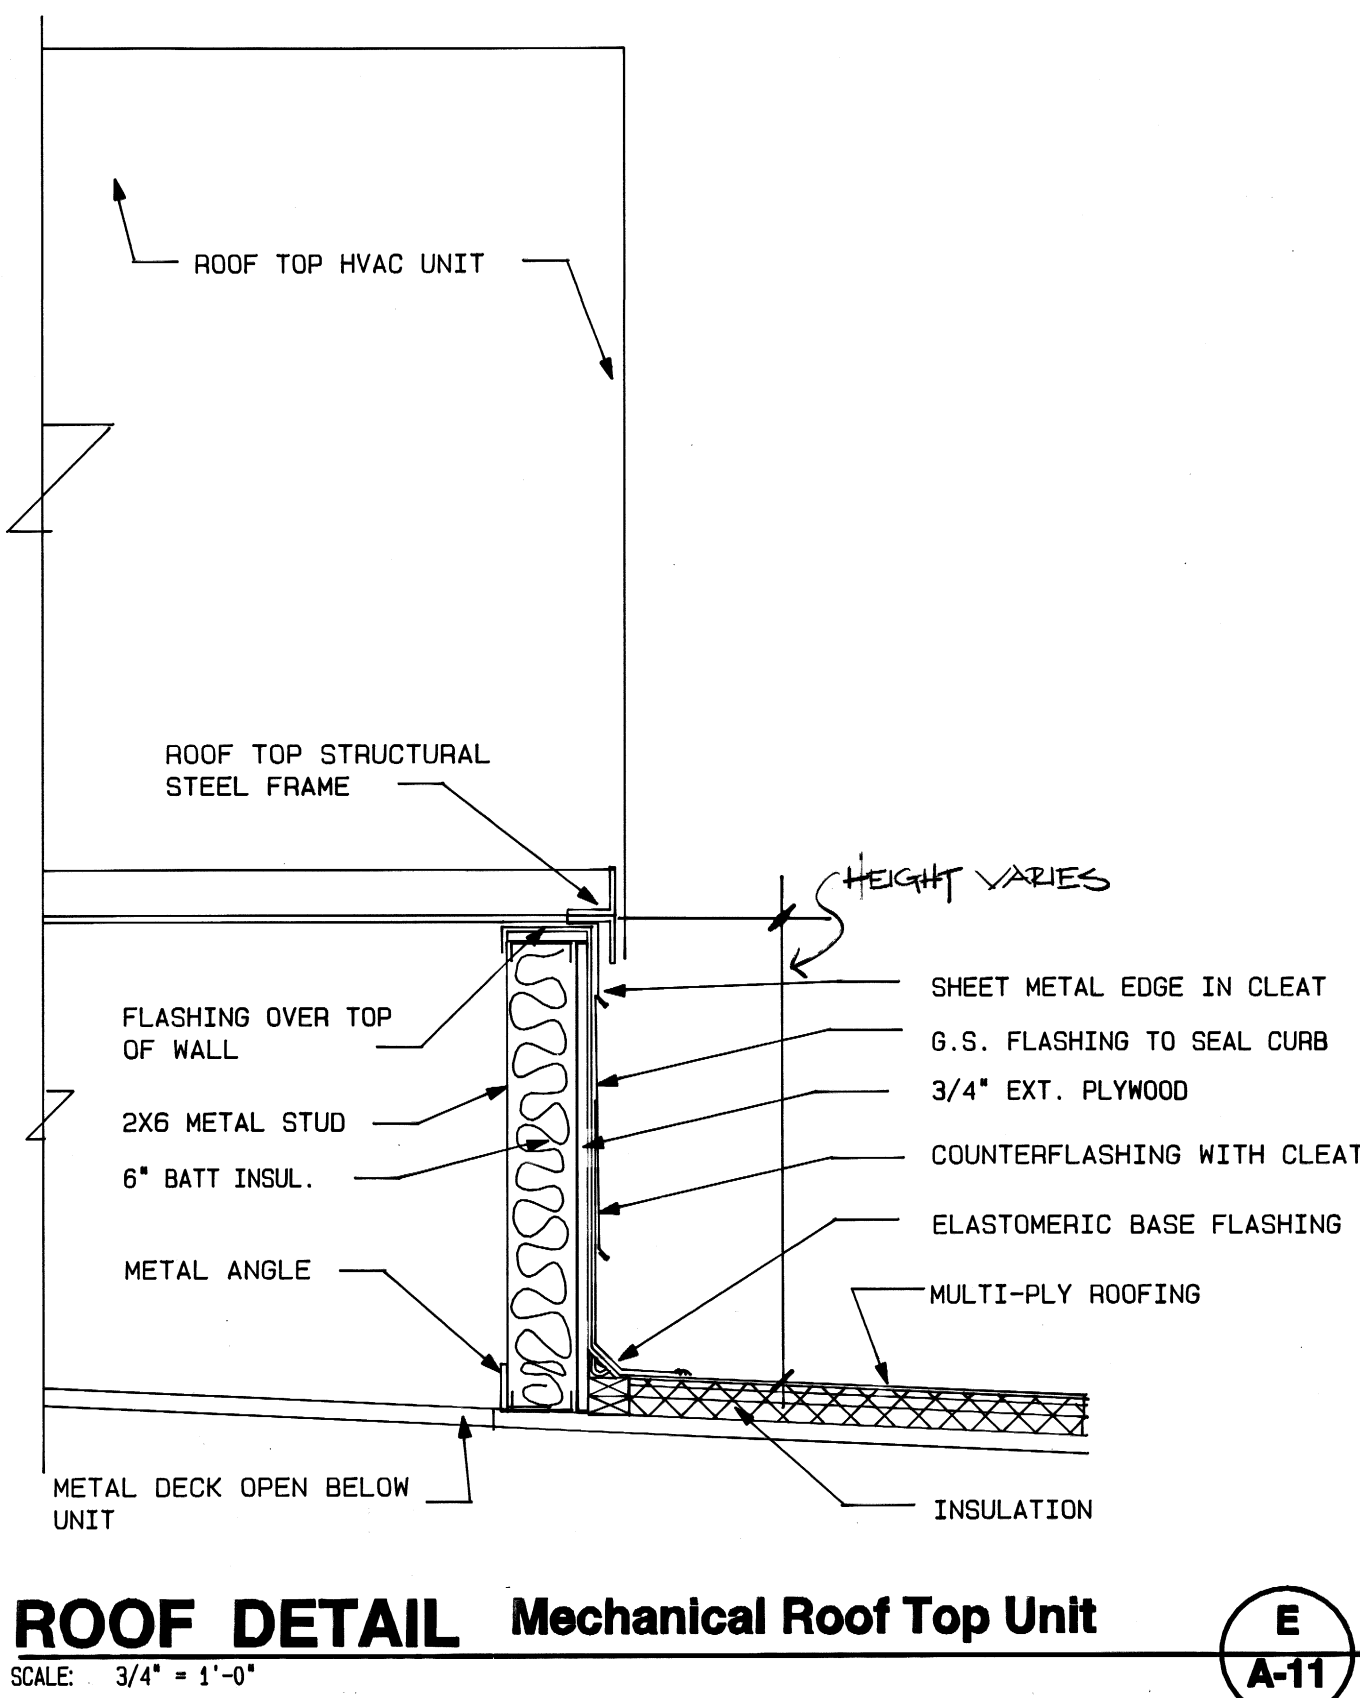

ROOF DETAIL Mechanical Roof Top Unit
SCALE 3/4\"/>

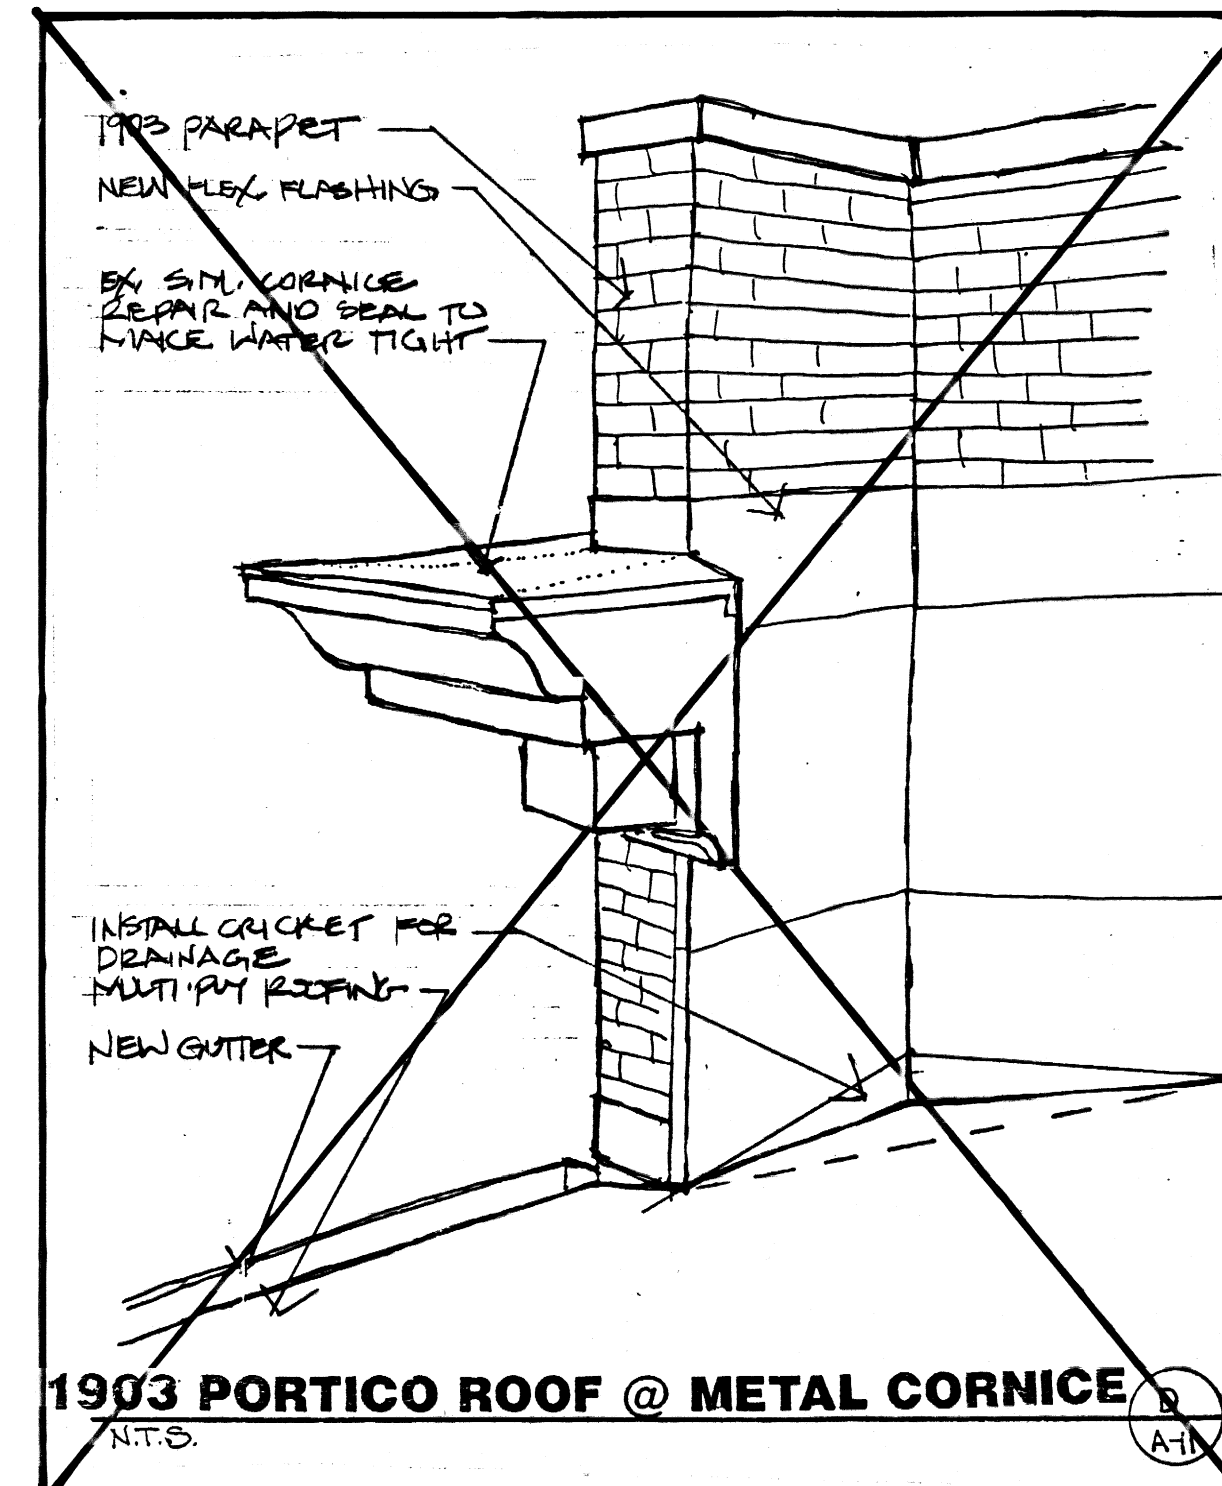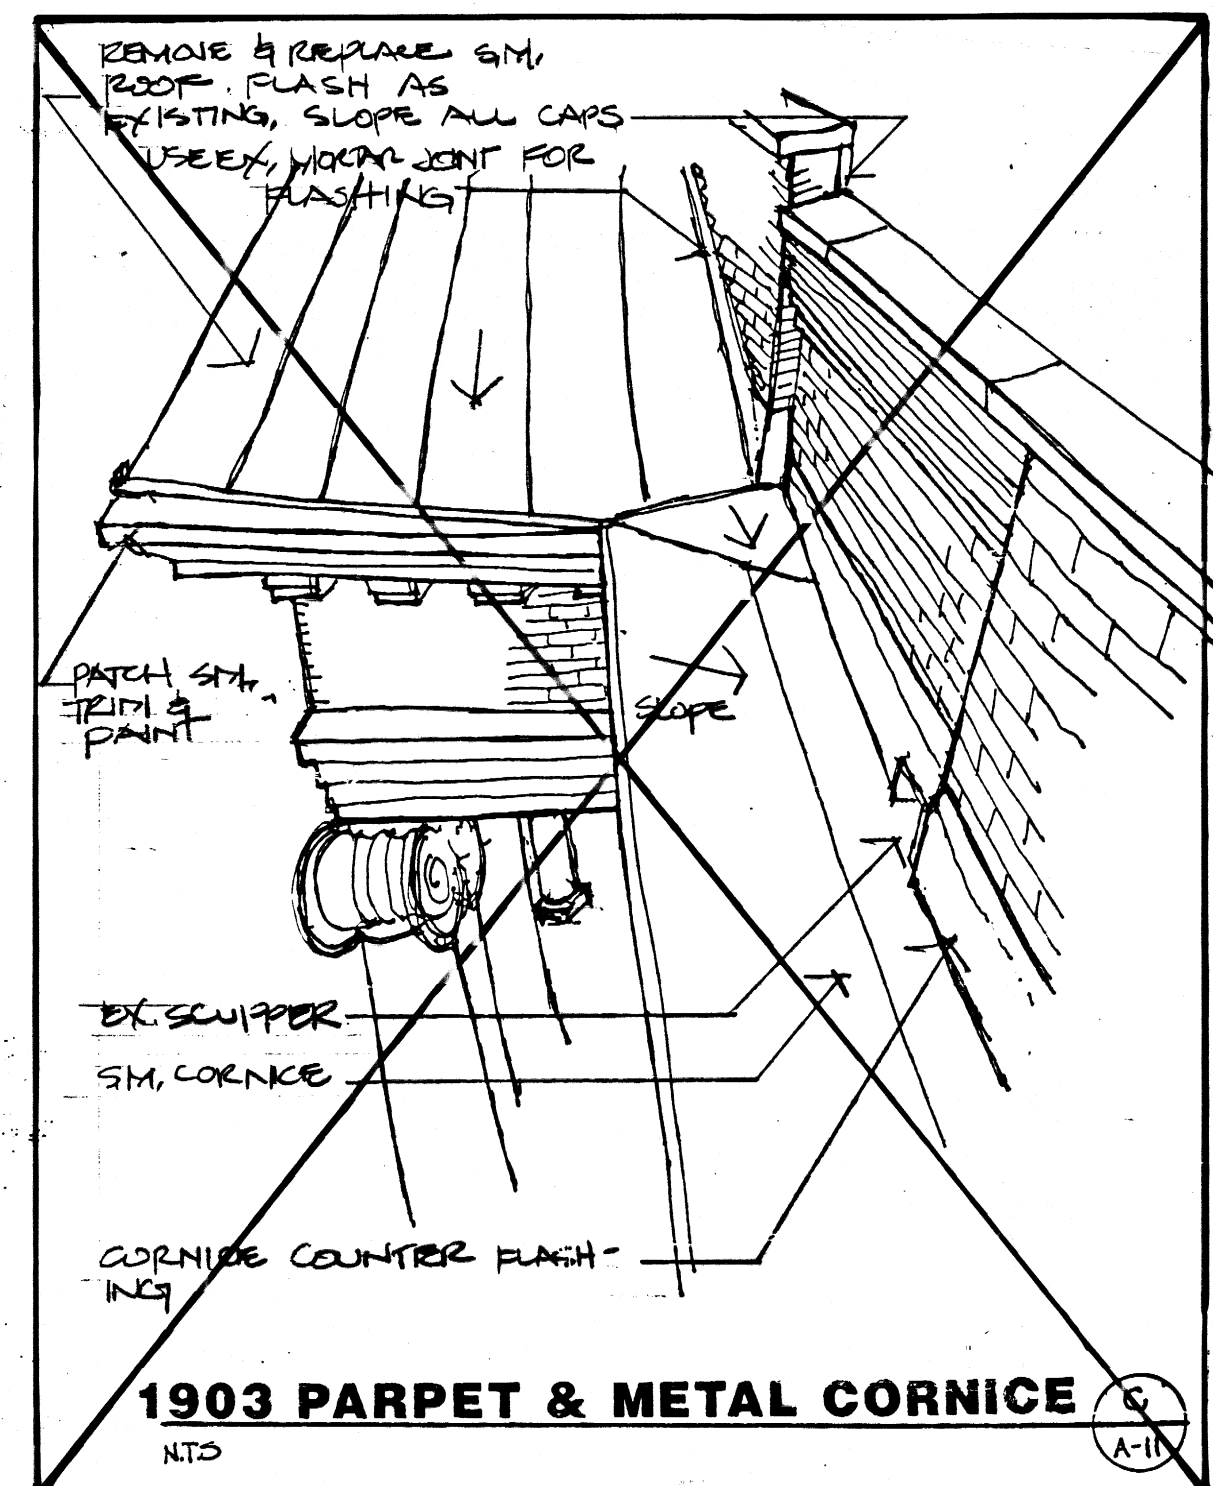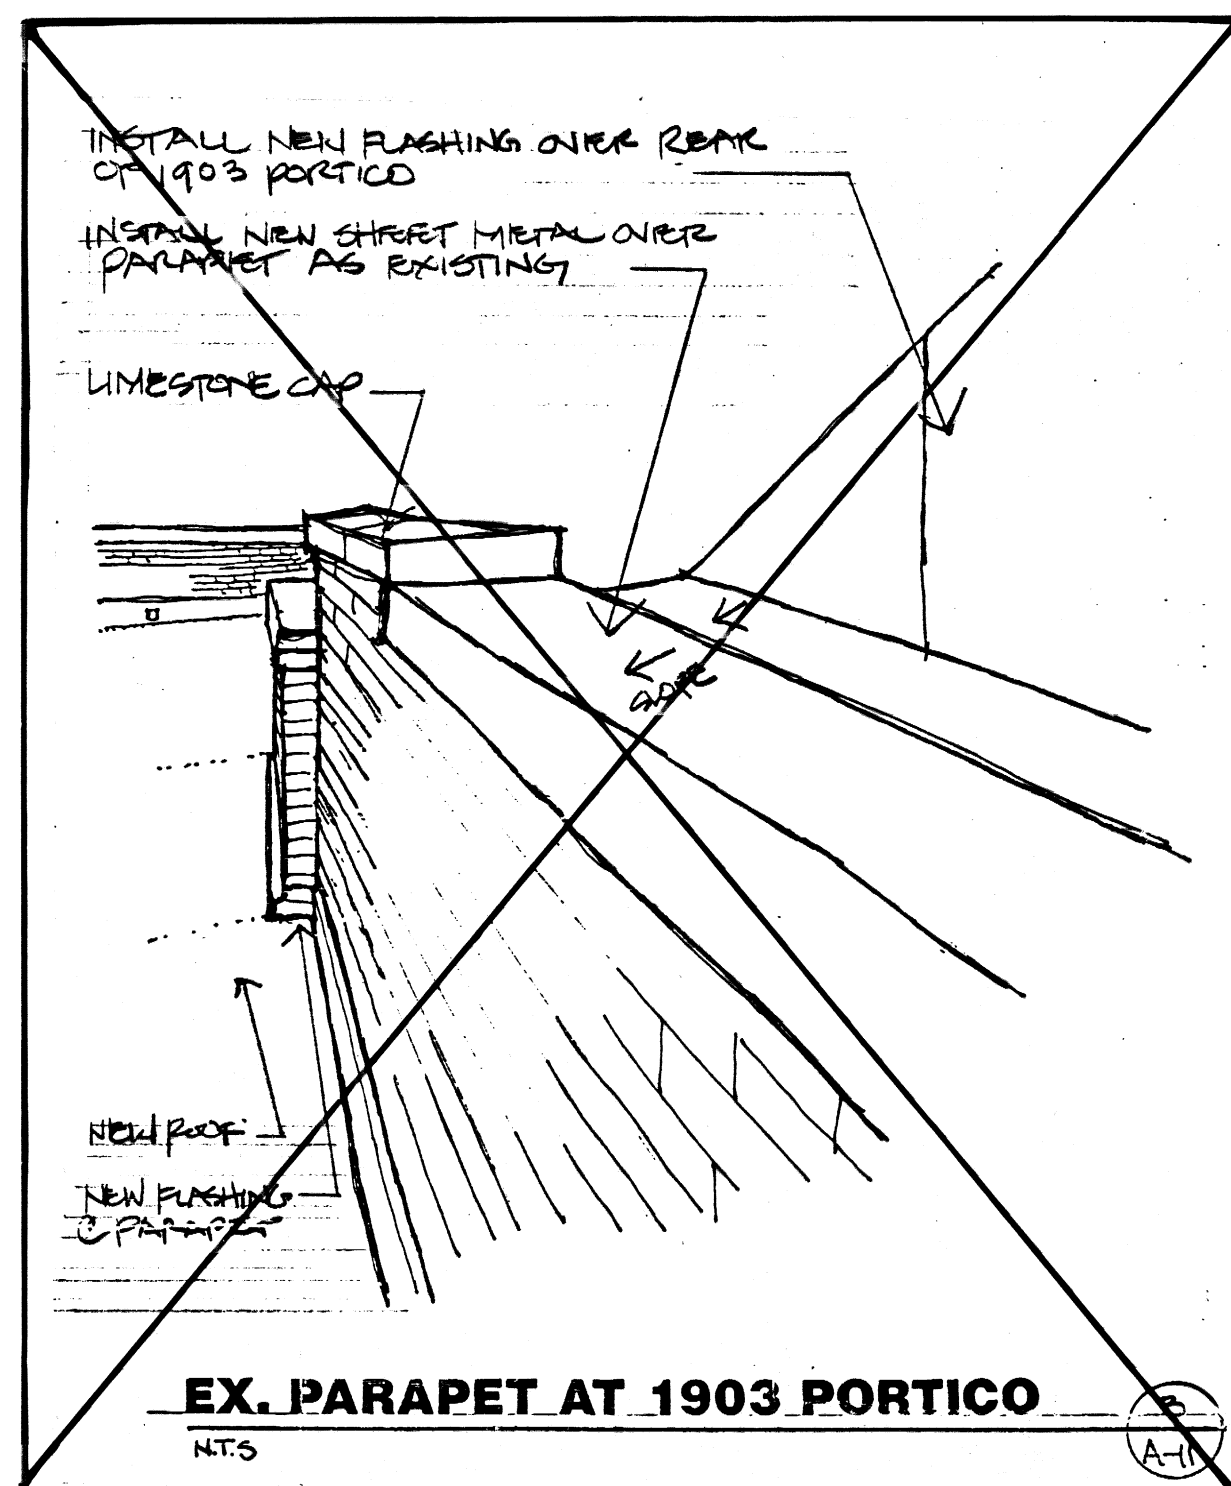

SCOVELL HALL RENOVATION

SCOVELL HALL RENOVATION


002114

A-11

University of Kentucky Campus Division	Sheet	38	A-3	002119
Project Name	Scovell Hall Renovation	Drawn By	Architect	Document #

University of Kentucky Campus Division	Sheet	38	A-3	002119
Project Name	Scovell Hall Renovation	Drawn By	Architect	Document #

Omni
Architects

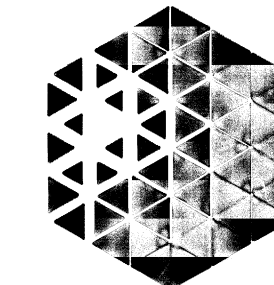



Architecture
 Landscape Architecture
 Planning
 Interiors
 212 North Upper Street
 Lexington, KY 40507
 (606) 255-0661 FAX: (606) 255-2558

UNIVERSITY OF KENTUCKY


AS-BUILT AUG. 10, 1995

This Drawing and Design shown herein are the property of Omni Architects, C. The reproduction, copying or other use of this drawing without the written consent of Omni Architects is prohibited.

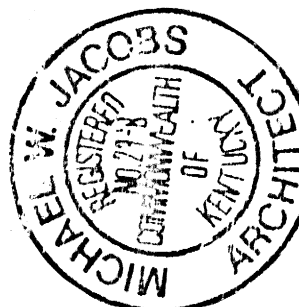


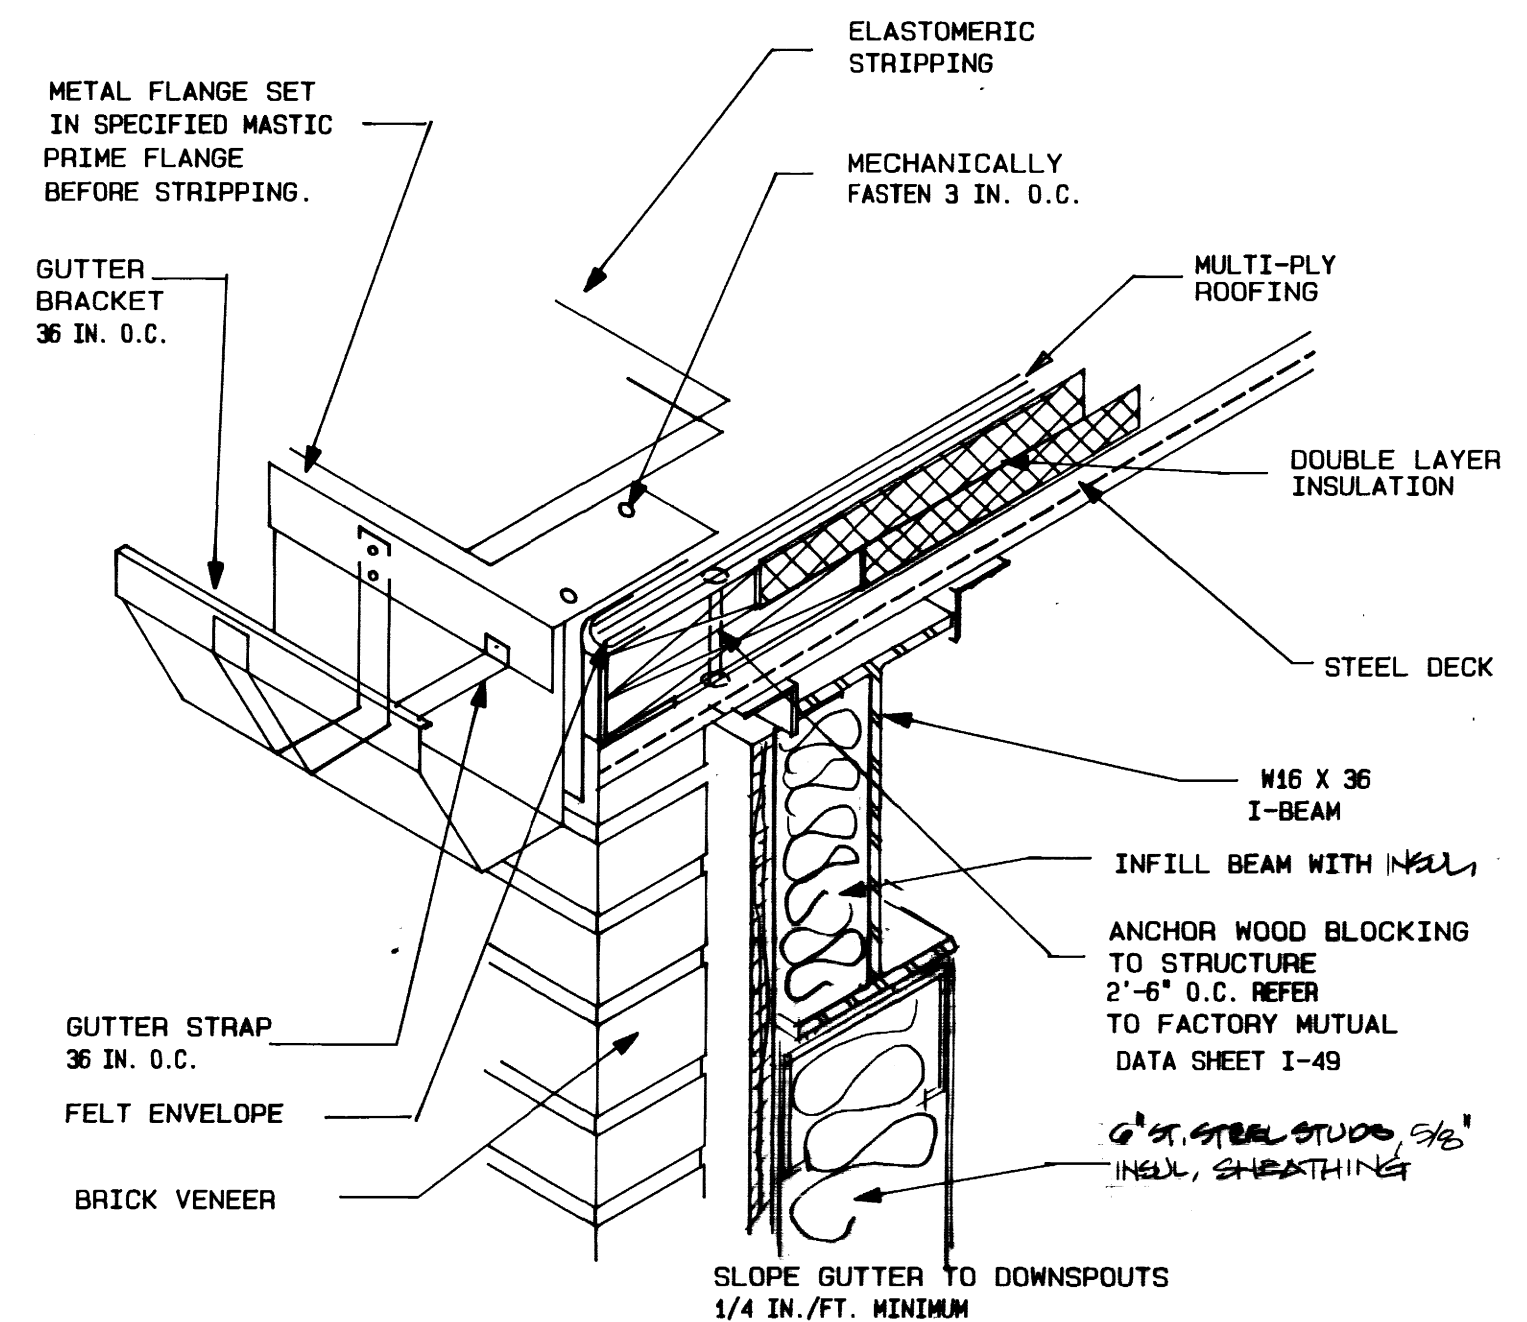


ROOF DETAIL ADDITION GUTTER AT ROOF EDGE
SCALE: 1 1/2" = 1'-0"

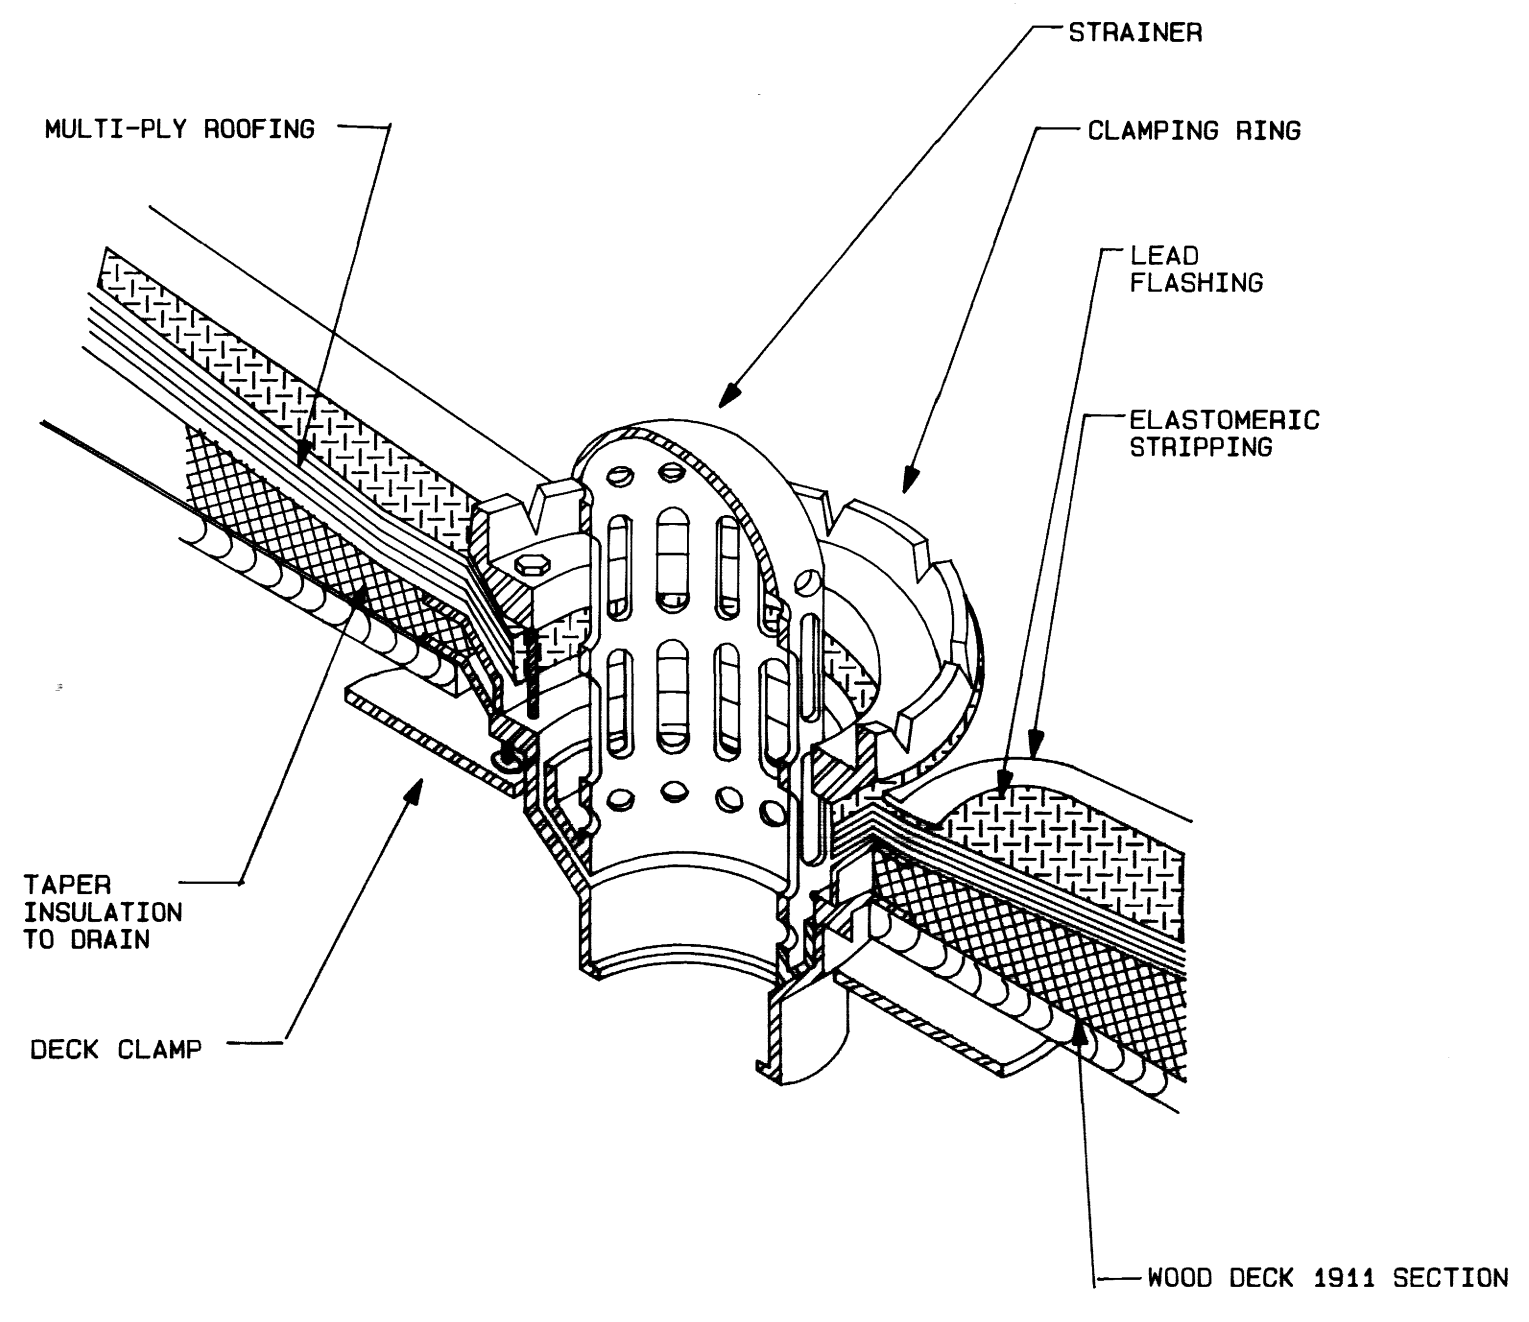


ROOF DETAIL ROOF DRAIN IN 1911 ROOF
SCALE: 1 1/2" = 1'-0"

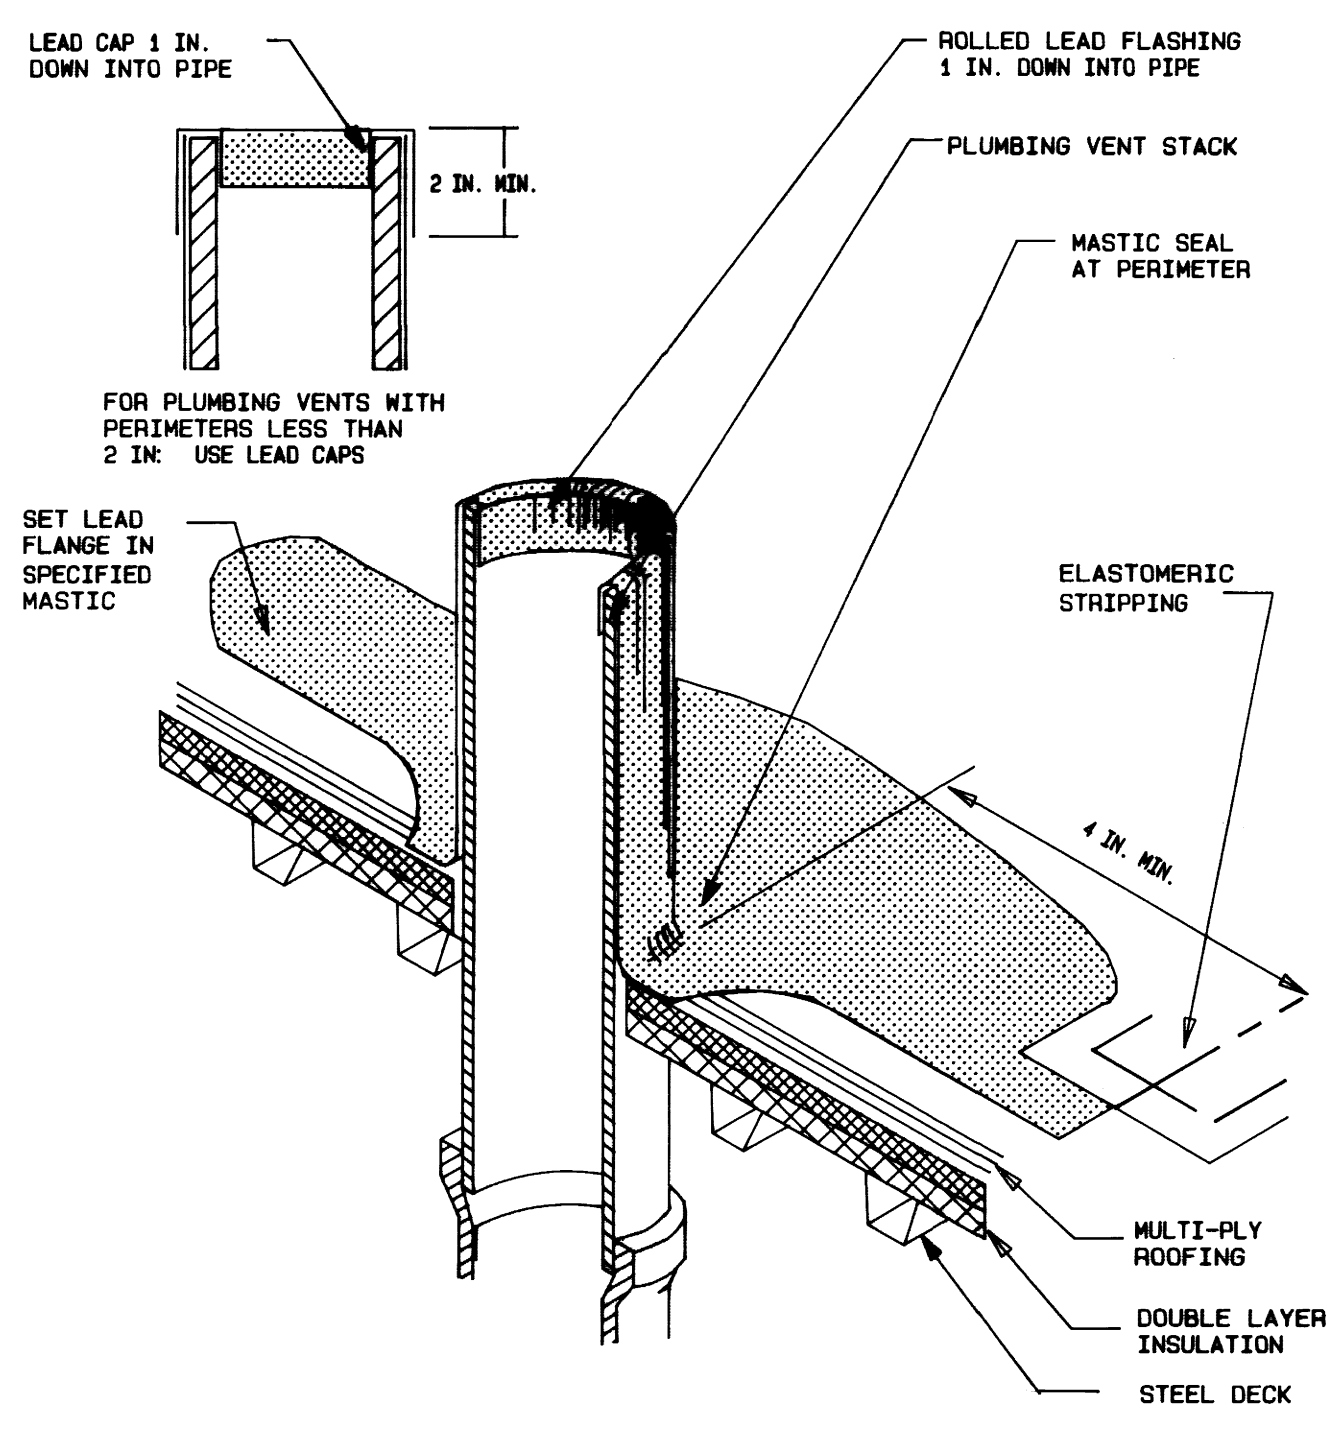


ROOF DETAIL PLUMBING VENT STACK
SCALE: 1 1/2" = 1'-0"

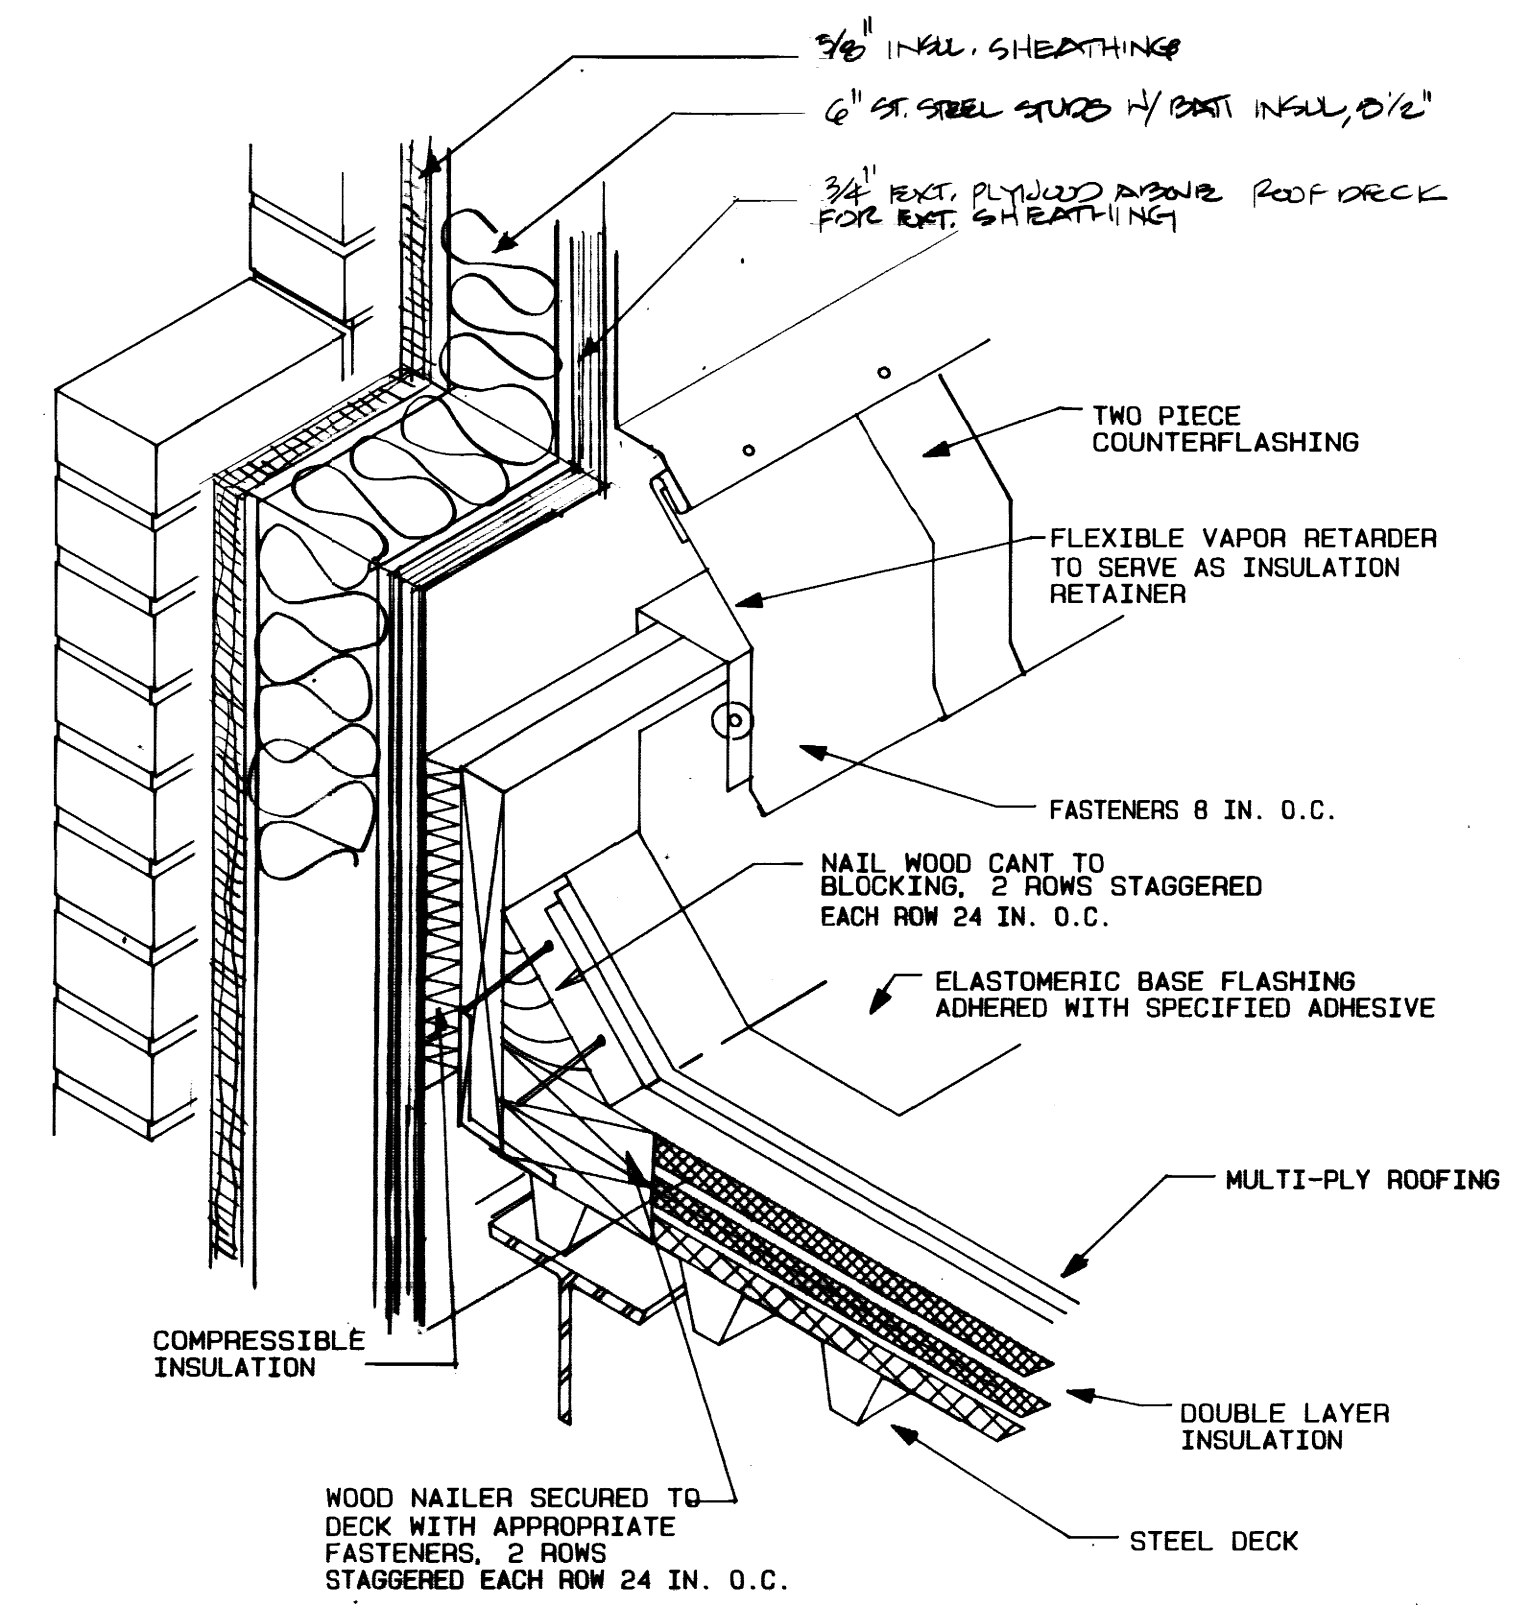


ROOF DETAIL NEW ADDITION PARAPET WALL
SCALE: 1 1/2" = 1'-0"

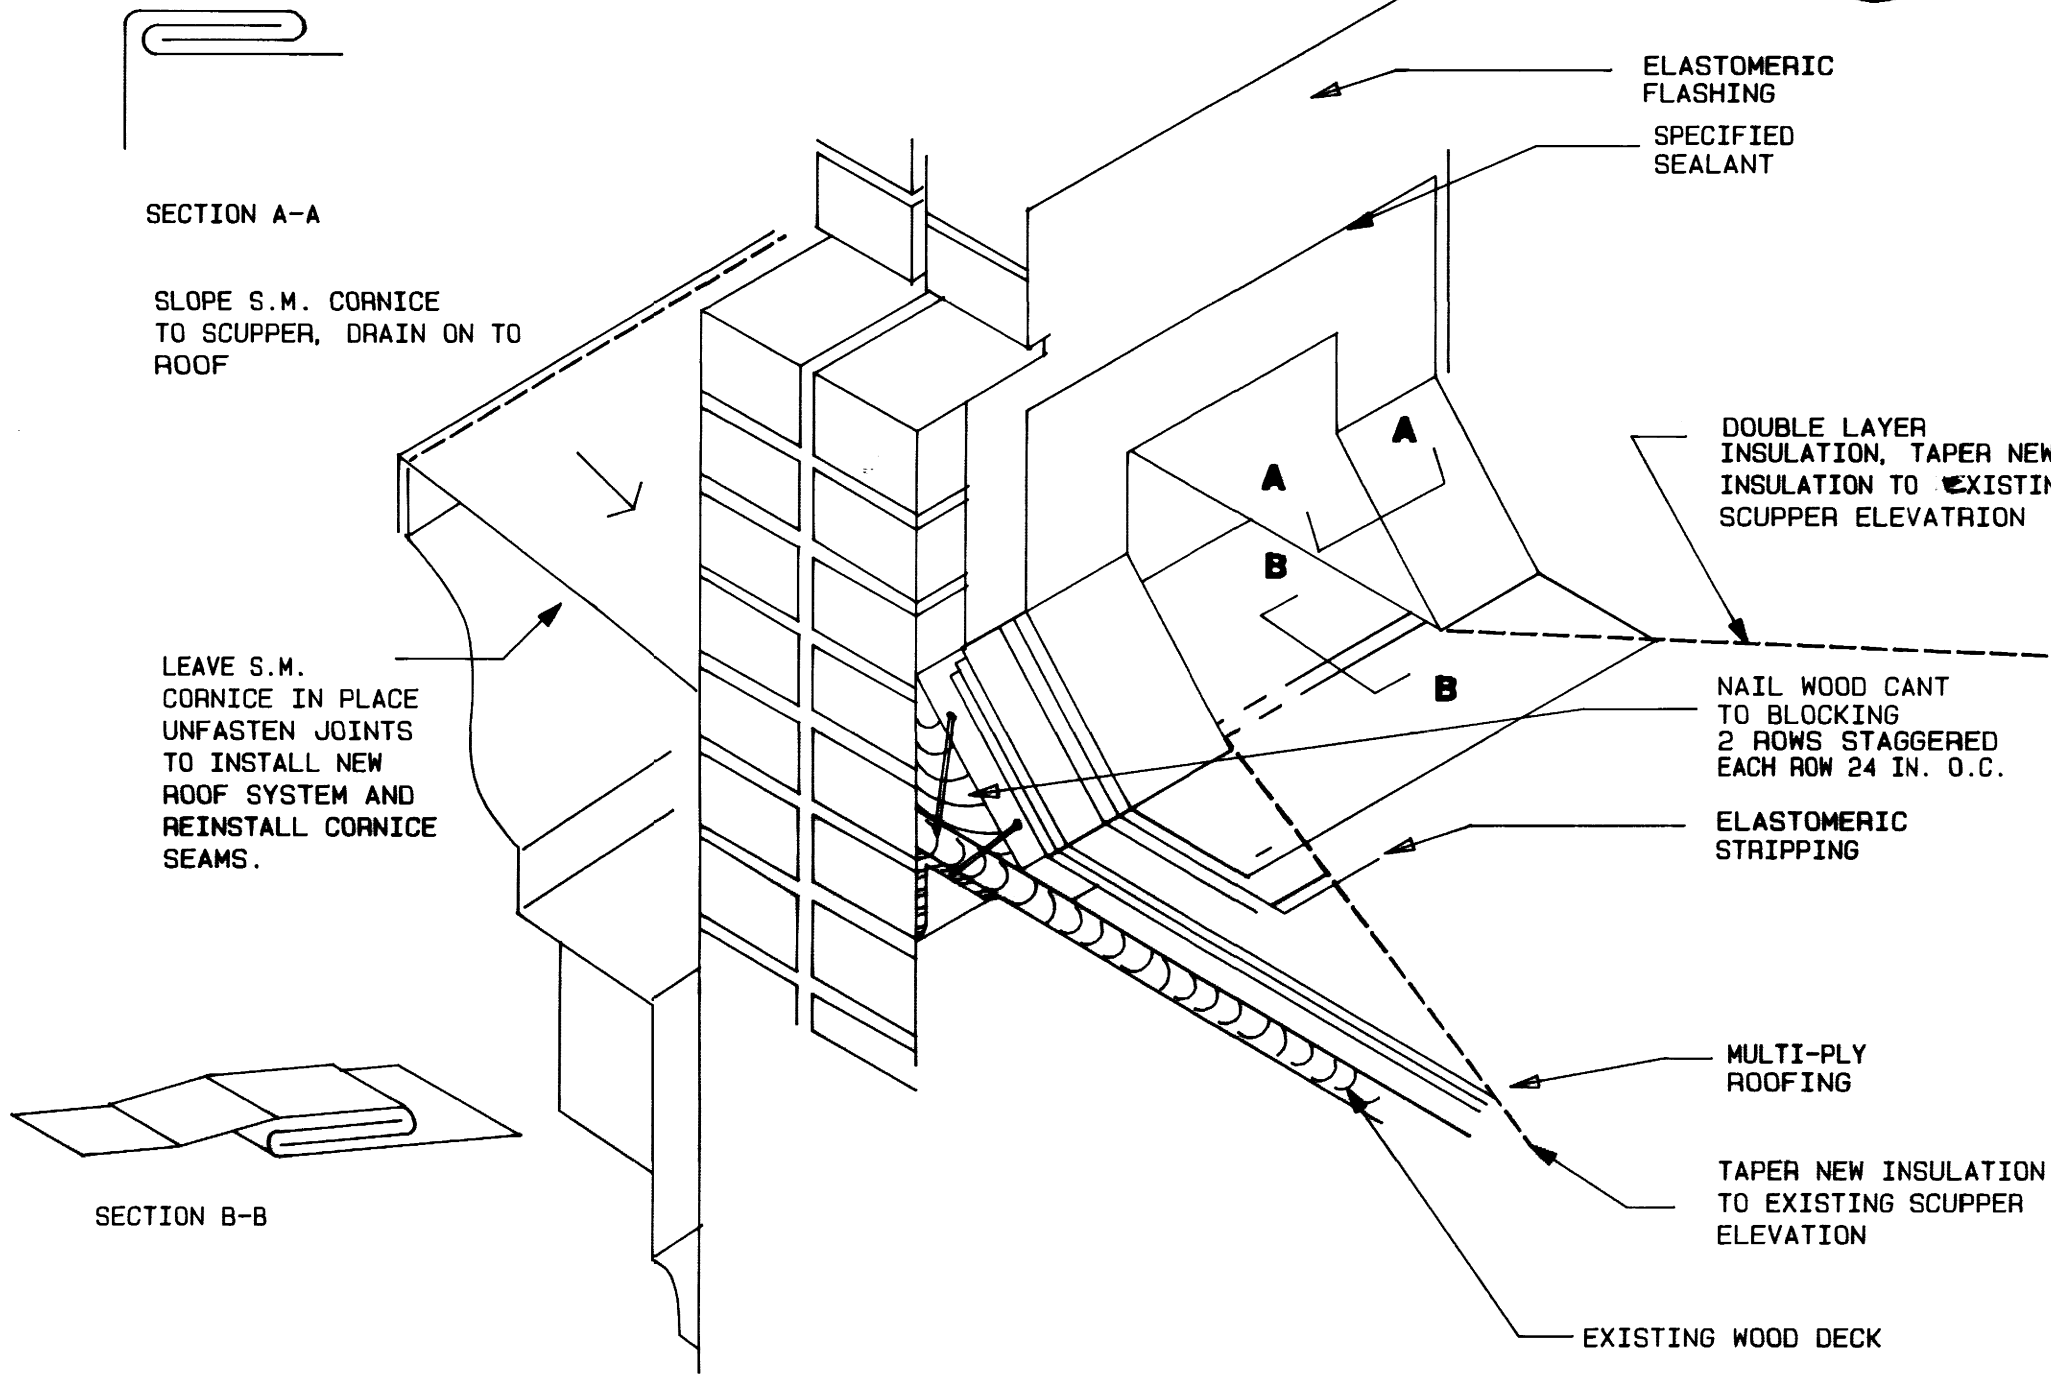


ROOF DETAIL EXISTING SCUPPER DETAIL 1911
SCALE: 1 1/2" = 1'-0"

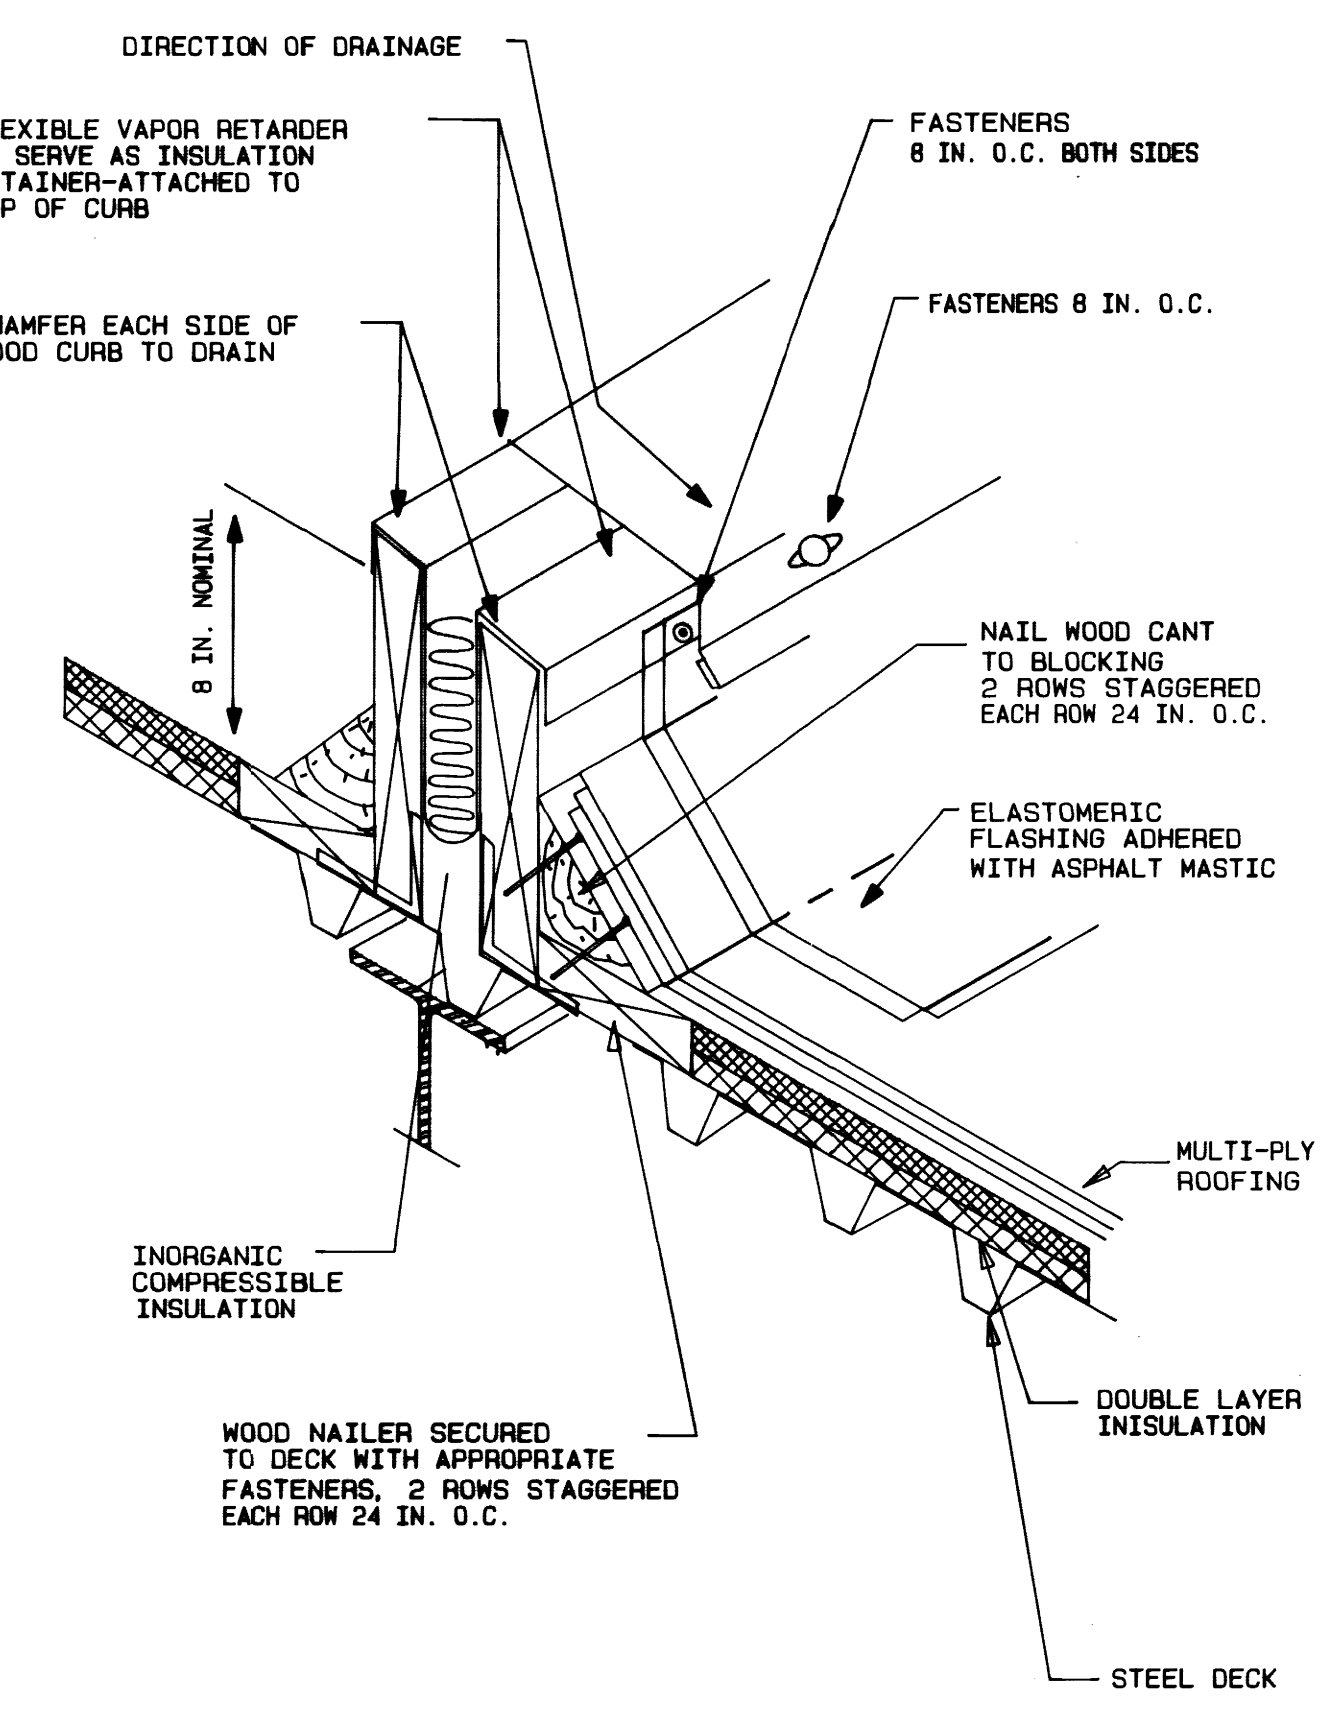


ROOF DETAIL EXPANSION JOINT DETAIL 1911
SCALE: 1 1/2" = 1'-0"

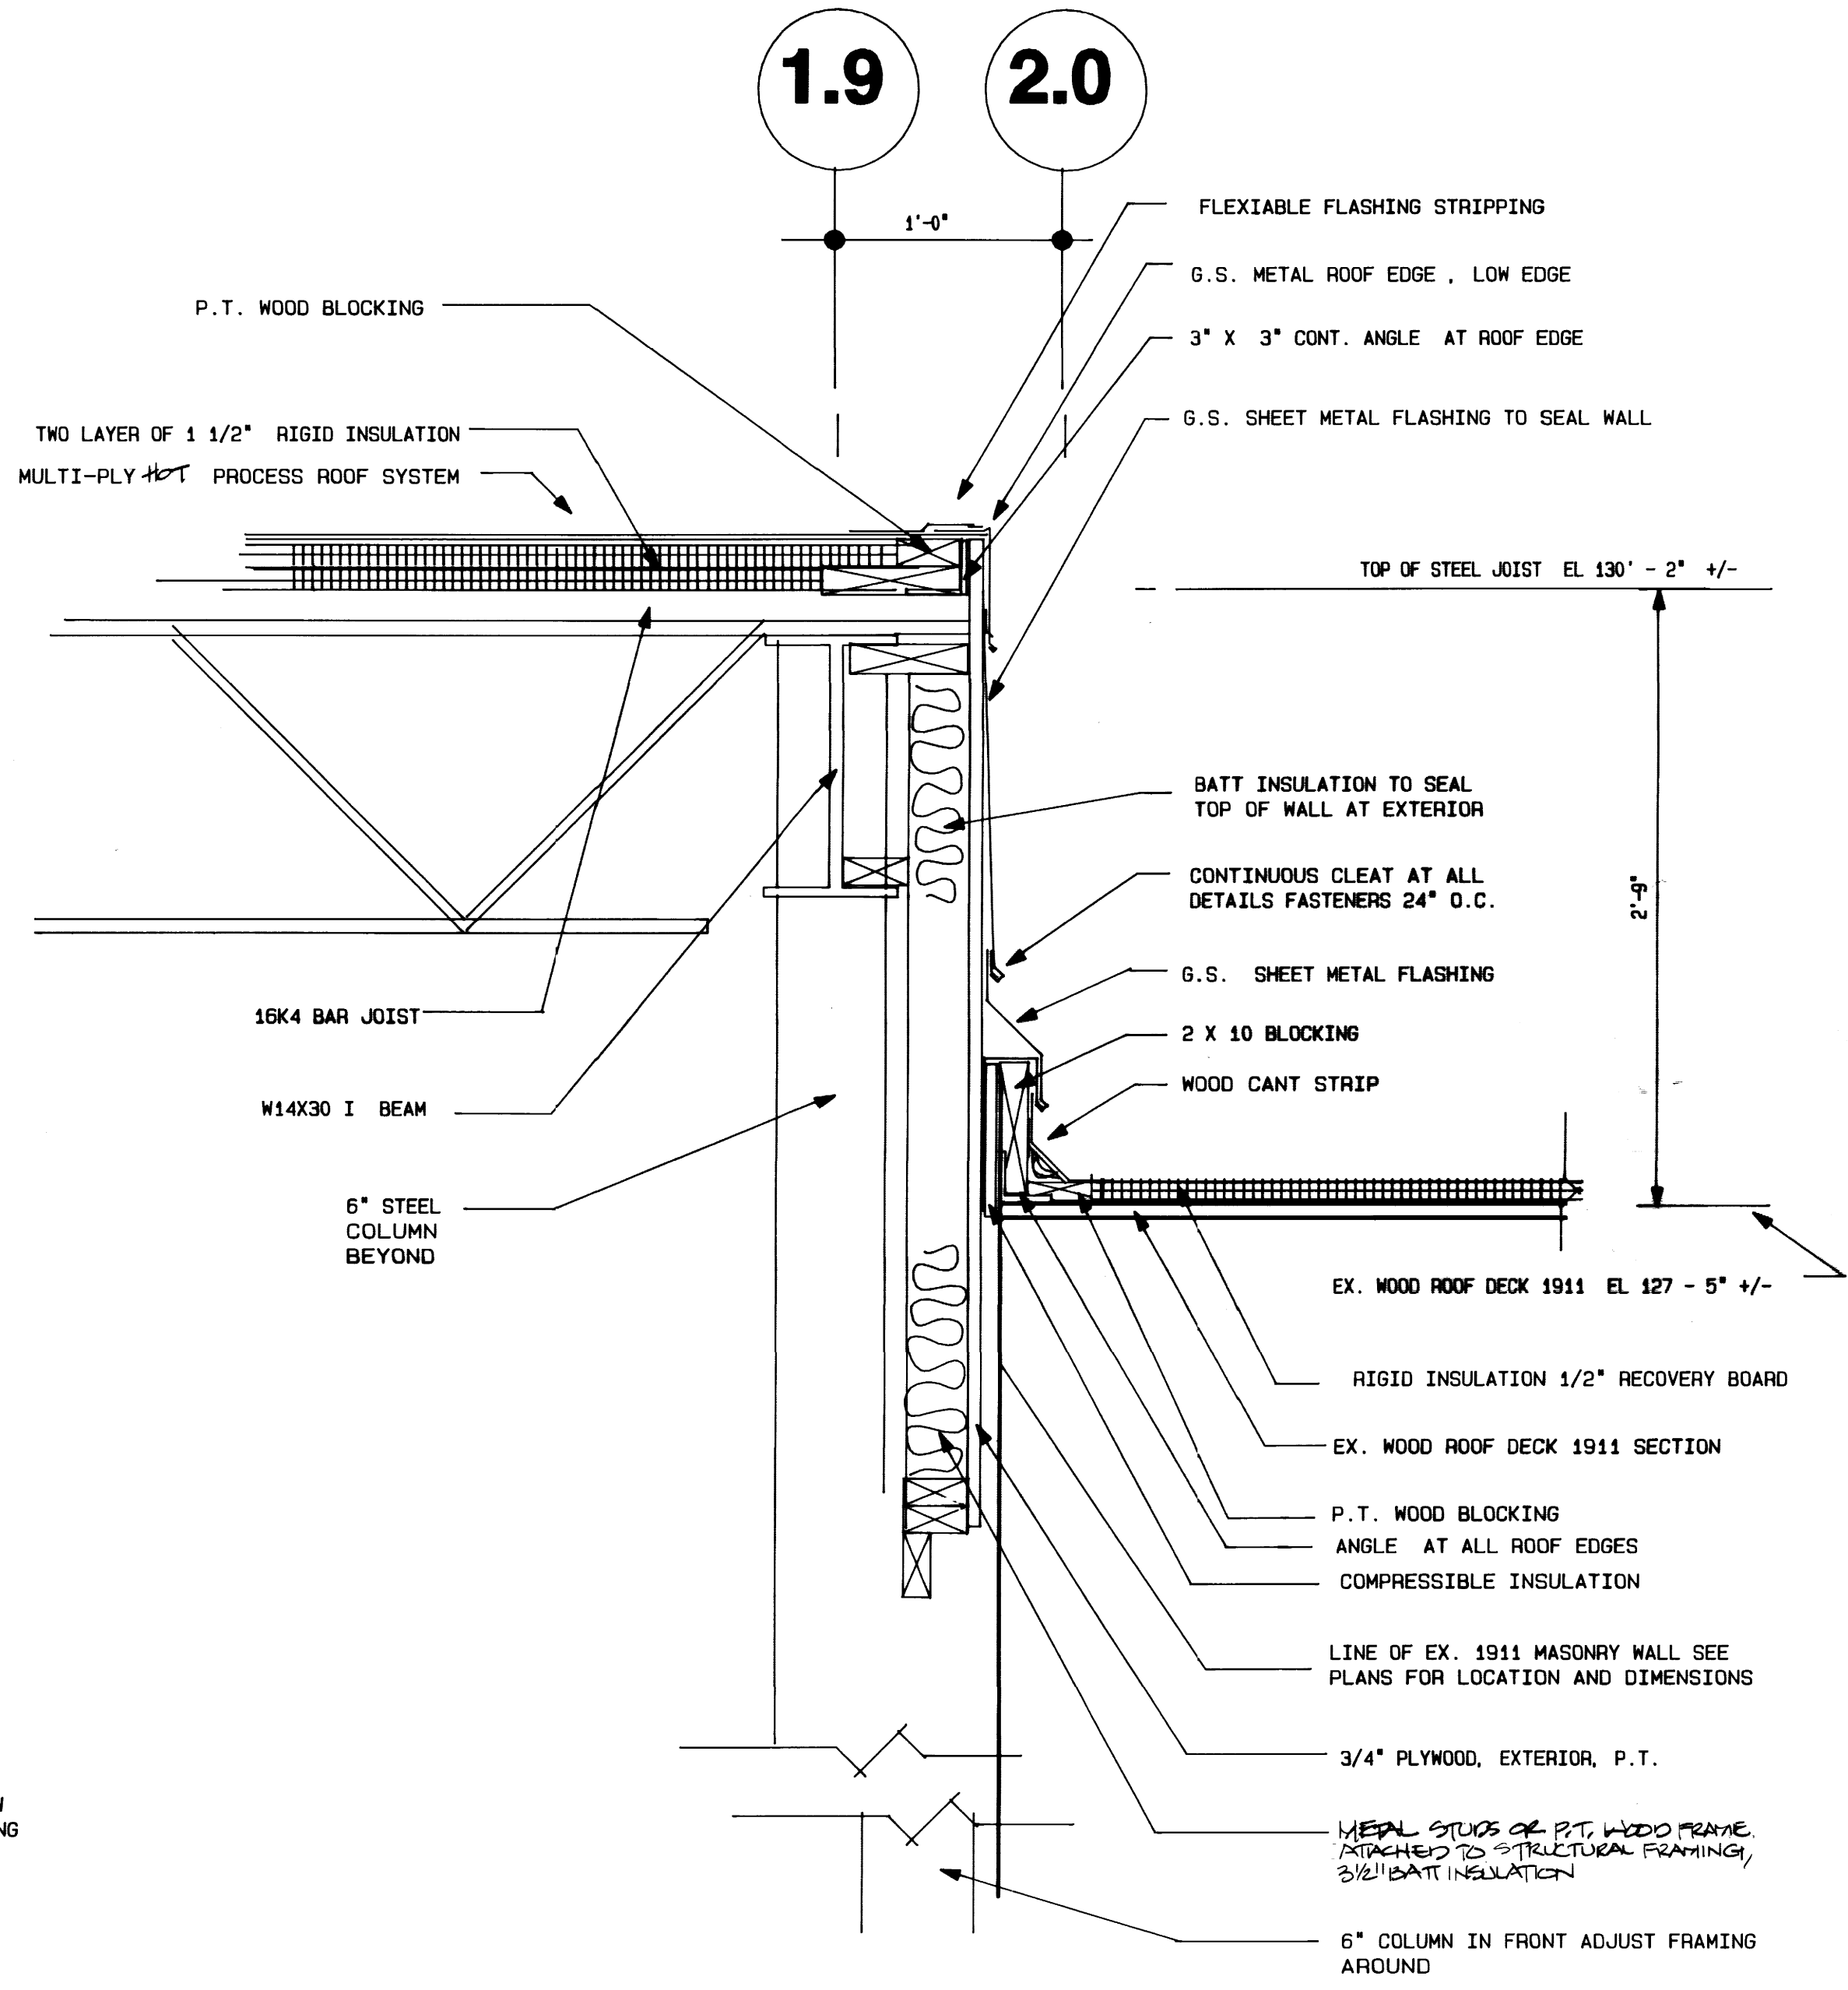

ROOF DETAIL NEAR COLUMN LINE E-1.9
SCALE: 1 1/2" = 1'-0"

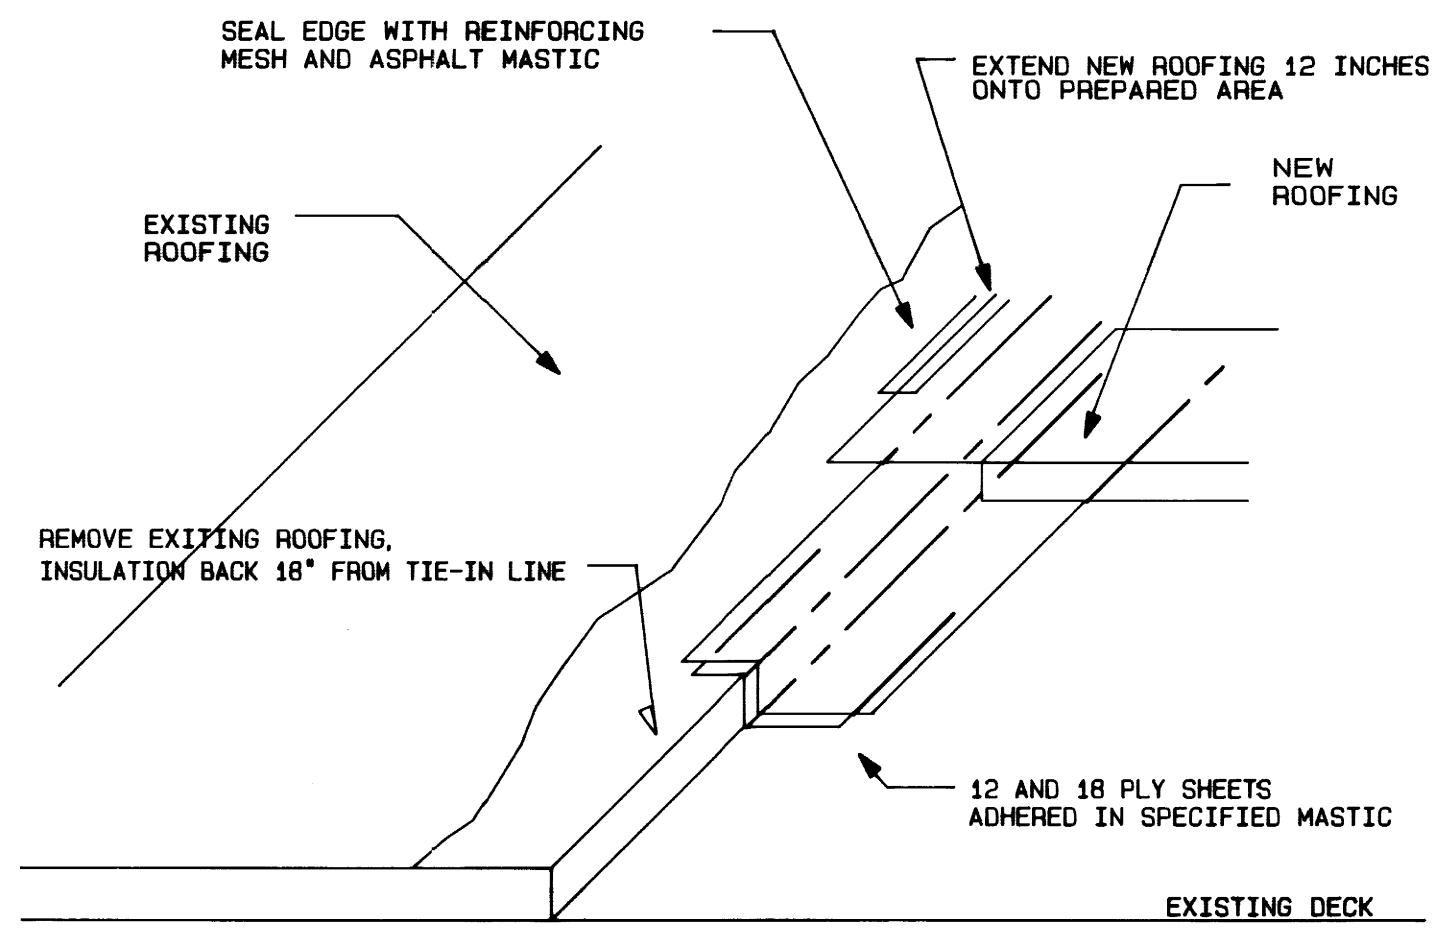

ROOF DETAIL PERMANENT TIE-IN NEW 1911 ROOF TO 1936 ROOF
SCALE: 1 1/2" = 1'-0"

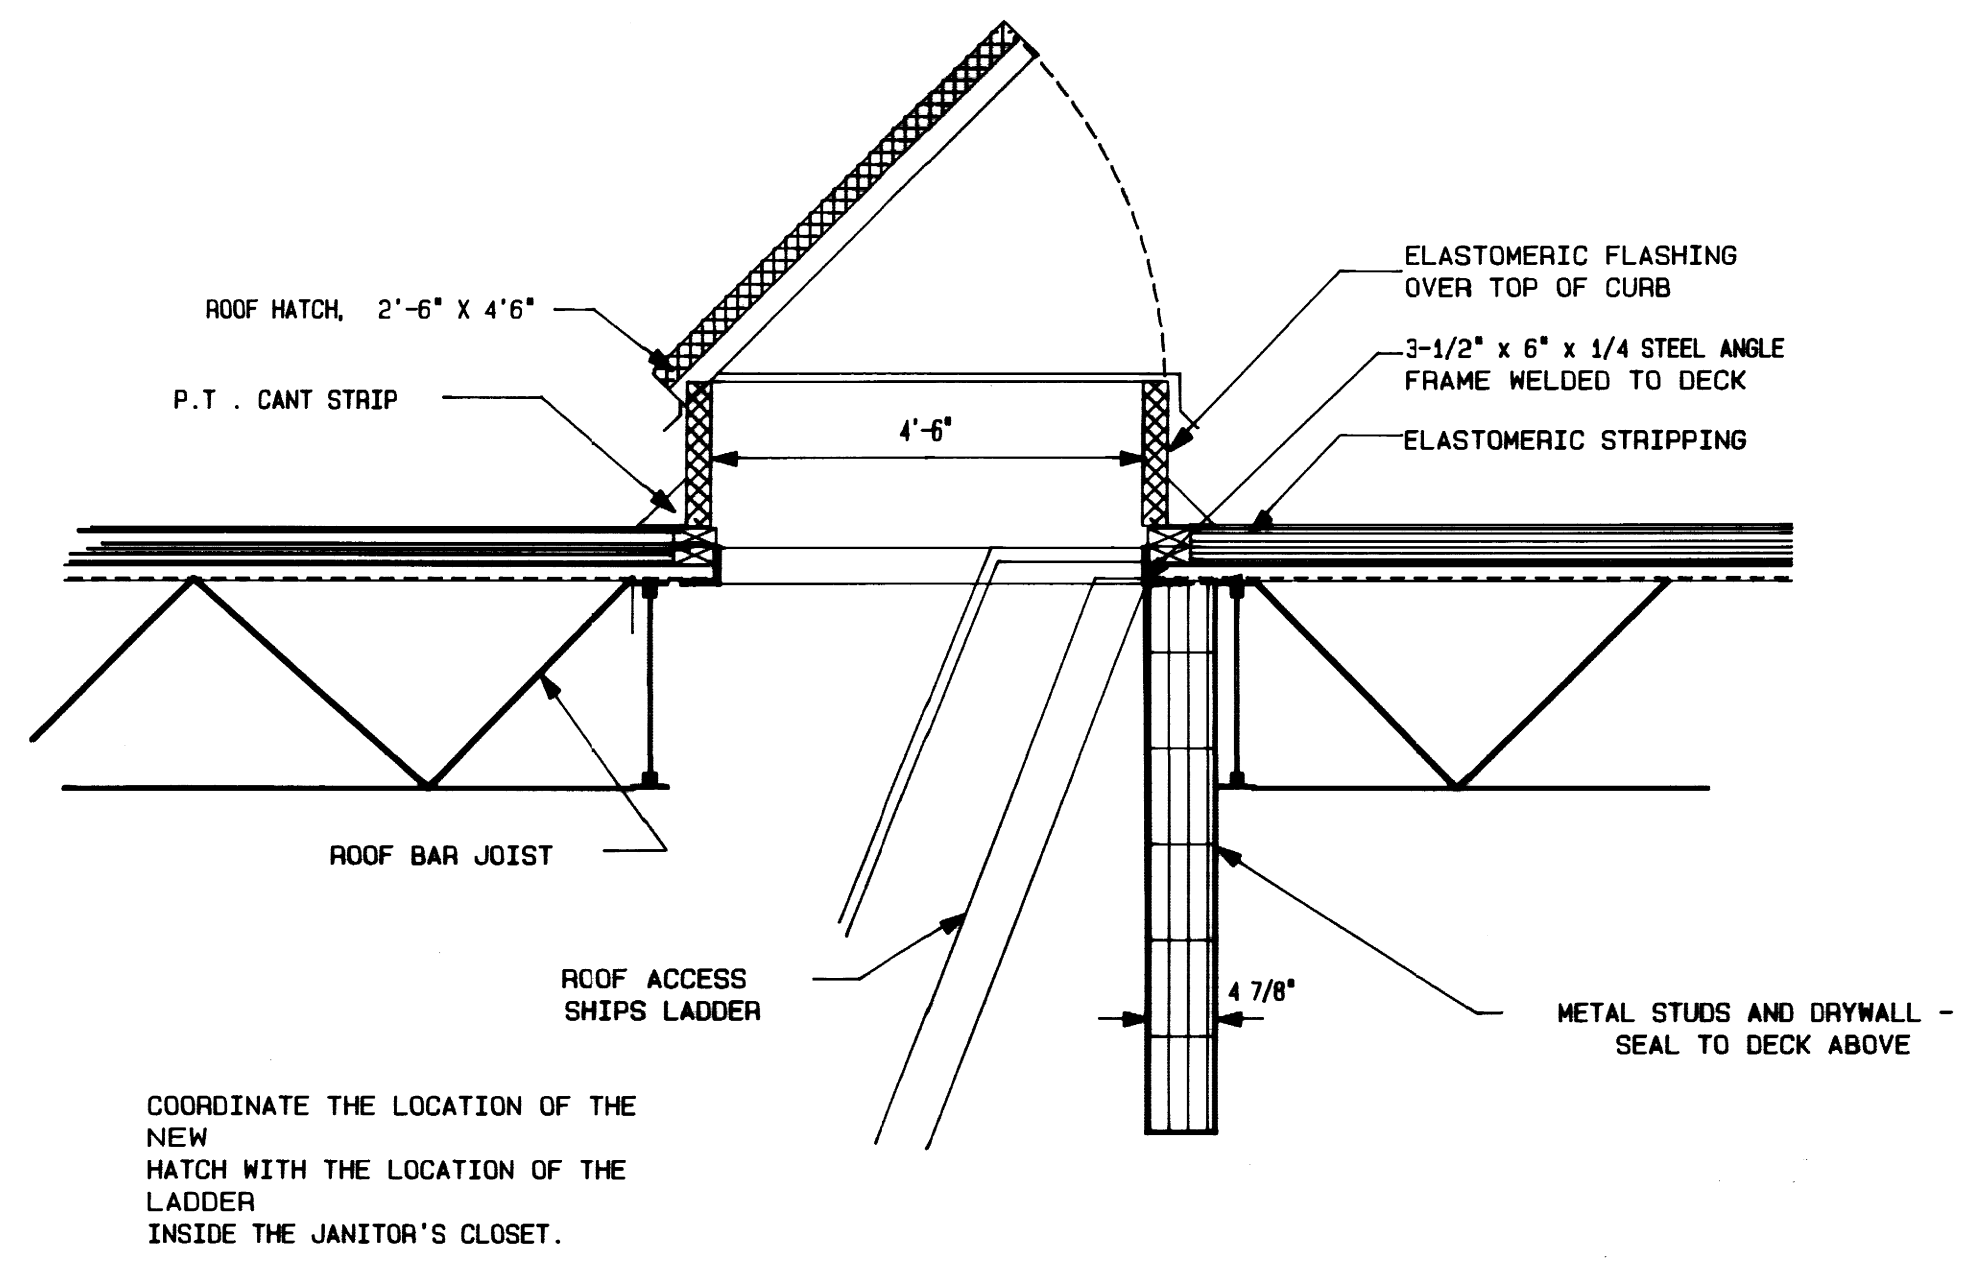

ROOF DETAIL ROOF HATCH, NEW ADDITION
SCALE: 1 1/2" = 1'-0"

UK
SCOTT

UNIVERSITY OF KENTUCKY
SCOVELL HALL RENOVATION

Roof Details
002120
A-11.1

AS-BUILT AUG. 10, 1995

Architect: W. Jacobs
Engineer: Michael W. Jacobs
Inspector: Michael W. Jacobs


Omni Architects

University of Kentucky
Department of Architecture
100 North Limestone Street
Lexington, Kentucky 40506-0020

Job No: 9385 Date: 4/9/1994 Drawn By: GF Checked: GF Revisions: 7/4/94

Official and Document
University of Kentucky
Lexington, Kentucky


Sheet: 38 of 38
Date: 002120

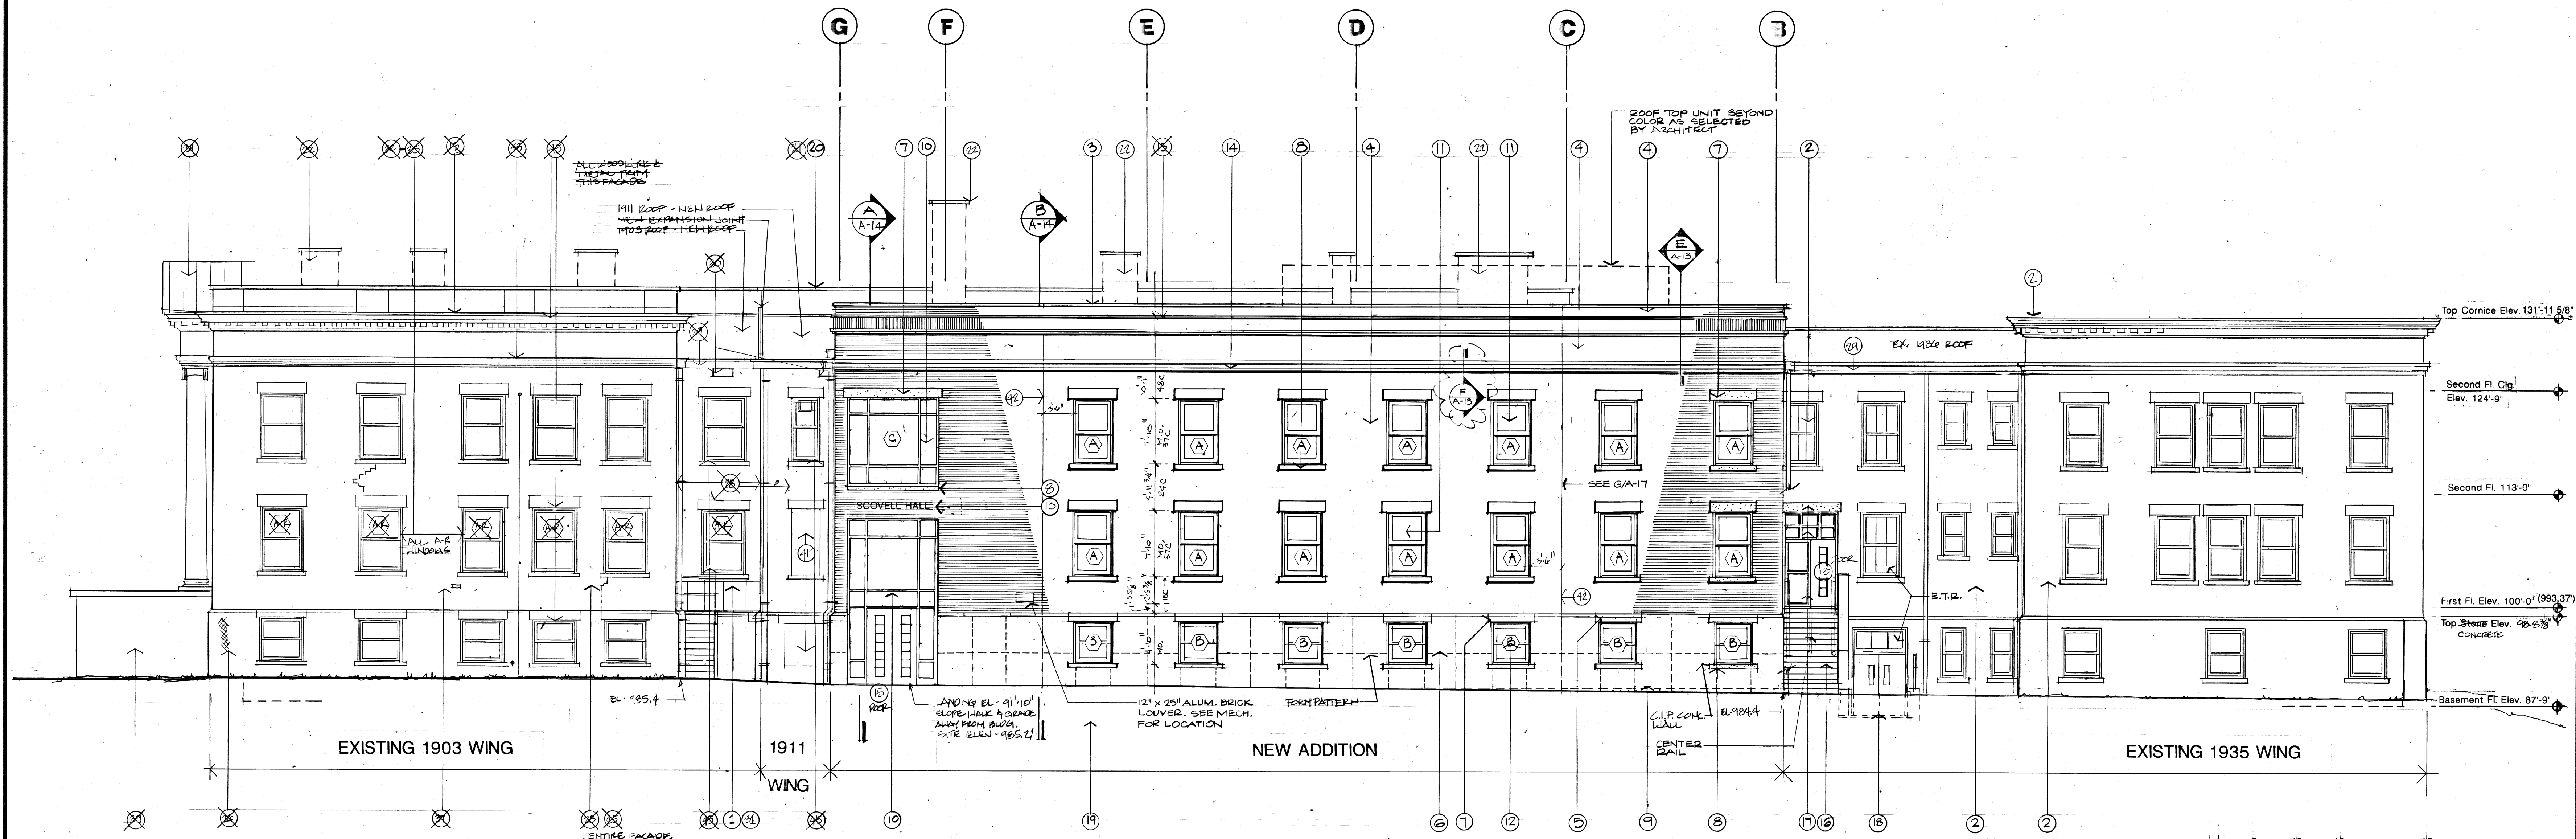

SOUTH ELEVATION


SCALE 1/8" = 1'-0"

REFER TO SHEET A-10 FOR KEY NOTES

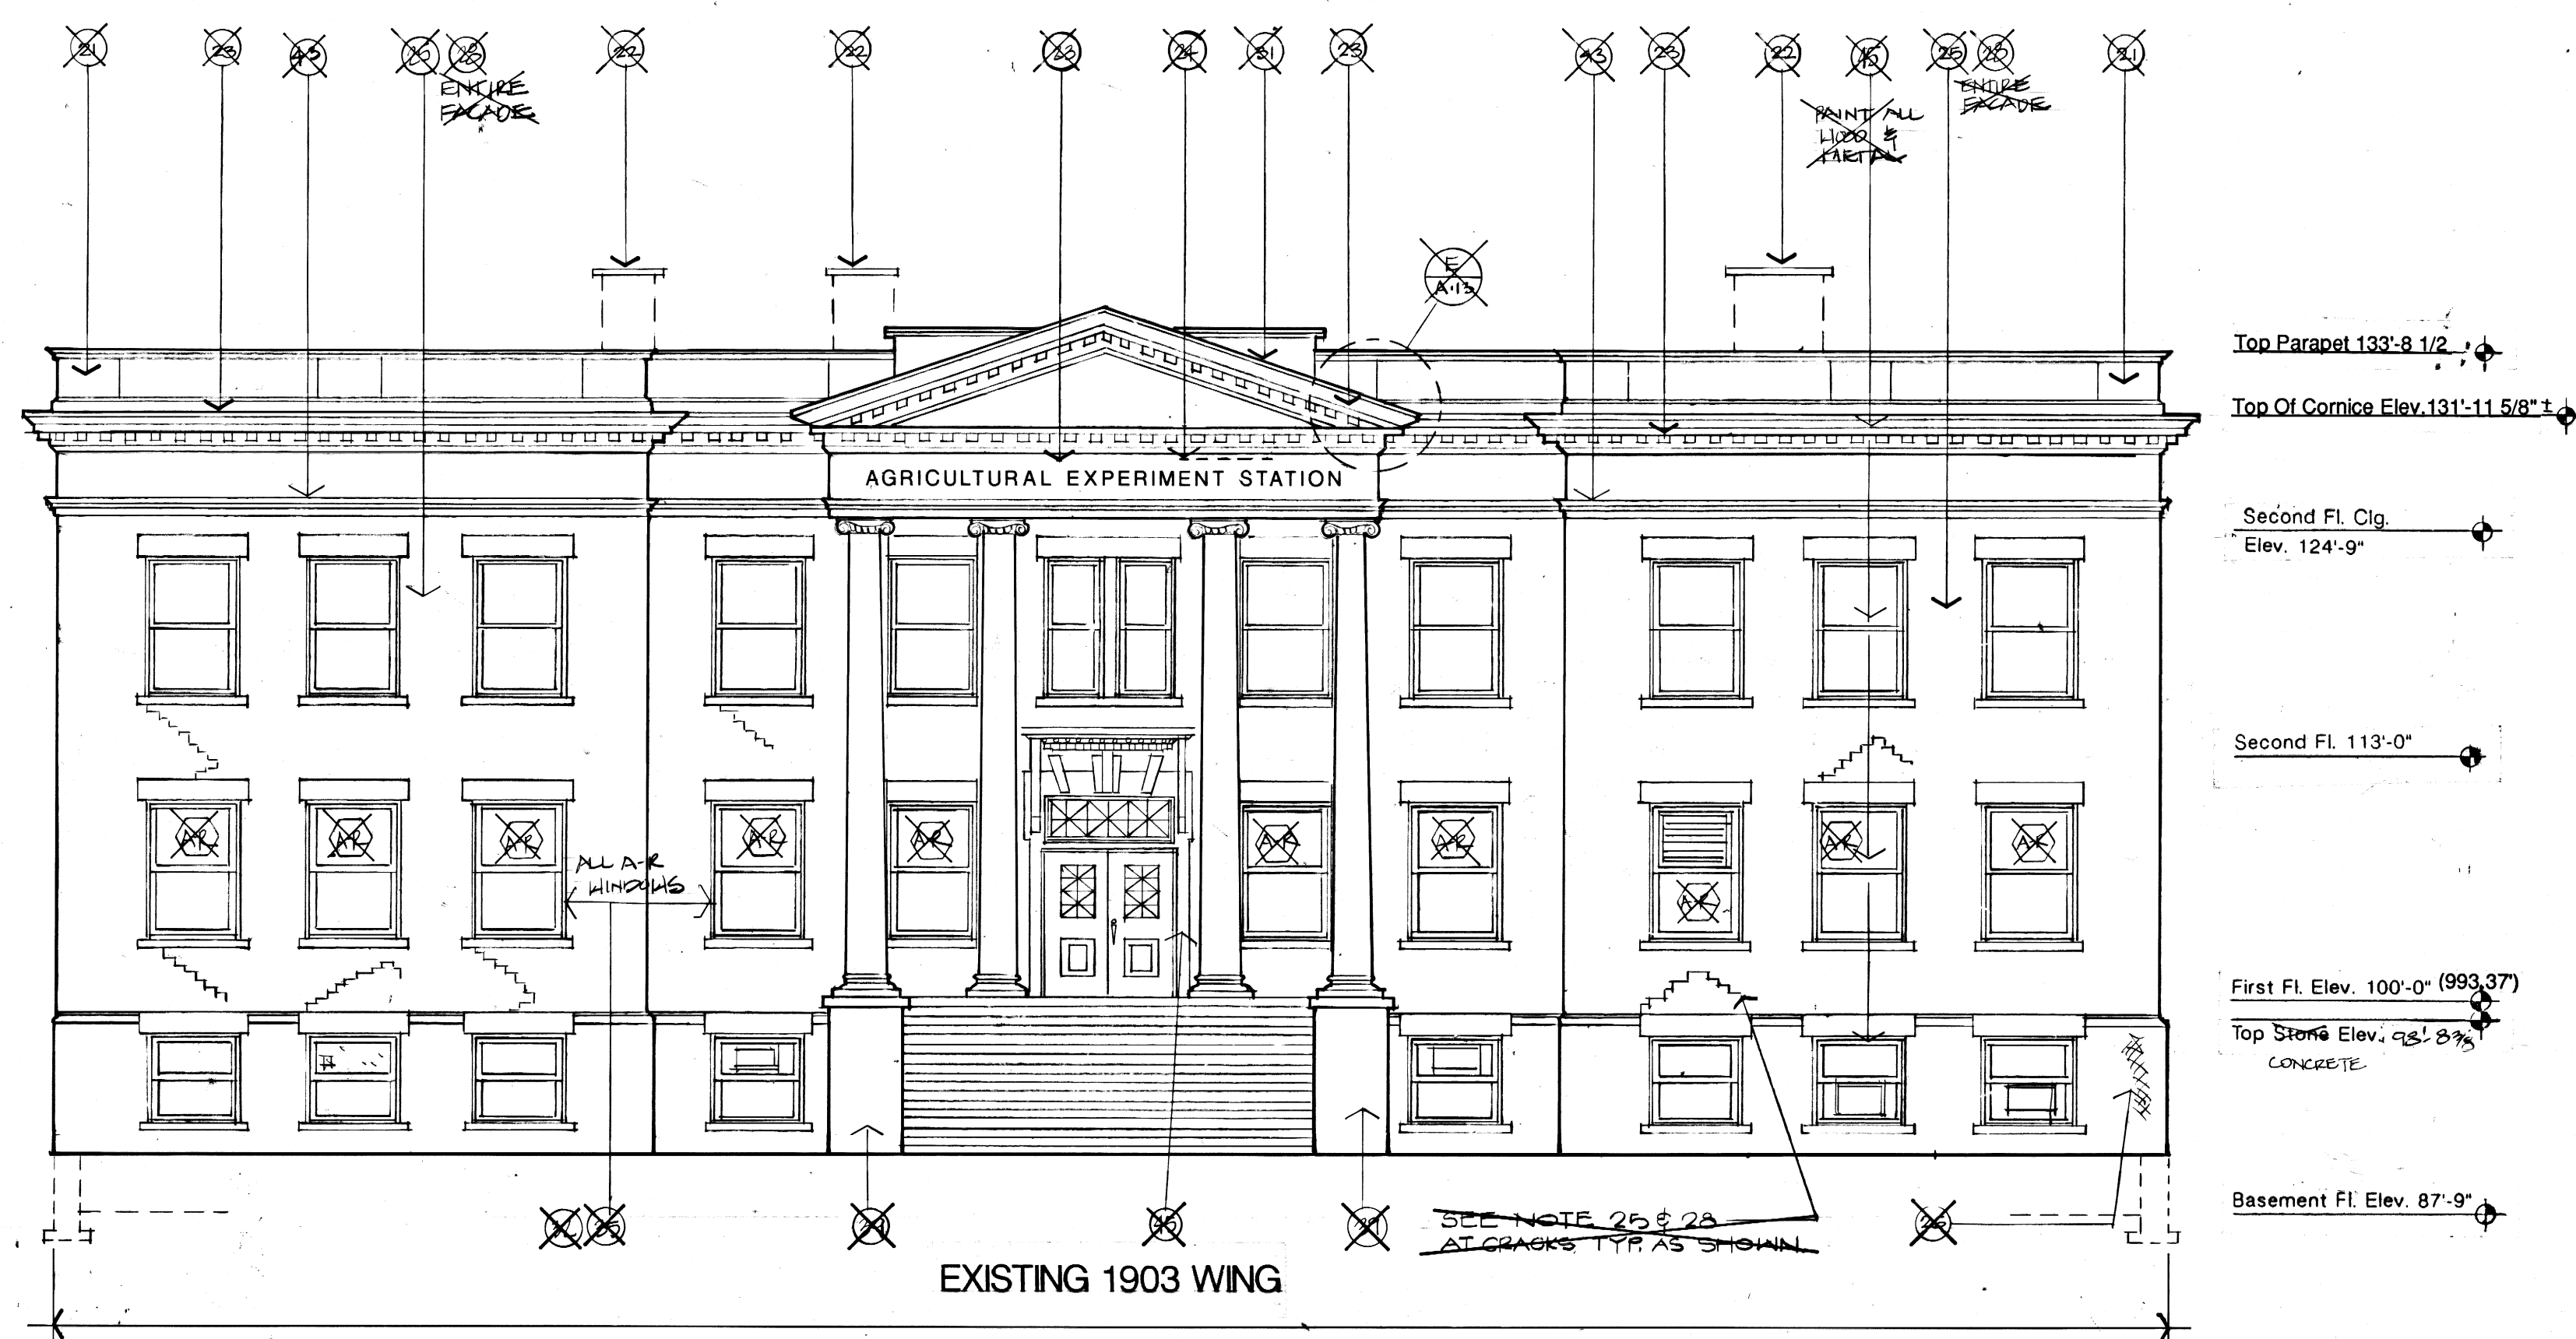

WEST ELEVATION

SCALE 1/8" = 1'-0"

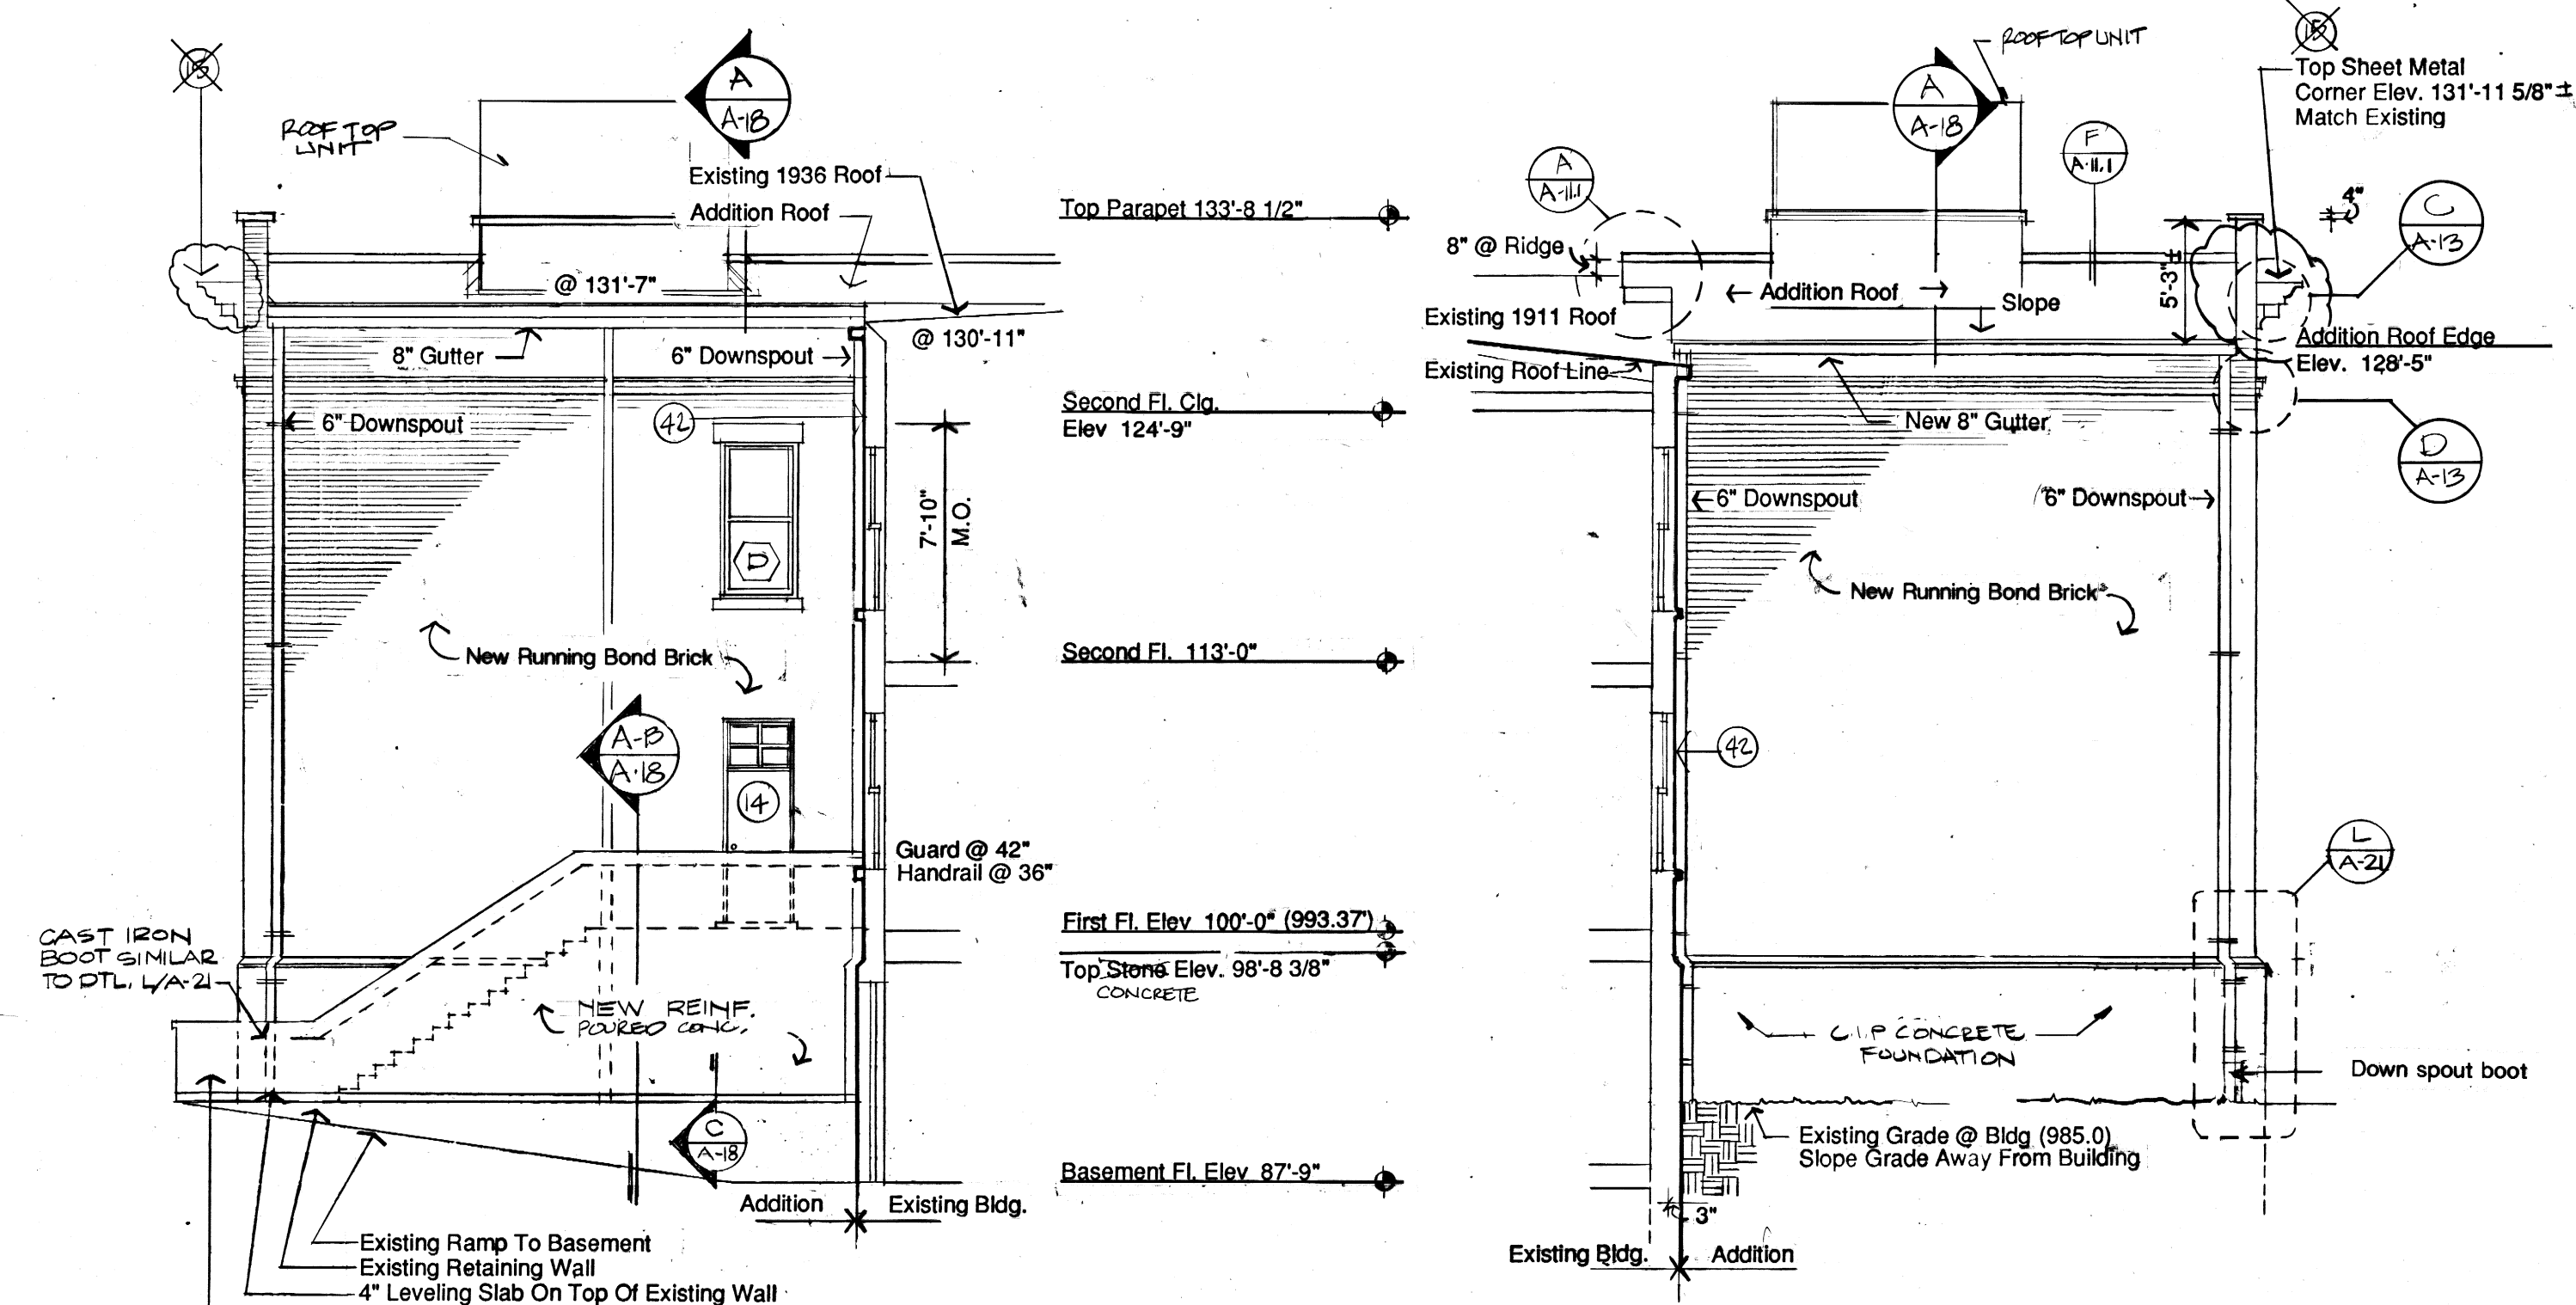

EAST ELEVATION

SCALE 1/8" = 1'-0"

WEST ELEVATION

SCALE 1/8" = 1'-0"

SCOVELL HALL RENOVATION

UNIVERSITY OF KENTUCKY

This Drawing and Design shall remain the property of Omni Architects, Inc. and shall not be reproduced, copied, or used in any way without the written consent of Omni Architects, Inc.

Revisions: JULY 21, 1994

Checked: HLL

Drawn: B.Y.G.

Date: 4/11

Job No: 414-C

Omni Architects

University of Kentucky
Design and Construction
Division

002121
A-12
38
A-3
002121

002121
A-12
38
A-3
002121

002121
A-12
38
A-3
002121


Renovation Tag Notes Exterior Elevations

- 1 Remove and replace sheet metal roof with new standing seam roofing. Use existing open mortar joints for flashing. Embed flashing and seal joints.
- 2 Existing 1935 wing new work in this area except for the trim of the new addition from foundation to roof. Protect the existing building elements during construction. All exists must be maintained and protected from overhead with enclosed structures.
- 3 New cut lime stone coping to match existing. Set in partial bed of mortar and seal top and side joints.
- 4 Running bond face brick. Color to match existing. Mortar color to match existing. Provide thru-wall flashing, waterproofing and weeps.
- 5 Re-use existing cut limestone water table. Clean and polish to provide like new appearance.
- 6 Clean and re-use existing cut ashlar stone and rubble stone foundation wall.
- 7 New cut limestone lintel.
- 8 New cut limestone window sill.
- 9 Grade elevations see site plan for accurate spot elevations. Existing grades not disturbed shall be graded into new grades to slope away from the building and new addition.
- 10 New alum. curtain wall for entry doors, transom and window D. System to be self-supporting and anchor securely at the jambs. System must be detailed to withstand the wind load and other building code requirements.
- 11 New aluminum windows with frames which approximate the dimensions of the existing windows. Top sash is fixed, glazing is insulated. Provide window blinds for all new windows in the addition. Color white.
- 12 New aluminum windows with fixed top sash as noted in 11.
- 13 Building name sign: 12" helvetic cast aluminum letters with white Kynar finish.
- 14 Corbel brick detail, to match existing. Provide concrete wash to slope top for drainage.
- 15 Sheet Metal Corbel: reinstall ex. sheet metal corbel on p.t. wood blocking as originally designed. Care must be taken and the work performed by skilled mechanics.
- 16 New concrete entry stairs and guard wall. Provide metal hand rails on both sides and down the center.
- 17 New entry doors, frames and opening out into 1936 section. Provide lintel and all accessories required to complete installation of new entry.
- 18 Existing loading ramp to remain. New stair guard wall is to set on top of existing ramp retaining wall.
- 19 Line of existing basement below grade.
- 20 Repair existing brick parapet to be limited to repairs to s.m. cornice and installation of new roofing system. Carefully remove base flashings from counter flashings to allow for new roof system to be installed. Leave counter flashing in place and seal all mortar joints. Reenter-counter flashing required to complete flashing of new roof to existing cornice and scuppers.
- 21 Remove all masonry chimneys to just above the ceiling framing on the second floor. One chimney is removed down through the building to become a communications shaft. The remaining chimneys are removed down through the building to become a communications shaft. The remaining chimneys are removed down through the building to become a communications shaft.
- 22 Sheet metal cornice repairs to include patching of all damaged areas, replacing sheet metal flashing and roof drainage details. Cornice to drain onto roof. Use the salvaged cornice to cut patches for existing cornice. Cornice small holes can be patched with plastic bonding compounds. Repair any cornice leaks above where cornice is damaged.
- 23 Remove and replace damaged wood ceiling area, 8' x 8' area, with matching box-car siding, beaded board. Stain to match existing. Renail loose boards and trim over ceiling area.
- 24 Area of existing masonry to be replaced: Areas to be repaired include the 1935 west, south, east facades, 1911 east, south facades adjacent to the addition and portions of the 1911-1935 north facade. After masonry is cleaned, clean out damaged mortar to 1" depth and tuckpoint with soft mortar matching the existing in strength and color. Where cracks are shown on the drawings, remove brick on either side and tuck back to blend the crack over the replaced brick.
- 25 Repairs to stone foundation: Clean out damaged mortar to 1" depth and tuckpoint with soft mortar matching the existing including the raised joint profile.
- 26 Remove existing roof to wood decking. Replace damaged decking with matching wood. Install new rigid insulation and built-up roofing system. Roof drainage is to be revised to work with new addition. Verify all elevations of gutters and roof edges.
- 27 Clean masonry with mild chemical and water wash with medium pressure power wash. Additional efforts will be needed to clean rust and other stains from the masonry.
- 28 Remove existing gutter and sheet metal at roof edge. Repair damaged sheathing and install new gutter to match existing on the 1935 section, 8" rectangular shape. Connect downspouts to site drainage system.
- 29 Remove attic vents and install masonry in-fill to close opening.
- 30 Remove existing sheet metal roofing and replace with new standing seam sheet metal over front portico and basement entry 1935 section.
- 31 Repairs to existing windows: fix upper sash and repair to good working order the lower sash. If pointed glass work open, if lower sash is loose then reinforce it with glued wood dowels or other approved wood sash repair, remove loose glazing compound but leave glass in place. Windows will not be replaced but the glass sealed to the wood sash with sealant to glaze the existing sash for painting.
- 32 Remove existing wood window down to masonry opening. Install new aluminum window to match new addition windows.
- 33 Remove steps to basement.
- 34 Existing wood windows: Remove existing wood sashes and save for the corner. Fix the top sash of all existing window. Repair as indicated in 32.
- 35 Install new 1" hour rated drywall partition to seal the attic of the 1911 section and 1936 section.
- 36 Remove metal and wire hardware attachments from all facades of the 1935 and 1911 section.
- 37 Removed damage plaster-bank to sound plaster. Patch and repair the plaster ceiling to match original.
- 38 Clean stone masonry at steps 1935 and 1911 entrances.
- 39 Add alternate: Repair 1911 sheet metal cornice over entry. Repair damaged area with patches salvaged from existing cornice. Replace sheet metal on top with new metal and flashing into existing raked mortar joints. Install as original. Pricing to include painting of cornice and wood surrounds for the entry.
- 40 Fill in masonry opening where windows or doors removed.
- 41 Expansion joint through the wall in noted locations.
- 42 Existing brick corbel: remove flashing and mortar on top and install new grand mortar wash to slope water away from building and mortar joints.
- 43 Painting of exterior wood windows and trim. Removed loose paint on all windows and exterior wood or metal trim. Do not damage wood. Carefully scrape loose paint down to laminated paint. Paint with special primer and wood or metal primer and finish paint. Paint only the repaired windows, and repaired sections of the cornice. Paint white to match existing.




NORTH ELEVATION

SCALE: 1/8" = 1'-0"

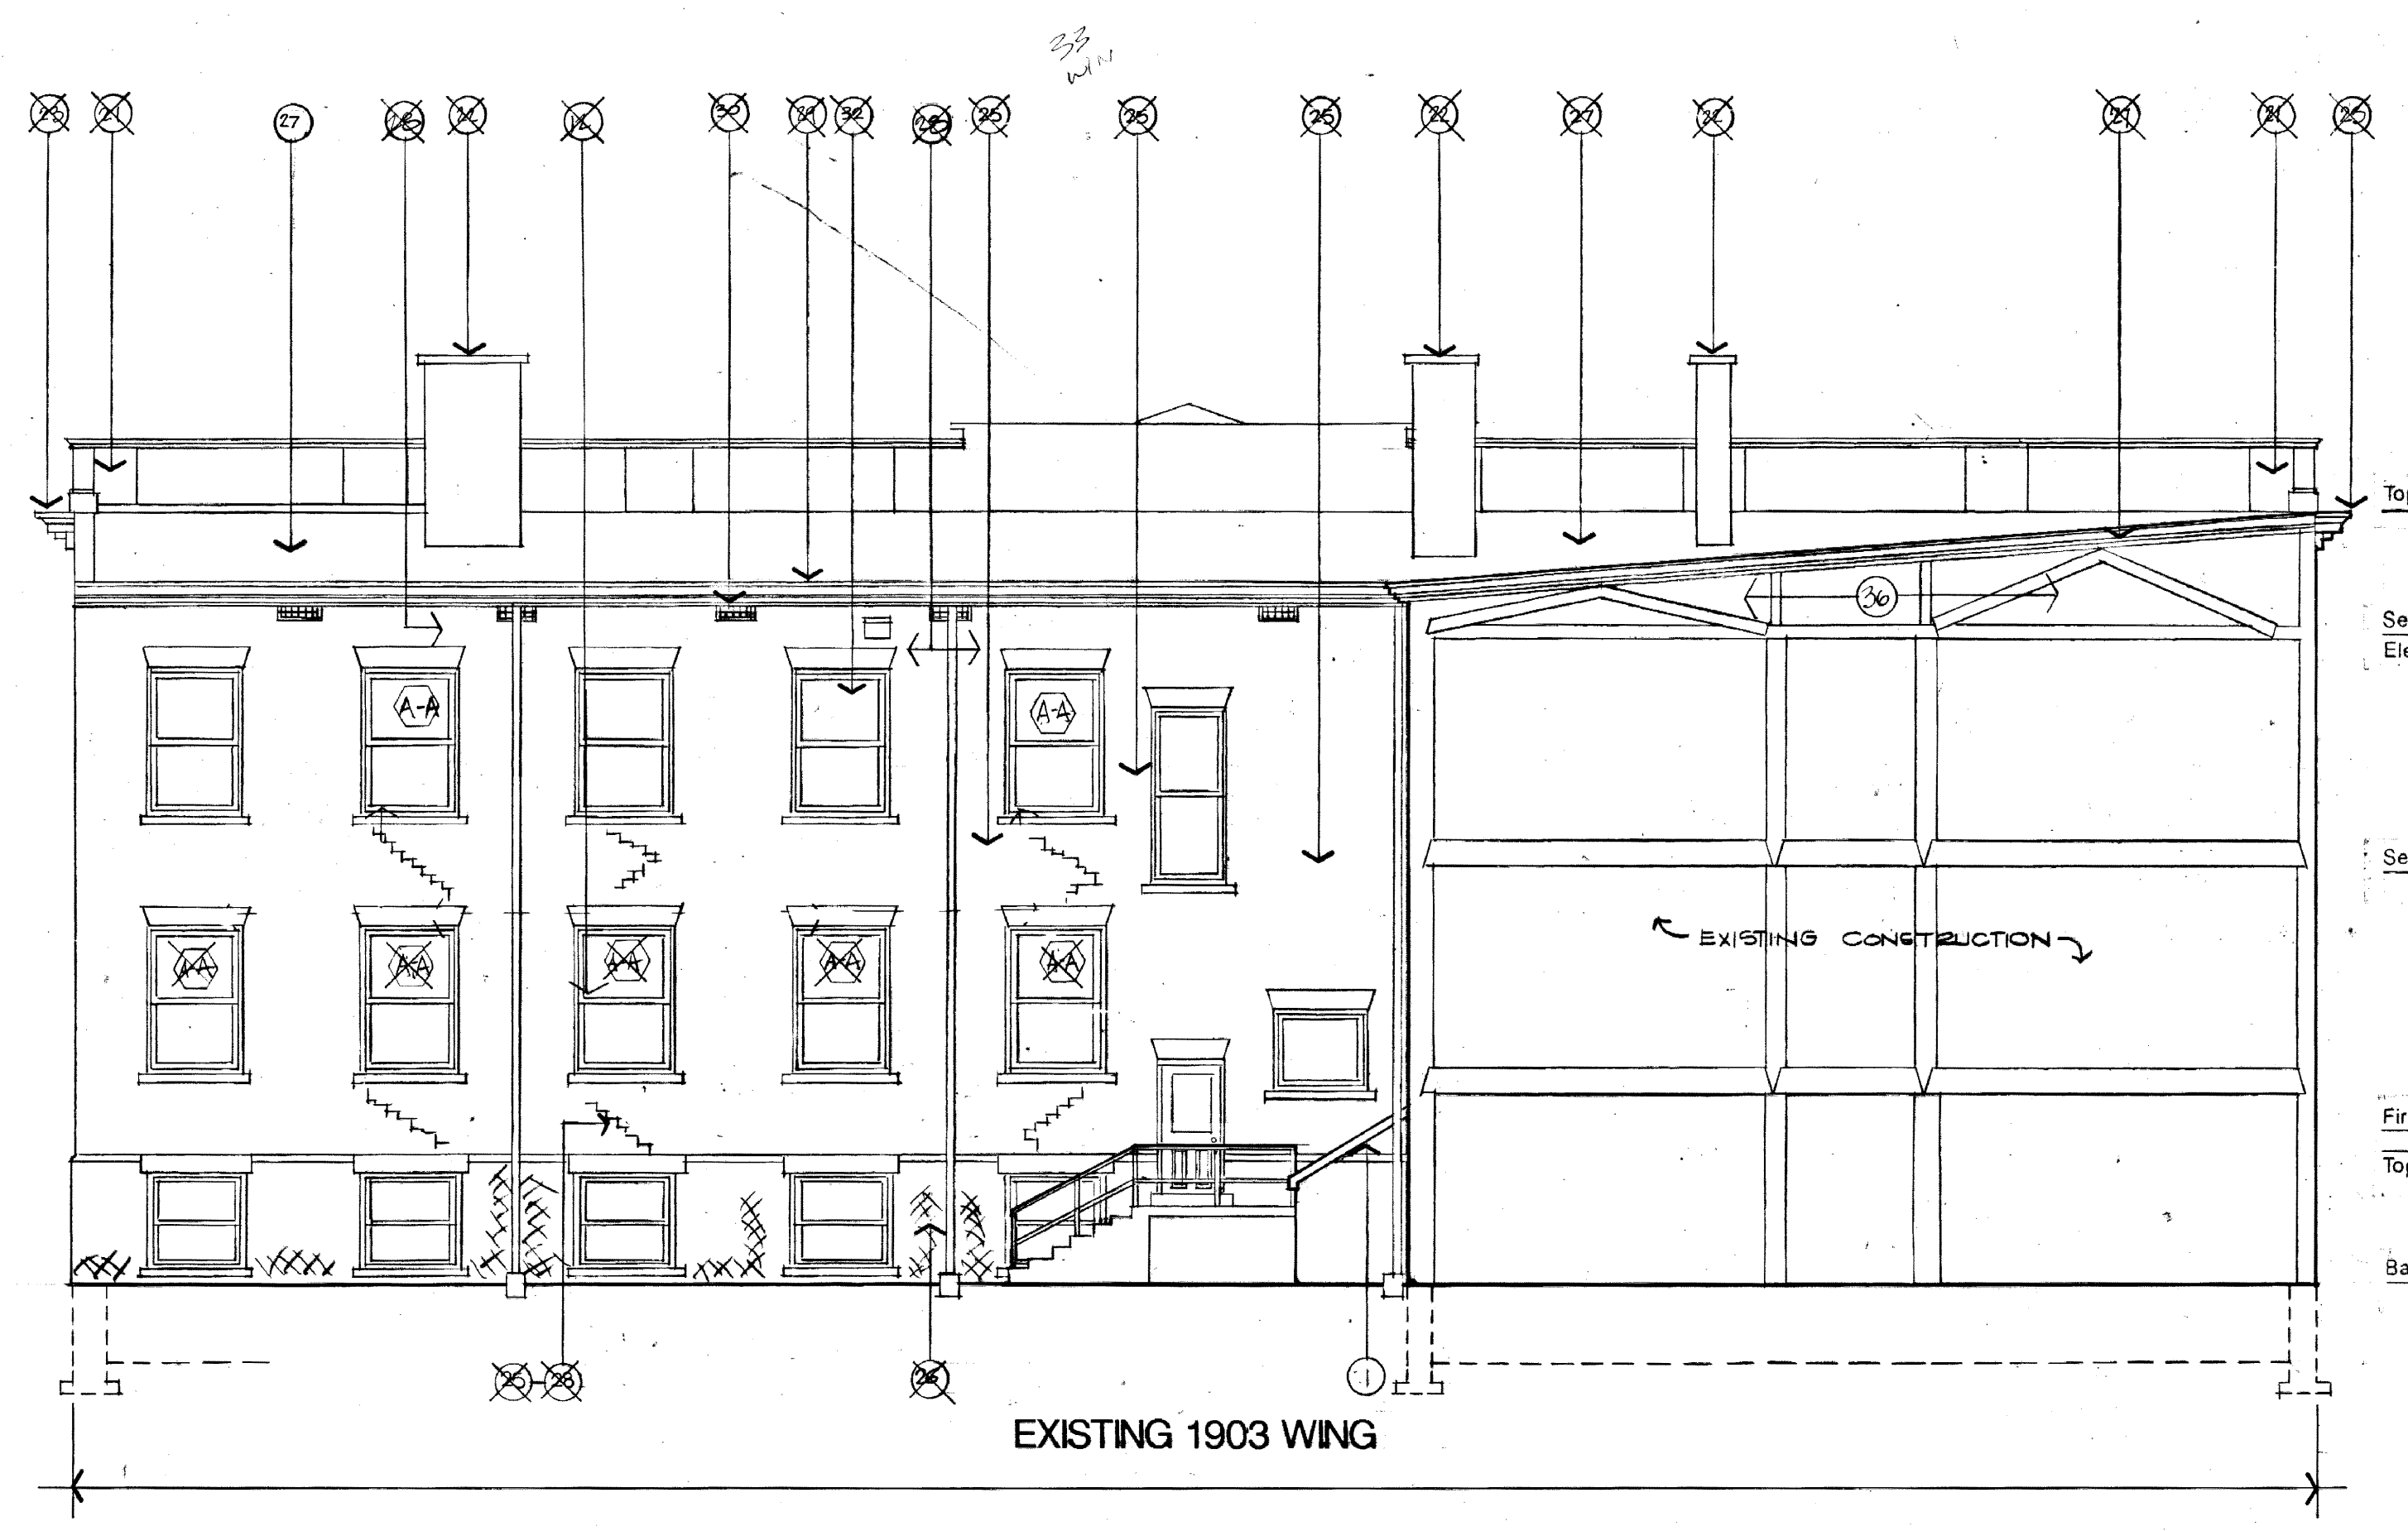


EAST ELEVATION

SCALE: 1/8" = 1'-0"

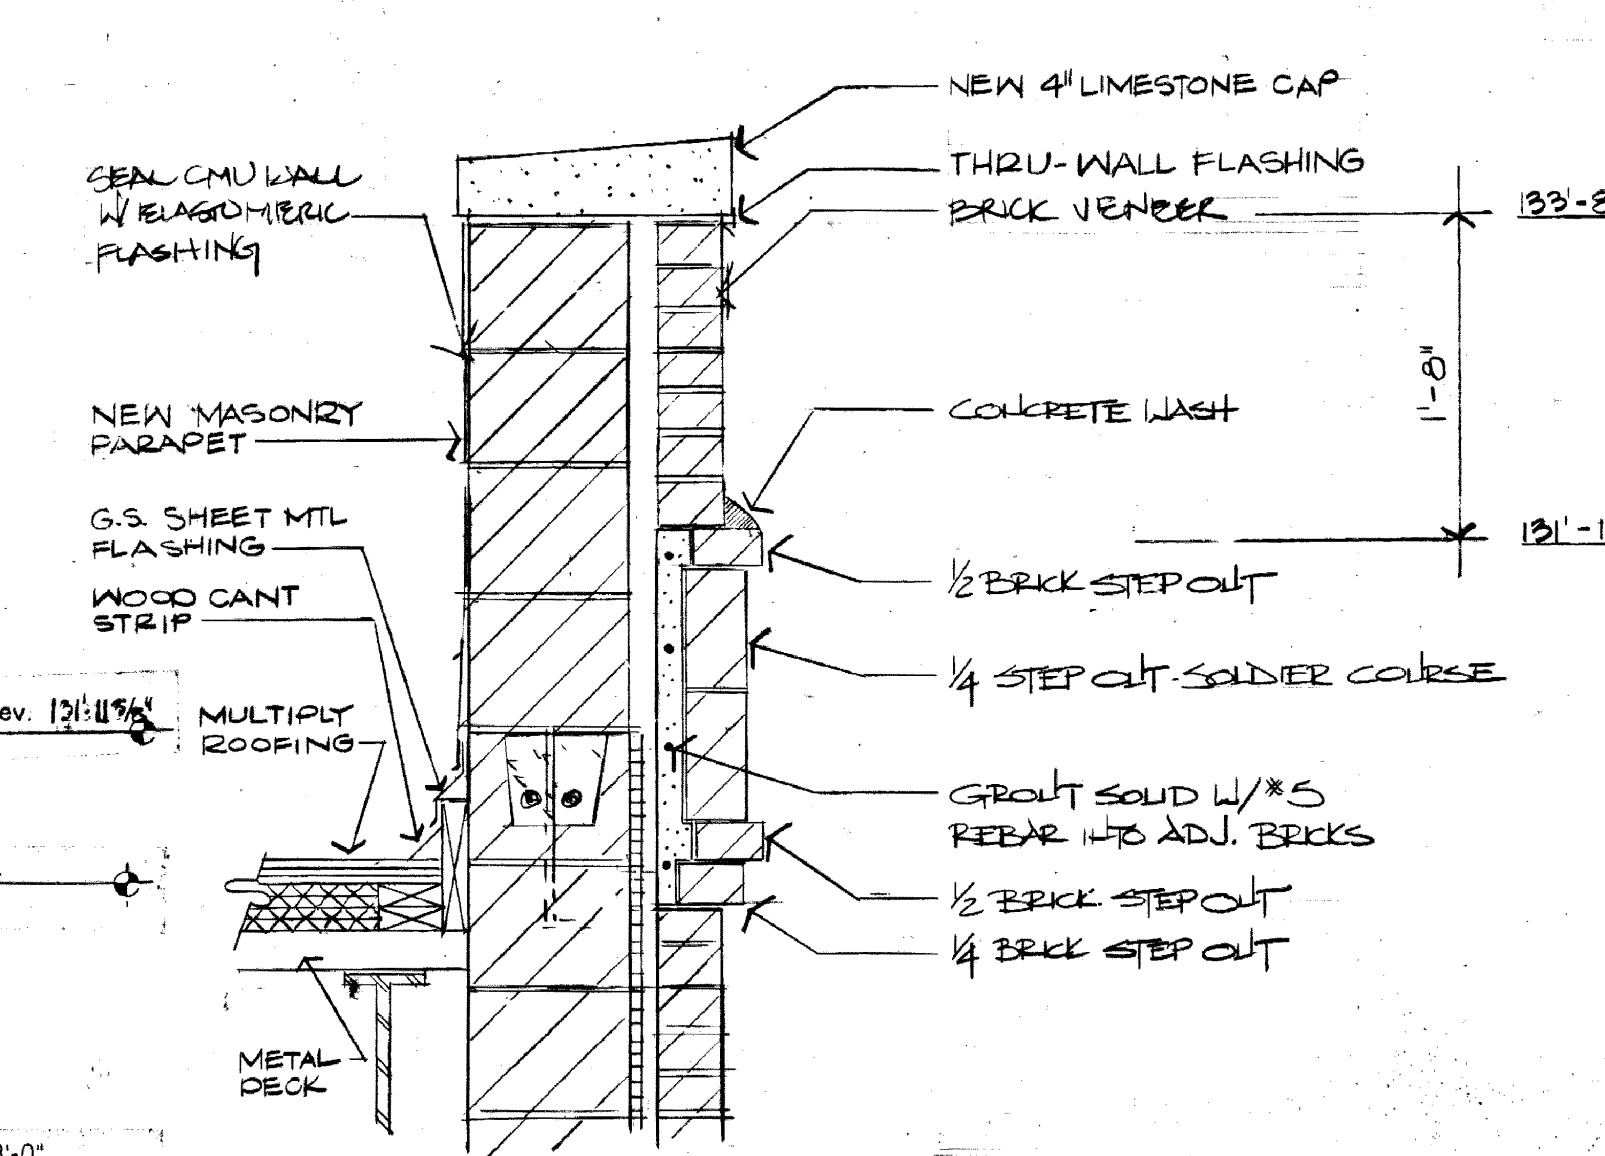


CORNICE DETAIL

SCALE: 1" = 1'-0"

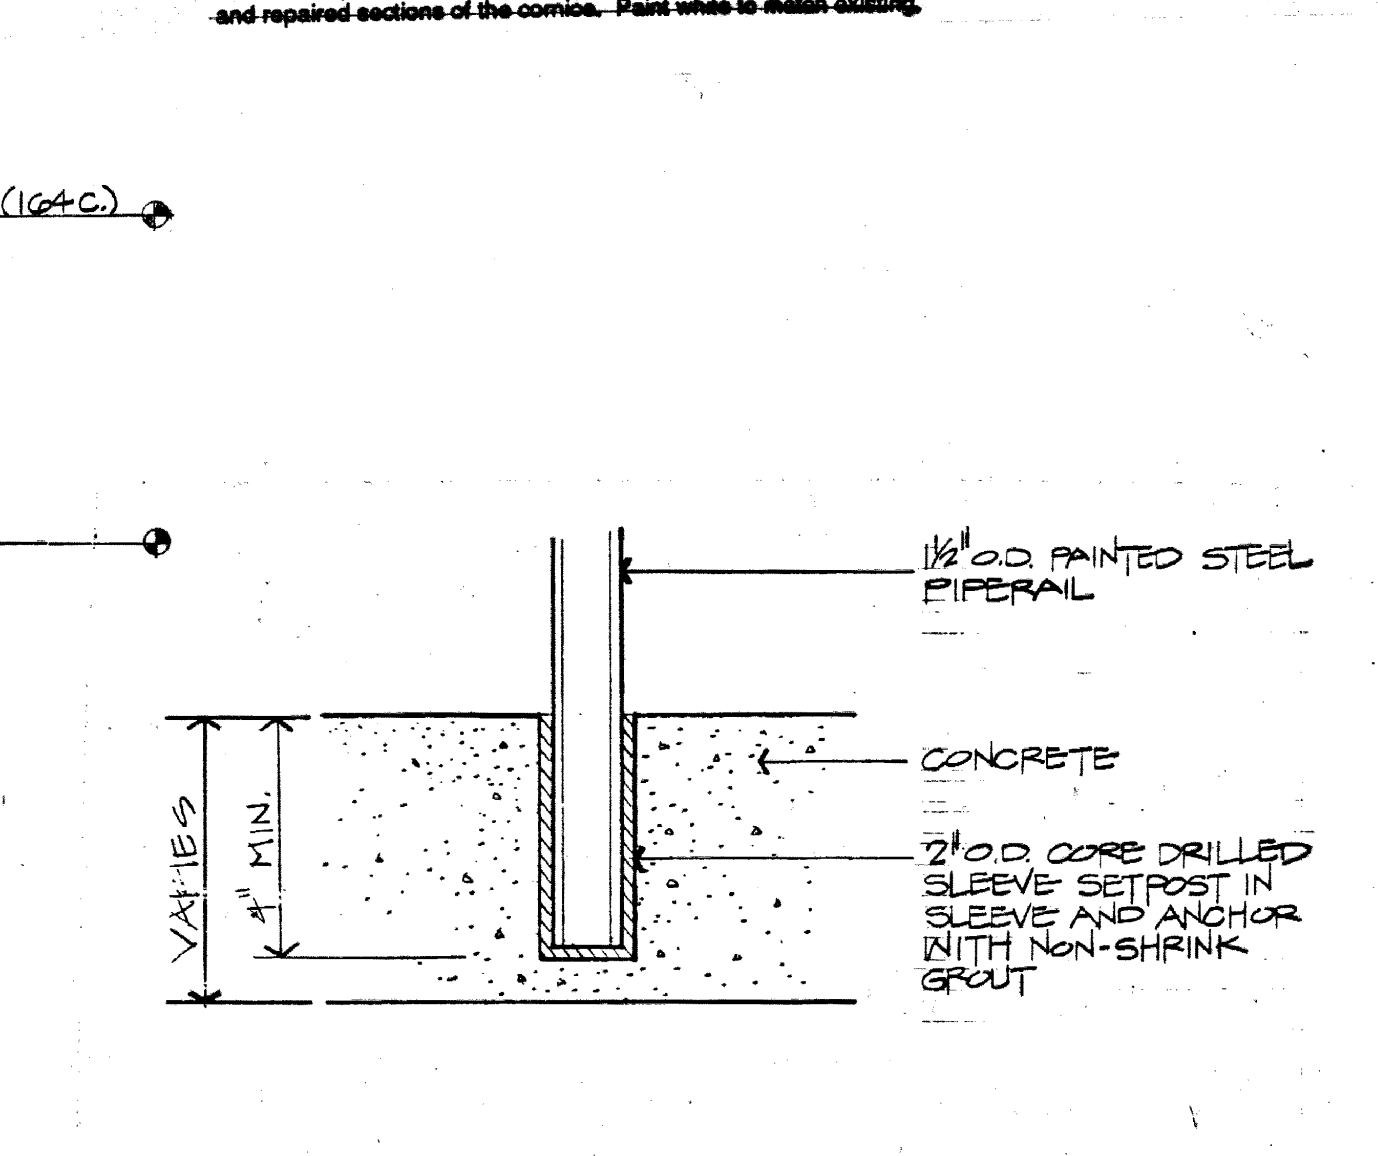


HANDRAIL ANCHOR DETAIL

SCALE: 3/4" = 1'-0"

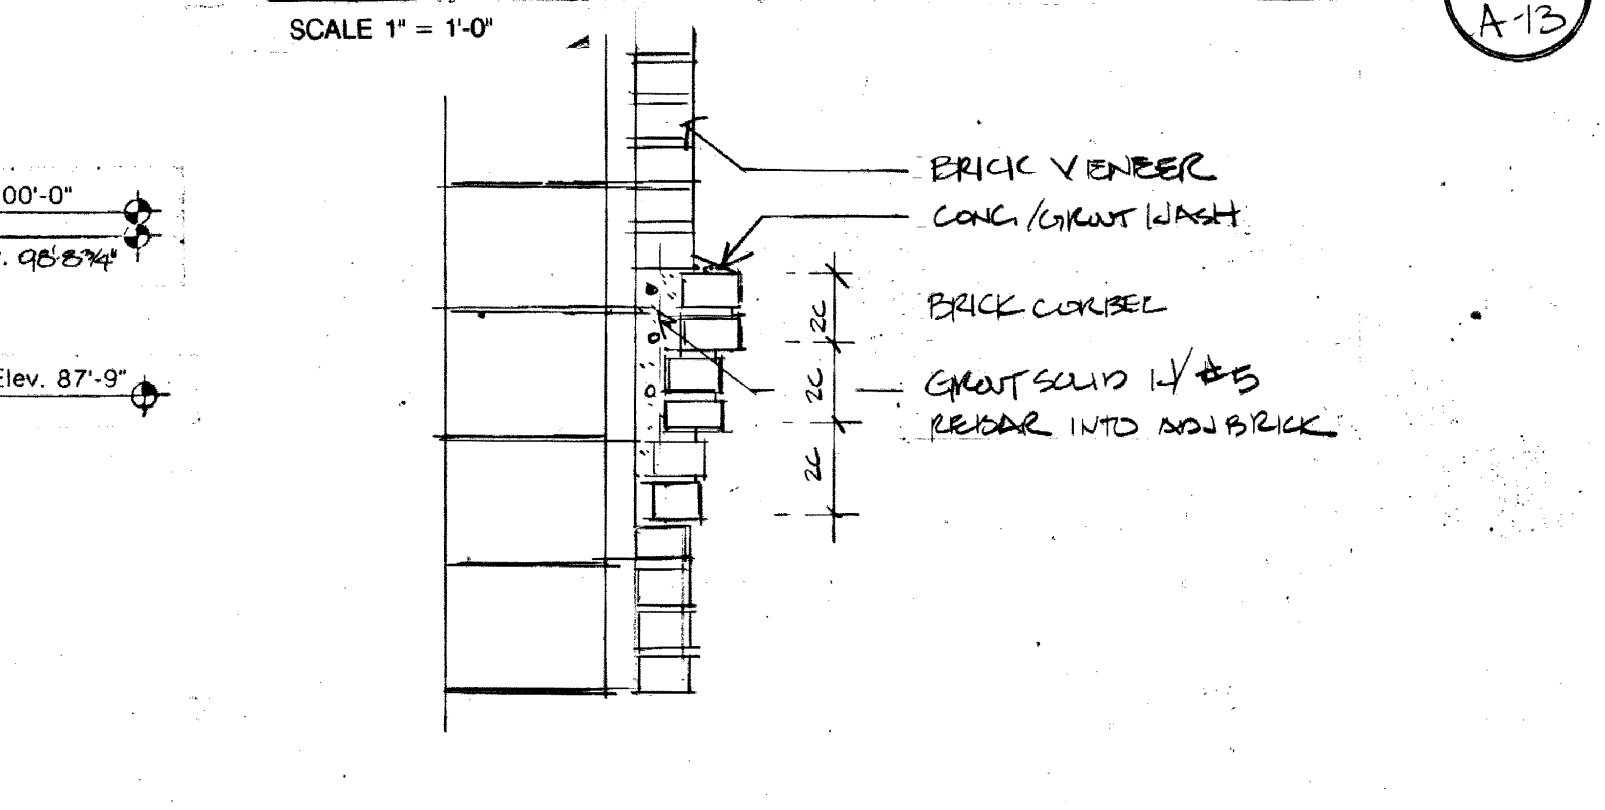

BRICK CORBEL DETAIL

SCALE: 1" = 1'-0"

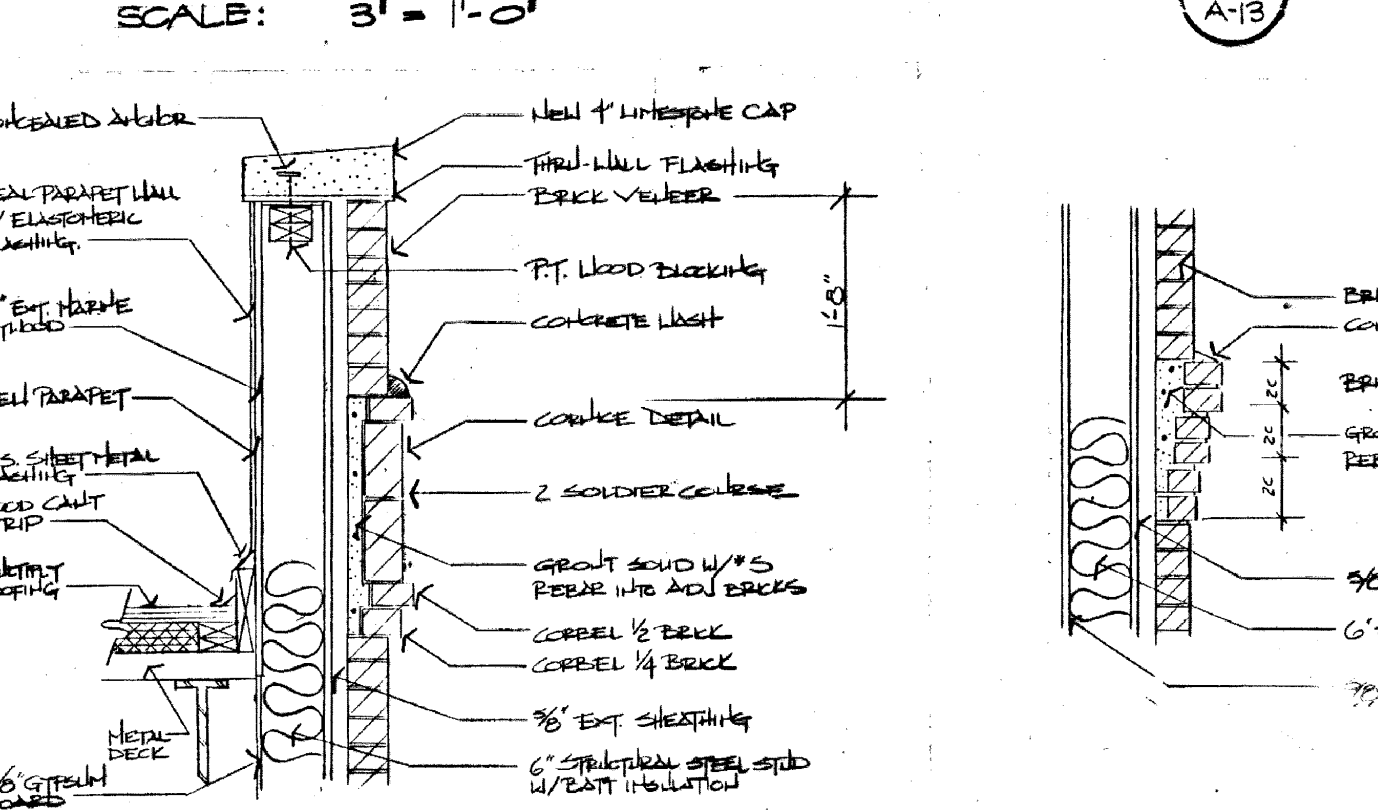

BRICK CORBEL DETAIL


SCALE: 3/4" = 1'-0"

CORNICE DETAIL

NO SCALE


BRICK CORBEL DETAIL

NO SCALE

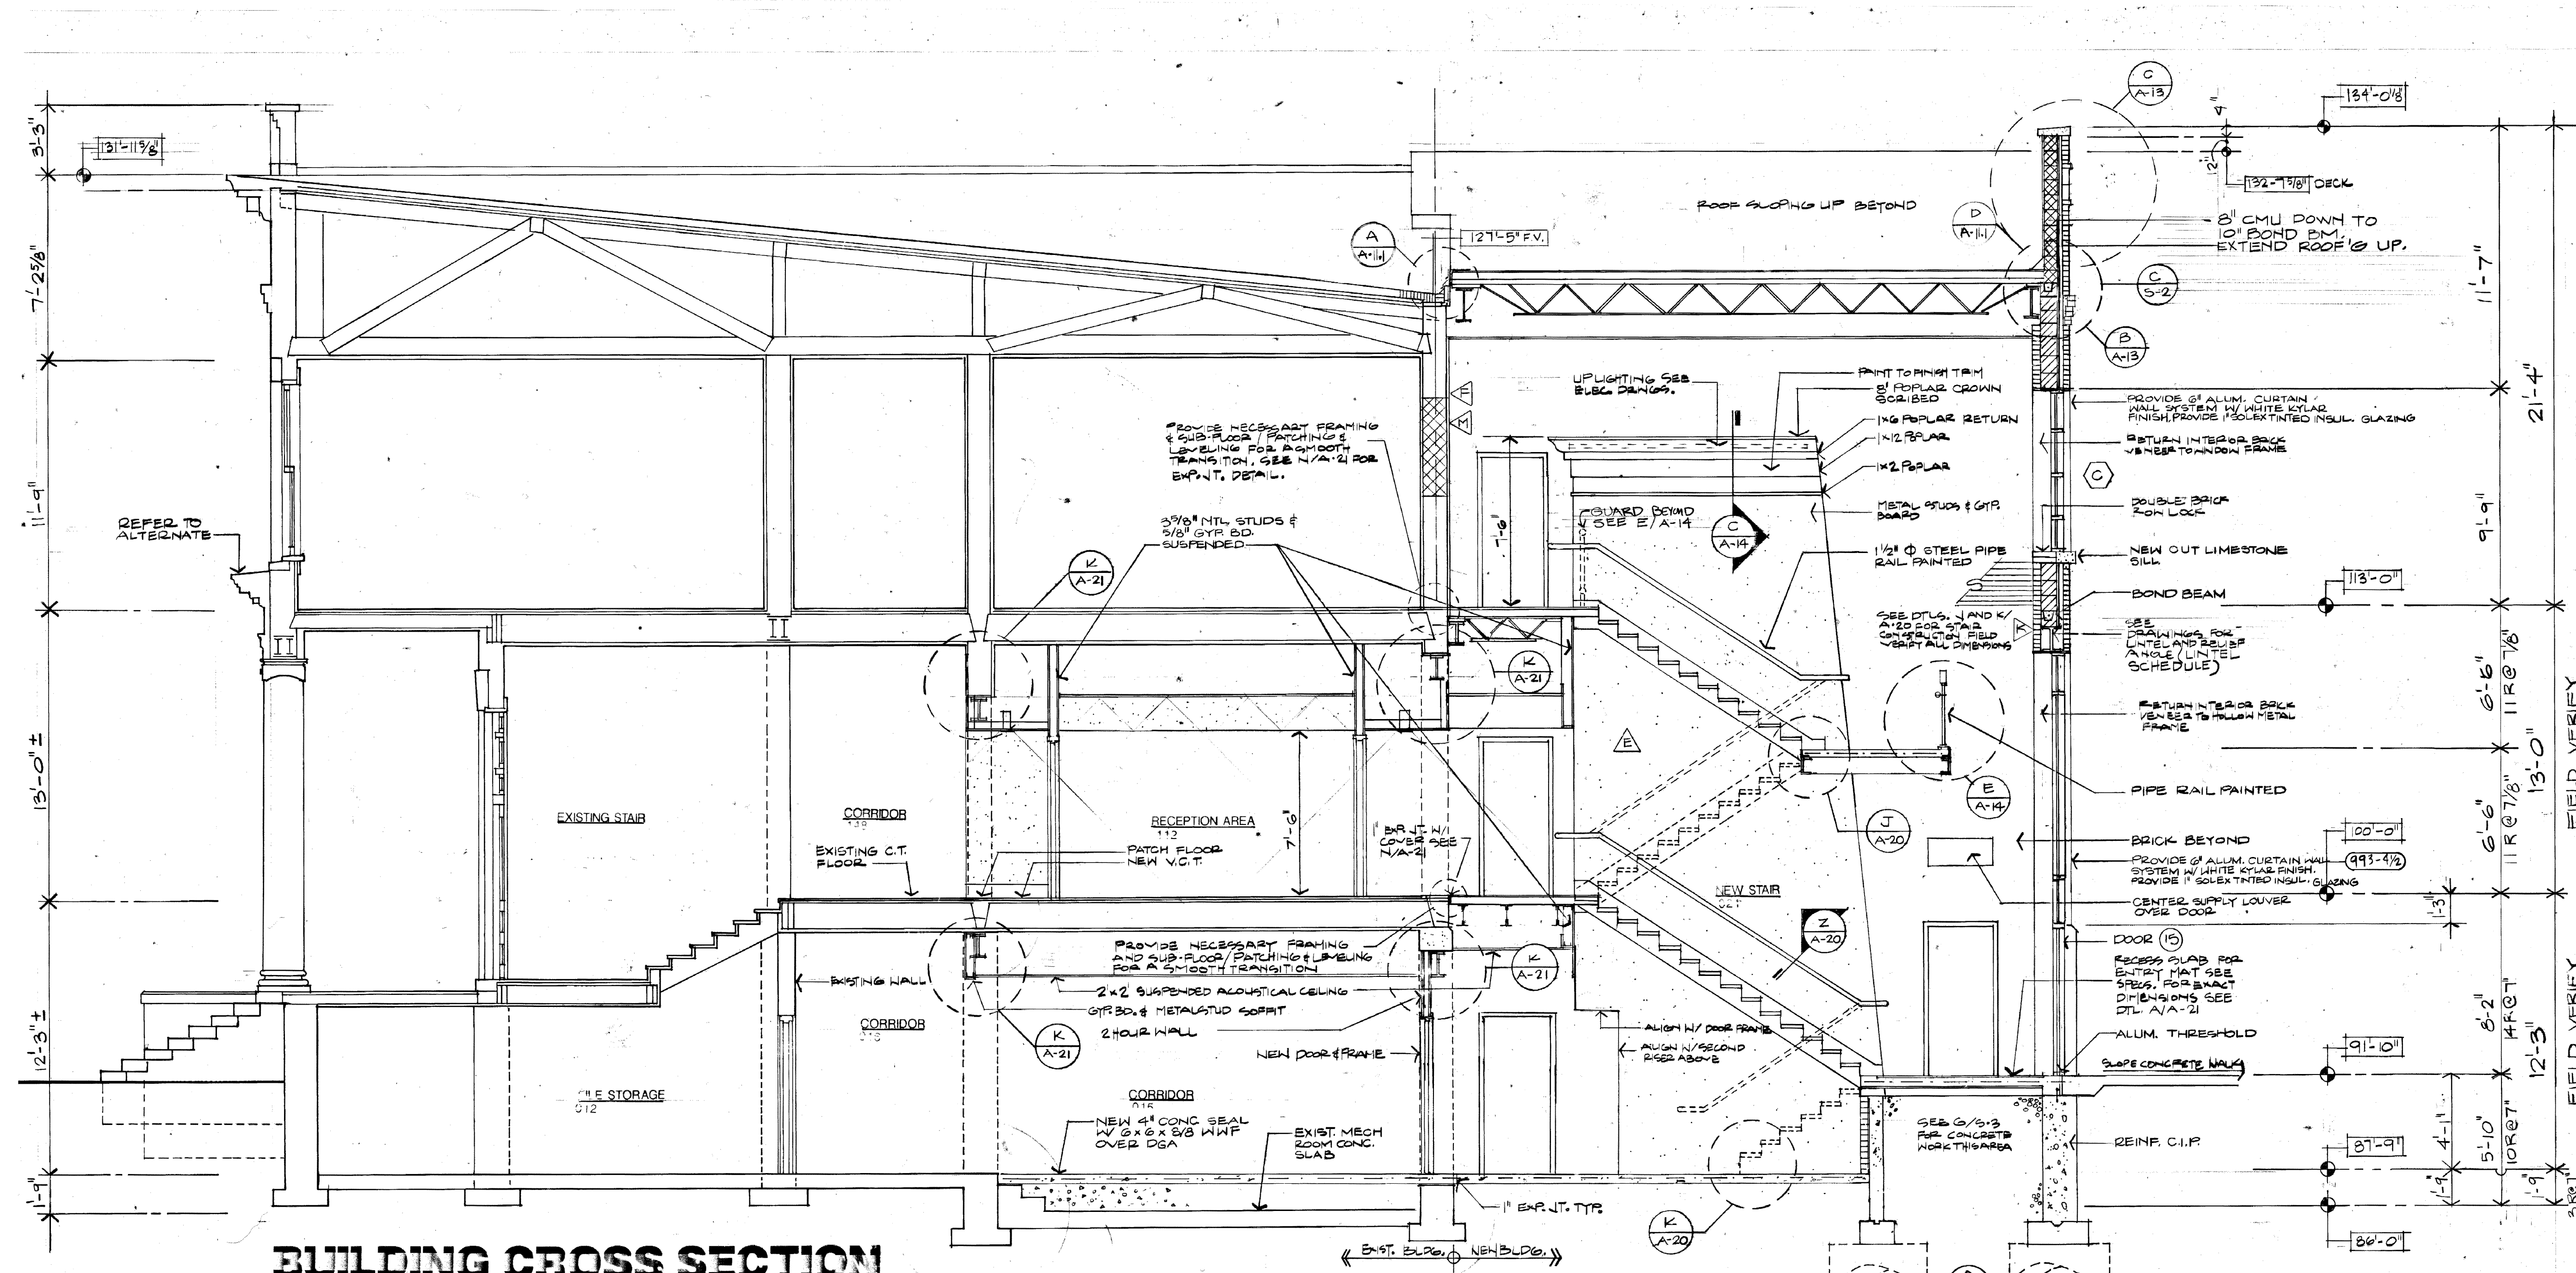


BUILDING CROSS SECTION

SCALE: 1/4" = 1'-0"

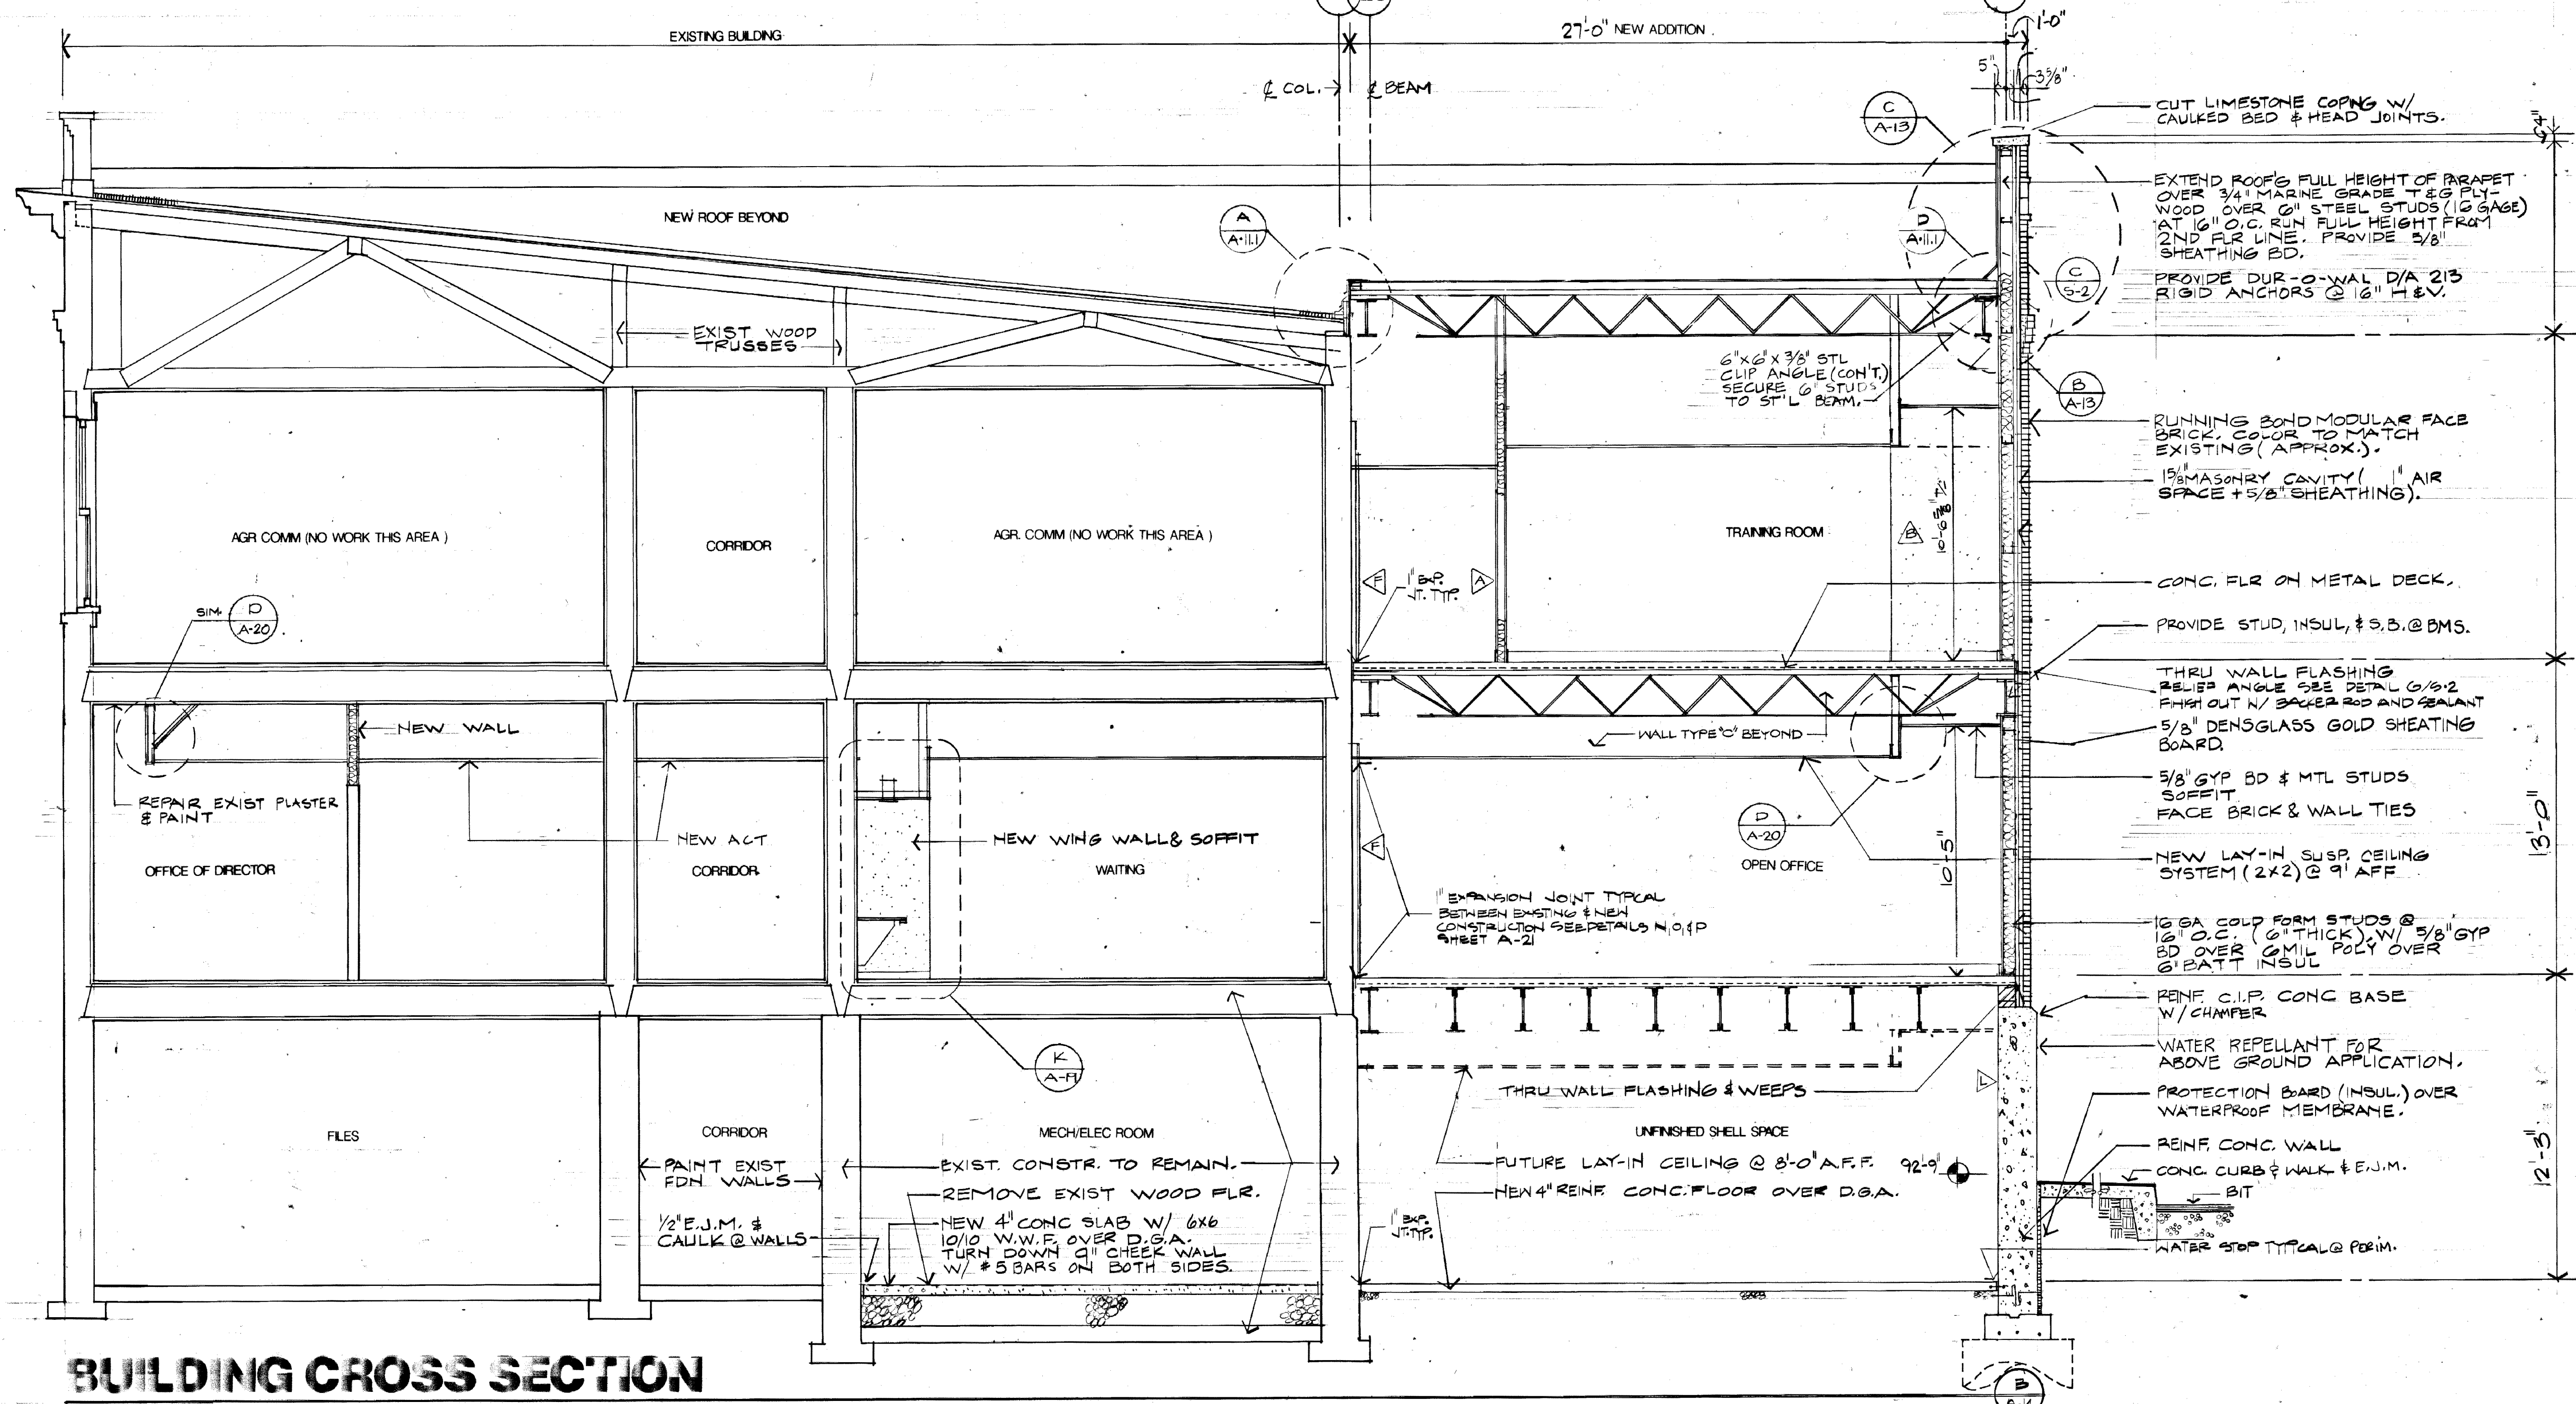


BUILDING CROSS SECTION

SCALE: 1/4" = 1'-0"

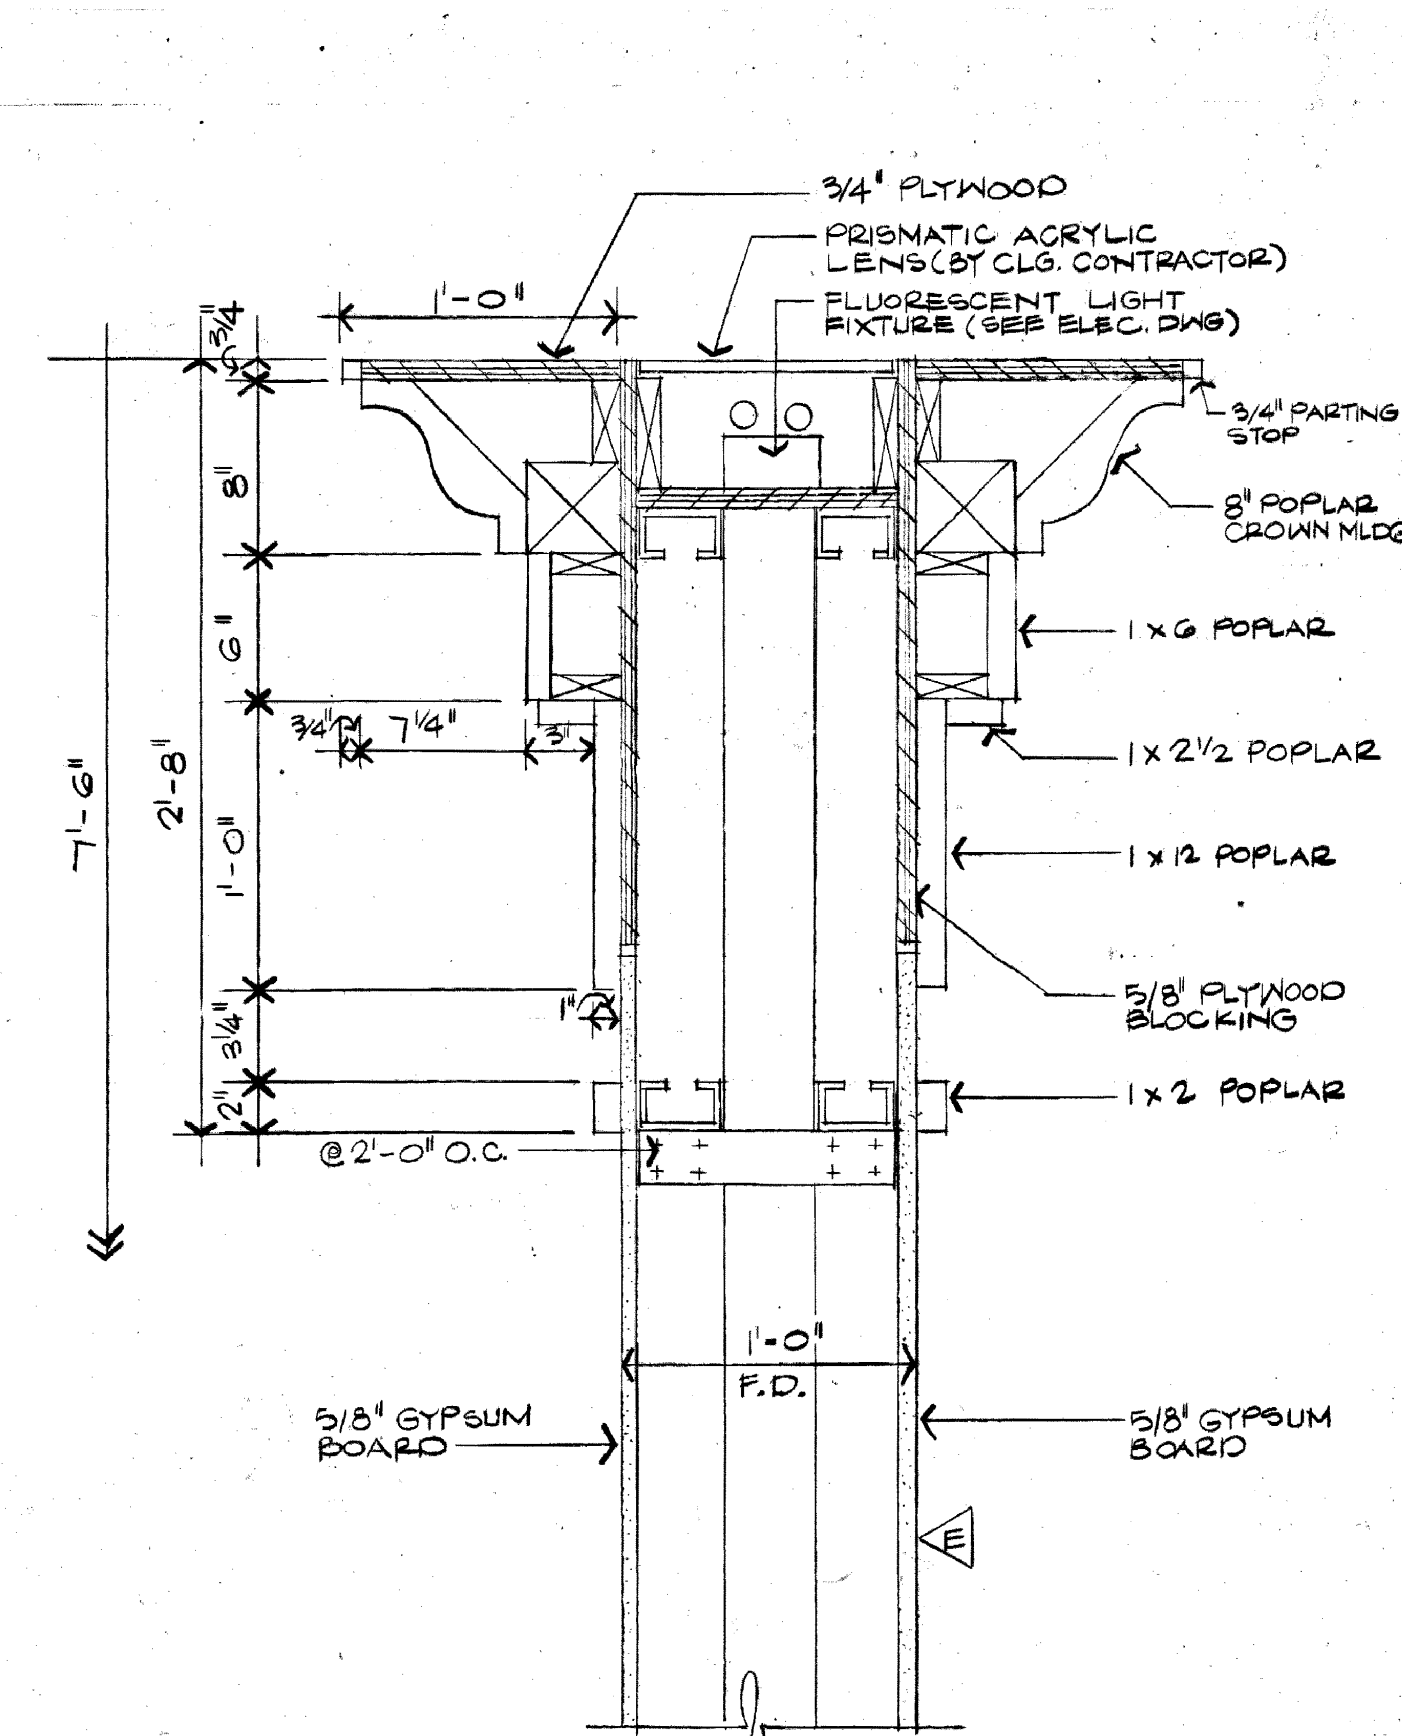


DETAIL

SCALE: 1 1/2" = 1'-0"

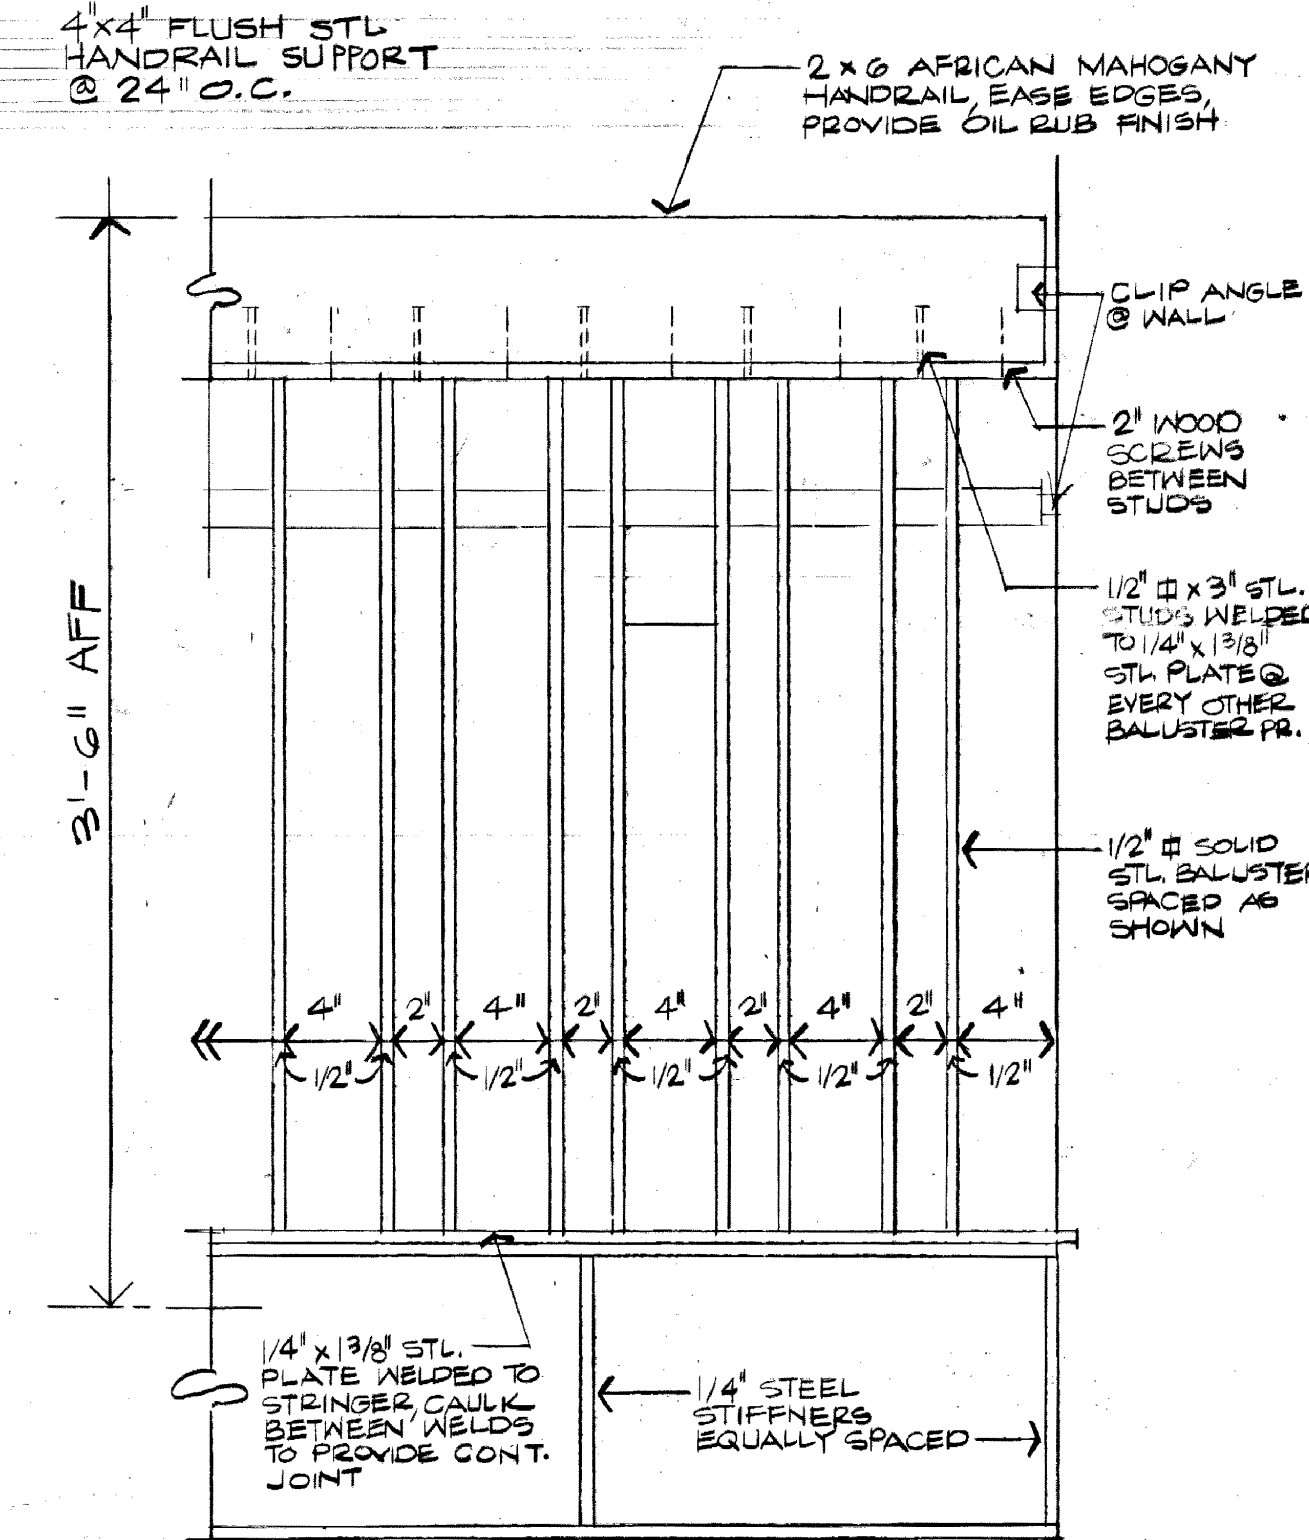








WALL RAIL DETAIL

SCALE: 1 1/2" = 1'-0"

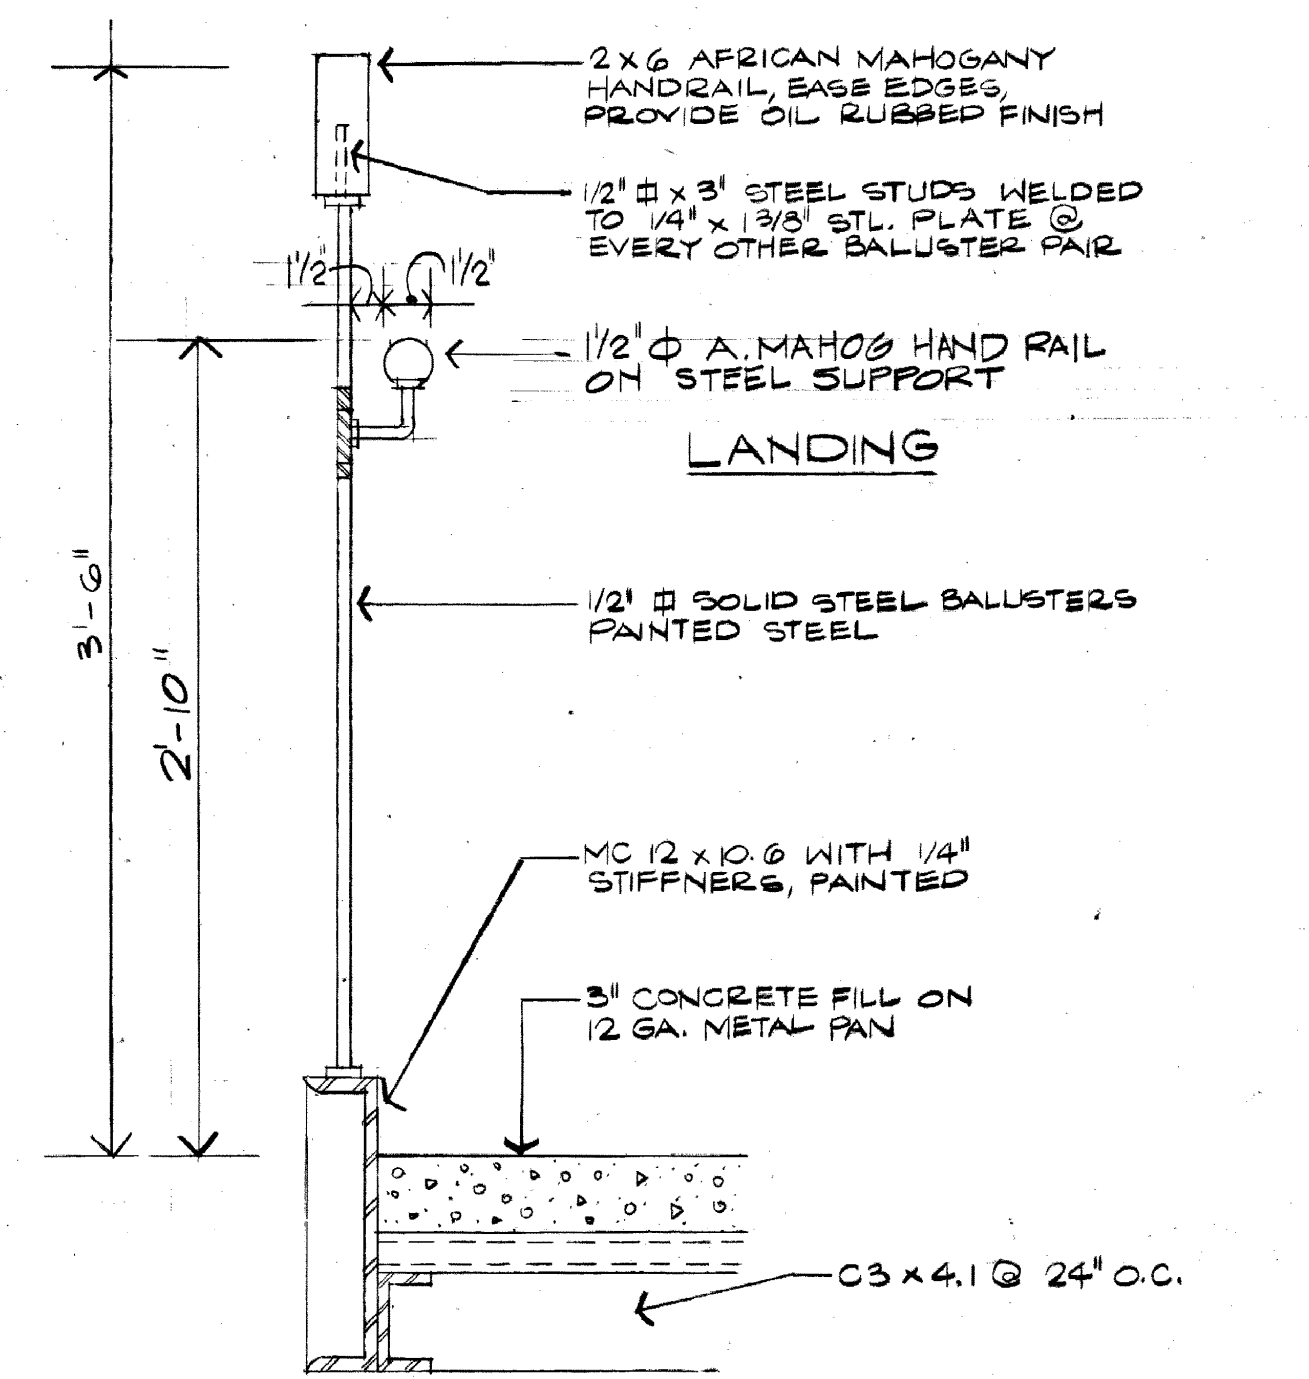

SECTION THRU RAIL


SCALE: 1 1/2" = 1'-0"

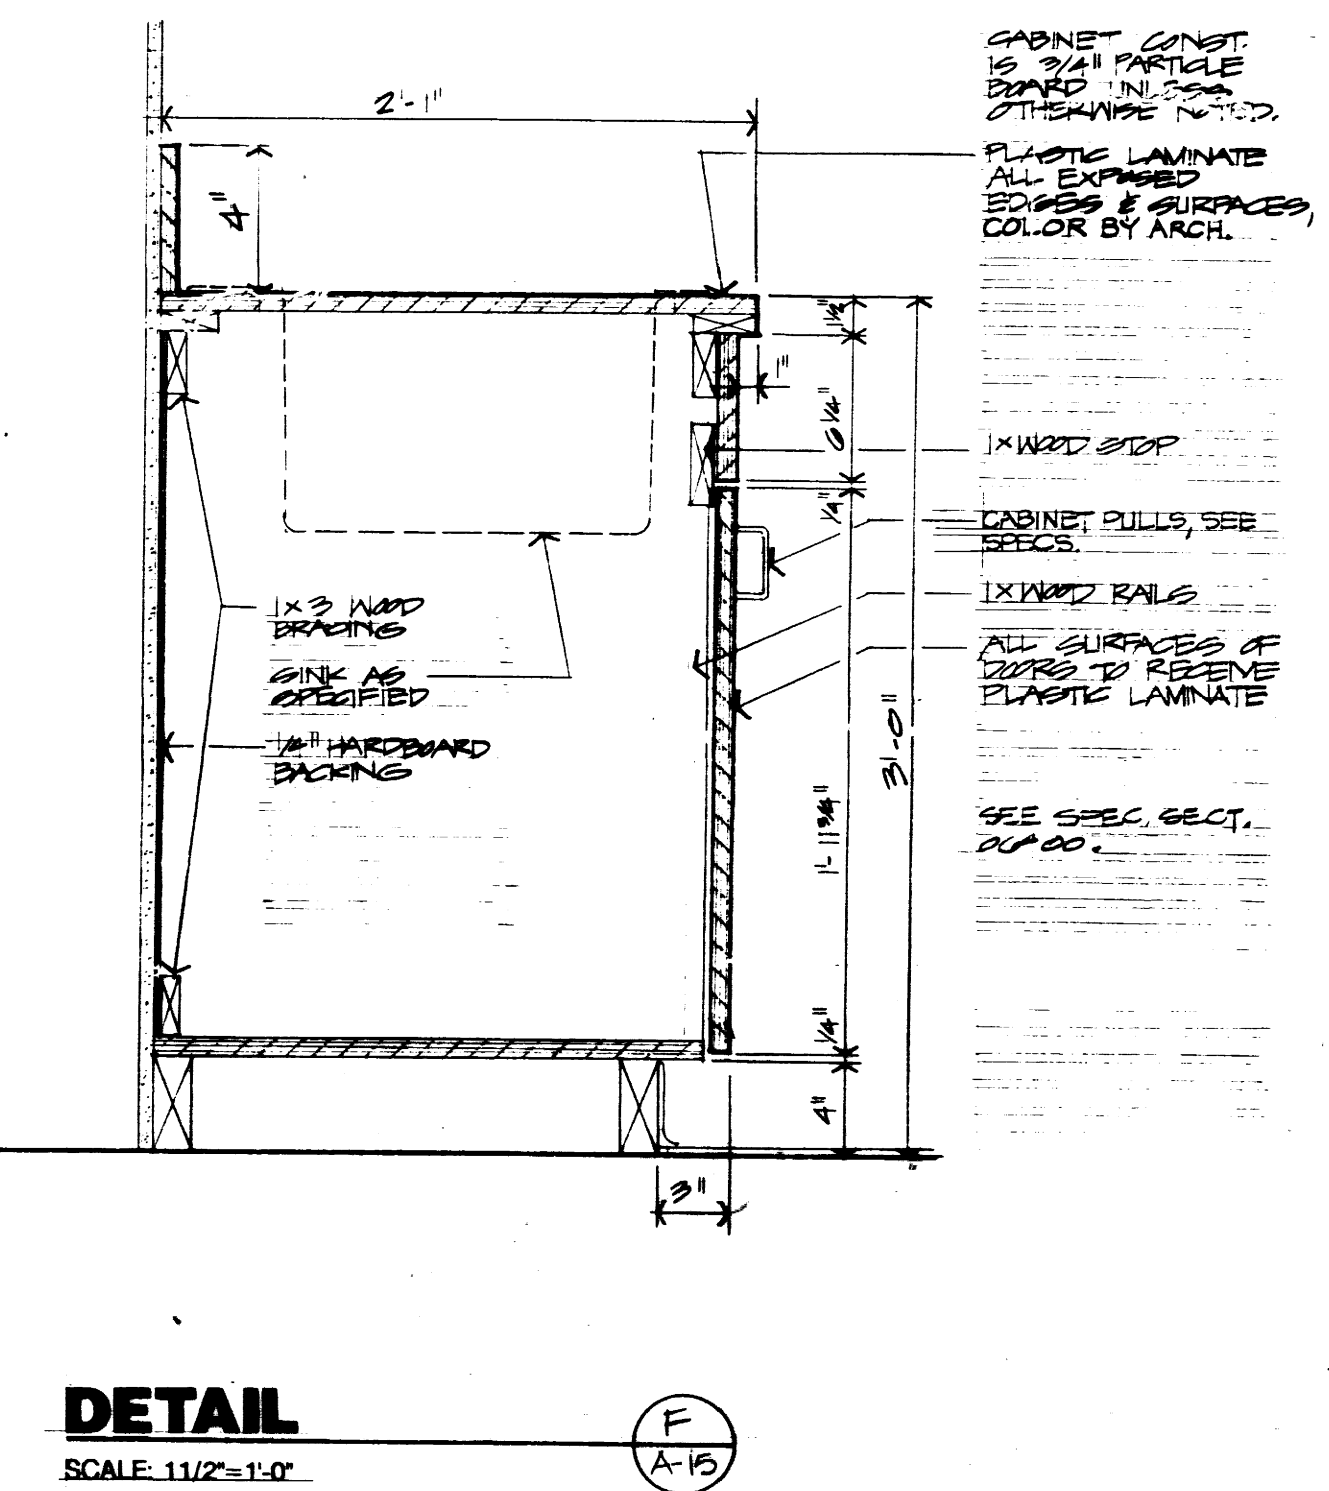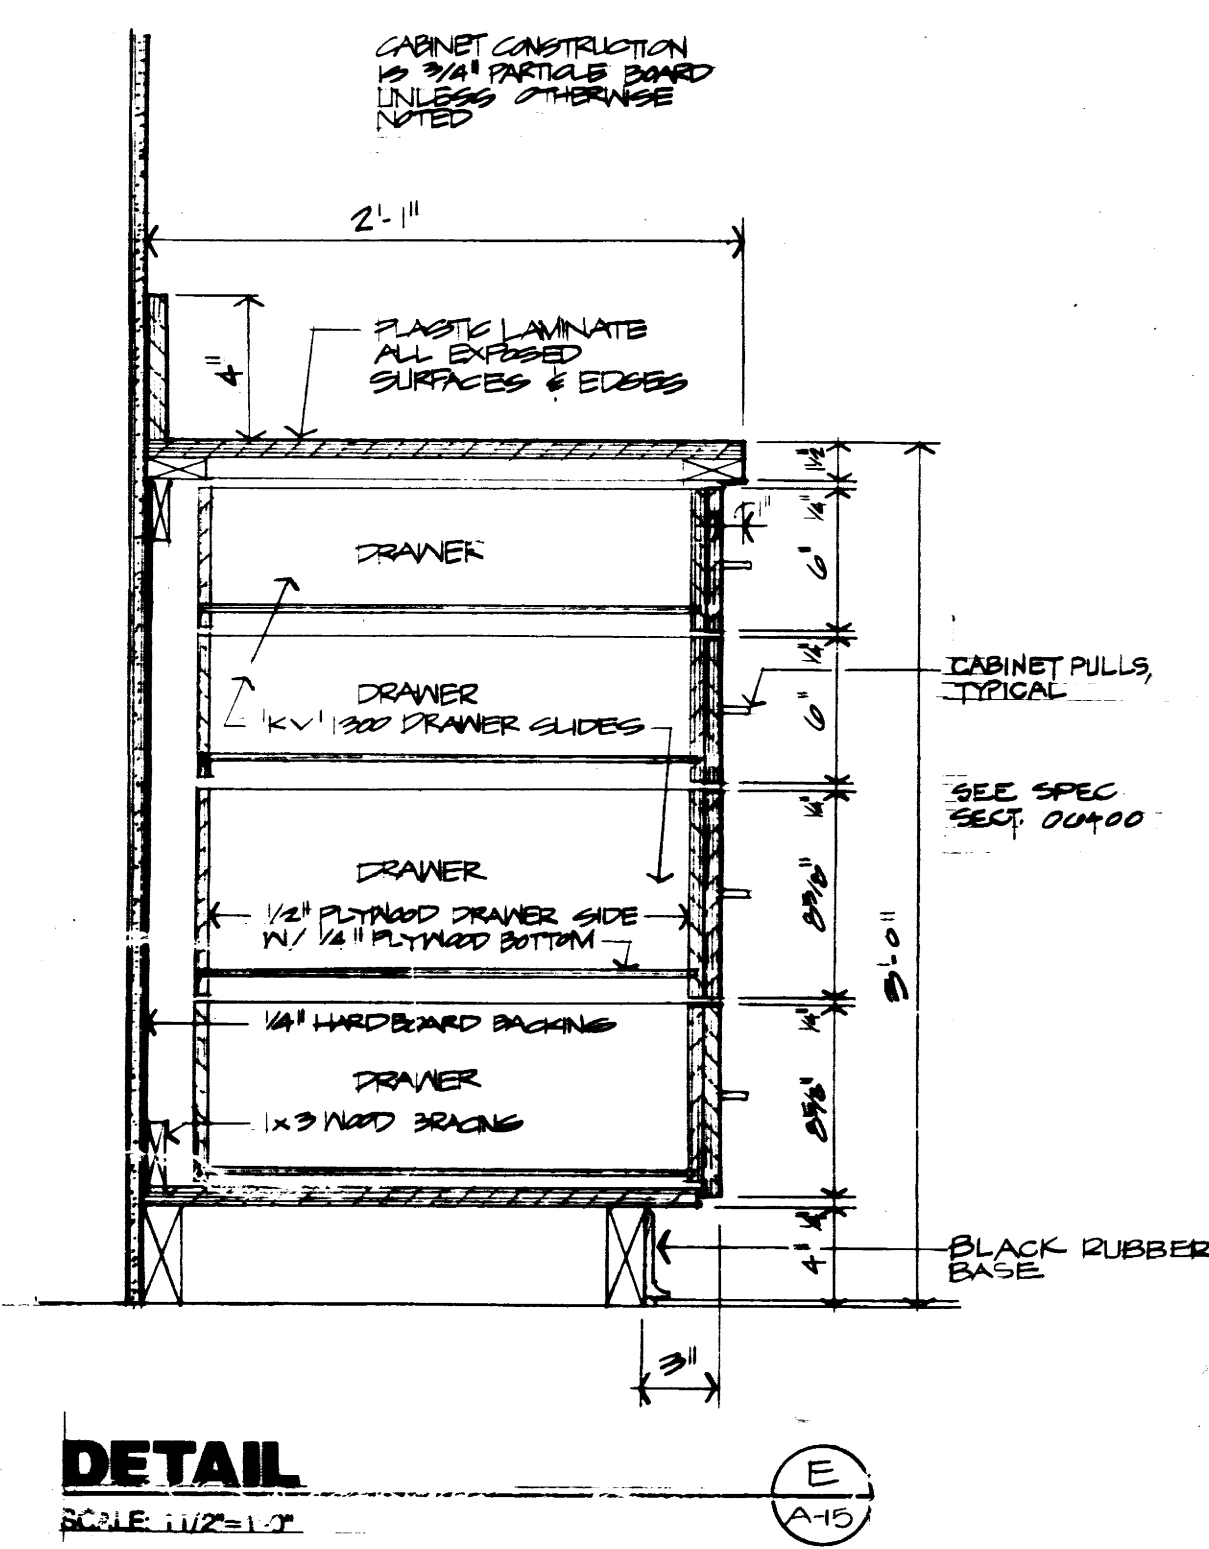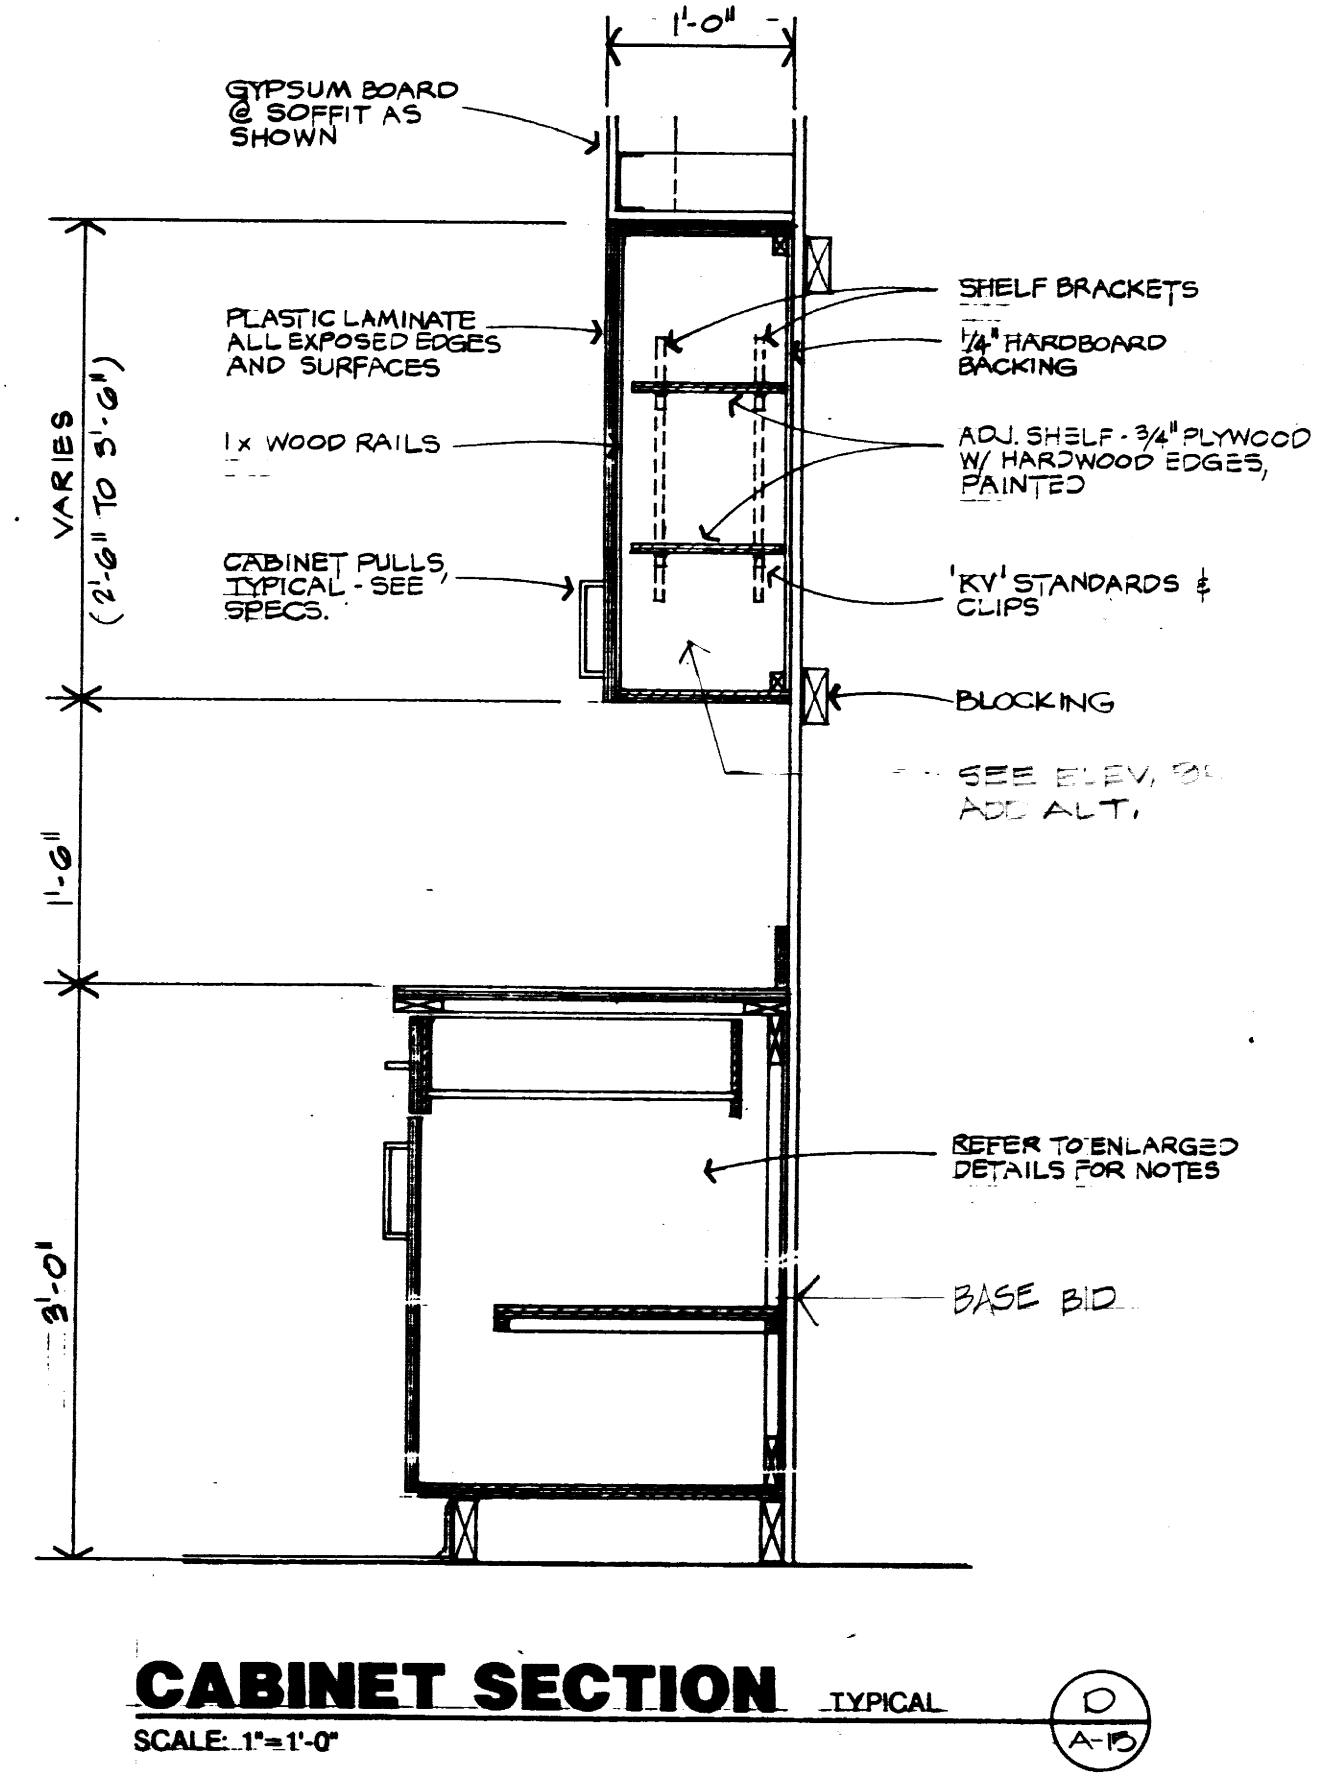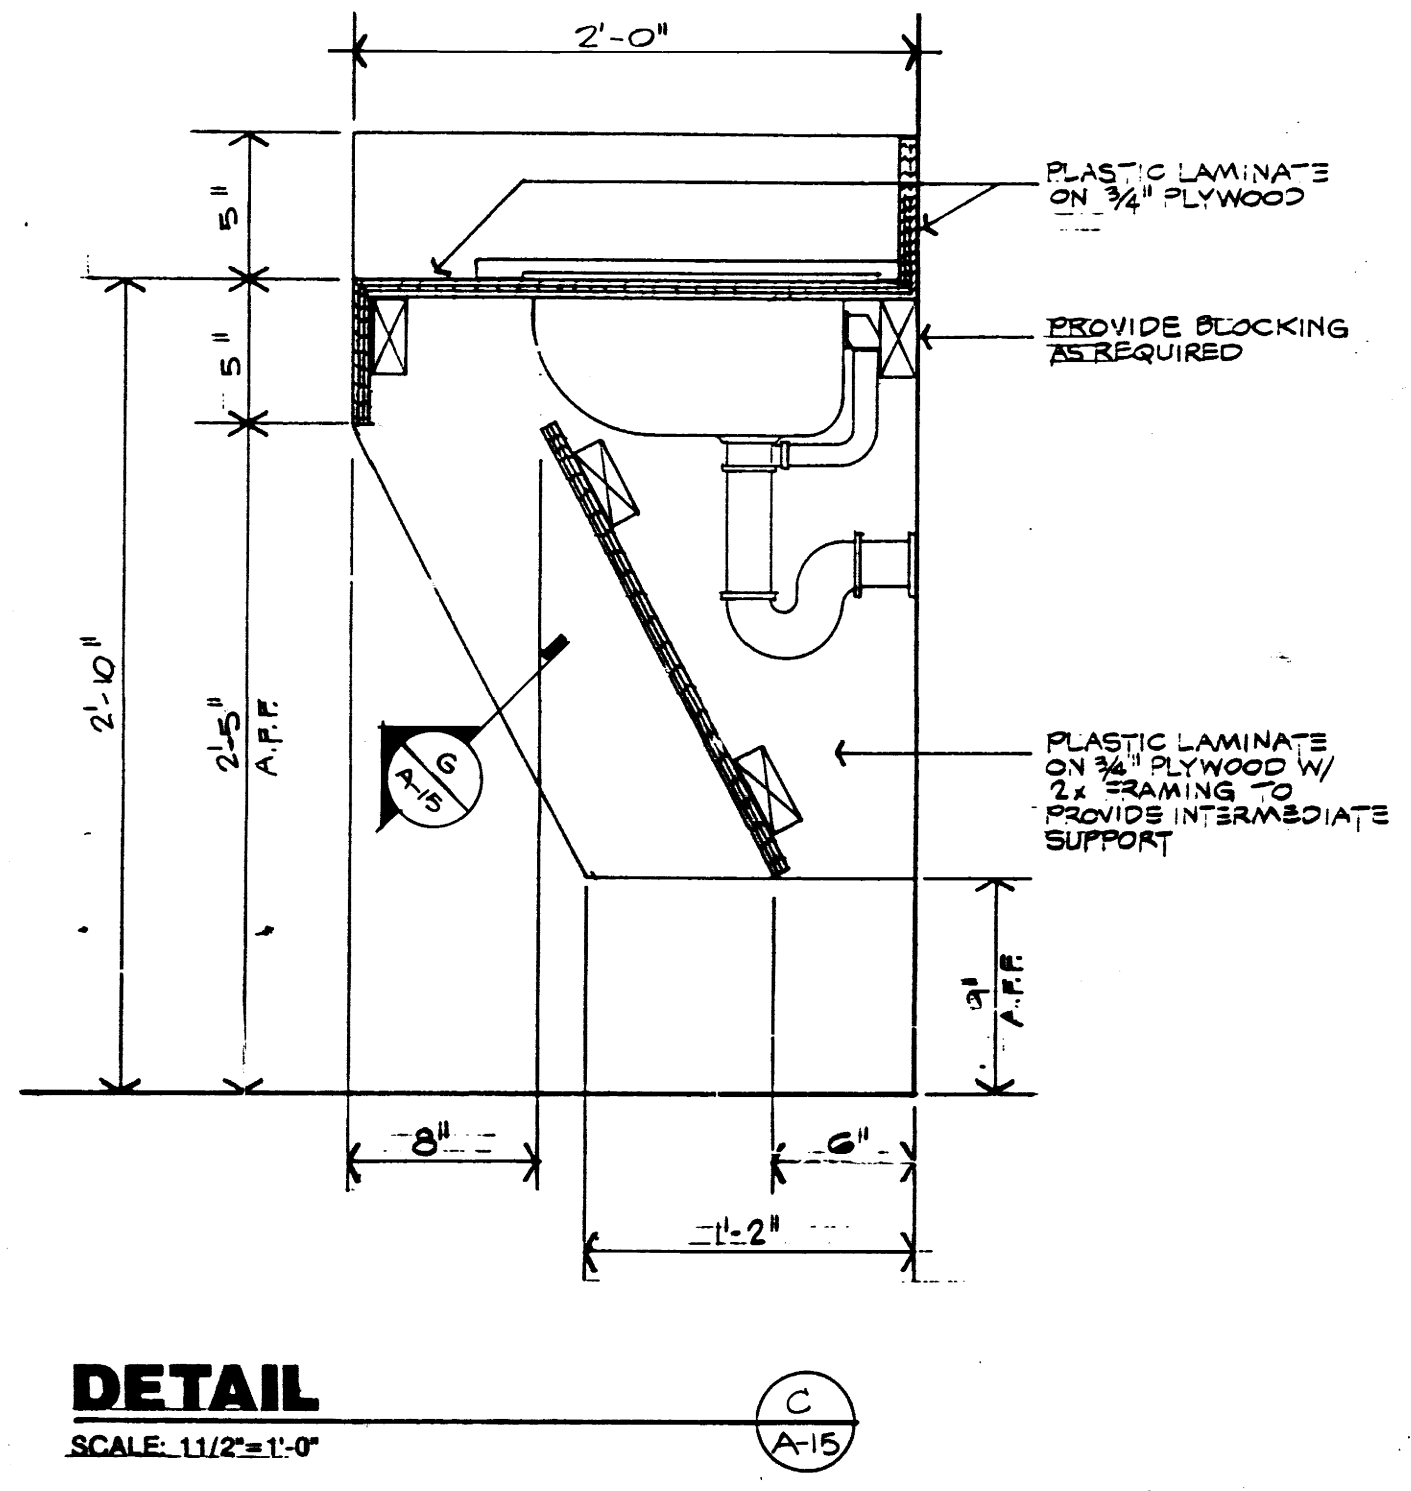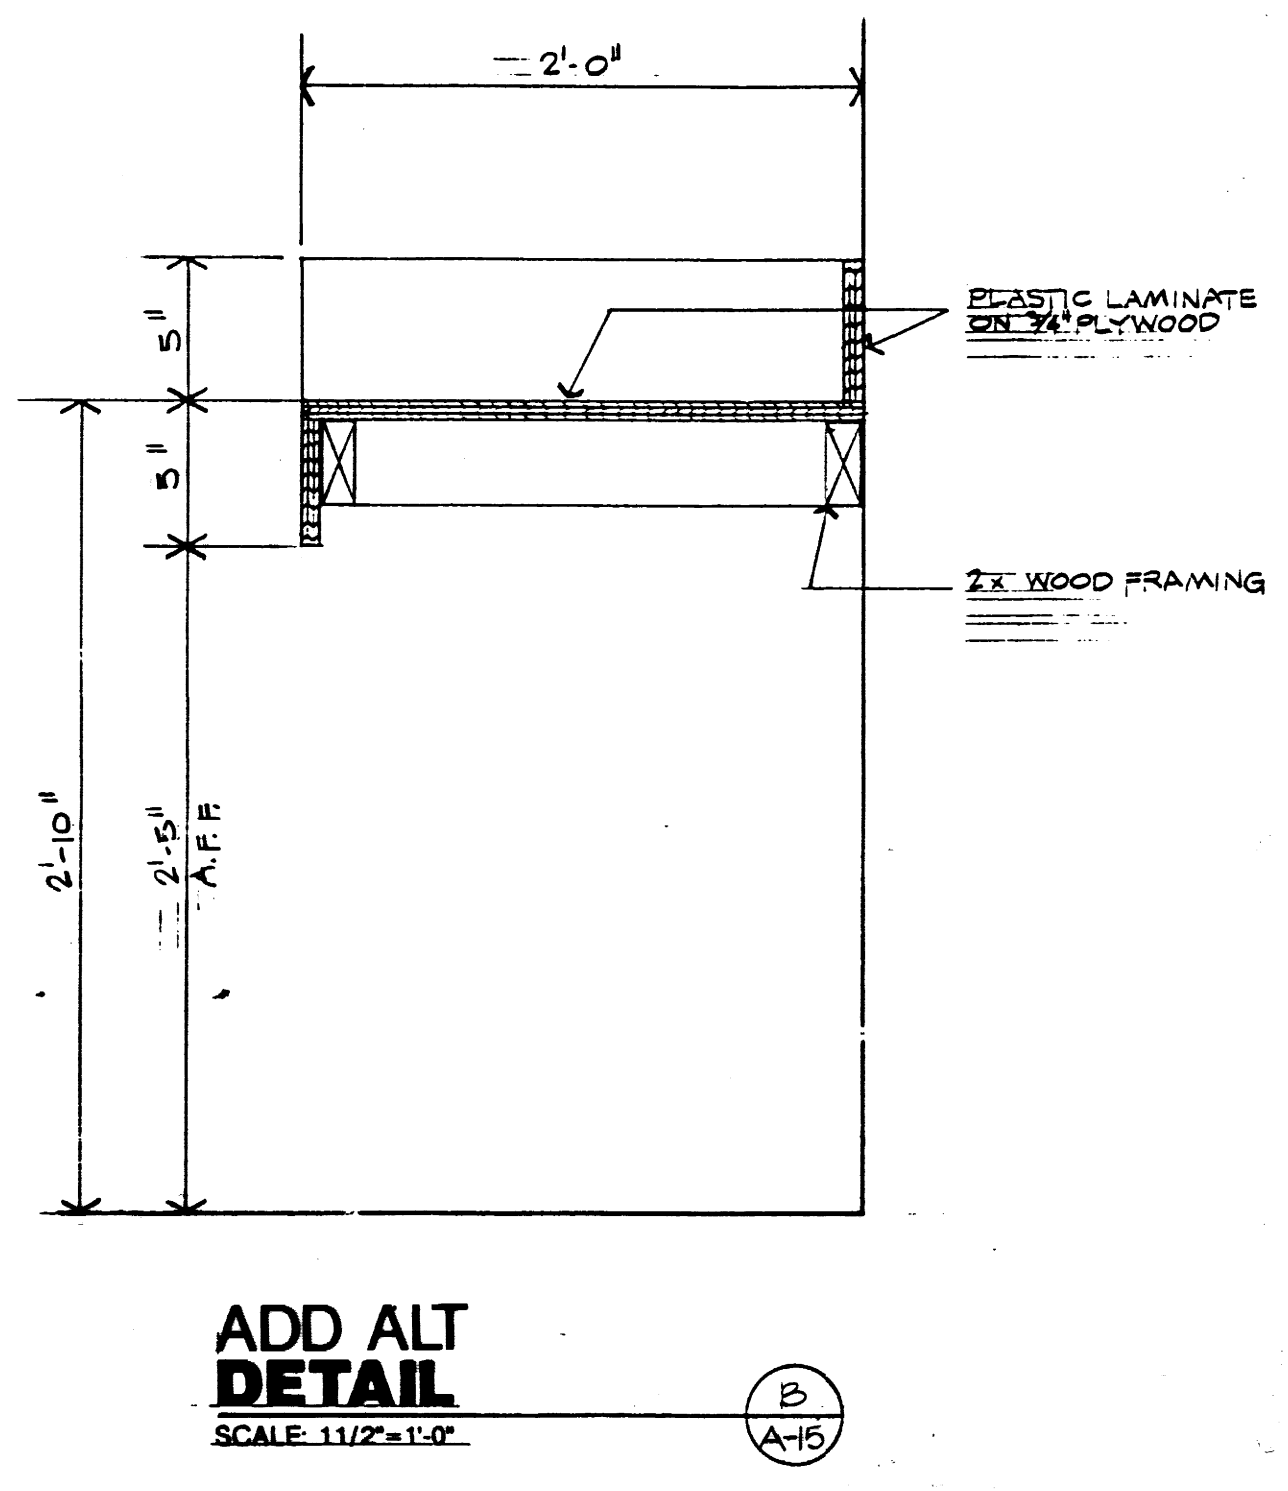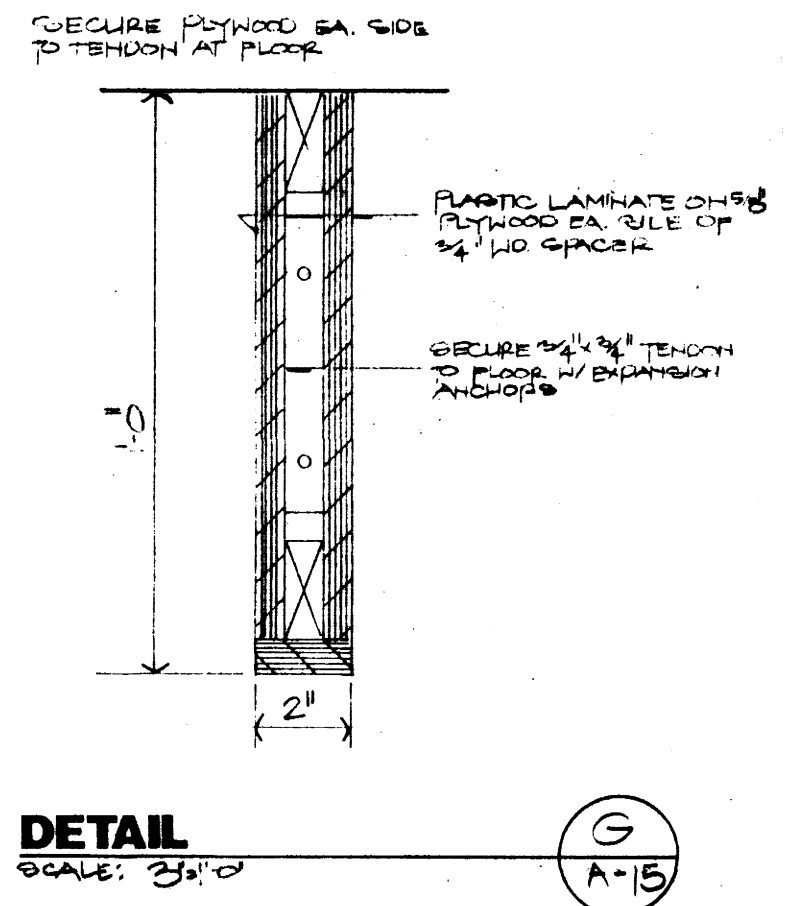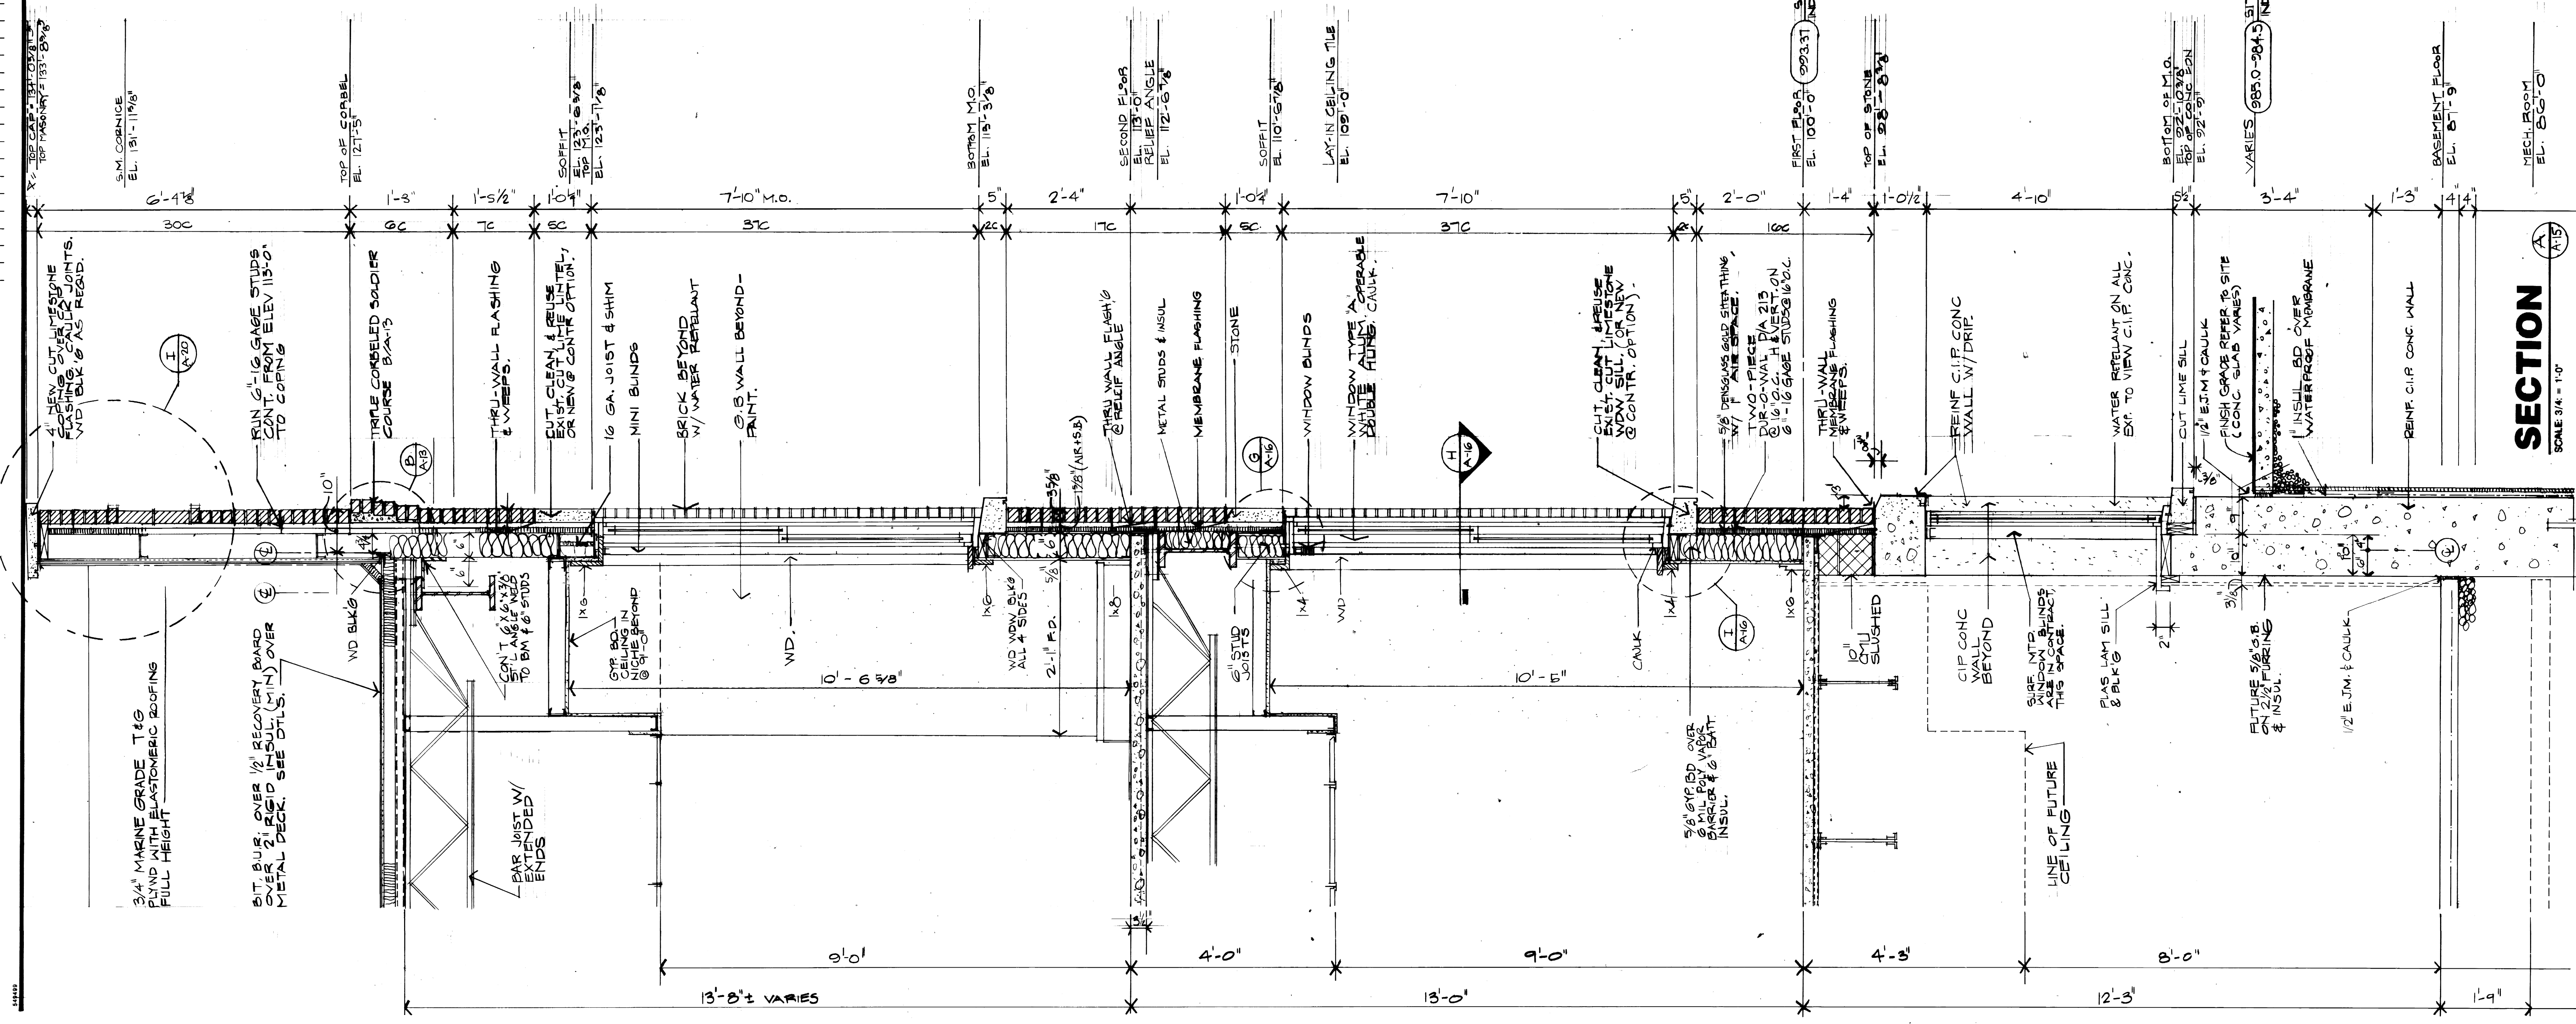

SCOVELL HALL RENOVATION


WALL SECTIONS @ 3/4"=1'-0"

002/24

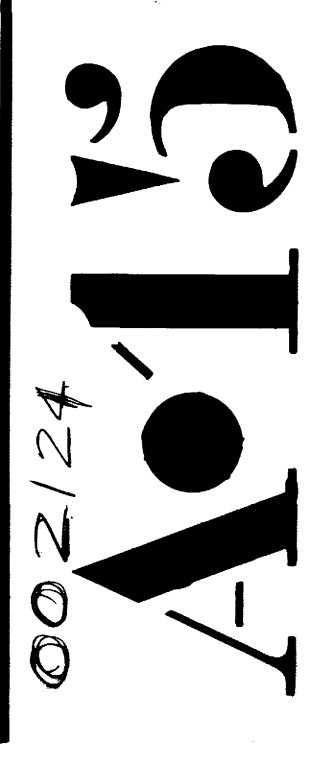

UNIVERSITY OF KENTUCKY
Design & Construction
Division
UNIVERSITY OF KENTUCKY
LEVINSON CENTER
CUB # 301
SHEL
A-3
000124

Omni
Architects

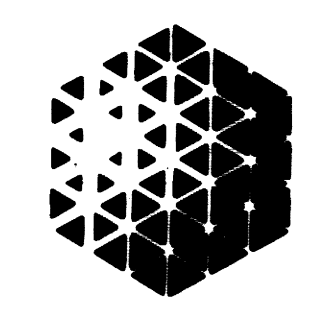


Architects
Landscape Architecture
Civil Engineering
Planning
Interior
212 North Upper Street
Lexington, Kentucky 40507
(606) 252-6644

Job No: _____ Date: _____ Drawn By: MWJ Checked: _____ Revisions: 7/21/94

UNIVERSITY OF KENTUCKY

AS-BUILT AUG. 10, 1995

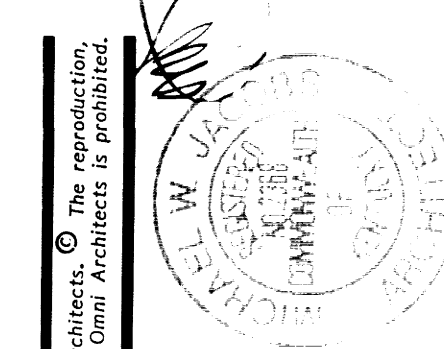

DOOR SCHEDULE

DOORS					FRAMES				
DOOR #	ROOM NAME/ROOM NO.	TYPE	SIZE	MATERIAL	FIRE RATING	TYPE	WIDTH	HEAD DETAIL	THRESHOLD
1	ELEV LOBBY LEVEL B	A	3'-0" x 7'-0"	HM	1-1/2 HR	C	5'-3/4"	E	E
2	CORRIDOR 015	A	3'-0" x 7'-0"	HM	1-1/2 HR	A	7'-1/8"	C	C
3	MECH/ELEC 005	B	3'-0" x 7'-0"	HM	1-1/2 HR	B	7'-1/8"	C	C
4	ELEV. MECH 004	B	3'-0" x 7'-0"	HM	1-1/2 HR	A	7'-1/8"	C	C
5	COMMUNICATIONS 003	B	3'-0" x 7'-0"	HM	1-1/2 HR	A	7'-1/8"	C	C
6	ELEV LOBBY LEVEL 1	A	3'-0" x 7'-0"	HM	1-1/2 HR	C	5'-3/4"	E	E
7	STAIR 022								
8	CORRIDOR 018	C	3'-0" x 7'-0"	HM	1 HR	C	5'-3/4"	A	A
9	CORRIDOR 019	C	3'-0" x 7'-0"	HM	1 HR	C	5'-3/4"	A	A
10	CORRIDOR 018	C	3'-0" x 7'-0"	HM	1 HR	C	5'-3/4"	A	A
51	FILE 012	B	3'-0" x 7'-0"	HM	20 MIN.	A	5'-7/8"	B	B

11	CORRIDOR 146	C	3'-0" x 7'-0"	HM	1 HR	C	5'-3/4"	A	A	11
12	CORRIDOR 144	C	3'-0" x 7'-0"	HM	1 HR	C	5'-3/4"	A	A	12
13	CORRIDOR 145	D	3'-0" x 7'-0"	HM	1 HR	D	5'-3/4"	F	F	13
14	OFFICE 105	B	3'-0" x 7'-0"	HM	1 HR	H	5'-3/4"	G	G	14
15	FOYER LEVEL 0 154	D	3'-0" x 7'-0"	HM	1 HR	E	5'-3/4"	H	H	15
16	ELEV LOBBY LEVEL G 107	A	3'-0" x 7'-0"	HM	1-1/2 HR	C	5'-3/4"	E	E	16
17	ELEV LOBBY LEVEL 1 108	A	3'-0" x 7'-0"	HM	1-1/2 HR	C	5'-3/4"	E	E	17
18	OFFICE 106	A	3'-0" x 7'-0"	HM	1 HR	C	5'-3/4"	E	E	18
19	WAITING/ENTRY 113	A	3'-0" x 7'-0"	HM	1-1/2 HR	C	5'-3/4"	E	E	19
20	WAITING/ENTRY 113	A	3'-0" x 7'-0"	HM	20 MIN	F	5'-7/8"	B	B	20
21	RECEPTION 114	F	3'-0" x 7'-0"	SCWD		C	5'-3/4"	E	E	21
22	OFFICE 125	E	3'-0" x 7'-0"	SCWD		A	5'-7/8"	B	B	22
23	BREAKROOM 101	F	3'-0" x 7'-0"	SCWD	20 MIN	A	5'-7/8"	B	B	23
24	OFFICE 104	F	3'-0" x 7'-0"	SCWD		A	5'-7/8"	B	B	24
25	CONFERENCE 103	G	3'-0" x 7'-0"	SCWD		A	5'-7/8"	B	B	25
26	WOMEN 109	E	3'-0" x 7'-0"	SCWD	20 MIN	C	5'-3/4"	E	E	26
27	MEN 110	E	3'-0" x 7'-0"	SCWD	20 MIN	C	5'-3/4"	E	E	27
28	JANITOR 102	B	3'-0" x 7'-0"	HM	1 HR	A	5'-7/8"	B	B	28
29	OFFICE 141	F	3'-0" x 7'-0"	SCWD		C	5'-3/4"	E	E	29
30	H.R. ADMINISTRATION	F	3'-0" x 7'-0"	SCWD		A	5'-7/8"	B	B	30
31	STAIR 153									31
50	CORRIDOR 149	C	3'-0" x 7'-0"	HM	1 HR	B	7'-1/8"	C	C	50


32	CORRIDOR 217	C	3'-0" x 7'-0"	HM	1 HR	A	7'-1/8"	C	C	32
33	CORRIDOR 219	C	3'-0" x 7'-0"	HM	1 HR	B	7'-1/8"	C	C	33
34	CORRIDOR 220	E	3'-0" x 7'-0"	SCWD	20 MIN	A	5'-7/8"	B	B	34
35	STORAGE 201	E	3'-0" x 7'-0"	SCWD	20 MIN	A	5'-7/8"	B	B	35
36	KITCHENETTE 202	G	3'-0" x 7'-0"	SCWD	20 MIN	A	5'-7/8"	B	B	36
37	NO. 1 - COMPUTER 203	E	3'-0" x 7'-0"	SCWD	20 MIN	A	5'-7/8"	B	B	37
38	NO. 2 - SATELLITE 204	E	3'-0" x 7'-0"	SCWD	20 MIN	A	5'-7/8"	B	B	38
39	NO. 3 - CONFERENCE 205	E	3'-0" x 7'-0"	SCWD	20 MIN	A	5'-7/8"	B	B	39
40	NO. 4 - 206	E	3'-0" x 7'-0"	SCWD	20 MIN	A	5'-7/8"	B	B	40
41	NO. 5 - 207	E	3'-0" x 7'-0"	SCWD	20 MIN	A	5'-7/8"	B	B	41
42	NO. 6 - 208	E	3'-0" x 7'-0"	SCWD	20 MIN	A	5'-7/8"	B	B	42
43	NO. 7 - VIDEO 209	E	3'-0" x 7'-0"	SCWD	20 MIN	A	5'-7/8"	B	B	43
44	AV STORAGE 210	E	3'-0" x 7'-0"	SCWD	20 MIN	C	5'-3/4"	E	E	44
45	ELEV LOBBY LEVEL 2 11	A	3'-0" x 7'-0"	HM	1-1/2 HR	C	5'-3/4"	E	E	45
46	MEN 213	E	3'-0" x 7'-0"	SCWD	20 MIN	C	5'-3/4"	E	E	46
47	WOMEN 212	E	3'-0" x 7'-0"	SCWD	20 MIN	C	5'-3/4"	E	E	47
48	JANITOR 200	B	3'-0" x 7'-0"	HM	1 HR	C	5'-3/4"	E	E	48
49	STAIR 226									49

LEGEND



SCWD - SOLID CORE WOOD
HM - HOLLOW METAL

NOTES



- FULL EXTERIOR WEATHERSTRIPPING INCLUDING THRESHOLDS
- PUSH-BUTTON OPERATORS FOR RESTROOM DOORS IS AN ALTERNATE
- SOUND WEATHERSTRIPPING FOR ALL TRAINING ROOMS
- PUSH-BUTTON DOOR OPERATORS AT ELEV. LOBBY DOORS
- DOORS AND HARDWARE TO BE CONNECTED TO ELECTRIC HOLD OPEN DEVICES
- USE JAMB FILLERS IF REQUIRED
- VERIFY ALL FRAMES FOR EXISTING WALL CONSTRUCTION

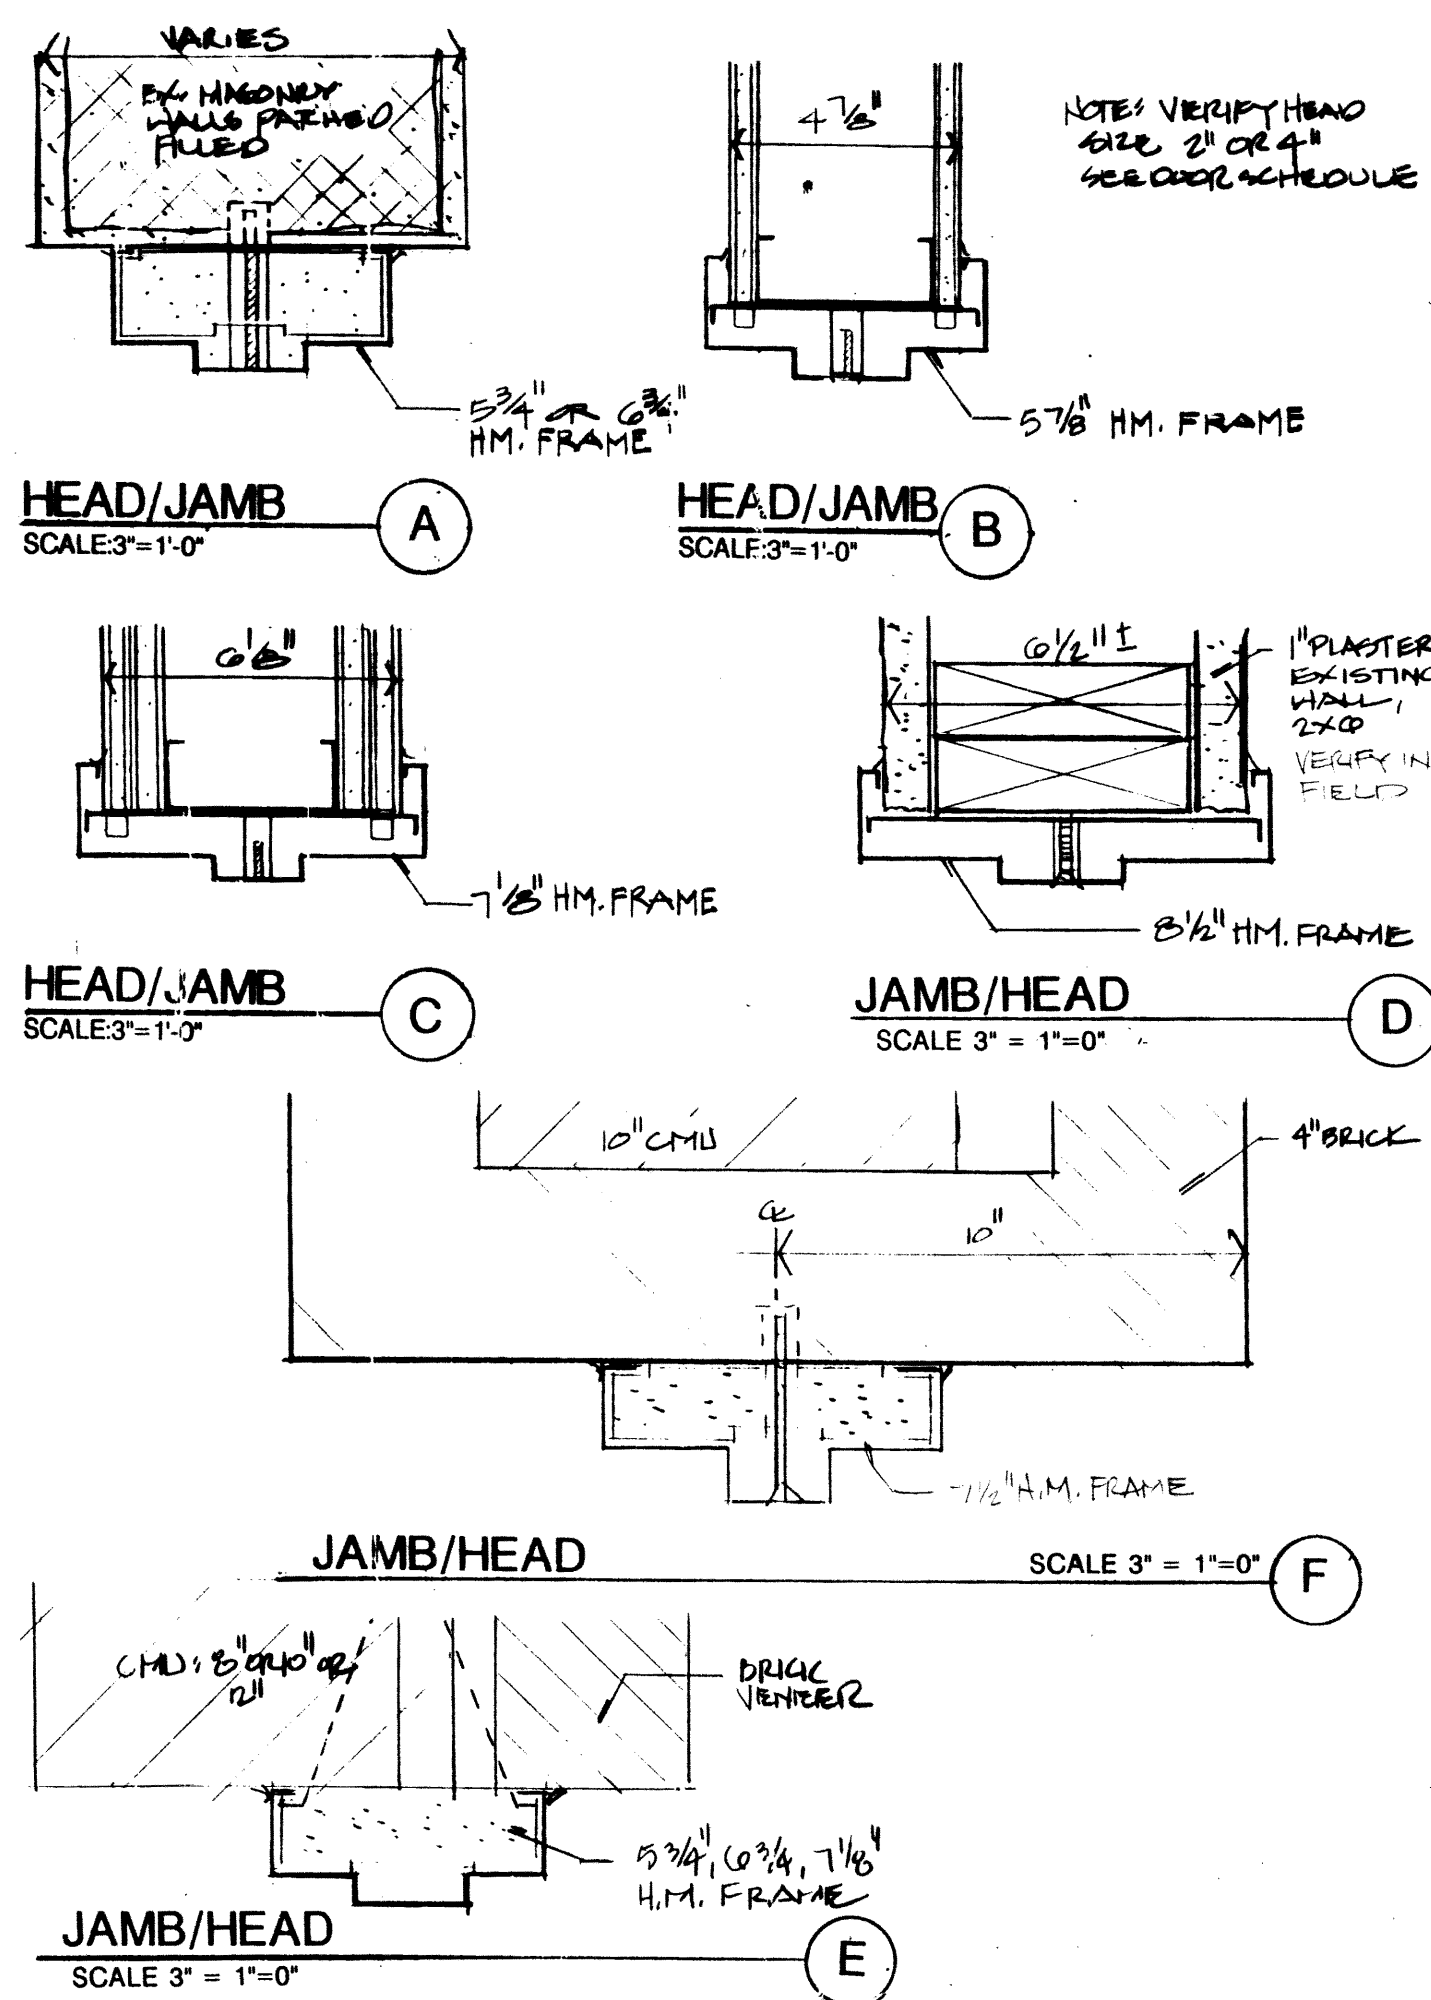


DOOR TYPES

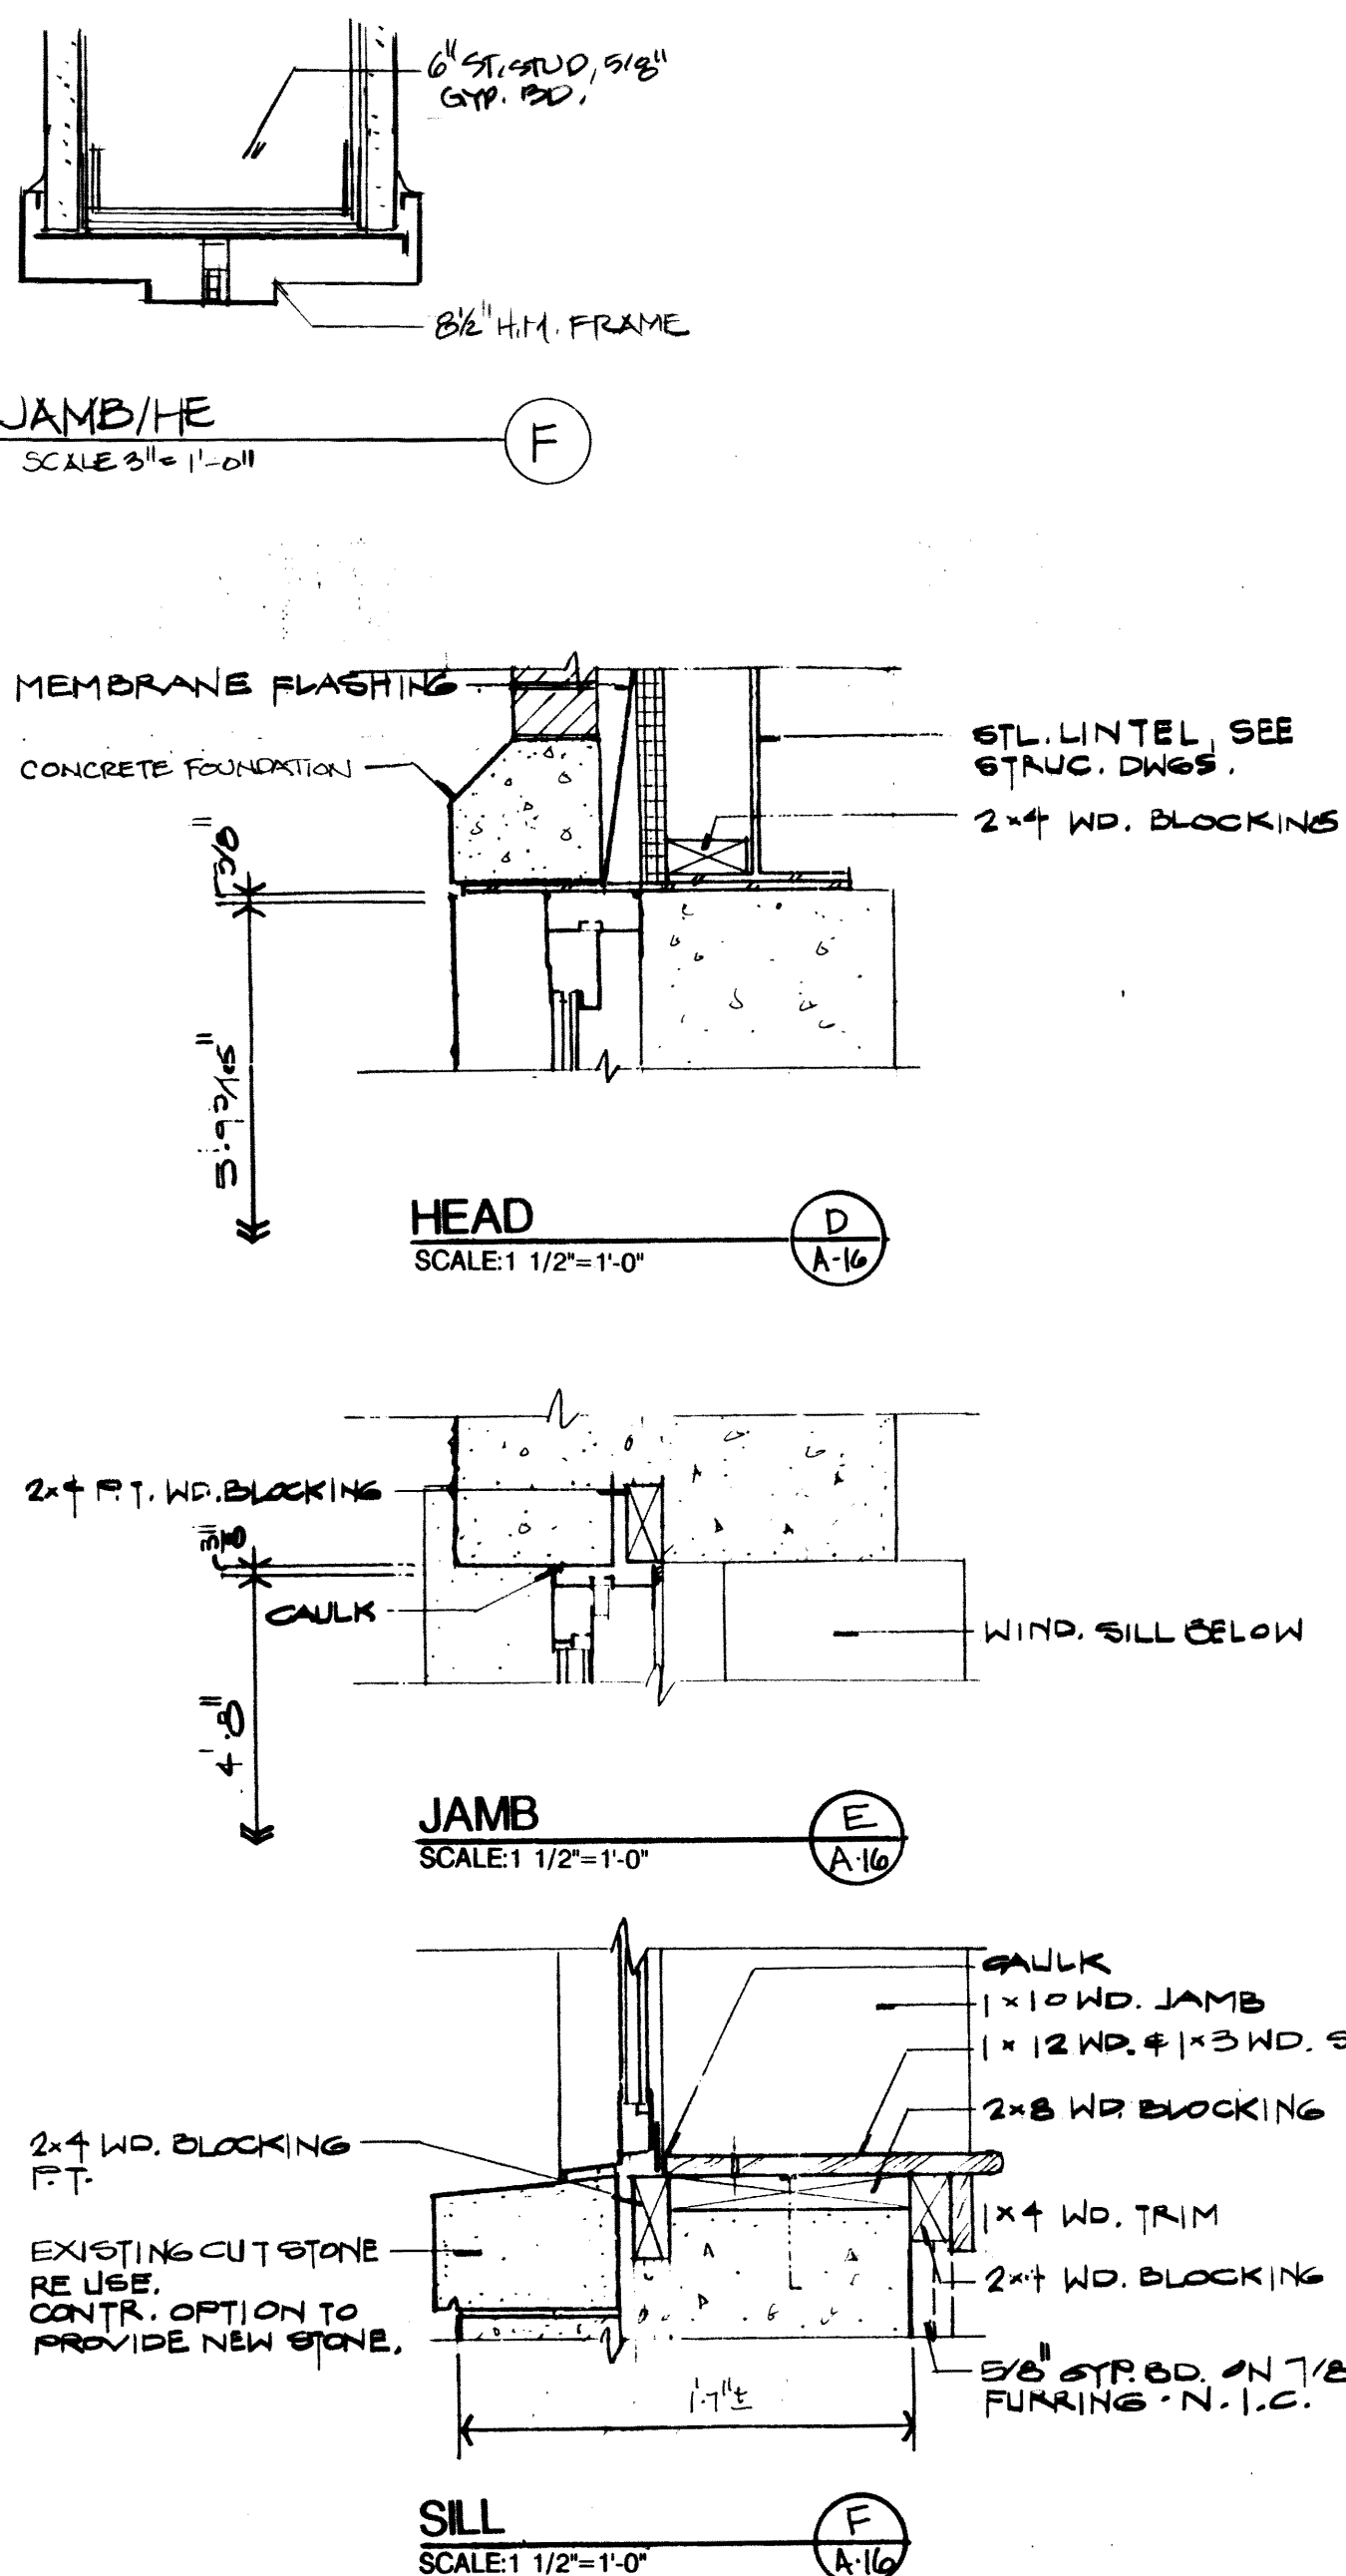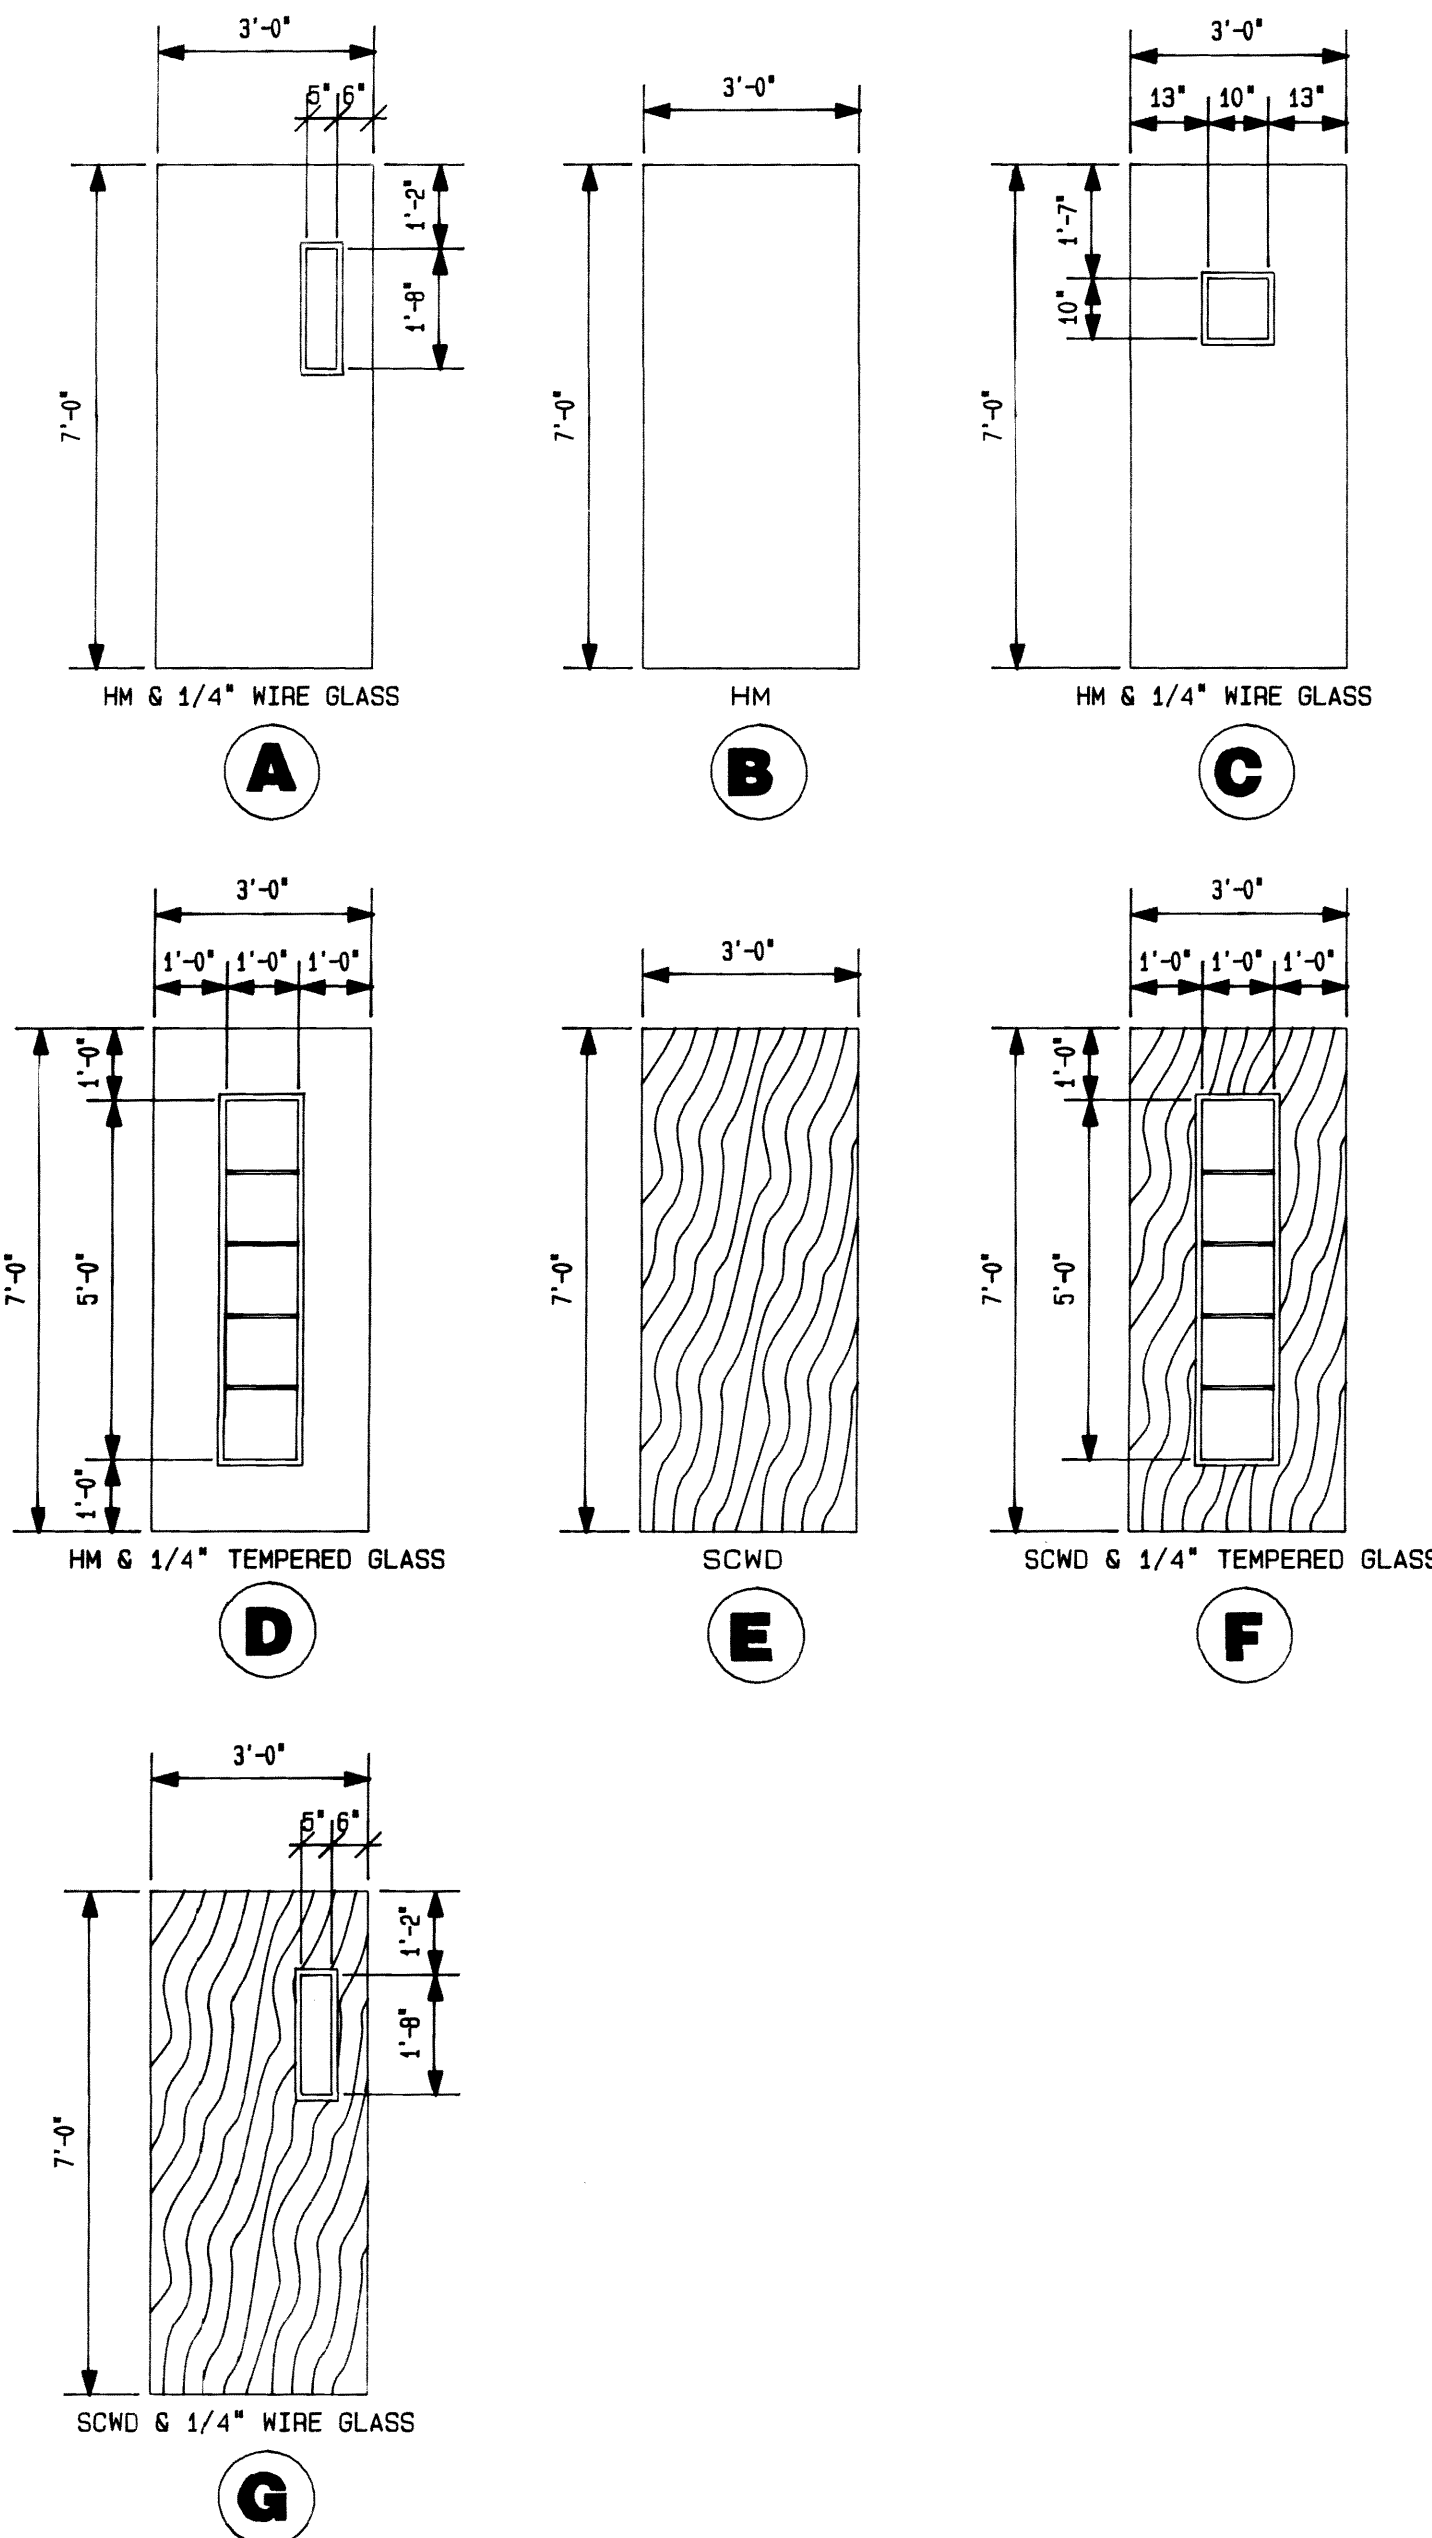

FRAME TYPES

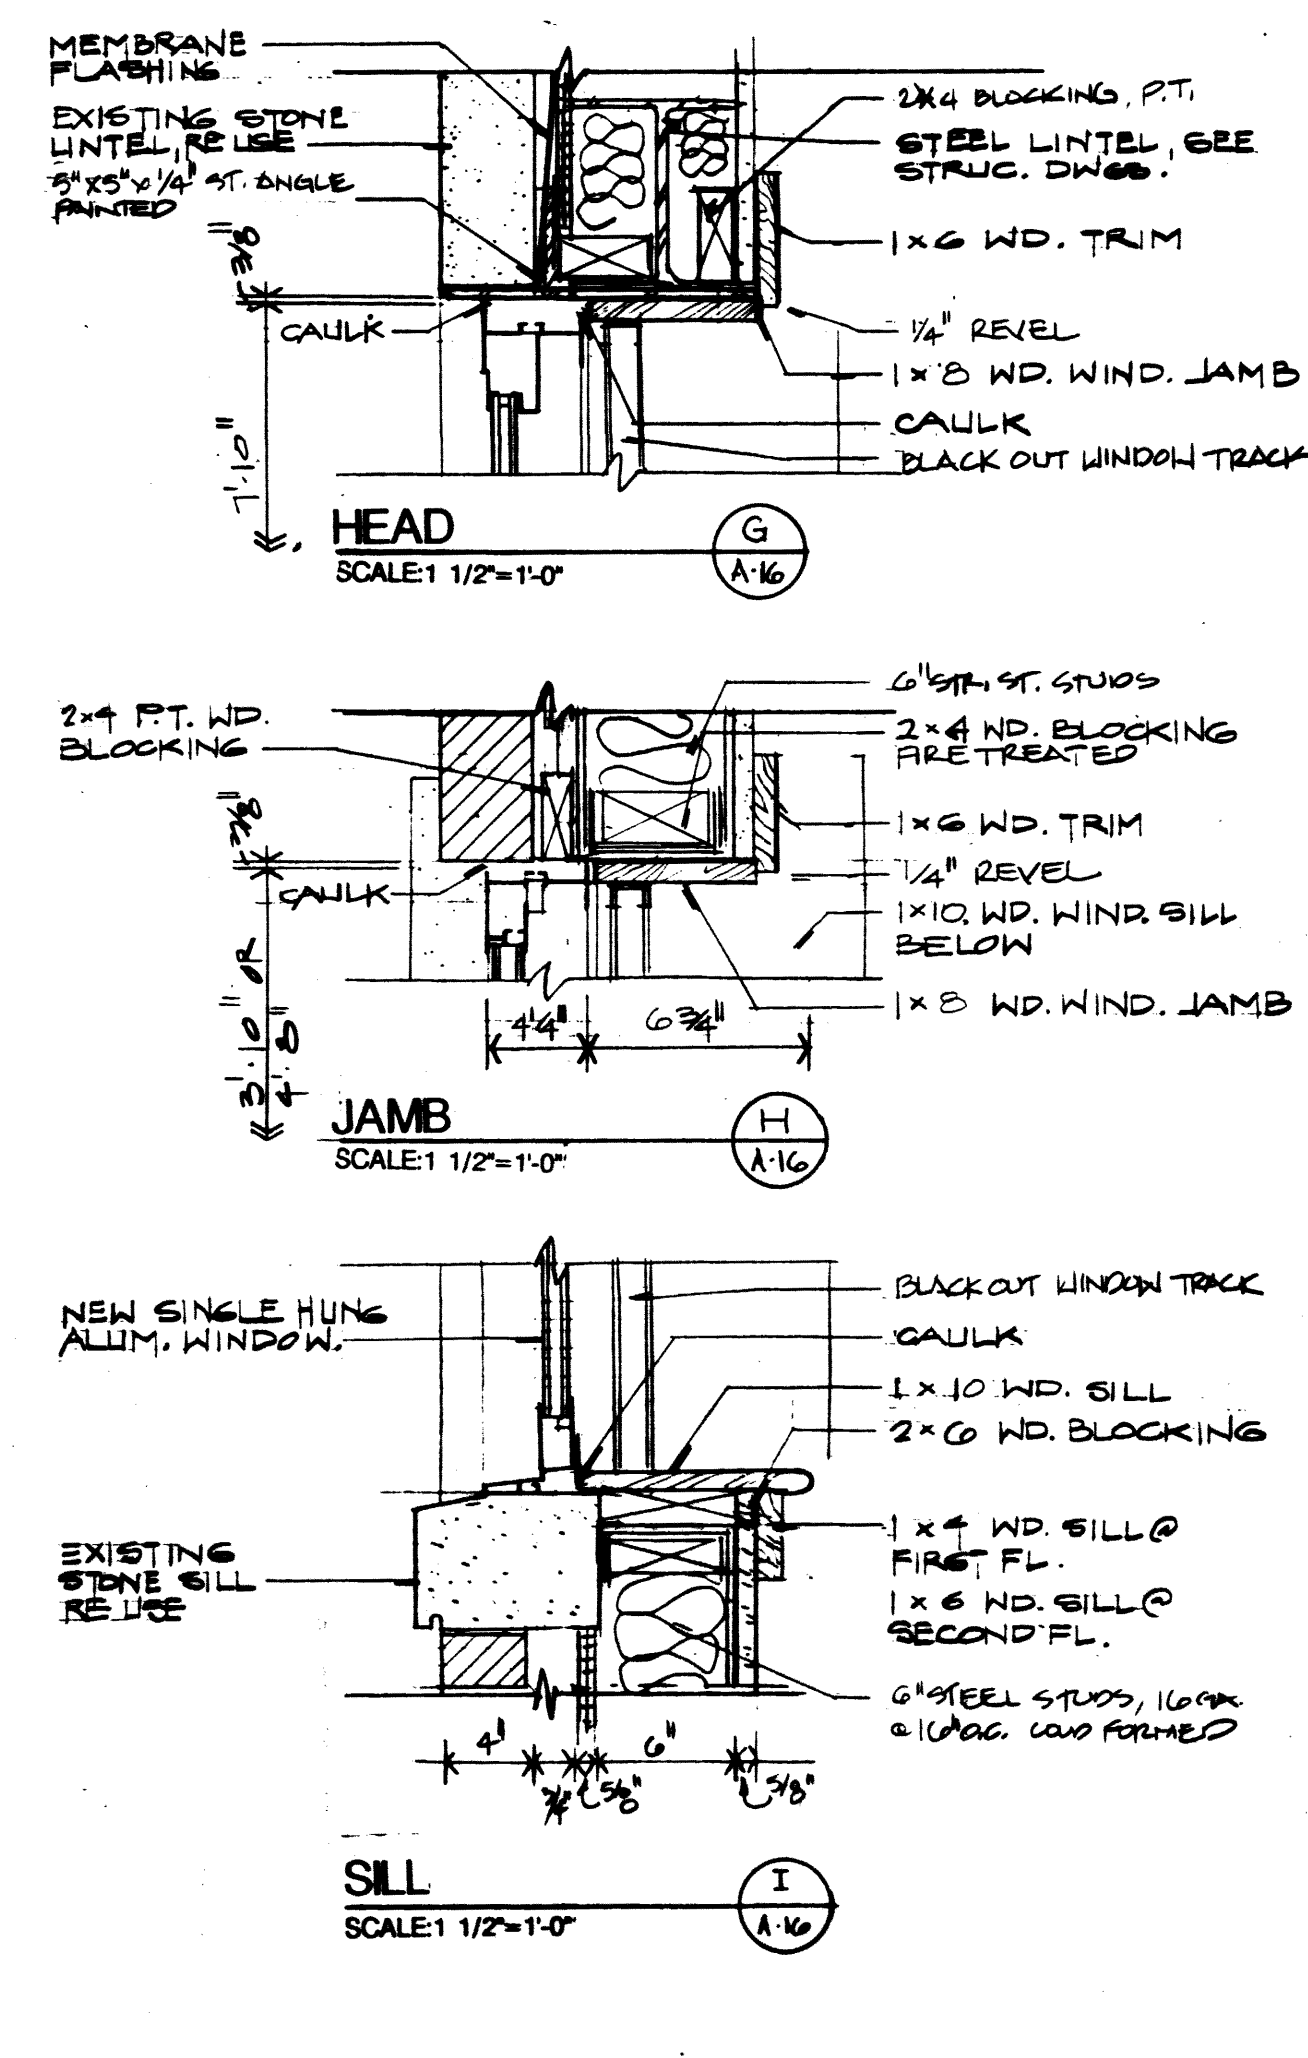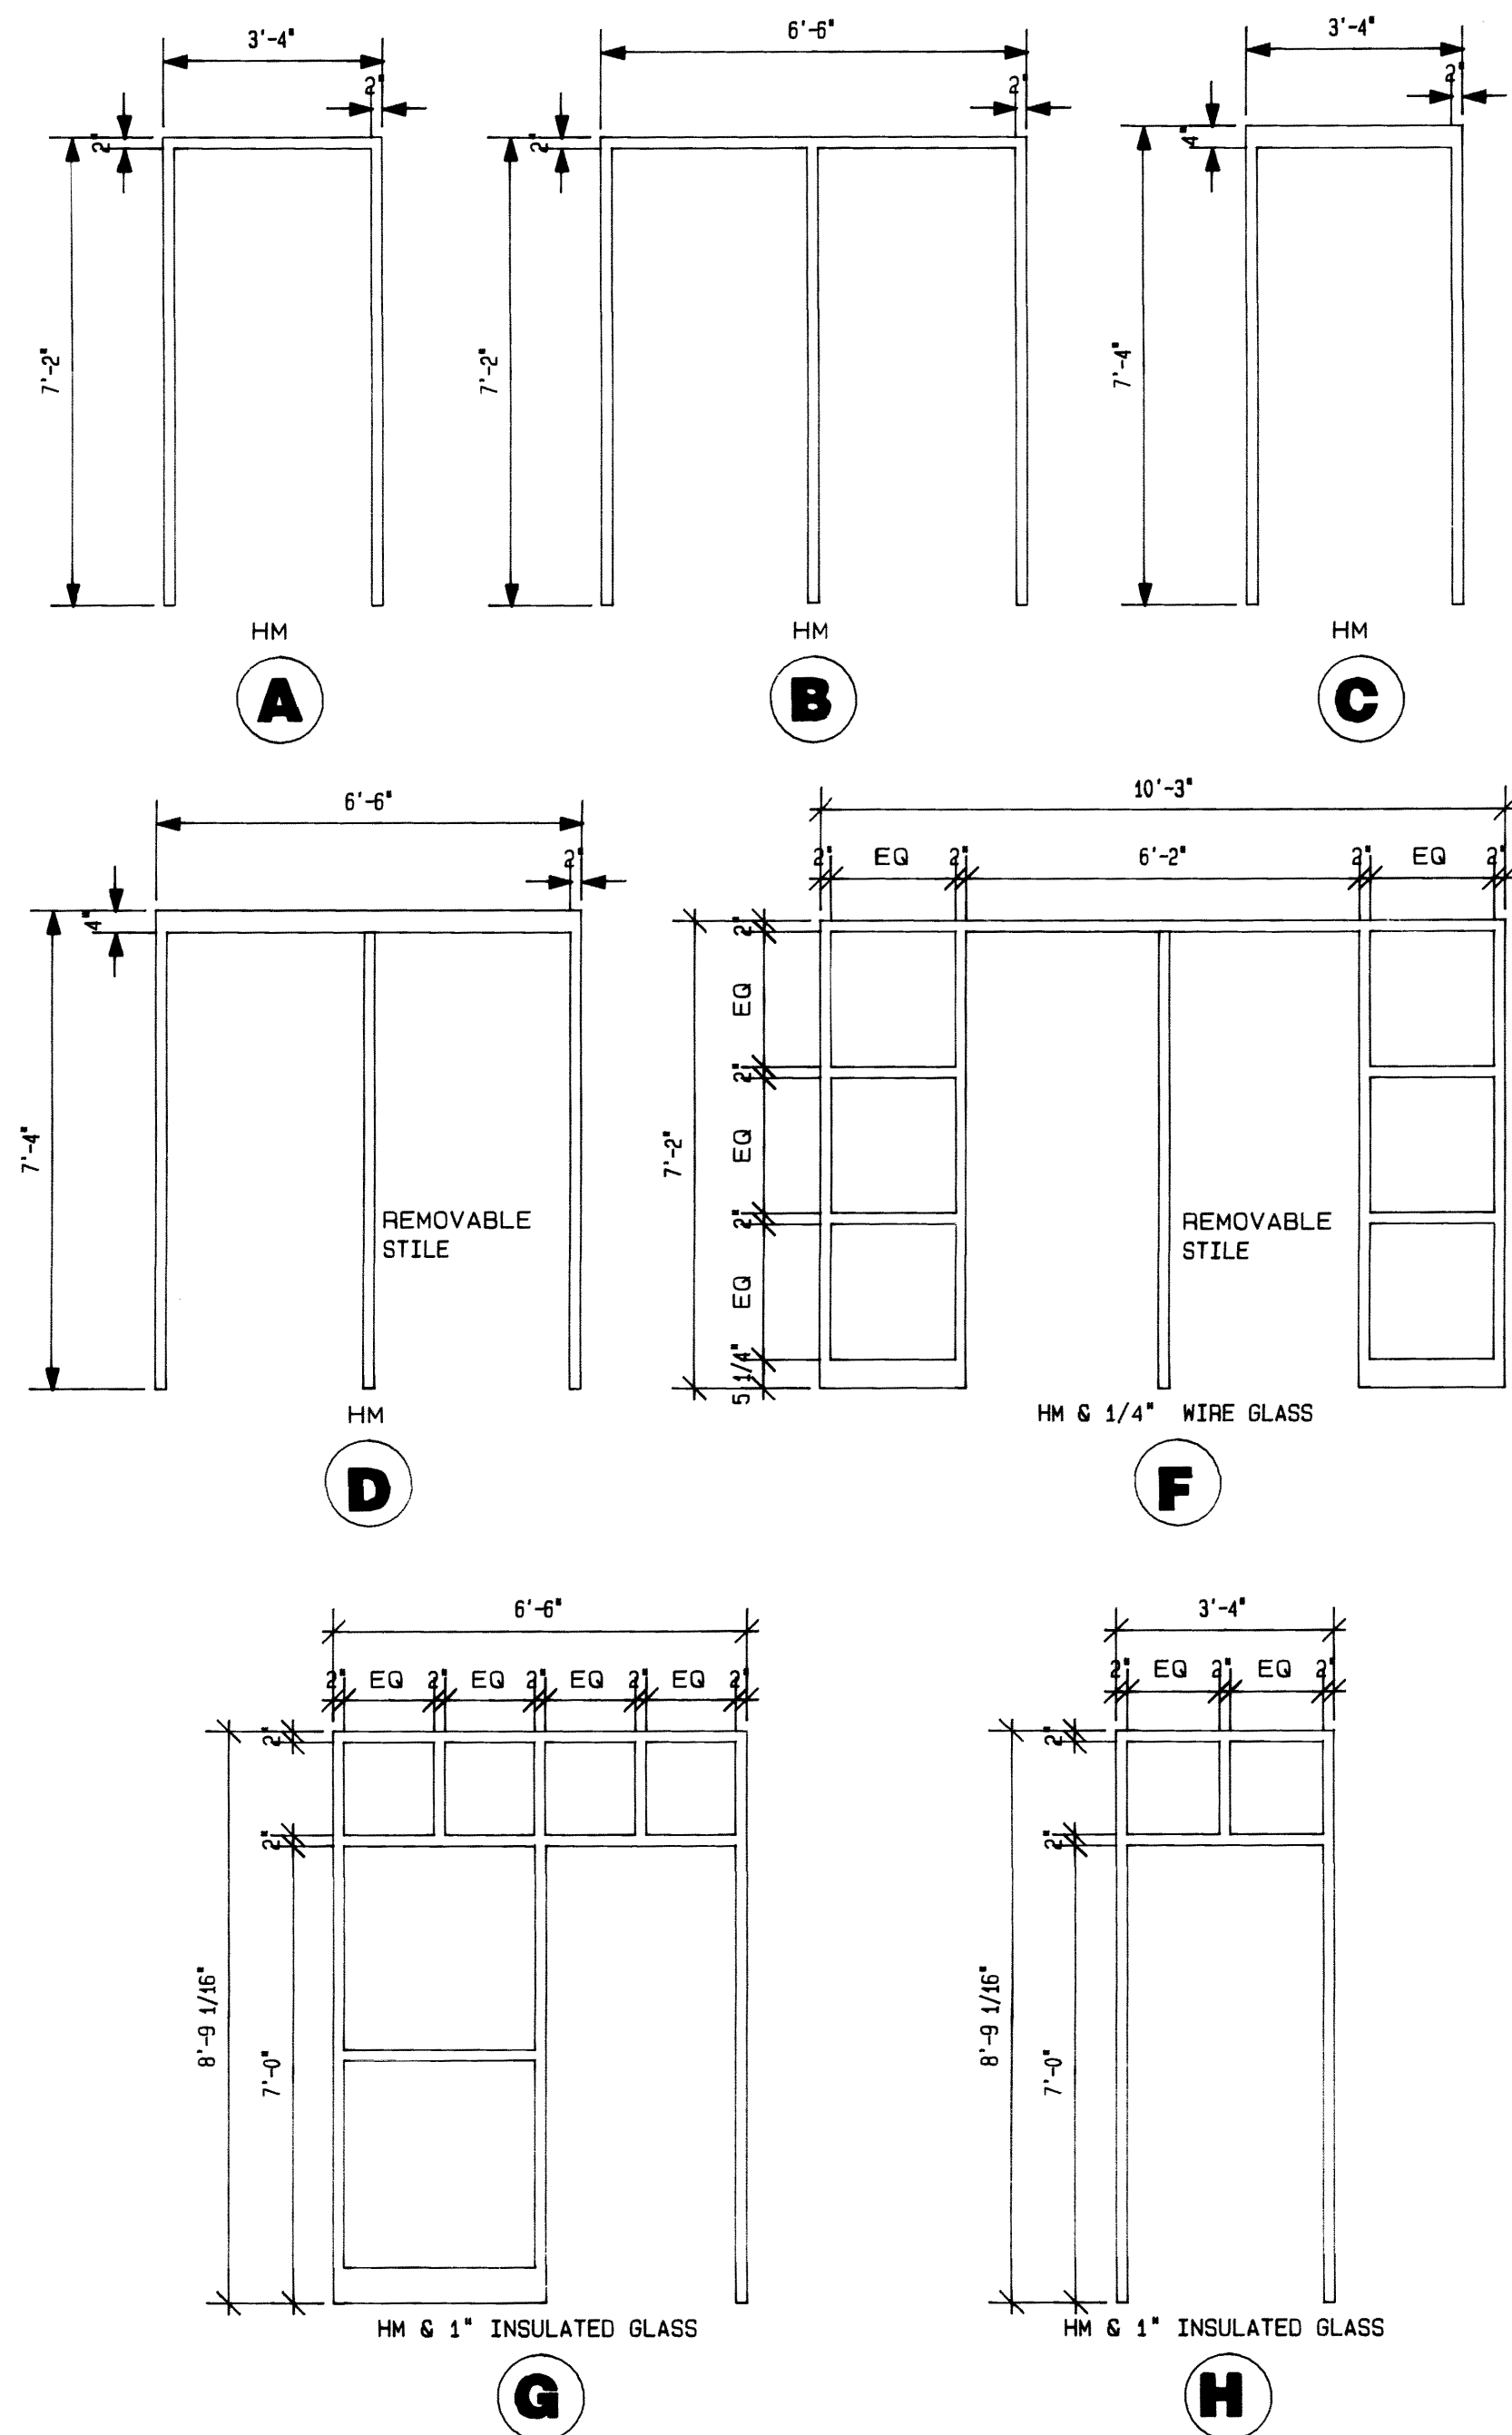

WINDOW TYPES

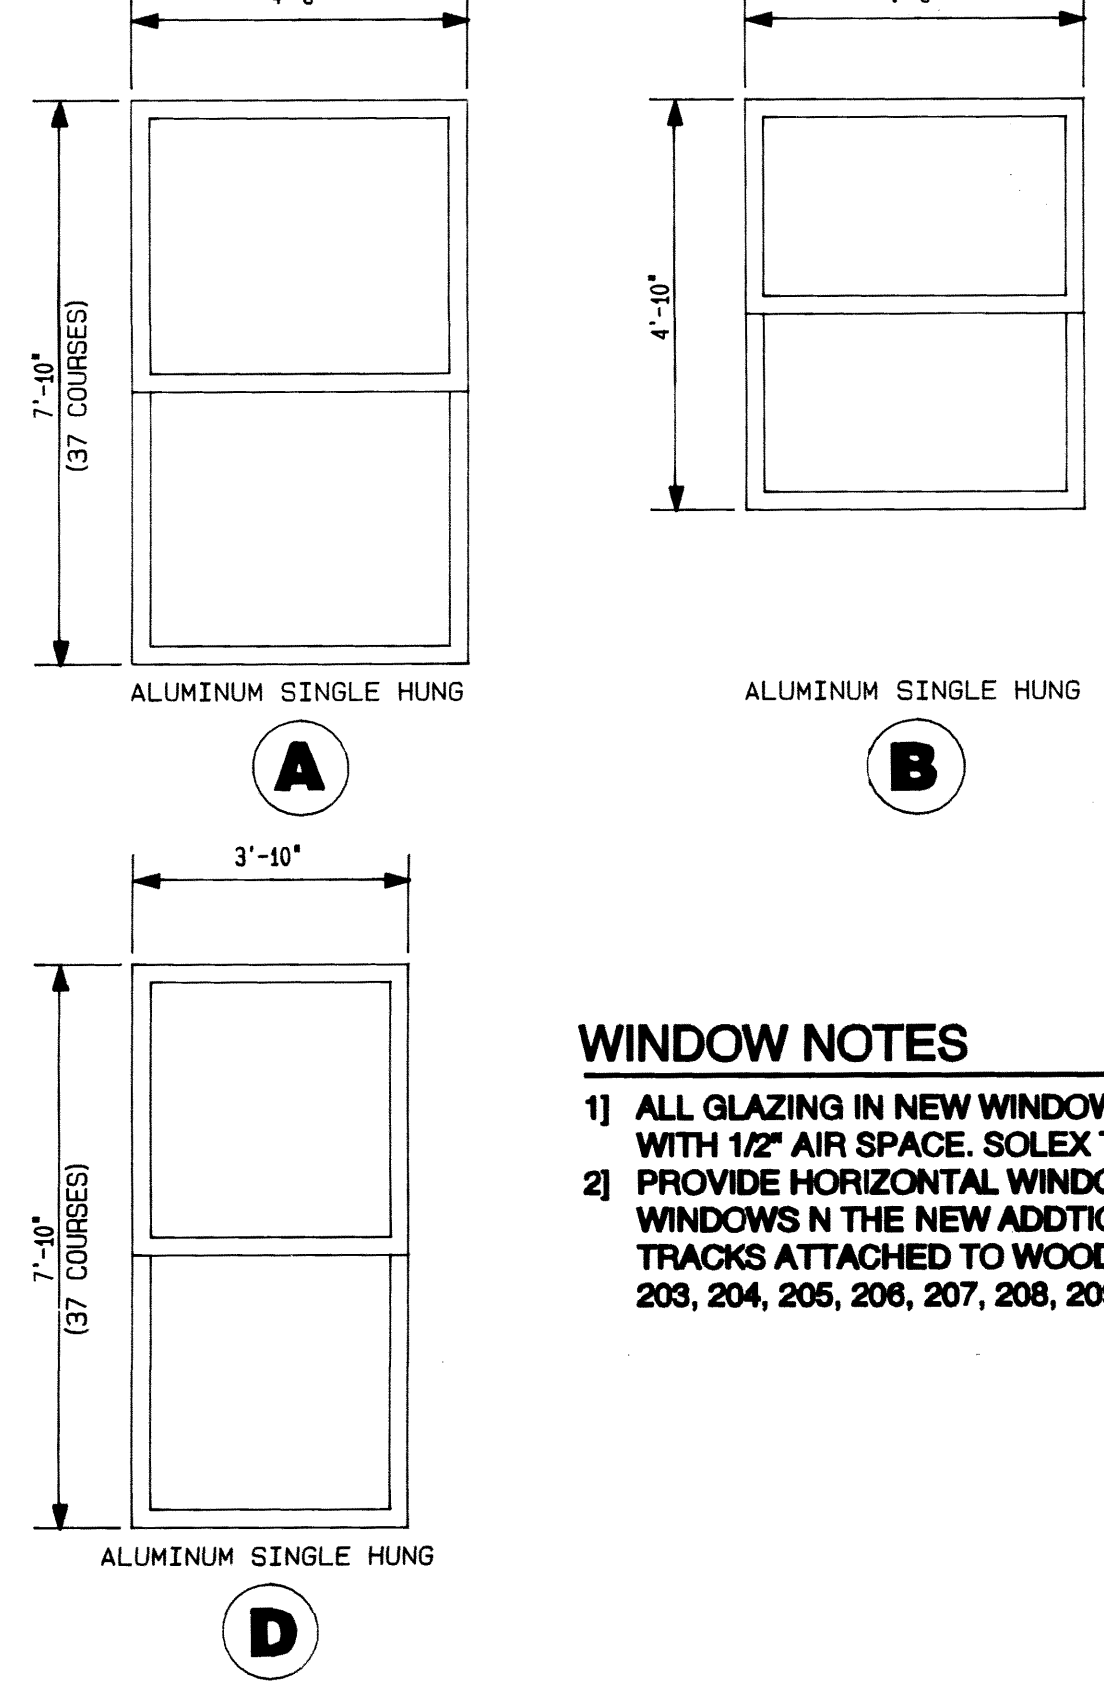

WINDOW NOTES


- ALL GLAZING IN NEW WINDOWS WILL BE 1/4" GLASS WITH 1/2" AIR SPACE. SOLEX TINTED GLAZING.
- PROVIDE HORIZONTAL WINDOW BLINDS FOR ALL WINDOWS IN THE NEW ADDITION. PROVIDE BLACK-OUT TRACKS ATTACHED TO WOOD CASING IN ROOMS 203, 204, 205, 206, 207, 208, 209.

A-A

WINDOW TYPE A-A NEW ALUM. WINDOW TO MATCH TYPE A ABOVE TO FIT EXISTING MASONRY OPENINGS. VERIFY SITE DIMENSIONS

A-R

EXISTING WOOD WINDOW TO BE REPAIRED IN THE 1903 OR 1911 SECTIONS. SEE RENOVATION NOTES ON ELEVATIONS. EXISTING GLASS IS TO BE REMAIN IN PLACE. CLEAN LOOSE PAINT AND GLAZING COMPOUND FROM SASHES AND FRAMES. SEAL GLASS TO SASHES WITH SEALANT AS NP-1 SOANBORNE. PREPARE FRAME, SASHES AND GLASS FOR PAINTING. PRIME WITH SPECIALIZED PAINTED WOOD PRIMER. FINISH PAINT. AA

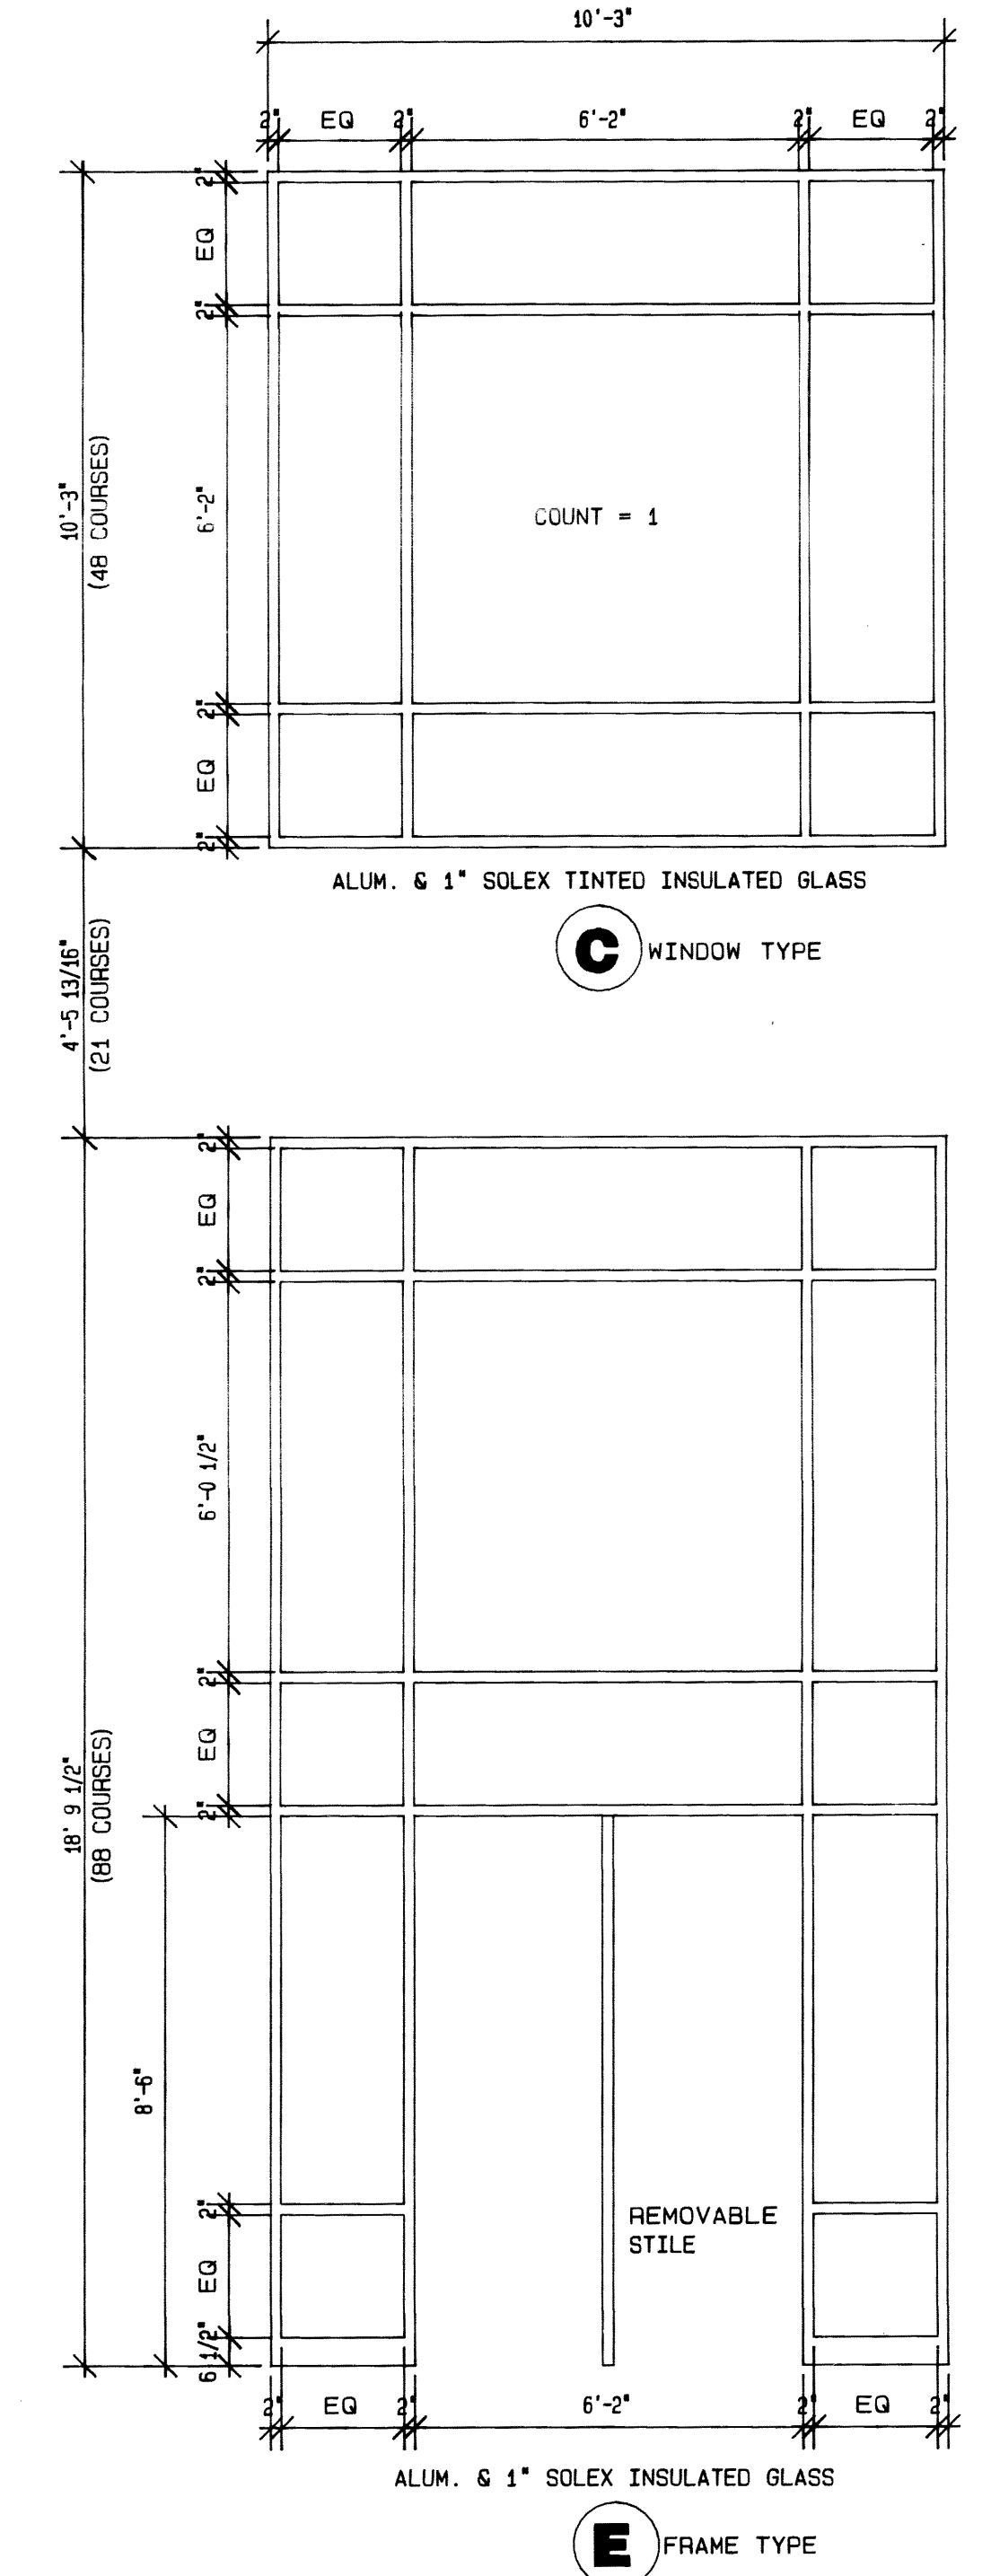

UNIVERSITY OF KENTUCKY

SCOVELL HALL RENOVATION

AS-BUILT AUG. 10, 1995


Omni Architects

Doors & Windows


002125

A-16


002125

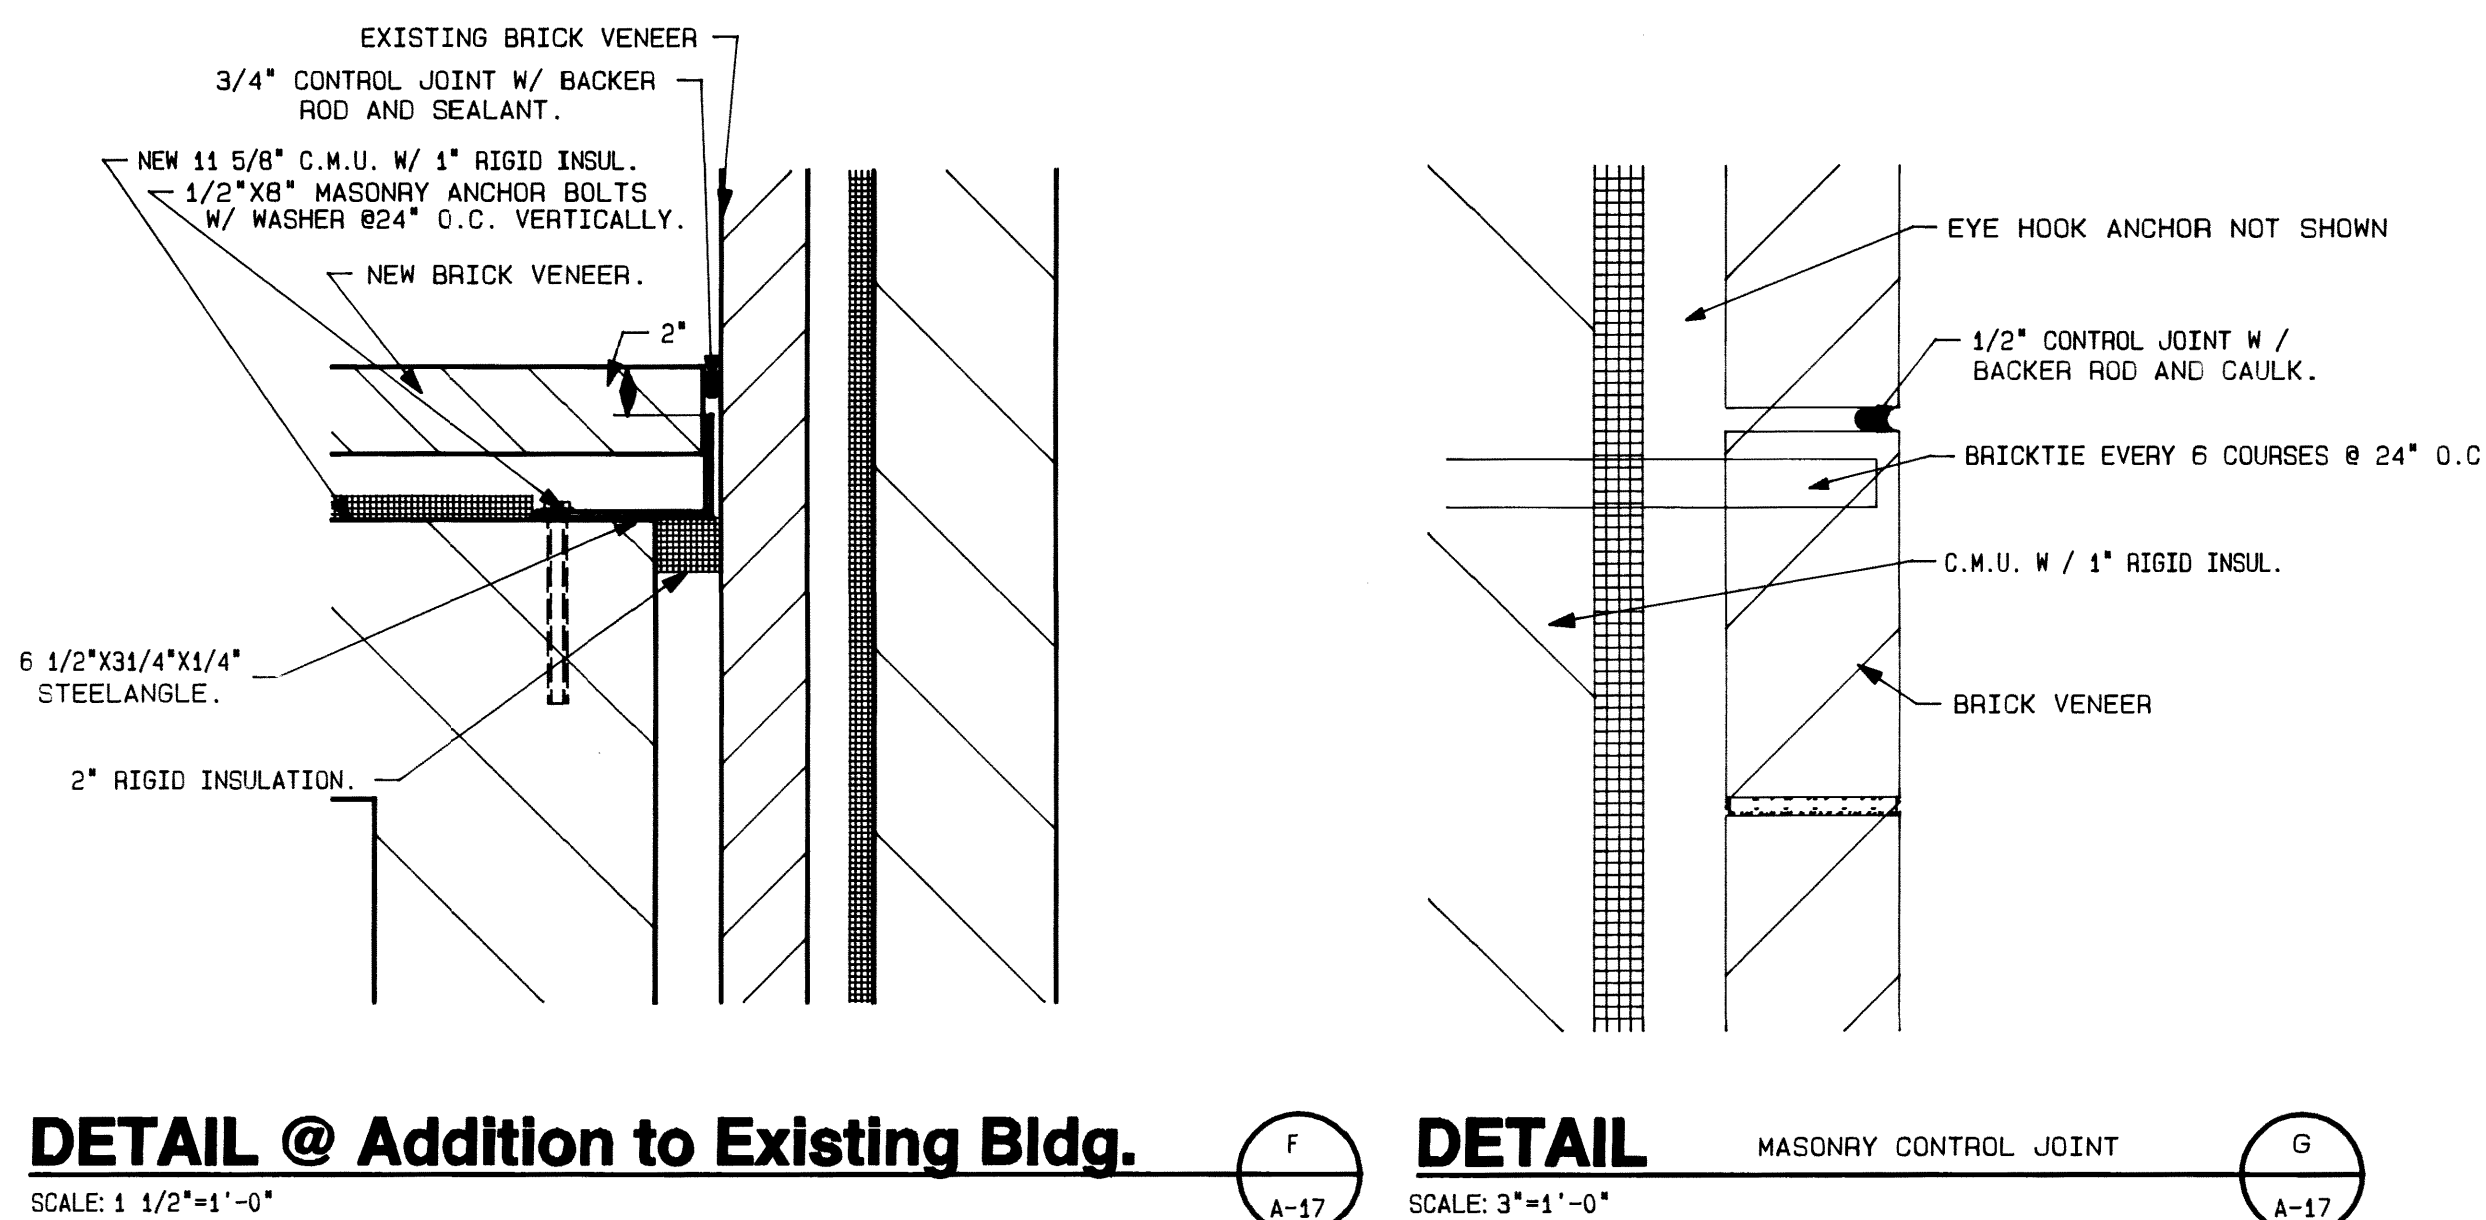

SCALE: $1/4" = 1'-0"$



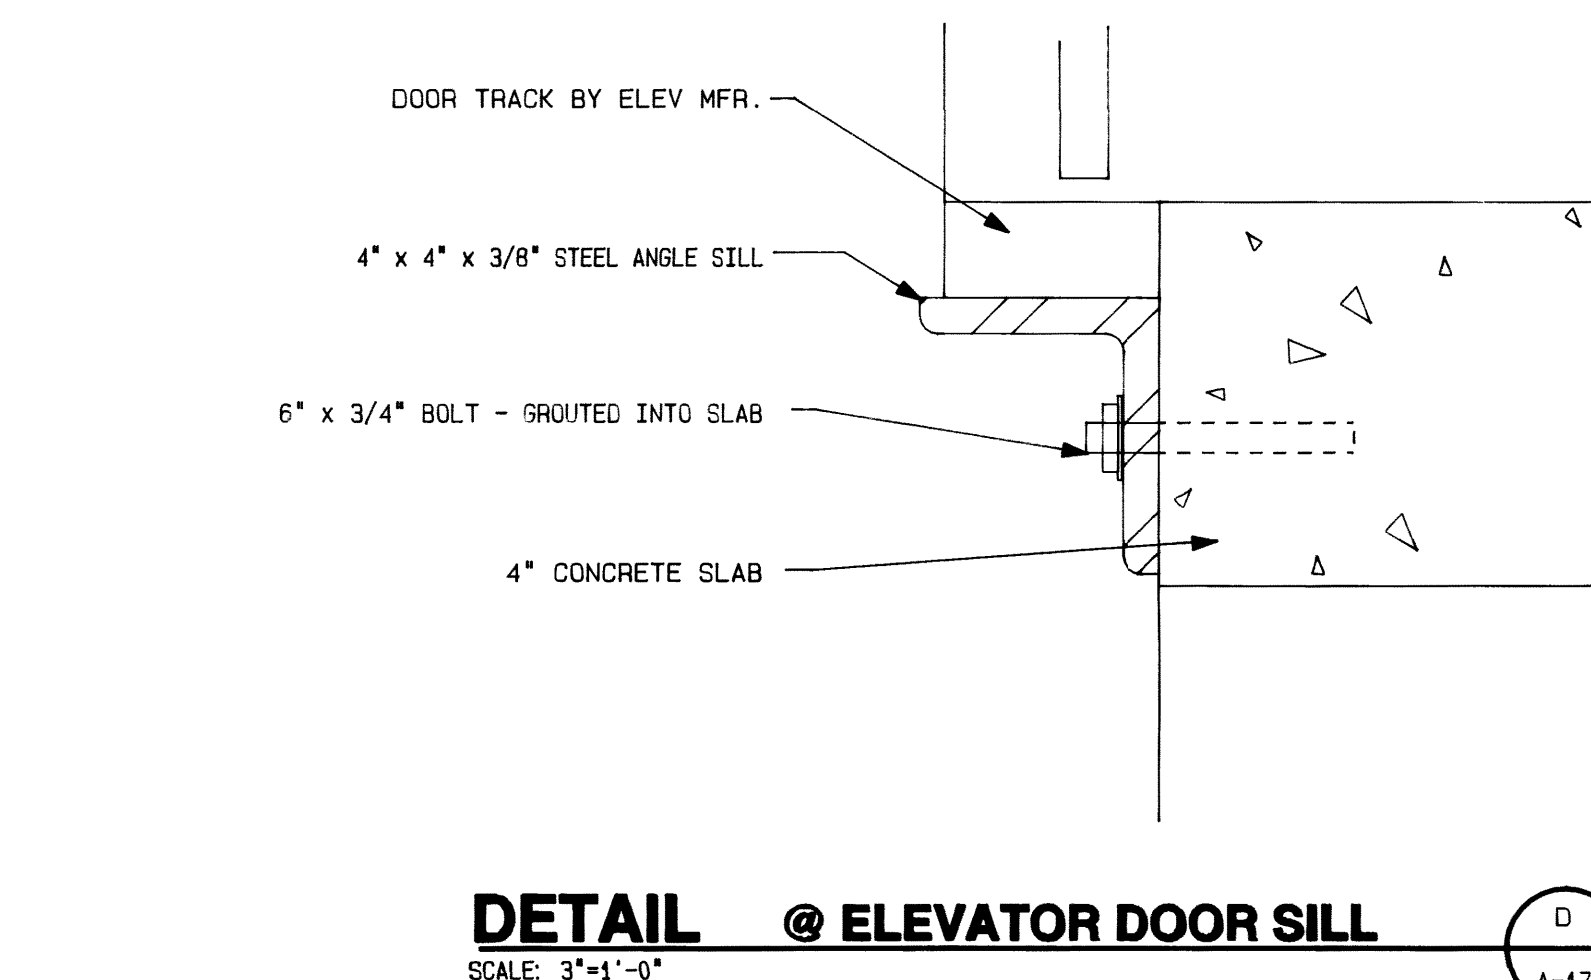


SCALE: 3"=1'-0"

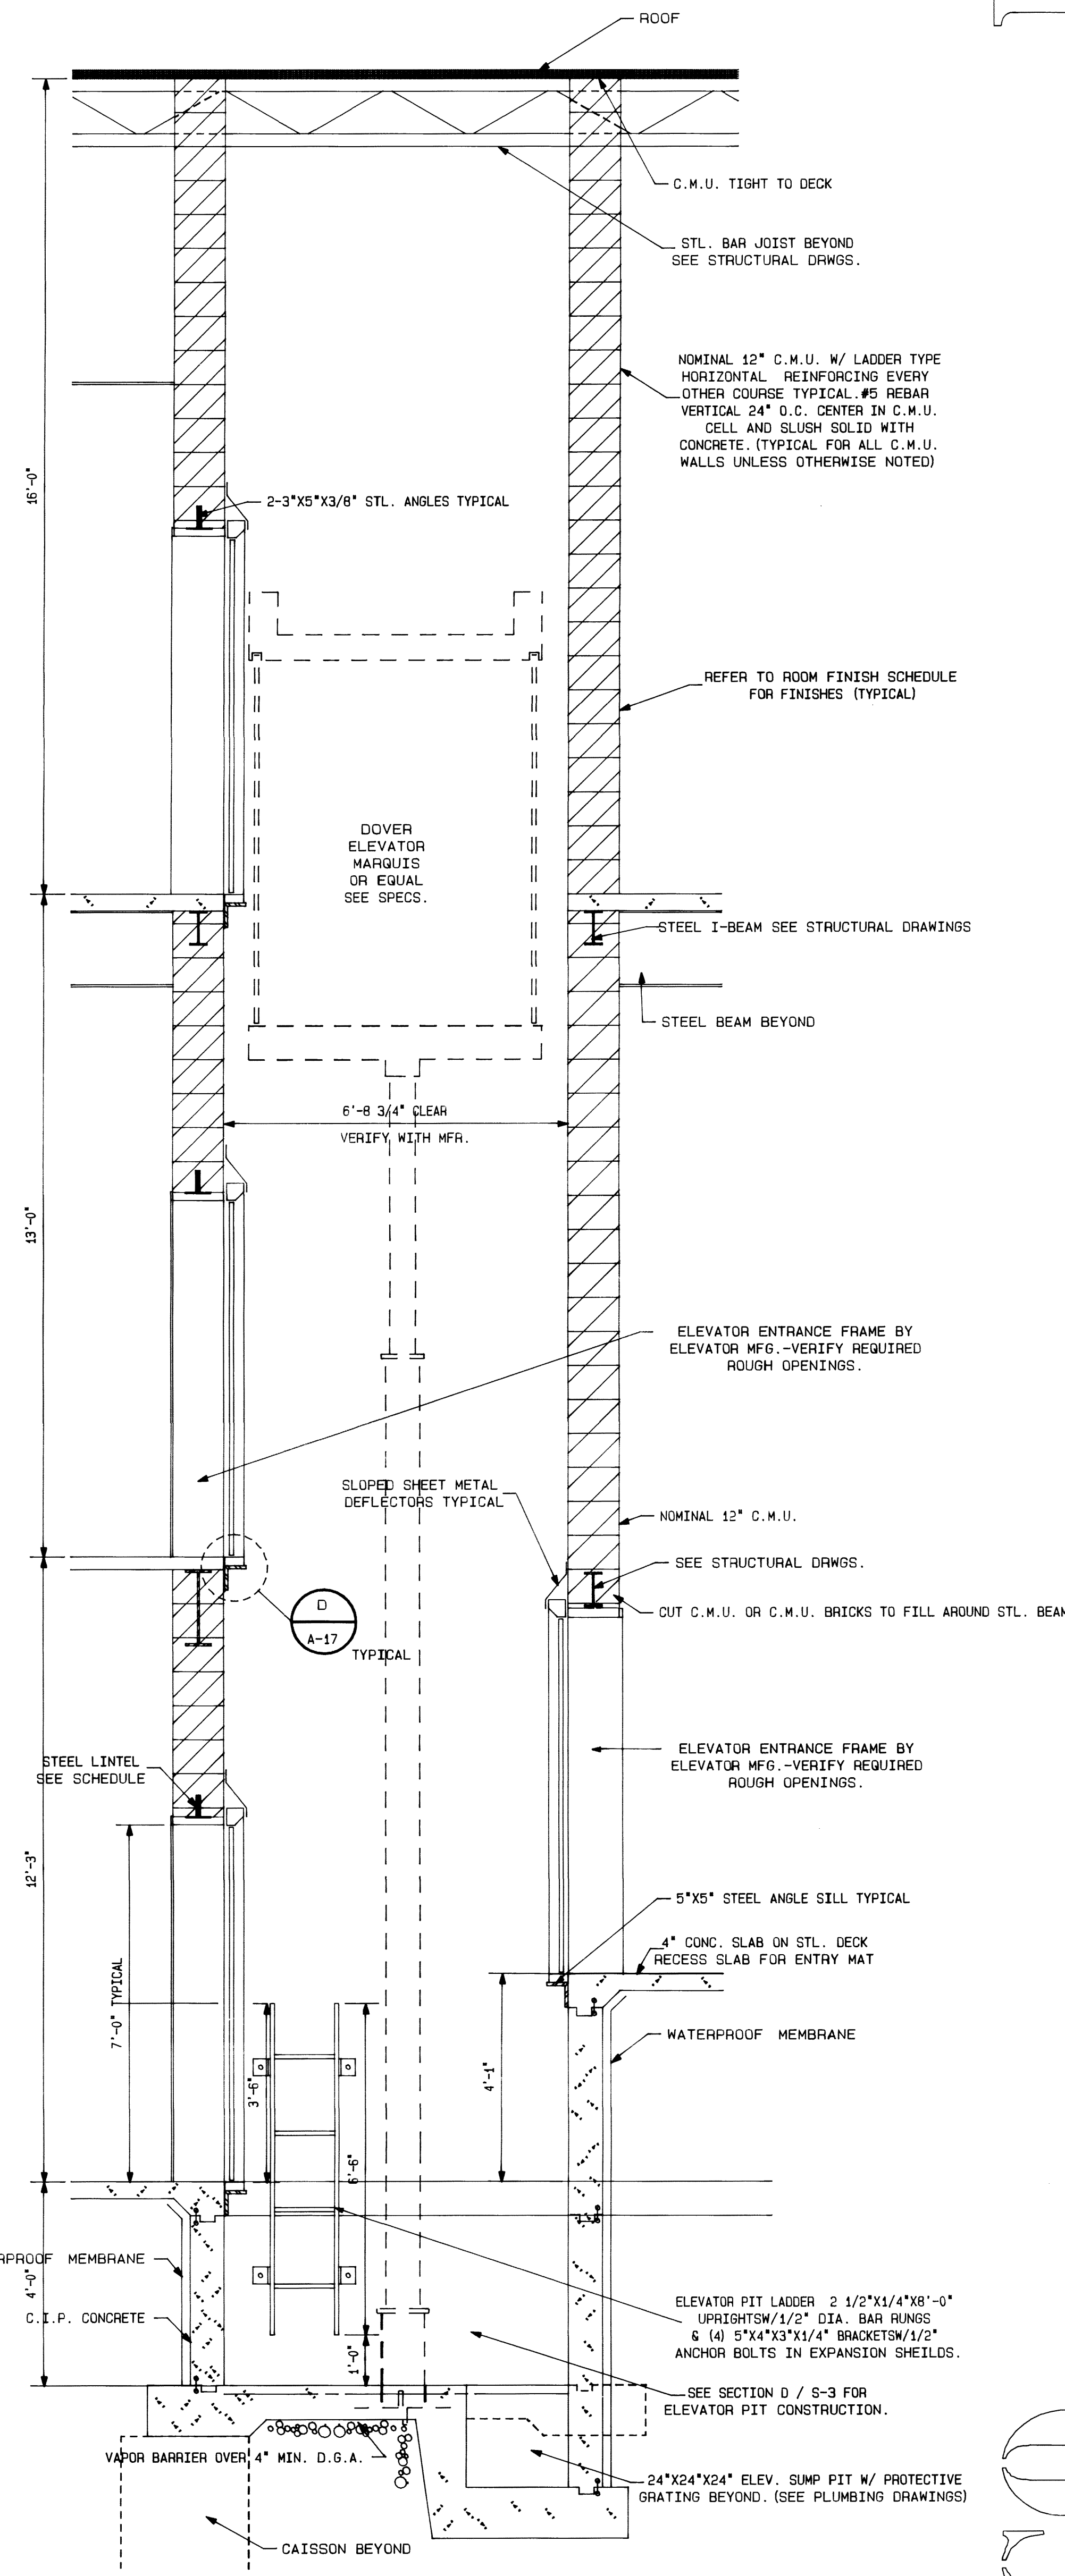

SCALE: $1/2'' = 1'-0''$

NOTE: GENERAL CONTRACTOR SHALL COORDINATE WITH ASSOCIATED TRADES TO PROVIDE CHASES AND OPENINGS IN WALLS NEEDED FOR ELEVATOR AND ELEVATOR EQUIPMENT INSTALLATION.

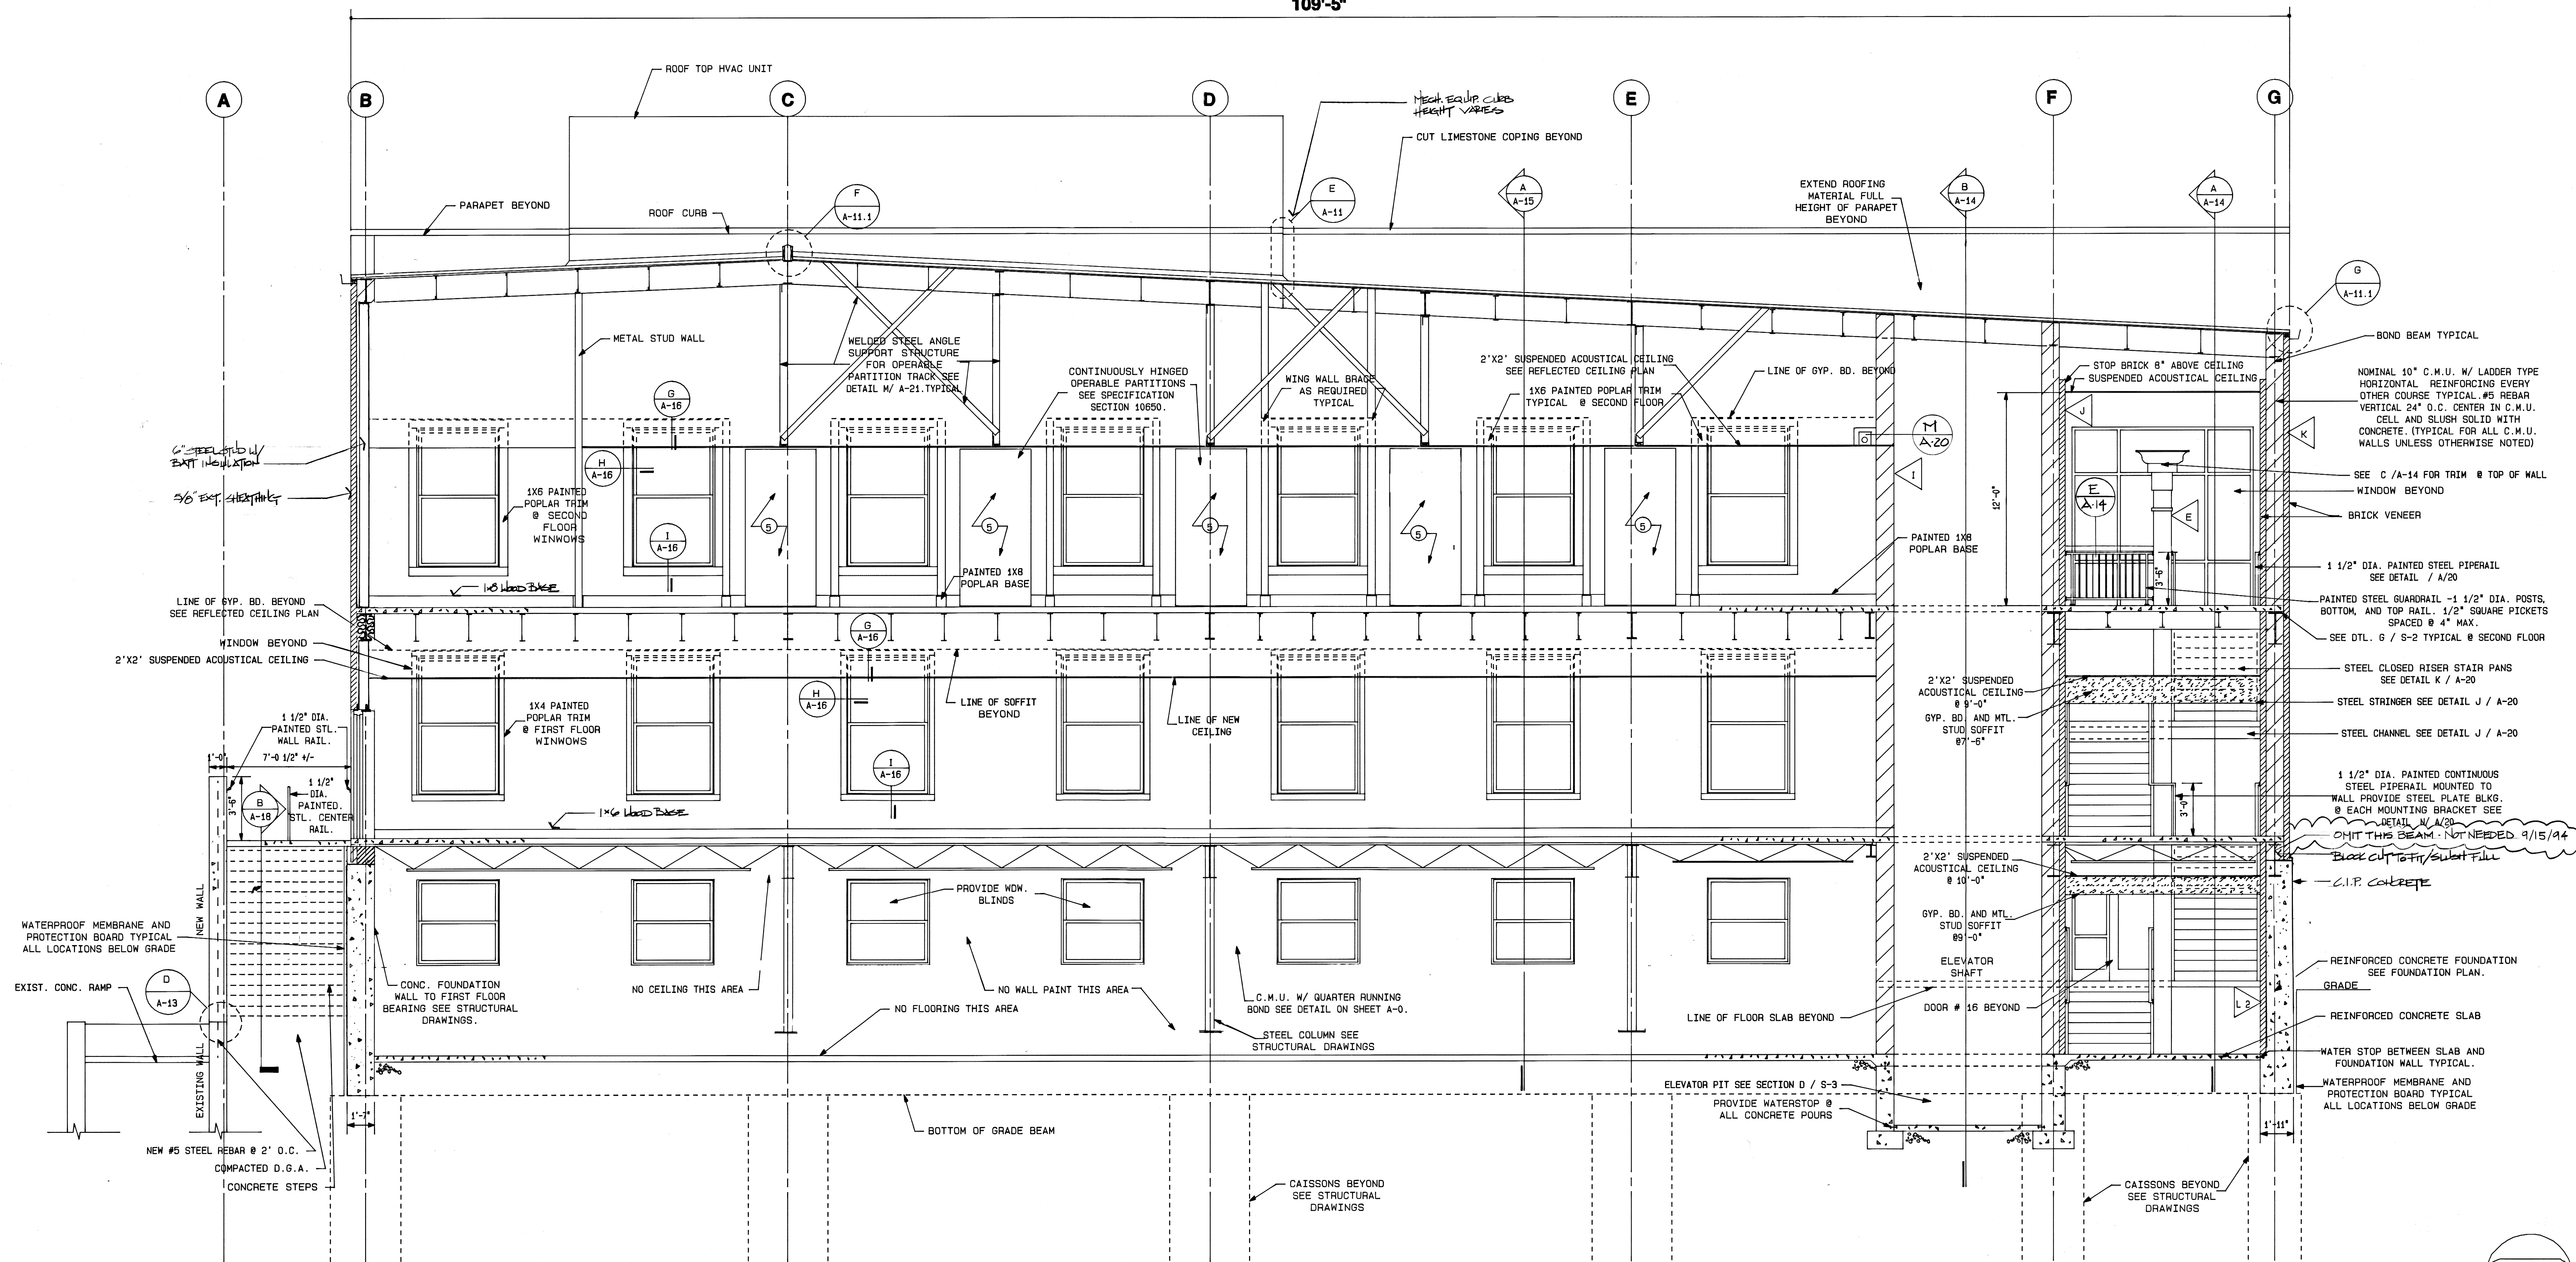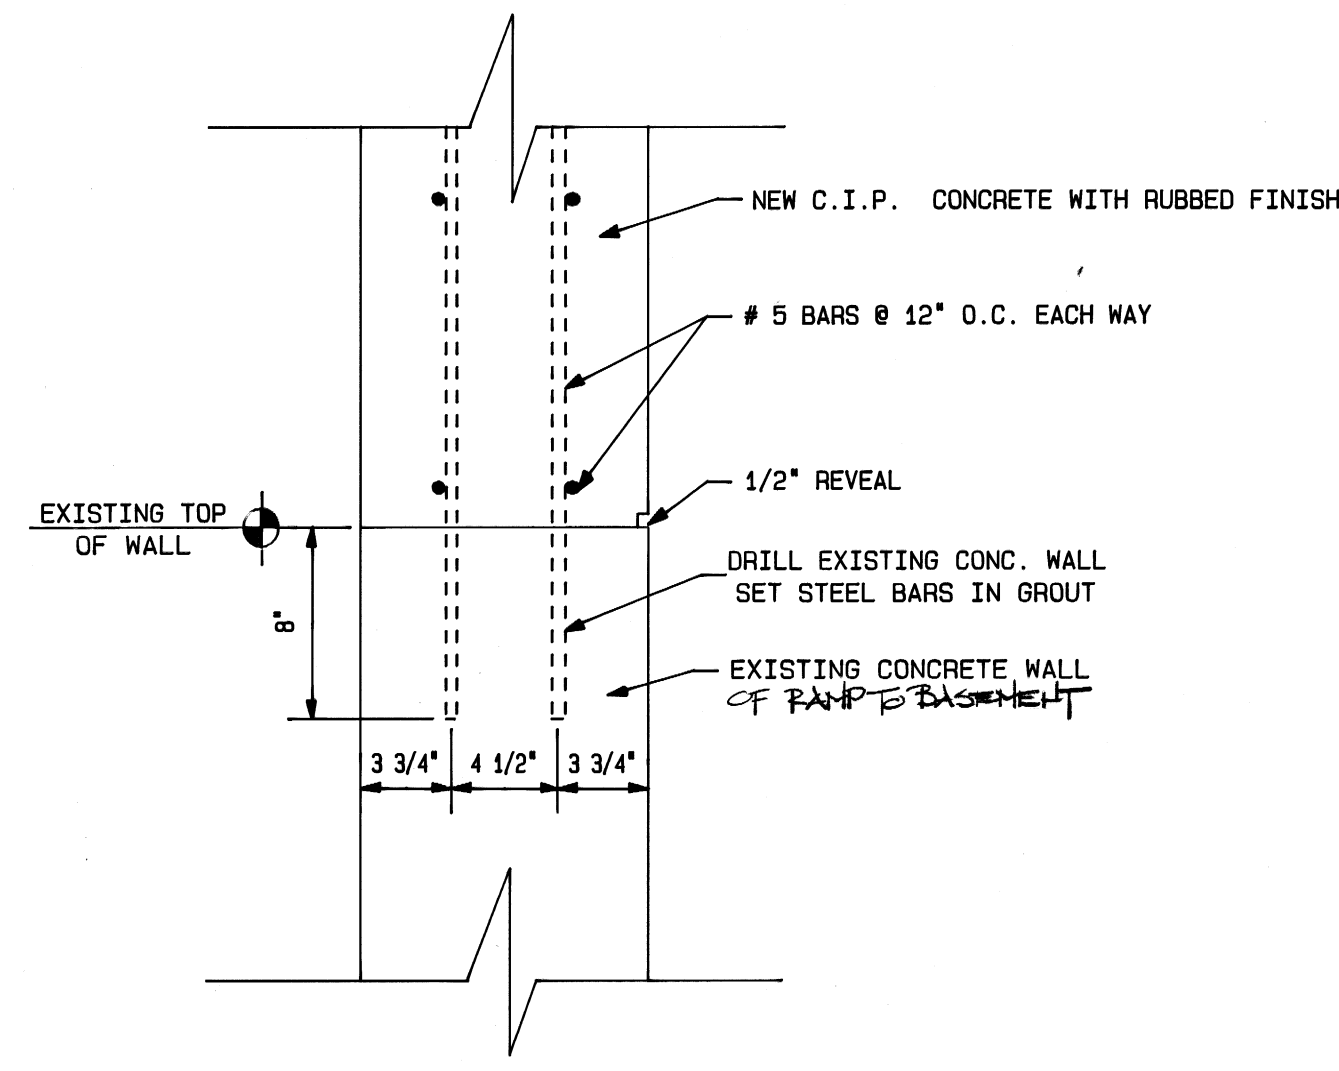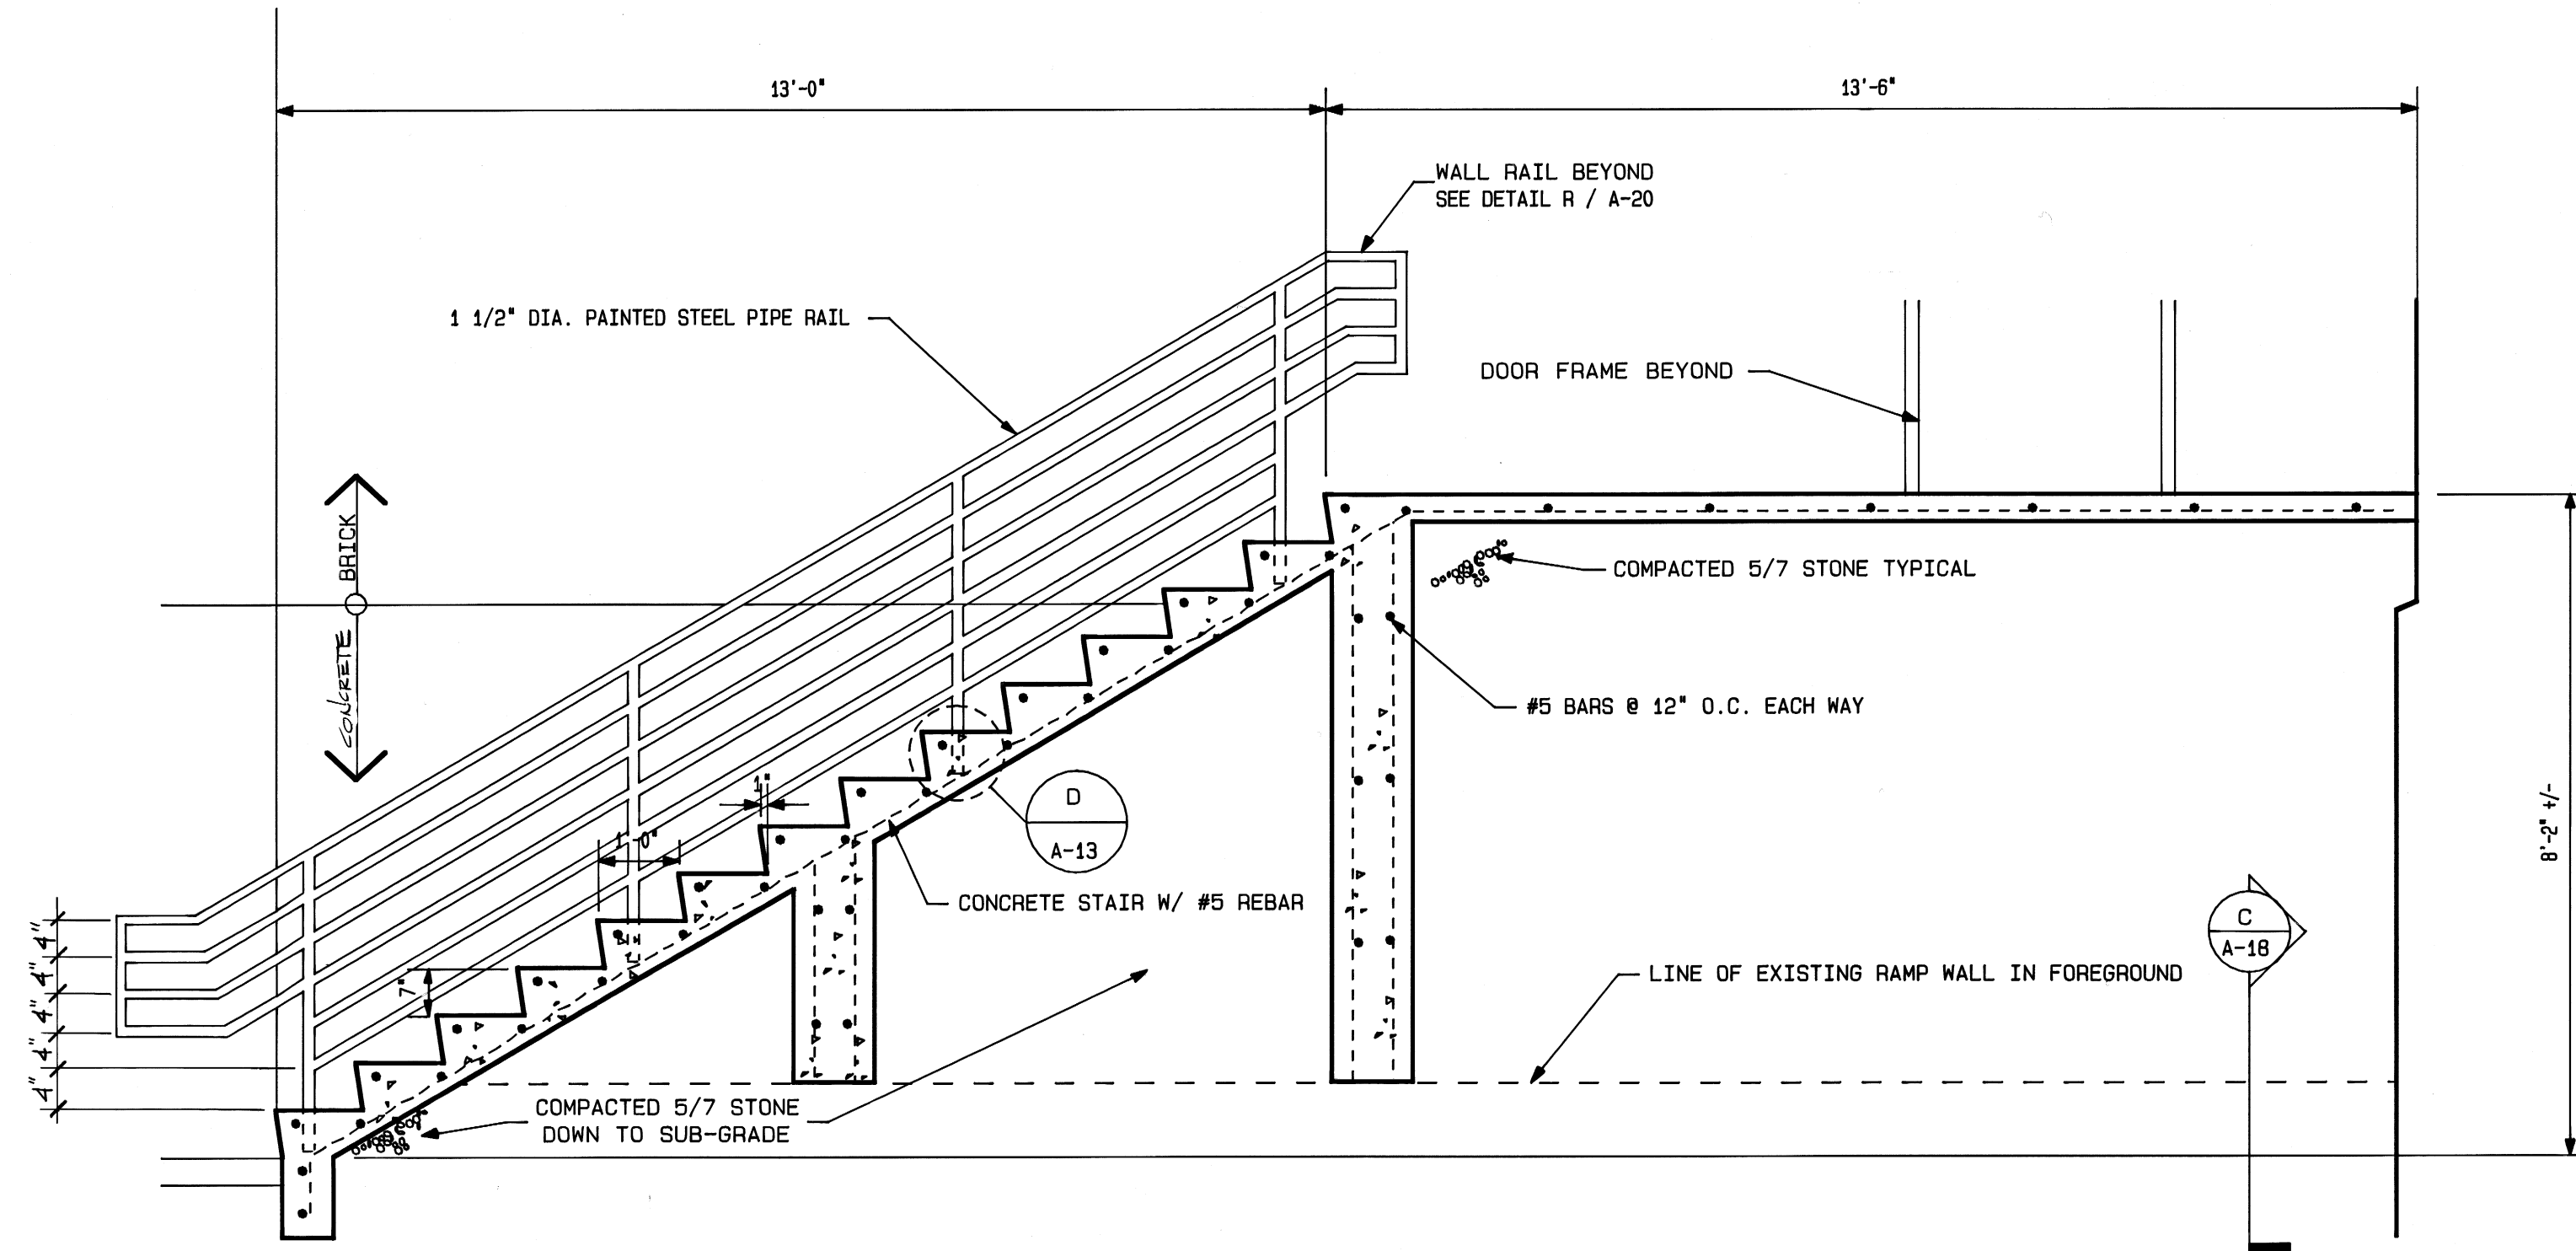


UNIVERSITY OF KENTUCKY

SCOVELL HALL RENOVATION


This drawing and design shown thereon are the property of Omni Architects, C. The reproduction or use of this drawing without the written consent of Omni Architects is prohibited.

Job No. 9805-00 Date: 5/1994 Drawn By: SWP / Jp Checked By: Revisions: JULY 29, 1994

BUILDING SECTION 002177

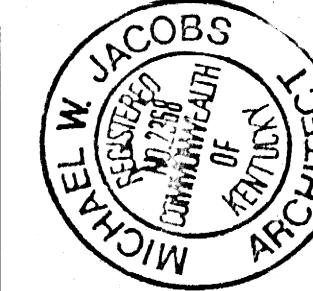

Architecture
Civil Engineering
Planning
Interior Design
122 North Ligon Street
Lexington, KY 40502
(606) 252-5664 FAX: (606) 253-2598

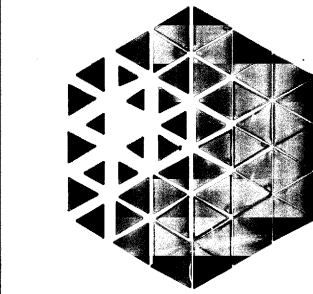


Omni
Architects

NO.	DATE	DESCRIPTION
1	5/1994	ISSUED FOR PERMITS
2	7/1994	ISSUED FOR PERMITS
3	7/1994	ISSUED FOR PERMITS
NO.	DATE	DESCRIPTION
1	5/1994	ISSUED FOR PERMITS
2	7/1994	ISSUED FOR PERMITS
3	7/1994	ISSUED FOR PERMITS
UNIVERSITY OF KENTUCKY
Design and Construction
Division
38 A-3 002127

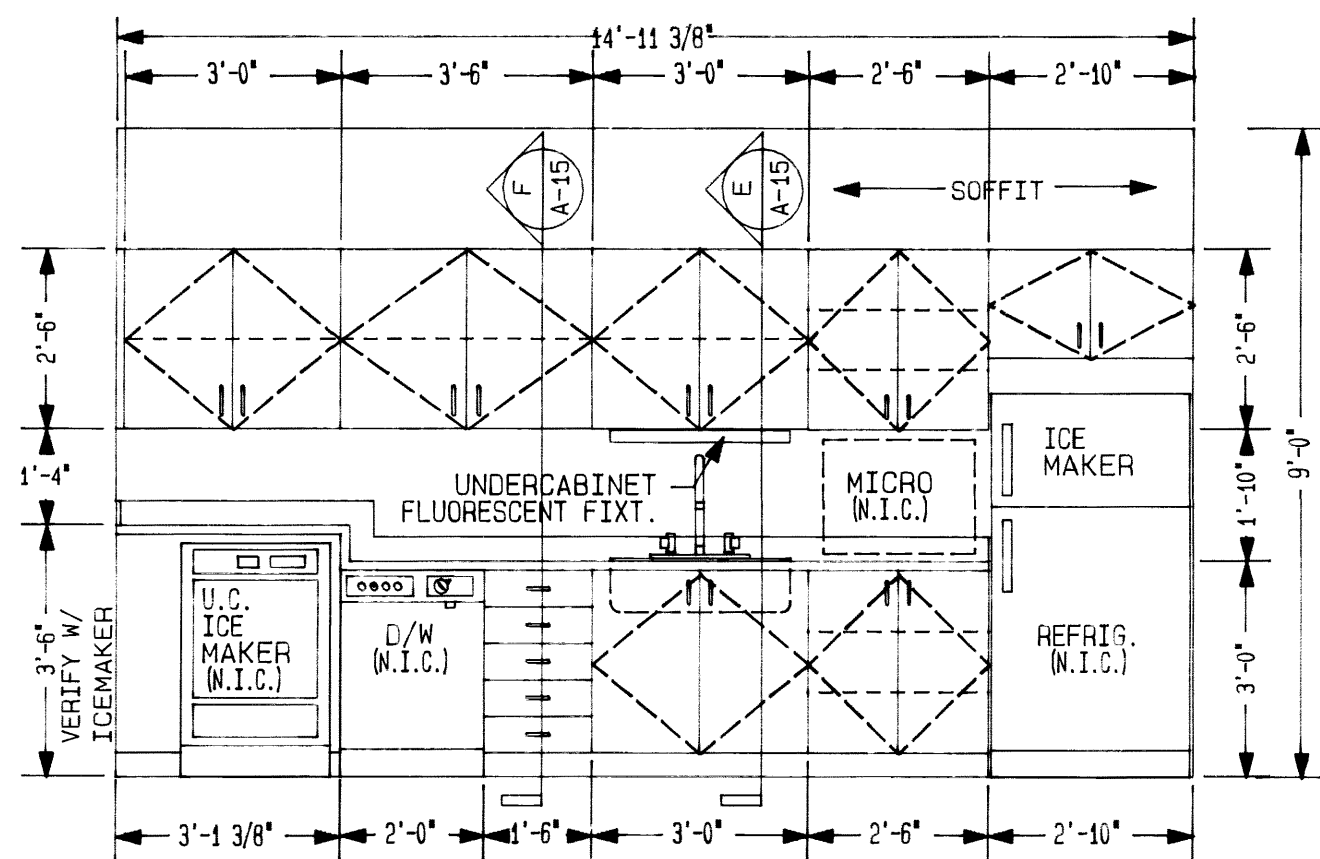


Elevation • Kitchenette 202

SCALE: 3/8" = 1'-0"

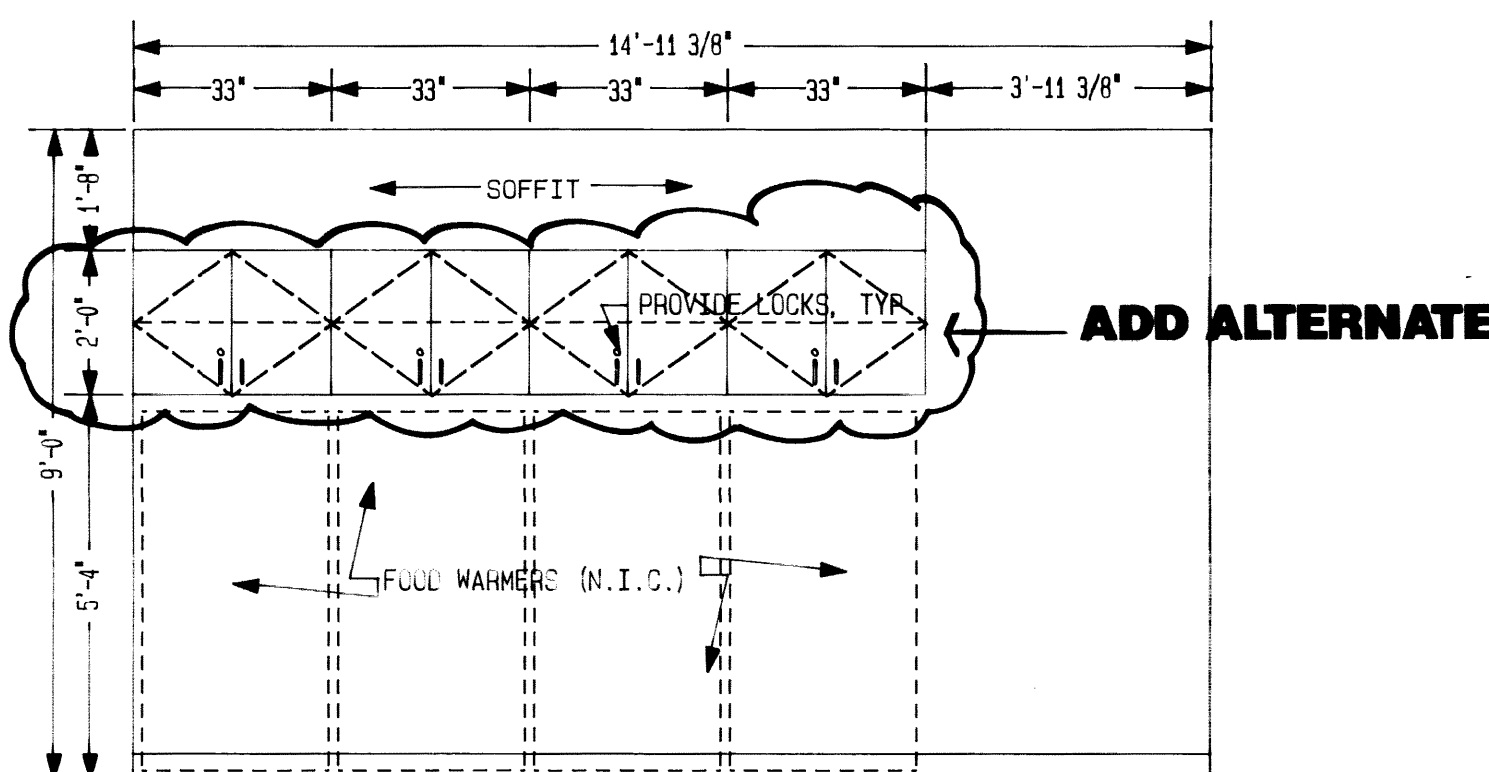


Elevation • Kitchenette 202

SCALE: 3/8" = 1'-0"

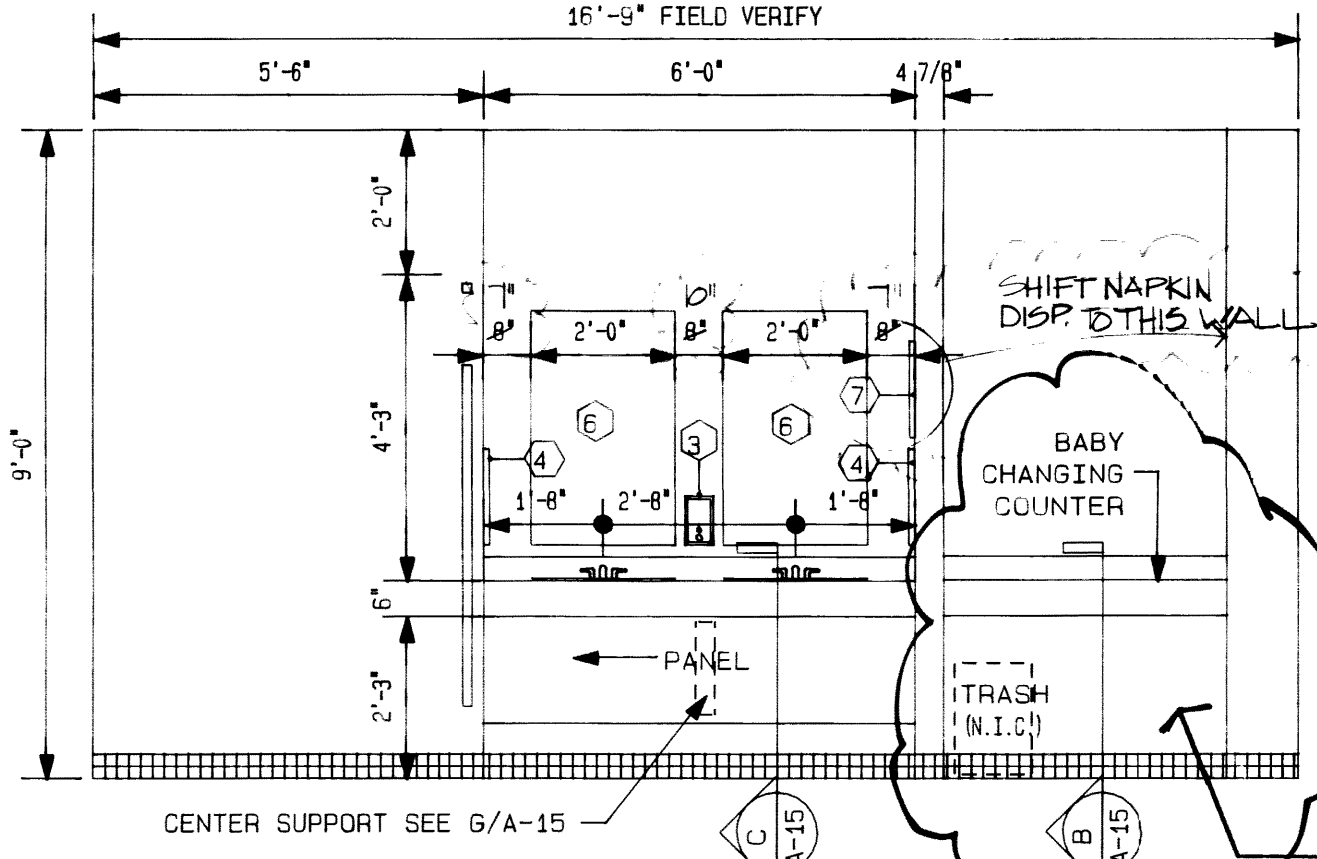

Elevation • Women 109 & 212 (OH) & Men 110 & 213


SCALE: 3/8" = 1'-0"

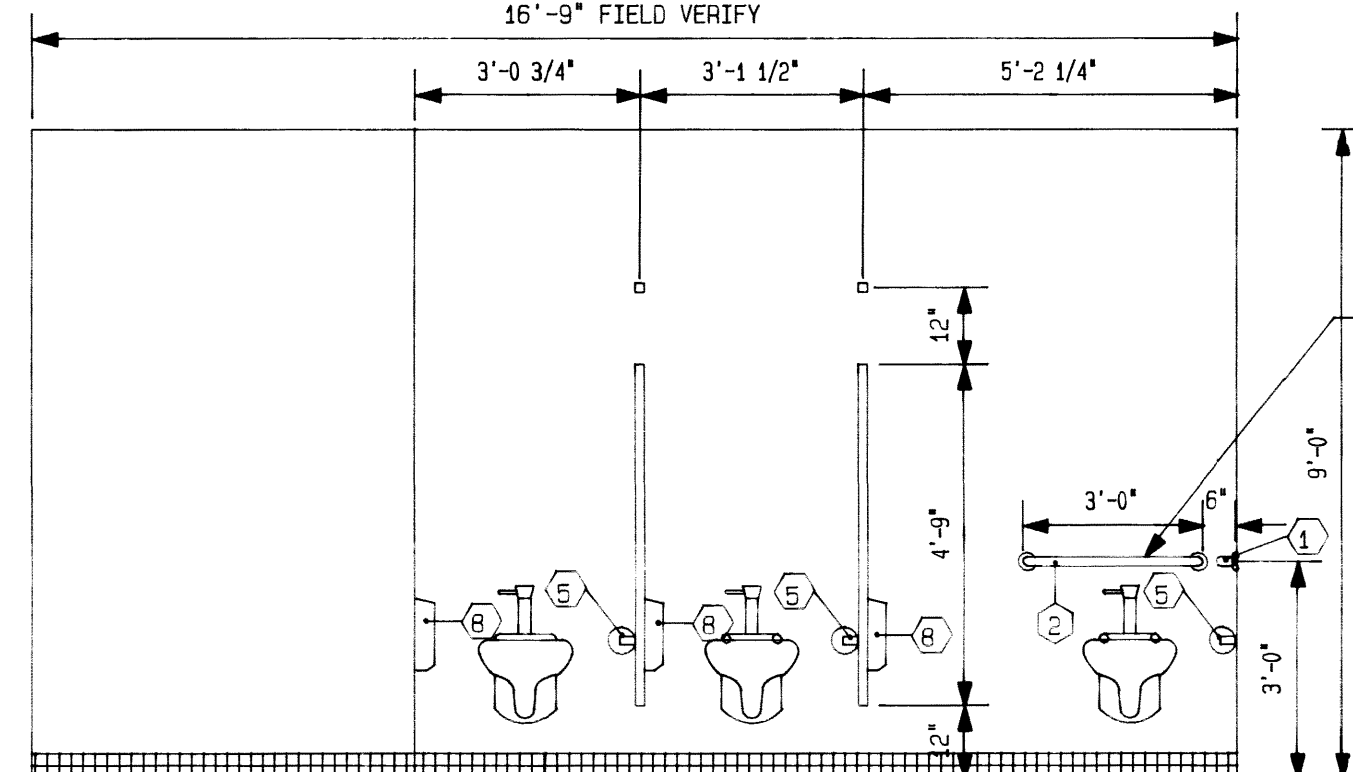

Elevation • Women 109 & 212


SCALE: 3/8" = 1'-0"

NOTE:
CASEWORK CONSTRUCTED OF 3/4" CABINET GRADE PLYWOOD W/ PLAS. LAM. ALL EXPOSED EDGES AND SURFACES PAINT ALL INTERIOR SURFACES. PROVIDE BACKSPLASH AND END SPLASHES @ ALL ADJACENT WALLS ON ALL COUNTERTOPS.

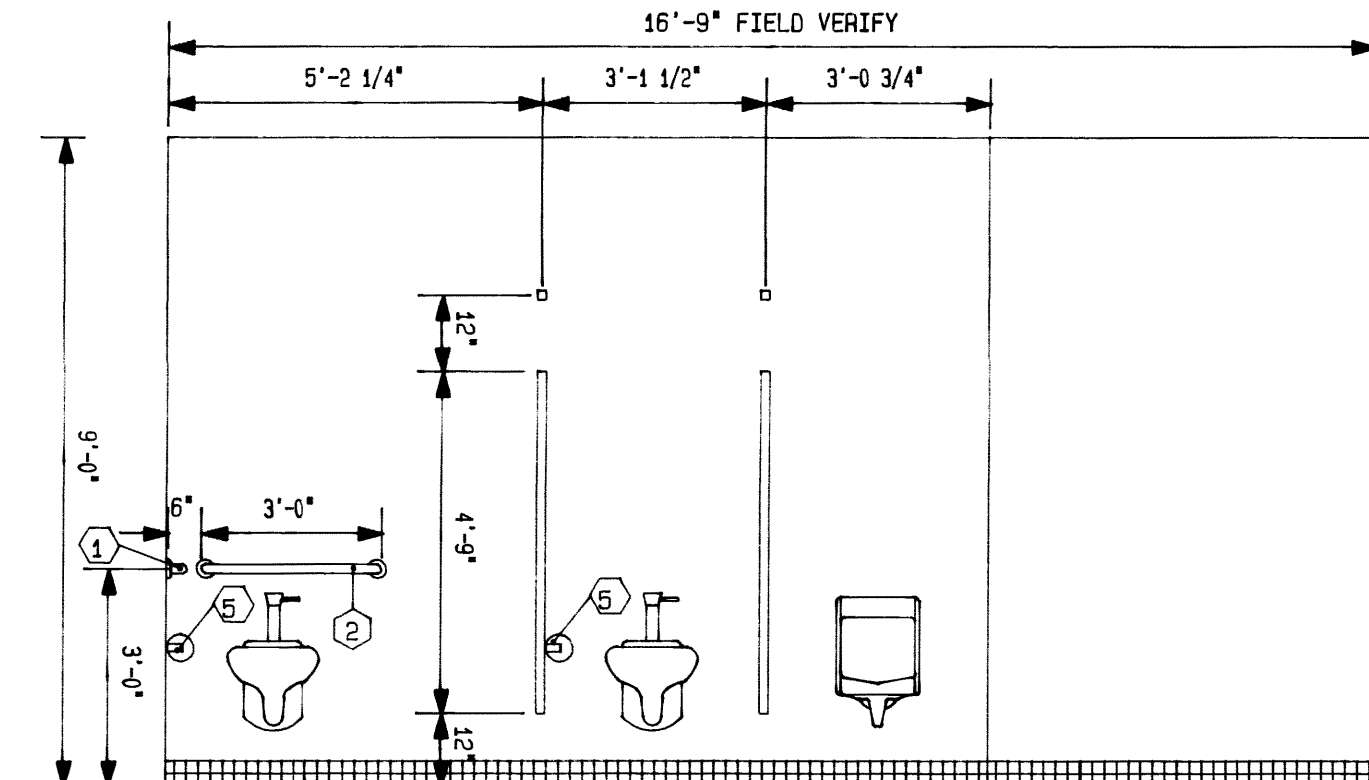


Elevation • Men 110 & 213

SCALE: 3/8" = 1'-0"

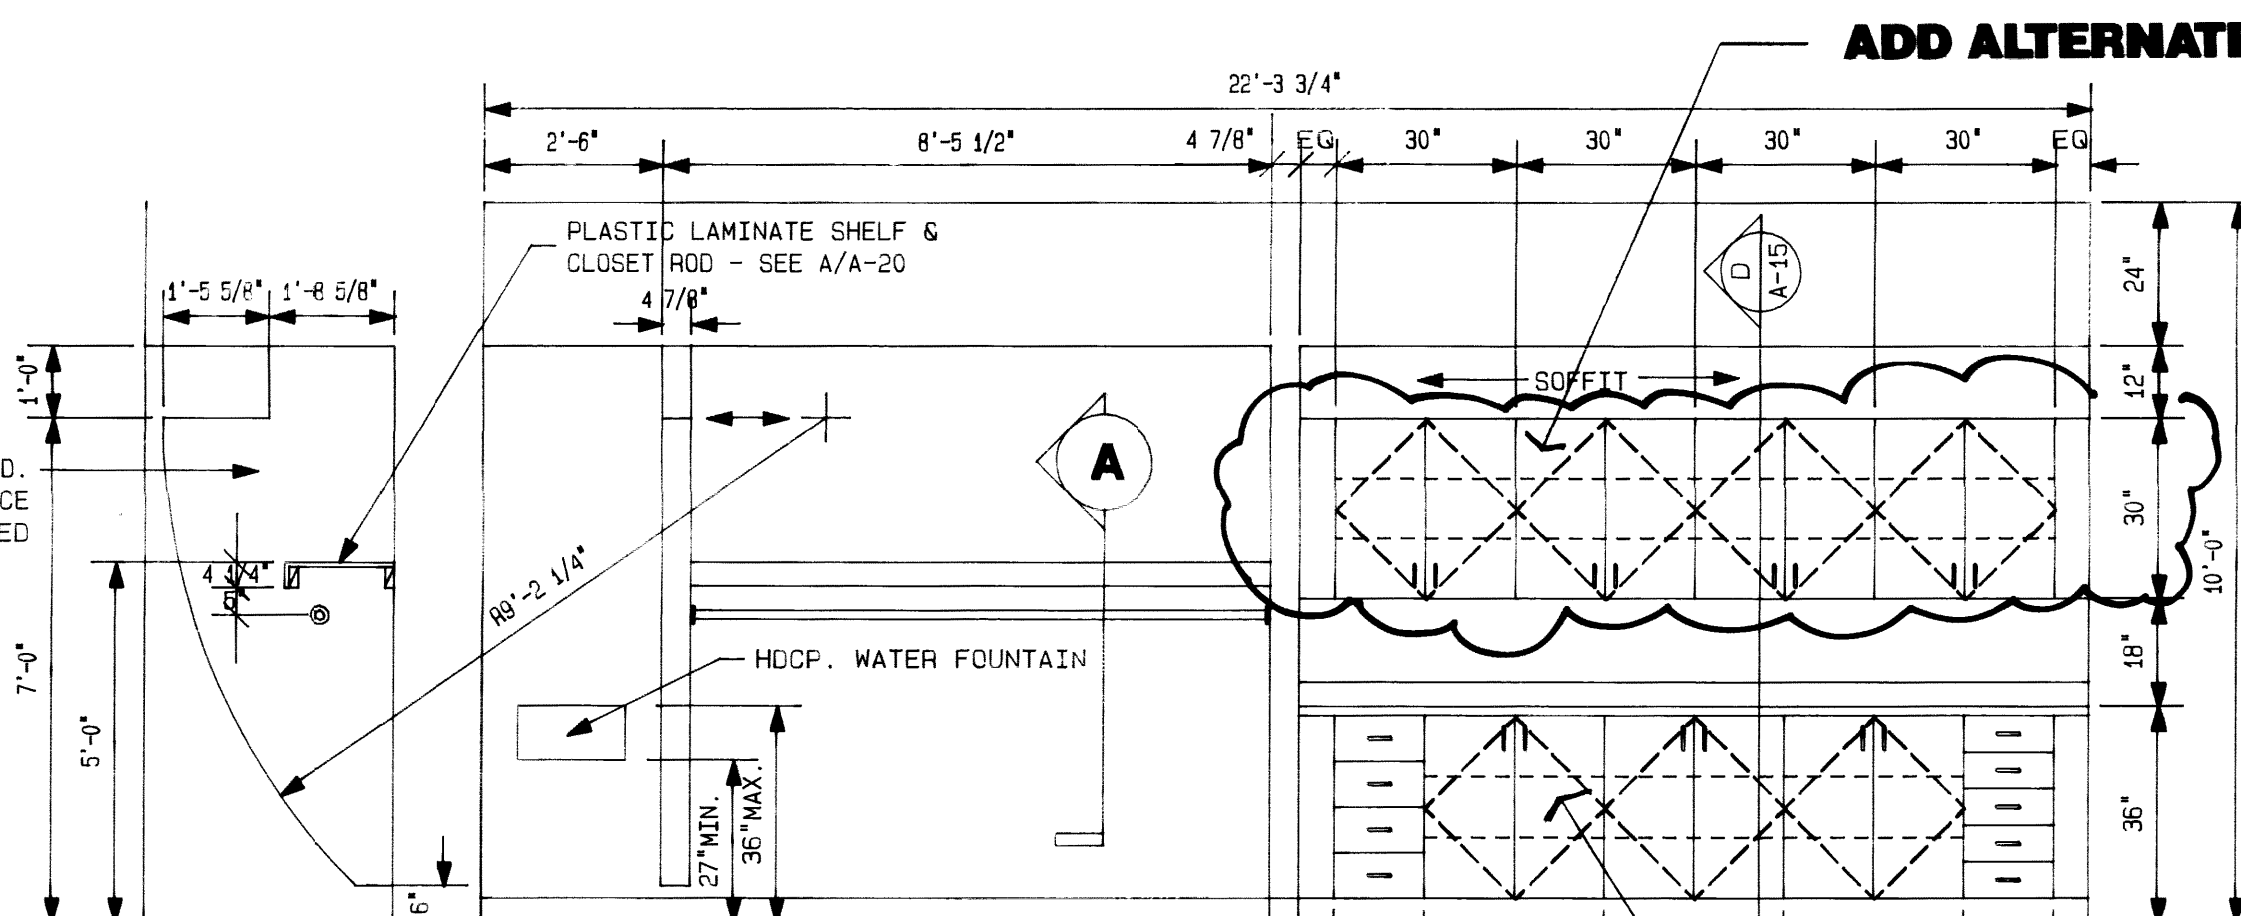


Elevation

SCALE: 3/8" = 1'-0"

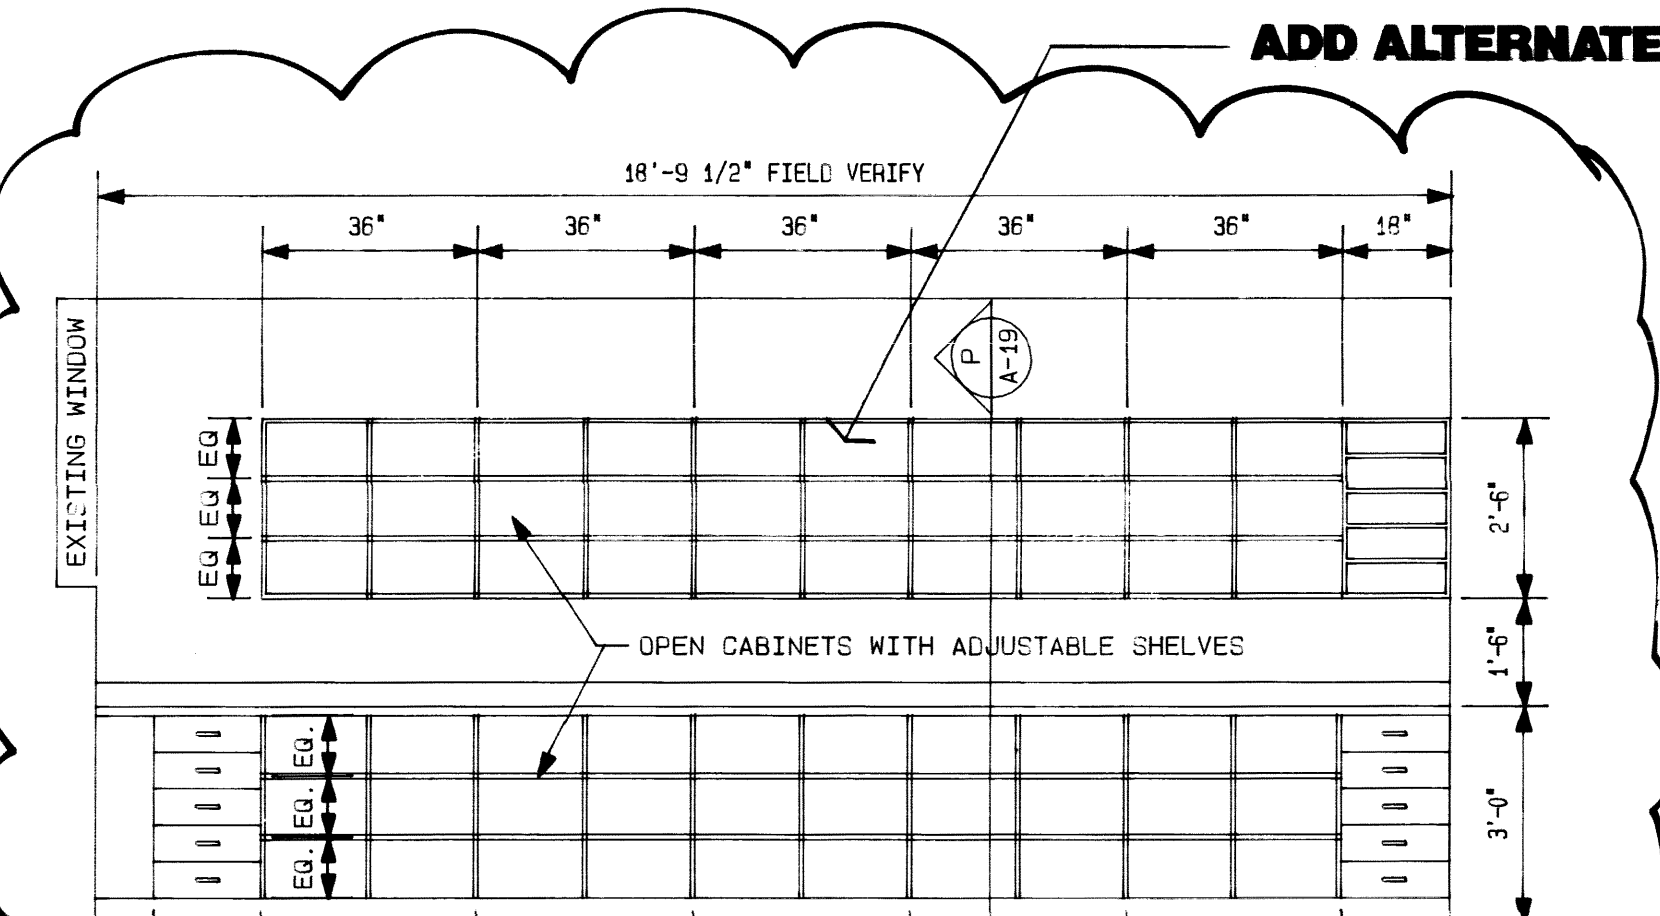

Elevation • Copy Center 007


SCALE: 3/8" = 1'-0"

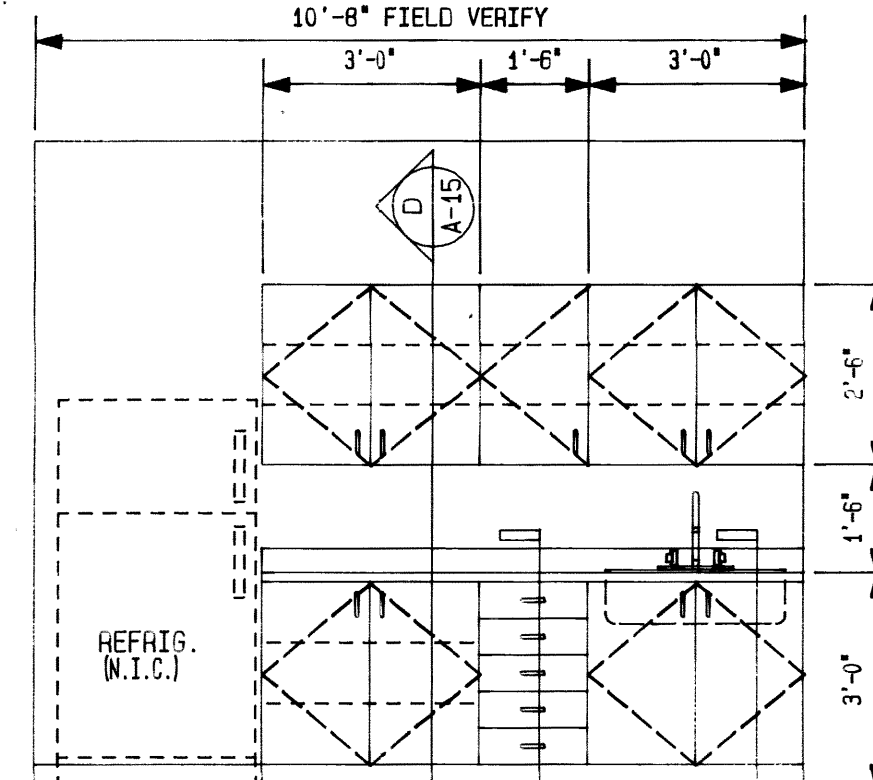

Elevation • Breakroom 101


SCALE: 3/8" = 1'-0"

NOTE:
CASEWORK CONSTRUCTED OF 3/4" CABINET GRADE PLYWOOD W/ PLAS. LAM. ALL EXPOSED EDGES AND SURFACES PAINT ALL INTERIOR SURFACES. PROVIDE BACKSPLASH AND END SPLASHES @ ALL ADJACENT WALLS ON ALL COUNTERTOPS.

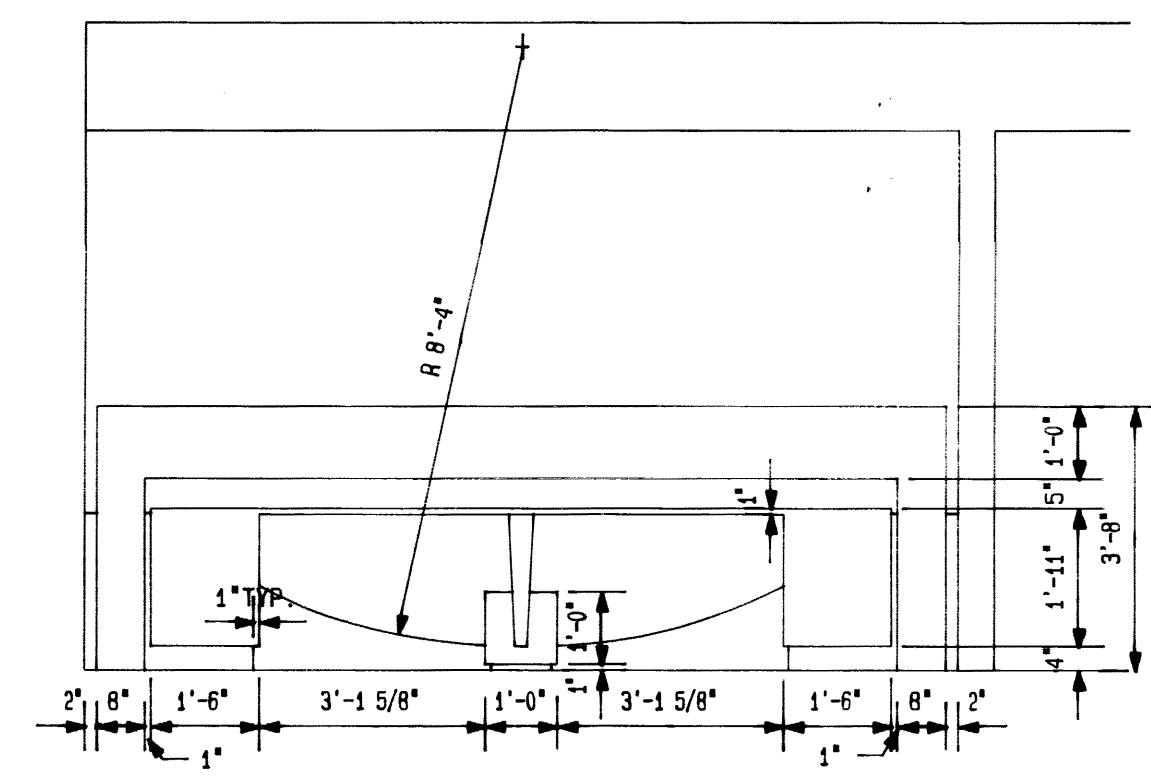


Elevation • Reception 114

SCALE: 3/8" = 1'-0"

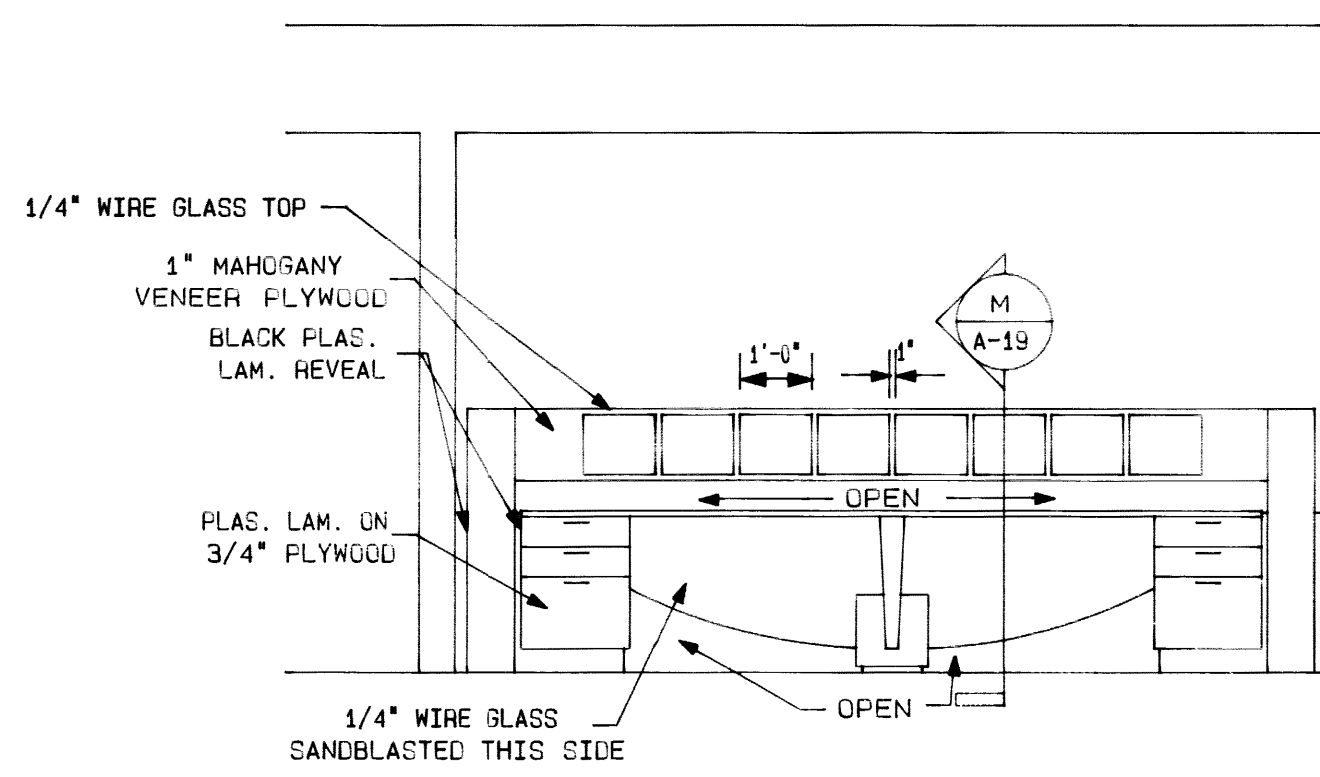


Elevation • Reception 114

SCALE: 3/8" = 1'-0"

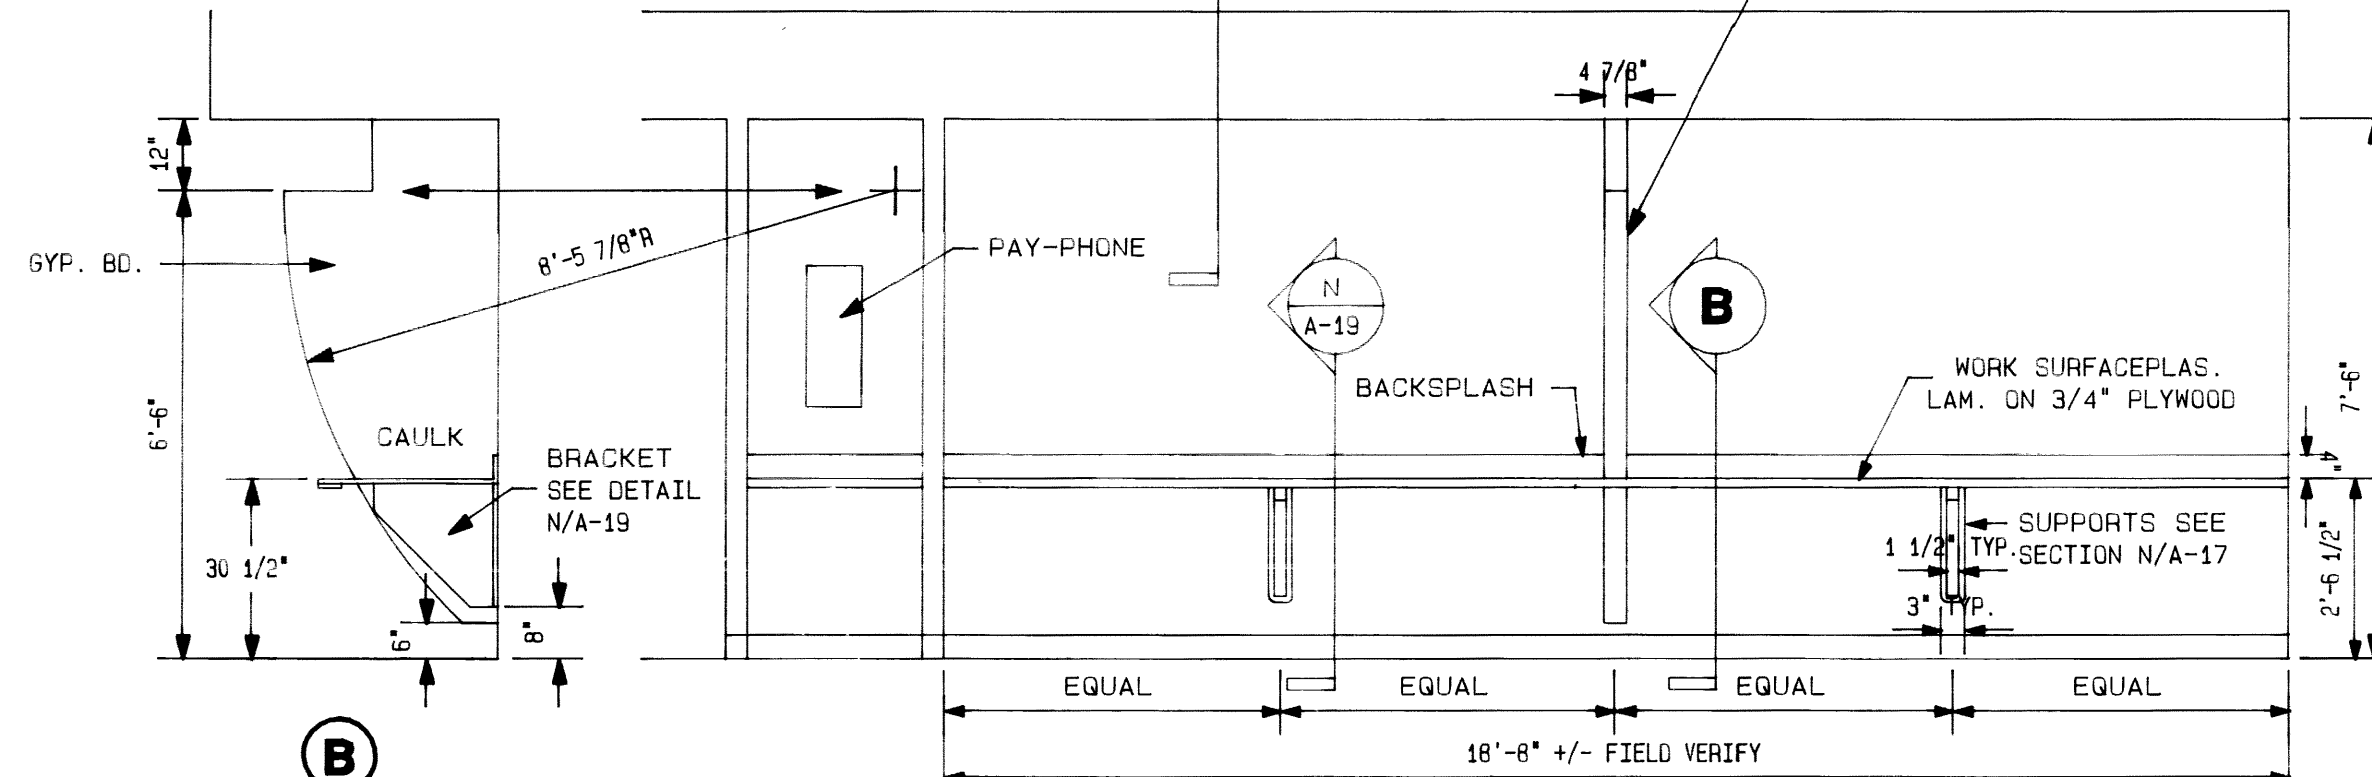

Elevation • Waiting 112

SCALE: 3/8" = 1'-0"

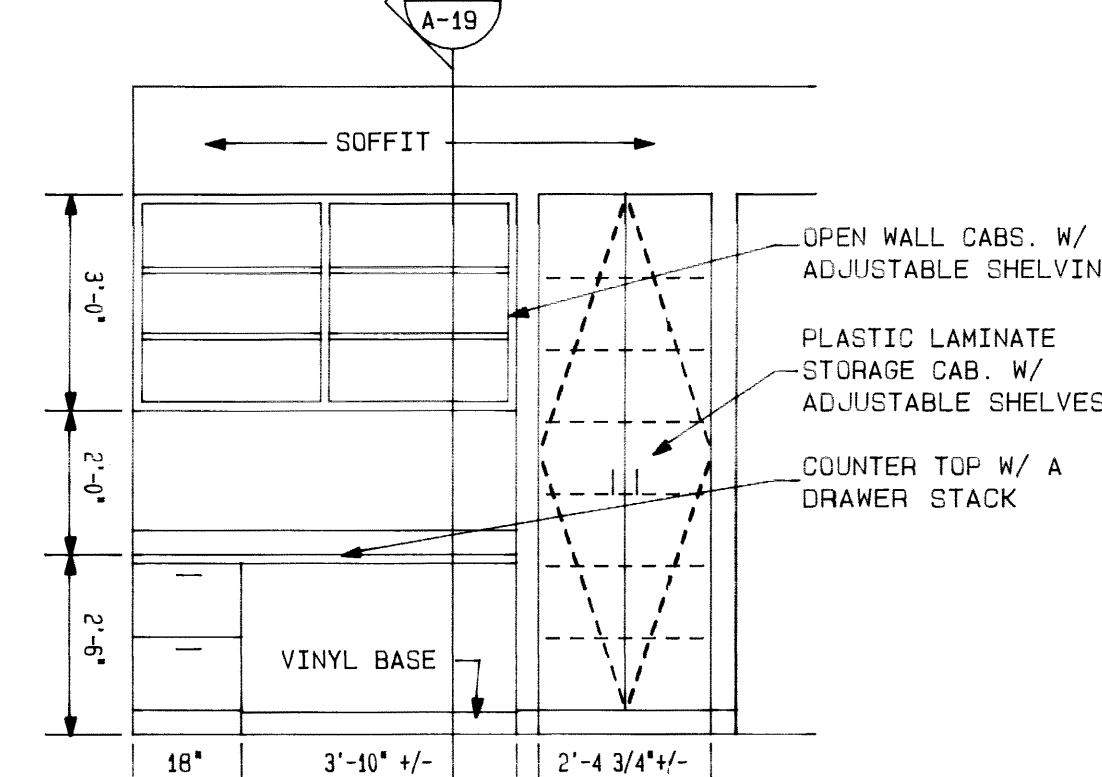


Elevation • Reception 114

SCALE: 3/8" = 1'-0"


NOTE: PROVIDE LOOKS ON ALL DRAWERS

NOTE:
CASEWORK CONSTRUCTED OF 3/4" CABINET GRADE PLYWOOD W/ PLAS. LAM. ALL EXPOSED EDGES AND SURFACES PAINT ALL INTERIOR SURFACES. PROVIDE BACKSPLASH AND END SPLASHES @ ALL ADJACENT WALLS ON ALL COUNTERTOPS.

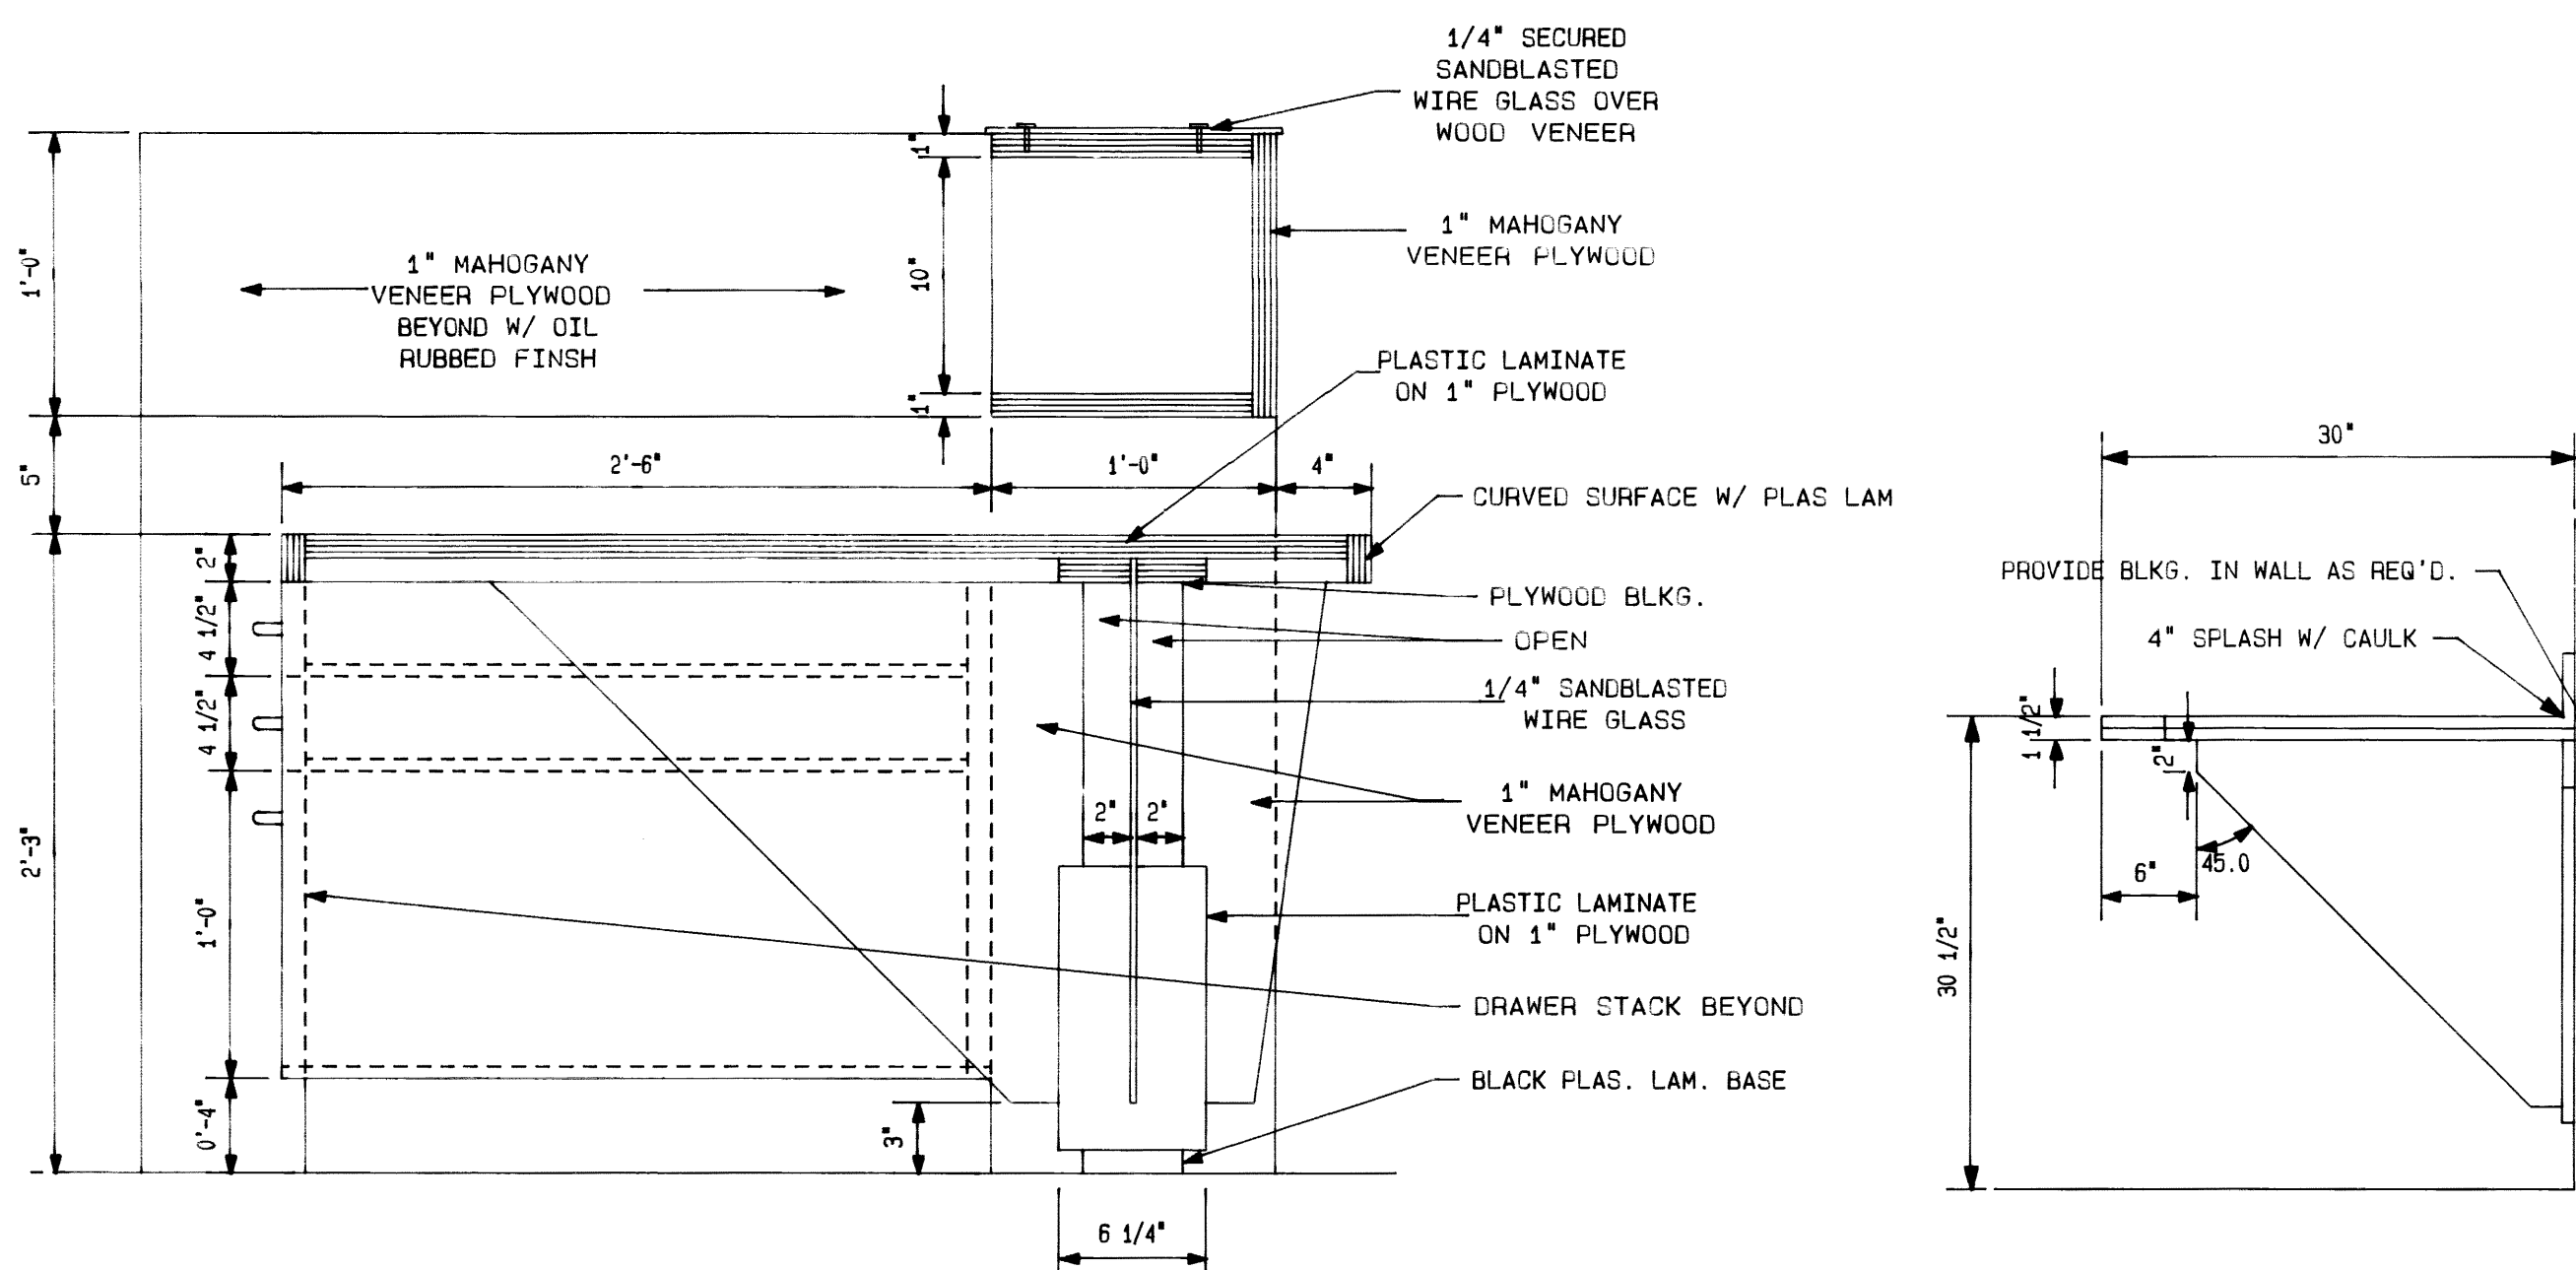


Section

SCALE: 1 1/2" = 1'-0"

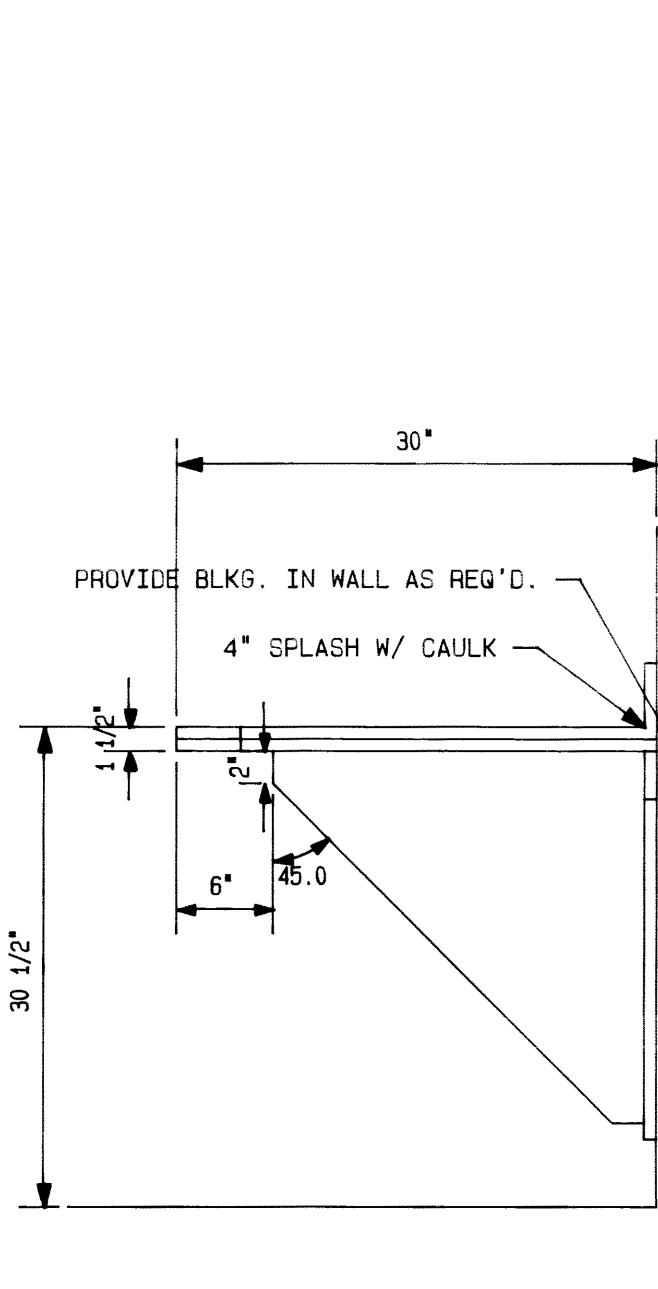


Section

SCALE: 1 1/2" = 1'-0"

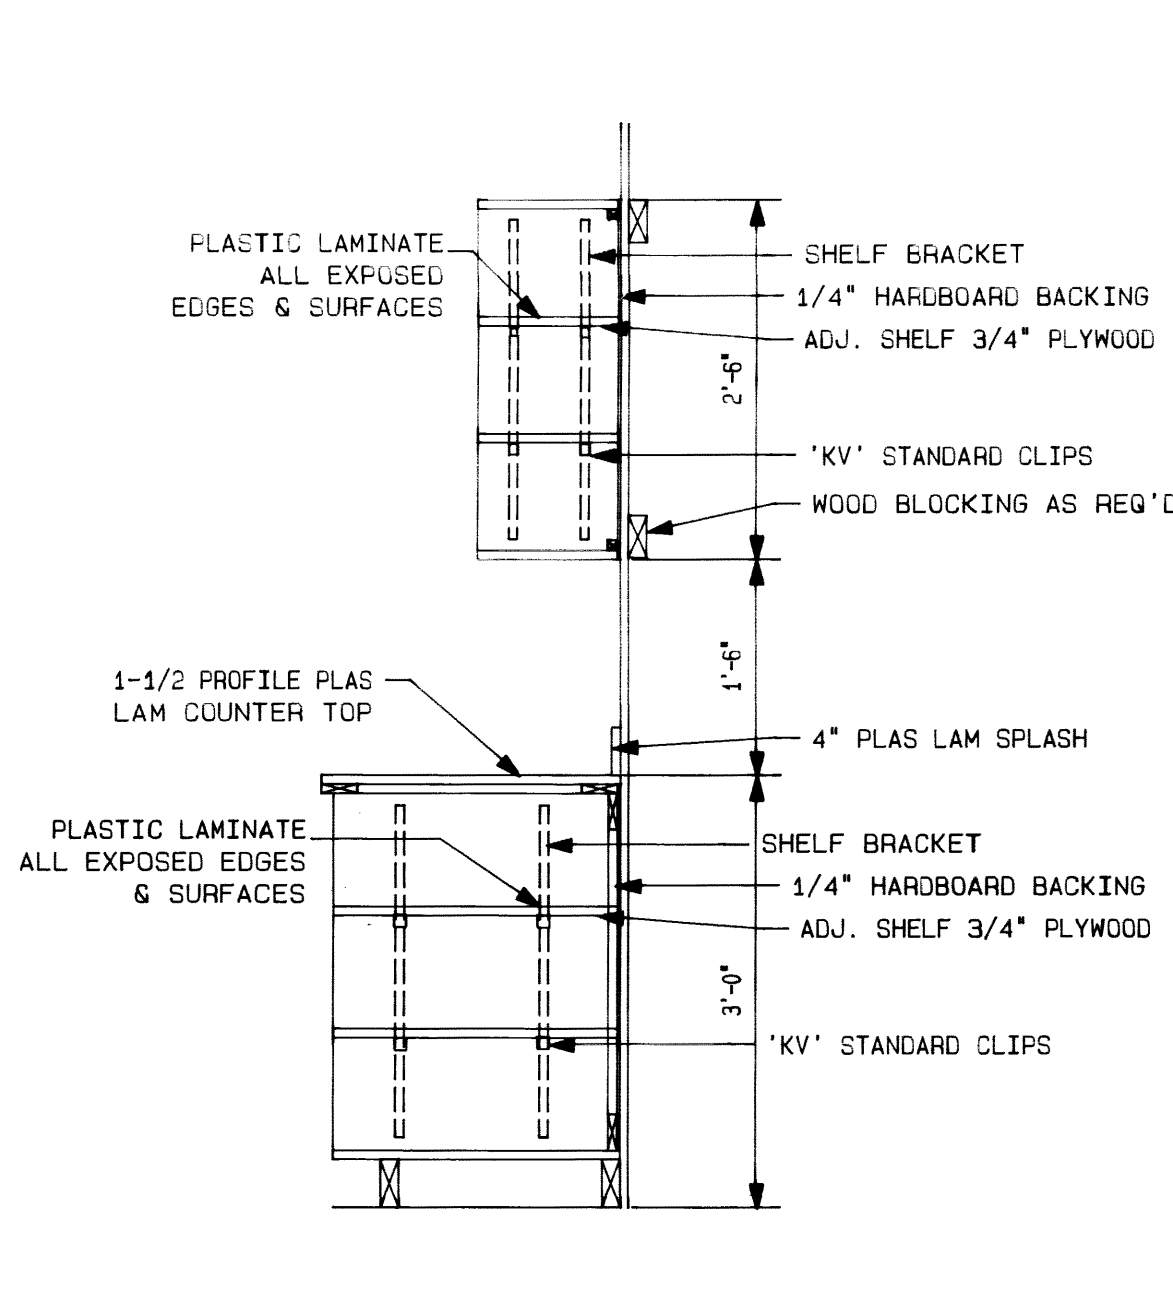

Casework Section

SCALE: 3/4" = 1'-0"

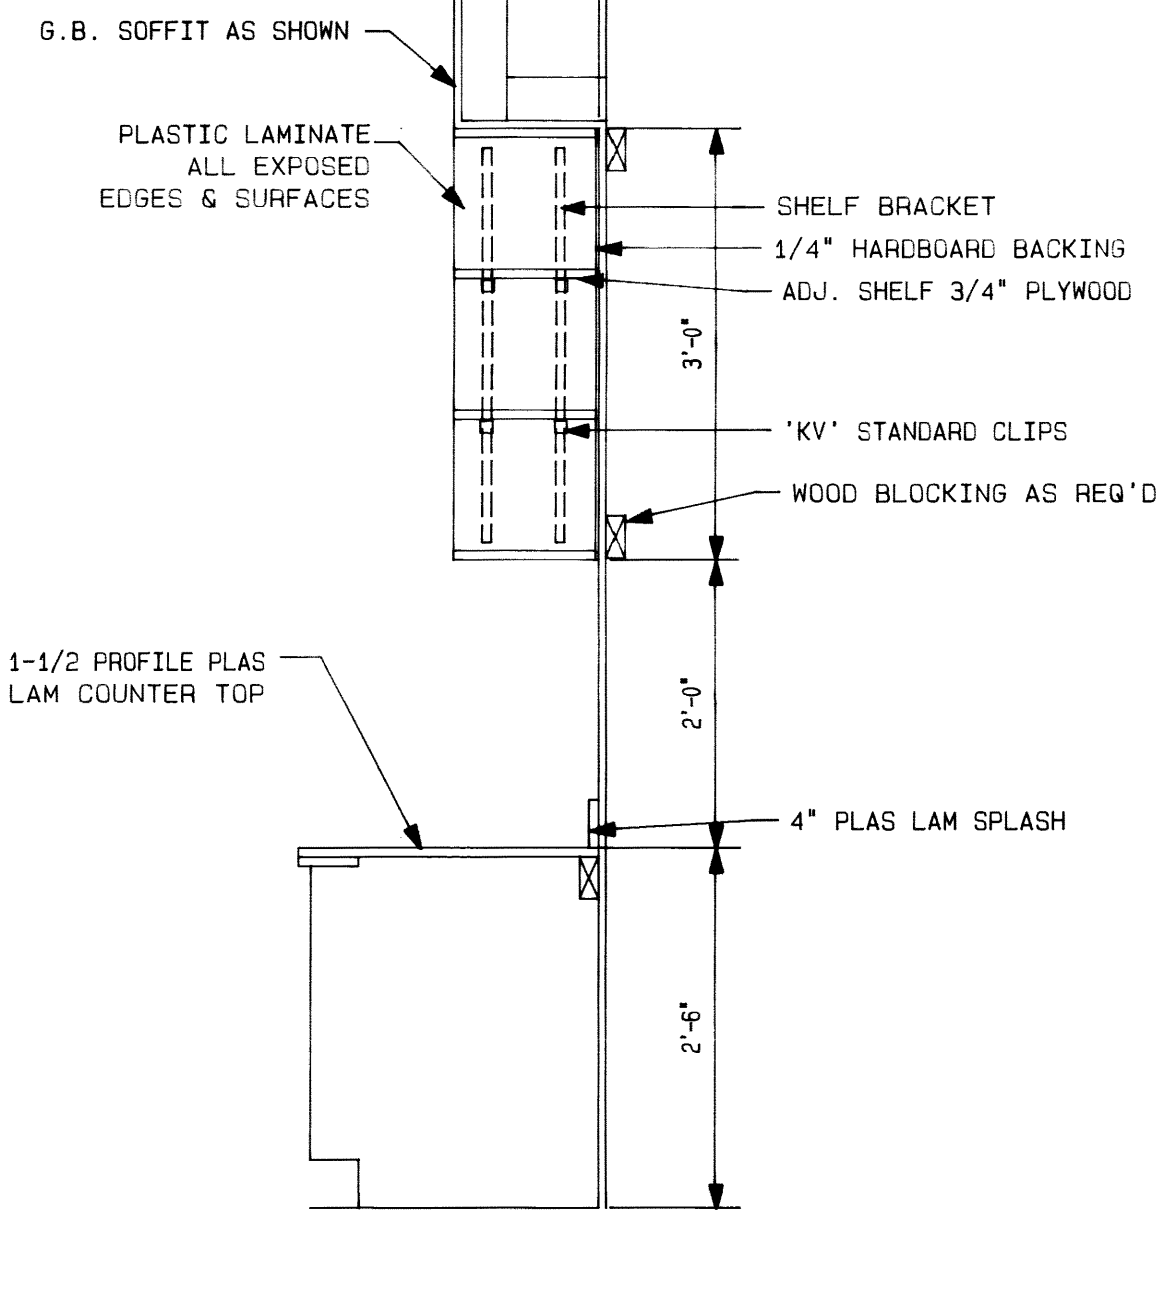

Casework Section

SCALE: 3/4" = 1'-0"

MARK	ITEM	ITEM# / MFG. OR EQUAL	MOUNTING HT.
1	42" GRAB BAR	BOBRICK B6202 X 42	3' 0" AFF TO CENTERLINE
2	36" GRAB BAR	BOBRICK B6202 X 36	3' 0" AFF TO CENTERLINE
3	SOAP DISPENSER	BOBRICK B-190	3' 2" AFF TO BOTTOM
4	PAPER TOWEL DISPENSER	OWNER FURN. AND INSTALL.	3' 2" AFF TO BOTTOM
5	TOILET PAPER DISPENSER	OWNER FURN. AND INSTALL.	19" MIN. AFF TO CTR. LINE
6	MIRROR	B-166 2436	3' 4" AFF TO BOTTOM
7	SANITARY NAPKIN DISPEN.	BOBRICK B-3502	3' 4" AFF TO BOTTOM
8	SANITARY NAPKIN DISPOS.	BOBRICK B-254	2' 0" AFF TO BOTTOM


SCOVELL HALL RENOVATION

Interior Elevations

BO 2128
A-19

University of Kentucky
Design and Construction
Division
200 North Upper Street
Lexington, KY 40507
(606) 255-8804 Fax: (606) 255-2556

Omni
Architects

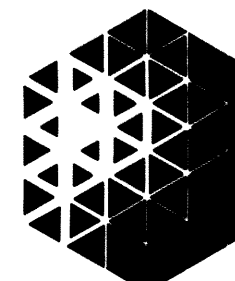


Architecture
Landscape Architecture
Planning
Interiors

AS-BUILT AUG. 10, 1995

UNIVERSITY OF KENTUCKY

This Drawing and Design show there are the property of Omni Architects C. The reproduction, copying or other use of this drawing without the written consent of Omni Architects is prohibited.

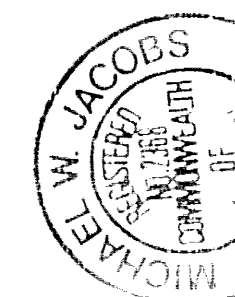

UNIVERSITY OF KENTUCKY

Revisions: Δ July 29, 1974

Checked: GF

Drawn By: ~~DE~~

Date: 4/94

Job No: 1474.0

1870

ACCEPTED MANUSCRIPT

1870

1

15 JULY 2004

1

ACCEPTED MANUSCRIPT

DETAILS

AS-BUILT AUG. 10, 1995

**Landscape Architecture
Civil Engineering
Planning
Interiors**
212 North Upper Street
Lexington, Kentucky 40507

Omni
Architects


OFFICIAL BID DOCUMENT

Section 1	University of Kentucky Lexington, Kentucky
Section 2	
Section 3	
Section 4	
Section 100	


UNIVERSITY OF KENTUCKY
Design and Construction
Division

Document #


Category	Slot
1	1
2	2
3	3
100	100

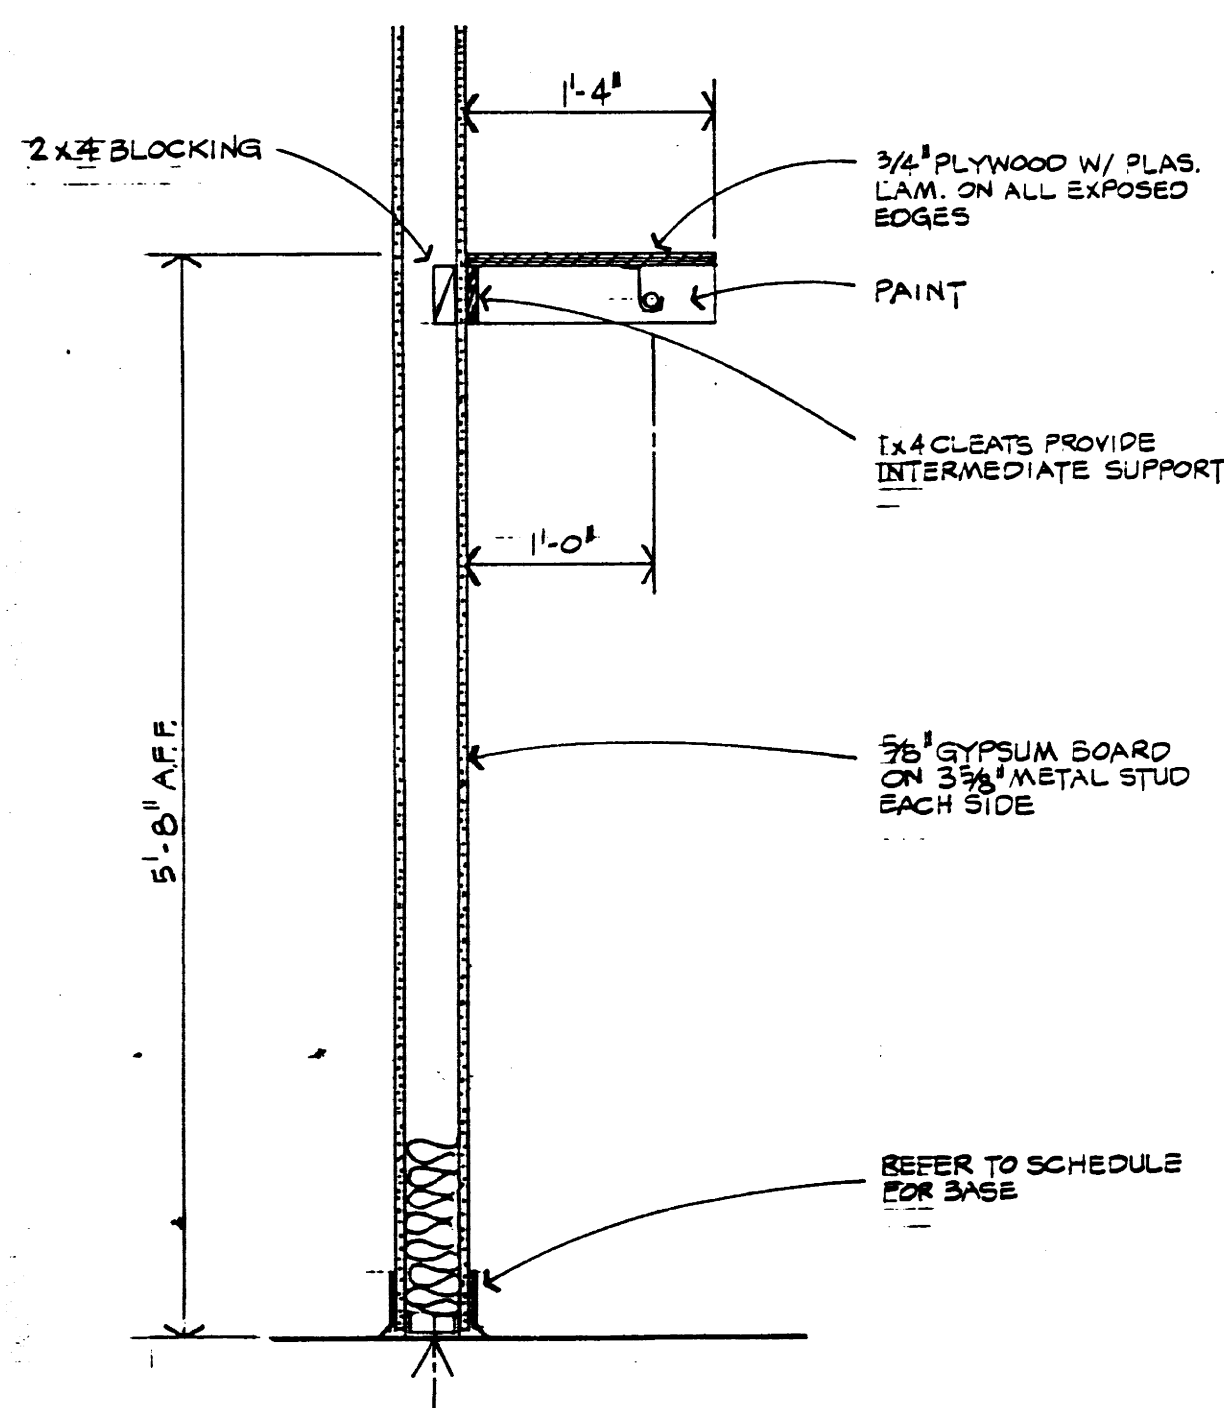


DETAIL (TYPICAL CLOSET) A
SCALE: 1"=1'-0"

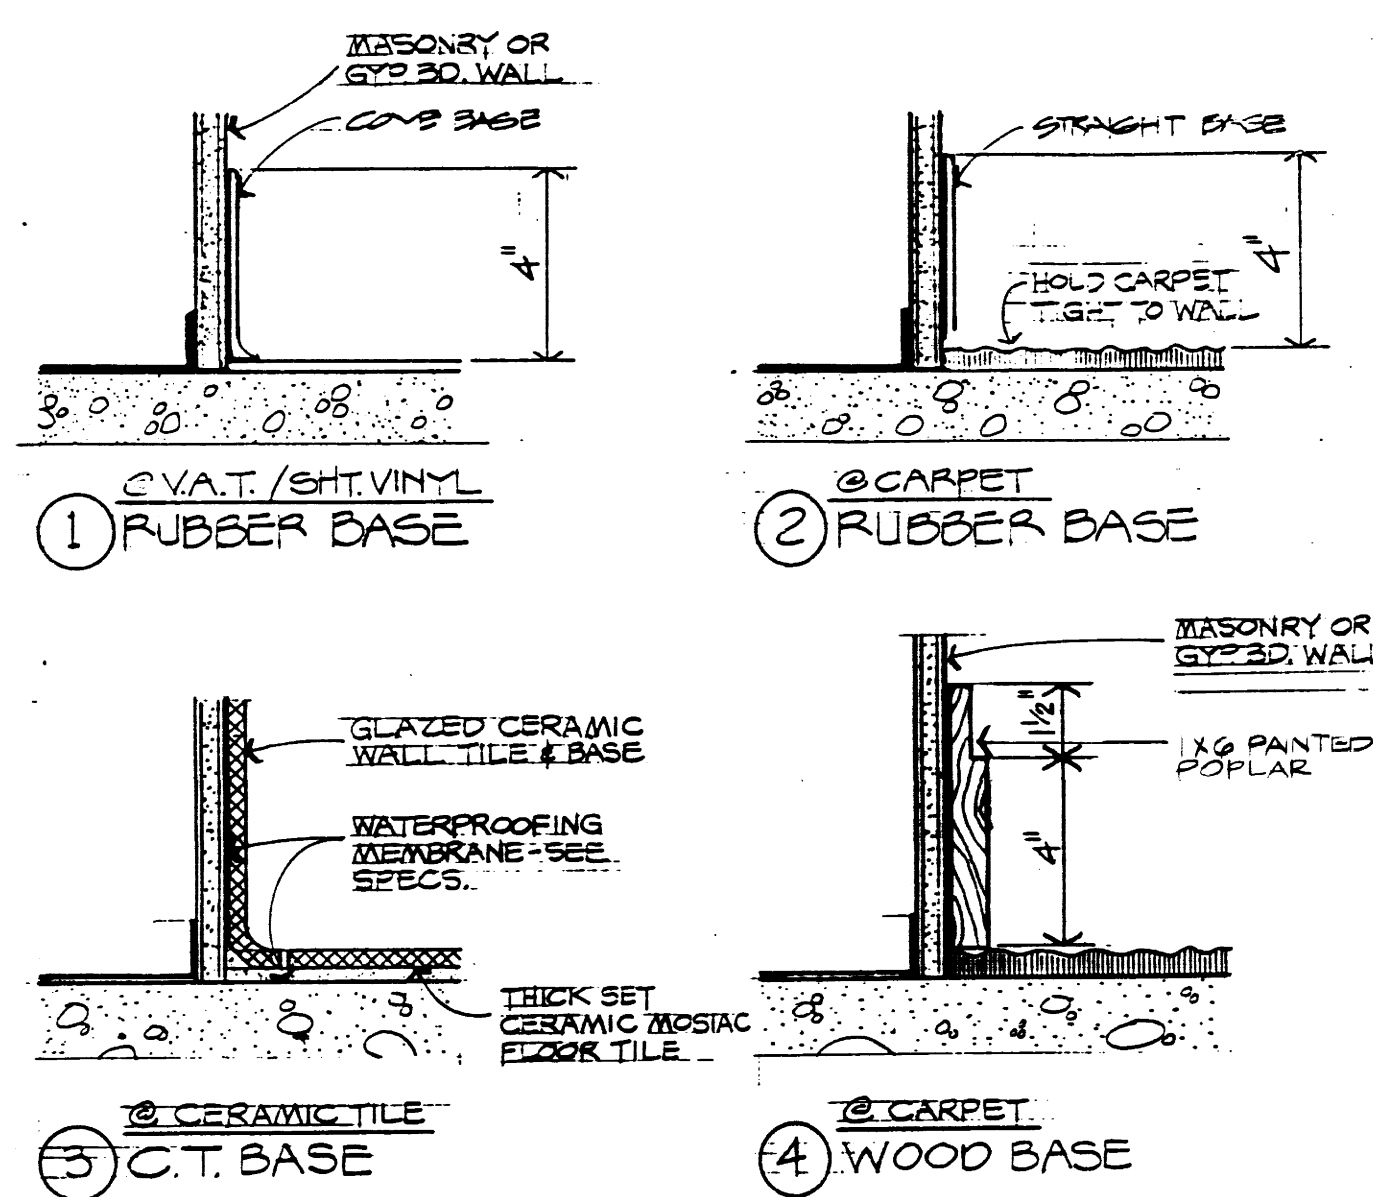

TYPICAL BASE DETAILS

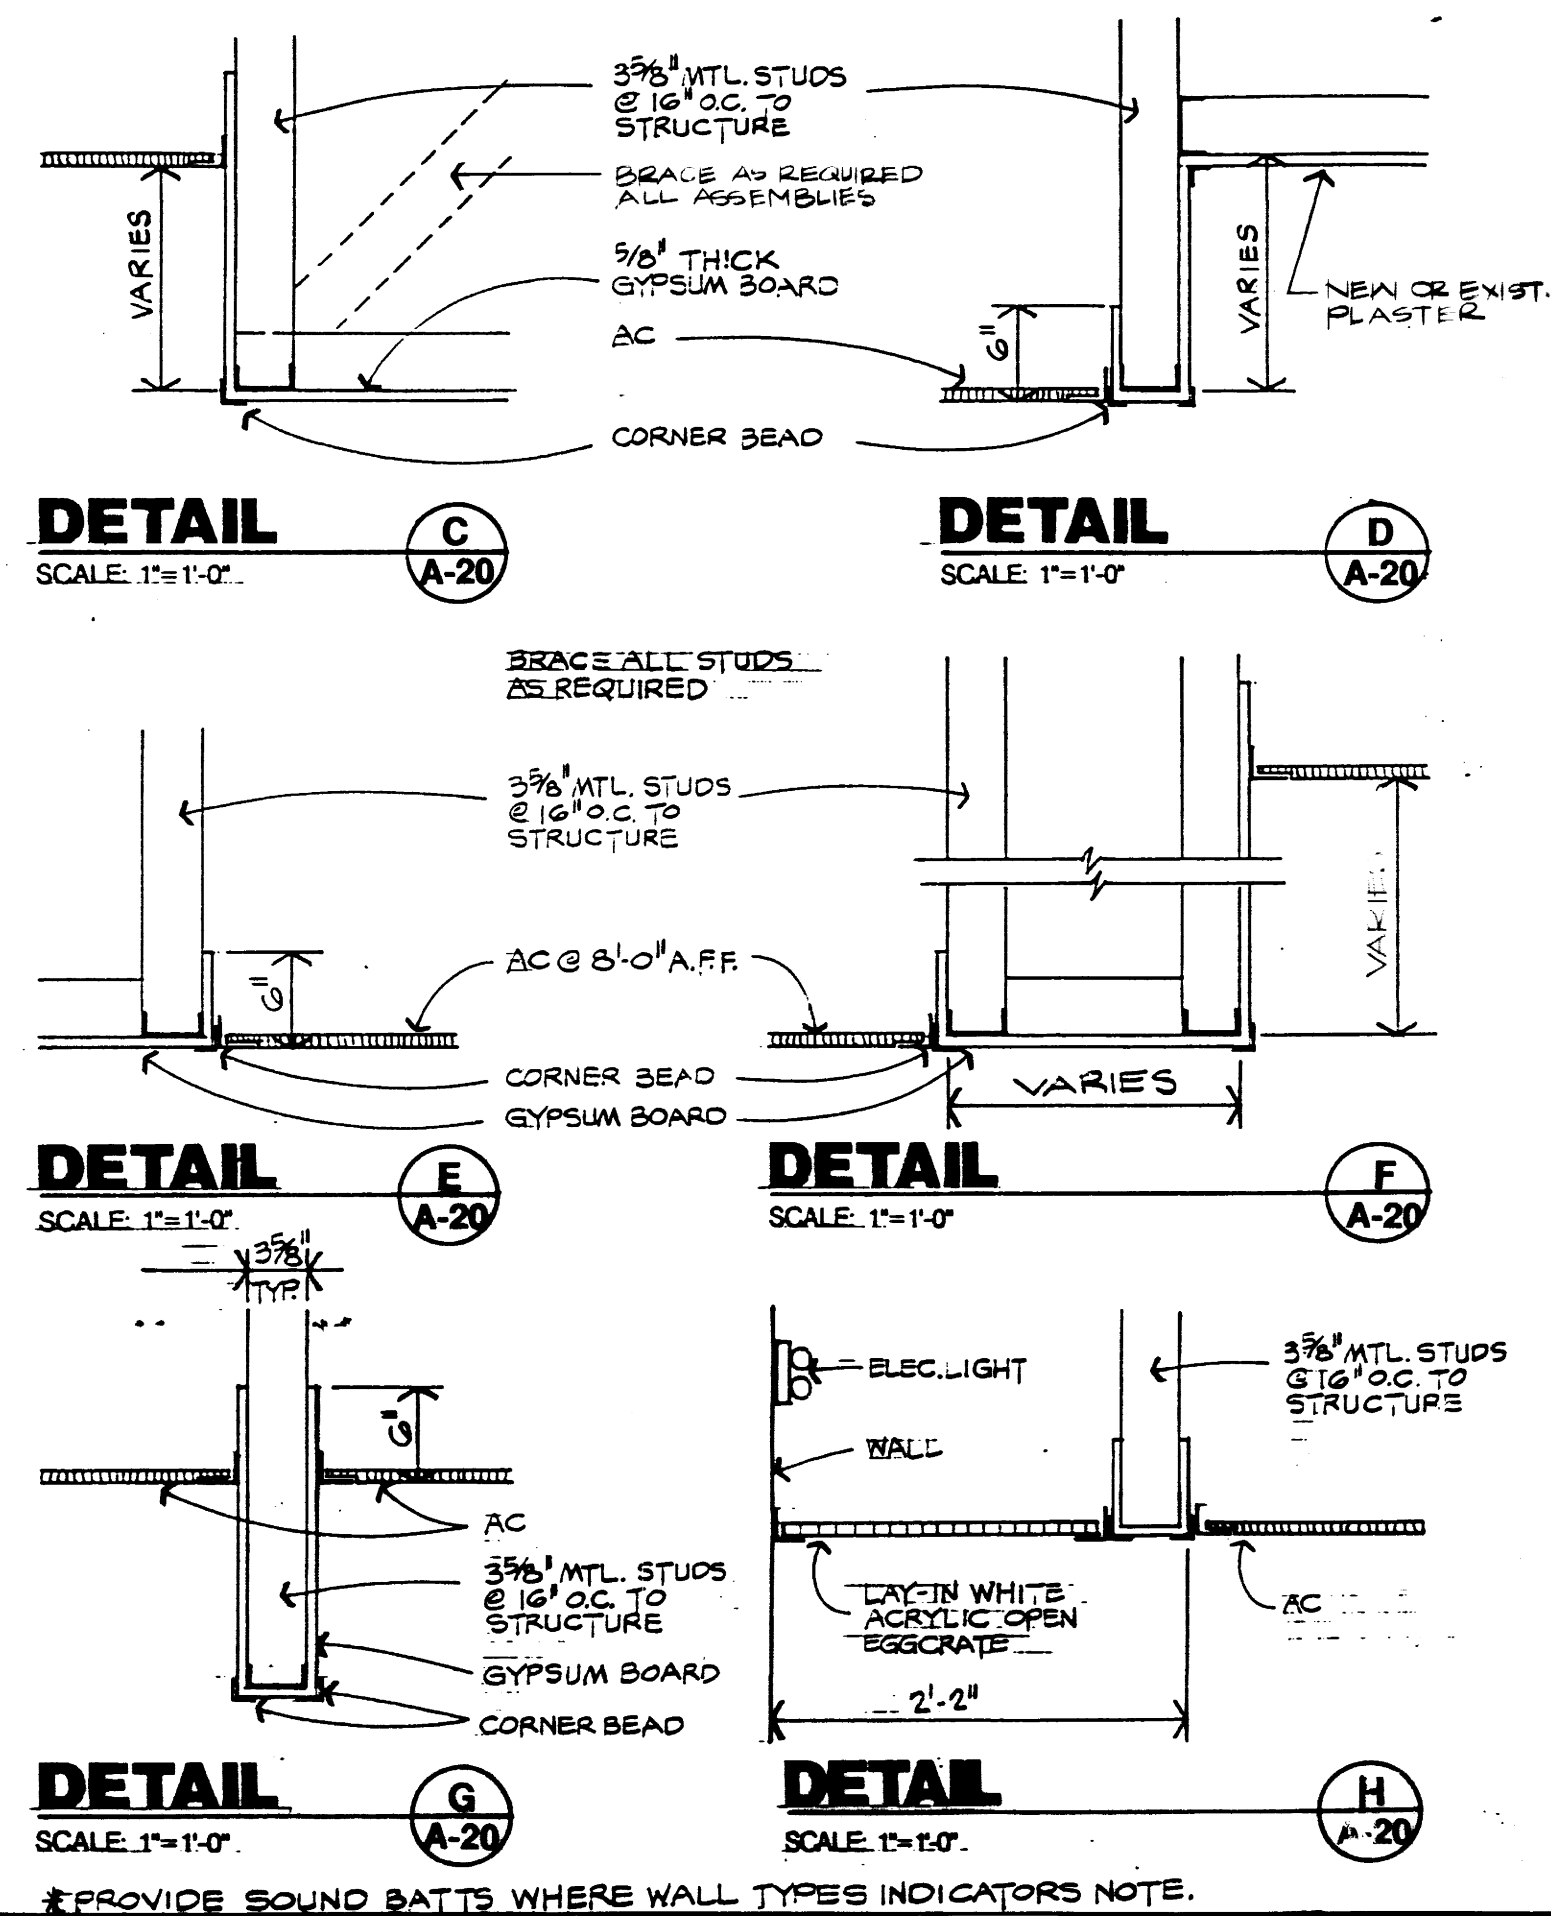


DETAIL  **DETAIL**
SCALE: 1"=1'-0" SCALE: 1"=1'-0"
*PROVIDE SOUND BATTS WHERE WALL TYPES INDICATORS NOTE.

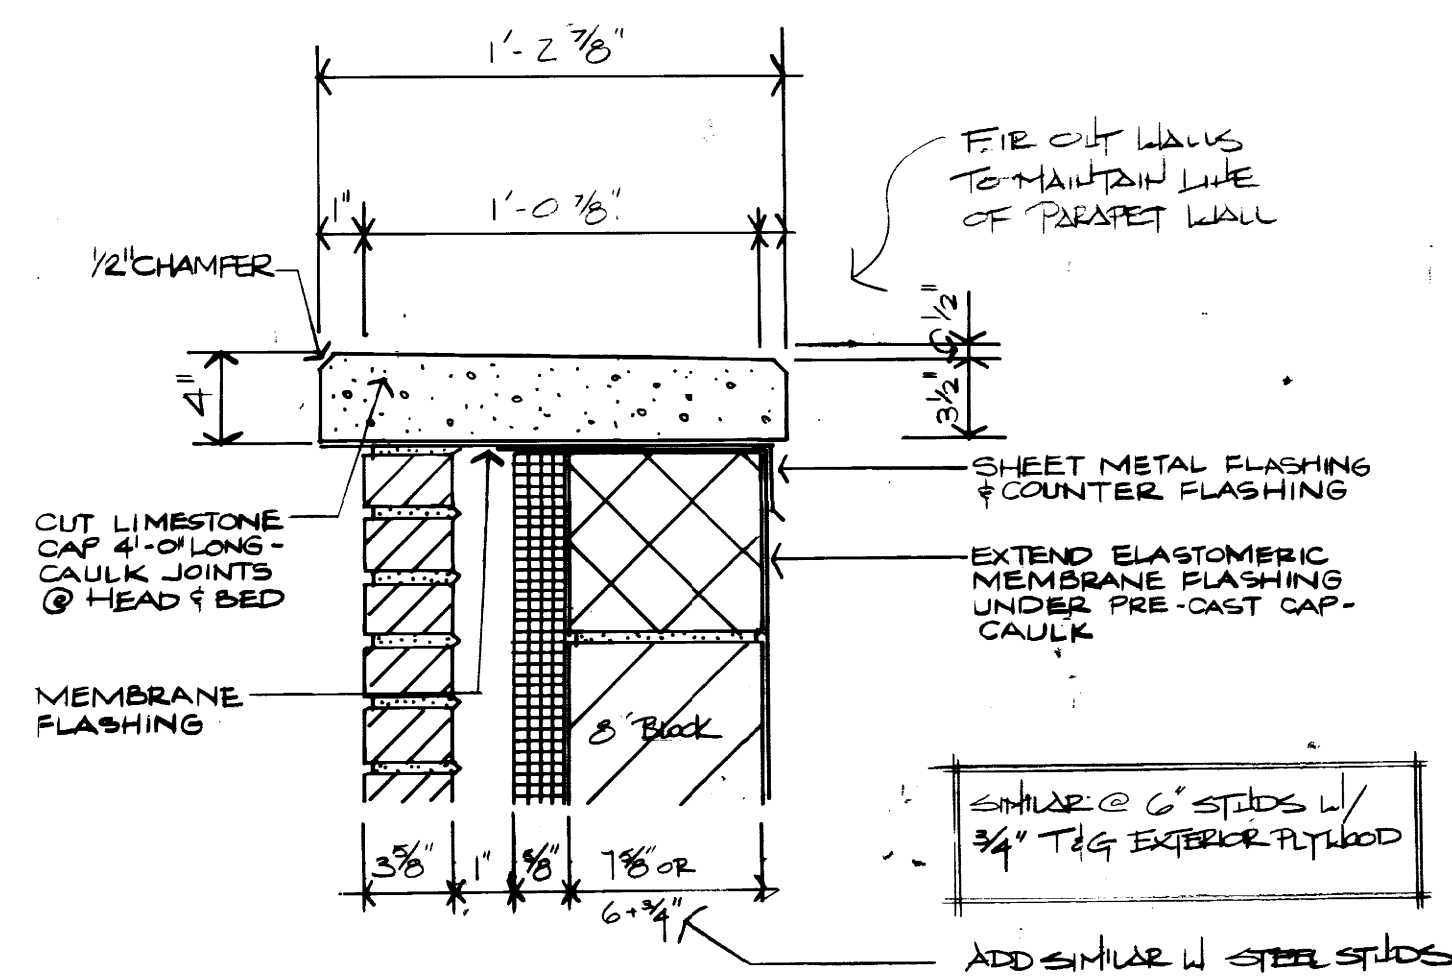


DETAIL

SCALE: $1 \frac{1}{2}'' = 1' - 0''$


I
A-20

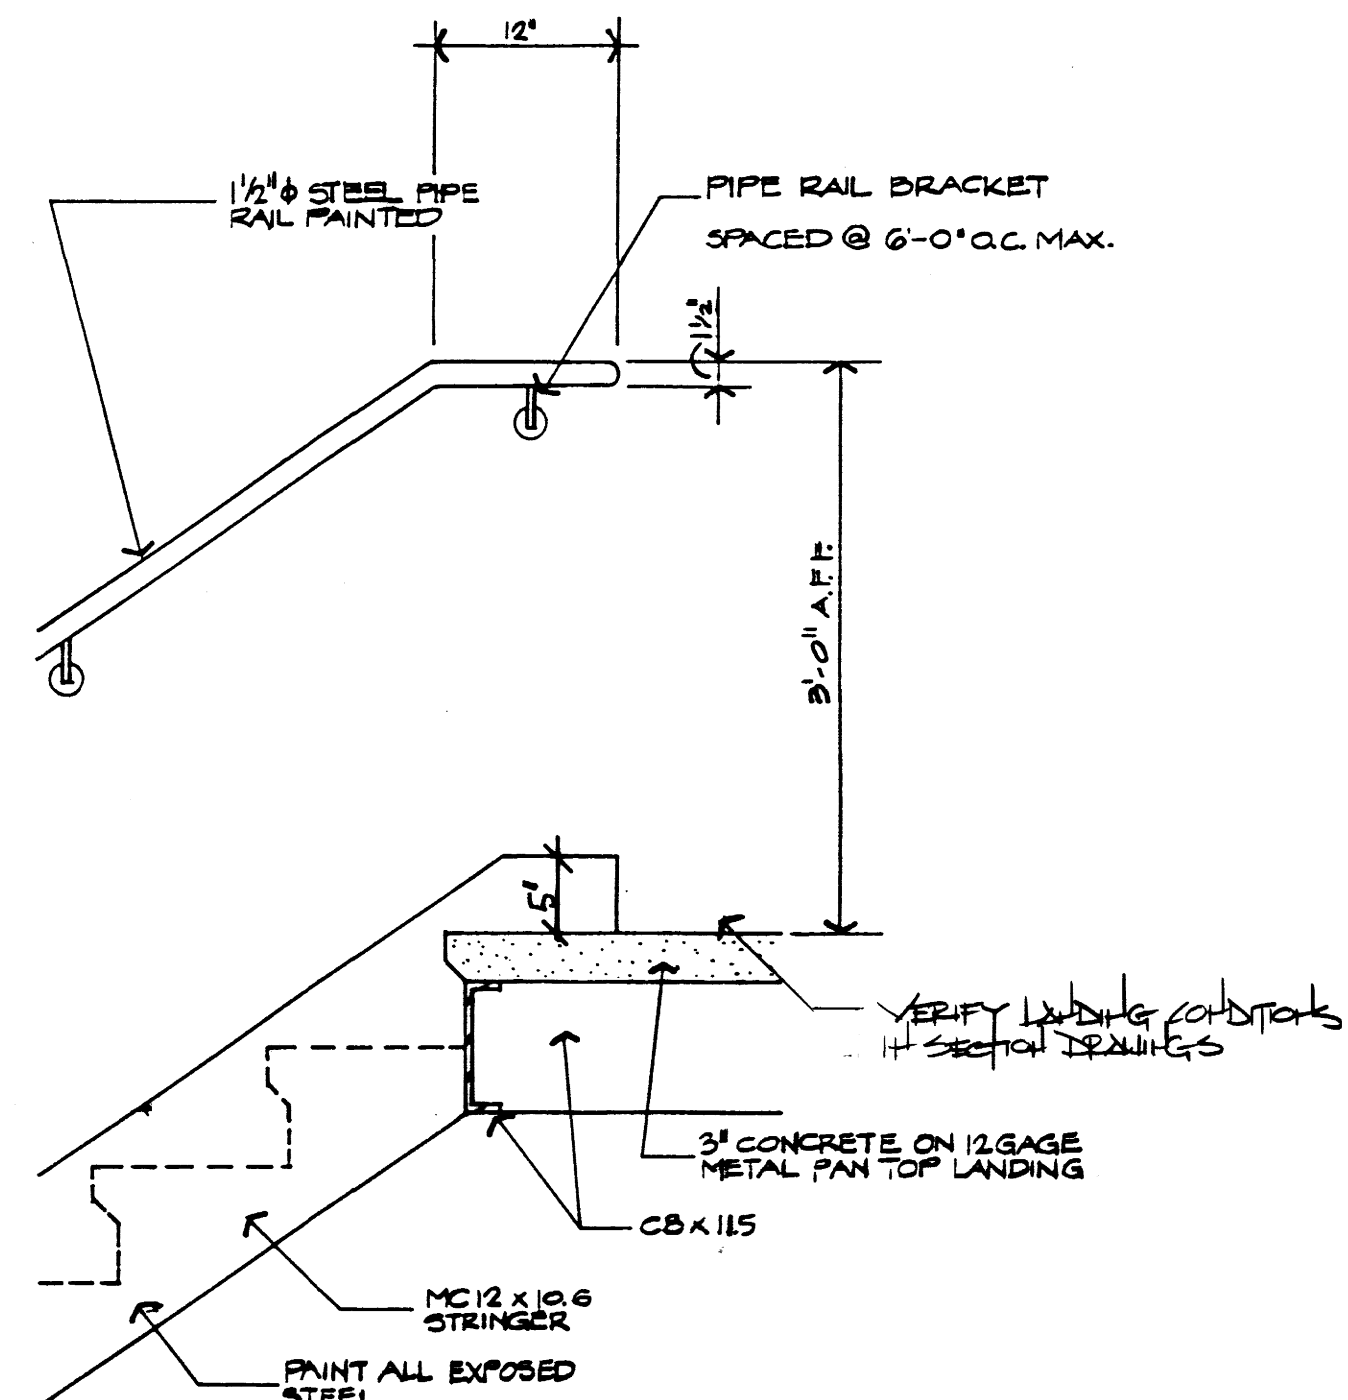

DETAIL
SCALE: 1" = 1' - 0"

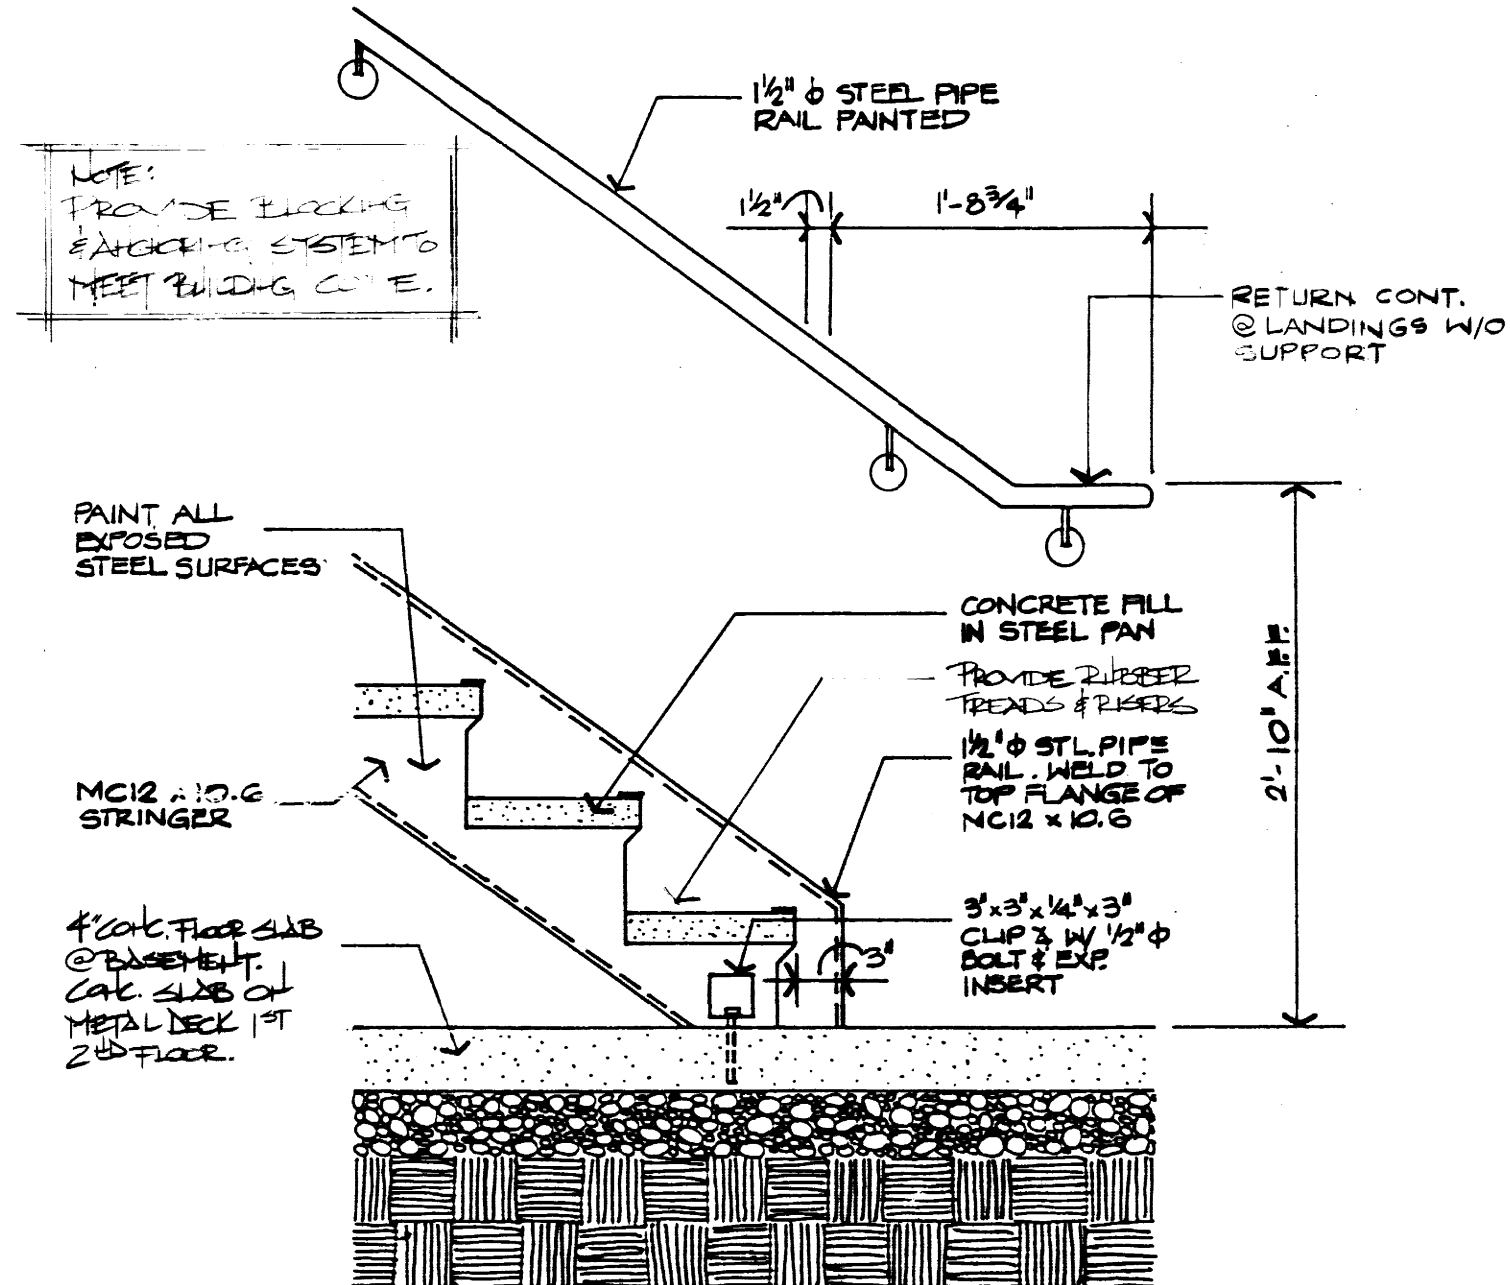


DETAIL K
A-2
SCALE 1" = 1'-0"

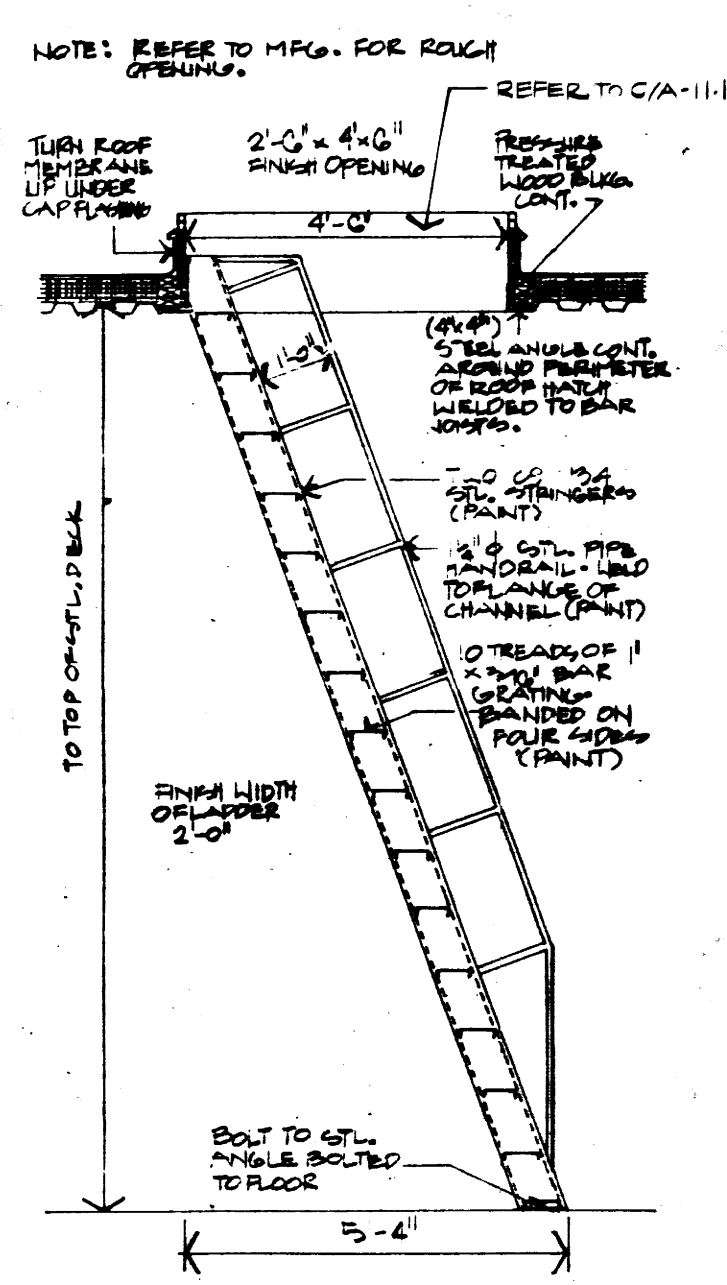


ROOF SCUTTLE/ LADDER

SCALE: 3/8" = 1'-0"

L
A-20

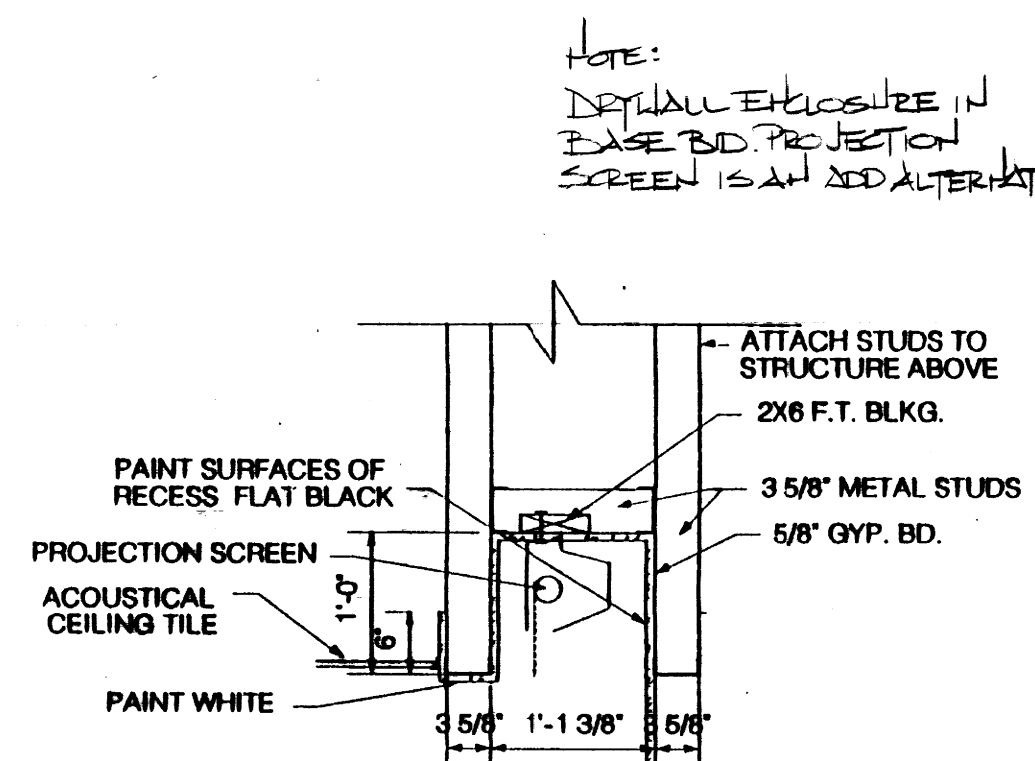


DETAIL
SCALE: 3/4" = 1'-0"

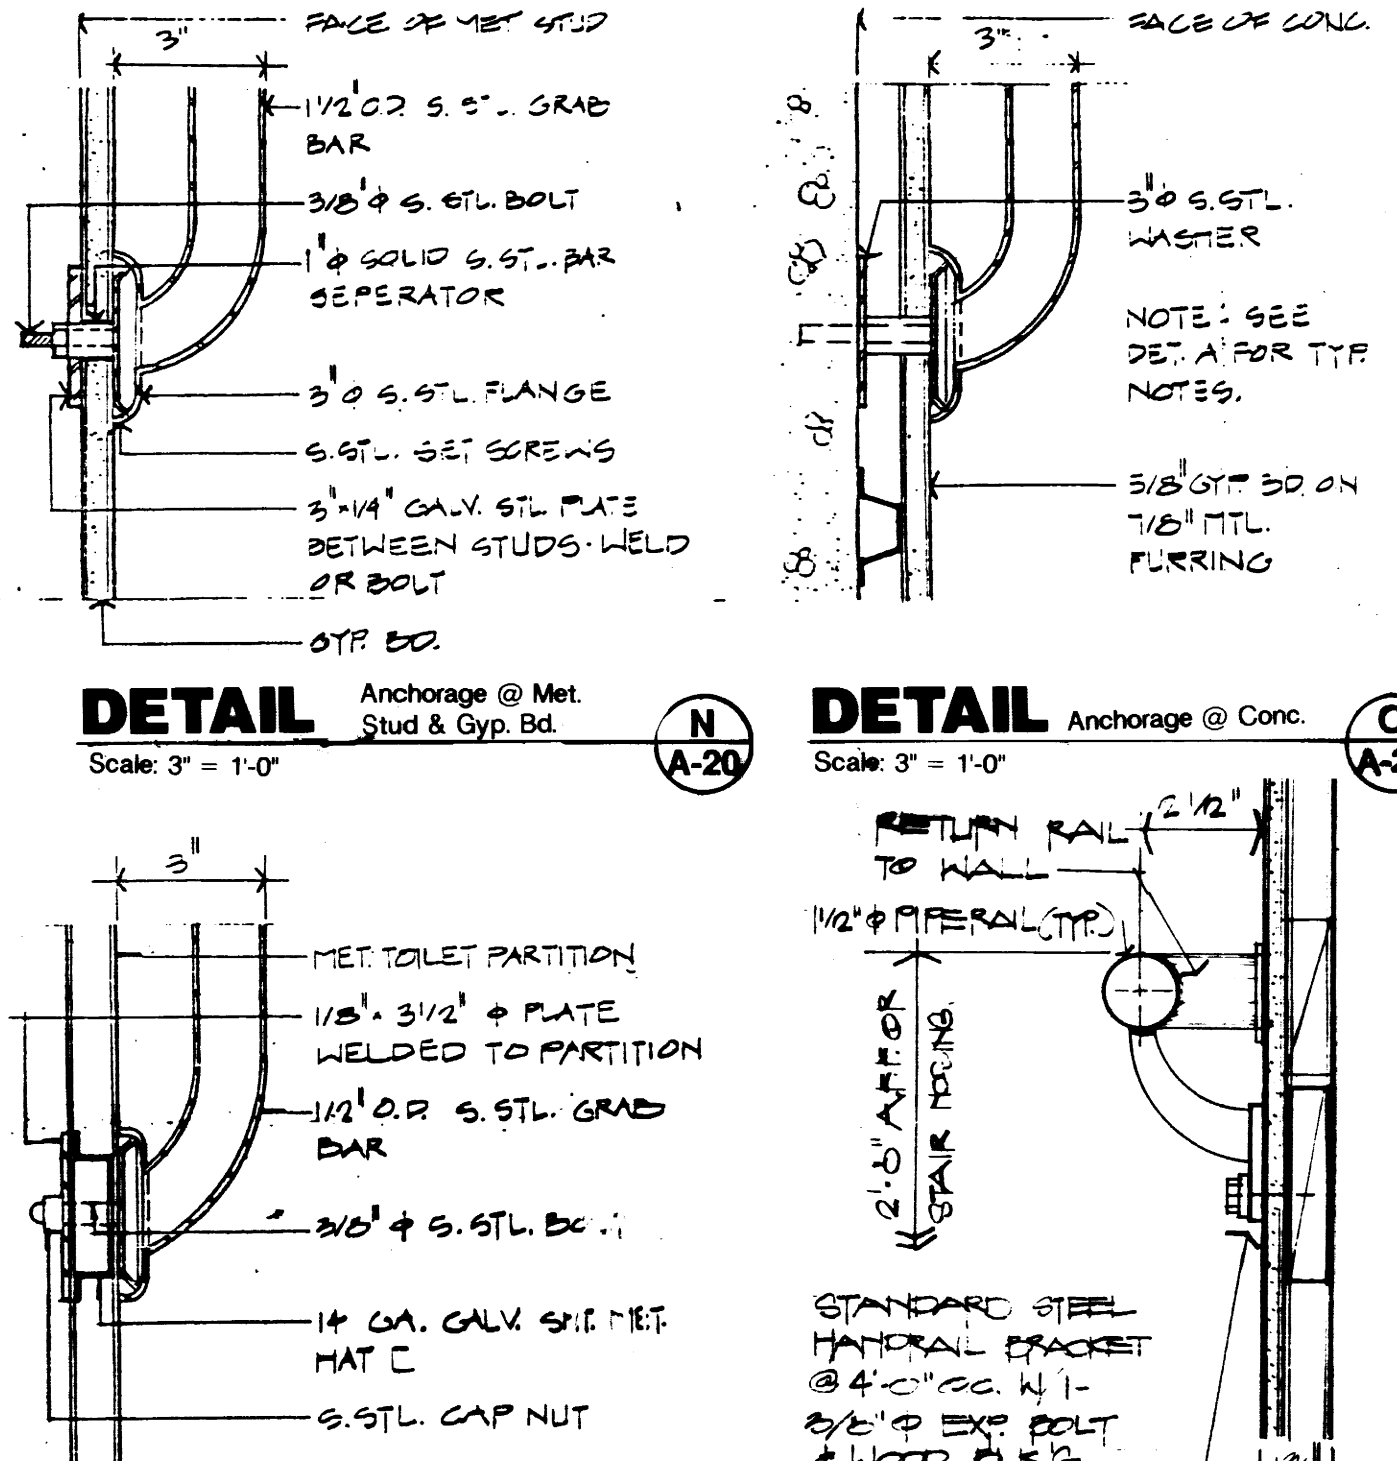


DETAIL Anchorage @ Metal Toilet Partition
Scale: 3" = 1'-0" **P**
A-20

DETAIL **Z**
SCALE: 3" = 1'-0" **A-21**

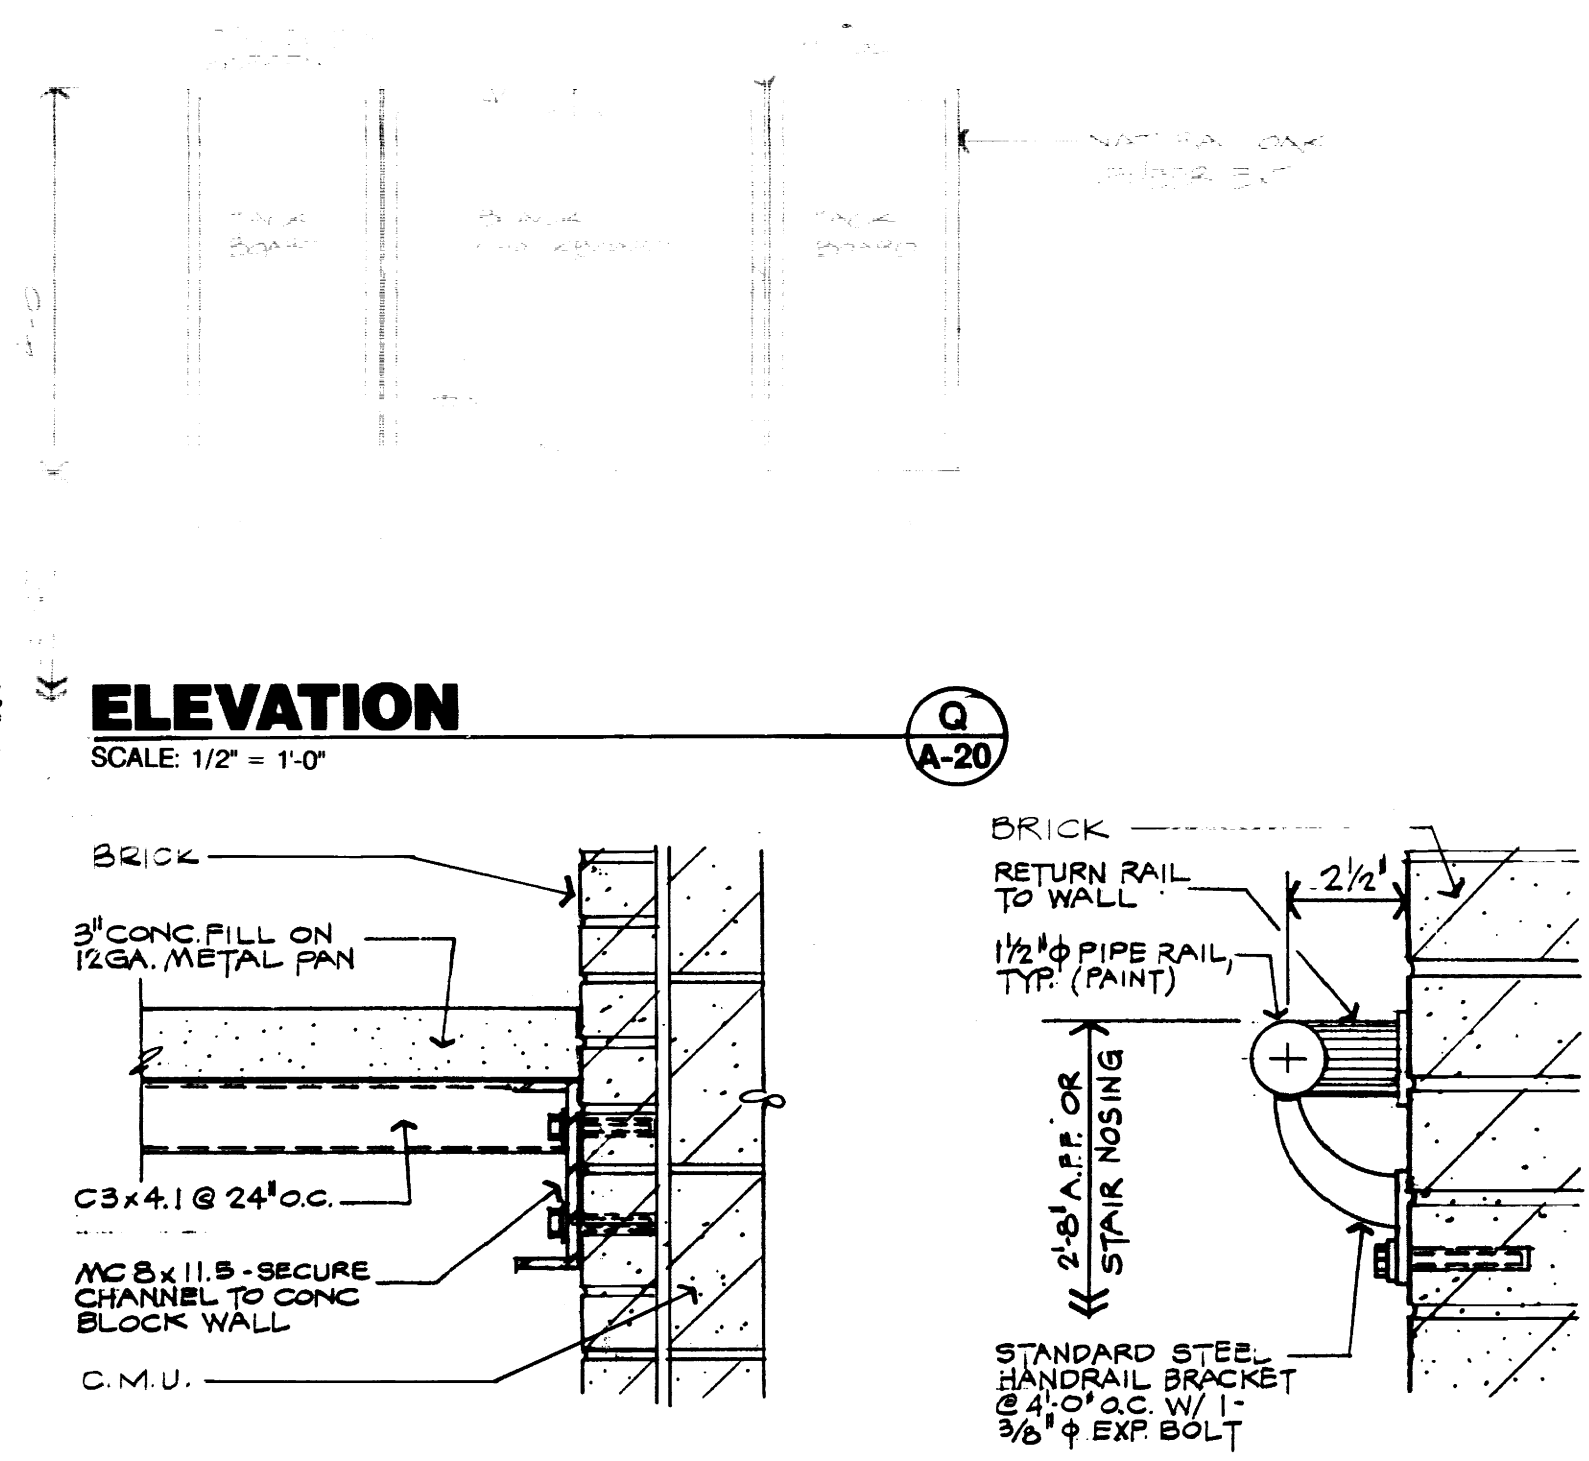


<p>DETAIL</p> <p>SCALE: 11/2"=1'-0"</p>	<p>DETAIL</p> <p>SCALE: 3"=1'-0"</p>
--	---

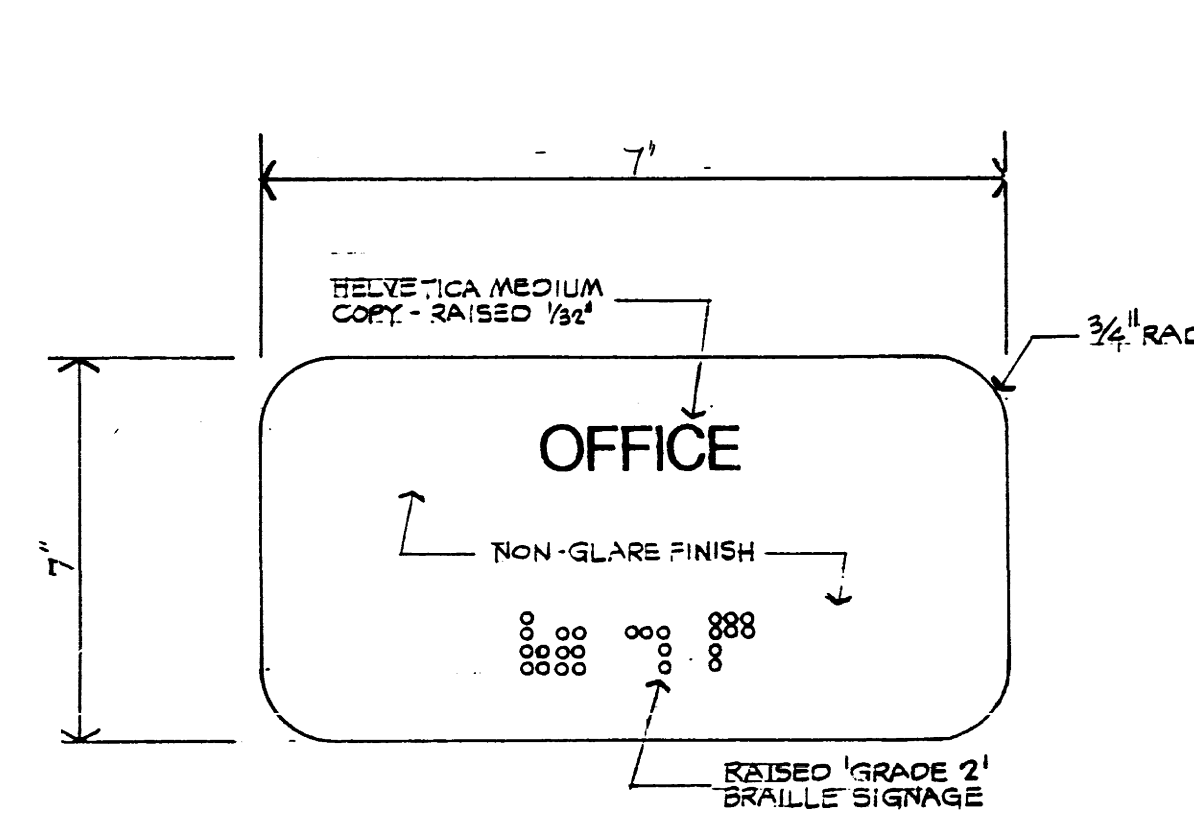

DETAIL - ROOM SIGNAGE


HALF SCALE

T
A-20

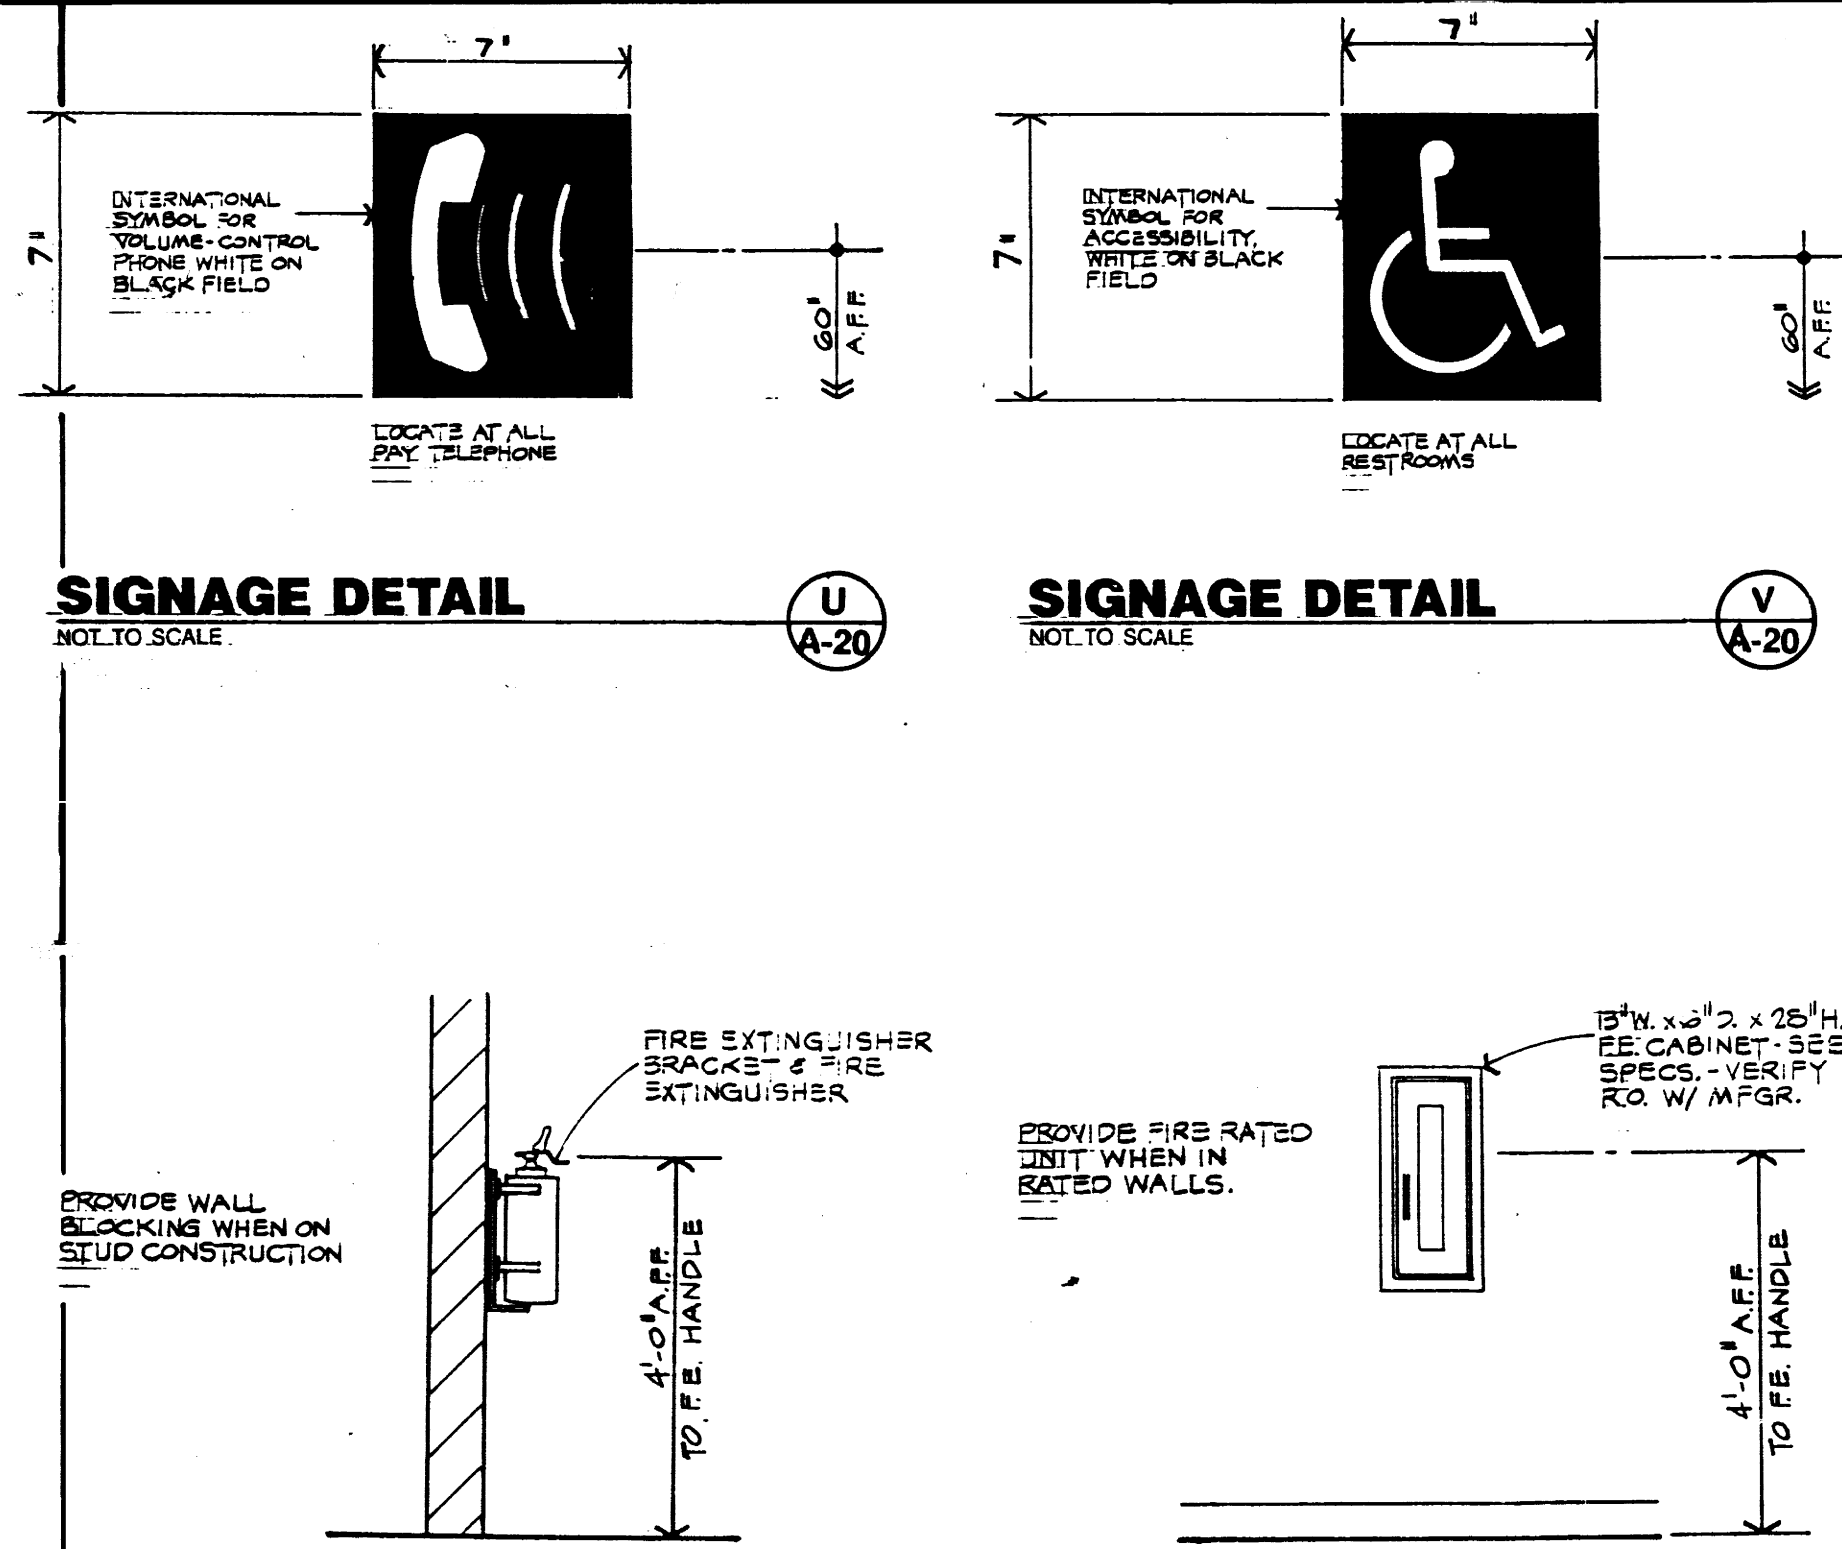


DETAIL  **ELEVATION** 
 SCALE: 1/2" = 1'-0" SCALE: 1/2" = 1'-0"


SCOVELL HALL RENOVATION

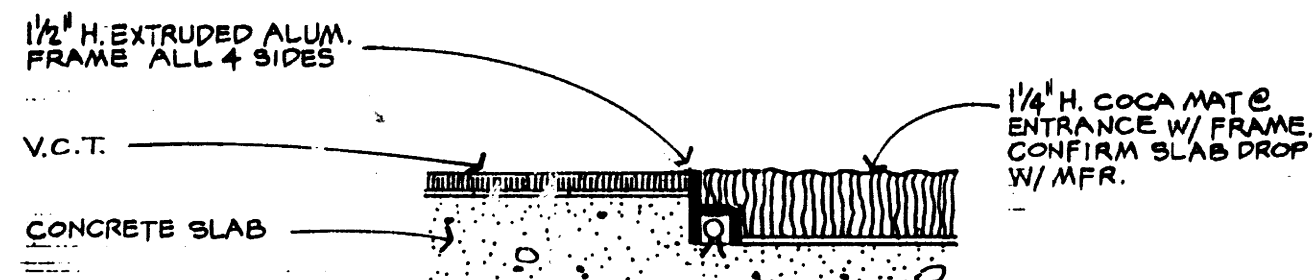


THRESHOLD DETAIL
NTS. (A-21)

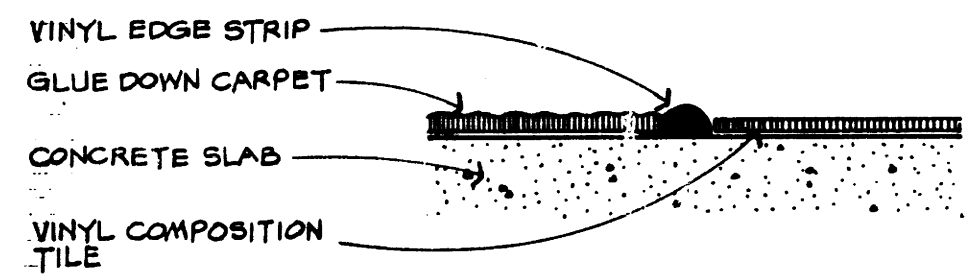


THRESHOLD DETAIL
NTS. (B-21)

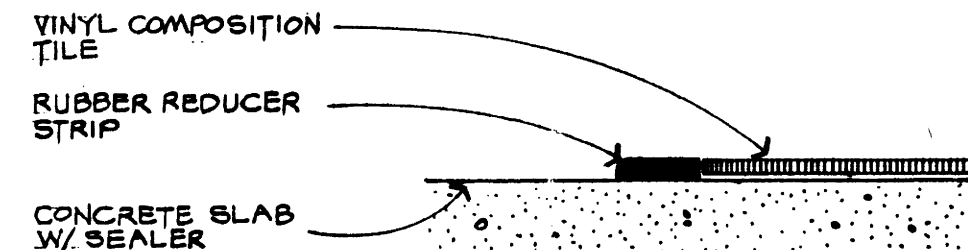


THRESHOLD DETAIL
NOT TO SCALE (C-21)

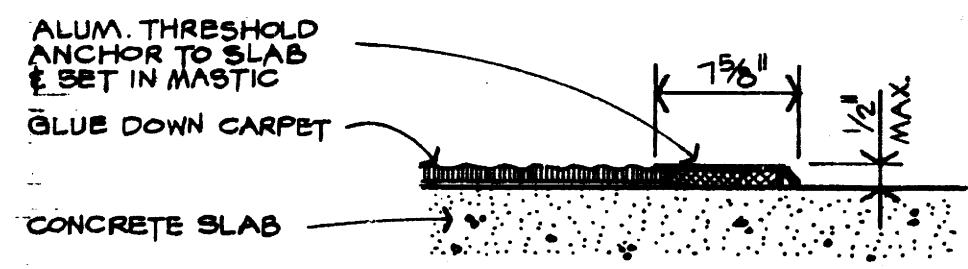

THRESHOLD DETAIL
NOT TO SCALE (D-21)

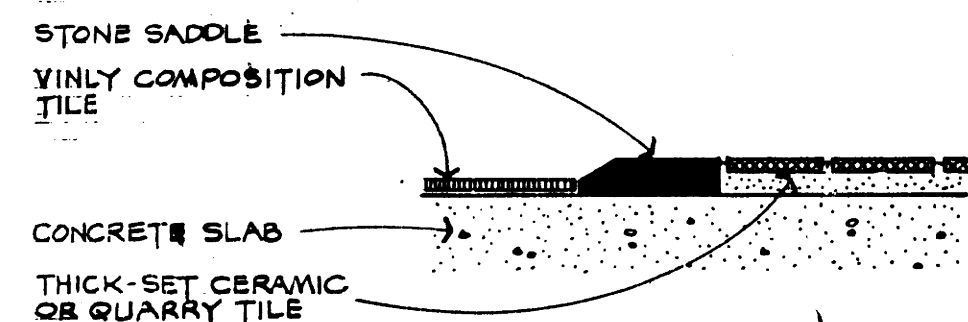

THRESHOLD DETAIL
NOT TO SCALE (E-21)

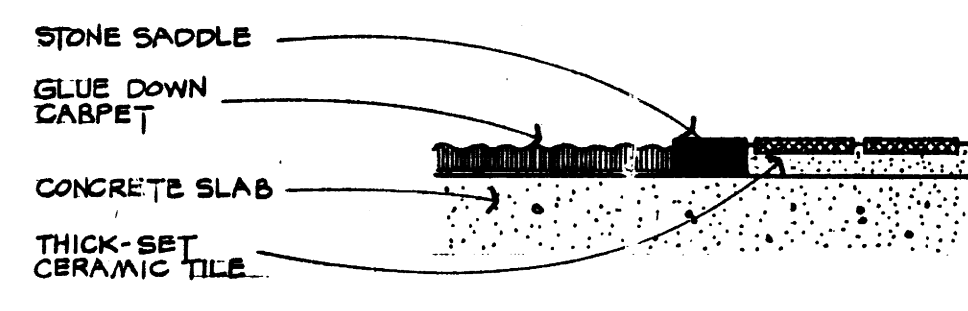


THRESHOLD DETAIL
NTS. (F-21)

OPENING	8" BLOCK		12" BLOCK		8" BLOCK & 4" VENEER		12" BLOCK & 4" VENEER	
	SIZE	SHAPE	SIZE	SHAPE	SIZE	SHAPE	SIZE	SHAPE
0 TO 4'-0"	3'-1/2" x 3'-1/2" x 1/4"	I	3'-1/2" x 3'-1/2" x 1/4"	I	3'-1/2" x 3'-1/2" x 1/4"	I	3'-1/2" x 3'-1/2" x 1/4"	I
4'-1" TO 6'-0"	W8 x 13 W/ R 7/16 x 7	I	W8 x 13 W/ R 7/16 x 7	I	W8 x 13 W/ R 7/16 x 7	I	W8 x 13 W/ R 7/16 x 7	I
6'-1" TO 8'-0"	W8 x 15 W/ R 7/16 x 7	I	W8 x 15 W/ R 7/16 x 7	I	W8 x 15 W/ R 7/16 x 7	I	W8 x 15 W/ R 7/16 x 7	I
8'-1" TO 10'-0"	W8 x 15 W/ R 7/16 x 7	I	W8 x 15 W/ R 7/16 x 7	I	W8 x 15 W/ R 7/16 x 7	I	W8 x 15 W/ R 7/16 x 7	I
10'-1" TO 12'-0"	W8 x 15 W/ R 7/16 x 7	I	W8 x 15 W/ R 7/16 x 7	I	W8 x 15 W/ R 7/16 x 7	I	W8 x 15 W/ R 7/16 x 7	I
12'-1" TO 14'-0"	W8 x 21 W/ R 7/16 x 7	I	W8 x 21 W/ R 7/16 x 7	I	W8 x 21 W/ R 7/16 x 7	I	W8 x 21 W/ R 7/16 x 7	I
14'-1" TO 16'-0"	W8 x 21 W/ R 7/16 x 7	I	W8 x 21 W/ R 7/16 x 7	I	W8 x 21 W/ R 7/16 x 7	I	W8 x 21 W/ R 7/16 x 7	I
16'-0" TO 24'-0"	W12 x 36 W/ R 7/16 x 15	I	W12 x 36 W/ R 7/16 x 15	I	W12 x 36 W/ R 7/16 x 15	I	W12 x 36 W/ R 7/16 x 15	I


THIS LINTEL SCHEDULE IS FOR ALL MASONRY OPENINGS SHOWN ON THE ARCHITECTURAL, MECHANICAL AND ELECTRICAL DRAWINGS. BOTTOM PLATE WIDTH MAY VARY FOR PARTICULAR OPENING. VERIFY WITH SHOP DRAWINGS. REF. TO DRAWINGS FOR LOCATIONS OF PRECAST CONCRETE LINTELS, AND SPECIAL METAL LINTELS. EXPOSED CORNERS TO HAVE 1/4" PLATE VERTICAL RISERS AT 4'-0" O.C.

LINTEL SCHEDULE
(A-21)

DETAIL
NTS. (G-21)

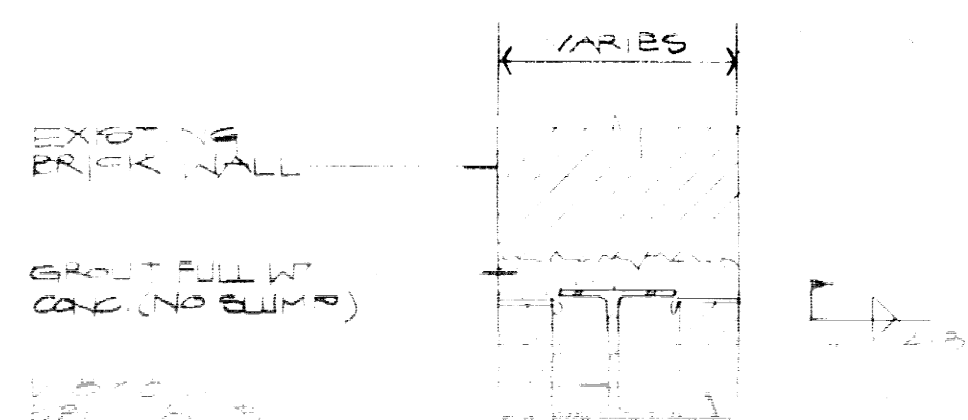


DETAIL
NTS. (H-21)

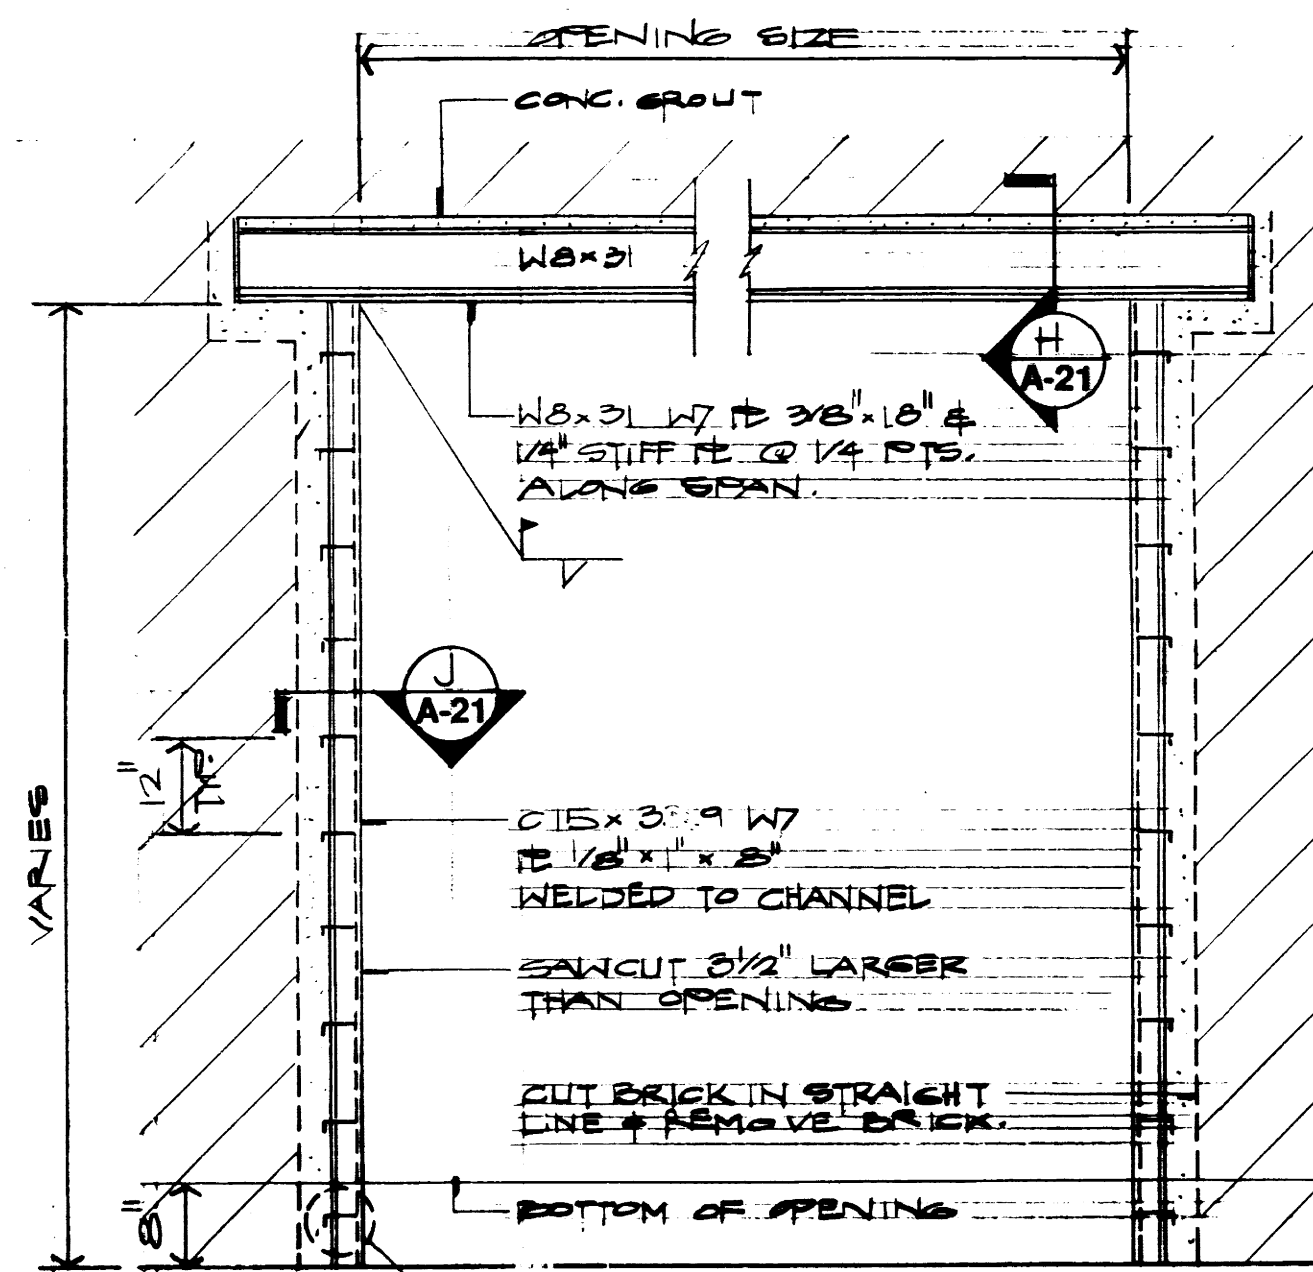


SECTION
SCALE: 1/2" = 1'-0" (K-21)


SECTION
NTS. (I-21)

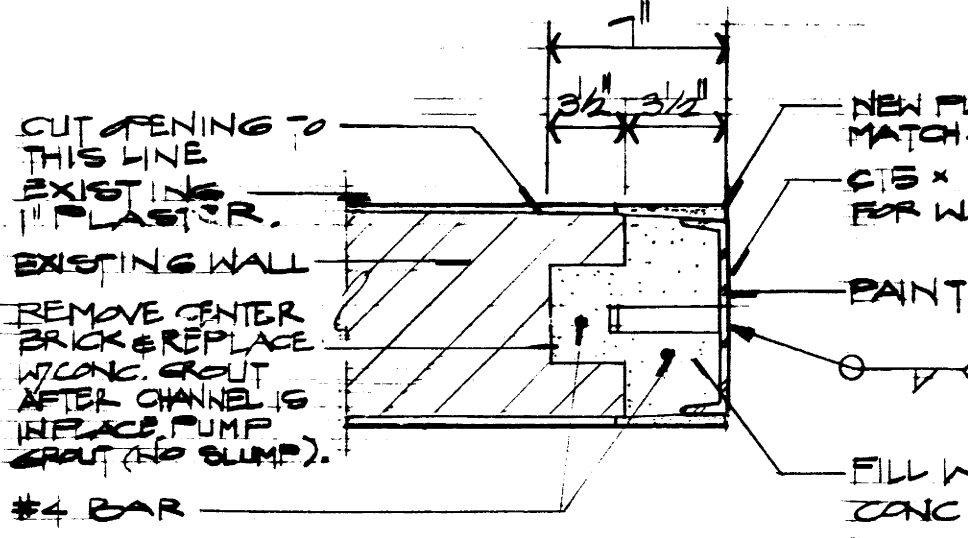


DETAIL
NTS. (J-21)

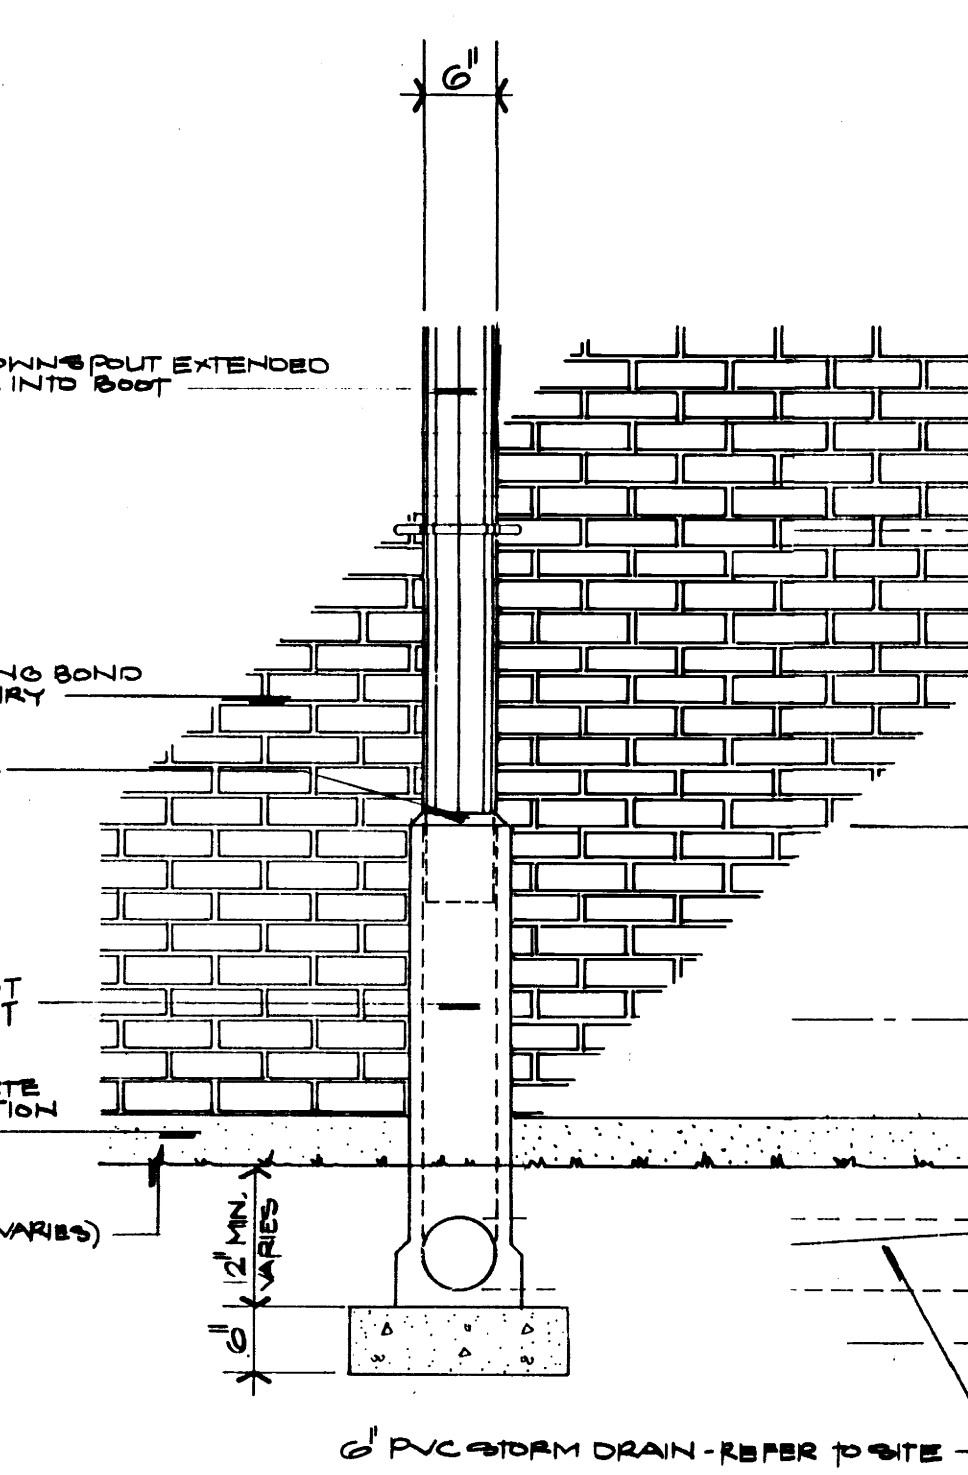


DOWNSPOUT DETAIL
SCALE: 3/4" = 1'-0" (L-21)

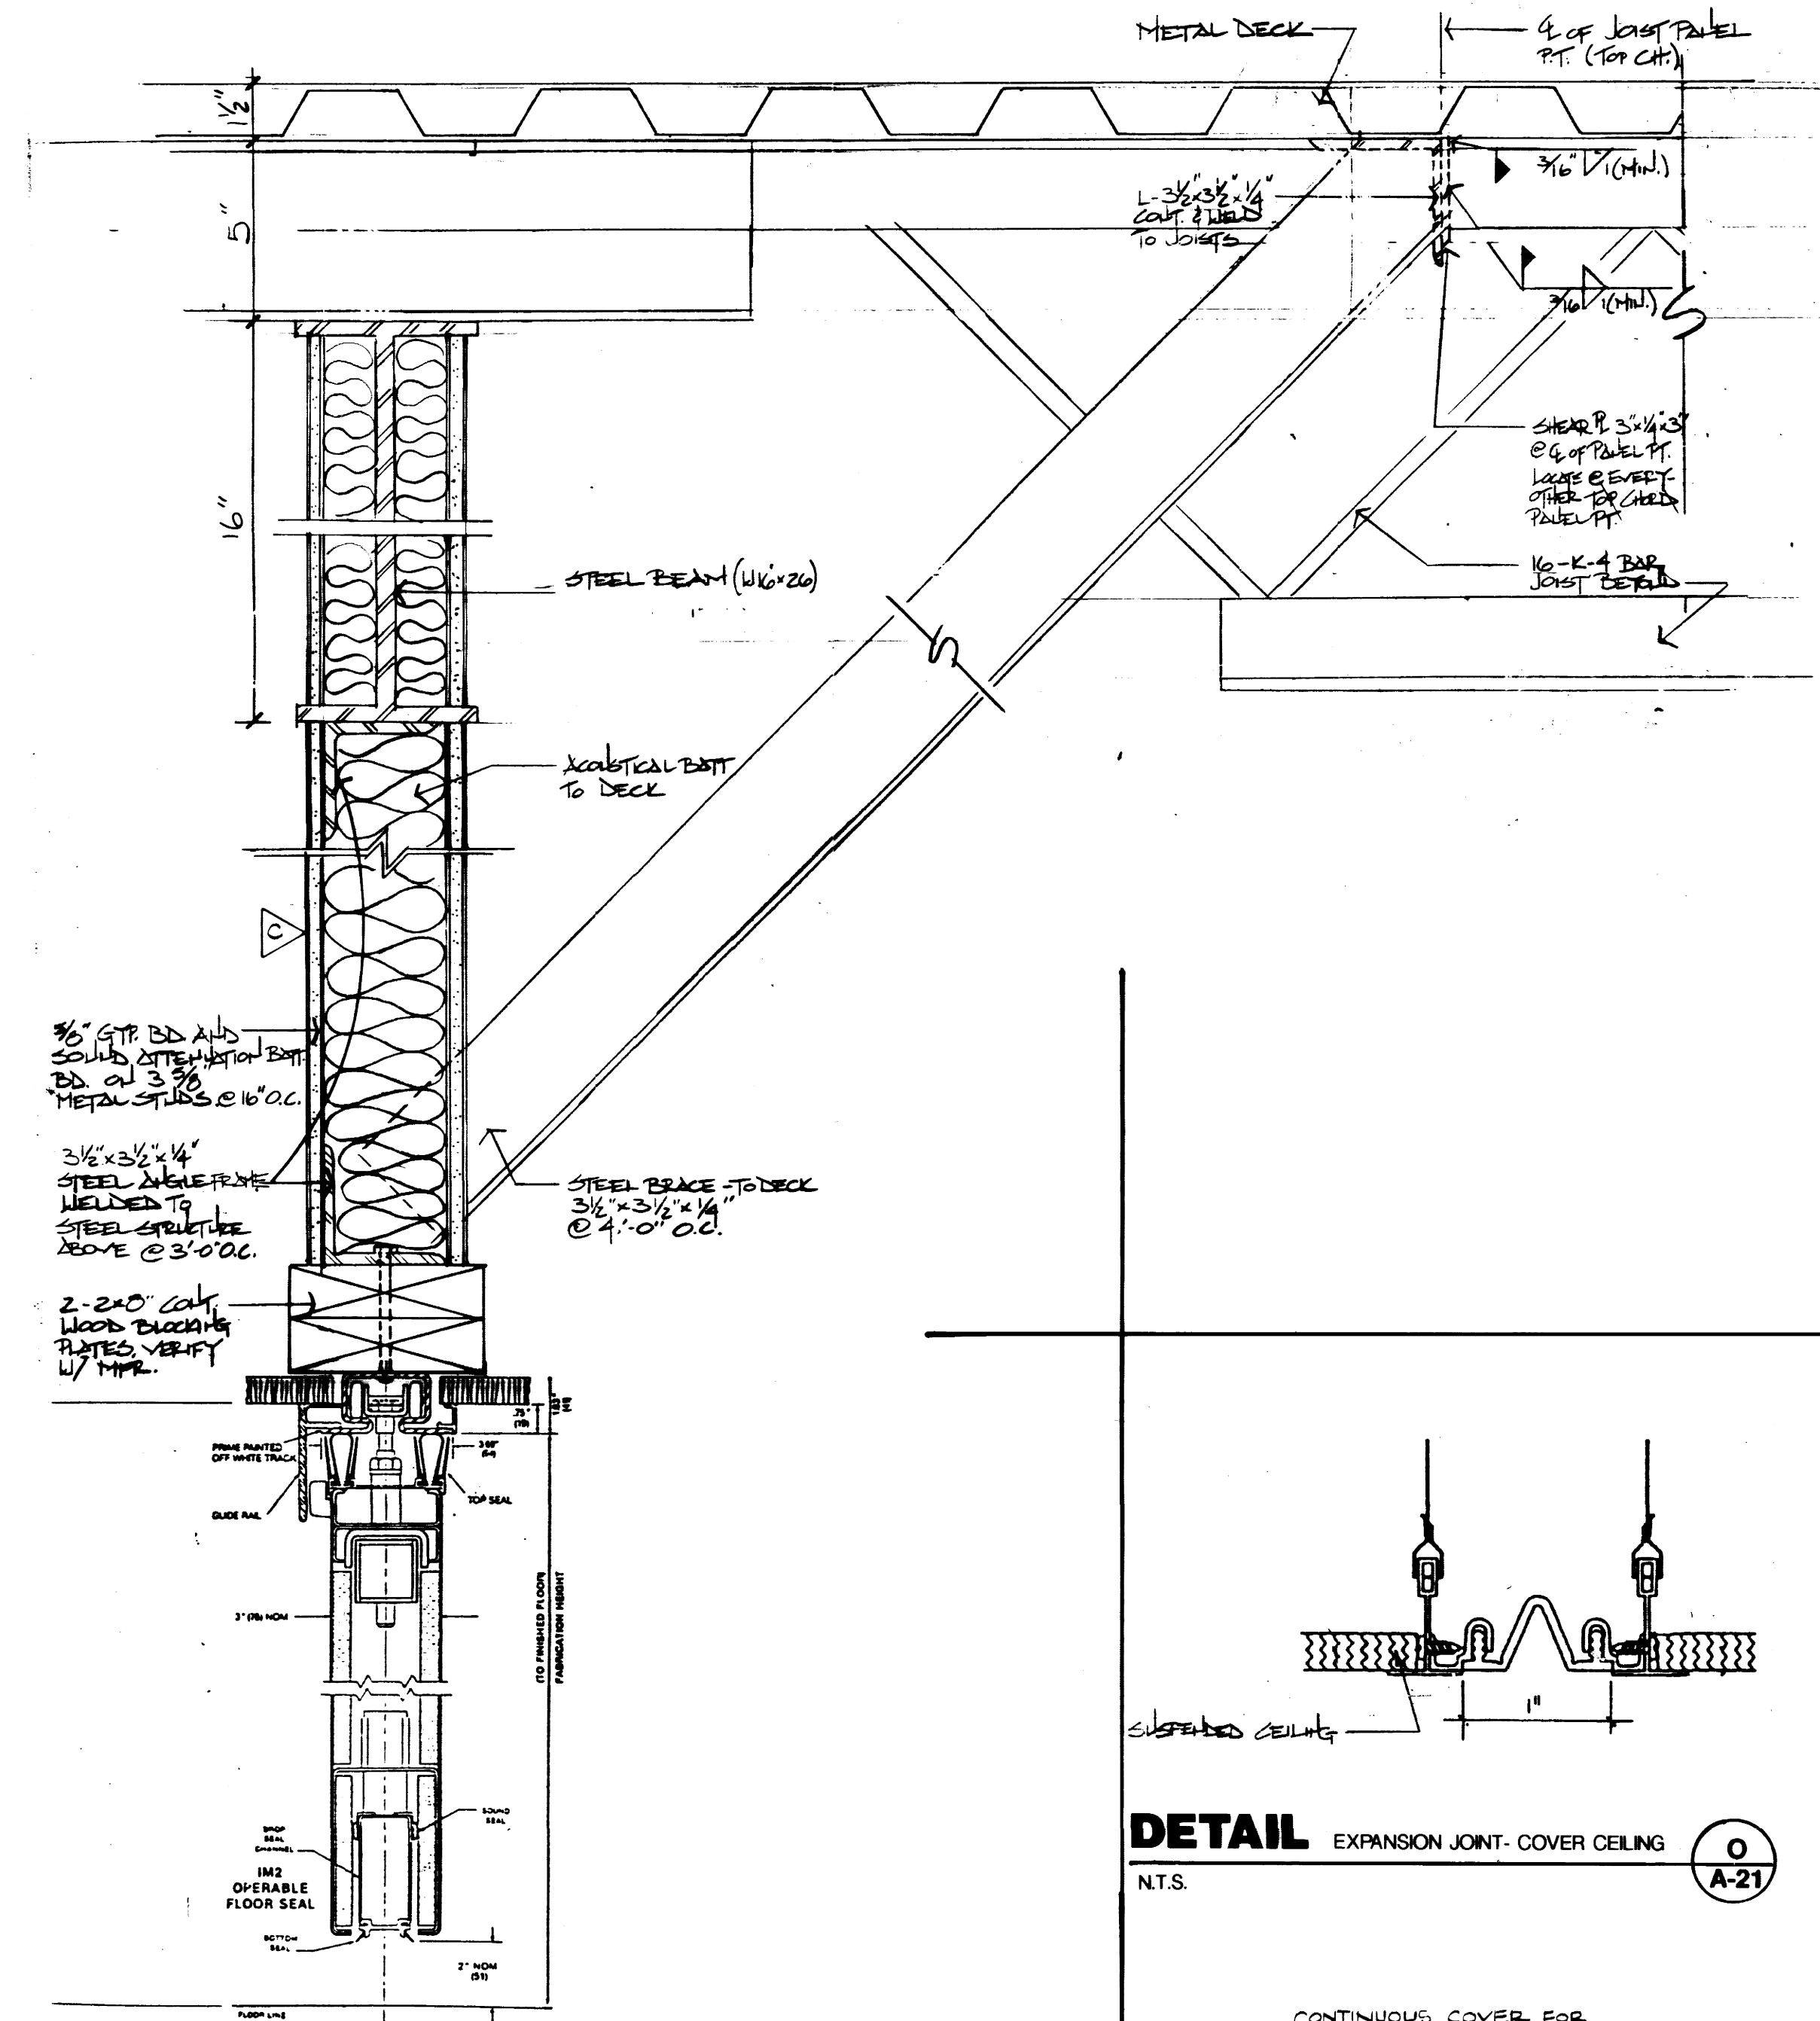


OPERABLE WALL TRACK
SCALE: 3/4" = 1'-0" (M-21)

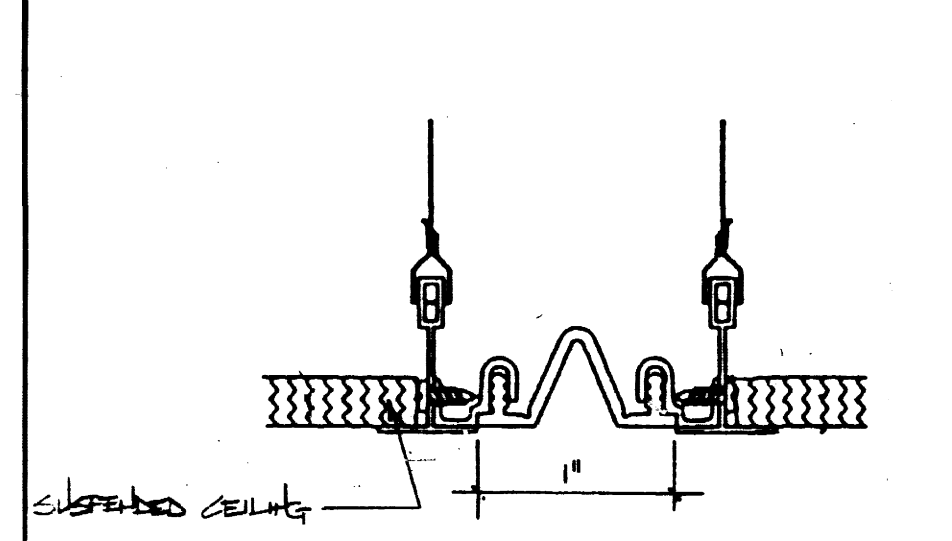

DETAIL
NTS. (N-21)

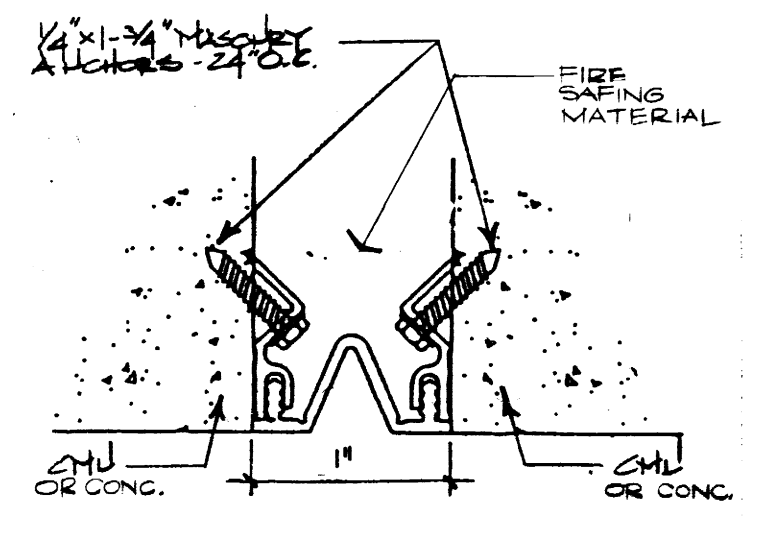

DETAIL
NTS. (O-21)

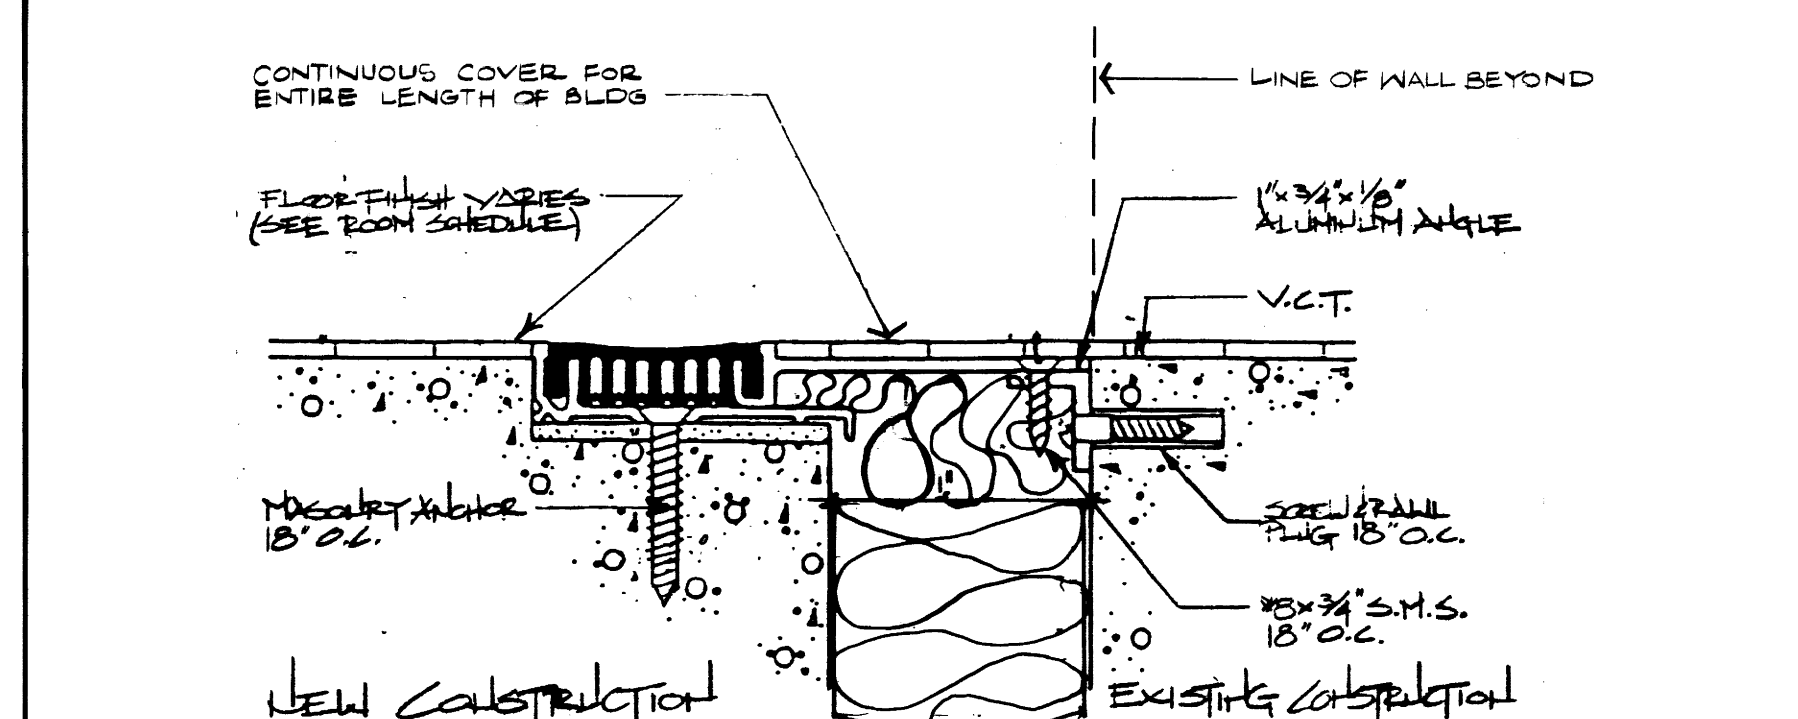


DETAIL
NTS. (P-21)

BASEMENT FLOOR PLAN - FURNITURE

SCALE 1/8" = 1'- 0"

SHADED AREAS DEMARK EXISTING AREAS TO REMAIN IN-USE DURING CONSTRUCTION BY AGRICULTURE-COMMUNICATIONS DEPARTMENT.

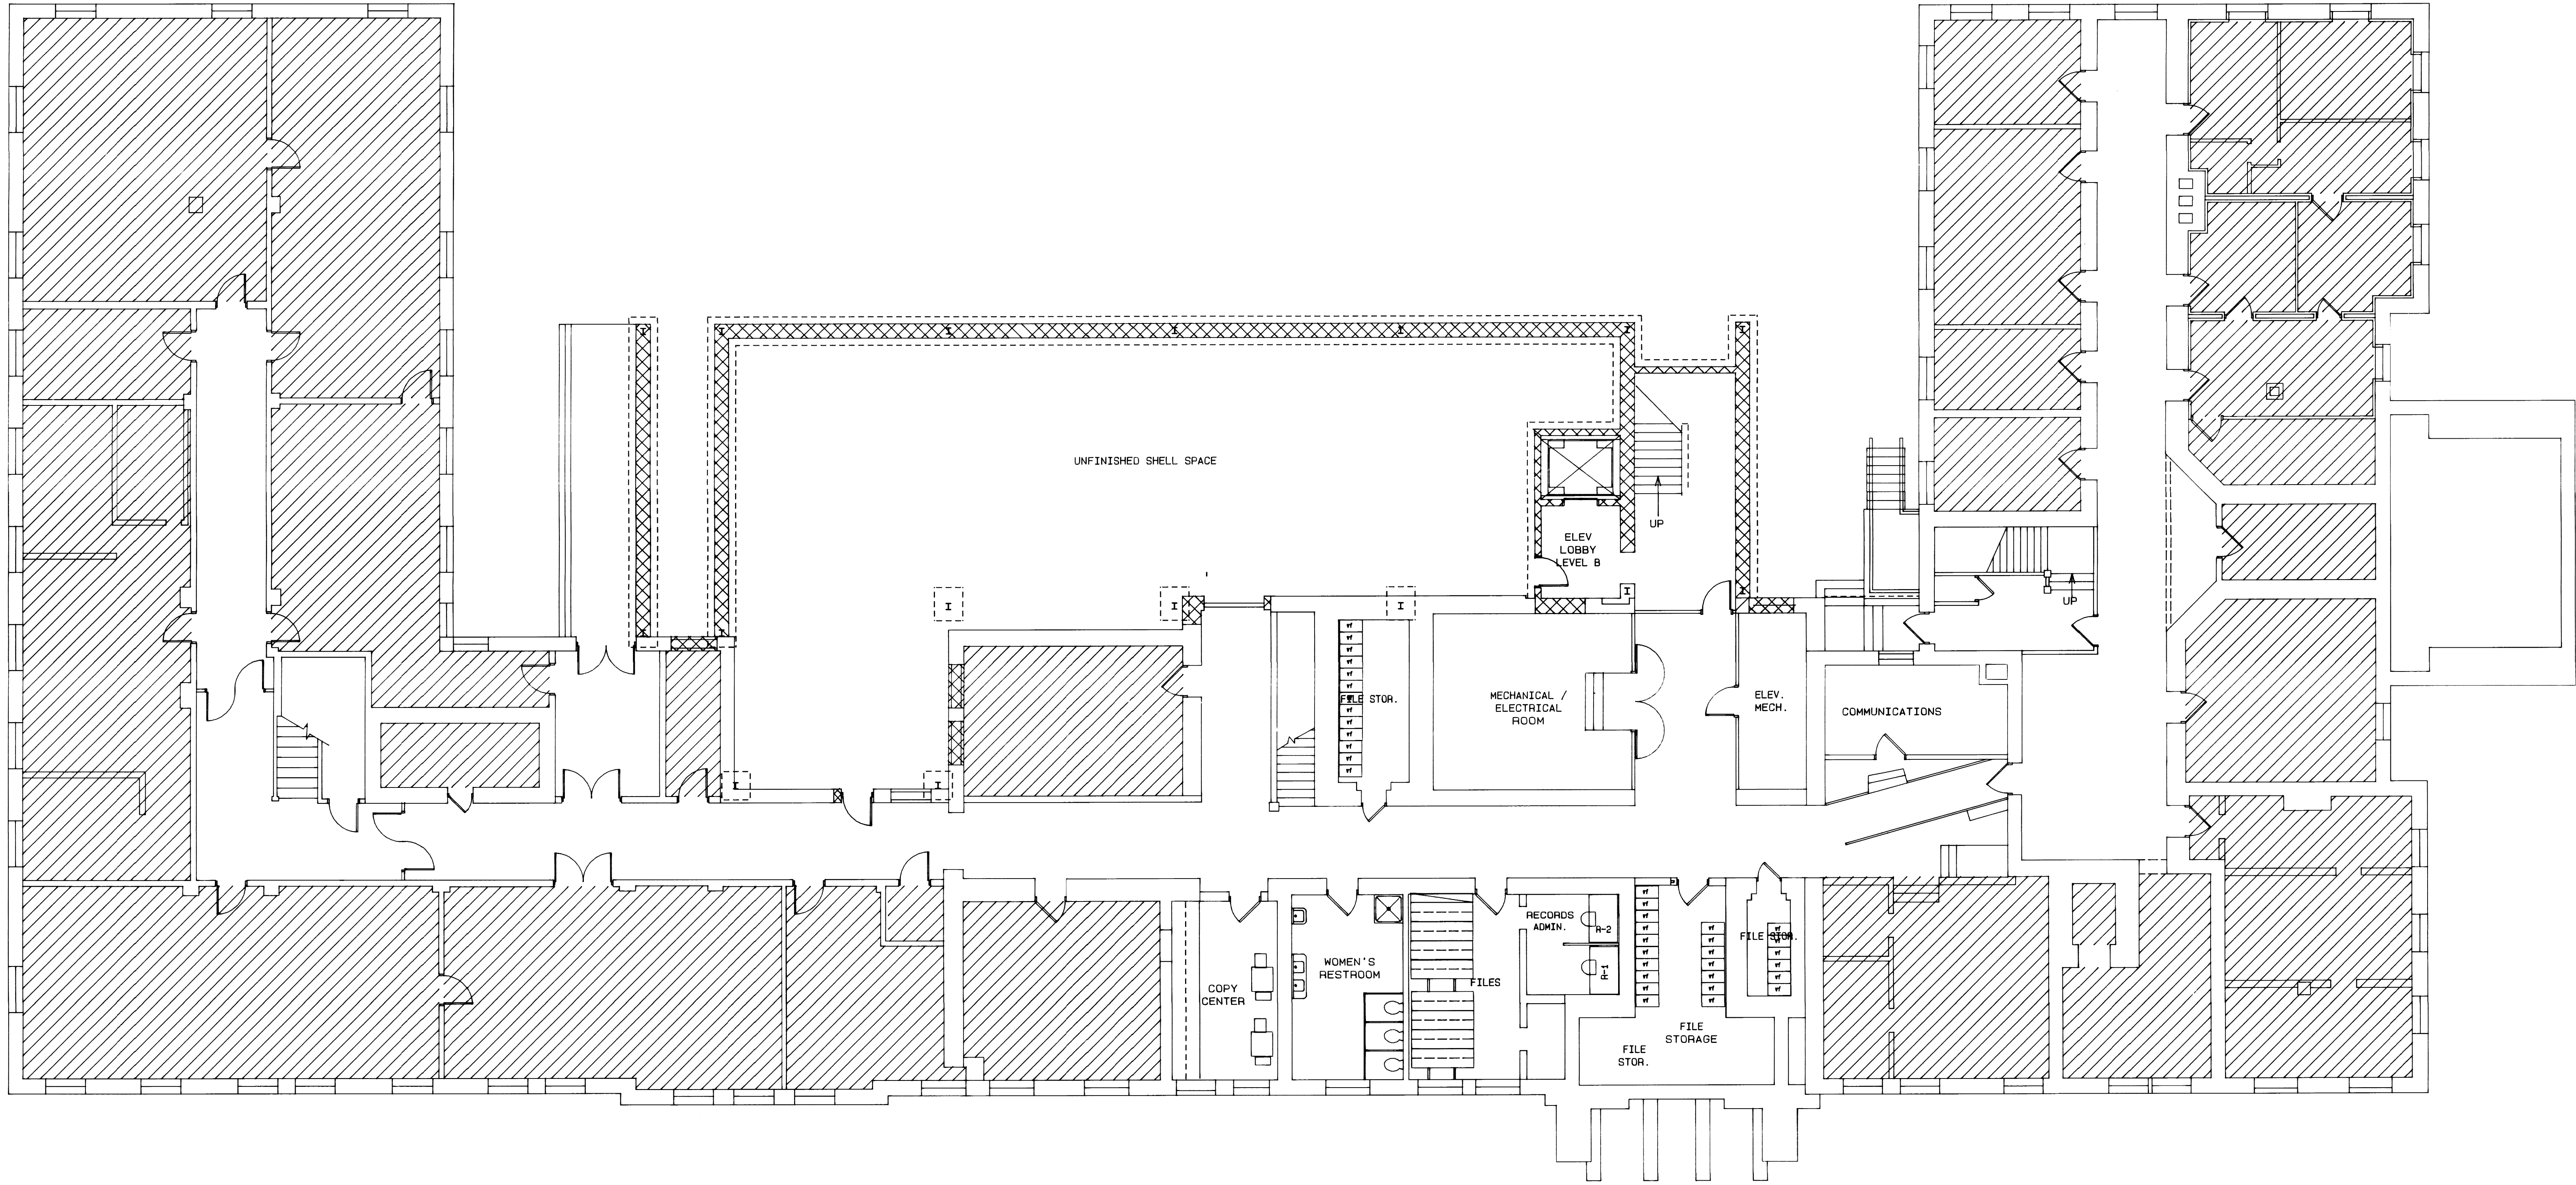

A
FR-1

SCD

UK

SCOVELL HALL RENOVATION

UNIVERSITY OF KENTUCKY

FURNITURE PLAN • FOR INFORMATIONAL PURPOSES ONLY

JOB NO: 9385.00 Date: 5 / 1993 Drawn By: S.G. Checked: G.F. Revisions:


This Drawing and Design shown thereon are the property of Omni Architects, C. The reproduction, copying or other use of this drawing without the written consent of Omni Architects is prohibited.

002/31


University of Kentucky Design Construction Division	Sheet A-3	Document # 100131
---	--------------	----------------------

University of Kentucky Lexington, Kentucky	Project # 100131	Revision # 002/31
---	---------------------	----------------------

Omni
Architects

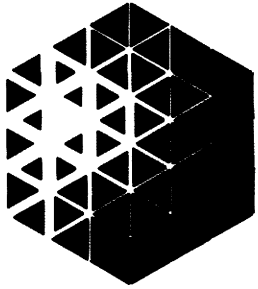

Architecture
Interior Architecture
Civil Engineering
Planning
Interiors
212 North Upper Street
Lexington, KY 40502
(606) 253-5654 Fax: (606) 253-5393

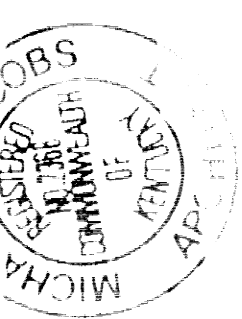


AS-BUILT AUG. 10, 1995

FIRST FLOOR PLAN - FURNITURE

SCALE 1/8" = 1' - 0"

SHADED AREAS DEMARK EXISTING AREAS TO
REMAIN IN-USE DURING CONSTRUCTION BY
AGRICULTURE-COMMUNICATIONS DEPARTMENT.

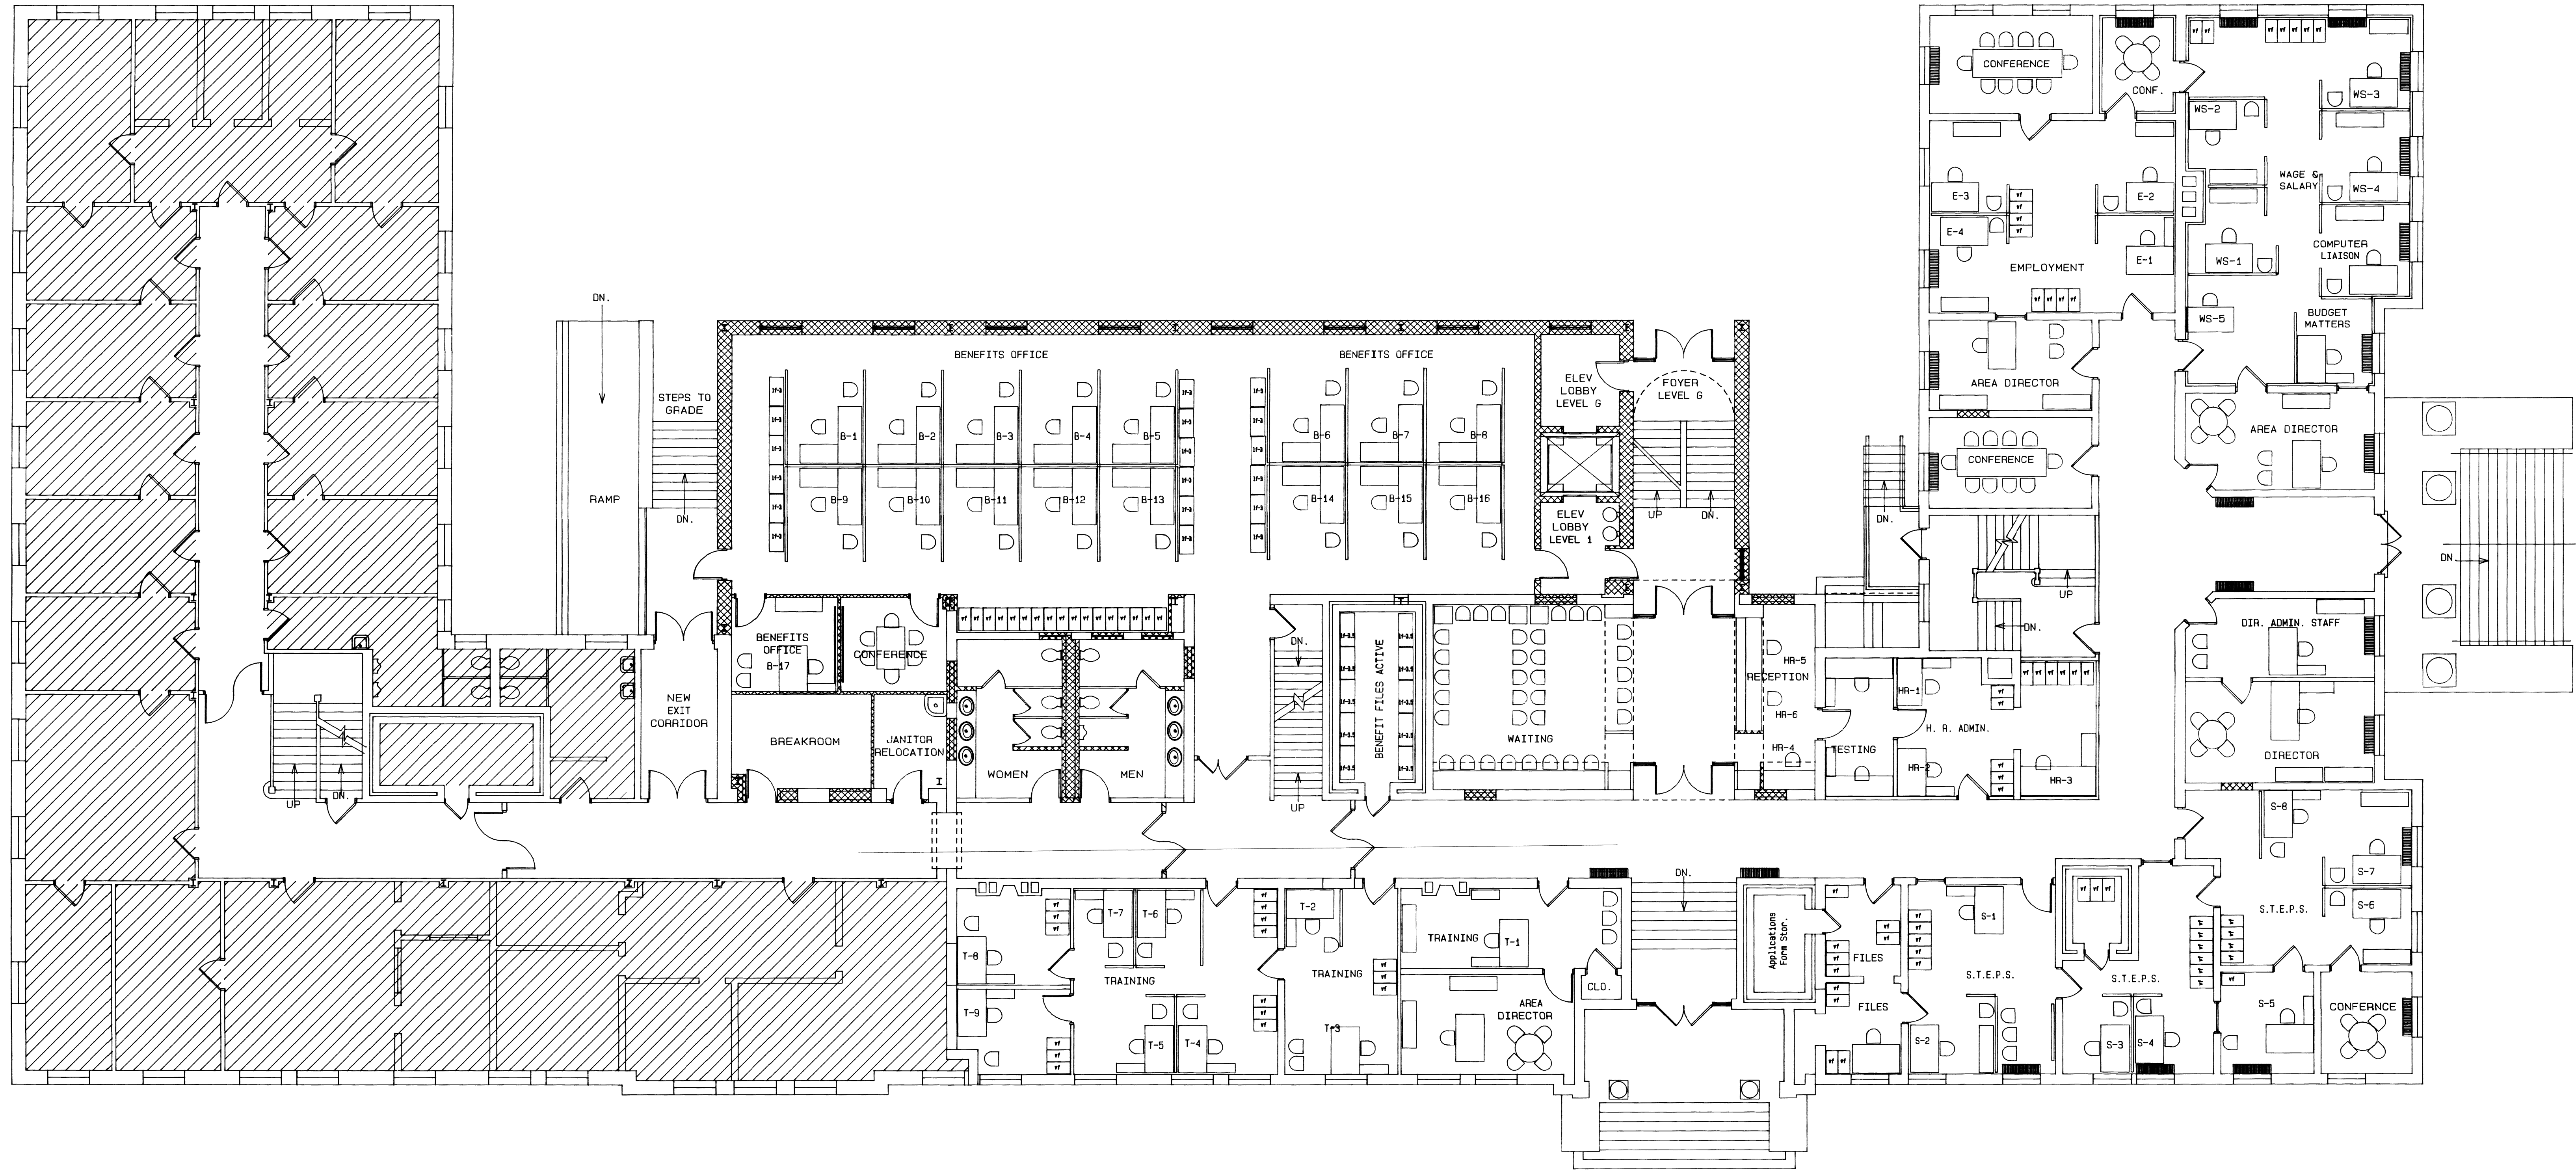

A
FR-2

SCD

UK

SCOVELL HALL RENOVATION

UNIVERSITY OF KENTUCKY

FURNITURE PLAN - FOR INFORMATIONAL PURPOSES ONLY


Job No: 1995.00 Date: 5 / 1994 Drawn By: S.G. Checked: G.F. Revisions:

This drawing and design shall remain the property of Omni Architects. No reproduction, copying or other use of this drawing without the written consent of Omni Architects is permitted.

002132
Pro2


University of Kentucky
Design and Construction
Division
200 Western Avenue, Suite 200
Lexington, Kentucky 40506
Cell # 518 Document # 1002132


Omni
Architects

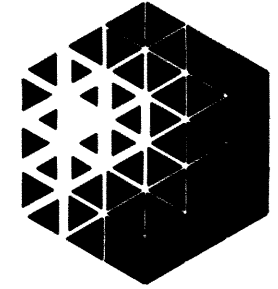

Architecture
Landscape Architecture
Civil Engineering
Planning
Interiors
212 North Upper Street
Lexington, KY 40502
(606) 252-0864 Fax: (606) 253-2288

AS-BUILT AUG. 10, 1995

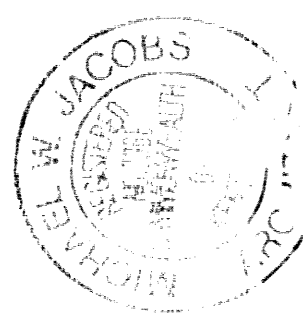

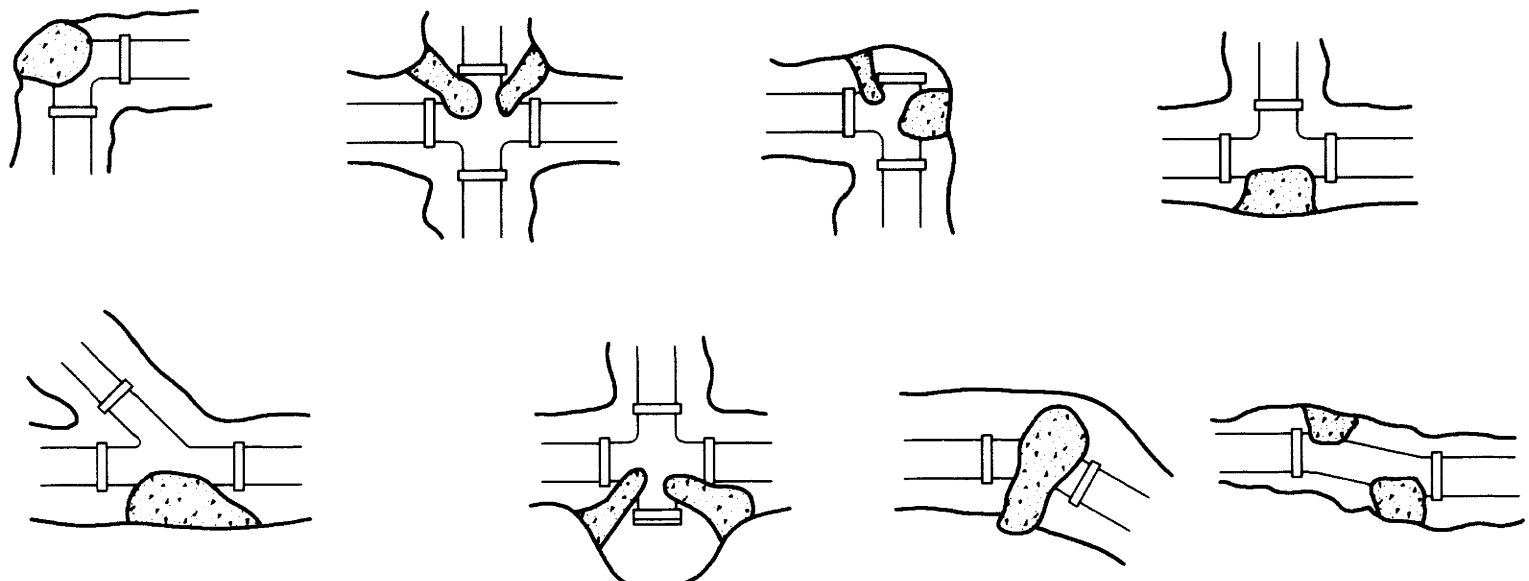

PIPE SIZE	END OF TEE	1/2 BEND	1/2 BEND	1/2 BEND
4" SMALLER	20	40	27	20
6	39	60	34	24
8	68	100	56	31
10	110	160	89	48


AREA OF BLOCKING - THRUST PER POUND X 150
SOIL BEARING VALUE

TYPE SOIL	PSF
CEMENTED GRAVEL	4000
COMPACTED SAND	3000
MEDIUM CLAY	2000
SOFT CLAY	1000

NOTE: THRUST BLOCKING IS REQUIRED AT
CHANGES IN DIRECTION IN UNDERGROUND
WATER PIPING

THRUST BLOCK DETAIL

NO SCALE

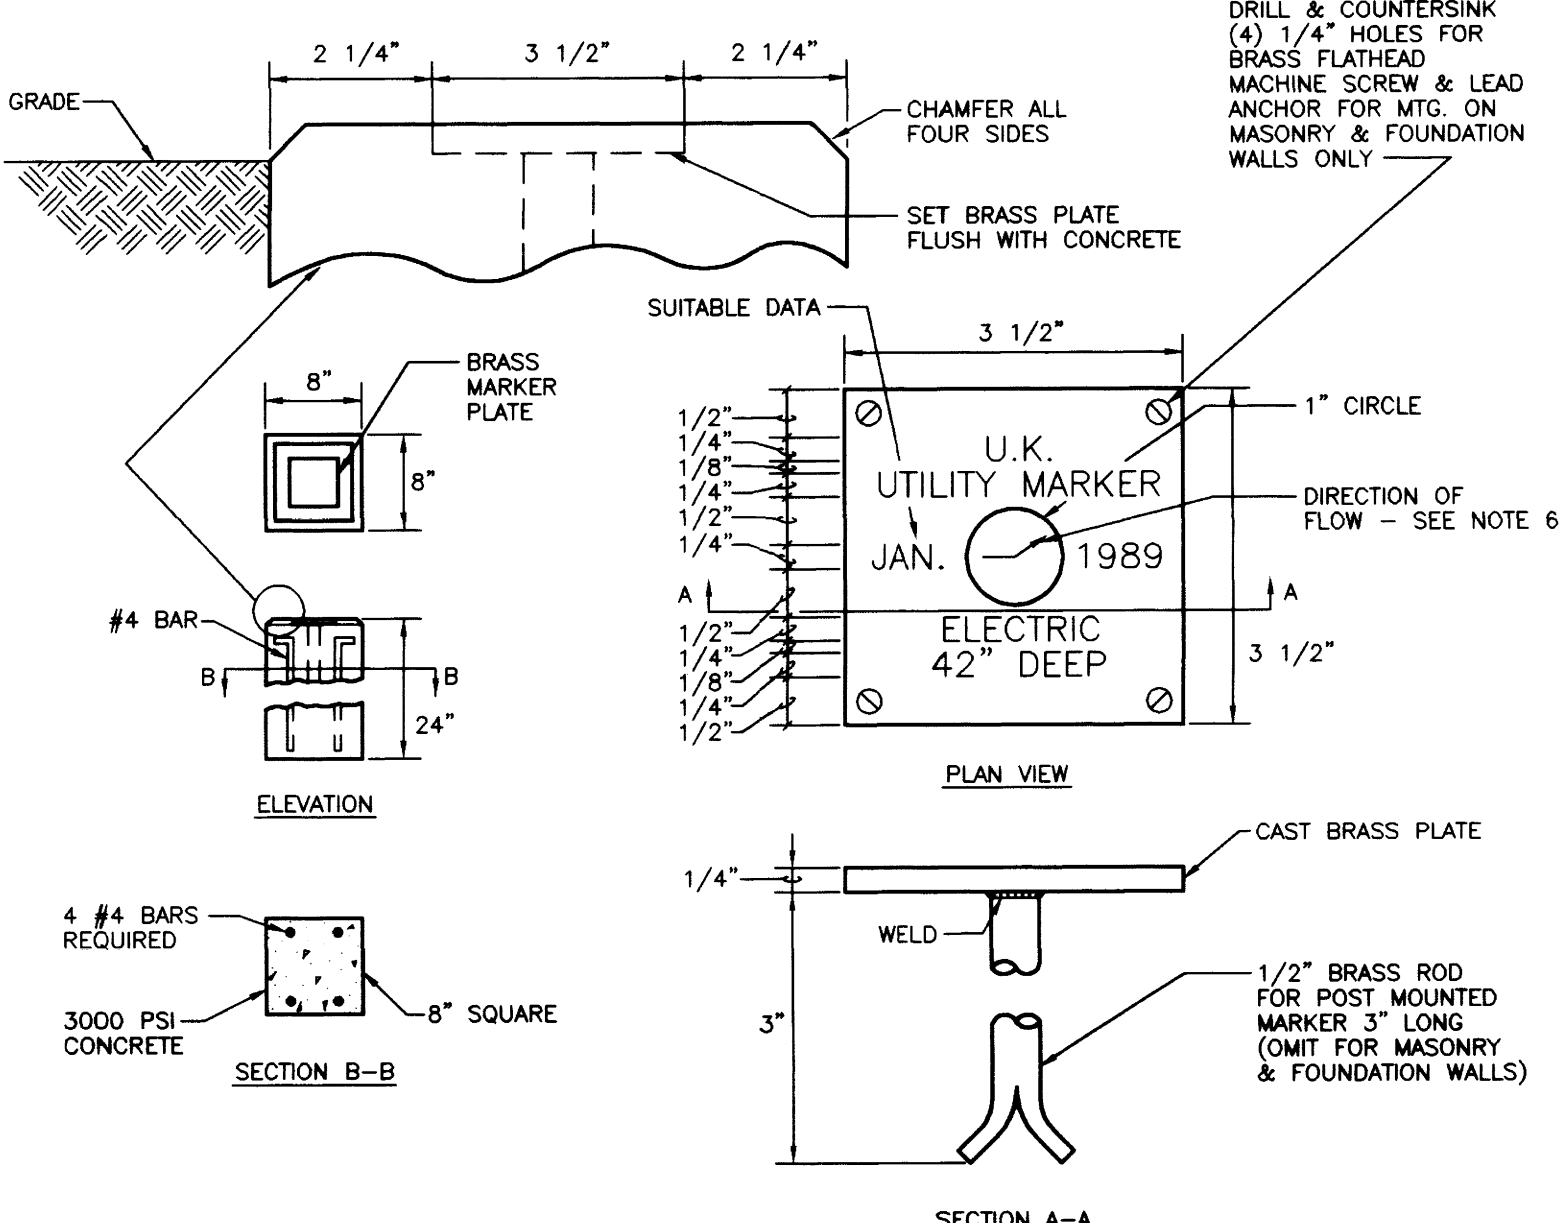


NOTES:

- MARKERS SHALL BE LOCATED WHERE INDICATED ON DRAWINGS.
- BRASS MARKERS SHALL BE CAST BY BRUCE FOX COMPANY, NEW ALBANY, INDIANA, OR EQUAL.
- ALL LETTERING SHALL BE OF THE RAISED TYPE. LETTERING SHOWN ON MARKER IS FOR EXAMPLE ONLY. LETTERING TO BE RAISED 1/8".
- AT THE CONTRACTOR'S OPTION, ONE MARKER MAY BE USED FOR COMPANION MAINS THAT ARE LOCATED CLOSE TOGETHER SUCH AS STEAM AND CONDENSATE PUMP DISCHARGE PIPING OR CHILLED WATER SUPPLY AND CHILLED WATER RETURN PIPING. PROVIDE ARROW FOR EACH MAIN.
- CONTRACTOR SHALL FURNISH A COMPLETE LIST FOR APPROVAL OF ALL MARKERS SHOWING NAMES, ARROWS, DEPTH AND DATE.
- WHEN UTILITY MARKERS ARE INSTALLED OVER LINES, AT A POINT OF DIRECTION CHANGE, THE ARROW ON THE MARKERS SHALL BE "ANGLED" AS REQUIRED TO IMPLY THIS ROUTING.


UTILITY SERVICE MARKER DETAIL

NO SCALE

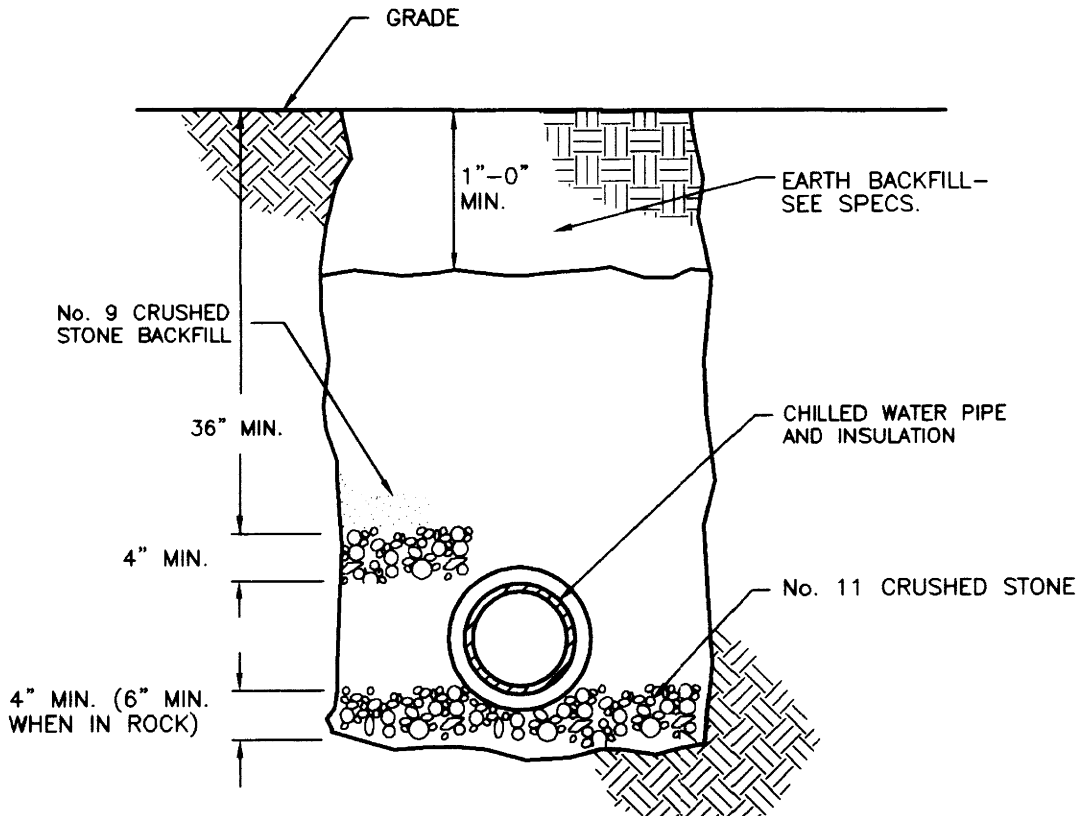

EXTERIOR CHILLED WATER PIPING INSTALLATION DETAIL

NO SCALE

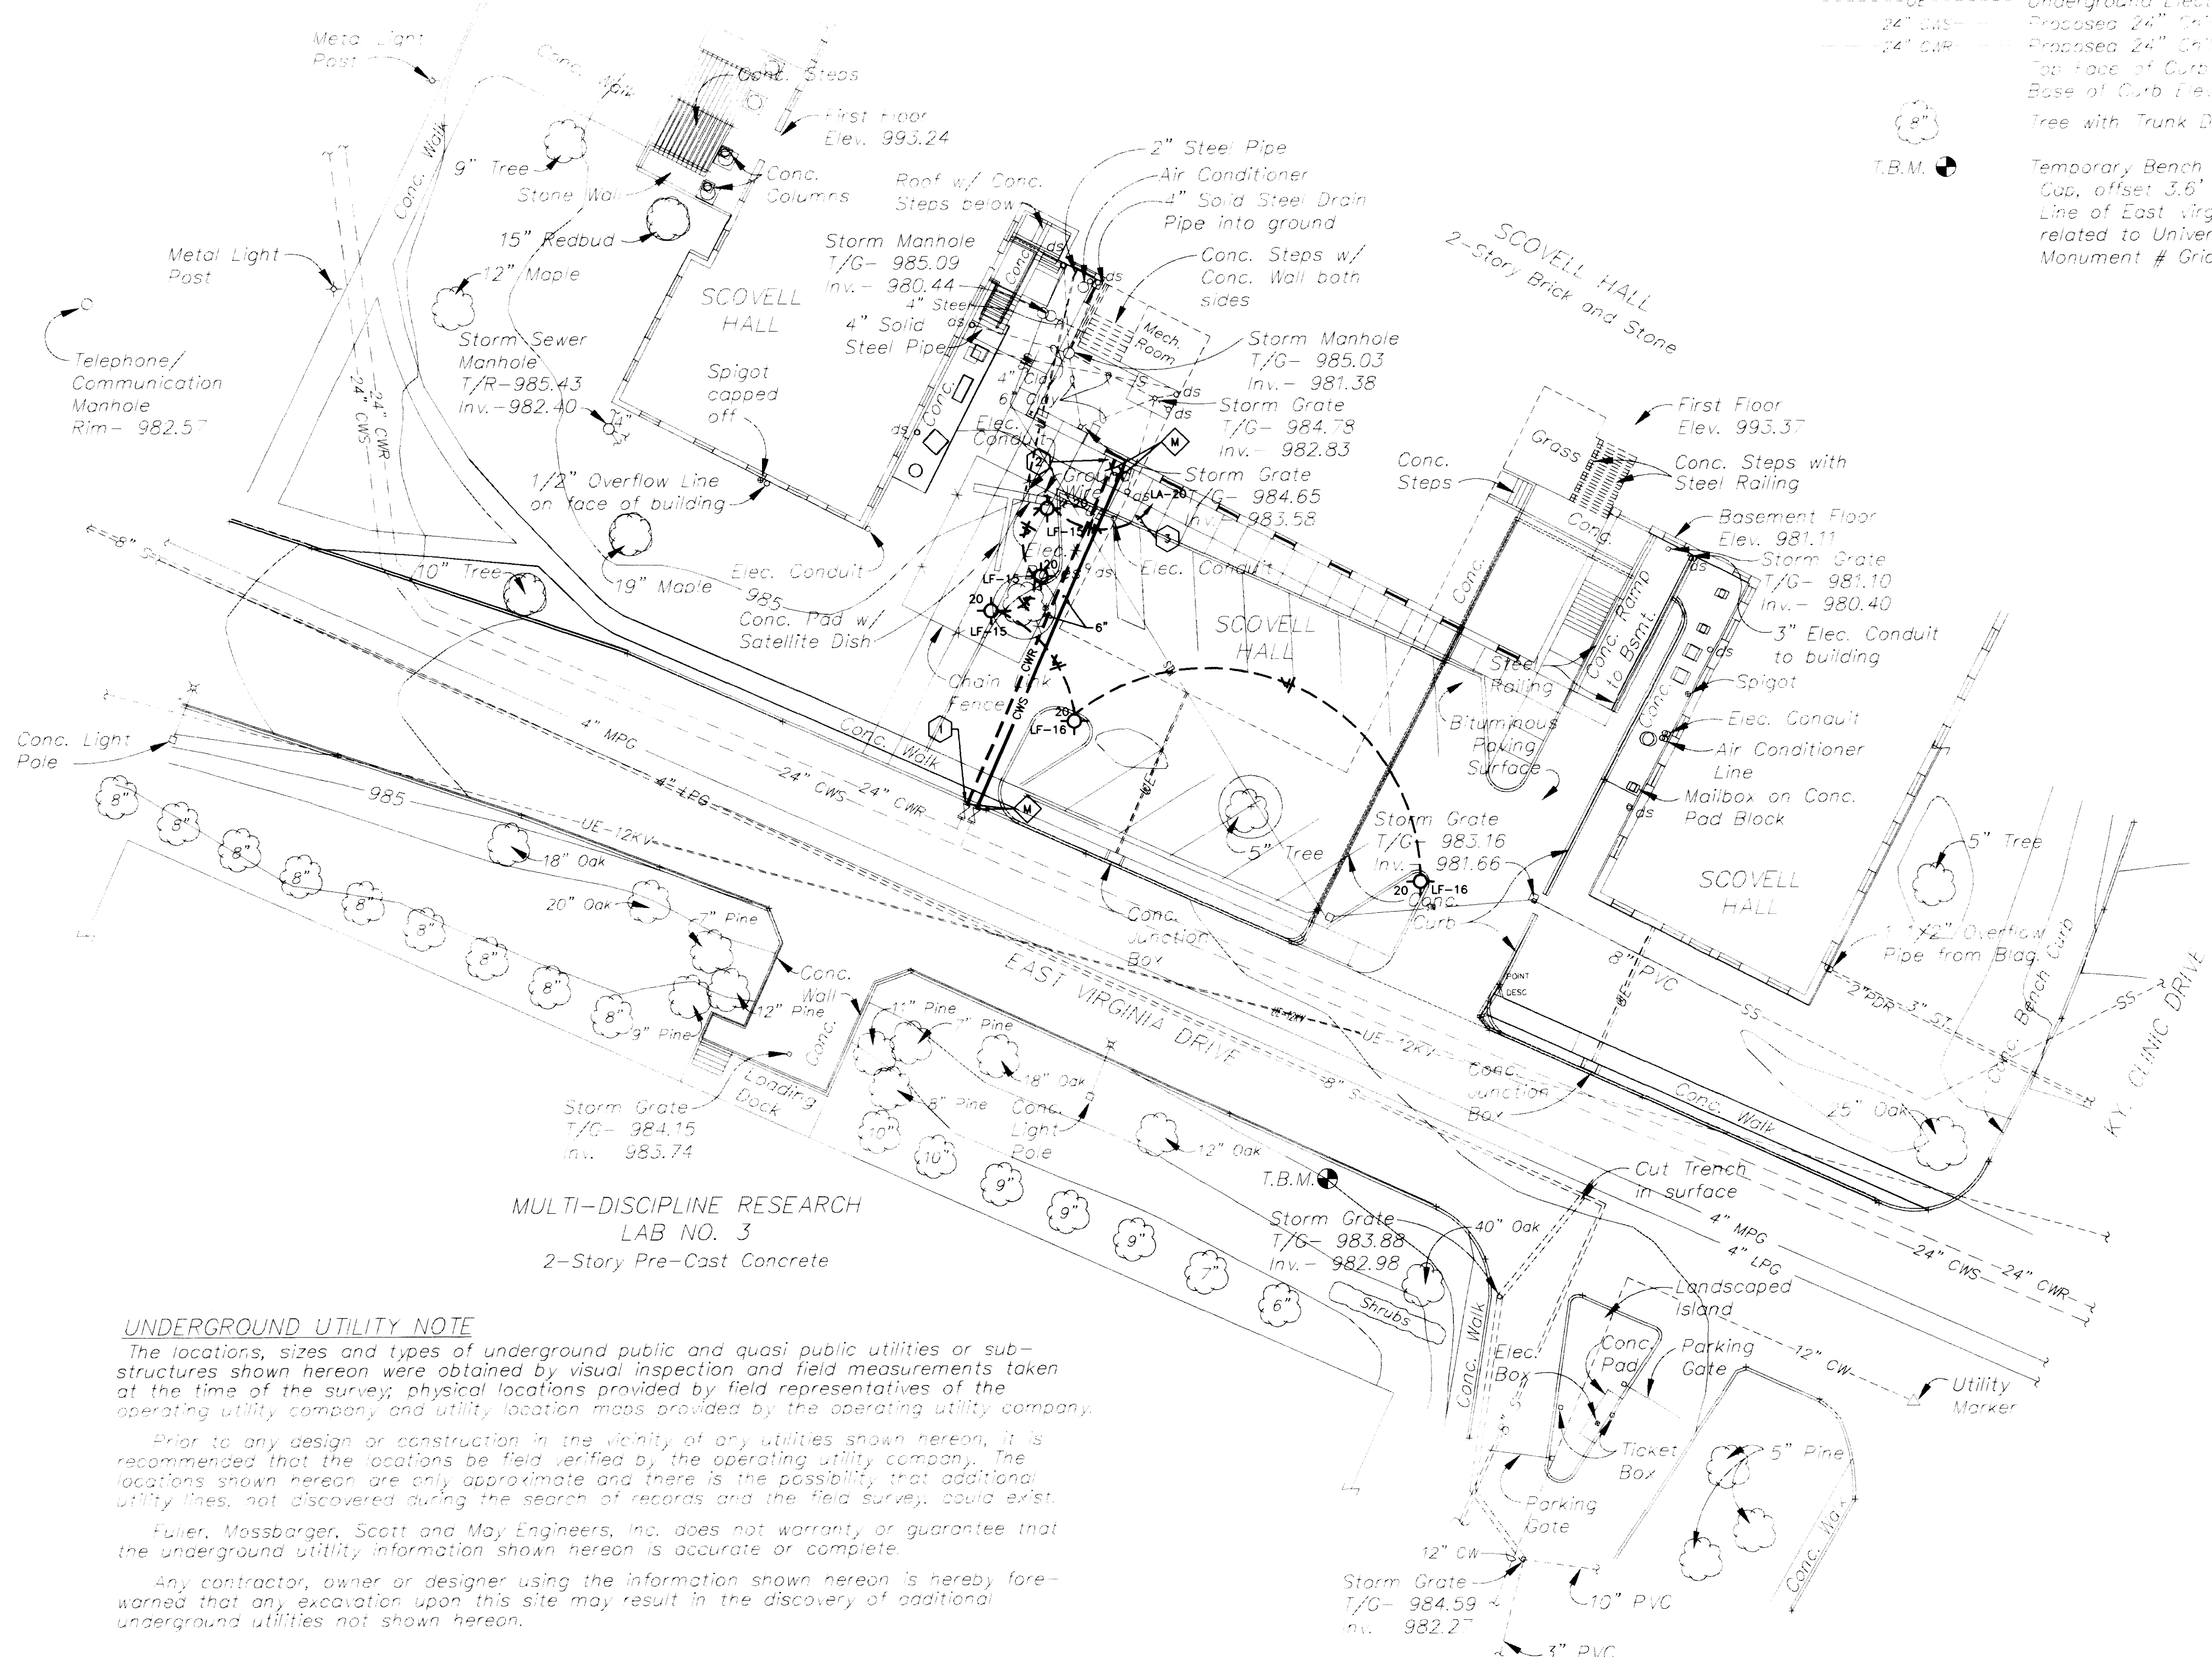


UNDERGROUND UTILITY NOTE

The locations, sizes and types of underground public and quasi public utilities or sub-structures shown hereon were obtained by visual inspection and field measurements taken at the time of the survey; physical locations provided by field representatives of the operating utility company and utility location maps provided by the operating utility company.

Prior to any design or construction in the vicinity of any utilities shown hereon, it is recommended that the locations be field verified by the operating utility company. The locations shown hereon are only approximate and there is the possibility that additional utility lines, not discovered during the search of records and the field survey, could exist.

Fuller, Mossbarger, Scott and May Engineers, Inc. does not warrant or guarantee that the underground utility information shown hereon is accurate or complete.

Any contractor, owner or designer using the information shown hereon is hereby forewarned that any excavation upon this site may result in the discovery of additional underground utilities not shown hereon.

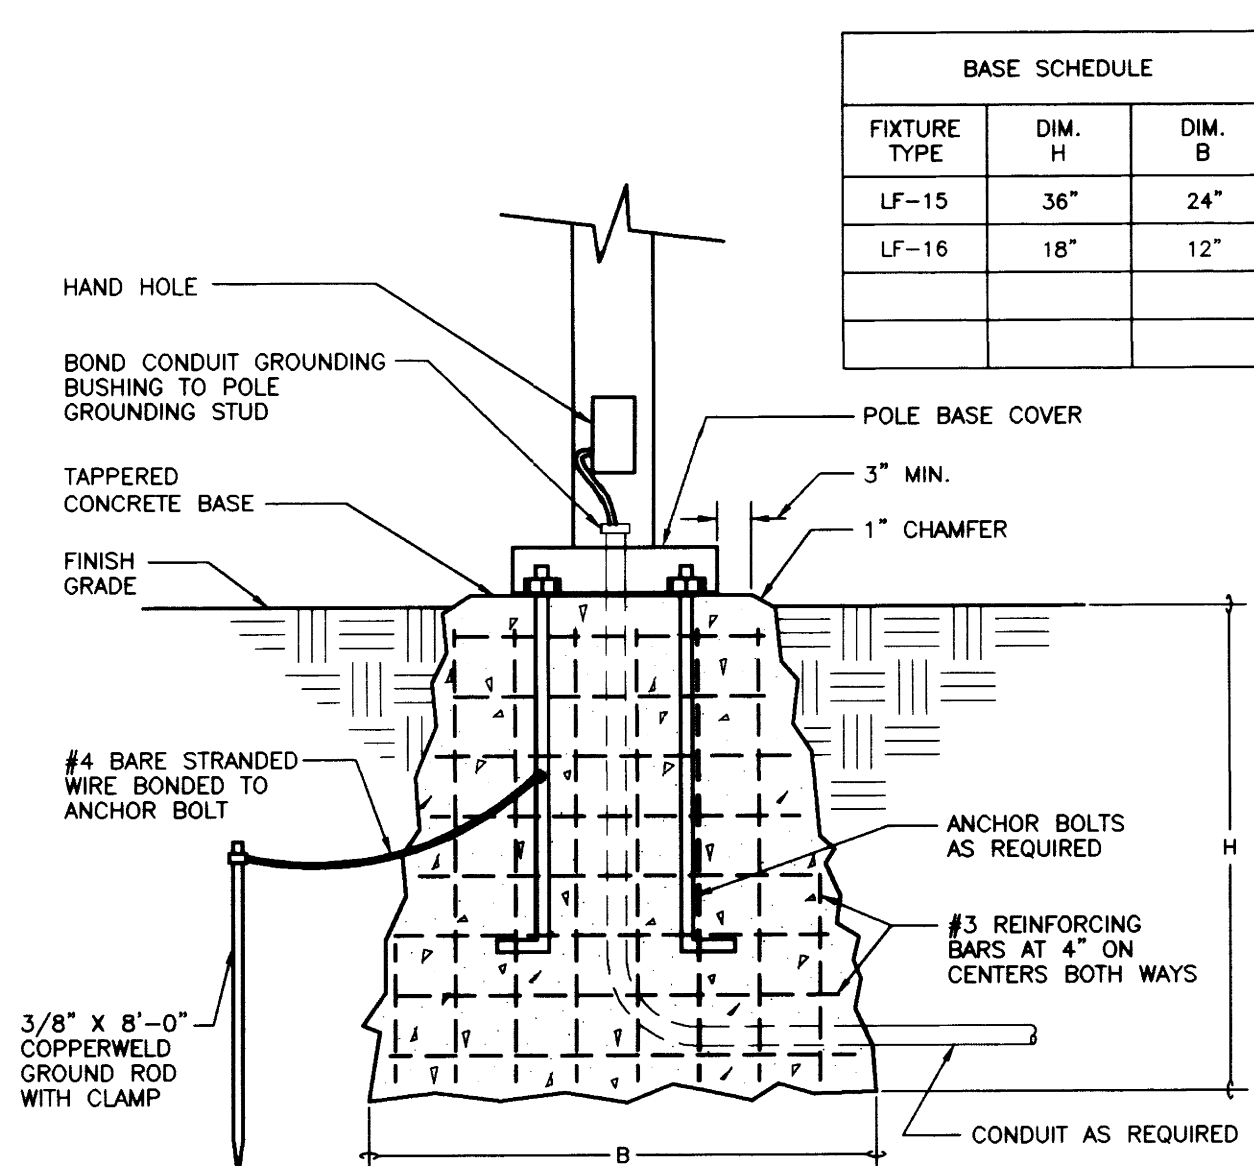

BASE DETAIL STANDARD

NO SCALE

FIXTURE TYPE	DIM. H	DIM. B
LF-15	36"	24"
LF-16	18"	12"

GENERAL NOTES: SITE UTILITIES:

- EXISTING UTILITIES SHOWN MAY ACTUALLY BE IN DIFFERENT LOCATIONS AND ADDITIONAL UTILITIES NOT SHOWN MAY EXIST AND MAY BE IN USE.
- TOP ELEVATIONS OF NEW UNDERGROUND STRUCTURE ARE APPROXIMATE AND ARE FOR ESTIMATING PURPOSES ONLY. ACTUAL TOP ELEVATIONS MUST BE THE SAME AS FINISHED GRADE IN THE SAME AREA. SEE ARCHITECTURAL PLANS FOR FINISHED GRADES.
- LOCATIONS OF UTILITIES ARE APPROXIMATE AND SUBJECT TO MINOR CHANGES IN THE FIELD. DO NOT SCALE THE DRAWINGS.
- VERIFY EXACT SIZES AND ROUTING OF EXISTING UNDERGROUND UTILITIES WITH APPROPRIATE UTILITY COMPANIES BEFORE DOING ANY EXCAVATING.
- THE CONTRACT DOCUMENTS SHOW THE APPROXIMATE LOCATION OF THE EXISTING AND NEW SUBSURFACE UTILITY LINES. THESE LINES HAVE BEEN IDENTIFIED AND LOCATED AS ACCURATELY AS POSSIBLE USING AVAILABLE INFORMATION. THE CONTRACTOR IS RESPONSIBLE FOR VERIFYING ALL ACTUAL LOCATIONS. IF ANY CHARTED, UNCHARTED OR MISLOCATED UTILITY SERVICE IS INTERRUPTED FOR ANY REASON, THE CONTRACTOR WILL WORK CONTINUOUSLY TO RESTORE SERVICE TO THE SATISFACTION OF THE OWNER.
- SHOULD UTILITIES REQUIRE RELOCATION OR REROUTING NOT SHOWN OR INDICATED TO BE RELOCATED OR REROUTED, CONTACT AND COOPERATE WITH THE OWNER TO MAKE THE REQUIRED ADJUSTMENTS AT AN EQUITABLE CHANGE IN THE CONTRACT PRICE.
- EXCAVATION: MATERIALS TO BE EXCAVATED SHALL INCLUDE EARTH AND ANY OTHER MATERIAL, INCLUDING ROCK, ENCOUNTERED IN THE TRENCH EXCAVATION. SEE SPECIFICATIONS.

CODED NOTES:

- CONNECT NEW 6" CHILLED WATER SUPPLY AND CHILLED WATER RETURN TO EXISTING VALVES ON THE 24" CHILLED WATER MAINS. VERIFY EXACT LOCATION OF VALVES AND CONNECTIONS AND REROUTE PIPE AS REQUIRED.
- CHILLED WATER ENTRANCE INTO NEW BASEMENT. PROVIDE SLEEVES AND SLEEVE SEALS AT ENTRANCE. PROVIDE PIPE ANCHOR AT BUILDING.
- ROUT THRU EXTERIOR LIGHTING TIME CLOCK.

RECORD DRAWINGS DATE 9-8-95

These record drawings have been prepared, in part, on the basis of information compiled and furnished by others. The Engineer will not be responsible for any errors or omissions which have been incorporated into this document as a result.

STAGGS & FISHER CONSULTING ENGINEERS, INC.

GRAPHIC SCALE: 1" = 20'
CONTOUR INTERVAL = 1'

SCOVELL HALL RENOVATION

SITE UTILITIES PLAN

UNIVERSITY OF KENTUCKY

Revisions: 7/29/94

Checked: DHB

Drawn By: DHB

Date: APRIL, 1994

Job No:

00 21 34

U.I.

00174

3S A-3

Disturbance

Calc #

Sheet

Division

University of Kentucky

Design and Construction

Official and Document

University of Kentucky

Division

Design and Construction

Official and Document

University of Kentucky

Division

Design and Construction

Official and Document

University of Kentucky


Division

Design and Construction


Official and Document

<

D:\DWG\SCOVELL\PLUMB\01.DWG SCALE= 48, LAYOUT= 30, DIMSCALE= 96, 09/01/95 AT 11:14

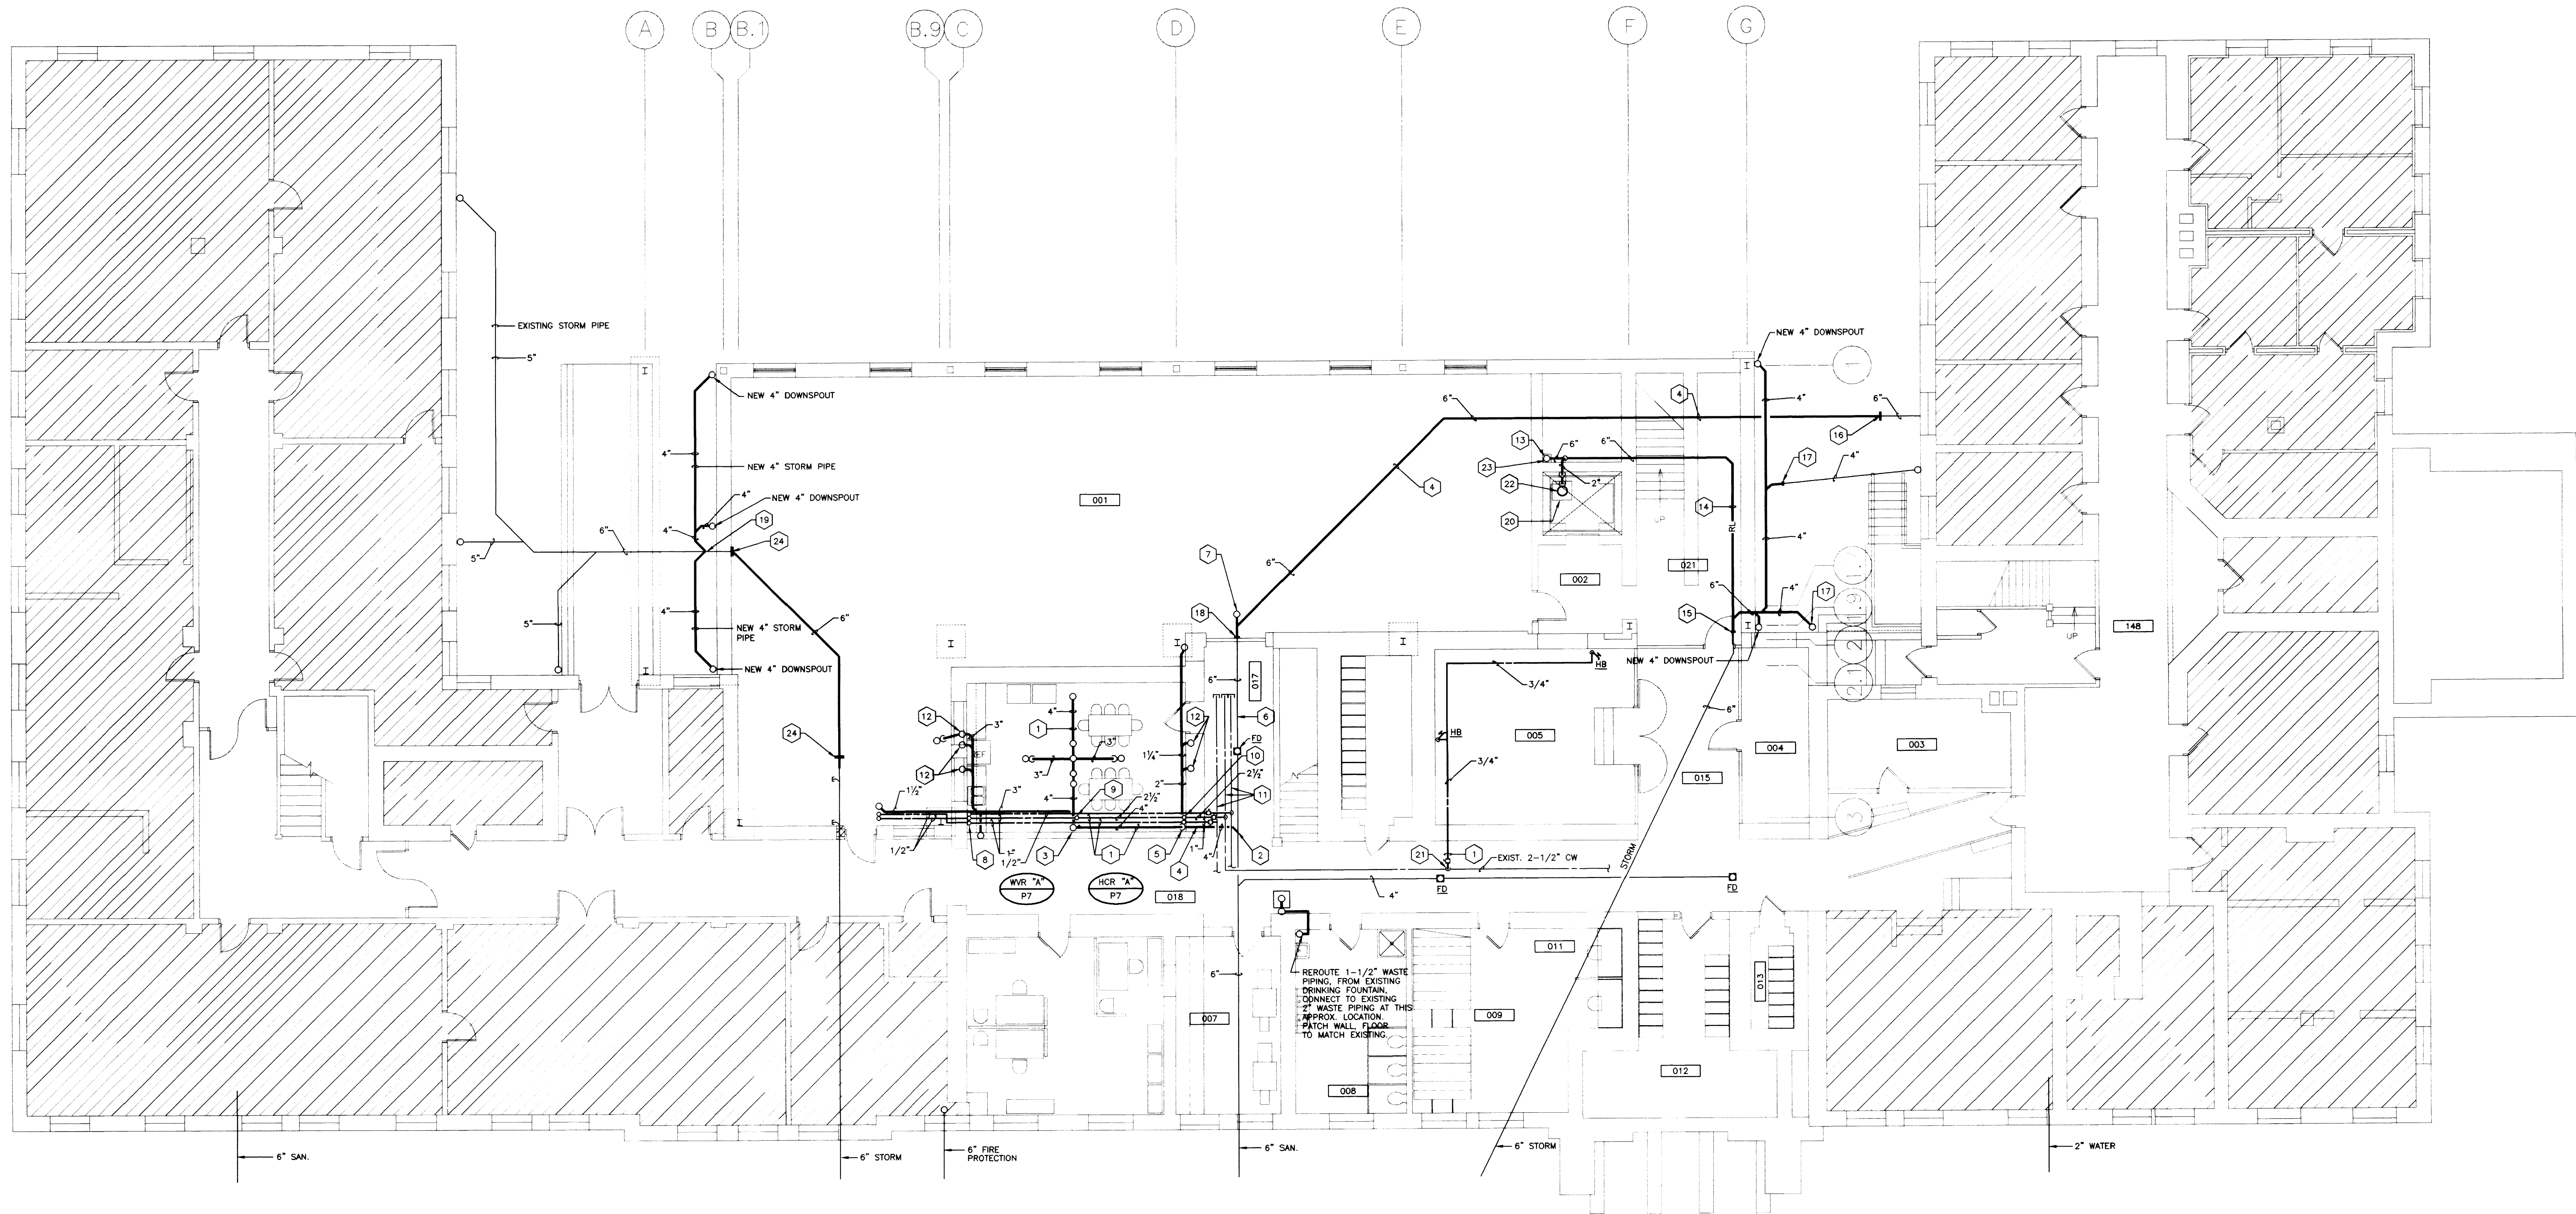

PLUMBING PLAN - BASEMENT
SCALE: 1/8"=1'-0"

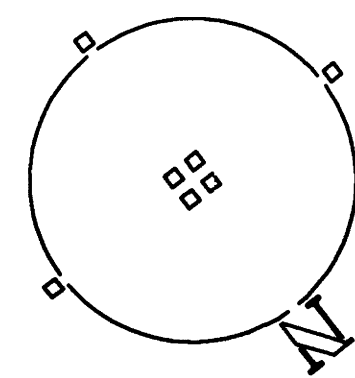

ROOM NO.	ROOM NAME
001	SHELL SPACE
002	ELEV. LOBBY LEVEL "B"
003	COMMUNICATIONS
004	ELEV. MECH.
005	MECHANICAL/ELECTRICAL ROOM
007	EMPLOYEE RECORDS
008	WOMEN'S RESTROOM
009	TRAINING STORAGE
011	BENNETT'S STORAGE
012	COPY CENTER
013	RECORDS
015	CORRIDOR
016	CORRIDOR
017	CORRIDOR
018	CORRIDOR
019	CORRIDOR
020	CORRIDOR
021	STAIR
148	CORRIDOR


- CODED NOTES-DRAWING P1
- 1 RUN ABOVE BASEMENT CEILING.
 - 2 CONNECT NEW 4" WASTE TO EXISTING 6" WASTE BELOW BASEMENT FLOOR.
 - 3 4" WASTE UP.
 - 4 RUN BELOW BASEMENT FLOOR.
 - 5 4" WASTE DOWN, FURR IN PIPE IN CORNER.
 - 6 EXISTING 6" WASTE BELOW BASEMENT FLOOR.
 - 7 INSTALL NEW CLEANOUT.
 - 8 1" CW, 1" HW & 1/2" HWR UP.
 - 9 2-1/2" CW UP.
 - 10 3/4" CW & 3/4" HW UP.
 - 11 EXISTING 2-1/2" CW, 1-1/2" HW & 3/4" HWR RUN ABOVE BASEMENT CEILING.
 - 12 CUT OUT EXISTING WALLS FOR NEW VERTICAL WASTE PIPES.
 - 13 6" RAIN LEADER UP, FURR IN.
 - 14 RUN RAIN LEADER BELOW BASEMENT FLOOR.
 - 15 CONNECT NEW 6" RAIN LEADER TO EXISTING 6" STORM DRAIN.
 - 16 CONNECT NEW 6" SANITARY SEWER TO EXISTING 6" SANITARY SEWER.
 - 17 CONNECT NEW 4" STORM PIPE TO EXISTING 4" STORM PIPE.
 - 18 CONNECT NEW 6" WASTE TO EXISTING 6" WASTE UNDER BASEMENT FLOOR.
 - 19 CONNECT NEW 4" STORM PIPE TO EXISTING 6" STORM PIPE BELOW GROUND.
 - 20 22" X 22" X 22" ELEVATOR SUMP.
 - 21 CONNECT NEW 3/4" CW TO EXISTING 2-1/2" CW ABOVE CEILING.
 - 22 ELEVATOR SUMP PUMP.
 - 23 CONNECT 2" PIPE FROM ELEVATOR SUMP TO 6" RAIN LEADER BELOW FLOOR.
 - 24 CONNECT NEW 6" STORM PIPE TO EXISTING 6" STORM PIPE.

RECORD DRAWINGS DATE 9-8-95
These record drawings have been prepared, in part, on the basis of information compiled and furnished by others. The Engineer will not be responsible for any errors or omissions which have been incorporated into this document as a result.
STAGGS & FISHER CONSULTING ENGINEERS, INC.

SCOVELL HALL RENOVATION

PLUMBING PLAN - BASEMENT


002135

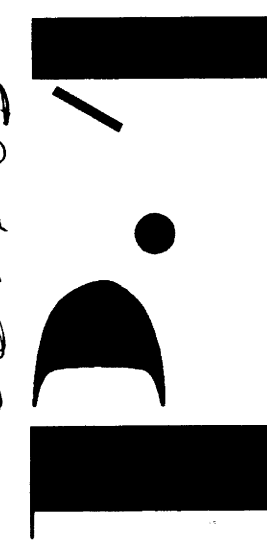

University of Kentucky
Design and Construction
Division - Facilities
Architects - Engineers
201 Pearson Service Building
Lexington, Kentucky 40507


OFFICIAL BD DOCUMENT
University of Kentucky
Lexington, Kentucky
Approved by
09/01/95 10:00 AM 09/01/95 10:00 AM

Omni
Architects

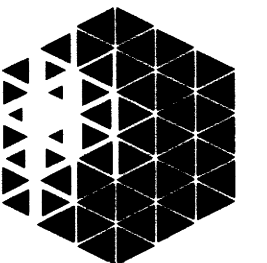


Architecture
Landscape Architecture
Planning
Interior Design
212 North Upper Street
Lexington, Kentucky 40507
(606) 552-6664

Staggs and Fisher
Consulting Engineers, Inc.
Professional Engineers
License No. 40507

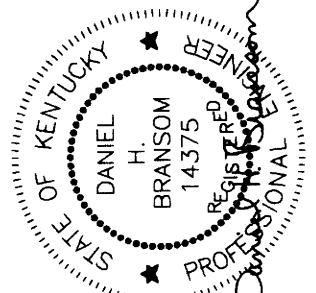


UNIVERSITY OF KENTUCKY

This drawing and design shall remain the property of Staggs and Fisher Consulting Engineers, Inc. The reproduction, copying or other use of this drawing without the written consent of Staggs and Fisher Consulting Engineers, Inc. is prohibited.

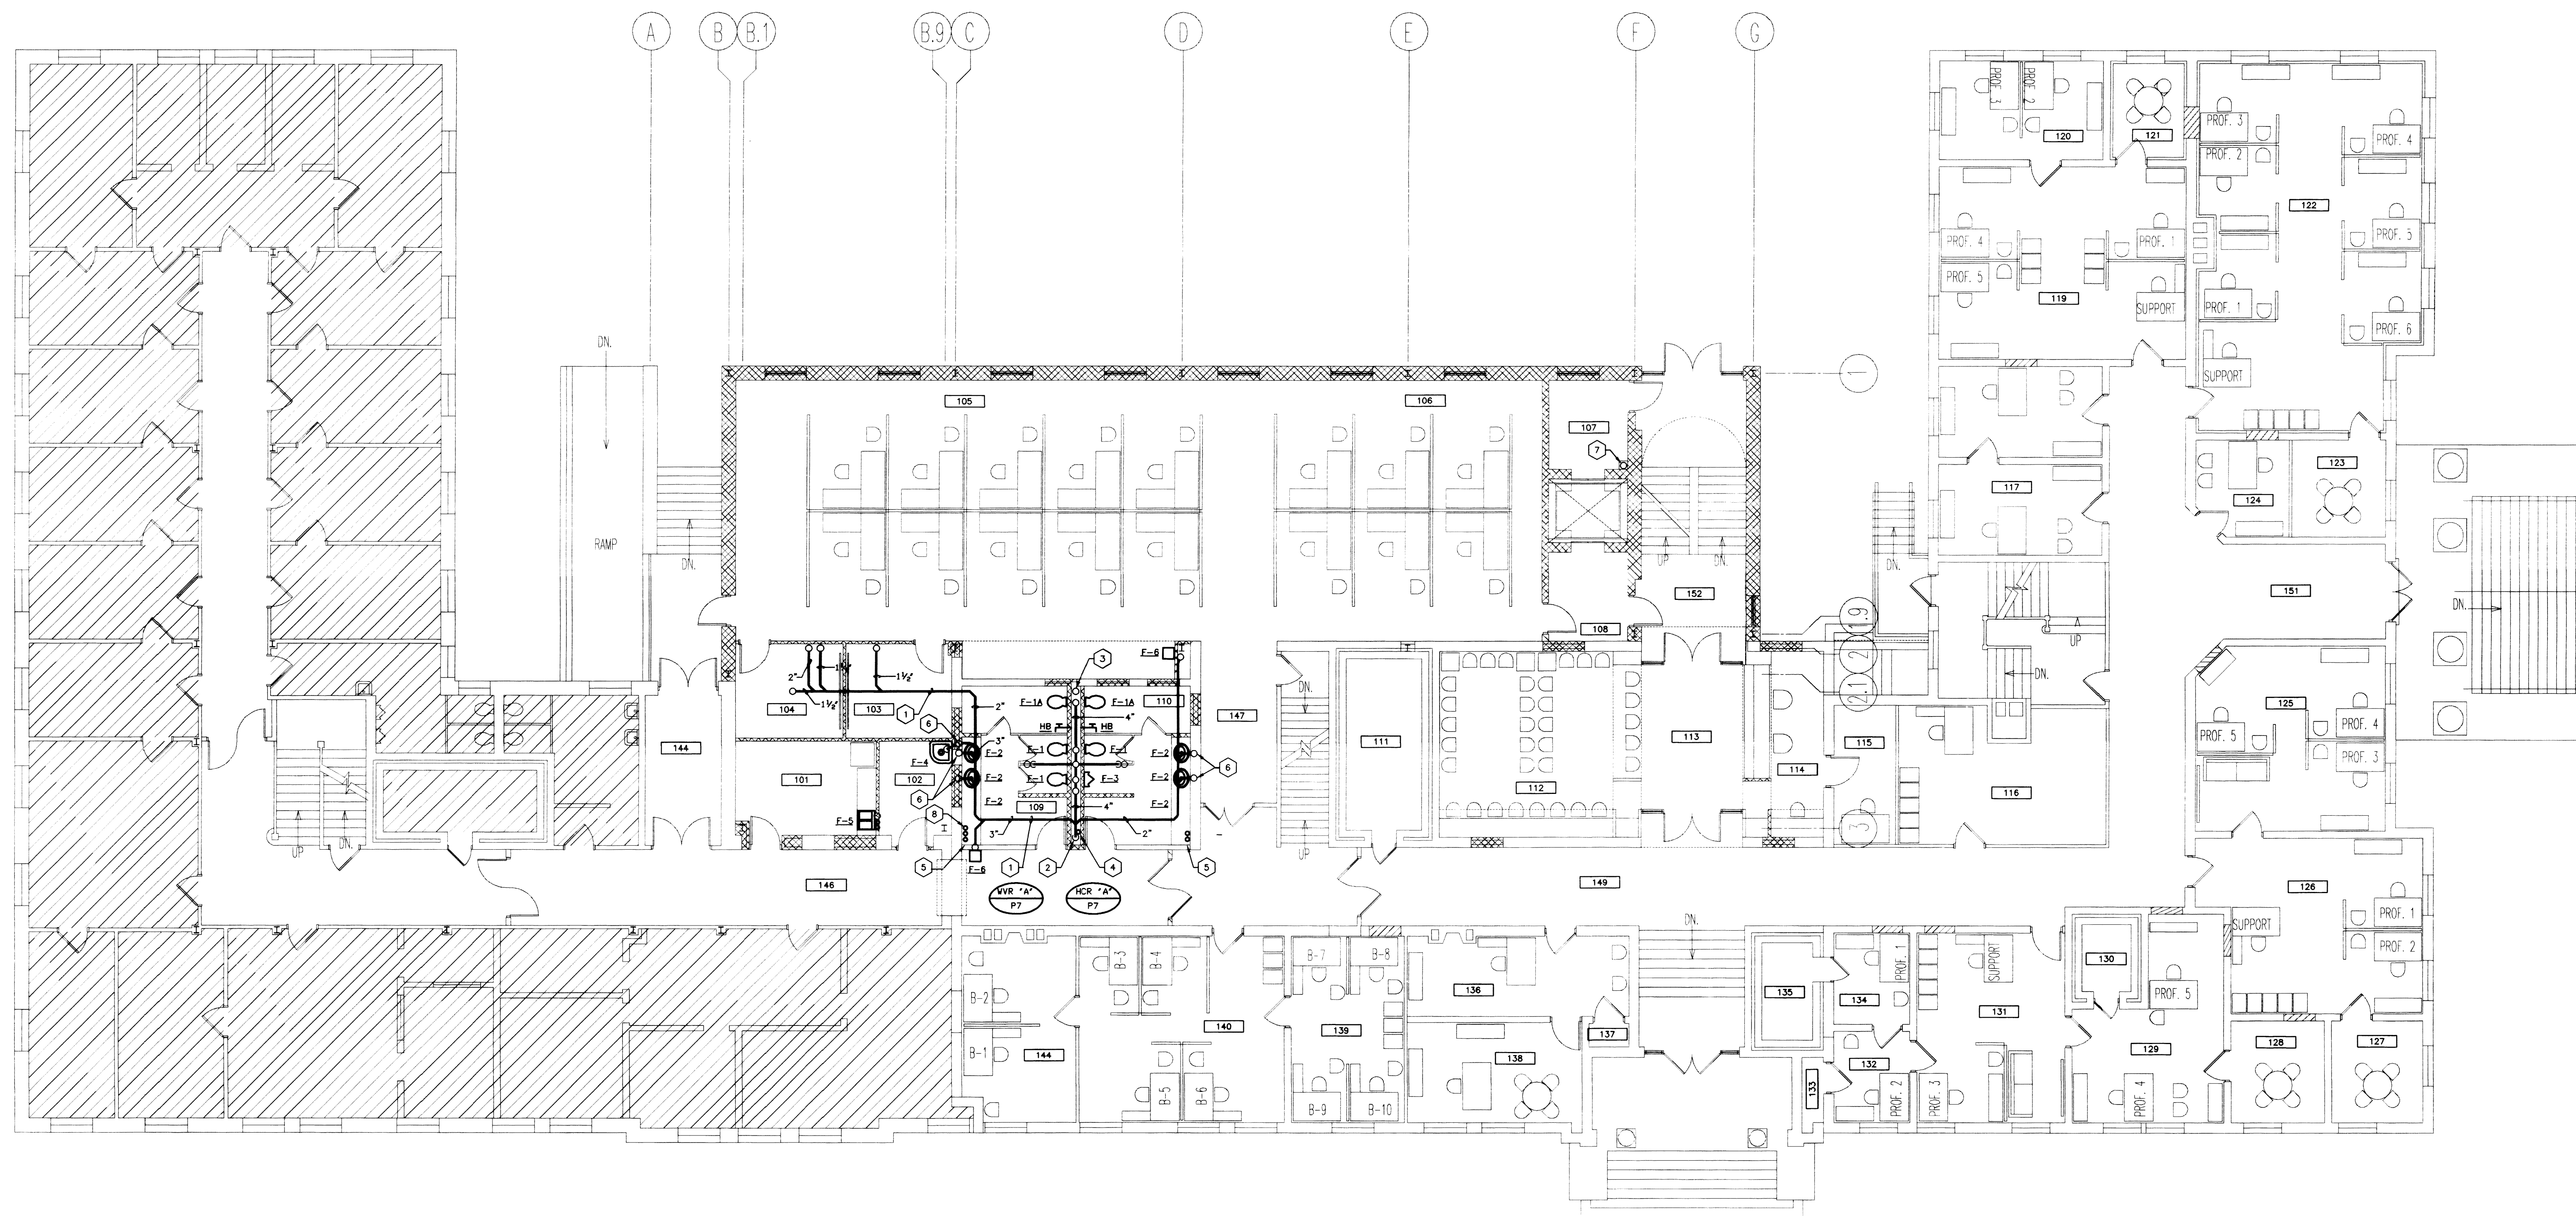

PLUMBING PLAN – FIRST FLOOR

SCALE : 1/8" = 1'-0"

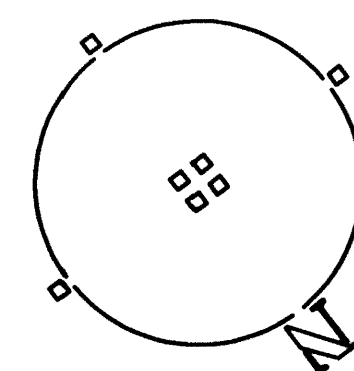


ROOM NO.	ROOM NAME
101	BREAKROOM
102	JANITOR
103	BENEFITS CONF.
104	TRAINING CONF.
105	TRAINING CONF.
106	BENEFITS
107	ELEV. LOBBY L
108	ELEV. LOBBY L
109	WOMEN
110	MEN
111	RECORDS
112	WAITING
113	WAITING ENTRY
114	RECEPTION
115	TESTING
116	WAGE/SALARY
117	S.T.E.P.S.
118	S.T.E.P.S.
119	HRS TEAM #2
120	HRS TEAM #2
121	CONF. #2
122	HRS TEAM #2
123	CONF. #1
124	S.T.E.P.S. STAFF
125	HRS TEAM #3
126	HRS TEAM #3
127	CONF. #3
128	CONF. #4

- CODED NOTES—DRAWING P2**
- 1 RUN ABOVE FIRST FLOOR CEILING.
 - 2 4" WASTE DOWN.
 - 3 4" VENT UP.
 - 4 2" CW UP AND 2-1/2" CW DOWN.
 - 5 3/4" CW & 3/4" HW UP AND 3/4" CW & 3/4" HW DOWN.
FURR IN PIPES IN CORNER.
 - 6 CUT OUT EXISTING WALLS FOR NEW VERTICAL WASTE & VENT PIPES.
 - 7 RUN LEADER UP AND DOWN. FURR IN.
 - 8 1/2" HWR UP & 1/2" HWR DOWN. FURR IN PIPE IN CORNER.

RECORD DRAWINGS DATE 9-8-95


These record drawings have been prepared, in part, on the basis of information compiled and furnished by others. The Engineer will not be responsible for any errors or omissions which have been incorporated into this document as a result

STAGGS & FISHER CONSULTING ENGINEERS, INC.

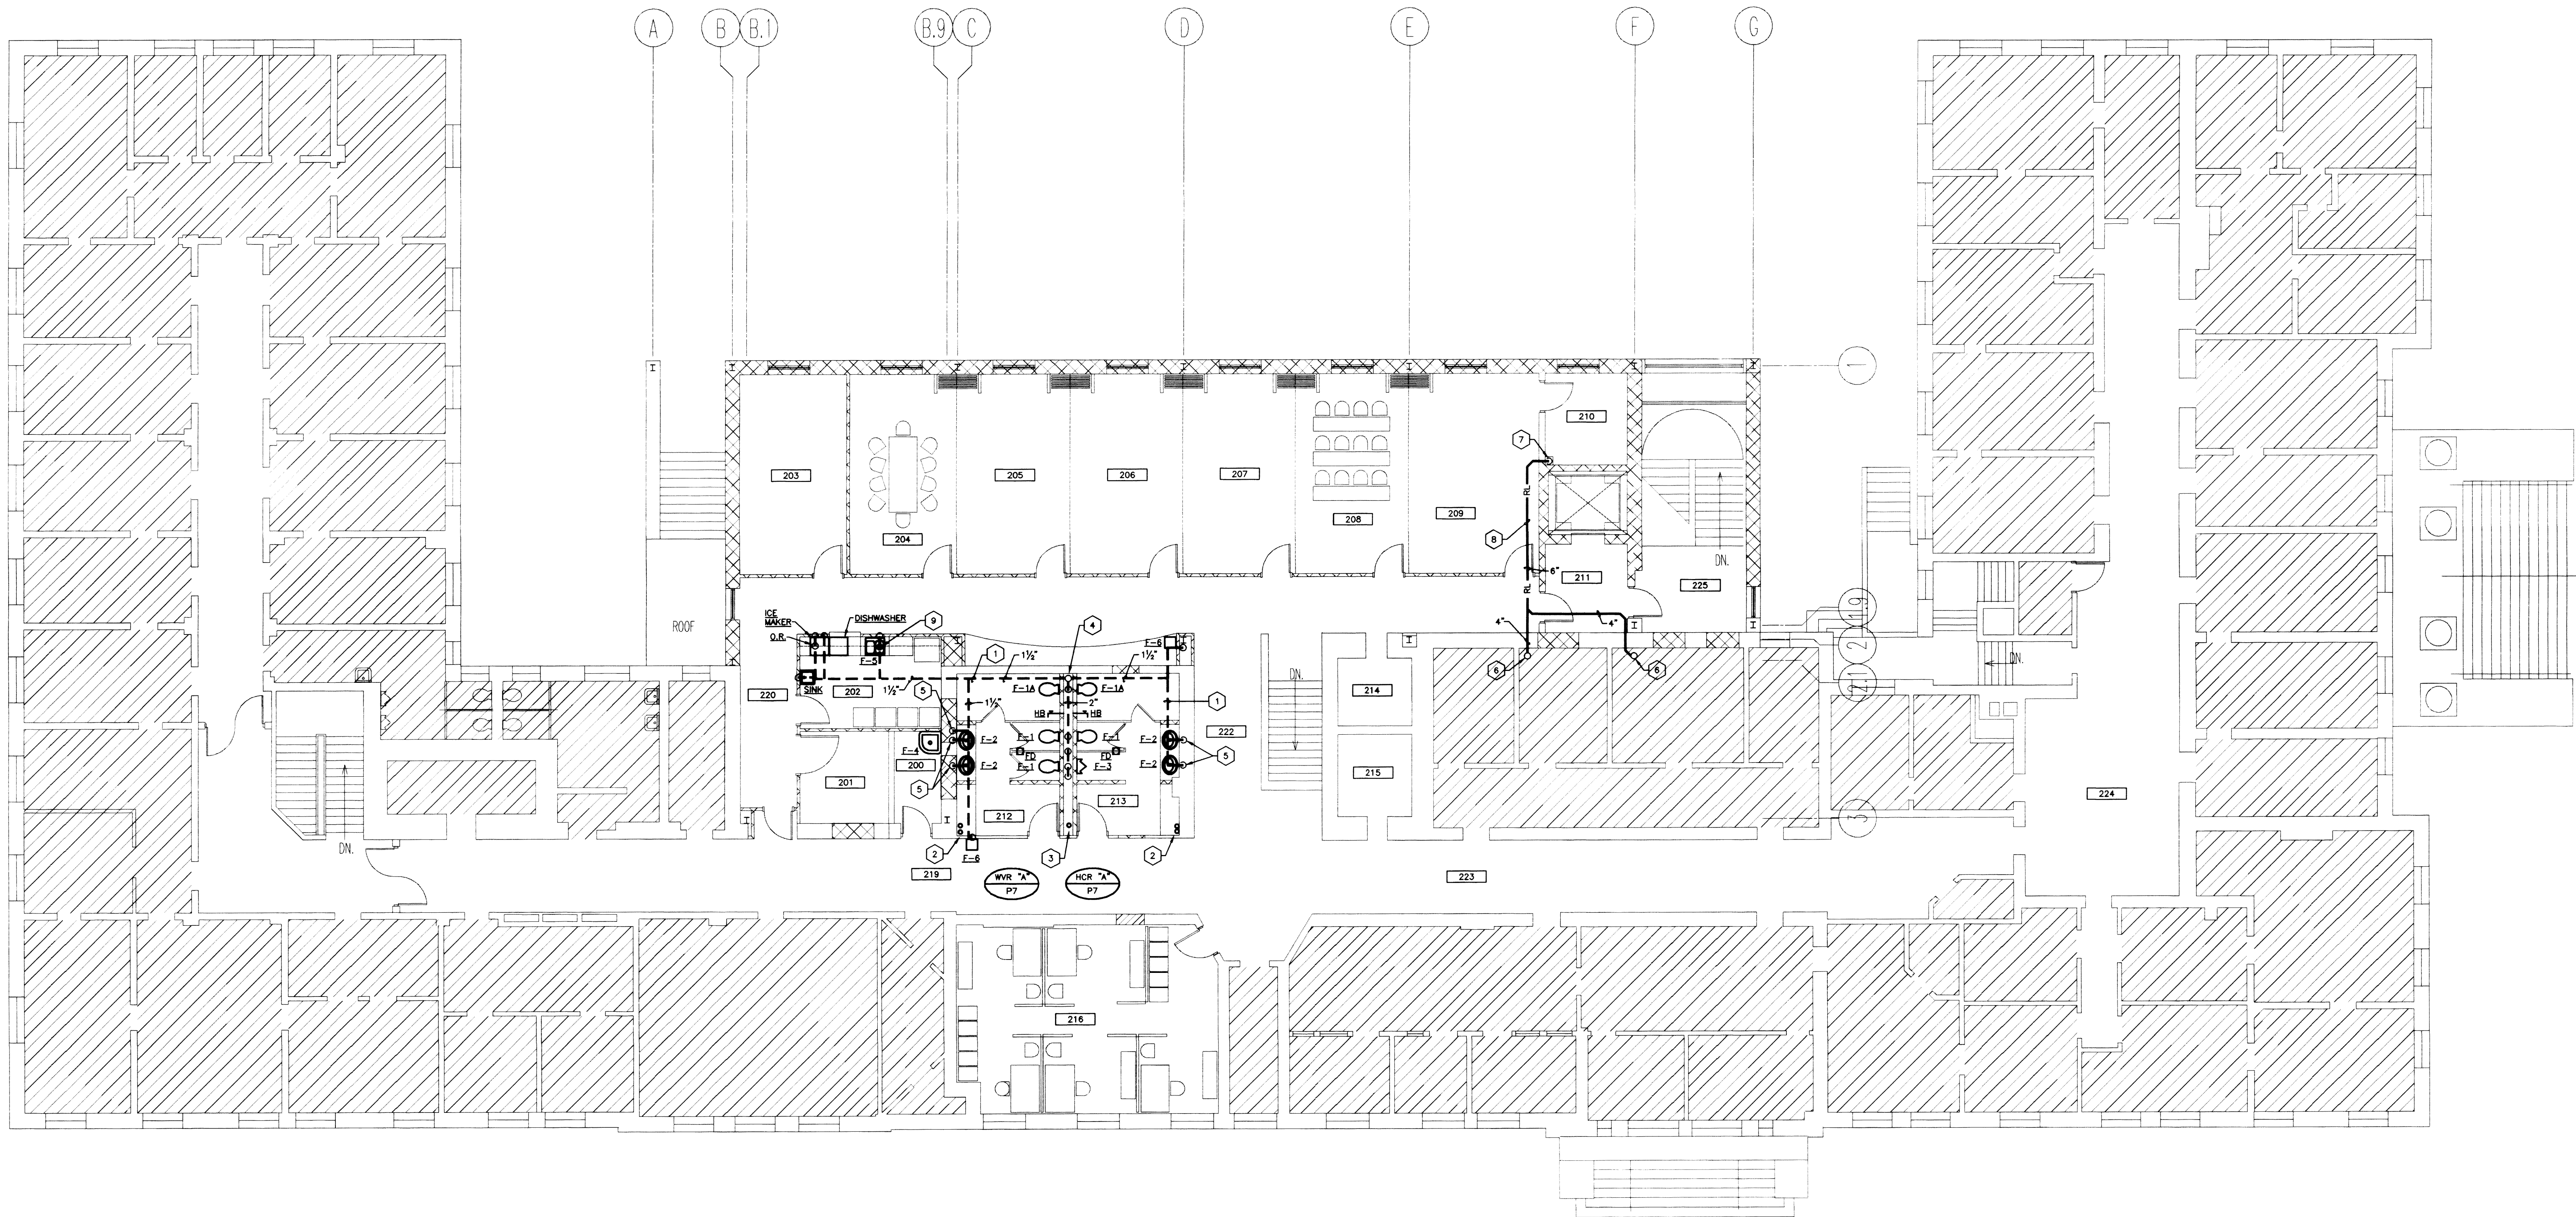

PLUMBING PLAN - SECOND FLOOR

SCALE: 1/8"=1'-0"

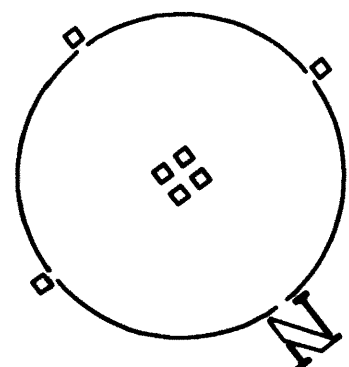

ROOM NO.	ROOM NAME
200	JANITOR
201	CHAIR STOR.
202	KITCHINETTE
203	COMPUTER
204	SATELLITE
205	CONFERENCE
206	VIDEO
207	A/V STORAGE
208	ELEV. LOBBY LEVEL 2
209	WOMEN
210	MEN
211	RECORDS
212	TRAINING OFFICE
213	CORRIDOR
214	CORRIDOR
215	CORRIDOR
216	CORRIDOR
217	CORRIDOR
218	CORRIDOR
219	CORRIDOR
220	CORRIDOR
221	CORRIDOR
222	CORRIDOR
223	CORRIDOR
224	CORRIDOR
225	STAIR

- CODED NOTES-DRAWING P3
- 1 RUN VENT PIPING ABOVE SECOND FLOOR CEILING.
 - 2 3/4" CW & 3/4" HW DOWN.
 - 3 2" CW DOWN.
 - 4 4" VENT DOWN AND 4" VENT UP TO 4" VENT THRU ROOF.
 - 5 CUT OUT EXISTING WALLS FOR NEW VERTICAL WASTE & VENT PIPES.
 - 6 4" RAIN LEADER UP TO ROOF DRAIN.
 - 7 6" RAIN LEADER DOWN, FURR IN.
 - 8 RUN RAIN LEADER ABOVE SECOND FLOOR CEILING.
 - 9 GARBAGE DISPOSAL.









RECORD DRAWINGS DATE 9-8-95

These record drawings have been prepared, in part, on the basis of information compiled and furnished by others. The Engineer will not be responsible for any errors or omissions which have been incorporated into this document as a result.

STAGGS & FISHER CONSULTING ENGINEERS, INC.

SCOVELL HALL RENOVATION


PLUMBING PLAN - SECOND FLOOR

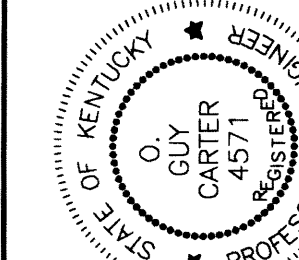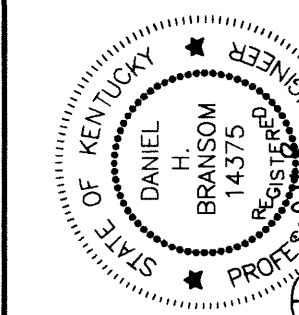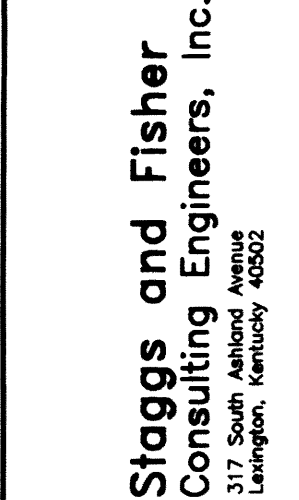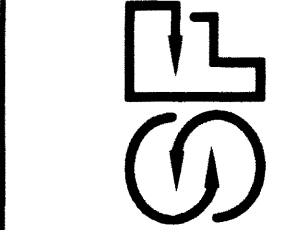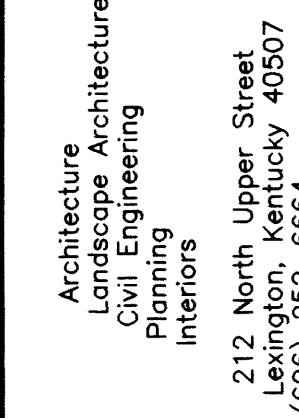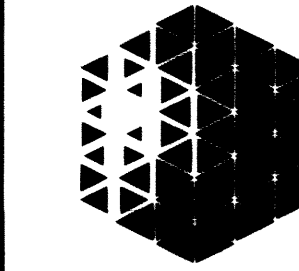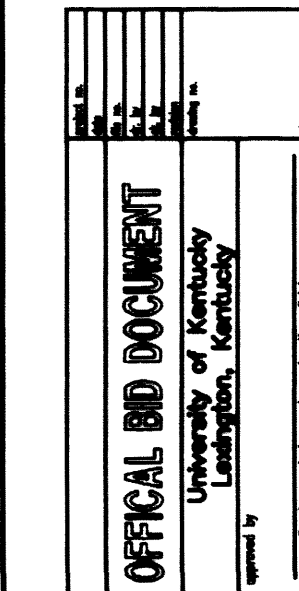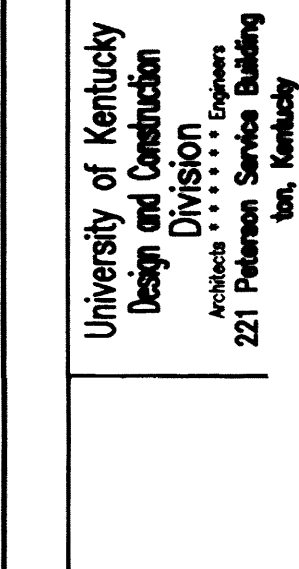

UNIVERSITY OF KENTUCKY


This Drawing and Design shall remain the property of Staggs and Fisher Consulting Engineers, Inc. The reproduction, copying or other use of this Drawing without the written consent of Staggs and Fisher Consulting Engineers, Inc. is prohibited.

DRAWING: S:\DWG\SCOVELL\PLUMB\44.DWG SCALE: 1/8" = 1'-0" DATE: 12/29/94 AT 09:14

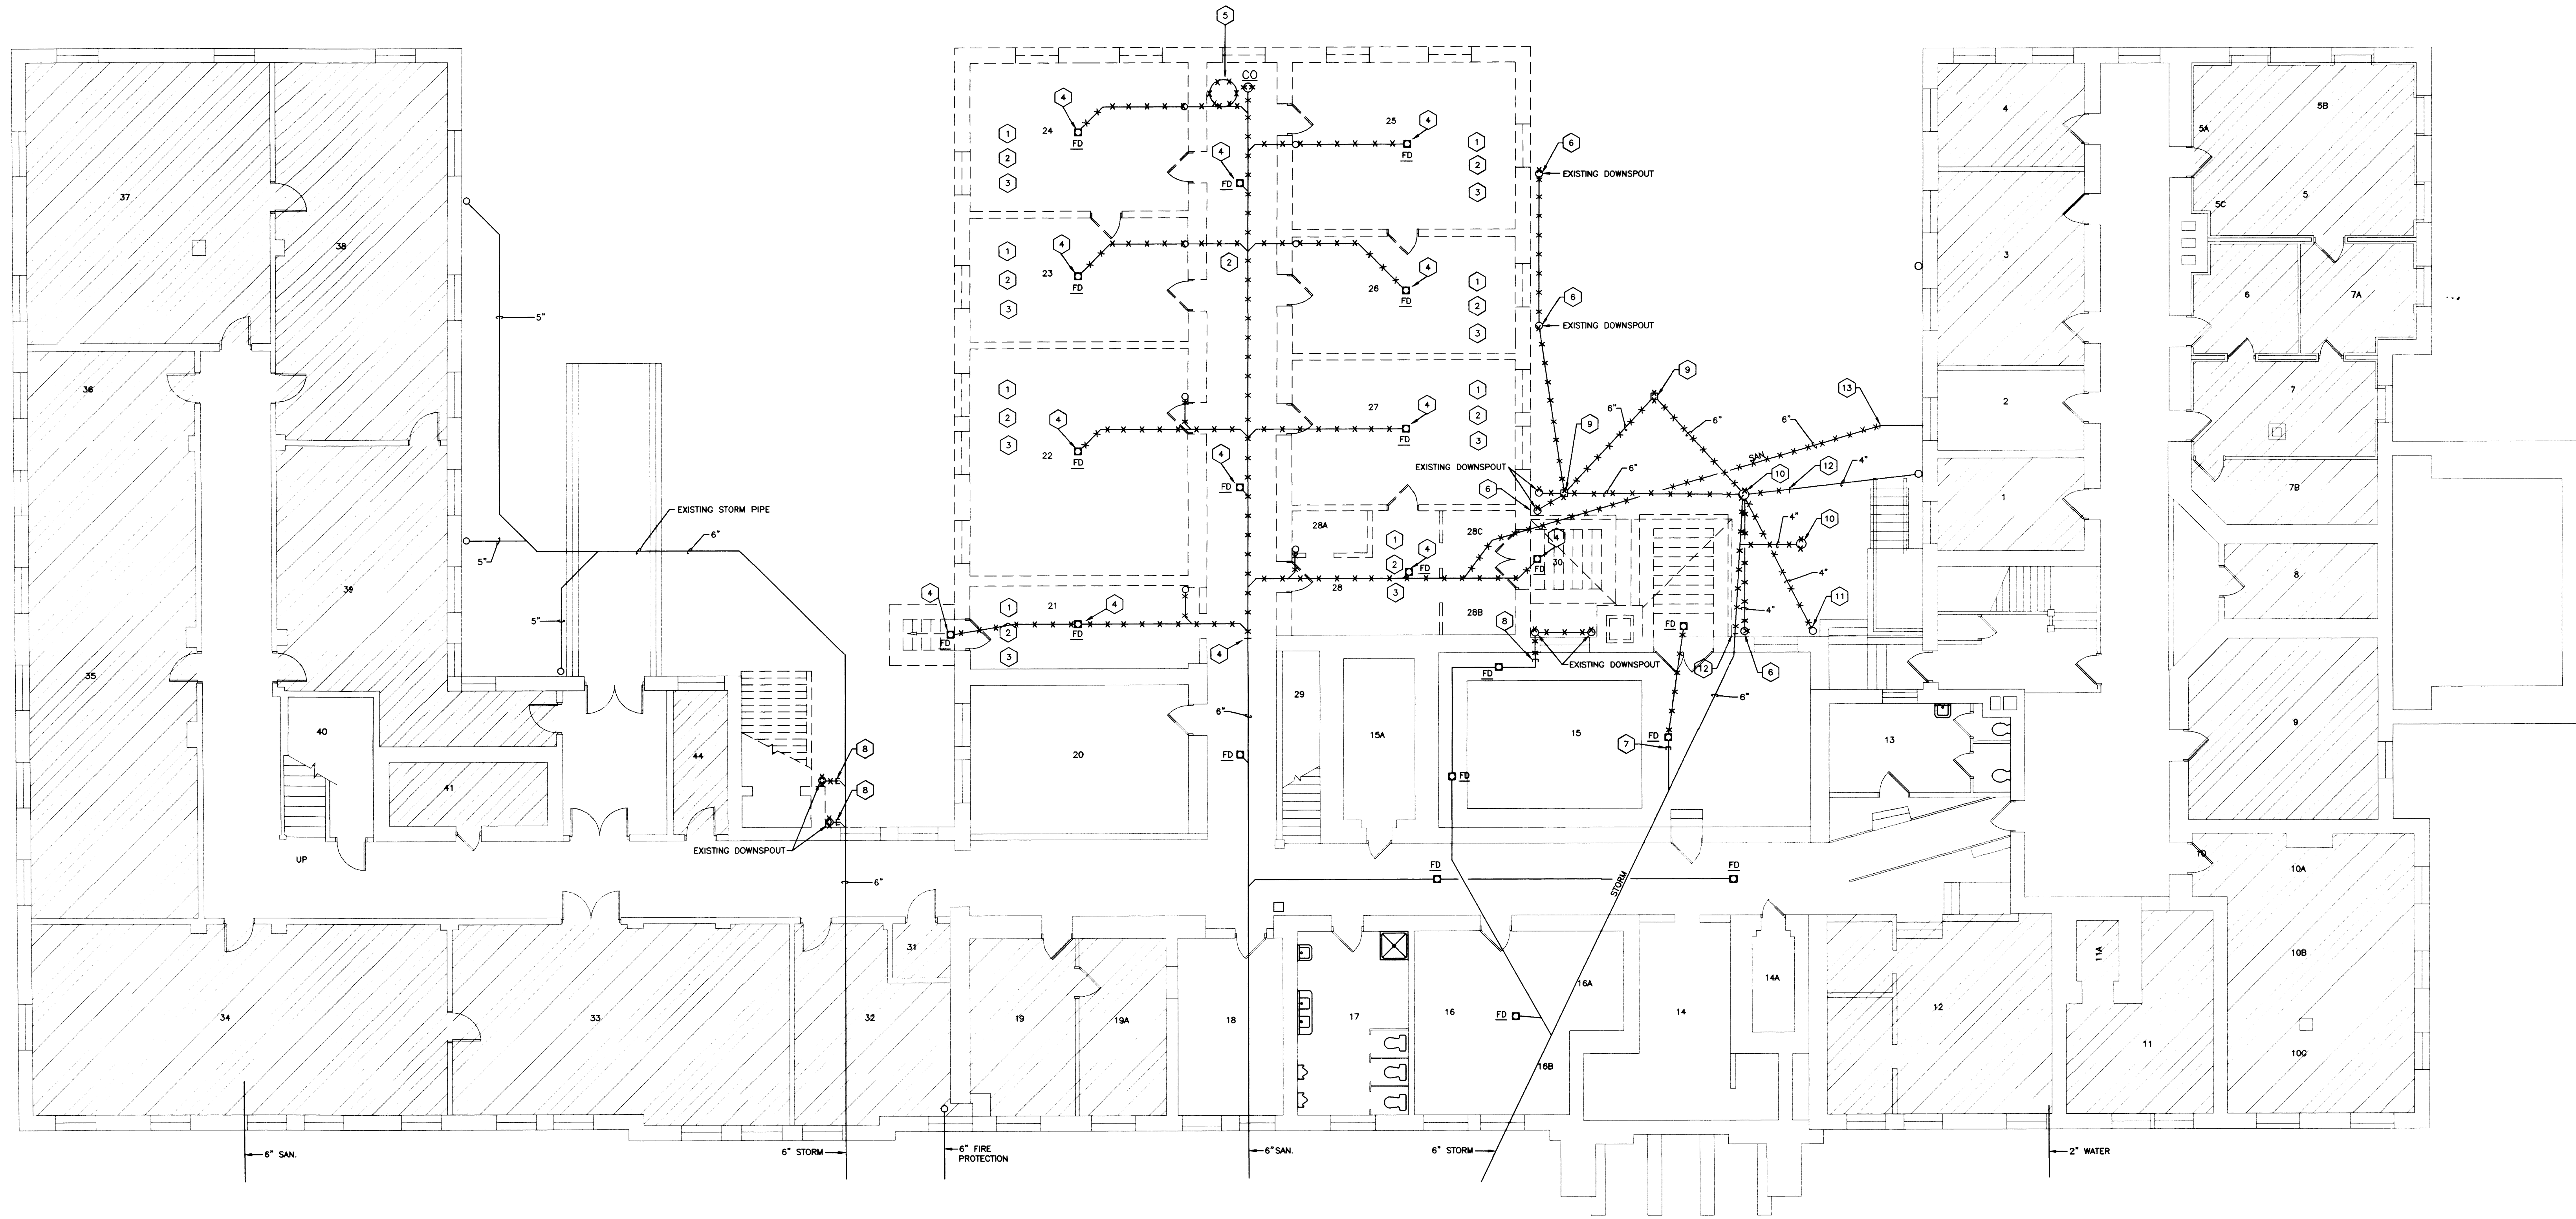

PLUMBING PLAN — BASEMENT FLOOR — DEMOLITION

SCALE: 1/8" = 1'-0"

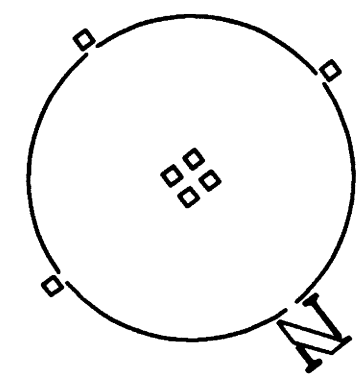

CODED NOTES—DRAWING P4

- 1 REMOVE ALL EXISTING LABORATORY SINKS, CUP SINKS, COUNTERS AND COLD WATER, HOT WATER AND HOT WATER RECIRCULATING PIPE TO DEMOLITION LIMIT AND CAP.
- 2 REMOVE ALL EXISTING FIRE PROTECTION SPRINKLER PIPE AND HEADS TO DEMOLITION LIMIT AND CAP.
- 3 REMOVE ALL EXISTING GAS, AIR AND VACUUM PIPE TO DEMOLITION LIMIT AND CAP.
- 4 REMOVE ALL EXISTING FLOOR DRAINS AND SOIL, WASTE AND VENT PIPE TO DEMOLITION LIMIT AND CAP VENT PIPE.
- 5 REMOVE EXISTING ACID DILUTION TANK AND ALL EXISTING ACID WASTE AND ACID VENT PIPE.
- 6 REMOVE EXISTING DOWNSPOUTS AND STORM PIPE.
- 7 REMOVE EXISTING FLOOR DRAINS AND PIPE TO THIS POINT AND CAP.
- 8 REMOVE EXISTING DOWNSPOUTS AND DRAIN PIPE TO THIS POINT AND CAP.
- 9 REMOVE EXISTING STORM GRATES.
- 10 REMOVE EXISTING STORM MANHOLE.
- 11 REMOVE EXISTING STORM PIPE TO THIS POINT. EXISTING DOWNSPOUT TO REMAIN.
- 12 REMOVE EXISTING STORM PIPE TO THIS POINT.
- 13 REMOVE EXISTING SANITARY SEWER TO THIS POINT.

RECORD DRAWINGS DATE 9-8-95

These record drawings have been prepared, in part, on the basis of information compiled and furnished by others. The Engineer will not be responsible for any errors or omissions which have been incorporated into this document as a result.

STAGGS & FISHER CONSULTING ENGINEERS, INC.

SCOVELL HALL RENOVATION

UNIVERSITY OF KENTUCKY

PLUMBING PLAN — BASEMENT FLOOR — DEMOLITION

Job No: 93202 Date: 8/1/94 Drawn By: Checked: DHB Revisions:


00 2138

P.4

University of Kentucky
Design and Construction
Division
1000 Commonwealth Building
Lexington, Kentucky 40507


OFFICIAL BIDD DOCUMENT
University of Kentucky
Lexington, Kentucky

Omni
Architects

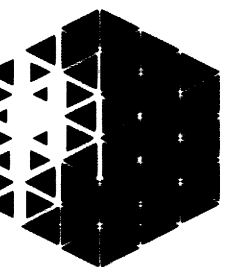


Architecture
Landscape Architecture
Civil Engineering
Planning
Interiors
212 North Upper Street
Lexington, Kentucky 40507
(606) 252-6864

SF
Staggs and Fisher
Consulting Engineers, Inc.
317 South Second Street
Lexington, Kentucky 40502

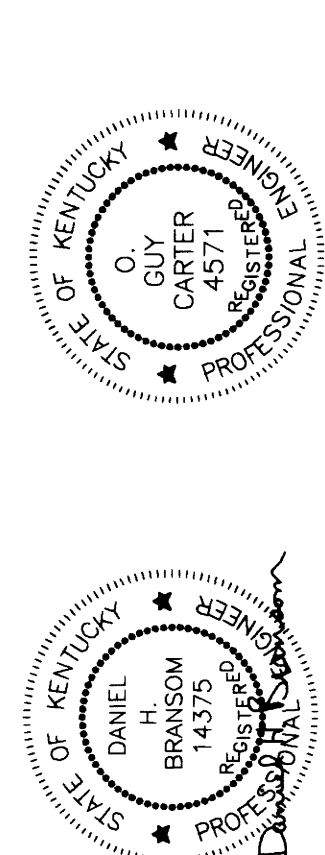


DRAWING: S:\DWG\SCOVELL\PLUMB\05.DWG SCALE: 96, 08/07/94 AT 08:48

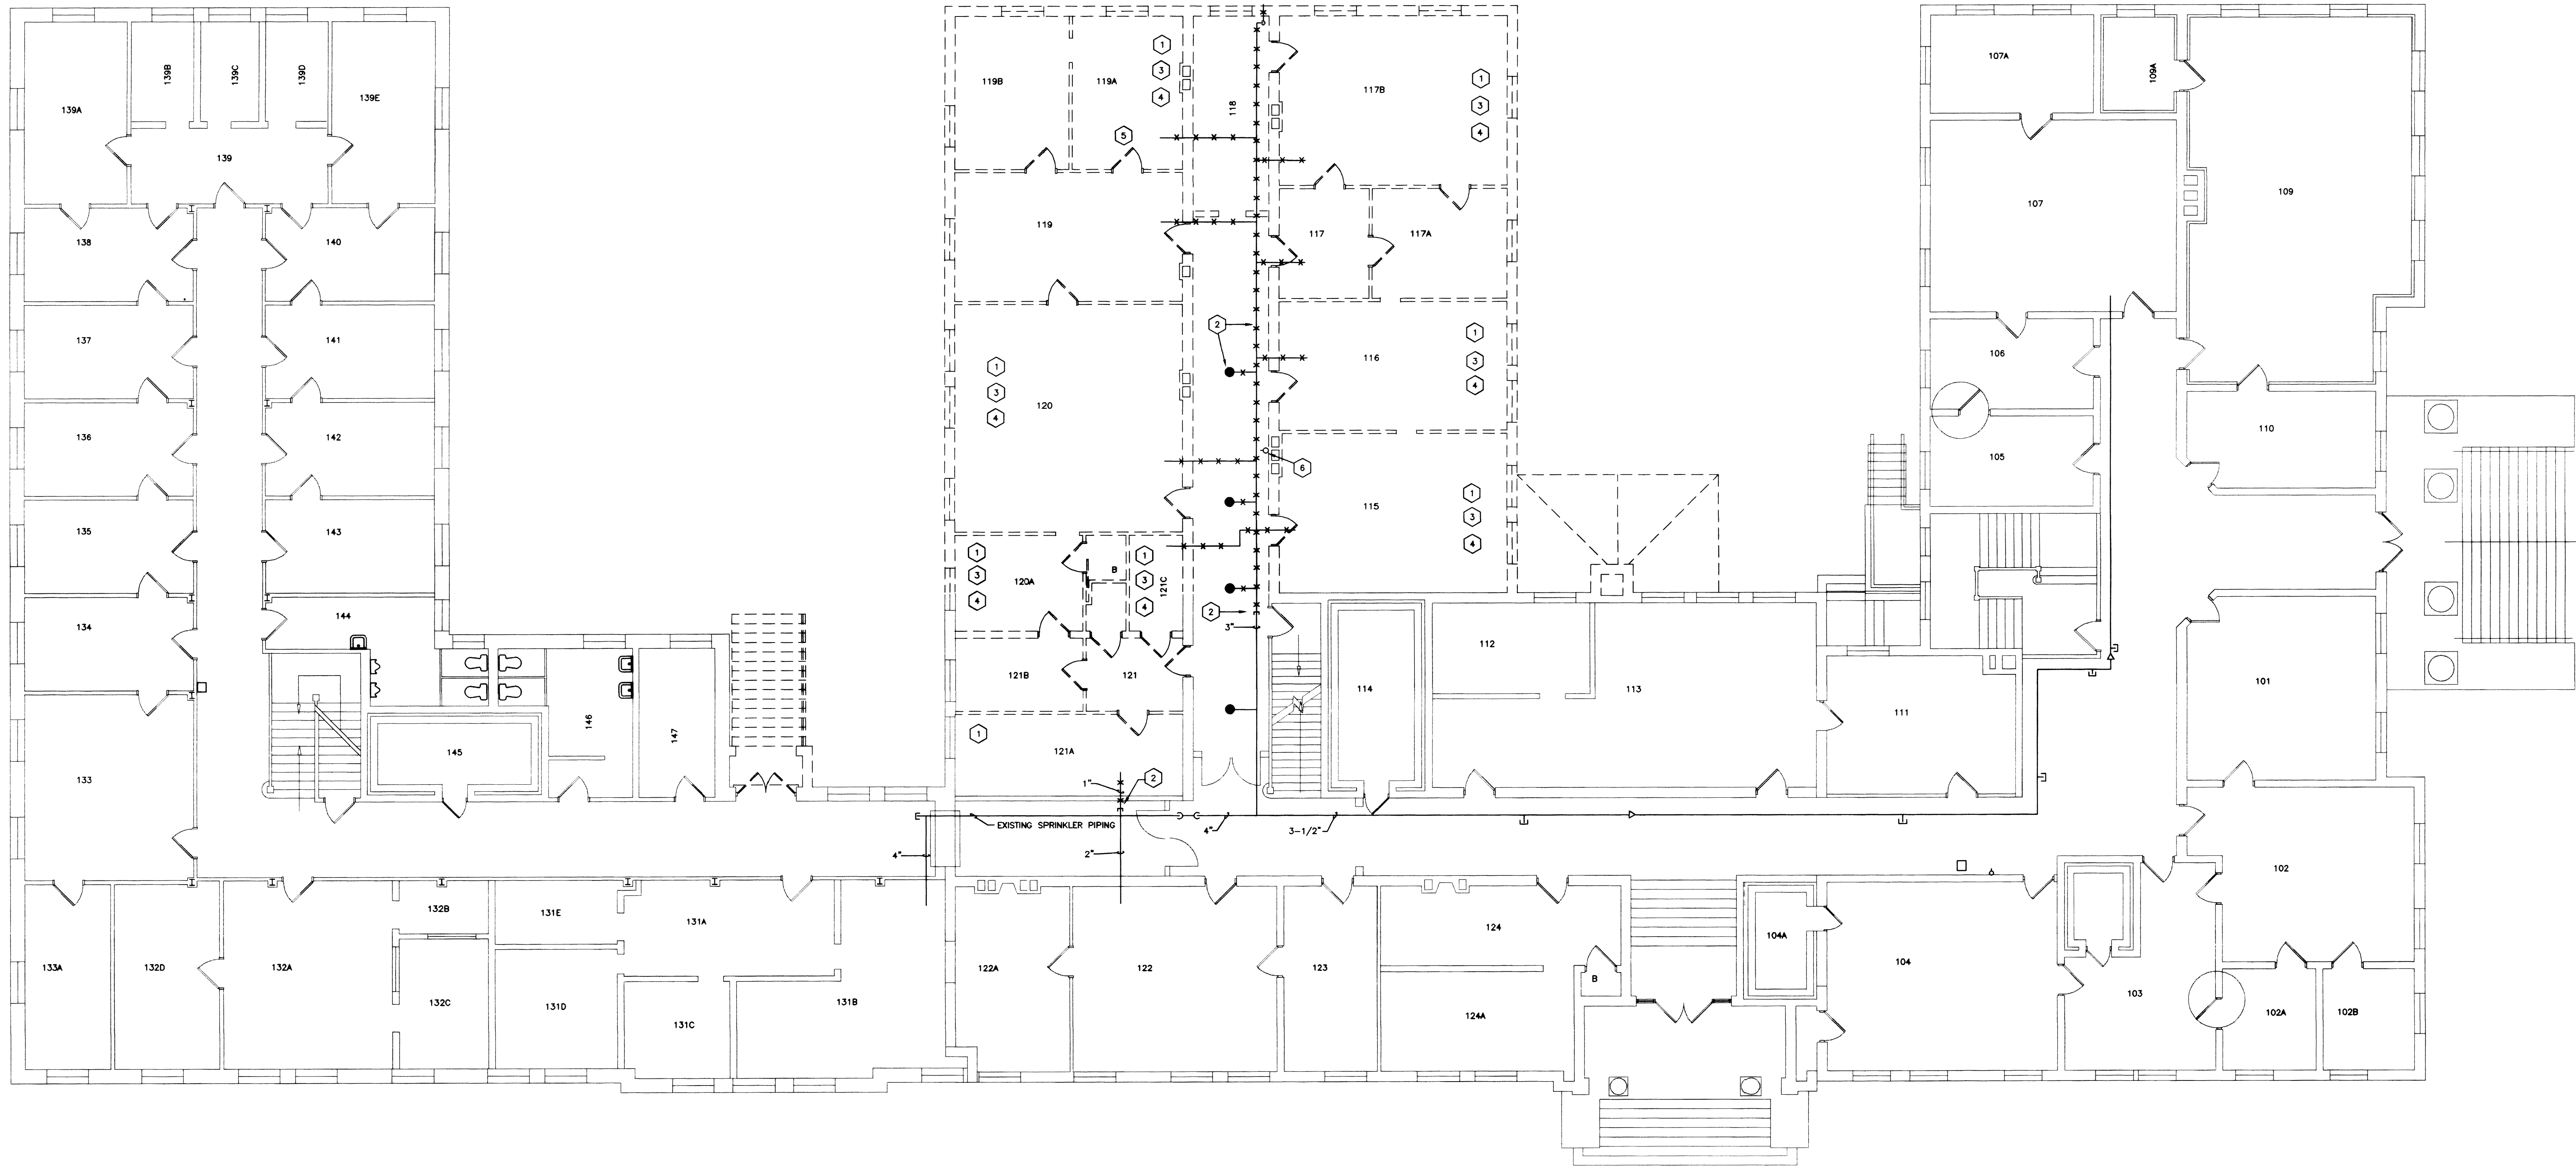

PLUMBING PLAN - FIRST FLOOR - DEMOLITION

SCALE : 1/8" = 1'-0"

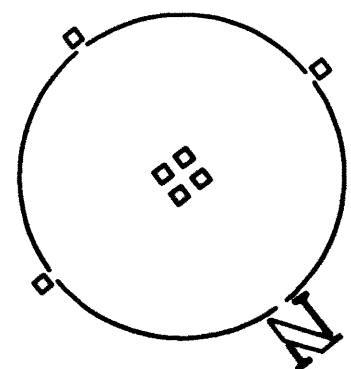

CODED NOTES--DRAWING P5

- 1 REMOVE ALL EXISTING LABORATORY SINKS, CUP SINKS, COUNTERS AND COLD WATER, HOT WATER AND HOT WATER RECIRCULATING PIPE TO DEMOLITION LIMIT AND CAP.
- 2 REMOVE ALL EXISTING FIRE PROTECTION SPRINKLER PIPE AND HEADS TO DEMOLITION LIMIT AND CAP.
- 3 REMOVE ALL EXISTING GAS, AIR AND VACUUM PIPE TO DEMOLITION LIMIT AND CAP.
- 4 REMOVE ALL EXISTING SOIL, WASTE AND VENT PIPE TO DEMOLITION LIMIT AND CAP VENT PIPE.
- 5 REMOVE ALL EXISTING ACID WASTE AND ACID VENT PIPE IN DEMOLITION AREA.
- 6 REMOVE EXISTING FIRE PROTECTION STANDPIPE AND HOSE CONNECTION.

RECORD DRAWINGS DATE 9-8-96
These record drawings have been prepared, in part, on the basis of information compiled and furnished by others. The Engineer will not be responsible for any errors or omissions which have been incorporated into this document as a result.
STAGGS & FISHER CONSULTING ENGINEERS, INC.

SCOVELL HALL RENOVATION

UNIVERSITY OF KENTUCKY

PLUMBING PLAN - FIRST FLOOR - DEMOLITION

Job No: 93202 Date: 8/1/94 Drawn By: Checked: DHB Revisions:


This Drawing and Design shown herein are the property of Omi Architects. The reproduction, copying or other use of this Drawing without the written consent of Omi Architects is prohibited.

002139
P.5



University of Kentucky
Design and Construction
DIVISION
Architect
James S. Fisher, Inc.
Lexington, Kentucky


OFFICIAL BMD DOCUMENT
University of Kentucky
Lexington, Kentucky

Omi
Architects

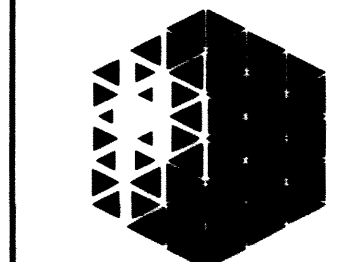



Staggs and Fisher
Consulting Engineers, Inc.
212 North Upper Street
Lexington, Kentucky 40507
(606) 252-6664

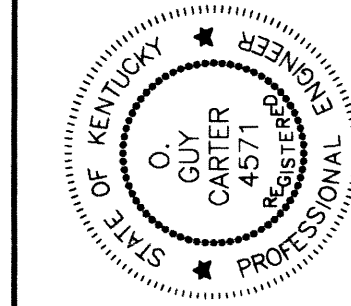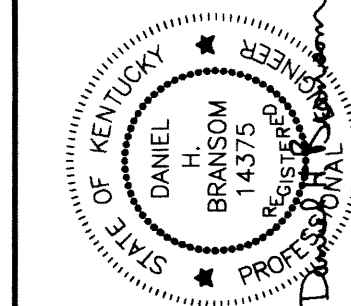

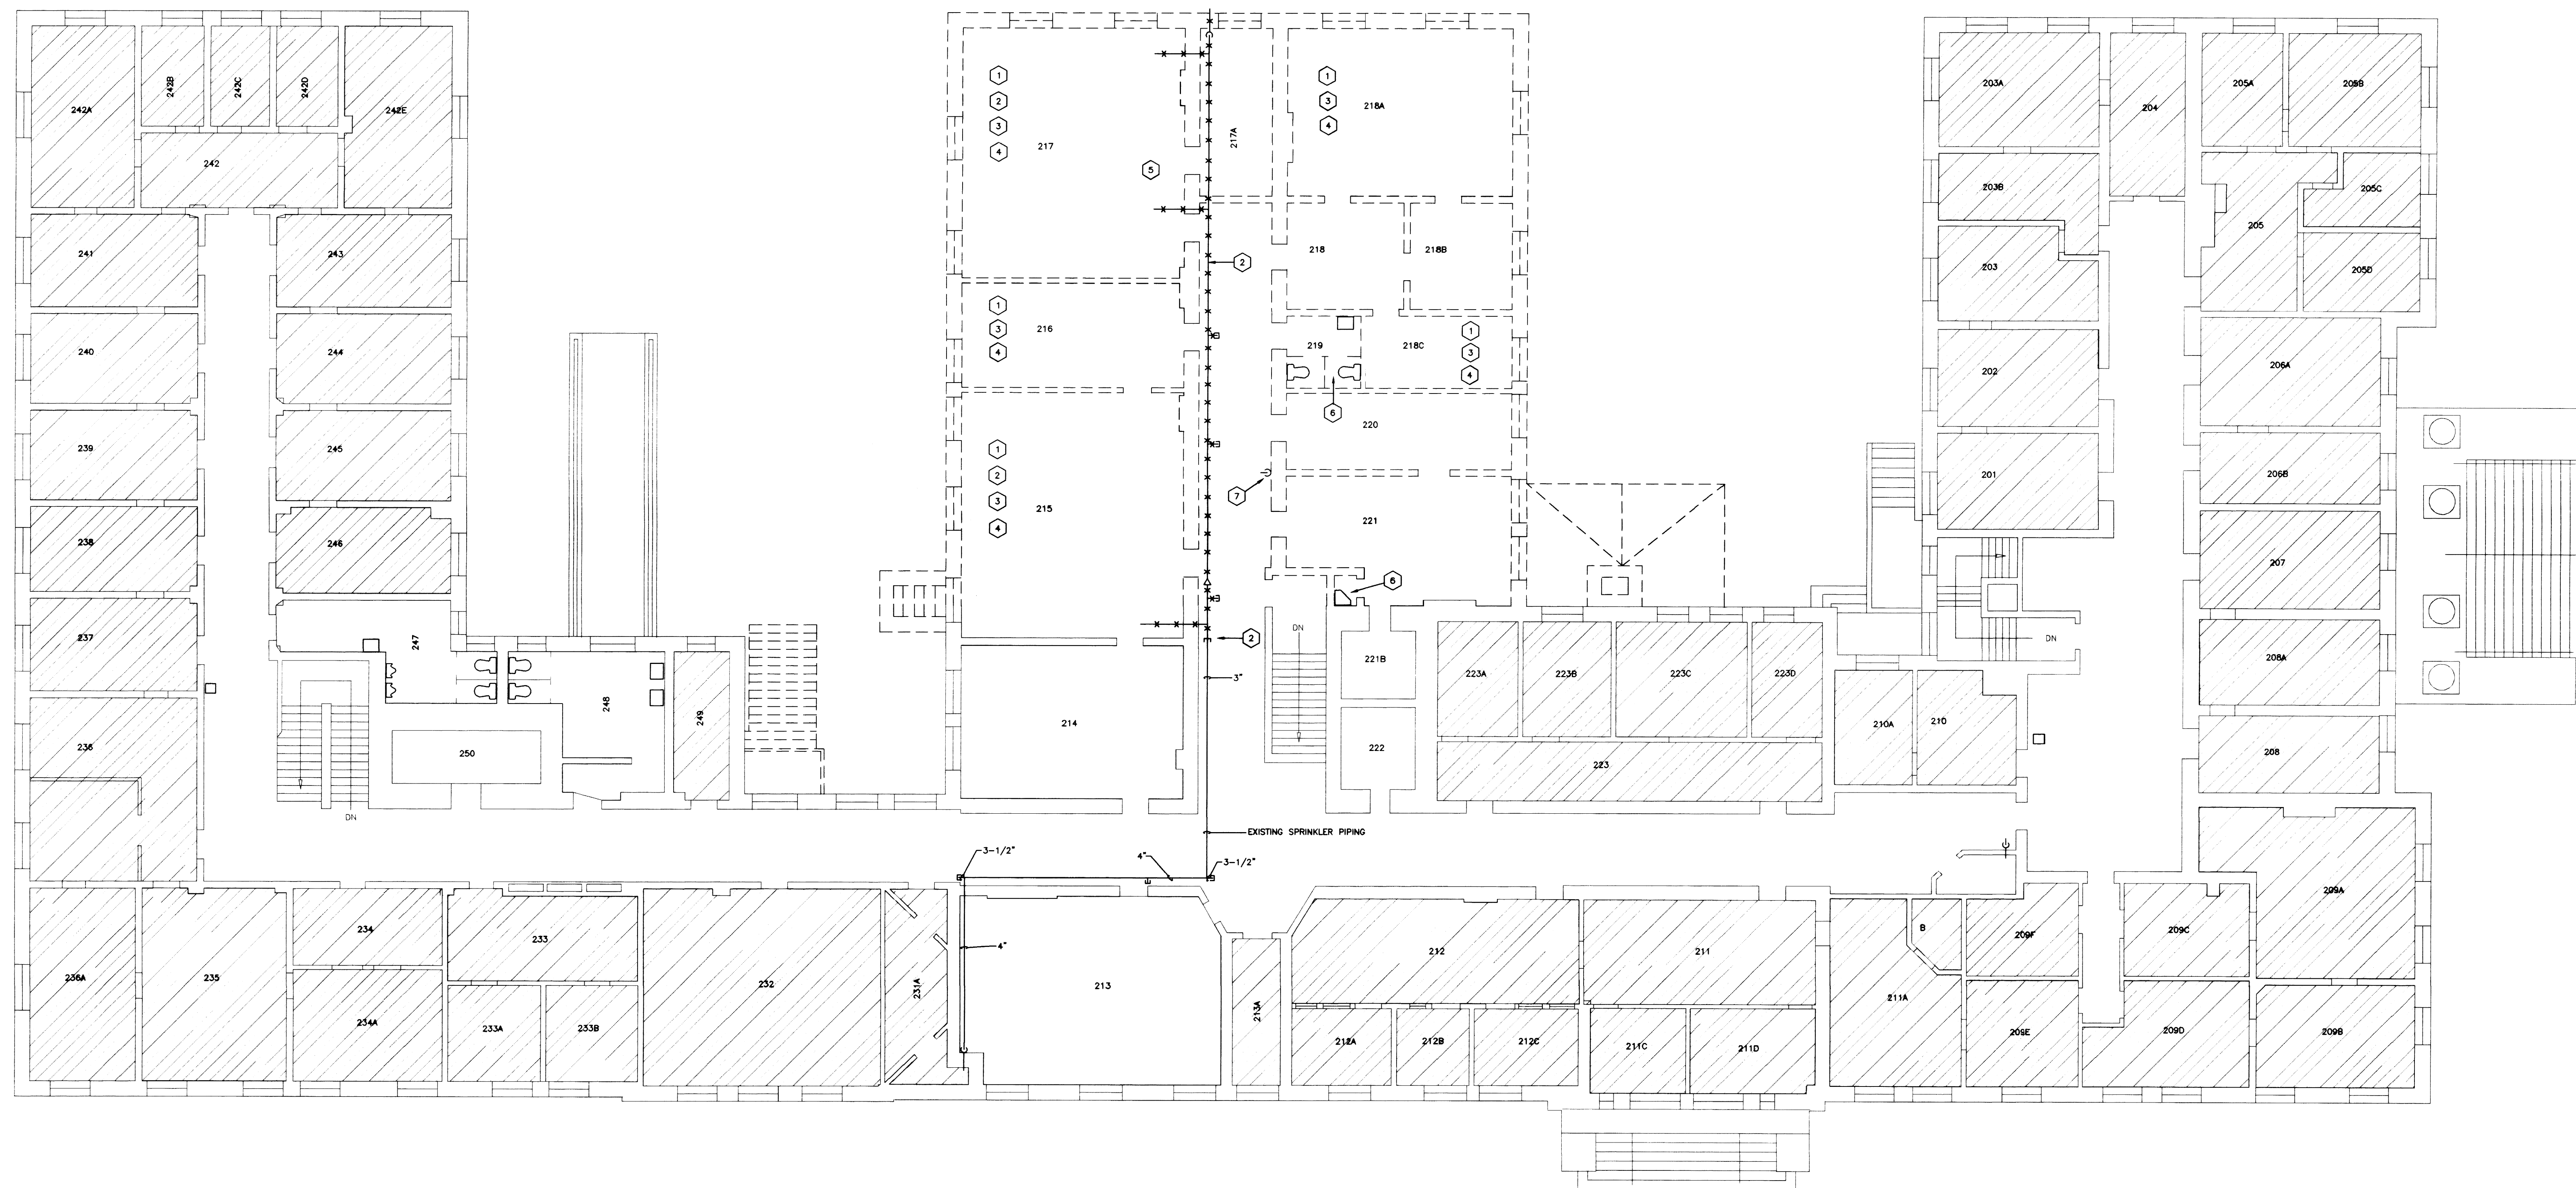

PLUMBING PLAN — SECOND FLOOR — DEMOLITION


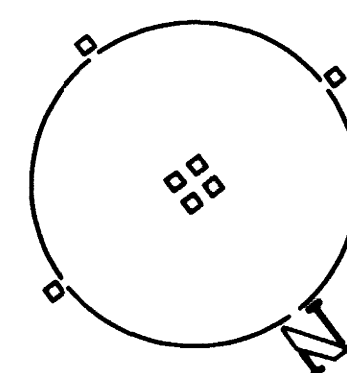










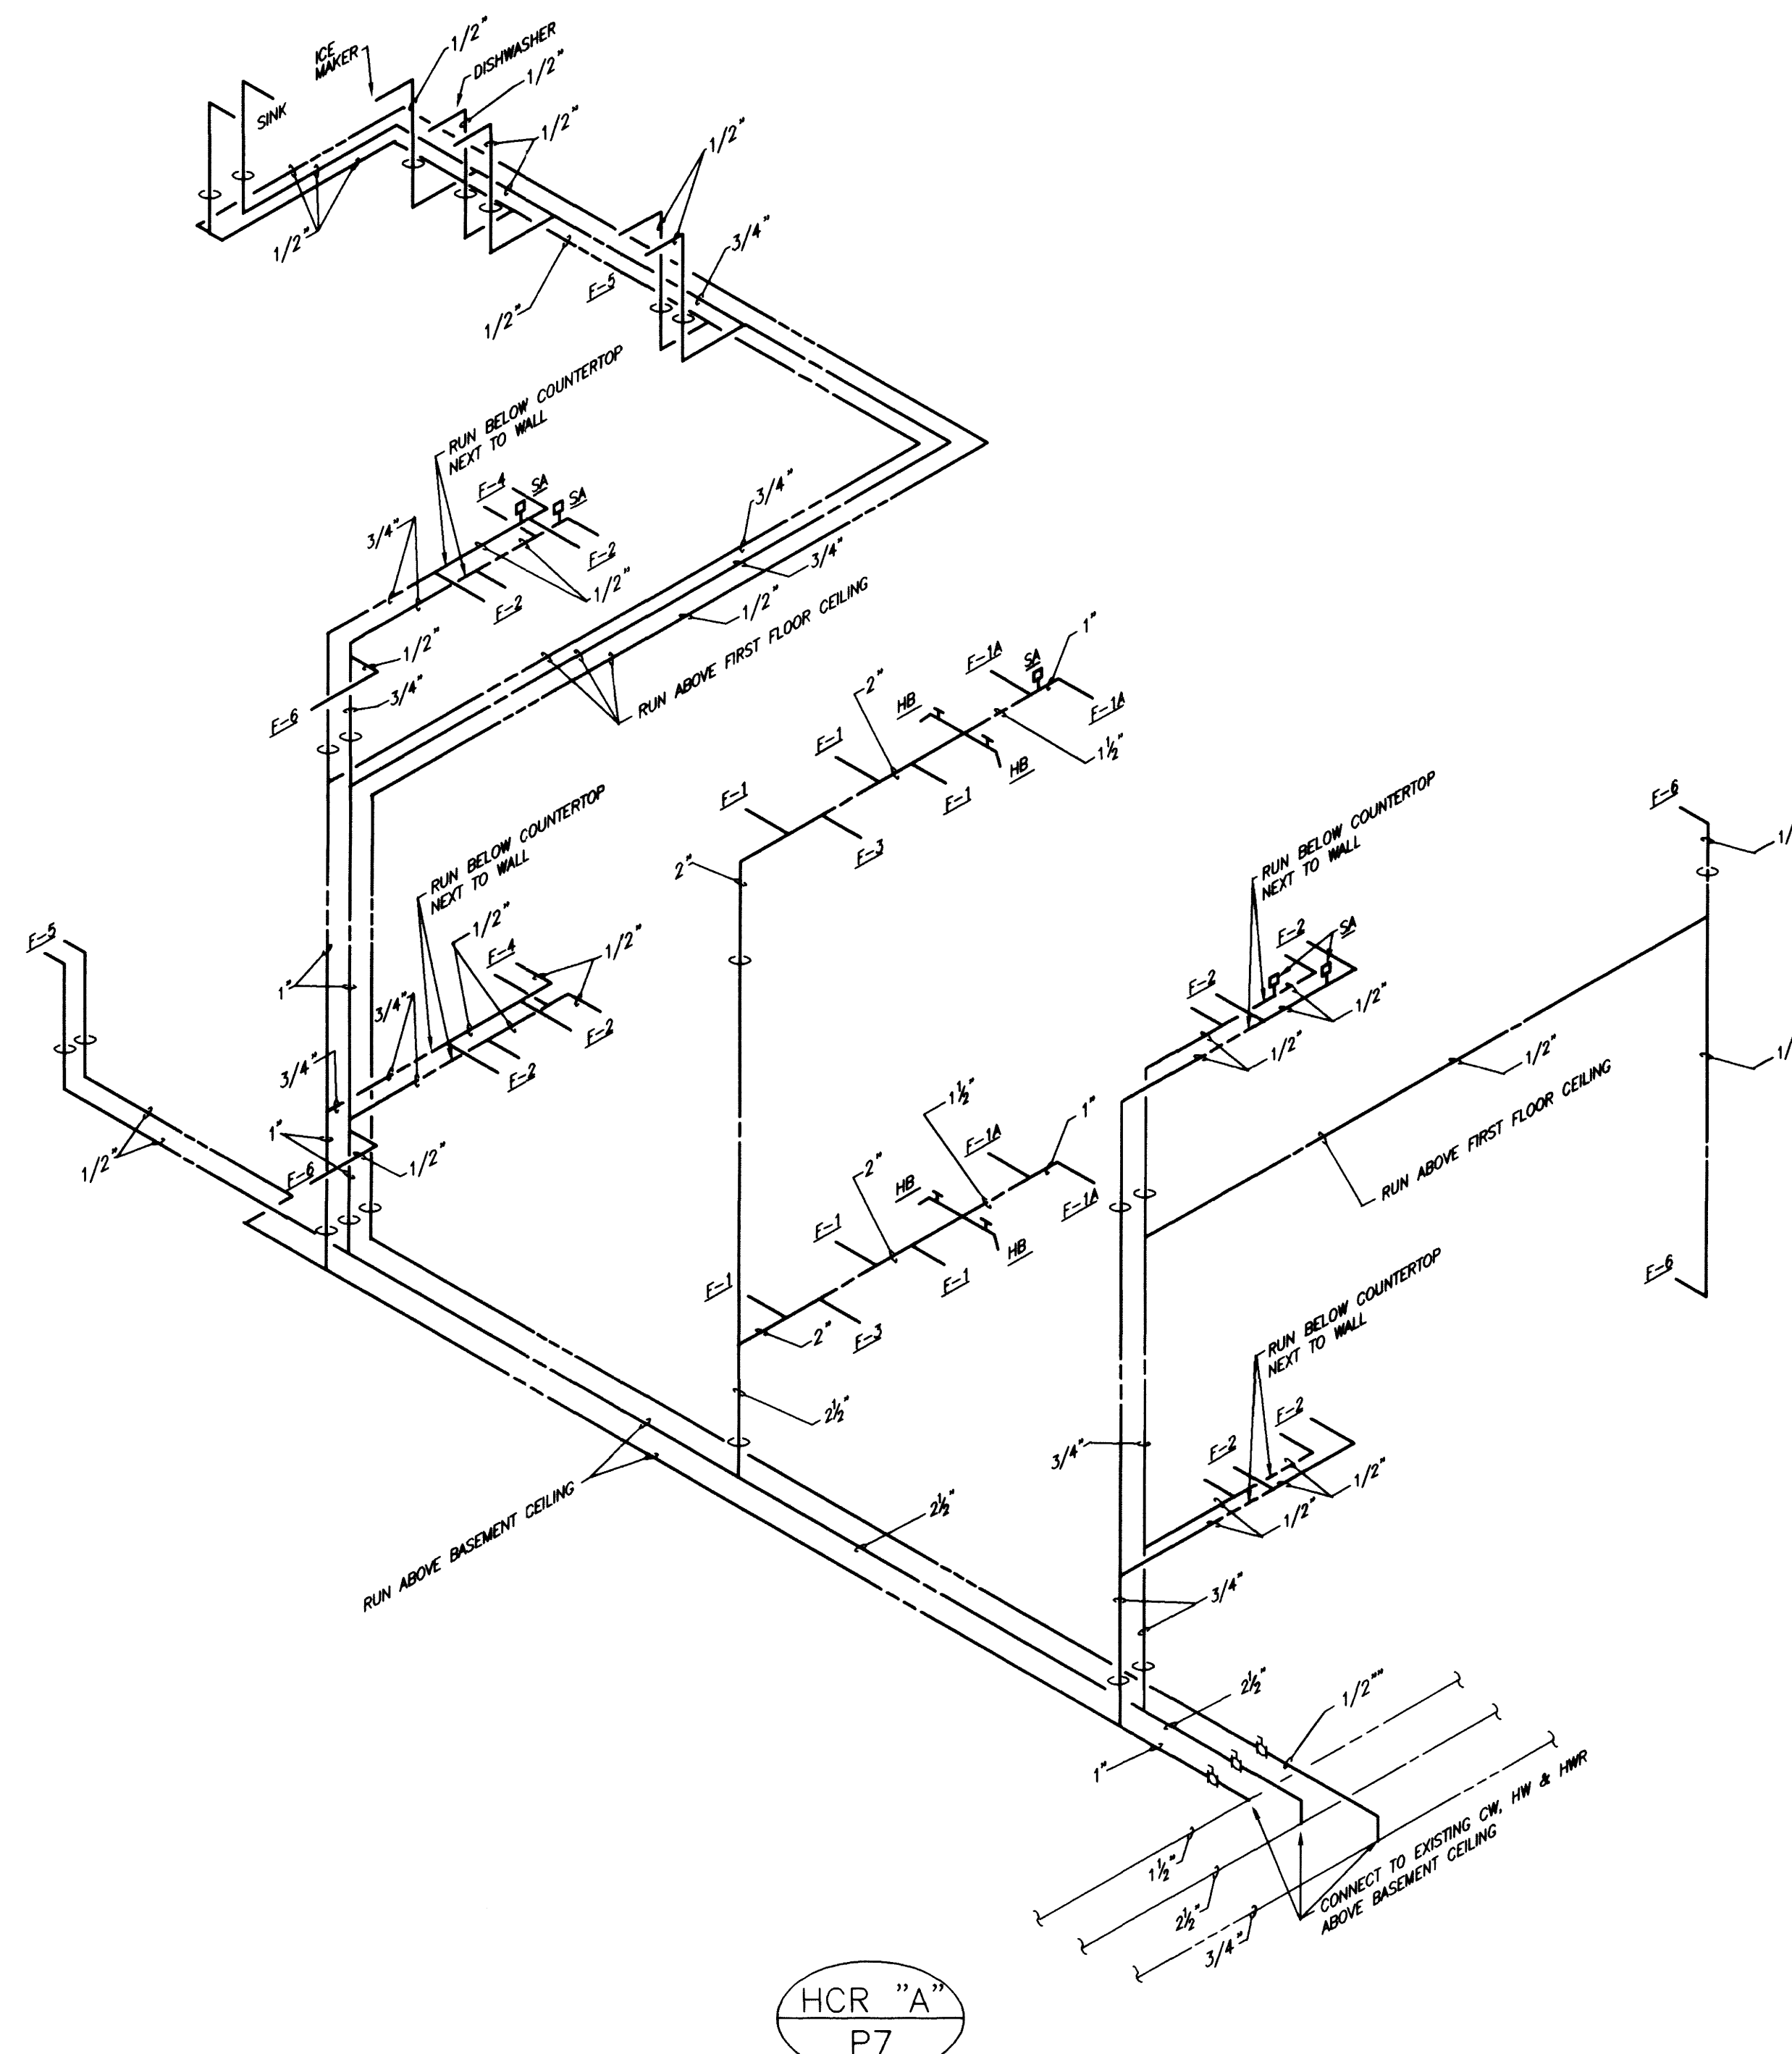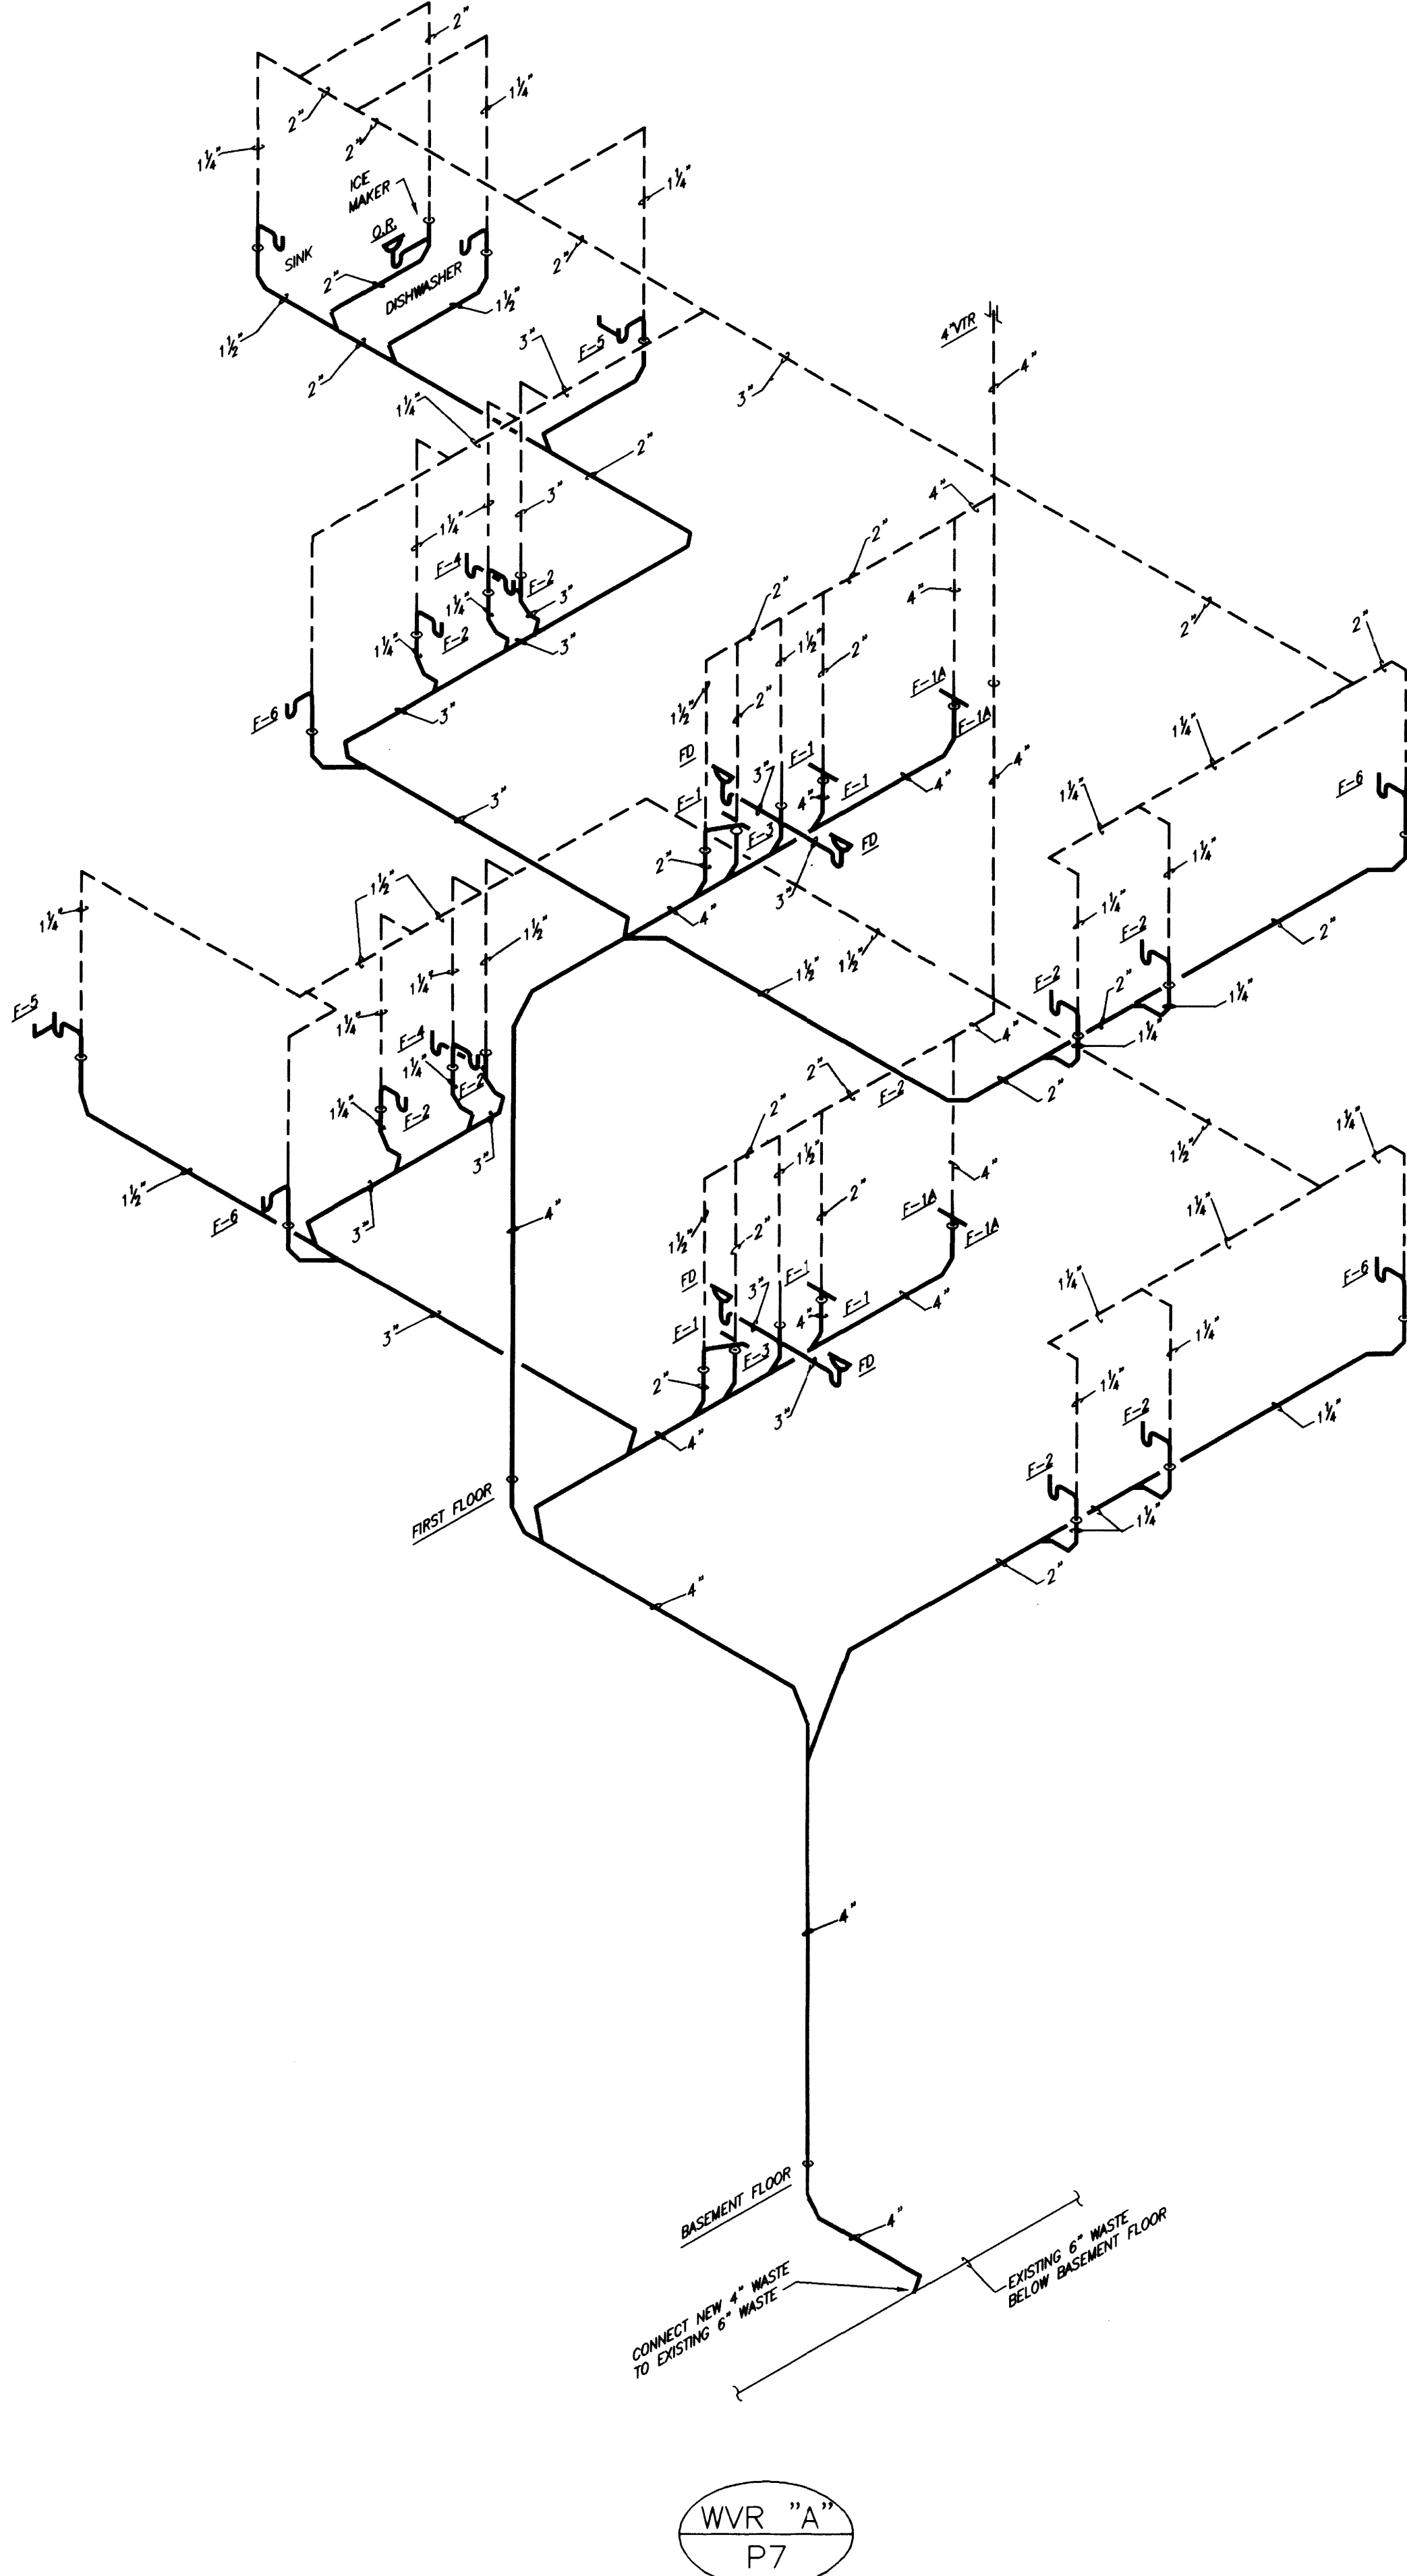








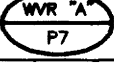
- |  | CODED NOTES—DRAWING PG. |
|---|--|
| 1 | REMOVE ALL EXISTING LABORATORY SINKS, CLIP SINKS, COUNTERS AND COLD WATER, HOT WATER AND HOT WATER REGULATOR PIPE TO DEMOLITION LIMIT AND CAP. |
| 2 | REMOVE ALL EXISTING FIRE PROTECTION SPRINKLER PIPE AND HEADS TO DEMOLITION LIMIT AND CAP. |
| 3 | REMOVE ALL EXISTING GAS, AIR AND VACUUM PIPE TO DEMOLITION LIMIT AND CAP. |
| 4 | REMOVE ALL EXISTING SLOPE AND VENT PIPE TO DEMOLITION LIMIT AND CAP VENT PIPE. |
| 5 | REMOVE ALL EXISTING ACID WASTE AND ACID VENT PIPE IN DEMOLITION AREA. |
| 6 | REMOVE EXISTING PLUMBING FIXTURES, TRIM AND COLD WATER, HOT WATER, SLOPE, WASTE AND VENT PIPE. |
| | 7 REMOVE EXISTING FIRE PROTECTION STANDPIPE AND HOSE CONNECTION. |

RECORD DRAWINGS DATE 2-2-95

These record drawings have been prepared, in part, on the basis of information compiled and furnished by others. The Engineer will not be responsible for any errors or omissions which have been incorporated into this document as a result.

STAGGS & FISHER CONSULTING ENGINEERS, INC.

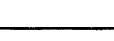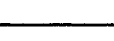

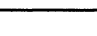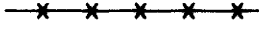PLUMBING LEGEND	
	EXISTING SANITARY OR WASTE PIPE
	NEW SANITARY OR WASTE PIPE
	VENT PIPE
	EXISTING COLD WATER
	EXISTING HOT WATER
	NEW COLD WATER
	NEW HOT WATER
	BALL VALVE
	ELBOW (UP)
	ELBOW (DOWN)
	ELBOW (SIDE)
	TEE (UP)
	TEE (DOWN)
	TEE (SIDE)
	HOSE BIBB
C.O.	CLEANOUT
F.D.	FLOOR DRAIN
CW	COLD WATER
HW	HOT WATER
VTR	VENT THRU ROOF
SA	SHOCK ARRESTOR
	PIPE AND EQUIPMENT TO BE REMOVED
	RAIN LEADER
	WASTE AND VENT RISER "A"/SHEET NO. P.7
O.R.	OPEN RECEPTACLE

FIXTURE SCHEDULE AND ROUGH-IN REQUIREMENTS:

A - F-1 WATER CLOSET (WALL HUNG) -- 15" FROM FLOOR TO EDGE OF BOWL.

B - F-1A WATER CLOSET (WALL HUNG - HANDICAPPED MOUNTING) -- 18" FROM FLOOR TO TOP OF SEAT.

C - F-2 LAVATORY -- LAVATORY MOUNTED IN COUNTERTOP. SEE ARCHITECTURAL DRAWINGS.


D - F-3 URINAL (HANDICAPPED MOUNTING) -- 17" FROM FLOOR TO TOP EDGE OF RECEPTOR (RIM OF BASIN).

E - F-4 MOP SINK -- 24" FROM FLOOR TO CENTERLINE OF DRAIN.

F - F-5 KITCHEN SINK -- SINK MOUNTED IN COUNTERTOP. SEE ARCHITECTURAL DRAWINGS.


G - F-6 ELECTRIC WATER COOLER -- 28" FROM FLOOR TO TOP EDGE OF RECEPTOR.

H - F-6A ELECTRIC WATER COOLER (HANDICAPPED MOUNTING) -- 30" FROM FLOOR TO TOP OF RECEPTOR.

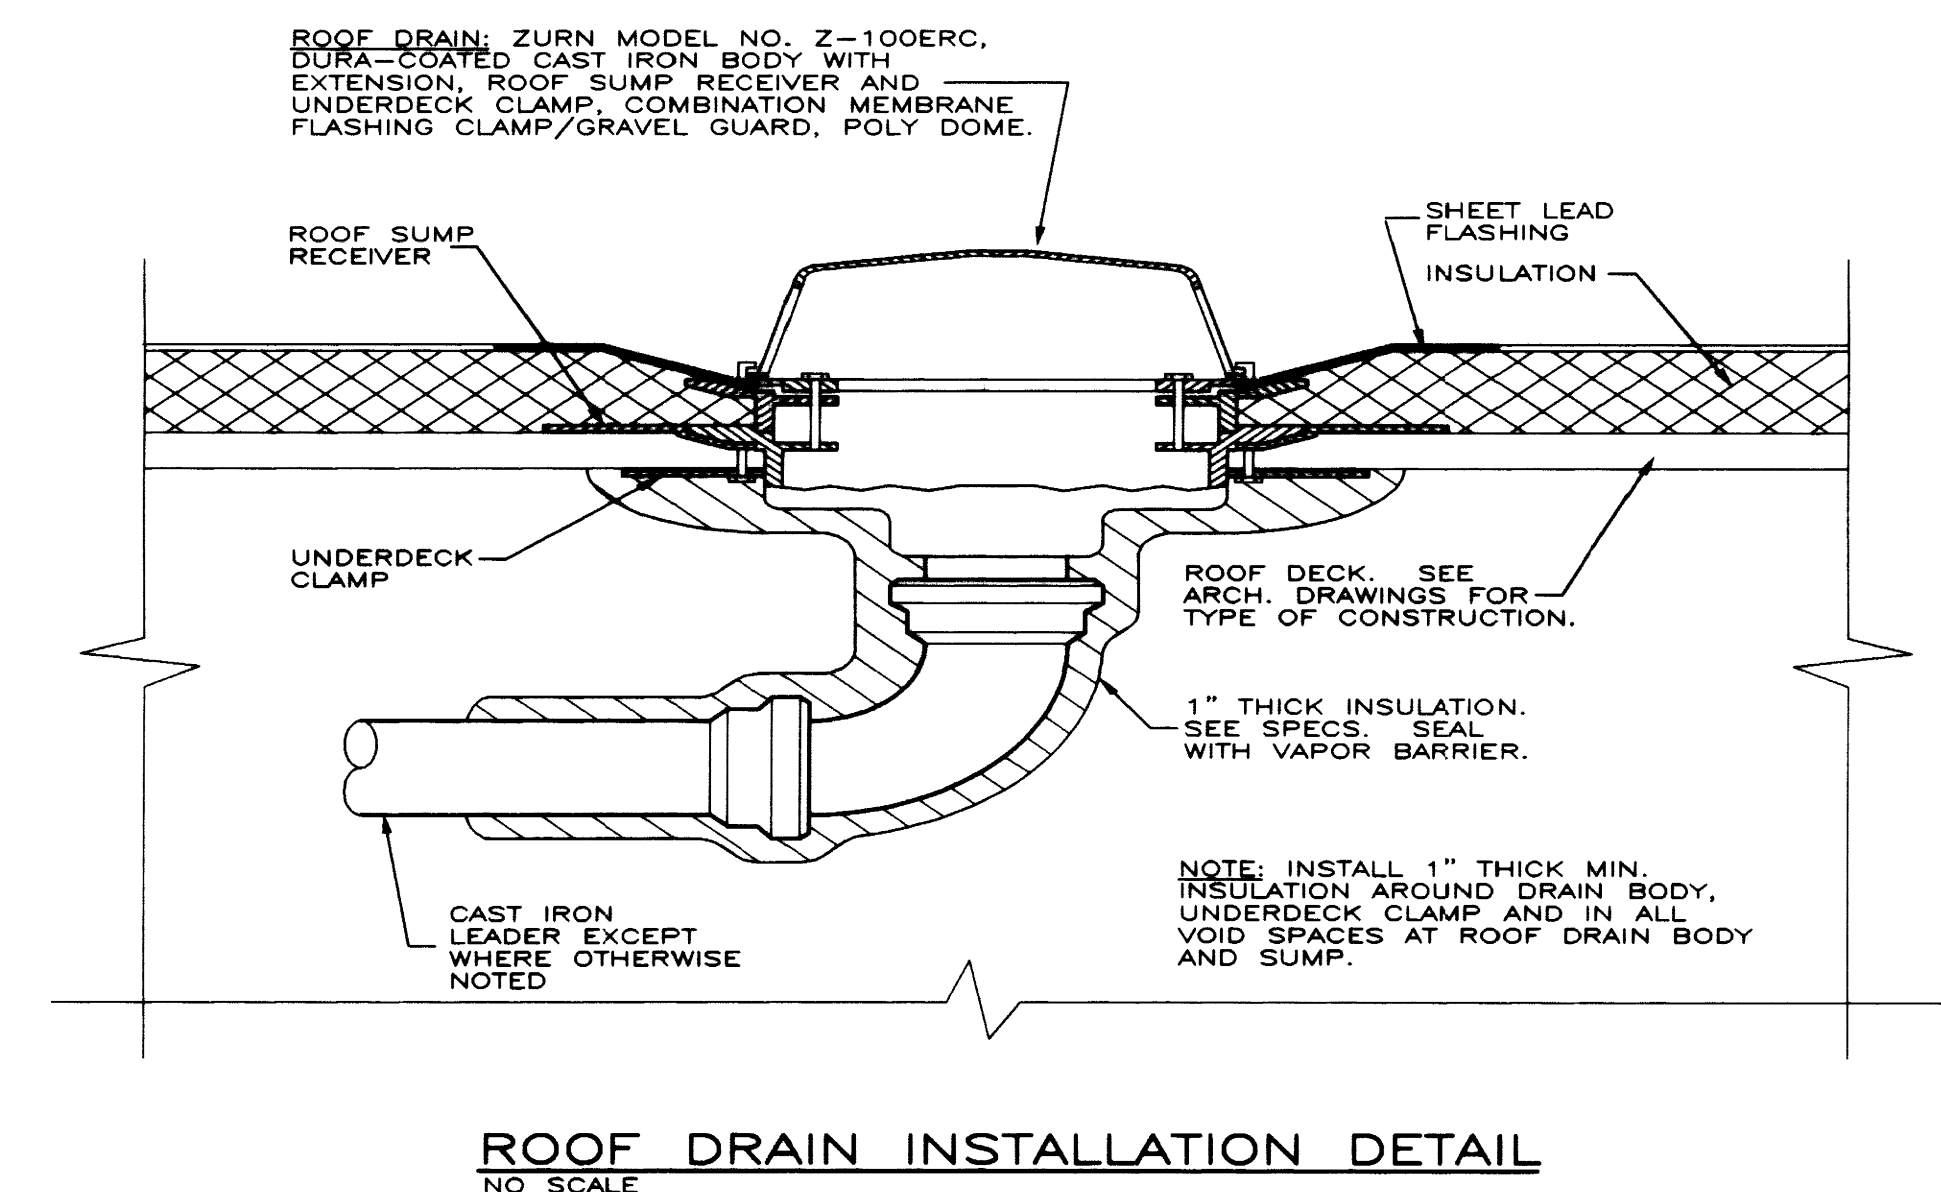


ROOF DRAIN INSTALLATION DETAIL
NO SCALE


NOTE: SUMP PUMP -- WEIL SERIES 1400, SIZE 1-1/4" SUBMERSIBLE SUMP PUMP, 30 GPM AT 21 FT. HEAD, 1750 RPM, 1/3 HP, 1 PHASE, 115 VOLTS. PROVIDE MERCURY SWITCH CONTROL.

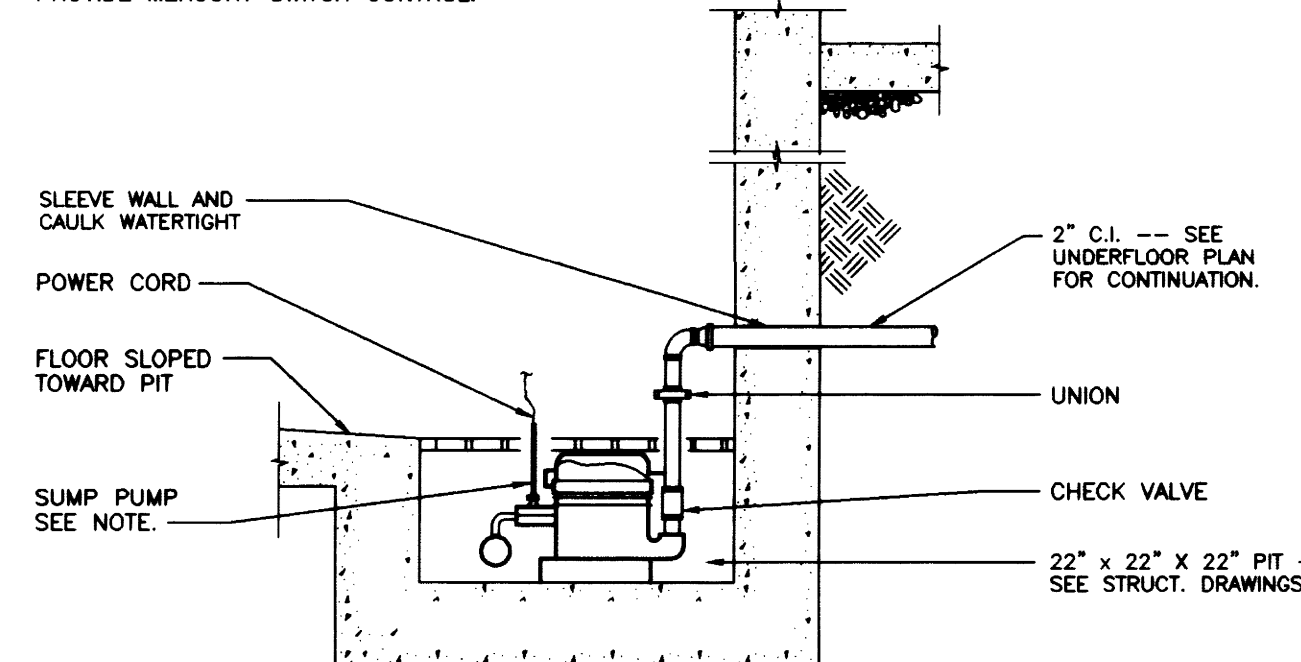

ELEVATOR SUMP PUMP DETAIL
NO SCALE

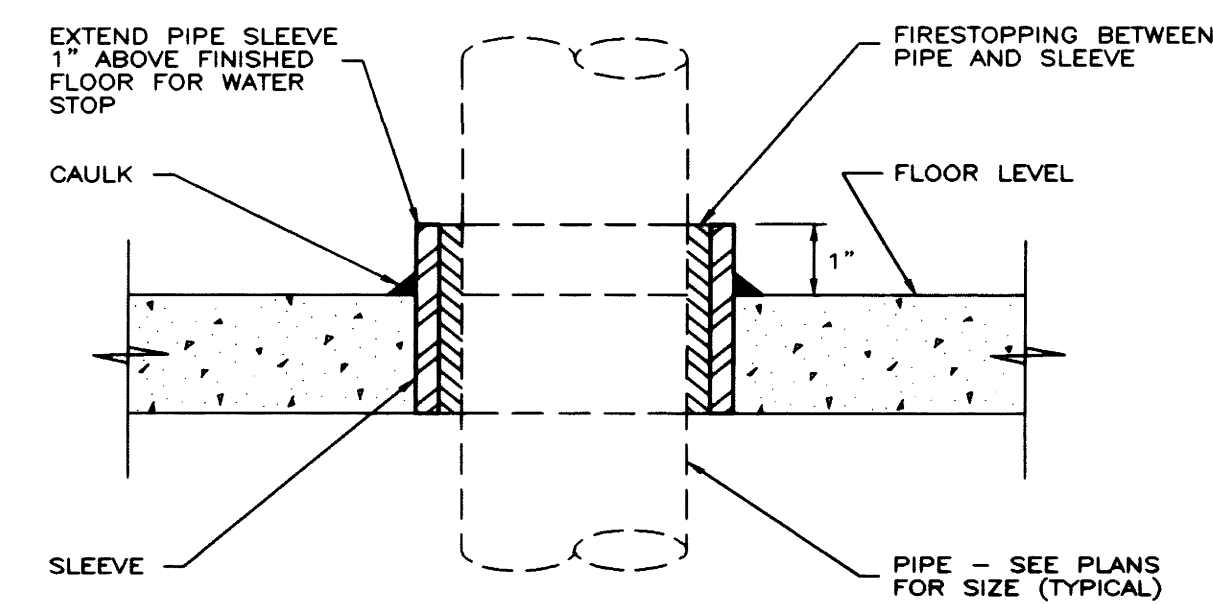

SLEEVE DETAIL FOR PIPING PASSING
THRU CONCRETE FLOOR SLAB
NO SCALE

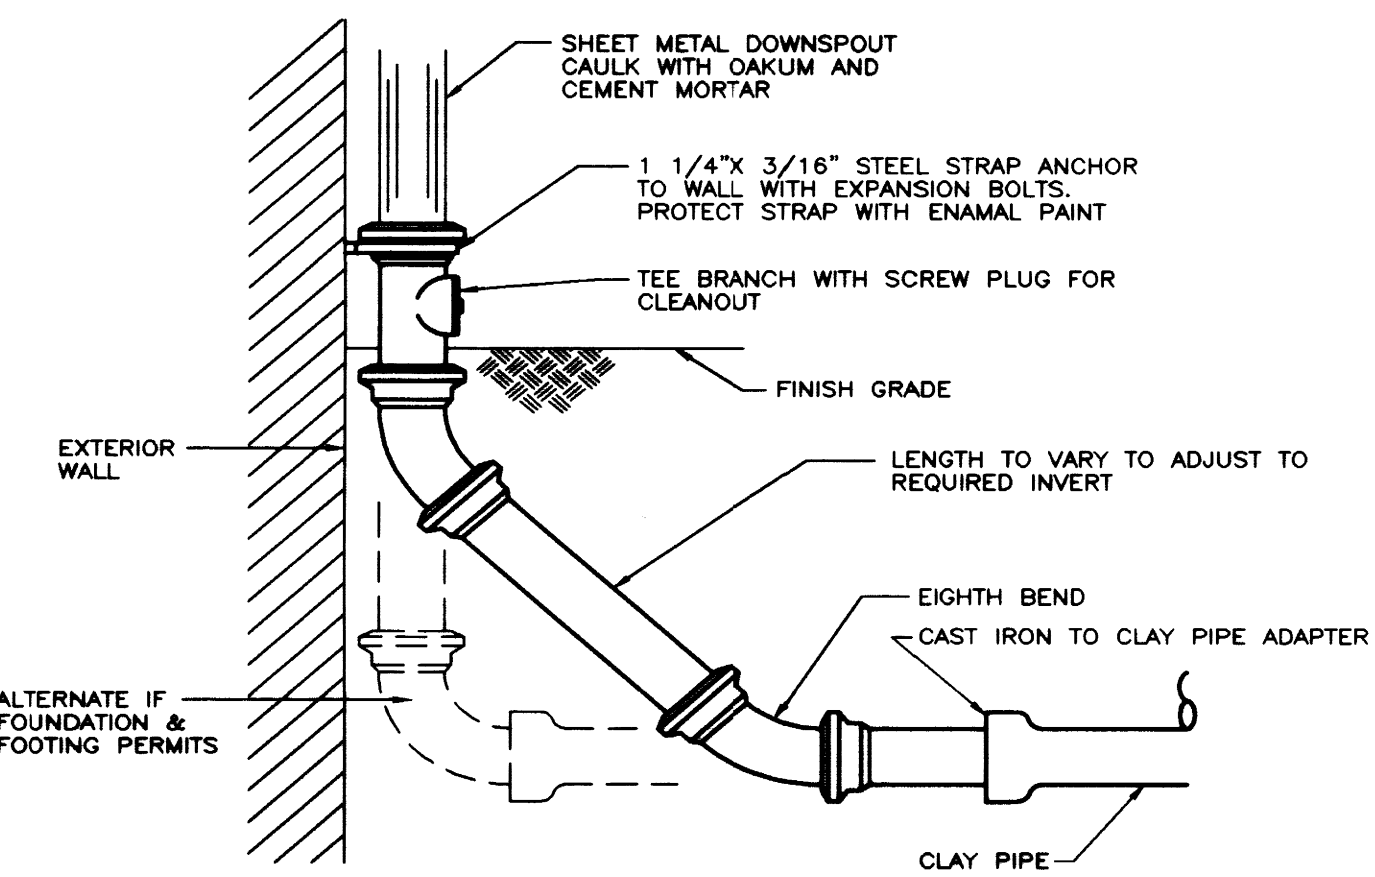


DOWNSPOUT BOOT DETAIL
NO SCALE


RECORD DRAWINGS DATE 9-8-95


These record drawings have been prepared, in part, on the basis of information compiled and furnished by others. The Engineer will not be responsible for any errors or omissions which have not been incorporated into this document as a result.

STAGGS & FISHER CONSULTING ENGINEERS, INC.

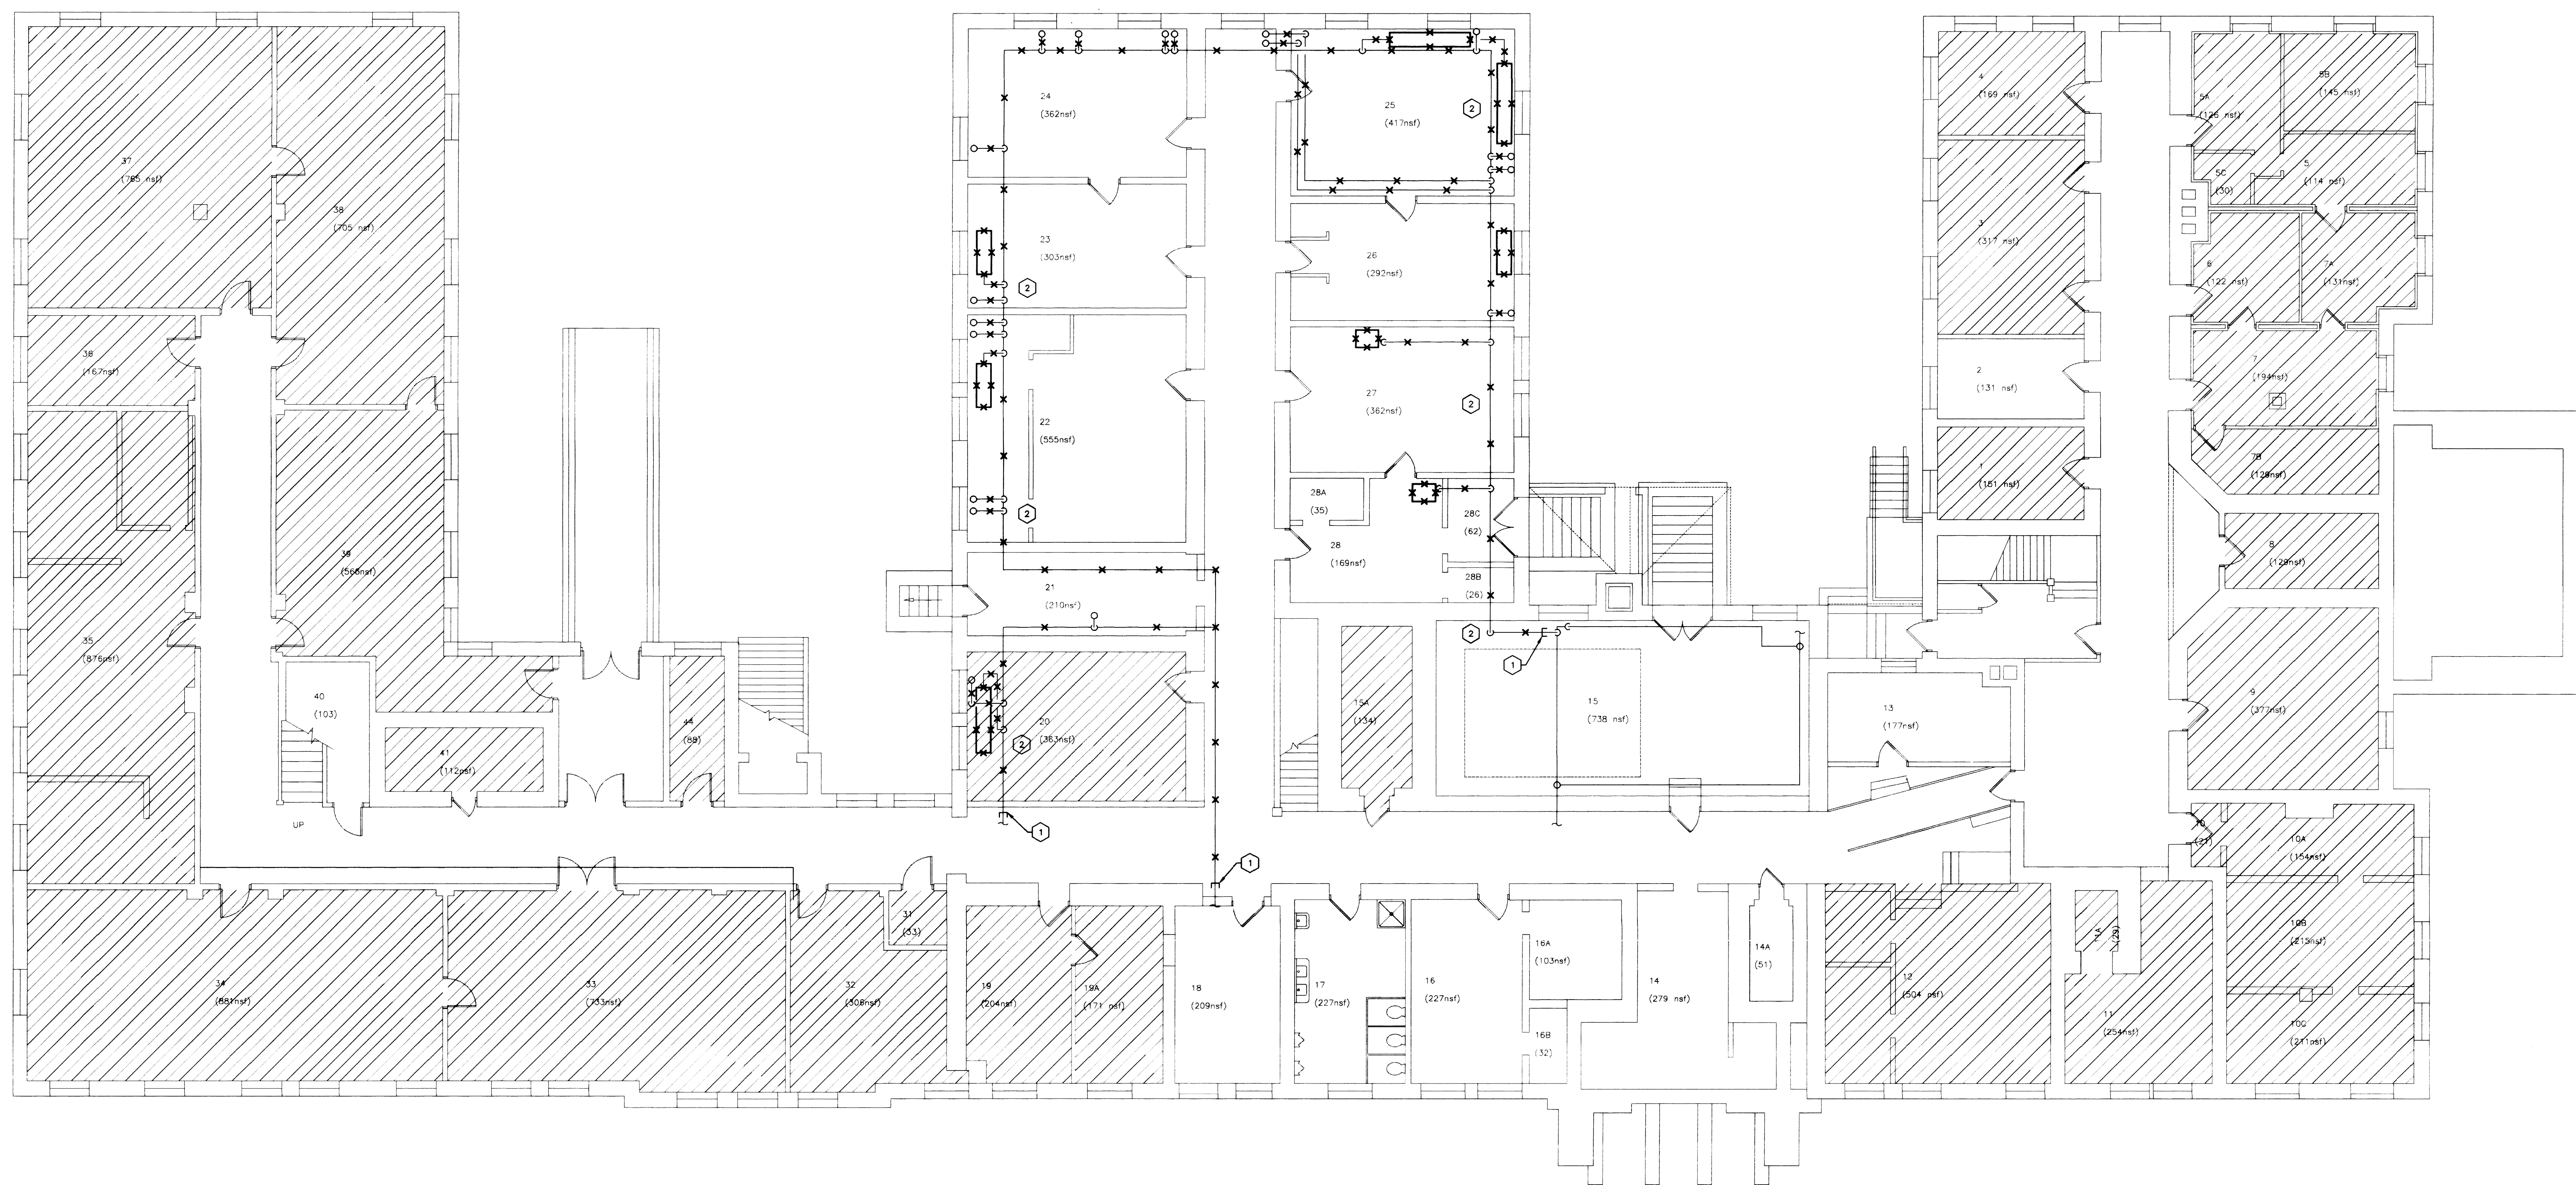

DEMOLITION H.V.A.C. PLAN — BASEMENT

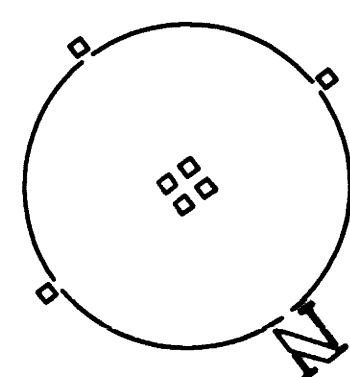


-  CODED NOTES :
- 1 CAP EXISTING STEAM LINE.
- 2 REMOVE STEAM PIPING AND EQUIPMENT SHOWN.


RECORD DRAWINGS DATE 9-8-95

These record drawings have been prepared, in part, on the basis of information compiled and furnished by others. The Engineer will not be responsible for any errors or omissions which have been incorporated into this document as a result

STAGGS & FISHER CONSULTING ENGINEERS, INC.

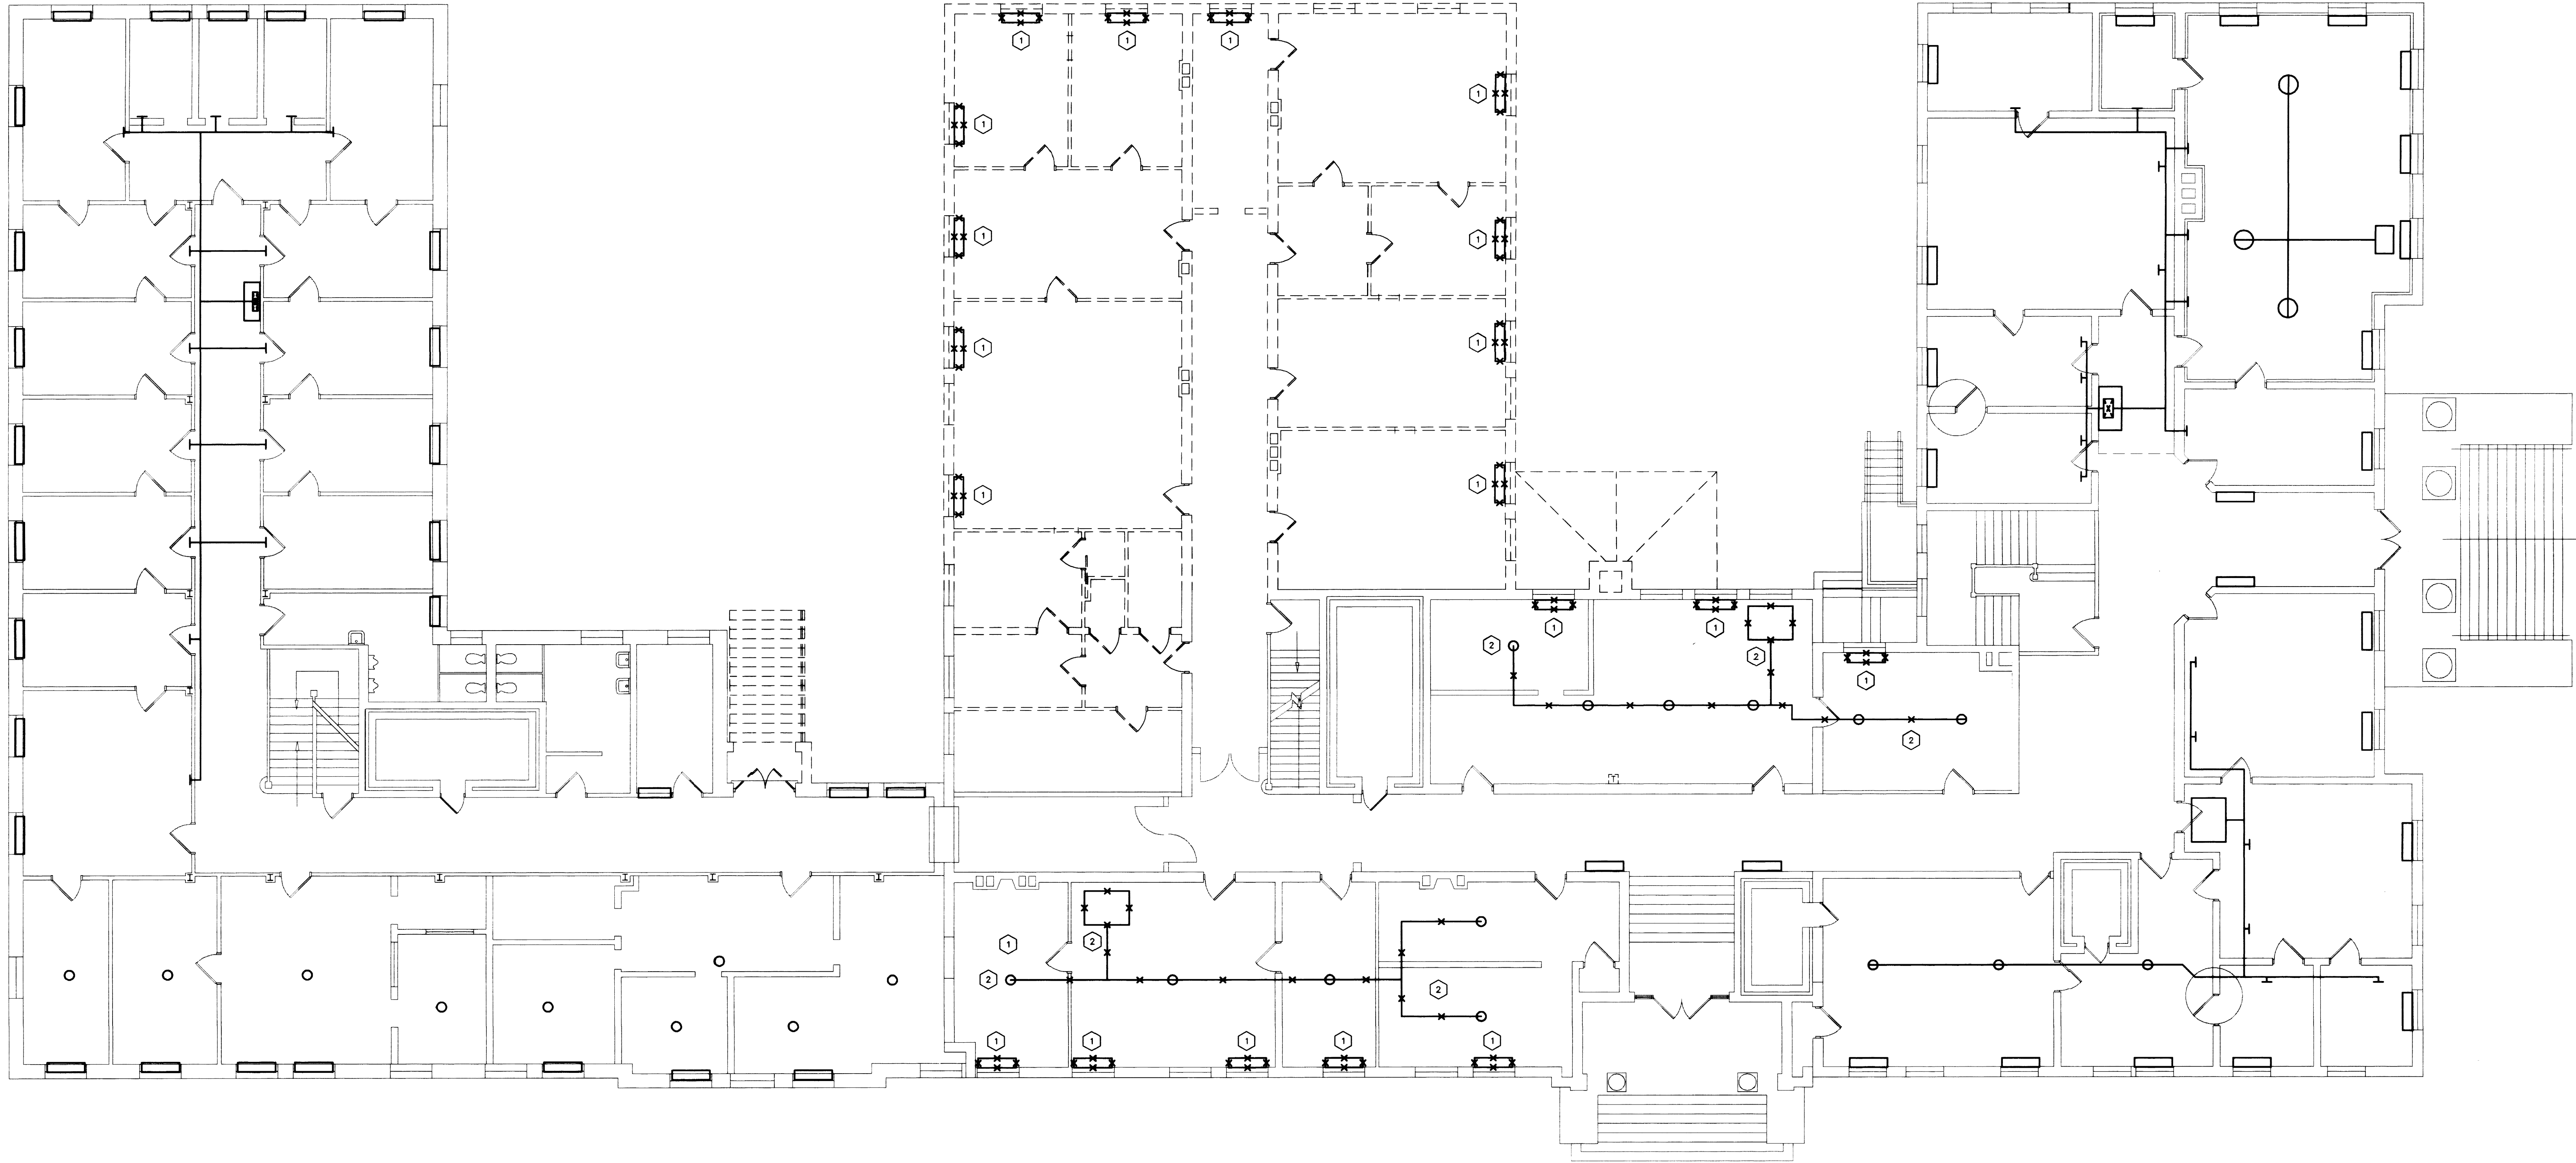


DEMOLITION H.V.A.C. PLAN - FIRST FLOOR
SCALE: 1/8" = 1'-0"

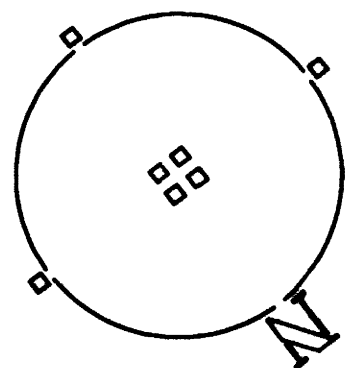


- CODED NOTES:
- 1 REMOVE STEAM HEATING EQUIPMENT AND RELATED PIPING IN THIS AREA. CAP LINES AT MAIN.
 - 2 REMOVE EXISTING AIR CONDUCTOR EQUIPMENT, DUCT, RELATED PIPING AND CONTROL WIRING. REMOVE RELATED CONDENSING UNIT.

RECORD DRAWINGS DATE 9-8-98
These record drawings have been prepared, in part, on the basis of information compiled and furnished by others. The Engineer will not be responsible for any errors or omissions which have been incorporated into this document as a result. STAGGS & FISHER CONSULTING ENGINEERS, INC.

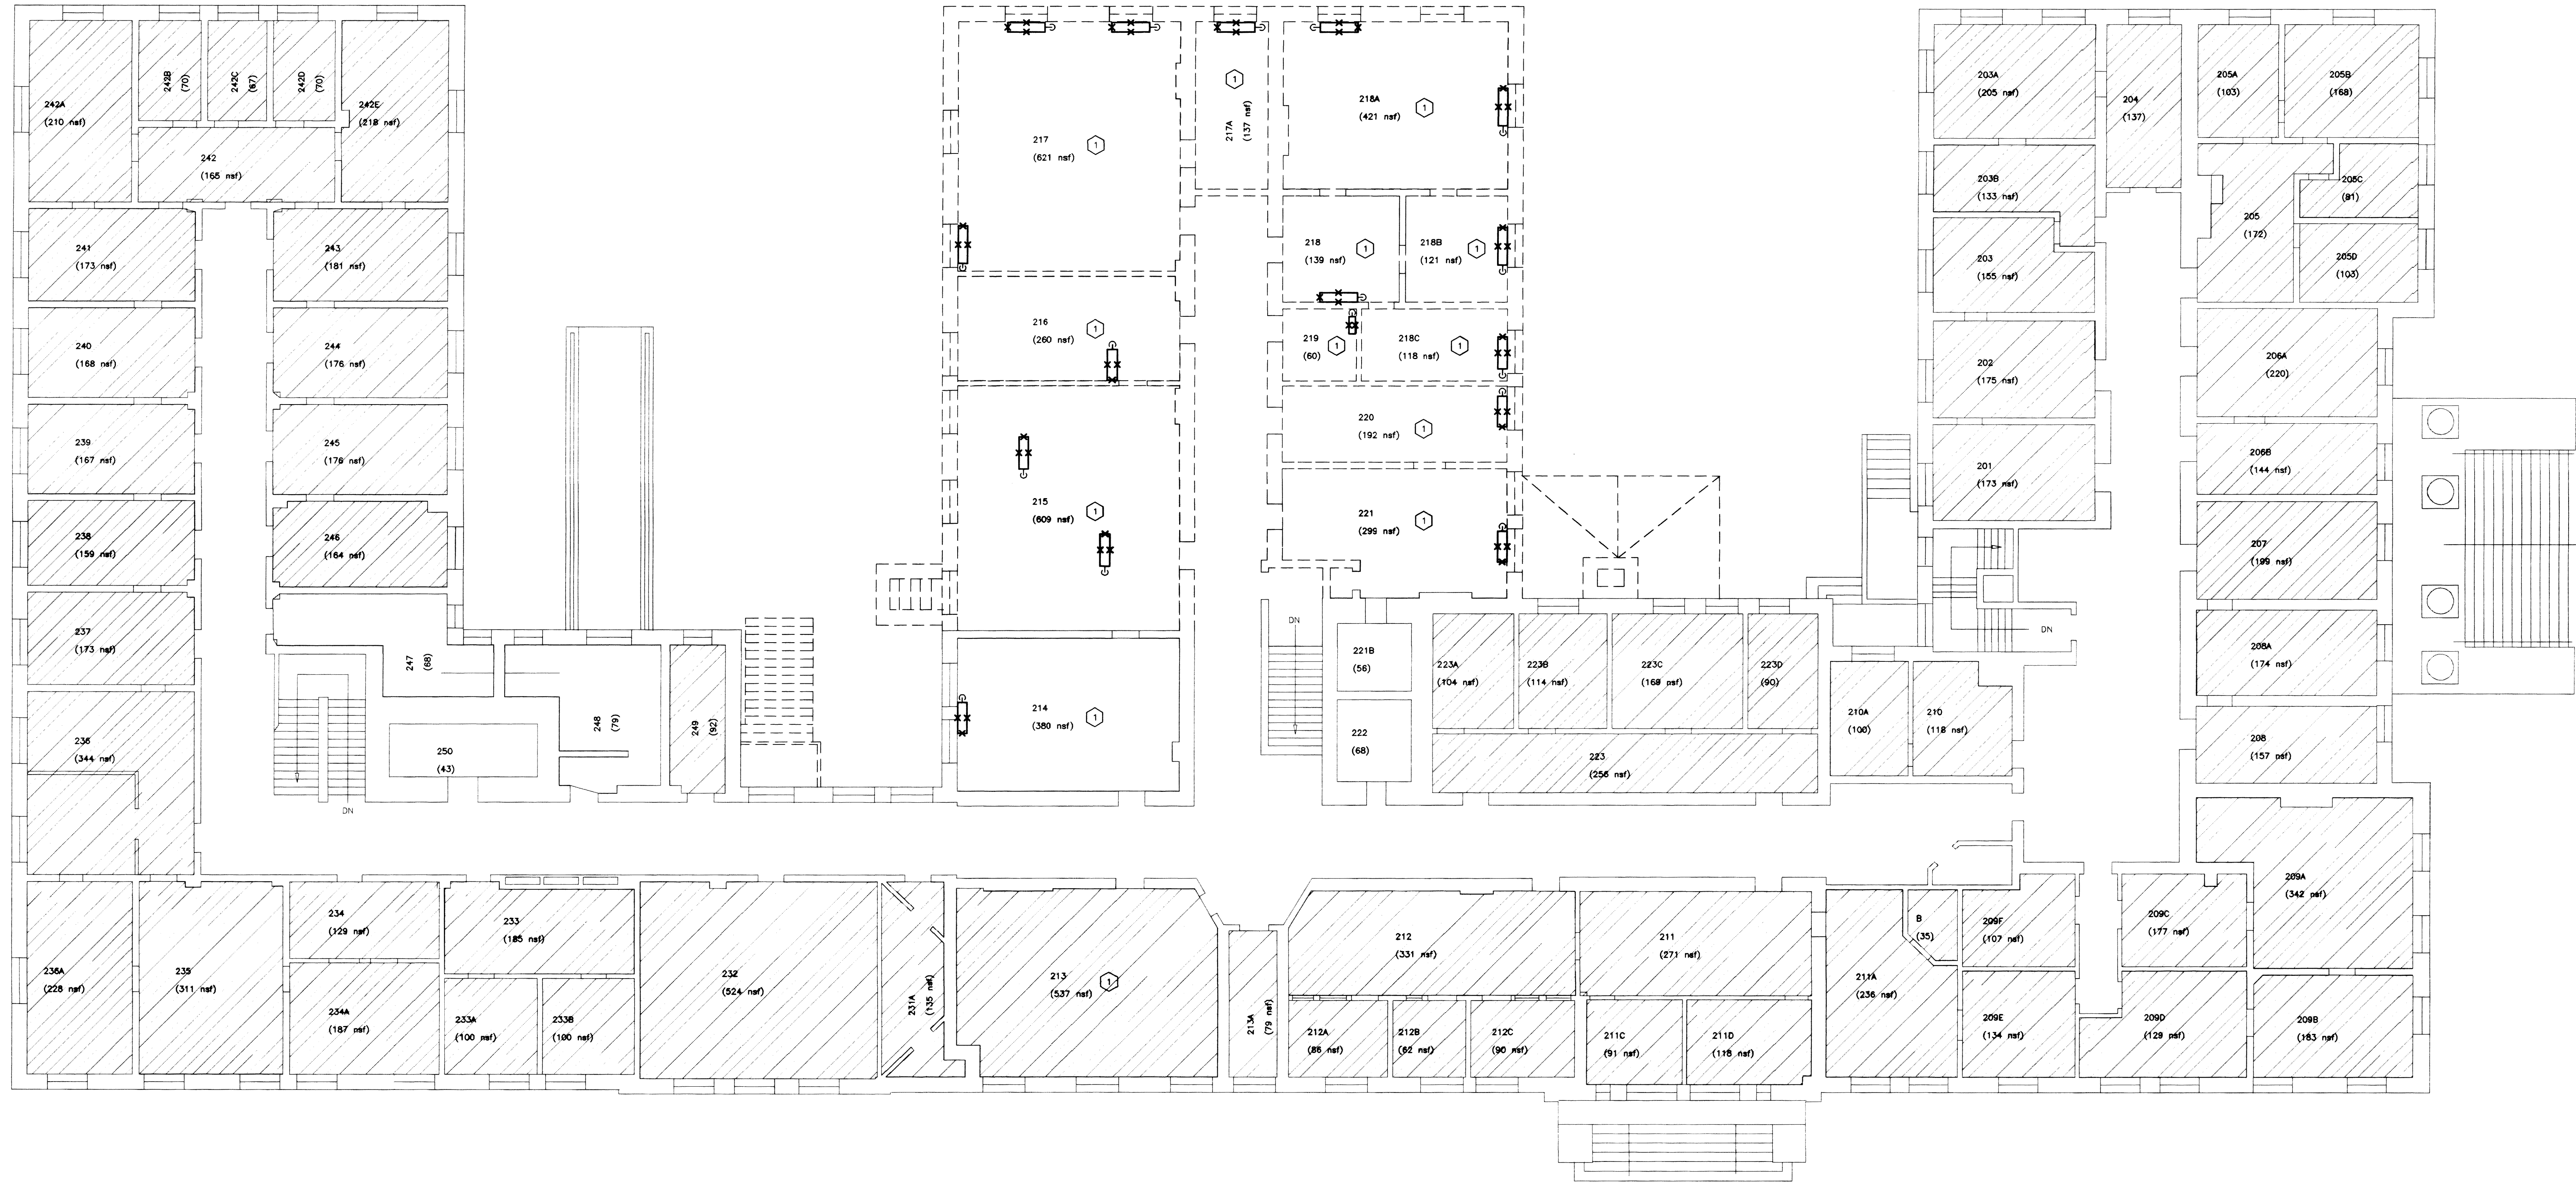

DEMOLITION H.V.A.C. PLAN - SECOND FLOOR

SCALE: 1/8" = 1'-0"

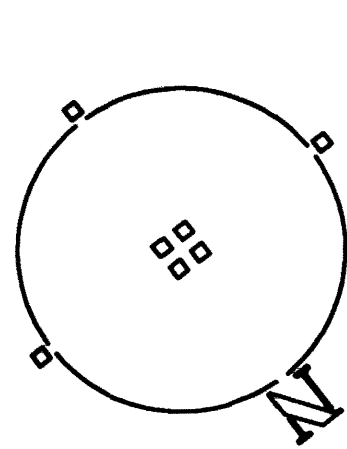


- CODED NOTES:
- 1 REMOVE STEAM HEATING AND RELATED PIPING IN THIS AREA. CAP LINES AT MAIN.

RECORD DRAWINGS DATE: 9-8-96


These record drawings have been prepared, in part, on the basis of information compiled and furnished by others. The Engineer will not be responsible for any errors or omissions which have been incorporated into this document as a result.

STAGGS & FISHER CONSULTING ENGINEERS, INC.

DRAWING: S:\DWG\SCOVELL\MECH\1-54.DWG SCALE: 48, 1/8"=1'-0" DATE: 02/05/93 BY: 15302

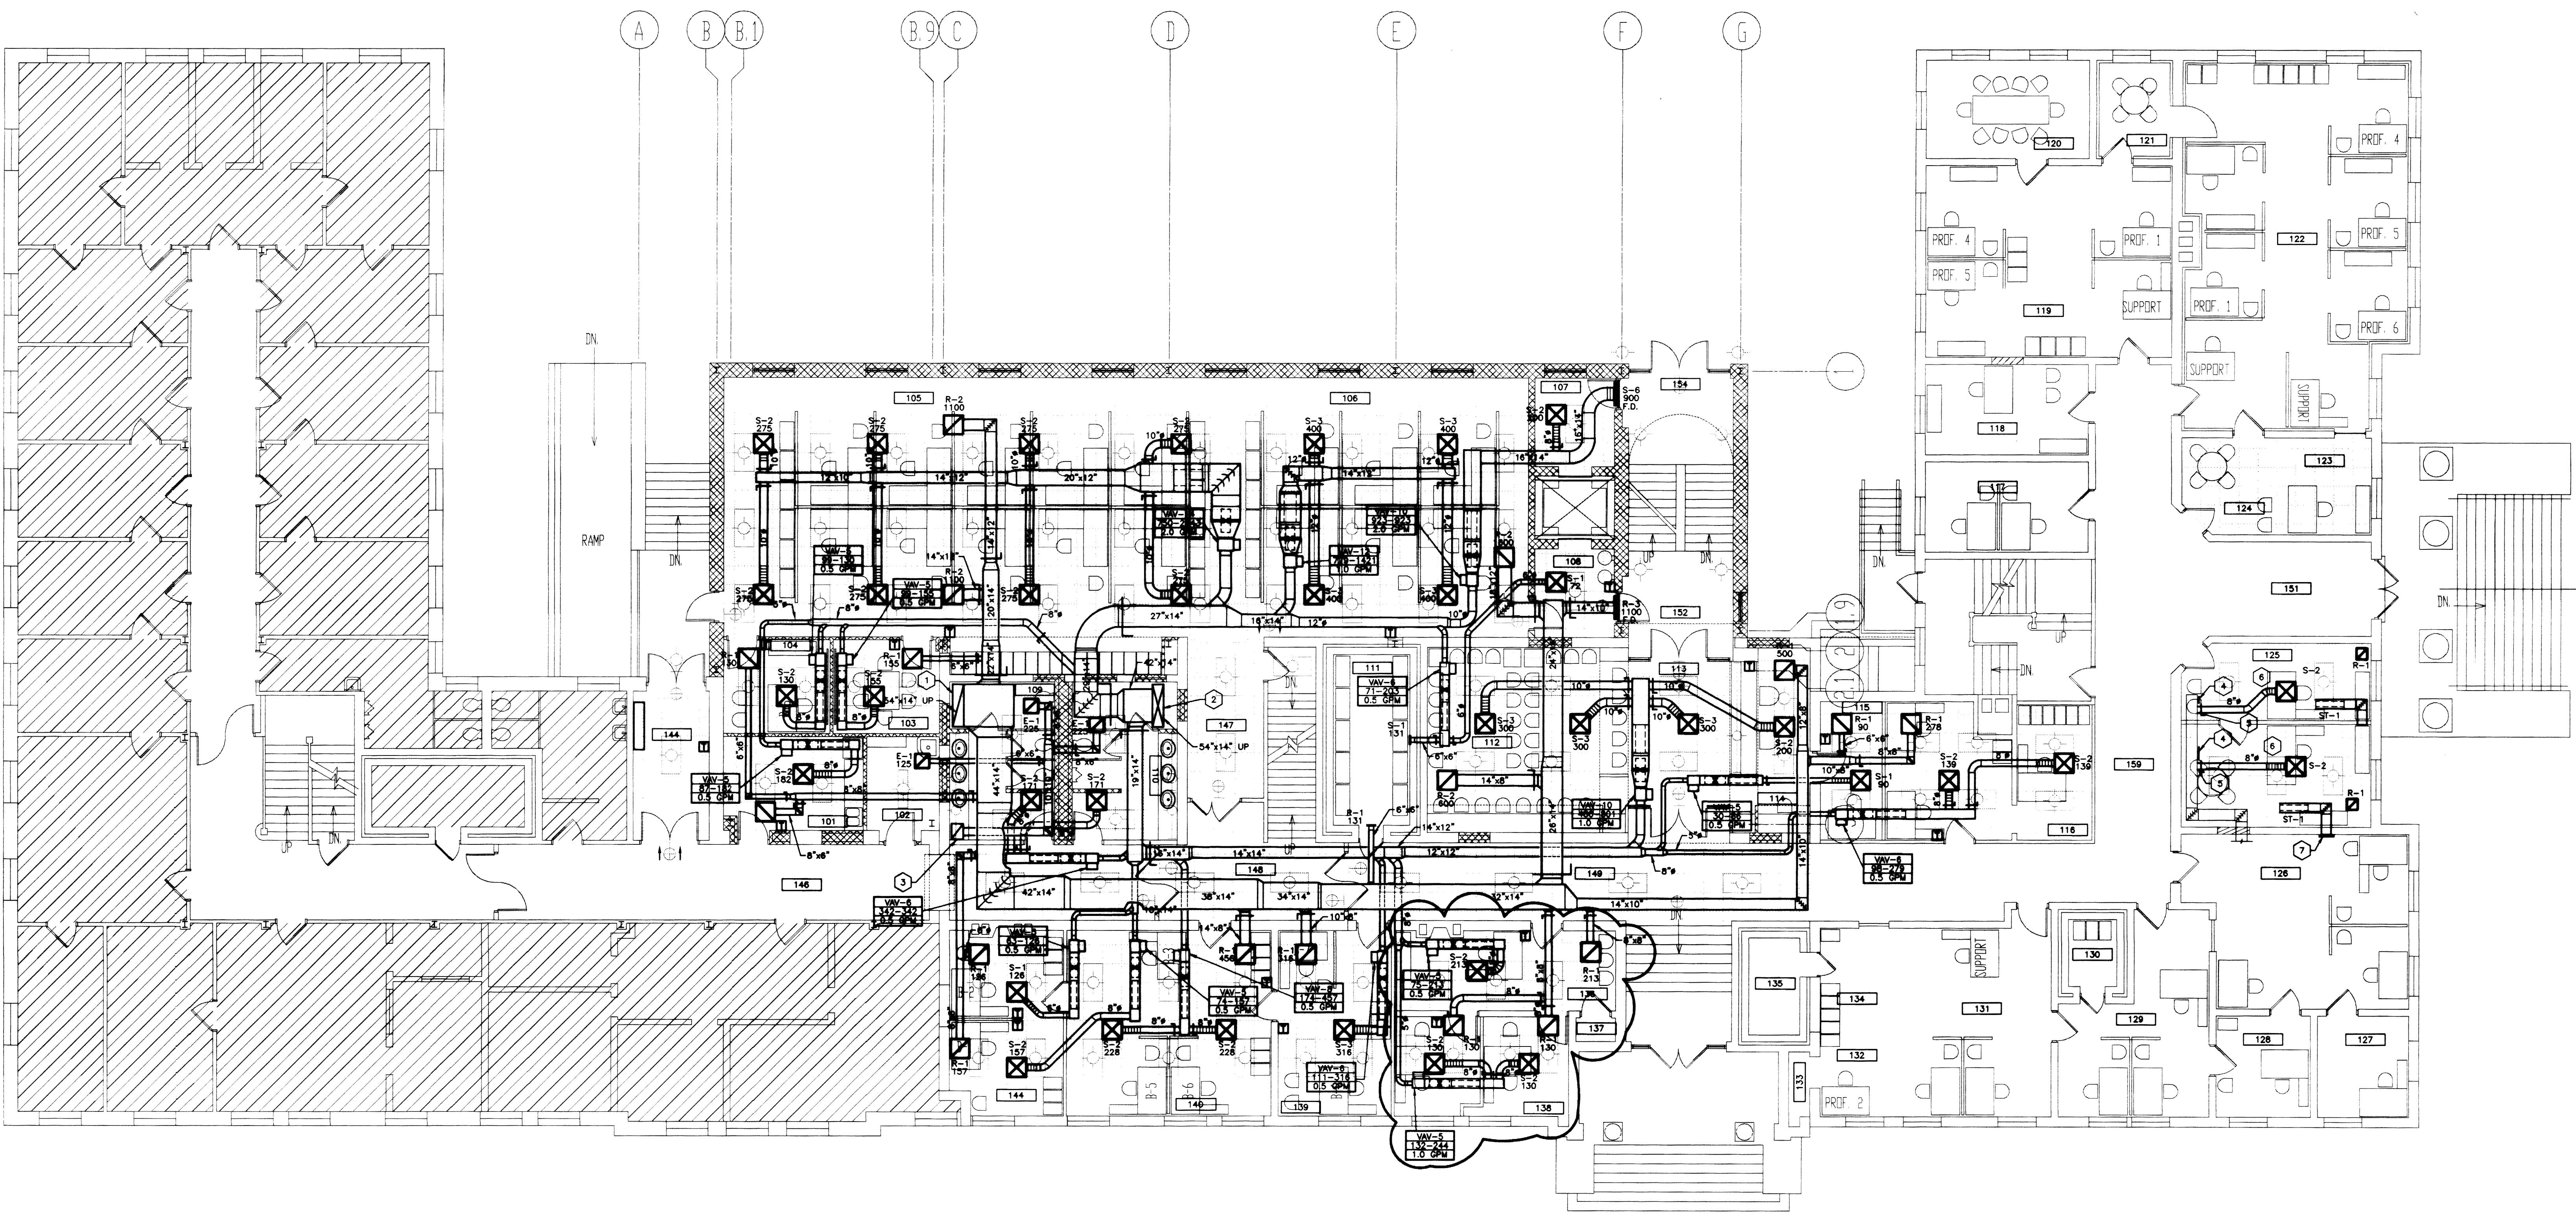

H.V.A.C. PLAN - FIRST FLOOR
SCALE: 1/8" = 1'-0"

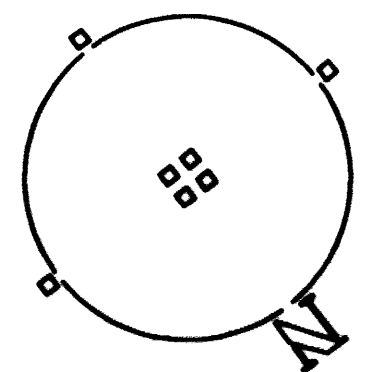


- CODED NOTES:
1. MAIN RETURN AIR DUCT RUN UP & DOWN.
 2. MAIN PRIMARY SUPPLY AIR DUCT RUN UP & DOWN.
 3. EXHAUST AIR DUCT RUN UP & DOWN.
 4. REMOVE AND BLANK OFF EXISTING REGISTERS IN EXISTING DUCT.
 5. CONNECT NEW DUCT TO EXISTING DUCT.
 6. MEASURE SUPPLY AIR FLOW BEFORE DOING ANY WORK AND BALANCE.
 7. NEW 12"x6" RETURN REGISTER (SAME MODEL AS R-1).

RECORD DRAWINGS DATE 9-8-93
These record drawings have been prepared, in part, on the basis of information compiled and furnished by others. The Engineer will not be responsible for any errors or omissions which have been incorporated into this document as a result.
STAGGS & FISHER CONSULTING ENGINEERS, INC.

ROOM NO.	ROOM NAME
101	BREAKROOM
102	JANITOR
103	BENEFITS CONFERENCE
104	TRAINING CONFERENCE
105	TRAINING CONFERENCE
106	BENEFITS
107	ELEV. LOBBY LEVEL "G"
108	ELEV. LOBBY LEVEL 1
109	WOMEN
110	MEN
111	RECORDS
112	WAITING
113	WAITING ENTRY
114	RECEPTION
115	TESTING
116	WAGE/SALARY
117	S.T.E.P.S.
118	S.T.E.P.S.
119	HRS TEAM #2
120	HRS TEAM #2
121	CONF. #2
122	HRS TEAM #2
123	CONF. #1
124	S.T.E.P.S. STAFF
125	HRS TEAM #3
126	HRS TEAM #3
127	CONF. #3
128	CONF. #4

SCOVELL HALL RENOVATION


H.V.A.C. PLAN - FIRST FLOOR

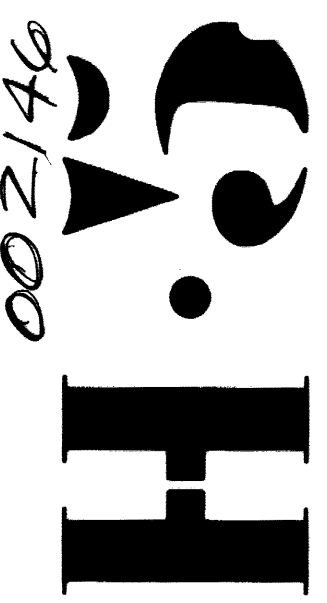


University of Kentucky
Design and Construction
Division
Architects - Engineers
111 Madison Square Building
Lexington, Kentucky

OFFICIAL RECORD DOCUMENT
University of Kentucky
Lexington, Kentucky



Omni
Architects

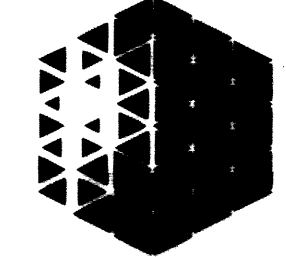

Architecture
Interior
Civil Engineering
Planning
212 North University Street
Lexington, Kentucky 40507
(606) 252-6664

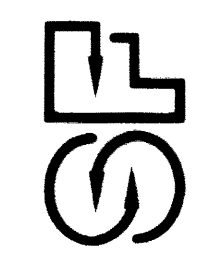

Stagg and Fisher
Consulting Engineers, Inc.
Lexington, Kentucky 40502

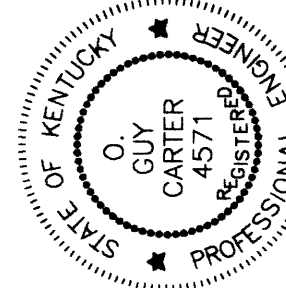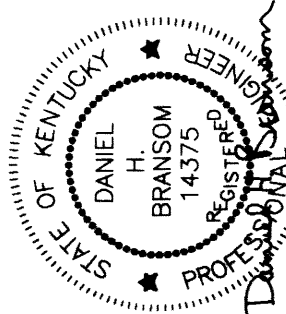

UNIVERSITY OF KENTUCKY

This Drawing and Design were prepared, in part, on the basis of information compiled and furnished by others. The Engineer will not be responsible for any errors or omissions which have been incorporated into this document as a result.

UNIVERSITY OF KENTUCKY

Date: APRIL, 1994

Job No:

Checked: DHB

Revisions:


**University of Kentucky
Design and Construction
Division**
Architects • • • • • Engineers
Harrison Service Building
Lexington, Kentucky

[illegible]

Omni
Architects

**Staggs and Fisher
Consulting Engineers, Inc.**
317 South Ashland Avenue
Lexington, Kentucky 40502

A circular professional engineer seal for the State of Kentucky. The outer ring contains the text "STATE OF KENTUCKY" at the top and "PROFESSIONAL ENGINEER" at the bottom, separated by two stars. The inner circle contains the name "DANIEL H. BRANSOM" and the registration number "14375". To the right of the seal, the name "Daniel H. Bransom" is handwritten in cursive.

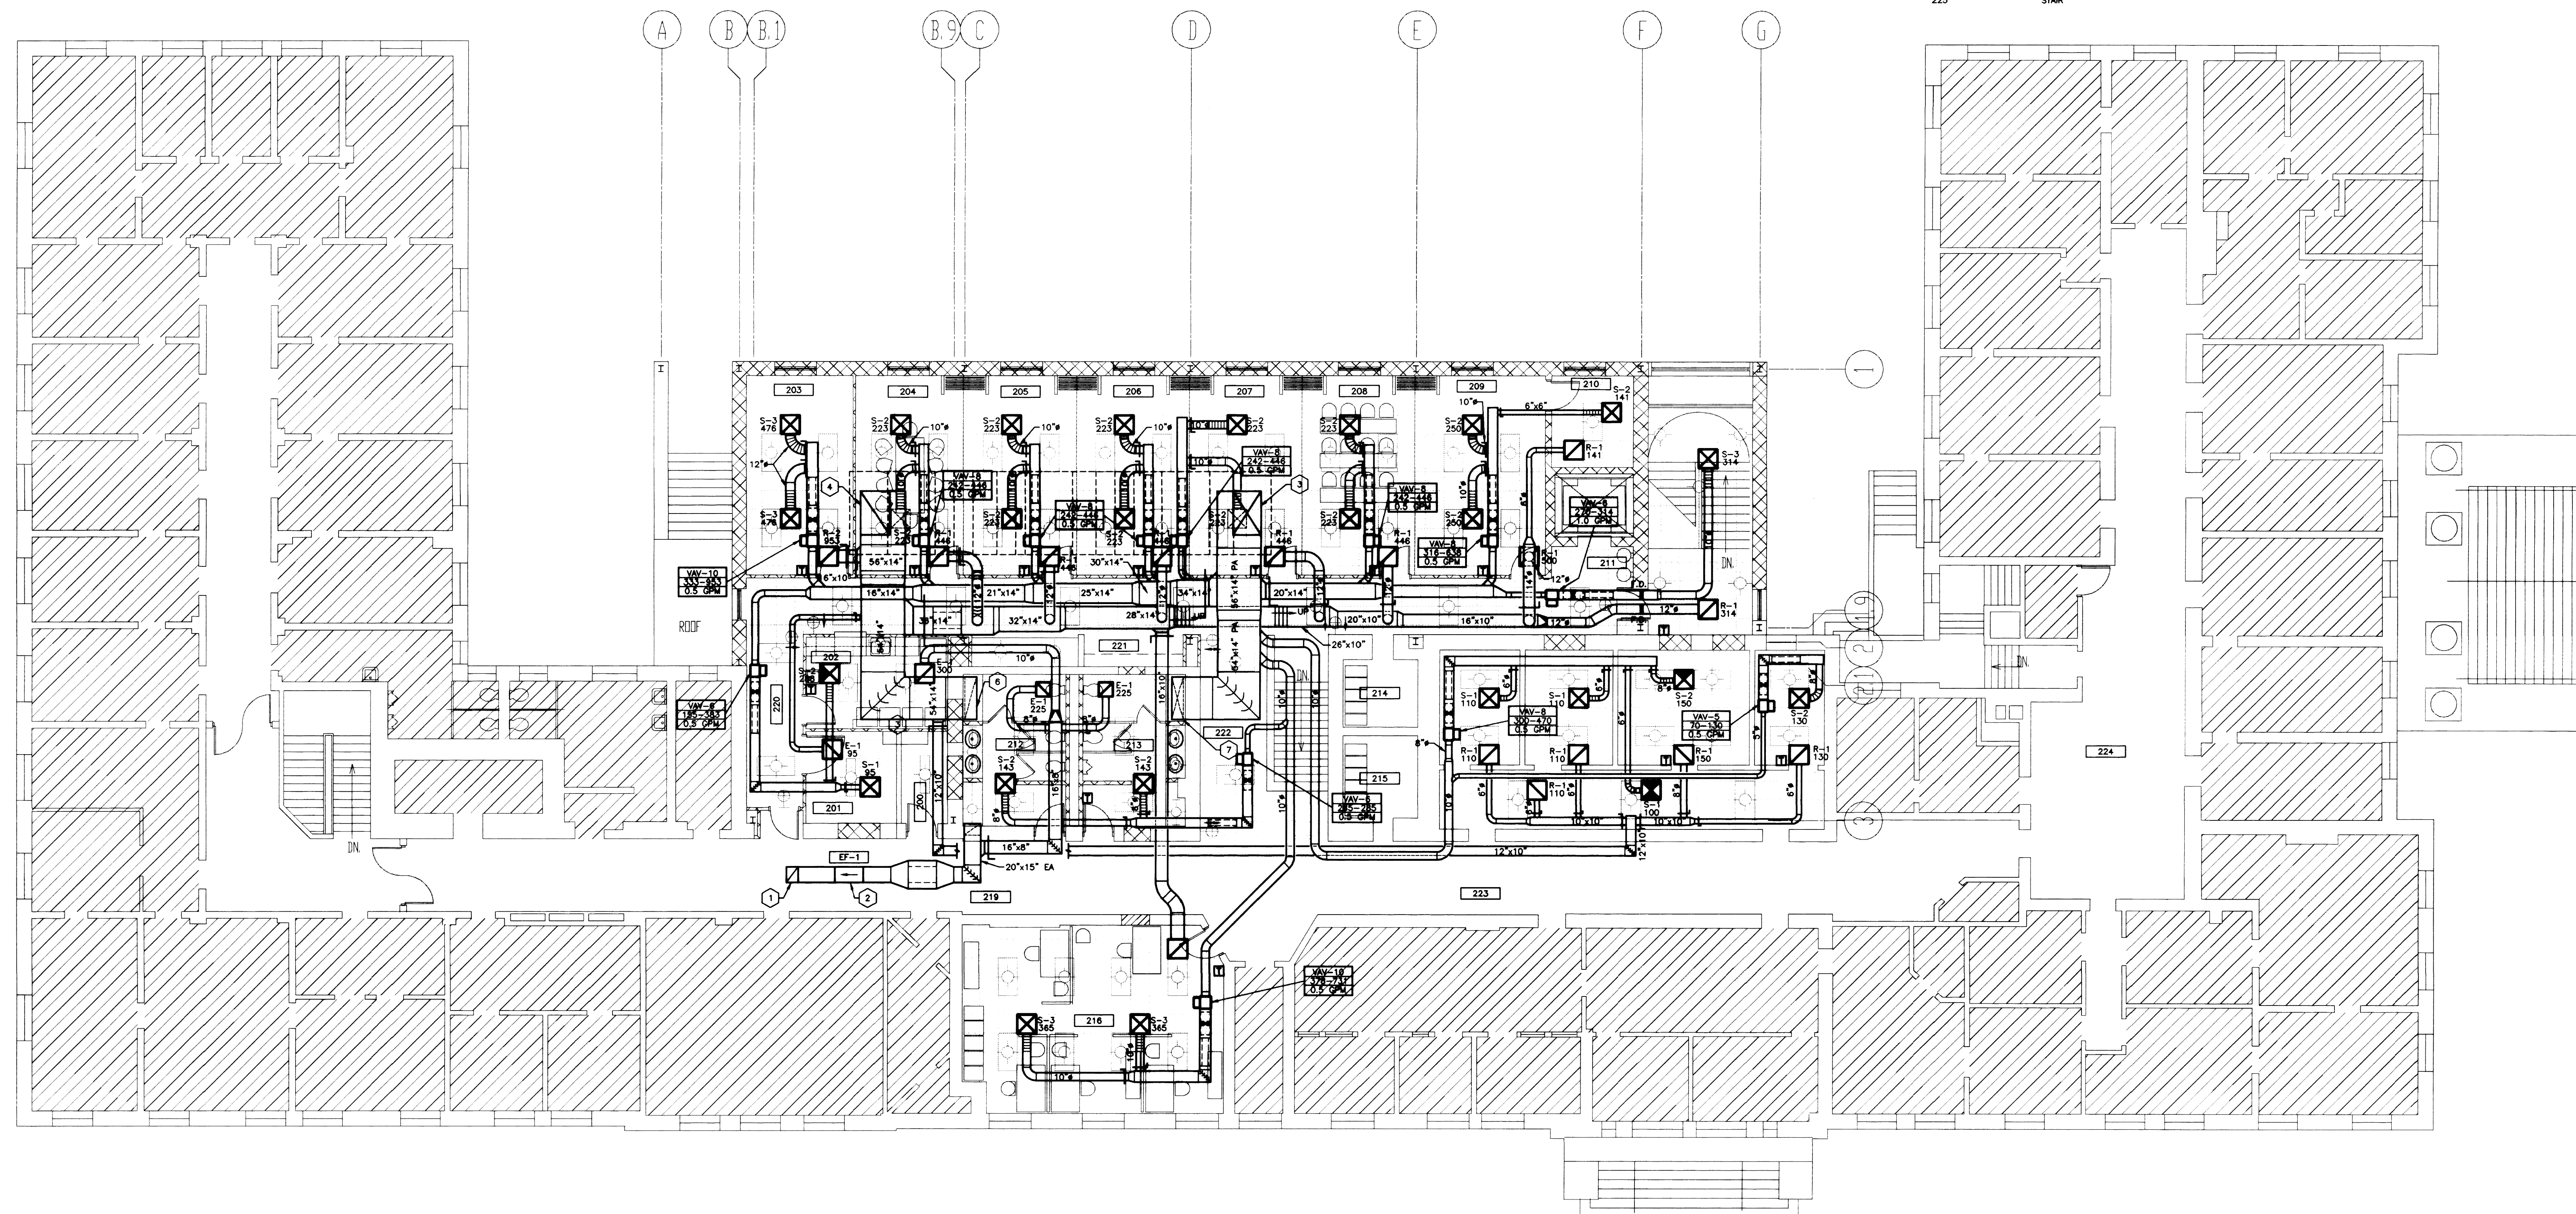

SCALE : 1/8" = 1'-0"


 CODED NOTES :

- 1 EXHAUST DUCT UP TO EXHAUST CAP & CURB ON ROOF.
- 2 GENERAL EXHAUST FAN ABOVE CEILING.
- 3 MAIN PRIMARY SUPPLY AIR DUCT UP TO UNIT ON ROOF.
- 4 MAIN RETURN AIR DUCT UP TO UNIT ON ROOF.
- 5 AIR HANDLER UNIT ON ROOF. SEE DETAIL ON SHEET H-12.
- 6 MAIN RETURN AIR DUCT DOWN. (SEE H-5 FOR CONTINUATION).
- 7 MAIN PRIMARY SUPPLY AIR DUCT DOWN. (SEE H-5 FOR CONTINUATION).

RECORD DRAWINGS DATE 9-8-95


These record drawings have been prepared, in part, on the basis of information compiled and furnished by others. The Engineer will not be responsible for any errors or omissions which have been incorporated into this document as a result.

STAGGS & FISHER CONSULTING ENGINEERS, INC.

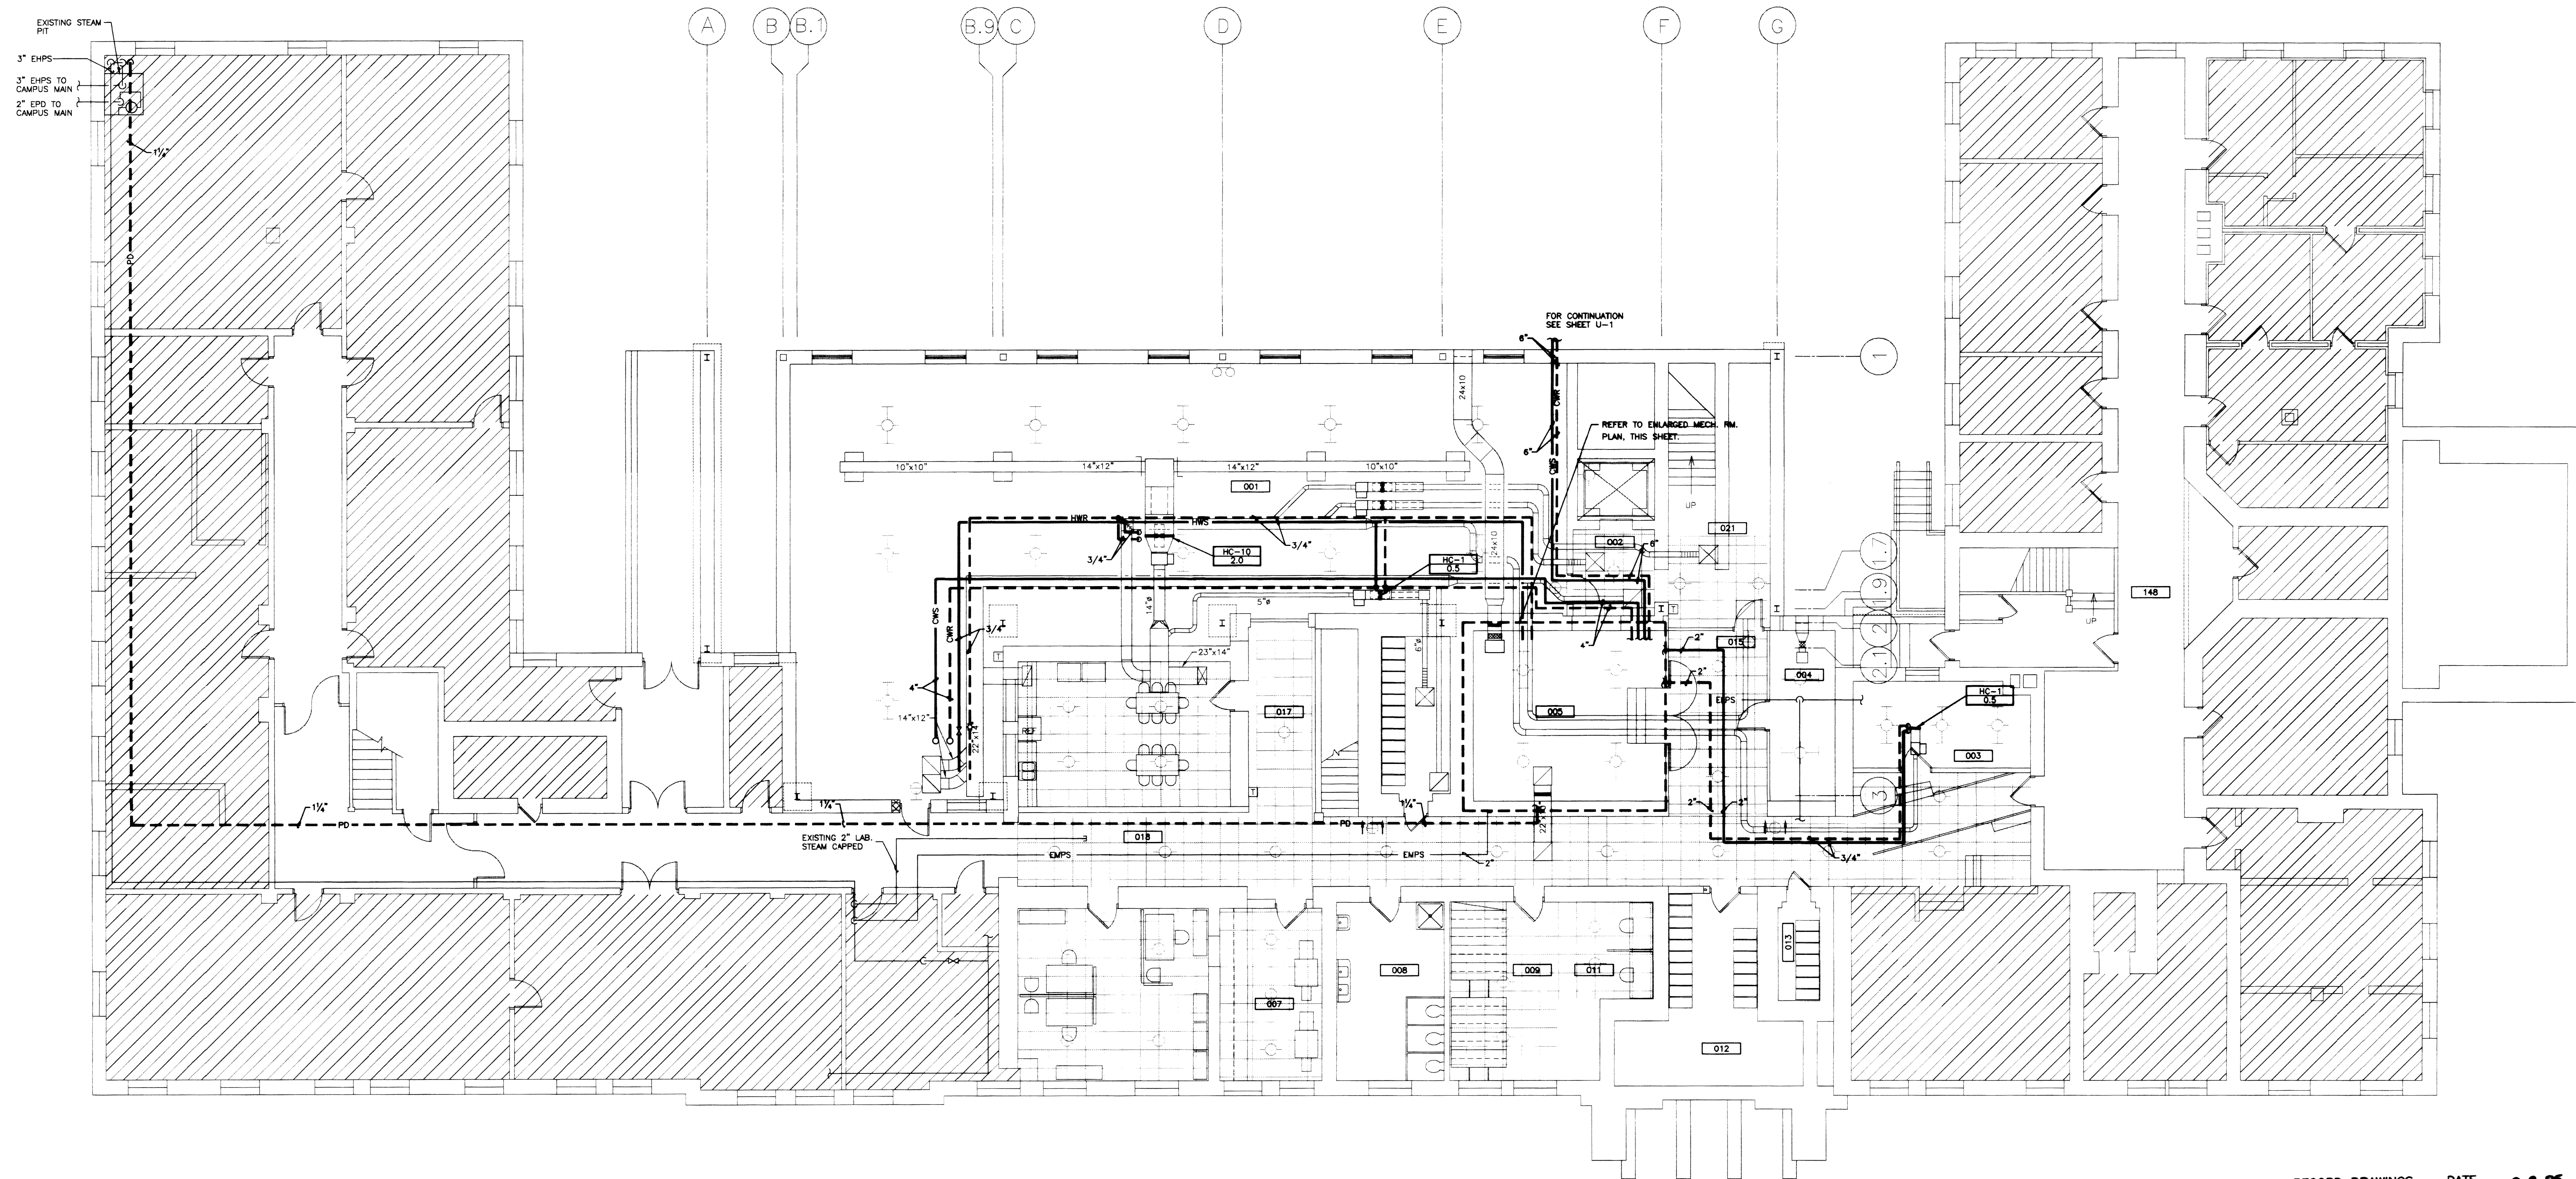


HYDRONIC PIPING - BASEMENT

SCALE: 1/8"=1'-0"

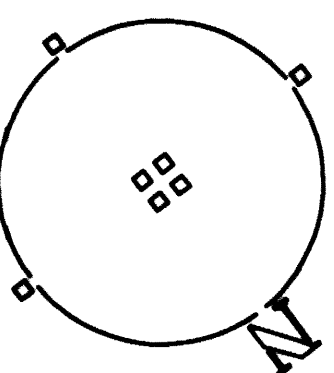

ROOM NO.	ROOM NAME
001	SHELL SPACE
002	ELEV. LOBBY LEVEL "B"
003	COMMUNICATIONS
004	ELEV. MECH.
005	MECHANICAL/ELECTRICAL ROOM
007	EMPLOYEE RECORDS
008	WOMEN'S RESTROOM
009	TRAINING STORAGE
010	BENEFITS STORAGE
011	COPY CENTER
012	RECORDS
013	CORRIDOR
014	CORRIDOR
015	CORRIDOR
016	CORRIDOR
017	CORRIDOR
018	CORRIDOR
019	CORRIDOR
020	CORRIDOR
021	STAIR
148	CORRIDOR

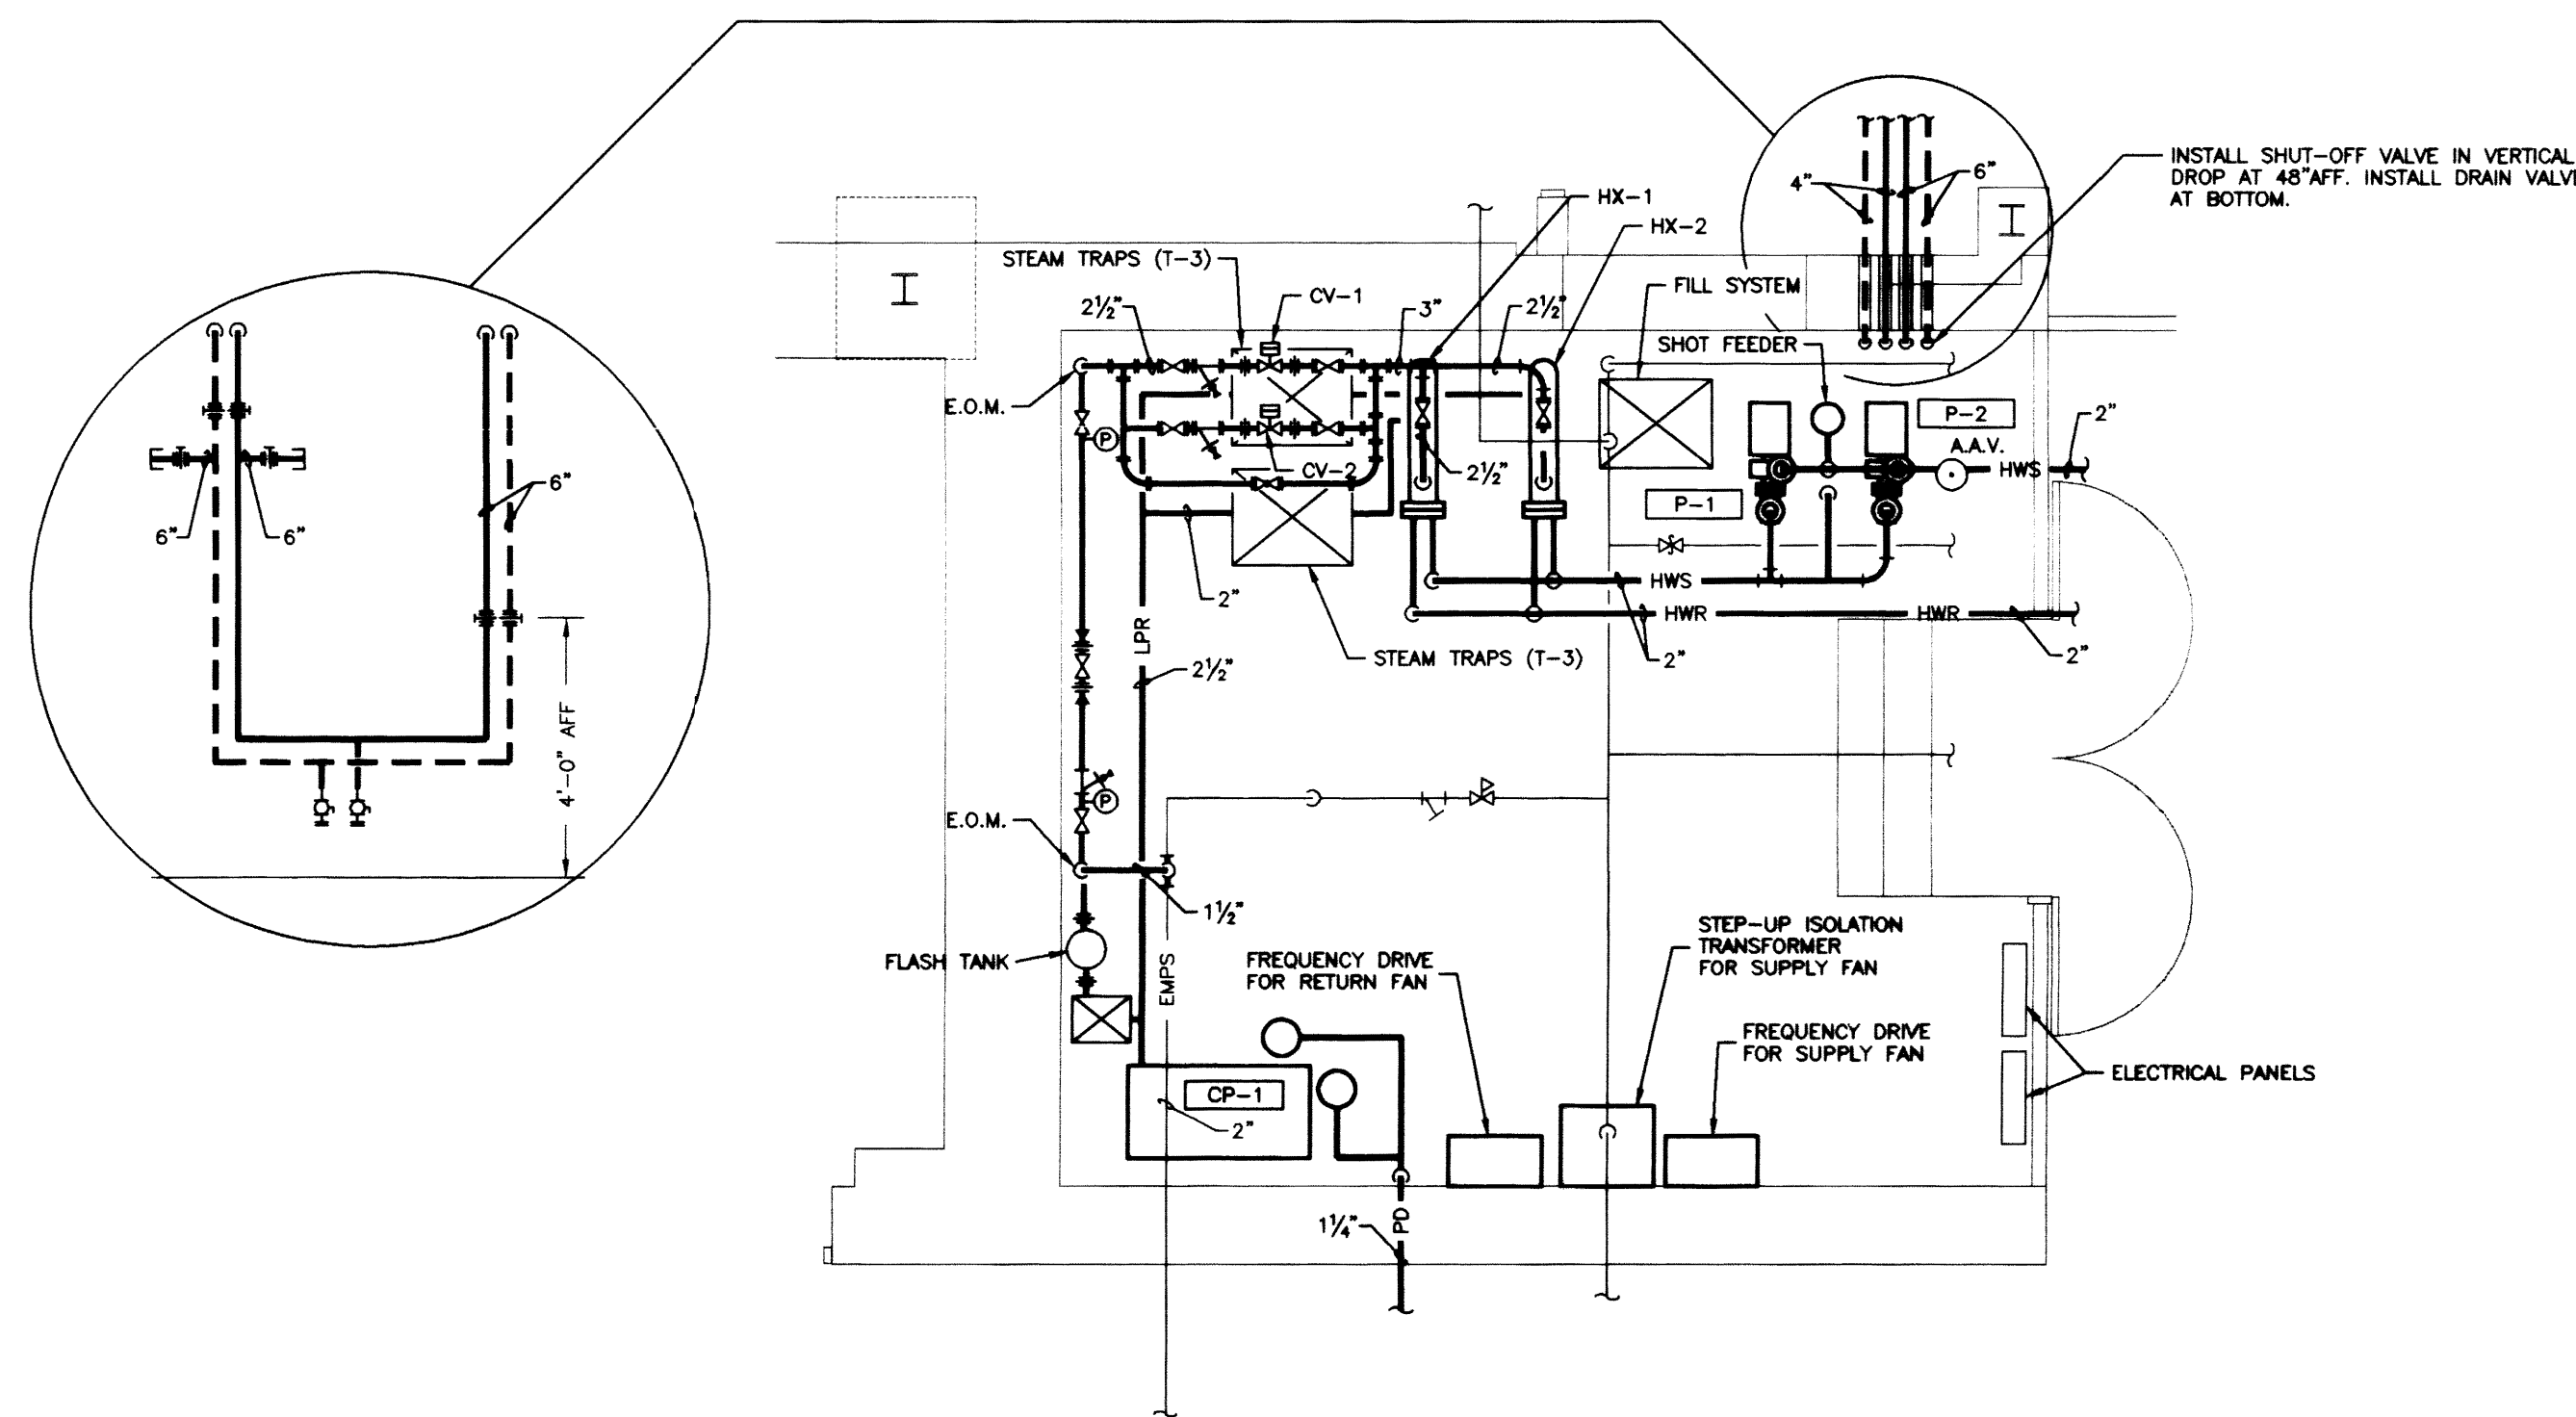

ENLARGED MECHANICAL ROOM - HYDRONIC PIPING








SCALE: 1/4"=1'-0"

RECORD DRAWINGS DATE 9-8-98
These record drawings have been prepared, in part, on the basis of information compiled and furnished by others. The Engineer will not be responsible for any errors or omissions which have been incorporated into this document as a result.
STAGGS & FISHER CONSULTING ENGINEERS, INC.

SCOVELL HALL RENOVATION

HYDRONIC PIPING - BASEMENT

000 2/148

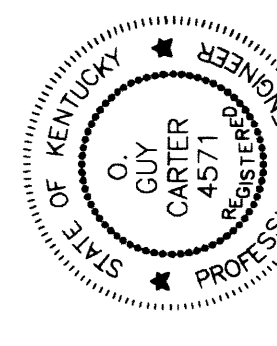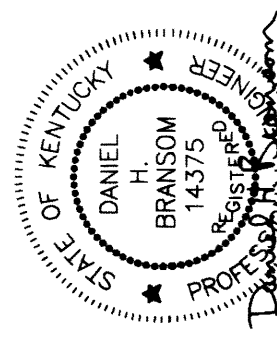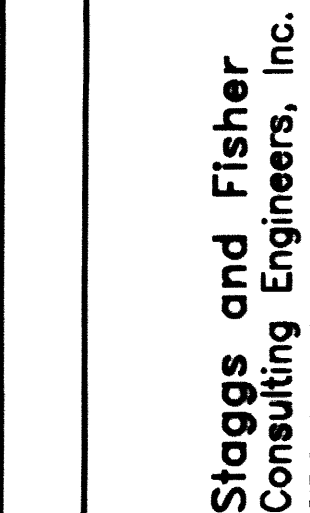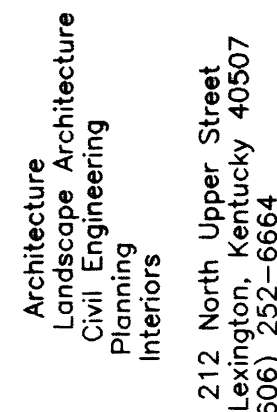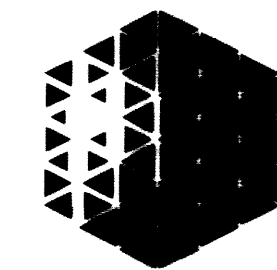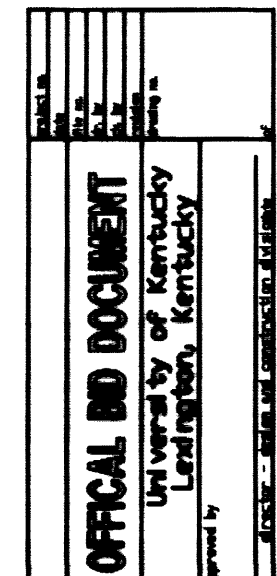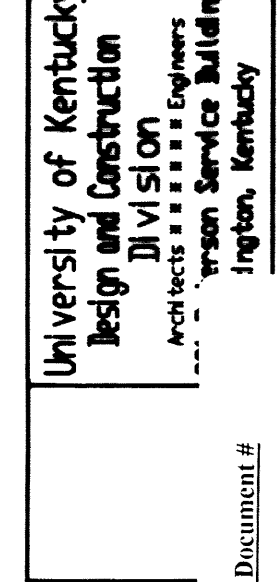

UNIVERSITY OF KENTUCKY


This Drawing and Design are the property of Staggs and Fisher Consulting Engineers, Inc. The reproduction of this drawing without the written consent of Staggs and Fisher Consulting Engineers, Inc. is prohibited.

Revisions:


Checked: DHB
Drawn By: AKL

Date: APRIL, 1994

Job No:

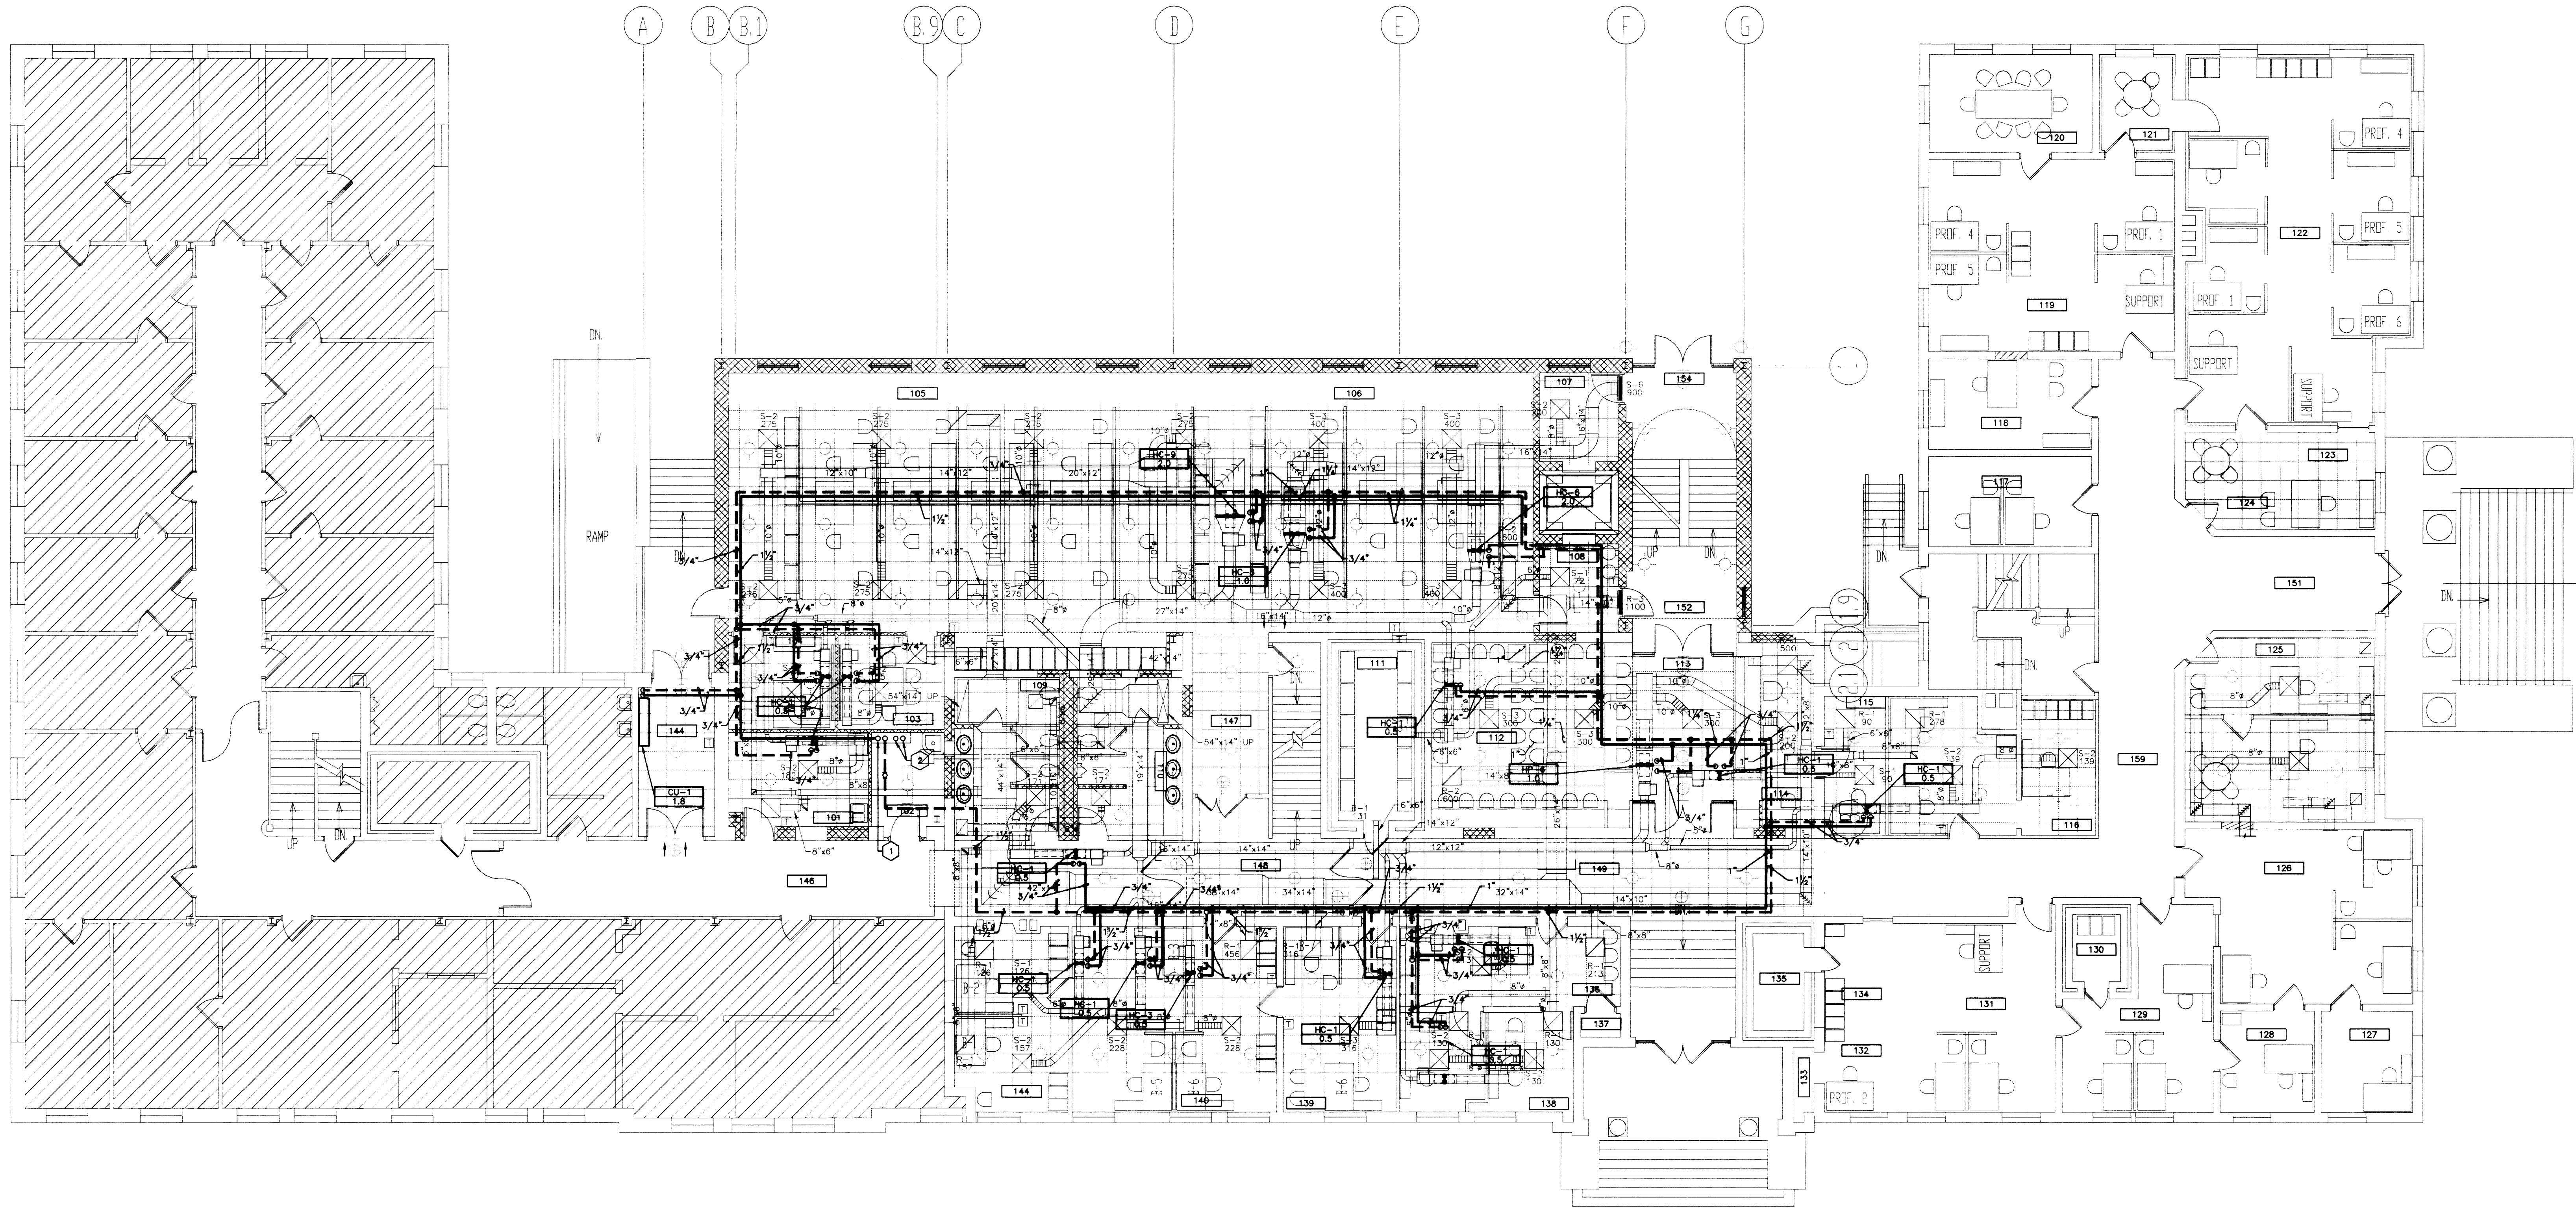


HYDRONIC PIPING - FIRST FLOOR
SCALE: 1/8"=1'-0"

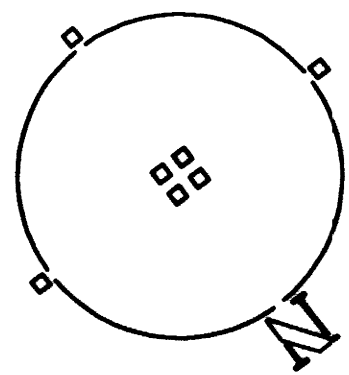

- CODED NOTES:
- 2" HWS & HWR PIPING DOWN TO BASEMENT, AND 1-1/2" HWS & HWR UP TO SECOND FLOOR.
 - 4" CWS & CWR PIPING RUN UP AND DOWN.


RECORD DRAWINGS DATE 9-8-94
These record drawings have been prepared, in part, on the basis of information compiled and furnished by others. The Engineer will not be responsible for any errors or omissions which have been incorporated into this document as a result.
STAGGS & FISHER CONSULTING ENGINEERS, INC.

ROOM NO.	ROOM NAME
101	BREAKROOM
102	JANITOR
103	BENEFITS CONFERENCE
104	TRAINING CONFERENCE
105	TRAINING CONFERENCE
106	BENEFITS
107	ELEV. LOBBY LEVEL "G"
108	ELEV. LOBBY LEVEL 1
109	WOMEN
110	MEN
111	RECORDS
112	WAITING
113	WAITING ENTRY
114	RECEPTION
115	TESTING
116	WAGE/SALARY
117	S.T.E.P.S.
118	S.T.E.P.S.
119	HRS TEAM #2
120	HRS TEAM #2
121	CONF. #2
122	HRS TEAM #2
123	CONF. #1
124	S.T.E.P.S. STAFF
125	HRS TEAM #3
126	HRS TEAM #3
127	CONF. #3
128	CONF. #4

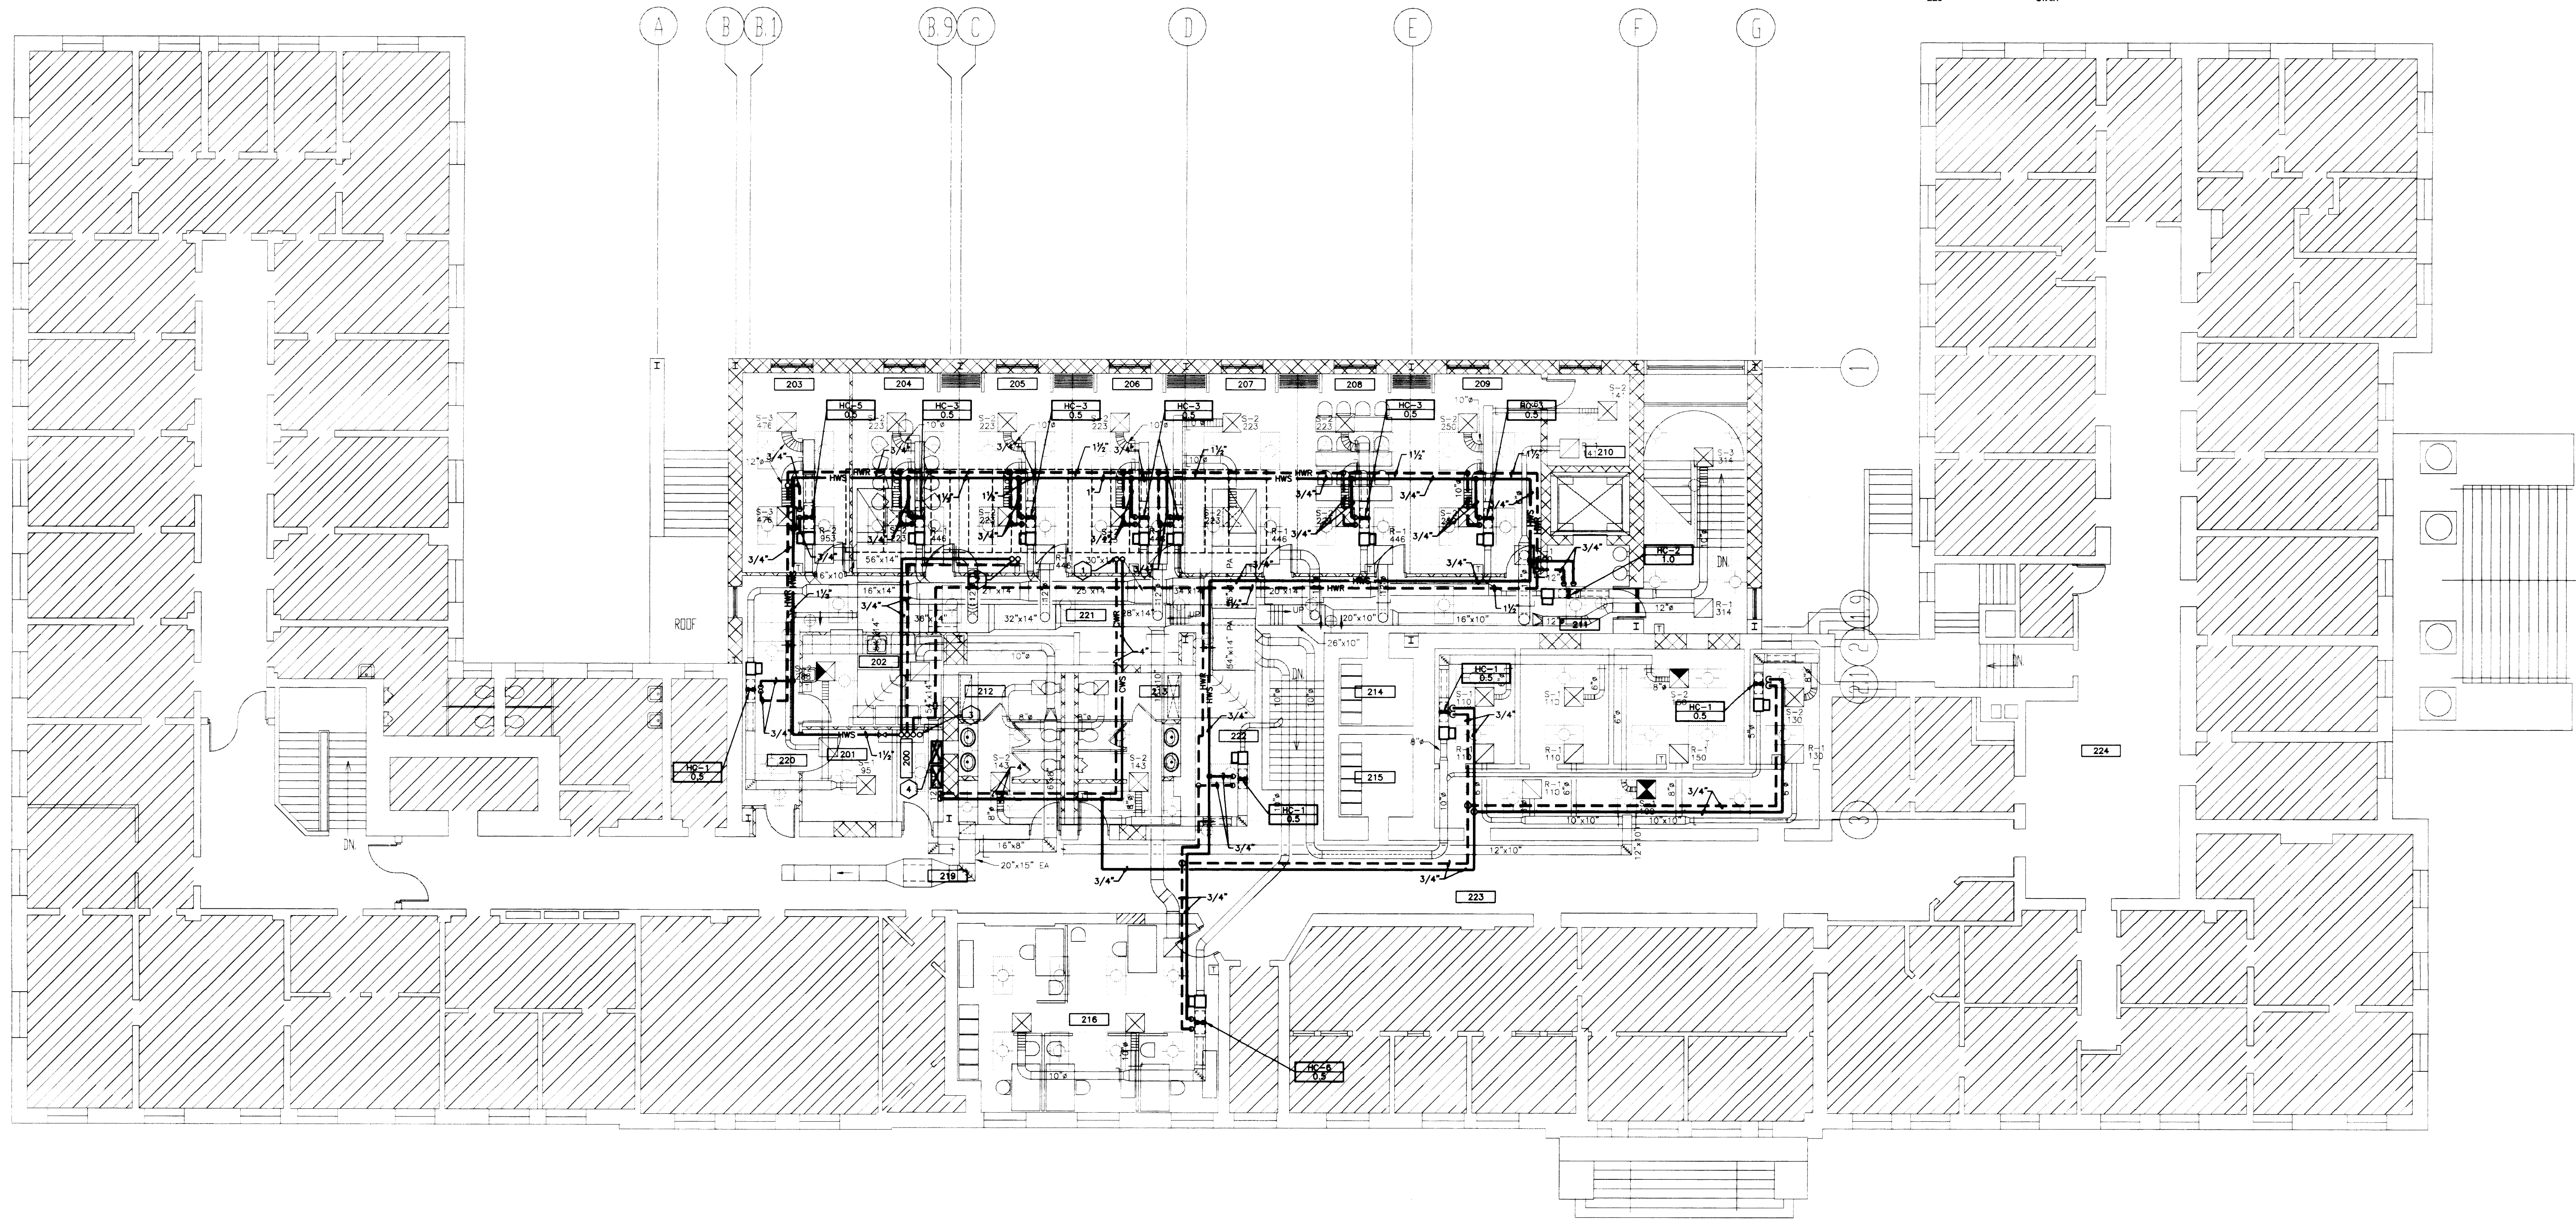

HYDRONIC PIPING - SECOND FLOOR

SCALE: 1/8"=1'-0"

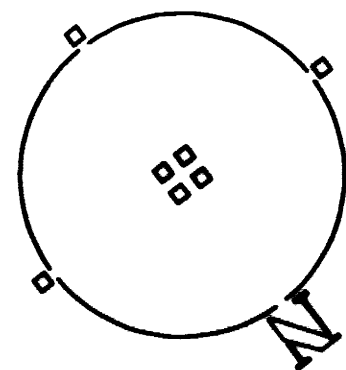

CODED NOTES:

- 1 4" CWS & CWR PIPING UP TO AIR HANDLING UNIT COOLING COIL.
- 2 1-1/2" HWS & HWR PIPING UP TO AIR HANDLING UNIT HEATING COIL.
- 3 CHILLED WATER COIL PUMP & VALVING (SEE FLOW DIAGRAM ON H-12).
- 4 HOT WATER COIL PUMP & VALVING (SEE FLOW DIAGRAM ON H-12).

ROOM NO.	ROOM NAME
200	JANITOR
201	CHAIR STOR.
202	KITCHENETTE
203	COMPUTER
204	SATELLITE
205	CONFERENCE
206	
207	
208	
209	VIDEO
210	A/V STORAGE
211	ELEV. LOBBY LEVEL 2
212	WOMEN
213	MEN
214	RECORDS
215	RECORDS
216	TRAINING OFFICE
217	CORRIDOR
218	CORRIDOR
219	CORRIDOR
220	CORRIDOR
221	CORRIDOR
222	CORRIDOR
223	CORRIDOR
224	CORRIDOR
225	STAIR

RECORD DRAWINGS DATE 9-8-98




These record drawings have been prepared, in part, on the basis of information compiled and furnished by others. The Engineer will not be responsible for any errors or omissions which have been incorporated into this document as a result.

STAGGS & FISHER CONSULTING ENGINEERS, INC.


SCOVELL HALL RENOVATION

HYDRONIC PIPING - SECOND FLOOR



002150

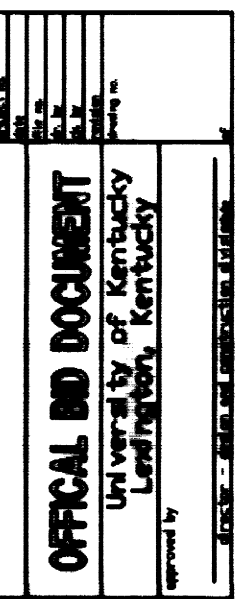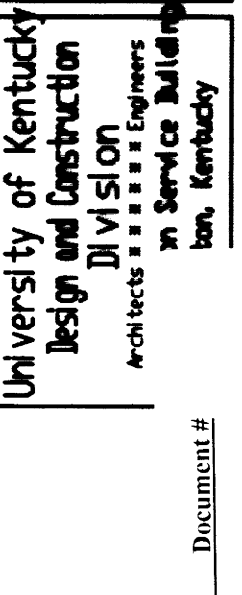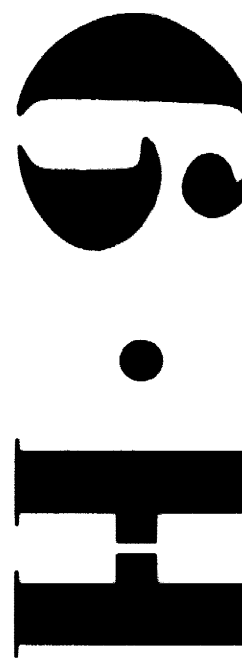

Omni Architects




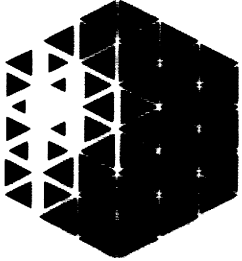



Staggs and Fisher Consulting Engineers, Inc.

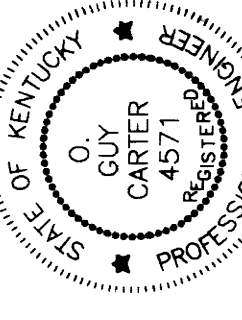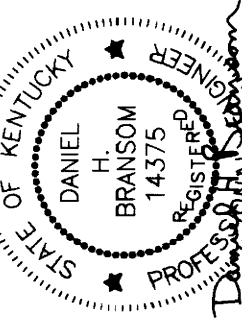


UNIVERSITY OF KENTUCKY

The drawings and design shown herein are the property of Staggs and Fisher Consulting Engineers, Inc. and are not to be used for any other project without the written consent of Staggs and Fisher Consulting Engineers, Inc.

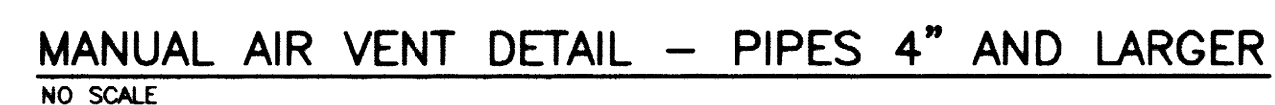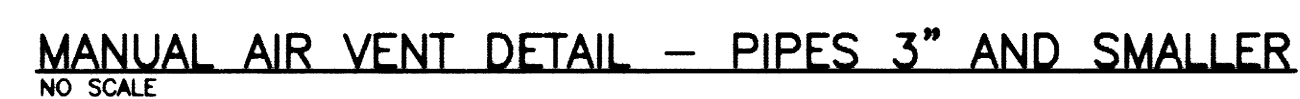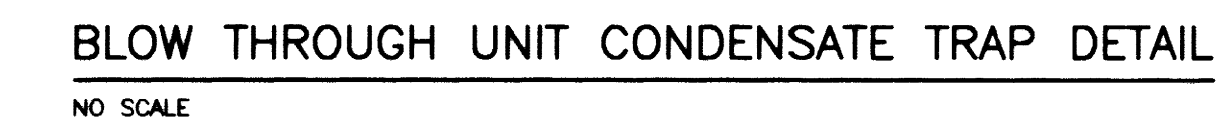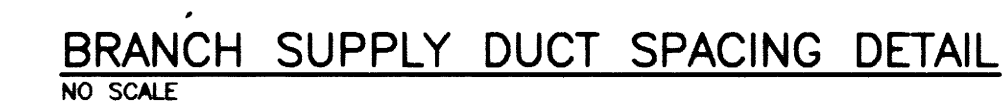


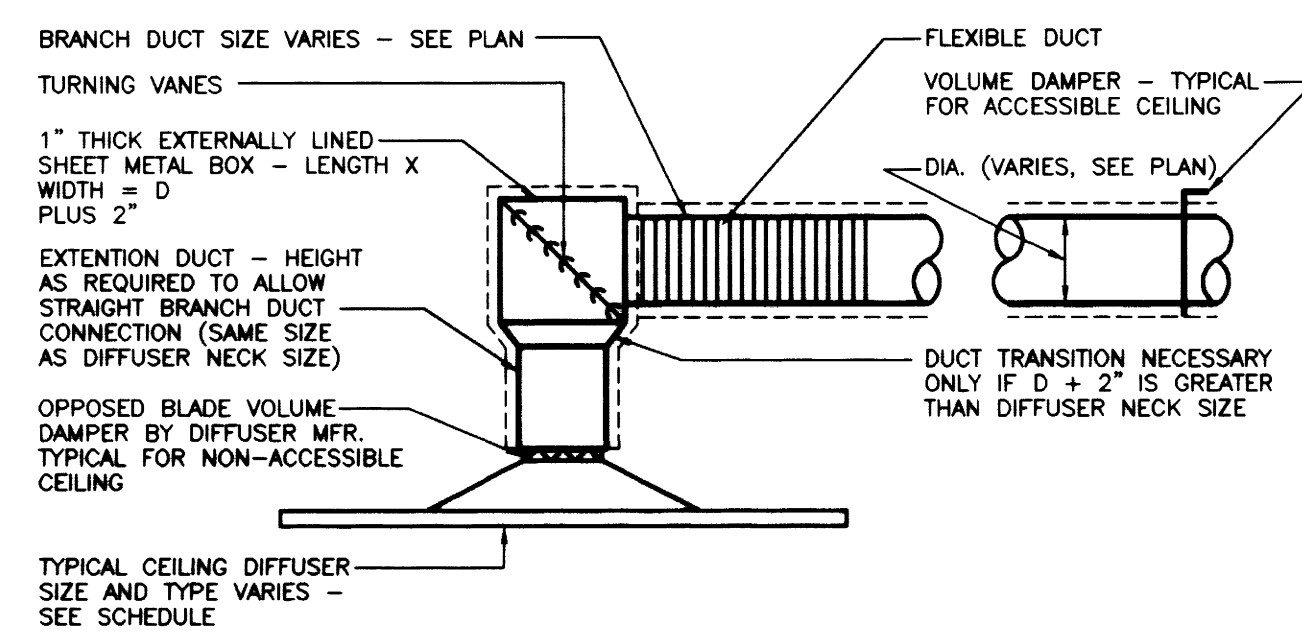


CONNECTION TO S.A. CEILING DIFFUSER
NO SCALE

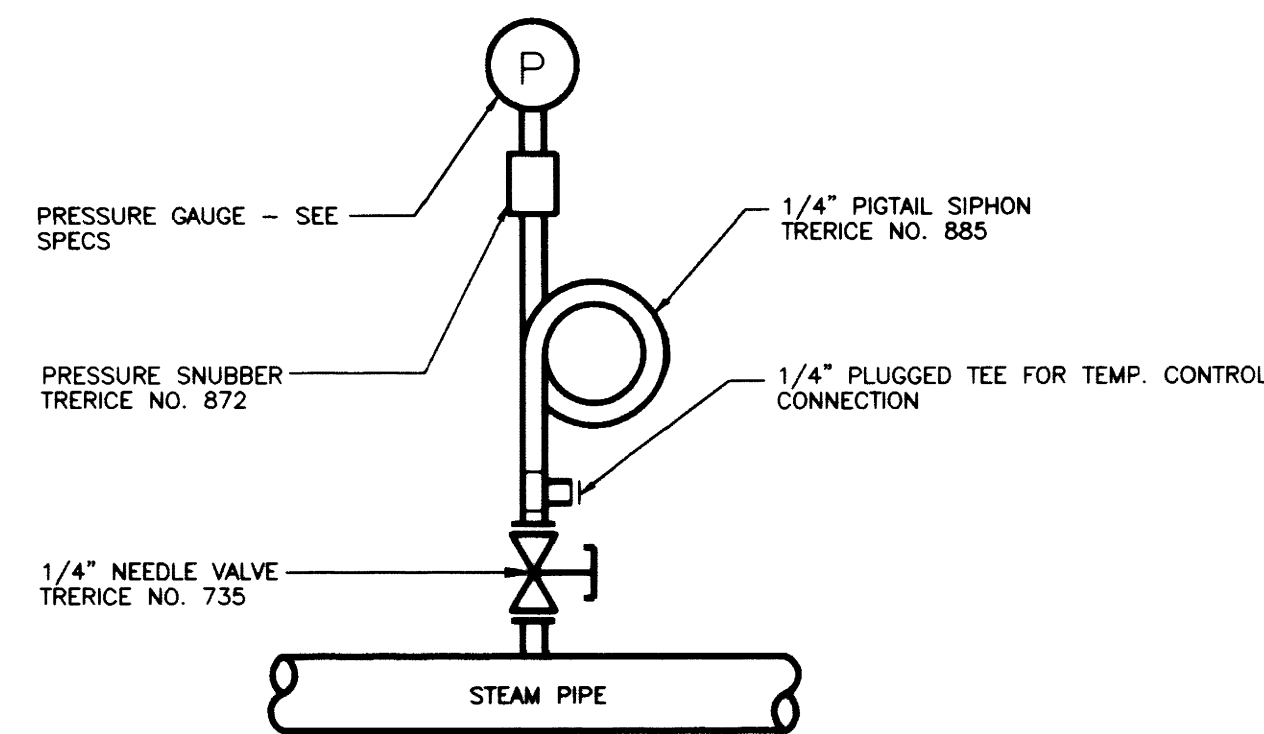


STEAM PRESSURE GAUGE INSTALLATION

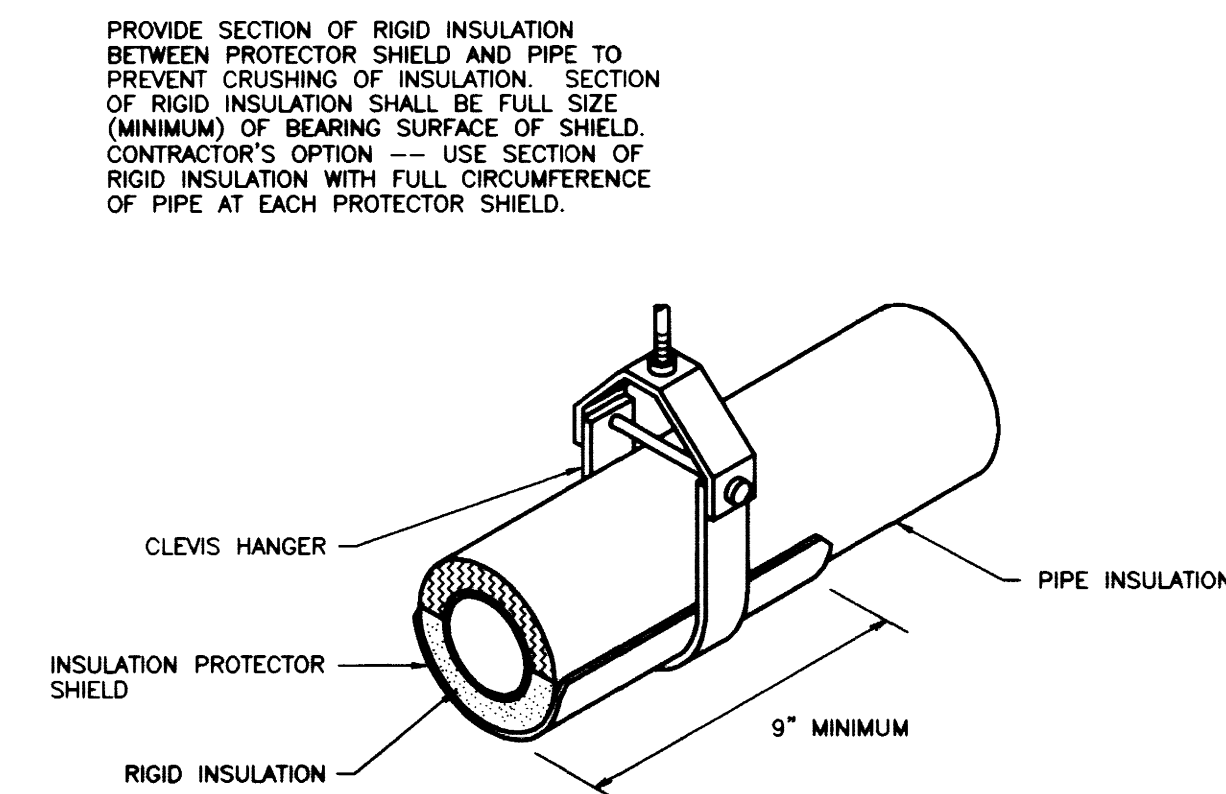


TYP. PIPE SUPPORT DETAIL WITH SHIELD
NO SCALE

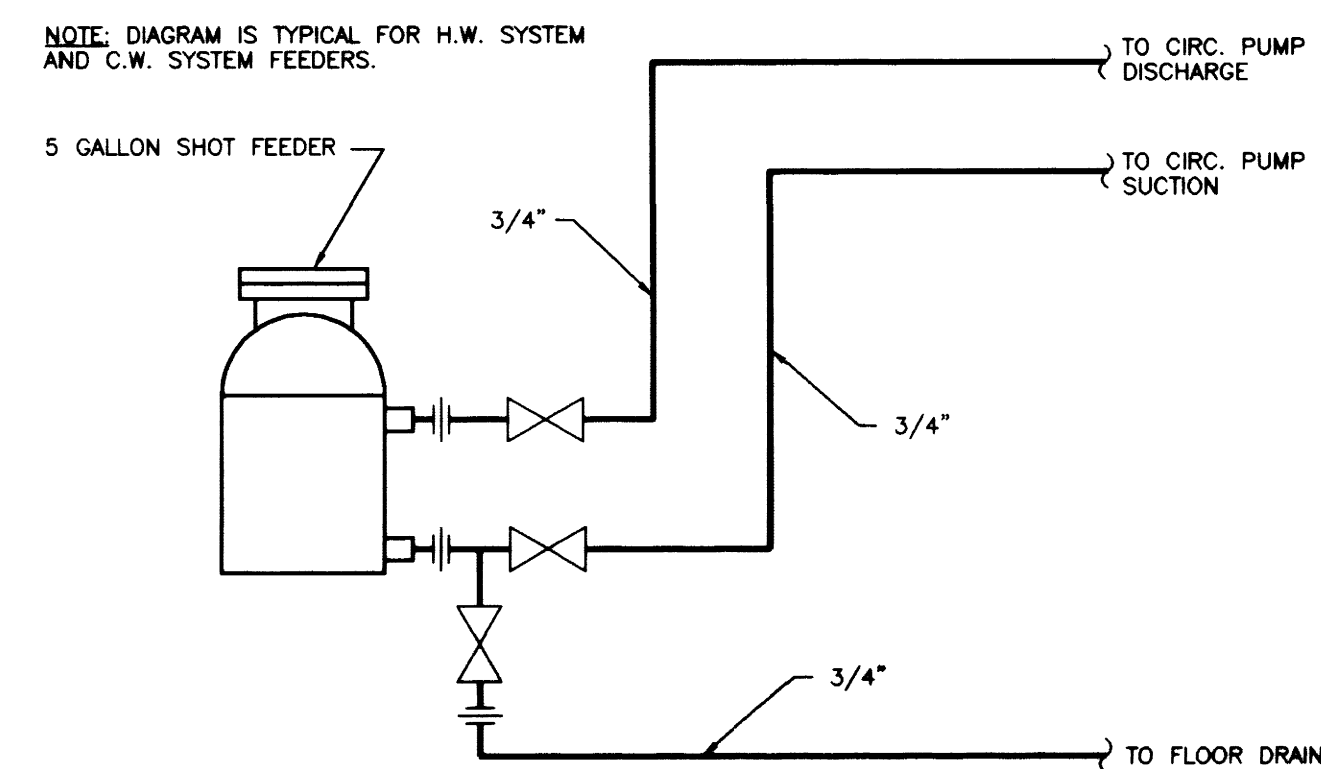


POT FEEDER PIPING DIAGRAM

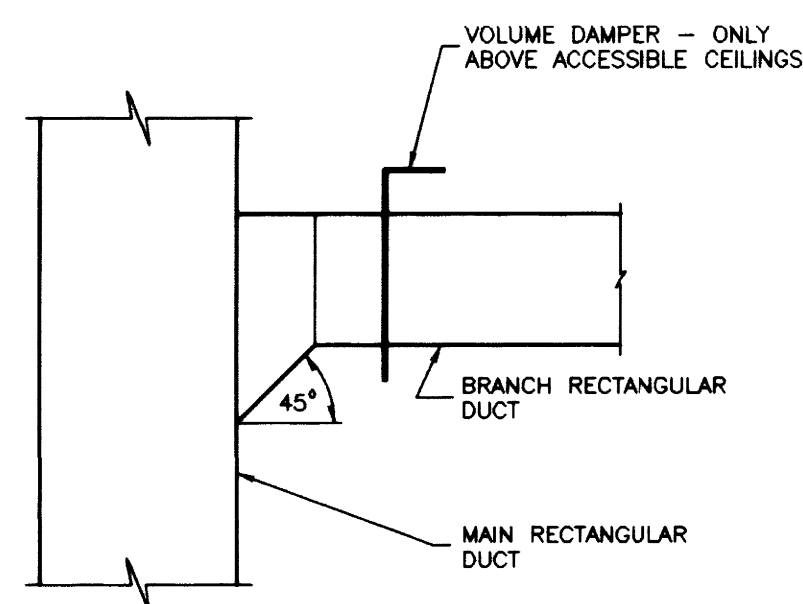


TYPICAL LOW PRESSURE
RECTANGULAR DUCT TAKE-OFF
NO SCALE

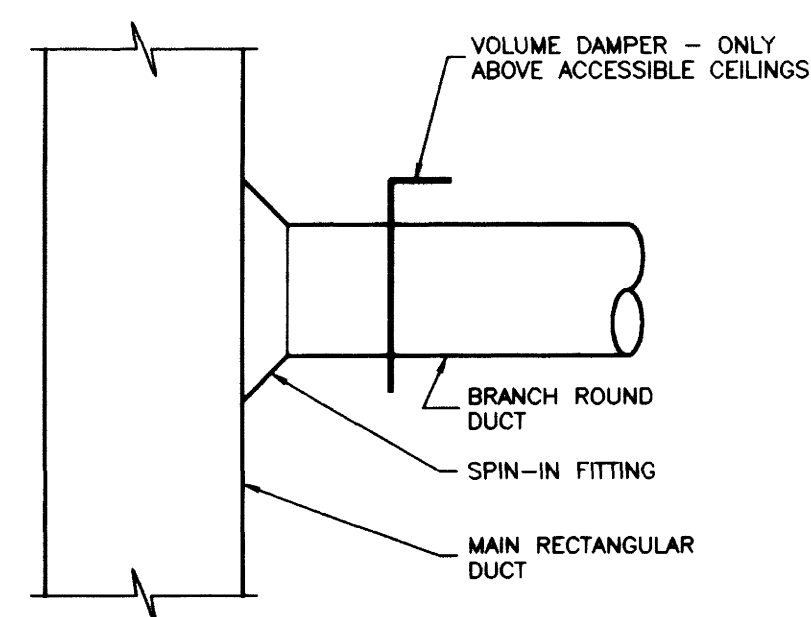


TYPICAL LOW PRESSURE
ROUND DUCT TAKE-OFF
NO SCALE

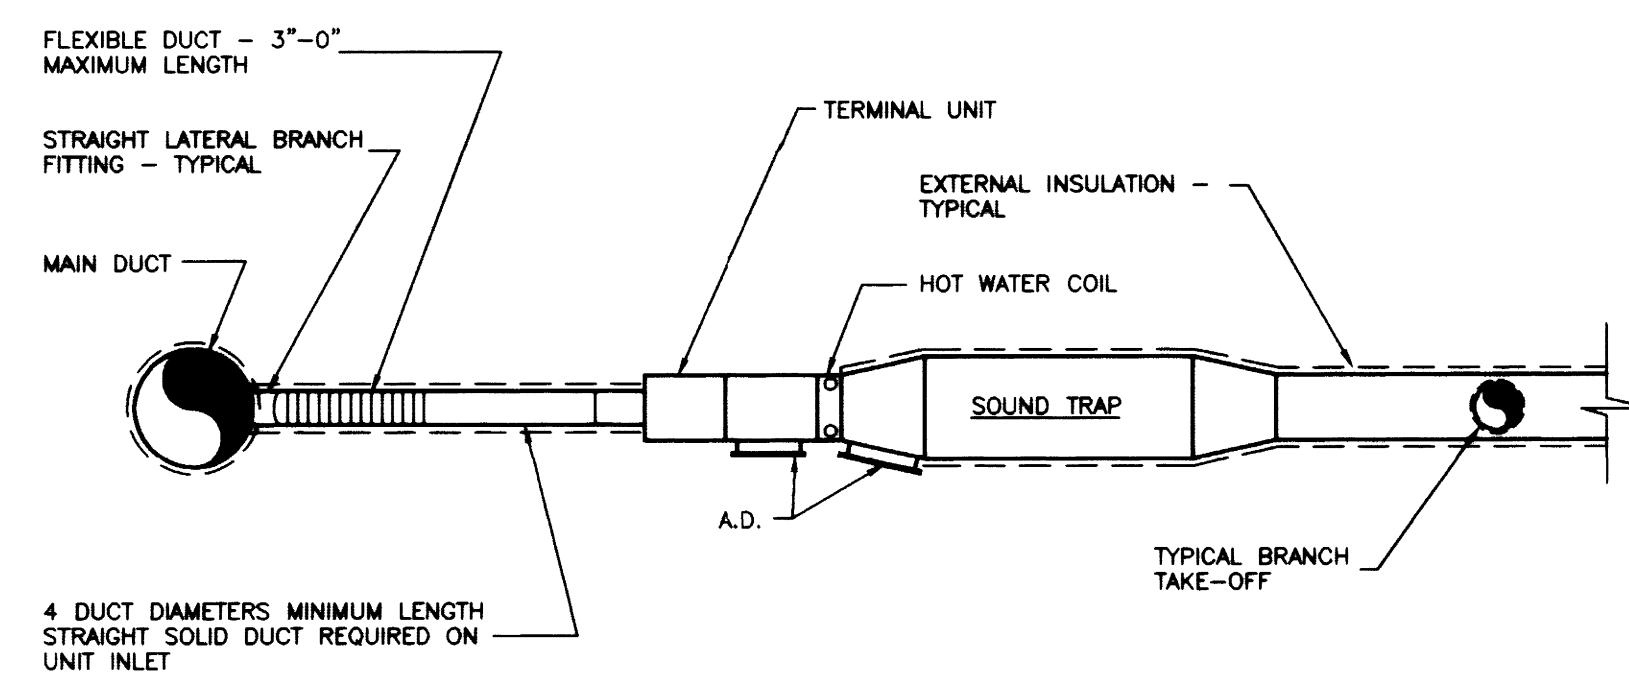


TERMINAL REHEAT UNIT INSTALLATION DETAIL
NO SCALE

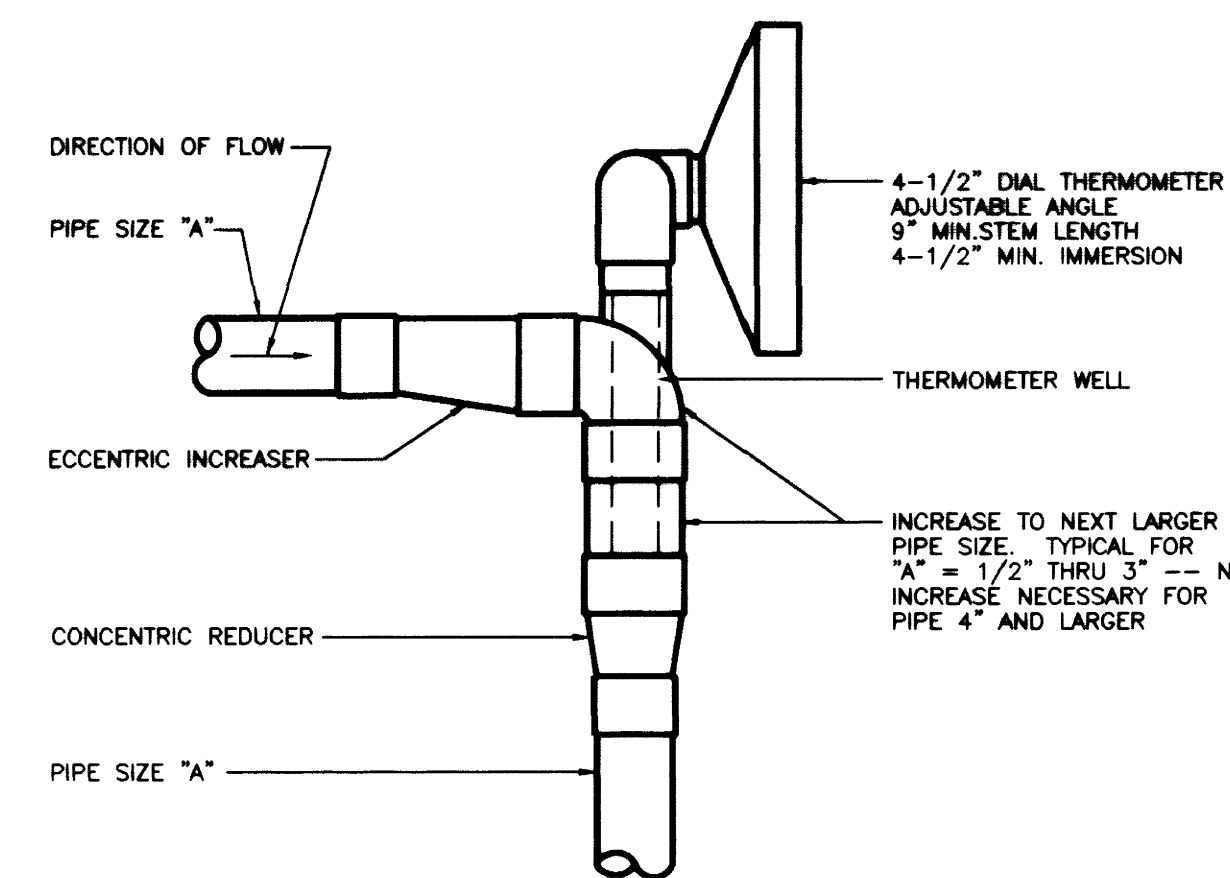


PIPE THERMOMETER INSTALLATION DETAIL

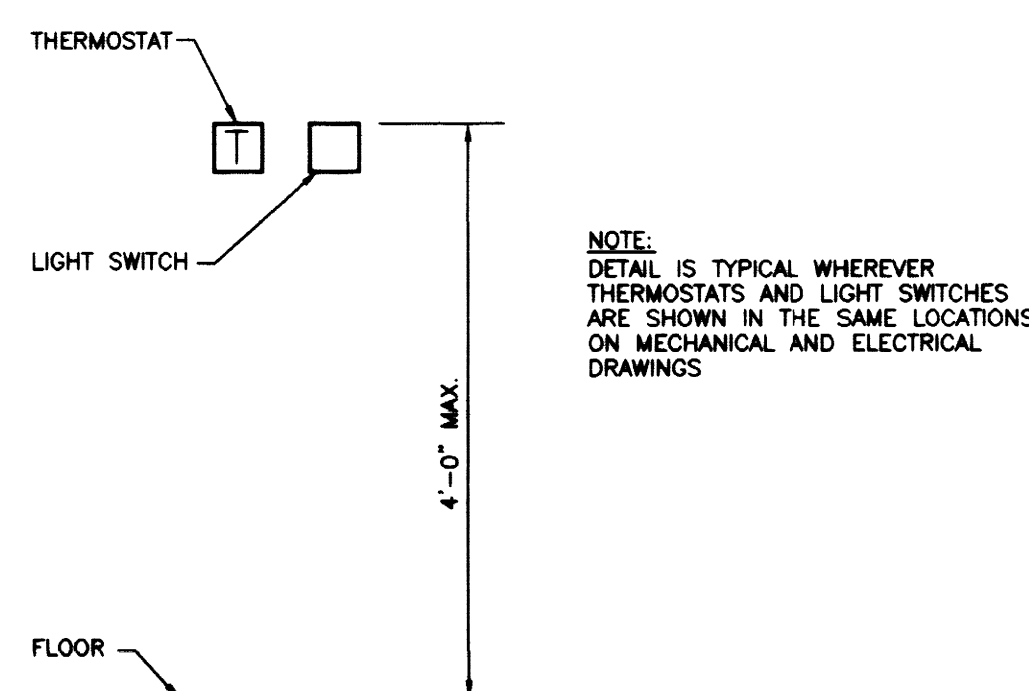

THERMOSTAT MOUNTING DETAIL
NO SCALE

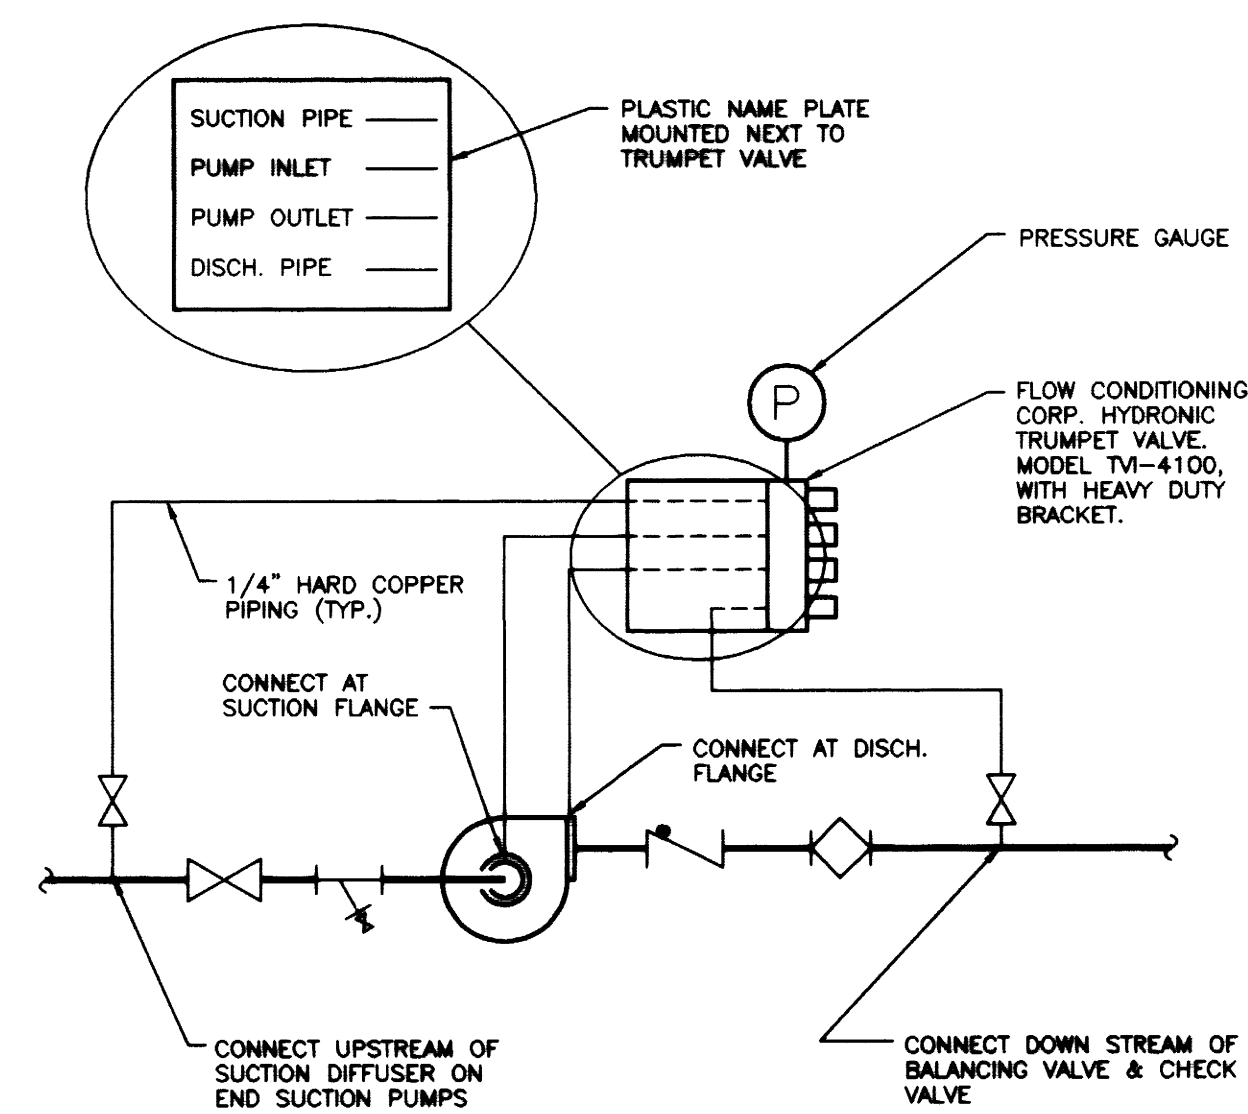

TYPICAL PUMP PRESSURE GAUGE INSTALLATION DETAIL
NO SCALE




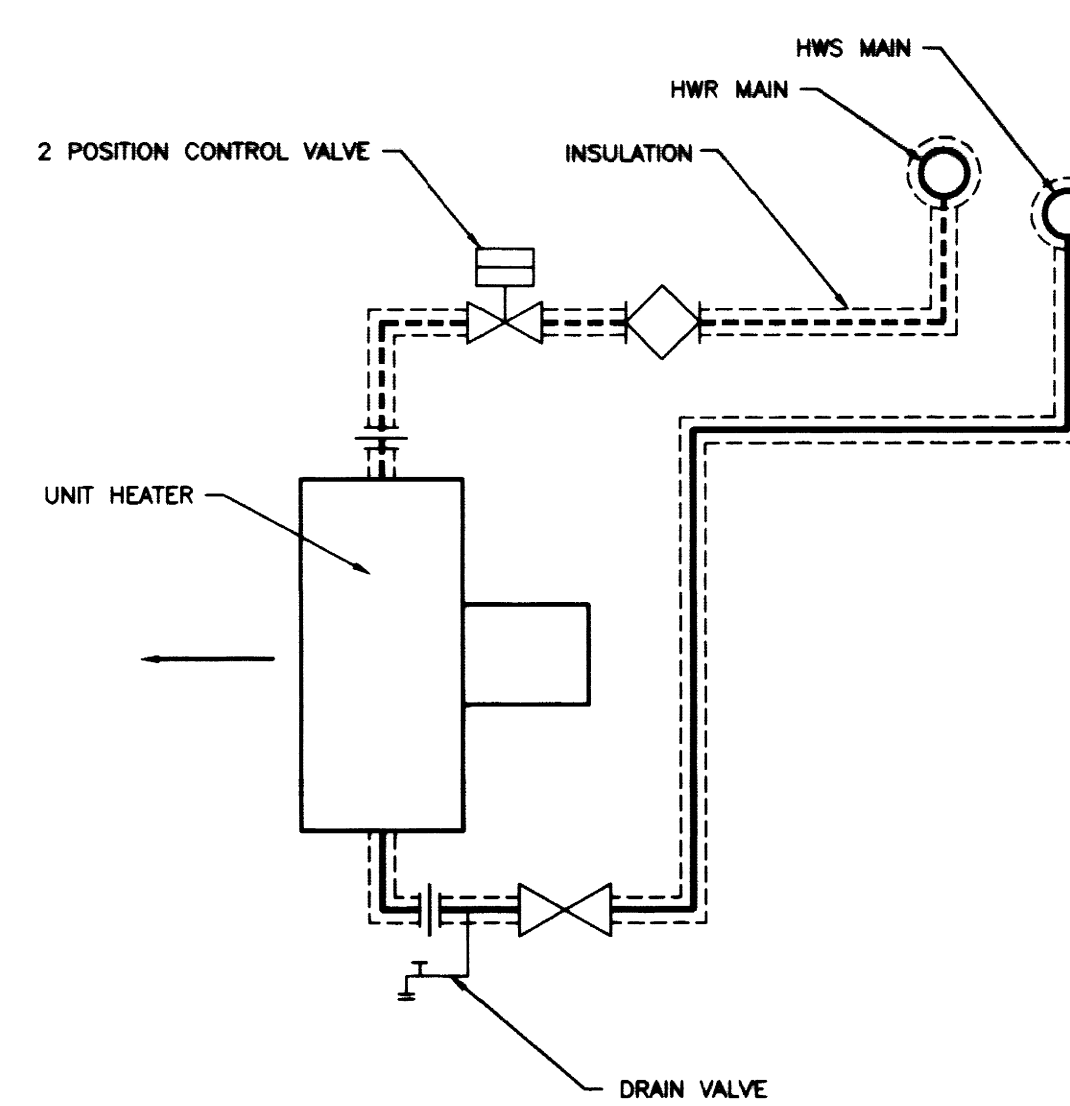


UNIT HEATER PIPING DIAGRAM

RECORD DRAWINGS . . . DATE 9-9-80

These record drawings have been prepared, in part, on the basis of information compiled and furnished by others. The Engineer will not be responsible for any errors or omissions which have been incorporated into this document as a result

STAGGS & FISHER CONSULTING ENGINEERS, INC.

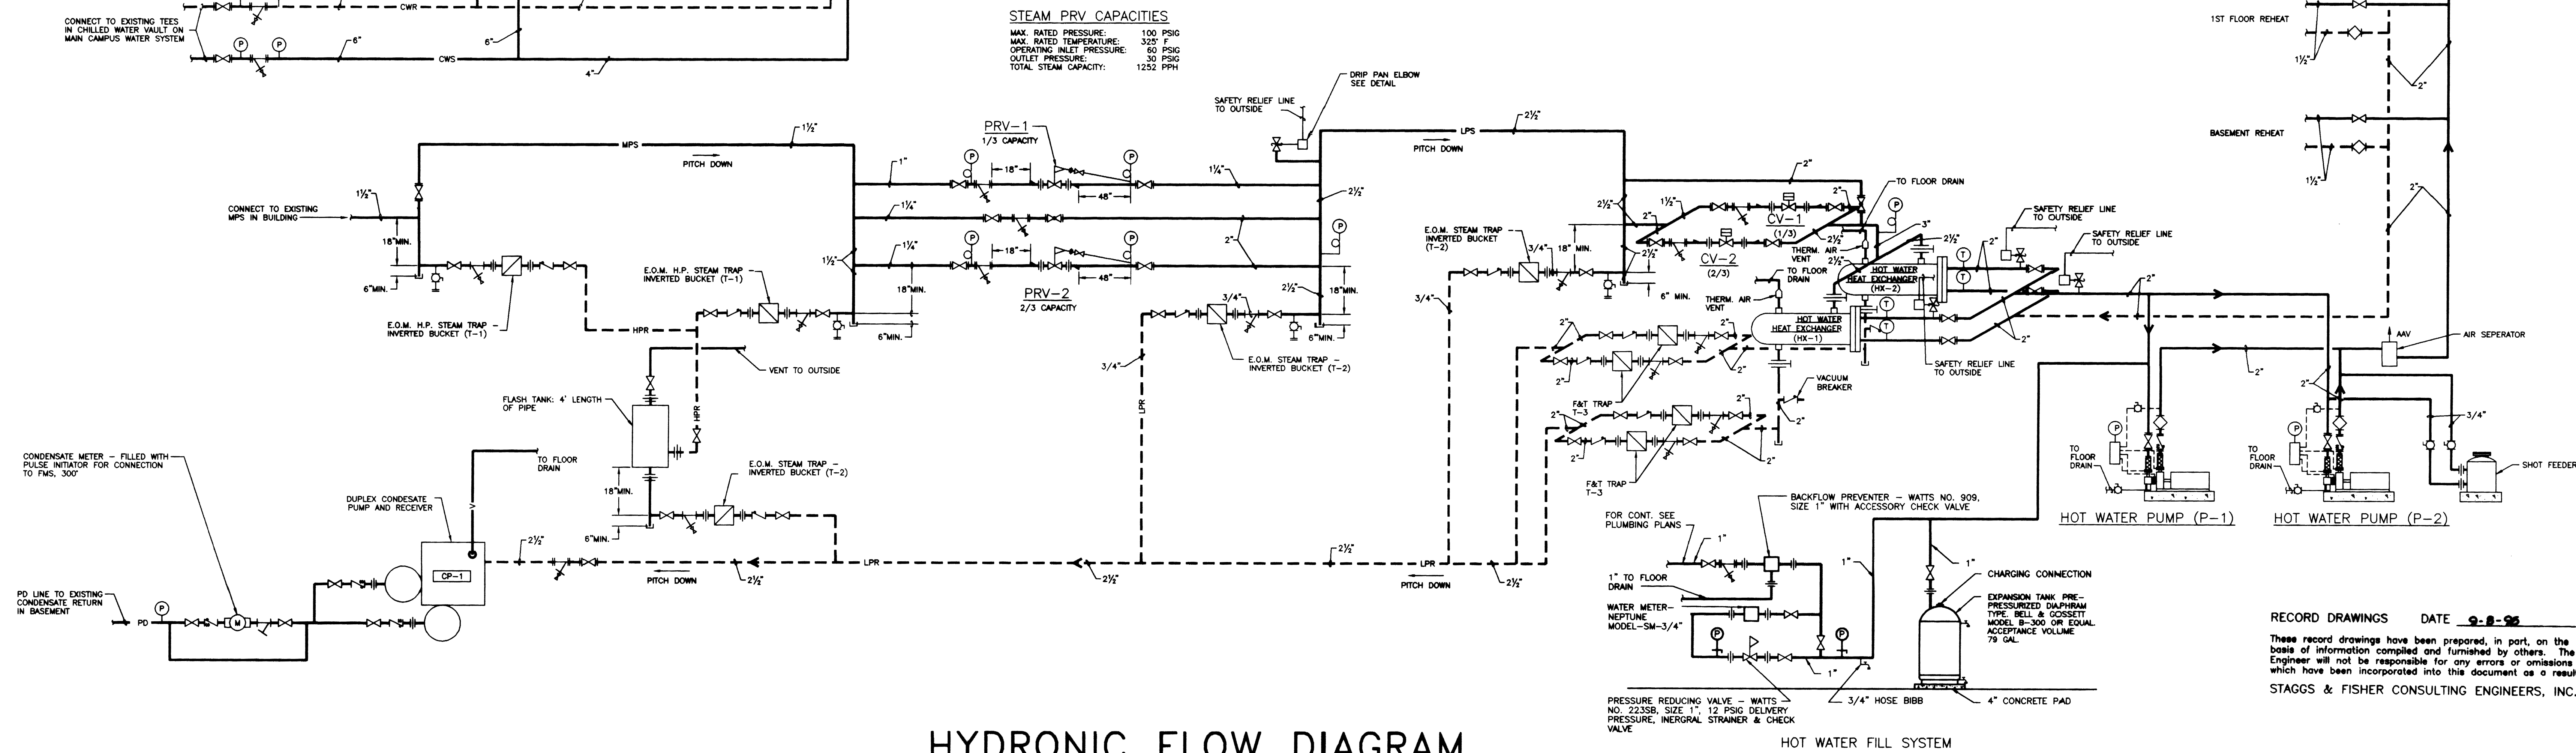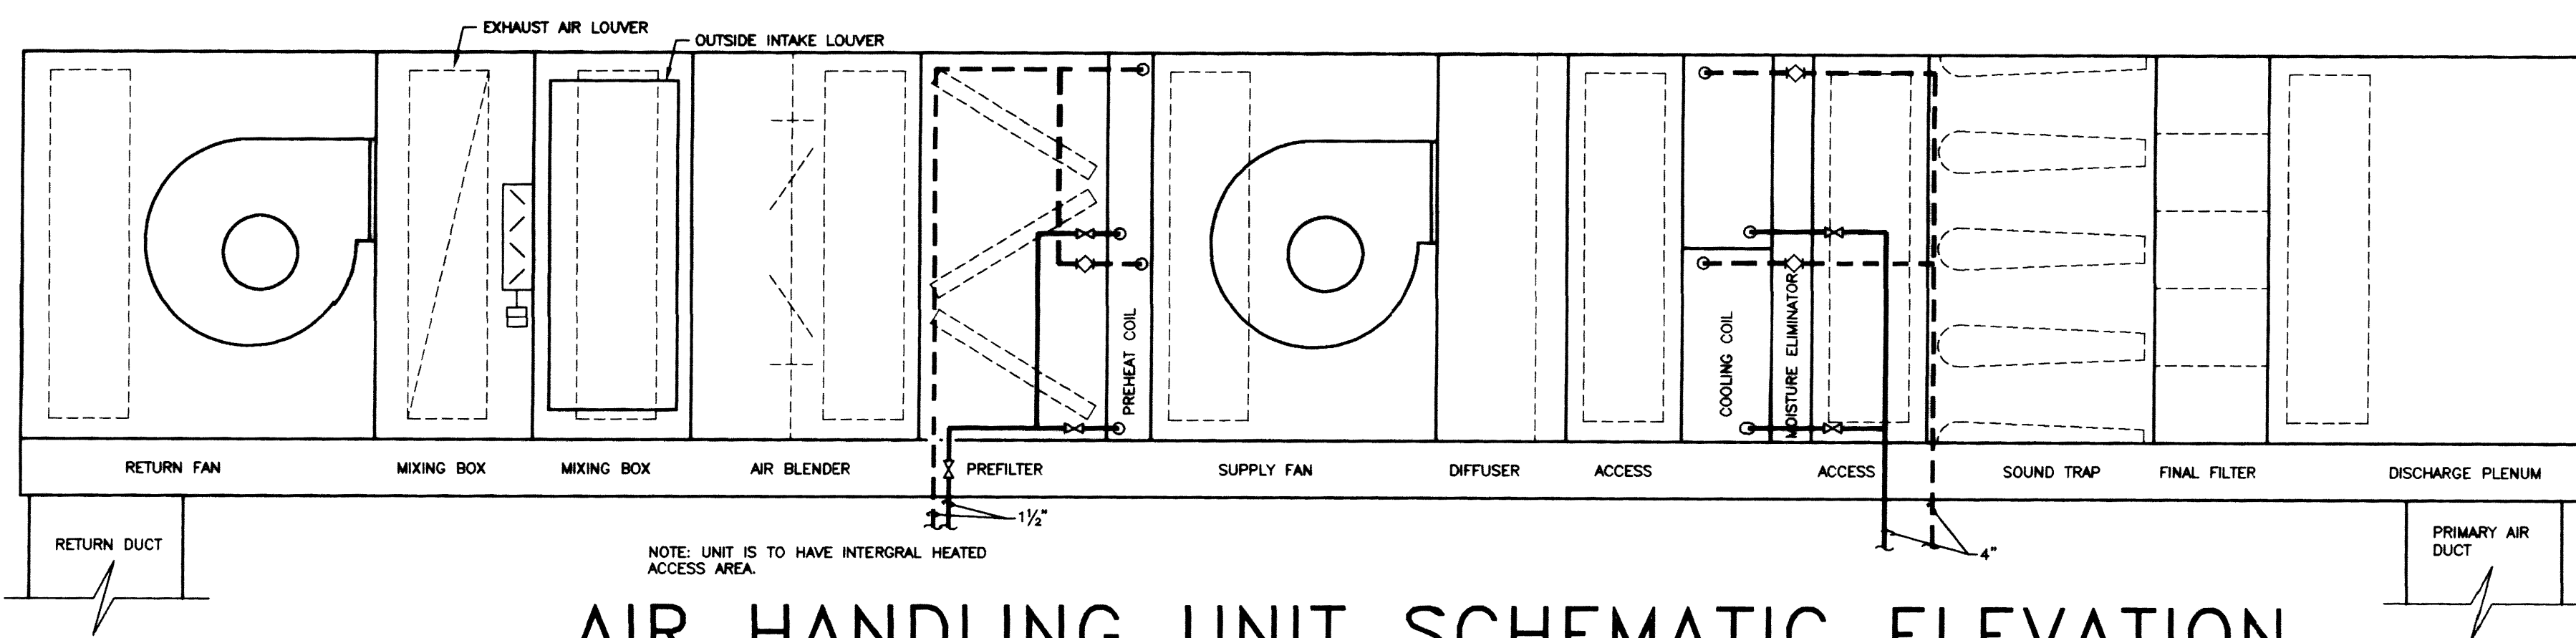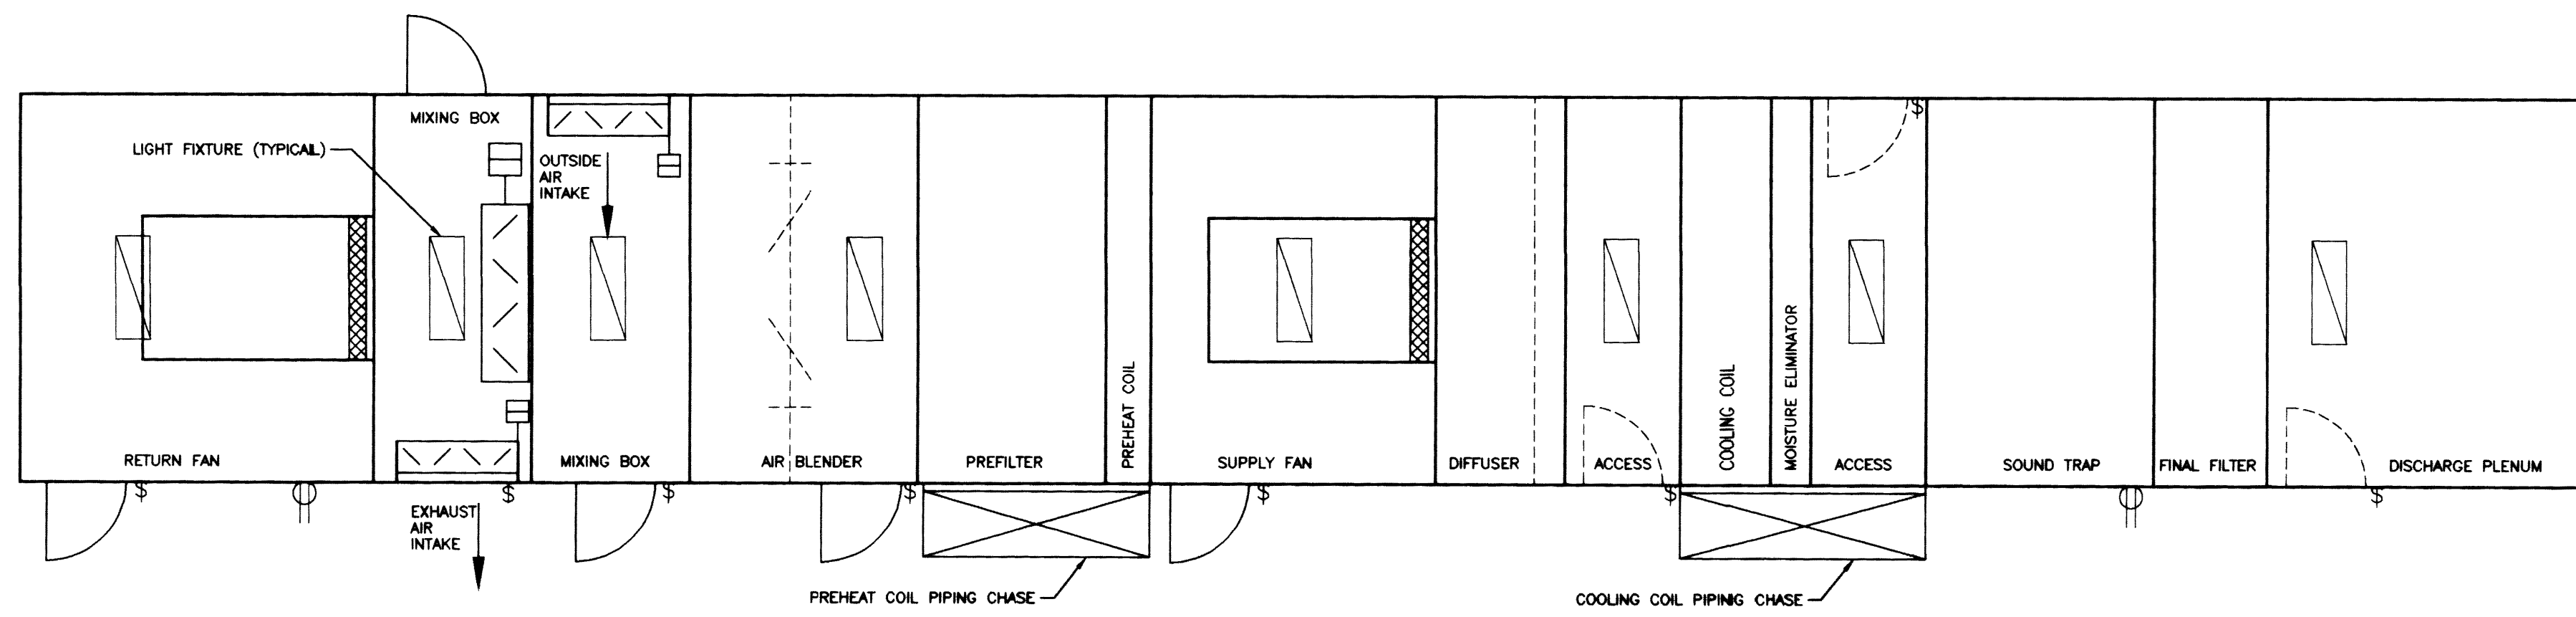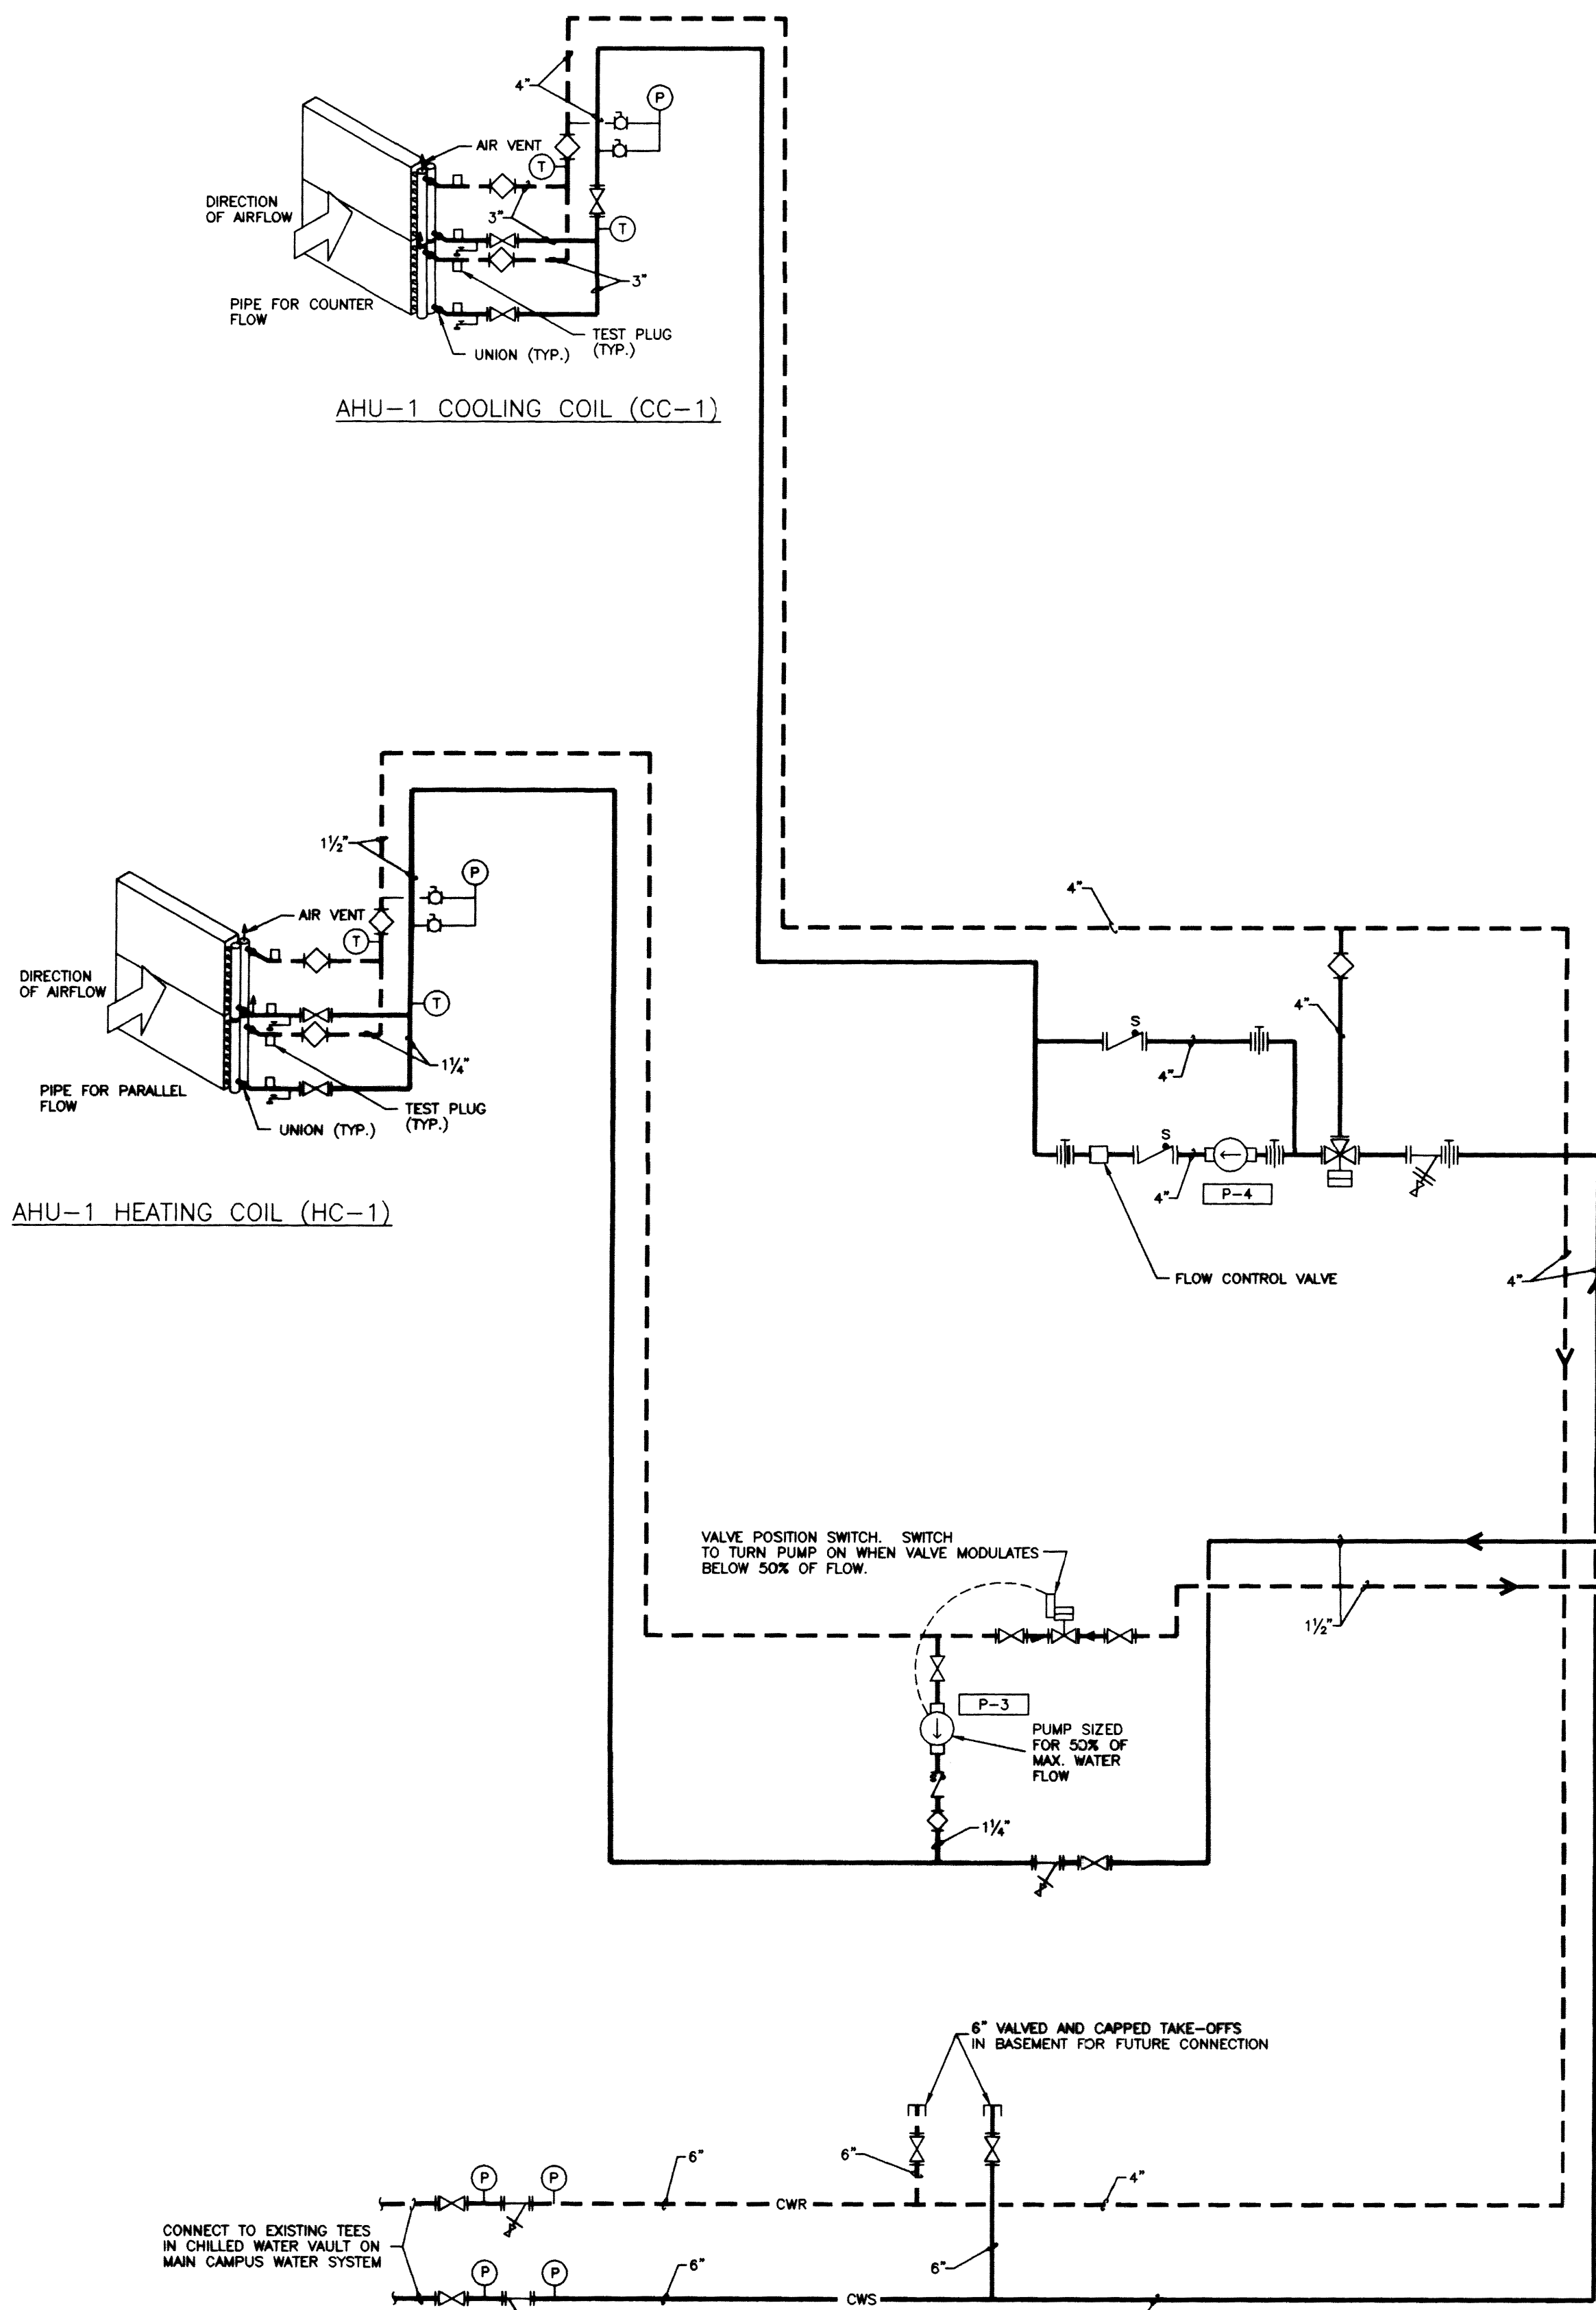

Job No. _____ Date: APRIL, 1994 Drawn By: DHB Checked: DHB

Revisions:

SE Stagg and Fisher Consulting Engineers, Inc. 317 South Third Street Lexington, Kentucky 40507 (606) 252-6664

Omni Architects

OFFICIAL AND DOCUMENT University of Kentucky Division of Construction Services

University of Kentucky Division of Construction Services

These record drawings have been prepared, in part, on the basis of information compiled and furnished by others. The Engineer will not be responsible for any errors or omissions which have been incorporated into this document as a result.

STAGGS & FISHER CONSULTING ENGINEERS, INC.

HEATING COILS														REMARKS	
SYMBOL	MFR.	MODEL NO.	ROWS	F.P.L.	TOT. CAP. BTU. MBH.	CFM	VEL. FPM	A.P.D. IN. W.G.	E.A.T. F.	L.A.T. F.	GPM	W.P.T. F.T.	EWT		DIM. WxH
HC-1	MCQUAY	5850801H	1	8	11.9	400	533	0.14	55	82.1	1.0	0.2	180	1209	*1
HC-2	MCQUAY	4850802H	2	8	21.0	400	533	0.20	55	103.0	1.0	0.2	180	1209	*1
HC-3	MCQUAY	5850801H	1	8	18.8	700	560	0.15	55	79.4	1.0	0.2	180	1511	*2
HC-4	MCQUAY	5851002B	2	10	34.6	700	560	0.22	55	100.1	2.0	1.5	180	1511X2	*2
HC-5	MCQUAY	4850801H	1	6	22.2	1100	502	0.07	55	73.4	1.0	1.0	180	2115	*3
HC-6	MCQUAY	4850802H	2	8	50.2	1100	502	0.18	55	96.8	2.0	6.8	180	2115X	*3
HC-7	MCQUAY	4850701H	1	7	37.7	1600	568	0.10	55	76.5	2.0	3.8	180	2715X	*4
HC-8	MCQUAY	5851002	2	10	74.6	1600	568	0.22	55	97.6	3.0	5.0	180	2715X	*4
HC-9	MCQUAY	5850801H	1	8	57.1	2200	586	0.17	55	78.7	2.0	1.6	180	3615X	*5
HC-10	MCQUAY	5851002B	2	10	101.5	2200	586	0.24	55	97.2	4.0	10.7	180	3615X	*5
HC-11	MCQUAY	5850601H	1	6	45.8	18394	519	0.09	34	56.8	14	0.9	180	85X60	*6

[illegible][illegible][illegible][illegible][illegible][illegible][illegible][illegible]

SOUND TRAPS																							
SYMBOL	MANUFACTURE	MODEL	DIMEN. WxHxL	CFM	FACE VEL. PPM	P.D. IN. W.G.	INSERTION LOSS dB								SELF GEN. NOISE dB								REMARKS
							1	2	3	4	5	6	7	8	1	2	3	4	5	6	7	8	
ST-1	COMM. ACOUSTIC	HP-EE	1290X90	400	533	0.06	-	7	14	22	31	36	27	17	37	31	28	30	28	23	VW-5.6		
ST-2	COMM. ACOUSTIC	HP-EE	1634 X1236	700	560	0.06	-	7	14	22	31	36	27	17	37	31	28	30	28	23	VW-9		
ST-3	COMM. ACOUSTIC	HP-EE	2113 X1636	1100	502	0.06	-	7	14	22	31	36	27	17	40	34	31	33	26	27	VW-10		
ST-4	COMM. ACOUSTIC	HP-EE	2781 X1536	1800	560	0.06	-	7	14	22	31	36	27	17	43	37	34	36	29	30	VW-12		
ST-5	COMM. ACOUSTIC	HP-EE	3611 X1536	2200	587	0.06	-	7	14	22	31	36	27	17	43	37	34	36	29	30	VW-14		
ST-6	COMM. ACOUSTIC	SP	244T10X136	1450	-	0.10	-	6	13	20	29	33	19	12	46	44	47	51	52	34	EF-3		
ST-7	COMM. ACOUSTIC	HP	85X60X80	18394	519	0.13	-	12	26	40	57	60	48	27	45	50	42	40	41	39	AHU-1		

SOUND TRAPS																							
SYMBOL	MANUFACTURE	MODEL	DIMEN. WxHxL	CFM	FACE VEL. PPM	P.D. IN. W.G.	INSERTION LOSS dB								SELF GEN. NOISE dB								REMARKS
							1	2	3	4	5	6	7	8	1	2	3	4	5	6	7	8	
ST-1	COMM. ACOUSTIC	HP-EE	1290X90	400	533	0.06	-	7	14	22	31	36	27	17	37	31	28	30	28	23	VW-5.6		
ST-2	COMM. ACOUSTIC	HP-EE	1634 X1236	700	560	0.06	-	7	14	22	31	36	27	17	37	31	28	30	28	23	VW-9		
ST-3	COMM. ACOUSTIC	HP-EE	2113 X1636	1100	502	0.06	-	7	14	22	31	36	27	17	40	34	31	33	26	27	VW-10		
ST-4	COMM. ACOUSTIC	HP-EE	2781 X1536	1800	560	0.06	-	7	14	22	31	36	27	17	43	37	34	36	29	30	VW-12		
ST-5	COMM. ACOUSTIC	HP-EE	3611 X1536	2200	587	0.06	-	7	14	22	31	36	27	17	43	37	34	36	29	30	VW-14		
ST-6	COMM. ACOUSTIC	SP	244T10X136	1450	-	0.10	-	6	13	20	29	33	19	12	46	44	47	51	52	34	EF-3		
ST-7	COMM. ACOUSTIC	HP	85X60X80	18394	519	0.13	-	12	26	40	57	60	48	27	45	50	42	40	41	39	AHU-1		

VARIABLE VOLUME TERMINAL UNITS									
SYMBOL	MFR.	CFM		NC	DUCT CONNECTION		INLET S.P. (MIN)	SOUND TRAP NO.	REMARKS
		MIN	MAX		INLET	OUTLET			
VAV-5	TEMPMASTER	96	275	48	5"	9X10	0.26	ST-1	*2
VAV-6	TEMPMASTER	140	400	48	6"	9X10	0.35	ST-1	*2
VAV-8	TEMPMASTER	245	700	41	8"	12X10	0.38	ST-2	*3
VAV-10	TEMPMASTER	385	1100	41	10"	14x10	0.45	ST-3	*4
VAV-12	TEMPMASTER	560	1600	42	12"	17x10	0.37	ST-4	*5
VAV-14	TEMPMASTER	770	2200	40	14"	22X10	0.45	ST-5	*6

[illegible][illegible]

CLERK TO BE SELECTED BY ARCH


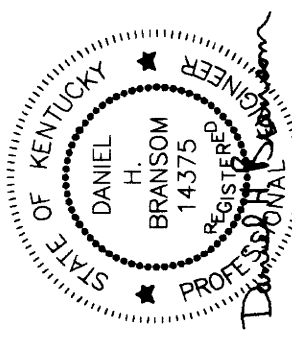
[illegible][illegible][illegible][illegible]

RECORD DRAWINGS DATE 9-8-95

RECORD DRAWINGS DATE 9-8-95

These record drawings have been prepared, in part, on the basis of information compiled and furnished by others. The Engineer will not be responsible for any errors or omissions which have been incorporated into this document as a result

STAGGS & FISHER CONSULTING ENGINEERS, INC.




OFFICIAL IND DOCUMENT	
University of Kentucky Lexington, Kentucky	
Approved by _____	
Director - Bureau of Transportation Systems _____	
PAGE NO.	_____
SERIAL NO.	_____
DATE	_____
TIME	_____
BY	_____
REMARKS	_____

University of Kentucky
 Design and Construction
 Division
 Architects • Engineers
 Slot Document #


4
1
2
3
TO GREENHOUSE

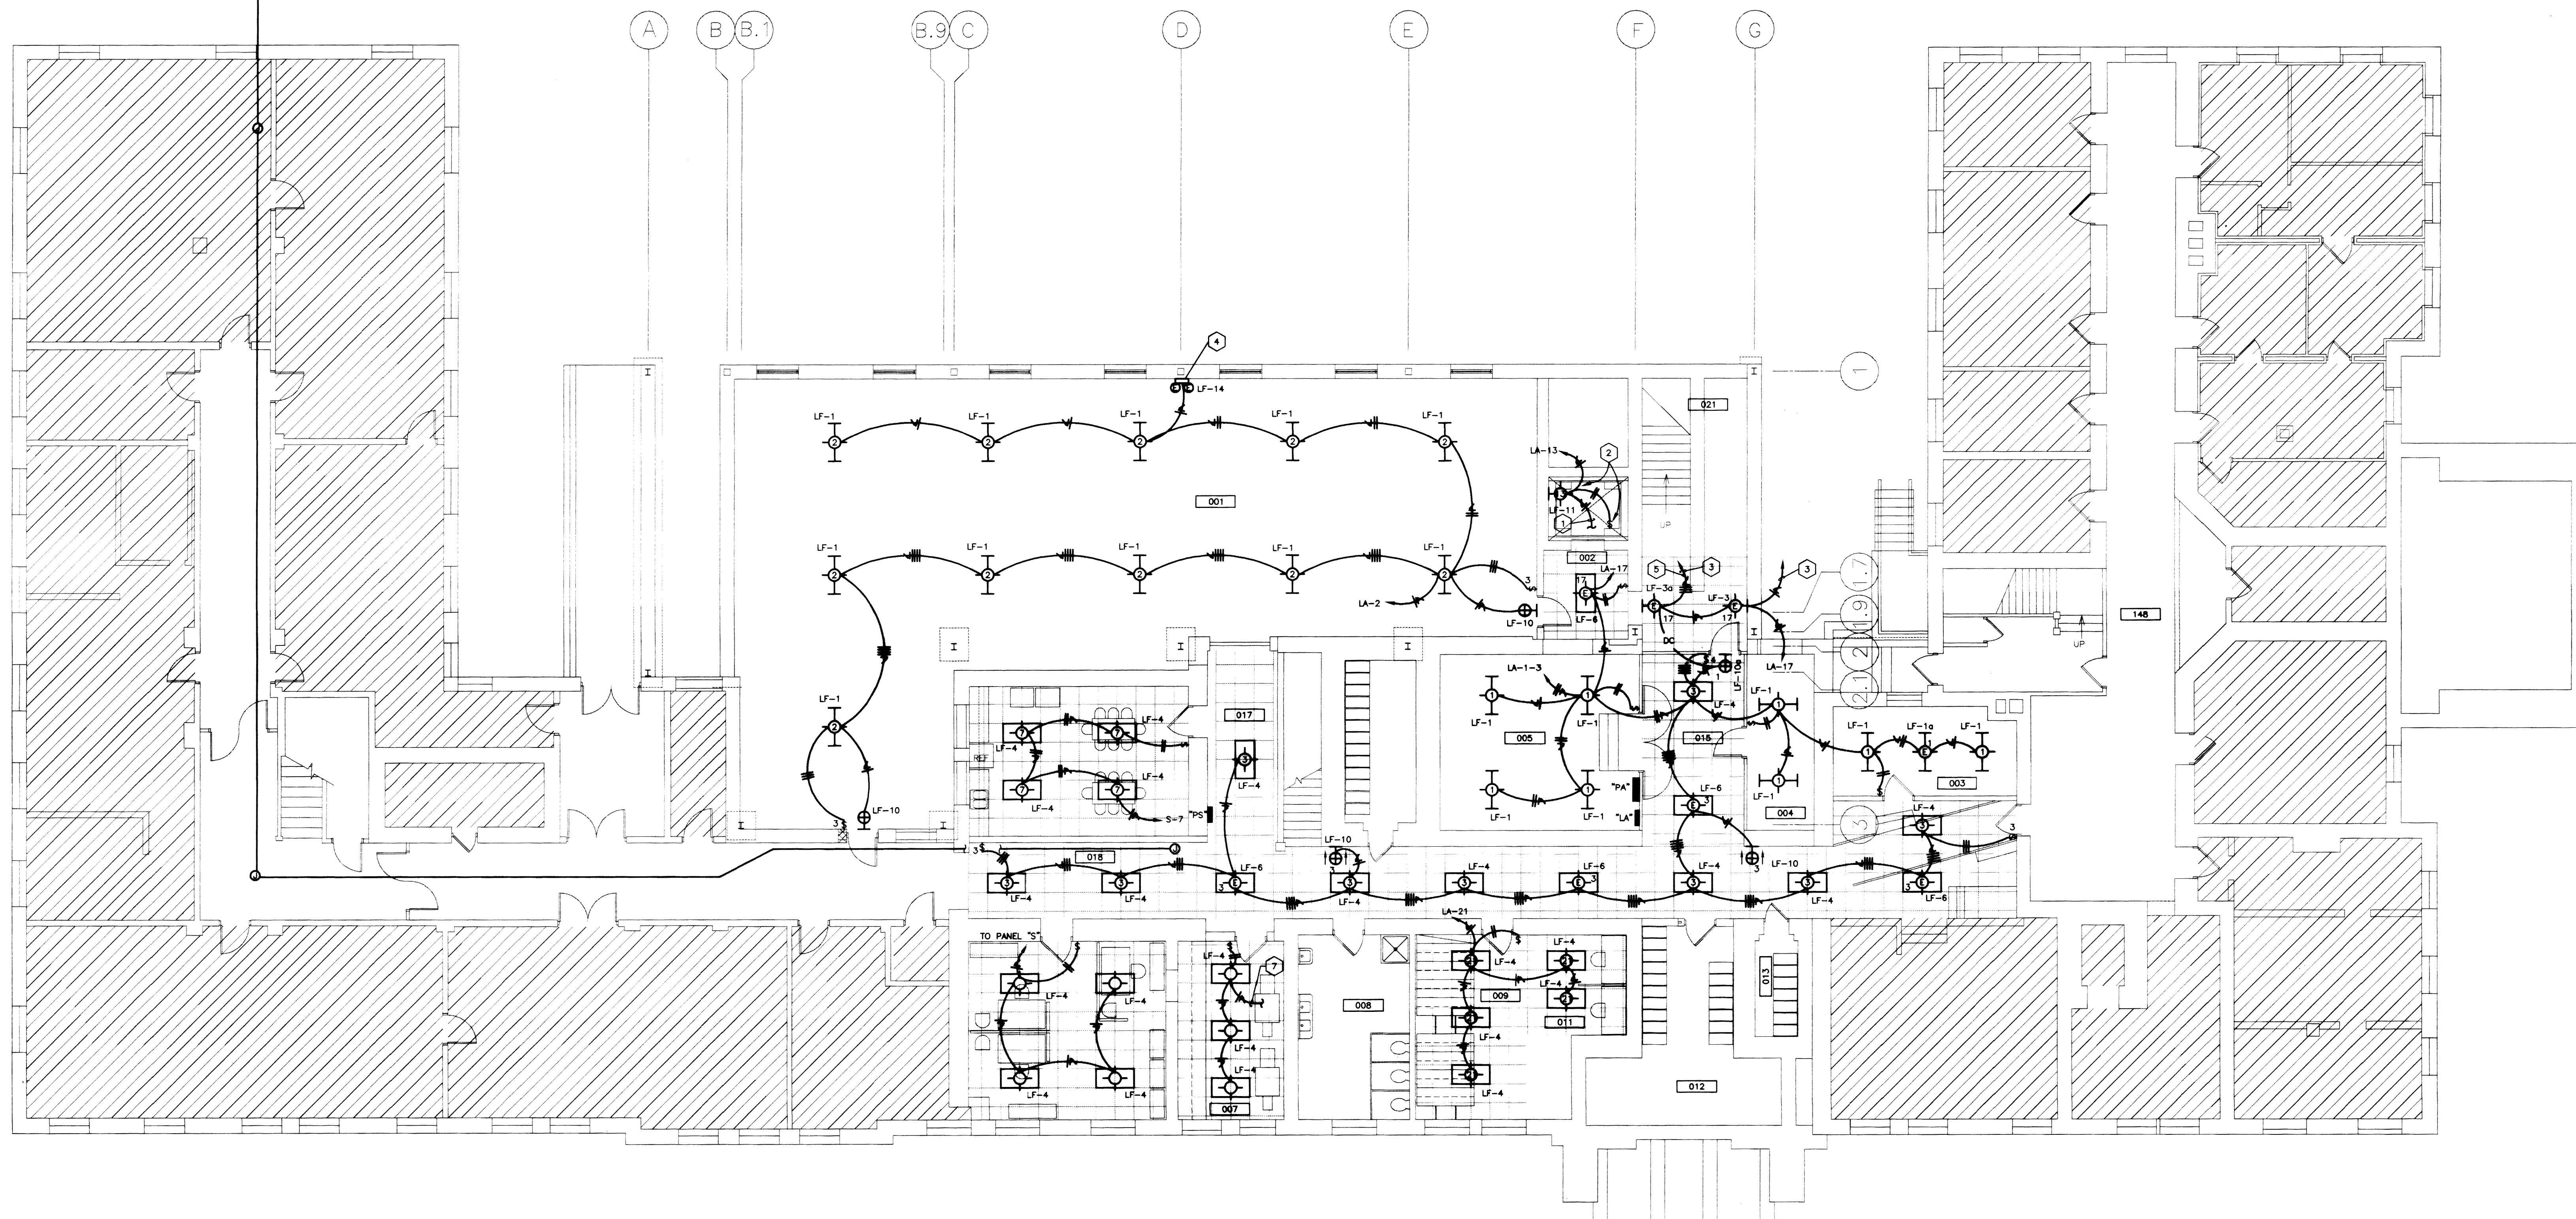

LIGHTING PLAN - BASEMENT

SCALE: 1/8"=1'-0"

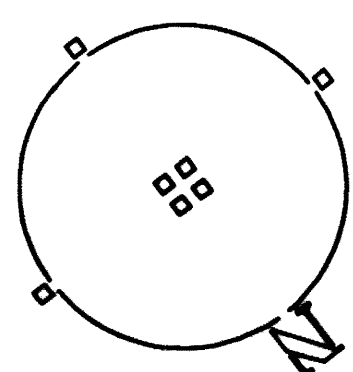

RECORD DRAWINGS DATE 9-8-95


These record drawings have been prepared, in part, on the basis of information compiled and furnished by others. The Engineer will not be responsible for any errors or omissions which have been incorporated into this document as a result. STAGGS & FISHER CONSULTING ENGINEERS, INC.

DEMOLITION NOTE:

REMOVE ALL ELECTRIC CONNECTIONS TO EQUIPMENT, LIGHTS, DEVICES, FIRE ALARM, PHONE, ETC. IN THE AREA TO BE DEMOLISHED. REFER TO ARCHITECTURAL PLANS FOR THE EXTENT OF WORK. REFER TO GENERAL NOTES.


- CODED NOTES:
- 1 DOWN TO RECEPTACLE BELOW.
 - 2 ROUGH-IN LIGHT AND SWITCH IN ACCORDANCE WITH ELEVATOR SUPPLIER INSTRUCTIONS.
 - 3 UP TO FIXTURE ABOVE.
 - 4 STEM MOUNT ON J-BOX.
 - 5 3/4"2'S AND 2#10'S FOR DC EMERGENCY LAMP.
 - 6 RELOCATE EXISTING LIGHTS AS REQUIRED TO COORDINATE WITH NEW DUCT WORK.
 - 7 CONNECT TO EXISTING CIRCUIT SERVING THIS AREA AS REQUIRED.

ROOM NO.	ROOM NAME
001	SHELL SPACE
002	ELEV. LOBBY LEVEL "B"
003	COMMUNICATIONS
004	ELEV. MECH.
005	MECHANICAL/ELECTRICAL ROOM
007	EMPLOYEE RECORDS
008	WOMEN'S RESTROOM
009	TRAINING STORAGE
011	RECEIPTS STORAGE
012	COPY CENTER
013	RECORDS
015	CORRIDOR
016	CORRIDOR
017	CORRIDOR
018	CORRIDOR
019	CORRIDOR
020	CORRIDOR
021	STAIR
148	CORRIDOR

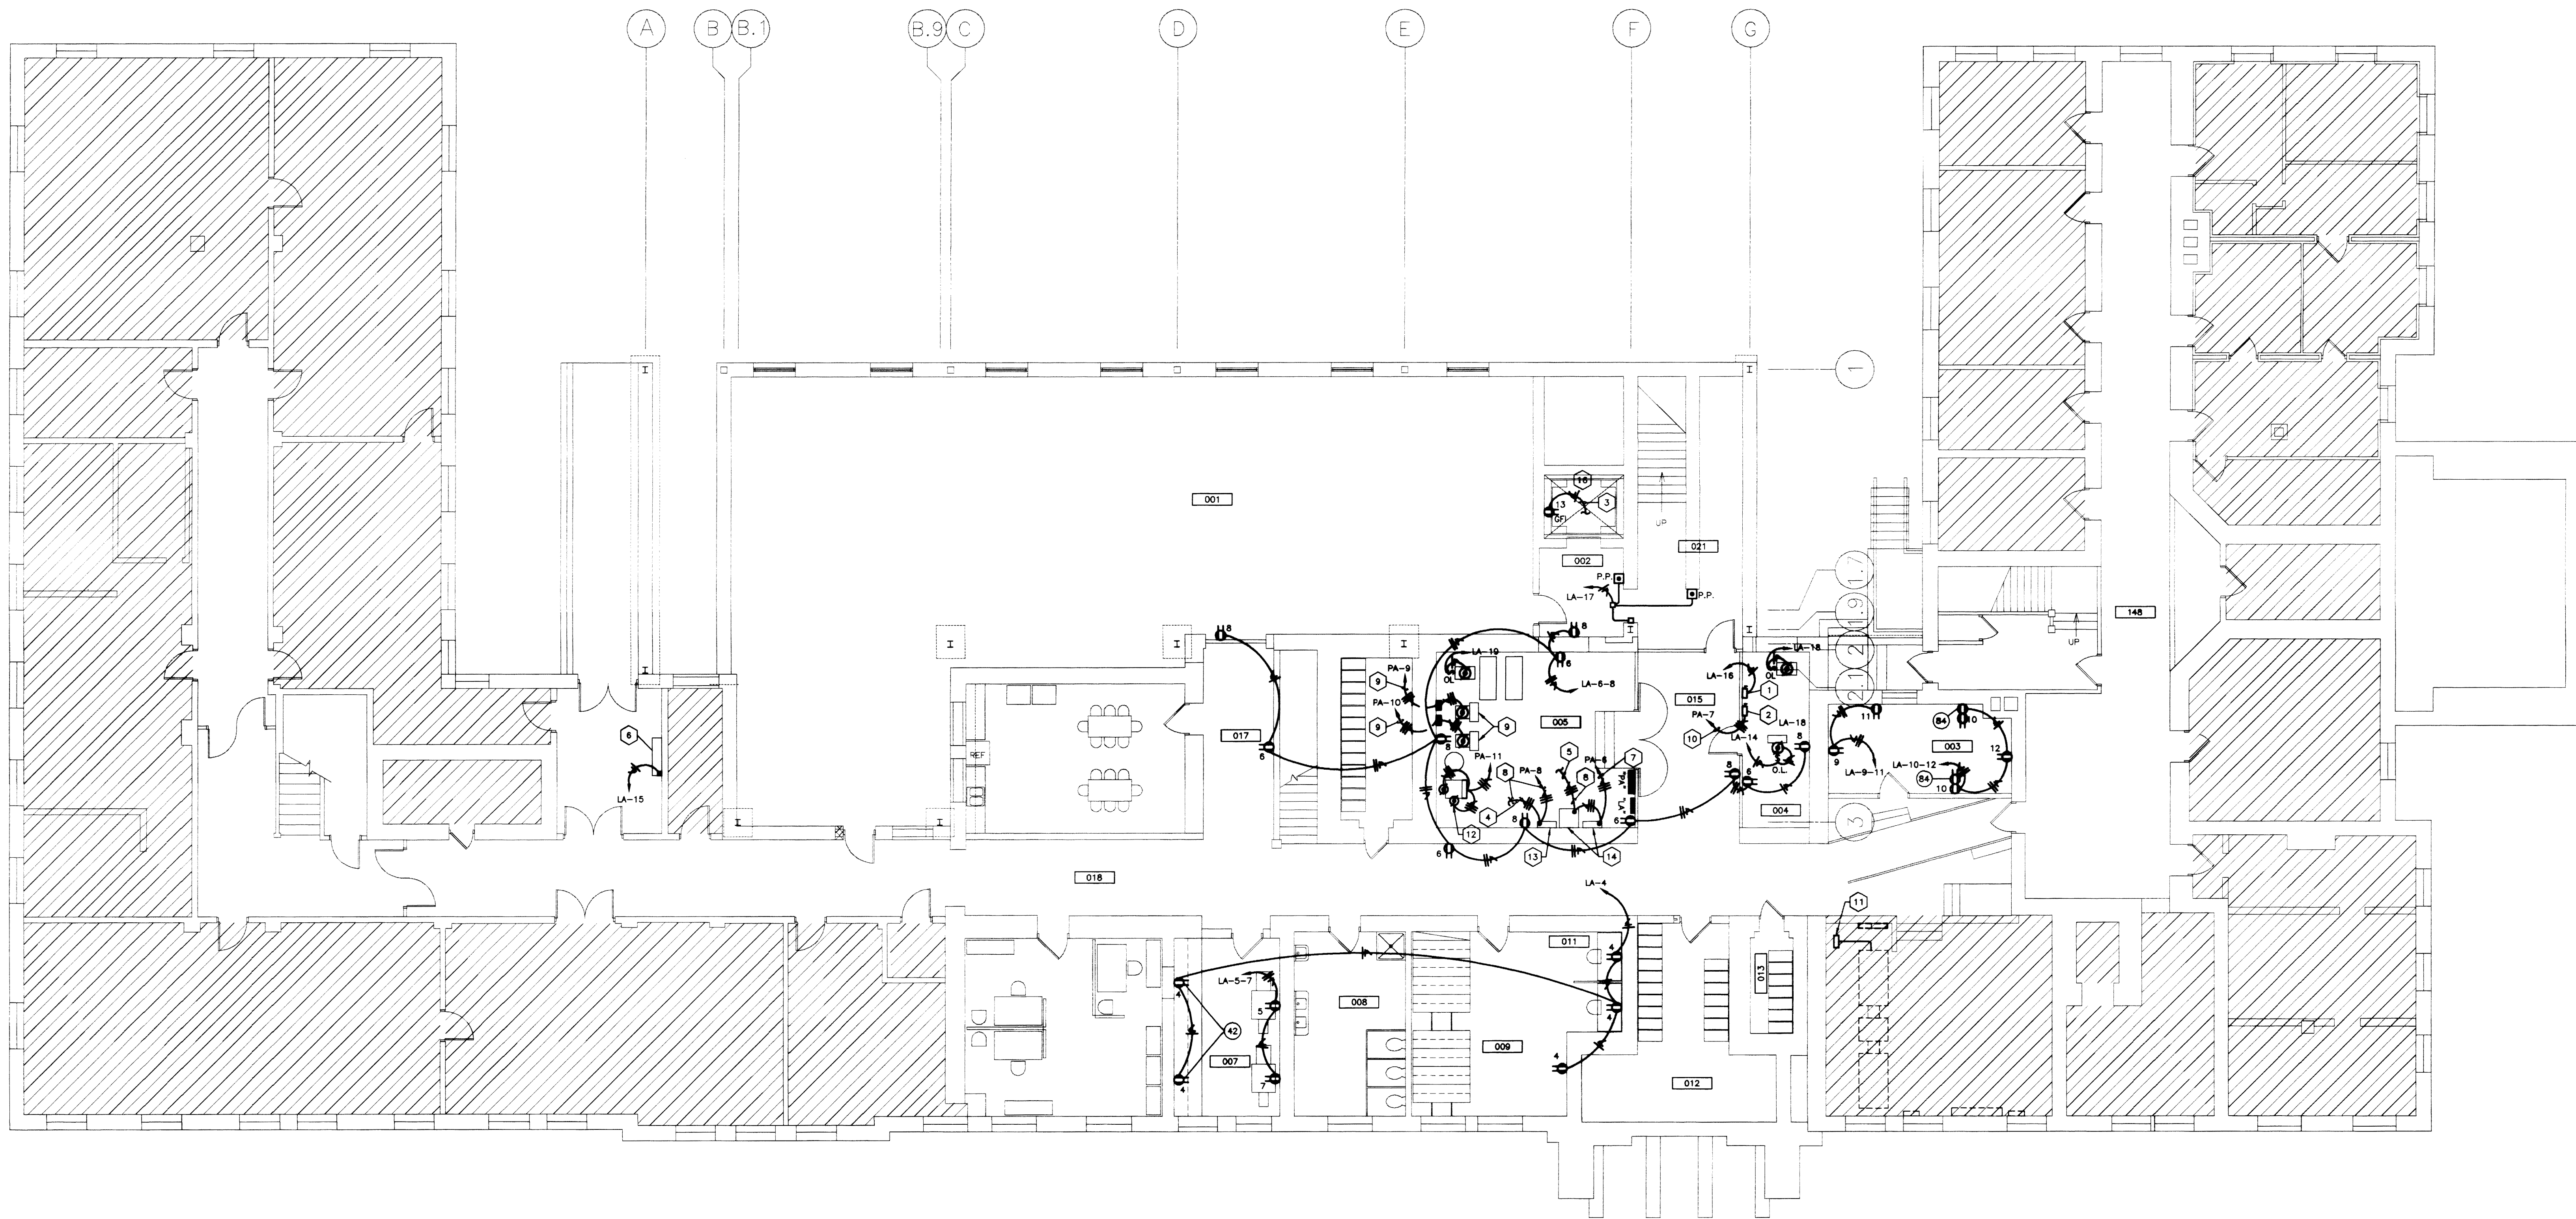

POWER PLAN - BASEMENT








SCALE: 1/8"=1'-0"

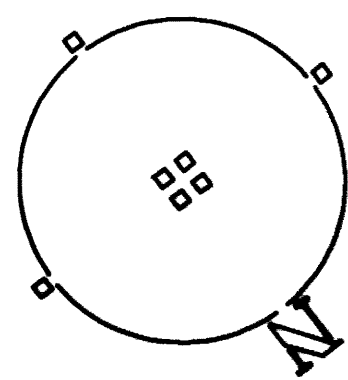


RECORD DRAWINGS DATE 9-8-98
These record drawings have been prepared, in part, on the basis of information compiled and furnished by others. The Engineer will not be responsible for any errors or omissions which have been incorporated into this document as a result.
STAGGS & FISHER CONSULTING ENGINEERS, INC.

DEMOLITION NOTE:
REMOVE ALL ELECTRIC CONNECTIONS TO EQUIPMENT LIGHTS, DEVICES, FIRE ALARM, PHONE, ETC. IN THE AREA TO BE DEMOLISHED. REFER TO ARCHITECTURAL PLANS FOR THE EXTENT OF WORK. REFER TO GENERAL NOTES.


CODED NOTES:	ROOM NO.	ROOM NAME
1 30A. ELEVATOR CAB LIGHT DISCONNECT	001	SHELL SPACE
2 200A. ELEVATOR CONTROLLER WITH AUXILIARY CONTACTS. FUSE IN ACCORDANCE WITH MANUFACTURERS SHOP DRAWINGS.	002	ELEV. LOBBY LEVEL "B"
3 UP TO LIGHT ABOVE.	003	COMMUNICATIONS
4 UP TO RETURN AIR FAN (R-1) ON ROOF. MAKE ELECTRICAL CONNECTION AS REQUIRED.	004	ELEV. MECH.
5 UP TO AIR HANDLING UNIT (AHU-1) ON ROOF. MAKE ELECTRICAL CONNECTION AS REQUIRED.	005	MECHANICAL/ELECTRICAL ROOM
6 CABINET UNIT HEATER 115V./1A.	006	EMPLOYEE RECORDS
7 3/2" O/S AND 1/8" GND. IN 1-1/4" C.	007	WOMEN'S RESTROOM
8 3/2" S AND 1/8" GND. IN 1-1/4" C.	008	TRAINING STORAGE
9 HOT WATER PUMP 2 H.P., 208V./3A.	009	BENEFITS STORAGE
10 3/4" S AND 1/8" GND. IN 1-1/2" C.	010	COPY CENTER
11 NEW 600A. SWITCH SEE ELECTRICAL DISTRIBUTION RISER DIAGRAM.	011	RECORDS
12 CONDENSATE PUMP 3/4 H.P. 208V./3A.	012	CORRIDOR
13 VARIABLE SPEED DRIVE TO FEED RETURN FAN.	013	CORRIDOR
14 ISOLATION TRANSFORMER AND VARIABLE SPEED DRIVE TO SERVE SUPPLY FAN.	014	CORRIDOR
15 AUTOMATIC DOOR SEE SCHEMATIC DRAWING E-10.	015	CORRIDOR
16 INSTALL RECEPTACLE IN ACCORDANCE WITH ELEVATOR MANUFACTURERS INSTRUCTIONS.	016	CORRIDOR
	017	CORRIDOR
	018	CORRIDOR
	019	CORRIDOR
	020	CORRIDOR
	021	STAIR
	022	CORRIDOR
	023	CORRIDOR

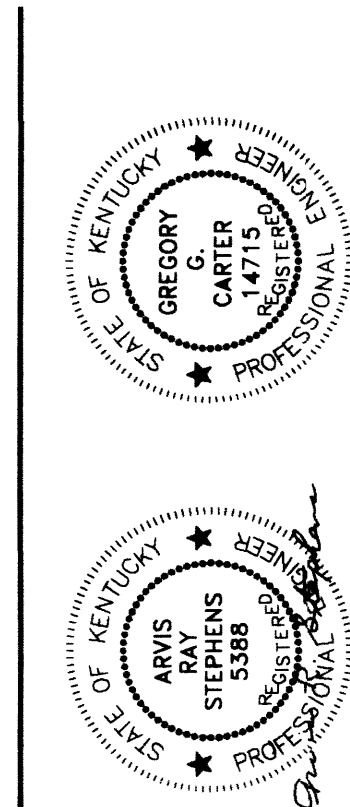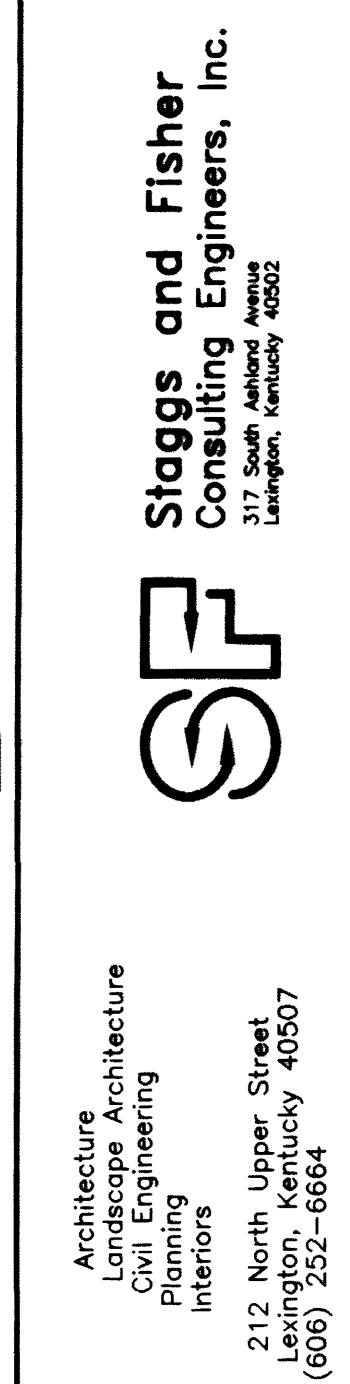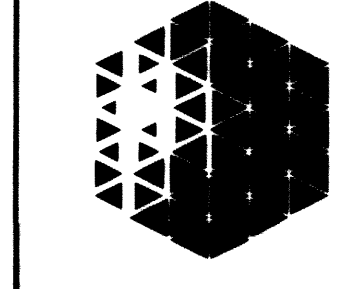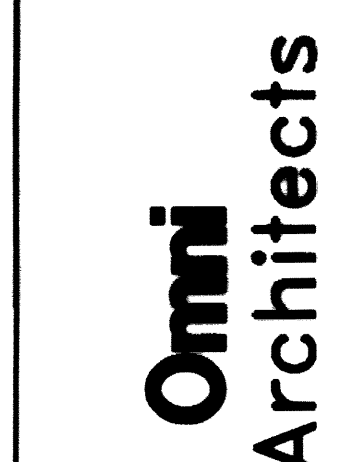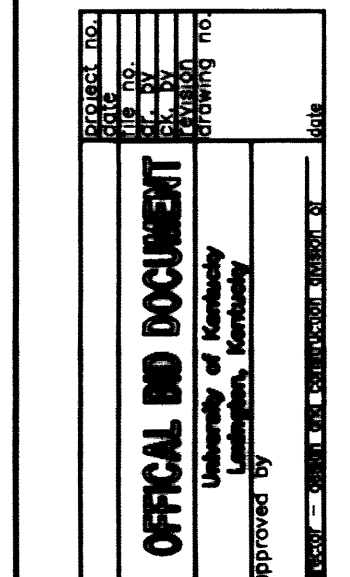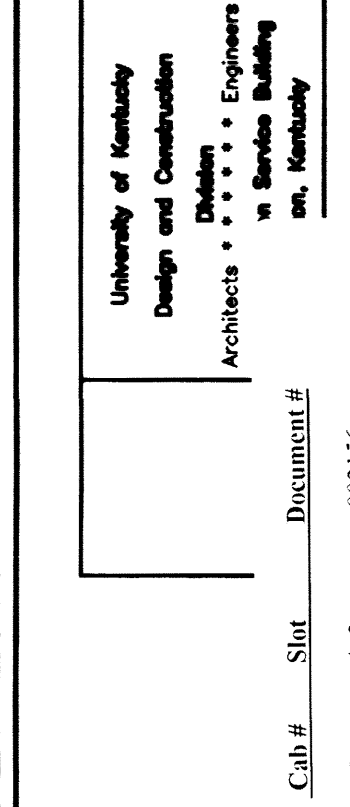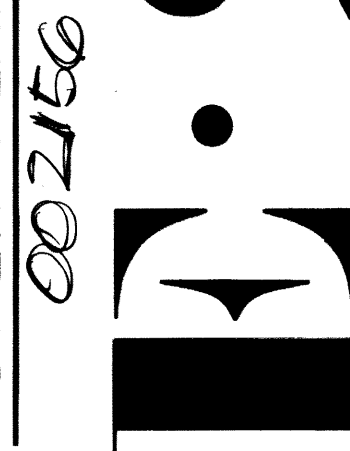

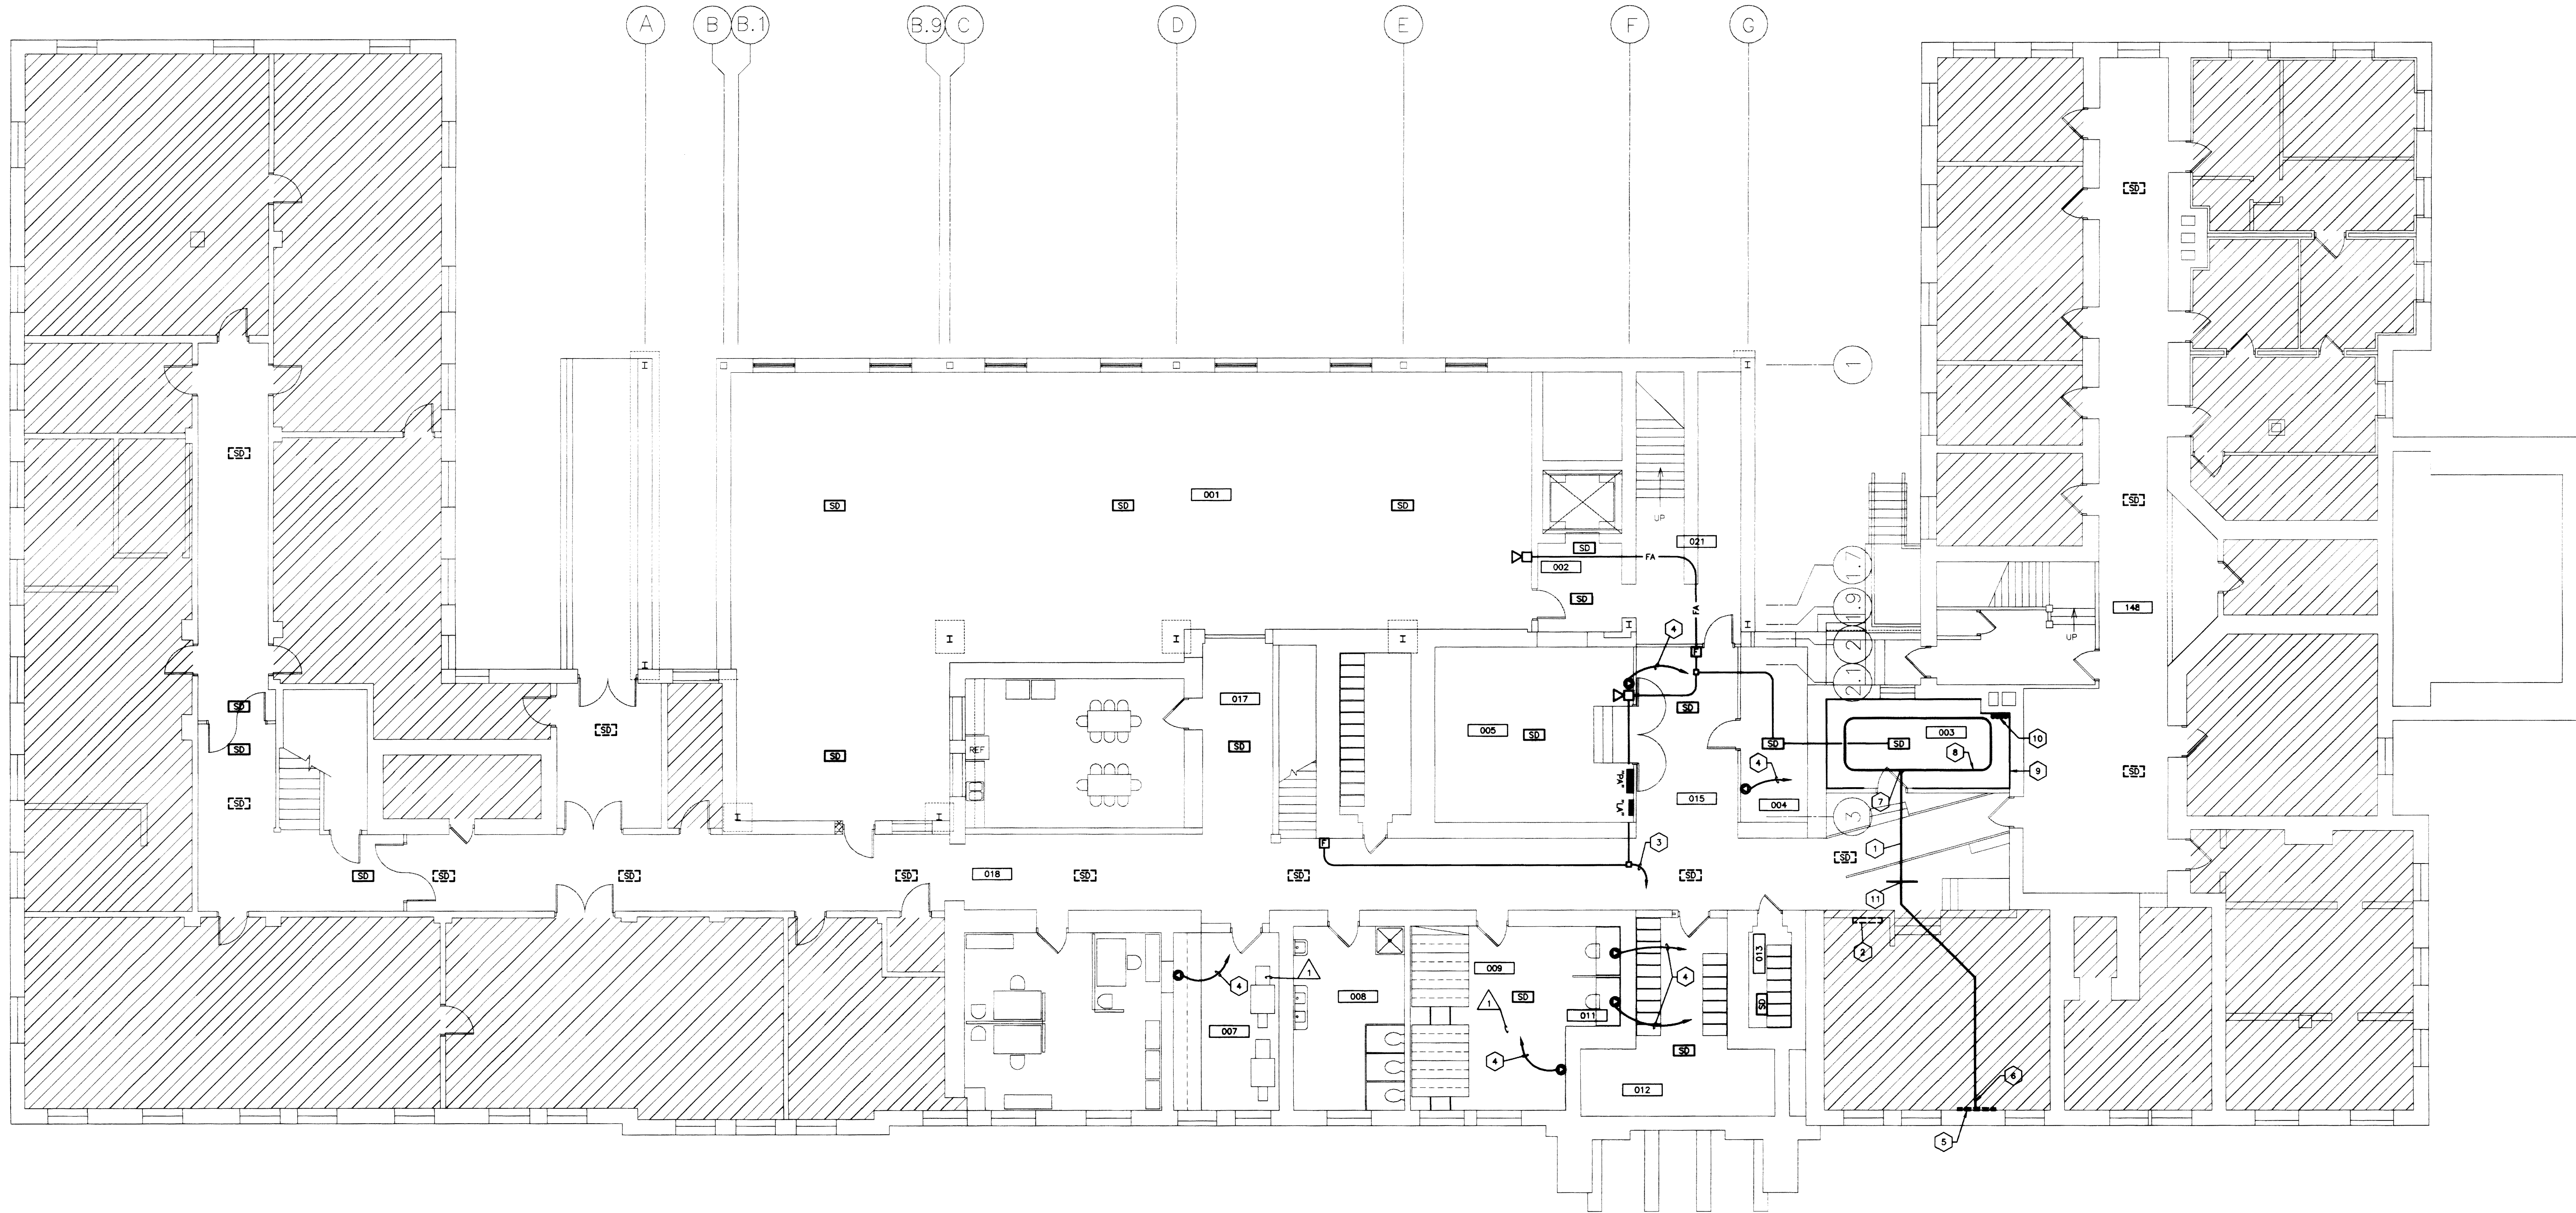

COMMUNICATIONS PLAN - BASEMENT

SCALE: 1/8"=1'-0"

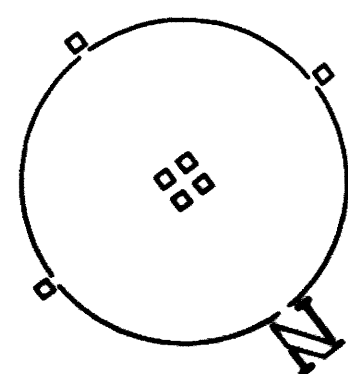

- CODED NOTES:
- 1 NEW 10"x10" WIREWAY.
 - 2 EXISTING FIRE ALARM CONTROL PANEL TO REMAIN, MODIFY AS REQUIRED TO ACCOMMODATE NEW DEVICES AND ZONES.
 - 3 CONNECT TO EXISTING FIRE ALARM SYSTEM.
 - 4 1" C. TO COMMUNICATION CLOSET.
 - 5 EXISTING COMMUNICATION SERVICE ENTRANCE.
 - 6 90 WIREWAY DOWN OVER COMMUNICATIONS BOARD.
 - 7 90 WIREWAY DOWN OVER CABLE TRAY.
 - 8 18"x3" CABLE TRAY - INSTALL 9'-0" A.F.F.
 - 9 3/4"x8'-0" HIGH FIRE RETARDANT PLYWOOD ALL AROUND ROOM.
 - 10 4" CONDUIT UP TO 1ST AND 2ND FLOOR.
 - 11 PROVIDE TEE WIRE BLANK END CAPS FOR FUTURE EXTENSION.

ROOM NO.	ROOM NAME
001	SHELL SPACE
002	ELEV. LOBBY LEVEL "B"
003	COMMUNICATIONS
004	ELEV. MECH.
005	MECHANICAL/ELECTRICAL ROOM
007	EMPLOYEE RECORDS
008	WOMEN'S RESTROOM
009	TRAINING STORAGE
011	BENEFITS STORAGE
012	COPY CENTER
013	RECORDS
015	CORRIDOR
016	CORRIDOR
017	CORRIDOR
018	CORRIDOR
020	CORRIDOR
021	STAIR
148	CORRIDOR

RECORD DRAWINGS DATE 9-2-95

These record drawings have been prepared, in part, on the basis of information compiled and furnished by others. The Engineer will not be responsible for any errors or omissions which have been incorporated into this document as a result.

STAGGS & FISHER CONSULTING ENGINEERS, INC.




DEMOLITION NOTE:

REMOVE ALL ELECTRIC CONNECTIONS TO EQUIPMENT LIGHTS, DEVICES, FIRE ALARM, PHONE, ETC. IN THE AREA TO BE DEMOLISHED. REFER TO ARCHITECTURAL PLANS FOR THE EXTENT OF WORK. REFER TO GENERAL NOTES.


SCOVELL HALL RENOVATION

COMMUNICATIONS PLAN - BASEMENT

002/57

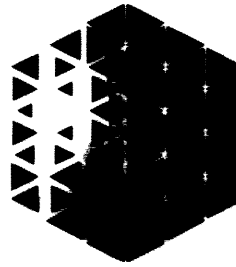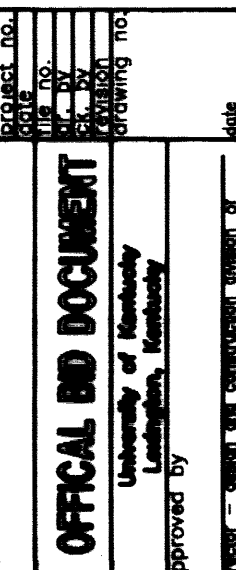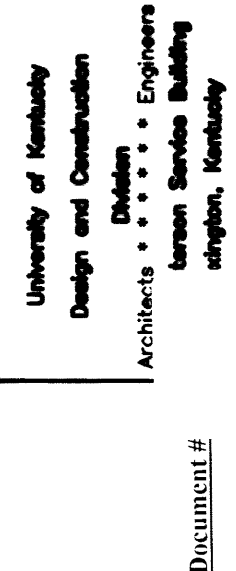

Architecture
Landscape Architecture
Civil Engineering
Planning
Interiors
212 North Upper Street
Lexington, Kentucky 40507
(606) 232-6864

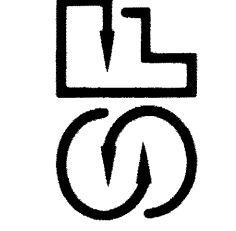

Staggs and Fisher
Consulting Engineers, Inc.
317 South Walnut Street
Lexington, Kentucky 40502

UNIVERSITY OF KENTUCKY

Revisions:

Checked: GGC

Date: APRIL 1994

Job No: 9385.00

Drawn By: WTC


Architect

Engineer

Planner

Interior

This drawing and those shown herein are the property of Staggs and Fisher Consulting Engineers, Inc. No reproduction or use of this drawing without the written consent of Staggs and Fisher Consulting Engineers, Inc. is permitted.

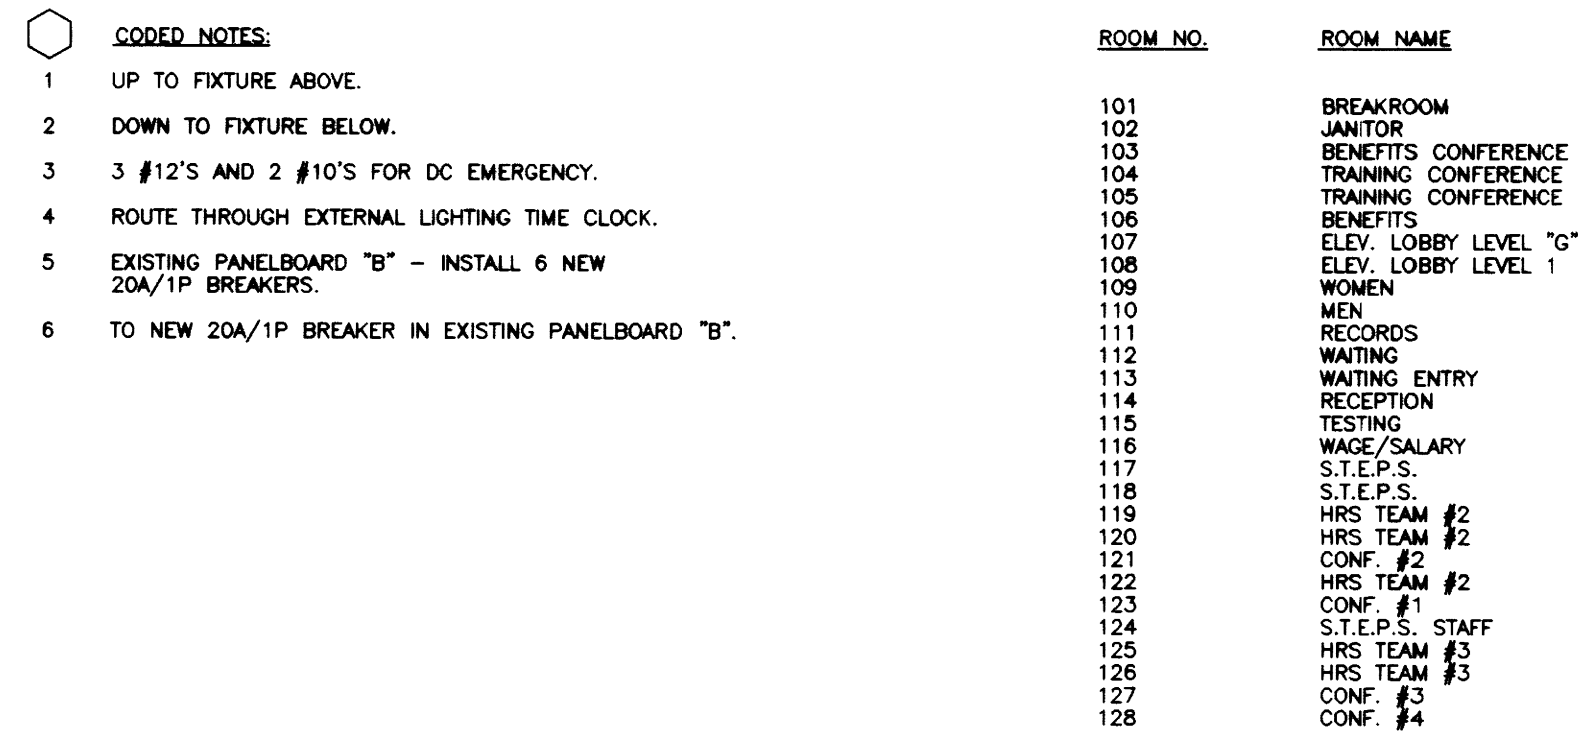


SCALE: 1/8"=1'-0"

These record drawings have been prepared, in part, on the basis of information compiled and furnished by others. The Engineer will not be responsible for any errors or omissions which have been incorporated into this document as a result.

STAGGS & FISHER CONSULTING ENGINEERS, INC.

DEMOLITION NOTE:

REMOVE ALL ELECTRIC CONNECTIONS TO EQUIPMENT LIGHTS, DEVICES, FIRE ALARM, PHONE, ETC. IN THE AREA TO BE DEMOLISHED. REFER TO ARCHITECTURAL PLANS FOR THE EXTENT OF WORK. REFER TO GENERAL NOTES.

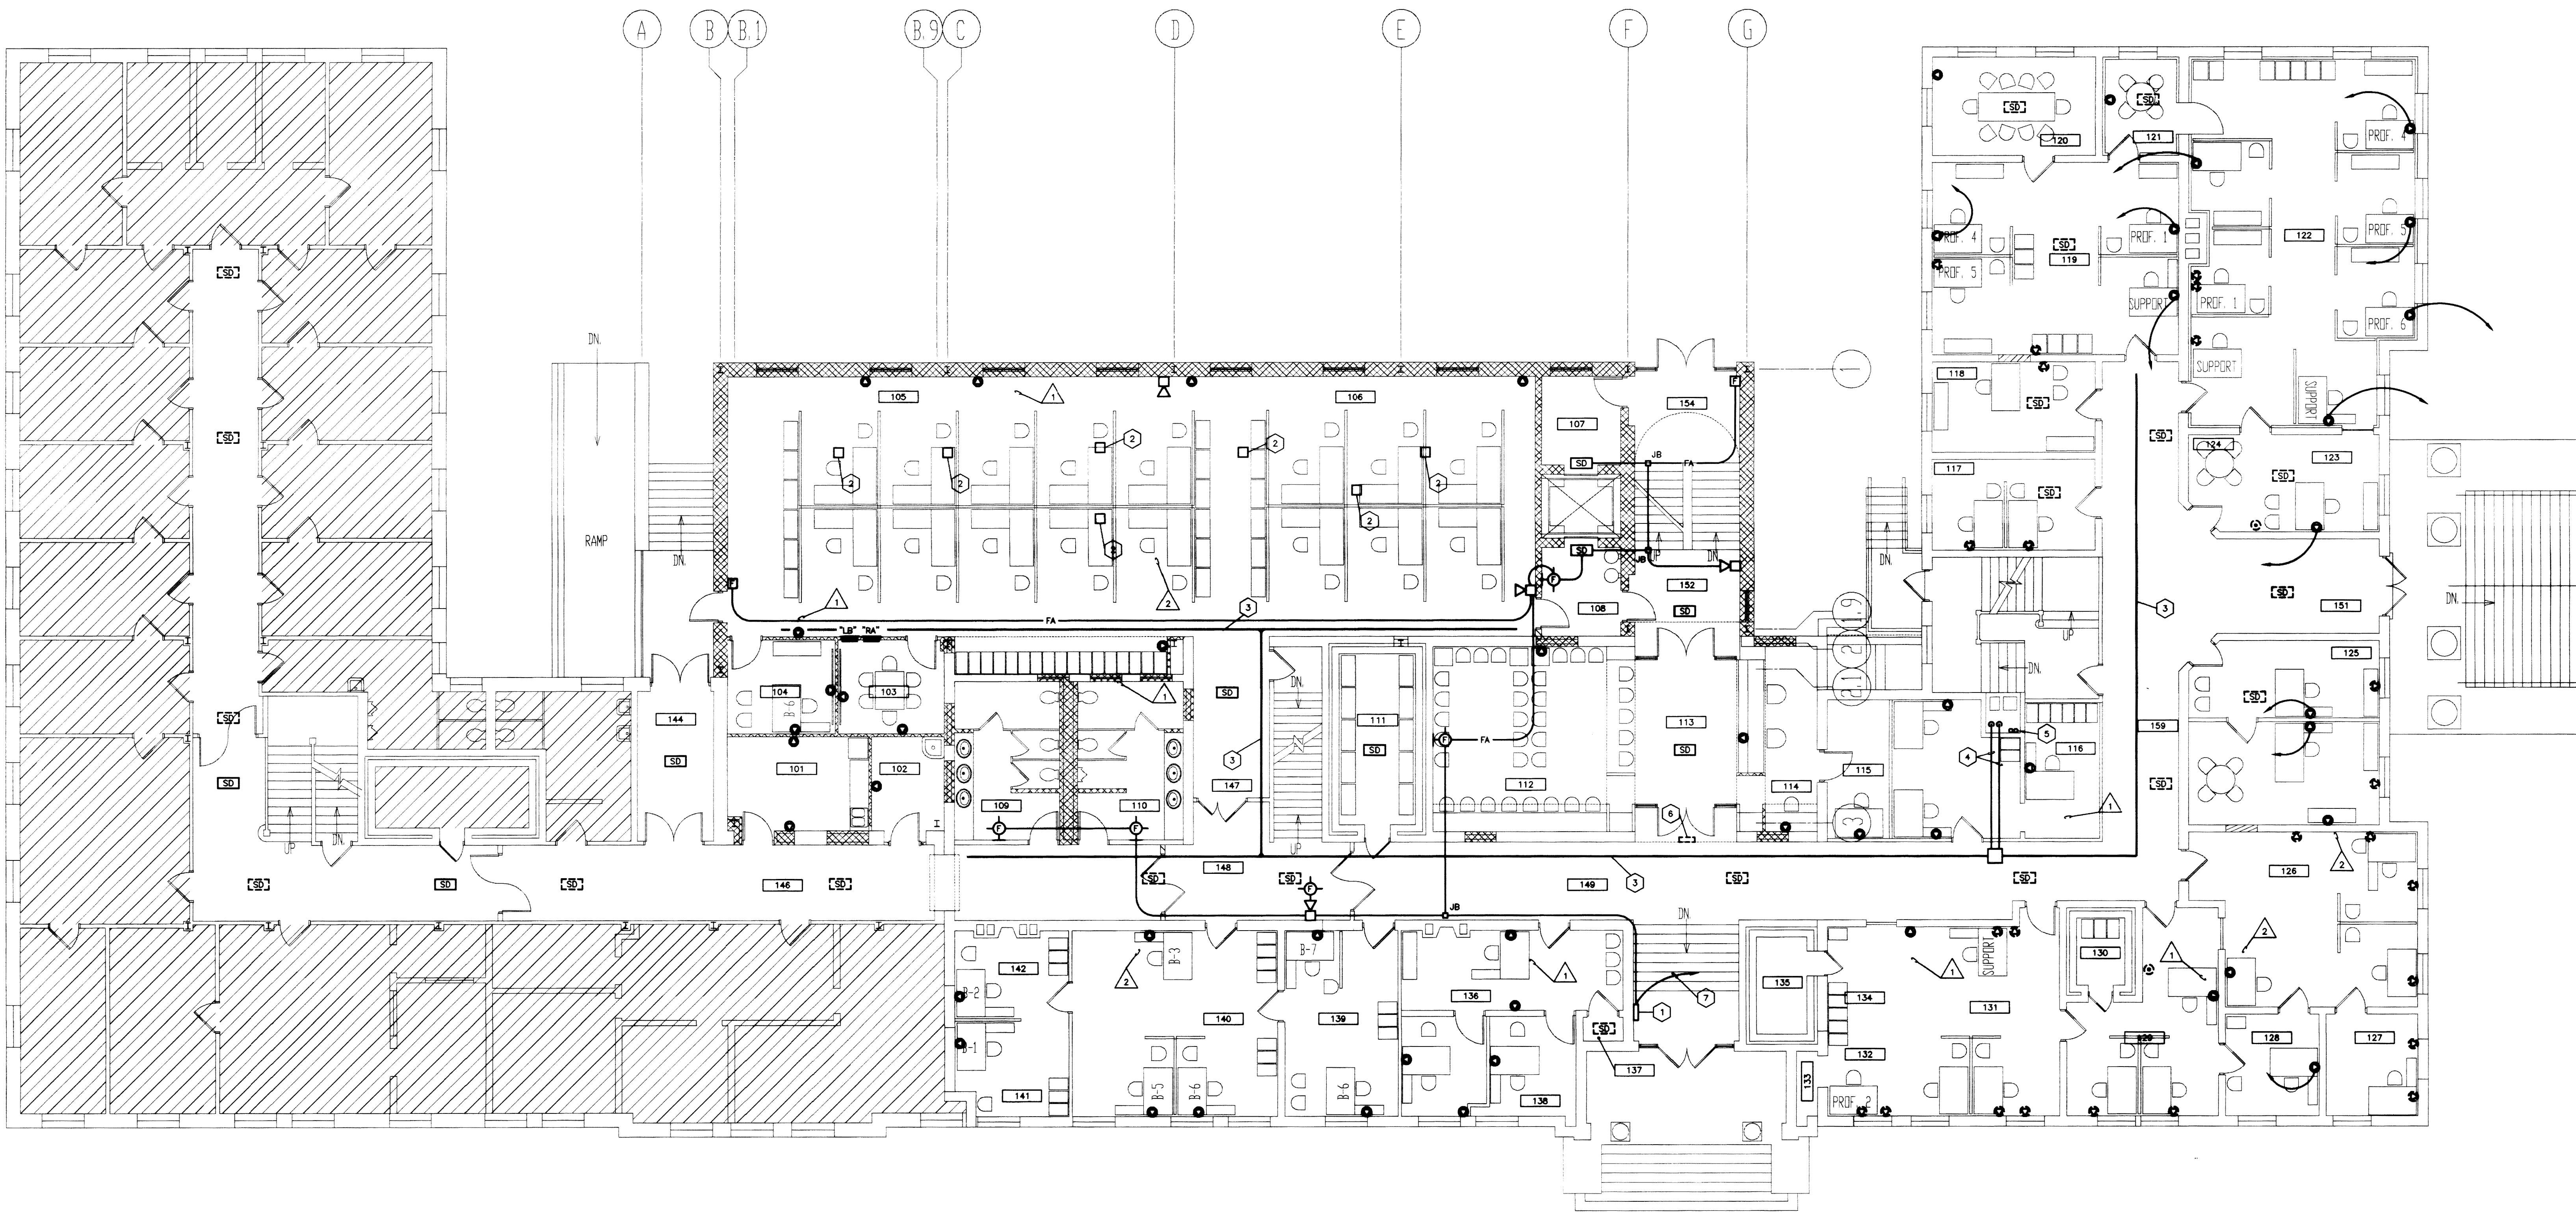

COMMUNICATIONS PLAN - FIRST FLOOR

SCALE: 1/8"=1'-0"

- CODED NOTES:
1. NEW LOCATION OF FIRE ALARM ANNUNCIATOR.
 2. NEW COMMUNICATION/POWER POLE.
 3. 6X6 WIREWAY ABOVE FINISHED CEILING.
 4. 2-4" DOWN TO COMMUNICATION ROOM IN BASEMENT.
 5. CONDUITS UP TO SECOND FLOOR AND DOWN TO BASEMENT.
 6. EXISTING FIRE ALARM ANNUNCIATOR TO BE REMOVED.
 7. CONNECT TO EXISTING FIRE ALARM SYSTEM.

ROOM NO.	ROOM NAME
101	BREAKROOM
102	JANITOR
103	BENEFITS CONFERENCE
104	TRAINING CONFERENCE
105	BENEFITS
106	ELEV. LOBBY LEVEL "D"
107	ELEV. LOBBY LEVEL "D"
108	WOMEN
109	MEN
110	RECORDS
111	WAITING ENTRY
112	RECEPTION
113	TESTING
114	WAGE/SALARY
115	S.T.E.P.S.
116	HRS TEAM #2
117	HRS TEAM #2
118	HRS TEAM #2
119	CONF #1
120	CONF #2
121	CONF #3
122	S.T.E.P.S. STAFF
123	HRS TEAM #3
124	HRS TEAM #3
125	HRS TEAM #3
126	CONF #4
127	CONF #4
128	CONF #4

RECORD DRAWINGS DATE 9-8-95

These record drawings have been prepared, in part, on the basis of information compiled and furnished by others. The Engineer will not be responsible for any errors or omissions which have been incorporated into this document as a result.

STAGGS & FISHER CONSULTING ENGINEERS, INC.

DEMOLITION NOTE:
REMOVE ALL ELECTRIC CONNECTIONS TO EQUIPMENT LIGHTS, DEVICES, FIRE ALARM, PHONE, ECT. IN THE AREA TO BE DEMOLISHED. REFER TO ARCHITECTURAL PLANS FOR THE EXTENT OF WORK. REFER TO GENERAL NOTES.

UNIVERSITY OF KENTUCKY

SCOVELL HALL RENOVATION

COMMUNICATIONS PLAN - FIRST FLOOR




Job No: 9385.00

Date: APRIL 1994


Drawn By: WTG

Checked: GOC



Revisions:

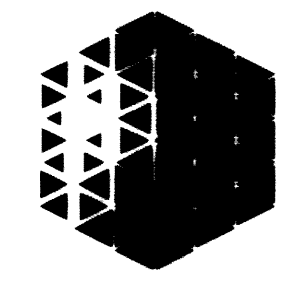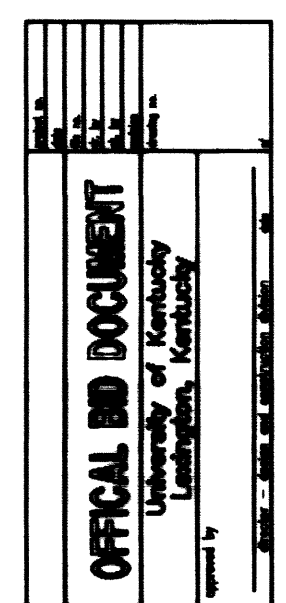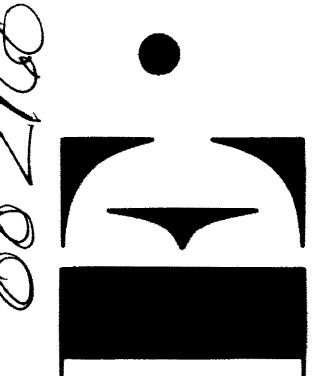


Stagg & Fisher
Consulting Engineers, Inc.
212 North Upper Street
Lexington, Kentucky 40507
(606) 252-6664

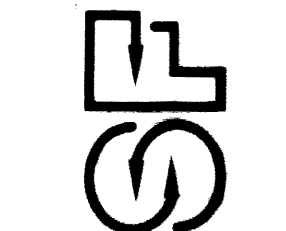

Stagg & Fisher
Consulting Engineers, Inc.
212 North Upper Street
Lexington, Kentucky 40507
(606) 252-6664

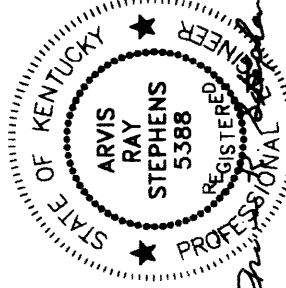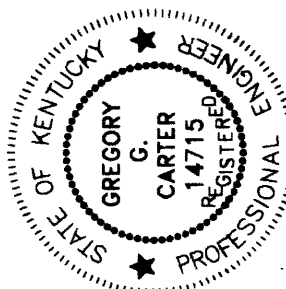

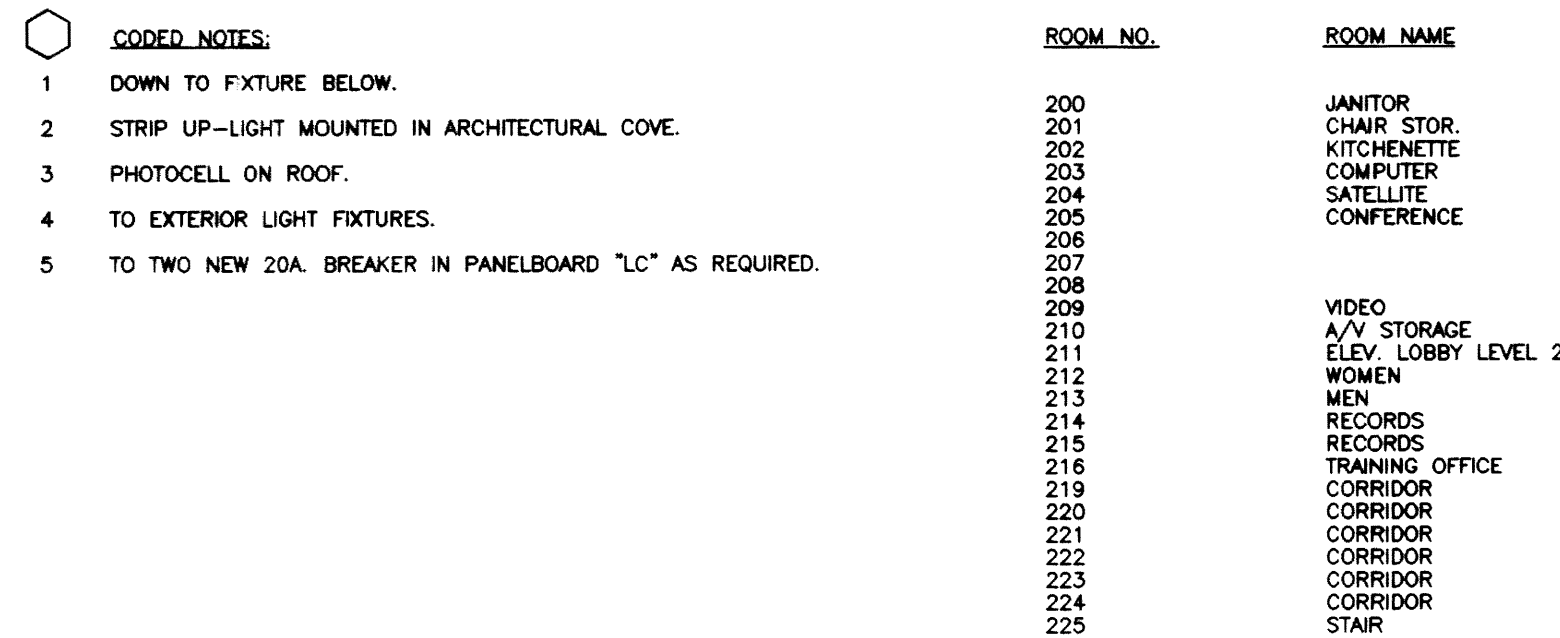


SCALE: 1/8"=1'-0"

RECORD DRAWINGS .. DATE 9-8-96

These record drawings have been prepared, in part, on the basis of information compiled and furnished by others. The Engineer will not be responsible for any errors or omissions which have been incorporated into this document as a result

EMOTION NOTE:

REMOVE ALL ELECTRIC CONNECTIONS TO EQUIPMENT LIGHTS, DEVICES, FIRE ALARM, PHONE, ETC. IN THE AREA TO BE DEMOLISHED. REFER TO ARCHITECTURAL PLANS FOR THE EXTENT OF WORK. REFER TO GENERAL NOTES.

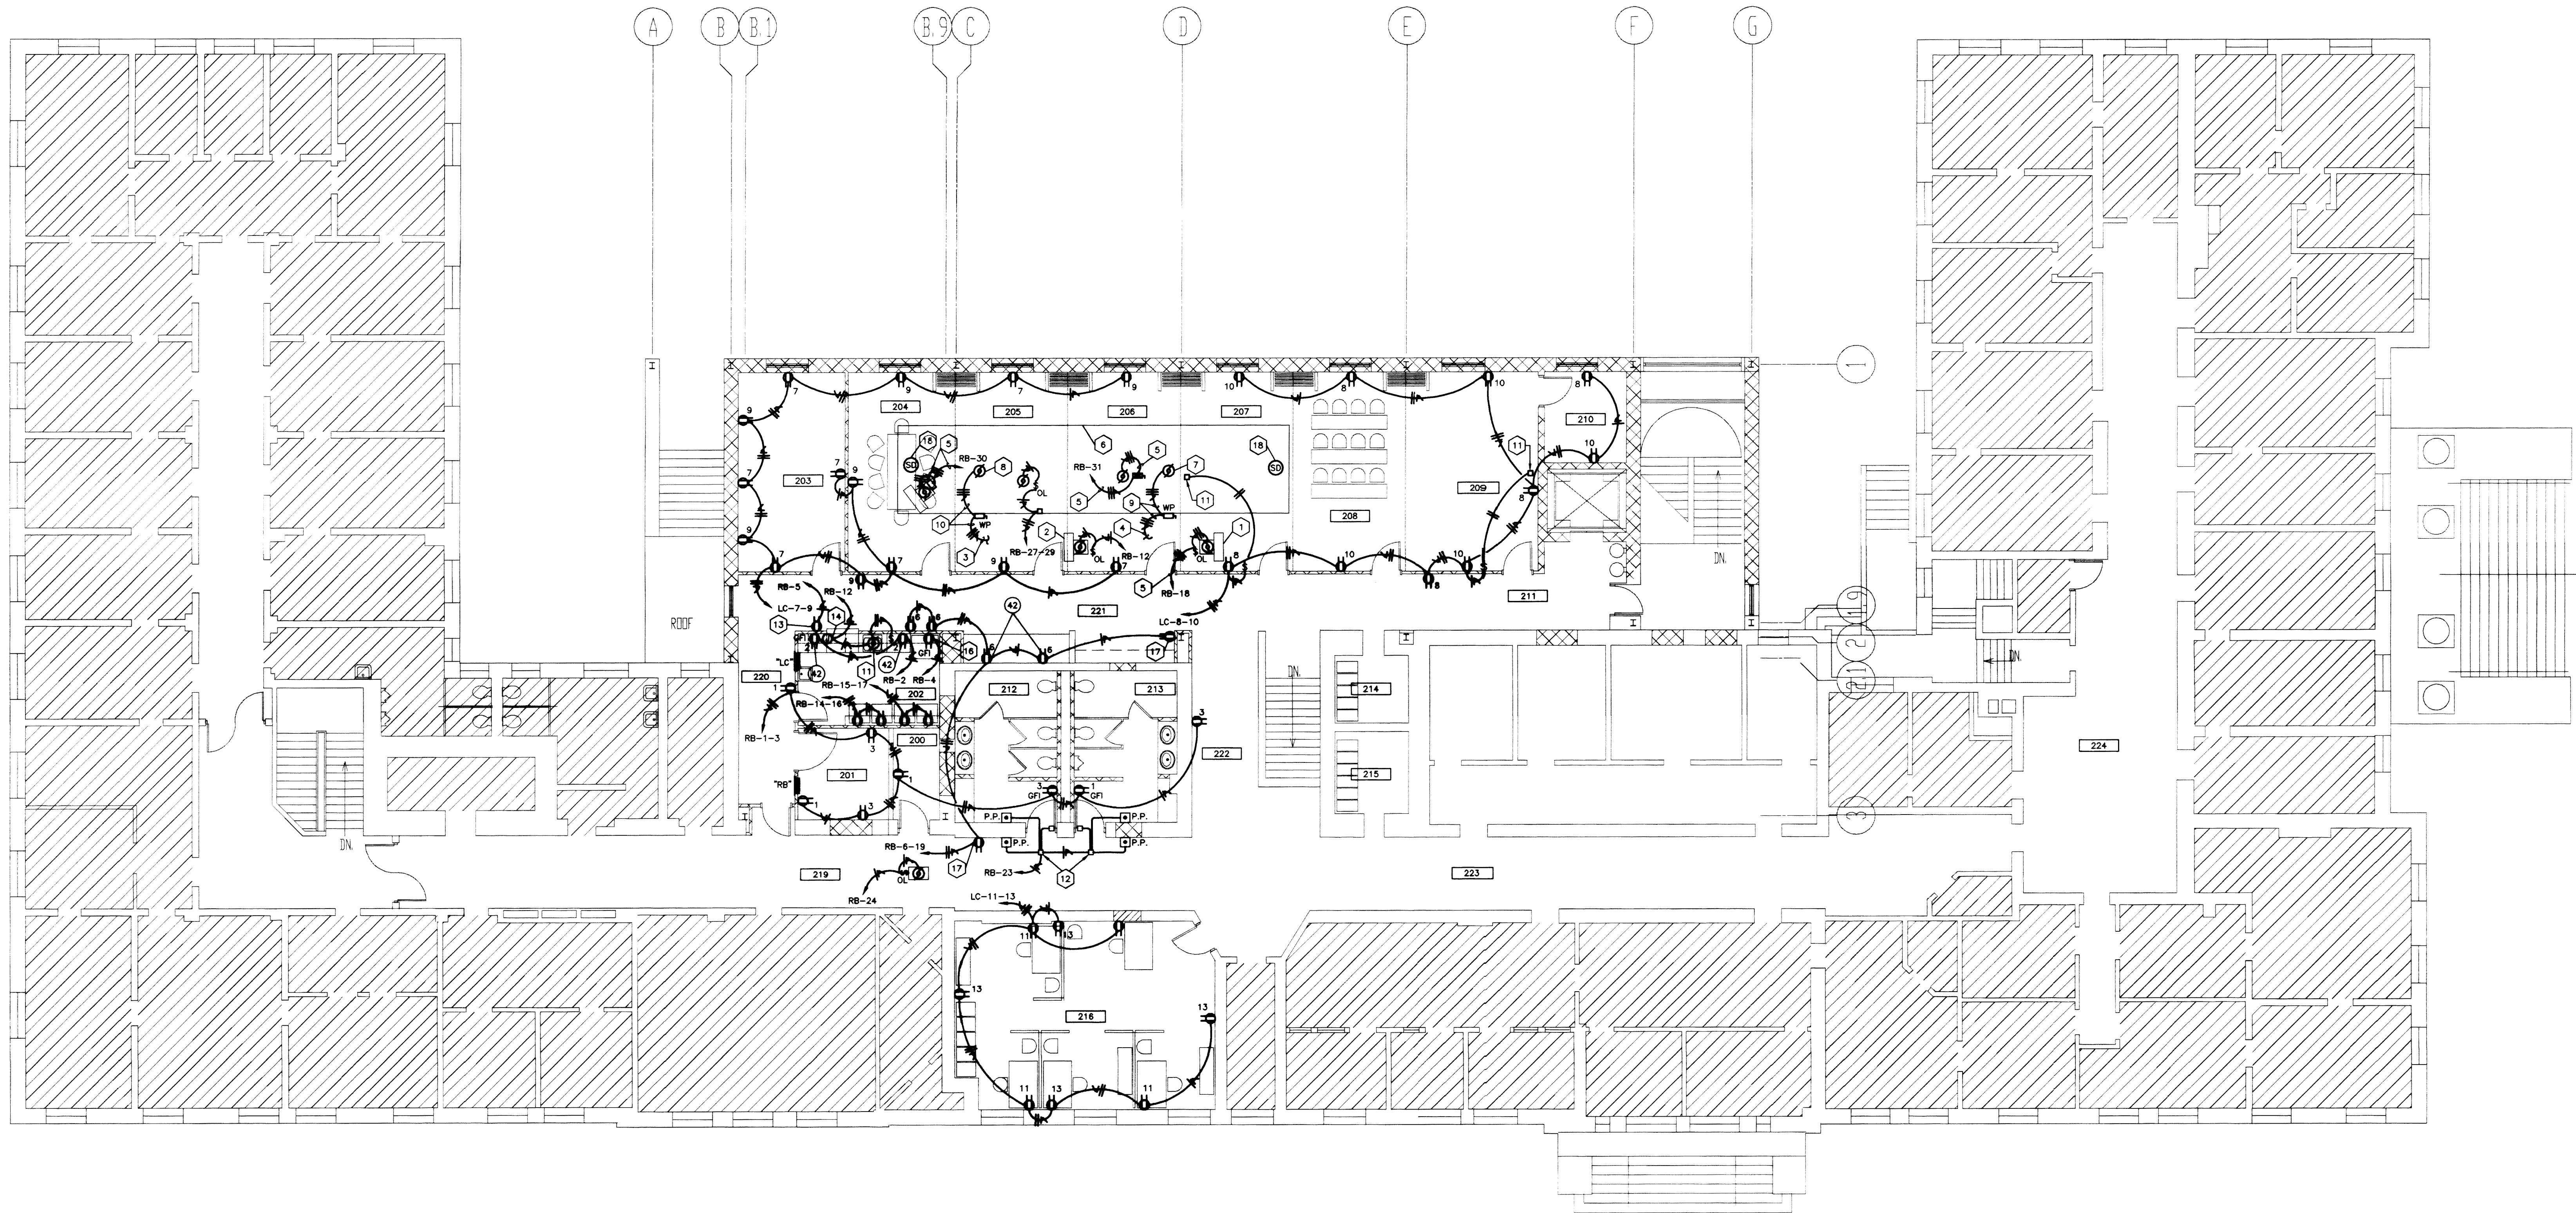

POWER PLAN - SECOND FLOOR

SCALE: 1/8"=1'-0"

- CODED NOTES:**
1. CHILLED WATER PUMP ON ROOF.
 2. HOT WATER PUMP ON ROOF.
 3. DOWN TO VARIABLE FREQUENCY DRIVE IN ROOM 005, MAKE CONNECTION AS REQUIRED.
 4. DOWN TO STEP-UP TRANSFORMER IN ROOM 005, MAKE CONNECTION AS REQUIRED.
 5. 3 #12'S AND 1 #12 GROUND IN 3/4" CONDUIT.
 6. AIR HANDLING UNIT ON ROOF.
 7. 208V/3Ø SUPPLY AIR FAN AHU-1 ON ROOF.
 8. 208V/3Ø RETURN AIR FAN R-1 ON ROOF.
 9. 3 #2 AND 1 #6 GROUND IN 1/4" CONDUIT.
 10. 3 #2 AND 1 #6 GROUND IN 1/4" CONDUIT.
 11. MAKE CONNECTION TO AUTOMATIC SCREEN AS REQUIRED.
 12. AUTOMATIC DOOR SEE SCHEMATIC DRAWING E-10.
 13. OUTLET FOR ICE MAKER.
 14. OUTLET FOR DISHWASHER.
 15. OUTLET FOR GARBAGE GRINDER.
 16. OUTLET FOR REFRIGERATOR.
 17. OUTLET FOR ELECTRIC WATER COOLER, ROUGH-IN IN ACCORDANCE WITH MANUFACTURERS INSTRUCTIONS.
 18. DUCT SMOKE DETECTOR IN AIR HANDLING UNIT ON ROOF.

ROOM NO.	ROOM NAME
200	JANITOR
201	CHAR. STOR.
202	KITCHENETTE
203	COMPUTER
204	SATELLITE
205	CONFERENCE
206	
207	
208	
209	VIDEO
210	A/V STORAGE
211	ELEV. LOBBY LEVEL 2
212	WOMEN
213	MEN
214	RECORDS
215	RECORDS
216	TRAINING OFFICE
217	CORRIDOR
218	CORRIDOR
219	CORRIDOR
220	CORRIDOR
221	CORRIDOR
222	CORRIDOR
223	CORRIDOR
224	STAIR

RECORD DRAWINGS DATE 9-8-95

These record drawings have been prepared, in part, on the basis of information compiled and furnished by others. The Engineer will not be responsible for any errors or omissions which have been incorporated into this document as a result.

STAGGS & FISHER CONSULTING ENGINEERS, INC.


DEMOLITION NOTE:

REMOVE ALL ELECTRIC CONNECTIONS TO EQUIPMENT LIGHTS, DEVICES, FIRE ALARM, PHONE, ETC. IN THE AREA TO BE DEMOLISHED. REFER TO ARCHITECTURAL PLANS FOR THE EXTENT OF WORK. REFER TO GENERAL NOTES.

SCOVELL HALL RENOVATION

POWER PLAN - SECOND FLOOR


002102

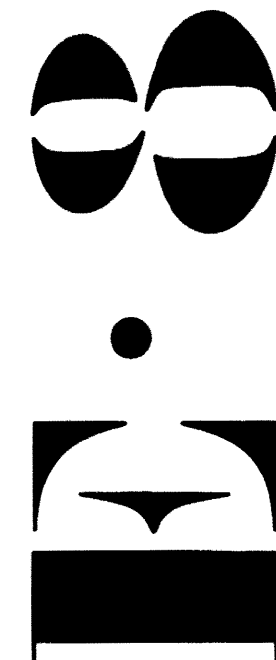

University of Kentucky
Design and Construction
Products in Service Building
Lexington, Kentucky



OFFICIAL AND DOCUMENT
University of Kentucky
Lexington, Kentucky

Omni Architects

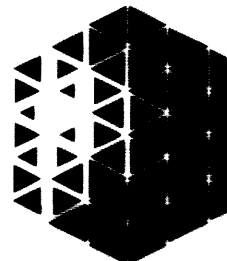


Architecture
Interior Design
Civil Engineering
Planning
212 North Upper Street
Lexington, Kentucky 40507
(606) 252-6664

Staggs and Fisher Consulting Engineers, Inc.

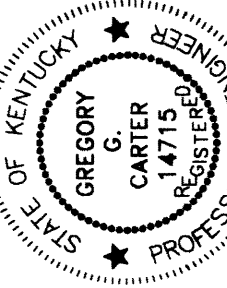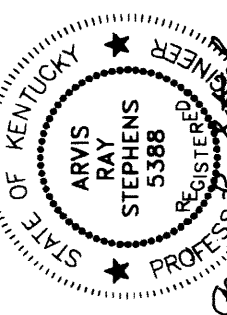

UNIVERSITY OF KENTUCKY

This Drawing and Design shown herein are the property of Staggs and Fisher Consulting Engineers, Inc. The reproduction, copying or other use of this Drawing without the written consent of Staggs and Fisher Consulting Engineers, Inc. is prohibited.

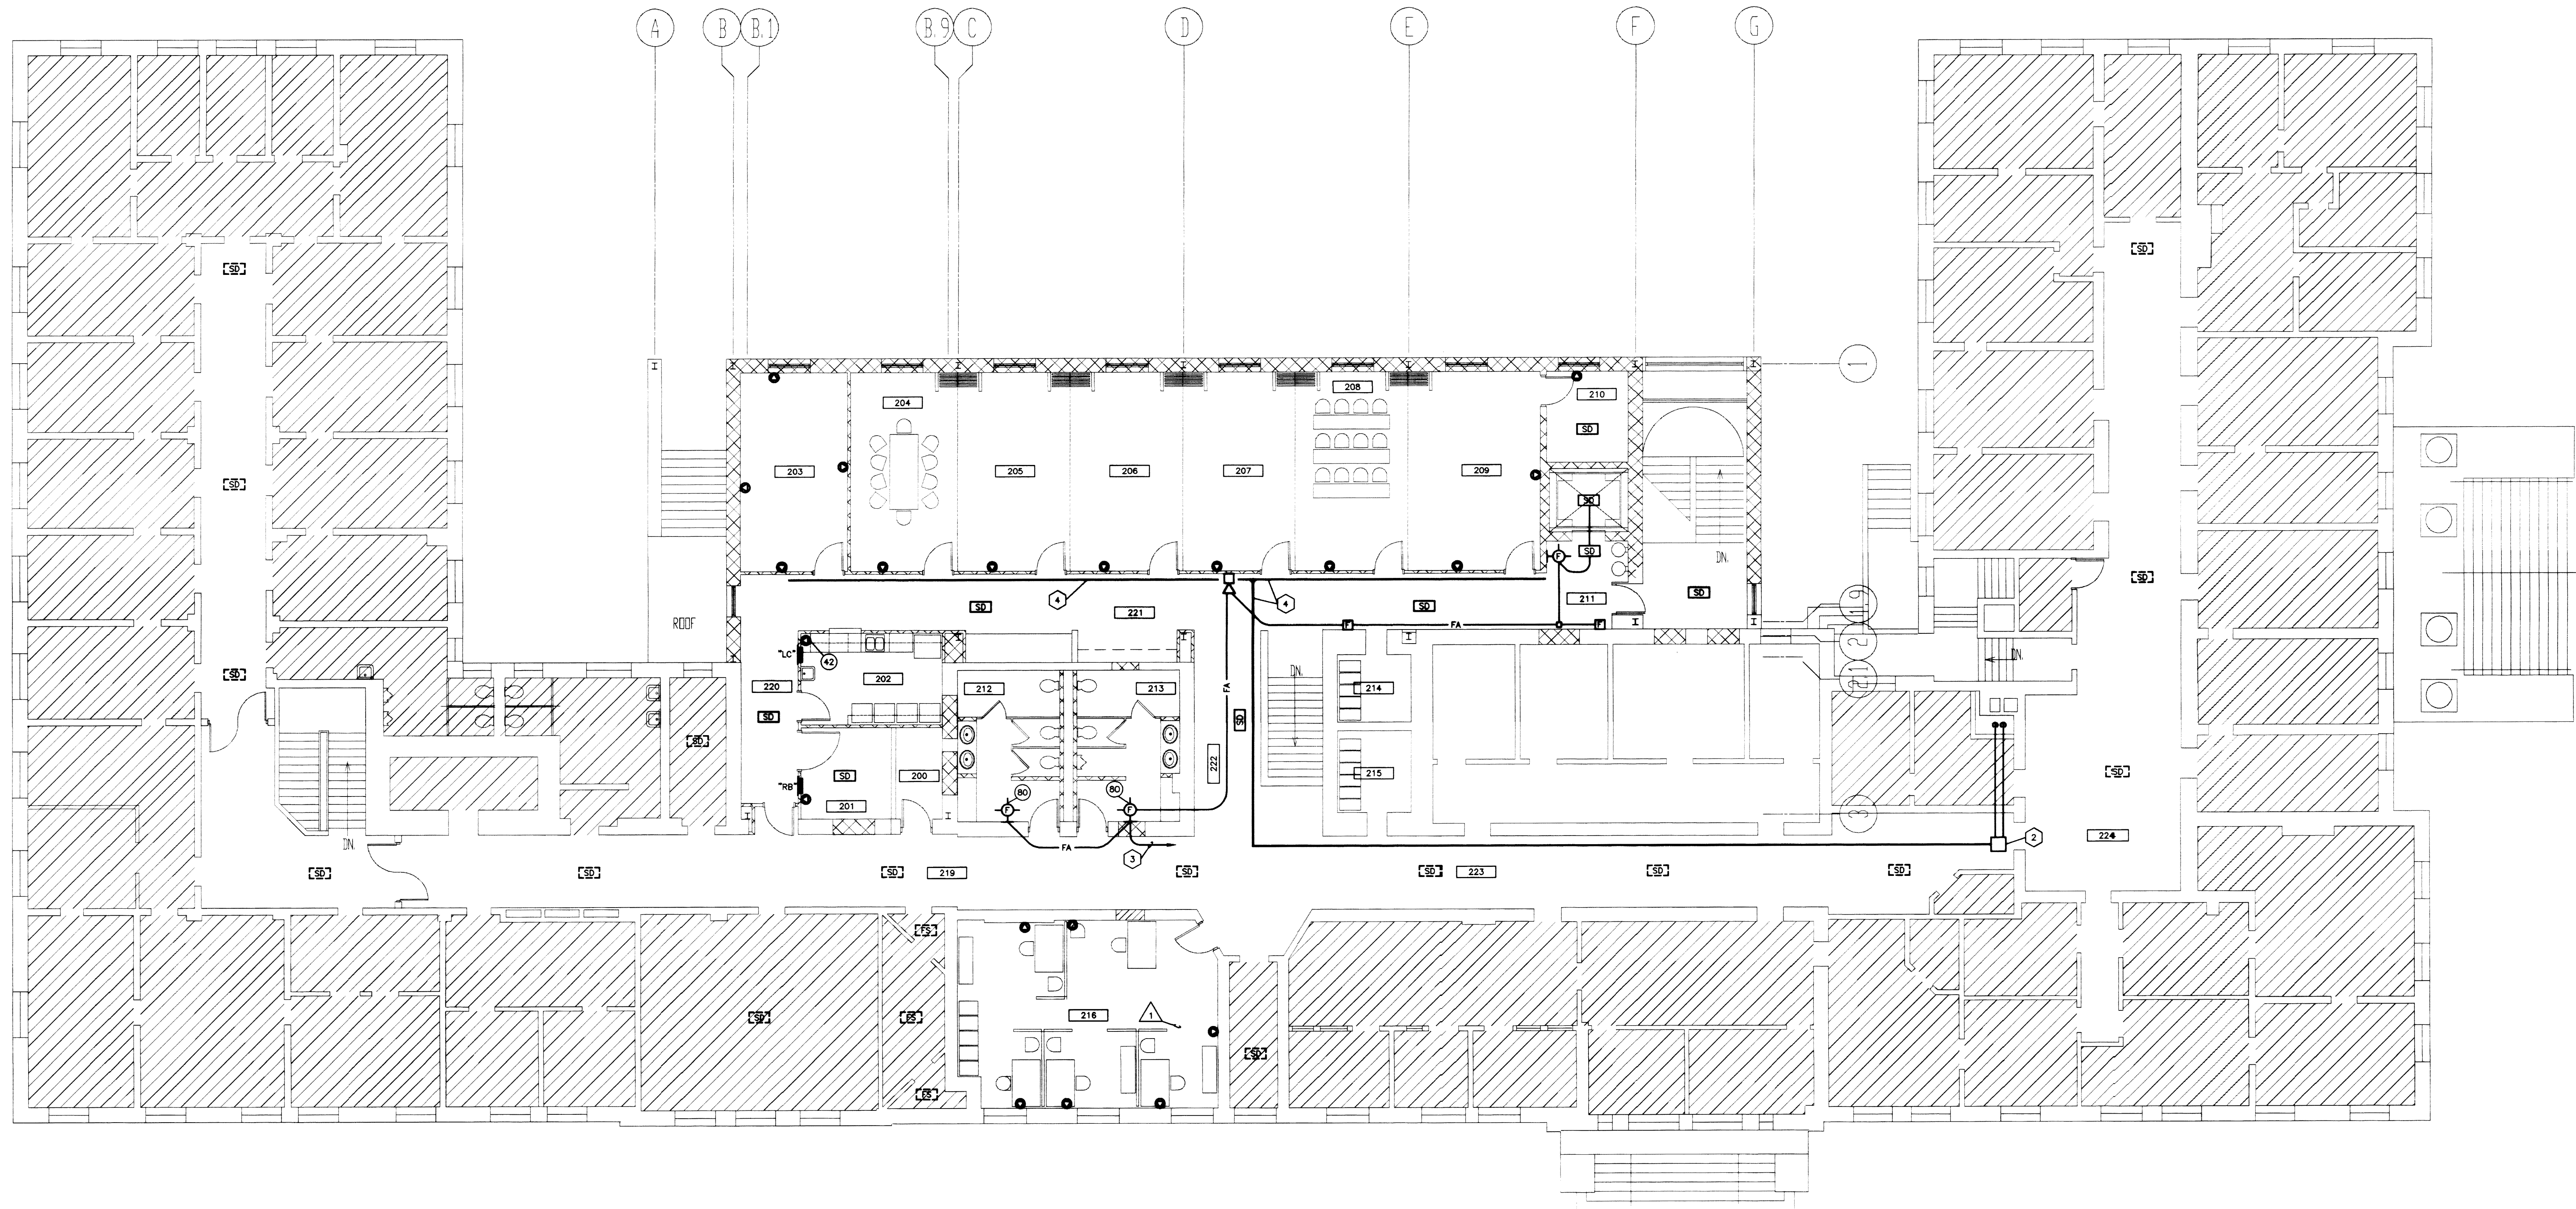

LOW-VOLTAGE PLAN - SECOND FLOOR

SCALE: 1/8"=1'-0"

- CODED NOTES:
- 1 2-4" C. DOWN TO COMMUNICATION ROOM IN BASEMENT.
 - 2 24"x24"x8" J-BOX.
 - 3 TIE INTO EXISTING FIRE ALARM.
 - 4 6"x6" WIREWAY ABOVE FINISHED CEILING.

ROOM NO.	ROOM NAME
200	JANITOR
201	CHAMF. STOR.
202	KITCHENETTE
203	COMPUTER
204	SATELLITE
205	CONFERENCE
206	
207	
208	
209	VIDEO
210	A-V STORAGE
211	ELEV. LOBBY LEVEL 2
212	WOMEN
213	MEN
214	RECORDS
215	RECORDS
216	TRAINING OFFICE
217	CORRIDOR
218	CORRIDOR
219	CORRIDOR
220	CORRIDOR
221	CORRIDOR
222	CORRIDOR
223	CORRIDOR
224	CORRIDOR
225	STAIR

RECORD DRAWINGS DATE 9-8-95

These record drawings have been prepared, in part, on the basis of information compiled and furnished by others. The Engineer will not be responsible for any errors or omissions which have been incorporated into this document as a result.

STAGGS & FISHER CONSULTING ENGINEERS, INC.







DEMOLITION NOTE:

REMOVE ALL ELECTRIC CONNECTIONS TO EQUIPMENT LIGHTS, DEVICES, FIRE ALARM, PHONE, ETC. IN THE AREA TO BE DEMOLISHED. REFER TO ARCHITECTURAL PLANS FOR THE EXTENT OF WORK. REFER TO GENERAL NOTES.

SCOVELL HALL RENOVATION


LOW-VOLTAGE PLAN - SECOND FLOOR

002463

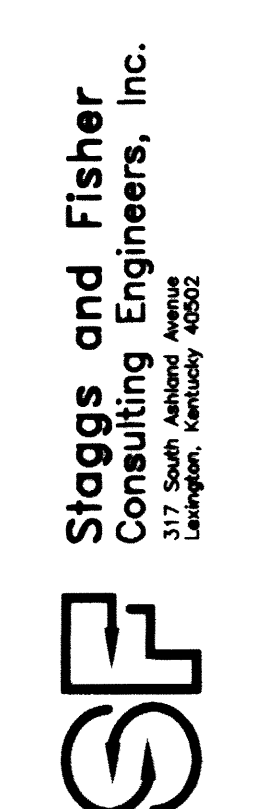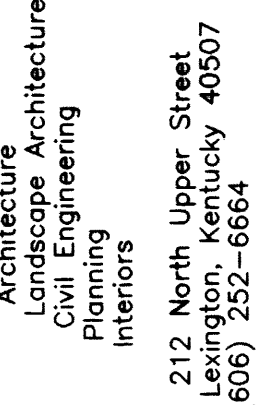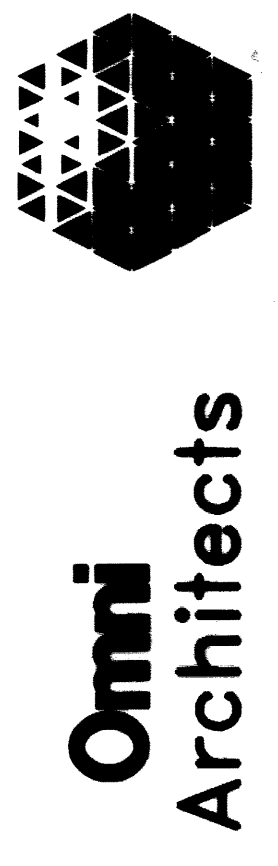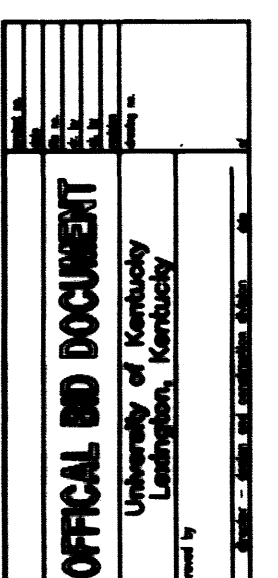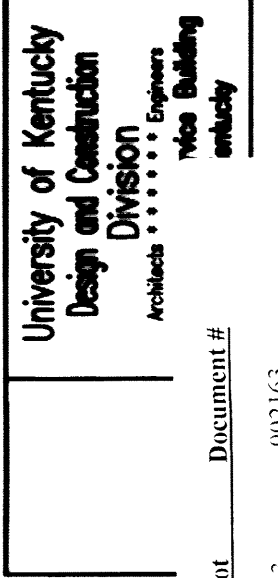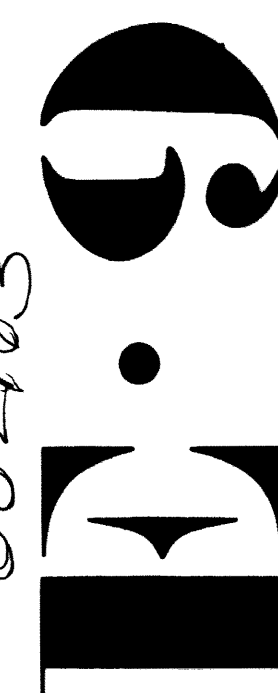


UNIVERSITY OF KENTUCKY

This Drawing and Design herein, together with the project description, are the property of Staggs and Fisher Consulting Engineers, Inc. No reproduction or copying is allowed without the written consent of Staggs and Fisher Consulting Engineers, Inc.

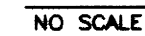

PANELBOARD CIRCUIT CAPACITY						
PANEL BOARD	ONE – POLE	TWO – POLE	3 – POLE	SPACES (MIN.)	CAP OF NEW, IN. AMPS	MOUNTING
"LC"	22–20A	22–20A	22–20A	6	100	SURFACE
"LB"	24–20A	24–20A	24–20A	4	100	RECESSED
"LC"	16–20A	16–20A	16–20A	2	100	RECESSED
"BA"	26–20A	26–20A	26–20A	2	100	RECESSED
"BB"	18–20A	18–20A	3–20A	2	100	RECESSED

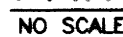

These record drawings have been prepared, in part, on the basis of information compiled and furnished by others. The Engineer will not be responsible for any errors or omissions which have been incorporated into this document as a result.

STAGGS & FISHER CONSULTING ENGINEERS, INC.

ELECTRICAL

CONDUITS, LIGHTING, ETC.

	CONDUIT BELOW FLOOR
	CONDUIT ABOVE FLOOR
	WIREWAY OR CABLE TRAY
	D.C. CIRCUIT IN CONDUIT (MIN. #10W.)
	PLUGMOLD
	STEP-DOWN TRANSFORMER
	CEILING OUTLET FOR LIGHT FIXTURE
	WALL OUTLET FOR LIGHT FIXTURE
	LIGHT OUTLET ON EMERGENCY CIRCUIT
	DARKROOM WALL-MOUNTED WARNING LIGHT
	NIGHT LIGHT
	EXIT LIGHT (CEILING MOUNTED)
	EXIT LIGHT (WALL MOUNTED)
	FLUORESCENT LIGHT FIXTURE
	EMERGENCY BATTERY PACK
	ENTRANCE POINT OF CONDUIT THROUGH FLOOR
	PANELBOARD OR TERMINAL CABINET
	JUNCTION BOX
	DISCONNECT SWITCH
	MAGNETIC STARTER
	COMBINATION MAGNETIC STARTER AND SWITCH
	MOTOR
	BOTTOM OF DEVICE (N INCHES A.F.F.)
	SEE NOTE 1 THIS SHEET
	FOUR (4) GROUND JACKS/RECEPTABLES (FLUSH-MOUNTED)
	HEADWALL - FOR SERVICES, SEE DETAILS

NURSE CALL

	PUSHBUTTON STATION
	DUTY STATION
	NURSE CALL MASTER STATION
	PATIENT BED STATION - SINGLE, 2-BED
	STAFF STATION
	TOILET PULL CORD/EMERGENCY STATION
	CODE BLUE STATION
	DOME LIGHT - SINGLE, DOUBLE, MULTI
	PHYSIOLOGICAL MONITOR OUTLET
	PHYSIOLOGICAL MONITOR OUTLET MASTER

RECEPTACLES (BOTTOM 16" A.F.F.)
(EXCEPT AS NOTED OTHERWISE)

	DUPLEX CONVENIENCE OUTLET
	QUADPLEX CONVENIENCE OUTLET
	ISOLATED GROUND OUTLET
	GROUND FAULT INTERRUPTING OUTLET
	WEATHERPROOF OUTLET
	DUPLEX RECEPTACLE ON EMERGENCY CIRCUIT
	COMBINATION OUTLET (120/240V.)
	WALL OUTLET (240V., 1-PHASE) (RATING AS NOTED)
	WALL OUTLET (240V., 3-PHASE) (RATING AS NOTED)
	ELECTRICAL OUTLET IN FLOOR (PEDESTAL-TYPE)
	ELECTRICAL OUTLET IN FLOOR (FLUSH-TYPE)

COMMUNICATIONS (BOTTOM 16" A.F.F.)
(EXCEPT AS NOTED OTHERWISE)

	COMPUTER OUTLET IN WALL
	TELEPHONE OUTLET IN FLOOR (PEDESTAL-TYPE)
	TELEPHONE OUTLET IN FLOOR (FLUSH-TYPE)
	COMPUTER OUTLET IN FLOOR (PEDESTAL-TYPE)
	COMPUTER OUTLET IN FLOOR (FLUSH-TYPE)
	TELEPHONE OUTLET IN WALL
	T.V. RECEIVER OUTLET
	T.V. CAMERA OUTLET
	CAMERA MONITOR OUTLET

SOUND AND INTERCOM

	CEILING MOUNTED SPEAKER
	WALL MOUNTED SPEAKER
	HORN TYPE SPEAKER
	VOLUME CONTROL
	MASTER INTERCOM STATION
	INTERCOM STATION
	DICTATION OUTLET
	MICROPHONE OUTLET IN FLOOR (FLUSH TYPE)
	MICROPHONE OUTLET IN WALL (BOTTOM 16" A.F.F.)
	PROJECTOR OUTLET

FIRE ALARM

	SUPERVISED VALVE
	FIRE ALARM BREAKGLASS STATION (BOTTOM 44" A.F.F.)
	FIRE ALARM NURSE STATION ANNUNCIATOR
	FLOW SWITCH
	DUCT TYPE SMOKE DETECTOR
	FIRE ALARM HORN/FLASHING LIGHT
	FIRE ALARM FLASHING LIGHT
	AUTOMATIC HEAT DETECTOR
	SMOKE DETECTOR (CEILING MOUNTED)
	SMOKE DETECTOR (CEILING MOUNTED SINGLE STATION)
	ELECTROMAGNETIC DOOR HOLDER
	ELECTROMAGNETIC DOOR CLOSER

WALL SWITCHES (BOTTOM 44" A.F.F.)
(EXCEPT AS NOTED OTHERWISE)

	SINGLE POLE
	DOUBLE POLE
	THREE-WAY
	FOUR-WAY
	WITH PILOT LIGHT
	THERMAL OVERLOAD
	THERMAL OVERLOAD WITH PILOT
	COMBINATION SWITCH AND RECEPTACLE
	KEY OPERATED SWITCH
	WALL DIMMER (FLUSH-MOUNTED)

CLOCK AND PROGRAM

	CLOCK - SINGLE FACE
	CLOCK - DOUBLE FACE
	CLOCK OUTLET
	PROGRAM BELL

ELECTRICAL ABBREVIATIONS

A.F.F.	ABOVE FINISHED FLOOR
A.T.C.P.	AUTOMATIC TEMPERATURE CONTROL PANEL
C.	CONDUIT
F.A.	FIRE ALARM
G.F.I.	GROUND FAULT INTERRUPTER
IG	ISOLATED GROUND
JB	JUNCTION BOX
T.T.C.	TELEPHONE TERMINAL CABINET
R	DEVICE OR OUTLET TO BE REMOVED
W.	WIRE

NOTE:
ALL DASHED DEVICES, OUTLETS, ETC., ARE EXISTING TO REMAIN UNLESS OTHERWISE NOTED.

MECHANICAL

PLUMBING LEGEND

	SANITARY OR WASTE PIPING
	VENT PIPING
	ROOF LEADER PIPING
	STORM SEWER PIPING
	STORM DRAIN PIPING
	UNDERFLOOR DRAINAGE PIPING
	DRAIN TILE
	COLD WATER PIPING
	HOT WATER PIPING
	HOT WATER RECIRCULATING PIPING
	GAS PIPING
	AIR PIPING
	VACUUM PIPING
	GATE VALVE
	BALL VALVE
	CHECK VALVE
	GAS COCK (SHUT-OFF VALVE)
	BALANCING COCK
	ELBOW (UP)
	ELBOW (DOWN)
	ELBOW (SIDE)
	TEE (UP)
	TEE (DOWN)
	TEE (SIDE)
	UNION
	REDUCER OR INCREASER
	WALL HYDRANT
	HOSE BIBB
	PRESSURE GAUGE
	THERMOMETER
	WASTE AND VENT RISER DIAGRAM DESIGNATION
	DOMESTIC HOT AND COLD WATER RISER DIAGRAM DESIGNATION

MEDICAL GAS LEGEND

	OXYGEN PIPING
	NITROUS OXIDE PIPING
	NITROGEN PIPING
	MEDICAL AIR PIPING
	MEDICAL VACUUM PIPING
	WASTE GAS EVACUATION PIPING
	HIGH-LOW PRESSURE SWITCH (PLAN)

FIRE PROTECTION LEGEND

	FIRE PROTECTION MAIN
	SPRINKLER BRANCH PIPING
	ELBOW (UP)
	ELBOW (DOWN)
	ELBOW (SIDE)
	TEE (UP)
	TEE (DOWN)
	TEE (SIDE)
	SUPERVISED VALVE
	INSPECTOR'S TEST PIPING
	FLOW SWITCH
	SPRINKLER HEAD (PENDENT)
	SPRINKLER HEAD (SEMI-RECESSED)
	SPRINKLER HEAD (CONCEALED)
	SPRINKLER HEAD (UPRIGHT)
	SPRINKLER HEAD (SIDEWALL)
	SPRINKLER HEAD (SIDEWALL - EXTENDED COVERAGE)
	HYDRAULIC CALCULATION REFERENCE POINT

H.V.A.C. LEGEND

	RECTANGULAR DUCT -- WIDTH X DEPTH
	OVAL DUCT -- WIDTH X DEPTH
	ROUND DUCT -- SIZE INDICATED DIAMETER
	FLEXIBLE DUCT -- SINGLE LINE, DOUBLE LINE
	RISE IN DIRECTION OF ARROW
	RECTANGULAR TO ROUND TRANSITION
	SQUARE ELBOW WITH TURNING VANES
	MANUAL VOLUME DAMPER
	FIRE DAMPER
	SMOKE DAMPER
	COMBINATION FIRE/SMOKE DAMPER
	ROUND DUCT -- UP, DOWN
	SUPPLY DUCT OR OUTSIDE AIR -- UP, DOWN
	RETURN DUCT -- UP, DOWN
	EXHAUST AIR -- UP, DOWN
	FLEXIBLE CONNECTION
	MOTOR-OPERATED DAMPER
	STATIC PRESSURE SENSOR IN DUCT
	THERMOSTAT
	NIGHT THERMOSTAT
	HUMIDISTAT
	FLOW SWITCH
	UNIT SYMBOL, MIN. -- MAX. AIR, WATER FLOW (GPM)
	UNIT SYMBOL, MIN. -- MAX. AIR FLOW (CFM)
	UNIT SYMBOL, MAX. AIR FLOW (CFM)
	UNIT SYMBOL, MAX. WATER FLOW (GPM)
	SOUND TRAP IN DUCT
	SUPPLY DIFFUSER -- TYPE, CFM (FOUR WAY)
	SUPPLY DIFFUSER -- TYPE, CFM (THREE WAY)
	SUPPLY DIFFUSER -- TYPE, CFM (TWO WAY CORNER)
	SUPPLY DIFFUSER -- TYPE, CFM (TWO WAY OPPOSITE)
	SUPPLY DIFFUSER -- TYPE, CFM (ONE WAY)
	RETURN INLET -- TYPE, CFM
	EXHAUST INLET -- TYPE, CFM
	ACCESS DOOR -- PLAN, SIDE VIEW
	EXISTING DUCTWORK TO BE REMOVED
	CONNECT TO EXISTING

H.V.A.C. PIPING LEGEND

	EXISTING PIPING TO BE REMOVED
	HIGH PRESSURE STEAM
	HIGH PRESSURE CONDENSATE RETURN
	MEDIUM PRESSURE STEAM
	MEDIUM PRESSURE CONDENSATE RETURN
	LOW PRESSURE STEAM
	LOW PRESSURE CONDENSATE RETURN
	STEAM VENT
	CONDENSATE PUMP DISCHARGE
	SAFETY RELIEF VALVE VENT
	EMERGENCY GENERATOR EXHAUST
	EXPANSION TANK PIPE
	VENT
	CONDENSER WATER SUPPLY
	CONDENSER WATER RETURN
	HOT WATER SUPPLY
	HOT WATER RETURN
	CHILLED WATER SUPPLY
	CHILLED WATER RETURN
	CONDENSATE DRAINAGE
	FUEL OIL SUPPLY
	FUEL OIL RETURN

H.V.A.C. PIPE FITTINGS

	GATE VALVE (SCREWED) -- PLAN, END VIEW
	GLOBE VALVE (SCREWED) -- PLAN, END VIEW
	GLOBE VALVE (FLANGED) -- PLAN, END VIEW
	CHECK VALVE, SILENT CHECK VALVE
	3-WAY CONTROL VALVE, 2-WAY CONTROL VALVE
	COMB. BALANCING SHUT-OFF VALVE -- PLAN, END VIEW
	BASKET STRAINER
	3/4" DRAIN VALVE WITH HOSE CONNECTION
	SAFETY RELIEF VALVE
	Y-TYPE STRAINER WITH DRAIN VALVE
	FLEXIBLE CONNECTOR
	PRESSURE GAUGE
	TEMPERATURE GAUGE
	UNION
	MANUAL AIR VENT -- PLAN, ELEVATION
	AUTOMATIC AIR VENT -- PLAN, ELEVATION
	CONCENTRIC REDUCER -- PLAN, ELEVATION
	ECCENTRIC REDUCER -- PLAN, ELEVATION
	BUTTERFLY VALVE
	BALL VALVE
	FLANGED CONNECTION
	NEEDLE VALVE IN GAUGE LINE
	FLANGED TUBE RADIATION - NUMBER INDICATES FEET OF ACTIVE ELEMENT REQUIRED

ABBREVIATIONS

PLUMBING	
C.I.	CAST IRON
C.O.	CLEANOUT
CW	COLD WATER
FD	FLOOR DRAIN
HW	HOT WATER
O.H.D.	OPEN HUB DRAIN
O.R.	OPEN RECEPTACLE
P.V.C.	POLY-VINYL CHLORIDE
RD	ROOF DRAIN
SA	SHOCK ARRESTOR
VTR	VENT-THROUGH-ROOF
VCP	VITRIFIED CLAY PIPE

H.V.A.C.

A.A.V.	AUTOMATIC AIR VENT
A.D.	ACCESS DOOR
A.F.	ABOVE FLOOR
B.E.	BELLMOUTH ENTRANCE
C.	COMMON
D.P.	DIFFUSER PLATE
E.A.	EXHAUST AIR
E.M.D.	END OF MAIN DRIP
F.D.	FIRE DAMPER
F.M.S.	FLOW MEASURING STATION
F.S.D.	FIRE/SMOKE DAMPER
I.B.	INLET BELL
I.S.	INLET SCREEN
M.A.V.	MANUAL AIR VENT
M.D.	MOTOR OPERATED DAMPER
M.E.	MOISTURE ELIMINATORS
N.C.	NORMALLY CLOSED
N.O.	NORMALLY OPEN
O.A.	OUTSIDE AIR
P.A.	PRIMARY AIR
R.A.	RETURN AIR
S.A.	SUPPLY AIR
R.H.	RANGE HOOD
S.D.	SUCTION DIFFUSER
S.M.D.	SMOKE DAMPER
T.A.V.	THERMOSTATIC AIR VENT
T.C.P.	TEMPERATURE CONTROL PANEL
V.B.	VACUUM BREAKER
V.D.	VOLUME DAMPER
V.F.C.	VARIABLE FREQUENCY CONTROLLER

SITE UTILITIES

SITE UTILITIES LEGEND

MECHANICAL	
	EXISTING SANITARY SEWER
	NEW SANITARY SEWER
	NEW STORM SEWER
	FIRE PROTECTION LINE
	EXISTING COLD WATER SERVICE
	NEW COLD WATER SERVICE
	EXISTING HIGH PRESSURE GAS
	HIGH PRESSURE GAS
	EXISTING GAS
	NEW GAS
	CURB VALVE WITH VALVE BOX
	VALVE WITH VALVE BOX
	UTILITY MARKER
	THRUST BLOCK
	HYDRAULIC CALCULATION REFERENCE POINT
C.I.	CAST IRON
ELEV.	ELEVATION
EXIST.	EXISTING
F.H.	FIRE HYDRANT
G.C.O.	GRADE CLEANOUT
I.E.	INVERT ELEVATION
P.I.V.	POST INDICATOR VALVE
P.V.C.	POLYVINYL CHLORIDE PIPING
T.E.	TOP ELEVATION

ELECTRICAL	
	EXISTING OVERHEAD ELECTRIC
	OVERHEAD ELECTRIC
	OVERHEAD ELECTRIC/TELEPHONE
	EXISTING ELECTRIC UNDERGROUND
	BRANCH CIRCUIT UNDERGROUND
	UNDERGROUND PRIMARY SERVICE
	UNDERGROUND SECONDARY SERVICE
	EXISTING TELEPHONE UNDERGROUND
	UNDERGROUND TELEPHONE CONDUIT
	UNDERGROUND TELEVISION CONDUIT
	LIGHTING STANDARD
	EXISTING POST LIGHT
	POST LIGHT

NOTE:

THE SYMBOLS LISTED ON THIS SHEET MAY NOT ALL BE USED ON THE CONTRACT DRAWINGS, HOWEVER, WHEREVER A SYMBOL IS USED, THE ITEM SHALL BE FURNISHED AND INSTALLED.

RECORD DRAWINGS DATE 9-8-95

These record drawings have been prepared, in part, on the basis of information compiled and furnished by others. The Engineer will not be responsible for any errors or omissions which have been incorporated into this document as a result.

STAGGS & FISHER CONSULTING ENGINEERS, INC.