



FITTINGS -- ALL FITTINGS SHALL BE FINISHED WITH CANVAS CLOTH APPLIED OVER INSULATION. CONTRACTOR HAS THE OPTION OF FINISHING FITTINGS WITH P.V.C. FIRE TESTED AND RATED FITTING COVERS. SEE SPECS.

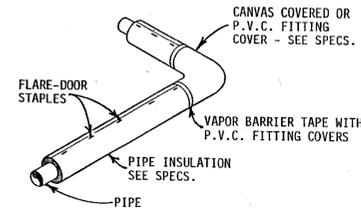

TYPICAL DETAIL OF INSULATION AT PIPE AND FITTING
NO SCALE

PIPING 1 1/2" AND LARGER -- PROVIDE SECTION OF RIGID INSULATION BETWEEN PROTECTOR SADDLE AND PIPE TO PREVENT CRUSHING OF INSULATION. SECTION OF RIGID INSULATION SHALL BE FULL SIZE (MINIMUM) OF BEARING SURFACE OF SADDLE. CONTRACTOR'S OPTION -- USE SECTION OF RIGID INSULATION WITH FULL CIRCUMFERENCE OF PIPE AT EACH PROTECTION SADDLE.

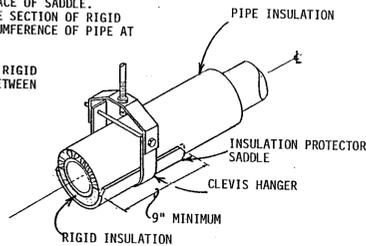

TYPICAL PIPE SUPPORT DETAIL WITH PROTECTOR SADDLE AND RIGID INSULATION -- PIPING 1-1/2" & LARGER
NO SCALE

PIPING 1" AND SMALLER -- RIGID INSULATION NOT REQUIRED BETWEEN SADDLE AND HANGER AT PIPE SUPPORTS

COFFEE SHOP KITCHEN EQUIPMENT SCHEDULE *

- C-1 SERVICE COUNTER
- C-3 SERVICE COUNTER
- C-4 HOT FOOD WELLS
- C-6 ICED TEA DISPENSER
- C-7 COFFEE MAKER
- C-9 WORK COUNTER W/SINK
- C-11 SODA SYSTEM AND DISPENSER
- C-12 REFRIGERATED TOPPING PAN
- C-13 SOFT SERVE MACHINE
- C-26 HAND SINK
- C-27 TABLE W/ THREE SINKS AND DISPOSER
- C-28 ICE MAKER
- C-36 MOP BASIN

* REFER TO ARCHITECTURAL DRAWINGS FOR COMPLETE KITCHEN EQUIPMENT SCHEDULE.

GENERAL NOTES: PLUMBING

1. REMOVE OR MODIFIED EXISTING HOT WATER, COLD WATER AND WASTE PIPING TO EXISTING KITCHEN EQUIPMENT AS REQUIRED FOR INSTALLATION OF NEW AND EXISTING (RELOCATED) KITCHEN EQUIPMENT.
2. CONNECT NEW WATER AND WASTE PIPING CONNECTIONS TO THE EXISTING WATER AND WASTE SYSTEMS AS INDICATED ON DRAWINGS.
3. THE CONTRACTOR SHALL REFER TO THE KITCHEN EQUIPMENT SPECS. AND DRAWINGS FOR ADDITIONAL INSTALLATION REQUIREMENTS.
4. THE CONTRACTOR SHALL VERIFY SIZES AND LOCATIONS OF KITCHEN EQUIPMENT ROUGH-INS WITH KITCHEN EQUIPMENT SUPPLIER.
5. THE CONTRACTOR SHALL INSTALL FULL SIZE INDIRECT WASTES FROM KITCHEN EQUIPMENT REQUIRING SAME TO NEAREST FLOOR DRAIN.
6. THE CONTRACTOR SHALL INSTALL ACCESSORIES (SUCH AS FAUCETS, STRAINERS, VACUUM BREAKERS, ETC.) FURNISHED BY THE KITCHEN EQUIPMENT SUPPLIER IN PIPING SYSTEMS WHERE REQUIRED.
7. PIPING IN ROOMS WITH SUSPENDED CEILINGS SHALL BE ABOVE CEILING UNLESS OTHERWISE NOTED.
8. LOCATIONS OF PIPING AND EQUIPMENT ARE APPROXIMATE AND SUBJECT TO MINOR ADJUSTMENTS IN THE FIELD. DO NOT SCALE THE DRAWINGS.
9. ALL OFFSETS IN PIPING ARE NOT NECESSARILY SHOWN. PROVIDE ADDITIONAL OFFSETS WHERE NECESSARY.
10. COORDINATE WITH MECHANICAL, FIRE PROTECTION AND ELECTRICAL CONTRACTORS TO AVOID INTERFERENCES WITH NEW OR EXISTING PIPING, DUCTS AND CONDUIT.
11. INSTALL PIPING AND EQUIPMENT IN ACCORDANCE WITH MANUFACTURER'S INSTALLATION INSTRUCTIONS.
12. SEAL AIRTIGHT AROUND ALL PIPING PENETRATIONS THROUGH WALLS, FLOOR AND ROOF.
13. VERIFY EXACT LOCATIONS OF ALL PLUMBING ROUGH-INS WITH ARCHITECT.
14. NEW SLEEVES IN FLOORS SHALL EXTEND 2" ABOVE FINISHED FLOOR AND CAULKED FOR WATERTIGHT INSTALLATION. SEE SPECIFICATIONS, SECTION 15000.
15. REMOVE EXISTING OPEN PIPE SLEEVES LEFT IN THE FLOOR DUE TO THE REMOVAL OF EXISTING SERVICES. OPENINGS SHALL BE PATCHED BY GENERAL CONTRACTOR.
16. REPAIR OF HOT WATER, COLD WATER AND WASTE PIPING -- AT ALL LOCATIONS WHERE SINKS AND LAVATORIES ARE REMOVED AND NOT REPLACED, PIPING (HOT, COLD AND WASTE) SHALL BE PLUGGED IN WALL WITH BRASS PLUGS. PIPING AND FITTINGS IN WALL SHALL BE INSULATED BEFORE WALL IS PATCHED.
17. VALVE TAGS -- HOT AND COLD WATER SHUT-OFF VALVES FOR NEW LAVATORIES AND SINKS SHALL BE TAPPED WITH BRASS TAGS STAMPED AS DIRECTED BY THE ARCHITECT (AS REQUIRED BY THE MEDICAL CENTER PHYSICAL PLANT DIVISION).
18. EXISTING PLUMBING FIXTURES AND TRIM NOT TO BE REUSED SHALL BE DELIVERED TO THE OWNER.
19. CONTRACTOR UNDER THIS DIVISION SHALL VERIFY ALL EXISTING PIPING SIZES AND LOCATIONS BEFORE CONNECTING NEW SERVICES.
20. SEE THIS DRAWING FOR TYPICAL DETAIL OF INSULATION AT PIPE AND FITTING.
21. SEE THIS DRAWING FOR TYPICAL PIPE SUPPORT DETAIL.

PLUMBING LEGEND

	EXISTING SANITARY OR WASTE PIPING
	NEW SANITARY OR WASTE PIPING
	EXISTING VENT PIPING
	NEW VENT PIPING
	EXISTING COLD WATER PIPING
	NEW COLD WATER PIPING
	EXISTING HOT WATER PIPING
	NEW HOT WATER PIPING
	EXISTING RECIRCULATING HOT WATER PIPING
	EXISTING GAS PIPING
	EXISTING PIPING TO BE REMOVED
	ELBOW UP
	ELBOW DOWN
	ELBOW SIDE
	TEE UP
	TEE DOWN
	TEE SIDE
	GATE VALVE
	BALL VALVE
	SOLENOID VALVE
	SHOCK ARRESTER
	UNION

RECORD DRAWINGS DATE **JAN 31 1990**

These record drawings have been prepared, in part, on the basis of information compiled and furnished by others. The Engineer will not be responsible for any errors or omissions which have been incorporated into this document as a result.

STAGGS & FISHER CONSULTING ENGINEERS, INC.



Tate & Fitzsimons Architects
Sarah House Tate
346 E. Main St. Lexington, KY 40507
Gregory Fitzsimons
606-252-5994



University of Kentucky
Lexington, Kentucky
Professional Engineer
Gregory Fitzsimons

PLUMBING - SCHEDULES AND DETAILS
COFFEE SHOP RENOVATION: 544
UNIVERSITY OF KENTUCKY MEDICAL CENTER
800 ROSE STREET
LEXINGTON, KENTUCKY

date: 3-31-89
drawn: D.H.
checked: D.P.
revised:

P-3

Sheet # 111
C-1
00544