



# CENTRAL HEATING PLANT BOILER REPLACEMENT UNIVERSITY OF KENTUCKY LEXINGTON, KY

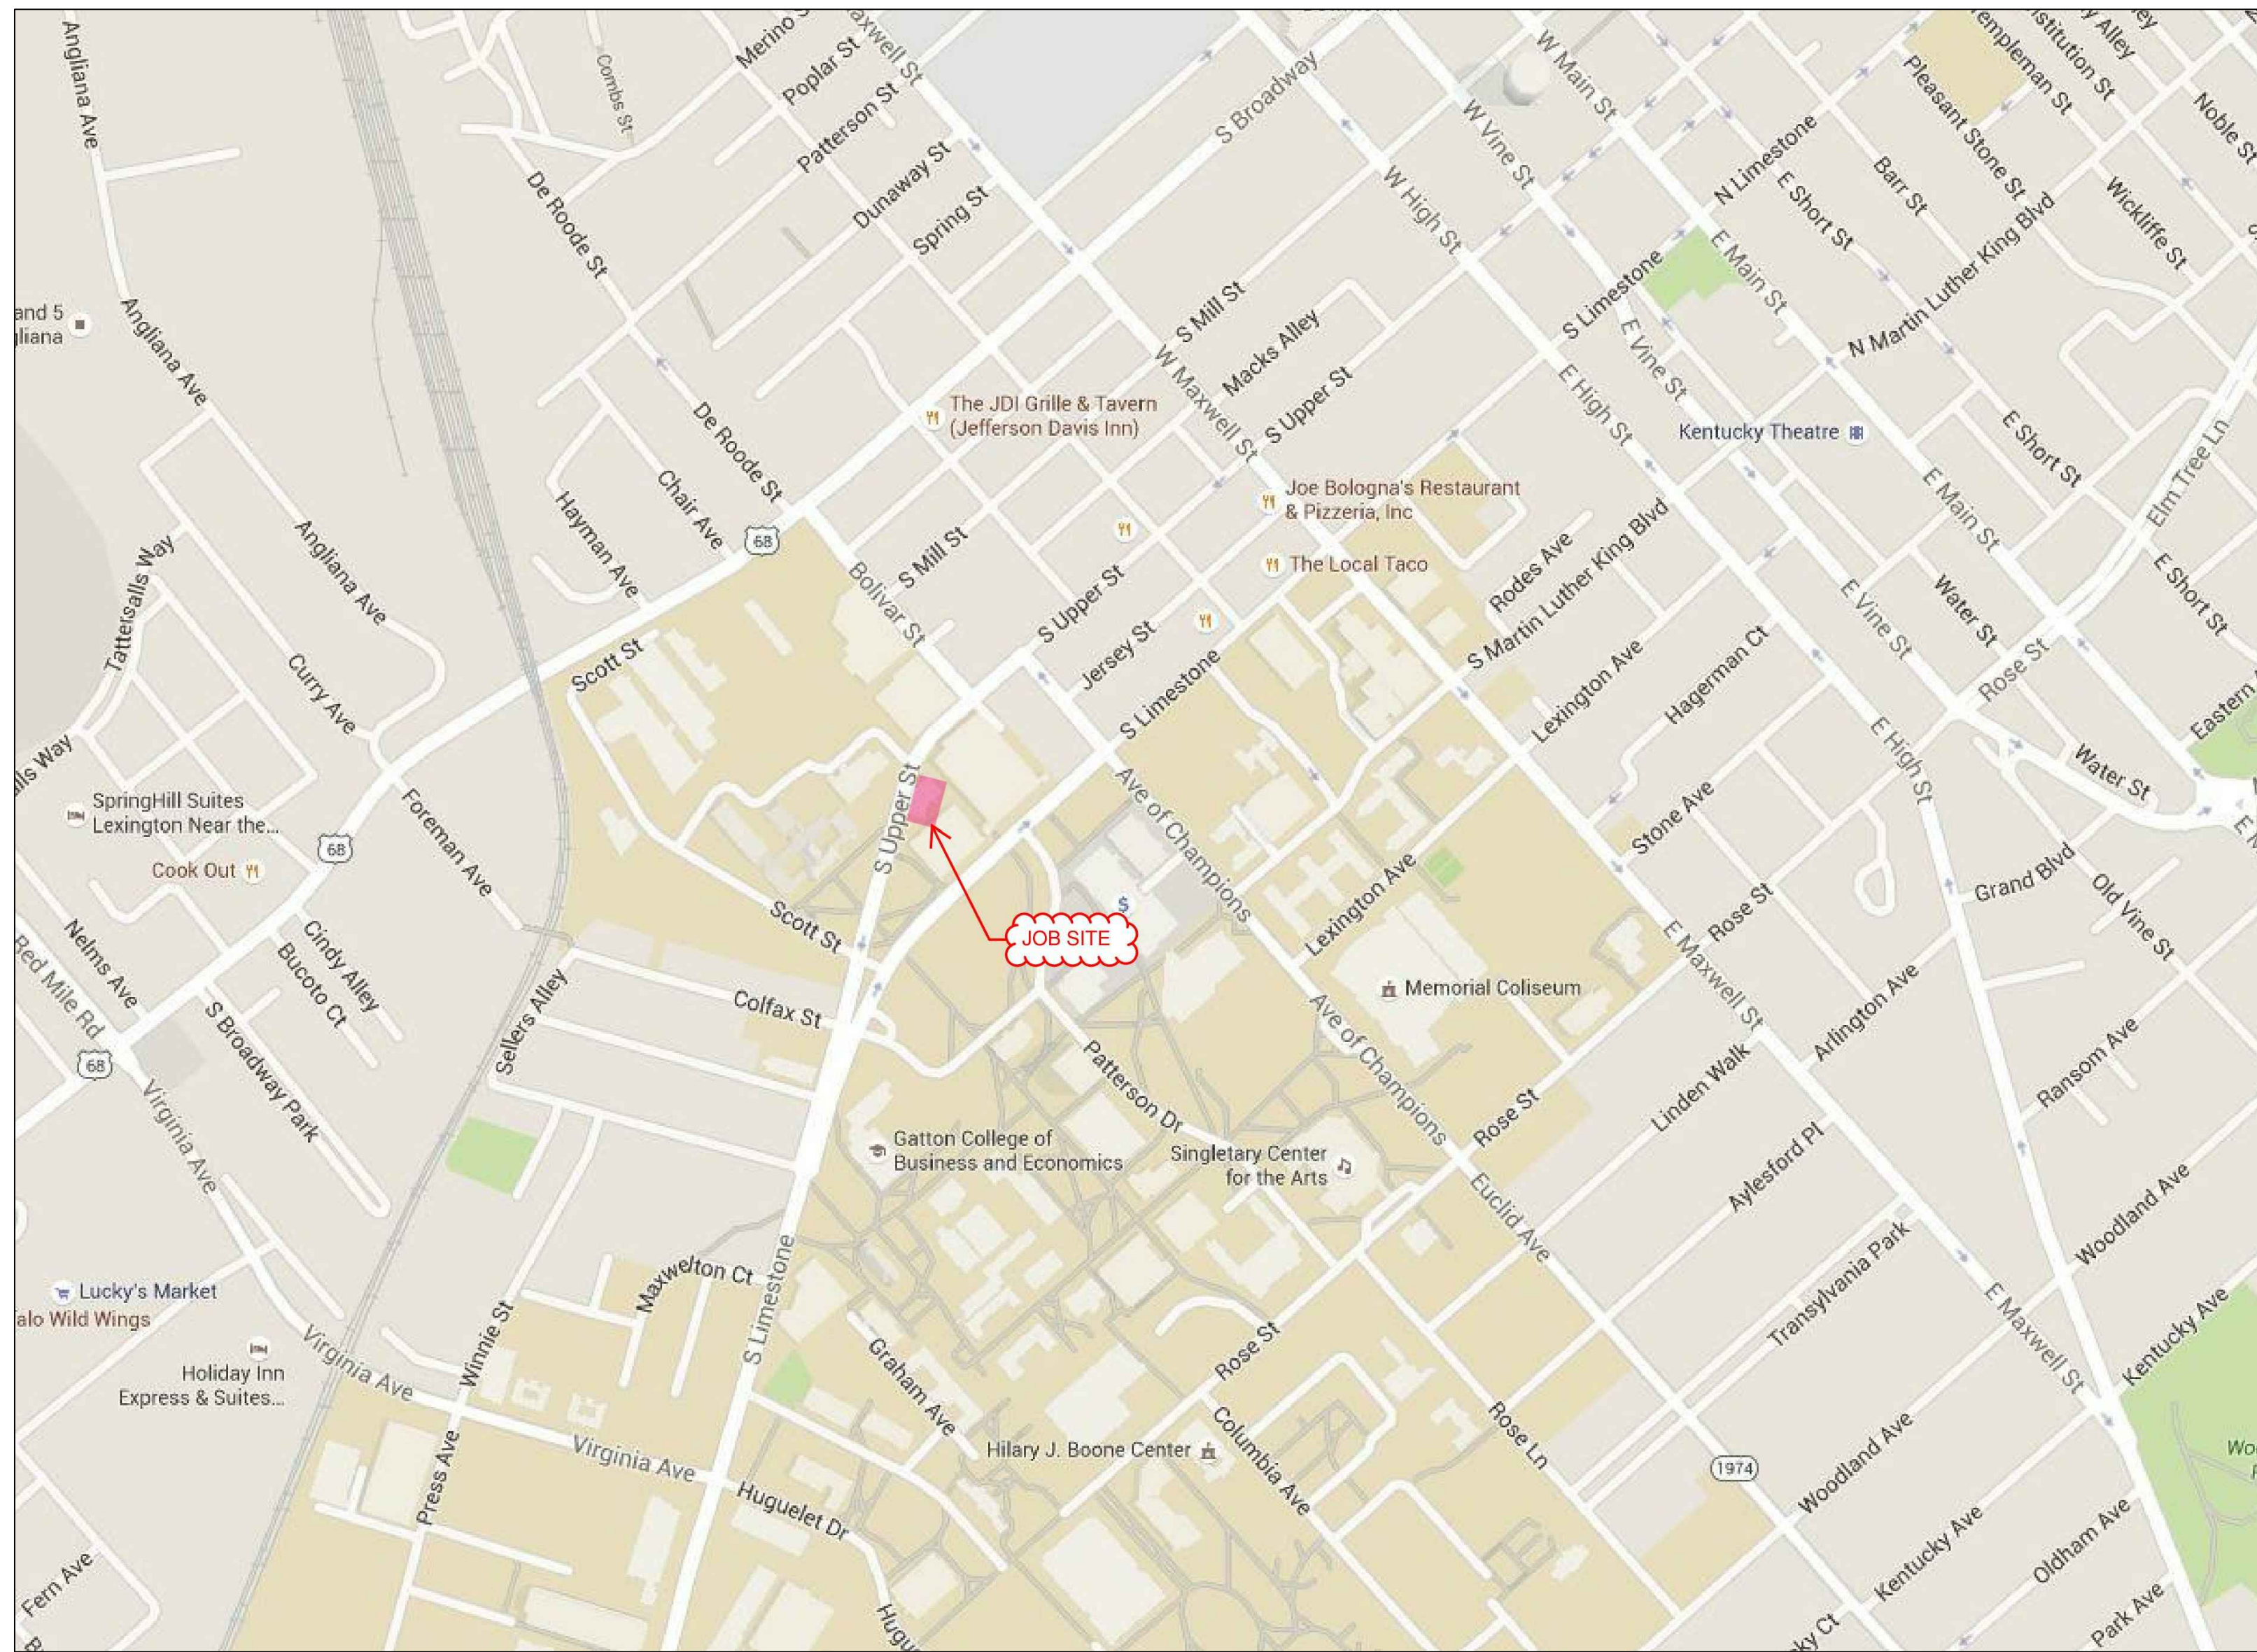

## SHEET LIST:

- C.0 COVER SHEET
- S-1 STRUCTURAL GENERAL NOTES
- S-2 STRUCTURAL GROUND FLOOR / FOUNDATION PLAN
- S-3 STRUCTURAL FIRST & SECOND TIER FRAMING PLANS
- S-4 STRUCTURAL ROOF FRAMING PLAN
- S-5 STRUCTURAL FRAMING DETAILS
- AD100 ARCHITECTURAL DEMO PLANS
- A100 PLANS, ELEVATIONS, SECTIONS AND SCHEDULES
- A200 DETAILS
- ME1 MECH/ELEC LEGEND
- H1.1D H.V.A.C. PLAN LOWER LEVEL DEMOLITION
- H1.2D H.V.A.C. PLAN INTERMEDIATE LEVEL DEMOLITION
- H1.3D H.V.A.C. PLAN UPPER LEVEL DEMOLITION
- H1.1 H.V.A.C. PLAN LOWER LEVEL NEW WORK
- H1.2 H.V.A.C. PLAN INTERMEDIATE LEVEL NEW WORK
- H1.3 H.V.A.C. PLAN UPPER LEVEL NEW WORK
- H2.1 H.V.A.C. AND FUEL OIL DIAGRAM
- H3.1 H.V.A.C. ENLARGED SECTIONS
- H4.1 H.V.A.C. DETAILS
- H5.1 BOILER DETAILS
- H5.2 BOILER DETAILS
- H5.3 BOILER DETAILS
- H5.4 BOILER DETAILS
- H5.5 BOILER DETAILS
- H5.6 BOILER DETAILS
- ES1.1 ELECTRICAL PLAN SITE NEW WORK
- E1.1 ELECTRICAL PLAN LOWER LEVEL NEW WORK
- E1.2 ELECTRICAL PLAN UPPER LEVEL NEW WORK
- E2.0 ELECTRICAL RISER

NOTE: IT IS NOT INTENDED THAT THE PLANS SHOW ALL OFFSETS IN PIPES, CONDUITS, AND DUCTWORK FOR INSTALLATION OF THE WORK. DETAILS AND SECTIONS ARE INCLUDED FOR SOME AREAS TO SHOW INTENDED RELATIONSHIP OF THE WORK OF VARIOUS TRADES. IT SHALL BE THE RESPONSIBILITY OF THE CONTRACTOR AND SUB-CONTRACTORS TO COORDINATE INSTALLATION OF THE WORK AND TO PROVIDE THE NECESSARY OFFSETS, TRANSFORMATIONS, AND FITTINGS REQUIRED. NO ADDITIONAL COMPENSATION WILL BE ALLOWED FOR CORRECTION CONTACTS BETWEEN THE WORK OF VARIOUS TRADES. DETAILS AND SECTIONS ARE SHOWN FOR THE CONTRACTORS CONVENIENCE, AND SHALL NOT BE CONSIDERED COMPLETE IN ANY DETAIL.

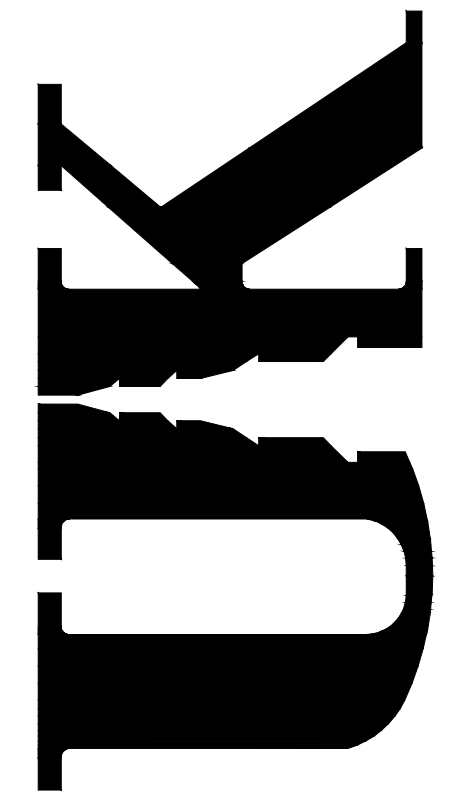

**Disclaimer:**  
Due to the nature of electronic media, Staggs and Fisher Consulting Engineers, Inc. cannot warrant the accuracy of data contained in files transmitted electronically. Any modification or reuse of original or altered CADD design materials by any entity without the review and written approval of Staggs and Fisher Consulting Engineers, Inc. shall be at the sole risk of said entity. Furthermore, said entity agrees to defend, indemnify, and hold Staggs and Fisher Consulting Engineers, Inc. harmless from any and all injuries, damages, losses, and expenses, including attorney's fees, arising out of any claim resulting from the modification or reuse of these materials.

Drawing Issue:

No.	Date	Description

Drawing Title:  
**COVER**








UK Eng. File#: 2429.0	
SF File#: 15510	
Scale: AS NOTED	
Date: 04-03-2015	

RECORD DRAWINGS     DATE     10/17/2017

These record drawings have been prepared, in part, on the basis of information compiled and furnished by others. The Engineer has not verified the accuracy and/or completeness of this information and shall not be responsible for any errors or omissions that may be incorporated as a result of erroneous information provided by others.

**STAGGS & FISHER CONSULTING ENGINEERS, INC.**



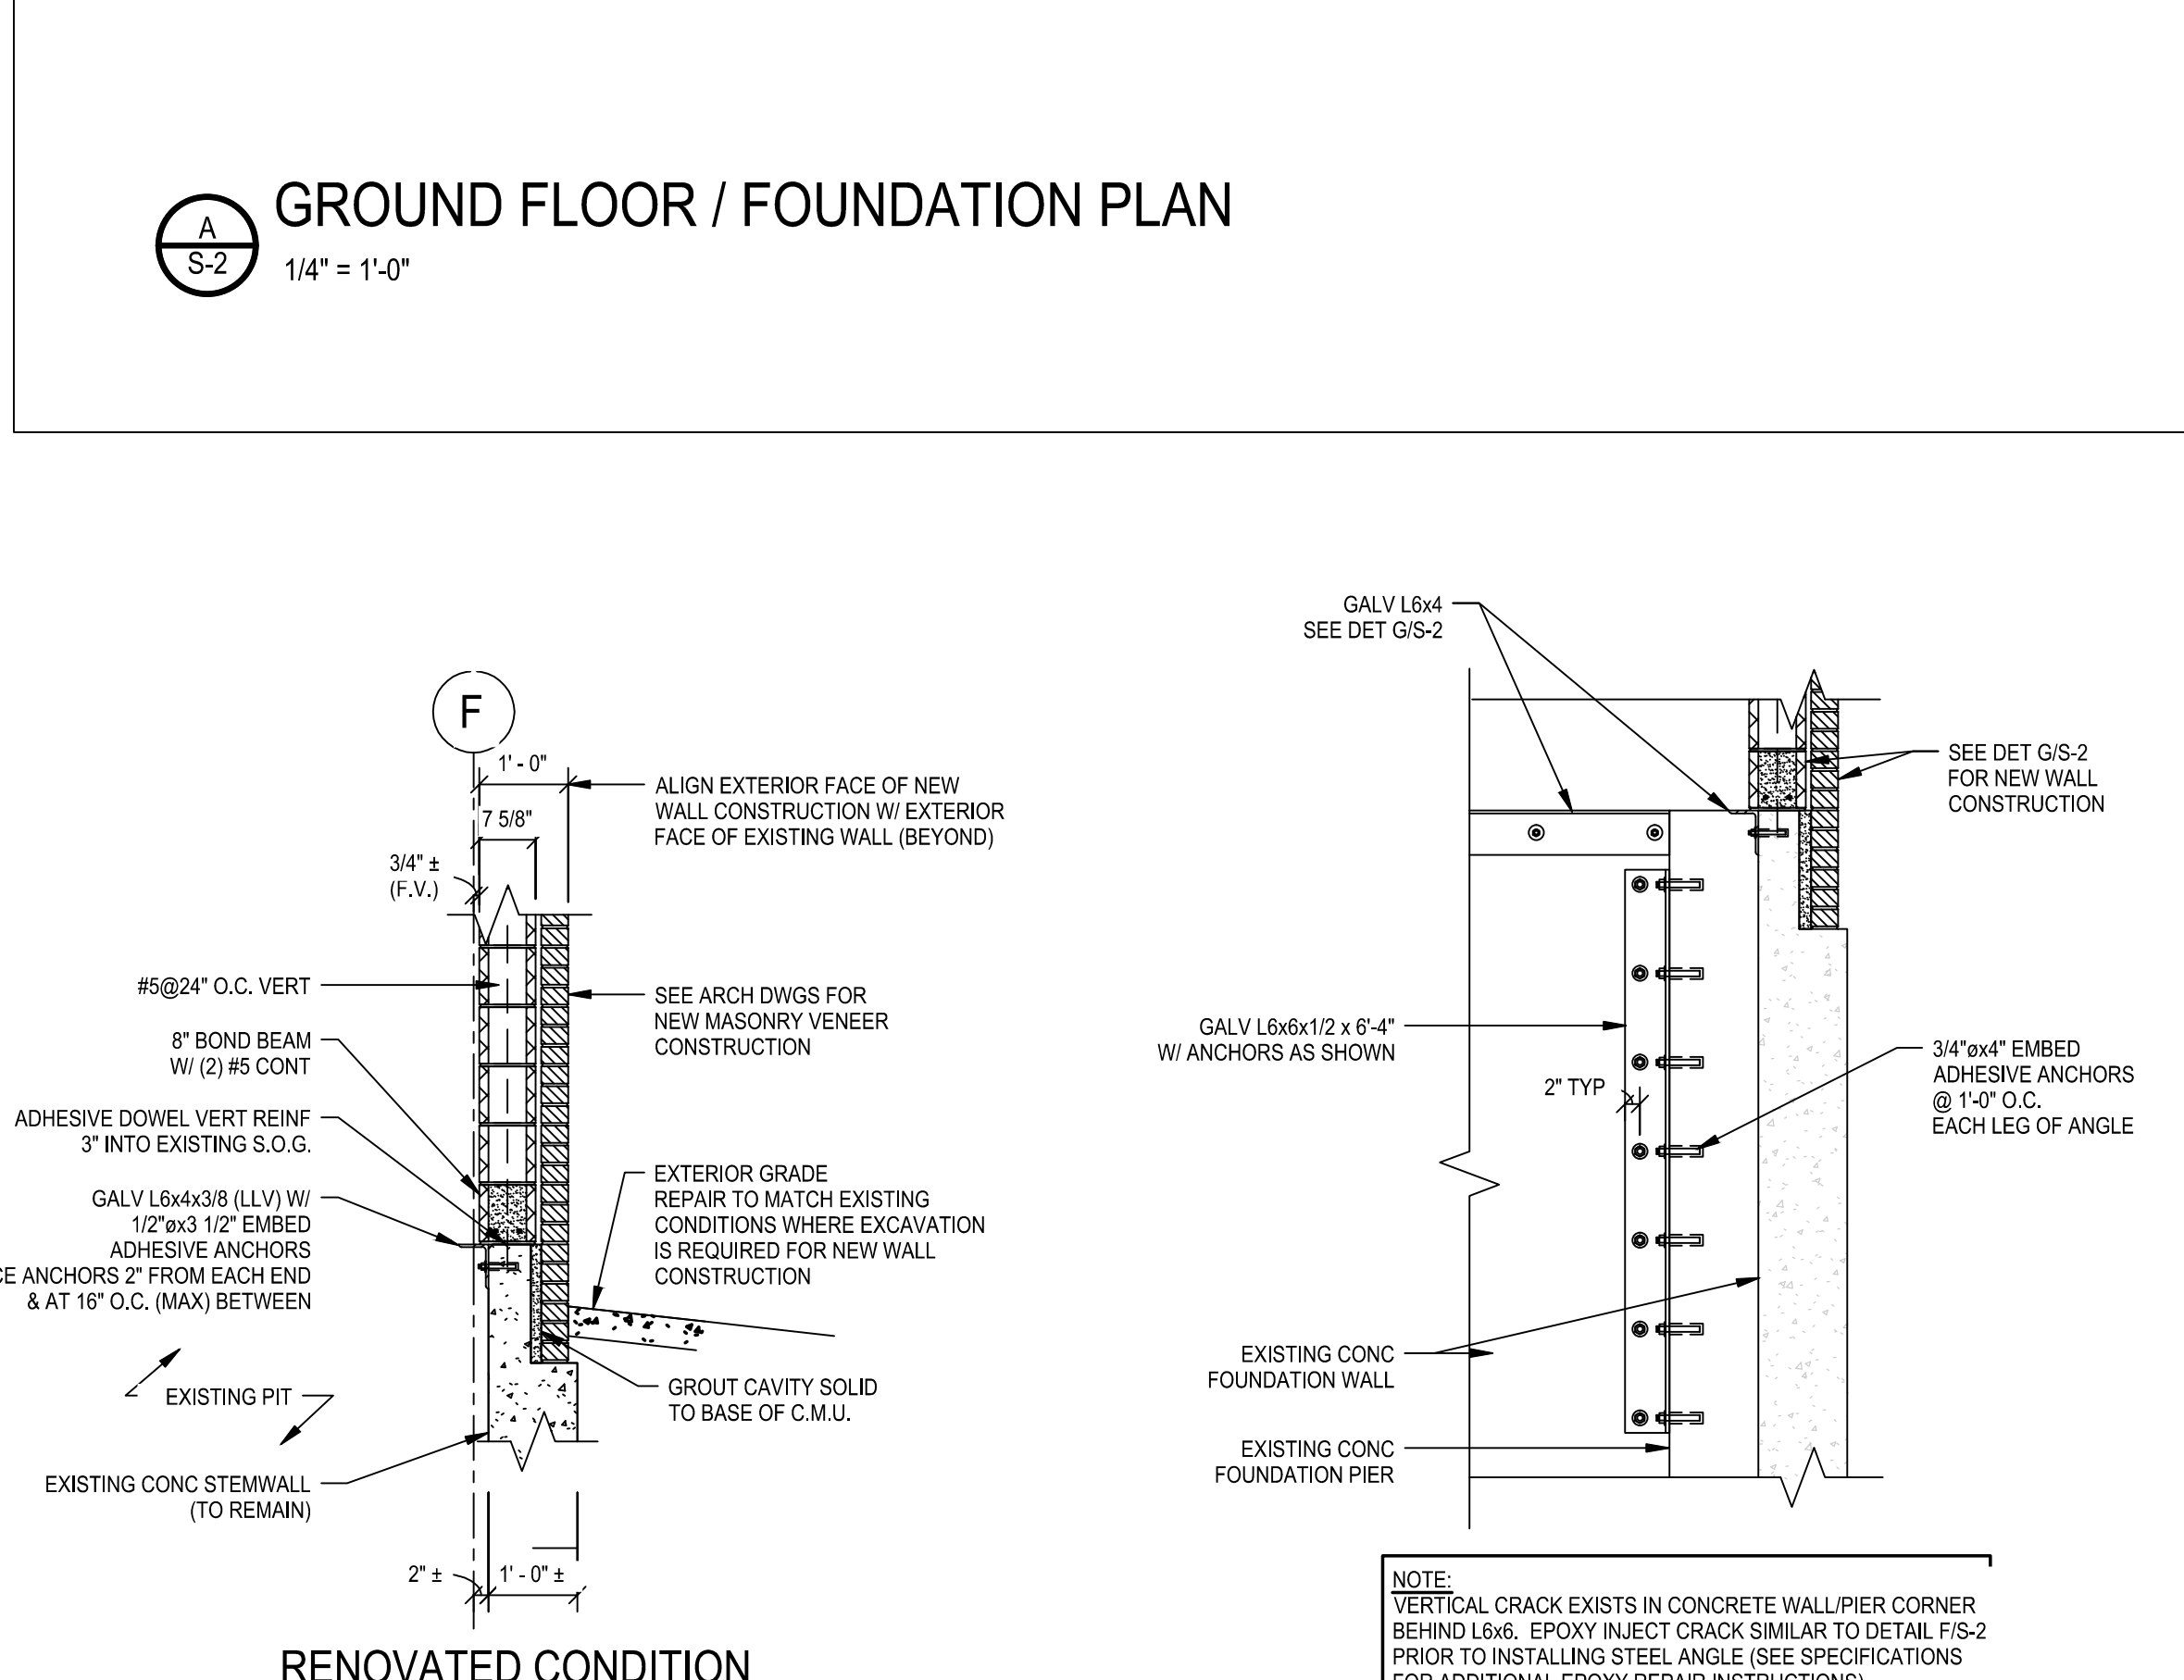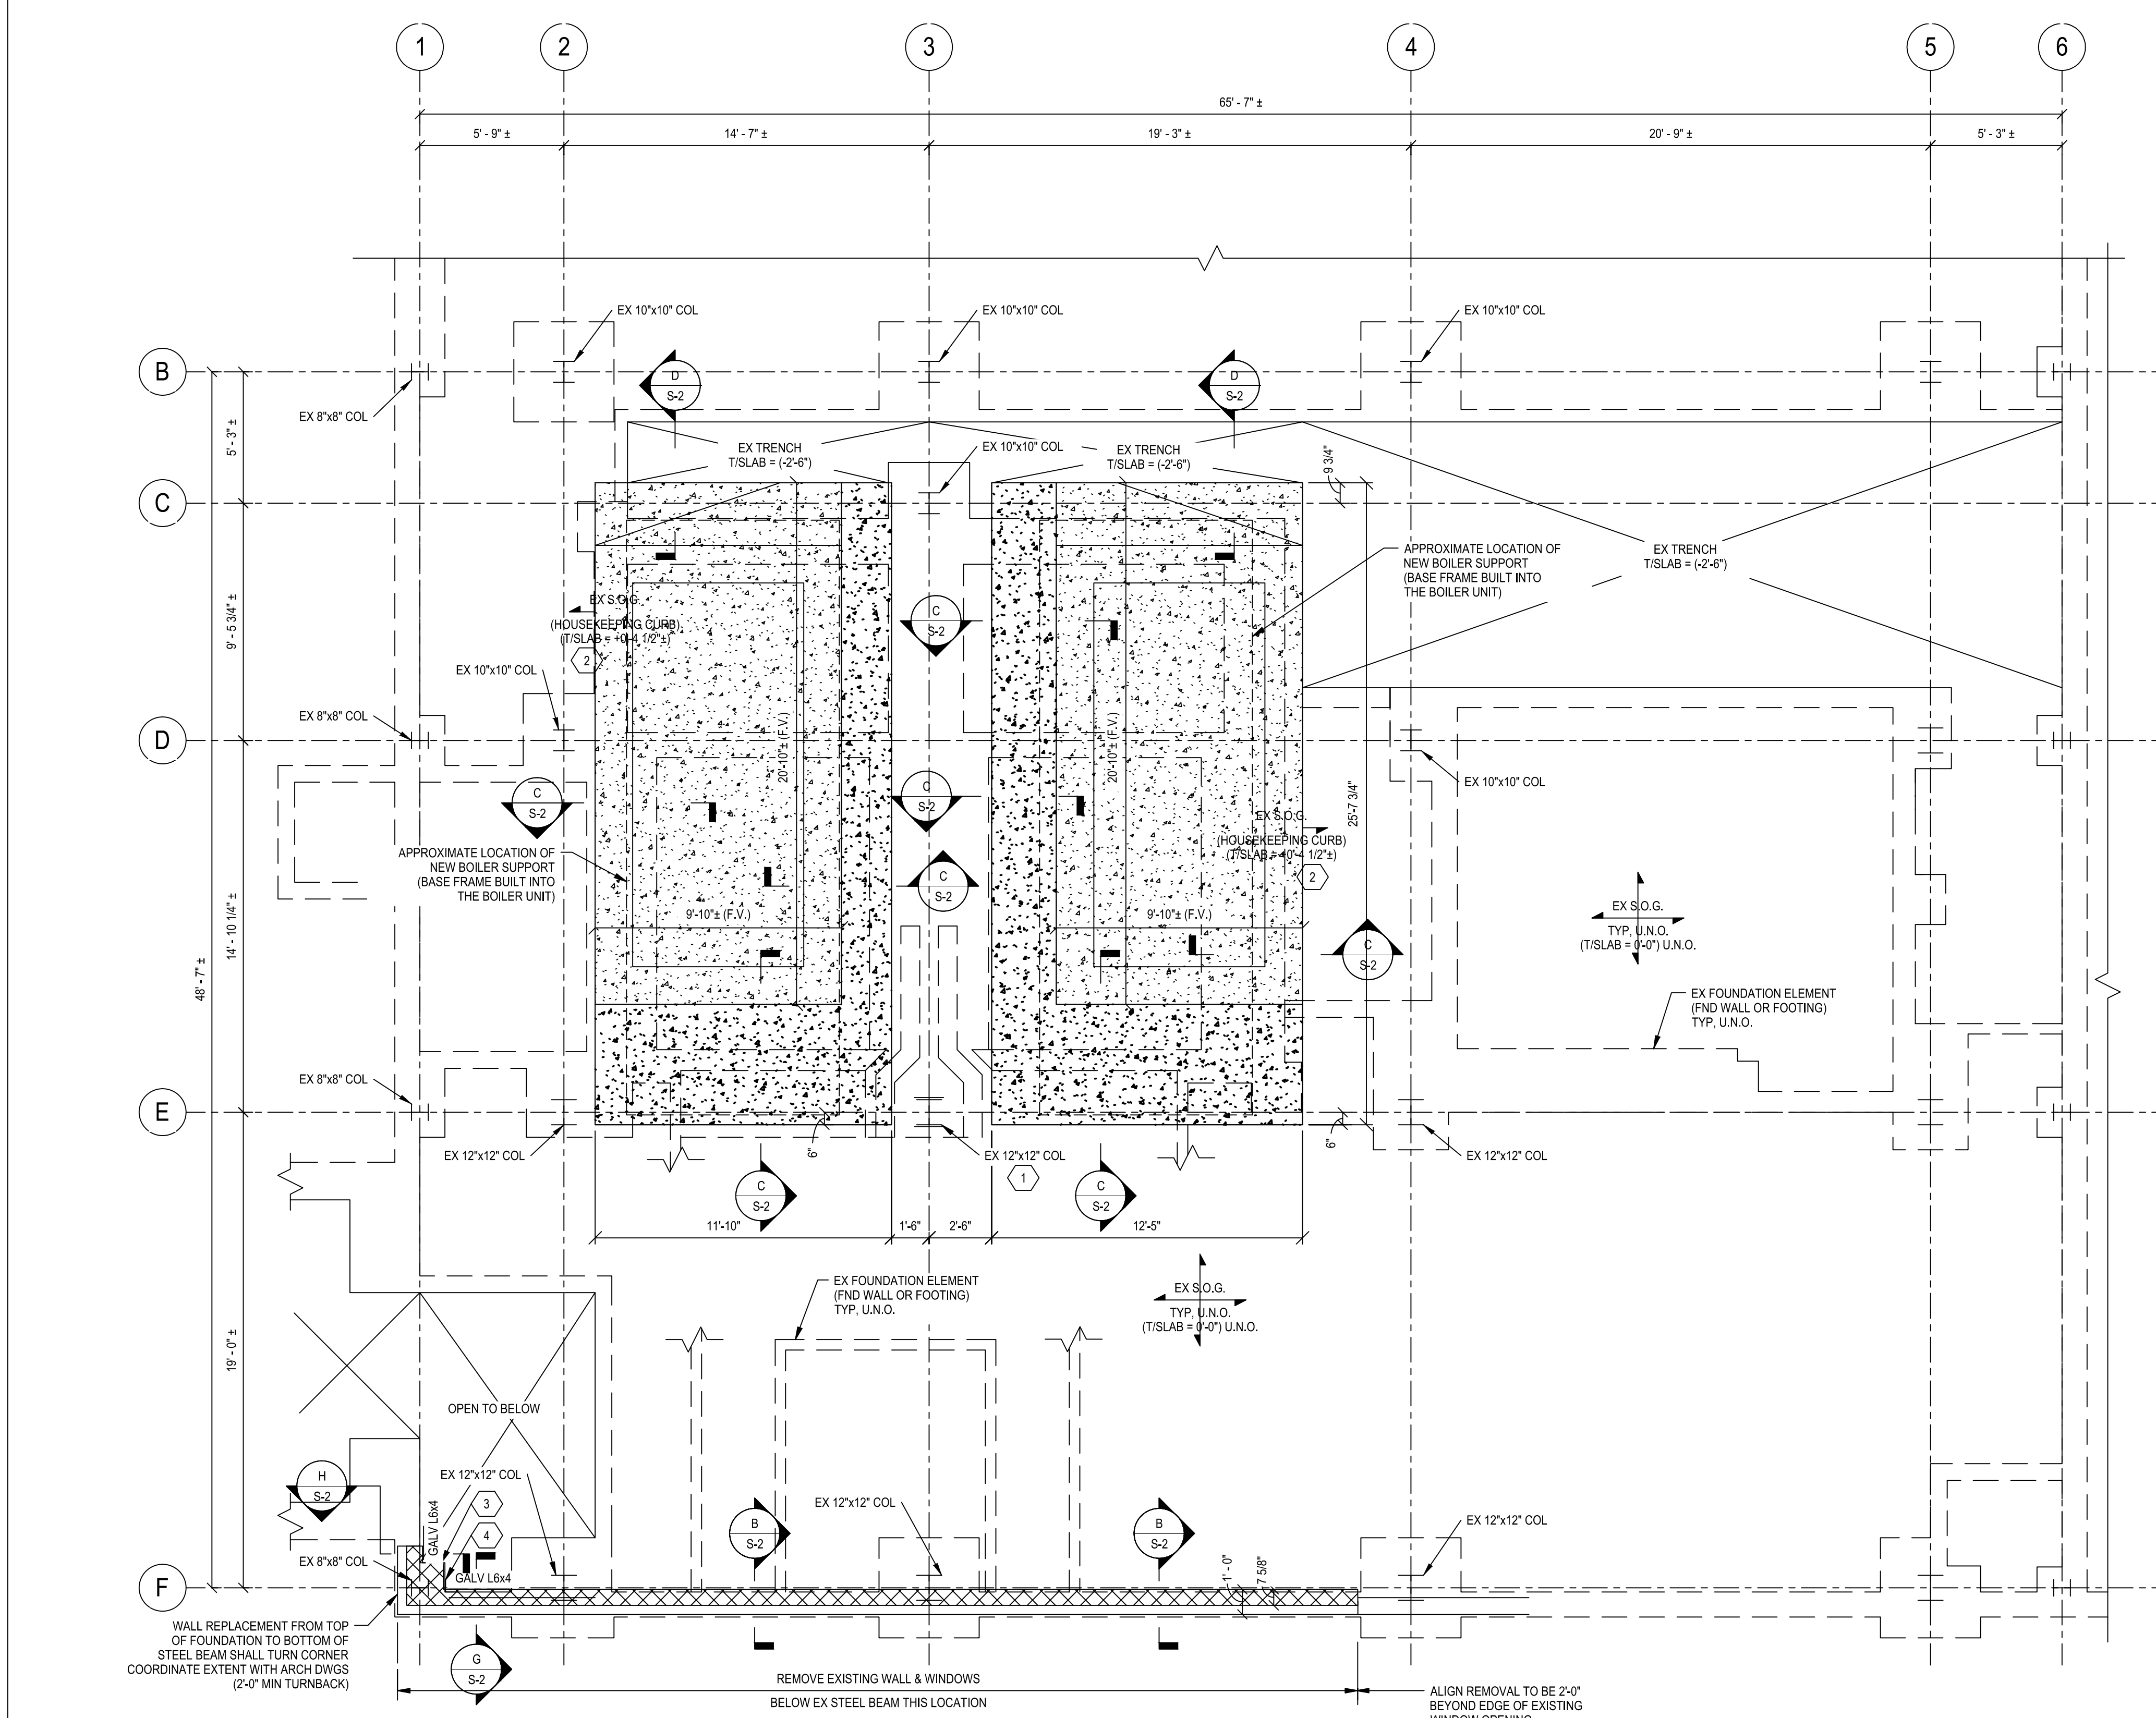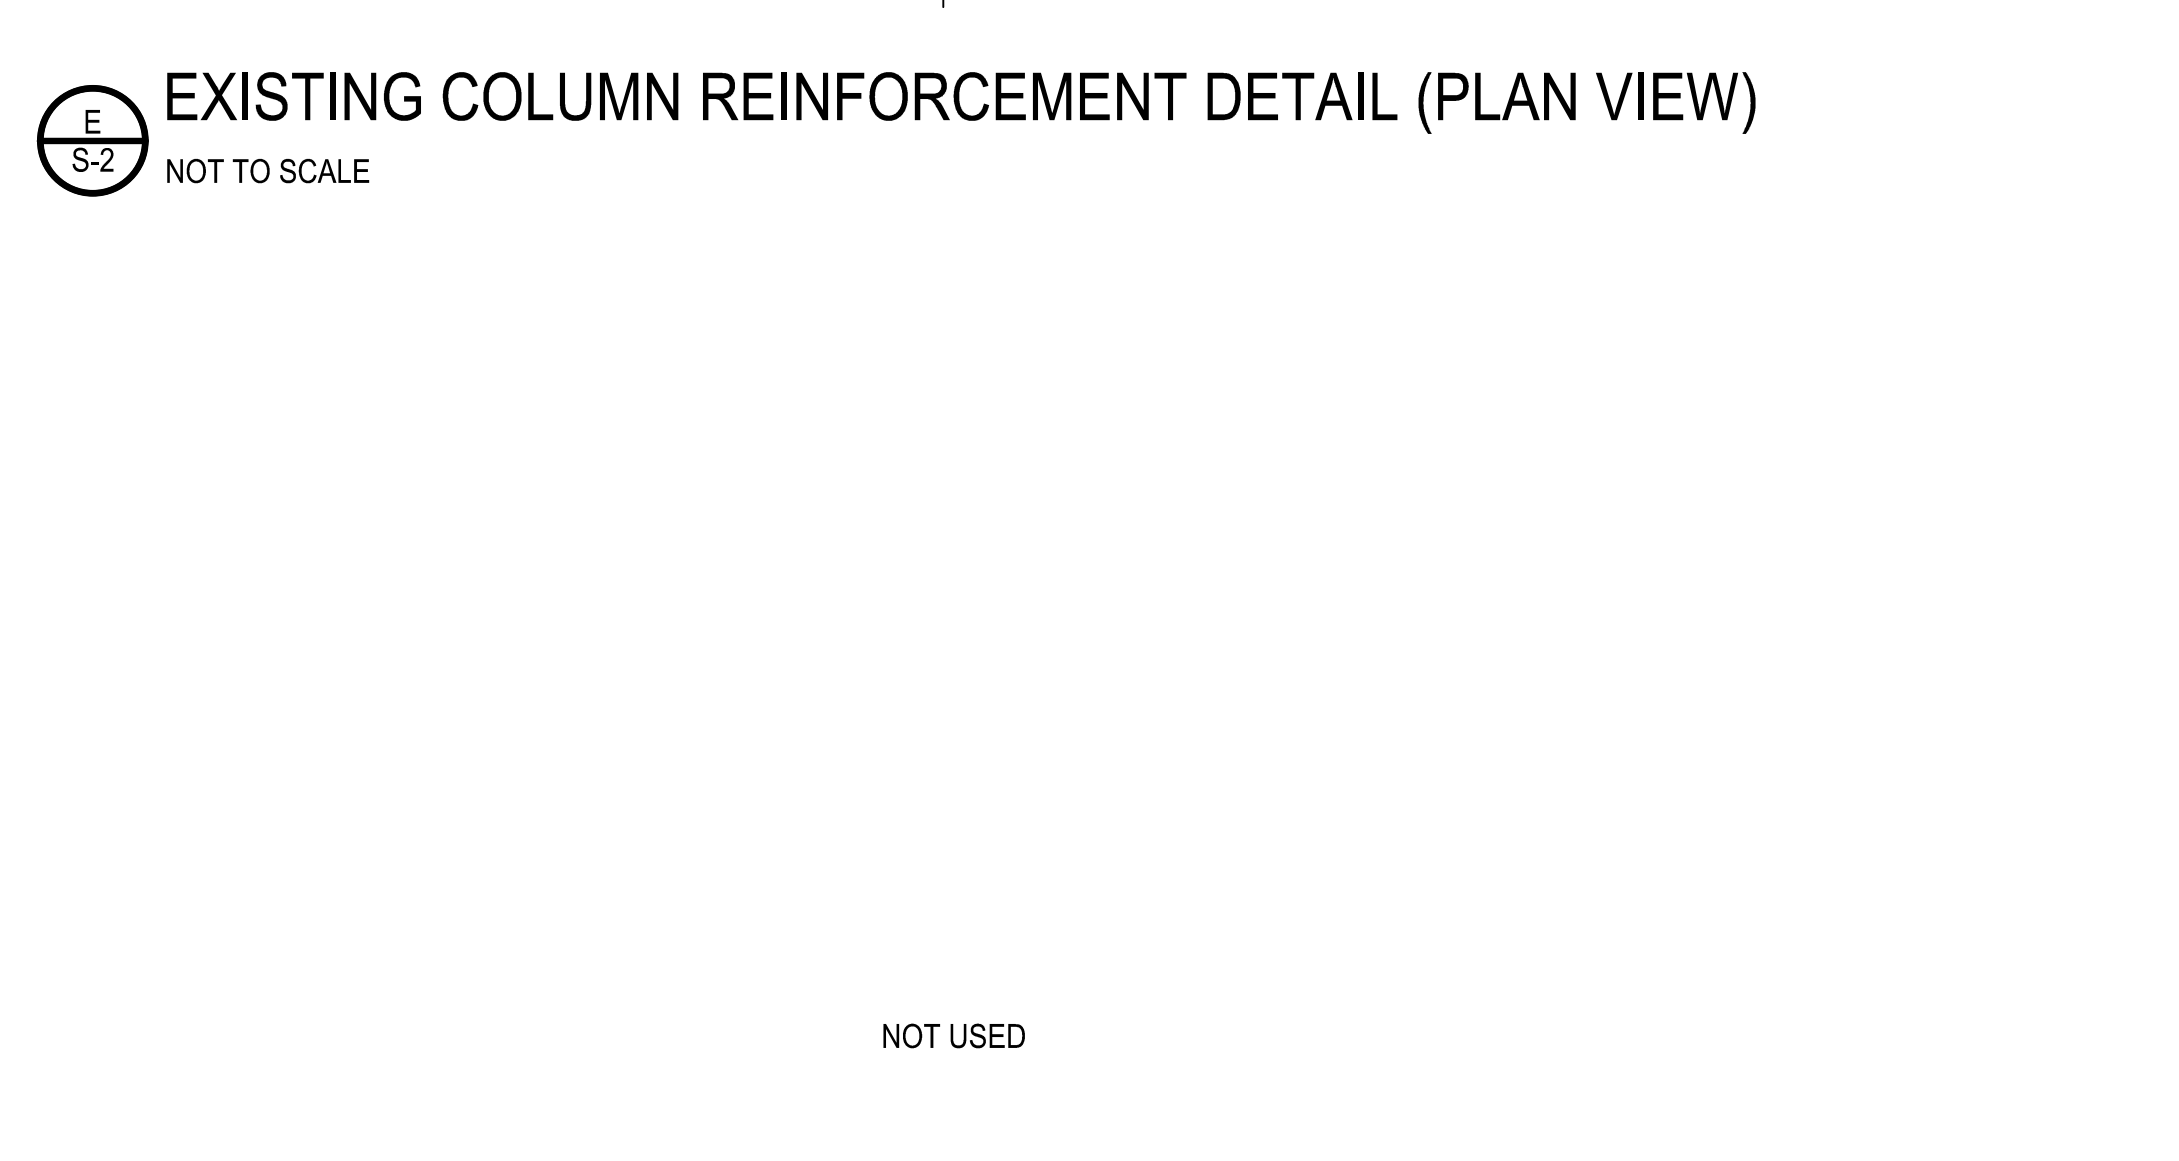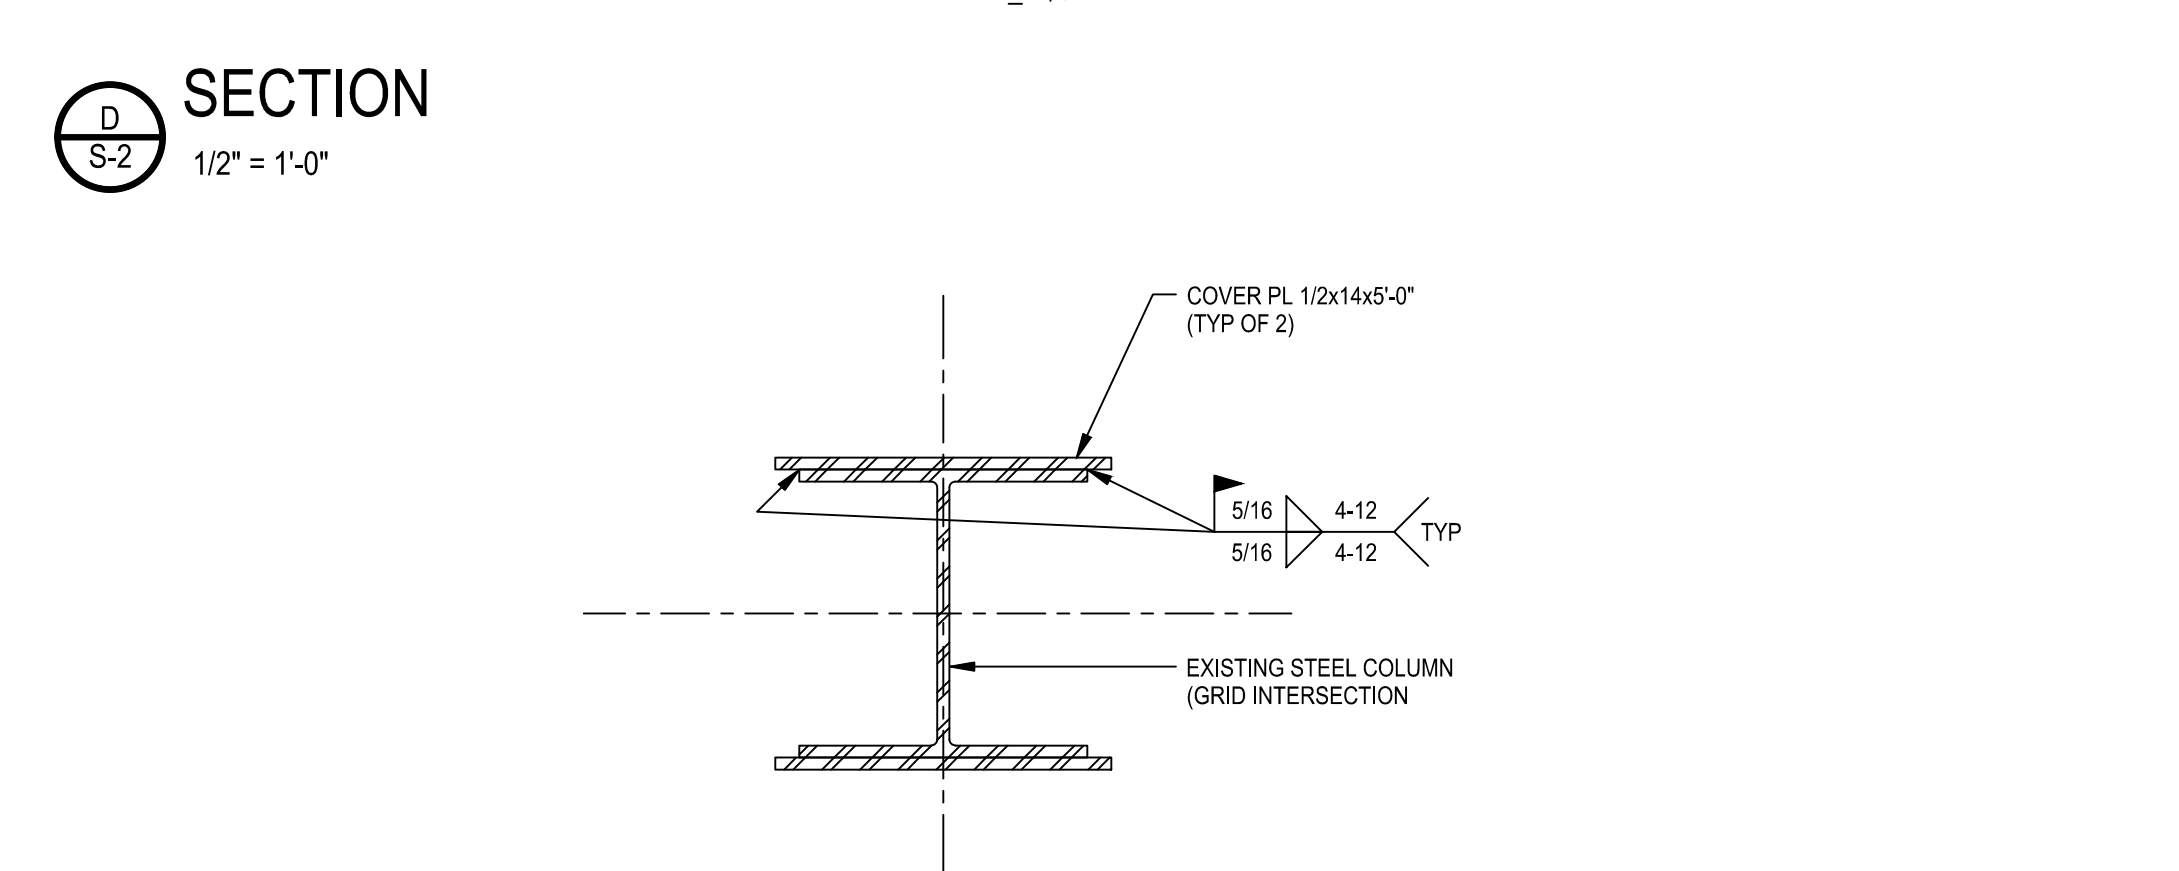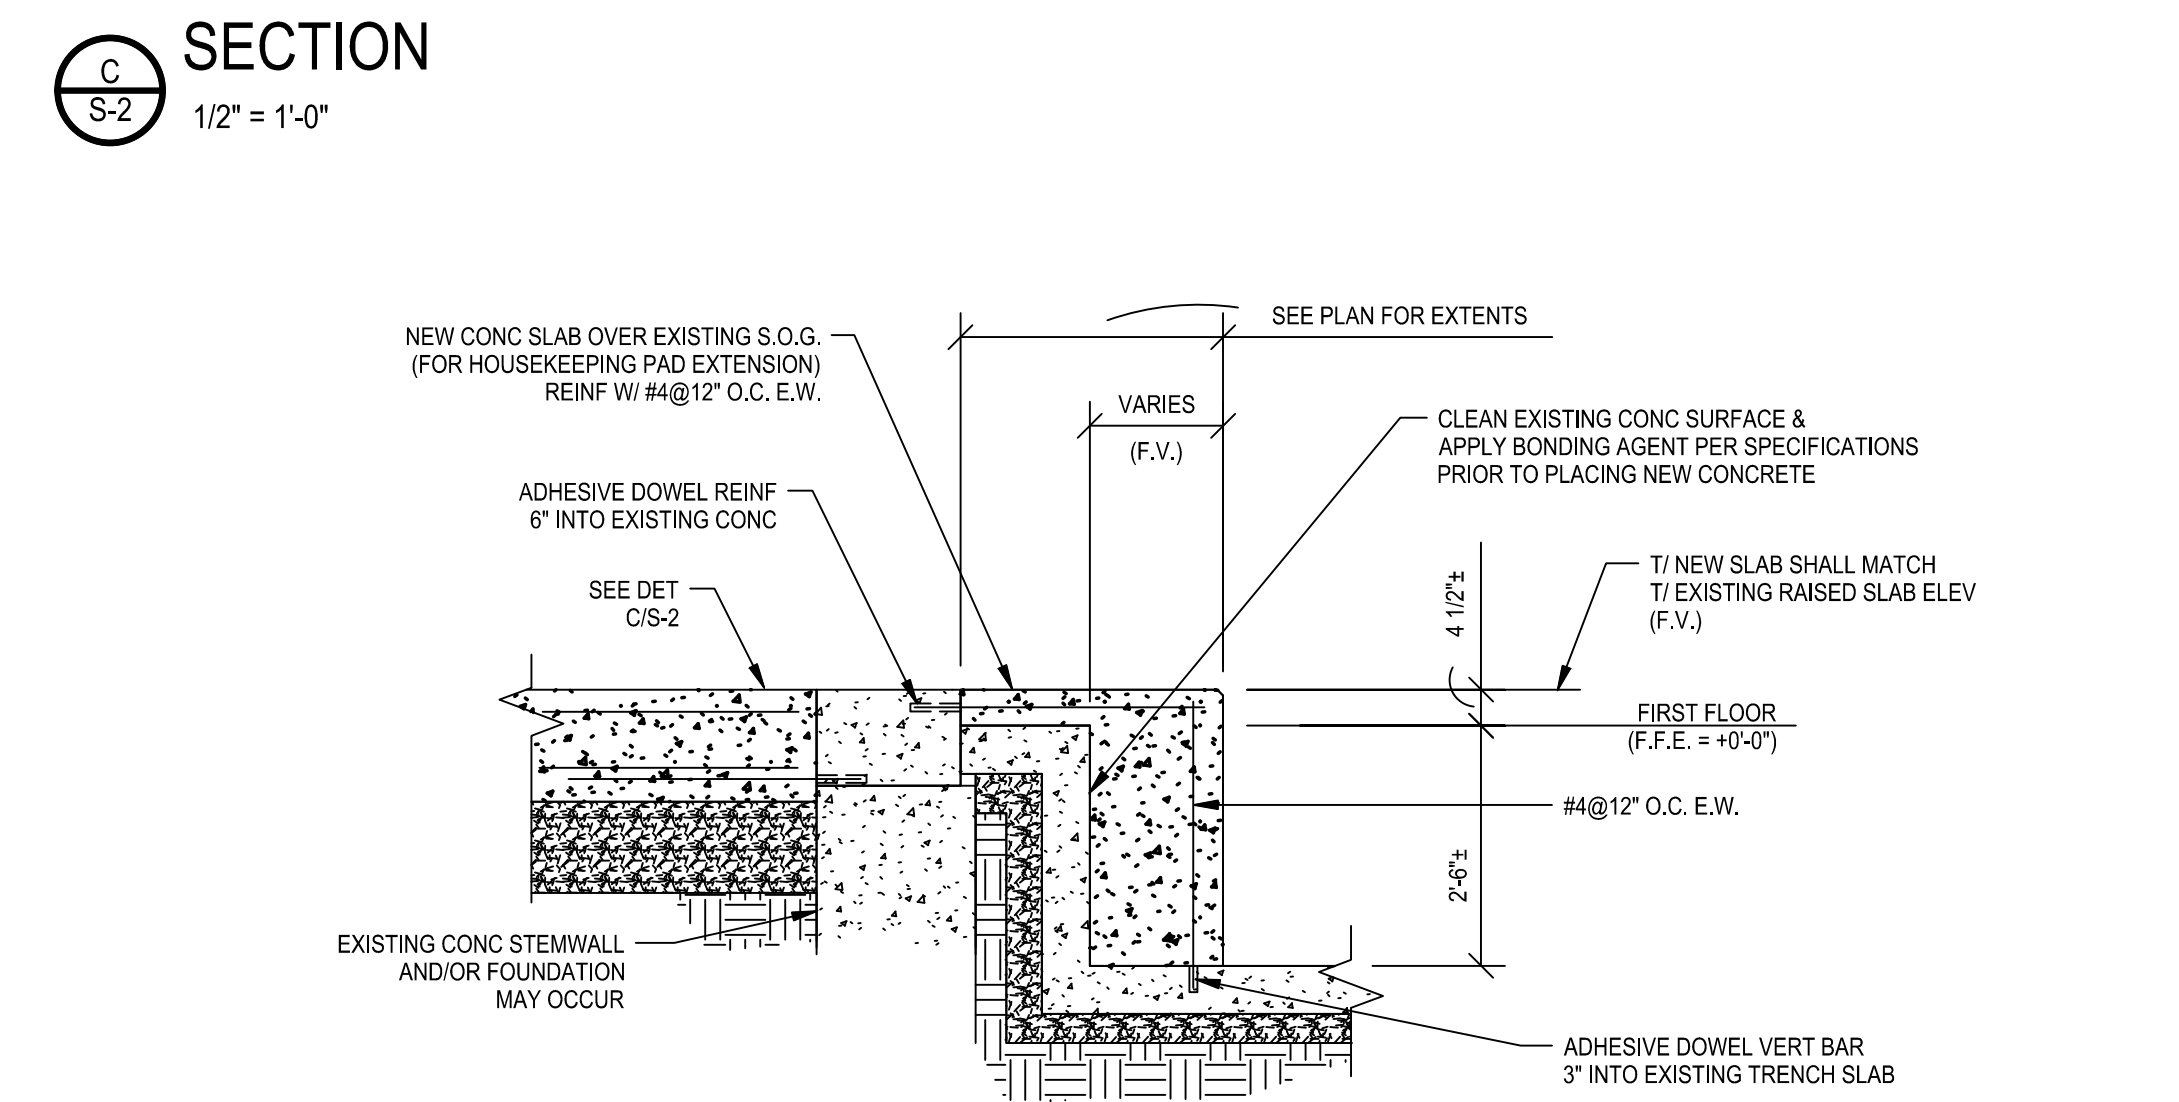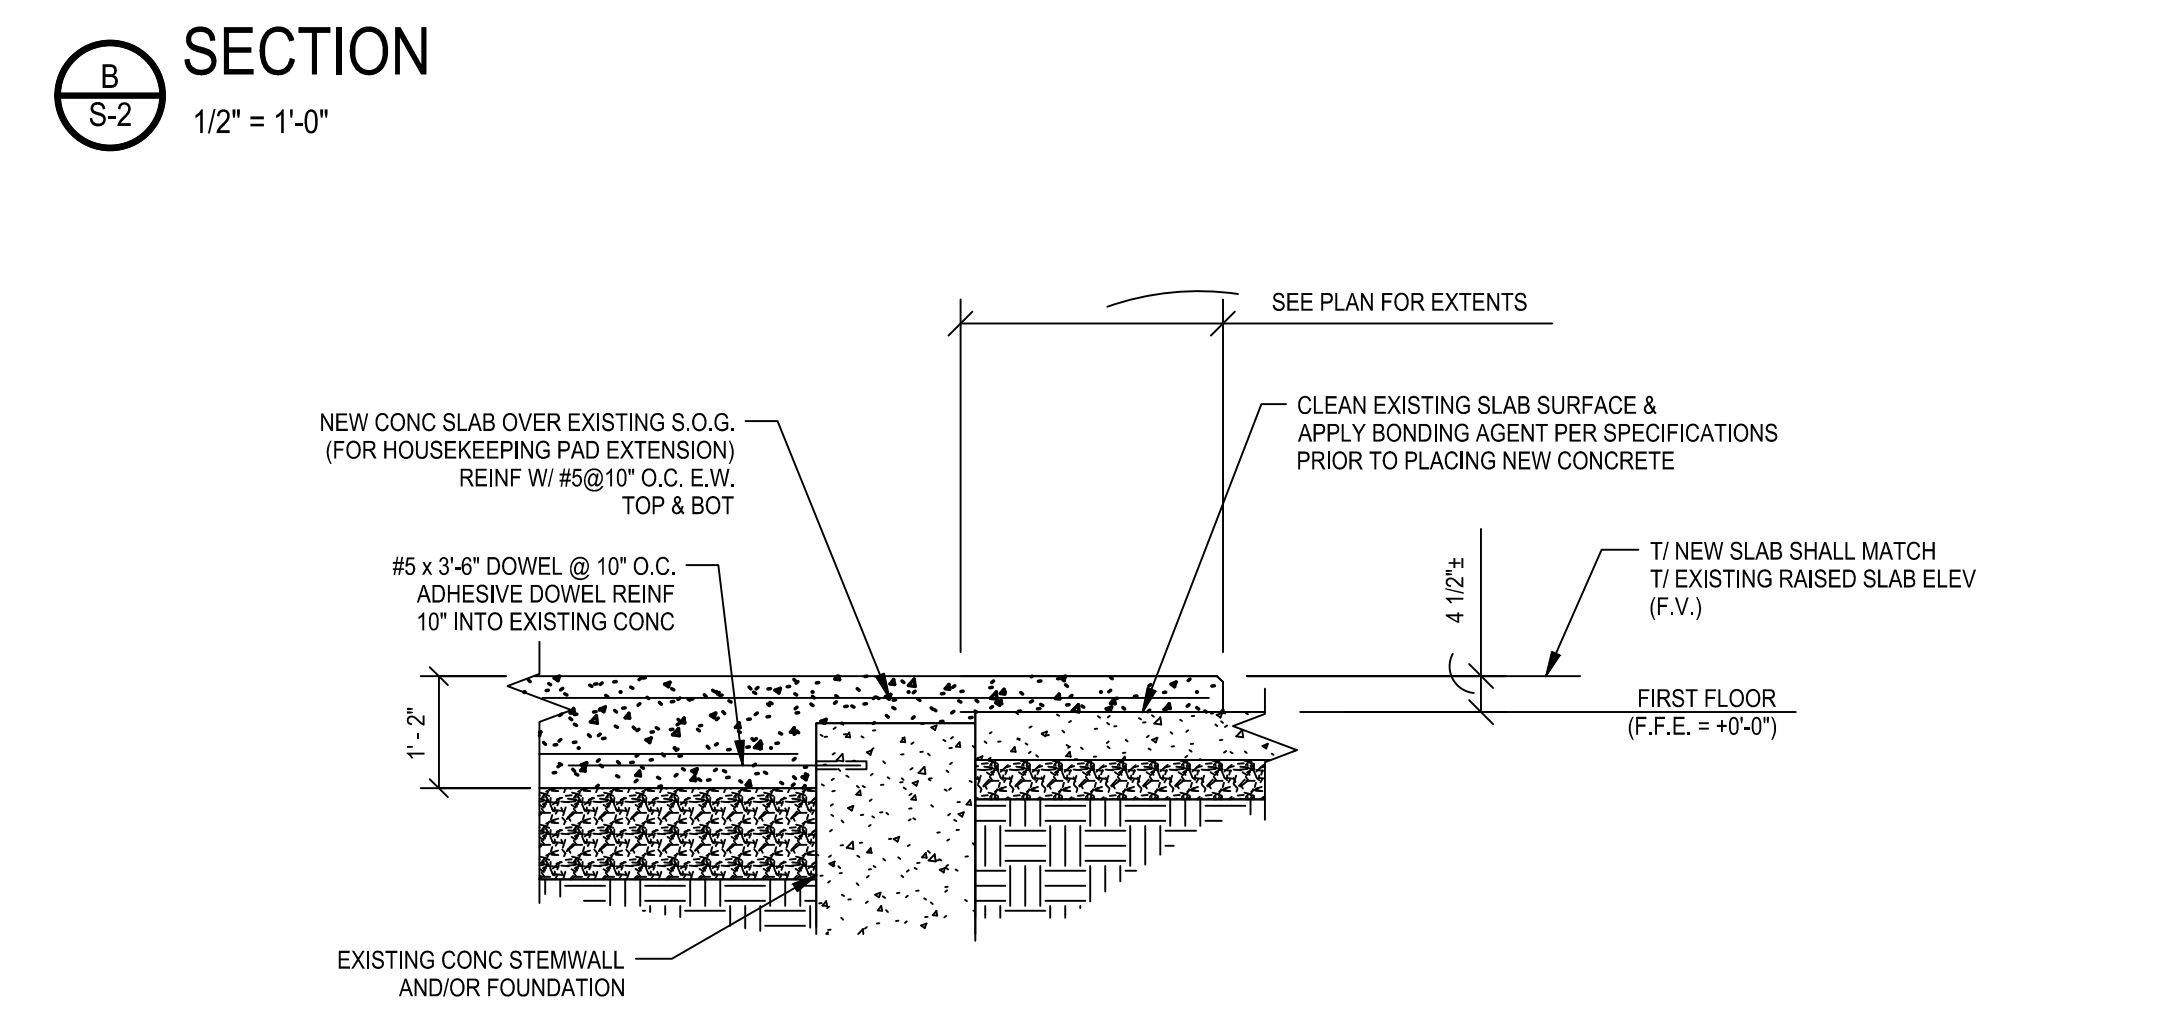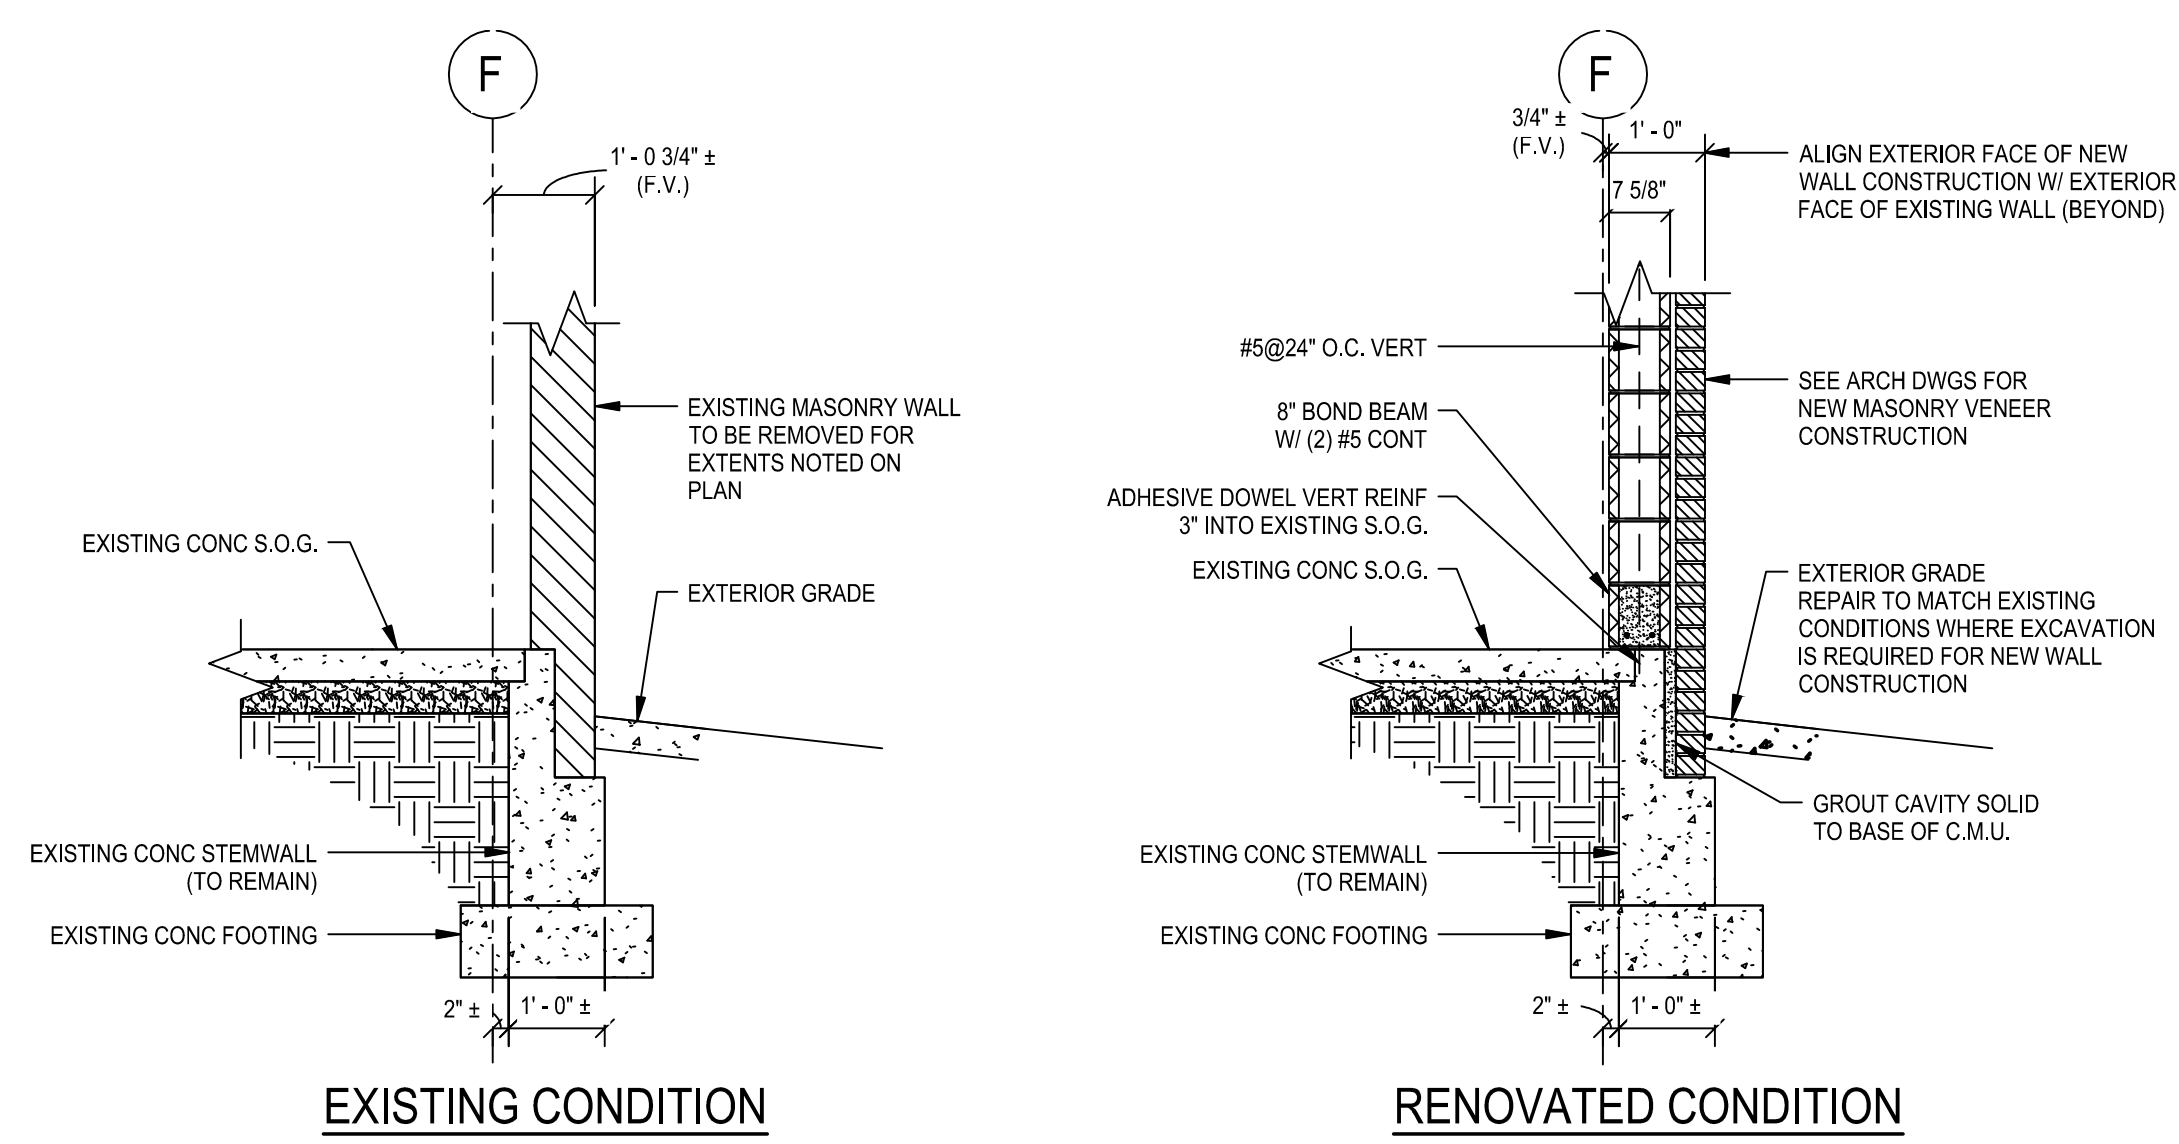

**PLAN NOTES**

- ELEVATIONS SHOWN ARE REFERENCED FROM THE FINISHED FIRST FLOOR REFERENCE ELEVATION = 0'-0".
- SEE DWG S-1 FOR GENERAL NOTES.
- SEE DWG S-5 FOR TYPICAL FRAMING DETAILS.
- SIZE & LOCATION OF MECHANICAL UNITS SHALL BE COORDINATED WITH THE MECHANICAL CONTRACTOR. FRAMING POSITIONS SHALL BE ADJUSTED ACCORDINGLY.
- SOME EXISTING STRUCTURE IS SHOWN BEYOND THE WORK AREA. THIS IS SHOWN FOR REFERENCE ONLY.

**TAG NOTES**

- REINFORCE BOTTOM 5'-0" OF COLUMN PER DETAIL EIS-2.
- REMOVE EXISTING HOUSE KEEPING CURBS. POUR BACK STRUCTURAL CONCRETE SLAB FOR FULL BASE DIMENSION OF NEW BOILER.
- 1-4"x1-4" C.M.U. PIER W/ #5 VERT REIN IN EACH CELL.
- GALVANIZED L6x6x12 x 6'-4". SEE DETAIL HS-2.

**FOUNDATION PLAN LEGEND**

- EXTENTS OF NEW CONCRETE PLACEMENT (U.N.O.)

FINISHED FIRST FLOOR REFERENCE ELEVATION 0'-0" = SEA LEVEL DATUM ELEVATION 944.00' (F.V.)

CONTRACTOR TO VERIFY ALL DIMENSIONS IN THE FIELD.

**BROWN & KUBICAN**  
 STRUCTURAL ENGINEERS  
 2224 Young Drive  
 Lexington, KY 40505  
 Phone: 859-543-0933  
 Fax: 859-543-0733


RECORD DRAWINGS  
 DATE: 10/17/2017

These record drawings have been prepared "in part" on the basis of information furnished by others. The accuracy and completeness of the information and shall not be responsible for any errors or omissions that may be incorporated as a result of construction information provided by others.

BROWN & KUBICAN, P.S.C.

Stagg and Fisher  
 Consulting Engineers, Inc.  
 1921 Green Road  
 Lexington, KY 40517  
 (606) 279-0344

# Central Heating Plant Boiler Replacement Lexington, Kentucky

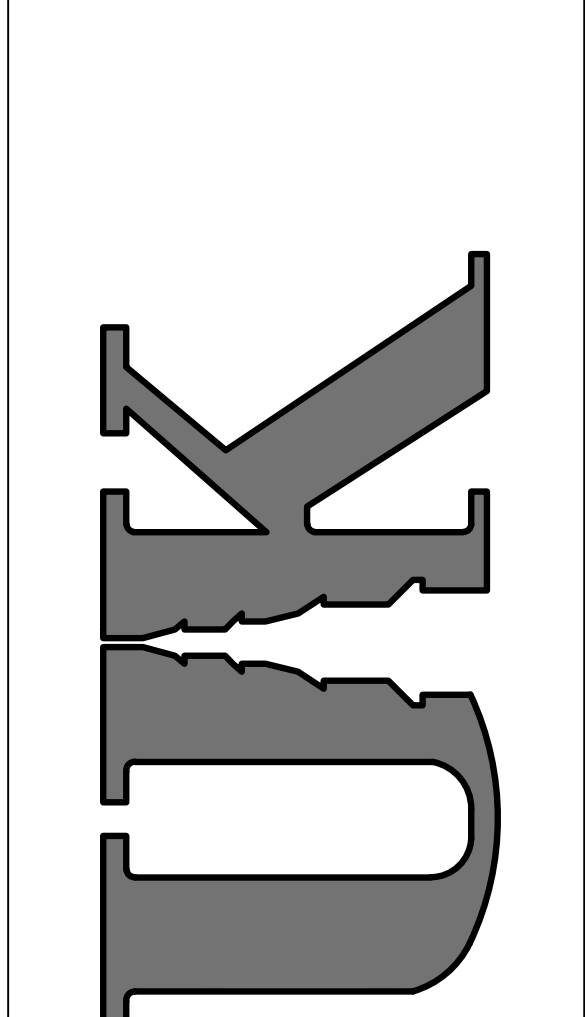

**Disclaimer:**  
 Due to the nature of electronic media, Stagg and Fisher Consulting Engineers, Inc. cannot warrant the accuracy of data contained in files transmitted electronically. Any modification or reuse of original or altered CADD design materials by any entity without the review and written approval of Stagg and Fisher Consulting Engineers, Inc. shall be at the sole risk of said entity. Furthermore, said entity agrees to defend, indemnify, and hold Stagg and Fisher Consulting Engineers, Inc. harmless from any and all injuries, damages, losses, and expenses, including attorney's fees, arising out of any claim resulting from the modification or reuse of these materials.

Drawing Issue:

No.	Date	Description
1	6/22/2017	NEAR GRID E. CATWALK
2	6/29/2017	TRANSFORMER SUPPORT
3	10/17/2017	RECORD DRAWINGS

CONSTRUCTION DOCUMENTS	

Drawing Title:

GROUND FLOOR / FOUNDATION PLAN
--------------------------------

UK Eng. File#: 2429.0
SF File#: 15510
Scale: AS NOTED
Date: 03-23-2016