

APPENDIX NOTES:


- PROVIDE SHUTOFF VALVE IN BOX FOR FIRE HYDRANT.
- REFERENCE UK DETAIL 16700002. ALL DIMENSION NOTED ARE "INSIDE CLEAR" DIMENSIONS. INTERIOR WIDTH SHALL BE 5'-0" IN LIEU OF 4'-0". LID DIAMETER SHALL BE 21" NOT 20". SUMP PUMP SHALL BE A 1-1/4" SUBMERSIBLE 5 GPM AT 24'-0" TDH. 150 RPM 1/2 HP 120 VOLT WITH MERCURY SWITCH LEVEL CONTROL AND LIGHT DUTY IRON GRATE COVER FOR SUMP OPENING. PIPE STORM WATER TO DAYLIGHT AND TERMINATE IN A "NO-COVER" CONCRETE HEADWALL.
- SEE UNIVERSITY OF KENTUCKY DESIGN AND CONSTRUCTION STANDARDS DETAILS 16700001, 16700002, 16700003, 16700005, 16700011, 16700015 AND 16700014. THESE DETAILS ARE FOR THE CONTRACTOR CONVENIENCE. INCLUSION OF THESE DETAILS DOES NOT PERMUTE THE APPLICABILITY OF ALL REFERENCED UNIVERSITY OF KENTUCKY STANDARDS.

NOTES:

1. As a minimum the contractor shall provide utility markers at each building entrance, at each bend and at each road crossing.
2. Brass marker is cast by Bruce Fox Company, New Albany, Indiana, or approved equal.
3. Use suitable information (letter shown above is for example only). Use raised type lettering.
4. Provide an additional utility marker for all existing utilities identified during the subject project.
5. Brass marker must be set flush in concrete when placed in the ground or roadway.

UTILITY COMPANY CONTACTS			
ELEC	PADUCAH POWER SYSTEMS	270 575-4000	RICK WINDHORST 270 575-4021 (FAX)
TELEPHONE	SOUTH CENTRAL BELL	270 444-5900	
CABLE TV	COMCAST CABLEVISION	270 442-6362	
WATER	PADUCAH WATER WORKS	270 444-0522	DARREN RENKIN
SEWER	JOINT SEWER AGENCY	270 575-0056	FRANK OVERBY
GAS	WESTERN KENTUCKY GAS	270 821-7145	ART LEBAHN
FIRE CHIEF	PADUCAH FIRE DEPARTMENT	270 444-8522	STEVE KYLE

These record documents have been prepared on the basis of information furnished by the contractor. CVTA, Inc. is not responsible for any errors or omissions which may have been incorporated into this document as a result of incomplete or erroneous information.

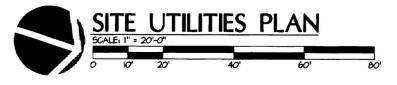

Consulting Engineers
Mechanical Electrical
14409 N. Forbes Rd.
Lexington, KY 40504
502/253/0682

**Crisp Building Replacement
Paducah Community College**

SITE UTILITIES PLAN

Sherman Carter Barnhart
PSC
PARTNERS IN ARCHITECTURE
2405 HARBOURSBURG ROAD • LEXINGTON, KY 40504 • PH: 502-254-1511 • FAX: 502-254-8446

UTILITY COMPANY CONTACTS	270 575-4000	RICK WINDHORST
ELEC	270 575-4021 (FAX)	
TELEPHONE	270 444-5900	
CABLE TV	270 442-6362	
WATER	270 444-0522	DARREN RENKIN
SEWER	270 575-0056	FRANK OVERBY
GAS	270 821-7145	ART LEBAHN
FIRE CHIEF	270 444-8522	STEVE KYLE

JOB NO. 0044/0000
DATE FEBRUARY 01, 2001
DRAWN ROI, BJO
CHECKED DC, DRH, TEM
COPYRIGHT © 2001
SHERMAN / CARTER /
BARNHART, PSC

REVISIONS
RECORD DRAWING 4/13/02

SHEET
ME-2