

HEATING AND COOLING PLANT

U.K. MEDICAL CENTER
(EXIST. BLDG.)
First Floor Elev. - 993.95
Ground Floor Elev. - 979.03

NEW MEDICAL CENTER ADDITION
Ground Floor Elev. - 979.03



HOSPITAL PARKING GARAGE
(UNDER CONSTRUCTION)

DELETED PER C/PK S-2

SITE PLANTING PLAN


SCALE: 1" = 20'

IN THE AREA WEST OF THE NEW BUILDING BETWEEN ROSE STREET AND HOSPITAL DRIVE AND SOUTH OF THE TEMPORARY ACCESS ROAD TO ROSE STREET FURNISH & INSTALL SOD IN ALL DISTURBED AREAS WHERE THE TEMPORARY GRAVEL PARKING HAS BEEN REMOVED.

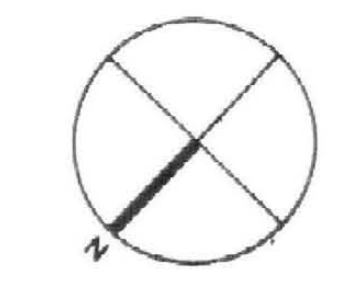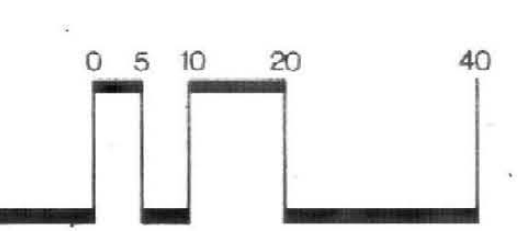

- NOTES:**
- SEE SHT S-3 FOR SITE SYMBOLS AND ABBREVIATIONS.
 - SEE SHT S-5 FOR PLANTING NOTES.
 - SEE SHT S-5 FOR PLANT LIST AND PLANTING DETAILS.

ALBERT B. CHANDLER MEDICAL CENTER UNIVERSITY OF KENTUCKY HOSPITAL EXPANSION & RENOVATION

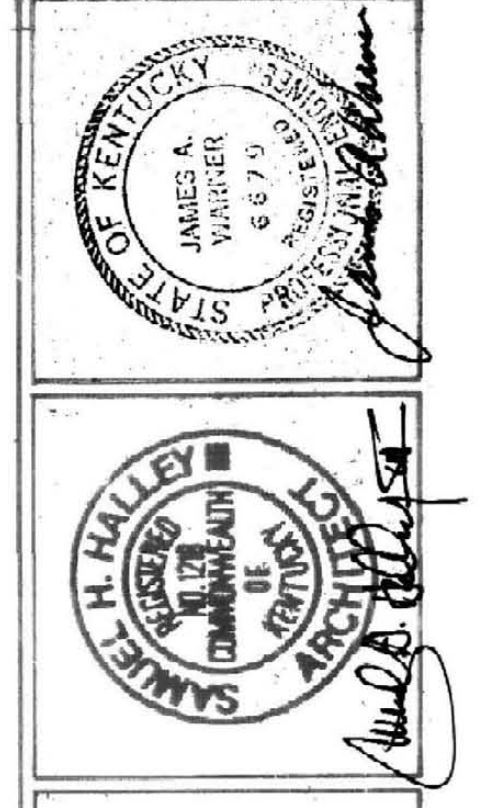

OMNI/CMW Joint Venture Architects
In Association with Hellmuth, Obata, & Kassabaum
2085 Harrodsburg Road, Lexington, KY 40504 PH 606-253-3345
308 S. Broadway, Lexington, KY 40505 PH 606-254-8823

SITE PLANTING
HOSPITAL EXPANSION & RENOVATION
ALBERT B. CHANDLER MEDICAL CENTER
PROJECT NO. 304.1

University of Kentucky
Design & Construction
W. M. S. M.
Director

Date: **DEC 27**
Drawn by: **SEM**
Check by: **ME**
Revisions:

S-4
HOSPITAL ADDITION