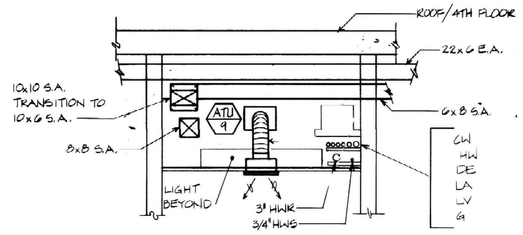

M SECTION
SCALE: 1/2"=1'-0"

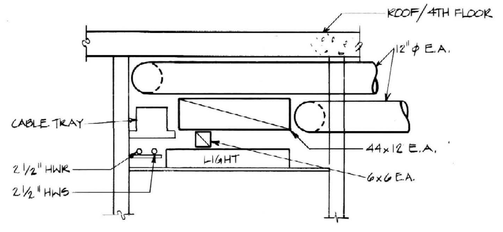

I SECTION
SCALE: 1/2"=1'-0"

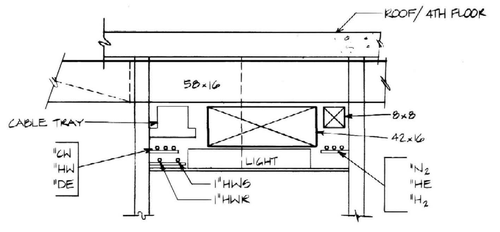

E SECTION
SCALE: 1/2"=1'-0"

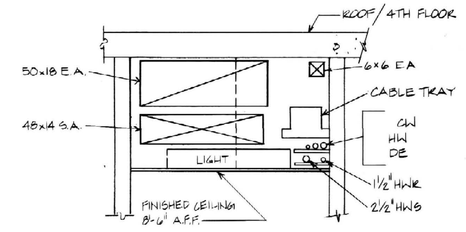

A SECTION
SCALE: 1/2"=1'-0"

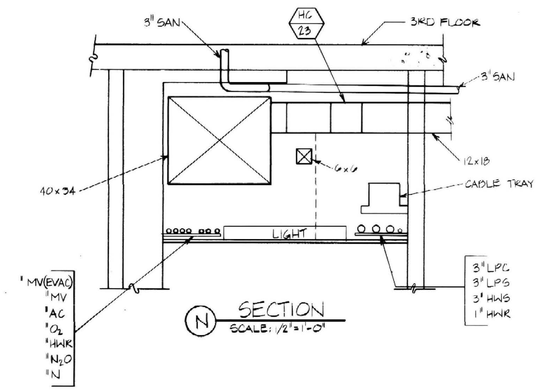

N SECTION
SCALE: 1/2"=1'-0"

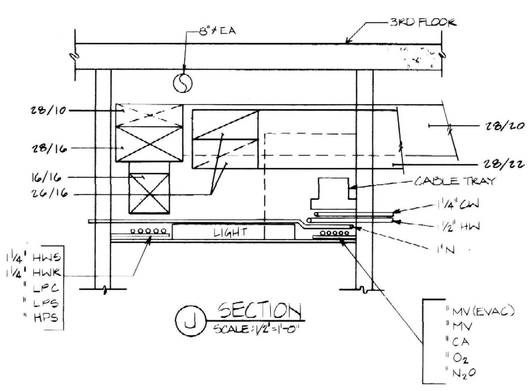

J SECTION
SCALE: 1/2"=1'-0"

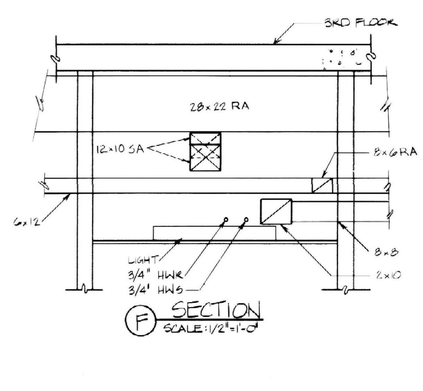

F SECTION
SCALE: 1/2"=1'-0"

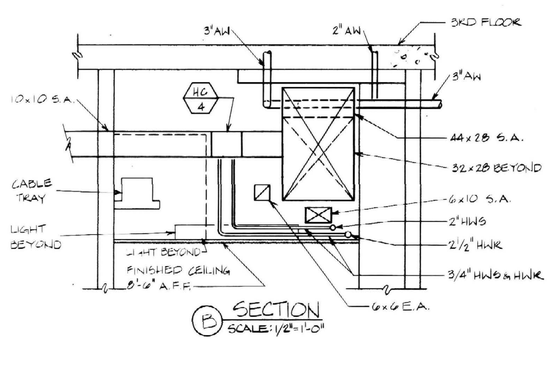

B SECTION
SCALE: 1/2"=1'-0"

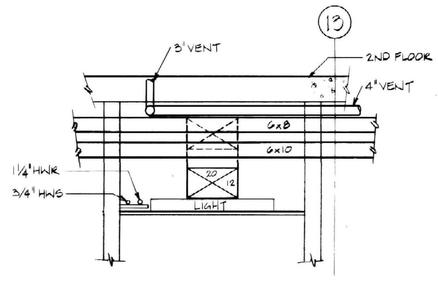

O SECTION
SCALE: 1/2"=1'-0"

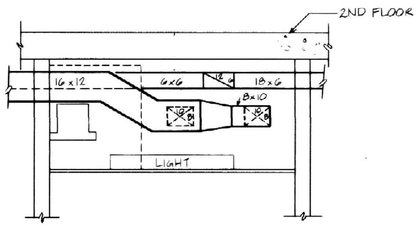

K SECTION
SCALE: 1/2"=1'-0"

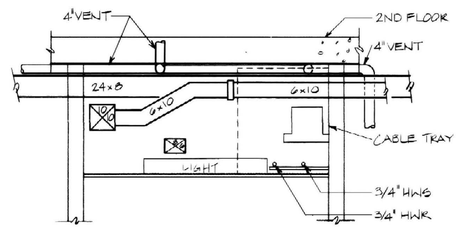

G SECTION
SCALE: 1/2"=1'-0"

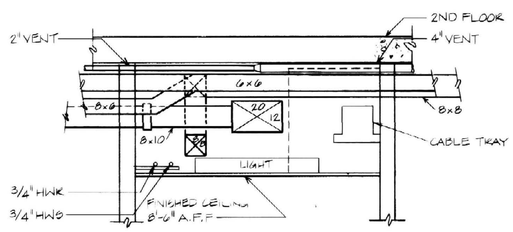

C SECTION
SCALE: 1/2"=1'-0"

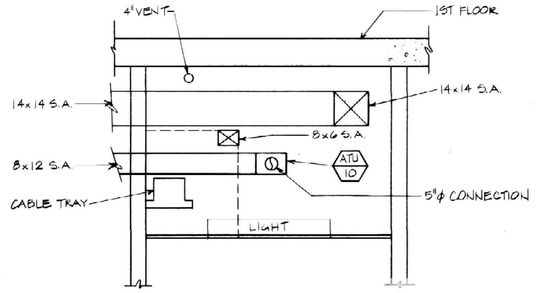

P SECTION
SCALE: 1/2"=1'-0"

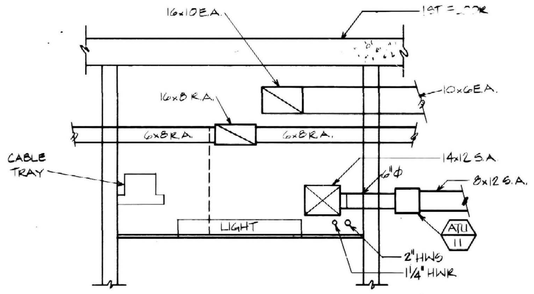

L SECTION
SCALE: 1/2"=1'-0"

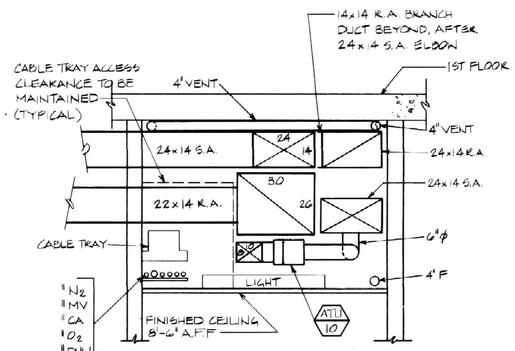

H SECTION
SCALE: 1/2"=1'-0"

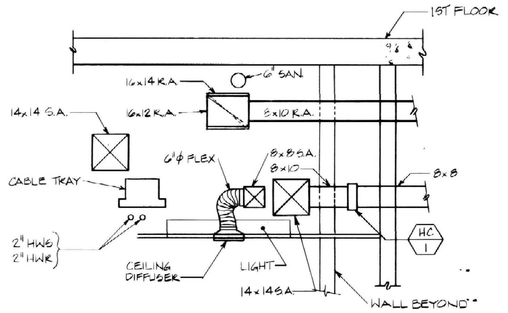

D SECTION
SCALE: 1/2"=1'-0"

RECORD DRAWINGS DATE 10-22-93

These record drawings have been prepared, in part, on the basis of information compiled and furnished by others. The Engineer will not be responsible for any errors or omissions which have been incorporated into this document as a result.

STAGGS & FISHER CONSULTING ENGINEERS, INC.

M-24	
M-24	M-24
AS-2	AS-2

ALBERT B. CHANDLER MEDICAL CENTER UNIVERSITY OF KENTUCKY HOSPITAL EXPANSION & RENOVATION

OMNI/CMW Joint Venture Architects
In Association with Hellmuth, Obata, & Kassabaum

Omni Architects — 2365 Harrodsburg Road, Lexington, KY 40504 Ph 606-223-3045
Chrisman-Miller-Woodford — 326 S. Broadway, Lexington, KY 40508 Ph 606-254-6823

Hellmuth, Obata, & Kassabaum, Inc.
M-E-P Engineering
190 North Broadway, St. Louis, Mo. 63102 Ph 314-421-2000

Sections

HOSPITAL EXPANSION & RENOVATION
A. B. CHANDLER MEDICAL CENTER
PROJECT NO. 304.1

BID PACKAGE #2

University of Kentucky
Design & Construction
Approval
Director
FEB 05 1988

Date 11/87
Drawn by JEB
Check by
Revisions
1

M•24

HOSPITAL ADDITION