



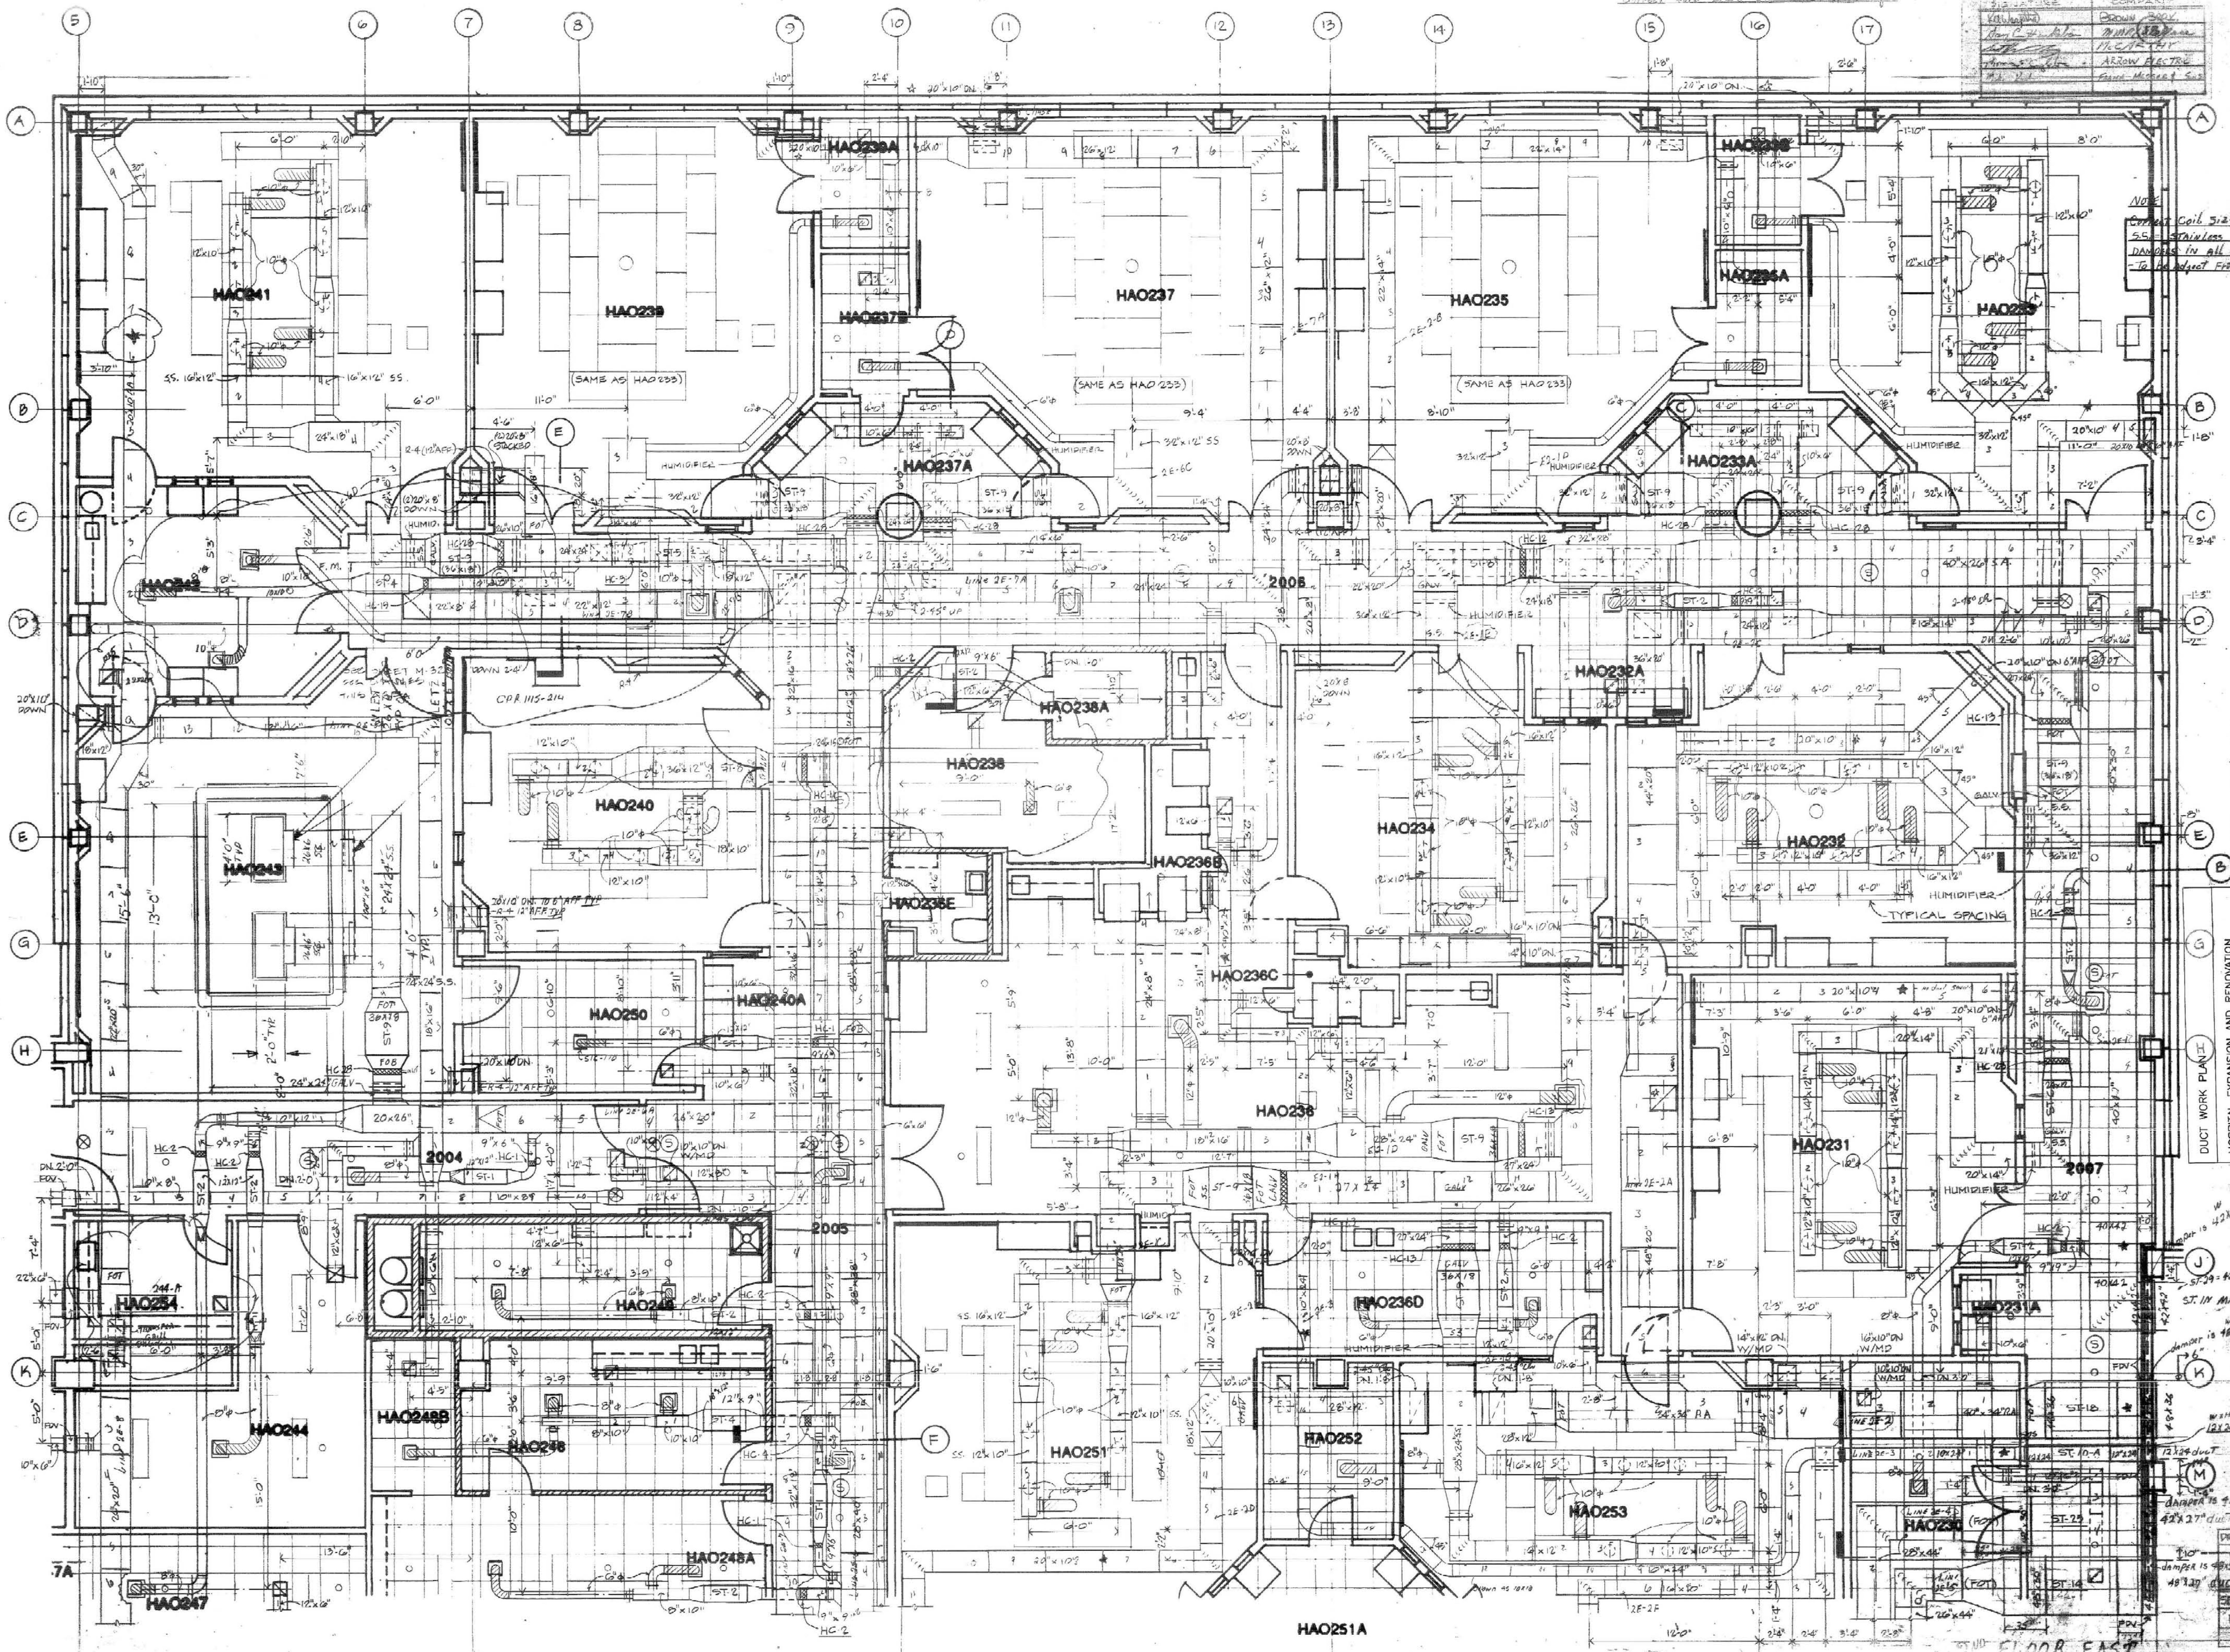

NOTE:  
Coil Size Shows  
55 STAINLESS STEEL  
DAMPERS IN ALL O.A. ROOMS  
TO BE ADJUSTED FROM GRID  
TO GRID

DUCT WORK PLAN I  
HOSPITAL EXPANSION AND RENOVATION  
A. B. CHANDLER MEDICAL CENTER  
PROJECT NO. 304.1  
PID PACKAGE #2

FLOOR EAST  
PART III