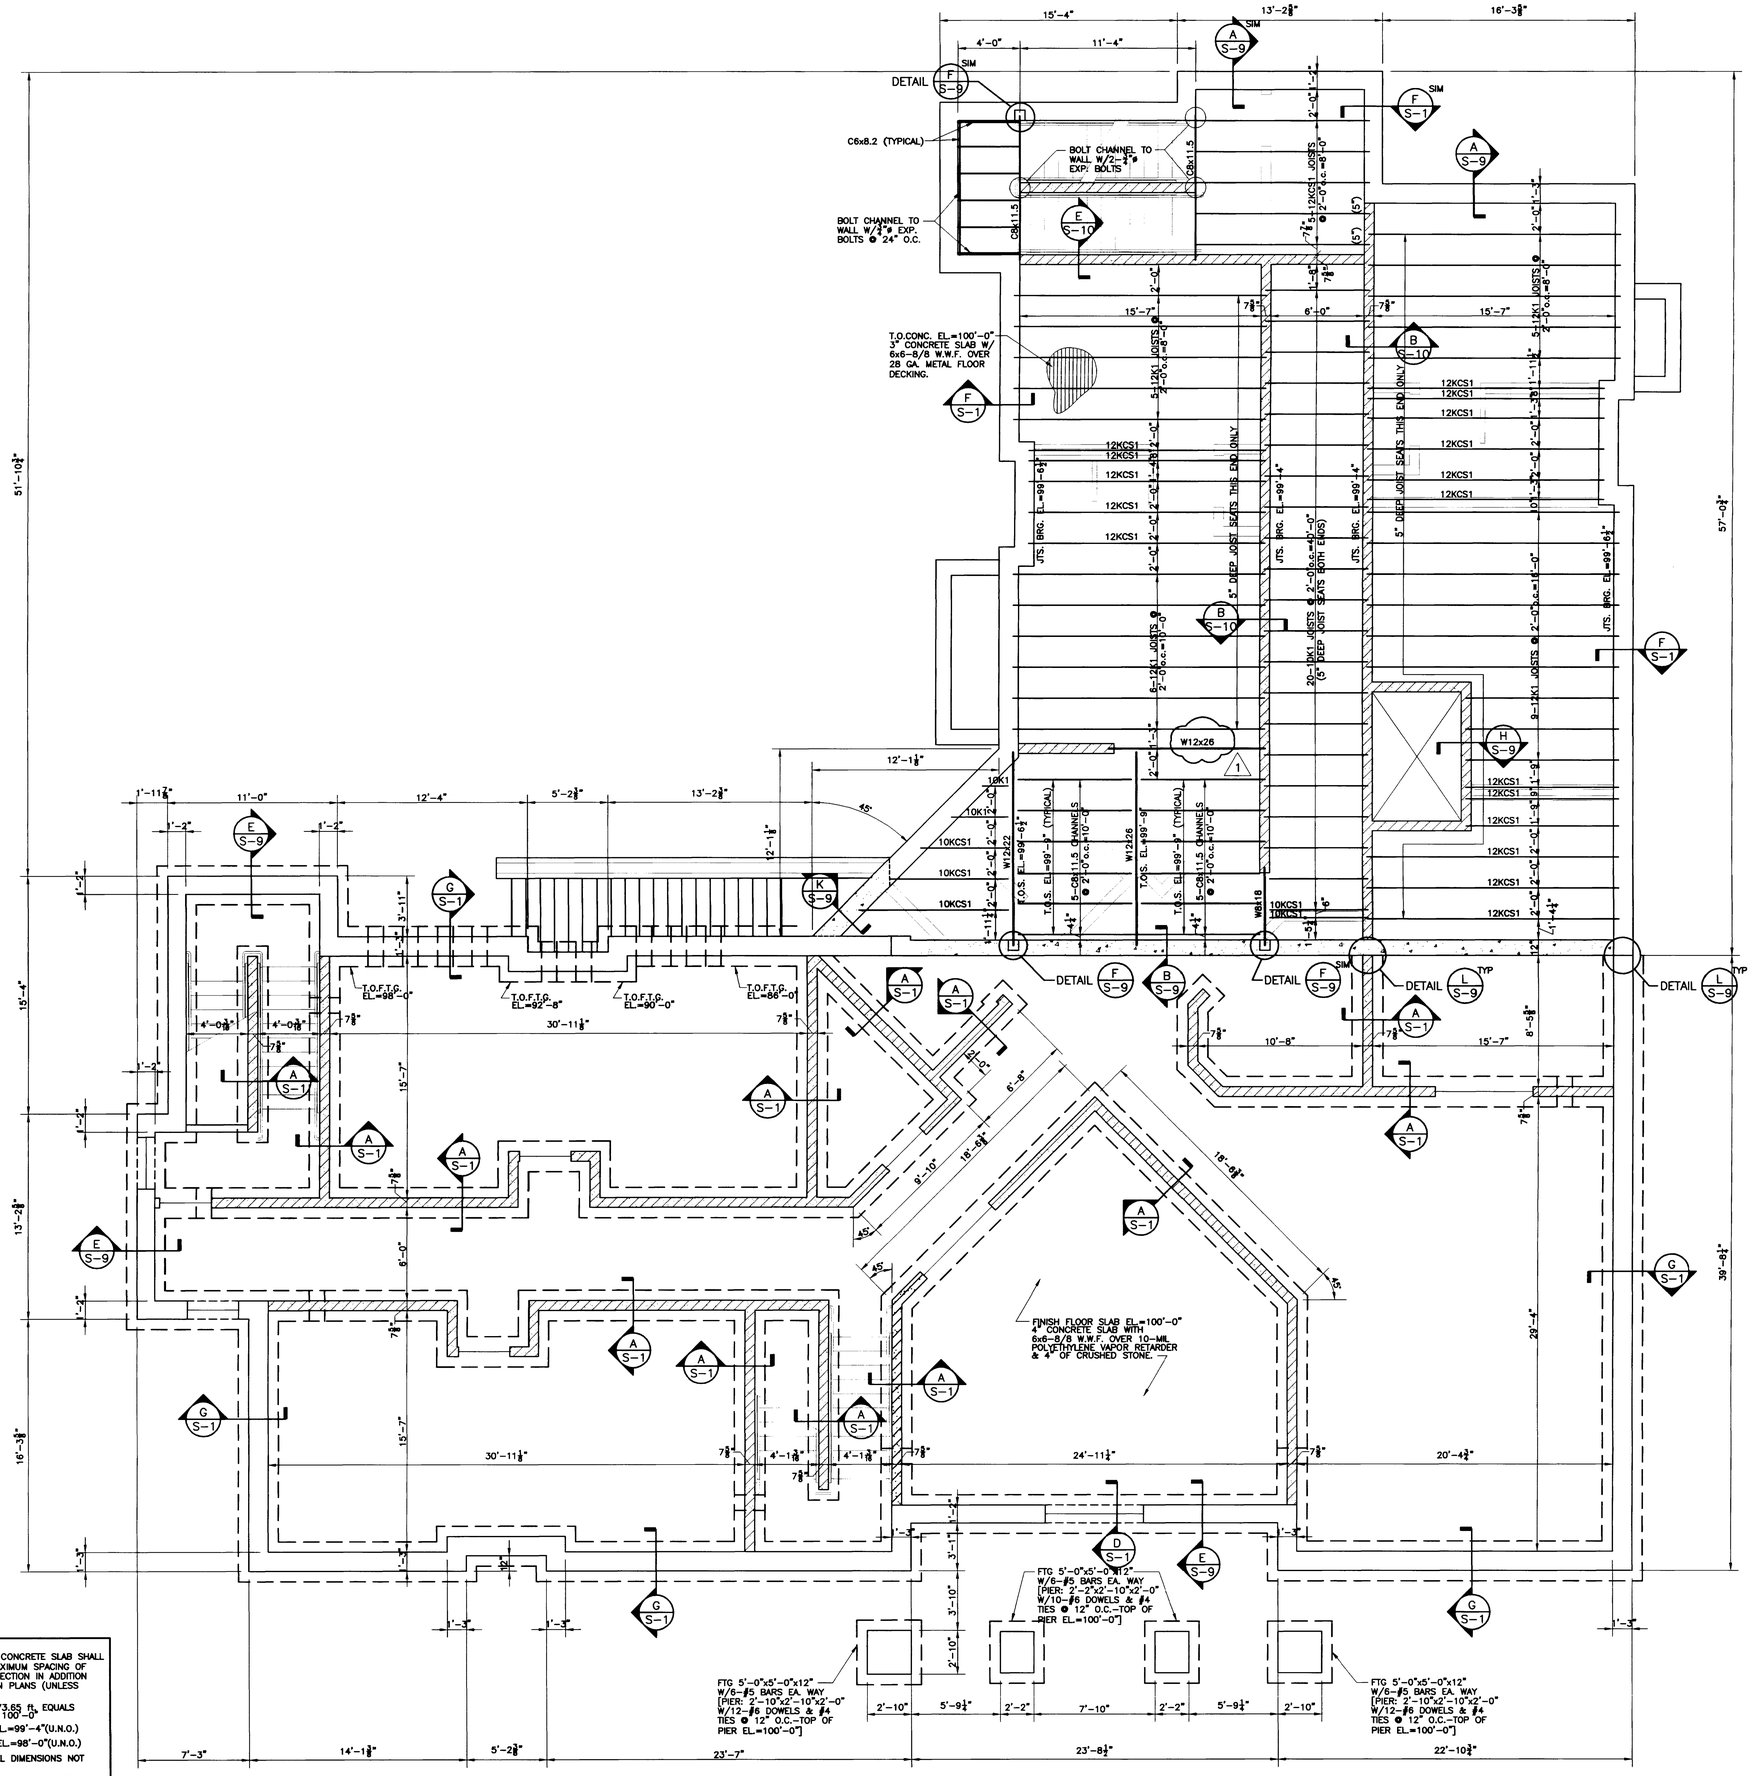

NOTES TO CONTRACTOR:

1.) CONTROL JOINTS IN CONCRETE SLAB SHALL BE PLACED AT A MAXIMUM SPACING OF 16'-0" IN EACH DIRECTION IN ADDITION TO THOSE NOTED ON PLANS (UNLESS NOTED OTHERWISE.)

2.) DATUM ELEVATION 973.65 ft. EQUALS ASSUMED ELEVATION 100'-0"

3.) INTERIOR T.O. FTG EL.=99'-4"(U.N.O.)

4.) EXTERIOR T.O. FTG EL.=98'-0"(U.N.O.)

5.) SEE ARCH. FOR WALL DIMENSIONS NOT SHOWN ON PLAN.

6.) ALL FOOTING EXCAVATIONS SHALL BE PERFORMED ACCORDING TO GEOTECHNICAL REPORT.

FIRST FLOOR FRAMING & PARTIAL FOUNDATION PLAN - BUILDING 0505

These Record Drawings have been prepared based on information provided by others. The Design Professional has not verified the accuracy and/or the completeness of this information and shall not be responsible for any errors or omissions which may be incorporated herein as a result.

FRATERNITY HOUSE REPLACEMENT - PROJECT 1747.0

UNIVERSITY OF KENTUCKY

LEXINGTON, KENTUCKY

FIRST FLOOR FRAMING & PARTIAL FOUNDATION PLAN - BUILDING 0505

Job No: P-2252 Omni-4913 | Date: Aug. 2000 | Drawn By: BCT | Checked: CJK | Revisions: 1 RECORD DRAWINGS 5-29-02

This Drawing and Design shown thereon are the property of Omni Architects®. The reproduction, copying or other use of this Drawing without the written consent of Omni Architects is prohibited.

POAGE ENGINEERS & ASSOCIATES, INC.
445 EAST HIGH STREET
LEXINGTON, KENTUCKY 40507
PHONE: (859) 252-0054
FAX: (859) 252-0150

Omni Architects
Architecture
Landscape Architecture
Civil Engineering
Planning
Interiors
212 North Upper Street
Lexington, KY 40507
(859) 252-8004 Fax (859) 252-9368

S-6

2c 92c