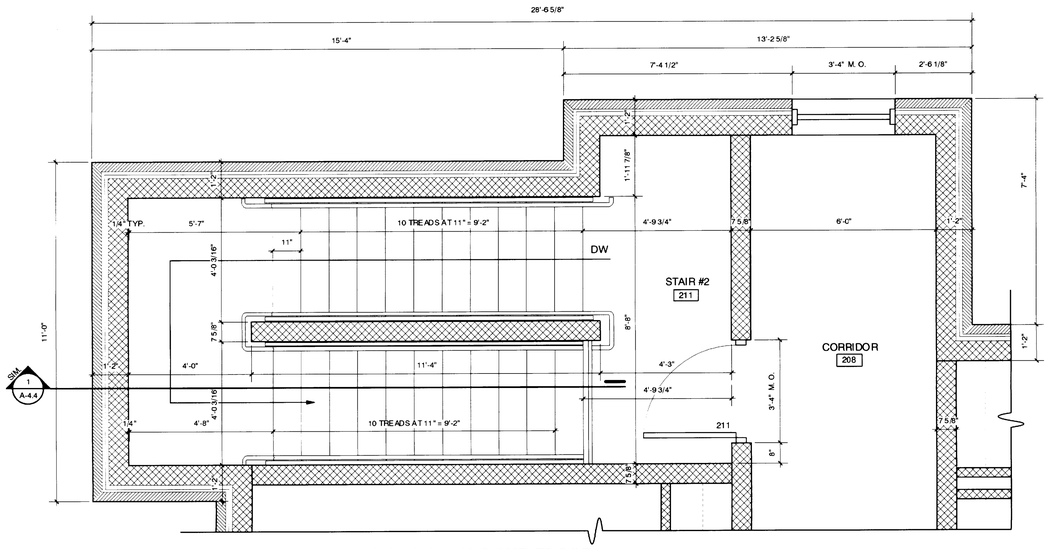

6 A-5.3 **BUILDING 0505 - STAIR PLAN "#2" @ 2ND FLOOR**
1/2" = 1'-0"

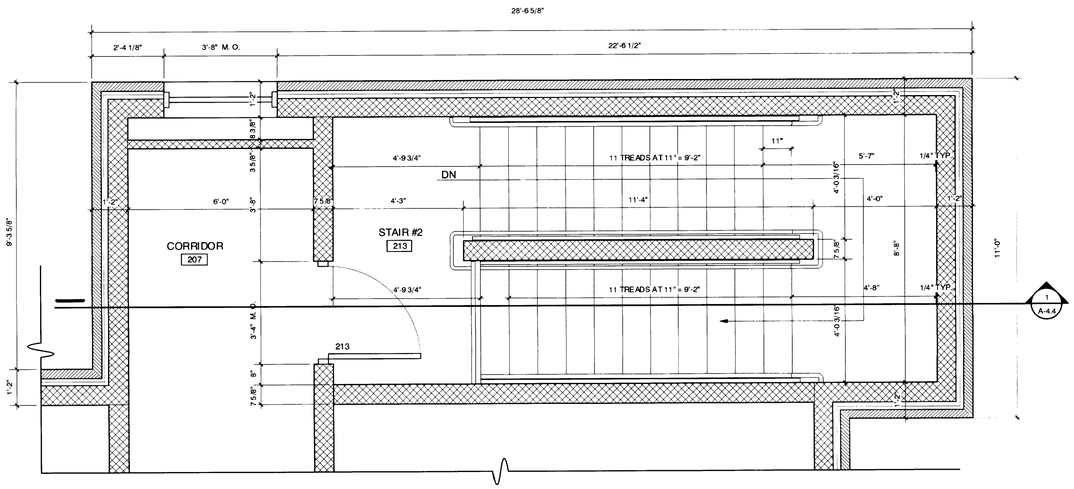

3 A-5.3 **BUILDING 0504 - STAIR PLAN "#2" @ 2ND FLOOR**
1/2" = 1'-0"

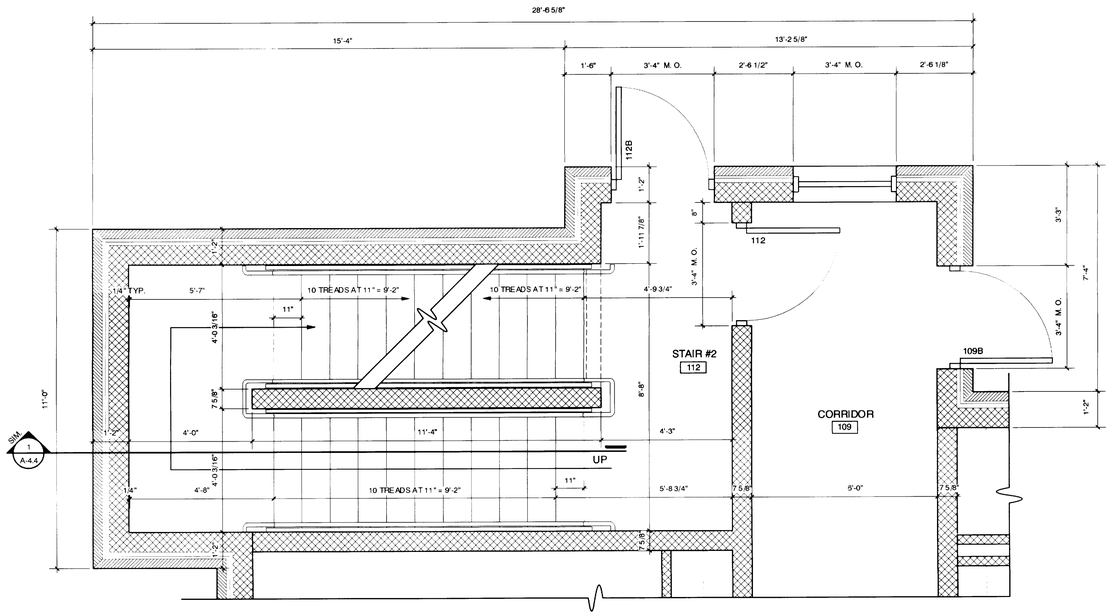

5 A-5.3 **BUILDING 0505 - STAIR PLAN "#2" @ 1ST FLOOR**
1/2" = 1'-0"

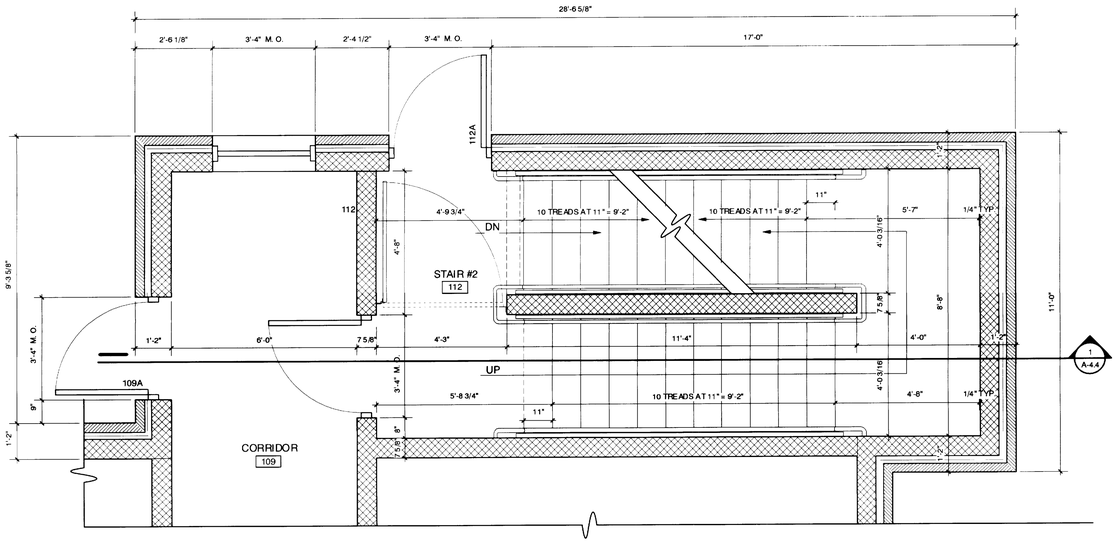

2 A-5.3 **BUILDING 0504 - STAIR PLAN "#2" @ 1ST FLOOR**
1/2" = 1'-0"

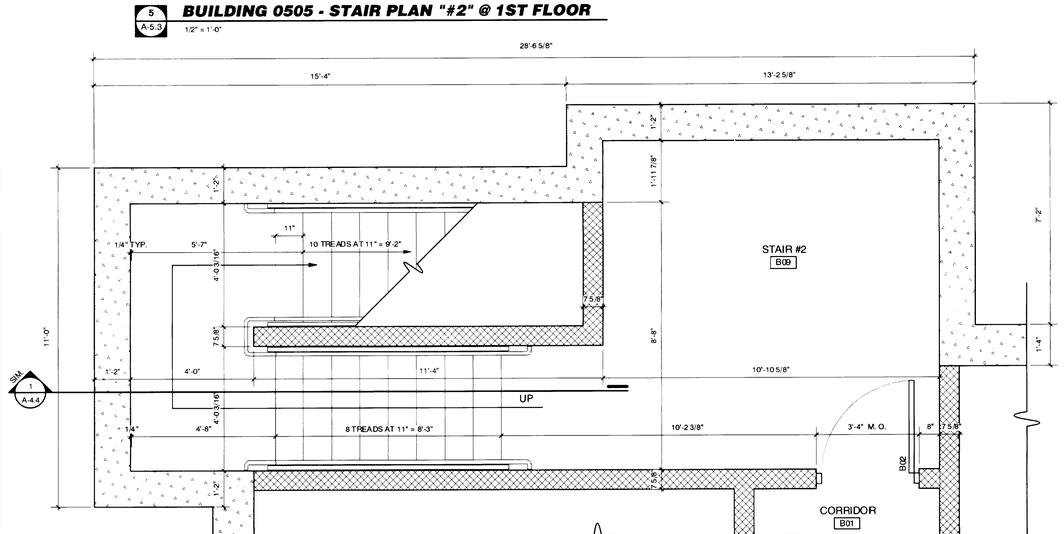

4 A-5.3 **BUILDING 0505 - STAIR PLAN "#2" @ BASEMENT**
1/2" = 1'-0"

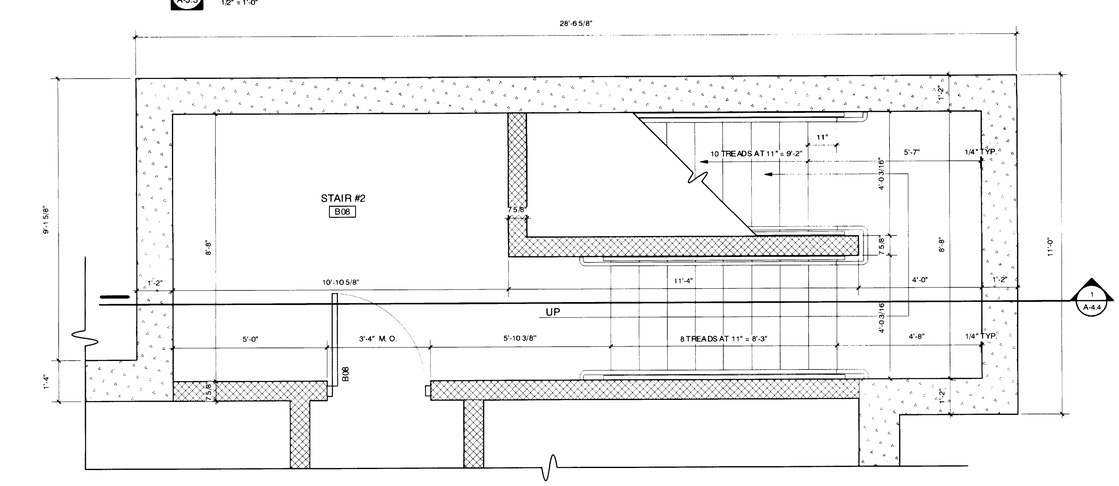

1 A-5.3 **BUILDING 0504 - STAIR PLAN "#2" @ BASEMENT**
1/2" = 1'-0"

UNIVERSITY OF KENTUCKY

LEXINGTON, KENTUCKY

This Drawing and Design shown thereon are the property of Omni Architects ©. The reproduction, copying or other use of this Drawing without the written consent of Omni Architects is prohibited.

GREGORY W. WHITE — REGISTERED ARCHITECT — KENTUCKY — 2850 — COMMONWEALTH OF KENTUCKY

JOSEPH F. WILLIAMS — REGISTERED ARCHITECT — KENTUCKY — 1225 — COMMONWEALTH OF KENTUCKY

Omni Architects
Architecture
Landscape Architecture
Civil Engineering
Planning
Interiors
212 North Upper Street
Lexington, KY 40507
(859) 252-9666 Fax: (859) 253-2258

Omni Architects

FRATERNITY HOUSE REPLACEMENT - PROJECT 1747.0

BUILDING 0504 & 0505 - STAIR PLANS

Job No: 9913.00 Date: August 2000 Drawn By: MD Checked: JFW/GWW Revisions:

RECORD DRAWINGS
These record drawings have been prepared, in part, from information furnished by others. The Architect/Engineer has not performed any on-site observations to verify the data shown and has been incorporated into this document as a result.
Omni Architects — 6-21-02 — DATE

A-5.3

Cab # Slot Document # 21012