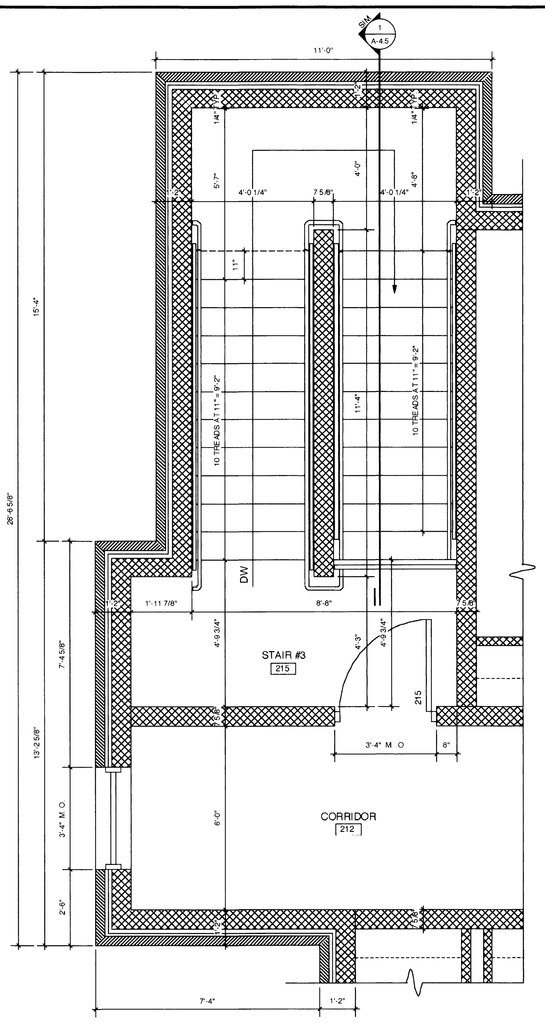

4 A-5.4 **BUILDING 0505 - STAIR PLAN "#3" @ 2ND FLOOR**

1/2" = 1'-0"

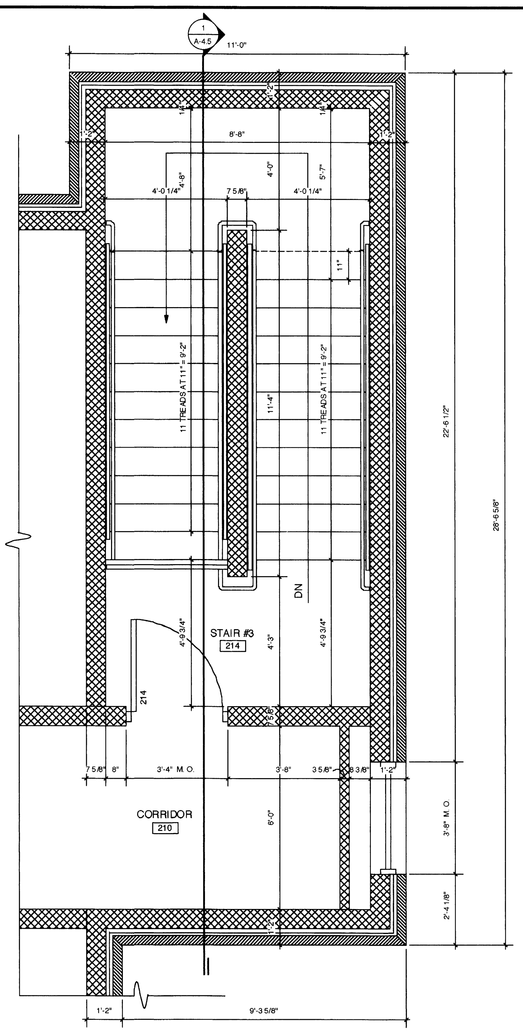

2 A-5.4 **BUILDING 0504 - STAIR PLAN "#3" @ 2ND FLOOR**

1/2" = 1'-0"

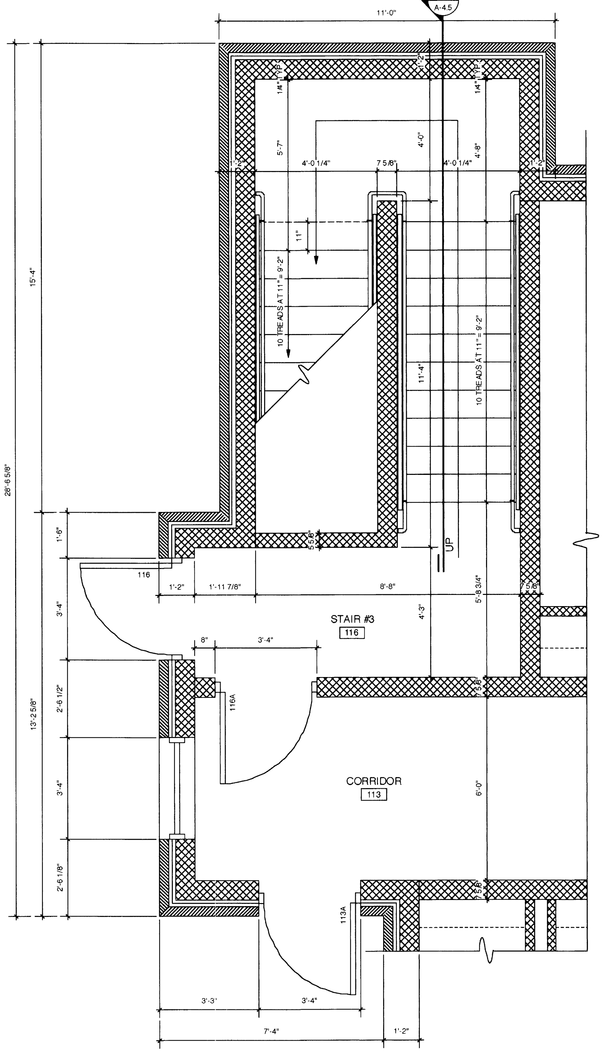

3 A-5.4 **BUILDING 0505 - STAIR PLAN "#3" @ 1ST FLOOR**

1/2" = 1'-0"

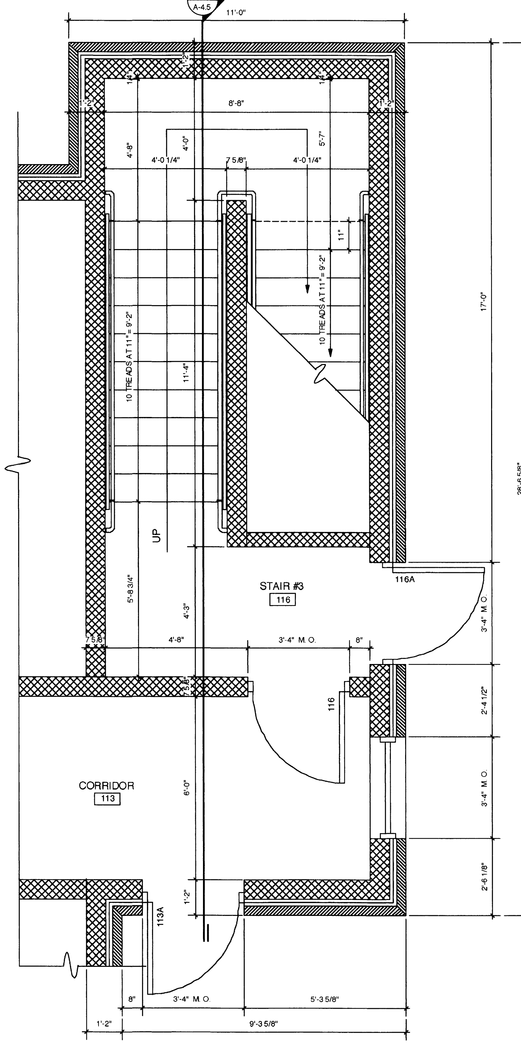

1 A-5.4 **BUILDING 0504 - STAIR PLAN "#3" @ 1ST FLOOR**

1/2" = 1'-0"

FRATERNITY HOUSE REPLACEMENT - PROJECT 1747.0

UNIVERSITY OF KENTUCKY

LEXINGTON, KENTUCKY

BUILDING 0504 & 0505 - STAIR PLANS

Job No: 9913.00 Date: August, 2000 Drawn By: NXD Checked: JFW Revisions:

This Drawing and Design shown thereon are the property of Omni Architects ©. The reproduction, copying or other use of this Drawing without the written consent of Omni Architects is prohibited.

A-5.4

Cab # Slot Document #
43 C-3 21013

RECORD DRAWINGS
These record drawings have been prepared, in part, on the basis of information compiled and furnished by others. The Architect will not be responsible for any errors or omissions which have been incorporated into this document as a result.
Omni Architects 6-31-02 DATE

Omni *Architects*

Architecture
Landscape Architecture
Civil Engineering
Planning
Interiors

212 North Upper Street
Lexington, KY 40507
(859) 252-6664 Fax: (859) 253-2358

JOSEPH F. WILLIAMS REGISTERED NO. 1223 COMMONWEALTH OF KENTUCKY ARCHITECT

GREGORY W. WHITE REGISTERED NO. 2800 COMMONWEALTH OF KENTUCKY ARCHITECT