


W.T. YOUNG

1-85 HVAC MODIFICATIONS - RETURNS FOR OFFICES

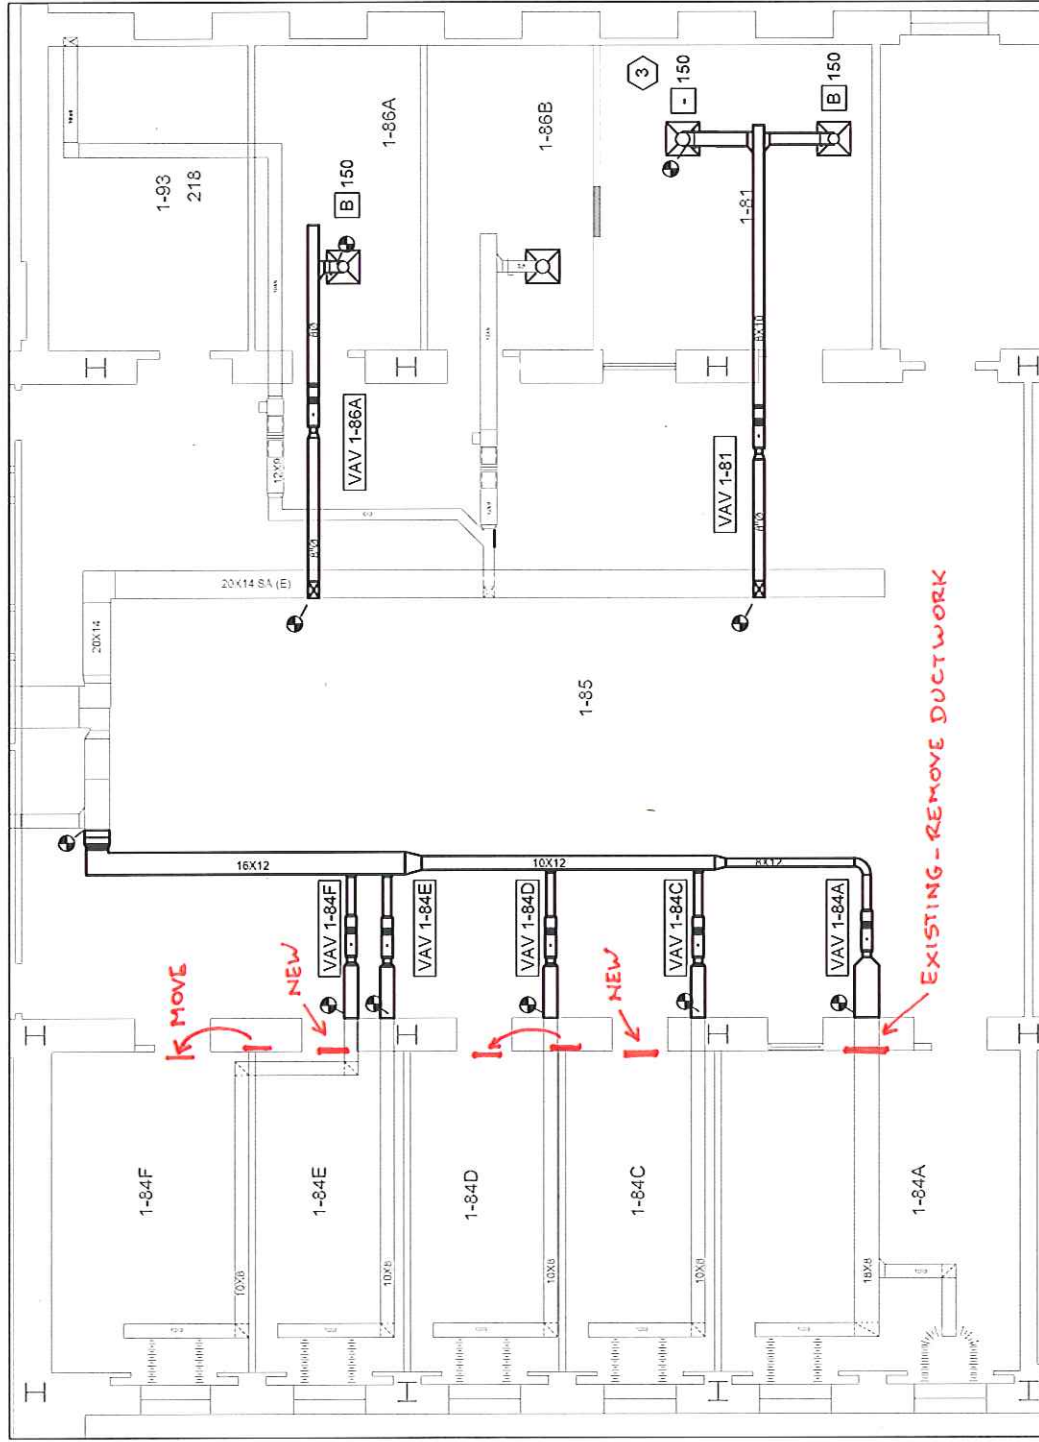

HVAC RETURN AIR NETWORK

NEW GRILLES TO MATCH EXISTING SIZE, CONSTRUCTION, & COLOR.

6.18.14
BL