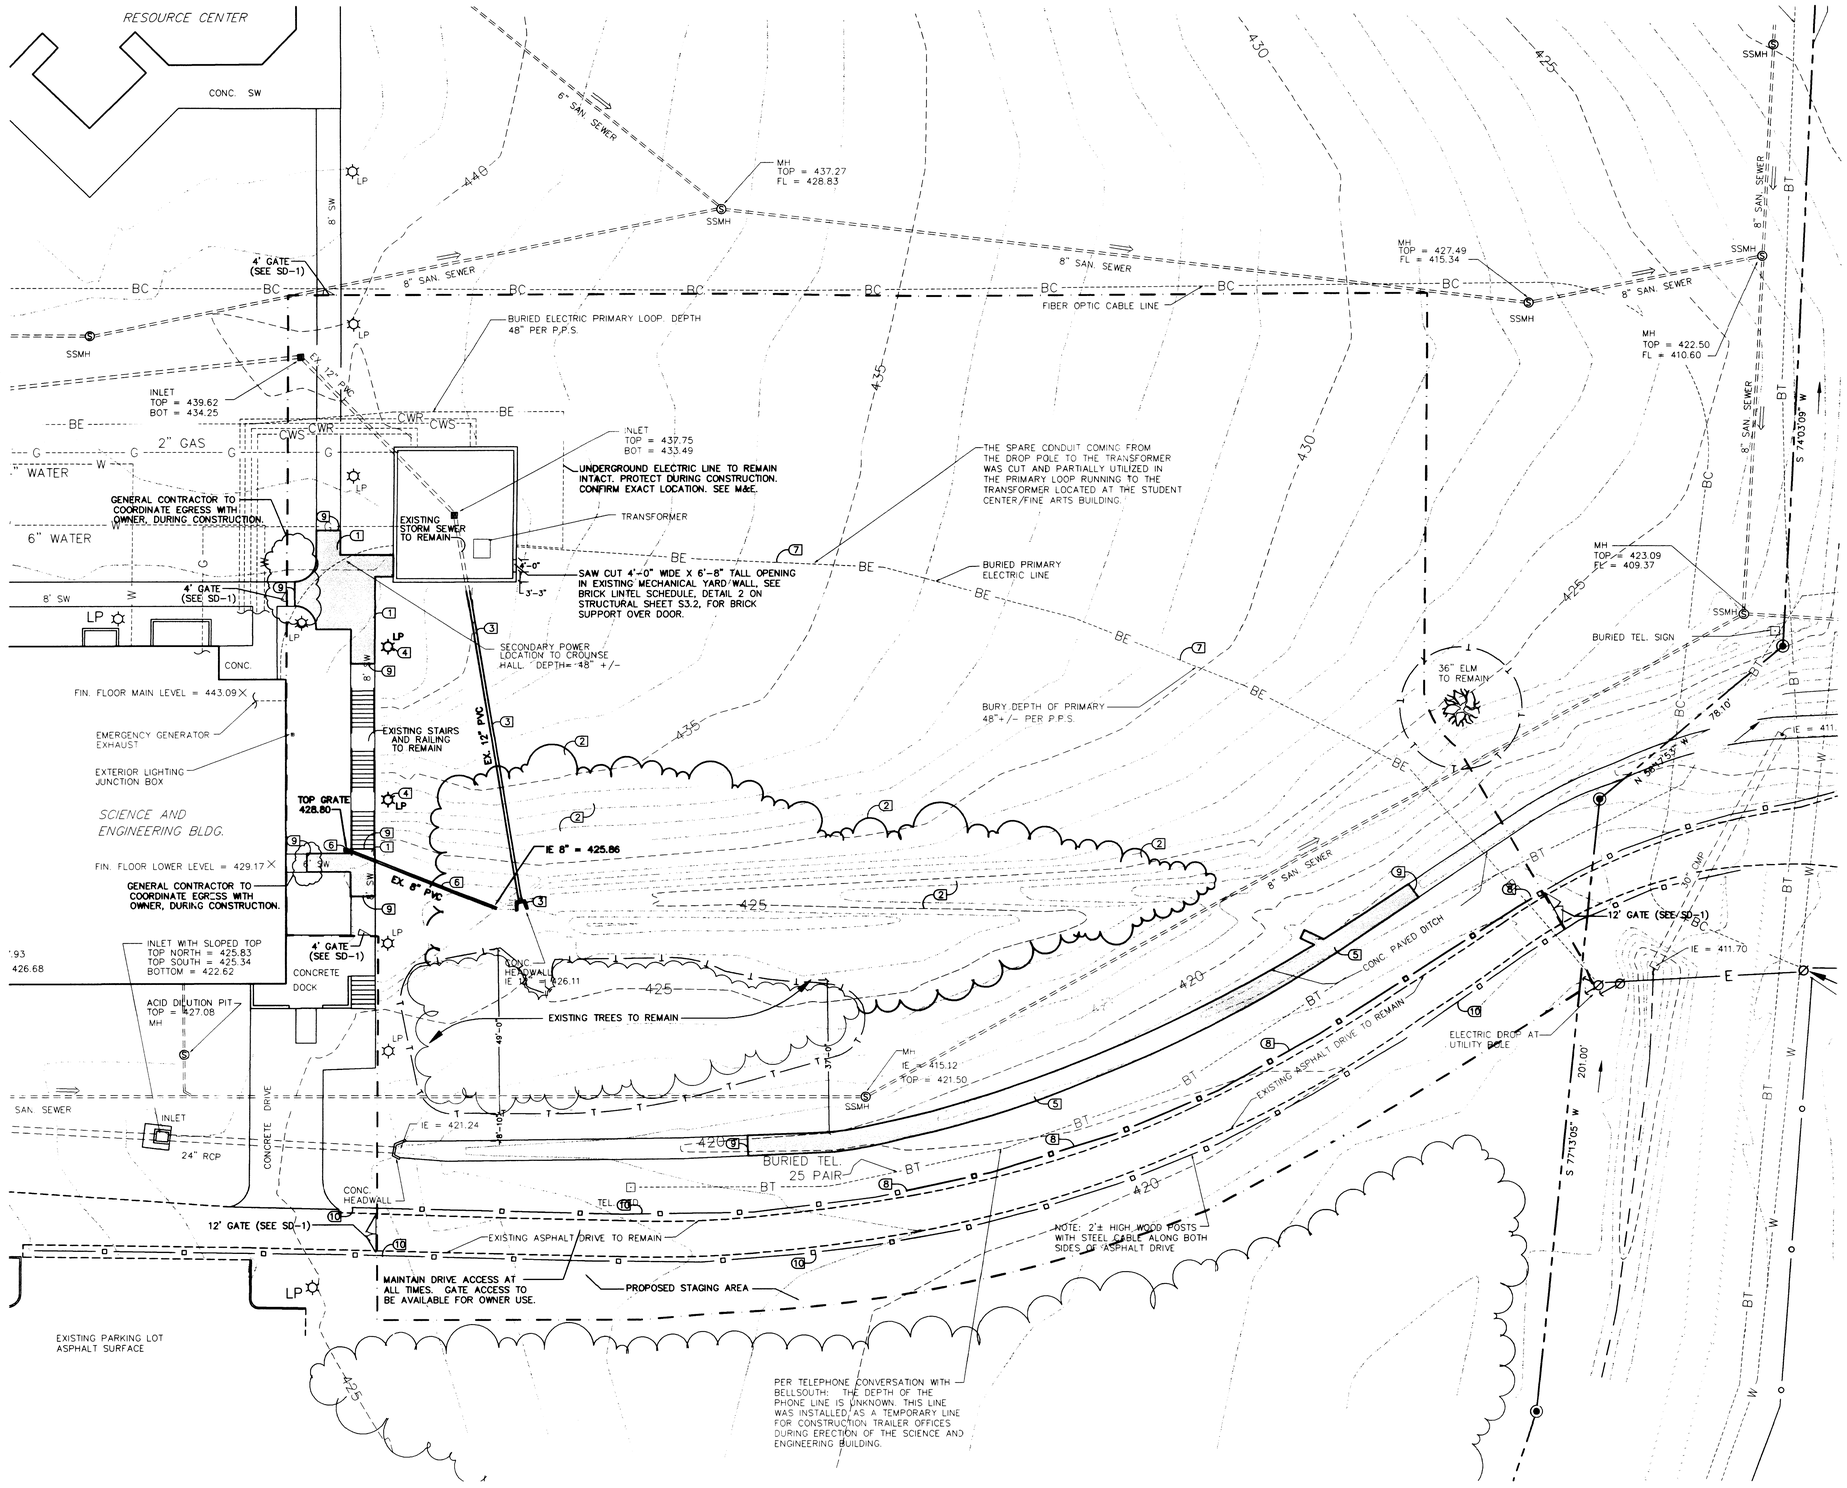

TREE PROTECTION NOTES

1. TREE PROTECTION FENCES SHALL BE CONSTRUCTED PRIOR TO ANY EARTHWORK ON SITE. ALL EXISTING TOPSOIL / GRASS / GROUNDCOVER SHALL BE LEFT INTACT WITHIN THE BOUNDARY OF THE TREE PROTECTION FENCE.

2. TREE PROTECTION FENCES SHALL BE MAINTAINED AND THE AREA WITHIN THE BOUNDARY SHALL BE MOWED THROUGHOUT THE CONSTRUCTION PERIOD.

3. NO HEAVY EQUIPMENT OR TRAFFIC SHALL BE ALLOWED WITHIN THE TREE PROTECTION FENCES AT ANY TIME.

4. IF NEW CONSTRUCTION IS REQUIRED WITHIN THE TREE PROTECTION FENCE BOUNDARY, THE ARCHITECT IS TO BE NOTIFIED OF THE REASON AND THE SCOPE OF WORK WITHIN THE TREE PROTECTION FENCE. THE FENCE SHALL BE REINSTALLED TO MAINTAIN PROTECTION THROUGH THE ENTIRE CONSTRUCTION PERIOD.

5. TREE PROTECTION FENCES SHALL BE REMOVED FROM THE SITE AT THE END OF THE CONSTRUCTION.

6. TREE PROTECTION FENCES TO BE "SERVICE AND MATERIALS COMPANY" ORANGE LIGHTWEIGHT WARNING BARRIER FENCE OR EQUAL.

GENERAL DEMOLITION NOTES:

1. SITE DEMOLITION DRAWINGS ARE INTENDED TO GENERALLY SHOW THE DEMOLITION NECESSARY TO COMPLETE THE NEW WORK. THE CONTRACTOR SHALL REVIEW ALL DOCUMENTS AND VISIT AND OBSERVE THE SITE PRIOR TO SUBMITTING HIS BID AND SHALL INCLUDE IN HIS BID ALL WORK NECESSARY TO ACCOMPLISH THE NEW WORK, WHETHER OR NOT SHOWN ON THESE DEMOLITION DRAWINGS.

2. ALL TREES ARE TO REMAIN UNLESS SPECIFICALLY NOTED OTHERWISE.

3. SEE SITE UTILITY PLANS (SHEET ME-2) FOR DEMOLITION OF UTILITIES.

SITE DEMOLITION KEY

1. EXISTING CONCRETE PAVING AND GRAVEL SUB-BASE TO BE REMOVED.
2. EXISTING TREES AND ROOT SYSTEMS TO BE REMOVED COMPLETELY, AS REQUIRED BY GRADING.
3. EXISTING STORM SEWER PIPE & HEADWALL TO BE REMOVED TO THE LIMITS SHOWN.
4. EXISTING LIGHT POLE TO BE REMOVED COMPLETELY – REFER TO ELECTRICAL DRAWINGS.
5. EXISTING CONCRETE PAVED DITCH TO BE REMOVED TO THE LIMITS SHOWN.
6. EXISTING STORM SEWER PIPE & INLET TO BE REMOVED.
7. SEE SITE UTILITY PLANS.
8. EXISTING WOOD POSTS WITH STEEL CABLE TO BE REMOVED TO THE LIMITS SHOWN.
9. SAWCUT EXISTING PAVEMENT FOR STRAIGHT, CLEAN EDGE.
10. EXISTING WOOD POSTS WITH STEEL CABLE TO BE REMOVED AS REQUIRED FOR GENERAL CONTRACTOR USE OF STAGING AREA. WOOD POSTS AND STEEL CABLE TO BE REINSTALLED AT THE END OF CONSTRUCTION.

LEGEND

EXISTING CONCRETE AND GRAVEL SUB-BASE TO BE REMOVED.

— — — LIMITS OF DEMOLITION/CONSTRUCTION

—— T —— TREE PROTECTION FENCE

SITE DEMOLITION

SCALE: 1" = 20'-0"

10 0 20 80

SCALE IN FEET

Crisp Building Replacement
Paducah Community College

SITE DEMOLITION

RECORD DRAWING-SEPTEMBER 23, 2002

Sherman·Carter·Barnhart PSC
PARTNERS IN ARCHITECTURE
2405 HARRODSBURG ROAD · LEXINGTON, KY 40504 · PH: 859-224-1351 · FAX: 859-224-8446

JOB NO.	0044
DATE	FEBRUARY 01, 2001
DRAWN	JBS, DCL, CAH
CHECKED	BKL, JDC

COPYRIGHT © 2001 SHERMAN / CARTER / BARNHART, PSC

REVISIONS 1

SHEET

DS-1

Paducah Community College - Crisp
Drawing Name: J:\2000\0044\dwg\0044-01.dwg
Date & Time: Oct 08, 2002 - 9:32am
Login Name: deschman